
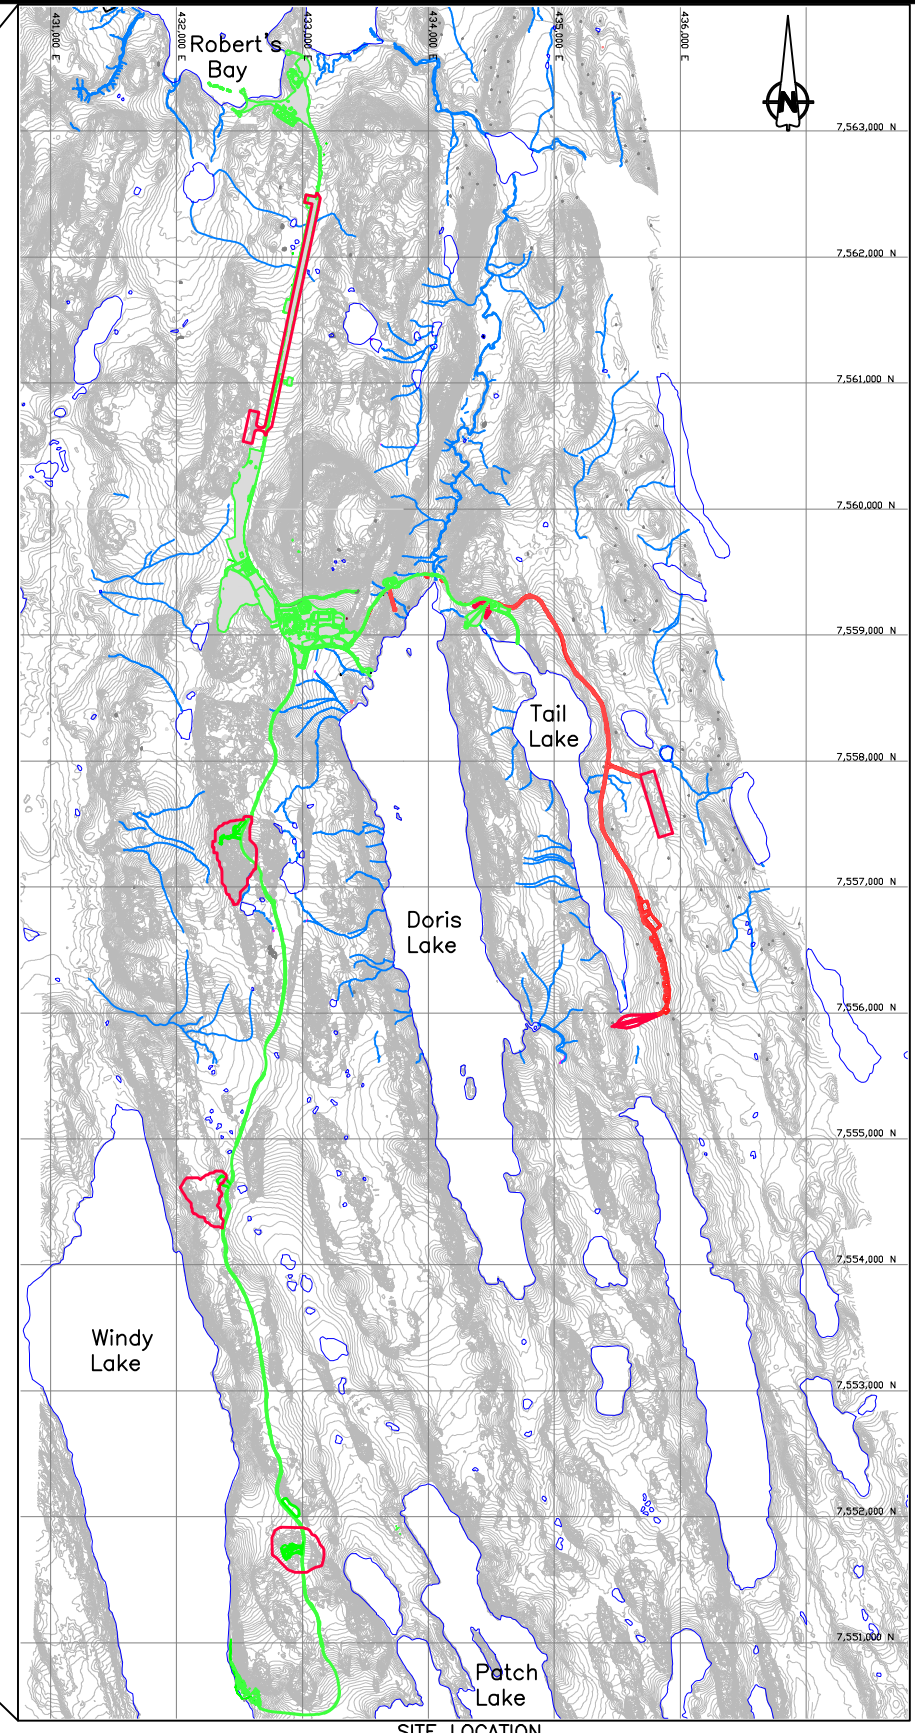
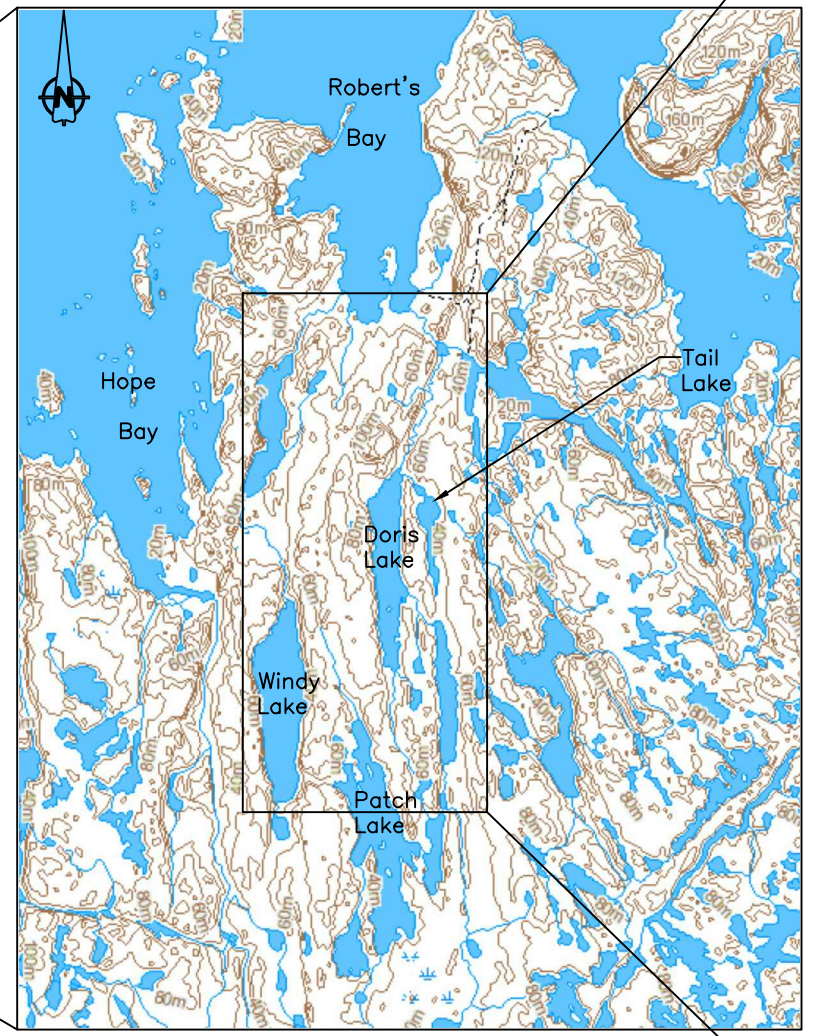


Figures

J:\01_SITES\Hope Bay\1CT022.001_2014 Hope Bay Ongoing Support\040_AutoCAD\1CT022.001_GT-2014.dwg

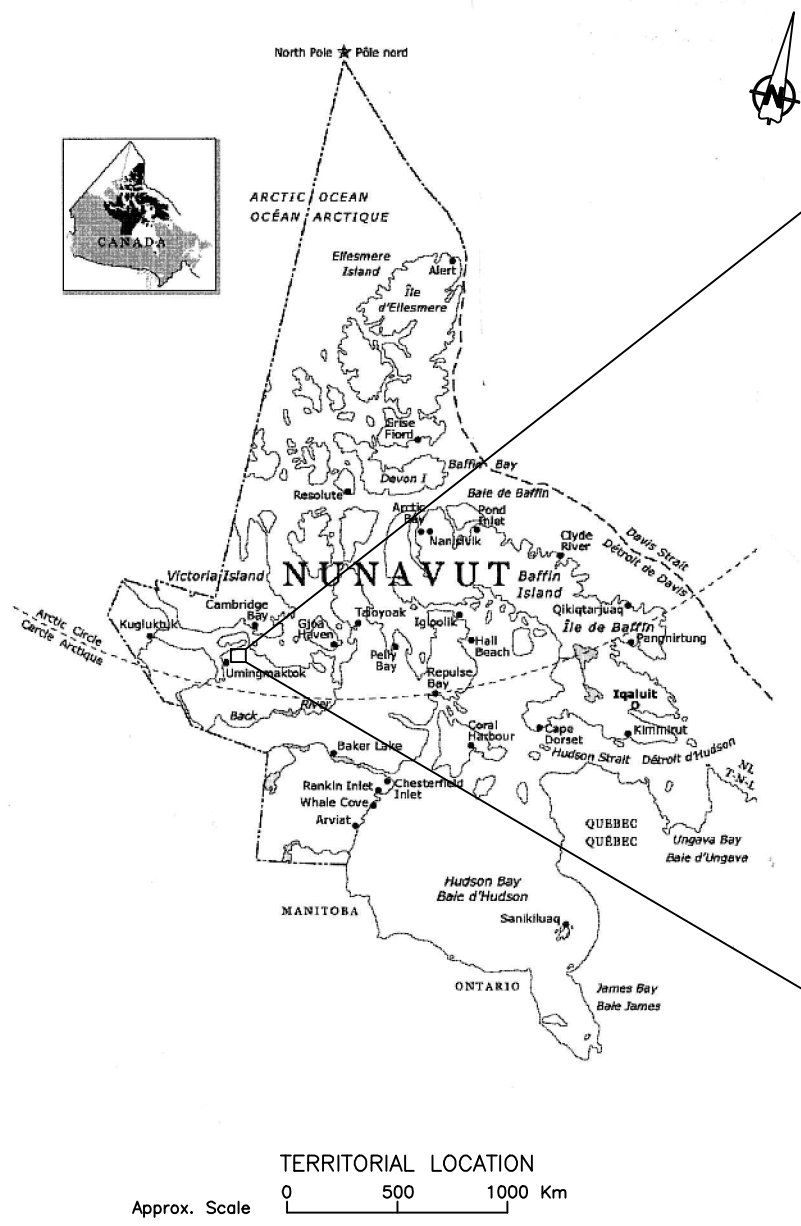

LEGEND

| | |
|--|----------------------------------|
| | Asbuilt |
| | Licensed but not yet constructed |

| | | | | | |
|--|-----------------------------|------------------------------|------------------|---------------|-----------|
| | | 2014 Geotechnical Inspection | | | |
| | | Location Map | | | |
| SRK JOB NO.: 1CT022.001 FILE NAME: 1CT022.001_GT-2014.dwg | HOPE BAY MINING LTD. | | DATE: March 2014 | APPROVED: EMR | FIGURE: 1 |