


c:\01\_SITES\Hope Bay\1CT022.000.320\_2014\_Doris\_Annual\_Inspection\1CT022.001\_GT-2014.dwg

LEGEND

- Active Thermistor Installation
- Inactive Thermistor Installation
- Status Unknown
- Westbay Wells
- Proposed Thermistor Location
- Asbuilt
- Licensed but not yet Constructed

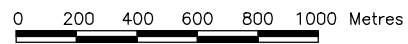

 SRK JOB NO.: 1CT022.001 FILE NAME: 1CT022.001_GT-2014.dwg	 HOPE BAY MINING LTD.	2014 Geotechnical Inspection		
		Overall Site Layout (Sheet 2)		
		DATE: Nov. 2014	APPROVED: EMR	FIGURE: 3





View of Roberts Bay Fuel Tank Farm and Laydown area – looking southwest




View of Roberts Bay Fuel Tank Farm, Jetty and Laydown area – looking southeast



View of the Old Beach Laydown Area – looking north



Airstrip – looking northwest towards North Apron

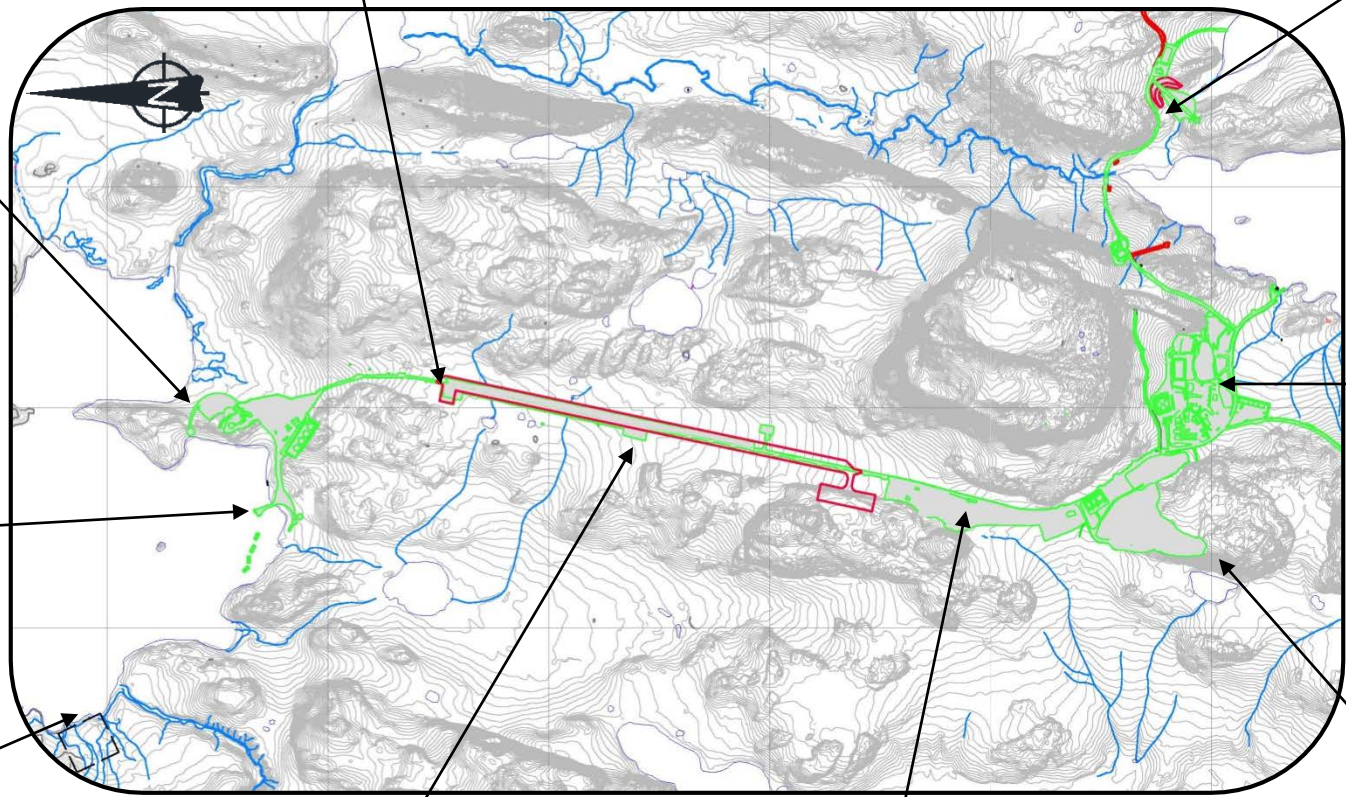

Aerial view of the North Dam - looking west



Aerial view of Camp – looking east



Aerial view Quarry 2 – looking north



Upper and Lower Reagent Pads – looking west



Airstrip -- looking northwest

		2014 Geotechnical Inspection		
		Current Site Layout		
Job No: 1CT022.001	HOPE BAY MINING LTD.	Date: Oct 2014	Approved: LW	Figure: 4
Filename: 2014GeotechInsp_rev00				