
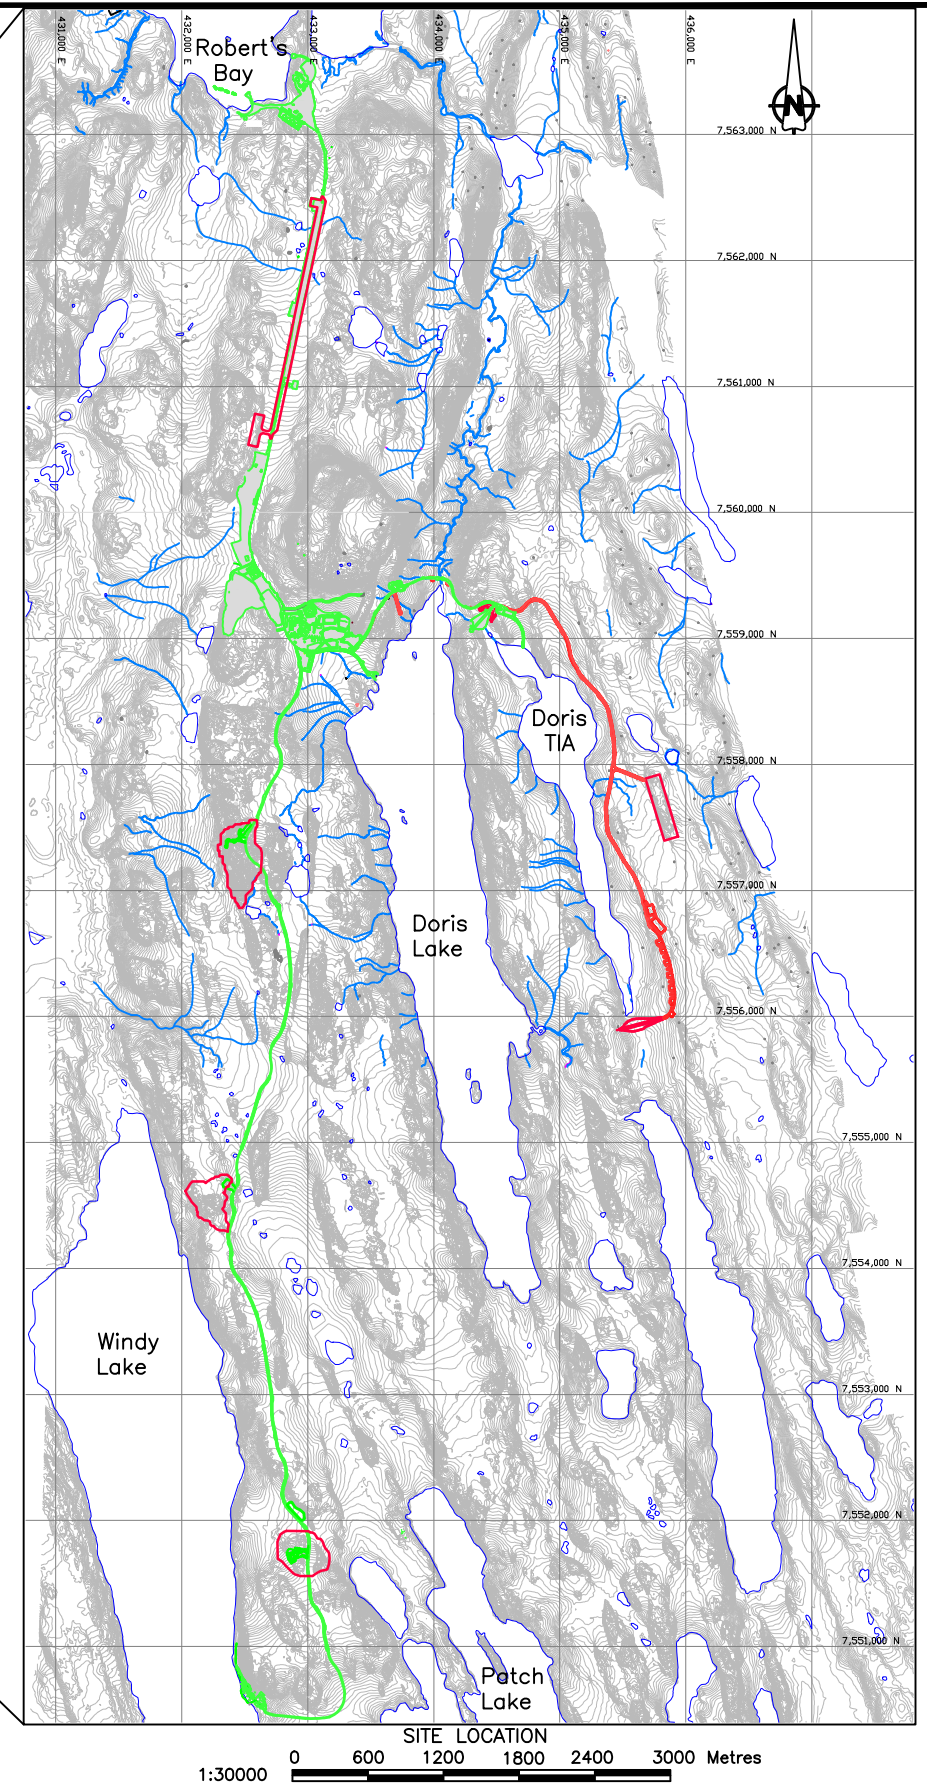
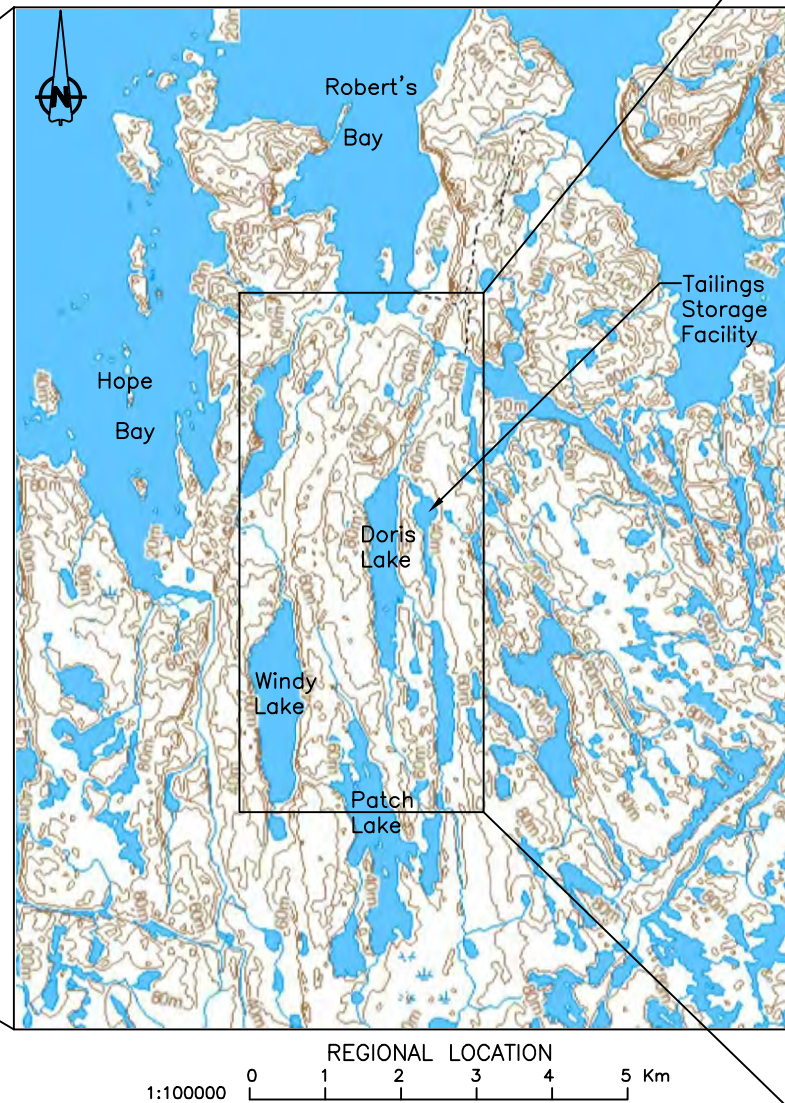


Figures

C:\GT_SITES\Hope Bay\North Dem\2016 Annual Inspection\1CT022.009_GT-2016.dwg

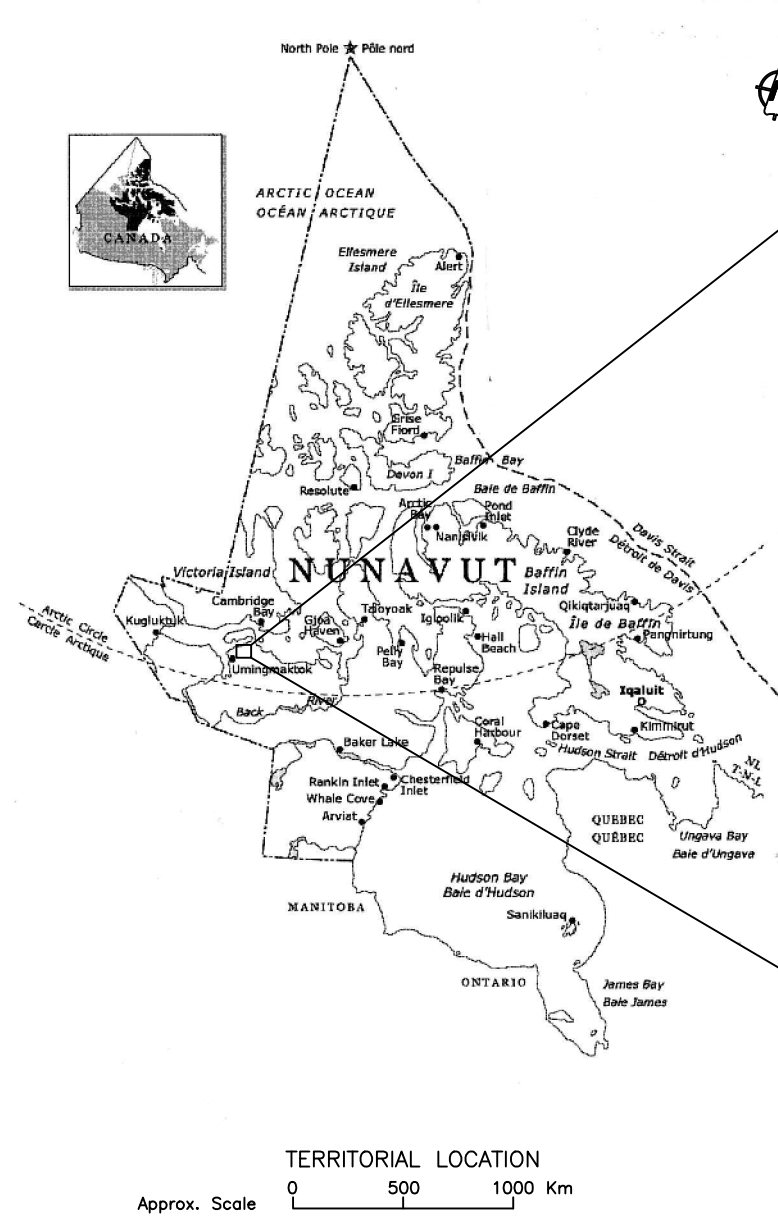

LEGEND

- Asbuilt
- Licensed but not yet constructed

srk consulting

SRK JOB NO.: 1CT022.009

FILE NAME: 1CT022.009_GT-2016.dwg

MAC
RESOURCES

DORIS MINE

2016 Geotechnical Inspection

Location Map

DATE: Jan. 2017 APPROVED: PL FIGURE: 1