


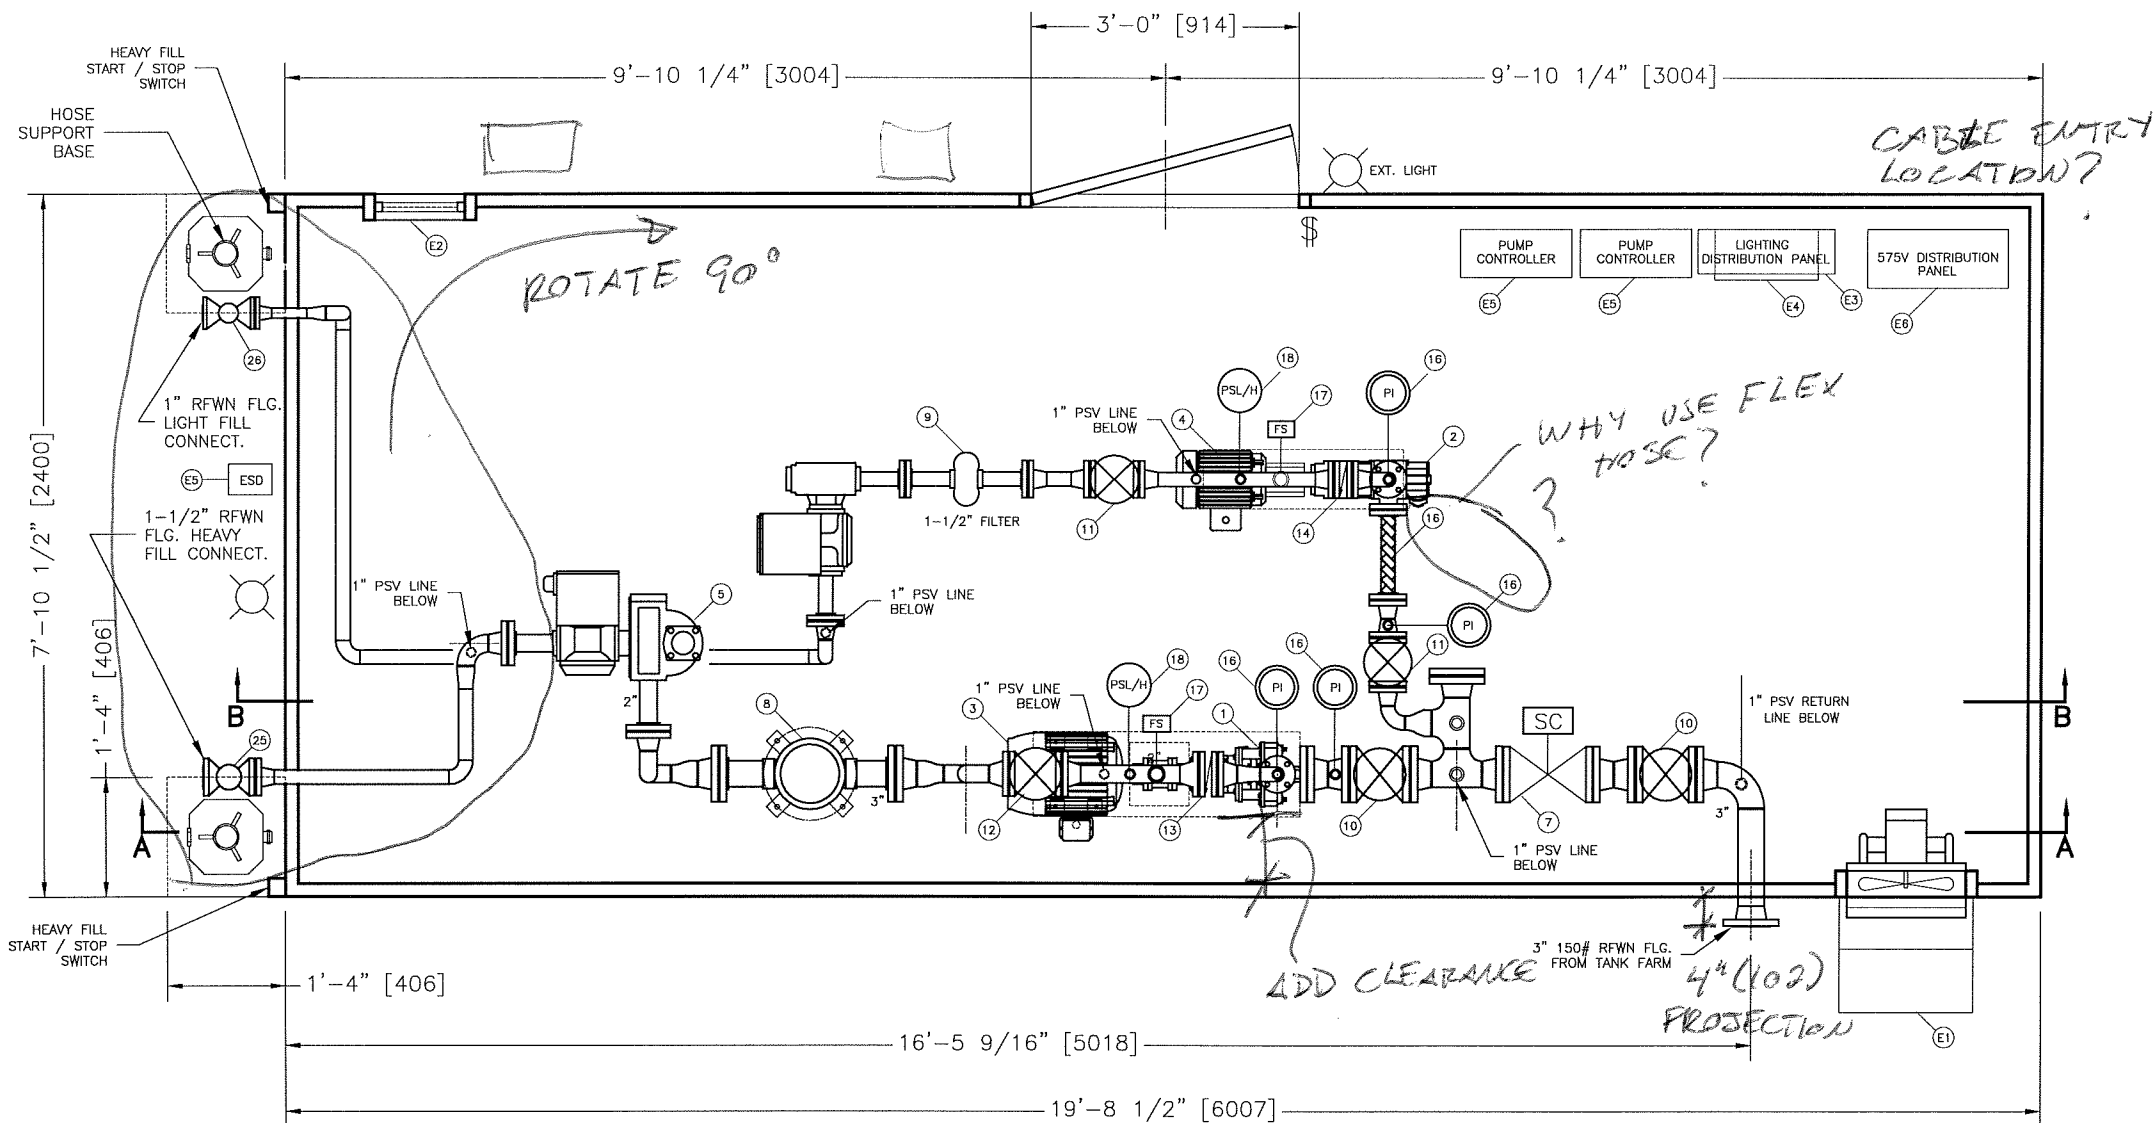

LEGEND

- ① PEERLESS - 1.5X3 - 6 STP 8196 HEAVY FILL PUMP
- ② 1 HP GORMAN RUPP PUMP RATED AT 10 GPM - LIGHT FILL
- ③ WEG ELECTRIC MOTOR (7.5HP, 3500RPM, 213T, 3/60/575V)
- ④ WEG ELECTRIC MOTOR (1HP, 1200RPM, 145T, 3/60/575V)
- ⑤ TCS 700-25 2" DISCHARGE STRAINER AND FLOW METER
- ⑥ TCS 700-15 2" DISCHARGE STRAINER AND FLOW METER
- ⑦ CLAVAL - 3" 120VAC SOLENOID FIRE SAFE VALVE
- ⑧ CIMTEK GENERAL III 3" BASKET FILTER
- ⑨ 1-1/2" CIMTEK CENTURION III FILTER
- ⑩ 3" GATE VALVE
- ⑪ 1-1/2" GATE VALVE
- ⑫ 2" GATE VALVE
- ⑬ 2" CHECK VALVE
- ⑭ 1-1/2" CHECK VALVE
- ⑮ 1-1/2" FLEX HOSE
- ⑯ PRESSURE GAUGE
- ⑰ FLOW SWITCH
- ⑱ PRESSURE SWITCH HIGH/LO DISCHARGE PRESSURE ALARM
- ⑲ 1" PSV SET AT 75PSI
- ⑳ 1-1/2" WIGGEN DRY BREAK (HEAVY FILL)
- ㉑ 1" NOZZLE (LIGHT FILL)
- ㉒ 3" PIPE AND FITTINGS
- ㉓ 1-1/2" PIPE AND FITTINGS
- ㉔ 2" PIPE AND FITTINGS
- ㉕ 1-1/2" BALL VALVE
- ㉖ 1" BALL VALVE
- ㉗ 1" PIPE AND FITTINGS
- ㉘ EXHAUST FAN
- ㉙ INTAKE LOUVRE
- ㉚ LIGHTING DISTRIBUTION PANEL
- ㉛ TRANSFORMER
- ㉜ PUMP CONTROLLER
- ㉝ 575V DISTRIBUTION PANEL

EQUIPMENT WEIGHT

TOTAL WEIGHT OF PACKAGE = 7900 LBS. [3587 kg]


GENERAL NOTES:

- ALL DIMENSIONS ARE + OR - 1/2" [13 mm]

PAINT SPECIFICATIONS:

STRUCTURAL STEEL AND PLATEWORK - GREY, INTERNATIONAL 71044
 PIPING - YELLOW, INTERNATIONAL 71039
 BUILDING EXTERIOR - QC 6067 SLATE BLUE

HATCH		Statut Dessin / Manuel Fournisseur	
Vendor Drawing / Manual Status			
1	☐ Fabrication autorisée - Dessin et/ou manuel final reçu Fabrication Authorised - Final Drawing and/or Manual Received		
2	☐ Fabrication autorisée - Soumettre dessin et/ou manuel final Fabrication Authorised - Submit Final Drawing and/or Manual		
3	☒ Fabrication autorisée conditionnelle à l'ajout des changements indiqués; Revoir et soumettre dessin et/ou manuel final Fabrication Authorised - Subject to incorporation of indicated changes; Revise and Submit Final Drawing and/or Manual		
4	☐ Fabrication non autorisée - Revoir et resoumettre Do Not Fabricate - Revise and Resubmit		
Par/By: <i>[Signature]</i> Date: 21/01/05			
La révision et l'autorisation de fabriquer portent seulement sur la conformité générale à la conception du projet et à l'information disponible dans les documents contractuels. Le fournisseur/entrepreneur demeure le seul responsable de la conformité du document aux exigences des plans et devis, y compris mais sans s'y limiter, aux dimensions et aux quantités. HATCH ne garantit aucune des informations contenues dans les présentes et n'autorise ni n'approuve aucun procédé de fabrication ou technique de construction ou toute mesure ou procédure de sécurité.			
Review and authorization to fabricate are only for general conformance with the design concept of the Project as expressed in the Contract Documents. Sole responsibility for the accuracy and completeness of this document, including but not limited to dimensions and quantities, remains with the Vendor/Contractor. HATCH does not warrant the accuracy or completeness of any of the information contained herein, nor does HATCH authorize or approve any construction means, methods, techniques, sequences or any safety precautions or procedures.			
HATCH N°/No. 316996-DF-PM503-008 R:			
CLIENT N°/No. R:			

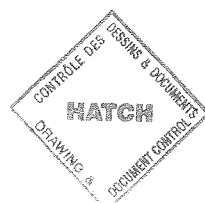

19 JAN 2005

DISPENSING MODULE - PLAN VIEW

PRELIMINARY
FOR APPROVAL
CHAMCO INDUSTRIES LTD.

THIS PRINT IS THE PROPERTY OF CHAMCO INDUSTRIES LTD., IS CONFIDENTIAL, IS LENT ONLY FOR REFERENCE IN EQUIPMENT MAINTENANCE OR IN DEALING WITH CHAMCO INDUSTRIES LTD. AND IS NOT TO BE COPIED OR REPRODUCED WITHOUT OUR EXPRESS WRITTEN PERMISSION			
REV.	DATE	BY	DESCRIPTION
CHAMCO INDUSTRIES LTD. VANCOUVER - CALGARY - EDMONTON - PRINCE GEORGE			

TAMERA DIAMOND CORPORATION		DESIGNED BY	
JERICHO DIAMOND PROJECT		D.J.C.	
C/O HATCH LTD.		DRAWN BY	
P.O. No. 316996-PM503		B.L.	
Tag No. 150 DM-002		CHECKED BY	
DISPENSING FUEL MODULE			
GENERAL ARRANGEMENT DRAWING		JOB No.	
		1010069ABS	
DATE	SCALE	DWG No.	REV.
DEC. 13, 2004	N.T.S.	CUP1010075-01-10F3	0