


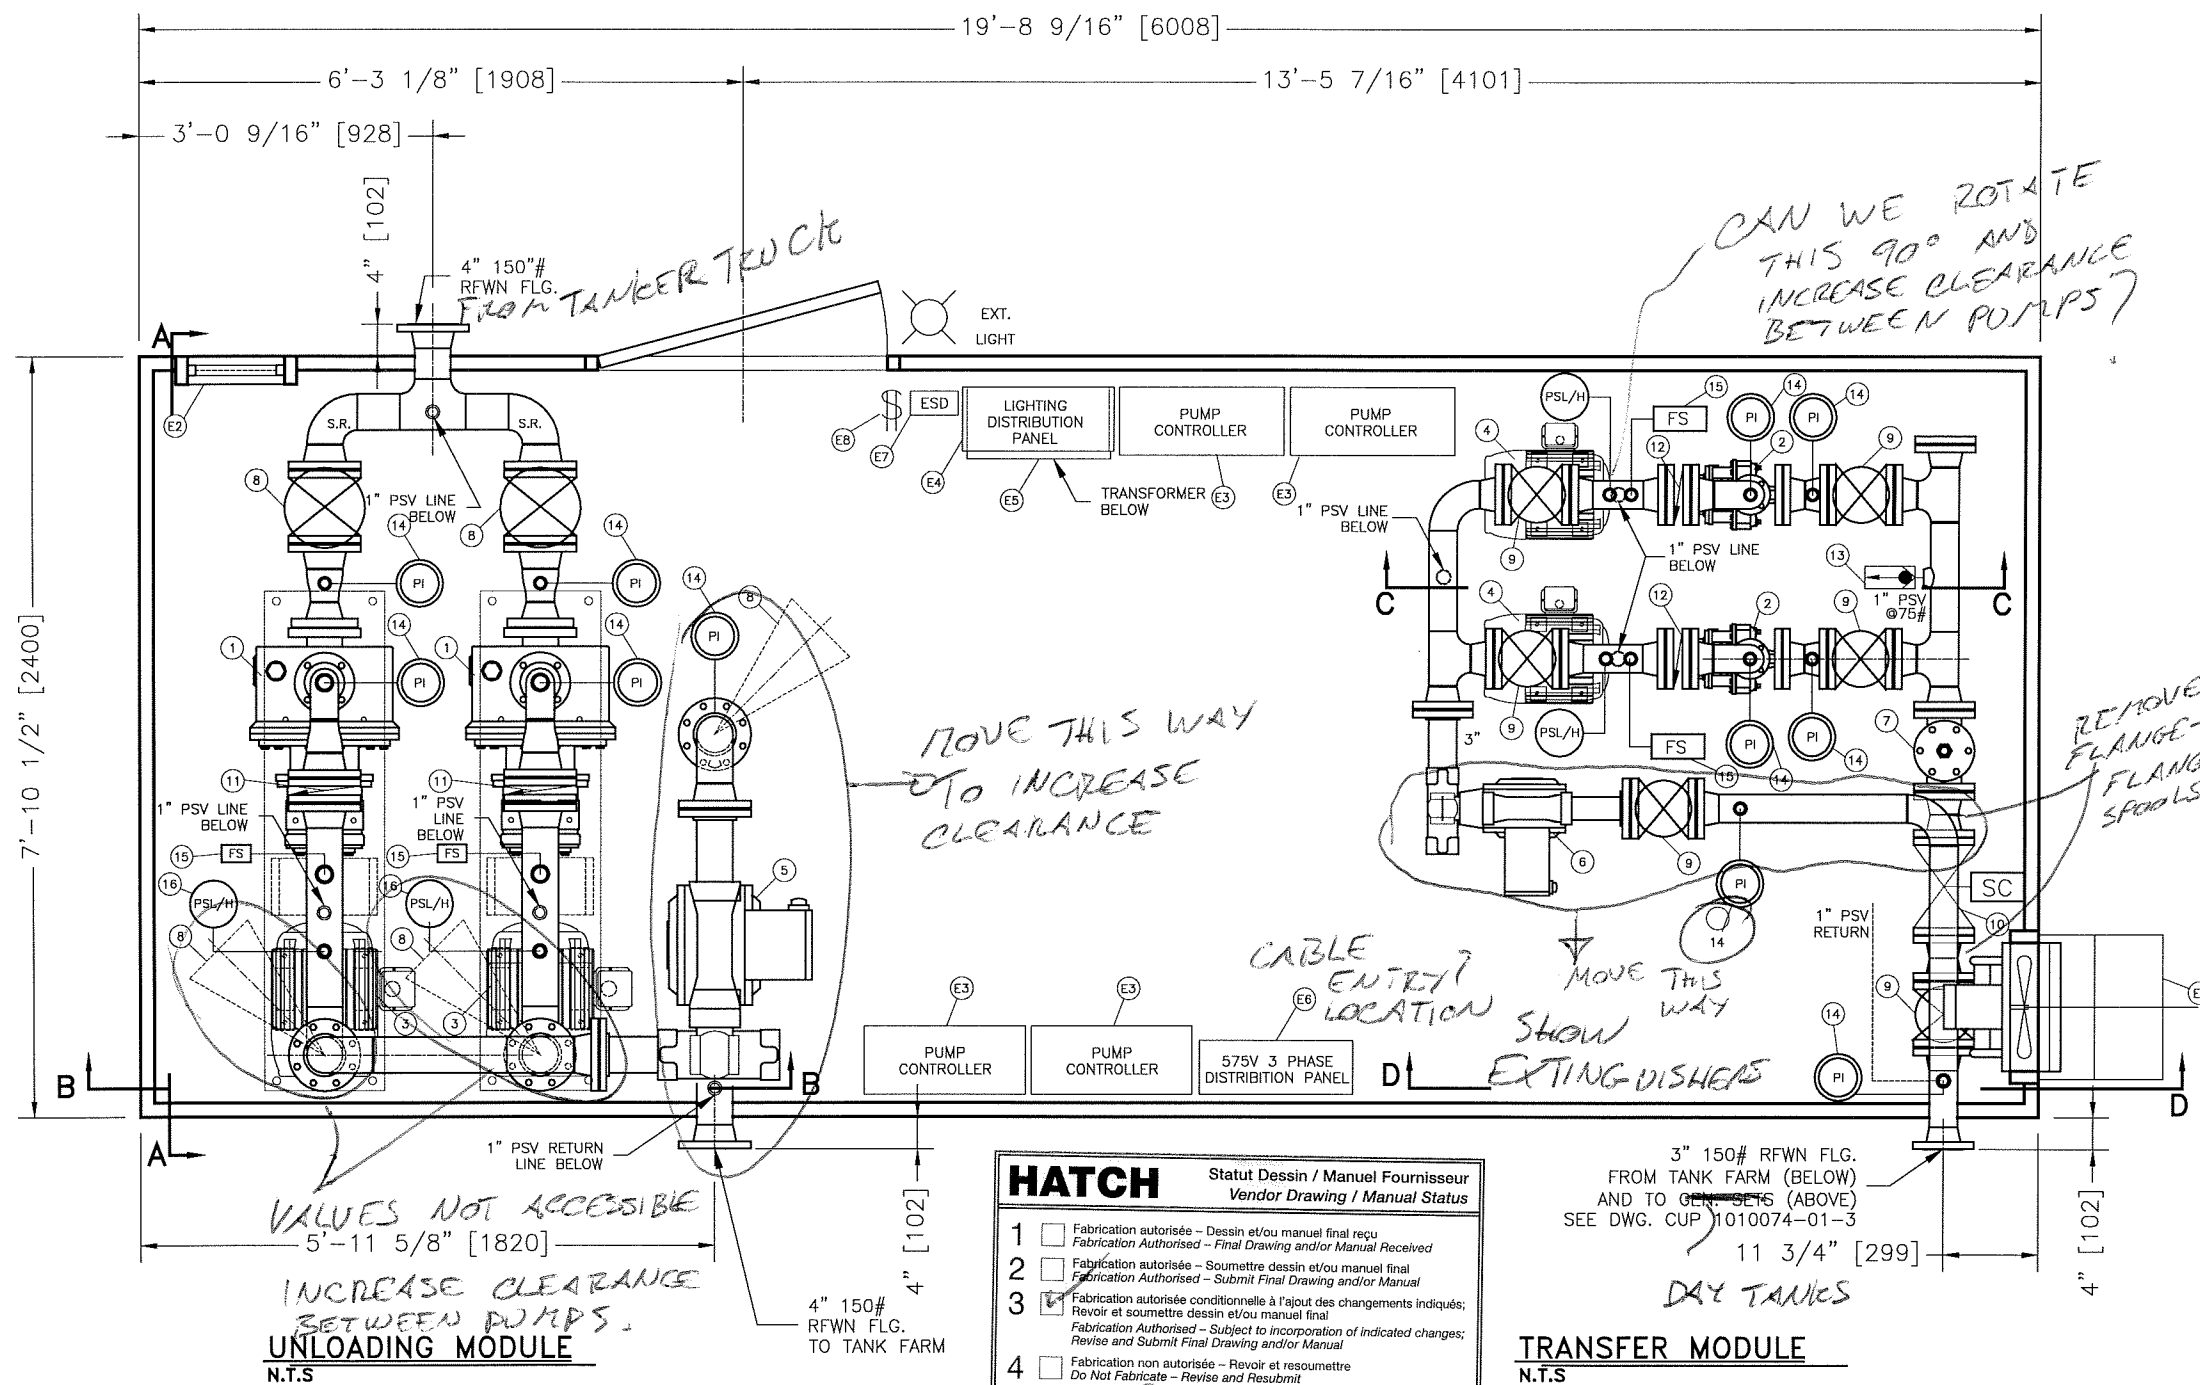

LEGEND	
①	PEERLESS - 3X3 - 13 MTP 8796 UNLOADING PUMP
②	PEERLESS - 1.5X3 - 6 STP 8196 TRANSFER PUMP
③	WEG ELECTRIC MOTOR (15HP, 1800RPM, 254T, 3/60/575V)
④	WEG ELECTRIC MOTOR (5HP, 3500RPM, 184T, 3/60/575V)
⑤	TCS 700-40 4" DISCHARGE STRAINER/AIR ELIMINATOR AND FLOW METER
⑥	TCS 700-30 3" DISCHARGE STRAINER/AIR ELIMINATOR AND FLOW METER
⑦	3" BASKET STRAINER
⑧	4" GATE VALVE
⑨	3" GATE VALVE
⑩	CLAVAL - 3" 120VAC SOLENOID FIRE SAFE VALVE
⑪	4" CHECK VALVE
⑫	3" CHECK VALVE
⑬	1" PSV SET AT 75 PSI
⑭	PRESSURE GAUGE
⑮	FLOW SWITCH
⑯	PRESSURE SWITCH HIGH/LO DISCHARGE PRESSURE ALARM
⑰	4" PIPE AND FITTINGS
⑱	3" PIPE AND FITTINGS
Ⓔ	EXHAUST FAN
Ⓕ	INTAKE LOUVRE
Ⓖ	PUMP CONTROLLER
Ⓖ	LIGHTING DISTRIBUTION PANEL
Ⓖ	TRANSFORMER
Ⓖ	575V 3-PHASE DISTRIBUTION PANEL
Ⓖ	EMERGENCY SHUT DOWN
Ⓖ	LIGHT SWITCH

EQUIPMENT WEIGHT	
TOTAL WEIGHT OF PACKAGE =	9600 LBS. [4358kg]


GENERAL NOTES:	
- ALL DIMENSIONS ARE + OR - 1/2" [13 mm]	

PAINT SPECIFICATIONS:	
STRUCTURAL STEEL AND PLATE WORK - GREY, INTERNATIONAL 71044	
PIPING - YELLOW, INTERNATIONAL 71039	
BUILDING EXTERIOR - QC 6067 SLATE BLUE	

HATCH		Statut Dessin / Manuel Fournisseur
		Vendor Drawing / Manual Status
1	☐	Fabrication autorisée - Dessin et/ou manuel final reçu Fabrication Authorised - Final Drawing and/or Manual Received
2	☐	Fabrication autorisée - Soumettre dessin et/ou manuel final Fabrication Authorised - Submit Final Drawing and/or Manual
3	☒	Fabrication autorisée conditionnelle à l'ajout des changements indiqués; Revoir et soumettre dessin et/ou manuel final Fabrication Authorised - Subject to incorporation of indicated changes; Revise and Submit Final Drawing and/or Manual
4	☐	Fabrication non autorisée - Revoir et resoumettre Do Not Fabricate - Revise and Resubmit
Par/By: <i>[Signature]</i> Date: 2/10/05		
La révision et l'autorisation de fabriquer portent seulement sur la conformité générale à la conception du projet et à l'information disponible dans les documents contractuels. Le fournisseur/entrepreneur demeure le seul responsable de la conformité du document aux exigences des plans et devis, y compris mais sans s'y limiter, aux dimensions et aux quantités. HATCH ne garantit aucune des informations contenues dans les présentes et n'autorise ni n'approuve aucun procédé de fabrication ou technique de construction ou toute mesure ou procédure de sécurité.		
Review and authorization to fabricate are only for general conformance with the design concept of the Project as expressed in the Contract Documents. Sole responsibility for the accuracy and completeness of this document, including but not limited to dimensions and quantities, remains with the Vendor/Contractor. HATCH does not warrant the accuracy or completeness of any of the information contained herein, nor does HATCH authorize or approve any construction methods, techniques, sequences or any safety precautions or procedures.		
HATCH N°/No. 316996-DE-PM503-003	DATE	BY
CLIENT N°/No. PRELIMINARY FOR APPROVAL	DESCRIPTION	
CHAMCO INDUSTRIES LTD.		

CHAMCO
CHAMCO INDUSTRIES LTD.
VANCOUVER - CALGARY - EDMONTON - PRINCE GEORGE

TAHERA DIAMOND CORPORATION		DESIGNED BY
JERICHO DIAMOND PROJECT		D.J.C.
C/O HATCH LTD		
P.O. No. 316996-PM503		DRAWN BY
		B.L.
Tag No. 150 DM-001		CHECKED BY
UNLOADING / TRANSFER FUEL MODULE		
GENERAL ARRANGEMENT DRAWING - PLAN VIEW		JOB No.
		1010069ABS
DATE	SCALE	DWG No.
DEC. 13, 2004	N.T.S.	CUP1010074-01-10F3
		REV. 0

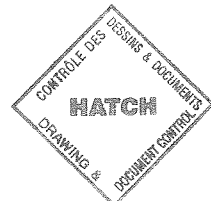

19 JAN 2005