


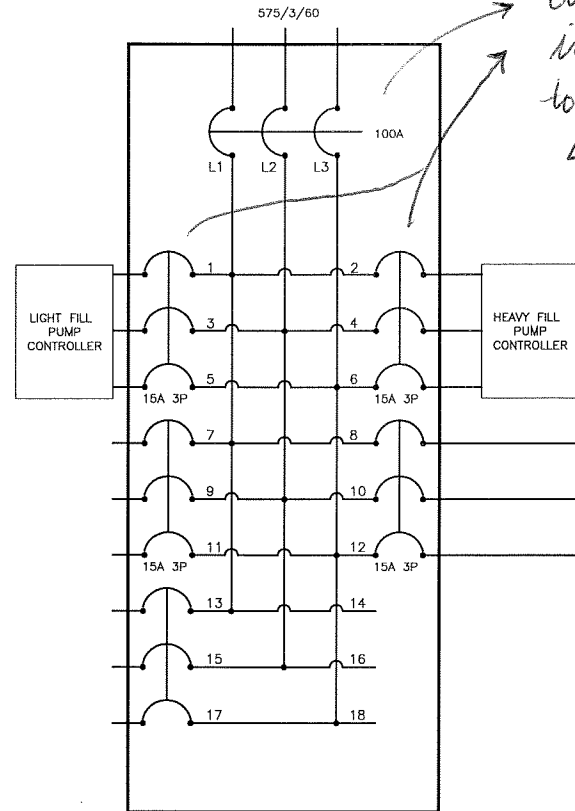


18 CIRCUIT 3Ø DISTRIBUTION PANEL


Circuit breaker
interrupting capacity
to be minimum
42 kA
at 600V

SAME COMMENTS AS
316996-DF-PM503-006


10 KVA THREE PHASE
575/ 208/120

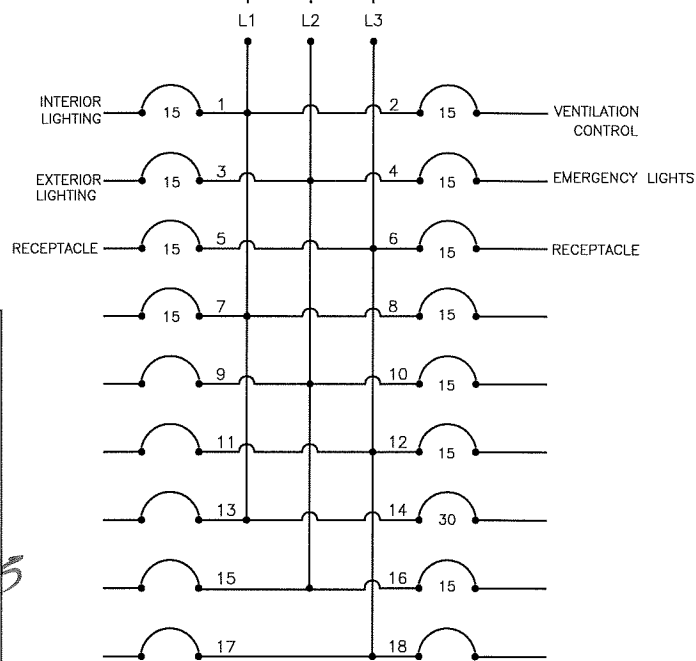


18 CIRCUIT DISTRIBUTION PANEL

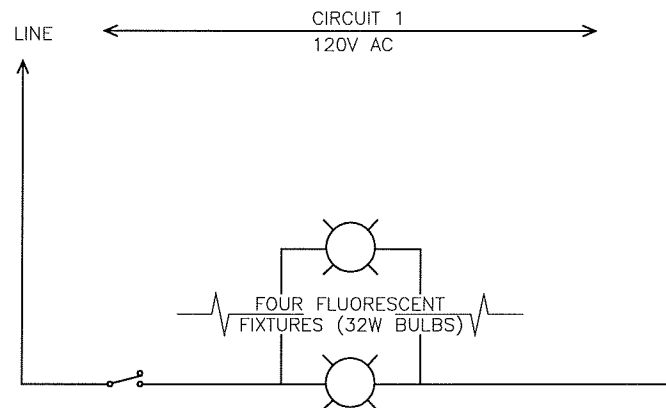


INTERIOR LIGHTING

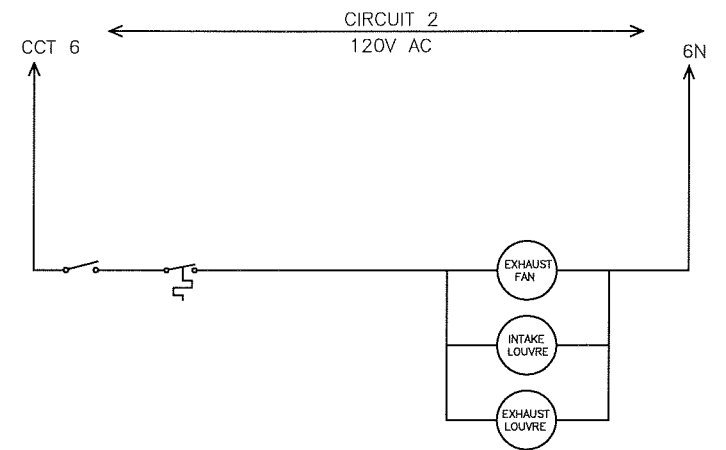

VENTILATION CONTROL

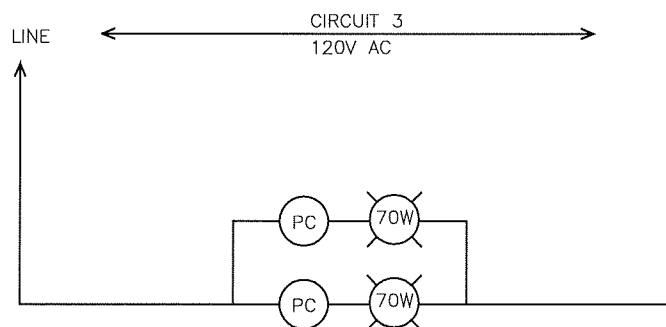


EXTERIOR LIGHTING

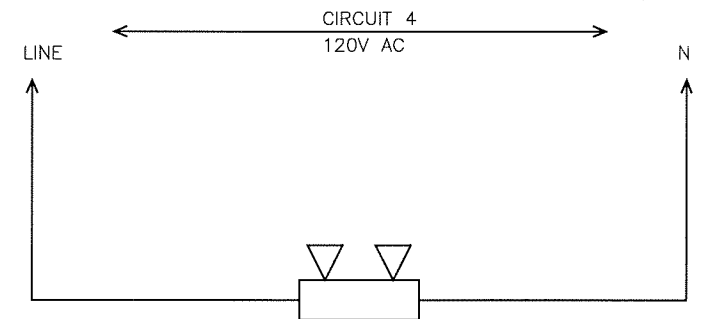

EMERGENCY LIGHTS

NOTES:
- EXIT LIGHTS, SELF POWERED.

PRELIMINARY
FOR APPROVAL
CHAMCO INDUSTRIES LTD.

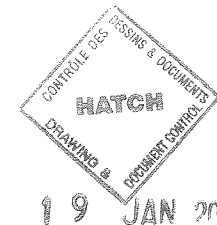

HATCH	
Statut Dessin / Manuel Fournisseur Vendor Drawing / Manual Status	
1	☐ Fabrication autorisée - Dessin et/ou manuel final reçu Fabrication Authorised - Final Drawing and/or Manual Received
2	☒ Fabrication autorisée - Soumettre dessin et/ou manuel final Fabrication Authorised - Submit Final Drawing and/or Manual
3	☐ Fabrication autorisée conditionnelle à l'ajout des changements indiqués; Revoir et soumettre dessin et/ou manuel final Fabrication Authorised - Subject to incorporation of indicated changes; Revise and Submit Final Drawing and/or Manual
4	☐ Fabrication non autorisée - Revoir et resoumettre Do Not Fabricate - Revise and Resubmit
Par/By: <i>[Signature]</i> Date: <i>Jan 25/05</i>	
La révision et l'autorisation de fabriquer portent seulement sur la conformité générale à la conception du projet et à l'information disponible dans les documents contractuels. Le fournisseur/entrepreneur demeure le seul responsable de la conformité du document aux exigences des plans et devis, y compris mais sans s'y limiter, aux dimensions et aux quantités. HATCH ne garantit aucune des informations contenues dans les présentes et n'autorise ni n'approuve aucun procédé de fabrication ou technique de construction ou toute mesure ou procédure de sécurité.	
Review and authorization to fabricate are only for general conformance with the design concept of the Project as expressed in the Contract Documents. Sole responsibility for the accuracy and completeness of this document, including but not limited to dimensions and quantities, remains with the Vendor/Contractor. HATCH does not warrant the accuracy or completeness of any of the information contained herein, nor does HATCH authorize or approve any construction means, methods, techniques, sequences or any safety precautions or procedures.	
HATCH N°/No. <i>316996-DF-PM503-011</i> R:	
CLIENT N°/No. R:	

REV. DATE BY DESCRIPTION		
THIS PRINT IS THE PROPERTY OF CHAMCO INDUSTRIES LTD., IS CONFIDENTIAL, IS LENT ONLY FOR REFERENCE IN EQUIPMENT MAINTENANCE OR IN DEALING WITH CHAMCO INDUSTRIES LTD. AND IS NOT TO BE COPIED OR REPRODUCED WITHOUT OUR EXPRESS WRITTEN PERMISSION		
CHAMCO CHAMCO INDUSTRIES LTD. VANCOUVER - CALGARY - EDMONTON - PRINCE GEORGE		
TAHERA DIAMOND CORPORATION JERICHO DIAMOND PROJECT C/O HATCH LTD P.O. No. 316996-PM503		
Tag No. 150 DM-002 DISPENSING FUEL MODULE		
ELECTRICAL WIRING DIAGRAM		
DATE DEC. 13, 2004	SCALE N.T.S.	DWG No. CUP1010075-03
DESIGNED BY D.J.C.		CHECKED BY B.L.
DRAWN BY B.L.		JOB No. 1010069ABS
REV. 0		