



NWB Tools

Richard Dwyer <richard.dwyer@nwb-oen.ca>

2AM-LUP1520 - Security Reduction - PRCU - LMI Providing Requested Additional Information

Karyn Lewis <k.lewis@mandalayresources.com>

Wed, Dec 12, 2018 at 5:35 PM

To: Richard Dwyer <richard.dwyer@nwb-oen.ca>, Karén Kharatyan <karen.kharatyan@nwb-oen.ca>, Assol Kubeisinova <assol.kubeisinova@nwb-oen.ca>, "licensing@nwb-oen.ca" <licensing@nwb-oen.ca>, "Parsons, Ian (AADNC/AANDC)" <ian.parsons@canada.ca>, Belinda Labatte <b.labatte@mandalayresources.com>, "Wiatzka, Gerd" <Gerd.Wiatzka@arcadis.com>, "Charles.Gravelle@arcadis.com" <Charles.Gravelle@arcadis.com>
Cc: Christine Kowbel <ckowbel@lawsonlundell.com>, David Hohnstein <david.hohnstein@shaw.ca>

Hi Everyone,

As per our discussion yesterday, LMI was requested to provide the following additional information in regards to the 2AM-LUP1520 Security Reduction Request and the Progressive Reclamation Cost Update:

1) LMI to send a map showing the tailings line removed to date (Response 2 from Golder PRCU Chapter 3.4, Item 4, first bullet)

Please find attached a map showing the tailings pipe that has been removed to date (line shown in red). Using the scale on the map you will be able to see that approx. 4,400m has been removed to date with the remaining being removed in 2019.

2) LMI to send the NWB ftp link to the 2018 Geotechnical Inspection Report which confirms the installation of instrumentation (Response 2 from Golder PRCU Chapter 3.4, Item 4, fourth bullet).

[ftp://ftp.nwb-oen.ca/registry/2%20MINING%20MILLING/2A/2AM%20-%20Mining/2AM-LUP1520%20LMI/3%20TECH/4%20WASTE%20DISP%20\(D\)%20\(E\)/E%206%20Annual%20Geotechnical%20Inspection/2018/181210%20AM-LUP1520%202018%20LMI%20TCA%20Geotech%20Inspection_Rev1_FINAL-IMLE.pdf](ftp://ftp.nwb-oen.ca/registry/2%20MINING%20MILLING/2A/2AM%20-%20Mining/2AM-LUP1520%20LMI/3%20TECH/4%20WASTE%20DISP%20(D)%20(E)/E%206%20Annual%20Geotechnical%20Inspection/2018/181210%20AM-LUP1520%202018%20LMI%20TCA%20Geotech%20Inspection_Rev1_FINAL-IMLE.pdf)


In providing the above items LMI has now addressed all of CIRNAC's outstanding issues.

LMI will be providing their speaking notes (Agenda Item C - Karyn and Belinda's speaking notes) and a final response prior to 3pmMT on Friday, December 14, 2018.

Karyn Lewis



2AM-LUP1520 - LUPIN MINE PIPING STATUS (1).pdf
1765K

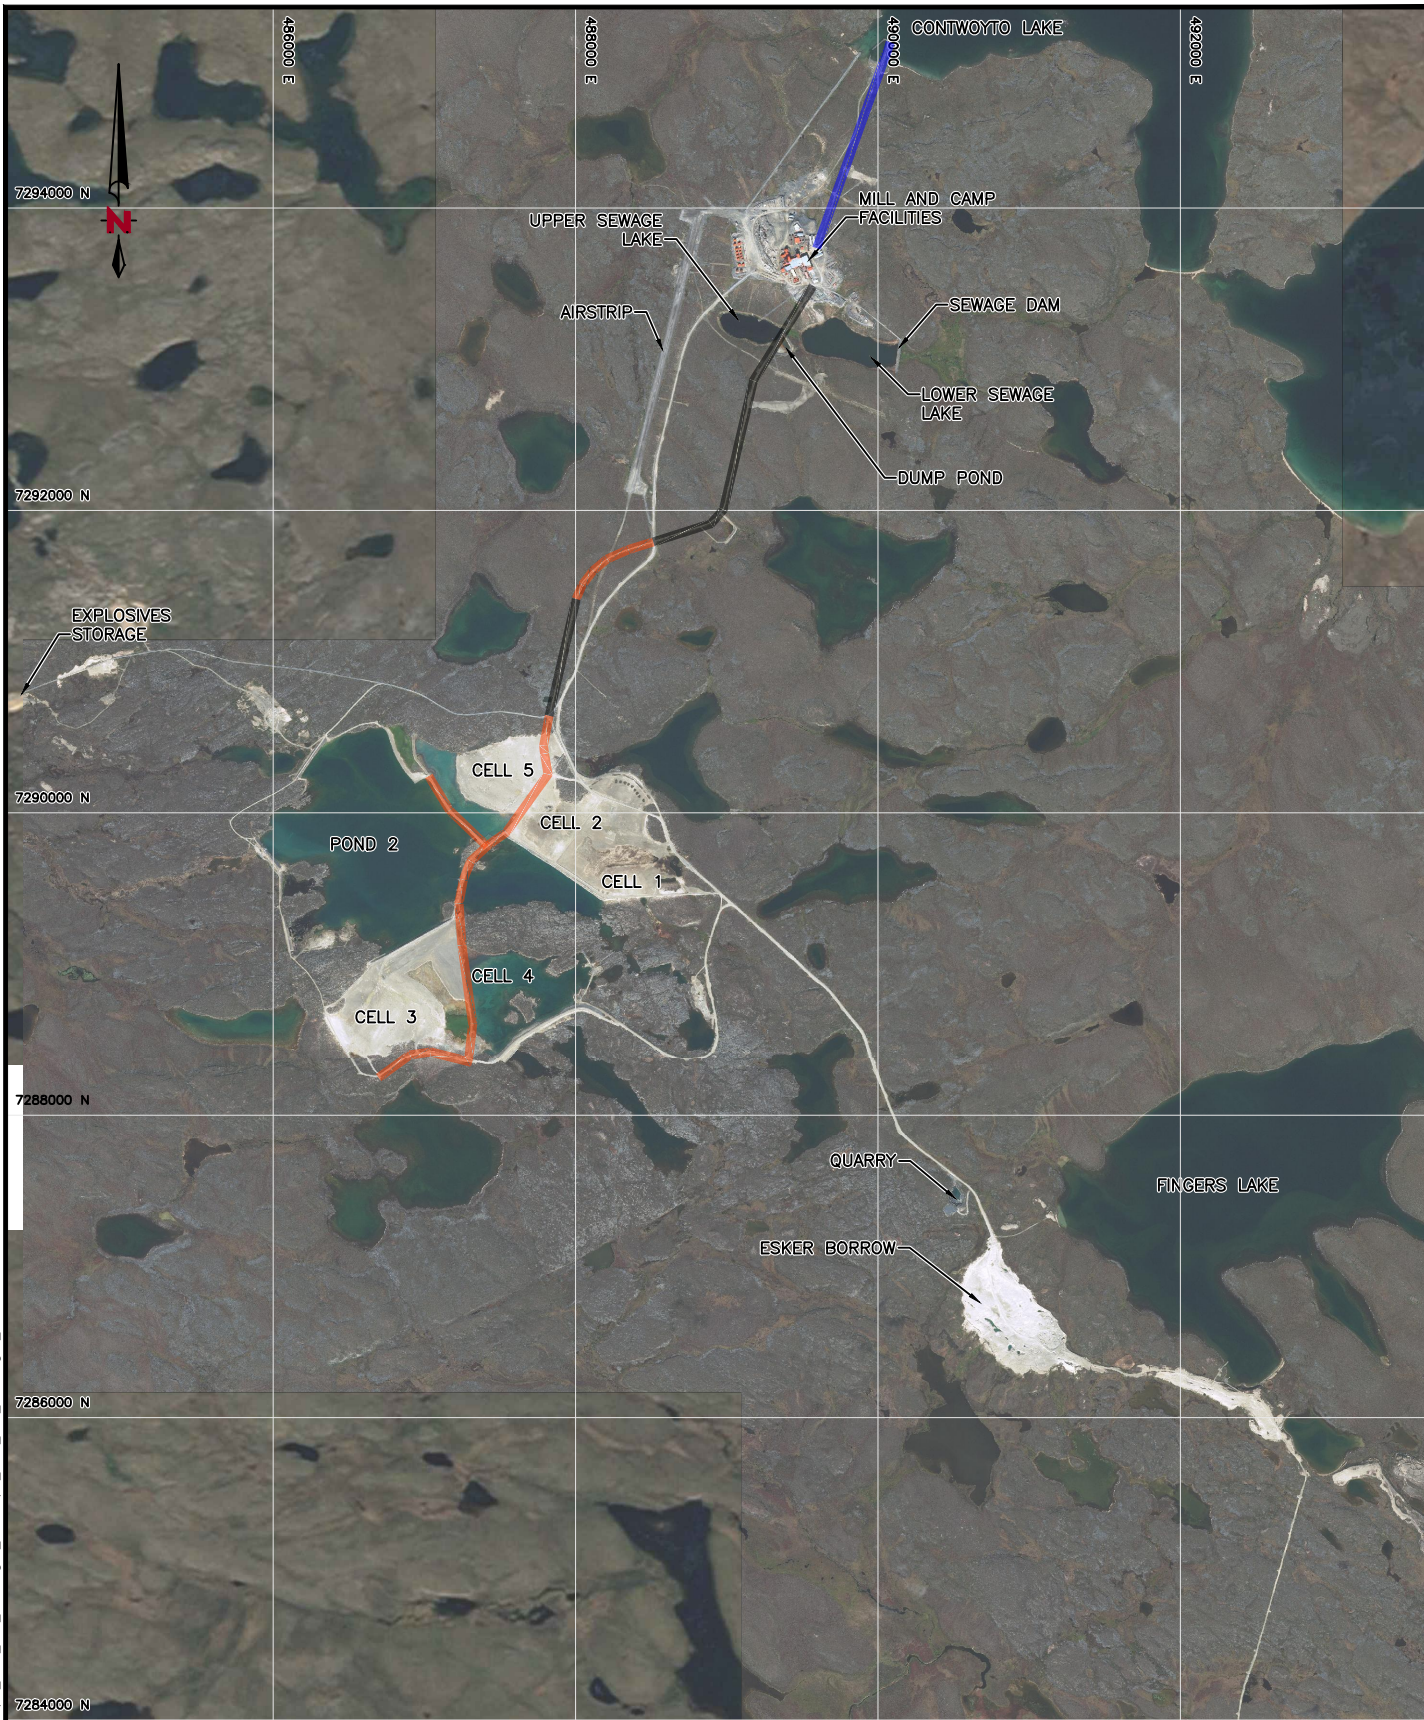


LEGEND

- TAILINGS PIPING REMOVED
- TAILINGS PIPING REMAINING
- WATER PIPING REMAINING

NOTE

1. THE TAILINGS AND WATER PIPELINE ALIGNMENT ARE APPROXIMATE. THE REMOVED SECTIONS OF THE TAILINGS PIPELINE ARE PROVIDED BY LMI FIELD REPRESENTATIVE.

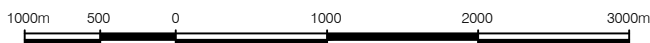

SCALE 1:50,000

SCALES INDICATED BASED ON AN 8.5"x11" PLOT CONFIGURATION

A		2018-12-12				ISSUED AS MEMO				KM	--	AT	SW
REV.	DATE	DESCRIPTION				DWN	DSG	CHK	APR				
LUPIN MINES INC.													
2018 REMEDIATION WORK													
SCALE:		AS SHOWN		SITE OVERVIEW PIPING STATUS									
DATE:		2018-12-12											
CO-ORD. SYS.:		UTM-NAD83-12											
DRWN BY:		KM											
DSGN BY:		--											
REV'D BY:		AT		 Stantec		PROJECT NO.:		FIG. NO.:		REV.:			
APP'D BY:		SW				129500081		1		A			