


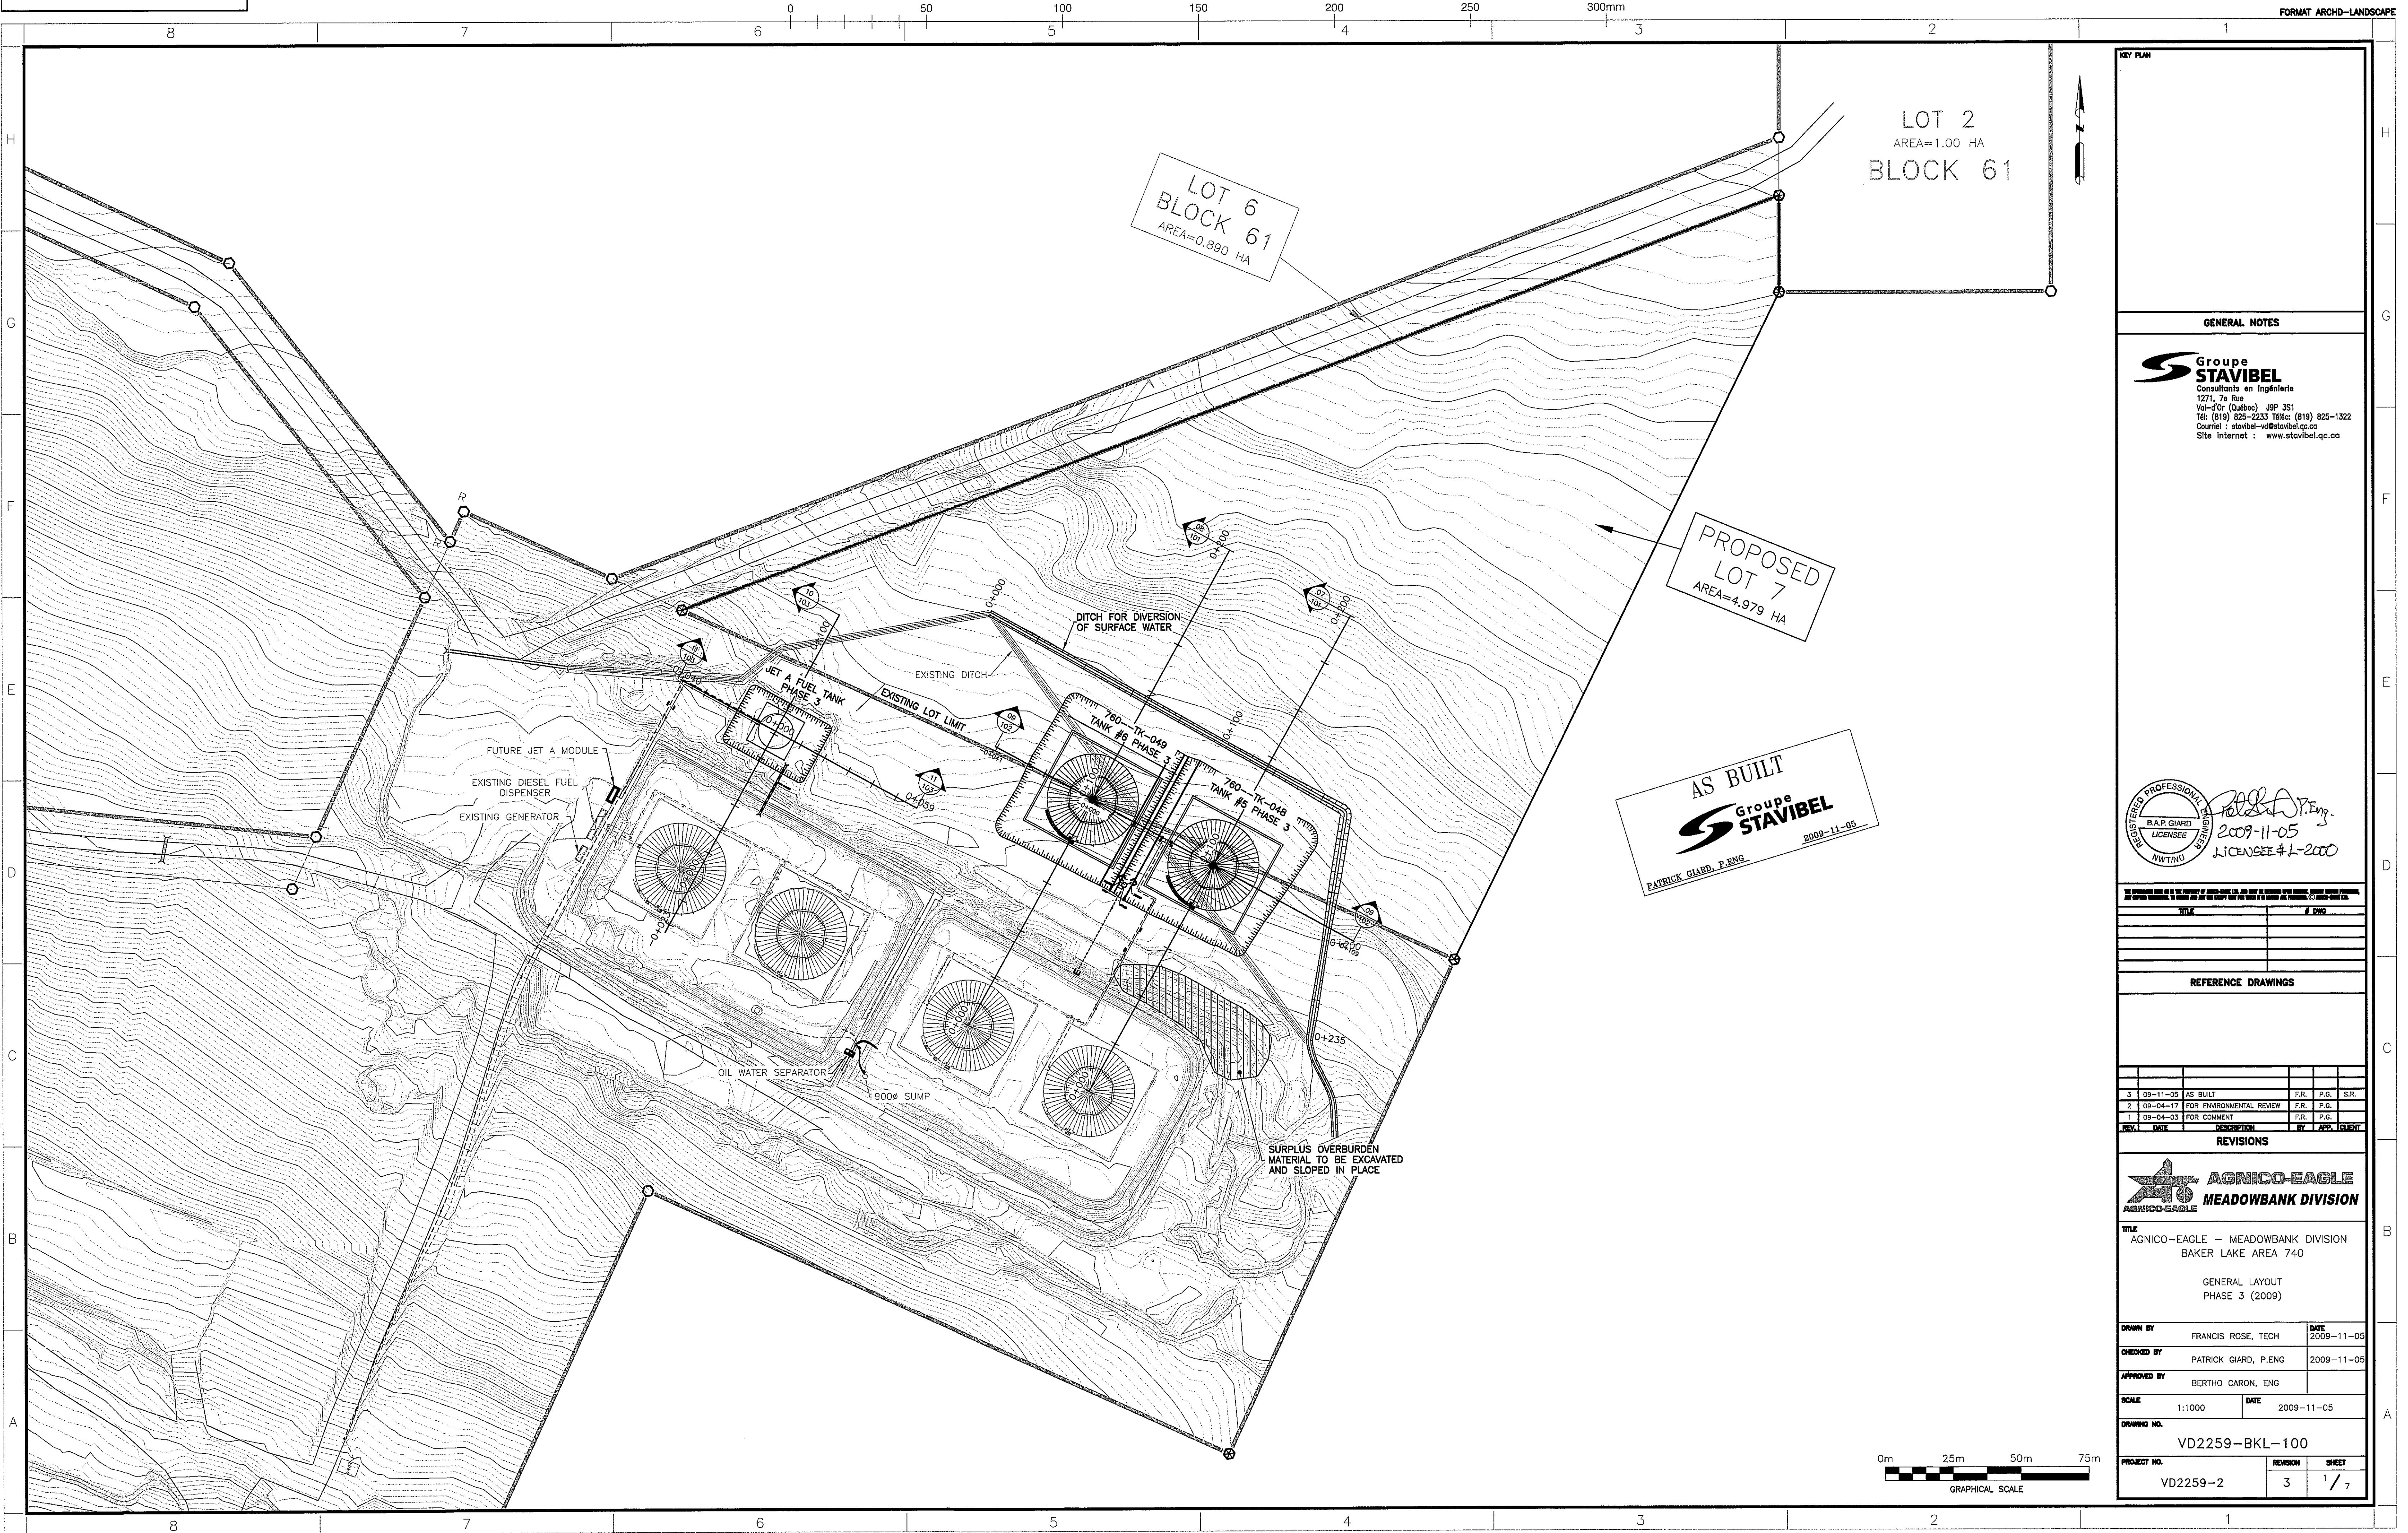

KEY PLAN

GENERAL NOTES
Groupe STAVIBEL
Consultants en Ingénierie
1271, 7e Rue
Val-d'Or (Québec) J9P 3S1
Tél: (819) 825-2233 Téléc: (819) 825-1322
Courriel : stavibel-vo@stavibel.qc.ca
Site Internet : www.stavibel.qc.ca

B.A.P. GIARD, P.Eng.
2009-11-05
LICENSEE #1-2000

TITLE		#

REFERENCE DRAWINGS

REV.	DATE	DESCRIPTION	BY	APP.	CLIENT
3	09-11-05	AS BUILT	F.R.	P.G.	S.R.
2	08-04-17	FOR ENVIRONMENTAL REVIEW	F.R.	P.G.	
1	08-04-03	FOR COMMENT	F.R.	P.G.	

REVISIONS

AGNICO-EAGLE
MEADOWBANK DIVISION

TITLE
AGNICO-EAGLE — MEADOWBANK DIVISION
BAKER LAKE AREA 740

GENERAL LAYOUT
PHASE 3 (2009)

DRAWN BY	DATE
FRANCIS ROSE, TECH	2009-11-05





CHECKED BY	DATE
PATRICK GIARD, P.ENG	2009-11-05

APPROVED BY	DATE
BERTHO CARON, ENG	

SCALE	DATE
1:1000	2009-11-05

DRAWING NO.
VD2259-BKL-100

PROJECT NO.	REVISION	SHEET
VD2259-2	3	1 / 7

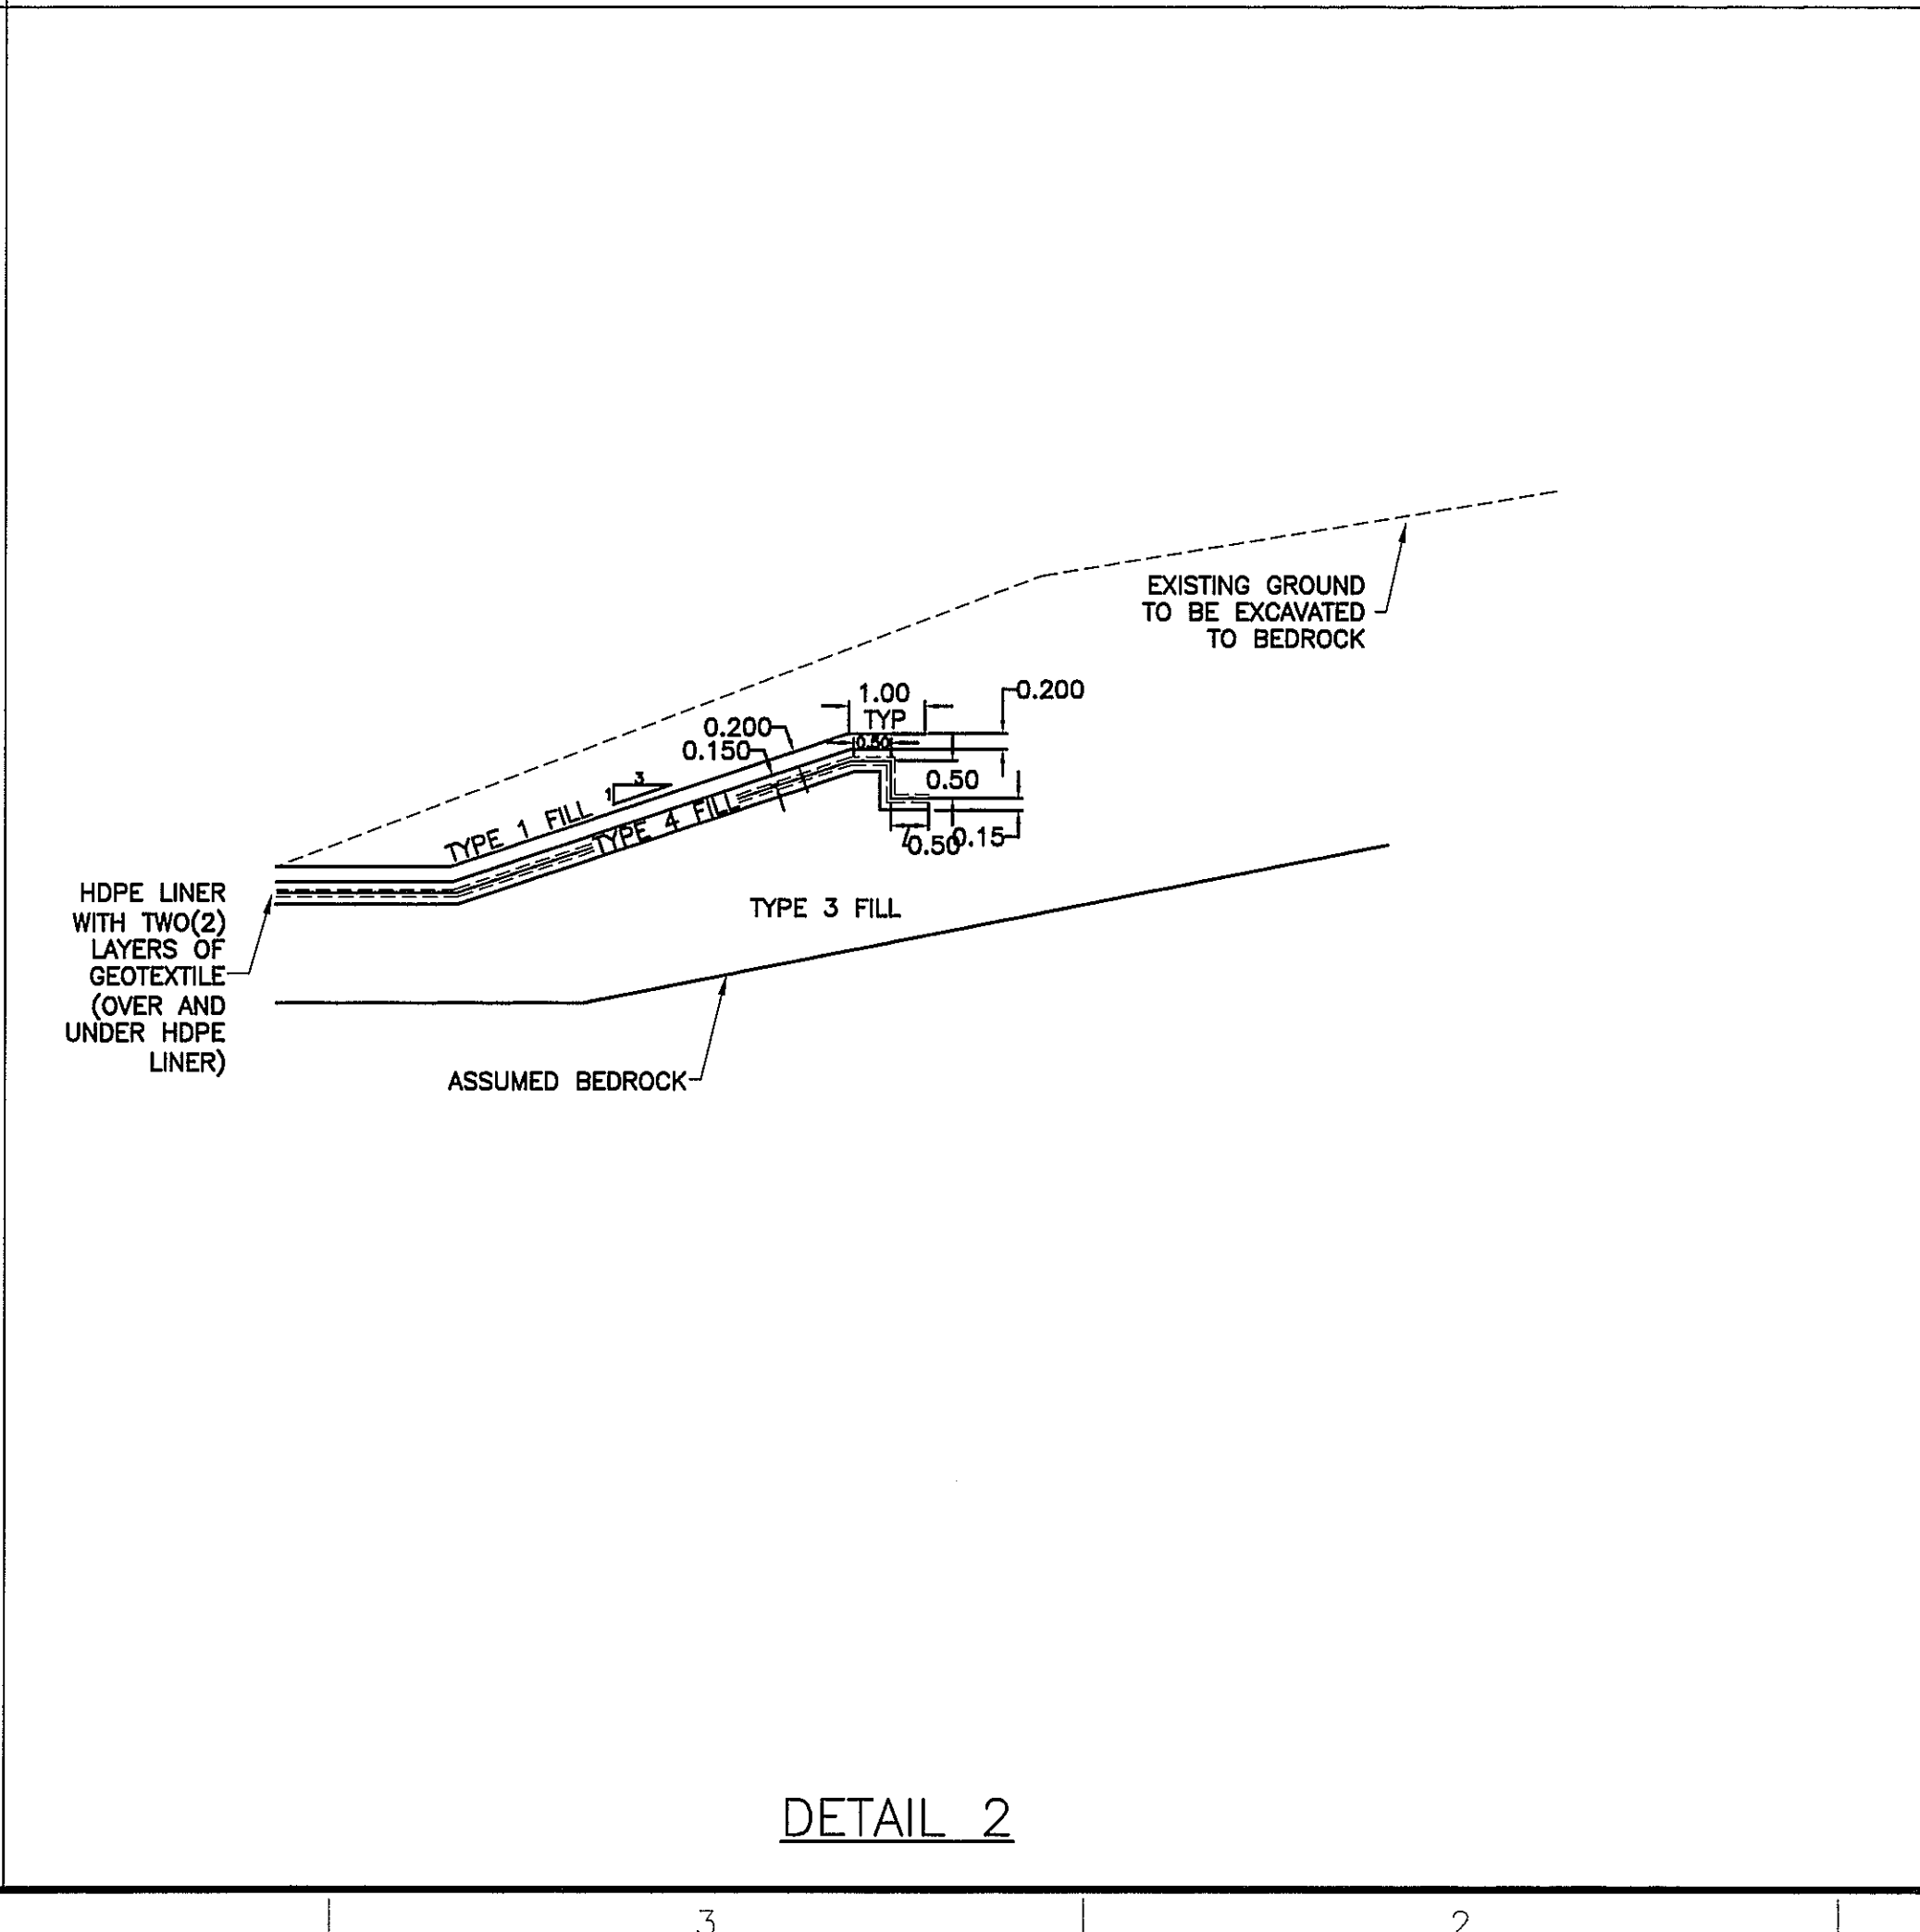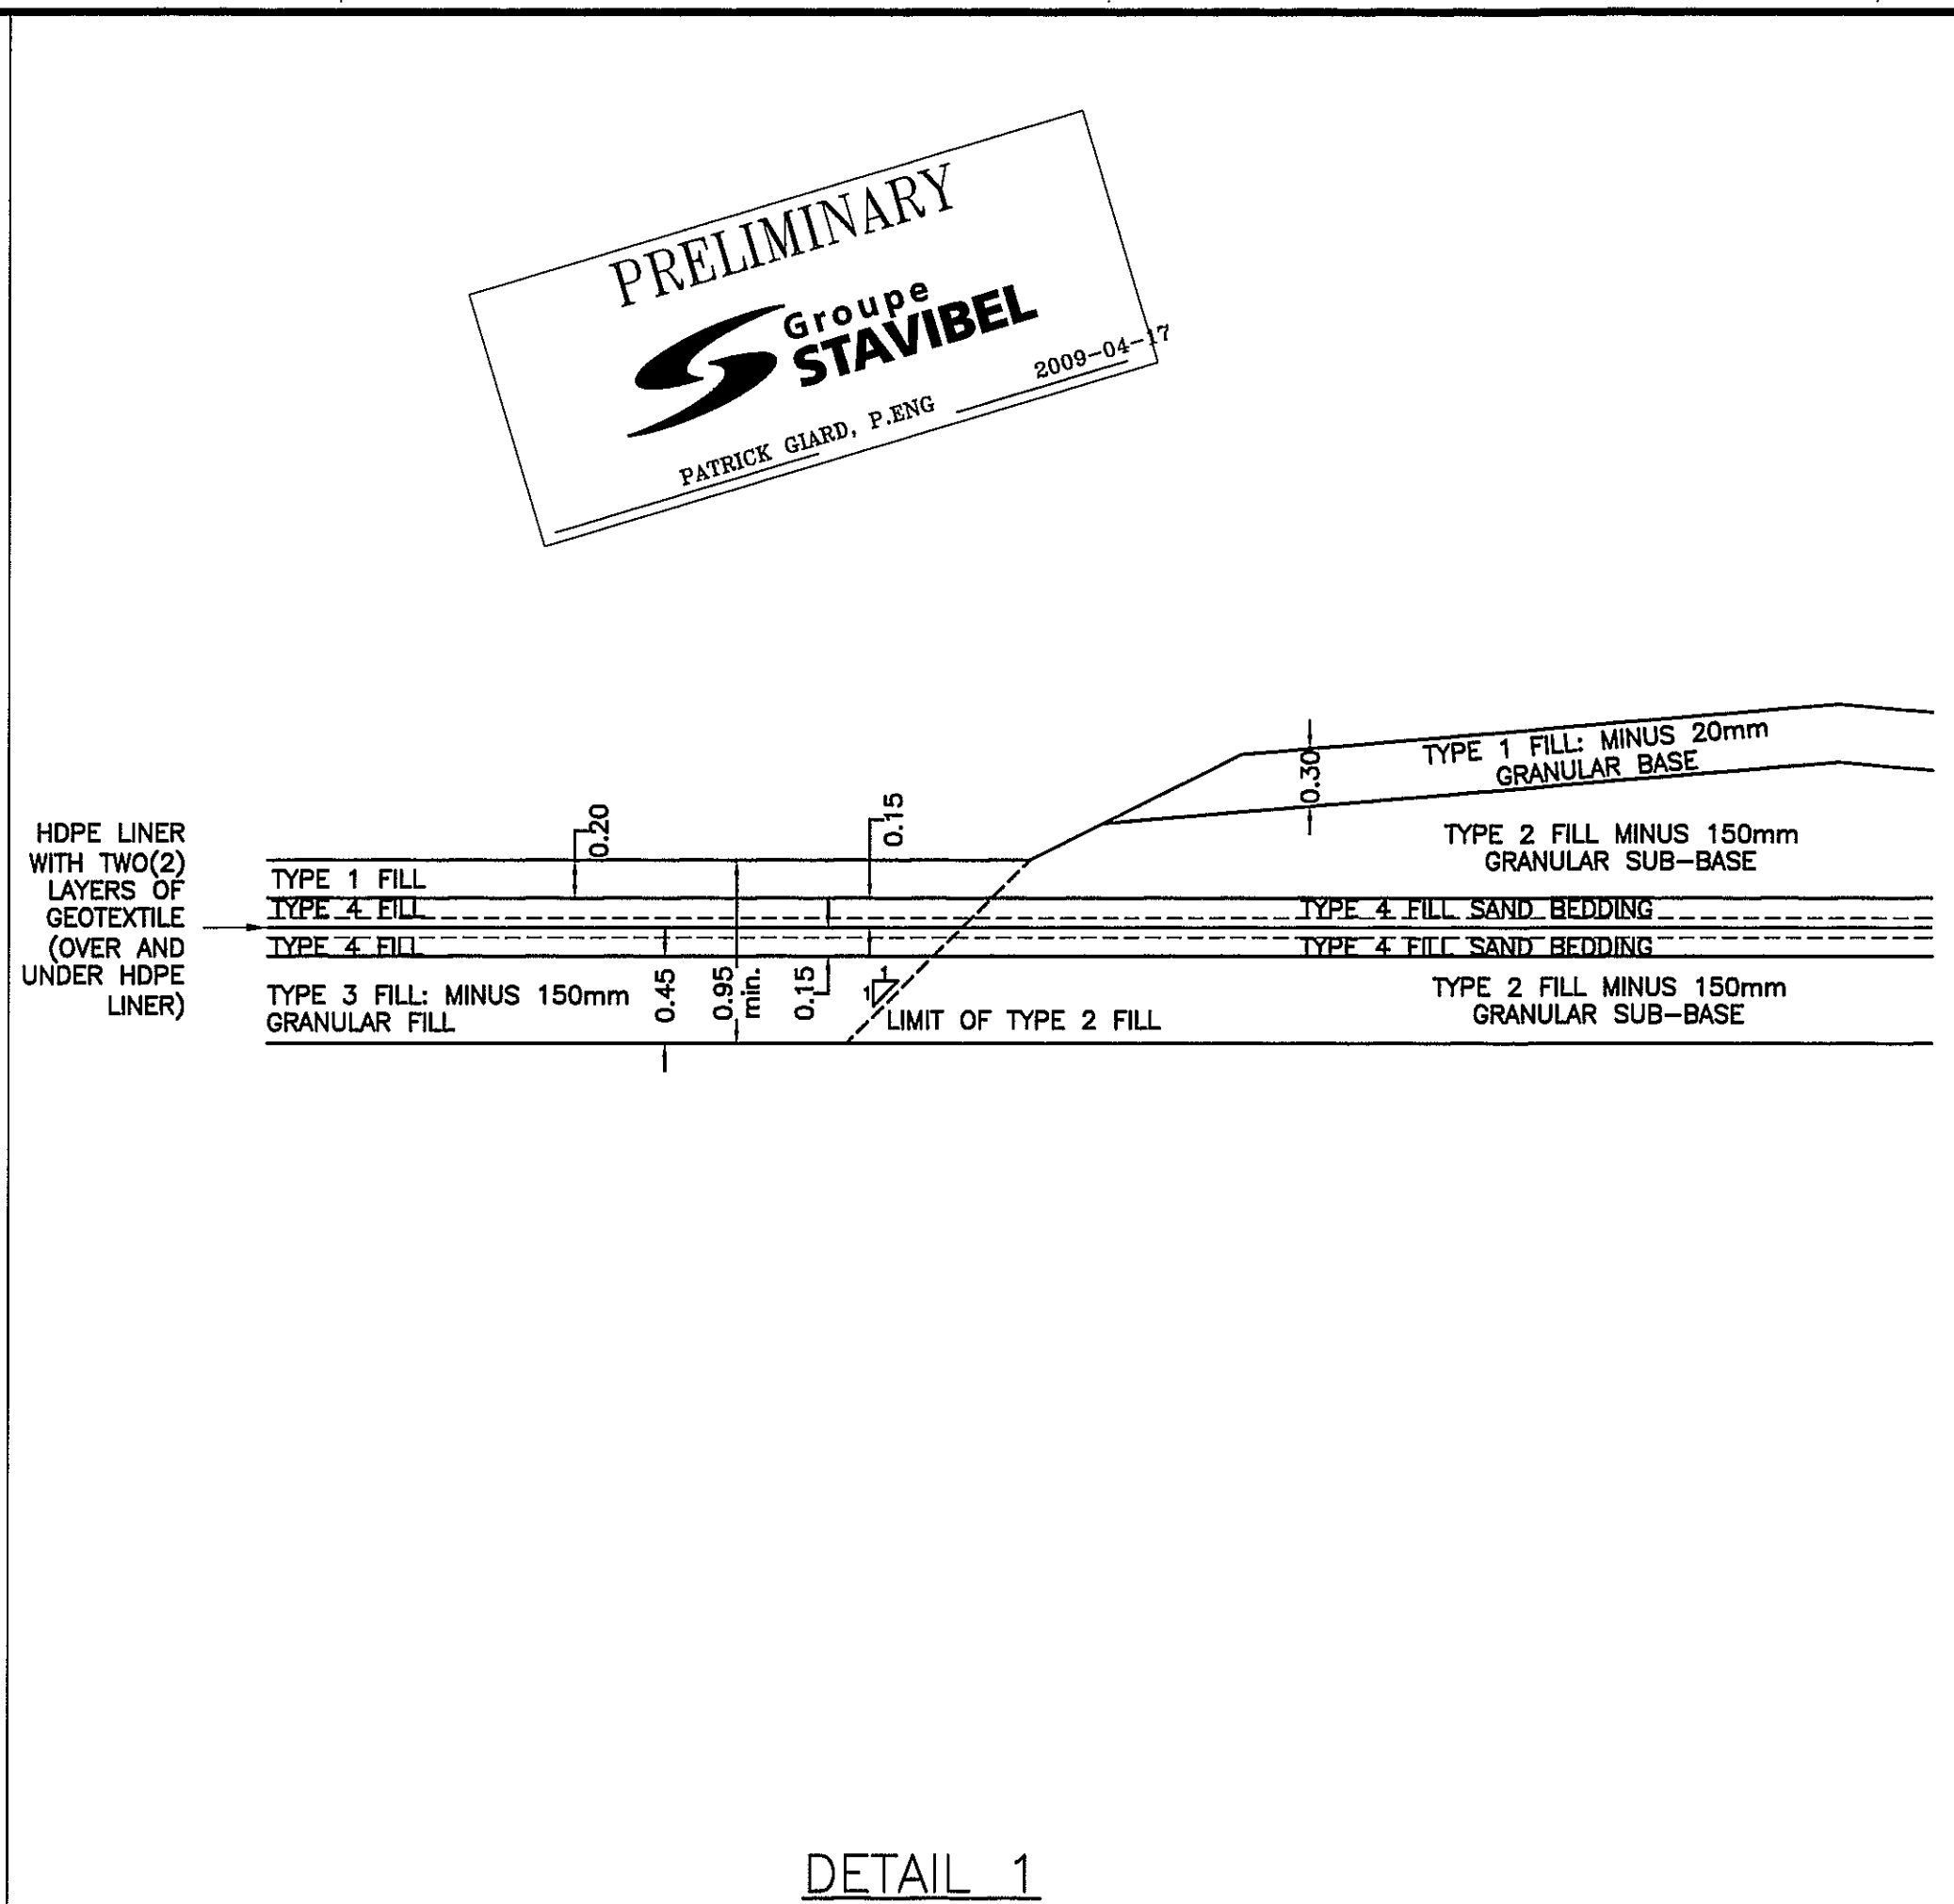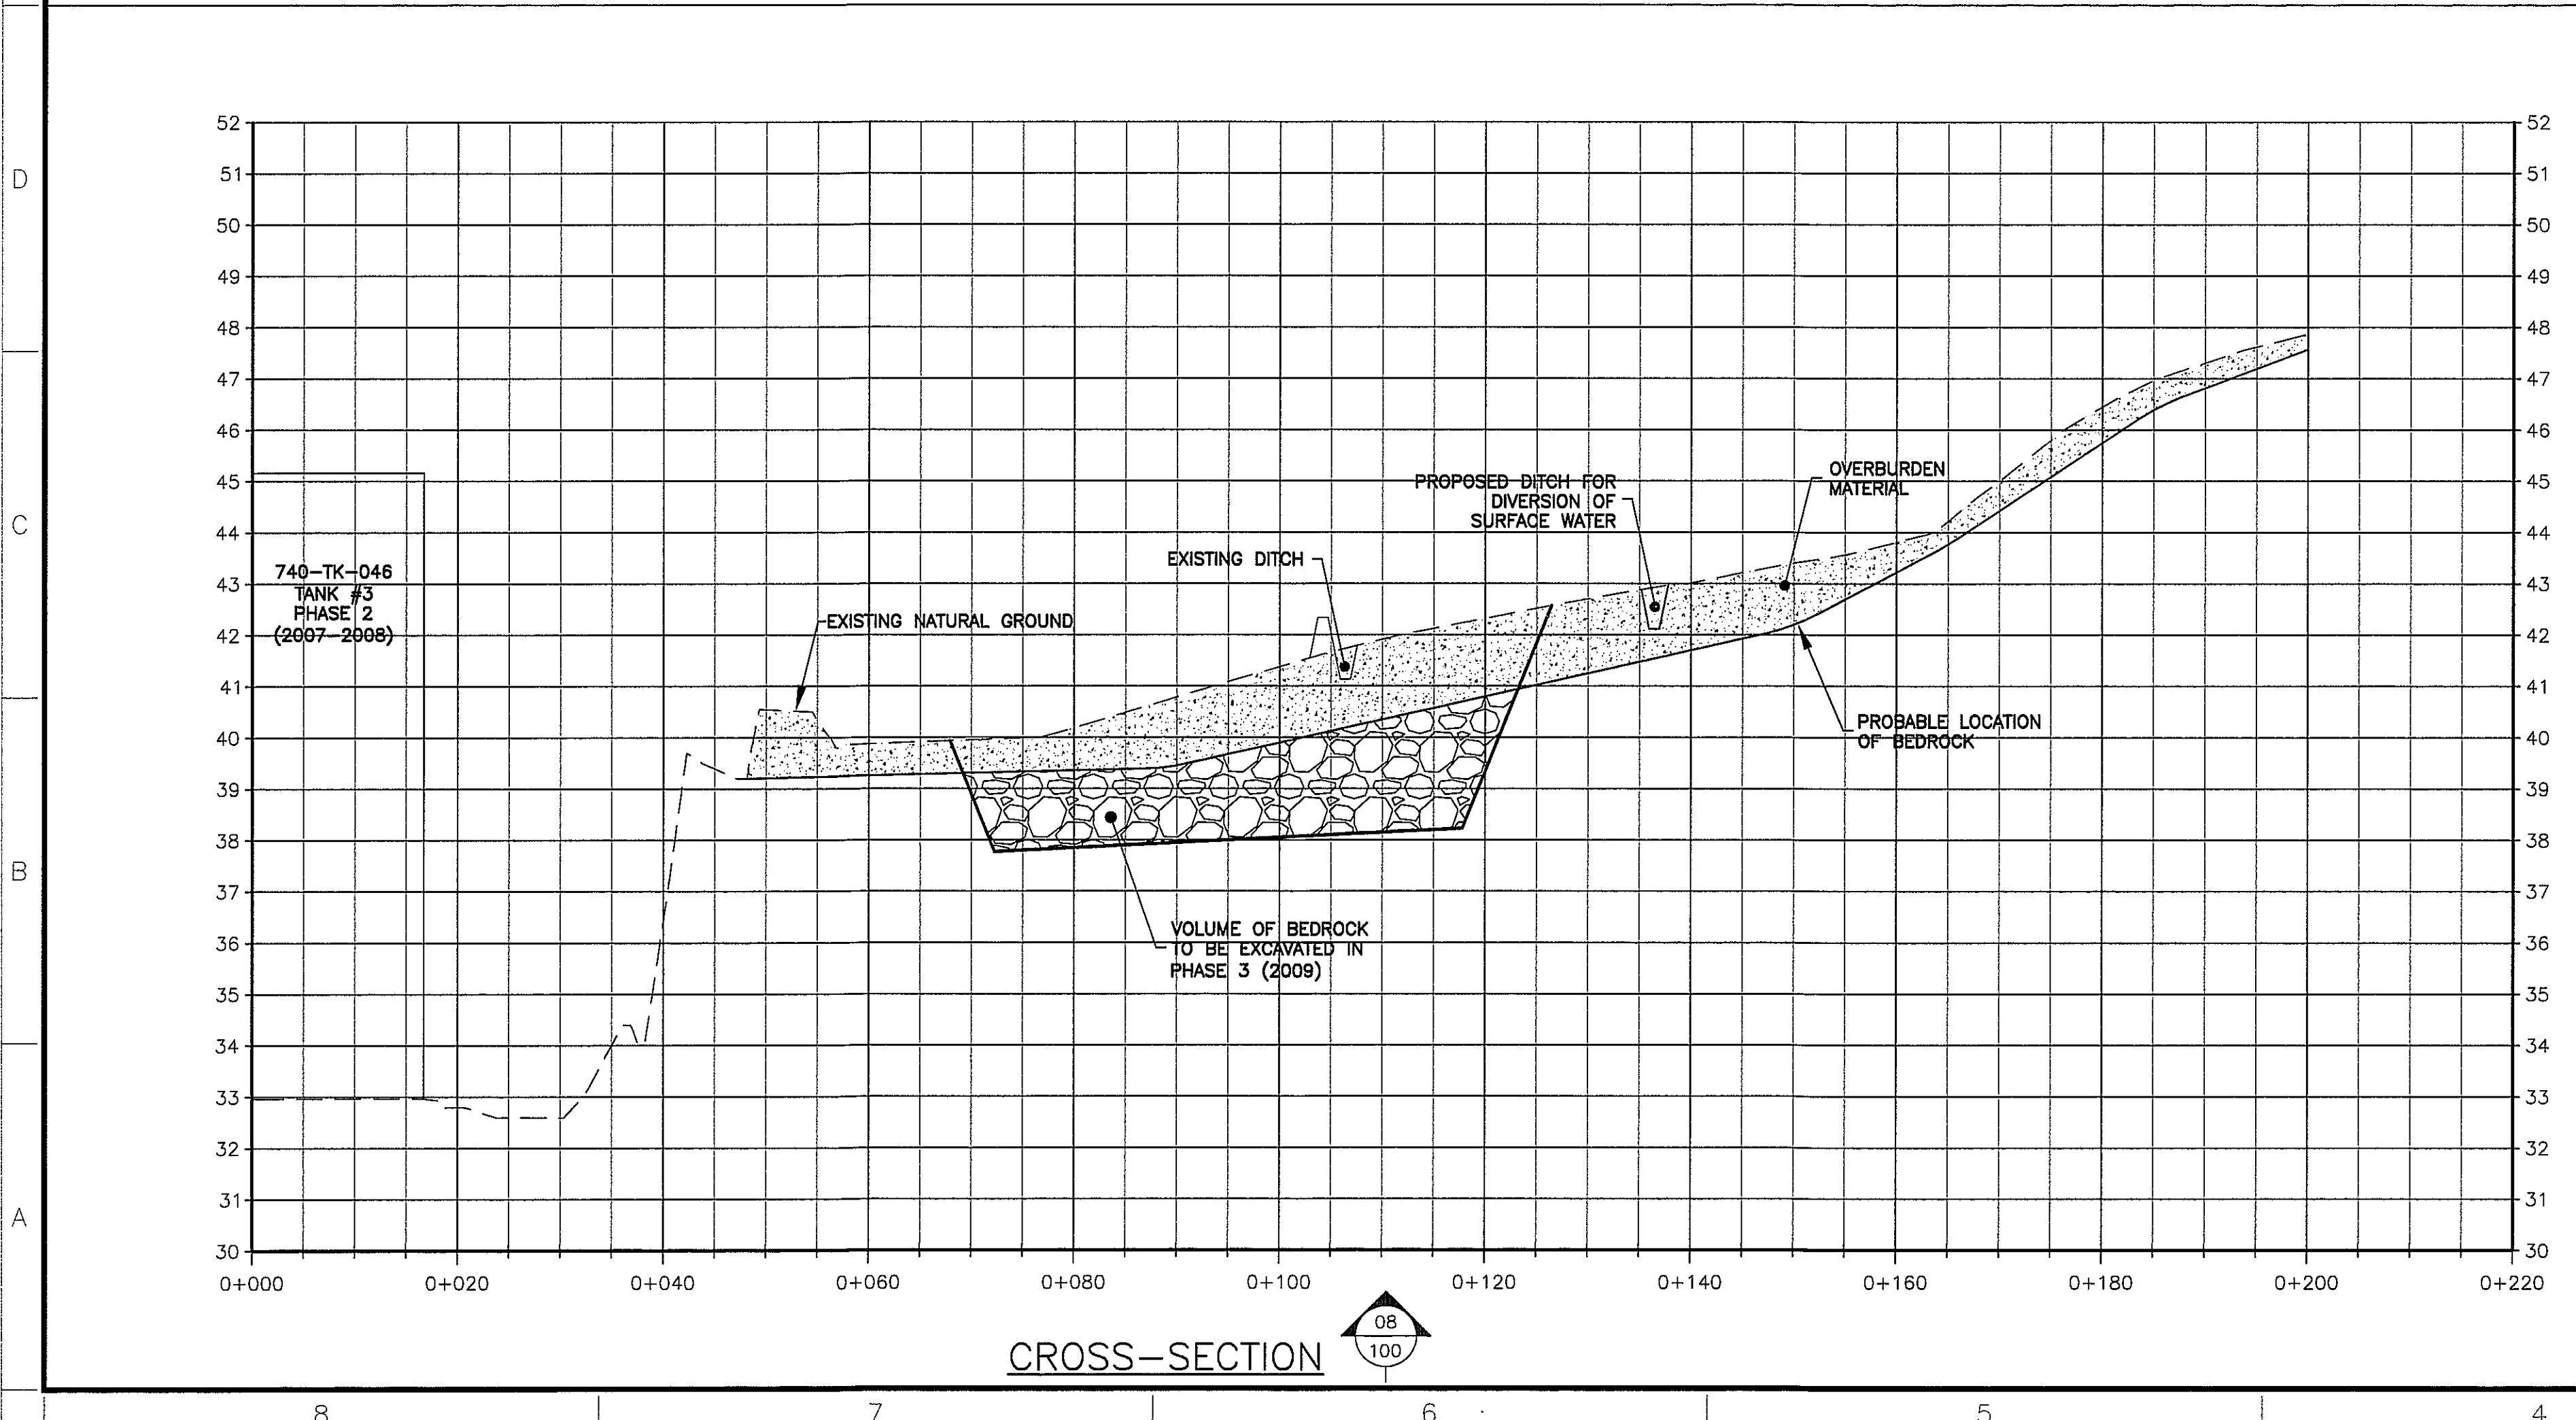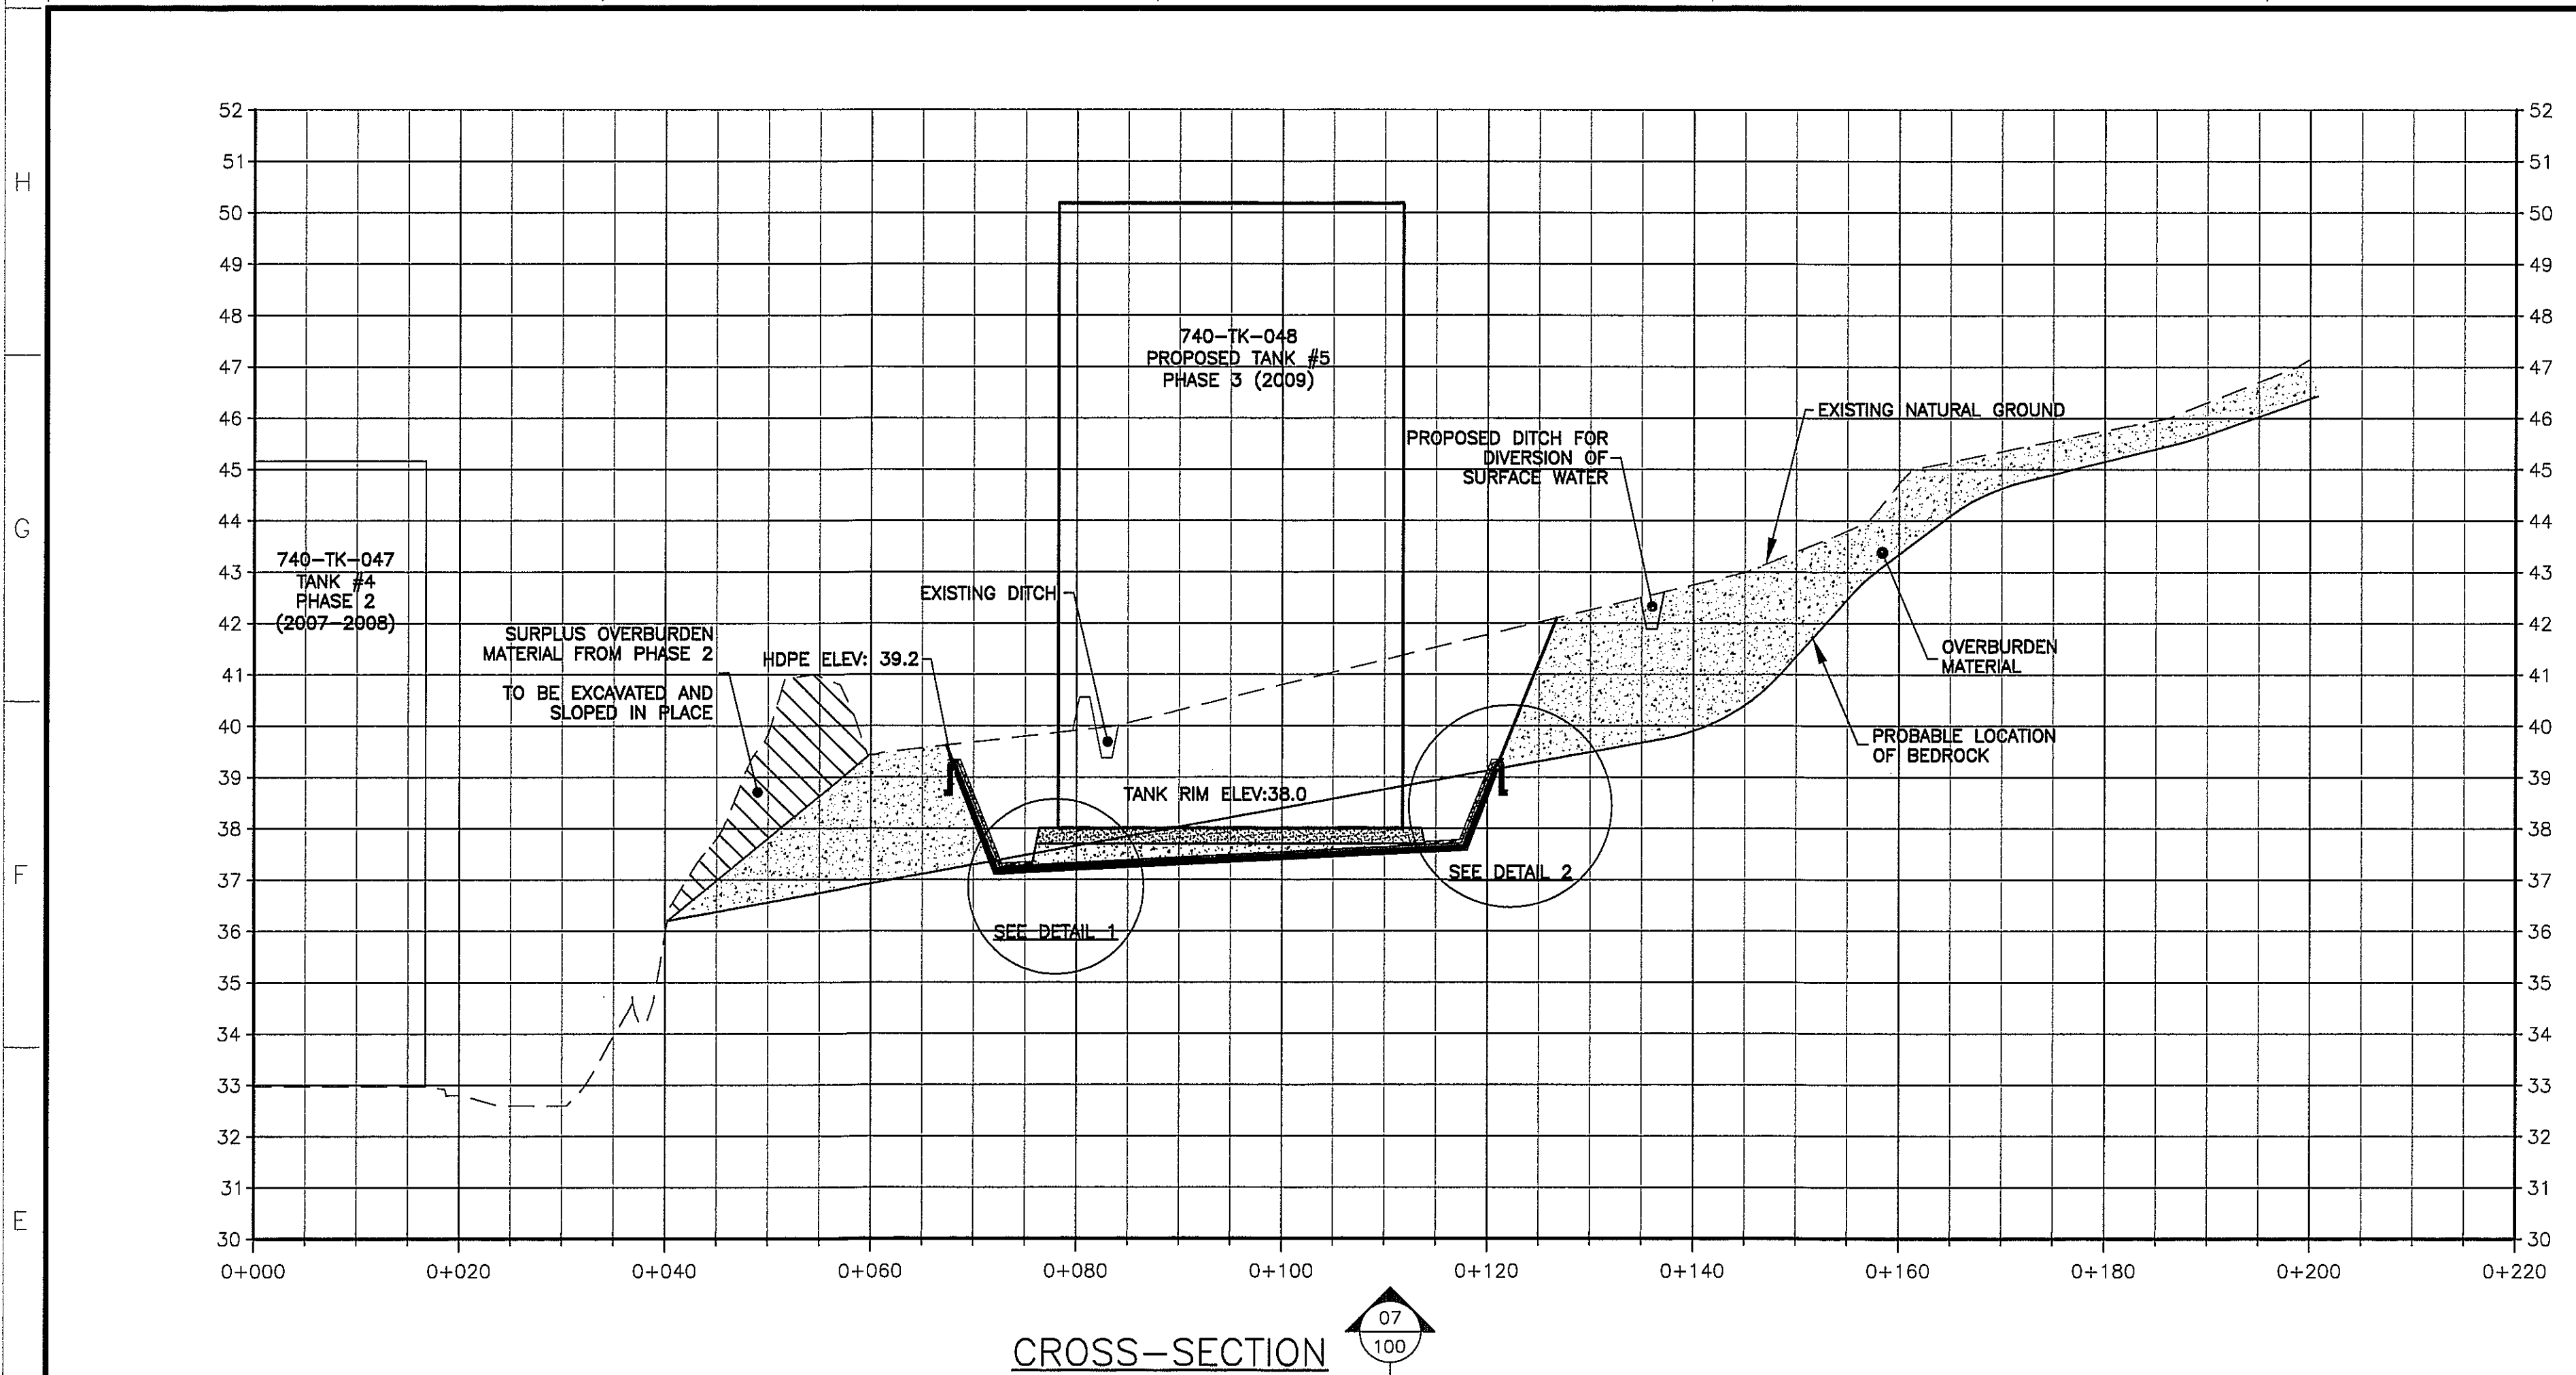

KEY PLAN

GENERAL NOTES

Groupe STAVIBEL
Consultants en Ingénierie
1271, 7e Rue
Val-d'Or (Québec) J9P 3S1
Tél: (819) 825-2233 Téléc: (819) 825-1322
Courriel: stavibel-vd@stavibel.qc.ca
Site Internet: www.stavibel.qc.ca

REGISTERED PROFESSIONAL ENGINEER
B.A.P. GIARD
LICENSEE
NWTNU

2009-11-05
LICENSEE #1-2000

REVISIONS

NO.	DATE	REVISION	BY	APP. CLIENT
1	09-04-03	FOR COMMENT	F.R.	P.G.
2	09-04-17	FOR ENVIRONMENTAL REVIEW	F.R.	P.G.

AGNICO-EAGLE MEADOWBANK DIVISION

TITLE
AGNICO-EAGLE - MEADOWBANK DIVISION
BAKER LAKE AREA 740

CROSS-SECTIONS
PHASE 3 (2009)

DRAWN BY
FRANCIS ROSE, TECH
DATE
2009-04-17

CHECKED BY
PATRICK GIARD, P.ENG
DATE
2009-04-17

APPROVED BY
BERTHO CARON, ENG


SCALE
HOR: 1:500 VER: 1:100
DATE
2009-04-17

DRAWING NO.
VD2259-BKL-101

PROJECT NO.
VD2259-2

REVISION
2

SHEET
2 / 7

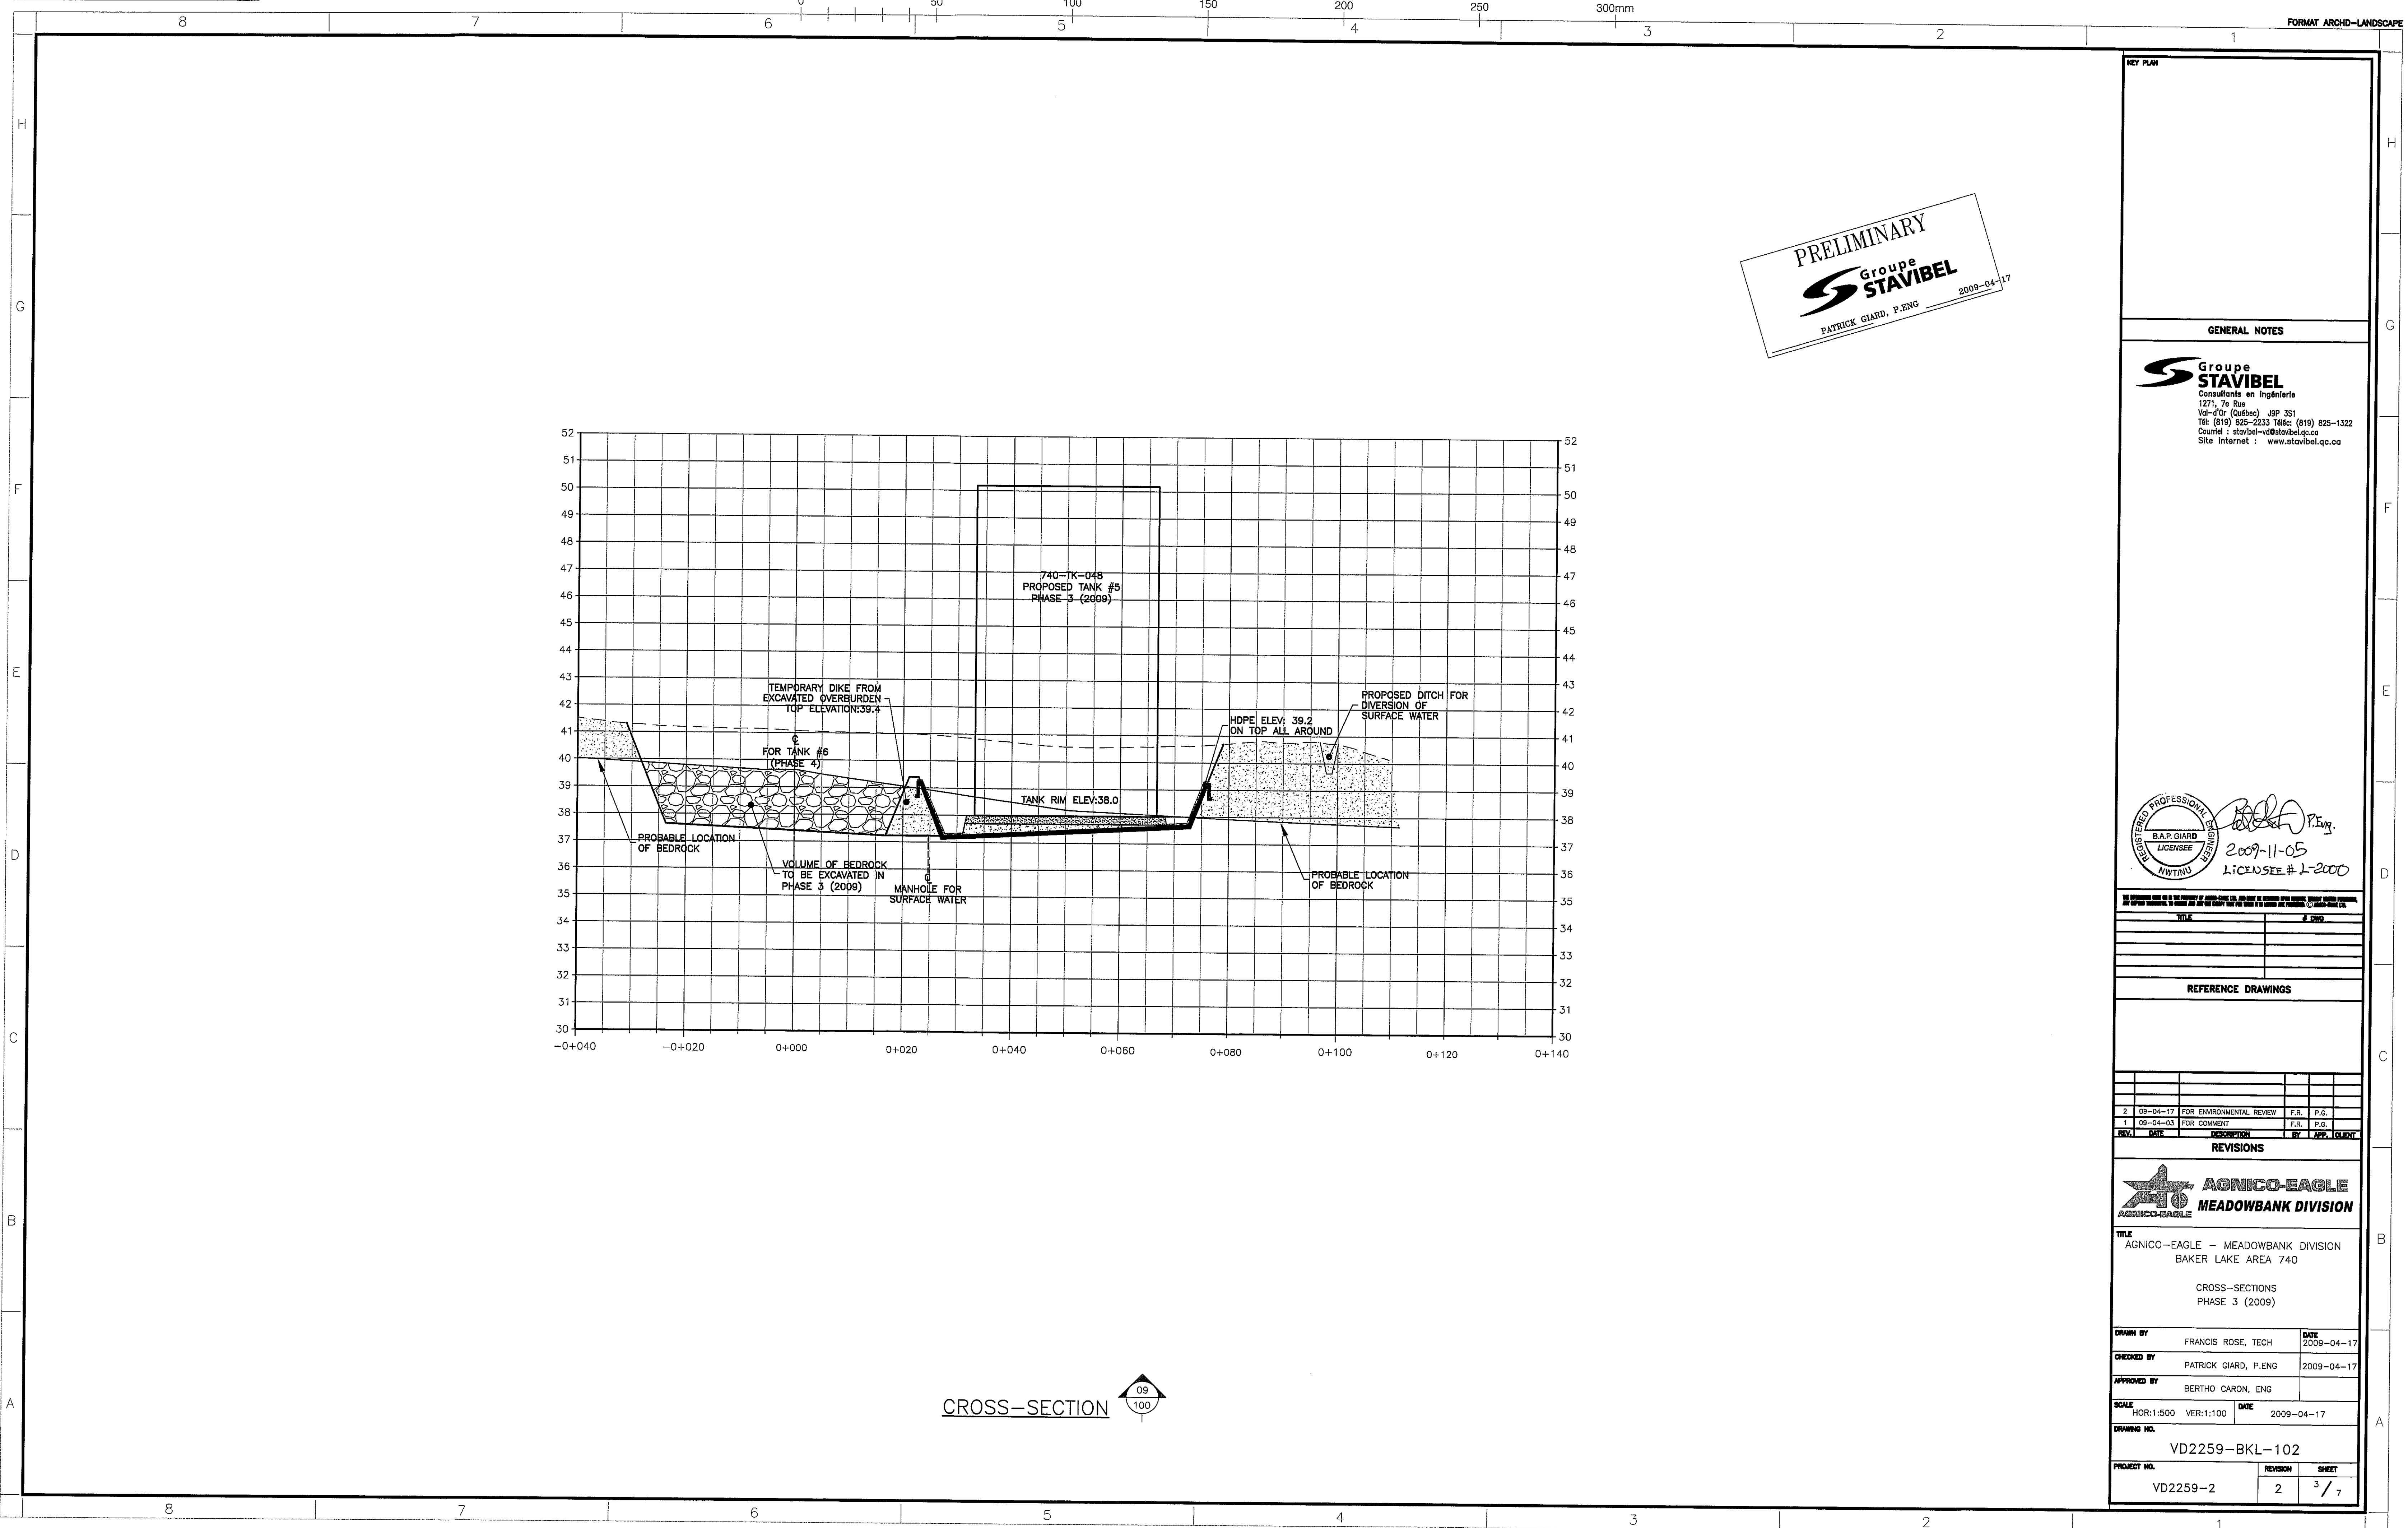

PRELIMINARY
Groupe
STAVIBEL
PATRICK GIARD, P.ENG 2009-04-17

KEY PLAN

GENERAL NOTES

Groupe
STAVIBEL
Consultants en Ingénierie
1271, 7e Rue
Val-d'Or (Québec) J9P 3S1
Tél: (819) 825-2233 Téléc: (819) 825-1322
Courriel : stavibel-vo@stavibel.qc.ca
Site internet : www.stavibel.qc.ca

REGISTERED PROFESSIONAL ENGINEER
B.A.P. GIARD
LICENSEE
NWTNU
2009-11-05
LICENSEE # 1-2000

THE INFORMATION CONTAINED HEREIN IS THE PROPERTY OF STAVIBEL INC. AND IS NOT TO BE REPRODUCED OR TRANSMITTED IN ANY FORM OR BY ANY MEANS, ELECTRONIC OR MECHANICAL, INCLUDING PHOTOCOPYING, RECORDING, OR BY ANY INFORMATION STORAGE AND RETRIEVAL SYSTEM, WITHOUT THE WRITTEN PERMISSION OF STAVIBEL INC.

TITLE	DATE

REFERENCE DRAWINGS

REV.	DATE	DESCRIPTION	BY	APP.	CLIENT
2	09-04-17	FOR ENVIRONMENTAL REVIEW	F.R.	P.G.	
1	09-04-03	FOR COMMENT	F.R.	P.G.	

REVISIONS

AGNICO-EAGLE
MEADOWBANK DIVISION

TITLE
AGNICO-EAGLE - MEADOWBANK DIVISION
BAKER LAKE AREA 740




CROSS-SECTIONS
PHASE 3 (2009)

DRAWN BY	FRANCIS ROSE, TECH	DATE	2009-04-17
CHECKED BY	PATRICK GIARD, P.ENG	DATE	2009-04-17
APPROVED BY	BERTHO CARON, ENG	DATE	

SCALE
HOR:1:500 VER:1:100 DATE 2009-04-17

DRAWING NO.
VD2259-BKL-102

PROJECT NO.	REVISION	SHEET
VD2259-2	2	3 / 7

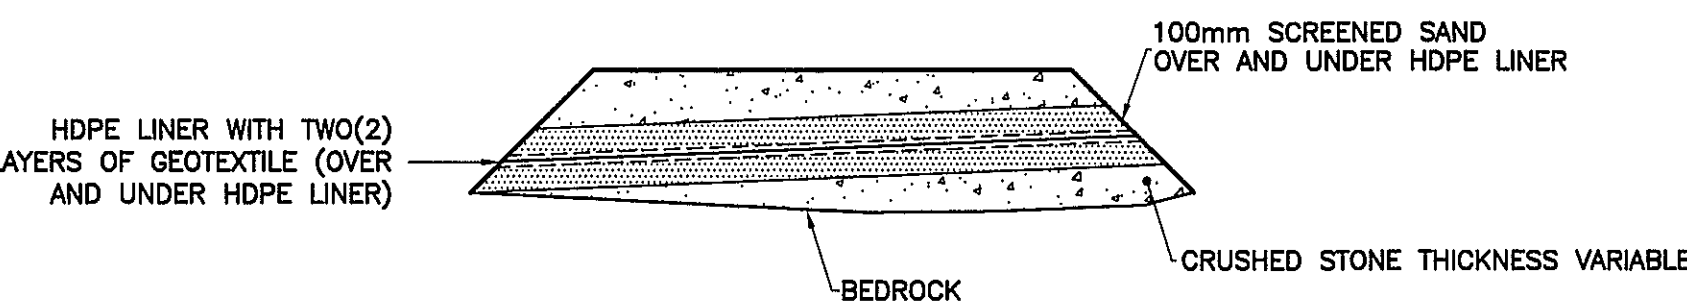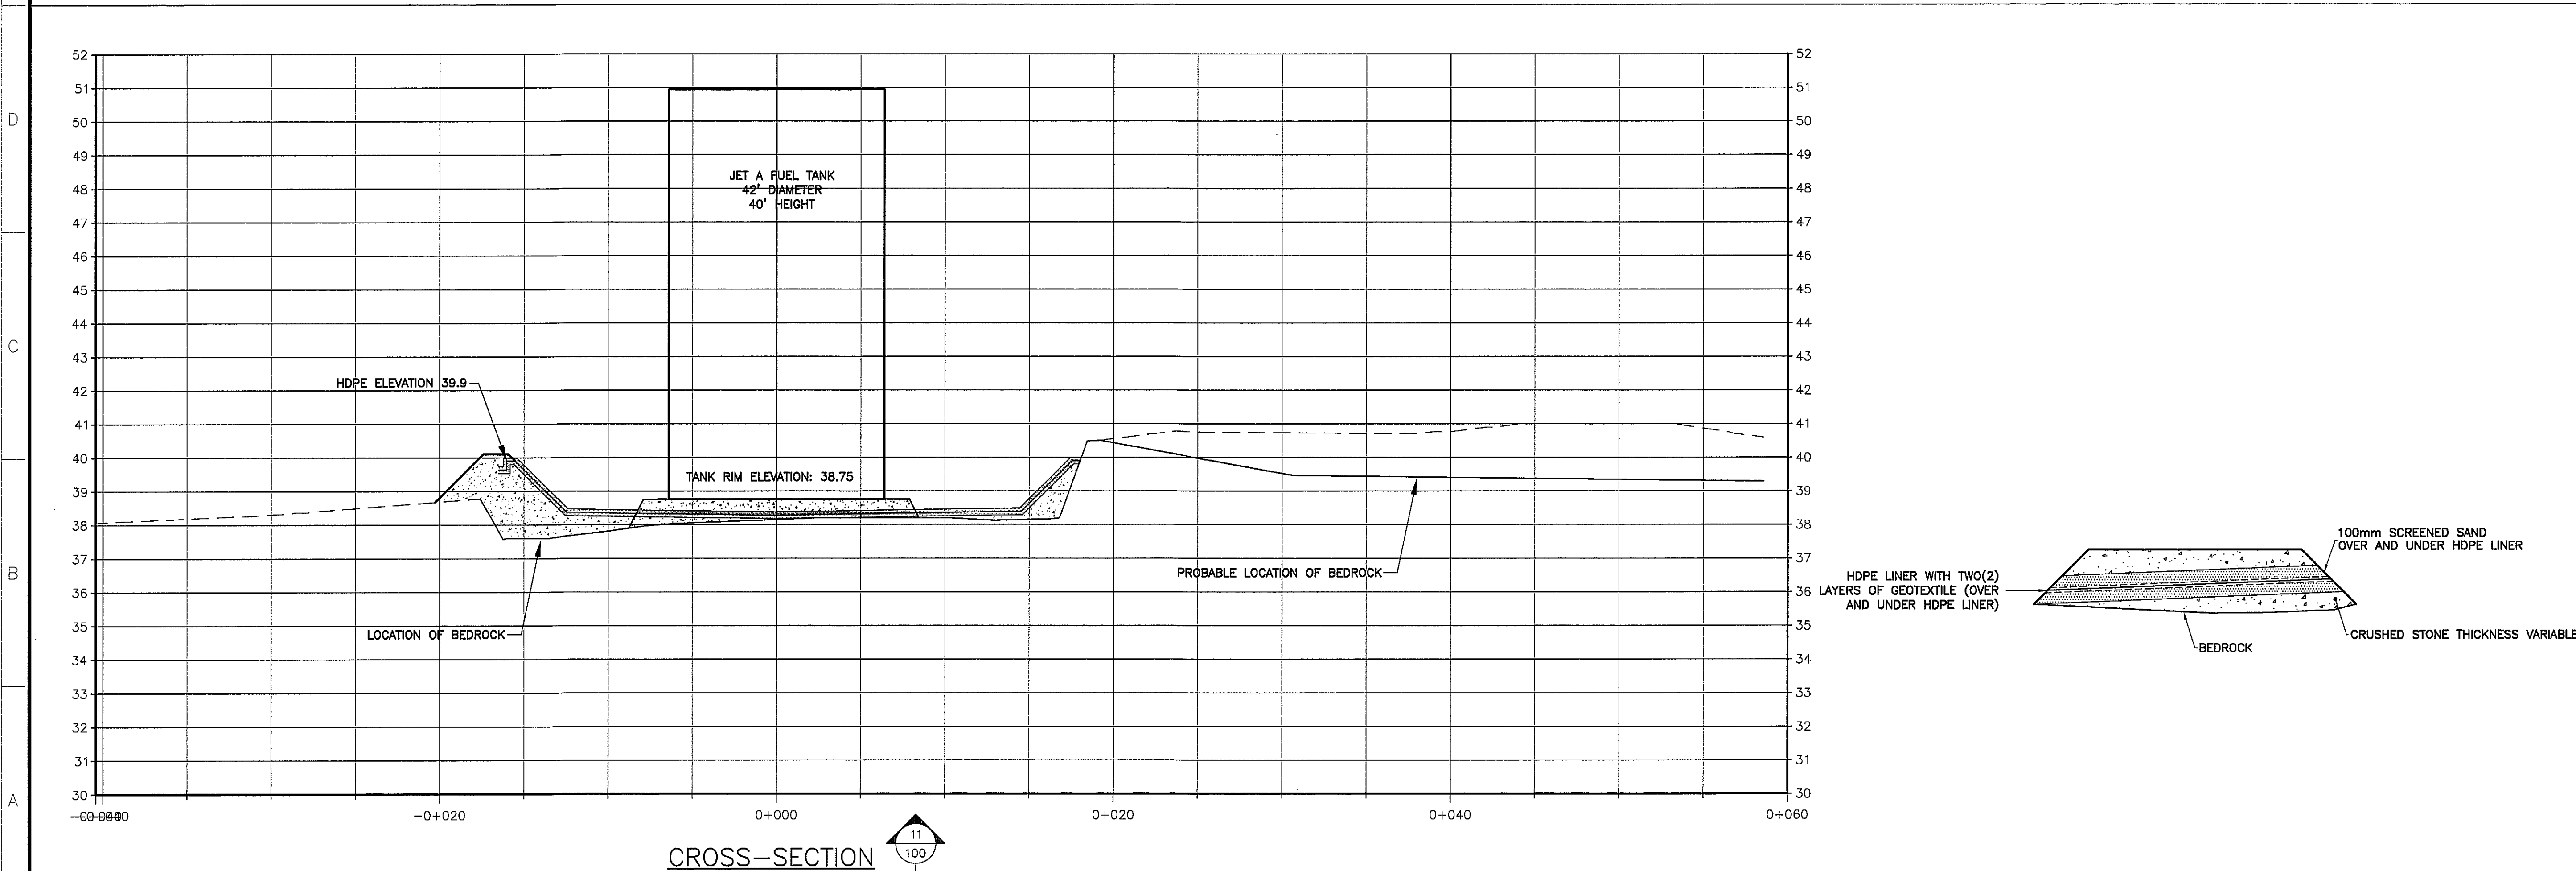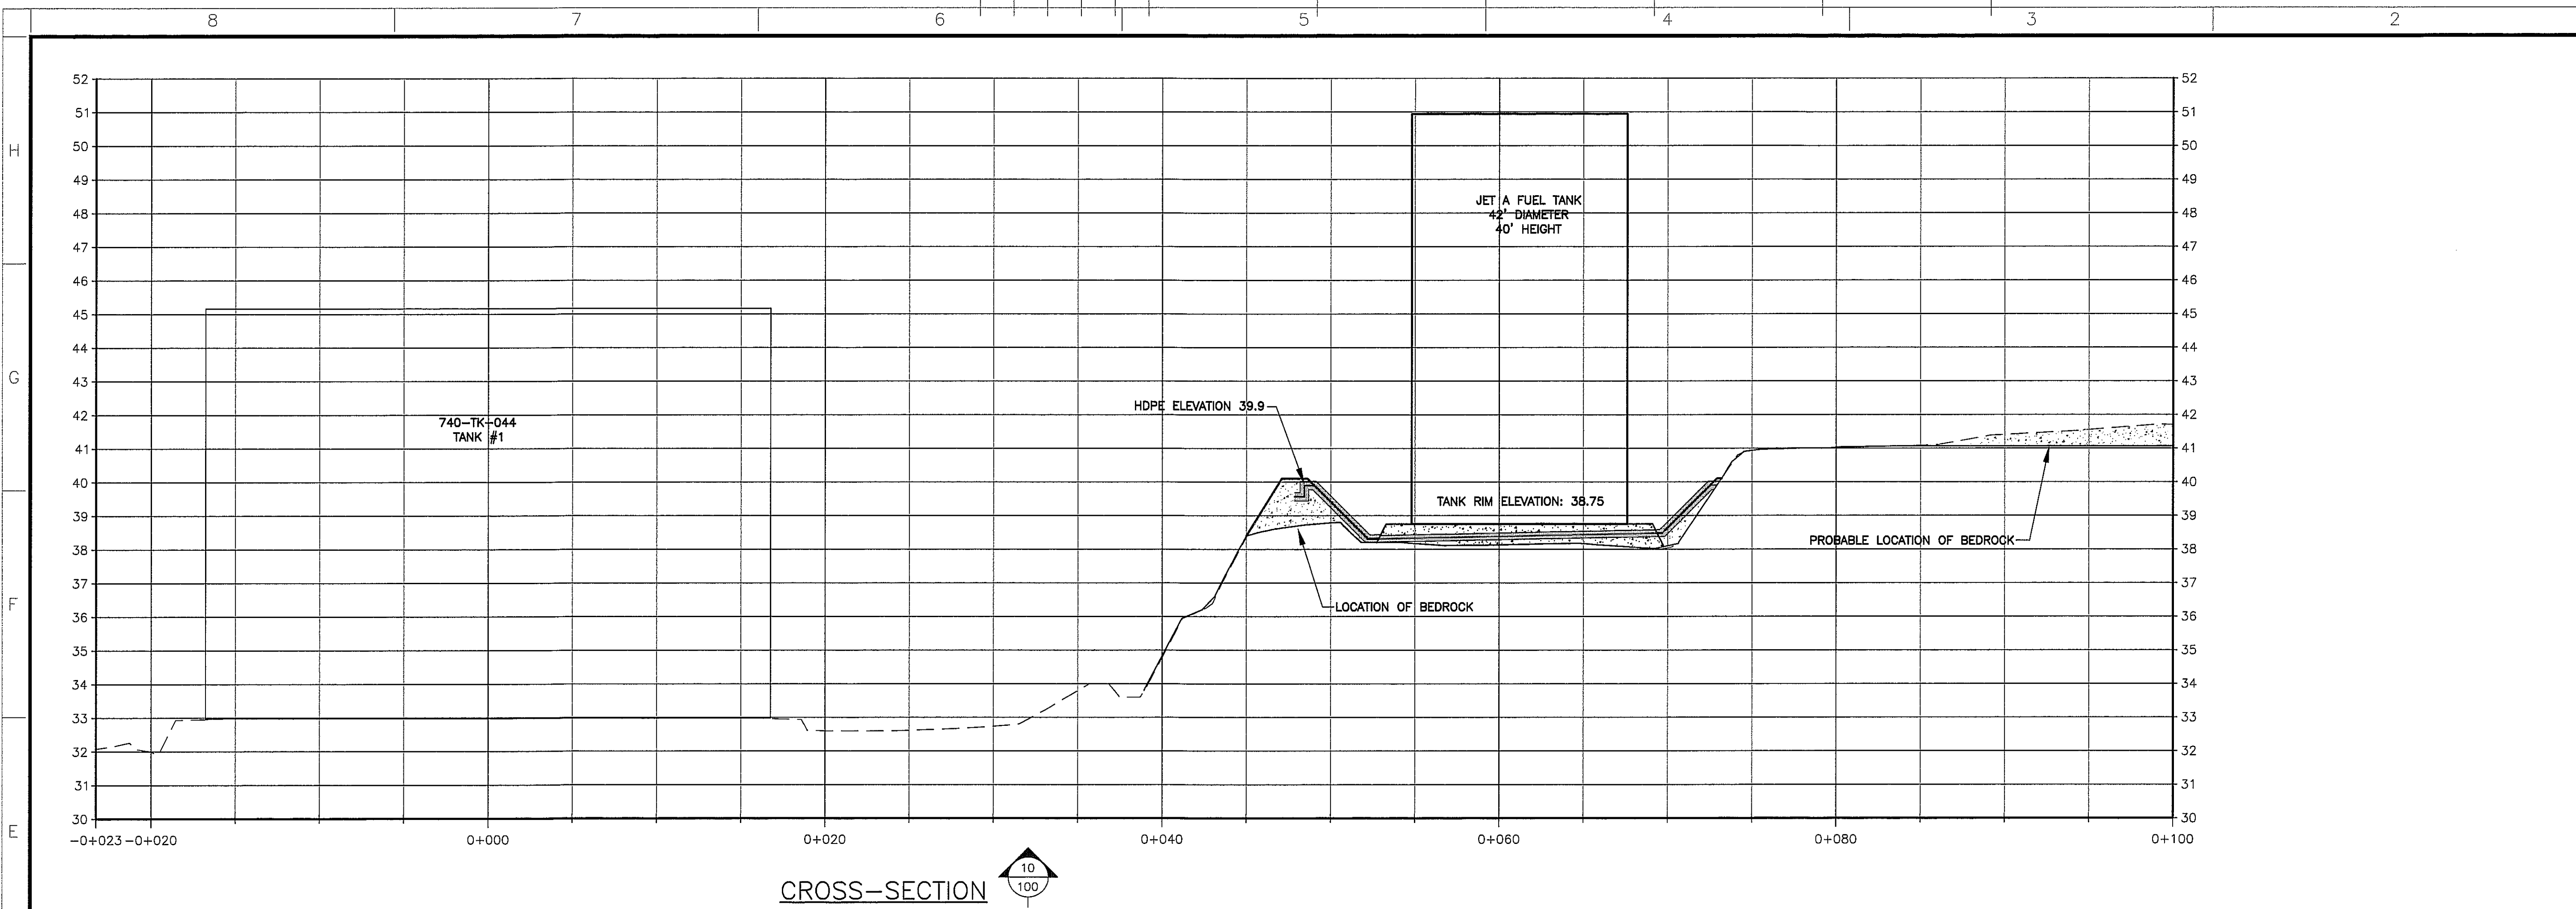

KEY PLAN

GENERAL NOTES

Groupe STAVIBEL
Consultants en Ingénierie
1271, 7e Rue
Val-d'Or (Québec) J9P 3S1
Tél: (819) 825-2233 Téléc: (819) 825-1322
Courriel : stavibel-vd@stavibel.qc.ca
Site Internet : www.stavibel.qc.ca

B.A.P. GIARD
LICENSÉE
2009-11-05
LICENSÉE # 1-2000

TITLE	#

REFERENCE DRAWINGS

REV.	DATE	DESCRIPTION	BY	APP.	CLIENT
2	09-04-17	FOR ENVIRONMENTAL REVIEW	F.R.	P.G.	
1	09-04-03	FOR COMMENT	F.R.	P.G.	

REVISIONS

AGNICO-EAGLE
MEADOWBANK DIVISION

TITLE
AGNICO-EAGLE - MEADOWBANK DIVISION
BAKER LAKE AREA 740

CROSS-SECTIONS
PHASE 3 (2009)

DRAWN BY: FRANCIS ROSE, TECH DATE: 2009-04-17



CHECKED BY: PATRICK GIARD, P.ENG 2009-04-17

APPROVED BY: BERTHO CARON, ENG


SCALE: HOR:1:200 VER:1:100 DATE: 2009-04-17

DRAWING NO. VD2259-BKL-103

PROJECT NO. 2259-2 REVISION 2 SHEET 4/7

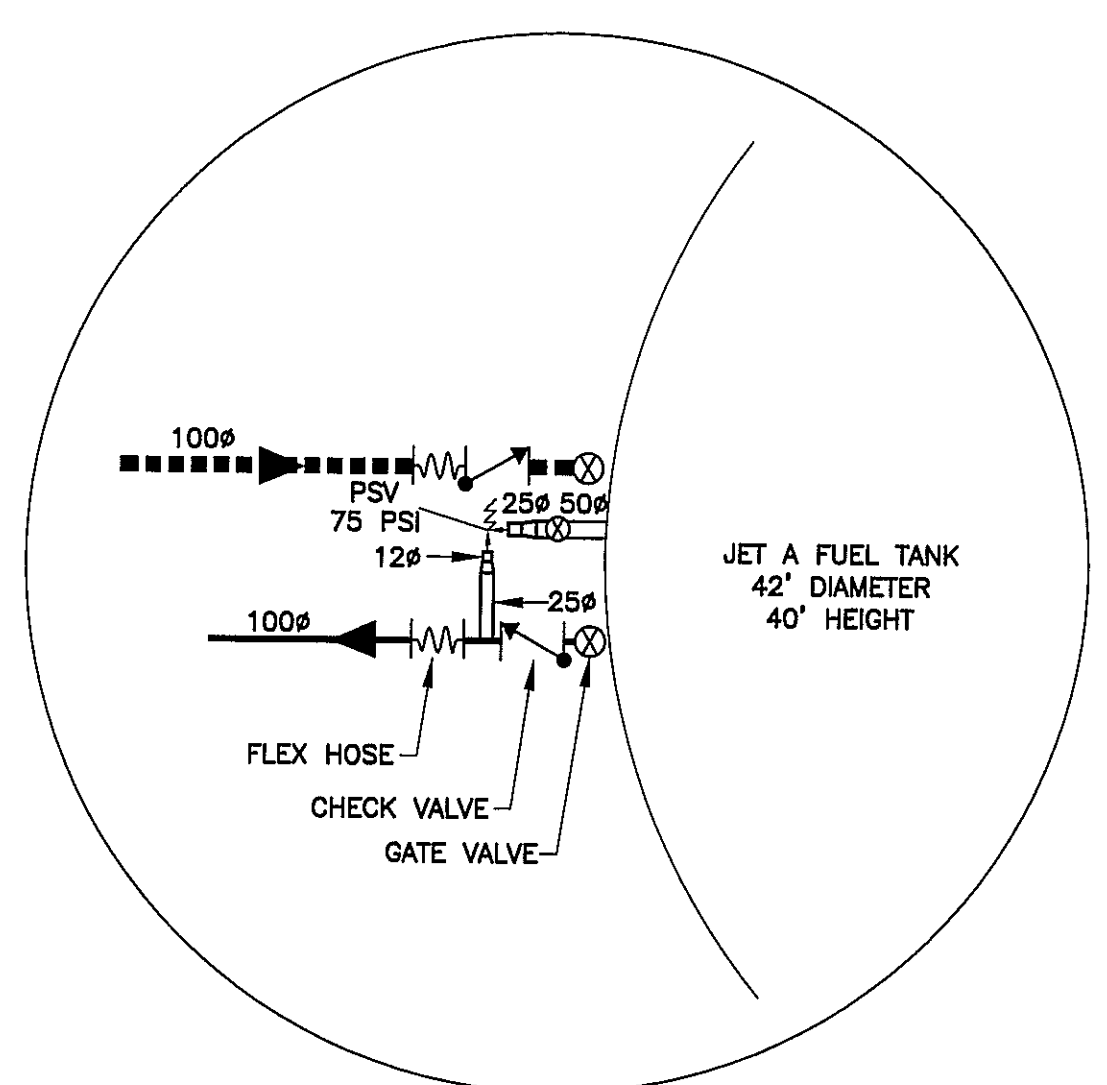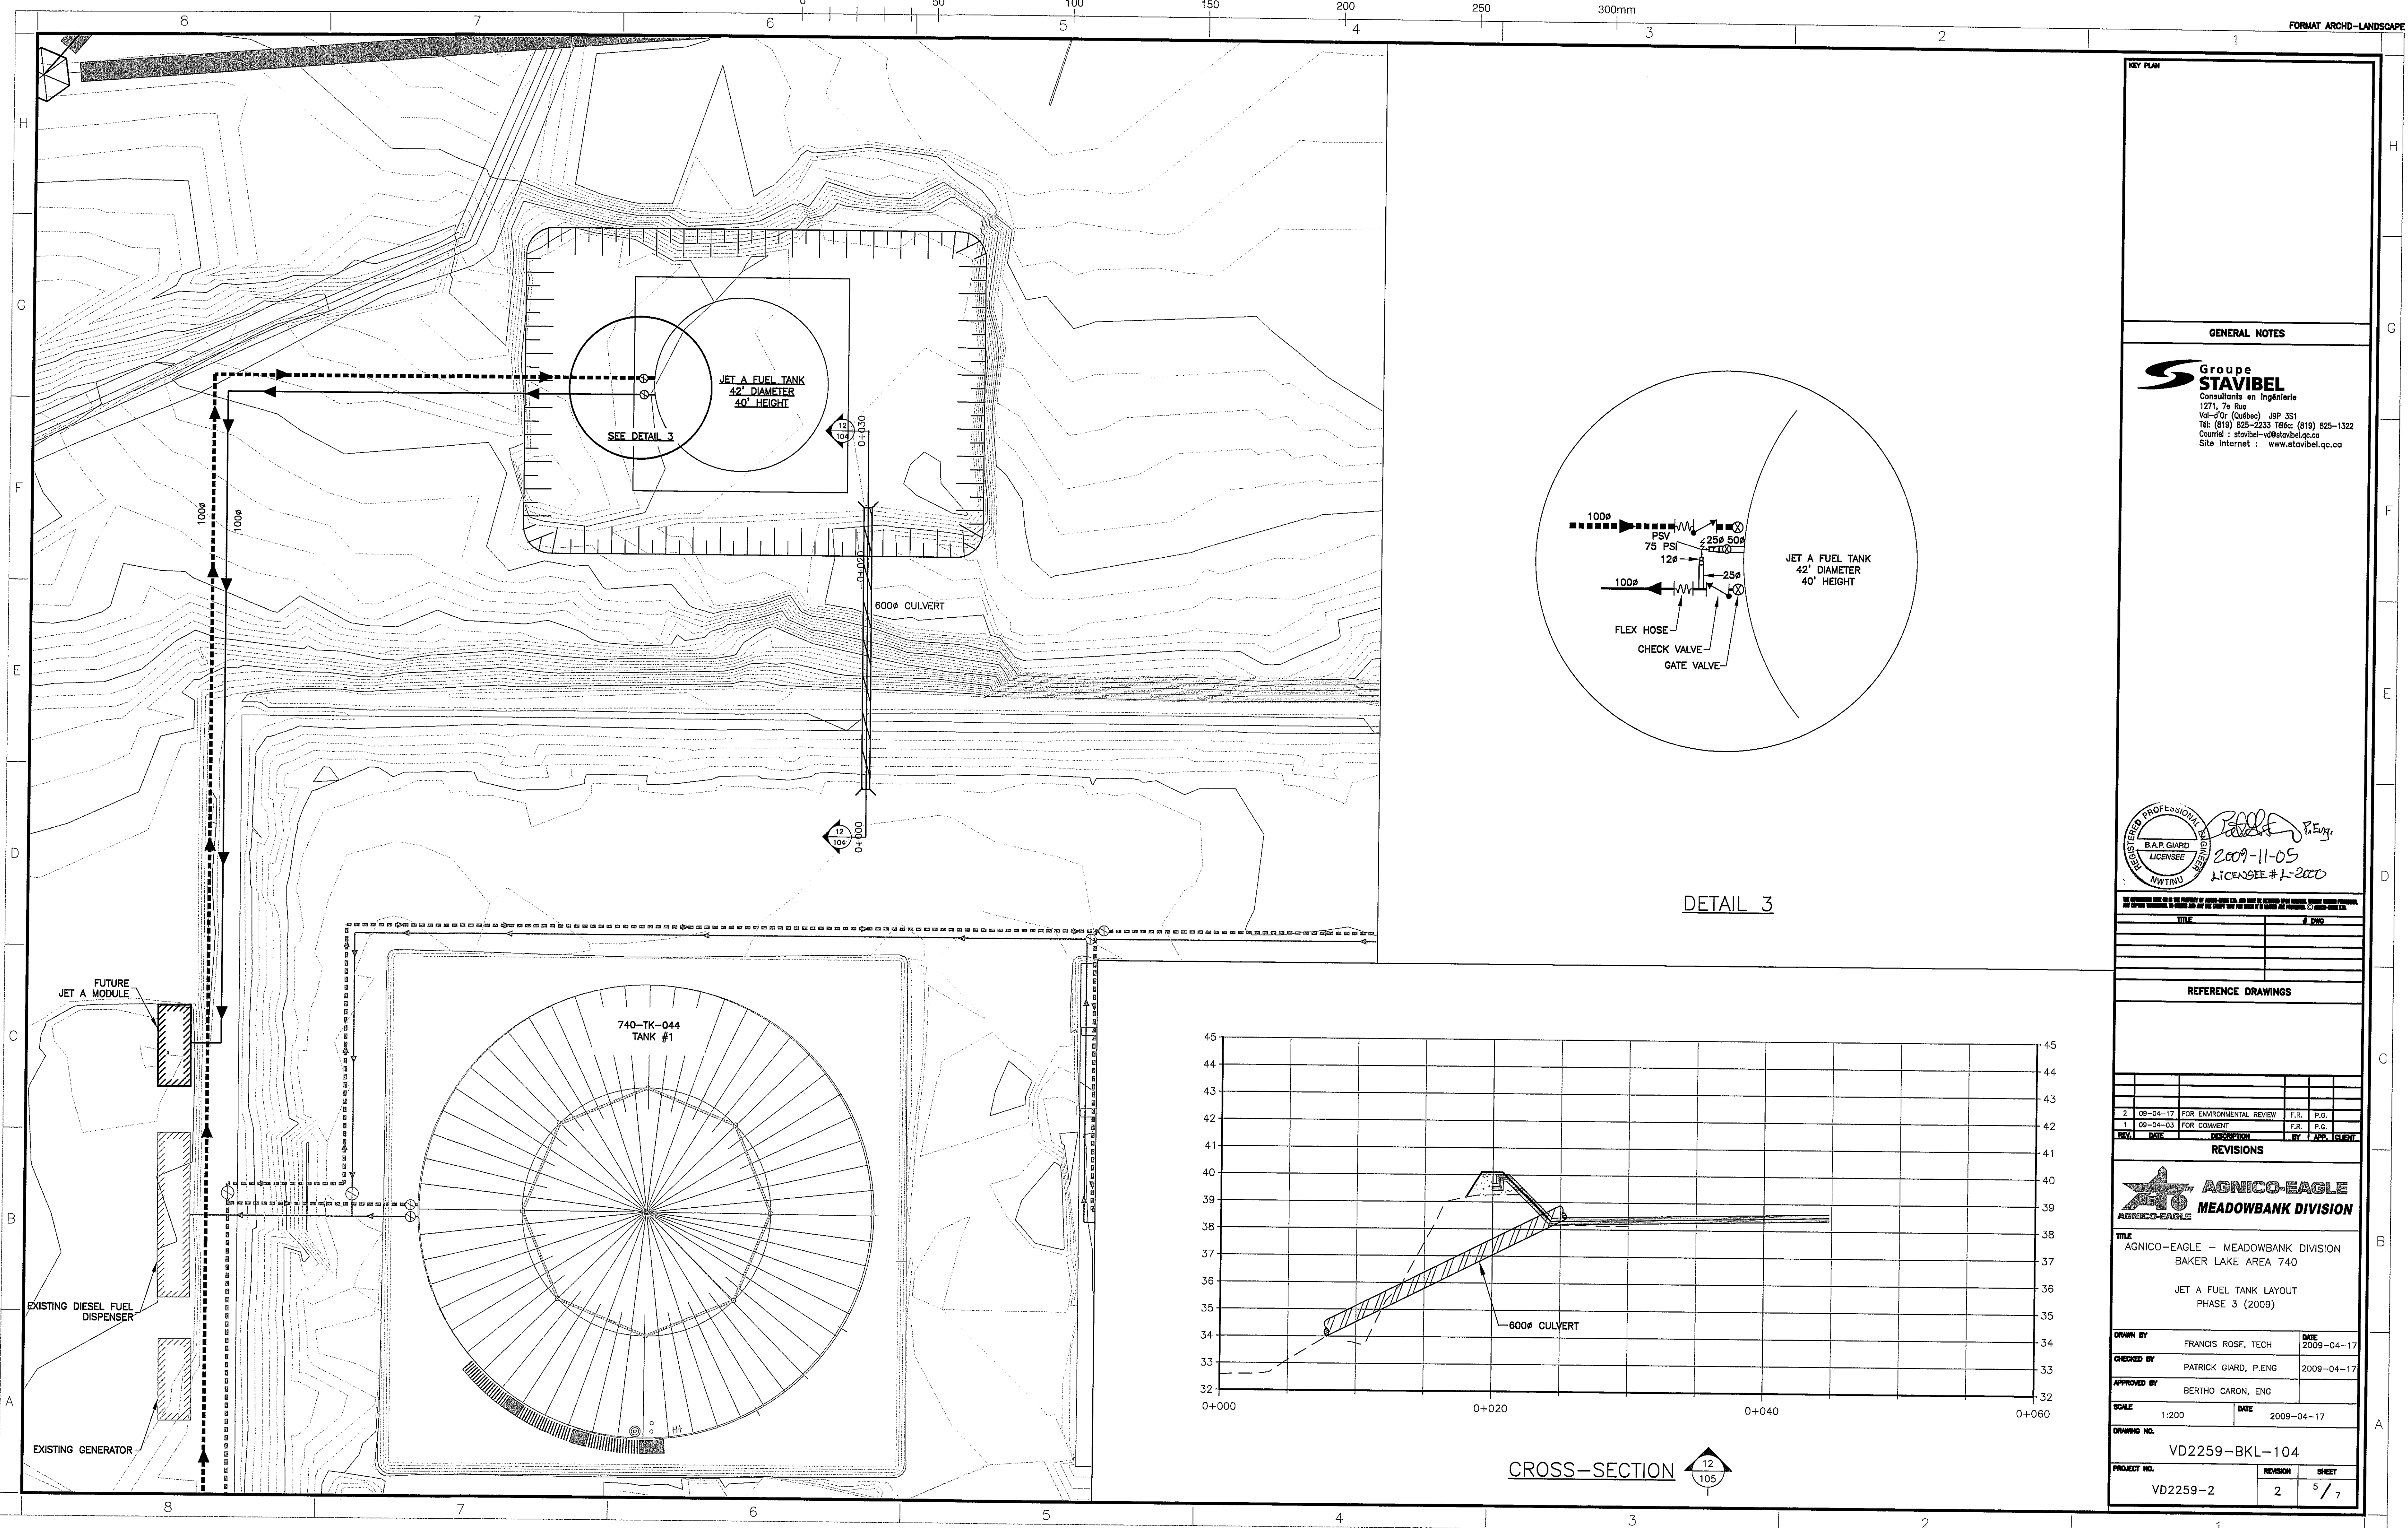

DETAIL 3

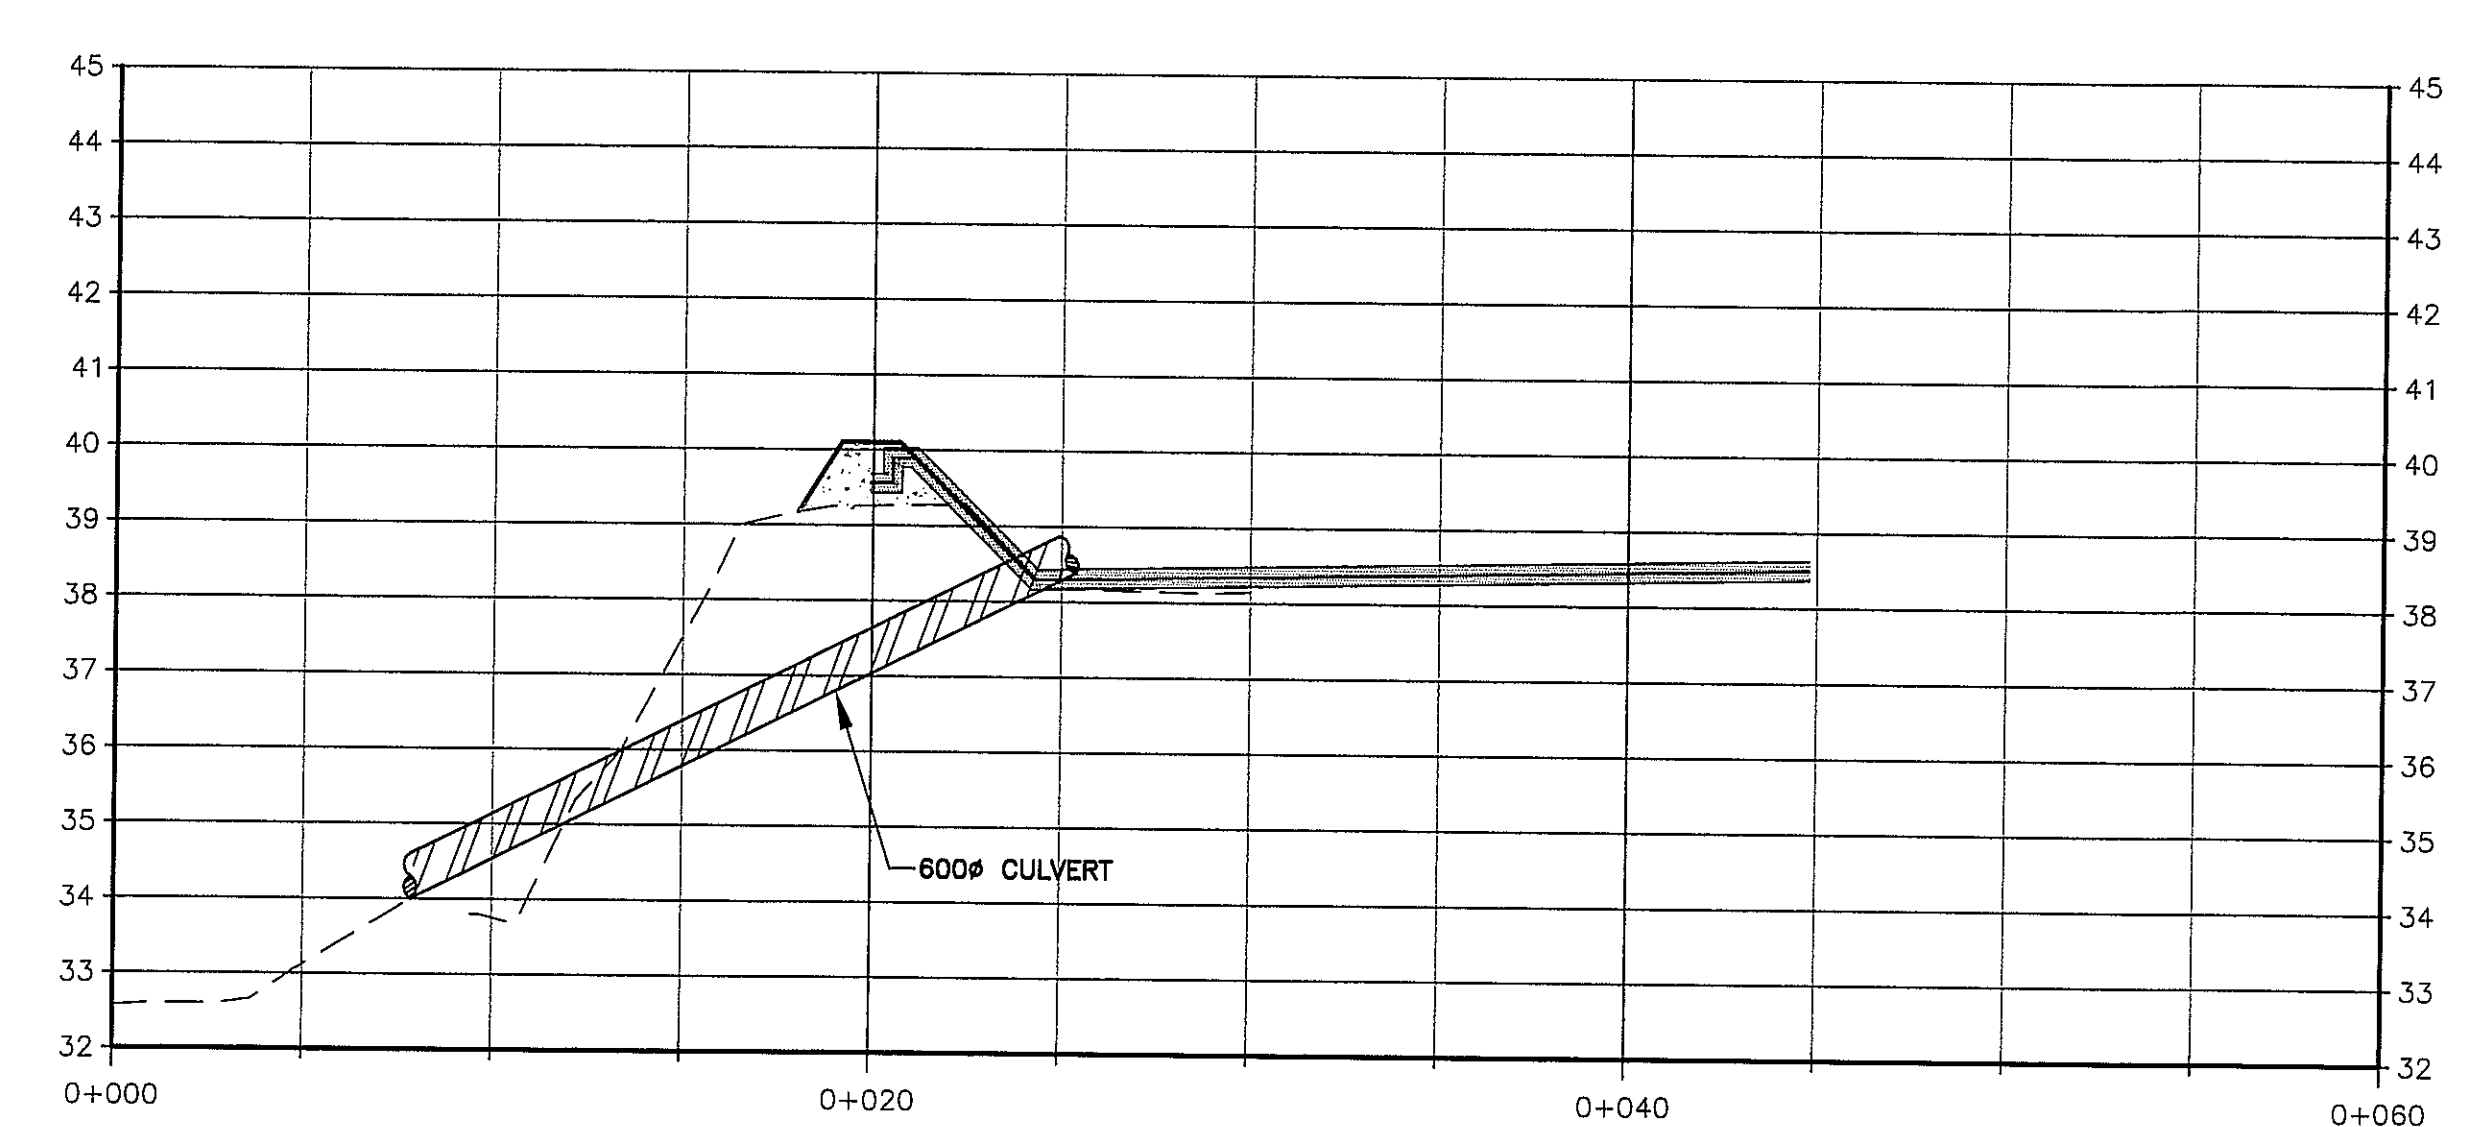

CROSS-SECTION

KEY PLAN

GENERAL NOTES

Groupe STAVIBEL
Consultants en Ingénierie
1271, 7e Rue
Val-d'Or (Québec) J9P 3S1
Tél: (819) 825-2233 Téléc: (819) 825-1322
Courriel : stavibel-vo@stavibel.qc.ca
Site Internet : www.stavibel.qc.ca

REGISTERED PROFESSIONAL ENGINEER
B.A.P. GIARD
LICENSEE
2009-11-05
LICENSEE # 1-2000

TITLE		# 100	

REFERENCE DRAWINGS

REV.	DATE	DESCRIPTION	BY	APP.	CLIENT
2	09-04-17	FOR ENVIRONMENTAL REVIEW	F.R.	P.G.	
1	09-04-03	FOR COMMENT	F.R.	P.G.	

REVISIONS

AGNICO-EAGLE
MEADOWBANK DIVISION

TITLE
AGNICO-EAGLE - MEADOWBANK DIVISION
BAKER LAKE AREA 740

JET A FUEL TANK LAYOUT
PHASE 3 (2009)


DRAWN BY	DATE
FRANCIS ROSE, TECH	2009-04-17

CHECKED BY	DATE
PATRICK GIARD, P.ENG	2009-04-17

APPROVED BY	DATE
BERTHO CARON, ENG	

SCALE	DATE
1:200	2009-04-17

DRAWING NO.	REVISION	SHEET
VD2259-BKL-104		
VD2259-2	2	5 / 7

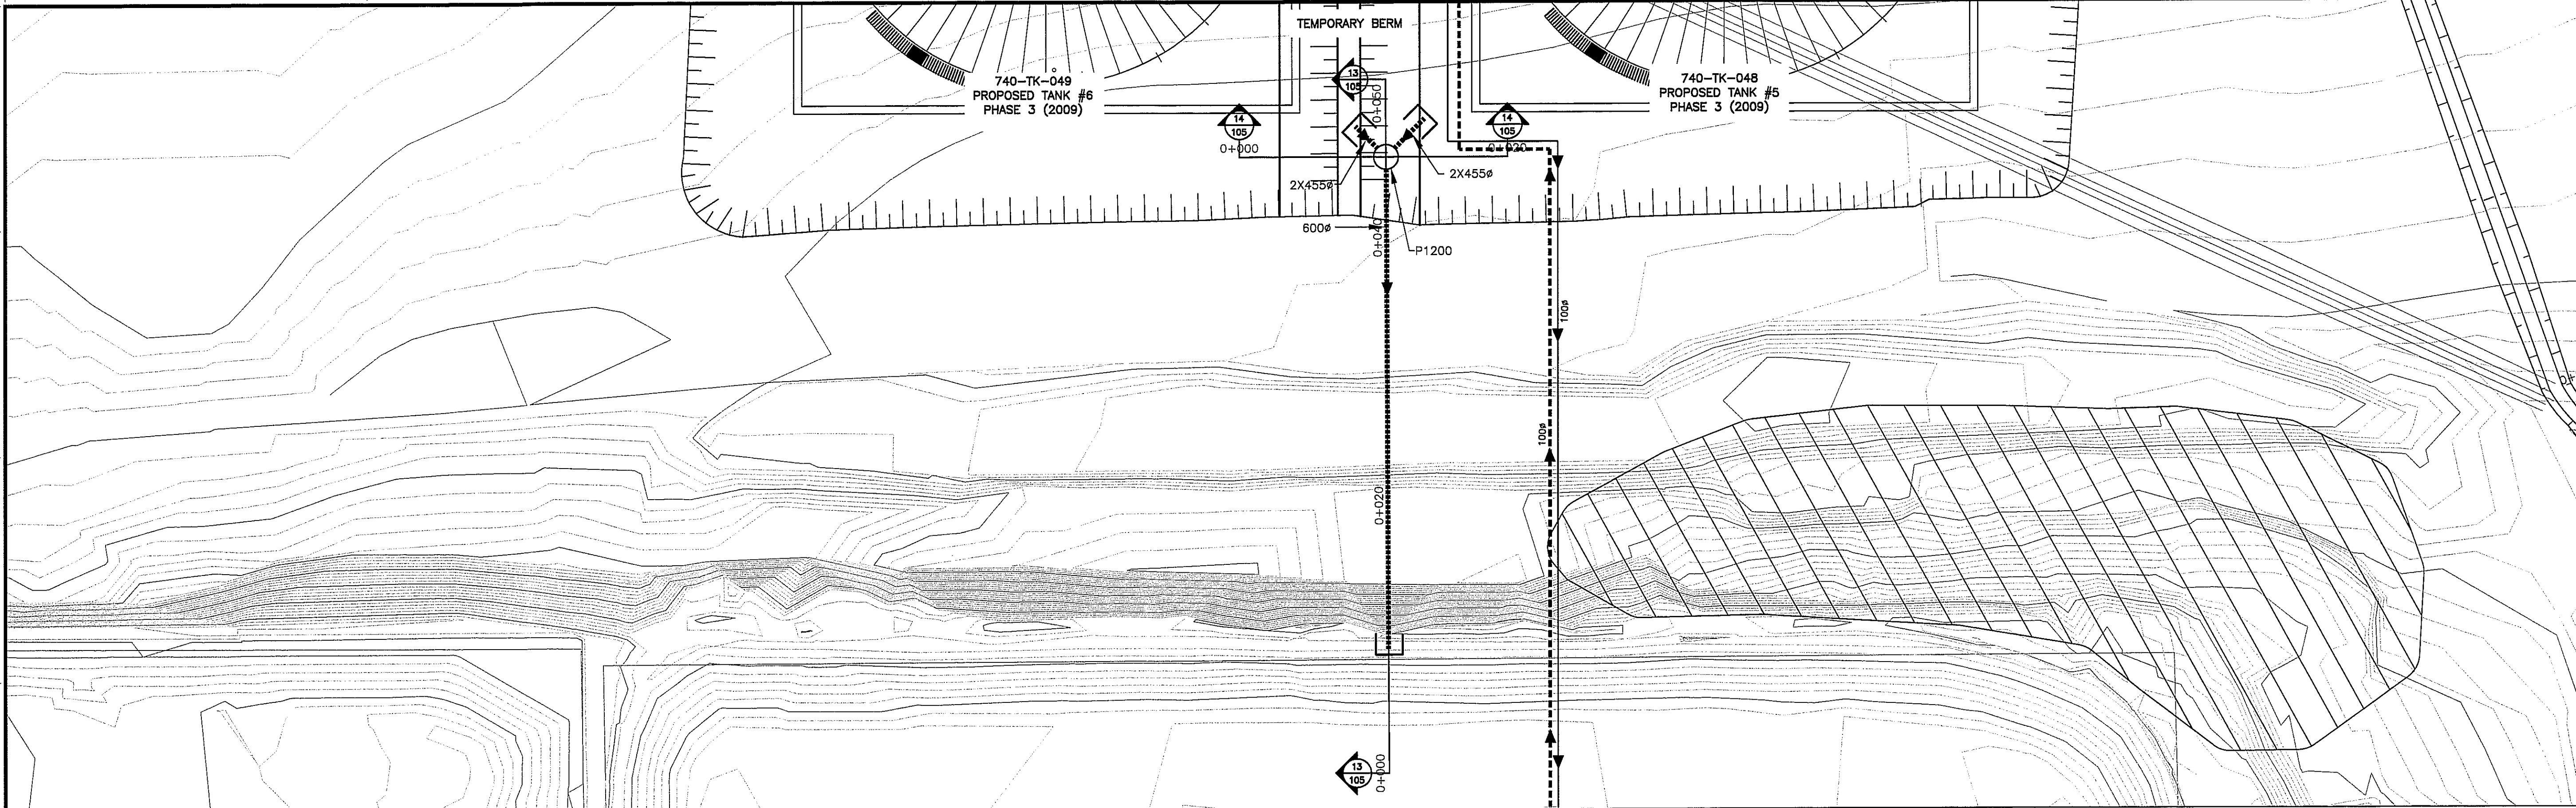

KEY PLAN

GENERAL NOTES

Groupe STAVIBEL
Consultants en Ingénierie
1271, 7e Rue
Val-d'Or (Québec) J9P 3S1
Tél: (819) 825-2233 Téléc: (819) 825-1322
Courriel : stavibel-va@stavibel.qc.ca
Site internet : www.stavibel.qc.ca

PROFESSIONAL ENGINEER
B.A.P. GIARD
LICENSEE
NWTNU
2009-11-05
LICENSEE # L-2000

REFERENCE DRAWINGS

REV.	DATE	DESCRIPTION	BY	APP.	CLIENT
3	07-11-05	AS-BUILT PIPING	F.R.	P.G.	
2	08-04-17	FOR ENVIRONMENTAL REVIEW	F.R.	P.G.	
1	09-04-03	FOR COMMENT	F.R.	P.G.	

AGNICO-EAGLE MEADOWBANK DIVISION

TITLE
AGNICO-EAGLE - MEADOWBANK DIVISION
BAKER LAKE AREA 740

CROSS-SECTIONS AND P-1200 DETAILS
PHASE 3 (2009)


DRIVEN BY	DATE
FRANCIS ROSE, TECH	2009-04-17

CHECKED BY	DATE
PATRICK GIARD, P.ENG	2009-04-17


APPROVED BY	DATE
BERTHO CARON, ENG	

SCALE	DATE
AS SHOWN	2009-04-17


DRAWING NO.	REVISION	SHEET
VD2259-BKL-105		
VD2259-2	2	6 / 7

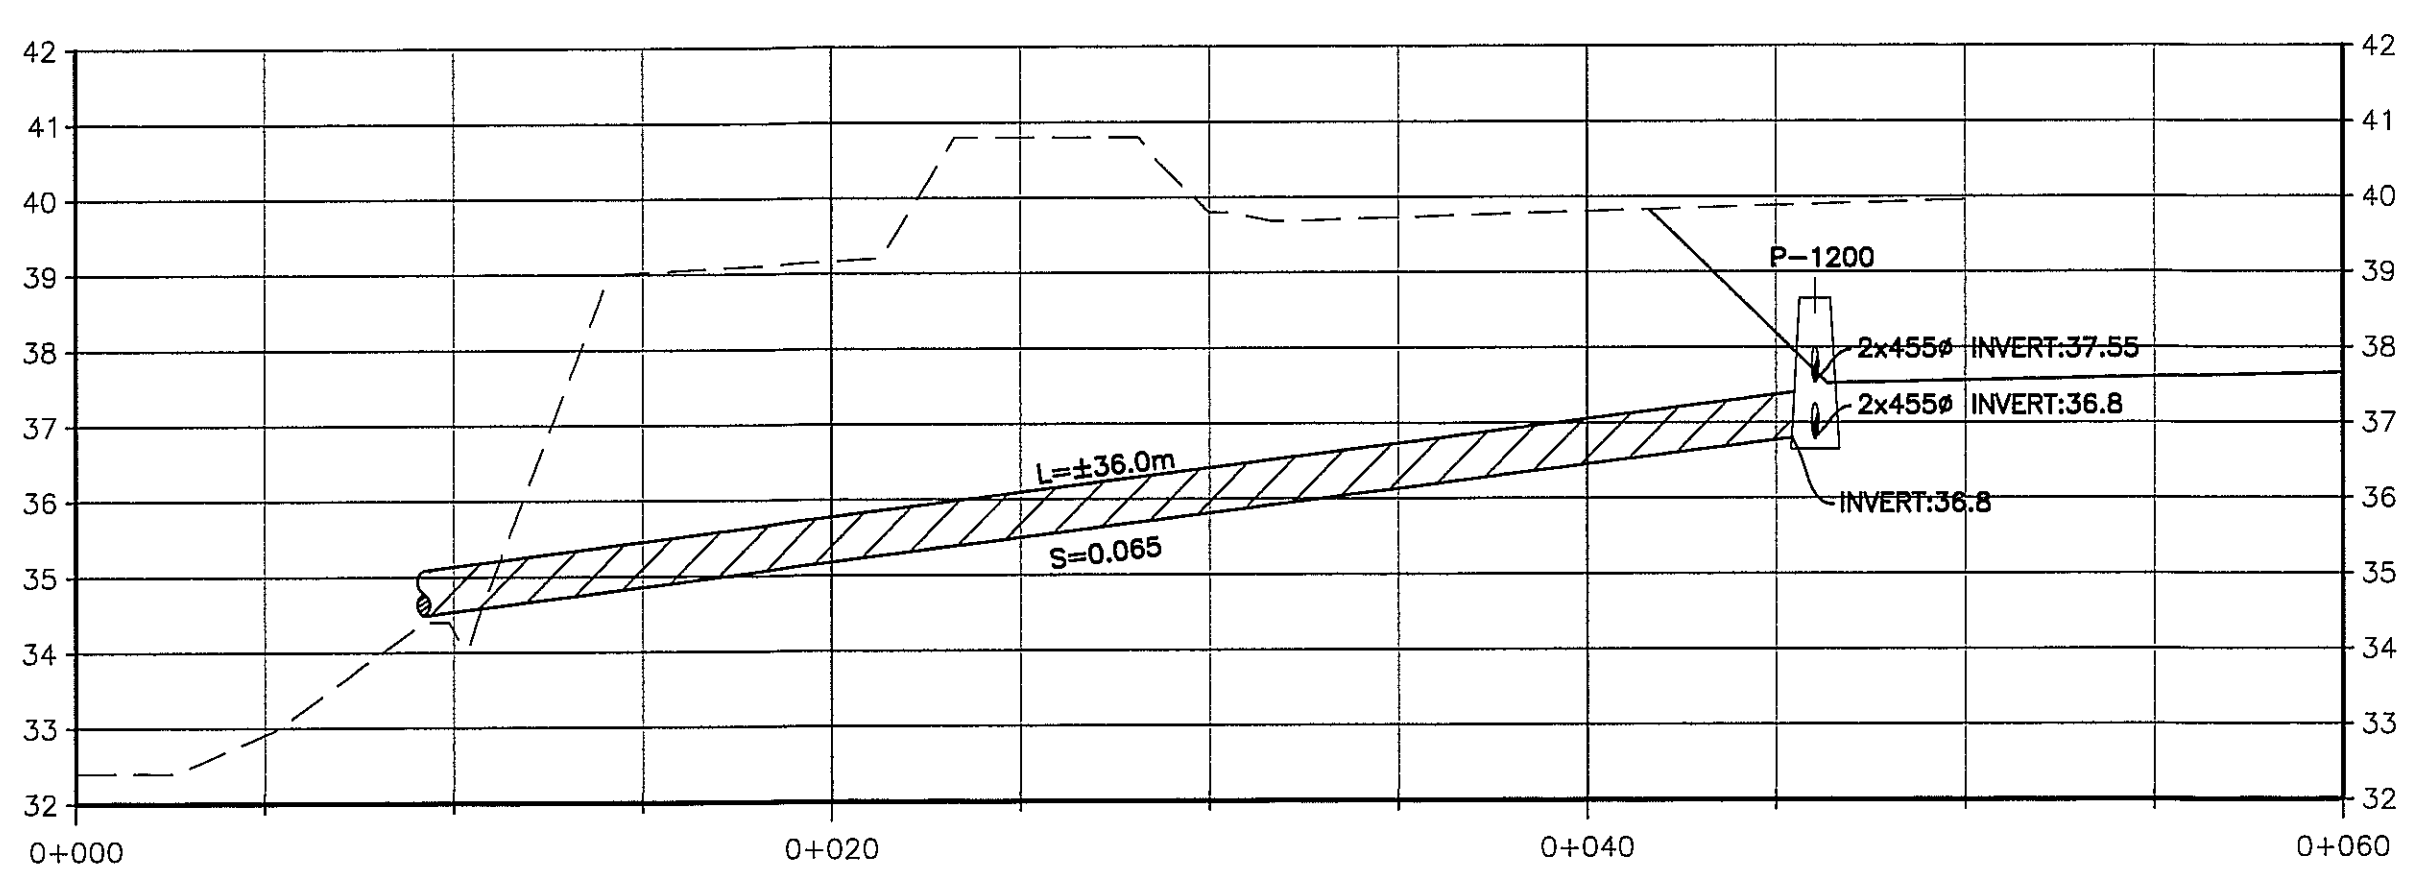


CROSS-SECTION
SCALE: HOR:1:200
VER:1:100

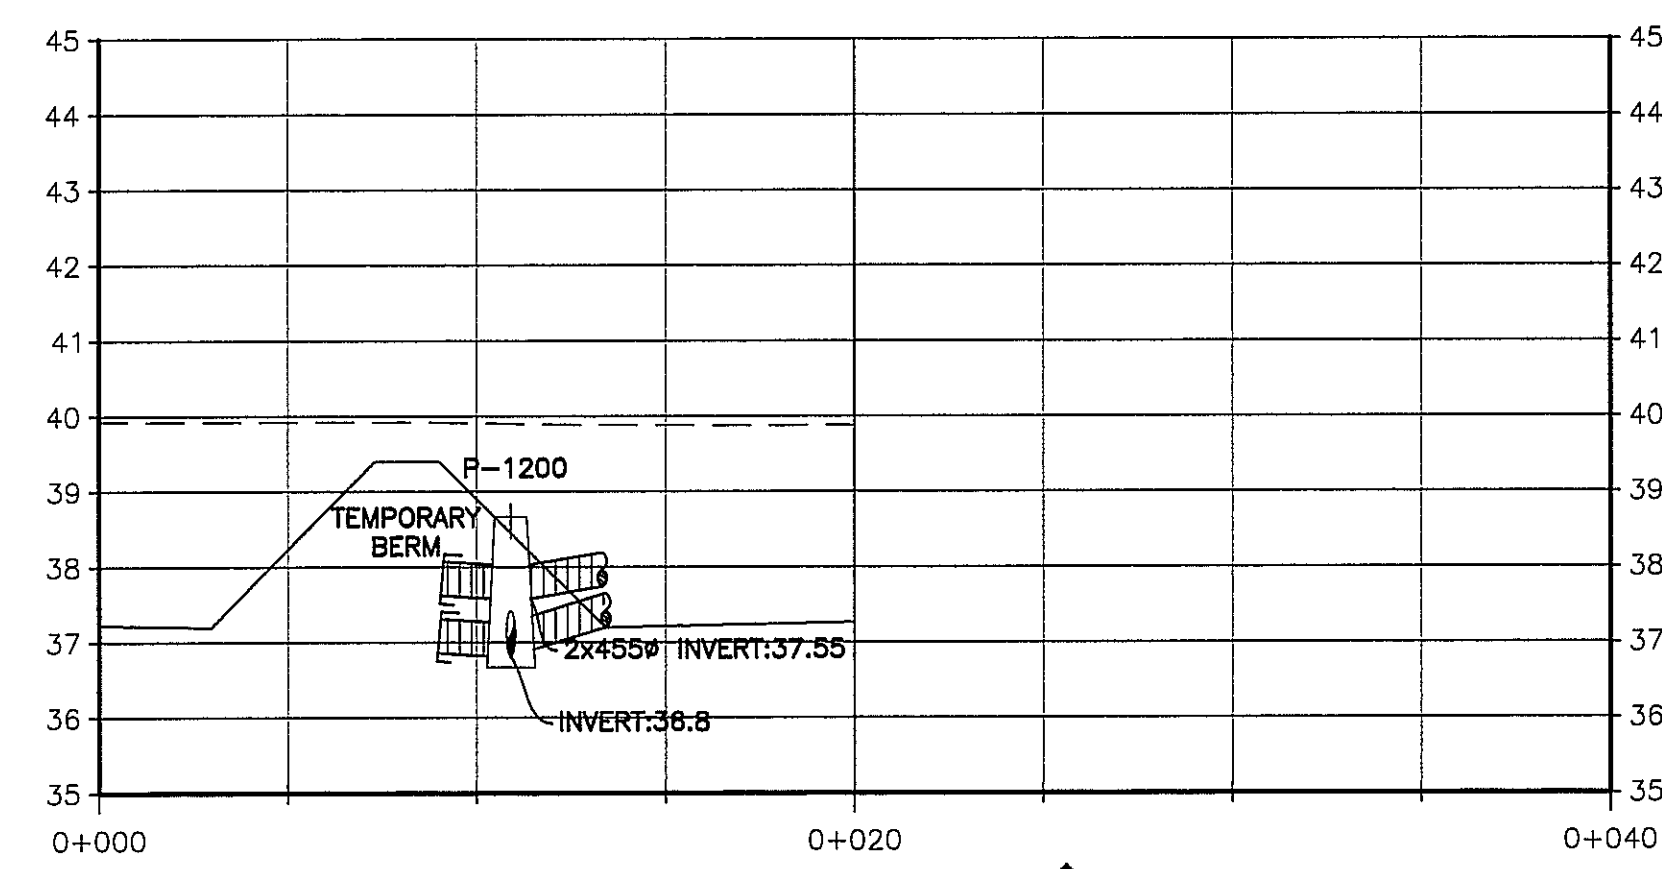


CROSS-SECTION
SCALE: HOR:1:200
VER:1:100

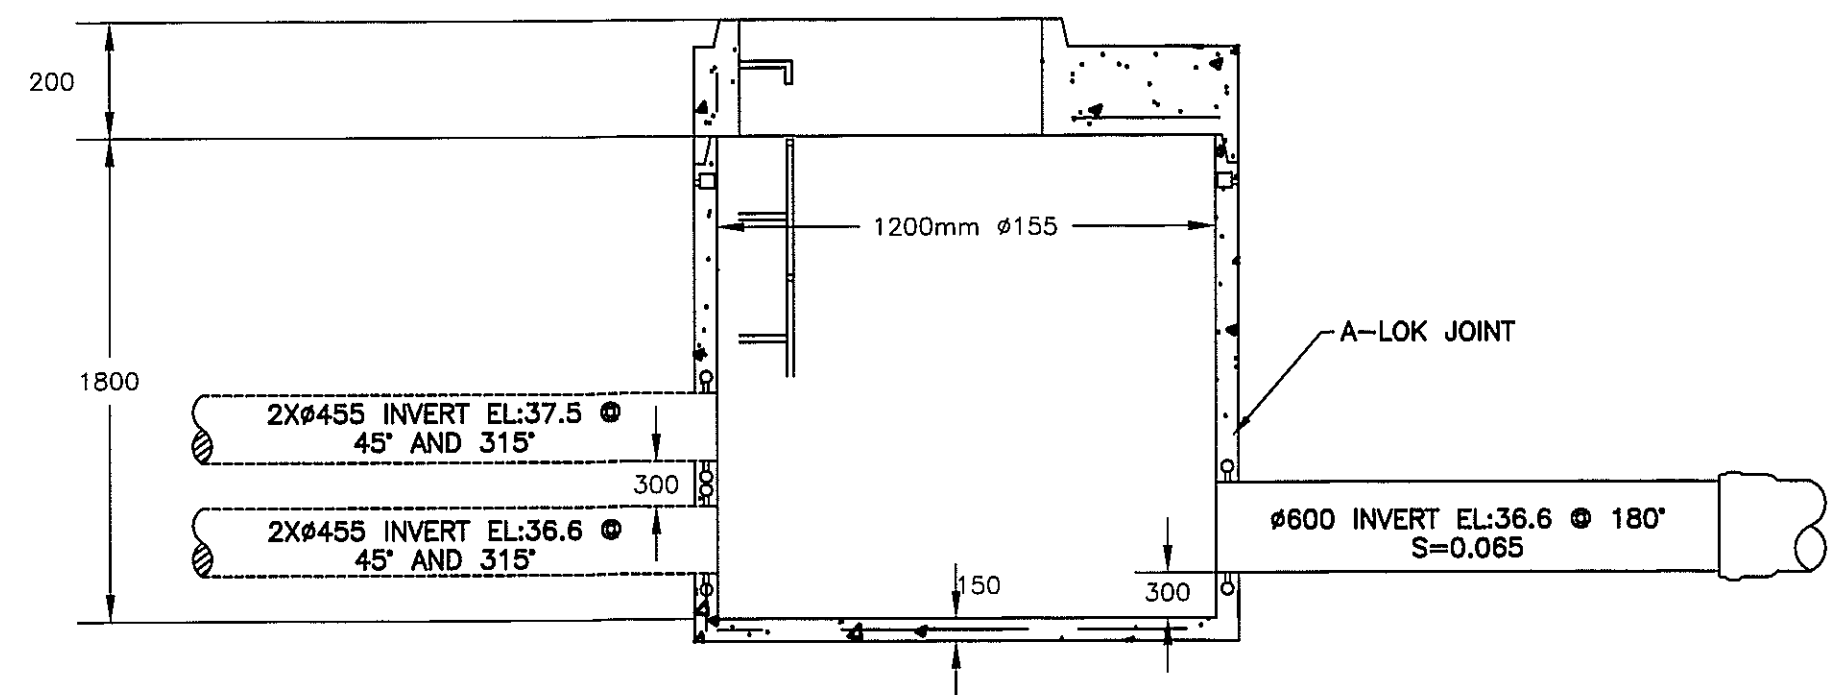

STORMWATER MANHOLE TYPE P1200
NOT TO SCALE

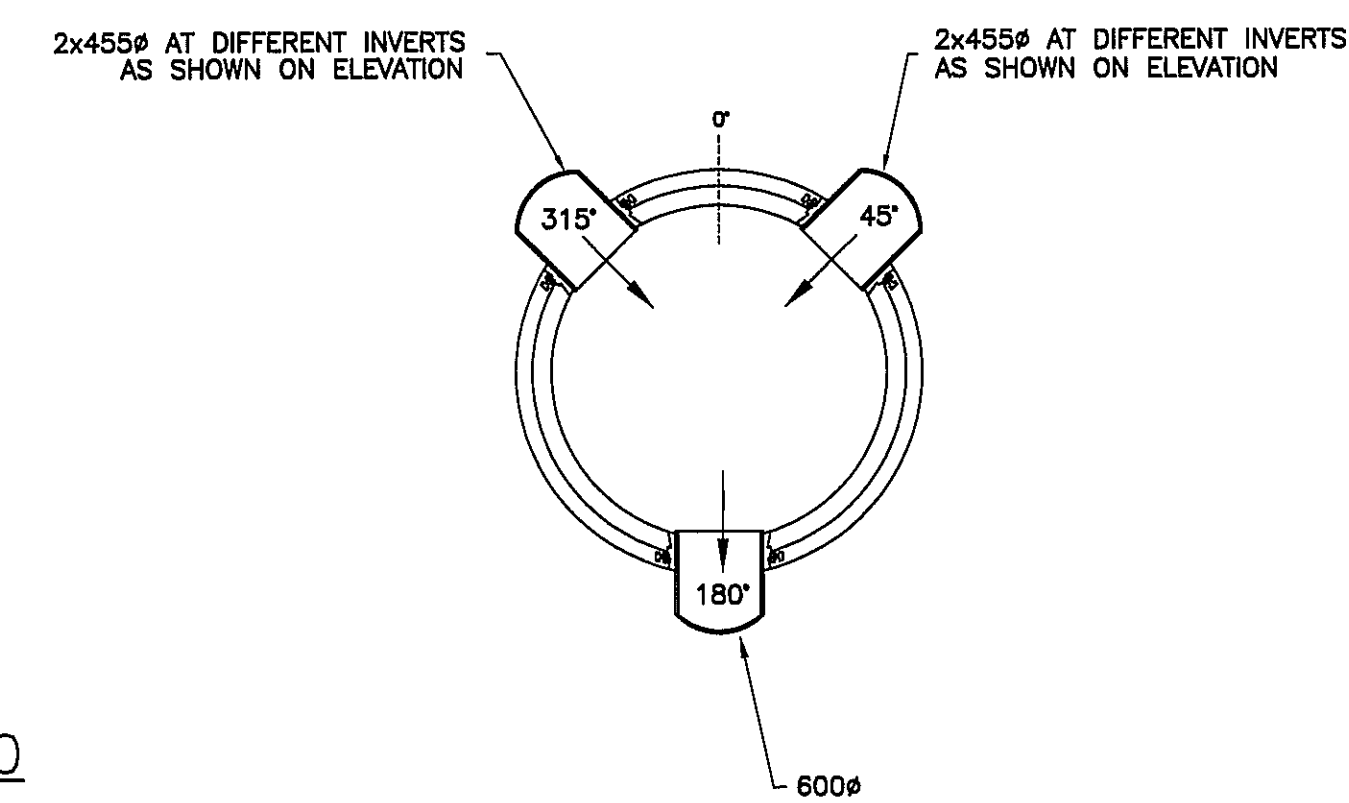

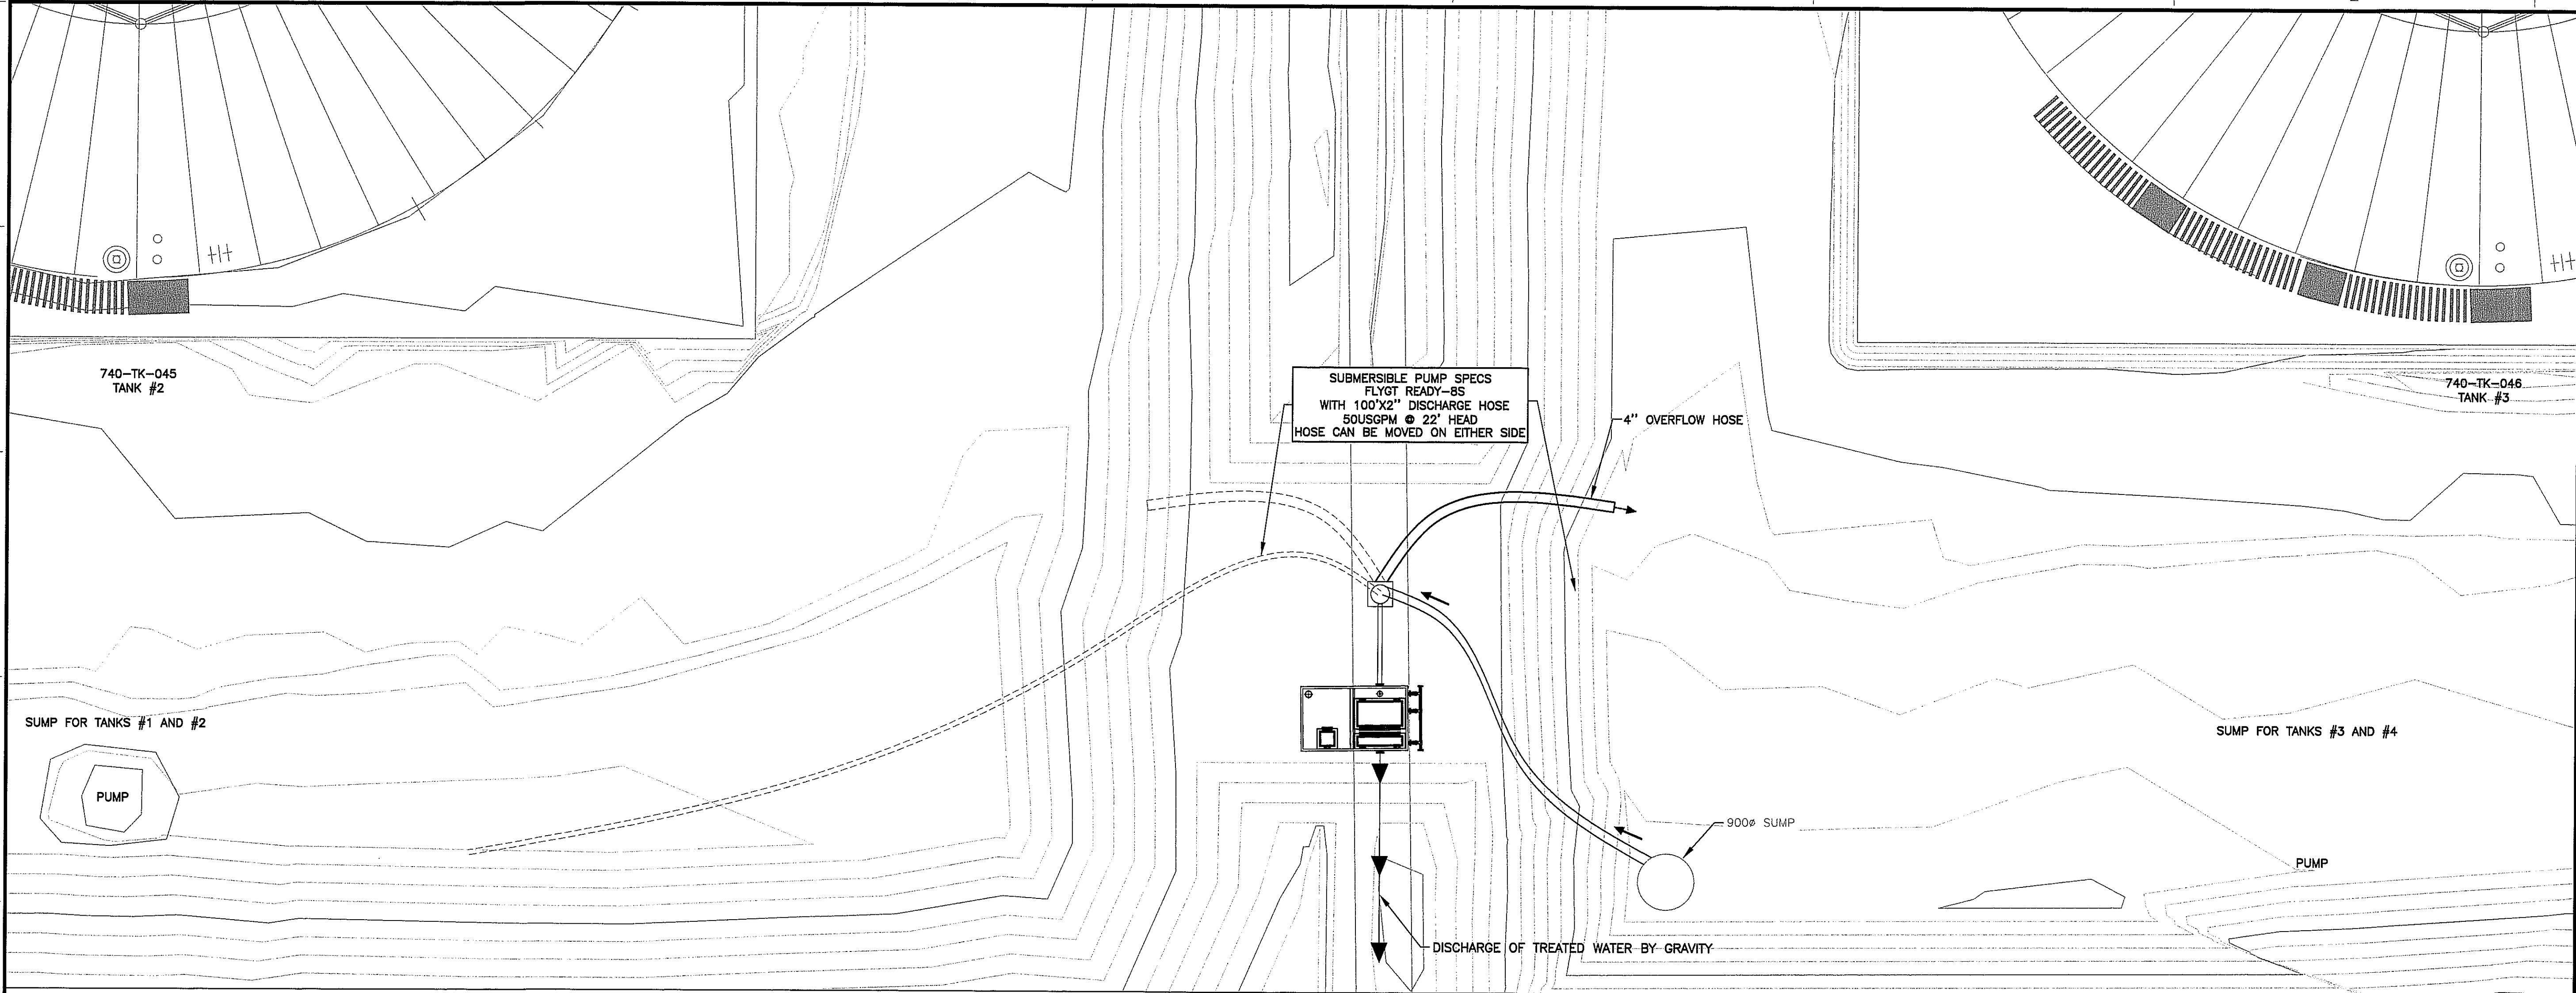

KEY PLAN

GENERAL NOTES

Groupe STAVIBEL
 Consultants en Ingénierie
 1221, 7e Rue
 Val-d'Or (Québec) J9P 3S1
 Tél: (819) 825-2233 Téléc: (819) 825-1322
 Courriel : stavibel-vd@stavibel.qc.ca
 Site Internet : www.stavibel.qc.ca

REGISTERED PROFESSIONAL ENGINEER
 B.A.P. GIARD
 LICENSEE
 NWTNNU
 2009-11-05
 License # 1-2000

TITLE	#

REFERENCE DRAWINGS

REV.	DATE	DESCRIPTION	BY	APP.	CLIENT
2	09-04-17	FOR ENVIRONMENTAL REVIEW	F.R.	P.G.	
1	08-04-03	FOR COMMENT	F.R.	P.G.	


REVISIONS



TITLE
 AGNICO-EAGLE - MEADOWBANK DIVISION
 BAKER LAKE AREA 740
 OIL WATER SEPARATOR DETAILS
 PHASE 3 (2009)


DRAWN BY	FRANCIS ROSE, TECH	DATE	2009-04-17
CHECKED BY	PATRICK GIARD, P.ENG	DATE	2009-04-17
APPROVED BY	BERTHO CARON, ENG	DATE	
SCALE	N.T.S.	DATE	2009-04-17
DRAWING NO.	VD2259-BKL-106	REVISION	2
PROJECT NO.	VD2259-2	SHEET	7 / 7

OIL-WATER SEPARATOR MODEL VTC-50AH FROM AFL INDUSTRIES

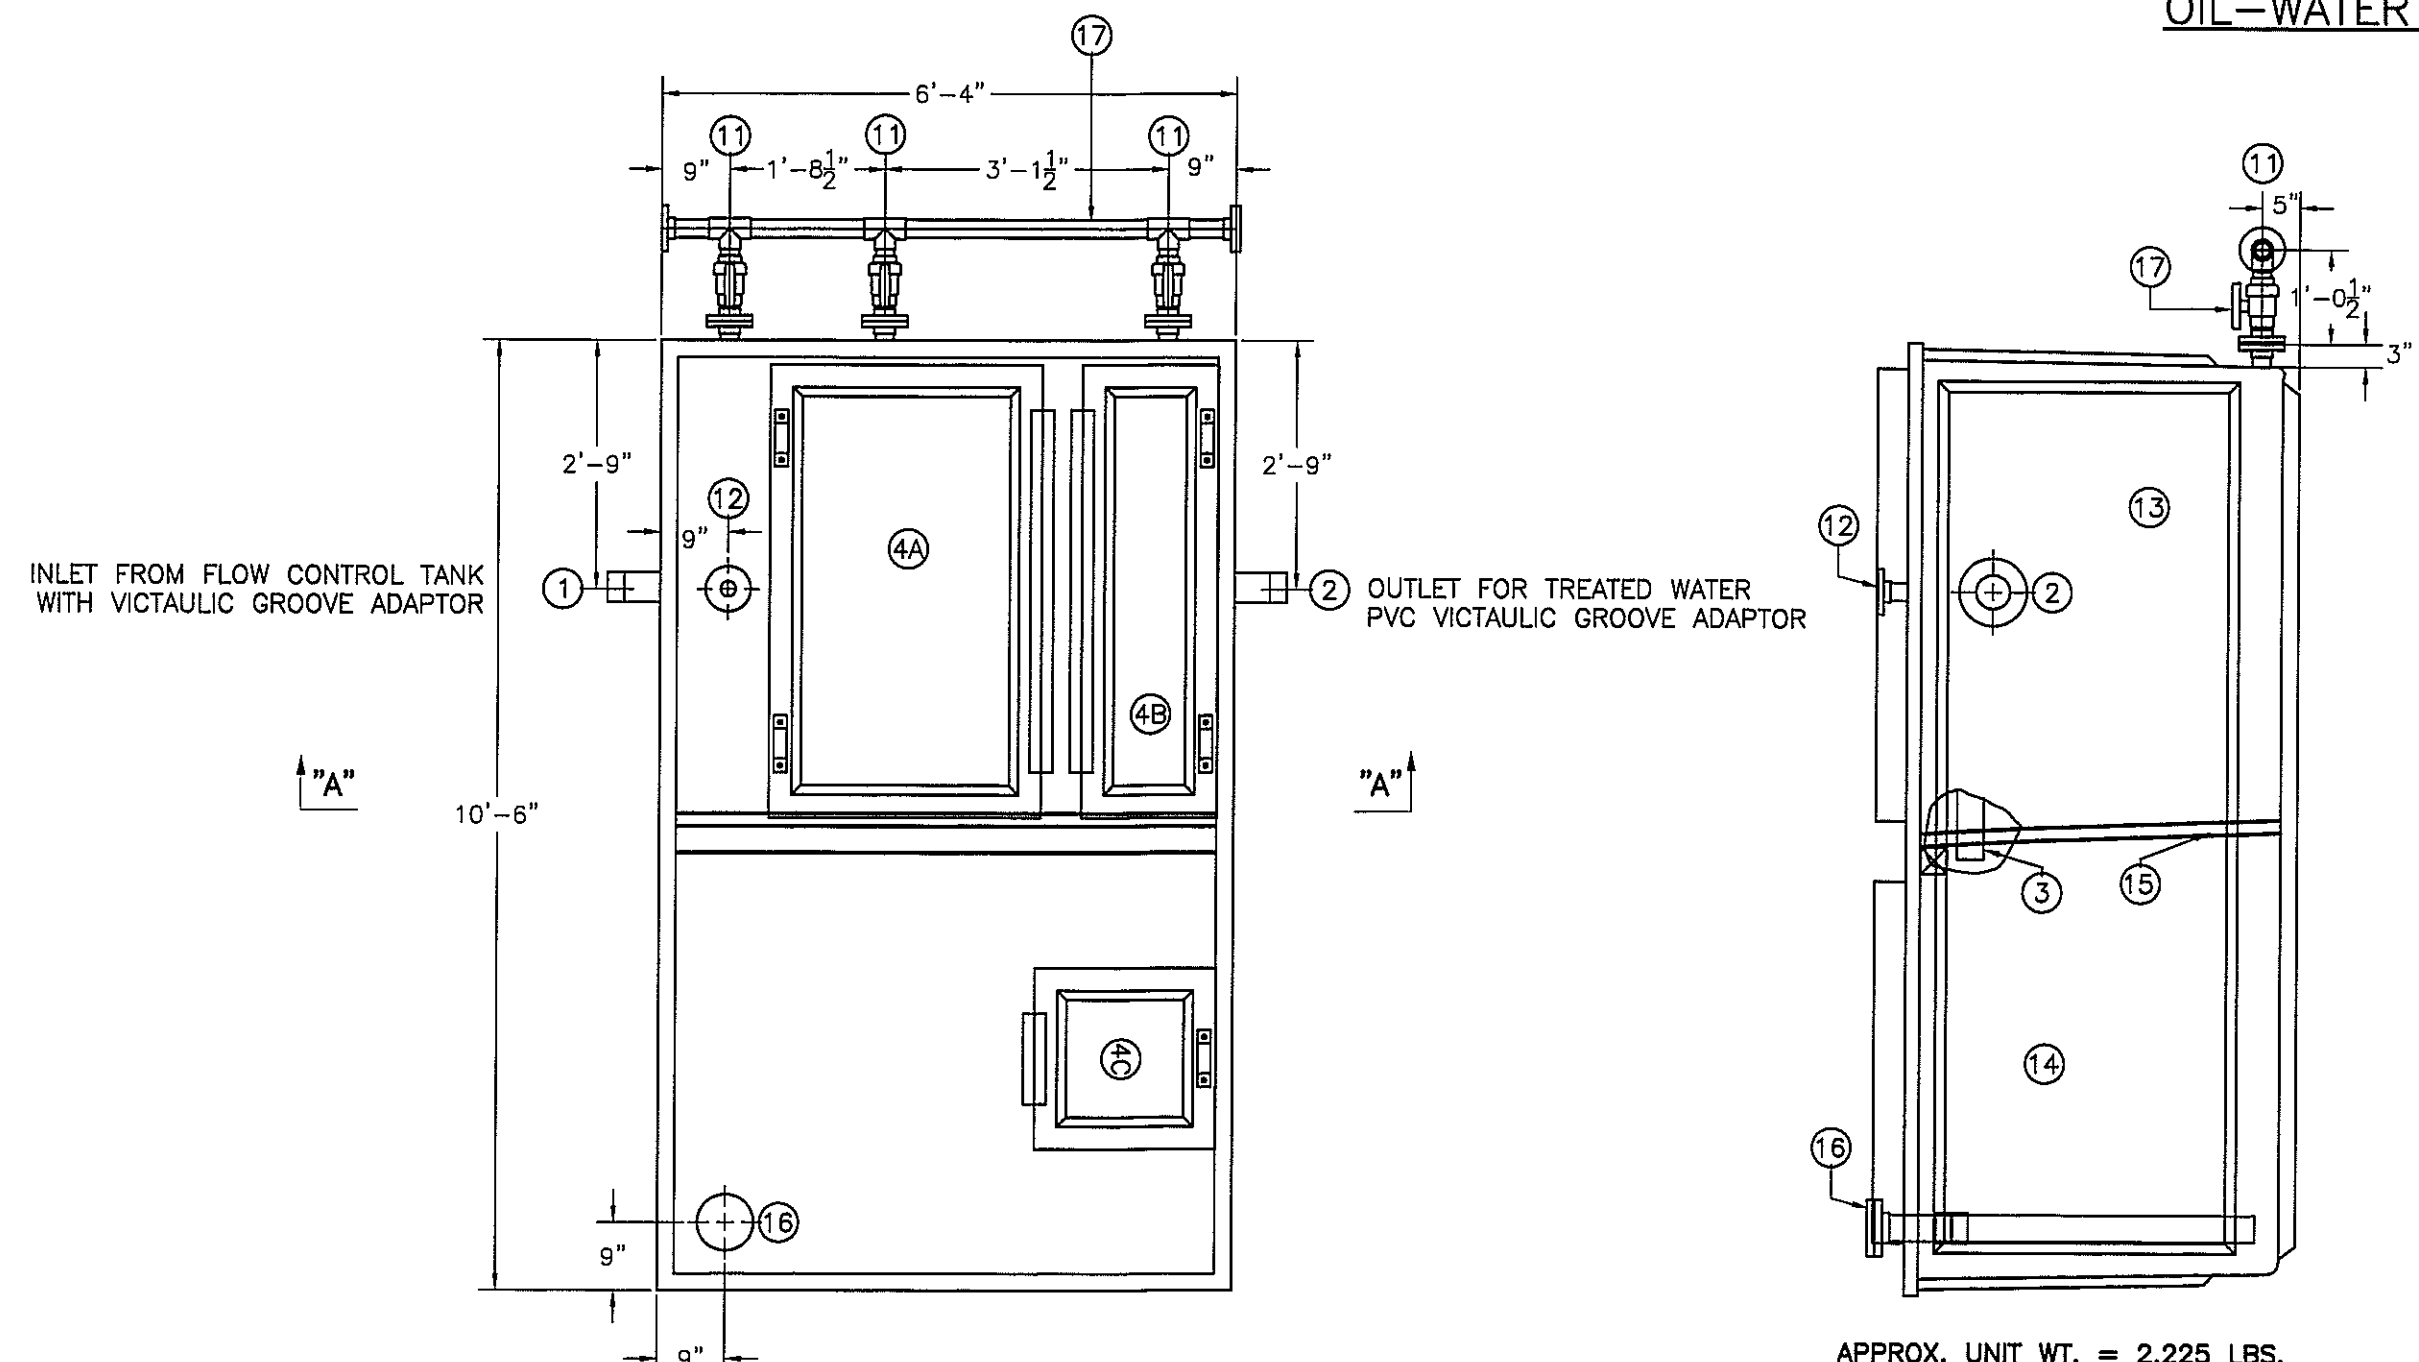

PLAN

OUTLET END ELEVATION

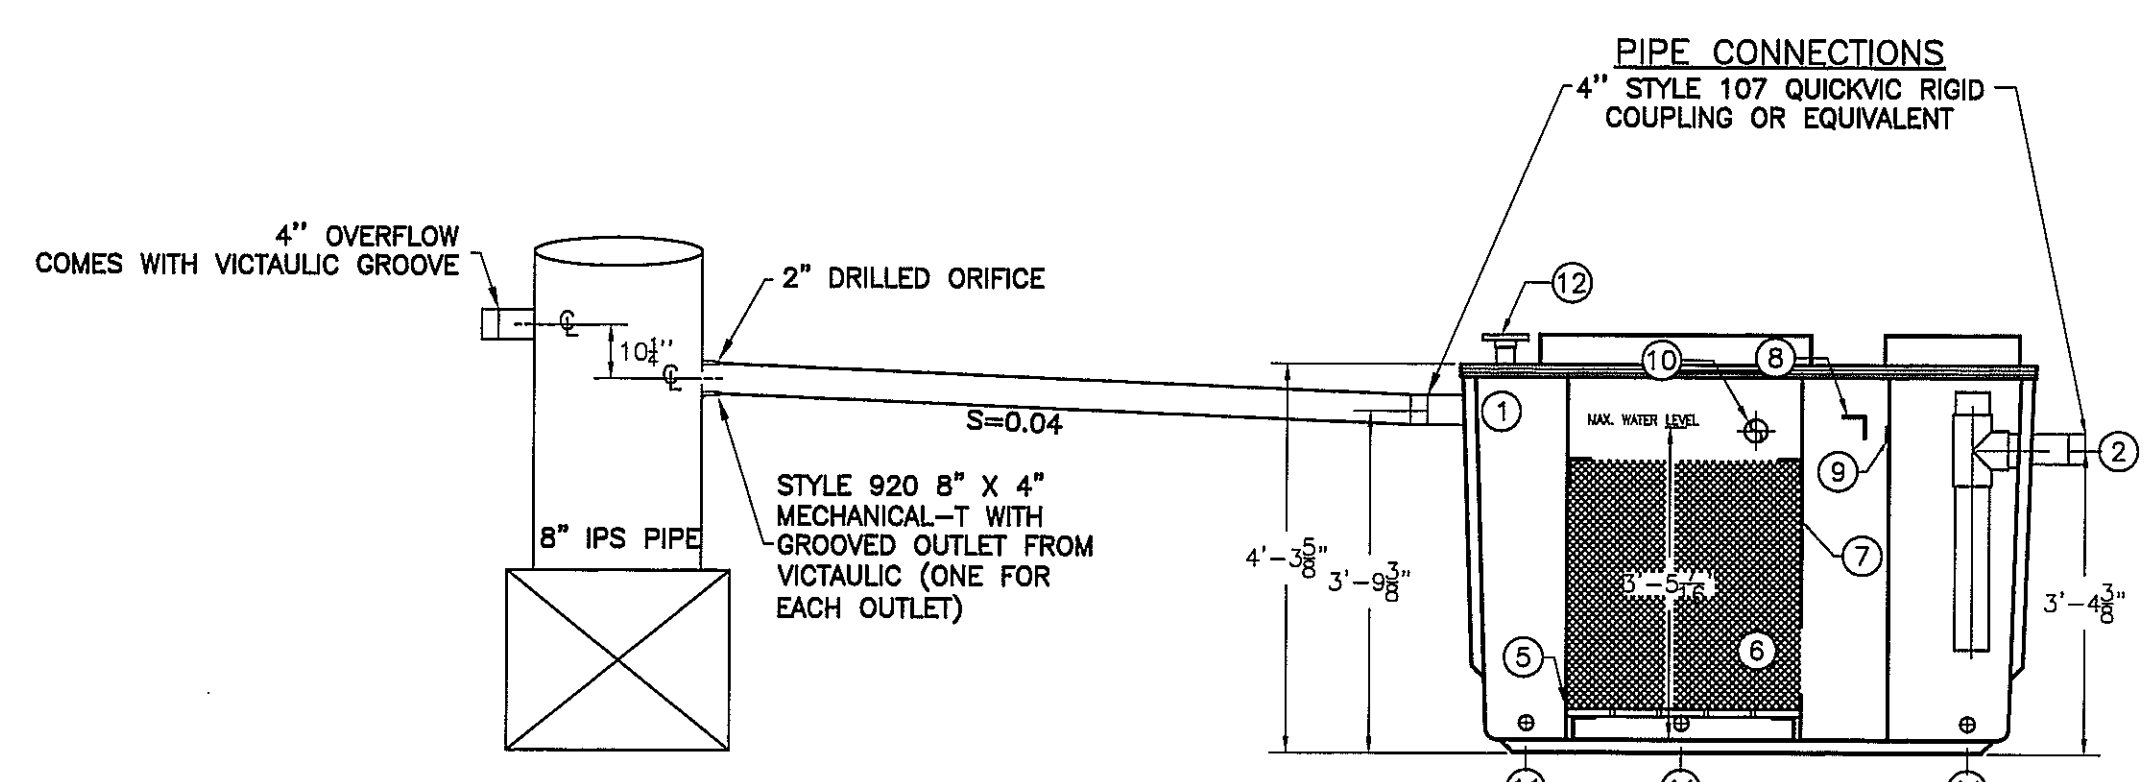

FLOW CONTROL TANK

SIDE ELEVATION

ASSEMBLY LIST

- 4" Ø INLET, PVC PIPE WITH VICTAULIC GROOVE ADAPTER
- 4" Ø OUTLET, PVC PIPE WITH VICTAULIC GROOVE ADAPTER
- 4" Ø OIL TRANSFER PIPE
- 5'-0" x 3'-0" MANWAY
- 5'-0" x 1'-6" MANWAY
- 2'-0" x 2'-0" MANWAY
- INLET BAFFLE
- VERTICAL TUBE COALESCERS
- OIL RETENTION BAFFLE
- SHEEN BAFFLE
- ADJUSTABLE OUTLET WEIR
- 4" Ø ROTARY PIPE SKIMMER
- 2" Ø DRAIN, FLANGED(3 REQ'D.)
- 2" Ø VENT, FLANGED
- VTC-50
- OIL STORAGE CHAMBER
- PARTITION WALL
- 3" Ø OIL DRAW OFF, FLANGED W/ BLIND FLANGED
- 2" Ø BALL VALVED DRAIN MANIFOLD

NOTES

- WITHOUT WRITTEN CONSENT FROM AFL INDUSTRIES, INC., DO NOT:
- DRILL HOLES OR OTHERWISE PUNCTURE THE FIBERGLASS SKINS OF THE UNIT.
- MOUNT ANY EQUIPMENT OR ACCESSORY ON THE UNIT.
- REMOVE ANY EQUIPMENT OR ACCESSORY FROM THE UNIT.
- FLOOD THE UNIT OR RESTRICT THE OUTFLOWS.
- AFL REQUIRES A FLEXIBLE COUPLING TO BE INSTALLED BETWEEN THE TANK AND CUSTOMER'S CONNECTING PIPES TO ELIMINATE EXCESSIVE LOADING ON TANK FLANGES.
- DIMENSIONAL TOLERANCE $\pm 1/2"$.
- ALL TANK FLANGES FURNISHED BY AFL ARE 150 lb. FLAT FACE FLANGES.
- ALL NOZZLE PROJECTIONS ARE 4" UNLESS NOTED OTHERWISE.
- ALL FLANGE BOLT HOLE PATTERNS TO STRADDLE CENTERLINES.