


Appendix G3


Report: Waste Rock Plug / Dike As-built

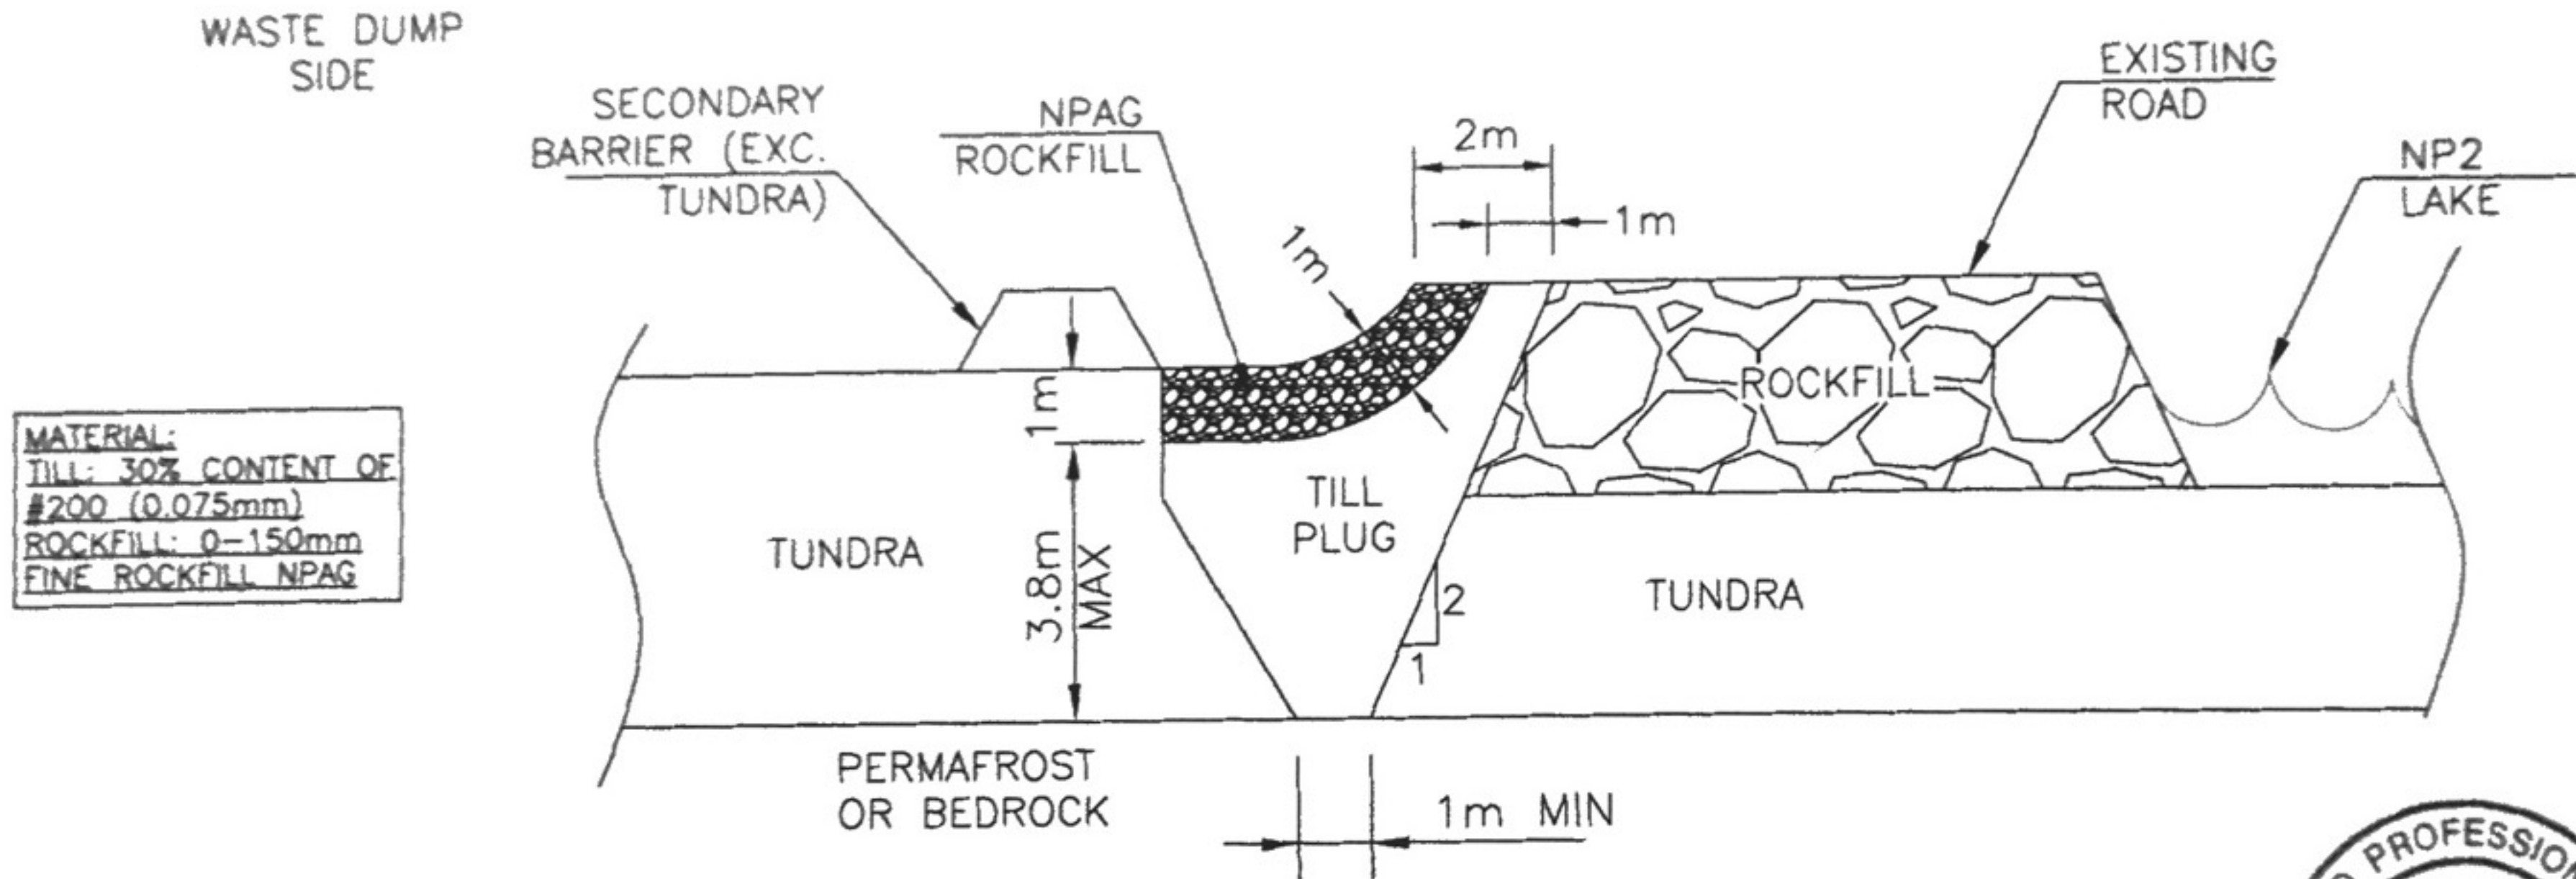

SECTION VIEW A-A



--	--	
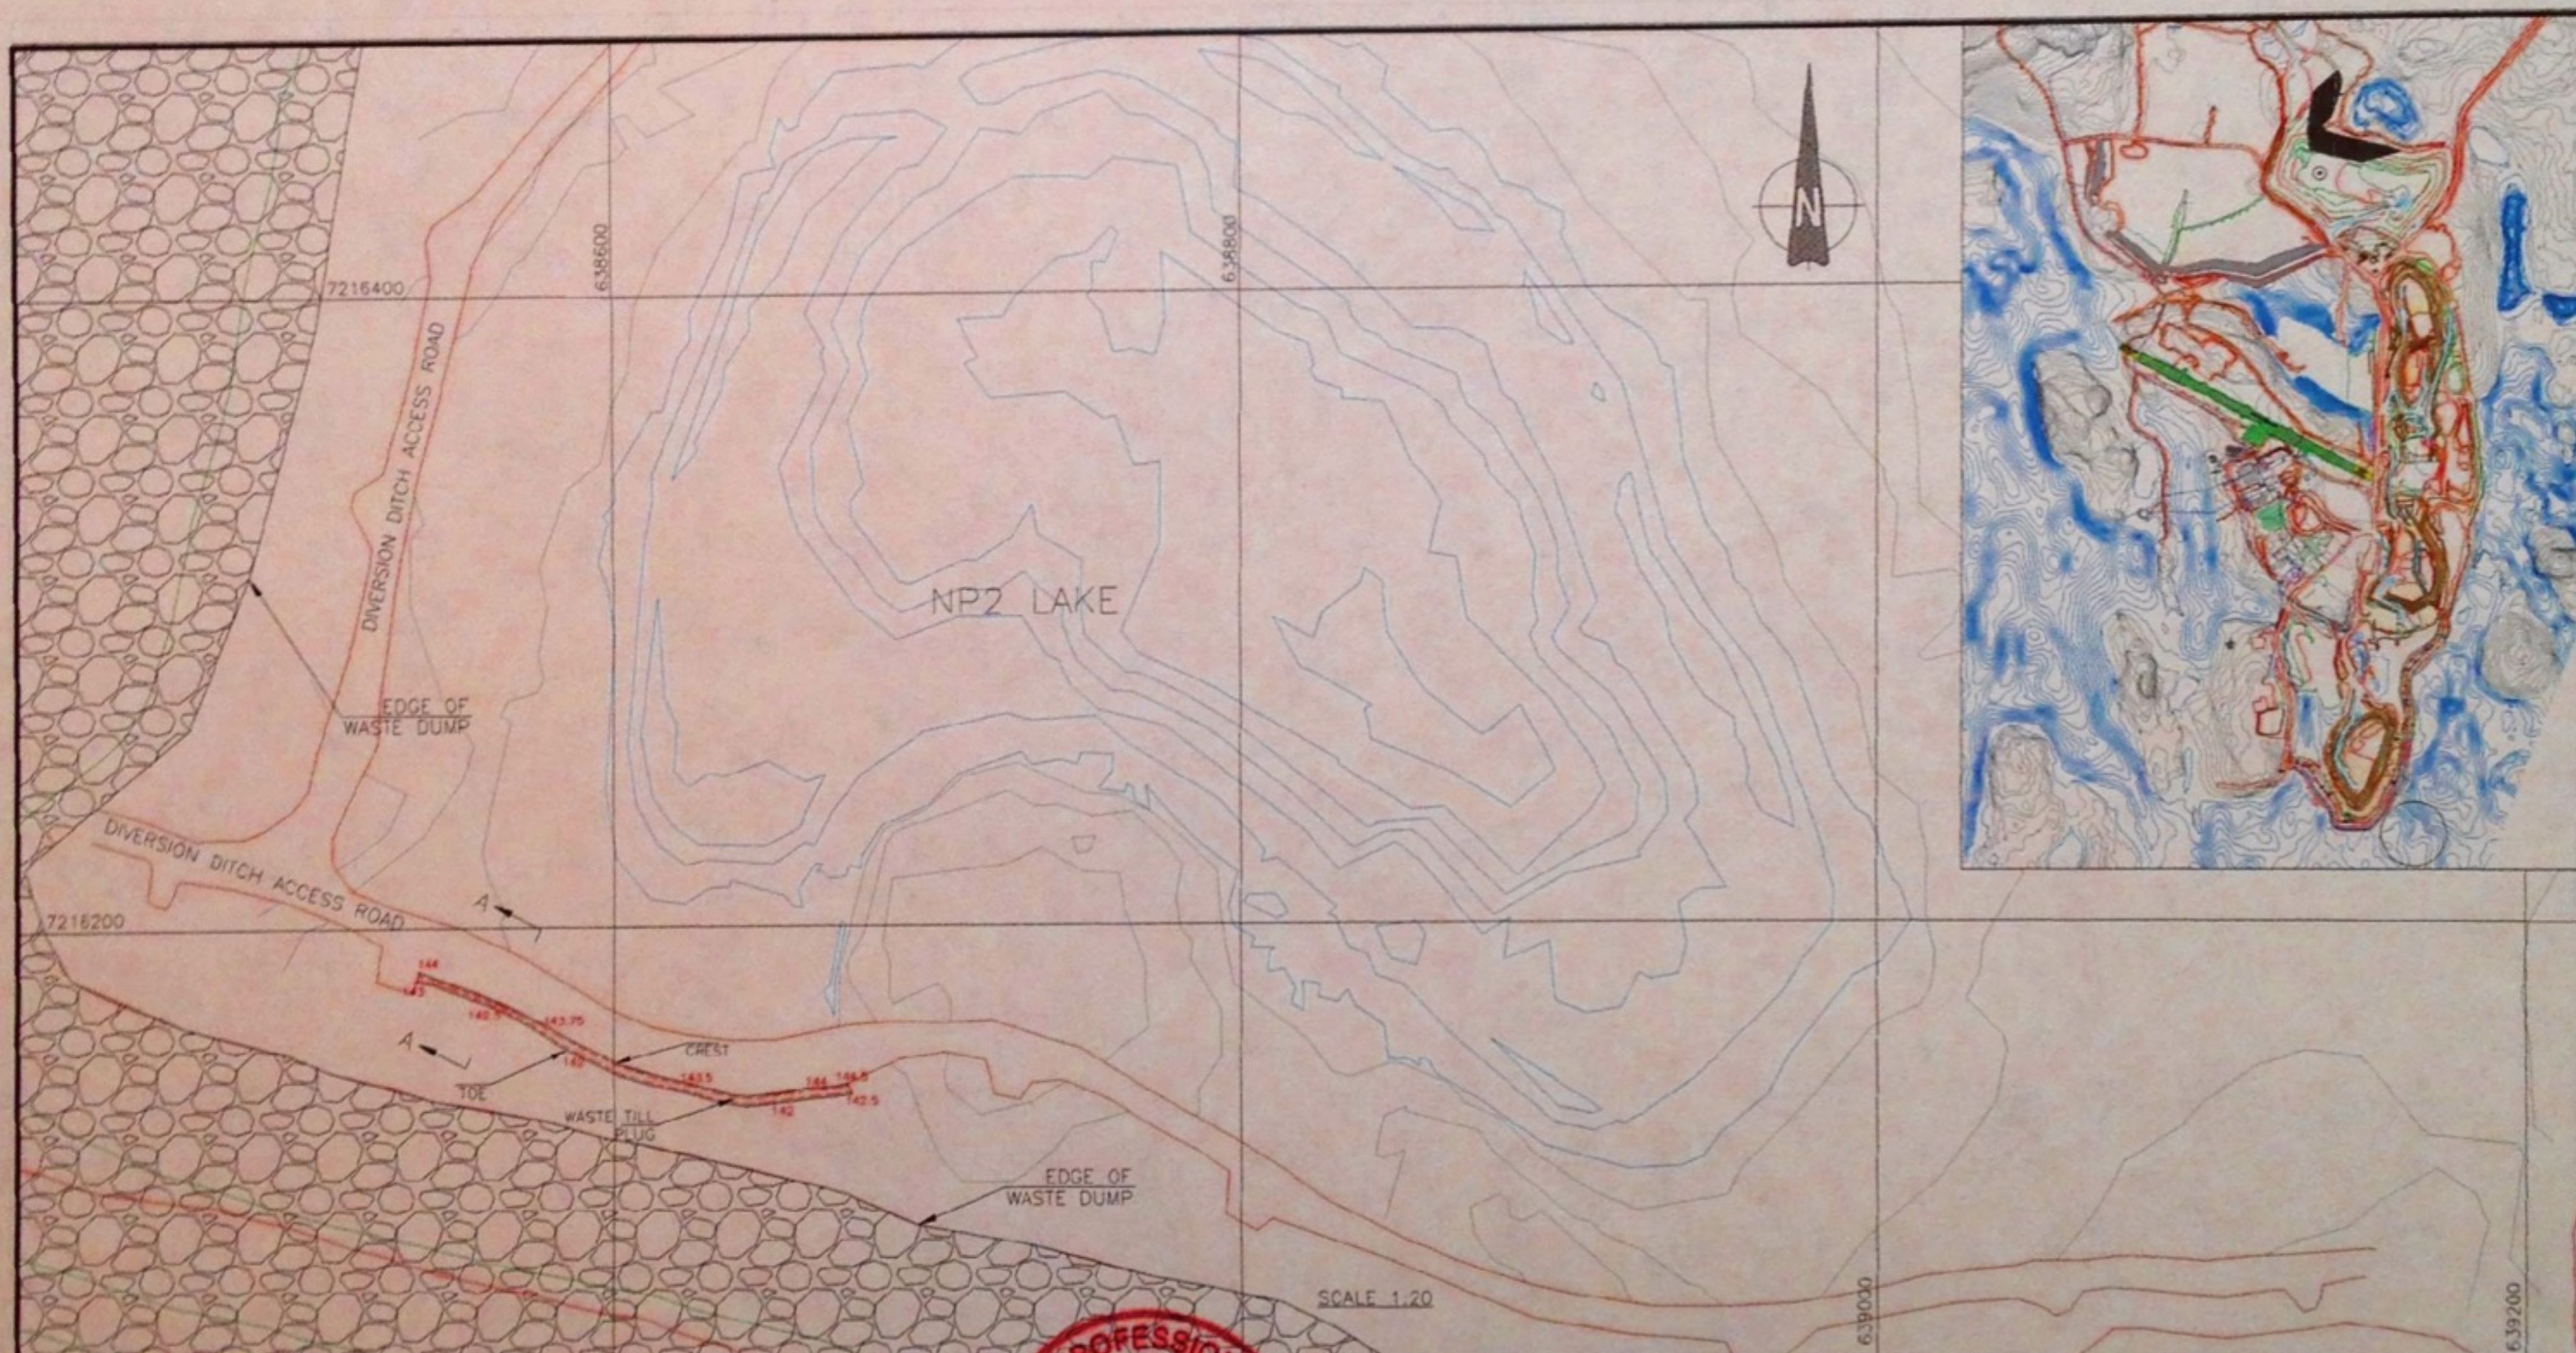

SCALE 1:20

<p>REGISTERED PROFESSIONAL ENGINEER</p> <p><i>J. Belanger</i></p> <p>J. BELANGER</p> <p>LICENSEE</p> <p>2015-03-07</p> <p>NWTNU</p>		<p>Drawn By: T. DIAHM</p> <p>Checked By: P. GAGNON</p> <p>Approved By: <i>J. Belanger</i></p> <p>Project: <i>2015/10/31/07</i></p> <p>Date:</p>		<p>Date: 2013/10/29</p> <p>Date: 2013/10/30</p>		<p>FILE</p> <p>AGNICO-EAGLE - MEADOWBANK DIVISION</p> <p>WASTE DUMP TEMPORARY TILL PLUG AS-BUILT</p> <p>SCALE: AS NOTED</p> <p>FILE: DWG</p> <p>REVISION: 1</p> <p>SHEET: 1</p>	
<p>TITLE</p> <p># DWG</p> <p>REV</p> <p>DESCRIPTION</p> <p>DATE</p> <p>BY</p>		<p>REFERENCE DRAWINGS</p>		<p>REVISIONS</p>		<p>AGNICO EAGLE</p> <p>MEADOWBANK</p>	