
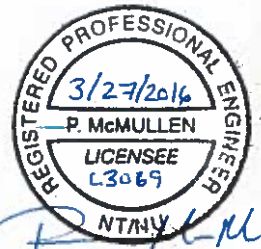
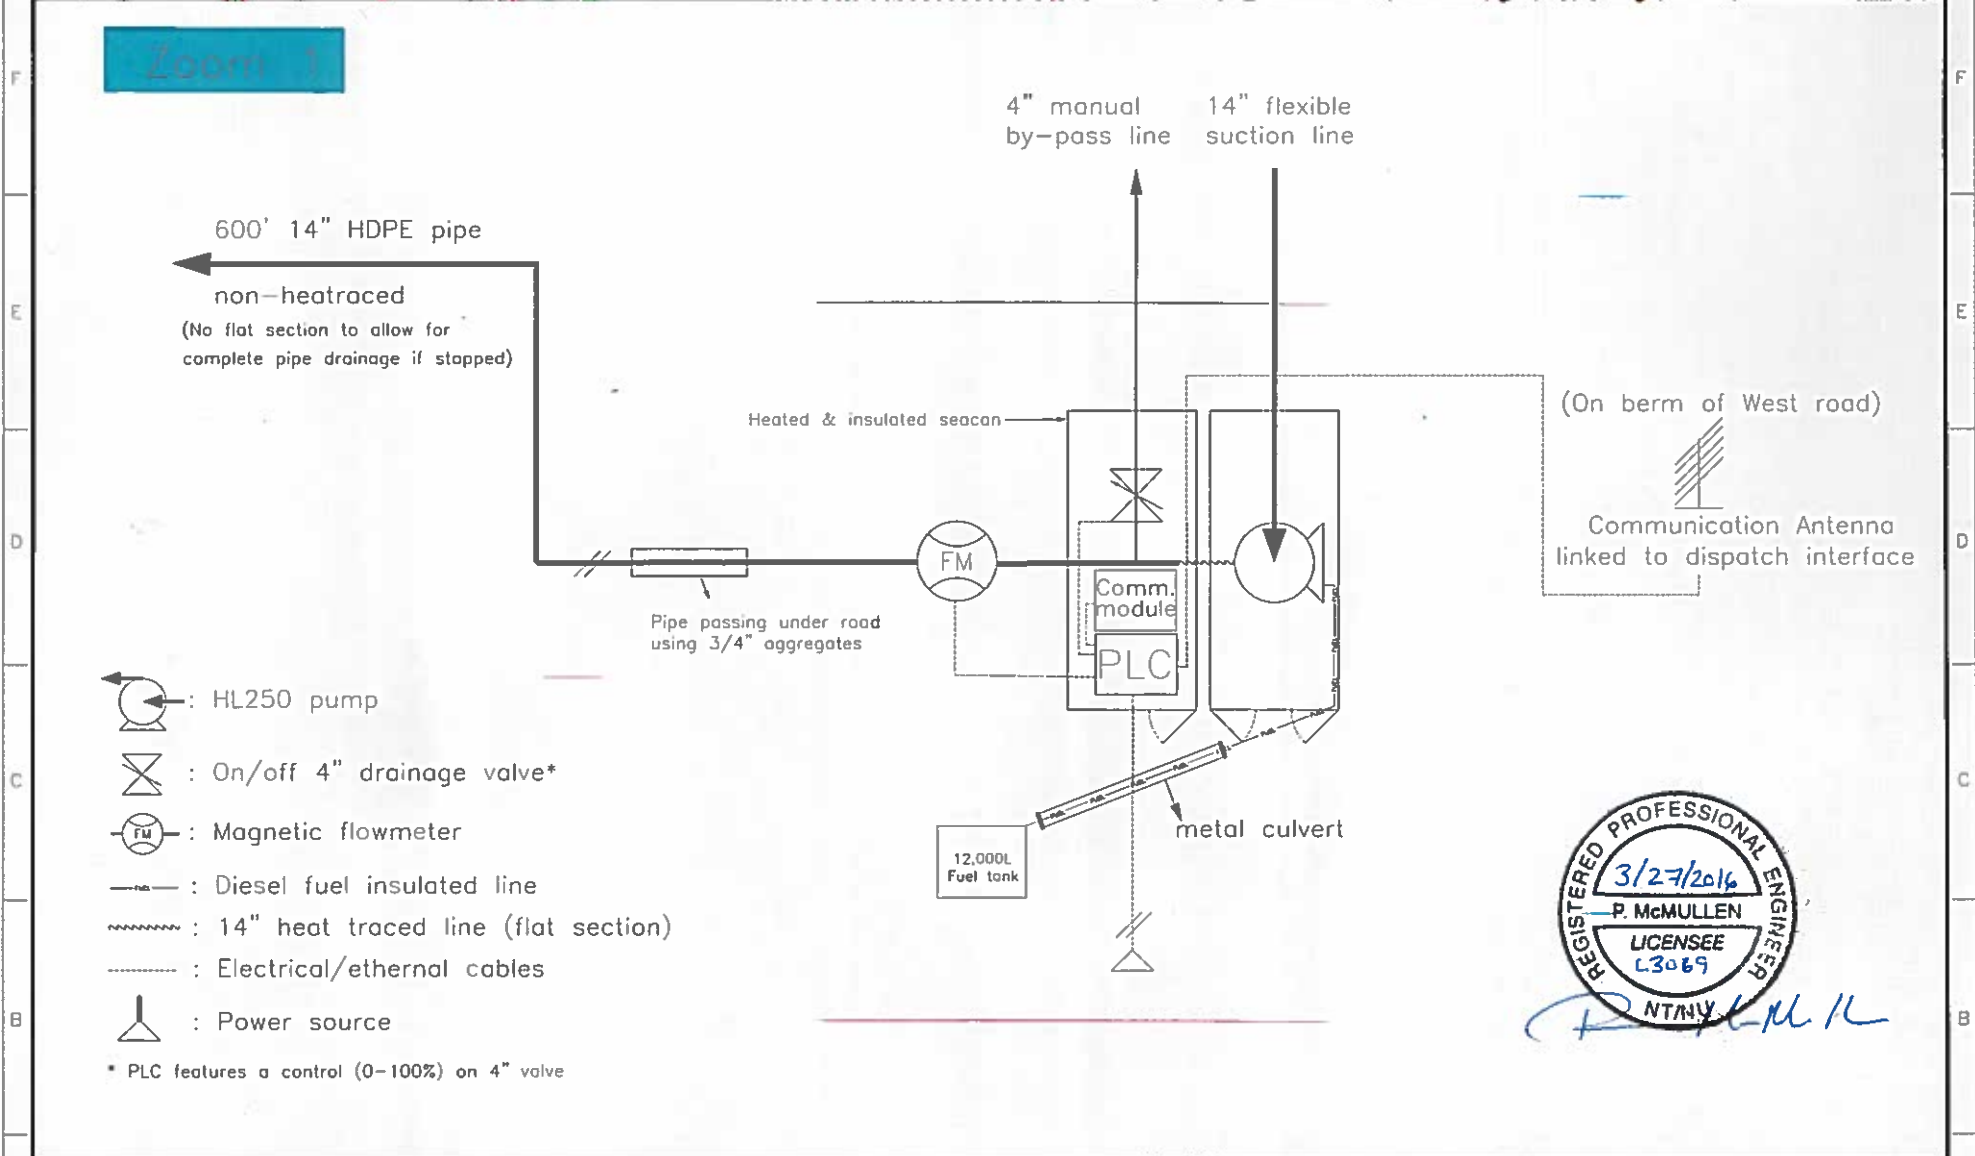


Appendix B2

Winterized Pumping System for Central Dike Seepage

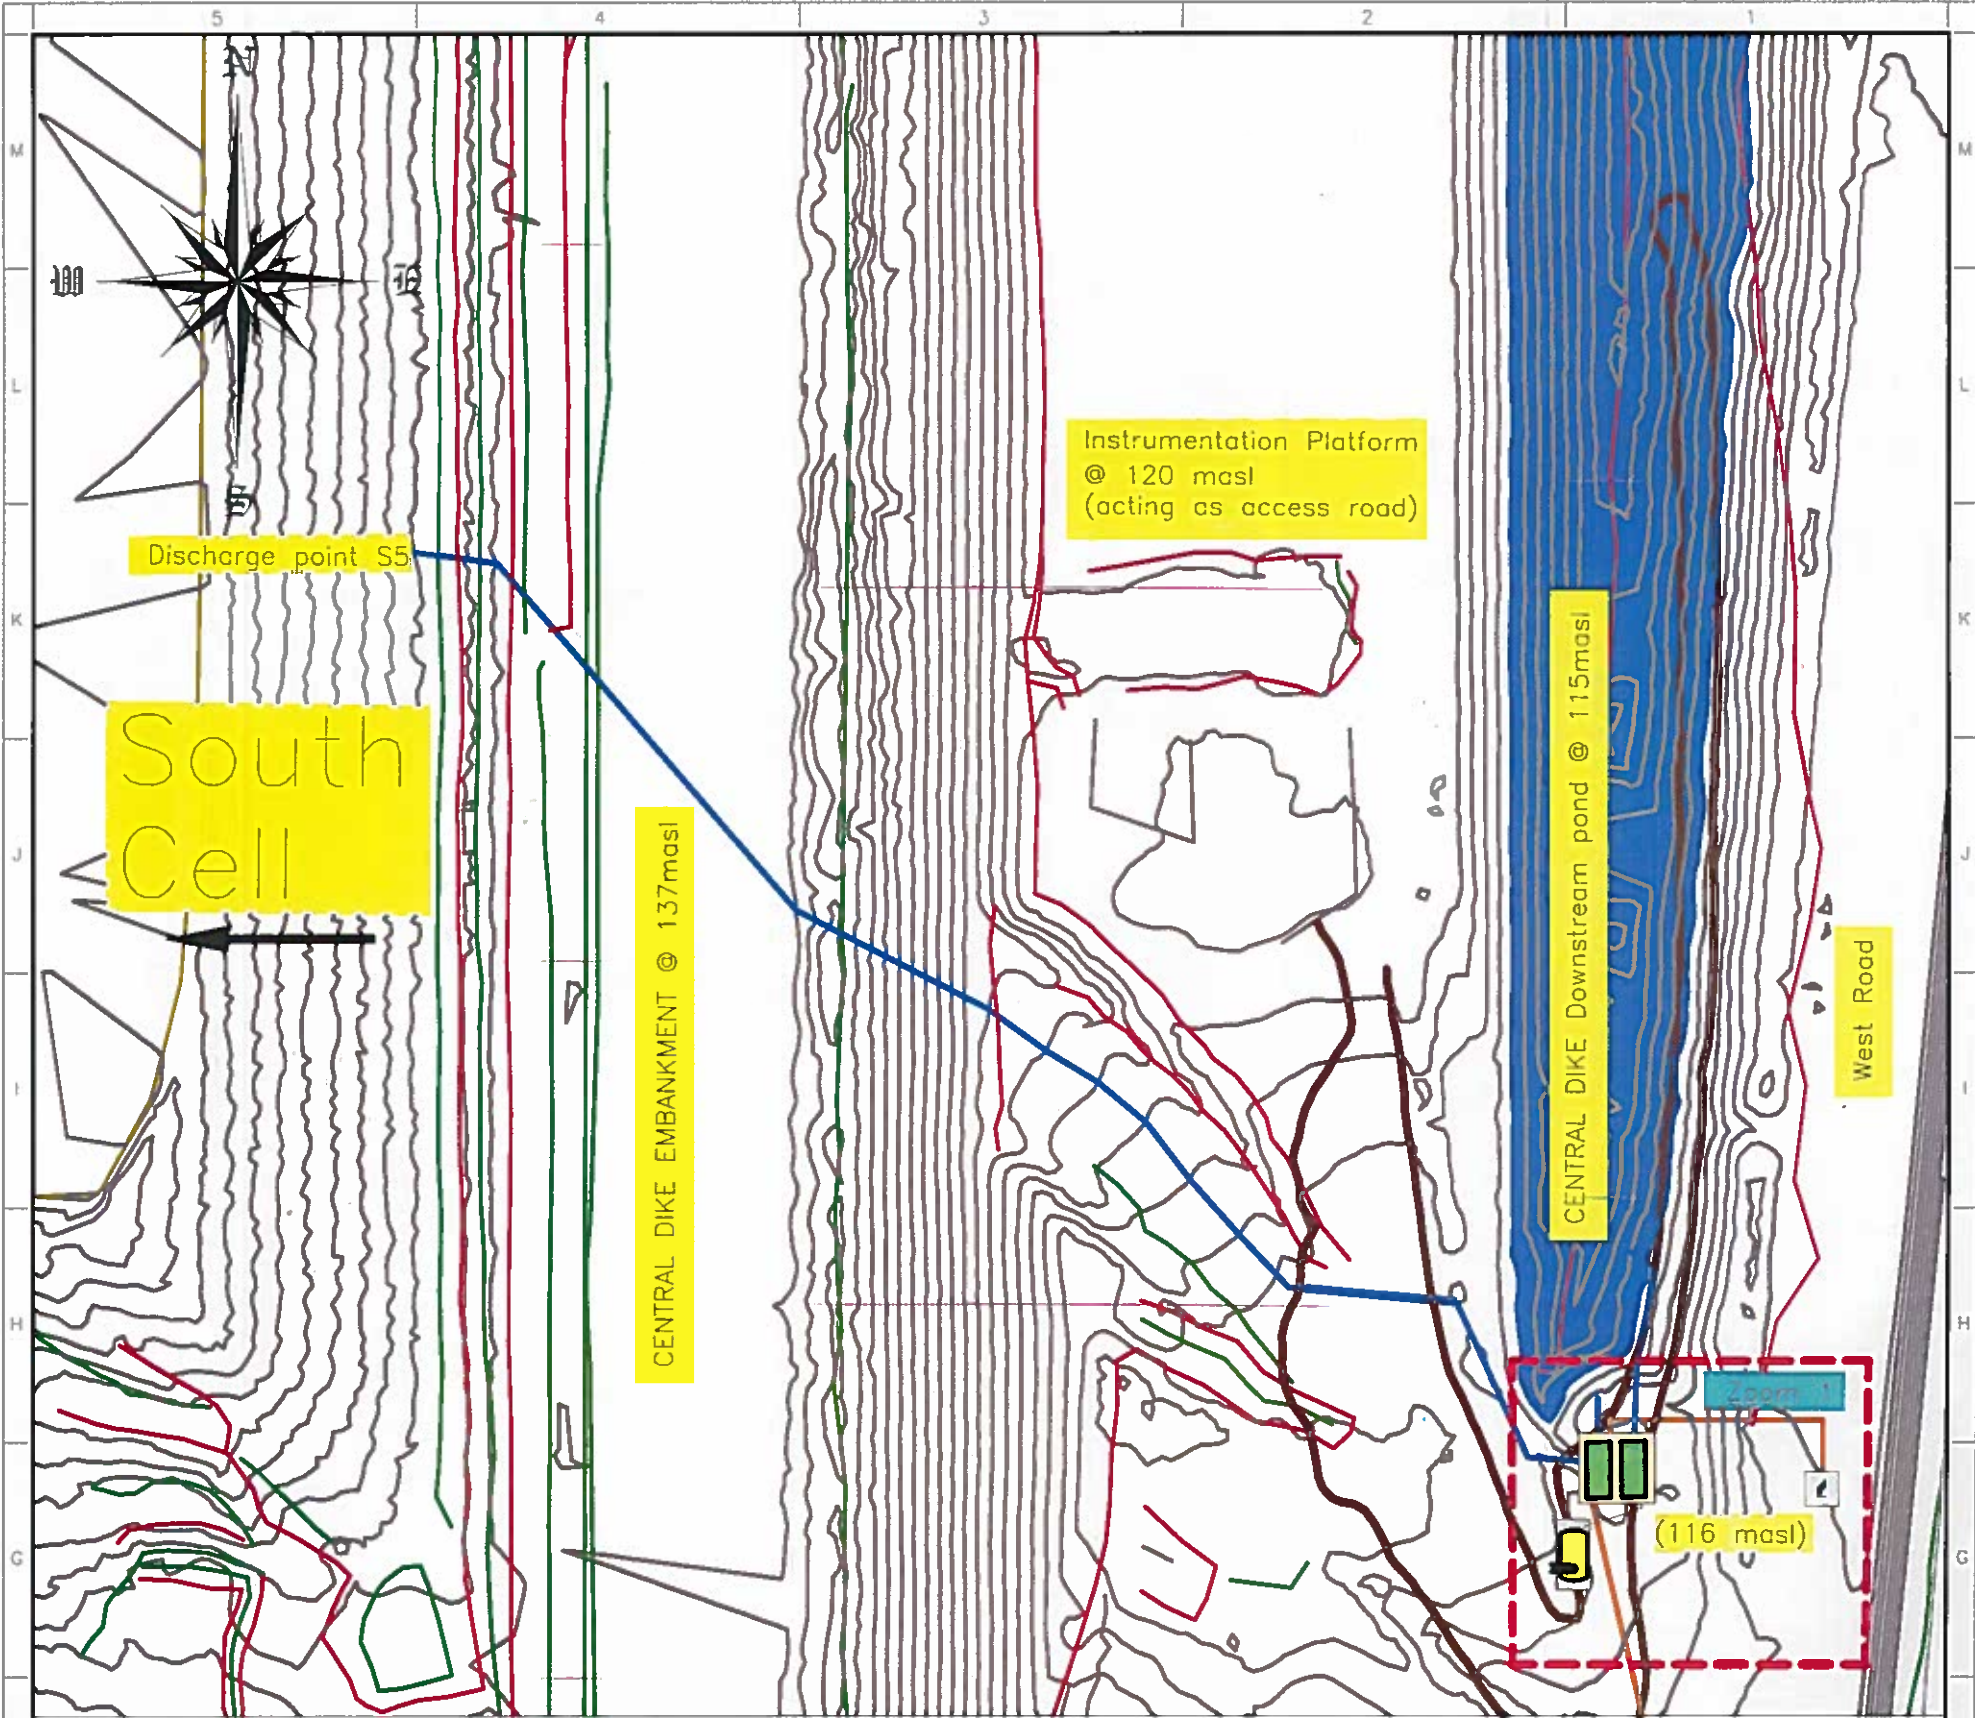

				 AGNICO EAGLE MEADOWBANK	DESIGNED BY PE McDonald		DATE 3/28/2016		SHEET AGNICO-EAGLE - MEADOWBANK DIVISION		
					CHECKED BY				Control Dike HL250 Winterization Setup - AS-BUILT		
					APPROVED BY						
					PROJECT NO.						
					DATE						
								SCALE N.T.S.		FILED .DWG	
								DRAWING NO.		REVISION	
										SHEET 1 / 1	