

2019-09-15

14:30





25.11



MLTS_6056-18731
Heat# SEE BELOW



CORPORATION

4151 North Service Road, Burlington, ON L7L 4X6 (905) 335-5320

Date: 6/5/2019

Mill Test Reports

Invoice: 1596625-00

PO: 4072649

Customer: 49300-001

A.B.F MINES INC (ROUYN NORANDA
LIVRER A EQUIPEMENT KN
8254 RANG DU VIEUX PONT
ROUYN-NORANDA, QC J9Y 0H4

Zinc	Heat#	Product	Description
2	176433	2530031	1 A333-6 STD BLK SMLS SRL
3	141352	2530074	2 A333-6 STD BLK SMLS SRL
4	610879	2530090	4 A333-6 STD BLK SMLS SRL
5	175147	2530104	6 A333-6 STD BLK SMLS SRL
5	178322	2530104	6 A333-6 STD BLK SMLS SRL
6	175142	2530112	8 A333-6 STD BLK SMLS SRL
6	175146	2530112	8 A333-6 STD BLK SMLS SRL
6	176433	2530112	8 A333-6 STD BLK SMLS SRL
6	177833	2530112	8 A333-6 STD BLK SMLS SRL

Heat codes followed by ** have been corrected, change may not show on the packing slip



Vallourec Soluções Tubulares do Brasil S.A.
Barreiro Plant - Av. Olimio Meireles, 65
ZIP 30640-010 - Belo Horizonte, MG



Inspection Certificate

(According to DIN EN 10204.3.1)

Nº.: 0030030837 / 00

Sheet: 1 / 4

Customer: VALLOUREC CANADA INC

Country: Canada

Material Number: 276243

Work Order: 531796 / 10

Customer Order: VM-4682 - P.O 4038589-400

Inspection: Vallourec Soluções Tubulares do Brasil S.A.

PRODUCT: SEAMLESS STEEL PIPE, HOT FINISHED, PLAIN ENDS, NORMALIZED

DIMENSIONS: 33,40 mm X 3,38 mm SCHEDULE: 040 GRADE: 290 # GR 1 # 6 # B

STANDARD: CSA-Z245.1-14 - CATEGORY II

IN ACCORDANCE ALSO TO THE STANDARDS: ASTM A 333M - 16 ASTM A 999M - 18 # ASTM A 106M - 18 ASTM A 530M - 12 # ASTM A 53M - 12 # ASME SA-333M - 17 ASME SA-999M - 17 # ASME SA-106M - 17 ASME SA-530M - 17

CUSTOMER SPECIFICATION: CCTF GrB.1.6.290 Cat II SS, 20.11.2017

SURFACE PROTECTION: EXTERNAL: LACQUER PIPE ENDS PROTECTOR: PLASTIC CAP

TOLERANCES: OUTSIDE DIAMETER (PIPE BODY): -0,40 mm / +0,40 mm WALL THICKNESS: -0,42 mm / +0,68 mm

TOLERANCES(PIPE ENDS): OUTSIDE DIAMETER: -0,40 mm / +0,40 mm

LENGTH: RANDOM 5486,00 mm - 6706,00 mm

STANDARD MARKING: PAINT STENCILED IN THE PIPE BODY: 531796/10 MANUFACTURER CSA-Z245.1-14 33,40 X 3,38 290 CAT II SS SHN HEAT NUMBER ASTM A/ASME SA 333, 1/6 HF SCH 040 LT-46C ASTM A/ASME SA 106 B 20700 KPA ASTM A 53 B NPS 1" X SCH 40 VSB LOGO

SHIPPING MARKING: NACE MR 0175/NACE MR 0103 - MADE IN BRAZIL * VM4682 / P.O # 4038589-00/ITEM-1 * TORONTO * CCTF

Hent	Pieces
176433	337
Total	337

THE PRODUCT IS SATISFACTORY IN THE FOLLOWING TESTS / INSPECTIONS: DIMENSIONAL # VISUAL # FLATTENING TEST # BENDING TEST # ENDS INSPECTION: UNTESTED ENDS CROPPED # HYDROSTATIC TEST: 20700,0 KPA 5 S # RESIDUAL MAGNETISM: MAX 30 GAUSS # ELECTROMAGNETIC TEST: CSAZ245.1-N10.LON/TRAN.OUT/INS # ULTRASONIC TEST FOR LAMINAR DEFECTS: ACC. CSA Z245.1-SOUR SERVICE #



Inspection Certificate

(According to DIN EN 10204 3.1)

N°.: 0030030837 / 00

Sheet 2 / 4

Chemical Composition (%)

Ceq: CSA-Z245.1-CE11

Process: Basic Oxygen Furnace, heats fully killed

Ceq: C+Mn/6+(Cr+Mo+V)/5+(Ni+Cu)/15

CE1: Cr + Cu + Mo + Ni + V

	C	Mn	P	S	Si	Ni	Cr	Mo	Al	Cu	V	Nb	B	Ti	N	Ca	Ceq	CE1
Heat Analysis		0,400			0,100													
Min	0,240	1,350	0,025	0,025	0,500	0,400	0,300	0,120		0,400	0,080	0,020	0,0010	0,110			0,400	0,430
Max																		1,000
Product Analysis		0,400			0,100													
Min	0,240	1,350	0,025	0,025	0,500	0,400	0,300	0,120		0,400	0,080	0,020	0,0010	0,110			0,400	0,430
Max																		1,000
Heat Control Lot																		
176433 030003101210	0,10	1,27	0,012	0,004	0,28	0,03	0,06	0,01	0,029	0,070	0,004	0,015	0,0004	0,002	0,0099	0,0012	0,265	0,333
Check 1	0,11	1,29	0,011	0,004	0,29	0,03	0,06	0,01	0,029	0,074	0,003	0,017	0,0003	0,002	0,0098	0,0013	0,277	0,347
Check 2	0,10	1,29	0,011	0,004	0,29	0,03	0,06	0,01	0,029	0,074	0,003	0,017	0,0003	0,002	0,0088	0,0013	0,267	0,337
																	0,267	0,337

Ceq: Carbon Equivalent; CE: Carbon Equivalent; CE: Combined Elements;

Tensile Test

Specimen Direction: Longitudinal

Method: Elong.Total Under Load 0,50 %

Temperature: Room Temperature

Wall Thickness: 3,38 mm

Gage Length: L0=2"

Type of Specimen

Required: Min
MaxArea
(MM2)YS
(MPA)TS
(MPA)E
(%)

Heat Control Lot

176433 030003101210

YS-Yield Strength; TS-Tensile Strength; E-Elongation;

Hardness Test Through Wall

Scale: HV

Individual

Required: Min
Max

246,0

MW1 MW2 MW3 Avg

Heat Control Lot

176433 030003101210

MW - Middle Wall;

Q1 160,0 159,0 162,0 160,3



Inspection Certificate

(According to DIN EN 10204.3.1)

N°.: 0030030837 / 00

Sheet:3 / 4

Impact Test

Test Specimen: CHARPY 10X55X2.5 V NOTCH

Direction: Longitudinal				Temperature: -55°C				Striker radius: 8 mm							
AE1	AE2	AE3	AE4	AE5	AE Avg	SA1	SA2	SA3	SA4	SA5	SA Avg	LE1	LE2	LE3	LE Avg
(J)	(J)	(J)	(J)	(J)	(J)	(%)	(%)	(%)	(%)	(%)	(%)	(Mils)	(Mils)	(Mils)	(Mils)
7	7	7	7	7	7	50	50	50	50	50	60				
Required: Min															
Max															



HEAT: 176433 CCTF Sku: 2530031 1 A333-6 STD BLK SMLS SRL Invoice: 1596625-00 PO: 4072649 6/5/2019 12:50:19 PM



Inspection Certificate
(According to DIN EN 10204 3.1)

N°.: 0030030837 / 00

Sheet: 4 / 4

We hereby certify that this product has been manufactured and examined in accordance with all requirements of the standards and specifications and all the results are found to be satisfactory. This testimonial and certificate respectively is recorded by a computer system and is valid without signature. Alteration or use for others products are regarded as falsification of documents and will be subject to criminal jurisdiction.

QUALITY CONTROL DEPARTMENT

FAX: (55-31) 3328-2773

e-mail: luis.silva@vallourec.com

DATE

11.20.2018


ENG. LUIZ FERNANDO DA SILVA - CREA/MG 58834-D
TECHNICAL RESPONSIBLE



Vallourec Soluções Tubulares do Brasil S.A.
Barcelos Plant - Av. Olimo Meireles, 65
ZIU 306-40-010 - Belo Horizonte, MG



Inspection Certificate
(According to DIN EN 10204.3.1)
Nº: 0030023868 / 00

Sheet: 1 / 3

Customer: VALLOUREC CANADA INC

Country: Canada

Material Number: 273193
Work Order: 509784 / 10
Customer Order: VM4238/P.O # 4037205-00

Inspection: Vallourec Soluções Tubulares do Brasil S.A

PRODUCT: SEAMLESS STEEL PIPE, HOT FINISHED, BEVELED ENDS 30 DEG., NORMALIZED
DIMENSIONS: 60.30 mm X 3.90 mm SCHEDULE: 040 GRADE: 290 # 6 # GR 1
STANDARD: CSA-Z245.1-14 - CATEGORY II
IN ACCORDANCE ALSO TO THE STANDARDS: ASTM A 333M - 16 ASTM A 995M - 16 # ASME SA-333M - 15
SURFACE PROTECTION: EXTERNAL: LACQUER PIPE ENDS PROTECTOR: PLASTIC CAP
TOLERANCES: OUTSIDE DIAMETER (PIPE BODY): -0.60 mm / +0.60 mm WALL THICKNESS: -0.49 mm / +0.78 mm
LENGTH: RANDOM 5486.00 mm - 6706.00 mm
STANDARD MARKING: Paint stenciled in the pipe body: 509784/10 MANUFACTURER CSA-Z245.1-14 60.30 X 3.90 290 CAT II SS 3 IN LENGTH HEAT NUMBER ASTM A333 1/6 11P SCH 040 LT .46C NACE MR
0175/NACE MR 0103 VSIR LOGO
SHIPPING MARKING: MADE IN BRAZIL * VM4238 / P.O # 4037205-00 * VANCOUVER
TOLERANCES/PIPE ENDS: OUTSIDE DIAMETER: -0.40 mm / +0.80 mm


Heat	Pieces
141352	122
Total	122

THE PRODUCT IS SATISFACTORY IN THE FOLLOWING TESTS / INSPECTIONS: DIMENSIONAL # VISUAL # FLATTENING TEST # ENDS INSPECTION : UNTESTED ENDS CROPPED # HYDROSTATIC TEST: 20700.0 KPA
5 S # RESIDUAL MAGNETISM: MAX 30 GAUSS # TESTE ELETROMAGNETICO : ACCORDING TO CSA Z245.1 # ULTRASONIC TEST FOR LAMINAR DEFECTS: ACC. CSA Z245.1-SOUR SERVICE #

Chemical Composition (%)

Ceq: CSA-Z245.1-CE11		CE1: Min/C														
		C	Mn	P	S	Si	Ni	Cr	Mo	Cu	V	Nb	B	Ti	Ceq	CE1
Heat Analysis	Min		0.400			0.100										3.000
	Max	0.240	1.350	0.025	0.025	0.500	0.400	0.300	0.120	0.400	0.080	0.020	0.0010	0.110	0.400	
Product Analysis	Min		0.400			0.100										3.000
	Max	0.240	1.350	0.025	0.025	0.500	0.400	0.300	0.120	0.400	0.080	0.020	0.0010	0.110	0.400	
Heat	Control Lot															
141352	030002389902	0.10	1.32	0.020	0.001	0.31	0.01	0.07	0.03	0.010	0.006	0.015	0.0002	0.002	0.342	13.290
Check 1		0.10	1.32	0.020	0.001	0.31	0.01	0.07	0.03	0.012	0.006	0.016	0.0002	0.002	0.343	12.941
Check 2		0.10	1.32	0.020	0.001	0.31	0.01	0.07	0.03	0.012	0.006	0.016	0.0002	0.002	0.343	12.816

Ceq: Carbon Equivalent; CE: Combined Elements;

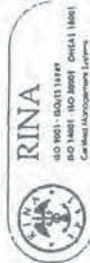

Inspection Certificate

(According to DIN EN 10204, 3, 1)

N°.: 0030023868 / 00

Sheet: 2 / 3

Tensile Test

Specimen Direction: Longitudinal

Temperature: Room Temperature

Gage Length: 10±2"

Type of Specimen

Method: Elong. Total Under Load 0.50 %

YS (MPa) (NPA) TS (MPa) (NPA) E (%)

290 415 625

Required: Min
Max

Heat Control Lot
141352 030002889902

STRIP WIDTH 19.05 MM

406 517 37

YS-Yield Strength; TS-Tensile Strength; E-Elongation;

Hardness Test Through Wall

Scale: HV

Individual AE2 AE3

Required: Min
Max

246.0 MW1 MW2 MW3 Avg
Q1 163.0 166.0 160.0 163.0

Heat Control Lot
141352 030002889902

MW - Middle Wall;

Impact Test

Test Specimen: CHARPY 10X55X2.5 V

Direction: Longitudinal

Temperature: -57°C

Striking tip: 8 mm

NOTCH

AE1 AE2 AE3 AE4 AE5 AE Avg
(J) (J) (J) (J) (J) (J)
Required: Min 4 4 4 4 4 5
Max


Heat Control Lot
141352 030002889902

AE - Absorbed Energy;

Remarks:

1. MATERIAL IN ACCORDANCE WITH NACE MR 0175
PAR. 3.2/ISO 15156-2, ANNEX A.2.1.2/NACE MR0103 PAR.2.1. ALL LATEST EDITIONS.

2. SKU 2530074

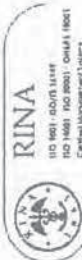

Inspection Certificate
(According to DIN EN 10204.3.1)

Nº.: 0030023868 / 00

Sheet 3 / 3

3. - MATERIAL SOUR SERVICE AS DEFINED IN PARAGRAPH 16 OF CSA Z245.1. BUT WITHOUT HIC TEST

4. MATERIAL:
- NO WELD REPAIR
 - FREE OF MERCURY
 - FINE GRAIN PRACTICE
 - FULLY KILLED STEEL
 - MATERIAL FROM BRAZIL

We hereby certify that this product has been manufactured and examined in accordance with all requirements of the standards and specifications and all the results are found to be satisfactory. This testimonial and certificate respectively is recorded by a computer system and is valid without signature. Alteration or use for others products are regarded as falsification of documents and will be subject to criminal jurisdiction.	QUALITY CONTROL DEPARTMENT FAX: (55-31) 428-2617 e-mail: guslavo.junior@vallourec.com	DATE: 08.14.2017 DR. GUSTAVO ALVES JUNIOR TECHNICAL RESPONSIBLE
--	---	--

Eco TUBES: The tubes from Vallourec do Brasil S.A. are manufactured with steel which uses charcoal as a source of energy in its production. This coal comes from more than 100,000 ha of forest planted by Vallourec Florestal Ltda. With the acquisition of 4.6 tons of steel tubes from Vallourec do Brasil S.A., your company contributed to the reduction of the greenhouse effect, avoiding the accumulation of 8.3 tons of Carbon Dioxide CO2 in the atmosphere.

Benteler Steel/Tube GmbH

Postfach 13 40
33043 Paderborn
Deutschland

Tel.: + 49 5254.81-0 Fax: + 49 5254.13666



Steel/Tube

ABNAHMEPRÜFZEUGNIS EN 10204-3.1

INSPECTION CERTIFICATE EN 10204-3.1

CERTIFICAT DE RECEPTION EN 10204-3.1

EN 10204:2005-01

Benteler Steel/Tube GmbH · Postfach 1340 · 33043 Paderborn · Deutschland

CCTF Corporation
Unit 2 4151 North Service Road
BURLINGTON, ON ON L7L 4X6
CANADA

65-1069887/001/E

Dokument-Nr.:

No. du document :

Kunden-Bestell-Nr.:

Purchase Order No.:

No. de commande du client:

Benteler Auftrags-Nr.:

Benteler Order No.:

No. de commande Benteler:

Versandanzeigen-Nr.:

Dispatch Note No.:

No. d'avis d'expédition:

Produkt: NAHTLOSE STAHLROHRE

Product: SEAMLESS STEEL TUBES

Produit: TUBES D'ACIER SANS SOUDURE

Warmrohrwerk Dinslaken

(DIN EN ISO 9001, ISO/TS-16949 CERTIFIED BY TÜV NORD CERT)

(PED 2014/68/EU CERTIFIED BY TÜV NORD SYSTEMS)

Herstellerzeichen:

Manufacturer's brand:

Marque du producteur:

Stempel des Abnahmebeauftragten: WA

Stamp of the inspection representative:

Poinçon du contrôleur:

Stahlschmelzungsverfahren: ELEKTROSTAHL

Steelmaking process: ELECTRIC FURNACE

Procédé d'élaboration de l'acier: FOUR ELECTRIQUE

Lieferbedingungen:

Terms of delivery:

Conditions de livraison:

Masse - Toleranzen:

Dimensions-tolerances:

Dimensions-tolerances:

Stahlsorte:

Steel grade:

Nuance d'acier:

Lieferzustand:

Delivery condition:

État de livraison:

Produktkennzeichnung:

Product marking:

Marquage du produit:

ASTM-A 106-2015, ASTM-A 333-2016-HF, ASME SA-106, ASME BPVC.II.A-2017, ASME SA-333-HF, ASME

BPVC.II.A-2017, CSA Standard Z245.1-14 Category II, Sour Service, ANSI/NACE MR0175/ISO 15156-1:

2015, ANSI/NACE MR0175/ISO 15156-2: 2015

ASME SA-106, ASME BPVC.II.A-2017, ASTM-A 106-2015, ASME SA-999 ASME BPVC.II.A-2017, ASTM-A 999-2016

GRADE 1, GRADE 290, GRADE 6, GRADE B

Normalized

FS: BENTELER Z.245.1 - 14 - A / SA-106 / A / SA-333 B/1/6/290 CATEGORIE 2 SS HEAT-NO. LT

50 SMLS HN DIMENSION TEST PRESSURE S6 WA GERMANY PO 4038177-00 / 2530090 DIMENSIONS

SCHEDULE

PS: HEAT-NO. DIMENSIONS SCHEDULE B/1/6/290 SS

AZ = Arzinkenbeschriftung, Eching ink marking, Geyure à l'encre PK = Farbkennzeichnung, color marking, marquage par couleur FSD = Farbstanddrucker Color jet printer, imprimante à jet d'encre de couleur UK = Laserkennzeichnung, Laser marking, Marquage laser PS = Prägestempel, die stamp, marquage par poinçonnage TS = Tintenstrahlkennzeichnung, ink jet spray marking, imprimante à jet d'encre

Blatt: 1 / 6

Page:

Benteler Steel/Tube GmbH

Postfach 13 40
33043 Paderborn
Deutschland

Tel.: + 49.5254.81-0 Fax: + 49.5254.13666



Steel/Tube

ABNAHMEPRÜFZEUGNIS EN 10204-3.1

INSPECTION CERTIFICATE EN 10204-3.1

CERTIFICAT DE RECEPTION EN 10204-3.1

65-1069887/001/E

Dokument-Nr.:

Document No.:

No. du document:

Prüf-Nr.:

Inspection No.:

No. du certificat:

Blatt: 2 / 6

Page:

Page:

Pos.	Stück	Maße	Gesamtlänge	Gewicht	Schmelzen-Nr.	Prüfdruck	Rohr-Nr.-Gruppe	Vielfachlängen
Item	Number	Dimensions	Length total	Weight	Heat No.	Test pressure	Tube number group	Multiple lengths
Poste	Nombre	Dimensions	Longueur totale	Poids	No. de coulée	Pression d'épreuve	Série de no. des tubes	Longueurs multiples
			feet	lbs		PSI		
0002	72	4" NPS * Sched. 40 20 FT - 22 FT	2530090 1570,90	17284	610879	2650	5	

Schmelzenanalyse [%] / Heat analysis [%] / Analyse sur coulée [%]

Pos.	Schmelzen-Nr.	C	SI	MN	P	S	CR	MO	NI	CU	V	NB	TI	B
Item	Heat No.													
Poste	No. de coulée													
0002	610879	0,130	0,320	1,25	0,008	0,001	0,14	0,05	0,25	0,11	0,062	0,014	0,003	0,0003

1. Formel: $CE_{IIV} = C + (Mn/6) + ((Cr + Mo + V)/5) + ((Cu + Ni)/15) < = 0,42 \%$ 2. Formel: $CE_V = C + F * ((Mn/6) + (Si/24) + (Cu/15) + ((Ni/20) + ((Cr + Mo + V + Nb)/5) + (5 * B)) < = 0,40 \%$ 3. Formel: $Mn / C > = 3 / 1$ 4. Formel: $Cr + Cu + Mo + Ni + V < = 1,00 \%$

Formelergebnisse / Formula results / Résultats des formules

Pos.	Schmelzen-Nr.	1. Formel	2. Formel	3. Formel	4. Formel
Item	Heat No.	1.	2.	3.	4.
Poste	No. de coulée	1.	2.	3.	4.
0002	610879	0,415	0,369	9,615	0,622

Produktanalyse [%] / Product analysis [%] / Analyse sur produit [%]

Pos.	Schmelzen-Nr.	C	SI	MN	P	S	CR	MO	NI	CU	V	NB	TI	B
Item	Heat No.													
Poste	No. de coulée													
0002	610879	0,130	0,320	1,21	0,004	0,003	0,15	0,06	0,26	0,09	0,067	0,017	0,005	0,0004

1. Formel: $CE_{IIV} = C + (Mn/6) + ((Cr + Mo + V)/5) + ((Cu + Ni)/15) < = 0,42 \%$ 2. Formel: $CE_V = C + F * ((Mn/6) + (Si/24) + (Cu/15) + ((Ni/20) + ((Cr + Mo + V + Nb)/5) + (5 * B)) < = 0,40 \%$ 3. Formel: $Mn / C > = 3 / 1$ 4. Formel: $Cr + Cu + Mo + Ni + V < = 1,00 \%$

Benteler Steel/Tube GmbH
Postfach 13 40
33043 Paderborn
Deutschland
Tel.: + 49 5254 81-0 Fax: + 49 5254 13666



Steel/Tube

ABNAHMEPRÜFZEUGNIS EN 10204-3.1
INSPECTION CERTIFICATE EN 10204-3.1
CERTIFICAT DE RECEPTION EN 10204-3.1

Dokument-Nr.: 65-1069887/001/E

Prüf-Nr.:
Inspection No.:
No. du certificat:

Blatt: 3 / 6
Page:

Formelergebnisse / Formula results / Résultats des formules

Pos.	Schmelzen-Nr	1. Formel	2. Formel	3. Formel	4. Formel
Item	Heat No.	1.	2.	3.	4.
Poste	No. de coulée	1.	2.	3.	4.
0002	610879	0,410	0,366	9,308	0,627

Prüfergebnisse / Test results / Résultats des essais

Die Rohre sind auf Dichtheit geprüft durch:

The tubes have been submitted to a leak tightness test by:

Les tubes ont passé un contrôle d'étanchéité par:

Die Rohre wurden zerstörungsfrei geprüft:

The tubes are non destructive tested:

Les tubes ont passé un essai non destructif:

Augensichtkontrolle:

Visual inspection:

Examen visuel:

PASSED

Maßkontrolle:

Dimensions examination:

Vérification des dimensions:

PASSED

Ringfaltversuch:

Flattening test:

Essai d'aplatissement:

PASSED

PASSED

Hydrostatic test: acc. to CSA Z245.1, holding time min 5 seconds, Test pressure/Time-record

ET-test: acc. to CSA Z245.1; for imperfections; drilled hole: 3,20 mm

PASSED

Ergebnisse der mechanischen Prüfung / Results of mechanical testing / Résultats des essais mécaniques

Die Probennahme erfolgte an Vielfachlängen.

The sampling was carried out on multiple lengths.

L'échantillonnage était réalisé aux longueurs multiples.

Zugversuch längs bei RT, Streifenprobe / Tensile test longitudinal at RT, Strip test specimen / Essai de traction longitudinale à TA, Bande decoupée sur tube

Pos.	Proben-Nr.	Schmelzen-Nr.	Probenabmessung	Streckgrenze	Zugfestigkeit	Dehnung
Item	Specimen No.	Heat No.	Specimen dimensions	Yield strength	Tensile strength	Elongation
Poste	No. de l'éprouv.	No. de coulée	Dimensions de l'éprouv.	Limite élastique	Résistance à la traction	Allongement
Anforderungen				RT 0,5 %	Rm	A2"
Requirements				PSI	PSI	%
Exigences				42206-71794	60046-90504	MIN 32,00
0002	000001	610879	25,40 X 5,80	59175	77740	32,00
0002	000002	610879	25,40 X 6,10	58305	78320	32,00
0002	000003	610879	25,40 X 6,20	58885	77305	32,00
0002	000004	610879	25,40 X 6,20	59466	79336	34,00

1. Formel

1. Formula

1. Formule

Benteler Steel/Tube GmbH
Postfach 13 40
33043 Paderborn
Deutschland
Tel.: + 49.5254.81-0 Fax: + 49.5254.13666



Steel/Tube

Blatt: 4 / 6
Page:

ABNAHMEPRÜFZEUGNIS EN 10204-3.1

INSPECTION CERTIFICATE EN 10204-3.1
CERTIFICAT DE RECEPTION EN 10204-3.1

Dokument-Nr.: 65-1069887/001/E
Document No.:

No. du document:

Prof.-Nr.:
Inspection No.:

No. du certificat:

Härteprüfung / Hardness test / Essai de dureté

Pos. Item	Proben-Nr. Specimen No.	Schmelzen-Nr. Heat No.	Härte Hardness
Poste	No. de l'éprouv.	No. de coulée	Dureté
Anforderungen Requirements	HRC	HB	HV
Exigences	MAX 200	HRB	HBW
0002 000001	610879	159	
0002 000002	610879	158	
0002 000003	610879	160	
0002 000004	610879	156	

Kerbschlagbiegeversuch. Notched bar impact test / Essai de flexion par choc (résilience) [1 CHARPY_V]

Probenlage: längs (L); Prüftemperatur: -51 °F

Specimen position: longitudinal (L); Test temperature: -51 °F

Position de l'éprouvette: longitudinal (L); Température d'essai: -51 °F

Pos.	Proben-Nr.	Schmelzen-Nr.	Probenabmessung Specimen dimensions	Kerbschlagarbeit Absorbed energy	Kerbschlagzähigkeit Impact strength	Verf.-Bruchanteil Shear fracture	Laterale Breitung Lateral expansion	Sprödbbruchanteil Brittle Fracture
Poste	No. de l'éprouv.	No. de coulée	Dimensions de l'éprouvette	Energie absorbée	Résistance au choc	Rupture ductile	Expansion latérale	Rupture Fragile
Anforderungen Requirements	Länge Length	Breite Width	Höhe Height	einzel single	mittel average	einzel single	einzel single	mittel average
Exigences	Longueur	Largeur	Hauteur	individuelle moyenne	individuelle moyenne	individuelle moyenne	individuelle moyenne	individuelle moyenne
	mm	mm	mm	J	J/cm ²	%	mm	mm
	55	5,00	10,00	MIN 014		%	mm	mm
0002 000001	610879	55	5,00	10,00	88	70	2,20	
		5,00	10,00	89		70	2,10	
		5,00	10,00	85		70	2,00	2,10

ABNAHMEPRÜFZEUGNIS EN 10204-3.1

INSPECTION CERTIFICATE EN 10204-3.1
CERTIFICAT DE RECEPTION EN 10204-3.1

Dokument-Nr.:
Document No.:
No. du document:

65-1069887/001/E

Prüf-Nr.:
Inspection No.:
No. du certificat:

Blatt: 5 / 6

Kerbschlagbiegeversuch Notched bar impact test / Essai de flexion par choc (résilience) [2 CHARPY V]

Probenlage: quer (Q); Prüftemperatur: -51 °F

Specimen position: transversal (Q); Test temperature: -51 °F

Position de l'éprouvette: transversal (Q); Température d'essai: -51 °F

Pos.	Proben-Nr.	Schmelzen-Nr.	Probenabmessung	Kerbschlagarbeit	Kerbschlagzähigkeit	Verf.-Bruchanteil	Laterale Breitung	Spödrbruchanteil
Item	Specimen No.	Heat No.	Specimen dimensions	Absorbed energy	Impact strength	Shear fracture	Lateral expansion	Brittle Fracture
Poste	No. de l'éprouv.	No. de coulée	Dimensions de l'éprouvette	Energie absorbée	Résistance au choc	Rupture ductile	Expansion latérale	Rupture Fragile
Anforderungen Requirements Exigences			Länge Length	einzel single	einzel single	einzel single	einzel single	einzel single
			Breite Width	mittel average	mittel average	mittel average	mittel average	mittel average
			Höhe Height	einzel single	einzel single	einzel single	einzel single	einzel single
			Longueur Longueur	individuelle individuelle	individuelle individuelle	individuelle individuelle	individuelle individuelle	individuelle individuelle
			Largeur Largeur	individuelle individuelle	individuelle individuelle	individuelle individuelle	individuelle individuelle	individuelle individuelle
			Hauteur Hauteur	individuelle individuelle	individuelle individuelle	individuelle individuelle	individuelle individuelle	individuelle individuelle

	mm	mm	mm	J	J	J	J/cm ²	%	%	mm	mm
	55	5,00	10,00	MIN 014	MIN 020	MIN 50	MIN 60				
0002 000001	55	5,00	10,00	35		60				1,20	
		5,00	10,00	32		60				1,10	
		5,00	10,00	33	33	60	60			1,00	1,10

Wärmebehandlung / Heat treatment / Traitement thermique

Normalizing temperature: 920°C, Holding time: 5 min, Cooling: Air

Restmagnetismus / Demagnetize / Démagnétiser

demagnetized tubes; 1 measurement per 4 hours on both tube ends Two readings 180° apart around the circumference. Average value max 3.0 Millitesla (24 A/cm), individual value max 3.5 Millitesla (28 A/cm)

Vermerk / Remark / Remarque

NACE Standard: Hardness acc. to NACE Standard MR0175 HRC max. 22., The material meets the requirements of NACE MR0103, Region 3, in accordance to Figure 1 and Appendix A.2, ANSI/NACE MR0175/ISO 15156-2:2015, Certificate remarks: fully killed fine grained steel, This is to confirm that the seamless linepipe supplied by BENTELER and verified to CSA Standard Z245.1-14 meets the requirement for micro hardness of max. 248 HV 500 gf., No weld repair has been carried out, Sour Service, The Material is Aluminium deoxygenized and inclusion shape controlled with Calcium-Silicon treatment, It is the end user's responsibility to ensure that all environmental requirements as well as the requirements regarding engineering, construction and operation of facilities are fulfilled in the country of use. Fit for purpose of the parts as well as homologation is not the scope of this contract., Steelmaking: BENTELER Steel Mill Lingen

Grain size: acc. to ASTM-E112; Grain size and finer: 6

Verkäufer(in) / Sales Personnel / Personne chargée : Mr Dyka, Tel.: 05254/81-4265-204265, Fax: 204229

Benteler Steel/Tube GmbH
Postfach 13 40
33043 Paderborn
Deutschland
Tel.: + 49.5254.81-0 Fax: + 49.5254.13666



Steel/Tube

ABNAHMEPRÜFZEUGNIS EN 10204-3.1
INSPECTION CERTIFICATE EN 10204-3.1
CERTIFICAT DE RECEPTION EN 10204-3.1

65-1069887/001/E

Dokument-Nr.:
Document No.:
No. du document.

Prüf-Nr.:
Inspection No.:
No. du certificat.

Blatt:
Page:
Page:
6 / 6

Dinslaken, 13.04.2018, TEL.: 02064.623-5360 FAX: 02064.623-5390

Abnahmebeauftragter
Inspection representative

Contrôleur

i. A. Patrick Hanraths / LABACH

Es wird bestätigt, daß die gelieferten Erzeugnisse den techn. Lieferbedingungen des Auftrages entsprechen. Dieses Dokument wurde mittels EDV erstellt und ist ohne Unterschrift rechtsgültig.
We certify that the supplied products comply with the order specifications. This document was prepared by means of electronic data processing and is valid without signature.
Nous attestons que les produits livrés sont conformes aux stipulations de la commande. Ce document a été établi par traitement électronique de l'information et est valide sans signature.



Vallourec Soluções Tubulares do Brasil S.A.
Barricão Plant - Av. Olimio Menezes, 65
ZIP 30640-010 - Belo Horizonte, MG



RINA
ISO 9001:2015 CERTIFIED
ISO 14001:2015 CERTIFIED
ASME U2 STAMPED

Inspection Certificate

(According to DIN EN 10204 J 1)

Nº.: 0030032296 / 00

Sheet: 1 / 4

Customer: VALLOUREC CANADA INC

Country: Canada

Material Number: 276430
Work Order: 536721 / 20
Customer Order: VM-4811/P.O.4038915-00

Inspection: Vallourec Soluções Tubulares do Brasil S.A.

PRODUCT: SEAMLESS STEEL PIPE, HOT FINISHED, BEVELED ENDS 30 DEG., NORMALIZED

DIMENSIONS: 168.30 mm X 7.11 mm GRADE: 290 # GR 1 # 6 # B

STANDARD: CSA-Z245.1-18 - CATEGORY II

IN ACCORDANCE ALSO TO THE STANDARDS: ASTM A 333M - 18 ASTM A 995M - 18 # ASTM A 106M - 18 ASTM A 53M - 18 # ASTM SA-333M - 17 # ASTM SA-106M - 17 # ASTM SA-530M - 17

CUSTOMER SPECIFICATION: CCTF GrB.1.6.290 Cat II SS, 20.11.2017

SURFACE PROTECTION: EXTERNAL: LACQUER PIPE ENDS PROTECTOR: PLASTIC CAP

TOLERANCES: OUTSIDE DIAMETER (PIPE BODY): -0.80 mm / +1.26 mm WALL THICKNESS: -0.89 mm / +1.07 mm

TOLERANCES (PIPE ENDS): OUTSIDE DIAMETER: -0.40 mm / +1.00 mm

LENGTH: RANDOM 5486.00 mm - 6706.00 mm

STANDARD MARKING: PAINT STENCILED IN THE PIPE BODY: 536721/20 MANUFACTURER CSA-Z245.1-18 168.30 X 7.11 290 CAT II M46C SS SH LENGTH HEAT NUMBER ASTM A/ASME SA 333. 1/6 HF SCH 040 LT -46C

ASTM A/ASME SA 106 B 18400 KPA WEIGHT ASTM A 53 B VSB LOGO

SHIPPING MARKING: NPS 6" X SCH 40 NACE MR 0175/NACE MR 0103 - MADE IN BRAZIL * VM4811 / P.O # 4038915-00/ITEM-2 * TORONTO * CCTF

Heat	Pieces
175147	11
175724	24
178322	89
Total	124

THE PRODUCT IS SATISFACTORY IN THE FOLLOWING TESTS / INSPECTIONS: DIMENSIONAL # VISUAL # FLATTENING TEST # ENDS INSPECTION : UNTESTED ENDS CROPPED # HYDROSTATIC TEST: 18400.0 KPA
SS # RESIDUAL MAGNETISM: MAX 30 GAUSS # ELECTROMAGNETIC TEST : CSAZ245.1-N10.LON/TRAN.OUT/INS # ULTRASONIC TEST FOR LAMINAR DEFECTS: ACC. CSA Z245.1-SOUR SERVICE #



Inspection Certificate

(According to DIN EN 10204.3.1)

N°.: 0030032296 / 00

Sheet 2 / 4

Chemical Composition (%)

Ceq: CSA-Z245.1-CE1

Process: Basic Oxygen Furnace, heats fully killed

Ceq: C/Mn/6/(Cr+Mo+V)/5/(Ni+Cu)/15

CE1: Cr + Cu + Mo + Ni + V

Heat Analysis	C	Mn	P	S	Si	Ni	Cr	Mo	Al	Cu	V	Nb	B	Ti	N	C'a	Ceq	CEq	CE
Product Analysis	0,240	1,350	0,025	0,025	0,500	0,400	0,300	0,120		0,400	0,080	0,020	0,0010	0,110			0,400	0,430	1,000
	0,400				0,100														
	0,240	1,350	0,025	0,025	0,500	0,400	0,300	0,120		0,400	0,080	0,020	0,0010	0,110			0,400	0,430	1,000
Heat Control Lot	0,12	1,31	0,010	0,007	0,30	0,01	0,04	0,01	0,027	0,025	0,004	0,016	0,0004	0,003	0,0055	0,0013	0,309	0,351	0,084
	0,12	1,29	0,010	0,005	0,29	0,01	0,04	0,01	0,028	0,024	0,004	0,017	0,0002	0,003	0,0050	0,0011	0,309	0,348	0,088
	0,12	1,29	0,010	0,006	0,28	0,01	0,04	0,01	0,027	0,023	0,004	0,016	0,0002	0,002	0,0050	0,0012	0,308	0,347	0,086
	0,11	1,30	0,009	0,003	0,30	0,02	0,05	0,01	0,029	0,030	0,004	0,015	0,0004	0,002	0,0045	0,0015	0,284	0,347	0,115
175724 030003127905	0,11	1,31	0,009	0,002	0,29	0,02	0,05	0,01	0,031	0,029	0,004	0,016	0,0002	0,002	0,0050	0,0013	0,285	0,346	0,116
	0,11	1,32	0,009	0,002	0,28	0,02	0,05	0,01	0,030	0,029	0,003	0,016	0,0002	0,002	0,0050	0,0013	0,287	0,346	0,115
	0,10	1,28	0,012	0,003	0,29	0,04	0,06	0,02	0,028	0,080	0,004	0,016	0,0004	0,002	0,0071	0,0015	0,267	0,348	0,201
	0,10	1,29	0,013	0,003	0,29	0,04	0,06	0,02	0,030	0,083	0,002	0,017	0,0002	0,002	0,0071	0,0014	0,269	0,350	0,197
178322 030003155671	0,10	1,27	0,011	0,004	0,30	0,04	0,06	0,02	0,029	0,082	0,004	0,015	0,0002	0,003	0,0075	0,0013	0,267	0,347	0,203

Ceq: Carbon Equivalent; Ceq: Carbon Equivalent; CE: Combined Elements;

Tensile Test

Specimen Direction: Longitudinal

Method: Elong. Total Under Load 0,50 %

Temperatures: Room Temperature

Wall Thickness: 7,11 mm

Gauge Length: L0=2"

Type of Specimen

Required: Min
Max

TS (MPa)

E (%)

YS (MPa)

Area (MM2)

VS (MPa)

TS (MPa)

E (%)

YS (MPa)

Area (MM2)

VS (MPa)

TS (MPa)

E (%)

YS (MPa)

Area (MM2)



RINA
ISO 9001:2015
ISO 14001:2015
OHSAS 18001

Inspection Certificate

(According to DIN EN 10204.3.1)

N°: 0030032296 / 00

Sheet: 3 / 4

Hardness Test

Scale: HV

Max

Required: Min

Max 246,0

Heat Control Lot

175147 030003140032

175724 030003127905

030003140031

178322 030003155671

Impact Test

Test Specimen: CHARPY 10X55X5 V NOTCH

Direction: Longitudinal

AE1

(J)

14

AE2

(J)

14

AE3

(J)

14

AE4

(J)

14

AE5

(J)

14

AE Avg

(J)

14

SA1

(%)

50

SA2

(%)

50

SA3

(%)

50

Temperature: -53°C

Striker radius: 8 mm

SA4

(%)

100

SA5

(%)

100

SA Avg

(%)

100

LE1

(Mils)

64

LE2

(Mils)

64

LE3

(Mils)

65

LE Avg

(Mils)

67

Test Specimen: CHARPY 10X55X5 V NOTCH

Direction: Longitudinal

AE1

(J)

122

AE2

(J)

122

AE3

(J)

122

AE4

(J)

122

AE5

(J)

122

AE Avg

(J)

122

SA1

(%)

100

SA2

(%)

100

SA3

(%)

100

Temperature: -53°C

Striker radius: 8 mm

SA4

(%)

100

SA5

(%)

100

SA Avg

(%)

100

LE1

(Mils)

64

LE2

(Mils)

64

LE3

(Mils)

65

LE Avg

(Mils)

67

Test Specimen: CHARPY 10X55X5 V NOTCH

Direction: Longitudinal

AE1

(J)

144

AE2

(J)

142

AE3

(J)

151

AE4

(J)

151

AE5

(J)

151

AE Avg

(J)

146

SA1

(%)

100

SA2

(%)

100

SA3

(%)

100

Temperature: -53°C

Striker radius: 8 mm

SA4

(%)

100

SA5

(%)

100

SA Avg

(%)

100

LE1

(Mils)

64

LE2

(Mils)

64

LE3

(Mils)

66

LE Avg

(Mils)

75

Test Specimen: CHARPY 10X55X5 V NOTCH

Direction: Longitudinal

AE1

(J)

121

AE2

(J)

121

AE3

(J)

122

AE4

(J)

122

AE5

(J)

121

AE Avg

(J)

121

SA1

(%)

100

SA2

(%)

100

SA3

(%)

100

Temperature: -46°C

Striker radius: 8 mm

SA4

(%)

100

SA5

(%)

100

SA Avg

(%)

100

LE1

(Mils)

53

LE2

(Mils)

58

LE3

(Mils)

59

LE Avg

(Mils)

64

Test Specimen: CHARPY 10X55X5 V NOTCH

Direction: Longitudinal

AE1

(J)

121

AE2

(J)

121

AE3

(J)

121

AE4

(J)

121

AE5

(J)

121

AE Avg

(J)

121

SA1

(%)

100

SA2

(%)

100

SA3

(%)

100

Temperature: -46°C

Striker radius: 8 mm

SA4

(%)

100

SA5

(%)

100

SA Avg

(%)

100

LE1

(Mils)

53

LE2

(Mils)

58

LE3

(Mils)

59

LE Avg

(Mils)

64

Test Specimen: CHARPY 10X55X5 V NOTCH

Direction: Longitudinal

AE1

(J)

106

AE2

(J)

111

AE3

(J)

104

AE4

(J)

104

AE5

(J)

104

AE Avg

(J)

106

SA1

(%)

100


SA2

(%)

100

SA3

(%)

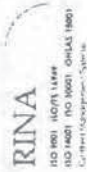

Inspection Certificate

(According to DIN EN 10204 3.1)

N°.: 0030032296 / 00

Sheet 4 / 4

HEAT: 175147 CCTF SKU: 2530104 6 A333-6 STD BLK SMLS SRL Invoice: 1596625-00 PO: 4072649 6/5/2019 12:50:22 PM

Remarks:

1. MATERIAL IN ACCORDANCE WITH NACE MR 0175 PAR. 3.2/ISO 15156-2, ANNEX A.2.1.2/NACE MR0103 PAR.2.1. ALL LATEST EDITIONS

2. SKU 2530104

3. THE WORKS OPERATE A QUALITY MANAGEMENT SYSTEM ACCORDING TO EUROPEAN DIRECTIVE 2014/68/UE ANNEX I PAR. 4.3 (CERTIFICATE 2016 RH:MP 02-03) VALID UNTIL 12.05 2019).

- MATERIAL ACCORDING TO PED 2014/68/UE ANNEX I PAR. 7.5

4. - NO WELD REPAIR

- FREE OF MERCURY CONTAMINATION
- NO RADIOACTIVE CONTAMINATION
- FINE GRAIN PRACTICE
- FULLY KILLED STEEL
- MATERIAL FROM BRAZIL

NORMALIZED

TEMPERATURE 892°C

SOAKING TIME 40 MINUTES

METHOD OF COOLING : AIR

We hereby certify that this product has been manufactured and examined in accordance with all requirements of the standards and specifications and all the results are found to be satisfactory. This testimonial and certificate respectively is recorded by a computer system and is valid without signature. Alteration or use for others products are regarded as falsification of documents and will be subject to criminal jurisdiction.

QUALITY CONTROL DEPARTMENT

FAX: (55-31) 3328-7773

e-mail:luiz.silva@vallourec.com


ENG. LUIZ FERNANDO DA SILVA - CREA/MG 58834-D
TECHNICAL RESPONSIBLE

DATE

02.27.2019



Vallourec Soluções Tubulares do Brasil S.A.
Barreiro Plant - Av. Olinto Meneses, 65
ZIP 30640-010 - Belo Horizonte, MG

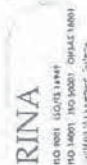

Inspection Certificate

(According to DIN EN 10204 3.1)

Nº.: 0030032296 / 00

Sheet: 1 / 4

Customer: VALLOUREC CANADA INC

Country: Canada

Material Number: 276430

Work Order: 536721 / 20

Customer Order: VM-4811/P.O.4038915-00

Inspection: Vallourec Soluções Tubulares do Brasil S.A.

PRODUCT: SEAMLESS STEEL PIPE, HOT FINISHED, BEVELED ENDS 30 DEG., NORMALIZED

DIMENSIONS: 168,30 mm X 7,11 mm GRADE: 290 # GR 1 # 6 # B

STANDARD: CSA-Z245.1-18 - CATEGORY II

IN ACCORDANCE ALSO TO THE STANDARDS: ASTM A 333M - 18 ASTM A 995M - 18 # ASTM A 106M - 18 ASTM A 53M - 18 # ASTM SA 99M - 17 # ASTM SA-106M - 17 ASME SA

530M - 17

CUSTOMER SPECIFICATION: CCTF-GrB.1.6.290 Cat II SS - 20.11.2017

SURFACE PROTECTION: EXTERNAL: LACQUER PIPE ENDS PROTECTOR: PLASTIC CAP

TOLERANCES: OUTSIDE DIAMETER (PIPE BODY): -0,80 mm / +1,26 mm WALL THICKNESS: -0,89 mm / +1,07 mm

TOLERANCES(PIPE ENDS): OUTSIDE DIAMETER: -0,40 mm / +1,60 mm

LENGTH: RANDOM 5486,00 mm - 6706,00 mm

STANDARD MARKING: PAINT STENCILED IN THE PIPE BODY: 536721/20 MANUFACTURER CSA-Z245.1-18 168,30 X 7,11 290 CAT II M46C SS S HN LENGTH HEAT NUMBER ASTM A/ASME SA 333, 1/6 HF SCH 040 LT -46C

ASTM A/ASME SA 106 B 18400 KPA WEIGHT ASTM A 53 B VSB LOGO

SHIPPING MARKING: NPS 6" X SCH 40 NACE MR 0175/NACE MR 0103 - MADE IN BRAZIL * VM4811 / P.O # 4038915-00/ITEM-2 * TORONTO * CCTF

Heat	Pieces
175147	11
175724	24
178322	89
Total	124

THE PRODUCT IS SATISFACTORY IN THE FOLLOWING TESTS / INSPECTIONS: DIMENSIONAL # VISUAL # FLATTENING TEST # ENDS INSPECTION : UNTESTED ENDS CROPPED # HYDROSTATIC TEST: 18400,0 KPA
SS # RESIDUAL MAGNETISM: MAX 30 GAUSS # ELECTROMAGNETIC TEST : CSAZ245.1-N10.LON/TRAN.OUT/INS # ULTRASONIC TEST FOR LAMINAR DEFECTS: ACC. CSA Z245.1-SOUR SERVICE #



Inspection Certificate

(According to DIN EN 10204 3.1)

N°: 0030032296 / 00

Sheet 2 / 4

Chemical Composition (%)

Ceq: CSA-2245 1-CE11

Process: Basic Oxygen Furnace, heats fully killed

Ceq: C/Mn/6-(Cr+Mo+V)/5 + (Ni+Cu)/15 CEI: Cr + Cu + Mo + Ni + V

	C	Mn	P	S	Si	Ni	Cr	Mo	Al	Cu	V	Nb	B	Ti	N	Cu	Ceq	Ceq	CEI
Heat Analysis					0,100														
Min	0,240	1,350	0,025	0,025	0,500	0,400	0,300	0,120	0,400	0,080	0,020	0,0010	0,110				0,400	0,430	1,000
Max																			
Product Analysis					0,100														
Min	0,240	1,350	0,025	0,025	0,500	0,400	0,300	0,120	0,400	0,080	0,020	0,0010	0,110				0,400	0,430	1,000
Max																			
Heat Control Lot																			
175147 030003127653	0,12	1,31	0,010	0,007	0,30	0,01	0,04	0,01	0,027	0,025	0,004	0,016	0,0004	0,003	0,0055	0,0013	0,309	0,351	0,044
Check 1	0,12	1,29	0,010	0,005	0,29	0,01	0,04	0,01	0,028	0,024	0,004	0,017	0,0002	0,003	0,0050	0,0011	0,309	0,348	0,088
Check 2	0,12	1,29	0,010	0,006	0,28	0,01	0,04	0,01	0,027	0,023	0,004	0,016	0,0002	0,002	0,0050	0,0012	0,308	0,347	0,086
175724 030003127905	0,11	1,30	0,009	0,003	0,30	0,02	0,05	0,01	0,029	0,030	0,004	0,015	0,0004	0,002	0,0045	0,0015	0,284	0,347	0,115
Check 1	0,11	1,31	0,009	0,002	0,29	0,02	0,05	0,01	0,031	0,029	0,004	0,016	0,0002	0,002	0,0050	0,0013	0,285	0,346	0,116
Check 2	0,11	1,32	0,009	0,002	0,28	0,02	0,05	0,01	0,030	0,029	0,003	0,016	0,0002	0,002	0,0050	0,0013	0,287	0,346	0,115
178322 030003155671	0,10	1,28	0,012	0,003	0,29	0,04	0,06	0,02	0,028	0,080	0,004	0,016	0,0004	0,002	0,0071	0,0015	0,267	0,348	0,201
Check 1	0,10	1,29	0,013	0,003	0,29	0,04	0,06	0,02	0,030	0,083	0,002	0,017	0,0002	0,002	0,0071	0,0014	0,269	0,350	0,197
Check 2	0,10	1,27	0,011	0,004	0,30	0,04	0,06	0,02	0,029	0,082	0,004	0,015	0,0002	0,003	0,0075	0,0013	0,267	0,347	0,203

Ceq: Carbon Equivalent; Ceq: Carbon Equivalent; CE: Combined Elements;

Tensile Test

Specimen Direction: Longitudinal

Method: Elong-Total Under Load 0,50 %

Temperature: Room Temperature

Gauge Length: 1.0=2"


Type of Specimen

Required: Min

Mat

	Area (MM2)	YS (MPa)	TS (MPa)	E (%)
Heat Control Lot				
175147 030003140032	188,5	376	500	40
175724 030003127905	190,0	382	505	40
030003140031	188,8	371	486	39
178322 030003155671	186,2	369	500	39
	188,8	370	489	39
	189,2	373	492	40
	186,5	355	488	39
	185,9	360	492	40

YS-Yield Strength; TS-Tensile Strength; E-Elongation;

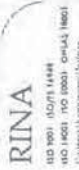

Inspection Certificate
(According to DIN EN 10204, 3.1)

N°.: 0030032296 / 00

Sheet 4 / 4

Remarks:

1. MATERIAL IN ACCORDANCE WITH NACE MR 0175 PAR. 3.2/ISO 15156-2, ANNEX A.2.1.2/NACE MR0103 PAR. 2.1 ALL LATEST EDITIONS
2. SKU 2530104
3. THE WORKS OPERATE A QUALITY MANAGEMENT SYSTEM ACCORDING TO EUROPEAN DIRECTIVE 2014/68/EU ANNEX I PAR. 4.3 (CERTIFICATE 2016 BH MP 02-03) VALID UNTIL 12.05.2019).
- MATERIAL ACCORDING TO PED 2014/68/EU ANNEX I PAR. 7.5
4. - NO WELD REPAIR
 - FREE OF MERCURY CONTAMINATION
 - NO RADIOACTIVE CONTAMINATION
 - FINE GRAIN PRACTICE
 - FULLY KILLED STEEL
 - MATERIAL FROM BRAZIL

NORMALIZED

TEMPERATURE 892°C
SOAKING TIME 40 MINUTES
METHOD OF COOLING - AIR

We hereby certify that this product has been manufactured and examined in accordance with all requirements of the standards and specifications and all the results are found to be satisfactory. This testimonial and certificate respectively is recorded by a computer system and is valid without signature. Alteration or use for others products are regarded as falsification of documents and will be subject to criminal jurisdiction.

QUALITY CONTROL DEPARTMENT

FAX: (55-31) 3328-2773

e-mail: luiz.silva@vallourec.com

ENG. LUIZ FERNANDO DA SILVA - CREA/MG 58834-D
TECHNICAL RESPONSIBLE

DATE

02.27.2019

HEAT: 175142 CCTF SKU: 2530112 B A333-6 STD BLK SMLS SRL Invoice: 1598625-00 PO: 4072649 8/5/2019 12:50:24 PM



Vallourec Soluções Tubulares do Brasil S.A.
Barreiro Plant - Av. Olinto Meireles, 65
ZIP 30640-010 - Belo Horizonte, MG



RINA
ISO 9001:2015 15447
ISO 14001:2015 15447
Certified Management System

Inspection Certificate

(According to DIN EN 10204 3.1)

Nº.: 0030030841 / 00

Sheet 1 / 4

Customer: VALLOUREC CANADA INC

Country: Canada

Material Number: 274465

Work Order: 531796 / 50

Customer Order: VM-4682 - P.O. 4038589-00

Inspection: Vallourec Soluções Tubulares do Brasil S.A.

PRODUCT: SEAMLESS STEEL PIPE, HOT FINISHED, BEVELED ENDS 30 DEG., NORMALIZED

DIMENSIONS: 219,10 mm X 8,18 mm SCHEDULE: 040 GRADE: GRADE 290 # GR 1 # 6 # B

STANDARD: CSA-Z245.1-14 - CATEGORY II

IN ACCORDANCE ALSO TO THE STANDARDS: ASTM A 333M - 16 ASTM A 999M - 18 # ASTM A 106M - 18 ASTM A 510M - 12 # ASTM A 53M - 12 # ASME SA-333M - 17 ASME SA-999M - 17 # ASME SA-106M - 17 ASME SA-530M - 17

CUSTOMER SPECIFICATION: CCTF GR.B.1.6.290 Cat II SS., 20.11.2017

SURFACE PROTECTION: EXTERNAL: LACQUER PIPE ENDS PROTECTOR: PLASTIC CAP

TOLERANCES: OUTSIDE DIAMETER (PIPE BODY): -0,80 mm / +1,60 mm WALL THICKNESS: -1,02 mm / +1,23 mm

TOLERANCES (PIPE ENDS): OUTSIDE DIAMETER: -0,40 mm / +1,60 mm

LENGTH: RANDOM 5486,00 mm - 6706,00 mm

STANDARD MARKING: PAINT STENCILED IN THE PIPE BODY: 531796/50 MANUFACTURER CSA-Z245.1-14 219,10 X 8,18 290 CAT II SS S IN LENGTH HEAT NUMBER ASTM A/ASME SA 333, 1/6 HF SCH 040 LT -46C ASTM

A/ASME SA 106 B 16300 KPA WEIGHT ASTM A 53 B NPS 8" X SCH 40 VSB LOGO

SHIPPING MARKING: NACE MR 0175/NACE MR 0103 - MADE IN BRAZIL * VM4682 / P.O # 4038589-00/ITEM-5 * TORONTO * CCTF

Heat	Pieces
175141	6
175142	8
176433	28
Total	42

THE PRODUCT IS SATISFACTORY IN THE FOLLOWING TESTS / INSPECTIONS: DIMENSIONAL # VISUAL # FLATTENING TEST # ENDS INSPECTION: UNTESTED ENDS CROPPED # HYDROSTATIC TEST: 16300,0 KPA

5 S # RESIDUAL MAGNETISM: MAX 30 GAUSS # ELECTROMAGNETIC TEST: CSAZ245.1-N101,0N/TRAN,OUT/INS # ULTRASONIC TEST FOR LAMINAR DEFECTS: ACC. CSA Z245.1-SOUR SERVICE #



Inspection Certificate

(According to DIN EN 10204 3.1)

N°: 0030030841 / 00

Sheet 2 / 4

Chemical Composition (%)

Ceq: CSA-Z245.1-CE11

Process: Basic Oxygen Furnace, heats fully killed

Ceq: C+Mn/6+(Cr+Mo+V)/5 -(Ni+Cu)/15

CE1: Cr + Cu + Mo + Ni + V

	C	Mn	P	S	Si	Ni	Cr	Mo	Al	Cu	V	Nb	B	Ti	N	Ca	Ceq	CE1
Heat Analysis	Min	0,400			0,100													
	Max	1,350	0,025	0,025	0,500	0,400	0,300	0,120		0,400	0,080	0,020	0,0010	0,110			0,400	0,430
Product Analysis	Min	0,400			0,100													1,000
	Max	1,350	0,025	0,025	0,500	0,400	0,300	0,120		0,400	0,080	0,020	0,0010	0,110			0,400	0,430
Heat Control Lot																		1,000
175141 030003103023																		1,000
Check 1		0,10	1,28	0,009	0,003	0,27	0,02	0,05	0,01	0,026	0,028	0,001	0,016	0,0005	0,001	0,0070	0,0019	0,262
Check 2		0,10	1,26	0,008	0,003	0,28	0,02	0,04	0,01	0,026	0,030	0,004	0,015	0,0003	0,001	0,0065	0,0016	0,258
175142 030003103024																		0,104
Check 1		0,11	1,28	0,008	0,002	0,28	0,02	0,04	0,01	0,026	0,031	0,004	0,016	0,0002	0,001	0,0065	0,0016	0,270
Check 2		0,11	1,29	0,010	0,004	0,28	0,02	0,05	0,01	0,030	0,025	0,001	0,015	0,0004	0,002	0,0077	0,0016	0,283
176433 030003103452																		0,106
Check 1		0,11	1,28	0,011	0,003	0,28	0,03	0,06	0,01	0,031	0,021	0,005	0,016	0,0003	0,002	0,0072	0,0013	0,283
Check 2		0,11	1,29	0,009	0,003	0,28	0,02	0,04	0,01	0,029	0,025	0,004	0,015	0,0003	0,002	0,0075	0,0014	0,281
175142 030003103023																		0,099
Check 1		0,10	1,27	0,012	0,004	0,28	0,03	0,06	0,01	0,029	0,070	0,004	0,015	0,0004	0,002	0,0099	0,0012	0,265
Check 2		0,11	1,29	0,013	0,004	0,29	0,03	0,06	0,01	0,028	0,066	0,005	0,016	0,0003	0,002	0,0096	0,0013	0,277
176433 030003103452																		0,171
Check 1		0,11	1,26	0,013	0,004	0,28	0,03	0,06	0,01	0,028	0,066	0,005	0,016	0,0002	0,002	0,0096	0,0013	0,273
Check 2		0,11	1,26	0,013	0,004	0,28	0,03	0,06	0,01	0,028	0,066	0,005	0,016	0,0002	0,002	0,0096	0,0013	0,273

Ceq: Carbon Equivalent; Ceq: Carbon Equivalent; CE: Combined Elements;

Tensile Test

Specimen Direction: Longitudinal

Method: Elong. Total Under Load 0,50 %

Temperature: Room Temperature

Wall Thickness: 8,18 mm

Gage Length: L0=Z"

Type of Specimen

Required: Min

Max

Heat Control Lot

175141 030003103023

175142 030003103024

176433 030003103452

STRIP WIDTH 38,1 MM
STRIP WIDTH 38,1 MM
Area (MM2)	YS (MPA)	TS (MPA)	E (%)
336,8	360	472	41
348,7	389	455	40
318,9	395	502	42
330,1	401	490	40
328,0	396	508	43
341,8	410	495	40

YS-Yield Strength; TS-Tensile Strength; E-Elongation;



Inspection Certificate

(According to DIN EN 10204 3.1)

N°: 0030030841 / 00

Sheet: 3 / 4

Hardness Test

Scale: HV

Max

Required: Min

Max 246,0

Heat Control Lot

175141 030003103023

175142 030003103024

176433 030003103452

158,0 160,0

162,0 164,0

169,0 170,0

Impact Test

Test Specimen: CHARPY 10X55X7,5 V NOTCH

Direction: Longitudinal

AE1 AE2 AE3

(J) (J) (J)

21 21 21

Required: Min

Max

Heat Control Lot

175141 030003103023

175142 030003103024

176433 030003103452

267 264 261

270 267 255

245 235 245

AE - Absorbed Energy; SA - Shear Area; LE - Lateral Expansion;

Impact Test

Test Specimen: CHARPY 10X55X6,67 V NOTCH

Direction: Transverse

AE1 AE2 AE3

(J) (J) (J)

18 18 18

Required: Min

Max

Heat Control Lot

175141 030003103023

175142 030003103024

176433 030003103452

196 208 213

203 179 187

160 187 156

AE - Absorbed Energy; SA - Shear Area; LE - Lateral Expansion;

Remarks:

1. MATERIAL IN ACCORDANCE WITH NACE MR 0175

PAR. 3.2/ISO 15156-2, ANNEX A 2.1.2/NACE MR0103 PAR.2.1. ALL LATEST

Temperature: -46°C

SA1 SA2

(J) (J)

21 50 50

Required: Min

Max

Heat Control Lot

175141 030003103023

175142 030003103024

176433 030003103452

264 100 100

264 100 100

242 100 100

AE - Absorbed Energy; SA - Shear Area; LE - Lateral Expansion;

Temperature: -46°C

SA1 SA2

(J) (J)

18 50 50

Required: Min

Max

Heat Control Lot

175141 030003103023

175142 030003103024

176433 030003103452

206 100 100

190 100 100

168 100 100

AE - Absorbed Energy; SA - Shear Area; LE - Lateral Expansion;

Striker radius: 8 mm

SA5 SA Avg

(%) (%)

100 75 75

Required: Min

Max

Heat Control Lot

175141 030003103023

175142 030003103024

176433 030003103452

100 75 75

100 80 80

100 80 80

AE - Absorbed Energy; SA - Shear Area; LE - Lateral Expansion;

Striker radius: 8 mm

SA5 SA Avg

(%) (%)

100 75 75

Required: Min

Max

Heat Control Lot

175141 030003103023

175142 030003103024

176433 030003103452

100 75 75

100 82 82

100 82 80

AE - Absorbed Energy; SA - Shear Area; LE - Lateral Expansion;



Inspection Certificate
(According to DIN EN 10204 3.1)

N°.: 0030030841 / 00

Sheet 4 / 4

HEAT: 175142 CCTF Sku: 2530112 8 A333-6 STD BLK SMLS SRL Invoice: 1596625-00 PO: 4072649 6/5/2019 12:50:24 PM

EDITIONS

2. SKU 2530112

3. THE WORKS OPERATE A QUALITY MANAGEMENT SYSTEM ACCORDING TO EUROPEAN DIRECTIVE 2014/68/UE ANNEX I PAR. 4.3 (CERTIFICATE 2016 BH MP 02-03 VALID UNTIL 12.05.2019).

- MATERIAL ACCORDING TO PED 2014/68/UE ANNEX I PAR. 7.5

"STEEL MADE BY BOF PROCESS"

- 4. - NO WELD REPAIR
- FREE OF MERCURY CONTAMINATION
- NO RADIOACTIVE CONTAMINATION
- FINE GRAIN PRACTICE
- FULLY KILLED STEEL
- MATERIAL FROM BRAZIL

We hereby certify that this product has been manufactured and examined in accordance with all requirements of the standards and specifications and all the results are found to be satisfactory. This testimonial and certificate respectively is recorded by a computer system and is valid without signature. Alteration or use for others products are regarded as falsification of documents and will be subject to criminal jurisdiction.

QUALITY CONTROL DEPARTMENT

FAX: (55-31) 3328-2773

e-mail: luis.silva@vallourec.com

DATE
11.20.2018

ENG. LUIZ FERNANDO DA SILVA - CREA-MG 59834-D
TECHNICAL RESPONSIBLE



Vallourec Soluções Tubulares do Brasil S.A.
Direção Plant - Av. Orlino Mendes, 65
Z/II - 11064-010 - Ilho Horizonte, MG



Inspection Certificate

(According to DIN EN 10204.3.1)

Nº.: 0030031810 / 00

Sheet: 1 - 4

Customer: VALLOURREC CANADA INC

Country: Canada

Material Number: 276624

Work Order: 534782 / 80

Customer Order: VM-4748 - P.O 4038825-00

Inspection: Vallourec Soluções Tubulares do Brasil S.A.

PRODUCT: SEAMLESS STEEL PIPE, HOT FINISHED, BEVELED ENDS 30 DEG., NORMALIZED

DIMENSIONS: 219,10 mm X 8,18 mm SCHEDULE: 040 GRADE: 290 # CR 1 # 6 # B

STANDARD: CSA-Z245.1-18 - CATEGORY II

IN ACCORDANCE ALSO TO THE STANDARDS: ASTM A 333M - 16 ASTM A 999M - 18 = ASTM A 106M - 18 ASTM A 530M - 12 = ASTM A 53M - 12 = ASME SA-333M - 17 ASME SA-999M - 17 = ASME SA-106M - 17 ASME SA-530M - 17

CUSTOMER SPECIFICATION: CCTF GRB.1.6.290 Cat II SS, 20.11.2017

SURFACE PROTECTION: EXTERNAL: LACQUER PIPE ENDS PROTECTOR: PLASTIC CAP

TOLERANCES: OUTSIDE DIAMETER (PIPE BODY): -0,80 mm / -1,60 mm WALL THICKNESS: -1,02 mm / -1,23 mm

TOLERANCES: PIPE ENDS: OUTSIDE DIAMETER: -0,40 mm / -1,60 mm

LENGTH: RANDOM 5486,00 mm - 6706,00 mm

STANDARD MARKING: PAINT STENCILED IN THE PIPE BODY: 534782 80 MANUFACTURER CSA-Z245.1-18 219,10 X 8,18 290 CAT II N46C 55,5 IN LENGTH HEAT NUMBER ASTM A ASME SA 333, 1 6 HF SCH 140 LT -46C

ASTM A ASME SA 106 B 16300 KPA WEIGHT ASTM A 53 B NPS 8" X SCH 40 VSB LOGO

SHIPPING MARKING: NACE MR 0175/NACE MR 0103 - MADE IN BRAZIL - VM4748 / P.O # 4038825-00 ITEM 8 - TORONTO - CCTF

Heat	Pieces
175146	12
177833	26
Total	38

THE PRODUCT IS SATISFACTORY IN THE FOLLOWING TESTS / INSPECTIONS: DIMENSIONAL # VISUAL # FLATTENING TEST # ENDS INSPECTION: UNTESTED ENDS CROPPED # HYDROSTATIC TEST 163000 KPA 5 S # RESIDUAL MAGNETIC FLUX 30 GAUSS # ELECTROMAGNETIC TEST: CSA Z245.1-N1010N:TRAN. OUT INS # ULTRASONIC TEST FOR LAMINAR DEFECTS: ACC. CSA Z245.1 SOUTHER SERVICE #



Inspection Certificate

(According to DIN EN 10204 3.1)

N°: 0030031810 / 00

Sheet 2 - 4

Chemical Composition (%)

Ceq: CSA-Z245, I-CE1

Process: Basic Oxygen Furnace, heats fully killed

Ceq: C-Mn/6+(Cr-Mo-V)/5-(Ni-Cu)/5

CE1: Cr-Cu-Mo-Ni-V

	C	Mn	P	S	Si	Ni	Cr	Mo	Al	Cu	V	Nb	B	Ti	N	Ca	Ceq	CE1
Heat Analysis																		
Min	0.240	0.400	0.025	0.025	0.500	0.400	0.300	0.120		0.400	0.080	0.020	0.0010	0.110			0.400	0.430
Max																		1.000
Product Analysis																		
Min	0.240	0.400	0.025	0.025	0.500	0.400	0.300	0.120		0.400	0.080	0.020	0.0010	0.110			0.400	0.430
Max																		1.000
Heat Control Lot																		
175146 030003113164	0.11	1.29	0.010	0.004	0.29	0.01	0.04	0.01	0.027	0.022	0.004	0.015	0.0004	0.002	0.0074	0.0012	0.281	0.338
Check 1	0.11	1.29	0.010	0.005	0.30	0.01	0.05	0.01	0.028	0.022	0.005	0.015	0.0005	0.002	0.0077	0.0012	0.284	0.340
Check 2	0.11	1.30	0.009	0.005	0.31	0.01	0.04	0.01	0.029	0.020	0.004	0.016	0.0002	0.002	0.0079	0.0014	0.283	0.339
177833 030003140903	0.11	1.29	0.010	0.004	0.28	0.03	0.07	0.01	0.029	0.090	0.004	0.014	0.0003	0.002	0.0067	0.0018	0.289	0.350
Check 1	0.11	1.28	0.011	0.003	0.27	0.03	0.07	0.01	0.030	0.090	0.003	0.015	0.0002	0.002	0.0064	0.0018	0.287	0.348
Check 2	0.10	1.28	0.011	0.003	0.27	0.03	0.07	0.01	0.030	0.090	0.003	0.015	0.0002	0.002	0.0067	0.0016	0.277	0.338

Ceq: Carbon Equivalent; Ceq: Carbon Equivalent; CE: Combined Elements

Tensile Test

Specimen Direction: Longitudinal

Method: Elong. Total Under Load 0.50 %

Temperature: Room Temperature

Wall Thickness: 8.18 mm

Gauge Length: 10-2"

Type of Specimen

E

(%)

(MPa)

(MPa)

(mm²)

Area

YS

Tensile

Elongation

Reduction of Area

Impact

Hardness

Weldability

Corrosion

Microstructure

Grain Size

Surface Finish

Dimensional Accuracy

Material Identification

Traceability

Documentation

Compliance

Quality Assurance

Customer Satisfaction

Environmental Protection

Social Responsibility

Health and Safety

Legal Compliance

Ethical Sourcing

Stakeholder Engagement

Continuous Improvement

Transparency

Accountability

Integrity

Honesty

Trust

Reliability

Consistency

Accuracy

Precision

Detail

Thoroughness

Completeness

Timeliness

Efficiency

Effectiveness

Productivity

Performance

Quality

Value

Cost

Time

Space

Energy

Materials

Equipment

Personnel

Information

Technology

Environment

Society

Government

Industry

Academia

Media

Public

Private

Non-Profit

For-Profit

Governmental

Non-Governmental

Public Sector

Private Sector

Non-Sector

For-Sector

Non-For-Sector

For-Non-For-Sector

Non-For-Non-For-Sector

For-Non-For-Non-For-Sector

Non-For-Non-For-Non-For-Sector

For-Non-For-Non-For-Non-For-Sector

Non-For-Non-For-Non-For-Non-For-Sector

For-Non-For-Non-For-Non-For-Non-For-Sector

Non-For-Non-For-Non-For-Non-For-Non-For-Sector

For-Non-For-Non-For-Non-For-Non-For-Non-For-Sector

Non-For-Non-For-Non-For-Non-For-Non-For-Non-For-Sector

For-Non-For-Non-For-Non-For-Non-For-Non-For-Non-For-Sector

Non-For-Non-For-Non-For-Non-For-Non-For-Non-For-Non-For-Sector

For-Non-For-Non-For-Non-For-Non-For-Non-For-Non-For-Non-For-Sector

Non-For-Non-For-Non-For-Non-For-Non-For-Non-For-Non-For-Non-For-Sector

For-Non-For-Non-For-Non-For-Non-For-Non-For-Non-For-Non-For-Non-For-Sector

Non-For-Non-For-Non-For-Non-For-Non-For-Non-For-Non-For-Non-For-Non-For-Sector

For-Non-For-Non-For-Non-For-Non-For-Non-For-Non-For-Non-For-Non-For-Non-For-Sector

Non-For-Non-For-Non-For-Non-For-Non-For-Non-For-Non-For-Non-For-Non-For-Non-For-Sector

For-Non-For-Non-For-Non-For-Non-For-Non-For-Non-For-Non-For-Non-For-Non-For-Non-For-Sector

Non-For-Non-For-Non-For-Non-For-Non-For-Non-For-Non-For-Non-For-Non-For-Non-For-Non-For-Sector

For-Non-For-Non-For-Non-For-Non-For-Non-For-Non-For-Non-For-Non-For-Non-For-Non-For-Non-For-Sector

Non-For-Non-For-Non-For-Non-For-Non-For-Non-For-Non-For-Non-For-Non-For-Non-For-Non-For-Non-For-Sector

Non-For-Non-For-Non-For-Non-For-Non-For-Non-For-Non-For-Non-For-Non-For-Non-For-Non-For-Non-For-Non-For-Non-For-Non-For-Non-For-Non-For-Non-For-Non-For-Sector

For-Non-For-Non-For-Non-For-Non-For-Non-For-Non-For-Non-For-Non-For-Non-For-Non-For-Non-For-Non-For-Non-For-Non-For-Non-For-Non-For-Non-For-Non-For-Non-For-Sector

Non-For-Sector

For-Non-For-Sector

Non-For-Sector

For-Non-For-Sector

Non-For-Non-For-



Inspection Certificate

(According to DIN EN 10204.3.1)

N°.: 0030031810 / 00

Sheet: 3 / 4

Hardness Test

Scale: HV

Max

Required: Min

Max 246.0

Heat Control Lot

175146 030003113164

148.0 150.0

177833 030003140903

152.0 155.0

Impact Test

Test Specimen: CHARPY 10N55N 5 V NOTCH

Direction: Longitudinal

Temperature: -46°C

Striker radius: 8 mm

AE1	AE2	AE3	AE4	AE5	AE Avg	SA1	SA2	SA3	SA4	SA5	SA Avg	LE1	LE2	LE3	LE Avg
(J)	(J)	(J)	(J)	(J)	(J)	(%)	(%)	(%)	(%)	(%)	(%)	(Mbs)	(Mbs)	(Mbs)	(Mbs)
21	21	21	21	21	21	50	50	50	50	50	50	60	60	60	60

Required: Min

Max

Heat Control Lot

175146 030003113164

269 100 100

177833 030003140903

269 100 100

78 81 79 69 73

Impact Test

Test Specimen: CHARPY 10N55N 6.7 V NOTCH

Direction: Transverse

Temperature: -46°C

Striker radius: 8 mm

AE1	AE2	AE3	AE4	AE5	AE Avg	SA1	SA2	SA3	SA4	SA5	SA Avg	LE1	LE2	LE3	LE Avg
(J)	(J)	(J)	(J)	(J)	(J)	(%)	(%)	(%)	(%)	(%)	(%)	(Mbs)	(Mbs)	(Mbs)	(Mbs)
18	18	18	18	18	18	50	50	50	50	50	50	60	60	60	60

Required: Min

Max

Heat Control Lot

177833 030003140903

100 100 100

174 186 174

88 88 88

Remarks:

1. MATERIAL IN ACCORDANCE WITH NACE MR 0175
PAR. 3.2/ISO 15156-2, ANNEX A.2.1.2/NACE MR 0103 PAR.2.1, ALL LATEST EDITIONS

2. SKO 2530112

3. THE WORKS OPERATE A QUALITY MANAGEMENT SYSTEM ACCORDING TO EUROPEAN



Inspection Certificate

(According to DIN EN 10204 3.1)

N°: 0030031810 / 00

Sheet: 4 4

DIRECTIVE 2014/68/EU ANNEX I PAR. 4.3 (CERTIFICATE 2016 BH MP 02-03)

VALID UNTIL: 12.05.2019.

- MATERIAL ACCORDING TO PHE 2014 68 (F-ANNEX I PAR. 7.5

4 - NO WELD REPAIR

- FREE OF MERCURY CONTAMINATION

- NO RADIOACTIVE CONTAMINATION

- FINE GRAIN PRACTICE

- FULLY KILLED STEEL

- MATERIAL FROM BRAZIL

We hereby certify that this product has been manufactured and examined in accordance with all requirements of the standards and specifications and all the results are found to be satisfactory. This testimonial and certificate respectively is recorded by a computer system and is valid without signature. Attention or use for others products are regarded as falsification of documents and will be subject to criminal jurisdiction.

QUALITY CONTROL DEPARTMENT

FAX: (55-31) 3328-2773

e-mail: info@vallourec.com

DATE:

01.22.2019


ENG. LUTZ FERNANDO DA SILVA - CREA-MG 58844-0
TECHNICAL RESPONSIBLE



Vallourec Soluções Tubulares do Brasil S.A.
Barreiro Plant - Av. Olinio Meireles, 65
ZIP 30640-010 - Belo Horizonte, MG



Inspection Certificate

(According to DIN EN 10204.3.1)

Nº.: 0030030841 / 00

Sheet: 1 / 4

Customer: VALLOUREC CANADA INC

Country: Canada

Material Number: 274465
Work Order: 531796 / 50
Customer Order: VM-4682 - P O 4038589-00

Inspection: Vallourec Soluções Tubulares do Brasil S.A.

PRODUCT: SEAMLESS STEEL PIPE, HOT FINISHED, BEVELLED ENDS 30 DEG., NORMALIZED

DIMENSIONS: 219.10 mm X 8.18 mm SCHEDULE: 040 GRADE: GRADE 290 # GR 1 # 6 # B

STANDARD: CSA-Z245.1-14 - CATEGORY II

IN ACCORDANCE ALSO TO THE STANDARDS: ASTM A 333M - 16 ASTM A 999M - 18 # ASTM A 106M - 18 ASTM A 530M - 12 # ASTM A 53M - 12 # ASME SA-333M - 17 ASME SA-106M - 17 ASME SA-530M - 17

CUSTOMER SPECIFICATION: CCTF GrB.1.6.290 Cat II SS., 20.11.2017

SURFACE PROTECTION: EXTERNAL: LACQUER PIPE ENDS PROTECTOR: PLASTIC CAP

TOLERANCES: OUTSIDE DIAMETER (PIPE BODY): -0.80 mm / +1.60 mm WALL THICKNESS: -1.02 mm / +1.23 mm

TOLERANCES (PIPE ENDS): OUTSIDE DIAMETER: -0.40 mm / +1.60 mm

LENGTH: RANDOM 5486.00 mm - 6706.00 mm

STANDARD MARKING: PAINT STENCILED IN THE PIPE BODY: 531796/50 MANUFACTURER CSA-Z245.1-14 219.10 X 8.18 290 CAT II SS S HN LENGTH HEAT NUMBER ASTM A/ASME SA 333. 1/6 HF SCH 040 LT -46C ASTM A/ASME SA 106 B 16300 KPA WEIGHT ASTM A 53 B NPS 8" X SCH 40 VSB LOGO

SHIPPING MARKING: NACE MR 0175/NACE MR 0103 - MADE IN BRAZIL • VM4682 / P.O # 4038589-00/ITEM-5 • TORONTO • CCTF

Heat	Pieces
175141	6
175142	8
176433	28
Total	42

THE PRODUCT IS SATISFACTORY IN THE FOLLOWING TESTS / INSPECTIONS: DIMENSIONAL # VISUAL # FLATTENING TEST # ENDS INSPECTION : UNTESTED ENDS CROPPED # HYDROSTATIC TEST: 16300.0 KPA
5 S # RESIDUAL MAGNETISM: MAX 30 GAUSS # ELECTROMAGNETIC TEST : CSAZ245.1-N10.10N/TRAN/OUT/INS # ULTRASONIC TEST FOR LAMINAR DEFECTS: ACC. CSA Z245.1-SOUR SERVICE #



Inspection Certificate

(According to DIN EN 10204 3.1)

N°.: 0030030841 / 00

Sheet 2 / 4

Chemical Composition (%)

Ceq: CSA-Z245.1-CE11

Process: Basic Oxygen Furnace, heats fully killed

Ceq: C+Mn/6+(Cr+Mo+V)/5 -(Ni+Cu)/15 CE1: Cr + Cu + Mo + Ni + V

	C	Mn	P	S	Si	Ni	Cr	Mo	Al	Cu	V	Nb	B	Ti	N	Ca	Ceq	Ceq	CE1
Heat Analysis																			
Min		0.400			0.100														
Max	0.240	1.350	0.025	0.025	0.500	0.400	0.300	0.120		0.400	0.080	0.020	0.0010	0.110			0.400	0.430	1.000
Product Analysis																			
Min		0.400			0.100														
Max	0.240	1.350	0.025	0.025	0.500	0.400	0.300	0.120		0.400	0.080	0.020	0.0010	0.110			0.400	0.430	1.000
Heat Control Lot																			
175141 030003103023																			
Check 1	0.10	1.28	0.009	0.003	0.27	0.02	0.05	0.01	0.026	0.028	0.001	0.016	0.0005	0.001	0.0070	0.0019	0.262	0.329	0.109
Check 2	0.10	1.26	0.008	0.003	0.28	0.02	0.04	0.01	0.026	0.030	0.004	0.015	0.0003	0.001	0.0065	0.0016	0.258	0.324	0.104
175142 030003103024																			
Check 1	0.11	1.28	0.008	0.002	0.28	0.02	0.04	0.01	0.026	0.031	0.004	0.016	0.0002	0.001	0.0065	0.0016	0.270	0.338	0.105
Check 2	0.11	1.29	0.010	0.004	0.28	0.02	0.05	0.01	0.030	0.025	0.001	0.015	0.0004	0.002	0.0077	0.0016	0.283	0.340	0.106
176433 030003103452																			
Check 1	0.11	1.28	0.011	0.003	0.28	0.03	0.06	0.01	0.031	0.021	0.005	0.016	0.0003	0.002	0.0072	0.0013	0.283	0.342	0.126
Check 2	0.11	1.29	0.009	0.003	0.28	0.02	0.04	0.01	0.029	0.025	0.004	0.015	0.0003	0.002	0.0075	0.0014	0.281	0.339	0.099
Check 1	0.10	1.27	0.012	0.004	0.28	0.03	0.06	0.01	0.029	0.070	0.004	0.015	0.0004	0.002	0.0099	0.0012	0.265	0.333	0.174
Check 2	0.11	1.29	0.013	0.004	0.29	0.03	0.06	0.01	0.028	0.066	0.005	0.016	0.0003	0.002	0.0096	0.0013	0.277	0.346	0.171
Ceq: Carbon Equivalent; Ceq: Carbon Equivalent; CE: Combined Elements;	0.11	1.26	0.013	0.004	0.28	0.03	0.06	0.01	0.028	0.066	0.005	0.016	0.0002	0.002	0.0096	0.0013	0.273	0.341	0.171

Tensile Test

Specimen Direction: Longitudinal

Method: Elong. Total Under Load 0.50 %

Temperature: Room Temperature

Wall Thickness: 8.18 mm

Gage Length: L0=2"

Type of Specimen

Required: Min

Max

	Area (MM2)	YS (MPa)	TS (MPa)	E (%)
Heat Control Lot				
175141 030003103023				
STRIP WIDTH 38.1 MM	336.8	360	472	41
STRIP WIDTH 38.1 MM	348.7	389	455	40
175142 030003103024				
STRIP WIDTH 38.1 MM	318.9	395	502	42
STRIP WIDTH 38.1 MM	330.1	401	490	40
176433 030003103452				
STRIP WIDTH 38.1 MM	328.0	396	508	43
STRIP WIDTH 38.1 MM	341.8	410	495	40

YS-Yield Strength; TS-Tensile Strength; E-Elongation;



Inspection Certificate
(According to DIN EN 10204.3.1)

N°.: 0030030841 / 00

Sheet: 3 / 4

Hardness Test

Scale: HV

Max

Required: Min

Max 246,0

Heat Control Lot

175141 030003103023

175142 030003103024

176433 030003103452

Impact Test

Test Specimen: CHARPY 10X55X7.5 V NOTCH

Direction: Longitudinal

AE1	AE2	AE3	AE4	AE5	AE Avg	SA1	SA2	SA3	SA4	SA5	SA Avg	LE1	LE2	LE3	LE Avg
(J)	(J)	(J)	(J)	(J)	(J)	(%)	(%)	(%)	(%)	(%)	(%)	(Mils)	(Mils)	(Mils)	(Mils)
21	21	21	21	21	21	50	50	50	50	50	50	60			
Required: Min															
Max															
267	264	261			264	100	100	100			100	75	75	75	75
270	267	255			264	100	100	100			100	80	80	80	80
245	235	245			242	100	100	100			100	80	80	80	80

AE - Absorbed Energy; SA - Shear Area; LE - Lateral Expansion;

Impact Test

Test Specimen: CHARPY 10X55X6.67 V NOTCH

Direction: Transverse

AE1	AE2	AE3	AE4	AE5	AE Avg	SA1	SA2	SA3	SA4	SA5	SA Avg	LE1	LE2	LE3	LE Avg
(J)	(J)	(J)	(J)	(J)	(J)	(%)	(%)	(%)	(%)	(%)	(%)	(Mils)	(Mils)	(Mils)	(Mils)
18	18	18	18	18	18	50	50	50	50	50	50	60			
Required: Min															
Max															
196	208	213			206	100	100	100			100	75	78	81	78
203	179	187			190	100	100	100			100	82	82	82	82
160	187	156			168	100	100	100			100	80	82	78	80

AE - Absorbed Energy; SA - Shear Area; LE - Lateral Expansion;

Remarks:

1. MATERIAL IN ACCORDANCE WITH NACE MR 0175
- PAR. 3.2/ISO 15156-2, ANNEX A.2.1.2/NACE MR0103 PAR.2.1. ALL LATEST



Inspection Certificate
(According to DIN EN 10204 3.1)
N°.: 0030030841 / 00

Sheet 4 / 4

EDITIONS

2. SKU 2530112

3. THE WORKS OPERATE A QUALITY MANAGEMENT SYSTEM ACCORDING TO EUROPEAN DIRECTIVE 2014/68/UE ANNEX I PAR. 4.3 (CERTIFICATE 2016 BH MP 02-03 VALID UNTIL 12.05.2019).
- MATERIAL ACCORDING TO PED 2014/68/UE ANNEX I PAR. 7.5

"STEEL MADE BY BOF PROCESS"

4. - NO WELD REPAIR
- FREE OF MERCURY CONTAMINATION
- NO RADIOACTIVE CONTAMINATION
- FINE GRAIN PRACTICE
- FULLY KILLED STEEL
- MATERIAL FROM BRAZIL

We hereby certify that this product has been manufactured and examined in accordance with all requirements of the standards and specifications and all the results are found to be satisfactory. This testimonial and certificate respectively is recorded by a computer system and is valid without signature. Alteration or use for others products are regarded as falsification of documents and will be subject to criminal jurisdiction.

QUALITY CONTROL DEPARTMENT
FAX: (55-31) 3328-2773
e-mail: luis.silva@vallourec.com

DATE
11.20.2018

ENG. LUIZ FERNANDO DA SILVA - CREA/ANG SRR34-D
TECHNICAL RESPONSIBLE



Vallourec Soluções Tubulares do Brasil S.A.
Barreiro Plant - Av. Orlino Meireles, 65
ZIP: 30640-010 - Belo Horizonte, MG



Inspection Certificate

(According to DIN EN 10204.3.1)

Nº.: 0030031810 / 00

Sheet: 1 - 4

Customer: VALLER-REC CANADA INC

Country: Canada

Material Number: 2766.24

Work Order: 534782 / 80

Customer Order: VM-4748 - P.O. 4038825-00

Inspection: Vallourec Soluções Tubulares do Brasil S.A.

PRODUCT: SEAMLESS STEEL PIPE, HOT FINISHED, BEVELED ENDS 30 DEG., NORMALIZED

DIMENSIONS: 219.10 mm X 8.18 mm SCHEDULE; 040 GRADE; 290 # GR 1 # 6 # B

STANDARD: CSA-Z245.1-18 - CATEGORY II

IN ACCORDANCE ALSO TO THE STANDARDS: ASTM A 333M - 16; ASTM A 995M - 18; ASTM A 106M - 18; ASTM A 53M - 12; ASTM A 53M - 12; ASTM A 333M - 17; ASME SA 990M - 17; ASME SA 106M - 17; ASME SA 530M - 17

CUSTOMER SPECIFICATION: CCTF GRB1.6.290 Cat II SS, 20.11.2017

SURFACE PROTECTION: EXTERNAL: LACQUER PIPE ENDS PROTECTOR; PLASTIC CAP

TOLERANCES: OUTSIDE DIAMETER (PIPE BODY): -0.80 mm / +1.60 mm WALL THICKNESS: -1.02 mm / +1.23 mm

TOLERANCES: PIPE ENDS: OUTSIDE DIAMETER: -0.40 mm / +1.60 mm

LENGTH: RANDOM 5486.00 mm - 6706.00 mm

STANDARD MARKING: PAINT STENCILED IN THE PIPE BODY: 534782 80 MANUFACTURER CSA-Z245.1-18 219.10 X 8.18 290 CAT II M46C 55 S IN LENGTH HEAT NUMBER ASTM A/ASME SA 333.1 6 HF SCH 40 LT 40C

ASTM A ASME SA 106 B 16300 KPA WEIGHT ASTM A 53 B NPS 8" X SCH 40 VSB LOGO

SHIPPING MARKING: NACE MR 0175/NACE MR 0103 - MADE IN BRAZIL * VM4748 / P.O. # 4038825-00 ITEM-8 * TORONTO * CCTF

Heat	Pieces
175146	12
177833	26
Total	38

THE PRODUCT IS SATISFACTORY IN THE FOLLOWING TESTS / INSPECTIONS: DIMENSIONAL # VISUAL # FLATTENING TEST # ENDS INSPECTION # UNTESTED ENDS CROPPED # HYDROSTATIC TEST 16300.0 KPA 5 S # RESIDUAL MAGNETISM: MAX 30 GAUSS # ELECTROMAGNETIC TEST CSA-Z245.1-18 LONGITUDINAL TRANSVERSE # ULTRASONIC TEST FOR LAMINAR DEFECTS: ACC. CSA Z245.1-18 SOUR SERVICE #



Inspection Certificate

(According to DIN EN 10204.3.1)

N°.: 0030031810 / 00

Sheet: 2 - 4

Chemical Composition (%)

Ceq: CSA-2245-1-CE1

Process: Basic Oxygen Furnace, heats fully killed

Ceq: C-Mn/6-(Cr-Mo-V)/5-(Si-Cu)/5

CE1: Cr-Cu-Mo-Ni-V

	C	Mn	P	S	Si	Ni	Cr	Mo	Al	Cu	V	Nb	B	Ti	N	Ca	Ceq	CE1
Heat Analysis	Min	0.400			0.100													
	Max	1.350	0.025	0.025	0.500	0.001	0.300	0.120		0.400	0.080	0.020	0.0010	0.110			0.400	0.430
Product Analysis	Min	0.400			0.100													
	Max	1.350	0.025	0.025	0.500	0.001	0.300	0.120		0.400	0.080	0.020	0.0010	0.110			0.400	0.430
Heat Control Lot																		
175146 030003113164		1.29	0.010	0.004	0.29	0.01	0.04	0.01	0.027	0.022	0.004	0.015	0.0003	0.002	0.0074	0.0012	0.281	0.338
Check 1		1.29	0.010	0.005	0.30	0.01	0.05	0.01	0.028	0.022	0.005	0.015	0.0005	0.002	0.0077	0.0012	0.284	0.340
Check 2		1.30	0.009	0.005	0.31	0.01	0.04	0.01	0.029	0.020	0.004	0.016	0.0002	0.002	0.0079	0.0014	0.283	0.339
177833 030003140903		1.29	0.010	0.004	0.28	0.03	0.07	0.01	0.029	0.000	0.004	0.014	0.0003	0.002	0.0067	0.0018	0.289	0.350
Check 1		1.28	0.011	0.003	0.27	0.03	0.07	0.01	0.030	0.000	0.003	0.015	0.0002	0.002	0.0064	0.0018	0.287	0.348
Check 2		1.28	0.011	0.003	0.27	0.03	0.07	0.01	0.030	0.000	0.003	0.015	0.0002	0.002	0.0067	0.0016	0.277	0.338

Ceq: Carbon Equivalent; Ceq: Carbon Equivalent; CE1: Combined Elements;

Tensile Test

Specimen Direction: Longitudinal

Method: Elong, Total Under Load (0.50 %)

Temperature: Room Temperature

Wall Thickness: 8.18 mm

Gauge Length: 10.2"

	Required: Min	Max	Type of Specimen	Area (MM ²)	YS (MPa)	TS (MPa)	E (%)
Heat Control Lot							
175146 030003113164			STRIP WIDTH 38 MM	324.3	383	502	41
			STRIP WIDTH 38 MM	329.7	399	515	40
177833 030003140903			STRIP WIDTH 38.1 MM	305.2	420	519	42
			STRIP WIDTH 38.1 MM	300.7	425	525	40

YS: Yield Strength; TS: Tensile Strength; E: Elongation;

3. THE WORKS OPERATING A QUALITY MANAGEMENT SYSTEM ACCORDING TO EUROPEAN



Inspection Certificate
(According to DIN EN 10204 3.1)

Nº.: 0030031810 / 00

Sheet: 4 - 4

DIRECTIVE 2014/68/EU, ANNEX I PAR. 4.3 (CERTIFICATE 2016 B1 MIP 02-03)
VALID UNTIL 12/05/2019.
- MATERIAL ACCORDING TO PED 2014/68/EU ANNEX I PAR. 7.5

- 4. - NO WELD REPAIR
- FREE OF MERCURY CONTAMINATION
- NO RADIOACTIVE CONTAMINATION
- FINE GRAIN PRACTICE
- FULLY KILLED STEEL
- MATERIAL FROM BRAZIL

We hereby certify that this product has been manufactured and examined in accordance with all requirements of the standards and specifications and all the results are found to be satisfactory. This testimonial and certificate respectively is recorded by a computer system and is valid without signature. Alteration or use for others products are regarded as falsification of documents and will be subject to criminal jurisdiction.

QUALITY CONTROL DEPARTMENT
FAX: (55-31) 3328-2773

e-mail: skis@vallourec.com

DATE
01/22/2019

ENG. LUIZ FERNANDO DA SILVA - CREA: AMG 58834-D
TECHNICAL RESPONSIBLE



CORPORATION

4151 North Service Road, Burlington, ON L7L 4X6 (905) 335-5320

Date: 6/11/2019

Mill Test Reports

Invoice: 1596643-01
PO: 2610087

Customer: 27403-261
EQUIPEMENT KN
POUR ABF MINES
8254 RANG DU VIEUX PONT
ROUYN-NORANDA, QC J9Y 0H4

Line	Heat#	Product	Description
3	61b01013 **	7561296	8 STD LR 45 WELD ELL A420WPL6
10	18/38332	7583949	8 300 RF WN FLG STD A350LF2



Thai Benkan Co., Ltd.
58 Soi Wadnana, Bangkok, Prapachong,
Samutprakan, 10130 Thailand.

INSPECTION CERTIFICATE

Purchaser :

TO EN10204 3.1

D M Y Certificate No.
08/08/2018 T = 2018020878

Purchase Order No. Job No.

E-No.	Specification for Material Made from Seamless Pipe	Specification for Inspection	Visual Examination	Dimensional Inspection															
ME-567	A234-18/SA234-17 Gr WPB/M420-16/SA420-17 Gr WPL6 CSA Z46.11-17 GR241 CAT B MKC 95	ASME B16.9-2012, B16.25-2017	Good	Good															
MFG. No.	Product & Size	Quantity	Hardness Actual Data																
81B01013	756 / 296 45 EL WPB/MWPL6 8 STD	50	HBW 123,128,128																
	Material Heat No.	Chemical Composition%(Note1)	Boron (%)																
	J6K1169	Ti= 1	0.0001																
Specifi- cation	Chemical Composition %													#2 Tension Test		transverse		HARDNESS MAX 197 HB : 1200	
	C	Si	Mn	P	S	Cu	Ni	Cr	Mo	Al	V	Nb	C.E.	Y S	TS	E	Impact Test (J) longitudinal 10 X 6.7 X 2V AT -46 °C		
	X	X	X	X	X	X	X	X	X	X	X	X	X				%		
	100	100	100	1000	1000	100	100	100	100	1000	1000	1000	100						
		15	50												240	415	30	116	
Min.																			
Max.	23	40	135	35	40	40	40	30	12		80	20	40		585		127	AVE. 111	
	12	27	127	13	1	1	3	11	1		0	0	38	295	452	48	90		

NORMALIZING 810 C X 40 MINUTES. COOLED IN STILL AIR

(Note 1) : Specification of Tl Composition (%) : Max 11 (Ti x 100) Material according to ANSI/AACE MR0175/ISO 15156-2-2015 Annex A & MR0103-2015 (SSC Region 3)

*Fully killed and fine grain practice** Steel making process : Basic Oxygen* Tensile test with longitudinal specimen and 50 mm. gauge length.

C.E. = C+Mn/6+(Cr+Mo+V)/5+(Ni+Cu)/15

We hereby certify that the product described herein has been manufactured in accordance with the specifications concerned and also with the purchaser's requirements and that the test results shown herein are correct.

* 1 : "T" symbolized wall thickness in mm. * 2 : YS Yield strength TS = Tensile strength T = Elongation

MAGNETIC PARTICLE EXAMINATION FOR TEE ONLY :

Rungnua Kampradon
Quality Assurance Manager
Thai Benkan Co., Ltd.

COMPANY WITH MANAGEMENT SYSTEM CERTIFIED BY DNV GL = ISO 9001 = = ISO 14001 =		METALFAR PRODOTTI INDUSTRIALI SPA 23861 CESANA BRIANZA (LC) - ITALY VIA G. PARINI, 28 PHONE + 39 031 855441 - FAX +39 031 855149 certificate@metalfaritaly.com	COMPANY WITH MANAGEMENT SYSTEM CERTIFIED BY DNV GL = ISO 9001 = = ISO 14001 =																																																																																				
INSPECTION CERTIFICATE EN 10204:2004 / 3.1																																																																																							
SILBO INDUSTRIES 50 CHESTNUT RIDGE ROAD SUITE 204 07645 MONTVALE N.J.		Nr. 2018-C_MFF-04299 Data / Dated 31.10.2018																																																																																					
Dest. CA		Ordine / PO 69051/BG Item 015 DDT / Delivery note 2018-3E301-0004398 Packing List 2018-3E401-0004238 Fattura / Invoice 2018-3E401-0004238 Ns. rif. / Our ref. 2017-3E201-0003478-0015																																																																																					
Cod. colata Heat Code	Nr. colata Heat Nr	Quantita Quantity	Descrizione Description																																																																																				
18/38332	18/38332	50,00	7583949 W/N 300 RF 8" STD LF2CL1																																																																																				
Mat. in acc. a / Mat. in acc. to ASTM A 350M -18, ASME SA 350 M -17, ASME CODE SECT. II, PART A, ED. 2017 ASTM A350 LF2 CL1 ASTM A105M -18, ASME SA105M-17, ASME CODE SECT. II, PART A, ED. 2017 NACE MR-0175/2015 ISO 15156 Part 2 - Annex A - SOUR SERVICE NACE MR-0103/2015 ISO 17495- SOUR SERVICE CSA Z245.12-17 GRADE 248 CAT.II SOUR SERVICE CSA Z245.12-17 GRADE 248 CAT.I SOUR SERVICE Q.A.S. IN ACCORD. WITH PRESS. EQUIPM. DIRECT. 2014/68/EU (PED) ANNEX I, PARAGRAPH 4.3 CERT. 4687-2014-CE-ITA-DNV GL																																																																																							
Ann. mat. / Mat. remarks FULLY KILLED STEEL AND FINE GRAIN PRACTICED GRAIN SIZE - 7 OR FINER NO WELD REPAIR																																																																																							
<table border="1" style="width:100%; border-collapse: collapse;"> <thead> <tr> <th>Elementi / Elements</th> <th>C</th> <th>Si</th> <th>Mn</th> <th>S</th> <th>P</th> <th>Cr</th> <th>Ni</th> <th>Mo</th> <th>Ti</th> <th>Cu</th> <th>V</th> <th>Nb</th> <th>N</th> </tr> </thead> <tbody> <tr> <td>LADLE ANALYSIS</td> <td>0.185</td> <td>0.220</td> <td>1.090</td> <td>0.008</td> <td>0.009</td> <td>0.110</td> <td>0.050</td> <td>0.010</td> <td>0.016</td> <td>0.160</td> <td>0.002</td> <td>0.001</td> <td>0.008</td> </tr> <tr> <td>PRODUCT ANALYSIS</td> <td>0.184</td> <td>0.228</td> <td>1.096</td> <td>0.007</td> <td>0.012</td> <td>0.116</td> <td>0.055</td> <td>0.013</td> <td>0.019</td> <td>0.164</td> <td>0.004</td> <td>0.002</td> <td>0.007</td> </tr> <tr> <td></td> <td>Al</td> <td>B</td> <td>Ce</td> <td></td> <td></td> <td></td> <td></td> <td></td> <td>CE</td> <td></td> <td>F1</td> <td>F2</td> <td>PREN</td> </tr> <tr> <td>LADLE ANALYSIS</td> <td>0.025</td> <td>0.0004</td> <td>0.002</td> <td></td> <td></td> <td></td> <td></td> <td></td> <td>0.407</td> <td></td> <td>0.332</td> <td>0.120</td> <td>-</td> </tr> <tr> <td>PRODUCT ANALYSIS</td> <td>0.027</td> <td>0.0000</td> <td>0.002</td> <td></td> <td></td> <td></td> <td></td> <td></td> <td>0.408</td> <td></td> <td>0.352</td> <td>0.129</td> <td>-</td> </tr> </tbody> </table>				Elementi / Elements	C	Si	Mn	S	P	Cr	Ni	Mo	Ti	Cu	V	Nb	N	LADLE ANALYSIS	0.185	0.220	1.090	0.008	0.009	0.110	0.050	0.010	0.016	0.160	0.002	0.001	0.008	PRODUCT ANALYSIS	0.184	0.228	1.096	0.007	0.012	0.116	0.055	0.013	0.019	0.164	0.004	0.002	0.007		Al	B	Ce						CE		F1	F2	PREN	LADLE ANALYSIS	0.025	0.0004	0.002						0.407		0.332	0.120	-	PRODUCT ANALYSIS	0.027	0.0000	0.002						0.408		0.352	0.129	-
Elementi / Elements	C	Si	Mn	S	P	Cr	Ni	Mo	Ti	Cu	V	Nb	N																																																																										
LADLE ANALYSIS	0.185	0.220	1.090	0.008	0.009	0.110	0.050	0.010	0.016	0.160	0.002	0.001	0.008																																																																										
PRODUCT ANALYSIS	0.184	0.228	1.096	0.007	0.012	0.116	0.055	0.013	0.019	0.164	0.004	0.002	0.007																																																																										
	Al	B	Ce						CE		F1	F2	PREN																																																																										
LADLE ANALYSIS	0.025	0.0004	0.002						0.407		0.332	0.120	-																																																																										
PRODUCT ANALYSIS	0.027	0.0000	0.002						0.408		0.352	0.129	-																																																																										
CE=C+(Mn/6+Si/24+Cu/15+Ni/20+(Cr+Mo+V+Nb)/5+5B) F1=Cu+Ni+Cr+Mo+V F2=Cr+Mo																																																																																							
<table border="1" style="width:100%; border-collapse: collapse;"> <thead> <tr> <th>Provetta Test specimen</th> <th>Forma Shape</th> <th>*C²³</th> <th>Sneramento > 0,2% Yield Strength > 0,2%</th> <th>Sneramento > 1,0% Yield Strength > 1,0%</th> <th>Rottura Tensile</th> <th>Allungamento Elongation</th> <th>Contrazione Reduction of area</th> </tr> </thead> <tbody> <tr> <td>Sez./Sect mm2 Gauge L mm f=O-2=□</td> <td></td> <td></td> <td>MPa</td> <td>MPa</td> <td>MPa</td> <td>%</td> <td>%</td> </tr> <tr> <td>126,60 50,80 1 20</td> <td></td> <td></td> <td>335,0</td> <td>-</td> <td>530,0</td> <td>37,0</td> <td>69,0</td> </tr> </tbody> </table>				Provetta Test specimen	Forma Shape	*C ²³	Sneramento > 0,2% Yield Strength > 0,2%	Sneramento > 1,0% Yield Strength > 1,0%	Rottura Tensile	Allungamento Elongation	Contrazione Reduction of area	Sez./Sect mm2 Gauge L mm f=O-2=□			MPa	MPa	MPa	%	%	126,60 50,80 1 20			335,0	-	530,0	37,0	69,0																																																												
Provetta Test specimen	Forma Shape	*C ²³	Sneramento > 0,2% Yield Strength > 0,2%	Sneramento > 1,0% Yield Strength > 1,0%	Rottura Tensile	Allungamento Elongation	Contrazione Reduction of area																																																																																
Sez./Sect mm2 Gauge L mm f=O-2=□			MPa	MPa	MPa	%	%																																																																																
126,60 50,80 1 20			335,0	-	530,0	37,0	69,0																																																																																
<table border="1" style="width:100%; border-collapse: collapse;"> <thead> <tr> <th colspan="2">DUREZZA / HARDNESS</th> <th colspan="4">RESILIENZA / IMPACT TEST</th> </tr> <tr> <th>HBW</th> <th>Tipo/Type</th> <th>Provetta / Test Specimen</th> <th>*C²³</th> <th>1-Joule</th> <th>2-Joule</th> <th>3-Joule</th> <th>Media/Average</th> </tr> </thead> <tbody> <tr> <td>162,0 166,0 160,0</td> <td>KV</td> <td>10x10 mm</td> <td>-46</td> <td>57</td> <td>60</td> <td>50</td> <td>55,7</td> </tr> </tbody> </table>				DUREZZA / HARDNESS		RESILIENZA / IMPACT TEST				HBW	Tipo/Type	Provetta / Test Specimen	*C ²³	1-Joule	2-Joule	3-Joule	Media/Average	162,0 166,0 160,0	KV	10x10 mm	-46	57	60	50	55,7																																																														
DUREZZA / HARDNESS		RESILIENZA / IMPACT TEST																																																																																					
HBW	Tipo/Type	Provetta / Test Specimen	*C ²³	1-Joule	2-Joule	3-Joule	Media/Average																																																																																
162,0 166,0 160,0	KV	10x10 mm	-46	57	60	50	55,7																																																																																
Tratt. Term. / Heat treatment NORMALIZED AT 930 °C - COOLED IN STILL AIR GAS FURNACE																																																																																							
Dim in acc. a / Dim. acc. to ASME/ANSI B16.5 -2017 ; ASME/ANSI B36.10M -2015 ; ASME/ANSI B16.25 -2017																																																																																							
Finitura / Roughness ASME/ANSI B46.1 -2009 125-250 µin AARH																																																																																							
Marcatura in acc. Marking in acc. to	ANSI/MSS SP-25-2018	Vis. & Dim.	SATISFACTORY																																																																																				
Origine Origin of Steel		ITALY																																																																																					

Note / Notes 100% MANUFACTURED IN ITALY

Introduction of flanges on the furnace at temperature below 200°C.
 Heating of piece of 150°C. every hour till 930°C
 Holding time: 1 hour/ Inch. - min 2 hours - Cooled in still air
 Test specimen orientation: Longitudinal

UFFICIO CONTROLLO QUALITA' QUALITY CONTROL DEPARTMENT 	ENTE UFFICIALE DI COLLAUDO INSPECTION AUTHORITY	MARCHIO PRODUZIONE MANUFACTURER'S SYMBOL
--	--	---

MLTS_6056-18732
Heat# SEE BELOW



CORPORATION

4151 North Service Road, Burlington, ON L7L 4X6 (905) 335-5320

Date: 6/14/2019

Mill Test Reports

Invoice: 1597082-00

PO: 2610096

Customer: 27403-261

A.B.F MINES/2985080

1310 AVE DAVY

REF 18777-6056

ROUYN NORANDA, QC J9Y 0A8



Line	Heat#	Product	Description
1	956v	7561733	8 STD WELD TEE A420WPL6
2	508105d	7586891	8 150 RF WN FLG STD A350LF2
3	508101C	7585666	8 300 RF BLIND FLG A350LF2
4	886v	7561288	6 STD LR 45 WELD ELL A420WPL6
5	18c1054	7561725	6 STD WELD TEE A420WPL6
6	508105g	7586832	6 150 RF WN FLG STD A350LF2
7	b03459	7585585	6 150 RF BLIND FLG A350LF2

Heat codes followed by ** have been corrected, change may not show on the packing slip

CERTIFICATE OF INSPECTION & TEST (EN 10204 3.1)



ST&H CORPORATION
 OFFICE - 74, Jwadongsunhwan-ro, Haeundae-gu, Busan, Korea
 PLANT - 11, Eogokgongdan 2-gil, Yangsan-si, Kyungnam, Korea
 Tel : +82.51.744-4680(5 line) Fax : +82.51.744-4670
 E-mail : qm@stnhcorp.com



Certificate No. MJH0165-02/07
 Customer CCTF CORPORATION
 Contract No. 4038929-00

Date : DEC. 20. 2018

Spec. For Material ASTM A105N-18, ASME SA105N-17, ASTM A350 LF2 CL1-18, ASME SA350 LF2 CL1-17, NACE MR0175/ISO 15156-2:2015, NACE MR0103/ISO 17495-1:2016
 Heat Treatment 930°C NORMALIZED & A/C

Certified to ISO9001/ISO14001:2015, PED2014/68/EC by LRQA

Dimensional inspection ASME B16.5 - 2017

ITEM / SIZE	Q'ty	Heat No./ Batch No.	Size of Test Specimen			Tension Test				Hardness Test (HB)	Charpy Impact Test (10X10mm Specimen Size)			
			D mm	GL mm	Y.S MPa	T.S MPa	E.L %	R.A %	Indiv. 16J		Ave. 20J	Notch V	Temp. -46°C	
														Max
			12.5	50.0	250	485	22.0	30.0	187					
7586502	5	508105C	12.5	50.0	330	522	33	73	150	155	136	154	142	144
7581210	20	508105C	12.5	50.0	330	522	33	73	150	155	136	154	142	144
7586891	20	508105D	12.5	50.0	330	522	33	73	150	155	136	154	142	144
7586867	25	508105D	12.5	50.0	330	522	33	73	150	155	136	154	142	144
7585496	35	508105D	12.5	50.0	330	522	33	73	150	155	136	154	142	144
BLANK		BLANK							BLANK	BLANK	136	154	142	144

Heat No./ Batch No.	Max Min	Chemical Composition (%)												NDE		
		C	Si	Mn	P	S	Ni	Cr	Mo	Cu	V	Nb		CE	UT	MT
		0.300	0.300	1.350	0.035	0.040	0.400	0.300	0.120	0.400	0.080	0.020				
		0.150	0.150	0.600												
508105C	H 0.159	0.234	1.260	0.011	0.003	0.019	0.077	0.005	0.017	0.001	0.004			0.388		
	P 0.160	0.244	1.250	0.014	0.003	0.017	0.079	0.006	0.018	0.001	0.004			0.387		
508105D	H 0.159	0.234	1.260	0.011	0.003	0.019	0.077	0.005	0.017	0.001	0.004			0.388		
	P 0.160	0.244	1.250	0.014	0.003	0.017	0.079	0.006	0.018	0.001	0.004			0.387		

REMARK * H : Heat Analysis P : Product Analysis

[Signature]



We hereby certify that the material herein has been made and tested in accordance with the above specification and also with the requirements called for by the above order.

Witnessed by / H. J. LEE

Manager of Q.A Dept. / JAY KIM

ST-801-14-02

ST&H CORPORATION

CERTIFICATE OF INSPECTION & TEST (EN 10204 3.1)

ST ST&H CORPORATION

OFFICE - 74, Jwadongsunhwan-ro, Haeundae-gu, Busan, Korea
PLANT - 11, Eogokgongdan 2-gil, Yangsan-si, Kyungnam, Korea
Tel : +82.51.744-4680(5 line) Fax : +82.51.744-4670
E-mail : qm@stnhcorp.com



CE
RPS DESIGN / 01

Certificate No. MJH0137-07/11

Date : DEC. 19, 2018

Customer CCTF CORPORATION

Contract No. 4038743-00

Spec. For Material ASTM A105N-18, ASME SA105N-17, ASTM A350 LF2 CL1-18, ASME SA350 LF2 CL1-17, NACE MR0175/ISO 15156-2:2015, NACE MR0103/ISO 17495-1:2016

Heat Treatment 930°C NORMALIZED & A.C

Certified to ISO9001 / ISO14001:2015, PED2014/68/EC by LRQA

Dimensional inspection ASME B16.5 - 2017

ITEM / SIZE	Q'ty	Heat No./ Batch No.	Size of Test Specimen		Tension Test				Hardness		Charpy Impact Test (10X10mm Specimen Size)					
			D mm	GL mm	Y.S MPa	T.S MPa	E.L %	R.A %	Test (HB)	Indiv. 16J	Ave. 20J	Notch V	Temp. -46°C			
														Max	Min	250
			Ave.(J)	187												
					Test Result (J)											
7585585	150LBS BL RF 6"	40	508101C	12.5	50.0	339	525	34	78	159	162	188	165	195	183	
7585666	300LBS BL RF 8"	25	508101C	12.5	50.0	339	525	34	78	159	162	188	165	195	183	
7580185	900/1500LBS SW RF S160 2"	20	508101C	12.5	50.0	339	525	34	78	159	162	188	165	195	183	
7580219	150LBS SO RF 10"	20	508101F	12.5	50.0	339	525	34	78	159	162	188	165	195	183	
7586507	150LBS SO RF 3"	50	508101F	12.5	50.0	339	525	34	78	159	162	188	165	195	183	
7586508	150LBS SO RF 4"	25	508101F	12.5	50.0	339	525	34	78	159	162	188	165	195	183	
7586509	150LBS SO RF 6"	70	508101F	12.5	50.0	339	525	34	78	159	162	188	165	195	183	
7580218	150LBS SO RF 8"	25	508101F	12.5	50.0	339	525	34	78	159	162	188	165	195	183	
BLANK			BLANK		BLANK		BLANK		BLANK		BLANK		BLANK		BLANK	

Heat No./ Batch No.	Max Min	Chemical Composition (%)												NDE		
		C	Si	Mn	P	S	Ni	Cr	Mo	Cu	V	Nb	CE	UT	MT	PT
508101C	H	0.160	0.207	1.250	0.009	0.007	0.020	0.091	0.002	0.024	0.001	0.004	0.390			
	P	0.164	0.220	1.250	0.009	0.005	0.013	0.092	0.002	0.022	0.003	0.004	0.394			
508101F	H	0.160	0.207	1.250	0.009	0.007	0.020	0.091	0.002	0.024	0.001	0.004	0.390			
	P	0.164	0.220	1.250	0.009	0.005	0.013	0.092	0.002	0.022	0.003	0.004	0.394			
BLANK																

REMARK * H : Heat Analysis P : Product Analysis



[Signature]

We hereby certify that the material herein has been made and tested in accordance with the above specification and also with the requirements called for by the above order.

Witnessed by / H. J. LEE
Manager of QA Dept. / JAY KIM
ST&H CORPORATION

ST-801-14-02



INSPECTION CERTIFICATE

Customer : CCTF CORPORATION
 Product : SEAMLESS LOW TEMPERATURE CARBON STEEL BUTT WELD FITTINGS
 Spec : ASTM A420-16/ASME SA420-15 WPL6, CSA Z245.11-17 Gr 241 Cat II -45C SS NACE MR0175/ISO 15156-2 Region 3-15 & NACE MR0103-16, ASTM A234-18/ASME SA234-15 WPB

ACCORDANCE WITH EN 10204-3.1
 CHUP HSIN ENTERPRISE CO., LTD.
 17, TUNG LI ROAD, HSIAO KANG DISTRICT, KAOHSIUNG CITY, TAIWAN, R.O.C.
 TEL:(07)831-9157 FAX:(07)821-7500, 831-2942

Certificate No : 00700220-0110
 Order No : 4039057-00
 Date : 2019/03/19

Raw Material		Specification for Inspection				Visual Inspection		Dimensional Inspection									
ASTM A106 GR.B/GREEN PIPE FOR A333-6		ASME B16.9-2012				PASS		PASS									
Item	Description	Quantity	Heat ID	Heat No	Raw Material Certificate No.	NDE MT	Test Temp ℃	Impact Test			Ave. J						
								Size of specimen mm	Charpy V-Notch Impact Value J								
123	45 E L/R WPL6 STD 756 1288 6	35	886V	1834886V	HENGYANG C201841289-1		-45	10 X 5.0 X 55	56	62	60						
131	RED TEE WPL6 STD 2624 4 X 2	10	885V	1834885V	HENGYANG C201841281-1	PASS	-45	10 X 5.0 X 55	54	48	51.33						
132	RED TEE WPL6 STD 2624 4 X 3	15	885V	1834885V	HENGYANG C201841281-1	PASS	-45	10 X 5.0 X 55	54	48	51.33						
135	TEE WPL6 XS 1938 6	8	A248	18322248	BAOSTEEL BGSAG1803080005100	PASS	-45	10 X 10 X 55	128	142	140						
136	TEE WPL6 XS 1946 8	2	E274	34274H	BAOSTEEL BGSQ1804040002900	PASS	-45	10 X 10 X 55	162	184	174.67						
Specifi- cation	Chemical Composition%										REMARK						
	C	Si	Mn	P	S	Cu	Ni	Cr	Mo	V		Nb	C.E	Y.S	T.S	E	Hardness Test
	X100	X100	X100	X1000	X1000	X100	X100	X100	X100	X1000	X1000	X100	P.S.I	P.S.I	%	HB	
Min.		15	50										35000	60000	30		
Max.	30	40	135	35	40	40	40	30	12	80	20	50		95000		197	
123	13	31	98	11	1	5	2	6	1	1	<1	31	49044	68100	42.5	135-138	NORM. 910 Cx0.5HR AC
131	13	31	100	11	2	5	2	6	2	<1	<1	31	47738	67600	37.0	138-139	
132	13	31	100	11	2	5	2	6	2	<1	<1	31	47738	67600	37.0	138-139	
135	13	15	74	6	4	4	2	4	1	<1	<1	27	39322	63600	40.0	138-139	
136	15	18	89	9	4	1	3	4	<1	<1	1	31	38306	68100	35.5	134-135	

C.E. = C+Mn / 6 + (Cr+Mo+V)/5 + (Ni+Cu)/15

We hereby certify that the material herein described has been manufactured, sampled, tested and inspected in accordance with, and was found to meet, the requirements of above specifications and purchaser's order.

K. Y. Tsai
 Chief of Quality Assurance Section



INSPECTION CERTIFICATE

PURCHASER SEYBOLD INT'L CORP.
 STANDARD ASTM A420 WPL6-16
 ASME SA420 WPL6-04
 CSA Z245.11-17 Gr.290 CAT II Sour Service
 MATERIALS ASTM A333-6
 INSP SPEC ASME B16.9 -12

8. MEI-CHUNG RD. NIAO-SONG,
 KAOHSIUNG 83301, TAIWAN
 TEL: 886-77310527-8
 FAX: 886-77315887

DATE: 2019-01-07
 ORDER NO: 7014596/4038286-00
 P.I. NO: 18B05-1
 CERTIFI NO: 181212-1

ACCORDING TO EN10204/DIN50049/3.1

ITEM NO.	PRODUCT & SIZE	QUANTITY PCS	MFG NO.	VISUAL & DIMENSIONAL INSPECTION	HARDNESS MAX. 197 HB	HEAT TREATMENT (NOTE)	MAGNETIC PARTICLE EXAMINATION	IMPACT TEST (J)												
35	TEE 6"WPL6 STD 7561725	25	18C1054	GOOD	132-143	N	GOOD	10 x 5.0 x 2V AT -45 °C 112.4 115.3 129.7 119.1												
ITEM NO.	MATERIAL CHARGE NO.	CHEMICAL COMPOSITION %											PHYSICAL TEST							
		C	Si	Mn	P	S	Cu	Ni	Cr	Mo	V	Nb	Ti	B	Y S	T S	E	**	*CE	*CEQ
		STANDARD	MIN.	MAX.																
35	J4LB254	11	26	130	14	3	1	100	25	13	100	2	1		42.0	60.0	27.0		50	50
									12	1	<1	<1	2	<1	44.1	66.9	30.9	L	35	29

(NOTE): A-HOT FORMED WITH FINAL TEMPERATURE BETWEEN 630°C - 980°C. AIR COOLING.
 N-NORMALIZING AT TEMPERATURE 880°C X0.5HR. AIR COOLING. S-STRESS RELIEF AT TEMPERATURE 650°C X0.5HR.
 NACE MR0175-2015/ISO15156-1 NACE MR0103-2015/ISO17945: SATISFACTORY
 WE HEREBY CERTIFY THAT THE PRODUCT DESCRIBED HEREIN HAS BEEN MANUFACTURED IN ACCORDANCE WITH THE SPECIFICATIONS CONCERNED AND ALSO WITH THE PURCHASER'S REQUIREMENTS AND THAT THE TEST RESULTS SHOWN HEREIN ARE CORRECT.
 * TYPE OF SPECIMEN-STRIP (WIDTH: 1 in. / GAGE LENGTH: 2 in.) ** SAMPLING DIRECTION: L=LONGITUDINAL, T=TRANSVERSE
 *($\frac{Fe}{Fe+Mn+6+(Cr+Ni+V)/5} + \frac{Cu+Nb}{15} + \frac{Ti}{20} + \frac{C}{100} + \frac{Nb}{5} + \frac{B}{5} + \frac{V}{5} + \frac{Sb}{5}$)

Ou L Lan

MANAGER OF Q.A. DEPT.

CERTIFICATE OF INSPECTION & TEST (EN 10204 3.1)



ST&H CORPORATION
 OFFICE - 74, Jwadongsunhwan-ro, Haeundae-gu, Busan, Korea
 PLANT - 11, Eogokgongdan 2-gil, Yangsan-si, Kyungnam, Korea
 Tel : +82.51.744-4680(5 line) Fax : +82.51.744-4670
 E-mail : qm@stnhcorp.com



Certificate No. MJH0165-03/07 **Date :** DEC. 20. 2018
Customer CCTF CORPORATION
Contract No. 4038829-00
Spec. For Material ASTM A105N-18, ASME SA105N-17, ASTM A350 LF2 CL1-18, ASME SA350 LF2 CL1-17, NACE MR0175/ISO 15156-2:2015, NACE MR0103/ISO 17495-1:2016
Heat Treatment 930°C NORMALIZED & A.C

Certified to ISO9001/ ISO14001:2015, PED2014/68/EC by LRQA
 Dimensional inspection ASME B16.5 - 2017

ITEM / SIZE	Q'ty	Heat No./ Batch No.	Size of Test Specimen		Tension Test					Hardness		Charpy Impact Test (10X10mm Specimen Size)				
			D mm	GL mm	Y.S MPa	T.S MPa	E.L %	R.A %	Test (HB)	Indiv. 16J	Ave. 20J	Notch V	Temp. -46°C			
12.5	50.0	Max	Min	250	485	22.0	30.0	187	Test Result (J)							
	5	508105E	12.5	50.0			330	522	33	73	150	155	136	154	142	144
	10	508105E	12.5	50.0			330	522	33	73	150	155	136	154	142	144
	10	508105E	12.5	50.0			330	522	33	73	150	155	136	154	142	144
	5	508105E	12.5	50.0			330	522	33	73	150	155	136	154	142	144
	50	508105G	12.5	50.0			330	522	33	73	150	155	136	154	142	144
		BLANK														
		BLANK														

Heat No./ Batch No.	Max Min	Chemical Composition (%)											NDE			
		C	Si	Mn	P	S	Ni	Cr	Mo	Cu	V	Nb	CE	UT	MT	PT
508105E	H	0.159	0.234	1.260	0.011	0.003	0.019	0.077	0.005	0.017	0.001	0.004	0.388			
	P	0.160	0.244	1.250	0.014	0.003	0.017	0.079	0.006	0.018	0.001	0.004	0.387			
508105G	H	0.159	0.234	1.260	0.011	0.003	0.019	0.077	0.005	0.017	0.001	0.004	0.388			
	P	0.160	0.244	1.250	0.014	0.003	0.017	0.079	0.006	0.018	0.001	0.004	0.387			
BLANK																

REMARK * H : Heat Analysis P : Product Analysis

[Signature]

We hereby certify that the material herein has been made and tested in accordance with the above specification and also with the requirements called for by the above order.

Witnessed by / H. J. LEE
 Manager of Q.A Dept. / JAY KIM
 ST&H CORPORATION



CERTIFICATE OF INSPECTION & TEST (EN 10204 3.1)

ST

ST&H CORPORATION

OFFICE - 74, Jwadongsunhwan-ro, Haeundae-gu, Busan, Korea
 PLANT - 11, Eogokgongdan 2-gil, Yangsan-si, Kyungnam, Korea
 Tel : +82.51.744-4680(5 line) Fax : +82.51.744-4670
 E-mail : qm@stnhcorp.com



CE

RPS 010006 / 01

Certificate No. MJH0290-01/05

Customer CCTF CORPORATION

Contract No. 4039095-00

Spec. For Material ASTM A105N-18, ASME SA105N-17, ASTM A350 LF2 CL1-18, ASME SA350 LF2 CL1-17, NACE MR0175/ISO 15156-2:2015, NACE MR0103/ISO 17495-1:2016

Heat Treatment 930°C NORMALIZED & A.C

Date : FEB. 14. 2019

E-mail : qm@stnhcorp.com

Certified to ISO9001/ ISO14001:2015, PED2014/68/EC by LRQA

Dimensional inspection ASME B16.5 - 2017

ITEM / SIZE	Q'ty	Heat No./ Batch No.	Size of Test Specimen		Tension Test					Hardness Test (HB)	Charpy Impact Test (10X10mm Specimen Size)				
			D mm	GL mm	Y.S MPa	T.S MPa	E.L %	R.A %	Indiv. 16J		Ave. 20J	Notch V	Temp. -46°C		
			12.5	50.0	Min	250	485	22.0	30.0	187	Test Result (J)				
															Ave.(J)

7585585	150LBS BL RF 6"	20	803459	12.5	50.0	330	520	34	76	150	156	80	75	86	80
7585860	150LBS BL RF 8"	10	803459	12.5	50.0	330	520	34	76	150	156	80	75	86	80
7580218	150LBS SO RF 8"	20	803459	12.5	50.0	330	520	34	76	150	156	80	75	86	80
7580202	150LBS SO RF 14"	2	803459	12.5	50.0	330	520	34	76	150	156	80	75	86	80
7586502	150LBS TH RF 6"	5	803459	12.5	50.0	330	520	34	76	150	156	80	75	86	80
7586824	150LBS WN RF STD 4"	50	803459	12.5	50.0	330	520	34	76	150	156	80	75	86	80
7586832	150LBS WN RF STD 6"	30	803459	12.5	50.0	330	520	34	76	150	156	80	75	86	80
7586891	150LBS WN RF STD 8"	20	803459	12.5	50.0	330	520	34	76	150	156	80	75	86	80
7583949	300LBS WN RF STD 8"	10	803459	12.5	50.0	330	520	34	76	150	156	80	75	86	80
7585321	150LBS WN RF STD 10"	20	803459	12.5	50.0	330	520	34	76	150	156	80	75	86	80

Heat No./ Batch No.	Max Min	Chemical Composition (%)											NDE				
		C	Si	Mn	P	S	Ni	Cr	Mo	Cu	V	Nb	CE		UT	MT	PT
		0.300	0.300	1.350	0.035	0.040	0.400	0.300	0.120	0.400	0.080	0.020					
			0.150	0.600													

B03459	H	0.163	0.226	1.230	0.012	0.002	0.057	0.138	0.017	0.147	0.001	0.006	0.412			
	P	0.162	0.224	1.240	0.011	0.002	0.054	0.136	0.014	0.138	0.001	0.001	0.411			

BLANK

REMARK * H : Heat Analysis P : Product Analysis



Witnessed by / H. J. LEE

We hereby certify that the material herein has been made and tested in accordance with the above specification and also with the requirements called for by the above order.

Manager of Q.A Dept. / JAY KIM
 ST&H CORPORATION

ST-801-14-02

MLTS_6056-18777
Heat# SEE BELOW



CORPORATION

5407 53rd Avenue, Edmonton, AB T6B 3G2 (780) 463-8700

Date: 6/14/2019

Mill Test Reports

Invoice: 5736215-00

PO: WT

Customer: 498

A.B.F. MINES/2985080 CANADA

1310 AVE DAVY

REF 18777-6056

ROUYN-NORANDA, QC J9Y 0A8

Line	Heat#	Product	Description
1	61k01m028	7561296	8 STD LR 45 WELD ELL A420WPL6
1	61m01m049	7561296	8 STD LR 45 WELD ELL A420WPL6
1	61n01m031-1	7561296	8 STD LR 45 WELD ELL A420WPL6
2	b21a8	7583949	8 300 RF WN FLG STD A350LF2

Heat codes followed by ** have been corrected, change may not show on the packing slip

Purchaser: CCTF CORPORATION

INSPECTION CERTIFICATE

TO EN10204 3.1



Thai Benkan Co., Ltd.
58 Soi Watrunoi, Bangru, Prapadaeng,
Samutprakan, 10130 Thailand.

Purchase Order No. 4901180-00
Job No.

D M Y Certificate No.
09/11/2018 T - 2018031531

E-No.	Specification for Material Made from Seamless Pipe	Specification for Inspection	Visual Examination	Dimensional Inspection													
TA-162	ASTM A420-16 / ASME SA420-17 Gr.WPL6 CSA Z45.11-17 Gr.241 CAT B WELC Sour Service	ASME B16.9-2012,B16.25-2017	Good	Good													
MFG. No.	Product & Size	(T:*)	Quantity	Hardness Actual Data													
61K01M028	45 EL WPL6 8 STD		10	HBW:115-145													
	Material Heat No.	Item No.															
	184740	7561296															
	Chemical Composition %											*2 Tension Test	transverse		HARDNESS MAX 197 HB : 0000		
Specifi- cation	C	Si	Mn	P	S	Cu	Ni	Cr	Mo	Al	V	Nb	C.E.	Y S	T S	E	Impact Test (I) longitudinal 10 X 6.7 X 2V AT -45 °C
	X 100	X 100	X 100	X 1000	X 1000	X 100	X 100	X 100	X 100	X 1000	X 1000	X 1000	X 100	MPa.			
Min.		15	50											241	415	30	120
Max.	30	35	135	35	40	40	40	30	12		80	20			585		129 AVE. 127
	15	21	105	9	5	6	4	5	2		1	1	35	305	481	41	131

NORMALIZING 910 C X 40 MINUTES. COOLED IN STILL AIR

The product was manufactured, sampled, tested, and inspected as specified in this Standard and the purchase order, and was found to have met such requirements.

The material meet ANSI/NACE MR0175/ISO15156-2 (Region 3) :2015 & MR0103-2015

C.E. = C+Mn/6+(Cr+Mo+V)/5+(Ni+Cu)/15

MAGNETIC PARTICLE EXAMINATION FOR THE ONLY :

We hereby certify that the product described herein has been manufactured in accordance with the specifications concerned and also with the purchaser's requirements and that the test results shown herein are correct.

* 1 : "T" symbolized wall thickness in mm. * 2 : YS Yield strength TS = Tensile strength E = Elongation
Form T7-6/11

CSE
Rungtapa Kemphanon

Quality Assurance Manager

Thai Benkan Co., Ltd.

Purchaser : CCTF CORPORATION

INSPECTION CERTIFICATE

TO EN10204 3.1

BENKAN.

Thai Benkan Co., Ltd.
58 Soi Watkrumji, Bangkru, Prapadaeng,
Samutprakan, 10130 Thailand.

Purchase Order No.
4901220-00

Job No.

D M Y Certificate No.
09/11/2018 T - 2018031547

E-No.		Specification for Material Made from Seamless Pipe		Specification for Inspection		Visual Examination		Dimensional Inspection											
TA-169		ASTM A420-16 / ASME SA420-17 Gr.WPL6 CSA Z45.11-17 Gr.241 CAT B M50C Sour Service		ASME B16.9-2012,B16.25-2017		Good		Good											
MFG. No.		Product & Size		(T:*)		Quantity		Hardness Actual Data											
61M01M049		45 EL WPL6 8 STD				10		HBW:115-145											
		Material Heat No.		Item No.															
		J8K4597		7561296															
		Chemical Composition %												#2 Tension Test		transverse		HARDNESS MAX 197HB : GOOD	
Specifi- cation	C	Si	Mn	P	S	Cu	Ni	Cr	Mo	Al	V	Nb	C.E.	Y S	T S	E	Impact Test (J) longitudinal		
	X 100	X 100	X 100	X 1000	X 1000	X 100	X 100	X 100	X 100	X 1000	X 1000	X 1000	X 100	MPa.			%	10 X 6.7 X 2V AT -46 °C	
Min.		15	50											241	415	30	161		
Max.	30	35	135	35	40	40	40	30	12		80	20			585		174	AVE. 173	
	12	27	128	11	1	2	2	11	1		0	0	36	286	458	46	183		

NORMALIZING 810 C X 40 MINUTES. COOLED IN STILL AIR

The product was manufactured, sampled, tested, and inspected as specified in this Standard and the purchase order, and was found to have met such requirements.

The material meet ANSI/NACE MR0175/ISO15156-2 (Region 3) :2015 & MR0103-2015

C.E. = C+Mn/6+(Cr+Mo+V)/5+(Ni+Cu)/15

MAGNETIC PARTICLE EXAMINATION FOR TEE ONLY :

We hereby certify that the product described herein has been manufactured in accordance with the specifications concerned and also with the purchaser's requirements and that the test results shown herein are correct.

* 1 : "T" symbolized wall thickness in mm. * 2 : YS Yield strength TS = Tensile strength E = Elongation

Form T7-611



Bangsapa Kaupitakon

Quality Assurance Manager

Thai Benkan Co., Ltd.

Purchaser : CCTF CORPORATION

INSPECTION CERTIFICATE

TO EN10204 3.1

BENKAN.

Thai Benkan Co., Ltd.
58 Soi Watkrusi, Bangkru, Prapadaeng,
Samutprakan, 10130 Thailand.

Purchase Order No. 4801278-00

Job No.

D M Y Certificate No.
11/12/2018 T - 2018031649

E-No.		Specification for Material Made from Seamless Pipe		Specification for Inspection		Visual Examination		Dimensional Inspection											
TA-194		ASTM A420-16 / ASME SA420-17 Gr.WPL6 CSA Z46.11-17 Or 241 CAT B WISC Sour Service		ASME B16.9-2012,B16.25-2017		Good		Good											
MFG. No.		Product & Size		(T*1)		Quantity		Hardness Actual Data											
61N01M031-1		45 EL WPL6 8 STD				9/10		HBW:115-145											
		Material Heat No.		Item No.															
		185081		7581286															
		Chemical Composition %												*2 Tension Test		transverse		HARDNESS MAX 197 HB : GOOD	
Specifi- cation	C	Si	Mn	P	S	Cu	Ni	Cr	Mo	Al	V	Nb	C.E.	Y S	T S	R	Impact Test (J)		
	X 100	X 100	X 100	X 1000	X 1000	X 100	X 100	X 100	X 100	X 1000	X 1000	X 1000	X	MPa.			%	10 X 7.5 X 2V AT -46 °C	
Min.		15	50											241	415	30	115		
Max.	30	35	135	35	40	40	40	30	12		80	20			585		118	AVE. 118	
	16	25	106	10	4	6	4	5	2		1	1	36	309	480	40	120		

NORMALIZING 910 C X 40 MINUTES. COOLED IN STILL AIR

The material meet ANS/INACE MR0175/ISO15156-2 (Region 3) :2015 & MR0103-2015

The product was manufactured, sampled, tested, and inspected as specified in this Standard and the purchase order, and was found to have met such requirements.

C.E. = C+Mn/6+(Cr+Mo+V)/5+(Ni+Cu)/15

MAGNETIC PARTICLE EXAMINATION FOR TEE ONLY :

We hereby certify that the product described herein has been manufactured in accordance with the specifications concerned and also with the purchaser's requirements and that the test results shown herein are correct.

* 1 : "T" symbolized wall thickness in mm. * 2 : YS Yield strength TS = Tensile strength E = Elongation
Form TZ-6/1

Ratana Karmkarn

Quality Assurance Manager

Thai Benkan Co., Ltd.

CLIENTE / Customer / Client
CCTF CORPORATION (ONTARIO)
4151 NORTH SERVICE RD.
UNIT 2
BURLINGTON, ONTARIO
L7L4X6 - CANADA
CAN

CERTIFICADO DE INSPECCION

Inspection Certificate - Certificat de Réception

UNE EN 10204.06 / 3.1
ISO 10474:15 / 3.1

FECHA: 27/06/2018
Date: 195066
HOJA: 2
Page: 2

PRODUCTO Article - Produit
FLANGES
ASME B16.5-17
NORMAS APLICABLES Requirements - Normes Applicables
MATERIAL CORRESPONDIENTE ASME SA350LF2CL1-2-17, ASTM A350LF2CL1-2-17

ASME B16.5-17

SU PEDIDO N.º Your Order No.
43038605-00 TORONTO
Votre Cde. N.º

DE 28/05/2018
of - de

MARCA DEL FABRICANTE
Mark of factory
Marque du fabricant



Packing 140699

NACE MR0175/ISO15156-02/03-15 & NACE MR0103/ISO17495-15
Clause 7.2.1.4, Annex A.2 and SSC Region 3.
CSA-Z245.12-17 GR248 CAT II-SS (WN & BLIND FLANGES ONLY)

PARTIDA Item Poste	CANTIDAD Quantity Quantité	DESCRIPCION Description Description	LOTE	OBSERVACIONES Remarks Observations	COLADA N.º Heat No. N.º Coulee	RESISTENCIA T. Strength Tensile Rupt N/mm2	LONGITUD Elongation Allongement Lo-50mm/4g %	RESILIENCIA Impact test Resilience Joules	CHARPY V 10x10mm MEDIA Average Moyenne J/C	DUREZA Hardness Dureté HBW
39 7580201	30	WN 1.1/2 150LB XS/80 RF A350LF2	24Y16	NE	A45A6	517	26.00	58	62	152 156
45 7581005	1	BLIND 14 150LB RF A350LF2	02M18G	NE	25AV8	522	30.20	59	64	150 154
46 7581006	1	BLIND 16 150LB RF A350LF2	06J803	NE	69AV8	507	30.40	60	60	147 148
48 7581006	1	BLIND 16 150LB RF A350LF2	19D17	NE	B64A7	499	33.30	45	42	144 148
48 7583949	1	WN 8 300LB STD/40 RF A350LF2	16Y816	NE	97AV8	517	29.80	75	70	150 151
48 7583949	7	WN 8 300LB STD/40 RF A350LF2	04J802	NE	B21A8	515	32.60	69	67	148 150
52 7582780	3	BLIND 8 600LB RF A350LF2	22Y827	NE	73AV8	511	36.30	58	52	147 148
52 7582780	3	BLIND 8 600LB RF A350LF2	23Y809	NE	73AV8	502	38.10	90	62	146 149

COMPOSICION QUIMICA - STEEL MAKER'S LADLE ANALYSIS - ANALYSE CHIMIQUE

COLADA N.º Heat No. N.º Coulee	C %	Si %	Mn %	P %	S %	Cr %	Ni %	Mo %	Nb %	V %	Cu %	Al %	Ti %	B %	CEq %
25AV8	0.190	0.230	1.050	0.005	0.007	0.058	0.090	0.014	0.002	0.004	0.180	0.025	0.002	0.0003	0.40
69AV8	0.184	0.200	1.115	0.012	0.003	0.055	0.147	0.017	0.001	0.001	0.138	0.033	0.001	0.0001	0.40
73AV8	0.190	0.193	1.073	0.011	0.003	0.062	0.075	0.015	0.001	0.001	0.112	0.037	0.002	0.0001	0.40
97AV8	0.190	0.220	1.110	0.005	0.007	0.045	0.072	0.012	0.003	0.005	0.150	0.027	0.002	0.0003	0.40
A45A6	0.195	0.222	0.994	0.007	0.008	0.053	0.103	0.024	0.000	0.001	0.212	0.028	0.001	0.0005	0.40
B21A8	0.170	0.190	1.060	0.011	0.004	0.110	0.090	0.009	0.004	0.000	0.180	0.029	0.001	0.0004	0.39
B64A7	0.190	0.170	1.030	0.011	0.004	0.100	0.060	0.008	0.007	0.006	0.150	0.041	0.001	0.0002	0.40

(*) OBSERVACIONES.

Remarks

Observations

N NORMALIZED AT 900 C AND ALLOWED TO COOL IN STILL AIR.

Las dimensiones y la condición superficial se hallaron satisfactorias.
Dimension and surface condition were found acceptable
Les dimensions et états de surface sont satisfaisants.

Los materiales citados cumplen las normas aplicables.
Manufacturing requirements are satisfied
Les normes applicables sont respectées.

EL INSPECTOR
Works Inspector - L'inspecteur



ULMA FORJAS COOP
Dpto. de Garantía de Calidad
Quality Assurance Dept

MLTS_6056-18929

Heat# B03238 A07A9 B011568B B05432B



CORPORATION

4151 North Service Road, Burlington, ON L7L 4X6 (905) 335-5320

Date: 8/8/2019

Mill Test Reports

Invoice: 1599344-00

PO: 2610155

Customer: 27403-261

A.B.F. MINES/2985080

1310 AVE DAVY

ROUYN-NORANDA, QC J9Y 0A8

Line	Heat#	Product	Description
1	b03238	7586832	6 150 RF WN FLG STD A350LF2
2	a07a9	7586824	4 150 RF WN FLG STD A350LF2
3	b01568b	7586509	6 150 RF SO FLG A350LF2
4	b05432b	7586508	4 150 RF SO FLG A350LF2

Heat codes followed by ** have been corrected, change may not show on the packing slip

CERTIFICATE OF INSPECTION & TEST (EN 10204 3.1)

ST&H CORPORATION

OFFICE - 74, Jwadongsunhwan-ro, Haendae-gu, Busan, Korea
PLANT - 11, Eogokgongdan 2-gil, Yangsan-si, Kyungnam, Korea
Tel : +82.51.744-4680(5 line) Fax : +82.51.744-4670

E-mail : qm@stnhcorp.com



CE

RPS 040209 / 01

Certificate No. MJH0103-10/16

Customer CCTF CORPORATION

Contract No. 4038603-00

Spec. For Material ASTM A105N-14, ASME SA105N-17, ASTM/ASME A/SA350 LF2 CL1-17, NACE MR0175/ISO 15156-2:2015, NACE MR0103/ISO 17495-1:2016

Heat Treatment 930°C NORMALIZED & A.C

Date : AUG. 27. 2018

Certified to ISO9001 / ISO14001:2015, PED2014/68/EC by LRQA

Dimensional inspection ASME B76.5 - 2017

ITEM / SIZE	Q'ty	Heat No./ Batch No.	Size of Test Specimen		Tension Test					Hardness Test (HB)	Charpy Impact Test (10X10mm Specimen Size)				
			D mm	GL mm	Y.S MPa	T.S MPa	EL %	R.A %	Indiv. 16J		Ave. 20J	Natch V	Temp. -46°C		
			12.5	50.0	Max	Min	250	485	22.0	30.0	187	Test Result (J)			
															Ave. (J)

7586502	150LBS TH RF 6"	2	B03238	12.5	50.0	375	545	35	67.5	151	153	118	145	68	110
7586824	150LBS WN RF STD 4"	50	B03238	12.5	50.0	375	545	35	67.5	151	153	118	145	68	110
7586832	150LBS WN RF STD 6"	50	B03238	12.5	50.0	375	545	35	67.5	151	153	118	145	68	110
7585267	150LBS WN RF XH 4"	10	B03238	12.5	50.0	375	545	35	67.5	151	153	118	145	68	110
7580014	300LBS SO RF 4"	5	B03238	12.5	50.0	375	545	35	67.5	151	153	118	145	68	110
7587735	300LBS SO RF 6"	2	B03238	12.5	50.0	375	545	35	67.5	151	153	118	145	68	110
7585259	600LBS WN RF STD 3"	10	B03238	12.5	50.0	375	545	35	67.5	151	153	118	145	68	110
7581040	600LBS WN RF XH 3"	25	B03238	12.5	50.0	375	545	35	67.5	151	153	118	145	68	110
7581007	150LBS BL RF 18"	2	B03776	12.5	50.0	375	540	38	74.5	152	154	135	80	118	111
7580205	150LBS SO RF 20"	2	B03776	12.5	50.0	375	540	38	74.5	152	154	135	80	118	111

Heat No./ Batch No.	Chemical Composition (%)														NDE		
	C	Si	Mn	P	S	Ni	Cr	Mo	Cu	V	Nb	CE	UT	MT	PT		
	Max	0.300	0.300	1.350	0.035	0.040	0.400	0.300	0.120	0.400	0.080	0.020					
	Min	0.150	0.600														
B03238	H	0.176	0.201	1.060	0.015	0.004	0.032	0.077	0.004	0.050	0.001	0.001	0.374				
	P	0.178	0.216	1.060	0.016	0.002	0.036	0.073	0.007	0.050	0.002	0.001	0.376				
	H	0.172	0.220	1.290	0.013	0.007	0.012	0.045	0.006	0.008	0.004	0.019	0.399				
B03776	P	0.174	0.220	1.290	0.011	0.003	0.012	0.044	0.006	0.008	0.001	0.015	0.400				

REMARK * H : Heat Analysis P : Product Analysis

We hereby certify that the material herein has been made and tested in accordance with the above specification and also with the requirements called for by the above order.

ST-801-14-02

Witnessed by / H. J. LEE

Manager of QA Dept. / JAY KIM

ST&H CORPORATION



CLIENTE / Customer / Client
CCTF CORPORATION (ONTARIO)
4151 NORTH SERVICE RD.
UNIT 2
BURLINGTON, ONTARIO
L7L4X6 - CANADA
CAN

CERTIFICADO DE INSPECCION

Inspection Certificate - Certificat de Réception

UNE EN 10204.06 / 3.1
ISO 10474.15 / 3.1

FECHA:
Date:

21/05/2019

N.º

HOJA:
Page:

2

203034

PRODUCTO
Article - Produit

FLANGES

SU PEDIDO N.º
Your Order No.

4039198-00

DE
of - de

18/02/2019

NORMAS APLICABLES
Requirements - Normes Applicables

ASME B16.5-17

MATERIAL CORRESPONDIENTE
Material Correspondent - Qualité

ASTM A350LF2CL1-2-17, ASTM A350LF2CL1-2-18

MODO DE FUSION (*)
Steel Making - Elaboration de l'acier

NACE MR0175/ISO15156-02/03-15 & NACE MR0103/ISO17495-15

Clause 7.2.1.4, Annex A.2 and SSC Region 3.

CSA-Z245.12-17 GR248 CAT II-SS (WN & BLIND FLANGES ONLY)

E = Elec. Y = Oxígeno básico

PARTIDA Item Poste	CANTIDAD Quantity Quantité	DESCRIPCION Description Description	LOTE	OBSERVACIONES Remarks Observations	COLADA N.º Heat No. N.º coulé	RESISTENCIA Y. Strength Y. Résist. Rp0.2 N/mm²	ELONGACION Elongation Lo-50mm/Aq. %	ESTRICCION Red Area Striction %	RESILIENCIA Impact test Resilience Joules	CHARPY V 10x10mm MEDIA Average Moyenne °C	DUREZA Hardness Dureté HBW
15 7586824	56	WN 4 150LB STD/40 RF A350LF2	18M912	NE	A07A9	502	36.44	71.53	102	99	146 148
22 7585496	24	WN 6 300LB STD/40 RF A350LF2	01F901	NE	B88A8	494	36.14	74.27	125	55	136 138
30 7586646	10	BLIND 2 500LB RF A350LF2	09A901	NE	A63A9	512	30.40	72.40	112	100	140 146

COMPOSICION QUIMICA - STEEL MAKER'S LADLE ANALYSIS - ANALYSE CHIMIQUE

COLADA N.º Heat No. Ladle - L Product - P	C %	Si %	Mn %	P %	S %	Cr %	Ni %	Mo %	Nb %	V %	Cu %	Al %	Ti %	B %	Ceq %	Origin of Steel
A07A9 L	0.192	0.206	1.138	0.008	0.004	0.037	0.050	0.017	0.000	0.002	0.053	0.034	0.001	0.0002	0.40	Germany
B88A8 L	0.182	0.206	1.153	0.010	0.005	0.050	0.057	0.014	0.001	0.002	0.061	0.026	0.001	0.0004	0.40	Germany
A63A9 L	0.189	0.223	1.151	0.011	0.005	0.049	0.055	0.012	0.001	0.002	0.094	0.028	0.002	0.0002	0.40	Germany

(*) OBSERVACIONES:
Remarks

N NORMALIZED AT 900 C AND ALLOWED TO COOL IN STILL AIR.

Observations



ULMA FORJA, S.COOP.

Bº Zubillaga, 3 - Apdo. 14

20560 OÑATI (Gipuzkoa) SPAIN

Tel.: 34 - 943 780552

Fax: 34 - 943 781808

E-mail: ulma@ulmaproing.com

Packing 148506

MARCA DEL FABRICANTE

Mark of factory

Marque du fabricant

DEPARTAMENTO QUALITY ASSURANCE

Section

Département

- Las dimensiones y la condición superficial se hallaron satisfactorias.
- Dimension and surface condition were found acceptable.
- Les dimensions et états de surface sont satisfaisants.

- Los materiales citados cumplen las normas aplicables.
- Manufacturing requirements are satisfied.
- Les normes applicables sont respectées.



CERTIFICATE OF INSPECTION & TEST (EN 10204 3.1)

ST&H CORPORATION
 OFFICE - 74, Jwadongsunhwan-ro, Haeundae-gu, Busan, Korea
 PLANT - 11, Eogokgongdan 2-gil, Yangsan-si, Kyungnam, Korea
 Tel : +82.51.744-4680(5 line) Fax : +82.51.744-4670
 E-mail : qm@stnhcorp.com



Certificate No. MJH0427-07/08
 Customer CCTF CORPORATION
 Contract No. 4039342-00

Date : JUN. 17. 2019

Certified to ISO9001/ ISO14001:2015, PED2014/68/EC by LRQA

Spec. For Material ASTM A105N-18, ASME SA105N-17, ASTM A350 LF2 CL1-18, ASME SA350 LF2 CL1-17, NACE MR0175/ISO15156-2:2015, NACE MR0103/ISO17945:2015
 Heat Treatment 930°C NORMALIZED & A.C

Dimensional inspection ASME B16.5 - 2017

ITEM / SIZE	Q'ty	Heat No./ Batch No.	Size of Test Specimen		Tension Test				Hardness Test (HB)		Charpy Impact Test (10X10mm Specimen Size)									
			D mm	GL mm	Y.S MPa	T.S MPa	E.L %	R.A %	Test (HB)	Indiv.	Ave.	Notch	Temp. -46°C							
														Max	655	187	16J	20J	V	
																				Test Result (J)
7589925	2	801979E	12.5	50.0	250	485	22.0	30.0	137	60	65	59	61							
7580216	15	805432B	12.5	50.0	357	515	41	76	150	154	89	86	99	91						
7586504	25	805432B	12.5	50.0	357	515	41	76	150	154	89	86	99	91						
7586507	50	805432B	12.5	50.0	357	515	41	76	150	154	89	86	99	91						
7586508	80	805432B	12.5	50.0	357	515	41	76	150	154	89	86	99	91						
7587602	25	805432B	12.5	50.0	357	515	41	76	150	154	89	86	99	91						
7587603	25	805432B	12.5	50.0	357	515	41	76	150	154	89	86	99	91						
7587600	250	805432B	12.5	50.0	357	515	41	76	150	154	89	86	99	91						
7587604	50	805432B	12.5	50.0	357	515	41	76	150	154	89	86	99	91						
7587601	25	805432B	12.5	50.0	357	515	41	76	150	154	89	86	99	91						
Chemical Composition (%)																				
Heat No./ Batch No.	Max Min	C	Si	Mn	P	S	Ni	Cr	Mo	Cu	V	Nb	CE	PT						
		0.300 0.150	0.300 0.150	1.350 0.600	0.035 0.035	0.040 0.040	0.400 0.400	0.300 0.300	0.120 0.120	0.400 0.400	0.080 0.080	0.020 0.020								

REMARK * H : Heat Analysis P : Product Analysis * C:Mn = 1±5

We hereby certify that the material herein has been made and tested in accordance
 with the above specification and also with the requirements called for by the above order.

Witnessed by / H. J. LEE

Manager of Q.A Dept. / JAY KIM

ST-801-14-02

ST&H CORPORATION



CERTIFIED MILL TEST REPORT



The Best Value -
Price, Quality, Service
All The Time.

LOG NO. F00000000100245

Page 1 of 2

BONNEY FORGE CORPORATION

P.O. BOX 330 • 14496 CROGHAN PIKE • MOUNT UNION, PA 17066-0330

(814) 542-2545 • (800) 345-7546 • FAX (814) 542-4906

www.bonneyforge.com

CUSTOMER: CCTF CORPORATION

DATE 10/04/2017

CUSTOMER

BONNEY ORDER NO. B000229128

ORDER NO.: 4037926-00

SHIP TO: CCTF CORPORATION (BURLINGTON)

4151 NORTH SERVICE ROAD

UNIT 2

BURLINGTON ON L7L 4X6

Canada

ITEM		QUANTITY	LOT NO.	GRADE OR SPECIFICATION NO CHEMICAL ANALYSIS, PHYSICAL PROPERTIES, REMARKS:							
3	50	50196	36-3X1 3M LF2 FLEX T	SA/A350 LF2 CL1							
7690075			Al 0.032 C 0.200 Co 0.002 Cr 0.040 Cu 0.030 Mn 1.050 Mo 0.003 Nb 0.014 Ni 0.020 P 0.005 S 0.019 Si 0.270 V 0.003 CE(Long Formula) = 0.39 T/S(PSI) 71,610 Y/S(PSI) 47,449 EL(%) 36.85 RA(%) 57.04 Brinell 135 BHN 135 BHN Charpy -50 F 77/66/56 (Ft-Lbs) Average 66.30								
5	50	50076	36-11/2X3/4 3M LF2 FLEX S	SA/A350 LF2 CL1							
7690149			Al 0.027 C 0.200 Co 0.004 Cr 0.050 Cu 0.100 Mn 0.970 Mo 0.016 Nb 0.013 Ni 0.060 P 0.011 S 0.019 Si 0.220 V 0.003 CE(Long Formula) = 0.39 T/S(PSI) 76,500 Y/S(PSI) 53,000 EL(%) 31.00 RA(%) 64.00 Brinell 159 BHN 146 BHN Charpy -50 F 42/58/45 (Ft-Lbs) Average 48.30								
6	50	50196	36-3X1 3M LF2 FLEX S	SA/A350 LF2 CL1							
7690199			Al 0.032 C 0.200 Co 0.002 Cr 0.040 Cu 0.030 Mn 1.050 Mo 0.003 Nb 0.014 Ni 0.020 P 0.005 S 0.019 Si 0.270 V 0.003 CE(Long Formula) = 0.39 T/S(PSI) 71,610 Y/S(PSI) 47,449 EL(%) 36.85 RA(%) 57.04 Brinell 135 BHN 135 BHN Charpy -50 F 77/66/56 (Ft-Lbs) Average 66.30								

We certify that the data on this sheet is a true copy taken from our records of material furnished us by the production mill, or as obtained by additional laboratory checks.

by

Kylee Ruiz

Kylee Ruiz

QUALITY PROCESS MANAGER

CMTR: REV2

CERTIFIED MILL TEST REPORT



The Best Value -
Price, Quality, Service
All The Time.

LOG NO. F00000000100245

Page 2 of 2

BONNEY FORGE CORPORATION

P.O. BOX 330 • 14496 CROGHAN PIKE • MOUNT UNION, PA 17066-0330

(814) 542-2545 • (800) 345-7546 • FAX (814) 542-4906

www.bonneyforge.com

CUSTOMER: CCTF CORPORATION

DATE 10/04/2017

CUSTOMER

BONNEY ORDER NO. B000229128

ORDER NO.: 4037926-00

SHIP TO: CCTF CORPORATION (BURLINGTON)

4151 NORTH SERVICE ROAD

UNIT 2

BURLINGTON ON L7L 4X6

Canada

ITEM	QUANTITY	LOT NO.	GRADE OR SPECIFICATION NO CHEMICAL ANALYSIS, PHYSICAL PROPERTIES, REMARKS
1.			THE FITTINGS SUPPLIED ARE IN ACCORDANCE WITH PURCHASE ORDER SPECIFICATIONS.
2.			CERTIFYING TO ASTM A350 LF2 07 REVISION.
3.			THE MATERIAL OF THE FITTINGS SUPPLIED IS ASTM A350-LF2 BUT MEETS THE REQUIREMENTS OF ASME SA350-LF2.
4.			THE CHARPY V-NOTCH IMPACT TEST WAS PERFORMED AT -50 DEGREES FAHRENHEIT IN ACCORDANCE WITH A350-LF2.
5.			THE MATERIAL SUPPLIED AS A350 LF2 CL1 MEETS THE REQUIREMENTS OF BOTH NACE MRO103-2007 AND NACE MRO175/ISO 15156-2.
6.			THE MATERIAL SUPPLIED WAS NORMALIZED IN ACCORDANCE WITH ASTM A350 HEAT TREATING REQUIREMENTS.
7.			THE PRODUCT SUPPLIED WAS INSPECTED IN ACCORDANCE WITH EN 10204:2004 EDITION TYPE 3.1 INSPECTION DOCUMENT. (EUROPEAN STANDARD)
8.			THE UNIT OF MEASURE FOR TENSILE AND YIELD (0.2%) STRENGTH ARE REPORTED IN PSI.
9.			ELONGATION TEST RESULTS ARE OBTAINED USING STANDARD ROUND SPECIMEN, 2 INCH OR 50 MM GAGE LENGTH.

We certify that the data on this sheet is a true copy taken from our records of material furnished us by the production mill, or as obtained by additional laboratory checks.

by

Kylee Ruiz

Kylee Ruiz

QUALITY PROCESS MANAGER

CMTR: REV2



CORPORATION

4151 North Service Road, Burlington, ON L7L 4X6 (905) 335-5320

Date: 8/13/2019

Mill Test Reports

Invoice: 1599535-00

PO: 2610160-00

Customer: 27403-261

A.B.F. MINES

1310 AVE DAVY

ROUYN-NORANDA, QC J9Y 0A8

Line	Heat#	Product	Description
1	b01568b	7583949	8 300 RF WN FLG STD A350LF2
2	b03238	7586832	6 150 RF WN FLG STD A350LF2
3	50313 **	7690199	1 X 3-36 3000 SOL A350LF2

CERTIFICATE OF INSPECTION & TEST (EN 10204 3.1)



ST&H CORPORATION
 OFFICE - 74, Jwadongsunhwan-ro, Haeundae-gu, Busan, Korea
 PLANT - 11, Eogokgongdan 2-gil, Yangsan-si, Kyungnam, Korea
 Tel : +82.51.744-4680(5 line) Fax : +82.51.744-4670
 E-mail : qm@stnhcorp.com



CE
 RPS 074000 / 01

Certificate No. MJH0427-06/08
 Customer CCTF CORPORATION
 Contract No. 4039342-00

Date : JUN. 17, 2019

Spec. For Material ASTM A105N-18, ASME SA105N-17, ASTM A350 LF2 CL1-18, ASME SA350 LF2 CL1-17, NACE MR0175/ISO15156-2:2015, NACE MR0103/ISO17945:2015
 Heat Treatment 930°C NORMALIZED & A.C
 Certified to ISO9001/ ISO14001:2015, PED2014/68/EC by LRQA
 Dimensional Inspection ASME B16.5 - 2017

ITEM / SIZE	Q'ty	Heat No./ Batch No.	Size of Test Specimen		Tension Test					Hardness Test (HB)		Charpy Impact Test (10X10mm Specimen Size)				
			D mm	GL mm	Y.S MPa	T.S MPa	E.L %	R.A %	Test (HB)	187	Indiv. 16J	Ave. 20J	Notch V	Temp. -46°C		
															Max	Min
			12.5	50.0	655	39	76	147	154	83	78	81	80			
														12.5	50.0	655
7580219	15	8015688	12.5	50.0	356	515	39	76	147	154	83	78	81	80		
7580220	25	8015688	12.5	50.0	356	515	39	76	147	154	83	78	81	80		
7586509	70	8015688	12.5	50.0	356	515	39	76	147	154	83	78	81	80		
7580218	12	8015688	12.5	50.0	356	515	39	76	147	154	83	78	81	80		
7580200	15	8015688	12.5	50.0	356	515	39	76	147	154	83	78	81	80		
7586832	45	8015688	12.5	50.0	356	515	39	76	147	154	83	78	81	80		
7583949	40	8015688	12.5	50.0	356	515	39	76	147	154	83	78	81	80		
7580203	4	801979E	12.5	50.0	344	541	35	75.5	150	152	60	65	59	61		
7580204	5	801979E	12.5	50.0	344	541	35	75.5	150	152	60	65	59	61		
7580205	2	801979E	12.5	50.0	344	541	35	75.5	150	152	60	65	59	61		

Heat No./ Batch No.		Chemical Composition (%)													NDE					
		C	Si	Mn	P	S	Ni	Cr	Mo	Cu	V	Nb					CE	UT	MT	PT
		Max	0.300	0.300	1.350	0.035	0.040	0.400	0.300	0.120	0.400	0.080	0.020							
	Min		0.150	0.600																
B01568B	H	0.172	0.243	1.290	0.011	0.004	0.026	0.094	0.017	0.020	0.001	0.001					0.412			
	P	0.177	0.250	1.300	0.012	0.005	0.029	0.101	0.015	0.020	0.002	0.001					0.420			
B01979E	H	0.177	0.212	1.270	0.009	0.003	0.010	0.061	0.004	0.009	0.001	0.012					0.403			
	P	0.180	0.229	1.280	0.009	0.002	0.012	0.038	0.006	0.012	0.001	0.015					0.403			

REMARK * H : Heat Analysis P : Product Analysis * C.Mn = 1±5

[Signature]

We hereby certify that the material herein has been made and tested in accordance with the above specification and also with the requirements called for by the above order.

Witnessed by / H. J. LEE

Manager of Q.A Dept. / JAY KIM

ST-801-14-02

ST&H CORPORATION



CERTIFICATE OF INSPECTION & TEST (EN 10204 3.1)

ST

ST&H CORPORATION
 OFFICE - 74, Jwadongsunhwan-ro, Haeundae-gu, Busan, Korea
 PLANT - 11, Eogokgongdan 2-gil, Yangsan-si, Kyungnam, Korea
 Tel : +82.51.744-4680(5 line) Fax : +82.51.744-4670
 E-mail : qm@stnhcorp.com



Certificate No. MJH0103-10/16
 Customer CCTF CORPORATION
 Contract No. 4038603-00

Date : AUG. 27. 2018

Certified to ISO9001/ ISO 14001:2015, PED2014/68/EC by LRQA

Spec. For Material ASTM A105N-14, ASME SA105N-17, ASTM/ASME A/SA350 LF2 CL1-17, NACE MR0175/ISO 15156-2:2015, NACE MR0103/ISO 17495-1:2016

Heat Treatment 930°C NORMALIZED & A.C

Dimensional inspection ASME B16.5 - 2017

ITEM / SIZE	Q'ty	Heat No./ Batch No.	Size of Test Specimen				Tension Test				Hardness Test (HB)		Charpy Impact Test (10X10mm Specimen Size)				
			D mm	GL mm	Max	Min	Y.S MPa	T.S MPa	E.L %	R.A %	Test (HB)	Indiv. 16J	Ave. 20J	Notch V	Temp. -46°C		
Test Result (J)																	
Ave.(J)																	
7586502	2	803238	12.5	50.0		Min	250	485	22.0	30.0	187	118	145	68	110		
150LBS TH RF 6"																	
7586824	50	803238	12.5	50.0			375	545	35	67.5	151	153	118	145	68	110	
150LBS WN RF STD 4"																	
7586832	50	803238	12.5	50.0			375	545	35	67.5	151	153	118	145	68	110	
150LBS WN RF STD 6"																	
7585267	10	803238	12.5	50.0			375	545	35	67.5	151	153	118	145	68	110	
150LBS WN RF XH 4"																	
7580014	5	803238	12.5	50.0			375	545	35	67.5	151	153	118	145	68	110	
300LBS SO RF 4"																	
7587735	2	803238	12.5	50.0			375	545	35	67.5	151	153	118	145	68	110	
300LBS SO RF 6"																	
7585259	10	803238	12.5	50.0			375	545	35	67.5	151	153	118	145	68	110	
600LBS WN RF STD 3"																	
7581040	25	803238	12.5	50.0			375	545	35	67.5	151	153	118	145	68	110	
600LBS WN RF XH 3"																	
7581007	2	803776	12.5	50.0			375	540	38	74.5	152	154	135	80	118	111	
150LBS BL RF 18"																	
7580205	2	803776	12.5	50.0			375	540	38	74.5	152	154	135	80	118	111	
150LBS SO RF 20"																	
Chemical Composition (%)																	
Heat No./ Batch No.	C	Si	Mn	P	S	Ni	Cr	Mo	Cu	V	Nb	CE			UT	MT	PT
	Max	0.300	0.300	1.350	0.035	0.040	0.400	0.300	0.120	0.400	0.080	0.020					
Min		0.150	0.600														

Chemical Composition (%)

Heat No./ Batch No.	Max Min	C	Si	Mn	P	S	Ni	Cr	Mo	Cu	V	Nb	NDE			
		0.300	0.150	1.350	0.035	0.040	0.400	0.300	0.120	0.400	0.080	0.020	CE	UT	MT	PT
803238	H	0.176	0.201	1.050	0.015	0.004	0.032	0.077	0.004	0.050	0.001	0.001	0.374			
	P	0.178	0.216	1.050	0.016	0.002	0.036	0.073	0.007	0.050	0.002	0.001	0.376			
	H	0.172	0.220	1.290	0.013	0.007	0.012	0.045	0.006	0.008	0.004	0.019	0.399			
803776	P	0.174	0.220	1.290	0.011	0.003	0.012	0.044	0.006	0.008	0.001	0.015	0.400			
													BLANK			

REMARK * H : Heat Analysis P : Product Analysis



[Signature]

We hereby certify that the material herein has been made and tested in accordance with the above specification and also with the requirements called for by the above order.

Witnessed by / H. J. LEE

Manager of Q.A Dept. / JAY KIM
 ST&H CORPORATION

ST-801-14-02

CERTIFIED MILL TEST REPORT

The Best Value -
Price, Quality, Service
All The Time.

LOG NO. F00000000110349

Page 1 of 2

BONNEY FORGE CORPORATION

P.O. BOX 330 • 14496 CROGHAN PIKE • MOUNT UNION, PA 17066-0330

(814) 542-2545 • (800) 345-7546 • FAX (814) 542-4906

www.bonneyforge.com

CUSTOMER: CCTF CORPORATION

DATE 07/13/2018

CUSTOMER

BONNEY ORDER NO. B000243044

ORDER NO.: 4038733-00

SHIP TO: CCTF CORPORATION (BURLINGTON)
4151 NORTH SERVICE ROAD
UNIT 2
BURLINGTON ON L7L 4X6
Canada

ITEM	QUANTITY	LOT NO.	GRADE OR SPECIFICATION NO.	
			CHEMICAL ANALYSIS, PHYSICAL PROPERTIES, REMARKS:	
3	50	50200	36-3/4 X 1/2 3M LF2 FLEX T	SA/A350 LF2 CL1
7690072			Al 0.024 C 0.200 Co 0.002 Cr 0.030 Cu 0.050 Mn 1.040 Mo 0.005 Nb 0.012 Ni 0.020 P 0.006 S 0.022 Si 0.230 V 0.003 CE(Long Formula) = 0.39 T/S(Psi) 71,500 Y/S(Psi) 48,100 EL(%) 35.00 RA(%) 69.00 Brinell Hardness 137 BHN 135 BHN Charpy -50 F 78/55/52 (Ft-Lbs) Average 61.70	
4	50	50313	36-3X1 3M LF2 FLEX S	SA/A350 LF2 CL1
7690199			Al 0.036 C 0.200 Co 0.002 Cr 0.060 Cu 0.080 Mn 1.000 Mo 0.006 Nb 0.014 Ni 0.030 P 0.006 S 0.023 Si 0.240 V 0.003 CE(Long Formula) = 0.39 T/S(Psi) 73,427 Y/S(Psi) 48,233 EL(%) 35.25 RA(%) 61.22 Brinell Hardness 135 BHN 135 BHN Charpy -50 F 27/28/33 (Ft-Lbs) Average 29.30	
5	100	50295	36-11/2X3/4 3M LF2 FLEX S	SA/A350 LF2 CL1
7690149			Al 0.021 C 0.200 Co 0.002 Cr 0.030 Cu 0.080 Mn 1.020 Mo 0.007 Nb 0.011 Ni 0.030 P 0.005 S 0.023 Si 0.260 V 0.003 CE(Long Formula) = 0.39 T/S(Psi) 73,778 Y/S(Psi) 50,401 EL(%) 36.55 RA(%) 65.23 Brinell Hardness 135 BHN 135 BHN Charpy -50 F 43/68/39 (Ft-Lbs) Average 50.00	

We certify that the data on this sheet is a true copy taken from our records of material furnished us by the production mill, or as obtained by additional laboratory checks.

by

Kylee Ruiz

QUALITY PROCESS MANAGER

CMTR: REV2

CERTIFIED MILL TEST REPORT

LOG NO. F00000000110349

Page 2 of 2

BONNEY FORGE CORPORATION

P.O. BOX 330 • 14496 CROGHAN PIKE • MOUNT UNION, PA 17066-0330

(814) 542-2545 • (800) 345-7546 • FAX (814) 542-4906

www.bonneyforge.com



The Best Value -
Price, Quality, Service
All The Time.

CUSTOMER: CCTF CORPORATION

DATE 07/13/2018

CUSTOMER

BONNEY ORDER NO. B000243044

ORDER NO.: 4038733-00

SHIP TO: CCTF CORPORATION (BURLINGTON)
4151 NORTH SERVICE ROAD
UNIT 2
BURLINGTON ON L7L 4X6
Canada

ITEM QUANTITY LOT NO.

GRADE OR SPECIFICATION NO.
CHEMICAL ANALYSIS, PHYSICAL PROPERTIES, REMARKS:

1. THE FITTINGS SUPPLIED ARE IN ACCORDANCE WITH PURCHASE ORDER SPECIFICATIONS.
2. CERTIFYING TO ASTM A350 LF2 17 REVISION.
3. THE MATERIAL OF THE FITTINGS SUPPLIED IS ASTM A350-LF2 BUT MEETS THE REQUIREMENTS OF ASME SA350-LF2.
4. THE CHARPY V-NOTCH IMPACT TEST WAS PERFORMED AT -50 DEGREES FAHRENHEIT IN ACCORDANCE WITH A350-LF2.
5. THE MATERIAL SUPPLIED AS A350 LF2 CL1 MEETS THE REQUIREMENTS OF BOTH NACE MRO103/ISO 17945 - 2015 & NACE MRO175/ISO 15156-2 - 2015 EDITION.
6. THE MATERIAL SUPPLIED WAS NORMALIZED IN ACCORDANCE WITH ASTM A350 HEAT TREATING REQUIREMENTS.
7. THE PRODUCT SUPPLIED WAS INSPECTED IN ACCORDANCE WITH EN 10204:2004 EDITION TYPE 3.1 INSPECTION DOCUMENT. (EUROPEAN STANDARD)
8. THE UNIT OF MEASURE FOR TENSILE AND YIELD (0.2%) STRENGTH ARE REPORTED IN PSI.
9. ELONGATION TEST RESULTS ARE OBTAINED USING STANDARD ROUND SPECIMEN, 2 INCH OR 50 MM GAGE LENGTH.

We certify that the data on this sheet is a true copy taken from our records of material furnished us by the production mill, or as obtained by additional laboratory checks.

by

Kylee Ruiz

Kylee Ruiz

QUALITY PROCESS MANAGER

CMTR: REV2



BOTH-WELL STEEL FITTINGS CO., LTD.

NO.303, REN-SIN ROAD, REN-WU DISTRICT, KAOHSIUNG CITY, TAIWAN, R.O.C.(81460)
TEL : (886)7-3711536, 3710497, 3720260 FAX : (886)7-371-3864, 3713882
WEB SITE : <http://www.bothwell.com.tw> E-Mail : box@bothwell.com.tw

An ISO 9001 : 2015 Registered Manufacturer

M L L TEST & I N S P E C T I O N C E R T I F I C A T E

ACCORDING TO EN 10204 3.1

CUSTOMER : SEYBOLD INTERNATIONAL CORP.

CERT NO : 180410

ORDER NO : 7013926

INVOICE NO : 5200011852

L/C NO :

PAGE : 19

DATE : 02/12/2018

ORIGIN : TAIWAN

ITEM	RAW HEAT NO. HEAT NO.	QTY	DESC/ GRADE OR SPECIFICATION NO. CHEMICAL COMPOSITION % MECHANICAL PROPERTIES.
108	355196 YB0001	100 PCS	UNION NUT (CT) - BODY (RD) LF2 CL1 (N) 1-1/2" 3000# S/W SQ3UI.5-BW C:0.18 Si:0.25 Mn:1.05 P:0.014 S:0.005 Cu:0.04 Cr:0.07 Ni:0.03 Mo:0.01 V:0.003 Nb:0.003 N:0.0099 Ti:0.002 CE:0.38 TS(KSI):73.8 YS 0.2%(KSI):55.5 EL(%):32.5 RA(%):69.1 HARDNESS 1(HBW):141 HARDNESS 2(HBW):143 IMPACT TEST -46°C (-50.8°F) 1:48 J 2:87 J 3:67 J AVG:67 J

1/2" 3000 FS SW
union A350LF2

REMARK :

THE MATERIAL SUPPLIED IDENTIFIED AS ASTM A350 -15, ASME SA350 -2015ED LF2 CL 1

THE FITTING SUPPLIED IDENTIFIED AS MSS SP-83 - 2014

THE PRODUCT SUPPLIED WAS INSPECTED IN ACCORDANCE WITH SPECIFICATION SURFACE & DIM. : GOOD

STANDARD : CHEMICAL COMPOSITION % & MECHANICAL PROPERTIES.

	C	Si	Mn	P	S	Cu	Cr	Ni	Mo	V	Co(Nb)
MIN	-	0.15	0.60	-	-	-	-	-	-	-	-
MAX	0.30	0.30	1.35	0.035	0.040	0.40	0.30	0.40	0.12	0.08	0.02
	N	Al	Ti	Zr	CE	TS(KSI)	YS(KSI)	YS 0.2%(KSI)	EL(%)	R of A(%)	HARDNESS(HBW)
MIN	-	-	-	-	-	70	-	36	22	30	-
MAX	-	-	-	-	0.47	95	-	-	-	-	197

HEAT TREATMENT : NORMALIZED 900°C(1652°F) A.C.

CONFORM TO NACE MR0175-15/ISO 15156-15/MR0103-15

FULLY KILLED AND FINE GRAIN PRACTICE

FREE FROM RADIATION CONTAMINATION

REF#90817ABW

WE CERTIFY THE ABOVE MENTIONED FITTINGS HAVE BEEN MANUFACTURED,

SAMPLED, TESTED, AND INSPECTED IN ACCORDANCE WITH THE

SPECIFICATIONS SHOWN

C.C. Huang
Q.C. MANAGER

C.L. Ko
INSPECTOR



柏緯鐵工股份有限公司

高雄縣仁武鄉烏林村仁心路 303 號

BOTH-WELL STEEL FITTINGS CO., LTD.

NO.303, JEN-HSIN ROAD JEN-WU HSIANG

KAHSIUNG HSIEN, TAIWAN R.O.C.(81480)

TEL: 886-7-371-0497, 371-1536, 372-0260

An ISO 9001:2000 Registered Manufacturer

ISO 9001

BUREAU VERITAS
Certification

N° TW00091Q



FAX: 886-7-371-3864, 371-3882

web site: <http://www.bothwell.com.tw> e-mail: bothwell@www.bothwell.com.tw or box@mail.bothwell.com.tw

MILL TEST & INSPECTION CERTIFICATE

ACCORDING TO EN10204/DIN50049/3.1.B

ORIGIN: TAIWAN

CUSTOMER: WEIFANG STEEL CANADA LTD.

INVOICE NO: BW089706095



DATE: 12/10/08

CERT NO: 83363-2

ORDER NO: AG0031-LF2

L/C NO:

PAGE: 4

ITEM	BOTH WELL HT.CD.	RAW MATERIAL HEAT NO.	DESCRIPTION								QUANTITY	SPECIFICATION: ASTM A350 -04a ASME SA350 -E04 LF2-Class1 DIMENSION: ASME B16.11-2005 SURFACE: BY VISUAL...GOOD			
014	Y050	X1651	TEE 3/4" 3000# NPT								300 PC				
023	Y050	X1651	FULL CPLG 1-1/2" 3000# NPT								1000 PC				
029	Y050	X1651	HALF CPLG 1-1/2" 3000# NPT								300 PC				
035	Y050	X1651	CAP 1-1/2" 3000# NPT								400 PC				
036	Y050	X1651	CAP 2" 3000# NPT								600 PC				
070	Y047	X1653	90D ELBOW 2" 3000# S/W								110 PC				
070	Y047	X1653	90D ELBOW 2" 3000# S/W								50 PC				
ITEM	BOTH WELL HT.CD	CHEMICAL COMPOSITION (%)													
		C	Si	Mn	P	S	Cu	Cr	Ni	Mo	V	Cb(Nb)	N		
Min		-	0.150	0.600	-	-	-	-	-	-	-	-	-		
Max		0.300	0.300	1.350	0.035	0.040	0.400	0.300	0.400	0.120	0.080	0.020	-		
014	Y050	0.200	0.190	1.040	0.007	0.001	0.030	0.060	0.030	0.010	0.001	0.000	-		
023	Y050	0.200	0.190	1.040	0.007	0.001	0.030	0.060	0.030	0.010	0.001	0.000	-		
029	Y050	0.200	0.190	1.040	0.007	0.001	0.030	0.060	0.030	0.010	0.001	0.000	-		
035	Y050	0.200	0.190	1.040	0.007	0.001	0.030	0.060	0.030	0.010	0.001	0.000	-		
036	Y050	0.200	0.190	1.040	0.007	0.001	0.030	0.060	0.030	0.010	0.001	0.000	-		
070	Y047	0.200	0.220	1.050	0.012	0.001	0.040	0.190	0.040	0.020	0.010	0.000	-		
070	Y047	0.200	0.220	1.050	0.012	0.001	0.040	0.190	0.040	0.020	0.010	0.000	-		
ITEM	BOTH WELL HT.CD	MECHANICAL TEST					Remark:								
		Tensile Strength (KSI)	Yield Strength (KSI)	Elon- Gation (%)	R of A (%)	Hardness (AVG.) (HB)	CONFORM TO NACE MR0175-2003/MR0103 STEEL MAKING PROCESS : ELECTRIC FURNACE HEAT TREATED(°C) NORMALIZED:900°C TEMPERED:620°C IMPACT VALUE(CHARPY) -50°F(-46.0°C) HEAT NO. HT.CD. JOULE(J) AVG.(J) X1653 Y047 285 272 257 271.333 X1651 Y050 242 188 175 201.667								
Min		70.0	36.0	22.0	30.0	-									
Max		95.0	-	-	-	197									
014	Y050	79.7	60.7	34.6	76.2	151	WE CERTIFY THE ABOVE MENTIONED FITTINGS HAVE BEEN MANUFACTURED AND TESTED IN ACCORDANCE WITH THE SPECIFICATIONS SHOWN <div> Q.C. MANAGER CHIN CHENG HSIEH</div> <div> INSPECTOR CHUN CHIEH HUANG</div>								
023	Y050	79.7	60.7	34.6	76.2	151									
029	Y050	79.7	60.7	34.6	76.2	151									
035	Y050	79.7	60.7	34.6	76.2	151									
036	Y050	79.7	60.7	34.6	76.2	151									
070	Y047	78.1	58.1	36.2	80.3	144									
070	Y047	78.1	58.1	36.2	80.3	144									

BW-D0839 REV:0



CapProducts, Ltd.
25 Winnipeg St
Vanastra, ON N0M 1L0

Phoenix * Capitol * Camco
CapProducts

Certified Material Test Report

Commanding a Higher Standardsm

Printed: 8/20/2019

Customer

EMCO DISTRIBUTION GROUP
PO BOX 5300 STATION A
LONDON, ON N6A 4N7

Certified: 12/18/2018

P.O. 2610174-00

Tag 3050060

Heat No 174321

Heat Code 87AH

Phoenix Order # 1481945

Material ASTM A333 GR6 2015/ASME SA333 GR6 2015 Edition

Part Number

15111512CSA

Description

1-1/2X6 XHSML BK STL NIPL A333 GR6 CSA

Chemical Properties

C	Mn	P	S	Si	Cu	Ni	Cr	C Eq. Long	
0.1300	1.3200	0.0090	0.0050	0.3100	0.0390	0.0200	0.0600	0.3687	
Mo	V	Co	Al	Cb	N	Pb	Sn	Ta	Ti
0.0100	0.0040			0.0180					0.0020

Additional Chemical Properties

B					Cr + Cu + Ni	
0.00030					0.1190	

Mechanical Properties

Tensile (PSI)	Yield (PSI)	Elong. % in 2 in. or 4D	R of A	HBW	HBW2
72,374	55,985	37.0%		150	0

Charpy Minimum Impact - ft/lbs

Test 1	Test 2	Test 3	Average	Test Temp.
48	41	49	46.00	-54

* Bend test passed.

We hereby certify that these parts were manufactured, sampled, tested, and inspected in accordance with the product specifications stated and were found to meet the requirements.

We further certify that this material was inspected using independent inspectors conforming to the requirements of EN 10204 3.1. These products meet the requirements of the latest editions of NACE MR0175, NACE MR0103, and ISO 15156. No weld repair has been performed on these products. This material was not exposed to mercury or any other metal alloy that is liquid at ambient temperatures during processing or while in our possession.

Comments:

Flattening test passed. Ultrasonic test passed.

Charpy V Impact Tested at -54° C. Specimen size - 10 x 3.33 mm

Hot finished, Normalized



CapProducts, Ltd.
25 Winnipeg St
Vanastra, ON N0M 1L0

Phoenix * Capitol * Camco
CapProducts

Certified Material Test Report

Commanding a Higher Standardsm

Printed: 8/20/2019

Certified: 06/07/2019

Customer

EMCO DISTRIBUTION GROUP
PO BOX 5300 STATION A
LONDON, ON N6A 4N7

P.O. 2610174-00

Tag 3050060

Heat No 608622

Heat Code 87HU

Phoenix Order # 1481945

Material ASTM A333 GR6 2015/ASME SA333 GR6 2015 Edition

Part Number

15111512CSA

Description

1-1/2X6 XHSML BK STL NIPL A333 GR6 CSA

Chemical Properties

C	Mn	P	S	Si	Cu	Ni	Cr	C Eq. Long	
0.1300	0.7200	0.0140	0.0030	0.2000	0.0900	0.0700	0.0900	0.2833	
Mo	V	Co	Al	Cb	N	Pb	Sn	Ta	Ti
0.0200	0.0030			0.0140					0.0020

Additional Chemical Properties

Boron				
0.00010				

Cr + Cu + Ni
0.2500

Mechanical Properties

Tensile (PSI)	Yield (PSI)	Elong. % in 2 in. or 4D	R of A	HBW	HBW2
64,107	44,672	34.0%		134	0

Charpy Minimum Impact - ft/lbs

Test 1	Test 2	Test 3	Average	Test Temp.
44	44	46	44.67	-55

* Hydro test passed. at 3000 psi.

* Bend test passed.

We hereby certify that these parts were manufactured, sampled, tested, and inspected in accordance with the product specifications stated and were found to meet the requirements.

We further certify that this material was inspected using independent inspectors conforming to the requirements of EN 10204 3.1. These products meet the requirements of the latest editions of NACE MR0175, NACE MR0103, and ISO 15156. No weld repair has been performed on these products. This material was not exposed to mercury or any other metal alloy that is liquid at ambient temperatures during processing or while in our possession.

Comments:

Flattening test passed.

Charpy V Impact Tested at -55° C. Specimen size - 10 x 4 mm.

Normalized

18353-6086



CapProducts, Ltd.
25 Winnipeg St
Vancouver, ON N0M 1L0

Phoenix * Capitol * Camco
CapProducts

Certified Material Test Report

Commanding a Higher Standard_{sm}

Printed: 8/20/2019

Customer

EMCO DISTRIBUTION GROUP
PO BOX 5300 STATION A
LONDON, ON N6A 4N7

Certified: 06/07/2019

P.O. 2610174-00

Tag 3050060

Heat No 608622

Heat Code 87HU

Phoenix Order # 1481945

Material ASTM A333 GR6 2015/ASME SA333 GR6 2015 Edition

Part Number

15111512CSA

Description

1-1/2X6 XHSML BK STL NIPL A333 GR6 CSA

Chemical Properties

C	Mn	P	S	Si	Cu	Ni	Cr
0.1300	0.7200	0.0140	0.0030	0.2000	0.0900	0.0700	0.0900

C Eq. Long
0.2833

Mo	V	Co	Al	Cb	N	Pb	Sn	Ta	Ti
0.0200	0.0030			0.0140					0.0020

Additional Chemical Properties

Boron				
0.00010				

Cr + Cu + Ni
0.2500

Mechanical Properties

Tensile (PSI)	Yield (PSI)	Elong. % in 2 in. or 4D	R of A	HBW	HBW2
64,107	44,672	34.0%		134	0

Charpy Minimum Impact - ft/lbs

Test 1	Test 2	Test 3	Average	Test Temp.
44	44	46	44.67	-55

* Hydro test passed. at 3000 psi.

* Bend test passed.

We hereby certify that these parts were manufactured, sampled, tested, and inspected in accordance with the product specifications stated and were found to meet the requirements.

We further certify that this material was inspected using independent inspectors conforming to the requirements of EN 10204 3.1. These products meet the requirements of the latest editions of NACE MR0175, NACE MR0103, and ISO 15156. No weld repair has been performed on these products. This material was not exposed to mercury or any other metal alloy that is liquid at ambient temperatures during processing or while in our possession.

Comments:

Flattening test passed.

Charpy V Impact Tested at -55° C. Specimen size - 10 x 4 mm.

Normalized

MLTS_6056-18953-1
Heat# 608622, 174321



CapProducts, Ltd.
25 Winnipeg St
Vancouver, ON N0M 1L0

Phoenix * Capitol * Camco
CapProducts

Certified Material Test Report

Commanding a Higher Standard_{sm}

Printed: 8/20/2019

Customer

EMCO DISTRIBUTION GROUP
PO BOX 5300 STATION A
LONDON, ON N6A 4N7

Certified: 12/18/2018

P.O. 2610174-00

Tag 3050060

Heat No 174321

Heat Code 87AH

Phoenix Order # 1481945

Material ASTM A333 GR6 2015/ASME SA333 GR6 2015 Edition

Part Number

15111512CSA

Description

1-1/2X6 XHSM BK STL NIPL A333 GR6 CSA

Chemical Properties

C	Mn	P	S	Si	Cu	Ni	Cr
0.1300	1.3200	0.0090	0.0050	0.3100	0.0390	0.0200	0.0600

C Eq. Long
0.3687

Mo	V	Co	Al	Cb	N	Pb	Sn	Ta	Ti
0.0100	0.0040			0.0180					0.0020

Additional Chemical Properties

B				
0.00030				

Cr + Cu + Ni
0.1190

Mechanical Properties

Tensile (PSI)	Yield (PSI)	Elong. % in 2 in. or 4D	R of A	HBW	HBW2
72,374	55,985	37.0%		150	0

Charpy Minimum Impact - ft/lbs

Test 1	Test 2	Test 3	Average	Test Temp.
48	41	49	46.00	-54

* Bend test passed.

We hereby certify that these parts were manufactured, sampled, tested, and inspected in accordance with the product specifications stated and were found to meet the requirements.

We further certify that this material was inspected using independent inspectors conforming to the requirements of EN 10204


3.1. These products meet the requirements of the latest editions of NACE MR0175, NACE MR0103, and ISO 15156. No weld repair has been performed on these products. This material was not exposed to mercury or any other metal alloy that is liquid at ambient temperatures during processing or while in our possession.

Comments:

Flattening test passed. Ultrasonic test passed.

Charpy V Impact Tested at -54° C. Specimen size - 10 x 3.33 mm

Hot finished, Normalized

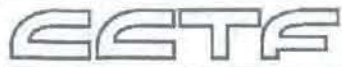

CORPORATION

4151 North Service Road, Burlington, ON L7L 4X6 (905) 335-5320

Date: 9/9/2019

Mill Test Reports

Invoice: 1600715-00

PO: 2610192

Customer: 27403-261

A.B.F. MINES/2985080 CANA 261
1310 AVE DAVY

ROUYN NORANDA, QC J9Y 0A8

Line	Heat#	Product	Description
1	b03459	7585585	6 150 RF BLIND FLG A350LF2

CERTIFICATE OF INSPECTION & TEST (EN 10204 3.1)



ST&H CORPORATION
 OFFICE - 74, Jwadongsunhwan-ro, Haeundae-gu, Busan, Korea
 PLANT - 11, Eogokgongdan 2-gil, Yangsan-si, Kyungnam, Korea
 Tel : +82.51.744-4680(5 line) Fax : +82.51.744-4670
 E-mail : qm@stnhcorp.com



Certificate No. MJH0290-01/05

Date : FEB. 14, 2019

Customer CCTF CORPORATION

Contract No. 4039095-00

Spec. For Material ASTM A105N-18, ASME SA105N-17, ASTM A350 LF2 CL1-17, NACE MR0175/ISO 15156-2:2015, NACE MR0103/ISO 17495-1:2016

Heat Treatment 930°C NORMALIZED & A.C

Dimensional inspection ASME B16.5 - 2017

Certified to ISO9001 / ISO14001:2015, PED2014/68/EC by LROA

ITEM / SIZE	Q'ty	Heat No./ Batch No.	Size of Test Specimen		Tension Test					Hardness Test (HB)	Charpy Impact Test (10X10mm Specimen Size)				
			D mm	GL mm	Y.S MPa	T.S MPa	E.L %	R.A %	Indiv. 16J		Ave. 20J	Notch V	Temp. -46°C		
										Max				Min	250
7585585	20	803459	12.5	50.0		330	520	34	76	150	156	80	75	86	80
7585860	10	803459	12.5	50.0		330	520	34	76	150	156	80	75	86	80
7580218	20	803459	12.5	50.0		330	520	34	76	150	156	80	75	86	80
7580202	2	803459	12.5	50.0		330	520	34	76	150	156	80	75	86	80
7586502	5	803459	12.5	50.0		330	520	34	76	150	156	80	75	86	80
7586824	50	803459	12.5	50.0		330	520	34	76	150	156	80	75	86	80
7586832	30	803459	12.5	50.0		330	520	34	76	150	156	80	75	86	80
7586891	20	803459	12.5	50.0		330	520	34	76	150	156	80	75	86	80
7583949	10	803459	12.5	50.0		330	520	34	76	150	156	80	75	86	80
7585321	20	803459	12.5	50.0		330	520	34	76	150	156	80	75	86	80

Heat No./ Batch No.	Chemical Composition (%)													NDE					
	C	Si	Mn	P	S	Ni	Cr	Mo	Cu	V	Nb					CE	UT	MT	PT
	Max																		
B03459	H	0.163	0.226	1.230	0.012	0.002	0.057	0.138	0.017	0.147	0.001	0.006							0.412
	P	0.162	0.224	1.240	0.011	0.002	0.054	0.136	0.014	0.138	0.001	0.001							0.411

BLANK

REMARK * H : Heat Analysis P : Product Analysis

We hereby certify that the material herein has been made and tested in accordance
 with the above specification and also with the requirements called for by the above order.

ST-801-14-02

Witnessed by / H. J. LEE

Manager of Q.A Dept. / JAY KIM

ST&H CORPORATION





NEWCO® | OIC® | DOUGLAS CHERO™

13127 Trinity Dr., Stafford, TX 77477
Tel: 281-302-4900 Fax: 281-302-4801

Item No: B3080030F*LCCW27B*****GA
Size/Type: 8" / Swing Check
Quantity: 1
Country of Origin: China
FigNo: 33P--LCC4/2-NC

Material Test Report

Cameron Newco is a 9001 certified registered company
CRN: OC7998.5C - EN 10204-3.1

06/17/19

Cert No: 1087586

Customer: EMCO	MLTS_6056-18734
Customer Number: 32043	Cert# 1087586
Customer PO: 2610091-00	
Cameron SO: QRC SO# 1007020	
Project Name:	
Valve Serial No:	
Description: 300# RF A352-LCC (TRIM 12) BC SWING CHECK	
NACE	
Customer Tag No:	

Inspection			
Dimension: Passed	Test Pressure	Duration	Test
Visual: Passed	(Psi)	(sec)	Result
Valve Materials meet the requirements for NACE MR0103 and NACE MR0175	7.757	120	Passed
	Backseat	-	-
	Seat Hydro	825	120
	Seat Air	-	-

Standard: API 598 / ASME B16.34

Heat No: N9183W

Material Code: A352 LCC

Spec:	C	Cr	Cu	Mn	Mo	Ni	P	S	Si	V
Chem Comp (%)	0.00	0.00	0.00	0.00	0.00	0.00	0.00	0.00	0.00	0.00
Min:	0.25	0.50	0.30	1.20	0.20	0.50	0.040	0.05	0.60	0.03
Max:	0.180	0.040	0.018	1.040	0.002	0.014	0.021	0.010	0.520	0.004
Val:	0.180	0.040	0.018	1.040	0.002	0.014	0.021	0.010	0.520	0.004

Heat No: LF2-B025

Material Code: A350 LF2

Spec:	C	Cr	Cu	Mn	Mo	Ni	P	S	Si	V
Chem Comp (%)	0.00	0.00	0.00	0.60	0.00	0.00	0.00	0.001	0.00	0.15
Min:	0.30	0.30	0.40	1.35	0.12	0.02	0.40	0.035	0.04	0.30
Max:	0.220	0.200	0.210	0.900	0.070	0.000	0.220	0.010	0.013	0.210
Val:	0.220	0.200	0.210	0.900	0.070	0.000	0.220	0.010	0.013	0.210

Part: Body Type 3.1

Heat Treatment: QUENCHING+TEMPERING

Spec:	C	Cr	Cu	Mn	Mo	Ni	P	S	Si	V
Chem Comp (%)	0.00	0.00	0.00	0.60	0.00	0.00	0.00	0.001	0.00	0.15
Min:	0.30	0.30	0.40	1.35	0.12	0.02	0.40	0.035	0.04	0.30
Max:	0.220	0.200	0.210	0.900	0.070	0.000	0.220	0.010	0.013	0.210
Val:	0.220	0.200	0.210	0.900	0.070	0.000	0.220	0.010	0.013	0.210

Part: Bonnet/Cap Type 3.1

Heat Treatment: QUENCHING+TEMPERING

Spec:	C	Cr	Cu	Mn	Mo	Ni	P	S	Si	V
Chem Comp (%)	0.00	0.00	0.00	0.60	0.00	0.00	0.00	0.001	0.00	0.15
Min:	0.30	0.30	0.40	1.35	0.12	0.02	0.40	0.035	0.04	0.30
Max:	0.220	0.200	0.210	0.900	0.070	0.000	0.220	0.010	0.013	0.210
Val:	0.220	0.200	0.210	0.900	0.070	0.000	0.220	0.010	0.013	0.210

Heat No: N9183W

Material Code: A352 LCC

Spec:	C	Cr	Cu	Mn	Mo	Ni	P	S	Si	V
Chem Comp (%)	0.00	0.00	0.00	0.60	0.00	0.00	0.00	0.001	0.00	0.15
Min:	0.30	0.30	0.40	1.35	0.12	0.02	0.40	0.035	0.04	0.30
Max:	0.220	0.200	0.210	0.900	0.070	0.000	0.220	0.010	0.013	0.210
Val:	0.220	0.200	0.210	0.900	0.070	0.000	0.220	0.010	0.013	0.210

Heat No: LF2-B025

Material Code: A350 LF2

Spec:	C	Cr	Cu	Mn	Mo	Ni	P	S	Si	V
Chem Comp (%)	0.00	0.00	0.00	0.60	0.00	0.00	0.00	0.001	0.00	0.15
Min:	0.30	0.30	0.40	1.35	0.12	0.02	0.40	0.035	0.04	0.30
Max:	0.220	0.200	0.210	0.900	0.070	0.000	0.220	0.010	0.013	0.210
Val:	0.220	0.200	0.210	0.900	0.070	0.000	0.220	0.010	0.013	0.210

Material Code: A352 LCC

Material Code: A350 LF2

Spec:	C	Cr	Cu	Mn	Mo	Ni	P	S	Si	V
Chem Comp (%)	0.00	0.00	0.00	0.60	0.00	0.00	0.00	0.001	0.00	0.15
Min:	0.30	0.30	0.40	1.35	0.12	0.02	0.40	0.035	0.04	0.30
Max:	0.220	0.200	0.210	0.900	0.070	0.000	0.220	0.010	0.013	0.210
Val:	0.220	0.200	0.210	0.900	0.070	0.000	0.220	0.010	0.013	0.210

Material Code: A350 LF2

Material Code: A350 LF2

Spec:	C	Cr	Cu	Mn	Mo	Ni	P	S	Si	V
Chem Comp (%)	0.00	0.00	0.00	0.60	0.00	0.00	0.00	0.001	0.00	0.15
Min:	0.30	0.30	0.40	1.35	0.12	0.02	0.40	0.035	0.04	0.30
Max:	0.220	0.200	0.210	0.900	0.070	0.000	0.220	0.010	0.013	0.210
Val:	0.220	0.200	0.210	0.900	0.070	0.000	0.220	0.010	0.013	0.210

Material Code: A352 LCC

Material Code: A350 LF2

	S	Si	V
	0.00	0.00	0.00
	0.05	0.60	0.03
	0.10	0.520	0.004



NEWCO® | OIC® | DOUGLAS CHERO™

13127 Trinity Dr., Stafford, TX 77477
Tel: 281-302-4900 Fax: 281-302-4801

Item No: B3080030P*LCCW27B*****GA
Size/Type: 8" / Swing Check
Quantity: 1
Country of Origin: China
FigNo: 33F--LCC4/2-NC

Material Test Report

Cameron Newco is a 9001 certified registered company
CRN: OC7998.5C - EN 10204-3.1

06/17/19

Cert No: 1087587

Customer: EMCO
Customer Number: 32043
Customer PO: 2610091-00
Cameron SO: QRC SO# 1007020
Project Name:
Valve Serial No:
Description: 300# RF A352-LCC (TRIM 12) BC SWING CHECK
NACE
Customer Tag No:

MLTS_6056-18734
Cert# 1087587

Pressure Test Result

Item	Test Pressure (PSI)	Duration (sec)	Test Result
Shell	7.757	120	Passed
Backseat	-	-	-
Seat Hydro	5.688	120	Passed
Seat Air	-	-	-

Standard: API 598 / ASME B16.34

Inspection

Dimension: Passed
Visual: Passed

Valve Materials meet the requirements for NACE MR0103 and NACE MR0175

Part: Body Type 3.1

Heat Treatment: QUENCHING+TEMPERING

Material Code: A352 LCC

Notes:

Spec:	C	Cr	Cu	Mn	Mo	Ni	P	S	SI	V
Chem Comp (%)	0.00	0.00	0.00	0.00	0.00	0.00	0.00	0.00	0.00	0.00
Min:	0.25	0.50	0.30	1.20	0.20	0.50	0.040	0.05	0.60	0.03
Max:	0.190	0.025	0.015	1.090	0.004	0.014	0.023	0.009	0.550	0.005

Part: Bonnet/Cap Type 3.1

Heat Treatment: QUENCHING+TEMPERING

Material Code: A350 LF2

Notes:

Spec:	C	Cr	Cu	Mn	Mo	Nb	Ni	P	S	SI	V
Chem Comp (%)	0.00	0.00	0.00	0.60	0.00	0.00	0.00	0.001	0.00	0.15	0.00
Min:	0.30	0.30	0.40	1.35	0.12	0.02	0.40	0.035	0.04	0.30	0.08
Max:	0.220	0.200	0.210	0.900	0.070	0.000	0.220	0.010	0.013	0.210	0.010

Heat No: N9158W

Physical Props	Tensile KSI	Yield KSI	Elong %	Reduct %	Hard (HB)	Impact Tests @50 deg F	lb/ftc # 1: 30 # 2: 20 # 3: 23 Avg: 25
70.0	39.9	22.0	35.0	100.0	100.0		
85.6	59.5	100.0	100.0	225.0	180.0		

Heat No: LF2-B025

Physical Props	Tensile KSI	Yield KSI	Elong %	Reduct %	Hard (HB)	Impact Tests @50 deg F	lb/ftc # 1: 36 # 2: 45 # 3: 47 Avg: 36
70.0	36.0	22.0	30.0	1.0	1.0		
95.0	999.9	100.0	100.0	197.0	170.0		

Comments: Cameron declares that the parts above are in accordance with applicable material specification and purchase order requirements.
No Asbestos is contained in this product. Packing: 1 Gasket Graphite Spiral Wound (316)
Valves covered in this certificate are in full compliance with purchase order requirements and specifications.

MTR created by: DR

Signature

06/17/19



HEAT / SERIAL NUMBER RECORD

M. A. Stewart & Sons Ltd.
VALVES AND FITTINGS

(FORM 4.15.4A)

COMPANY;

EMCO / Equipment - KN for ABE mines

PAGE;

1 OF 1

BRANCH;

Rouyn-Noranda, Q.C.

MAS SALES REGISTER;

1436324

ATTN;

Richard Knight

DATE

June 10 / 19

PO#

26/0090 - 00

ITEM	QTY	SIZE	VALVE NO.	BODY	BONNET#/CAP#	ACTUATOR#	SOLENOID#	INDICATOR#
1	3	8"	Beric	HCNNC	HCNNC	DF-01-105-180206-12		
2			103-RF-AH12-H-N	LDRAC	LDRAC	DF-01-306-180901-12		
3				LDRAC	LDRAC	DF-01-305-180901-12		
7								
8	1	8"	Beric	LDRAC	LDRAC	DF-01-250-180901-12		
9			101-RF-AH12-H-N					
10								
11								
12	2	6"	Beric	GDN71	GDN71	DF-01-216-190116-12		
13			101-RF-AH12-H-N	LDRAC	LDRAC	DF-01-247-180901-12		
14								
15								
16	1	6"	Beric	GDN71	GDN71	DF-01-228-190116-12		
17			301-RF-FH12-X-N					
18								
19								
20								
21								
22								
23								
24								
25								

FAX STAMP



Valve design and construction is in accordance with API 600, ASME B16.34
Products supplied are in compliance with the requirements of the purchase order



Beric-Davis Companies International, Ltd.

Houston TV 77087

Phone: 713 673-2073

Fax: 713 673-4641

(CHEMICAL, PHYSICAL & HYDROSTATIC)

TAG NO.: 103-08-RF-AH12-H-N

Class Rating:	300
---------------	-----


DATE: FEB. 6. 2018

ARTICLE · 8 GATE VALVE RF 300 TRIM 12

O'tv 1 Pcs FIGURE NO : 103-08-RF-AH12-H-N

DIMENSION INSPECTION					(mm)			PRESSURE TEST (ASME B16.34 & API 598)			VISUAL TEST
INSPECTION	Face to Face (End to End)	Flange Diameter	Bolt Circle	Dia. Of Raised Face	Flange Thickness	No. of Bolt Hole	Bolt Hole Diameter	SHELL (PSIG)	SEAT(AIR) (PSIG)	BACK SEAT (PSIG)	VISUAL
STANDARD	419±1.6	381	330	270	42	12	25	1125	80	825	MSS-SP-55-
RESULT	※ W.T	W.T	W.T	W.T	W.T	W.T	W.T	GOOD	GOOD	GOOD	GOOD

※ W.T : Within Tolerance



REMARKS:

IN ACCORDANCE WITH EN 10204.3.1

HEAT TREATMENT: LCC QUENCHED; 930°C X 3HR(W.C.)+TEMPERED 700°C X 3HR(A.C.)


TO NACE MR0103

Manager, Q.A. Department

Witness Inspector

Valve design and construction is in accordance with API 600. ASME B16.34

Products supplied are in compliance with the requirements of the purchase order

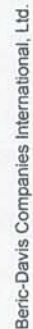

(CHEMICAL, PHYSICAL & HYDROSTATIC)

Beric-Davis Companies International, Ltd.
6059 South Loop East
Houston, TX 77087
Phone: 713 673-2073
Fax: 713 673-4641



DATE : SEP.1.2018
ARTICLE : 6 GATE VALVE RF 150 TRIM 12
FIGURE. NO. : 101-06-RF-AH12-H-N
SERIAL NO. : DF-01-247-180901-12

PARTS NAME	Body (BD)	Bonnet (BN)	Wedge/Disc (WD/DS)	Body Seat Ring	Stem
MATERIAL	ASTM A352 LCC	A352 LCC	A352 LCC+316	A350 LF2+HF	A182 F316

INSPECTION	DIMENSION INSPECTION						(mm)				PRESSURE TEST (ASME B16.34 & API 598)			VISUAL TEST
	Face to Face (End to End)	Flange Diameter	Bolt Circle	Dia. Of Raised Face	Flange Thickness	No. of Bolt Hole	Bolt Hole Diameter	SHELL (PSIG)	SEAT(Air) (PSIG)	BACK SEAT (PSIG)	VISUAL			
STANDARD	267±1.6	279	241.5	216	26	8	22	450	80	315	MSS-SP-95			
RESULT	W.T	W.T	W.T	W.T	W.T	W.T	W.T	GOOD	GOOD	GOOD	GOOD			

※ W.T : Within Tolerance

[illegible]

REMARKS :
IN ACCORDANCE WITH EN 10204 3.1
HEAT TREATMENT: LCC QUENCHED; 930°C X 3HR(W.C)+TEMPERED 700°C X 3HR(A.C)
TO NACE MR0103

Valve design and construction is in accordance with API 600, ASME B16.34
Products supplied are in compliance with the requirements of the purchase order

Manager, Q.A. Department

Witness Inspector

MATERIAL TEST REPORT

(CHEMICAL, PHYSICAL & HYDROSTATIC)

Beric-Davis Companies International, Ltd.
6059 South Loop East
Houston, TX 77087
Phone: 713 673-2073
Fax: 713 673-4641

DATE : JAN.16.2019

ARTICLE : 6 GATE VALVE RF 150 TRIM 12

FIGURE NO. : 101-06-RF-AH12-H-N

SERIAL NO. : DF-01-216-190116-12

TAG NO.: 101-06-RF-AH12-H-N

Q'ty : 1 Pcs

Class Rating: 150

SIZE : NPS 6

Body (BD) A352 LCC

Bonnet (BN) A352 LCC

Wedge/Disc (WD/DS) A352 LCC+316

Body Seat Ring A350 LF2+HF

Stem A182 F316

PARTS NAME	ASTM	Body (BD)	Bonnet (BN)	Wedge/Disc (WD/DS)	Body Seat Ring	Stem
MATERIAL		A352 LCC	A352 LCC	A352 LCC+316	A350 LF2+HF	A182 F316

INSPECTION	Face to Face (End to End)	Flange Diameter	Bolt Circle	Dia. Of Raised Face	Flange Thickness	No. of Bolt Hole	Bolt Hole Diameter	Shell (PSIG)	Seat (Air) (PSIG)	Back Seat (PSIG)	VISUAL TEST
STANDARD	267±1.6	279	241.5	216	26	8	22	450	80	320	VISUAL
RESULT	※ W.T	W.T	W.T	W.T	W.T	W.T	W.T	GOOD	GOOD	GOOD	MSS-SP-55
								GOOD	GOOD	GOOD	GOOD

※ W.T : Within Tolerance

SERIAL NO. BATCH	PARTS	HEAT NUMBER	CHEMICAL COMPOSITION (%) (ASTM STD.)											TENSION TEST (MIN.) (ASTM)					HARDNESS (HB)	CHARPY		
			C	Si	Mn	P	S	Ni	Cr	Mo	Cu	V	T.S (MPa)	Y.P (MPa)	EL. %	R.A %						
STANDARD	A352 LCC	Min.	0.250	0.600	1.200	0.040	0.045	0.500	0.500	0.200	0.300	0.030										
		Max.																				
DF-01-216-190116-12	BODY	GDN71	0.200	0.480	1.140	0.027	0.014	0.015	0.103	0.028	0.028	0.002	534	346	32.0	55.0	151				33-37-40	
	BONNET	GDN71	0.200	0.480	1.140	0.027	0.014	0.015	0.103	0.028	0.028	0.002	534	348	32.0	55.0	151				33-37-40	
	WEDGE/DISC	GDN71	0.200	0.480	1.140	0.027	0.014	0.015	0.103	0.028	0.028	0.002	534	348	32.0	55.0	151				33-37-40	



BERIC

(CHEMICAL, PHYSICAL & HYDROSTATIC)

DATE: SEP. 1. 2018

ARTICLE: 8 GATE VALVE RF 150 TRIM 12

FIGURE. NO.: 101-08-RF-AH12-H-N

SERIAL NO.: DF-01-250-180901-12

150

Class Rating:

INSPECTION	DIMENSION INSPECTION					No. of Bolt Hole	Bolt Hole Diameter	PRESSURE TEST (ASME B16.34 & API 698)			VISUAL TEST
	Face to Face (End to End)	Flange Diameter	Bolt Circle	Dia. Of Raised Face	Flange Thickness			SHELL (PSIG)	SEAT (Air) (PSIG)	BACK SEAT (PSIG)	
STANDARD	292±1.6	343	298.5	270	29	8	22	450	80	315	MSS-SP-55
RESULT	※ W.T	W.T	W.T	W.T	W.T	W.T	W.T	GOOD	GOOD	GOOD	GOOD

[illegible]

TO NACE MR0103

Manager, Q.A. Department

Witness Inspector

Products supplied are in compliance with the requirements of the purchase order



BERIC

(CHEMICAL, PHYSICAL & HYDROSTATIC)

DATE: JAN.16.2019

ARTICLE: 6 CHECK VALVE RF 150 TRIM 12

FIGURE NO. : 301-06-RF-FH12-X-N

SERIAL NO.: DF-01-228-190116-12

PCS

SIZE:	
-------	--

PARTS NAME	Body (BD)	Bonnet (BN)	Wedge/Disc (WD/DS)	Body Seat Ring	Pin
MATERIAL	ASTM	A352 LCC	A352 LCC	A350 LF2+HF	A182 F316

(mm)

INSPECTION	Face to Face (End to End)	Flange Diameter	Bolt Circle	Dia. Of Raised Face	Flange Thickness	No. of Bolt Hole	Bolt Hole Diameter	SHELL (PSIG)	SEAT (Hydro) (PSIG)	BACK SEAT (PSIG)	VISUAL
STANDARD	356±1.6	279	241.5	216	26	8	22	450	320	N/A	MSS-SP-55
RESULT	※ W.T	W.T	W.T	W.T	W.T	W.T	W.T	GOOD	GOOD	N/A	GOOD

※ W.T : Within Tolerance

[illegible]

REMARKS: IN ACCORDANCE WITH EN 10204 3.1

HEAT TREATMENT: LCC QUENCHED; 930°C X 3 HR(W.C)+TEMPERED 700°C X 3 HR(A.C)

TO NACE MR0103

Manager, Q.A. Department

Witness Inspector

Valve design and construction is in accordance with API 594, ASME B16.34

Products supplied are in compliance with the requirements of the purchase order



HEAT / SERIAL NUMBER RECORD

M. A. Stewart & Sons Ltd.
VALVES AND FITTINGS

(FORM 4.15.4A)

COMPANY;

EMCO / Equipment - KN for ABE mines

PAGE;

1 OF 1

BRANCH;

Rouyn - Noranda, Q.C.

MAS SALES REGISTER;

1436324

ATTN;

Richard Knight

DATE

June 10 / 19

PO#

26/0090 - 00

4						
5	1	8" Powell 3003FK	C5CL54	C5CL54	7F19226	
6		86XXX				
7						

19						
20						
21						
22						
23						
24						
25						

FAX STAMP



2503 Spring Grove Ave.
Cincinnati, OH 45214 U.S.A
Tel: 513-852-2000
info@powellvalves.com

VALVE CERTIFICATION

CERTIFIED MATERIAL TEST REPORT/CERTIFICATE OF CONFORMANCE
CERTIFIED TO ISO 9001 QUALITY STANDARDS

CERTIFICATE
NUMBER: **7F19226**
DATE: **7/15/15**

CUSTOMER: M. A. STEWART & SONS LTD.
CUSTOMER PO #: 1001802
POWELL ORDER: 904159
ITEM NUMBER: 8.0 3003FK8GXXX

PRESSURE TEST
Standard: API-598

SHELL 1125 PASS
SEAT (AIR) 80 PASS
SEAT (HYDRO) N/A N/A
BACKSEAT 825 PASS
(Values are PSI minimums)

INSPECTION

Dimensional: PASS
Operational: PASS
Visual: PASS

We certify that the valve meets the requirements of one or more of the following industry standards:

API 598 Valve Inspection and Testing
API 600 Bolted Bonnet Cast Steel Valves
API 602 Forged Valves
API 603 Bolted Bonnet Cast Stainless Steel Valves
API 622/624 Fugitive Emissions
ASME B16.10 End to End Dimensions
ASME B16.34 Valves
MSS SP25 Valve Markings
MSS SP55 Casting Surface Inspection

COMPONENT DATA (Chemical Properties)

HEAT NO: C5CL54 MATERIAL: A352LCC												PHYSICAL PROPERTIES		
BODY												Tensile (KSI)	Elong%	Reduct%
C	SI	MN	P	S	NI	CR	MO	CU	V			76.4	30.0	62.0
.19	.432	.86	.019	.011	.214	.047	.015	.031	.001			53.9		152

Normalized 1650°F Min, Liquid Quench, Temper 1100°F Min

HEAT NO: C5CL54 MATERIAL: A352LCC												PHYSICAL PROPERTIES		
BONNET/CAP												Tensile (KSI)	Elong%	Reduct%
C	SI	MN	P	S	NI	CR	MO	CU	V			76.4	30.0	152
.19	.432	.86	.019	.011	.214	.047	.015	.031	.001			53.9		62.0

Normalized 1650°F Min, Liquid Quench, Temper 1100°F Min

HEAT NO: C5C680 MATERIAL: A352LCC												PHYSICAL PROPERTIES		
DISC												Tensile (KSI)	Elong%	Reduct%
C	SI	MN	P	S	NI	CR	MO	CU	V			91.6	31.0	159
.197	.446	.915	.022	.009	.274	.058	.007	.026	.006			66.1		62.0

Normalized 1650°F Min, Liquid Quench, Temper 1100°F Min

CHARPY IMPACT RESULT

BODY	BONNET/CAP	DISC	MIN. OF 1 SPECIMEN (FT-LB)
28.7	28.7	34.6	
28.7	28.7	37.6	AVG OF 3 SPEC., MIN. OF 2 SPEC. (FT-LAB)
-50	-50	-50	TEST TEMPERATURE (DEGREES F)

SHELL TEST : 10 MIN MINIMUM DURATION

WE CERTIFY THAT THE ABOVE PRODUCT(S) CONFORM TO THE APPLICABLE REQUIREMENTS OF THE PURCHASE ORDER.
THESE RESULTS ARE IN ACCORDANCE WITH EN 10204 TYPE 3.1. <http://www.powellvalves.com>

CERTIFIED TO ISO 9001 QUALITY STANDARDS

Willard E. Kinter Jr.

Quality Manager

THE WM. POWELL COMPANY

Form F.10.6 2/23/11

WE CERTIFY THAT THE ABOVE PRODUCT(S) CONFORM TO THE APPLICABLE REQUIREMENTS OF THE PURCHASE ORDER.
THESE RESULTS ARE IN ACCORDANCE WITH EN 10204 TYPE 3.1. <http://www.powellvalves.com>

CERTIFIED TO ISO 9001 QUALITY STANDARDS



Apollo Valves
Division of Conbraco Industries
Conway, SC 29526
FAX: 843/347-1773
PHONE: 843/347-4666



MLTS_6056-18735
Cert# BV APOLLO

MATERIAL TEST REPORT

We certify that the below listed components were manufactured, tested, and inspected in accordance with the requirements of the procurement documents as stated.

Model Number: 831
Size: 2"
Quantity: 8
Material Specification: ASTM A352-18 LCC(LCC)

Customer Name: Masdom LTD
Customer Order Number: 19503
Valve Part Number: 83L-248-24
User Tag Number: B36652

Heat Code	C	Mn	P	S	Si	Cr	Ni	Mo	Cu	V	Cb	TENSILE		YIELD		%ELO 2"	%RA	HARDNESS S (RB unless noted)
												PSI	PSI	PSI	PSI			
AX	0.1965	1.3639	0.0109	0.0128	0.2577	0.1313	0.0341	0.0134	0.0443	0.0027		81002		54270		25	74	80
BW	0.1901	1.3903	0.0123	0.0138	0.3772	0.064	0.0364	0.0047	0.0433	0.0025		79634		53506		30	65	77
HU	0.197	1.34	0.014	0.008	0.334	0.061	0.038	0.012	0.115	0.003		83872		54730		31	67	81
KW	0.2085	1.314	0.0139	0.0115	0.2952	0.0273	0.0216	0.0052	0.0327	0.0023	0	77629		52937		27	70	79
Charpy Impact Test: Conducted in accordance with ASTM A370 Sections 19 Through 20. Standard full size test specimen.																		
Test Temperature: -50F	Heat Code		Average of 3 Test				Test 1		Test 2		Test 3							
	AX		36.52				32.95		29.95		46.67							
	BW		20.5333				20		20.4		21.2							
	HU		21.4667				23.2		20.8		20.4							
	KW		22.8667				22.8		23.6		22.2							

TESTING PROCEDURE: All Apollo Valves are 100% tested in accordance with their standard of construction. Valves designed to the requirements of ASME B16.34 are tested to meet or exceed the requirements of

We certify that the above listed components meet the requirements of the procurement documents as stated.
This material certificate complies with EN 10204-2004 Type 3.1 (formerly Type F3.1.B).

The above listed information is certified to be true and accurate to the best of my knowledge and belief.

Date: 08/01/19

Signed:



Steve Causey
Quality Assurance Manager



Apollo Valves

Division of Conbraco Industries

Conway, SC 29526

FAX: 843/347-1773

PHONE: 843/347-4666



MATERIAL TEST REPORT

We certify that the below listed components were manufactured, tested, and inspected in accordance with the requirements of the procurement documents as stated.

Model Number: 831

Size: 1"

Quantity: 8

Material Specification: ASTM A352-18 LCC(LCC)

Customer Name: Masdom LTD
Customer Order Number: 19503
Valve Part Number: 83L-245-24
User Tag Number: B36652

Heat Code	C	Mn	P	S	Si	Cr	Ni	Mo	Cu	V	Cb	TENSILE		YIELD	%ELO	%RA	HARDNES
												PSI	PSI				
AX	0.1965	1.3639	0.0109	0.0128	0.2577	0.1313	0.0341	0.0134	0.0443	0.0027		81002		54270	25	74	80
KW	0.2085	1.314	0.0139	0.0115	0.2952	0.0273	0.0216	0.0052	0.0327	0.0023	0	77629		52937	27	70	79
LW	0.1848	1.3624	0.0111	0.002	0.2961	0.1055	0.0326	0.0114	0.0266	0.0021		77277		50671	27.2	71.7	79

Charpy Impact Test: Conducted in accordance with ASTM A370 Sections 19 Through 20. Standard full size test specimen.	
Test Temperature: -50F	Heat Code
	AX
	KW
	LW
Average of 3 Test	Test 1
36.52	32.95
22.8667	22.8
25.6	20
Test 2	Test 3
29.95	46.67
23.6	22.2
21.1	35.7

Charpy Impact Test: Conducted in accordance with ASTM A370 Sections 19 Through 20. Standard full size test specimen.

Test Temperature: -50F

Heat Code

AX

KW

LW

Average of 3 Test

36.52

22.8667

25.6

Test 1

32.95

22.8

20

Test 2

29.95

23.6

21.1

Test 3

46.67

22.2

35.7

TESTING PROCEDURE: All Apollo Valves are 100% tested in accordance with their standard of construction. Valves designed to the requirements of ASME B16.34 are tested to meet or exceed the requirements of API 598, ASME B16.34, MSS SP-61 and MSS SP-72. Valves designed to the requirements of MSS SP-110, are tested to meet or exceed the requirements of MSS SP-110. Specification sheets are available at www.apollovalves.com.

We certify that the above listed components meet the requirements of the procurement documents as stated.

This material certificate complies with EN 10204-2004 Type 3.1 (formerly Type F3.1.B).

Date:

08/01/19

Signed:

The above listed information is certified to be true and accurate to the best of my knowledge and belief.



Steve Causey
Quality Assurance Manager

Certificate of Compliance (QC-02)**FARRIS ENGINEERING
DIV. OF CURTISS-WRIGHT FCC
10195 BRECKSVILLE RD
BRECKSVILLE OH 44141
UNITED STATES**

Date: 07/10/2019

Sales Order No.: 1SL047059

Customer:

Customer Order No.: 00026111

CRN No.: CSA-0G11969.5CL

**MLTS_6056-18735
Cert# PRV FARRIS**

Line	Tag Number	Model Number	Serial Number
1		27EA34-M20	942333-1-KE
1		27EA34-M20	942333-2-KE
1		27EA34-M20	942333-3-KE
1		27EA34-M20	942333-4-KE

We hereby certify that the valve(s) indicated above have been designed, manufactured and tested in accordance with ASME Section VIII, Division 1 by Curtiss-Wright Flow Control Corp.- Farris Engineering in accordance with the company's Quality Control Program. The Brecksville Facility's Quality Control Program is registered to ISO 9001:2015, Certificate Identity No. 10076249. We hereby certify that they were produced in conformance with the contract and Farris Worldwide Quality Manual Revision N, dated 13-Sep-18.

The representative signing the document states that the above information is correct and true.

Anthony Korinek



Certified Individual

Date: 07/10/2019

Material Test Reports (QC-04)

FARRIS ENGINEERING
DIV. OF CURTISS-WRIGHT FCC
10195 BRECKSVILLE RD
BRECKSVILLE OH 44141
UNITED STATES

Sales Order No.: 1SL047059 Line No.: 1 Qty: 4
Customer:
Customer Order No.: 00026111
Model No.: 27EA34-M20
Serial No.: 942333-1-KE, 942333-2-KE, 942333-3-KE, 942333-4-KE
Tag No.:

Serial No.	Component	Item Number	Lot Number	Material Description
942333-1-KE	BODY 1 X 1/2 MNPT 2700	325737X1-010	872-0118	ASME SA-479 316SS
942333-1-KE	DISC 2700	325742-010	900758	ASME SA-479 316SS
942333-1-KE	BONNET 2700	326076X2-023	640G	ASME SA-216 WCB
942333-2-KE	BODY 1 X 1/2 MNPT 2700	325737X1-010	872-0118	ASME SA-479 316SS
942333-2-KE	DISC 2700	325742-010	900758	ASME SA-479 316SS
942333-2-KE	BONNET 2700	326076X2-023	640G	ASME SA-216 WCB
942333-3-KE	BODY 1 X 1/2 MNPT 2700	325737X1-010	872-0118	ASME SA-479 316SS
942333-3-KE	DISC 2700	325742-010	900758	ASME SA-479 316SS
942333-3-KE	BONNET 2700	326076X2-023	640G	ASME SA-216 WCB
942333-4-KE	BODY 1 X 1/2 MNPT 2700	325737X1-010	872-0118	ASME SA-479 316SS
942333-4-KE	DISC 2700	325742-010	900758	ASME SA-479 316SS
942333-4-KE	BONNET 2700	326076X2-023	640G	ASME SA-216 WCB

Note: Traceability of individual parts to their NDE and special process reports is maintained through Lot Codes created by serializing the lot number shown on the material manufacturer's Material Test Report.

产品质量证明书 INSPECTION CERTIFICATE

---EN10204 3.1

TJ8868

江阴市不锈钢材料厂JIANGYINSHI STAINLESS STEEL MATERIAL FACTORY

地址: 中国江苏省江阴市周庄镇路口桥

Add: Lukouqiao Zhouzhuang Town JiangYin JiangSu China

TEL:(0510)86236681 FAX:(0510)86905200

收货单位: 成飞机械

执行标准:

ASME SA479 2015

合同号: 7969

编号: 20180901

SOLD TO: Curtisswright (Tianjin) Flow Control CO.,LTD

STANDARDS:

CONTRACT NO:

Serial number:

序号 No	钢号 Grade	规格 Size	冶炼炉号 Heat No.	支数 Bundles	重量 Weight (kg)	化学成分 Chemical Composition (%)					
						C	Si	Mn	P	S	Ni
1	316/316L	φ78	872-0118	9	1120	≤0.030	≤1.00	≤2.00	≤0.045	≤0.030	10.00-14.00
2	316/316L	φ72	872-0117	18	2176	0.03	0.4	1.76	0.034	0.025	10.2
3	316/316L	φ72	872-0117	9	1075	0.026	0.4	1.74	0.034	0.02	10.14
4	316/316L	φ50.8	872-0118	15	1093	0.026	0.4	1.74	0.034	0.02	10.14
5	316/316L	φ50.8	872-0118	9	984	0.03	0.4	1.76	0.034	0.025	10.2

机械性能: Mechanical Properties

序号 No	热处理炉号 Heat treatment furnace no.	热处理状态Heat treatment condition	抗拉强度 Tensile Strength Rm (Mpa) ≥ 515	屈服强度 Yield Strength Rp0.2(Mpa) ≥ 205	伸长率 Elongation A (%) ≥ 30	断面收缩率 Reduction of Area Z (%) ≥ 40	冲击试验Impact charpy		交货状态 The delivery status
							Individual Kv2(J) ≥ 41 Individual 单个功	Average 平均功	
1	180326-1	固溶处理 Solution treatment	587	310	58	80	APPROVED		光亮Bright
2	180326-1		592	311	56	78			
3	180315-1		595	314	55	76			
4	180407-1		590	312	57	79			
5	180407-1		590	312	57	79			

说明: 1. 有异议时, 来函请标明钢号、炉号、规格、发货日期、原因, 并将实物保管好。

Notes: (1) When there is any complain, you are kindly requested to mark the Steel Grade, Heat No., Size, Delivery Date, Causes and reserve the materials in the condition

备注: Heat treatment: Solution treatment : 1900°F, 1 hours minimum, rapidly cooled to below 90°F.
The material supplied meets the requirements of the current versions of NACE MR0103 and MR0175/ISO 15156, 提供的材料符合NACE MR0103 and MR0175/ISO15156标准

热处理: 固溶处理: 1040℃最少1小时保温, 出炉急冷到32℃以下。

签发日期: 2018/9/10

制单:

卡玉霞

审核:

张永忠

examine and verify

Principal

Issued Date

质量部盖章有效

Stamp of Department of Quality Assurance

质量检验章

江阴市不锈钢材料厂

福建省明溪县长虹精密铸钢有限公司
Fujian Mingxi Changhong Precision
Steel Casting Co., Ltd.
Address: Pingpu industrial Park Mingxi
county, Fujian, China. Tel: 0598-2866208, Fax: 0598-
2867736

材料质量证明书

Material Inspection

EN 10204 3.1



CHHJZ

Customer: Curtiss-wright Flow Control
Farris Engineering

Address: No. 3 Quanhui Road, Wuqing Development
Area, Tianjin China. Tel: 86-22-82166100, Fax: 86-22-
82166160

证书编号 Cert. No.: 201901085

No.	产品名称 Product	零件号 Part No.	执行标准 Product Std.	材质 Material	数量 Quantity	炉号 Heat No.	订单号 Order No.
1	Bonnet	326076X2-023	ASME SA216-2015	WCB	12	637G	6PR002478
2	Bonnet	326076X2-023	ASME SA216-2015	WCB	10	638G	6PR002478
3	Bonnet	326076X2-023	ASME SA216-2015	WCB	10	639G	6PR002478
4	Bonnet	326076X2-023	ASME SA216-2015	WCB	25	640G	6PR002478
5	Bonnet	326076X2-023	ASME SA216-2015	WCB	22	641G	6PR002478
6	Bonnet	326076X2-023	ASME SA216-2015	WCB	17	642G	6PR002478/2480
7	Bonnet	326076X2-023	ASME SA216-2015	WCB	20	752G	6PR002480

化学成分 Chemical Compositions

Spec.	C	Si	Mn	P	S	Cr	Ni	Mo	Cu	V	N
标准值	≤0.3	≤0.6	≤1.0	≤0.04	≤0.045	≤0.5	≤0.5	≤0.2	≤0.3	≤0.03	
637G	0.222	0.197	0.772	0.017	0.007	0.071	0.024	0.004	0.011	0.001	
638G	0.213	0.210	0.703	0.020	0.008	0.071	0.017	0.002	0.010	0.002	
639G	0.215	0.212	0.703	0.020	0.008	0.071	0.017	0.002	0.010	0.001	
640G	0.261	0.204	0.672	0.022	0.008	0.099	0.026	0.003	0.011	0.002	
641G	0.212	0.230	0.675	0.018	0.006	0.096	0.030	0.003	0.011	0.002	
642G	0.212	0.229	0.677	0.019	0.006	0.096	0.029	0.003	0.011	0.002	
752G	0.220	0.218	0.689	0.021	0.006	0.057	0.030	0.004	0.011	0.002	

	抗拉强度 Tensile	屈服强度 Yield	延伸率 Elongation	断面收缩率 Reduction	冲击功 Charpy Impact Test (J)	硬度 Hardness
Spec.	Strength (MPa)	Strength (MPa)	%	%	Temp. °C	HB
标准值	485-655	≥250	≥22	≥35	-29	≤237
637G	550	360	37	60		159
638G	553	350	36	62		158
639G	555	363	36	60		157
640G	546	357	38	59		156
641G	549	352	37	61		156
642G	549	348	36	60		153
752G	537	361	35	63		158

热处理 Heat Treatment

序号 No.	热处理炉号 Heat Lot.	浇注炉号 Heat No.	入炉时间 Charging time	入炉温度 Charging Temp.	到温时间 Start Time	到温温度 Hold Temp.	出炉时间 Finished Time	出炉温度 Finish Temp.	保温时间 H Soak time (H)	冷却方式 Cooling
1	181030-1	637G	7:25	413	9:20	905	11:20	907	2:00	Air 空气
2	181030-1	638G	7:25	413	9:20	905	11:20	907	2:00	Air 空气
3	181030-1	639G	7:25	413	9:20	905	11:20	907	2:00	Air 空气
4	181108-1	640G	7:16	520	9:00	902	11:00	906	2:00	Air 空气
5	181106-1	641G	8:00	368	10:00	901	12:00	905	2:00	Air 空气
6	181106-1	642G	8:00	368	10:00	901	12:00	905	2:00	Air 空气
7	180830-1	752G	7:25	425	9:20	908	11:20	910	2:00	Air 空气

其他信息 Other Informations

序号 No.	外观尺寸检查 Visual & Dimension	无损探伤 NDT MT/PT UT RT	交货状态 Delivery Condition
1	OK	OK	正火状态 Normalized

- We hereby certify that the materials described herein have been manufactured, inspected and tested in accordance with the customer's specification(s), and that they satisfy the requirements.
- All of casting visual inspection according to MSS-SP-55.
- The material supplied meets the requirements of the current version of NACE MR0103 and MR0175/ISO 15156.

APPROVE

编制 Prepared By:
谢海荣 2019-1-25

审批 Approved By: 2019-01-30
易娟 2019-1-25 FARRIS ENGINEERING
QUALITY CONTROL
BY QC 03

MILL TEST CERTIFICATE

Basauri Plant

ISO 9001; ISO-TS 16949; ISO 14001 Y OHSAS 18001



Product Made in Spain

CUSTOMER:MAGELLAN CORPORATION	WORKS REFERENCE:1910594
REFERENCE:211222	SALES ORDER:299090-2
PRODUCT NR:	HEAT NUMBER:900758
	ROLLED:04.01.2017
	MASTER REFERENCE:215719

REQUIRED PRODUCT			
AISI316/316L ROUND BARS TURNED SOLUTION ANNEALED 0.8750" SPECIFICATION'S TOLERANCE 12'-12'2" NORMAL			
EXPEDITION	DELIVERY:0080571873	WEIGHT (KG):4.614	BUNDLES:6
			UNITS:400

MADE ACCORDING TO	
AISI STAINLESS STEELS - 01.03.1999; ASME SA182-SA182M SECTION II, PART A -2015	
ASME SA193-SA193M/SECTION II, PART A -2015; ASME SA320-SA320M/SECTION II, PART A 20132013	
ASME SA479-SA479M SECTION II, PART A -2015; ASTM A182-A182M 2015 01.06.2015	
ASTM A193-A193M 2015 01.06.2015; ASTM A276/A276M 15 01.01.2015; ASTM A314 2015 15.07.2015	
ASTM A320-A320M 2015 01.05.2015; ASTM A370 2014 15.05.2014; ASTM A473 13 01.11.2013	
ASTM A479-A479M 2015 15.07.2015; ASTM A484-A484M 15 01.03.2015; ASTM A751 2014 01.03.2014	
EN 10204 :2004 OCT. 2004 3.1; MAGELLAN MIC 1751 AMD12.3 21.12.2016	
MAGELLAN MIC 1751 SUPP AISI316/AISI316L - 24.06.2015; NACE MR0103-2005 - 2005	
NACE MR0175/ISO 15156-1 3* EDICION 23.11.2015; NACE MR0175/ISO 15156-3 3* EDICION 23.11.2015	
SAE AMS 5648 L . .09.2012; SAE AMS 5653 H . .11.2012; SAE AMS-QQ-S-763 D 03.2015	

CHEMICAL ANALYSIS OF HEAT									U:% HEAT NUMBER:900758		
	C	Mn	Si	P	S	Cr	Ni	Mo	V	W	Co
Min.		1,250			0,020	16,500	10,000	2,000			
Max.	0,030	2,000	0,750	0,040	0,030	18,000	13,000	2,500	0,100	0,100	0,3000
cer.	0,015	1,490	0,488	0,026	0,025	16,700	10,120	2,030	0,060	0,082	0,2280
	Cu	Al	Ti	Nb	N						
Min.											
Max.	0,750	0,100	0,1000	0,1000	0,1000						
cer.	0,337	0,006	0,0050	0,0160	0,0730						

INCLUSIONS (MICROINCLUSIONS)	
Standard(ASTM E45 20132013); Type/method(A); A(t):2,5; A(h):1; B(t):0,5; B(h):0,5; C(t):1,5	
C(h):1; D(t):0,5; D(h):0,5	

MECHANICAL PROPERTIES AS SUPPLIED (TEST)	
Sample:Supply section (bar prolongation); Specimen Test location:Nucleus	
Standard(1) (ASTM A370 2014 15.05.2014); Standard(2) (ASTM E8/E8M 2015A 15.05.2015)	
Tensile direction:Longitudinal; Tensile test Temp.(Room temperature):Room temperature	
Ts(83.000/120.000PSI):88.605PSI; Ys(0,2% >=30.000PSI):0,2% 44.089PSI; El.(2" >=40%):2" 57,2%	
Z(>=50%):74,9%; Standard(ASTM E23 07-AE1 2007)	
Notch impact direction:Longitudinal; Notch Impact sample type(CHARPY-V):CHARPY-V	
Notch Impact Temp.(68°F):68°F; K(1):203Ft.Lb; K(2):206Ft.Lb; K(3):205Ft.Lb; K (average):204,67	
K (single)(>=75Ft.Lb):203Ft.Lb; Hardness Standard(1) (ASTM A370 2014 15.05.2014)	
Hardness Standard(2) (ASTM E10 2015 01.05.2015)	
Surface hardness(of the bar 140/223HB):of the bar 208HB	
Hardness at(at 1/2 radius of the bar 140/223HB):at 1/2 radius of the bar 162HB	

ADDITIONAL TESTS	
Standard(ASTM A262 - 01.07.2014); Type / Method(Practice E):Practice E	
Standard(ASTM E112 2013 01.10.2013); Grain size:Austenitic 6; Standard(ASTM E381 2001 R2006)	
macroetching(1):S 1; macroetching(2):R 1; macroetching(3):C 1; Intercrystalline Corrosion:0.K.	

APPROVED
PARRIS ENGINEERING - QUALITY CONTROL

NOV. 14 2018

BY N° 1005557

JH 7722

TECHNOLOGY & QUALITY CERTIFIES THAT THE PRODUCT FULL FILLS THE ORDER'S SPECIFICATION

APPROVED BY:ALBERTO CUBERO ZABALA

SIGN:

DATE:21.02.2017

Page 1 of 2

REF.:1002484420000

Analyst of Quality certificates



MILL TEST CERTIFICATE

Basauri Plant

ISO 9001; ISO-TS 16949; ISO 14001 Y OHSAS 18001



Product Made in Spain

CUSTOMER: MAGELLAN CORPORATION	WORKS REFERENCE: 1910594
REFERENCE: 211222	SALES ORDER: 299090-2
PRODUCT NR:	HEAT NUMBER: 900758
MASTER REFERENCE: 215719	ROLLED: 04.01.2017

NON DESTRUCTIVE TESTS

U.T. standard(1) (ASTM A388-A388M 2015 15.07.2015); U.T. type/method(1) (FBH)
 U.T. standard(2) (API SPEC 6A 20th ED.+ER1&2+AD12.3 . . 03.2013); U.T. type/method(2) (PSL3)
 U.T. standard(3) (ISO 10423 4th ED.2009 15.12.2009); U.T. type/method(3) (PSL3)
 ULTRASONIC INSPECTION 100% : O.K. (1) =<1,5 mm.(according to Suplem.1 ASTM A388)
 ULTRASONIC INSPECTION 100% : O.K. (2) according to: API 6A/ISO-10423 "PSL3"
 ULTRASONIC INSPECTION 100% : O.K. (3); CRACKS CONTROL 100% : O.K.

ADDITIONAL INFORMATION

Reduction ratio: 49,7; "Macrostructure: Satisfactory"
 Ultrasonic Inspection Results ("ASTM A388: Satisfactory"); DFARS Compliant
 HEAT MELTED AT OUTOKUMPU (UK) AND PROCESSED AT SIDENOR (SPAIN); RoHS Compliant
 Material Cold Finished, Peeled and Reeled; CONTINUOUS CASTING 150 X 150 mm.
 SOLUTION ANNEALED at 1922°F - IN AIR; .; .

Material manufactured through the Electric Arc Furnace and AOD.
 Steel not exposed to Mercury, or to any other metal alloy that is liquid, at ambient temperatures during processing or while in Sidenor's possession.
 Steel is free from Uranium or any other harmful radioactive contamination.
 Steel products were not repaired by welding.
 100% anti mix test: performed by spectrometry.

APPROVED
 FARRIS ENGINEERING - QUALITY CONTROL

NOV 14 2018

BY 1005557

JH7722

TECHNOLOGY & QUALITY CERTIFIES THAT THE PRODUCT FULL FILLS THE ORDER'S SPECIFICATIONS

APPROVED BY: ALBERTO CUBERO ZABALA

SIGN:

DATE: 21.02.2017

Page 2 of 2

REF.: 100243420000

Analyst of Quality Certificates





M.A. Stewart & Sons Ltd.

PICK TICKET

MAS Edmonton Branch
1315473

SOLD TO
EMCO LTD WESTLUND (261) ROUYN-NORANDA
PO BOX 5300 STN A
WESTLUND
LONDON, ON N6A 4N7
CANADA

Ordered By: Chantal Gregoire

EX EDM
MTL

PICK DATE	PICK TICKET	ORDER NUMBER
8/20/2019	1315473	1452662
SHIP TO NO	CUSTOMER NO	PAGE
103449	103449	1 of 1
PICKED BY:	CHECKED BY:	

MTR'S WHEN APPLICABLE

SHIP TO
ABF MINES CANADA INC. (2985080)
1310 AVE DAVY
ROUYN-NORANDA, QC J9Y 0A8
CANADA

ORDER DATE	CUSTOMER PO / ORDER NUMBER	CARRIER	TAKER
8/20/2019	DO2610173-00	Purolator	ANDREN
Delivery / Quick Notes		QTY	Item
		Box ID	Skid ID

Delivery Instructions: EX: EDMONTON / PUROLATOR # 7334590

18 FF

4
EA

014-53208 MAS LSSF3-HDFS-N
1 3000WOG FP LCC IP 3PC FS NACE BALL

18 FF 185K

1
EA

014-53214 MAS LSSF3-HDFS-N
2 2000WOG FP LCC IP 3PC FS NACE BALL

Total Lines: 2
Total Pieces: 5
Total Weight: 32.891

Total Skids / Boxes:

Shipment Weight:

MLTS_6056-18953
Cert# BV MAS

JY VALVE & MFG. CO., LTD.

(Qianguo Village, Huangtang Town) Chengxi Taiwanese Business Base
Huian County, Quanzhou, Fujian, China 362101
TEL : (0595) 2730-1335 FAX : (0595) 2730-1336

MESSRS.: M. A. STEWART & SONS LTD.

DELIVER TO: VANCOUVER

SHEET NO.: LSSF3HDFS-F181206-1

P.O. NO. #1011686

DATE : DEC. 26, 2018

CERTIFICATE OF COMPLIANCE

WE, JY VALVE & MFG. CO., LTD. HEREBY CERTIFY THAT OUR
PRODUCTS AS SHOWN ON DRAWINGS OF OUR MODEL LSSF3-HDFS-N ARE
MANUFACTURED, INSPECTED AND TESTED FULLY IN ACCORDANCE WITH THE
FOLLOWING STANDARDS:

PRESSURE-TEMPERATURE RATING	1/4" TO 1"	3000 PSIG @100°F
	1-1/4" TO 2"	2000 PSIG @100°F
	2-1/2" TO 3"	1000 PSIG @100°F
BODY & CAP	ASTM A352-LCC	
SEAT MATERIAL	R-PTFE	
VALVE TESTING	API 598 ※	
FIRE TEST STANDARD	API 607 5TH EDITION	
END CONNECTION	NPT THREADS TO ANSI B1.20.1	

※ HIGH PRESSURE SHELL TEST AND LOW PRESSURE SEAT TEST ARE
PERFORMED 100%.

- NACE MR-0175-2002 AND MR-0103 COMPLIANCE

JY VALVE & MFG. CO., LTD.



CHARLES CHAN, PRESIDENT

MATERIAL TEST RESULTS

MESSRS. : M. A. STEWART & SONS LTD.
TO : VANCOUVER
P.O. NO. : #1011686

SHEET NO. : LSSF3HDFSN-F181206-3
EXPORT NO : F181206
DATE : DEC. 26, 2018

VALVE MODEL : LSSF3-HDFS-N
3000/2000/1000 WOG BALL VALVE
REVIEWED BY : QUAN ZHOU JING YING VALVE CO., LTD.

SIZE : 1"
MATERIAL: ASTM-A352 GRADE LCC

Jason Huang

JASON HUANG, QC MANAGER
JY VALVE & MFG. CO., LTD.

CHEMICAL REQUIREMENT (%)												
ELEMENT		C	Si	Mn	P	S	Ni	Cr	Mo	V		
SPEC (MAX.)		0.250	0.600	1.200	0.040	0.045	0.500	0.500	0.200	0.030		
Production No	Parts Name	B For each reduction of 0.01% below the specified maximum carbon content, an increase of 0.04% Mn above the specified maximum will be permitted up to a maximum of 1.25%										
18FF	BODY & CAP	0.2010	0.4400	0.6900	0.0150	0.0048	0.3230	0.4000	0.0740	0.0120		
TENSILE REQUIREMENTS		Tensile Stength (MPa)	Yield Strength (MPa)	Elongation (%)	Reduction of area (%)	Hardness (HB)	Charpy V-Notch Energy value					
Production No	Parts Name	485 - 655	Min. 275	Min. 22	Min. 35	Max. 187	Min. 20					
18FF	BODY & CAP	524	288	36	45	160	52					
Heat treatment	NORMALIZED @890 DEGREE C - 1H AIR COOLING AND TEMPERED											

WE HEREBY CERTIFY THAT THE MATERIAL HEREIN DESCRIBED ARE SATISFACTORY IN ACCORDANCE WITH THE SPECIFICATION.

MATERIAL TEST RESULTS

MESSRS. : M. A. STEWART & SONS LTD.
 TO : VANCOUVER
 P.O. NO. : #1011686

SHEET NO. : LSSF3HDFSN-F181206-4
 EXPORT NO : F181206
 DATE : DEC. 26, 2018

Jason Huang

VALVE MODEL : LSSF3-HDFS-N SIZE : 1"
 3000/2000/1000 WOG BALL VALVE MATERIAL: ASTM-A351 GRADE CF8M
 REVIEWED BY : FUZHOU SHI GANG VALVE MANUFACTURE CO.,LTD

JASON HUANG, QC MANAGER
 JY VALVE & MFG. CO., LTD.

CHEMICAL REQUIREMENT (%)											
ELEMENT		C	Mn	Si	S	P	Cr	Ni	Mo		
SPEC (MAX.)		0.080	1.500	1.500	0.040	0.040	18.0-21.0	9.0-12.0	2.0-3.0		
Production No	Parts Name										
B-1118	BALL	0.0510	0.7900	0.5090	0.0083	0.0383	18.0900	9.0400	2.0700		
TENSILE REQUIREMENTS		Tensile Strength (MPa)		Yield Strength (MPa)		Elongation (%)		Hardness (HB)			
Production No	Parts Name	Min.485		Min. 205		Min. 30		Max. 187			
B-1118	BALL	515		225		35		165			
Heat treatment	SOLUTION TREATMENT: @1080 DEGREE C - 1H WATER QUENCHING										

WE HEREBY CERTIFY THAT THE MATERIAL HEREIN DESCRIBED ARE SATISFACTORY IN ACCORDANCE WITH THE SPECIFICATION.

MATERIAL TEST RESULTS

MESSRS. : M. A. STEWART & SONS LTD.
 TO : VANCOUVER
 P.O. NO. : #1011686

SHEET NO. : LSSF3HDFSN-F181206-5
 EXPORT NO : F181206
 DATE : DEC. 26, 2018

Jason Huang

VALVE MODEL : LSSF3-HDFS-N SIZE : 1"
 3000/2000/1000 WOG BALL VALVE MATERIAL: ASTM-A276 TYPE 316
 REVIEWED BY : GAOYOU WEI DA STAINLESS STEEL CO., LTD.

JASON HUANG, QC MANAGER
 JY VALVE & MFG. CO., LTD.

CHEMICAL REQUIREMENT (%)											
ELEMENT		C	Mn	P	S	Si	Cr	Ni	Mo		
SPEC (MAX.)											
Production No	Parts Name										
S-1118	STEM	0.080	2.000	0.045	0.030	1.000	16.0-18.0	10.0-14.0	2.00-3.00		
		0.0780	0.9800	0.0020	0.0210	0.6500	16.6200	10.8000	2.0800		
TENSILE REQUIREMENTS		Tensile Strength (MPa)		Yield Strength (MPa)		Elongation (%)		Reduction of area (%)		Hardness (HB)	
Production No	Parts Name	Min. 515		Min. 205		Min. 40		Min. 50		Max. 187	
S-1118	STEM	518		218		48		53		166	
Heat treatment	HOT-FINISHED										

WE HEREBY CERTIFY THAT THE MATERIAL HEREIN DESCRIBED ARE SATISFACTORY IN ACCORDANCE WITH THE SPECIFICATION.

JY VALVE & MFG. CO., LTD.

(Qianguo Village,Huangtang Town)Chengxi Taiwanese Business Base
Huian County,Quanzhou,Fujian,China 362101
TEL : (0595) 2730-1335 FAX : (0595) 2730-1336

MESSRS.: M. A. STEWART & SONS LTD.

DELIVER TO: VANCOUVER

SHEET NO.: LSSF3HDFS-N-F190403-1

P.O. NO. #1011686

DATE : APR. 24, 2019

CERTIFICATE OF COMPLIANCE

WE, JY VALVE & MFG. CO., LTD. HEREBY CERTIFY THAT OUR
PRODUCTS AS SHOWN ON DRAWINGS OF OUR MODEL LSSF3-HDFS-N ARE
MANUFACTURED, INSPECTED AND TESTED FULLY IN ACCORDANCE WITH THE
FOLLOWING STANDARDS:

PRESSURE-TEMPERATURE RATING	1/4" TO 1"	3000 PSIG @100°F
	1-1/4" TO 2"	2000 PSIG @100°F
	2-1/2" TO 3"	1000 PSIG @100°F
BODY & CAP	ASTM A352-LCC	
SEAT MATERIAL	R-PTFE	
VALVE TESTING	API 598 ※	
FIRE TEST STANDARD	API 607 5TH EDITION	
END CONNECTION	NPT THREADS TO ANSI B1.20.1	

※ HIGH PRESSURE SHELL TEST AND LOW PRESSURE SEAT TEST ARE
PERFORMED 100%.

- NACE MR-0175-2002 AND MR-0103 COMPLIANCE

JY VALVE & MFG. CO., LTD.



CHARLES CHAN, PRESIDENT

MATERIAL TEST RESULTS

MESSRS. : M. A. STEWART & SONS LTD.
 TO : VANCOUVER
 P.O. NO. : #1011686

SHEET NO. : LSSF3HDFSN-F190403-3
 EXPORT NO : F190403
 DATE : APR. 24, 2019

VALVE MODEL : LSSF3-HDFS-N
3000/2000/1000 WOG BALL VALVE
 REVIEWED BY : QUAN ZHOU JING YING VALVE CO., LTD.

SIZE : 2"

MATERIAL: ASTM-A352 GRADE LCC

Jason Huang

JASON HUANG, QC MANAGER
 JY VALVE & MFG. CO., LTD.

CHEMICAL REQUIREMENT (%)												
ELEMENT		C	Si	Mn	P	S	Ni	Cr	Mo	V		
SPEC (MAX.)		0.250	0.600	1.200	0.040	0.045	0.500	0.500	0.200	0.030		
Production No	Parts Name	B For each reduction of 0.01% below the specified maximum carbon content, an increase of 0.04% Mn above the specified maximum will be permitted up to a maximum of 1.25%										
18FF	BODY	0.2010	0.4400	0.6900	0.0150	0.0048	0.3230	0.4000	0.0740	0.0120		
18JF	CAP	0.2010	0.4400	0.6900	0.0150	0.0048	0.3230	0.4000	0.0740	0.0120		
TENSILE REQUIREMENTS		Tensile Stength (MPa)	Yield Strength (MPa)	Elongation (%)	Reduction of area (%)	Hardness (HB)	Charpy V-Notch Energy value					
Production No	Parts Name	485 - 655	Min. 275	Min. 22	Min. 35	Max. 187	Min. 20					
18FF	BODY	524	288	36	45	160	52					
18JF	CAP	524	288	36	45	160	52					
Heat treatment	NORMALIZED @890 DEGREE C - 1H AIR COOLING AND TEMPERED											

WE HEREBY CERTIFY THAT THE MATERIAL HEREIN DESCRIBED ARE SATISFACTORY IN ACCORDANCE WITH THE SPECIFICATION.

MATERIAL TEST RESULTS

MESSRS. : M. A. STEWART & SONS LTD.
 TO : VANCOUVER
 P.O. NO. : #1011686

SHEET NO. : LSSF3HDFS-N-F190403-4
 EXPORT NO : F190403
 DATE : APR. 24, 2019

Jason Huang

VALVE MODEL : LSSF3-HDFS-N
 3000/2000/1000 WOG BALL VALVE
 MATERIAL: ASTM-A351 GRADE CF8M
 REVIEWED BY : FUZHOU SHI GANG VALVE MANUFACTURE CO.,LTD

SIZE : 2"

JASON HUANG, QC MANAGER
 JY VALVE & MFG. CO., LTD.

CHEMICAL REQUIREMENT (%)										
ELEMENT		C	Mn	Si	S	P	Cr	Ni	Mo	
SPEC (MAX.)		0.080	1.500	1.500	0.040	0.040	18.0-21.0	9.0-12.0	2.0-3.0	
Production No	Parts Name									
B-0319	BALL	0.0503	0.6880	0.4740	0.0065	0.0378	18.3200	9.1600	2.0500	
TENSILE REQUIREMENTS		Tensile Strength (MPa)		Yield Strength (MPa)		Elongation (%)		Hardness (HB)		
Production No	Parts Name	Min.485		Min. 205		Min. 30		Max. 187		
B-0319	BALL	545		245		47		140		
Heat treatment	SOLUTION TREATMENT: @1080 DEGREE C - 1H WATER QUENCHING									

WE HEREBY CERTIFY THAT THE MATERIAL HEREIN DESCRIBED ARE SATISFACTORY IN ACCORDANCE WITH THE SPECIFICATION.

MATERIAL TEST RESULTS

MESSRS. : M. A. STEWART & SONS LTD.
 TO : VANCOUVER
 P.O. NO. : #1011686

SHEET NO. : LSSF3HDFS-N-F190403-5
 EXPORT NO : F190403
 DATE : APR. 24, 2019

VALVE MODEL : LSSF3-HDFS-N
 3000/2000/1000 WOG BALL VALVE

SIZE : 2"

MATERIAL: ASTM-A276 TYPE 316

REVIEWED BY : GAOYOU WEI DA STAINLESS STEEL CO., LTD.

Jason Huang

JASON HUANG, QC MANAGER
 JY VALVE & MFG. CO., LTD.

CHEMICAL REQUIREMENT (%)										
ELEMENT		C	Mn	P	S	Si	Cr	Ni	Mo	
SPEC (MAX.)		0.080	2.000	0.045	0.030	1.000	16.0-18.0	10.0-14.0	2.00-3.00	
Production No	Parts Name									
S-0319	STEM	0.0700	0.9600	0.0020	0.0230	0.7500	16.8200	10.6000	2.2500	
TENSILE REQUIREMENTS		Tensile Strength (MPa)		Yield Strength (MPa)		Elongation (%)		Reduction of area (%)		Hardness (HB)
Production No	Parts Name	Min. 515		Min. 205		Min. 40		Min. 50		Max. 187
S-0319	STEM	518		218		48		53		166
Heat treatment	HOT-FINISHED									

WE HEREBY CERTIFY THAT THE MATERIAL HEREIN DESCRIBED ARE SATISFACTORY IN ACCORDANCE WITH THE SPECIFICATION.



NEWCO® | OIC® | DOUGLAS CHERO™

13127 Trinity Dr., Stafford, TX 77477
Tel: 281-302-4900 Fax: 281-302-4801

Item No: B1060015FHLCCW27RF**GZA
Size/Type: 6" / Gate
Quantity: 1
Country of Origin: China
FigNo: 11F-LCC4/2-NC

Material Test Report

Cameron Newco is a 9001 certified registered company
CRN: OC7998.5C - EN 10204-3.1

09/09/19

Cert No: 1101809

Customer: EMCO
Customer Number: 32043
Customer PO: 2610191-00
Cameron SO: QRC SO# 1010576
Project Name:
Valve Serial No:
Description: 150# RF A352-LCC (TRIM 12) OS&Y BB GATE
NACE
Customer Tag No:

MLTS_6056-18971
Cert# 1101809

Pressure Test Result

Item	Test Pressure (Mpa)	(PSI)	Duration (sec)	Test Result
Shell	3.103	450	60	Passed
Backseat	2.241	325	60	Passed
Seat Hydro	-	-	-	Passed
Seat Air	0.552	80	60	Passed

Standard: API 598 / ASME B16.34

Inspection

Dimension: Passed
Visual: Passed
Valve Materials meet the requirements for NACE MR0103 and NACE MR0175

Part: Body Type 3.1

Heat Treatment: QUENCHING+TEMPERING

Material Code: A352 LCC

Notes:

Spec:	C	Cr	Cu	Mn	Mo	Ni	P	S	Si	V
Chem Comp (%)	0.00	0.00	0.00	0.00	0.00	0.00	0.00	0.00	0.00	0.00
Min:	0.25	0.50	0.30	1.20	0.20	0.50	0.040	0.05	0.60	0.03
Max:	0.180	0.063	0.018	1.070	0.007	0.016	0.027	0.008	0.440	0.004
Val:	0.180	0.063	0.018	1.070	0.007	0.016	0.027	0.008	0.440	0.004

Part: Bonnet/Cap Type 3.1

Heat Treatment: QUENCHING+TEMPERING

Material Code: A352 LCC

Notes:

Spec:	C	Cr	Cu	Mn	Mo	Ni	P	S	Si	V
Chem Comp (%)	0.00	0.00	0.00	0.00	0.00	0.00	0.00	0.00	0.00	0.00
Min:	0.25	0.50	0.30	1.20	0.20	0.50	0.040	0.05	0.60	0.03
Max:	0.180	0.063	0.018	1.070	0.007	0.016	0.027	0.008	0.440	0.004
Val:	0.180	0.063	0.018	1.070	0.007	0.016	0.027	0.008	0.440	0.004

Heat No: N86718

Physical Props	Tensile KSI	Yield KSI	Elong %	Reduct %	Hard (HB)	Impact Tests @-58 deg F	lb/ft
	70.0	39.9	22.0	35.0	100.0		# 1: 45
	95.0	999.9	100.0	100.0	225.0		# 2: 58
	80.5	53.7	30.0	65.0	174.0		# 3: 33
							AVG: 45

Heat No: N86718

Physical Props	Tensile KSI	Yield KSI	Elong %	Reduct %	Hard (HB)	Impact Tests @-58 deg F	lb/ft
	70.0	39.9	22.0	35.0	100.0		# 1: 45
	95.0	999.9	100.0	100.0	225.0		# 2: 58
	80.5	53.7	30.0	65.0	174.0		# 3: 33
							AVG: 45

Comments: Cameron declares that the parts above are in accordance with applicable material specification and purchase order requirements. No Asbestos is contained in this product. Packing: Flexible Graphite | Gasket: Corrugated (316) W/ Graftol Valves covered in this certificate are in full compliance with purchase order requirements and specifications.

MTR created by: DR

Signature

09/09/19



NEWCO® | OIC® | DOUGLAS CHERO™

13127 Trinity Dr., Stafford, TX 77477
Tel: 281-302-4900 Fax: 281-302-4801

Item No: B1060015FHLCCW27RF**GZA
Size/Type: 6" / Gate
Quantity: 1
Country of Origin: China
FigNo: 11F-LCC4/2-NC

Material Test Report

Cameron Newco is a 9001 certified registered company
CRN: OC7998.5C - EN 10204-3.1

09/09/19

Cert No: 1101813

Customer: EMCO
Customer Number: 32043
Customer PO: 2610191-00
Cameron SO: QRC SO# 1010576
Project Name:
Valve Serial No:
Description: 150# RF A352-LCC (TRIM 12) OS&Y BB GATE
NACE
Customer Tag No:

MLTS_6056-18971
Cert# 1101813

Pressure Test Result

Item	Test Pressure (Psi)	Duration (sec)	Test Result
Shell	3,103	450	Passed
Backseat	2,241	325	Passed
Seat Hydro	-	-	Passed
Seat Air	0.552	80	Passed

Inspection
Dimension: Passed
Visual: Passed
Valve Materials meet the requirements for NACE MR0103 and NACE MR0175

Standard: API 598 / ASME B16.34

Part: Body Type 3.1

Heat Treatment: QUENCHING+TEMPERING

Material Code: A352 LCC

Notes:

Spec:	C	Cr	Cu	Mn	Mo	Ni	P	S	Si	V
Chem Comp (%)	0.00	0.00	0.00	0.00	0.00	0.00	0.00	0.00	0.00	0.00
Min:	0.25	0.50	0.30	1.20	0.20	0.50	0.040	0.05	0.60	0.03
Max:	0.190	0.034	0.017	1.030	0.002	0.017	0.033	0.012	0.520	0.004

Part: Bonnet/Cap Type 3.1

Heat Treatment: QUENCHING+TEMPERING

Material Code: A352 LCC

Notes:

Spec:	C	Cr	Cu	Mn	Mo	Ni	P	S	Si	V
Chem Comp (%)	0.00	0.00	0.00	0.00	0.00	0.00	0.00	0.00	0.00	0.00
Min:	0.25	0.50	0.30	1.20	0.20	0.50	0.040	0.05	0.60	0.03
Max:	0.190	0.052	0.018	1.120	0.006	0.016	0.029	0.007	0.490	0.004

Heat No: N86708

Physical Props	Tensile KSI	Yield KSI	Elong %	Reduct %	Hard (HB)	Impact Tests @-58 deg F	lb/ft
	70.0	39.9	22.0	35.0	100.0		# 1: 22
	95.0	999.9	100.0	100.0	225.0		# 2: 30
	80.5	52.9	28.0	55.0	181.0		# 3: 19
							Avg: 24

Heat No: N86707

Physical Props	Tensile KSI	Yield KSI	Elong %	Reduct %	Hard (HB)	Impact Tests @-58 deg F	lb/ft
	70.0	39.9	22.0	35.0	100.0		# 1: 31
	95.0	999.9	100.0	100.0	225.0		# 2: 46
	80.5	56.6	29.0	60.0	172.0		# 3: 31
							Avg: 36

Comments: Cameron declares that the parts above are in accordance with applicable material specification and purchase order requirements.
No Asbestos is contained in this product. Packing: Flexible Graphite | Gasket: Corrugated (316) W/ Grafol
Valves covered in this certificate are in full compliance with purchase order requirements and specifications.

MTR created by: DR

Signature

09/09/19

Appendix A6

Construction Summary Report: Baker Lake Fuel Storage Tank 8 (2021)

Construction Summary Report

Baker Lake Fuel Storage Tank #8


Agnico Eagle Mines Ltd



Engineering, Design and Project Management

07 | 12 | 2021

report
Internal ref. 681783-0000-40ER-0001_R0

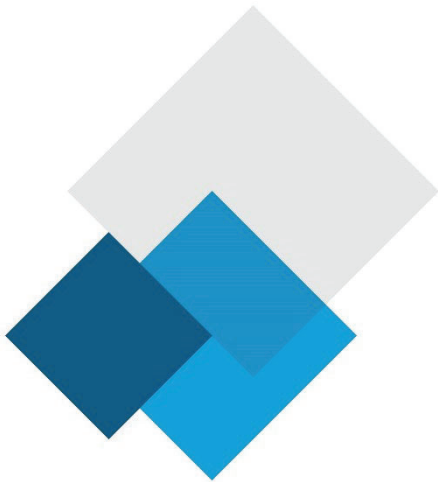

CONSTRUCTION SUMMARY REPORT Baker Lake Fuel Storage Tank #8


Agnico Eagle Mines Ltd

Report

6129-740-132-REP-001

December 7, 2021

Authorized Signatory:

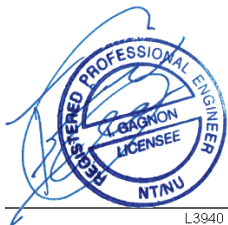

2021-12-07
Israël Gagnon, P.Eng., MBA
Mechanical engineer

EXECUTIVE SUMMARY

SNC Lavalin Inc. was retained by Agnico Eagle Mines Limited to prepare a construction summary (as built) report for the fuel storage tank #8 facilities of the Meadowbank Gold Project, Nunavut. SNC Lavalin Inc. previously prepared the construction drawings and specifications for the fuel storage tank facilities.

SNC Lavalin Inc. wasn't involved in the construction of the fuel storage tank, the information presented in this report was provided in part by Agnico Eagle.

The construction of the fuel storage tank facilities was completed in October 2021. The construction monitoring and quality assurance was managed by Agnico Eagle.

This report summarizes the construction as-built information for the fuel storage tank #8 facilities.

Table of content

1. Introduction	4
2. Construction Summary	4
2.1 Site location plan.....	4
2.2 Fuel tank size.....	5
2.3 Tank Foundations Design	5
2.4 Berms Design	5
2.5 Secondary Containment Capacity	6
2.6 Drawings and photographs.....	6
2.7 Timeline	6
3. Field decisions	7
3.1 Equipment and controls.....	7
3.2 Piping	7
4. Mitigation measure	7
5. Construction monitoring and inspection test plan	7
5.1 Tank weld	7

Figure

Figure 1 – Baker Lake Fuel Farm Site Overview (tank #7 and #8)	4
--	---

Tables

Table 1 – Description of the fuel farm.....	5
Table 2 – Design parameters for the tank foundations	5
Table 3 – Fuel farm containment capacity.....	6

Appendices

Appendix A	Final Construction drawings
Appendix B	As built drawings
Appendix C	Photographs
Appendix D	Fuel tank handover package

1. Introduction

This document presents the fuel storage tank 8 facilities construction summary report required by the Water Licence 2AM-MEA1530 Part D Item 14 and Part G Item 4. As required by Water Licence Schedule D, this report contains the final design and construction drawings, a summary of construction activities including pictures recorded before, during and after construction. The as-built drawings, detailed explanation of field decision to reflect any deviations from the original construction drawings/plans and how such deviations may affect performance of engineered structures, a discussion of the mitigation measures implemented during construction and its effectiveness are also presented.

2. Construction Summary

2.1 Site location plan

Agnico Eagle is developing the Whale Tail Project in the Kivalliq Region of Nunavut (65°24'25" N, 96°41'50" W). The 99,878-hectare Amaruq property is located on Inuit-owned and federal crown land, approximately 55 km north of the Meadowbank mine. The Meadowbank mine is accessible from Baker Lake, located 70 kilometers to the south. The Baker Lake Bulk Fuel Storage Tank Facility is located east of the hamlet of Baker Lake, on the north shore of Baker Lake.



Figure 1 – Baker Lake Fuel Farm Site Overview (tank #7 and #8)

2.2 Fuel tank size

Baker Lake fuel farm now includes eight (8) 10M liter fuel storage tank. This report is based on tank #8 construction, built in summer/fall 2021.

The Table 1 below presents the tank main dimensions.

Table 1 – Description of the fuel farm

Fuel farm Description	Baker Lake fuel tank 8
Product	Diesel
Volume (liter)	10 M
Diameter (m)	33.5
Height (m)	12.2

The detailed design drawings of the tank 8 are presented in Appendix A.

2.3 Tank Foundations Design

The tank foundation pad is built 2 meters lower than the surrounding ground with a minimum total thickness of 800 mm of compacted material which includes the liner system. A 3 m shoulder surround the tank with a slope of 1V:2H away from the tank. The embankments of the foundation pad are no steeper than 1V:2H.

The Table 2 below presents the design parameters for the tank foundations.

Table 2 – Design parameters for the tank foundations

Tank Foundation Pad	
Tank Diameter (m)	33.5
Tank foundation pad top (m)	2x 18.0 x 18.0
Tank foundation pad average thickness, above surrounding ground (m)	1.2
Slope on shoulder	1V:2H
Embankment slope	1V:2H

2.4 Berms Design

The storage tank is enclosed inside berms to contain accidental spillage of fuel product. The berms are made of granular material and are made impervious with a geomembrane. For more detail regarding containment, consult document 653281-0004-40ER-0005_0 Baker Lake Fuel Storage Tank #7 and Containment Facilities construction summary report.

2.5 Secondary Containment Capacity

The required capacity of the fuel farms section was calculated based on the following codes and regulations:

- › National Fire Code of Canada (NFCC);
- › National Fire Protection Association (NFPA); and
- › Design Rationale for Fuel Storage and Distribution Facility (DRFS).

As per the latest edition of NFCC, art. 4.3.7.3, the required secondary containment capacity for a fuel farm must have a volumetric capacity of not less than the sum of:

- › A) The capacity of the largest storage tank located in the contained space, and;
- › B) 10% of the greater of:
 - i. The capacity specified in Clause (A), or;
 - ii. The aggregate capacity of all other storage Tanks located in the contained space.

The volume occupied by the Tank foundation is considered in the total secondary containment capacity. The height of the secondary containment capacity is 300 mm lower than the berms' maximum elevation. Based on the above-mentioned, the secondary containment capacity requirements and the available capacity for fuel farms are summarized in the Table 3.

Table 3 – Fuel farm containment capacity

New section	
Volume (liter)	20 M (2X 10M)
Required Containment Capacity (liter)	12 M
Available Containment Capacity (liter)	20M

2.6 Drawings and photographs

Fuel farm tank final design and construction drawings are available in the Appendix A, construction pictures are available in Appendix C.

2.7 Timeline

The baker lake fuel storage tank # 8 was built in 2021. Earth work started on July 2021, followed by tank and piping fabrication in August and September 2021. Tank #8 construction ended September 8th, 2021, Piping installation work were finalised on October 12th, 2021.

3. Field decisions

3.1 Equipment and controls

Fuel tank #8 was built as in Document 6120-C-260-001-REP-001 Fuel Tank Storage and Containment Facilities Design Report and Drawings. This document presents the rational and decisions that led to its construction. No modifications were performed, and the Fuel storage tank is operational as it was designed.

3.2 Piping

Piping between filling line and the fuel tank respect the point-to-point design. The piping can be seen on photos in Appendix C and respect the P&ID. Red mark drawings can be consulted in Appendix B. Modifications made to the piping won't affect the construction performance in any ways.

4. Mitigation measure

No Quarrying activities where required to build tank #8. No blast were done on the construction site. During the fuel storage tank construction, no sediments were released in water from construction areas and no water was used to manage dust emissions from construction activity.

5. Construction monitoring and inspection test plan



5.1 Tank weld

During the tank construction, a testing protocol was followed by the construction team. To meet API Standard 650, companies building tank are required to monitor their work trough an inspection program. In this program, the contractor registers welder's qualifications, confirm construction material quality and outlines its testing protocol. The results from weld tests are also registered there. All that information is required by API 650 standard. Testing on welds took place during the whole construction process. To attest welds quality, inspector relied on visual inspection, magnetic particulate tests and high penetration oil tests. To review those tests results, the materials quality and weld inspection results can be consulted in Appendix D.

Appendix A

Final construction drawing



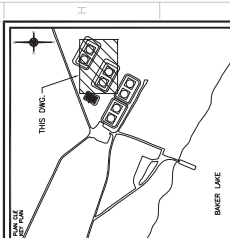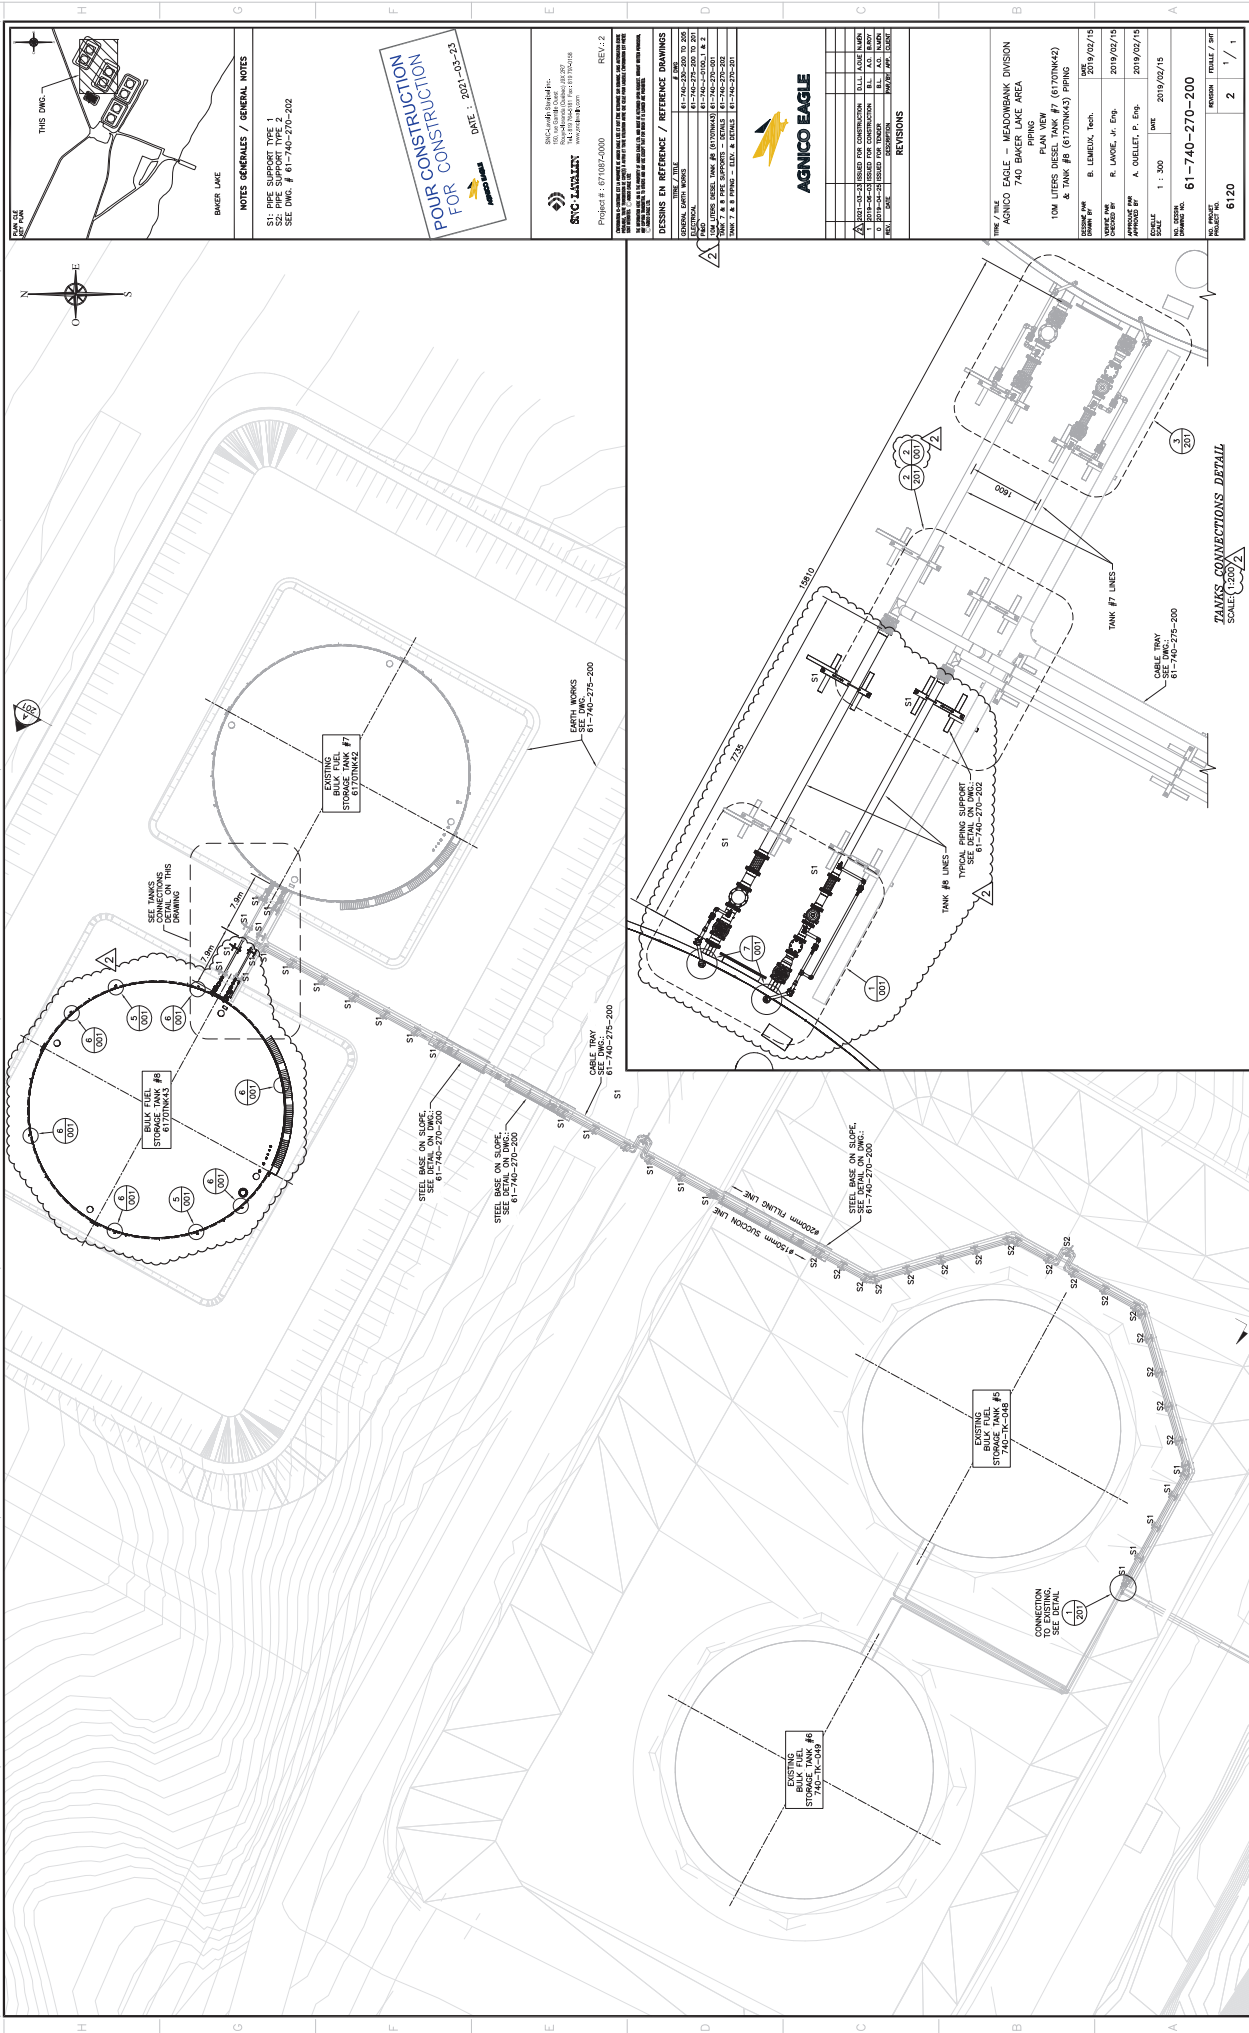

NOTES GENERALES / GENERAL NOTES

S1: PIPE SUPPORT TYPE 1
SEE DWG. # 61-740-270-202

DATE: 2021-03-23

POUR CONSTRUCTION
FOR CONSTRUCTION

SYN-LANALTY

Project # : 61-740-2000

REV: 1-2

EXPANSION	DATE	BY	REVISION
EXPANSION	2021-03-23	SYN-LANALTY	1-2



REVISIONS
1-2

AGNICO EAGLE - MEADOWBANK DIVISION

740 BAKER LAKE AREA

PLAN VIEW

10M LITERS DIESEL TANK #7 (61707N42)

& TANK #8 (61707N43) PIPING


DATE	BY	REVISION
2019/02/15	B. LEMULAY, Tech.	1-1
2019/02/15	R. LANGE, Jr. Eng.	1-2
2019/02/15	A. GUILLET, P. Eng.	1-3

SCALE: 1:300

DATE: 2019/02/15

PROJECT: 61-740-270-200

REVISION	DATE	BY	REVISION
1	2021-03-23	SYN-LANALTY	1-1

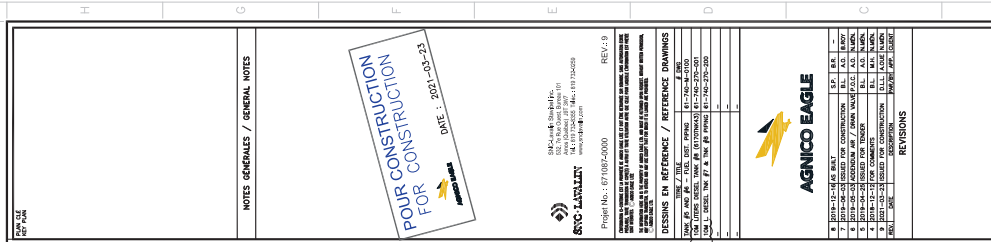

Appendix B

As built drawing



Panel Ident.: 6174-DP-06

Power source:	120/208 Volts
Feeder :	6174-TX-04
Mount:	Surface
Localisation:	BAKER LAKE SEA CAN
Type:	Schneider QO Series
Encl. Type :	NEMA 1
Main breaker:	N/A
Nb. of circuit:	42
Bars (Amps):	225A
Cap. rupt. (kA):	10

Local and description	TYPE	DISJ.	C	T	#	CT	DISJ.	TYPE	WATTS	DISJ.	TYPE	WATTS	TYPE	Local and description
6174-PLC-02 Power	D	15	1	A	2	15								Sea Can Lighting
6174-XV-01 - Elect. Actuator valve	M	15	3	B	4	15								Sea Can Receptacle
6174-XV-02 - Elect. actuator valve	M	15	5	C	6	15								Spare breaker
6174-XV-03 - Elect. actuator valve	M	15	7	A	8	15								Spare breaker
6174-XV-04 - Elect. actuator valve	M	15	9	B	10	15								Spare breaker
6174-XV-05 - Elect. actuator valve	M	15	11	C	12	15								Spare breaker
6174-XV-06 - Elect. actuator valve	M	15	13	A	14	15								Spare breaker
6174-IOP-003 power	D	15	15	B	16	15								Spare breaker
Spare breaker		15	17	C	18	30								Spare breaker
6174-XV-07	M	15	19	A	20									6174-HEA-07
Res. #7 Valve Actuator	M	15	21	B	22	15	GF							Res. #7 Valve Heating
6174-XV-08	M	15	23	C	24									6174-HEA-08
Res. #8 Valve Actuator	M	15	25	A	26	15	GF							Res. #8 Valve Heating
Space		27	B	28										Space
Space		29	C	30										Space
Space		31	A	32										Space
Space		33	B	34										Space
Space		35	C	36										Space
Space		37	A	38										Space
Space		39	B	40										Space
Space		41	C	42										Space


TYPE (REF)	(W) total	Qty	TYPE (REF)	Qty (ref)	Watts	Amp
(E) Lighting	0	0	(L) Spare	0	0	0,00
(P) Parking plug	0	0	(S) Spare	0	0	0,00
(C) Heating	0	0			0	0,00
(M) Motor	0	0			0	0,00
(W) Water heater	0	0			0	0,00
(D) Other	0	0			0	0,00


POUR CONSTRUCTION
FOR CONSTRUCTION
AGNICO EAGLE
DATE : 2021-03-10


PERMIT TO PRACTICE
SNC - LAVALIN STAVEL INC.
Signature: [Signature]
Date: 2021-03-17
PERMIT NUMBER: P 718
NTNU Association of Professional Engineers and Geoscientists





TIME / TITLE		DATE		DATE		DATE	
AGNICO EAGLE - MEADOWBANK DIVISION		MAY/16		JUNE/16		JUNE/16	
BAKER LAKE AREA 740		ST		ST		ST	
285 - SERVICE ELECTRICAL - LIGHT AND DISTRIBUTION		JUNE/16		JUNE/16		JUNE/16	
6174-DP-06 - PANEL SCHEDULE		6120		6120		6120	
BAKER LAKE SEA CAN - DISTRIBUTION PANEL 120/208VAC		DATE		DATE		DATE	
PROJECT FILE: 61-740-285-200_R4.dwg		PROJECT NO.		PROJECT NO.		PROJECT NO.	
61-740-285-200		4		4		4	
REVISION		REVISION		REVISION		REVISION	
1 / 1		1 / 1		1 / 1		1 / 1	

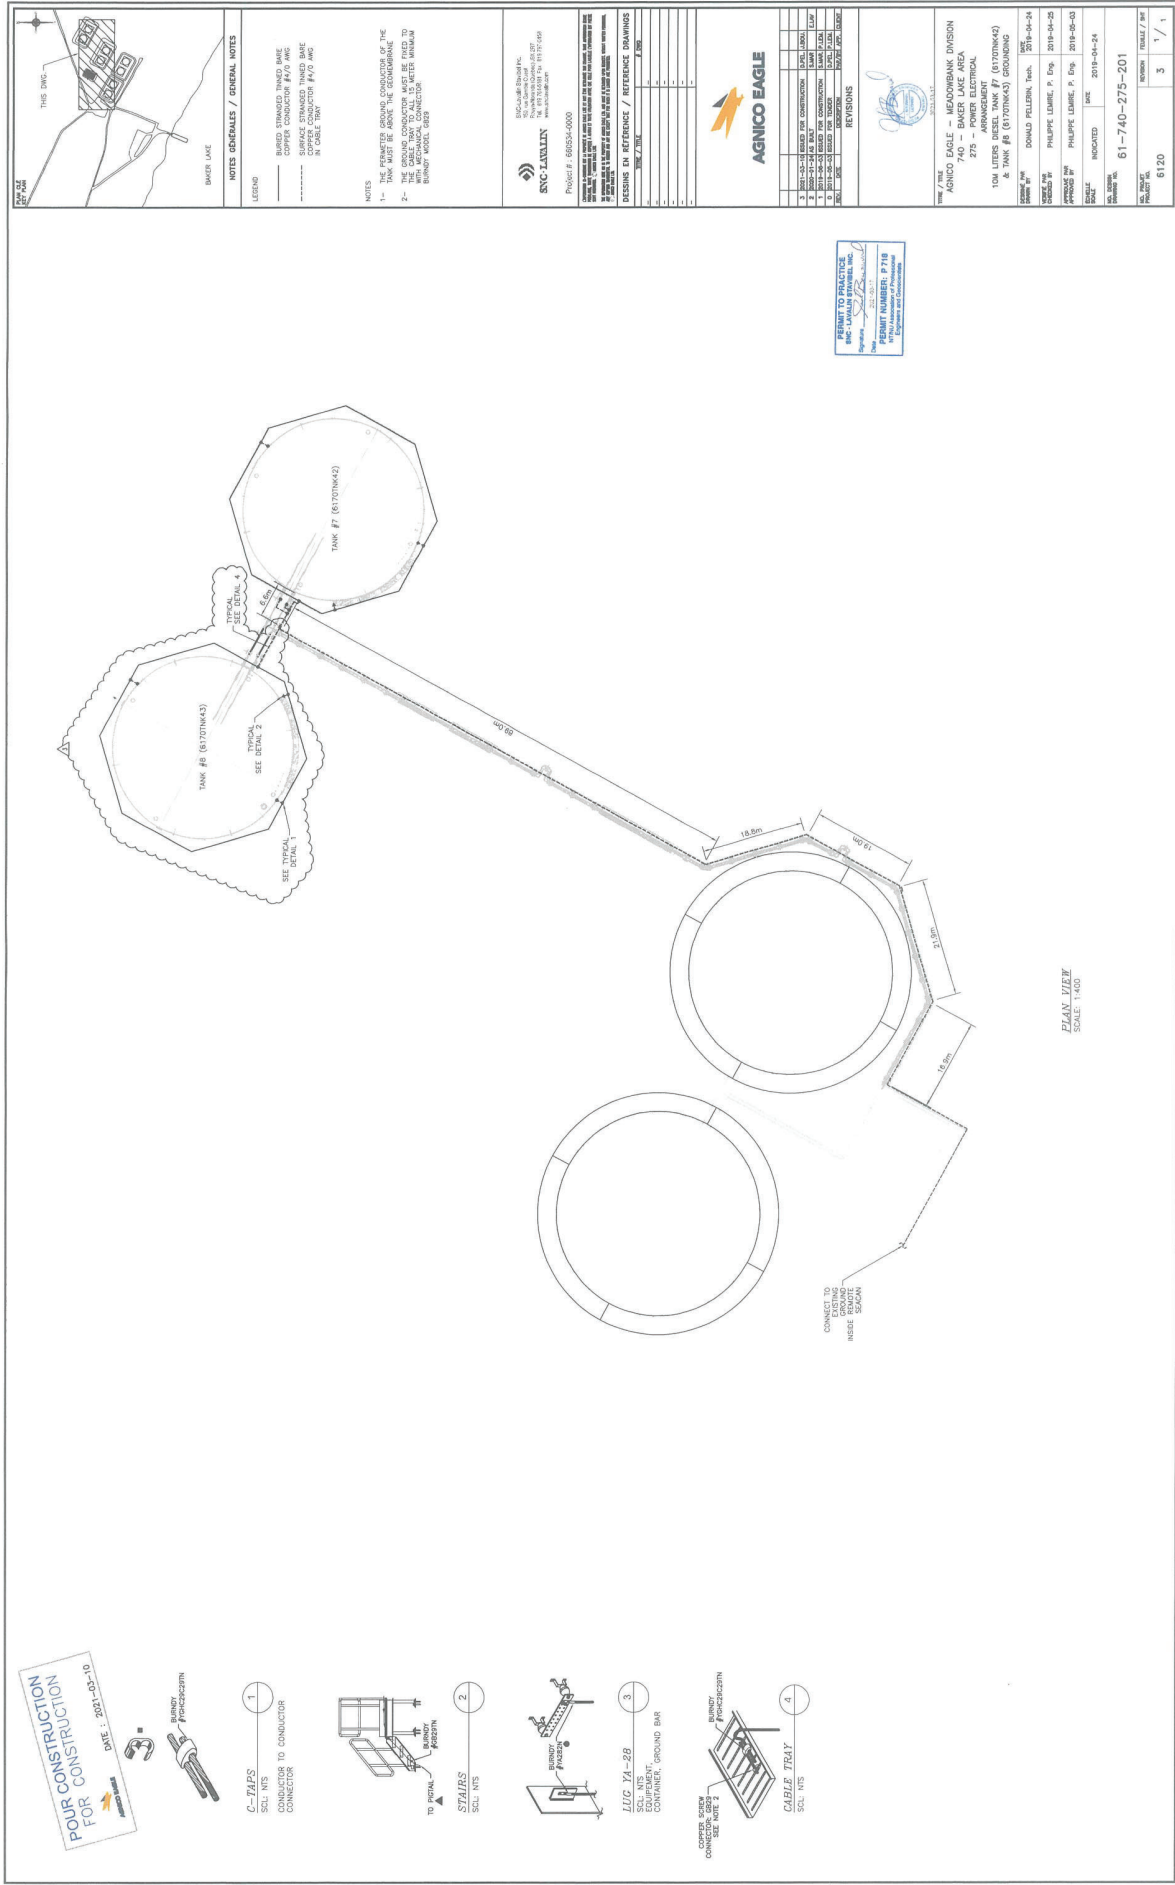

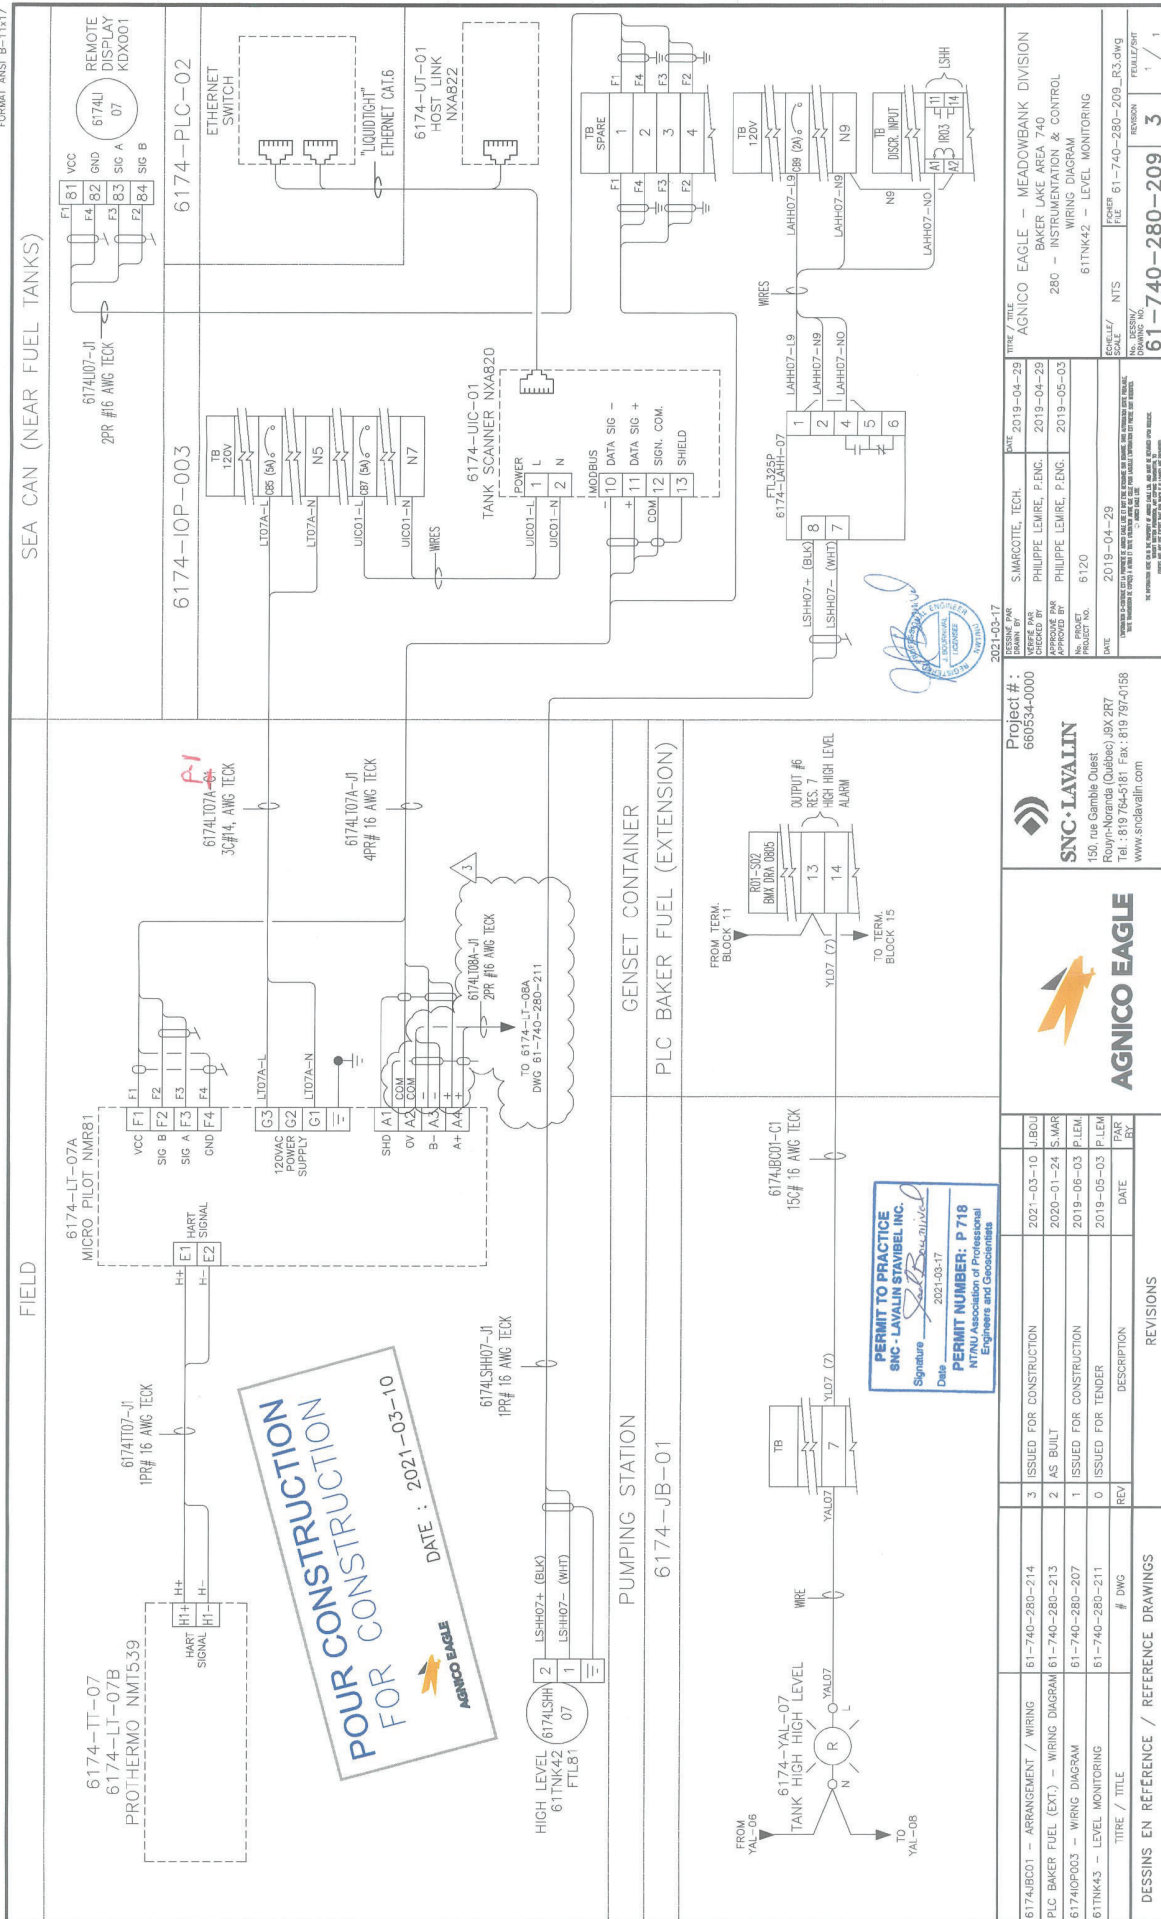

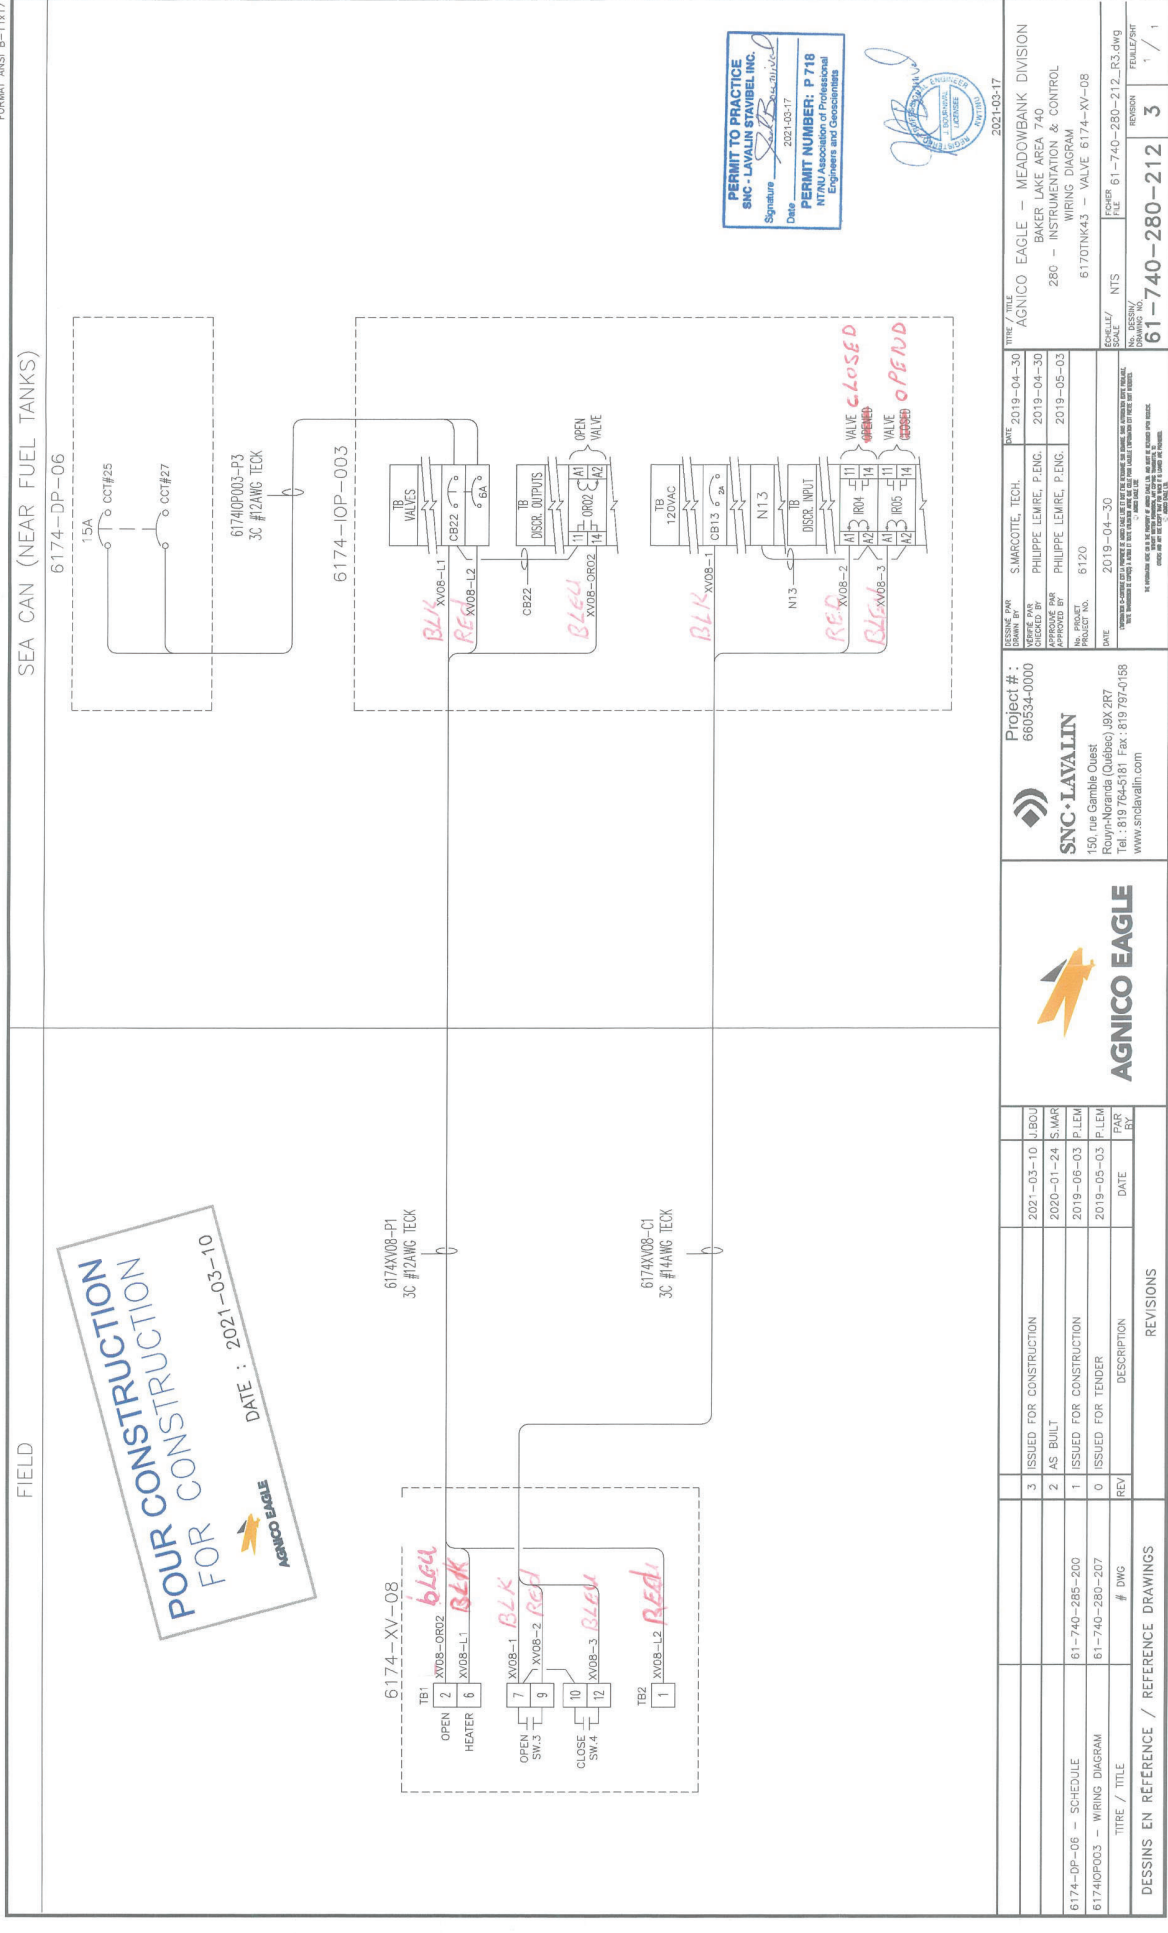

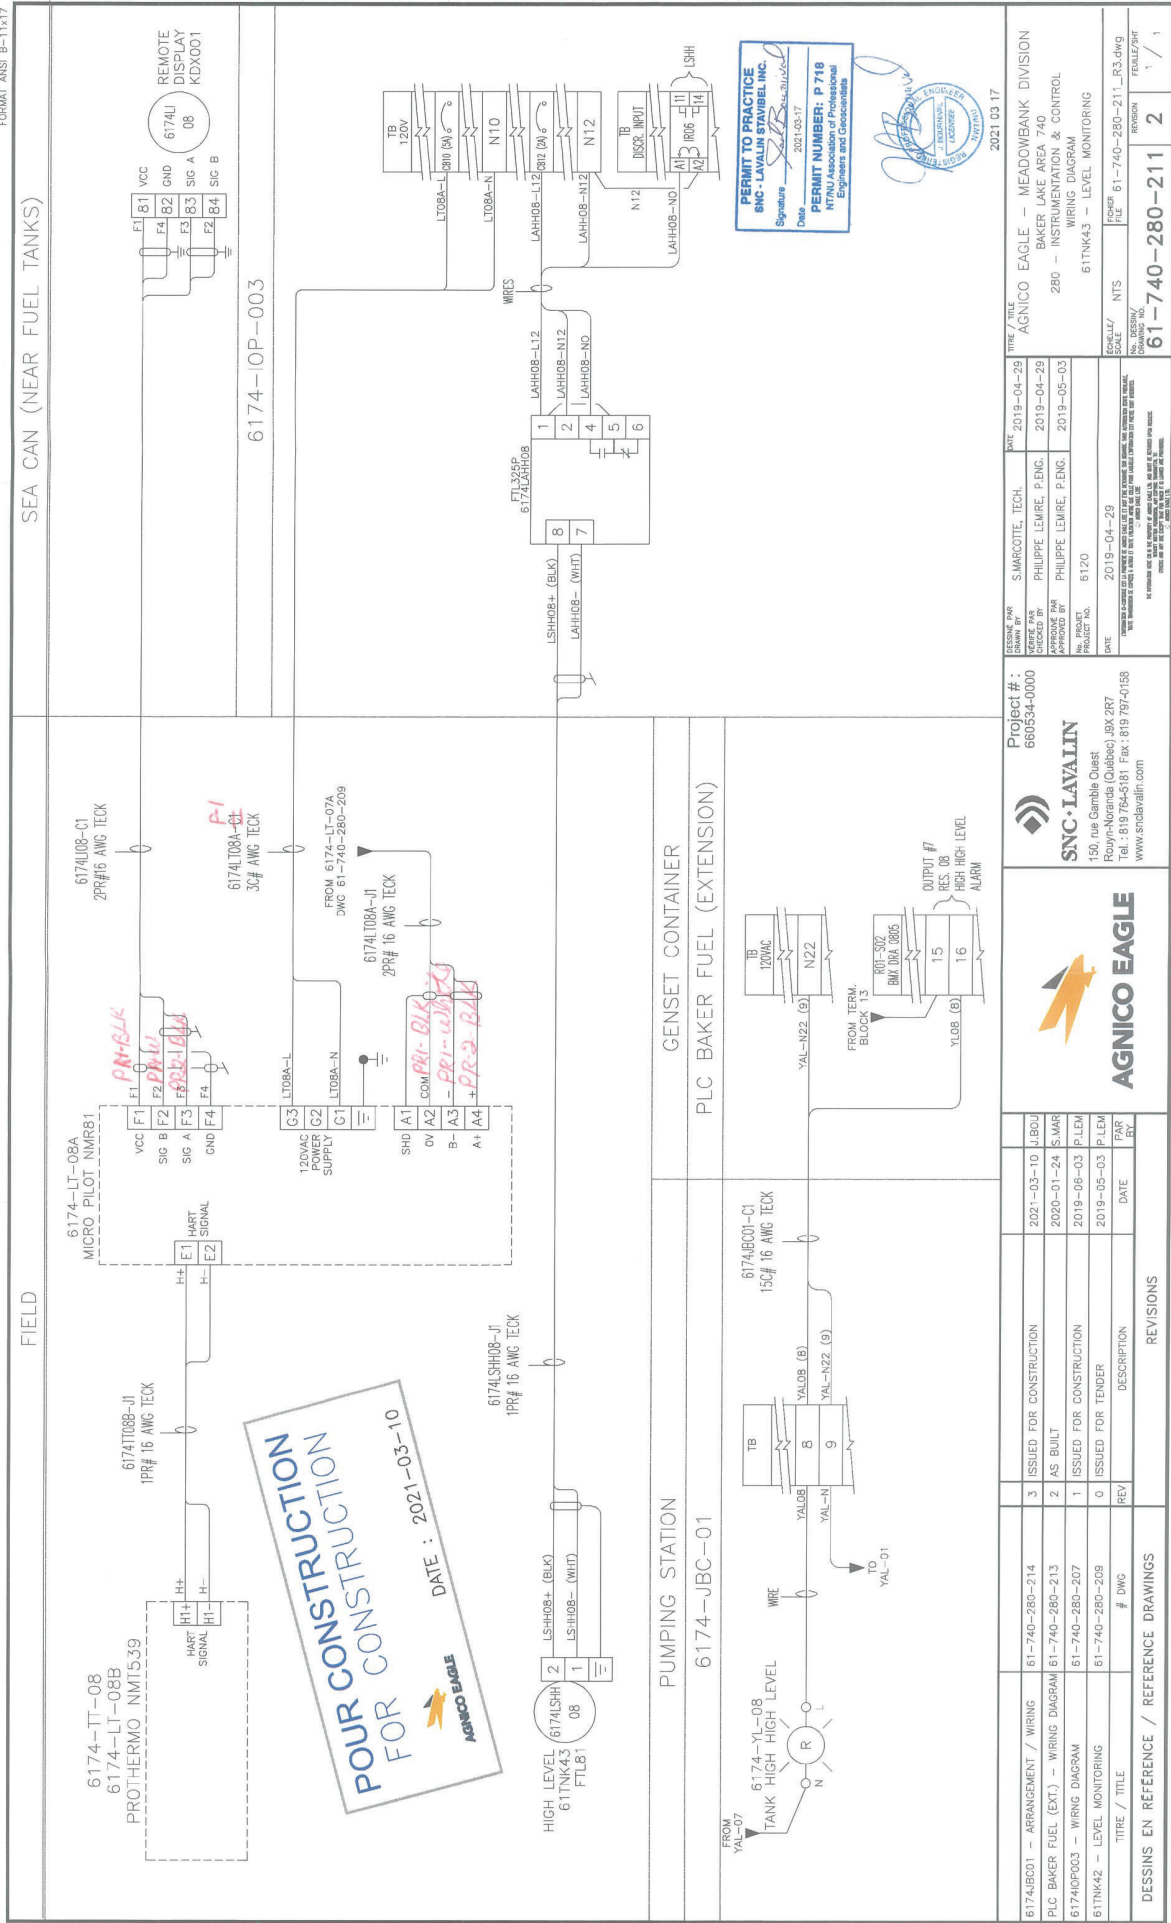

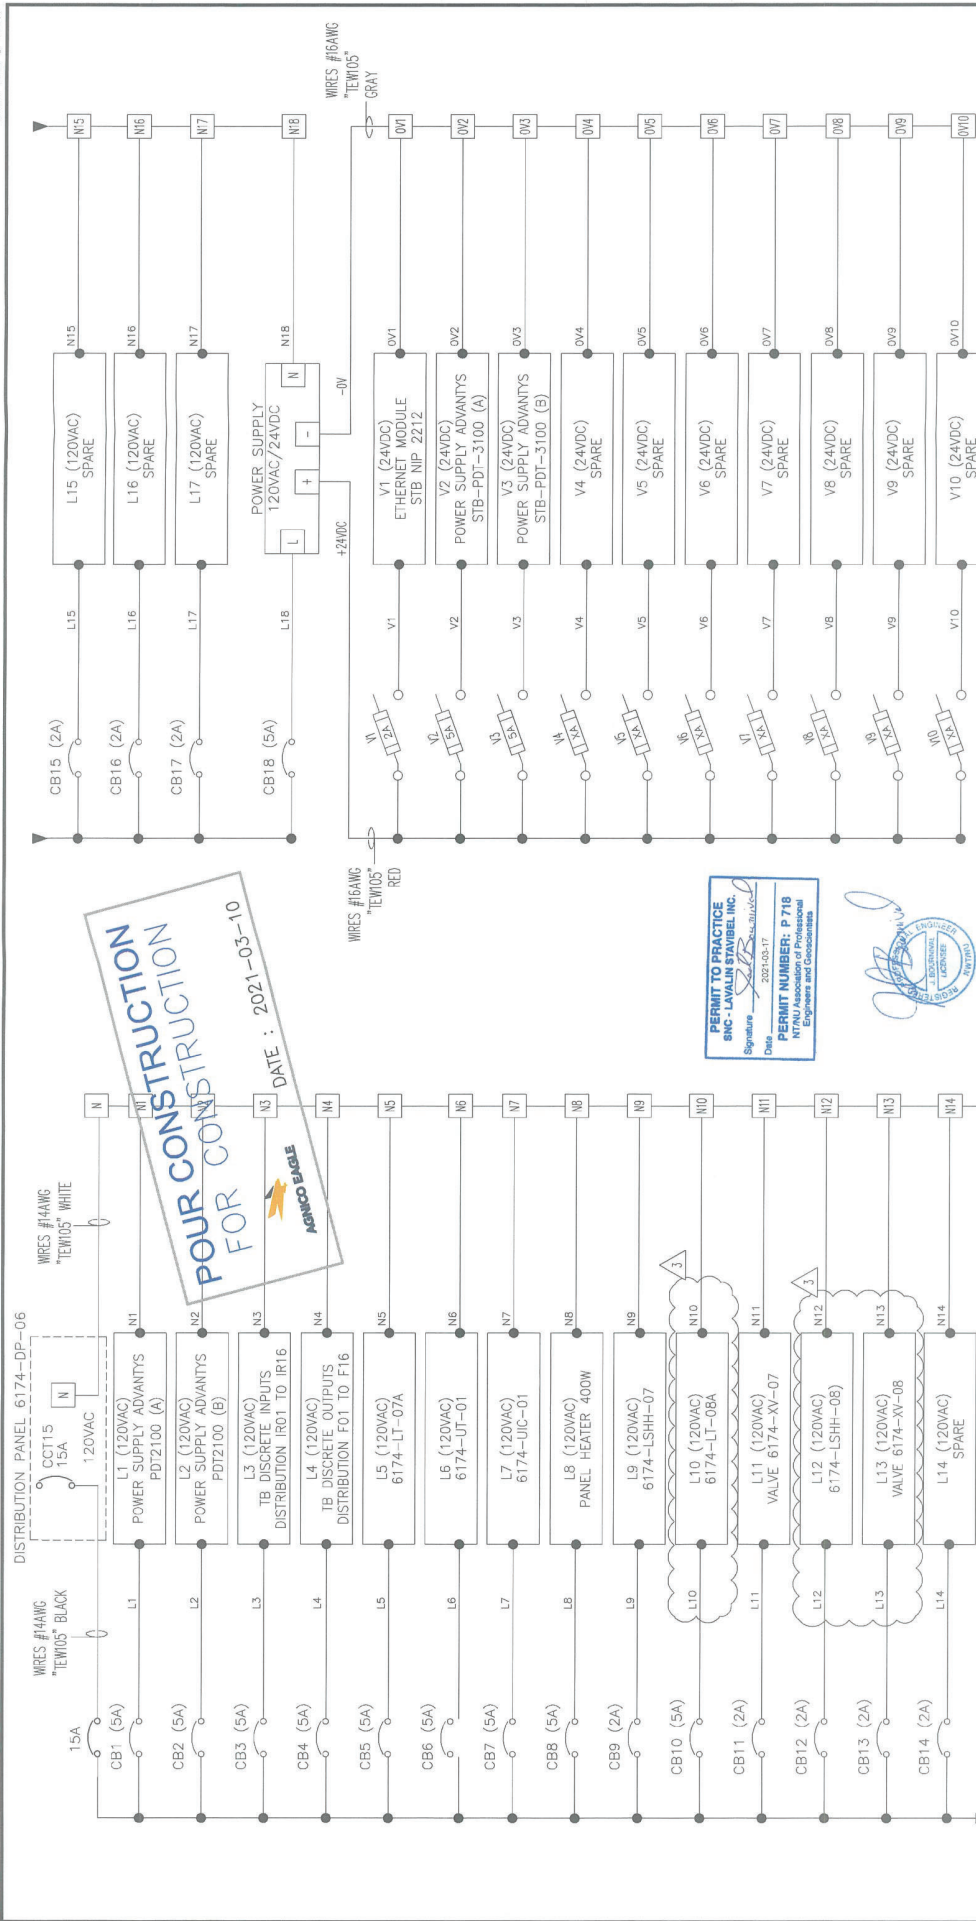


POUR CONSTRUCTION
FOR CONSTRUCTION

DATE : 2021-03-10

 **AGRICO EAGLE**

PERMIT TO PRACTICE
SNC - LAYALIN STAVIBEL INC.
Signature *L. Stavibel* 2021-03-17
Date

PERMIT NUMBER: P 718
NTNU Association of Professional
Engineers and Geoscientists

A circular blue ink stamp. The outer ring contains the text "PROFESSIONAL ENGINEER" at the top and "REGISTERED" at the bottom. The inner circle contains the text "J. BOURNIVAL" and "LICENSEE". There are some handwritten scribbles over the stamp.[illegible]


SNC • LAVALIN	OWNER	Agnico Eagle Mines	BY:	Nathan Blaisson	MATERIAL TAKE OFF Description	MANUFACTURER	MODEL	REMARKS				
	PROJECT NAME:	Baker Lake Fuel Farm	APPROVED:	Roxanne Lavoria, P. Eng. (OIQ) / (Gagnon P. Eng.								
	PROJECT NO:	6120-S-265-020	REV	0 - For Tender								
	DOC NO:	6120-S-265-020-MTO-002	REV DATE:	2021-06-30								
	MTO Piping - Baker Lake Fuel Farm Drawing number: 61-740-270-003											
Rev. Date	Qty ¹	Unit	Description	ND	STANDARD	SCH./PN	PACKAGE #	MTO #	MATERIAL			
PIPING AND FITTING TABLE												
2021-06-30	260	m	STEEL PIPING			ASTM A333 GR.6	SCH. STD			CARBON STEEL		SHOP PAINTED AS PER 60-000-245-GGD-001, YELLOW
2021-06-30	20	UNIT	WELDING NECK FLANGE			A350 GR. LF2	CL150			FORGED STEEL		SHOP PAINTED AS PER 60-000-245-GGD-001, YELLOW
2021-06-30	2	UNIT	BLIND FLANGE			ASTM A420 GR.WPL6	CL150			FORGED STEEL		SHOP PAINTED AS PER 60-000-245-GGD-001, YELLOW
2021-06-30	19	UNIT	45° ELBOW BUTT WELD			ASTM A420 GR.WPL6, BW	SCH. STD			FORGED STEEL		SHOP PAINTED AS PER 60-000-245-GGD-001, YELLOW
2021-06-30	4	UNIT	90° LONG RADIUS ELBOW BUTT WELD			ASTM A420 GR.WPL6, BW	SCH. STD			FORGED STEEL		SHOP PAINTED AS PER 60-000-245-GGD-001, YELLOW
2021-06-30	5	UNIT	STRAIGHT TEE BUTT WELD			ASTM A420 GR.WPL6, BW	SCH. STD			FORGED STEEL		SHOP PAINTED AS PER 60-000-245-GGD-001, YELLOW
2021-06-30	1	UNIT	WELDED 45° LATERAL BUTT WELD			ASTM A420 GR.WPL6, BW	SCH. STD			FORGED STEEL		SHOP PAINTED AS PER 60-000-245-GGD-001, YELLOW
2021-06-30	2	UNIT	FLEXIBLE HOSE, 350 mm I.d.			FLANGED	CL150			STAINLESS STEEL	SENIOR FLEXTRONICS	SA-88FS SERIES
2021-06-30	1	UNIT	FLEXIBLE HOSE, 450 mm I.d.			FLANGED	CL150			STAINLESS STEEL	SENIOR FLEXTRONICS	SA-88FS SERIES
2021-06-30	6	UNIT	ECCENTRIC REDUCER BUTT WELD			ASTM A420 GR.WPL6, BW	SCH. STD			CARBON STEEL		SHOP PAINTED AS PER 60-000-245-GGD-001, YELLOW
2021-06-30	6	UNIT	BLIND FLANGE			ASTM A420 GR.WPL6	CL150			FORGED STEEL		SHOP PAINTED AS PER 60-000-245-GGD-001, YELLOW
2021-06-30	10	UNIT	WELDING NECK FLANGE			A350 GR. LF2	CL150			FORGED STEEL		SHOP PAINTED AS PER 60-000-245-GGD-001, YELLOW
2021-06-30	3	UNIT	THREADEDLET FOR Ø150mm PIPE			ASTM A350 GR.LF2	CL3000			FORGED STEEL		SHOP PAINTED AS PER 60-000-245-GGD-001, YELLOW
2021-06-30	2	m	PIPING			ASTM A333 GR.6	SCH. 80			CARBON STEEL		SHOP PAINTED AS PER 60-000-245-GGD-001, YELLOW
2021-06-30	3	UNIT	SCREW CAP			FORGED STEEL	CL3000			FORGED STEEL		SHOP PAINTED AS PER 60-000-245-GGD-001, YELLOW
2021-06-30	22	UNIT	FLEXIBLE BRAID			-	-				INVENT	MBJ 3S-250-25
PIPING AND SUPPORT TABLE												
2021-06-30	12	UNIT	TYPE 1. PREFAB PIPING SUPPORT ON DRAWING 61-740-270-XXX			HSS G40 350 W OR ASTM A500	-			STRUCTURAL STEEL		SHOP PAINTED AS PER 60-000-245-GGD-001, GREY
2021-06-30	43	UNIT	TYPE 2 PREFAB PIPING SUPPORT ON DRAWING 61-740-270-XXX			HSS G40 350 W OR ASTM A500	-			STRUCTURAL STEEL		SHOP PAINTED AS PER 60-000-245-GGD-001, GREY
2021-06-30	4	UNIT	TYPE 3 PREFAB PIPING SUPPORT ON DRAWING 61-740-270-XXX			HSS G40 350 W OR ASTM A500	-			STRUCTURAL STEEL		SHOP PAINTED AS PER 60-000-245-GGD-001, GREY
2021-06-30	15	UNIT	EXTRA GREY PAINT GALLONS			-	-			-		FOR PAINT TOUCH-UP ON SITE
2021-06-30	10	UNIT	EXTRA YELLOW PAINT GALLON			-	-			-		FOR PAINT TOUCH-UP ON SITE
VALVE TABLE												
2021-06-30	7	UNIT	GATE VALVE			ASTM A-352, FLANGED	CL150			LCC	BERIC	API 600, LCC BODY
2021-06-30	3	UNIT	BALL VALVE API 607			SOCKET WELD	Ø25mm			LCC	APOLLO	8BL-240-24 SERIES

¹ No contingency was planned on material take off list and no material was planned for field adjustment.

Roxanne Lavore
 2021/06/30
 L33040


FILE NO. 61-740-275-200 P2.dwg



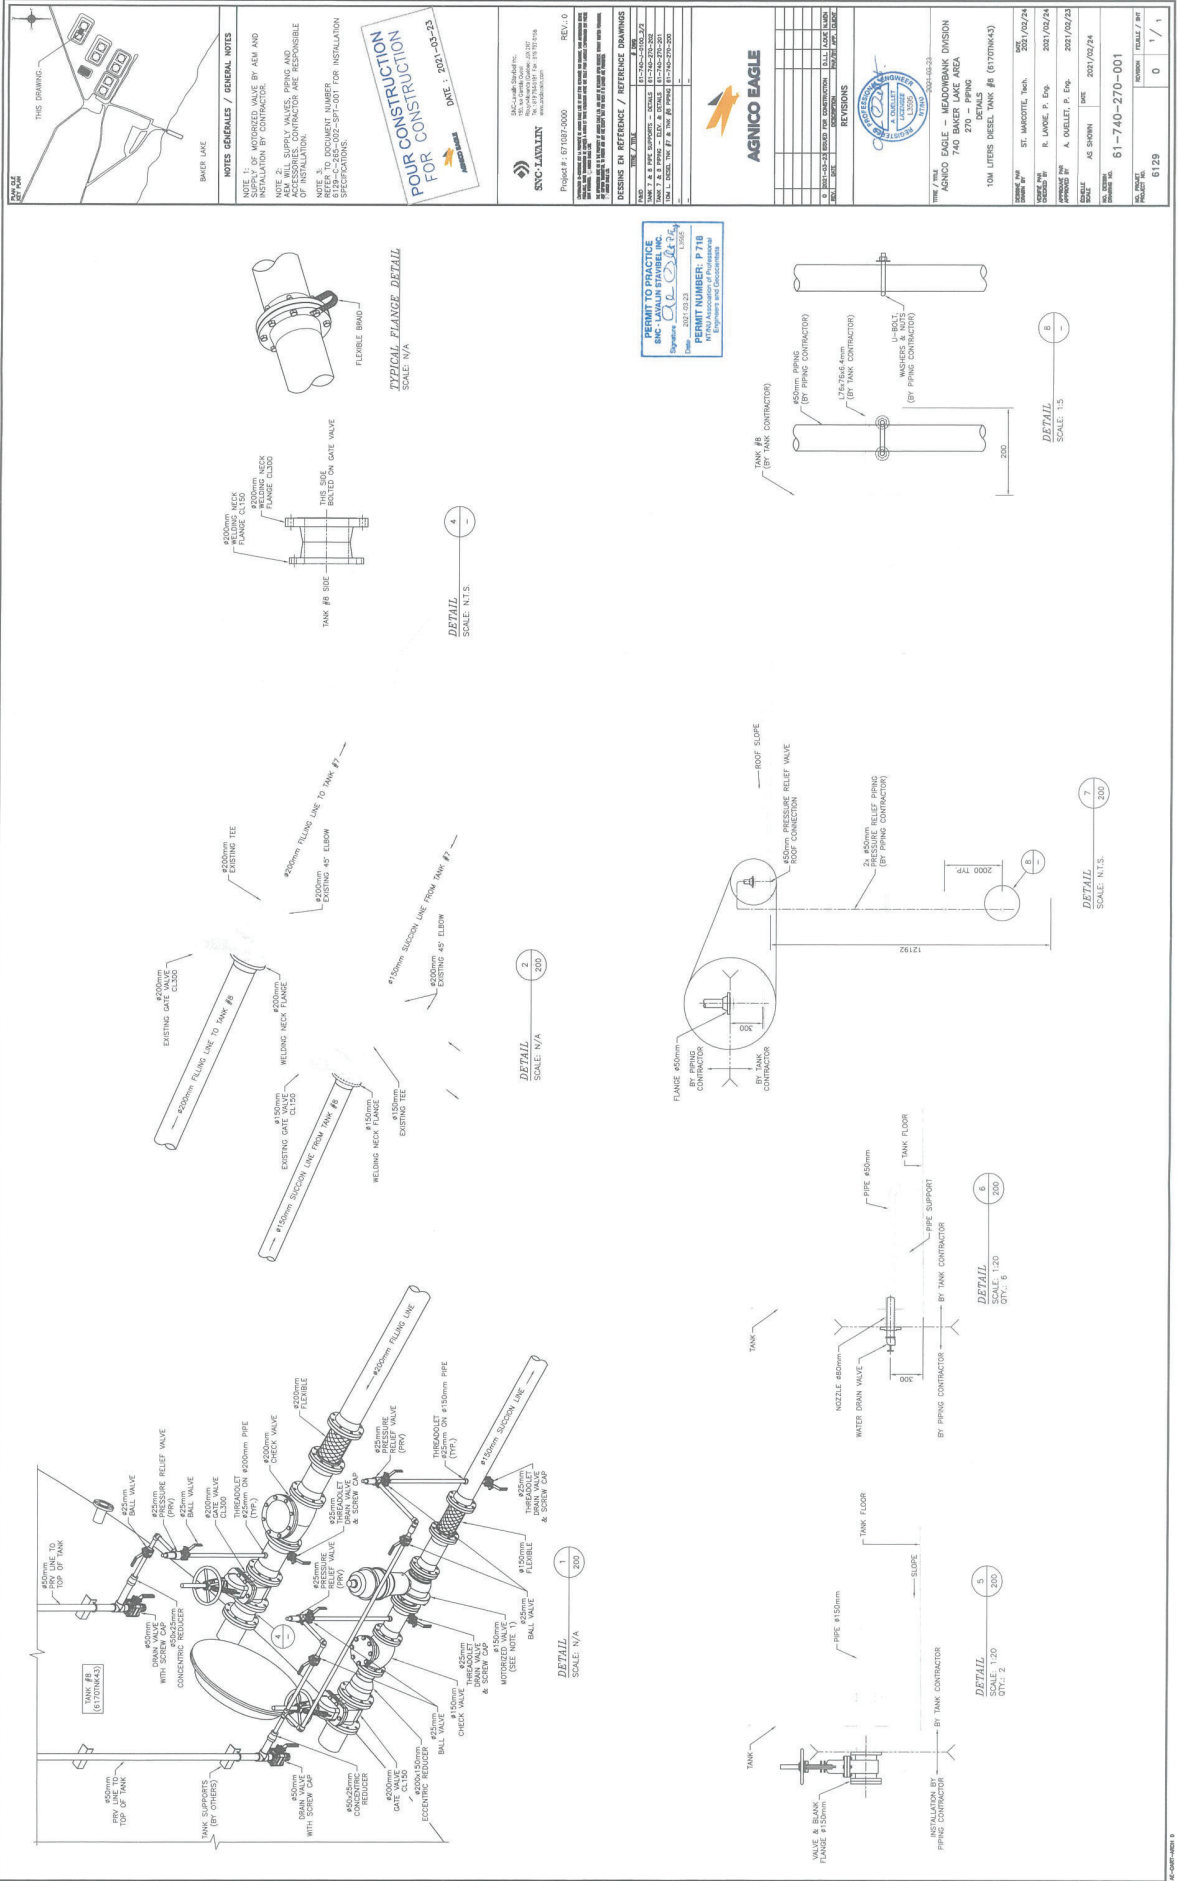

Appendix C

Photographs

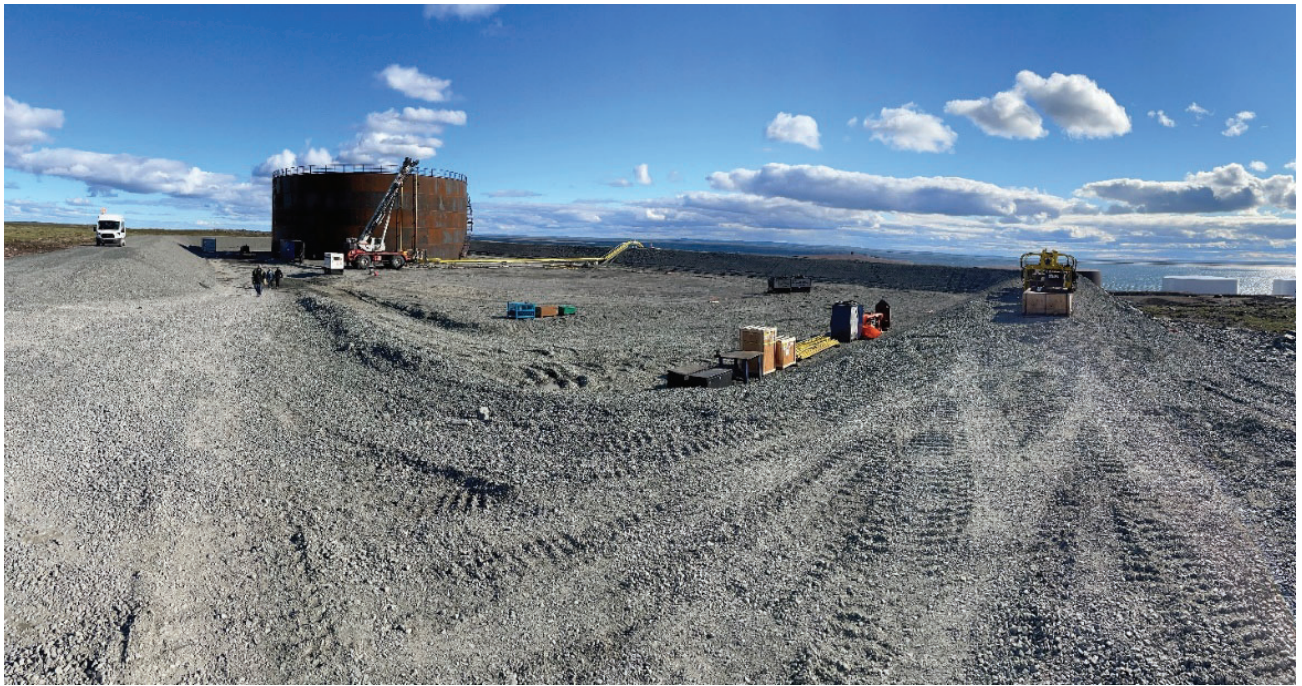

Tank #8 pad before construction



Tank floor construction



Weld testing with vacuum



Tank wall welding



Tank wall third ring installation



Tank general view



Tank roof structure




Tank roof plate welding



Control cable tray and over pressure valve piping



Tank #8 piping installation

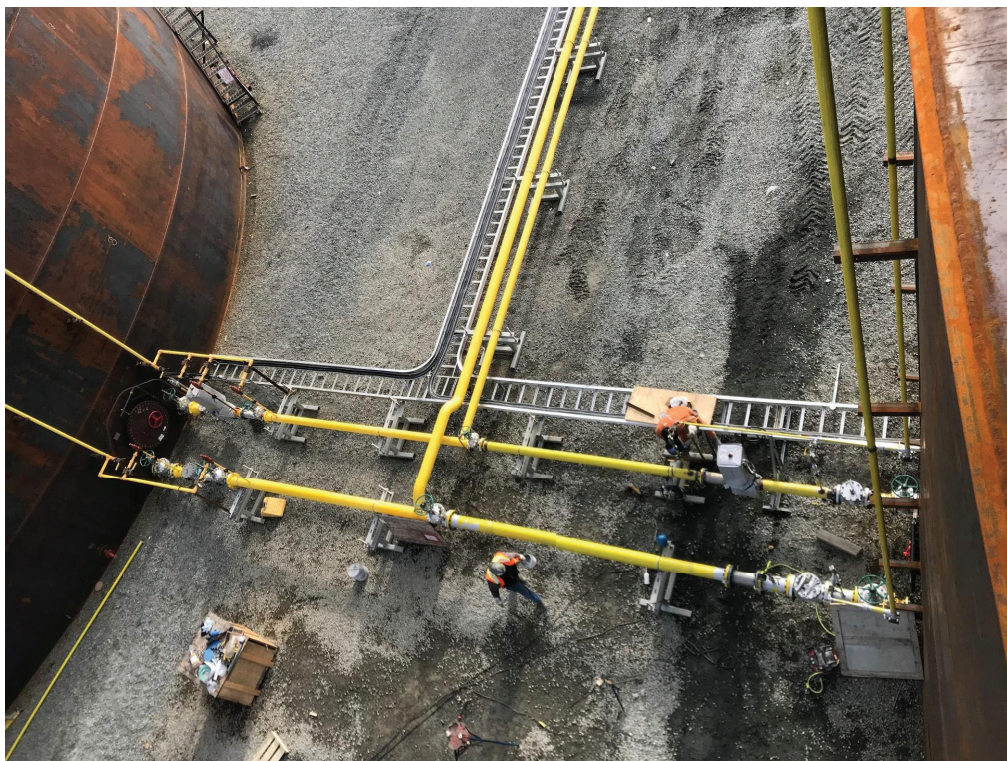

Tank #8 piping overview