

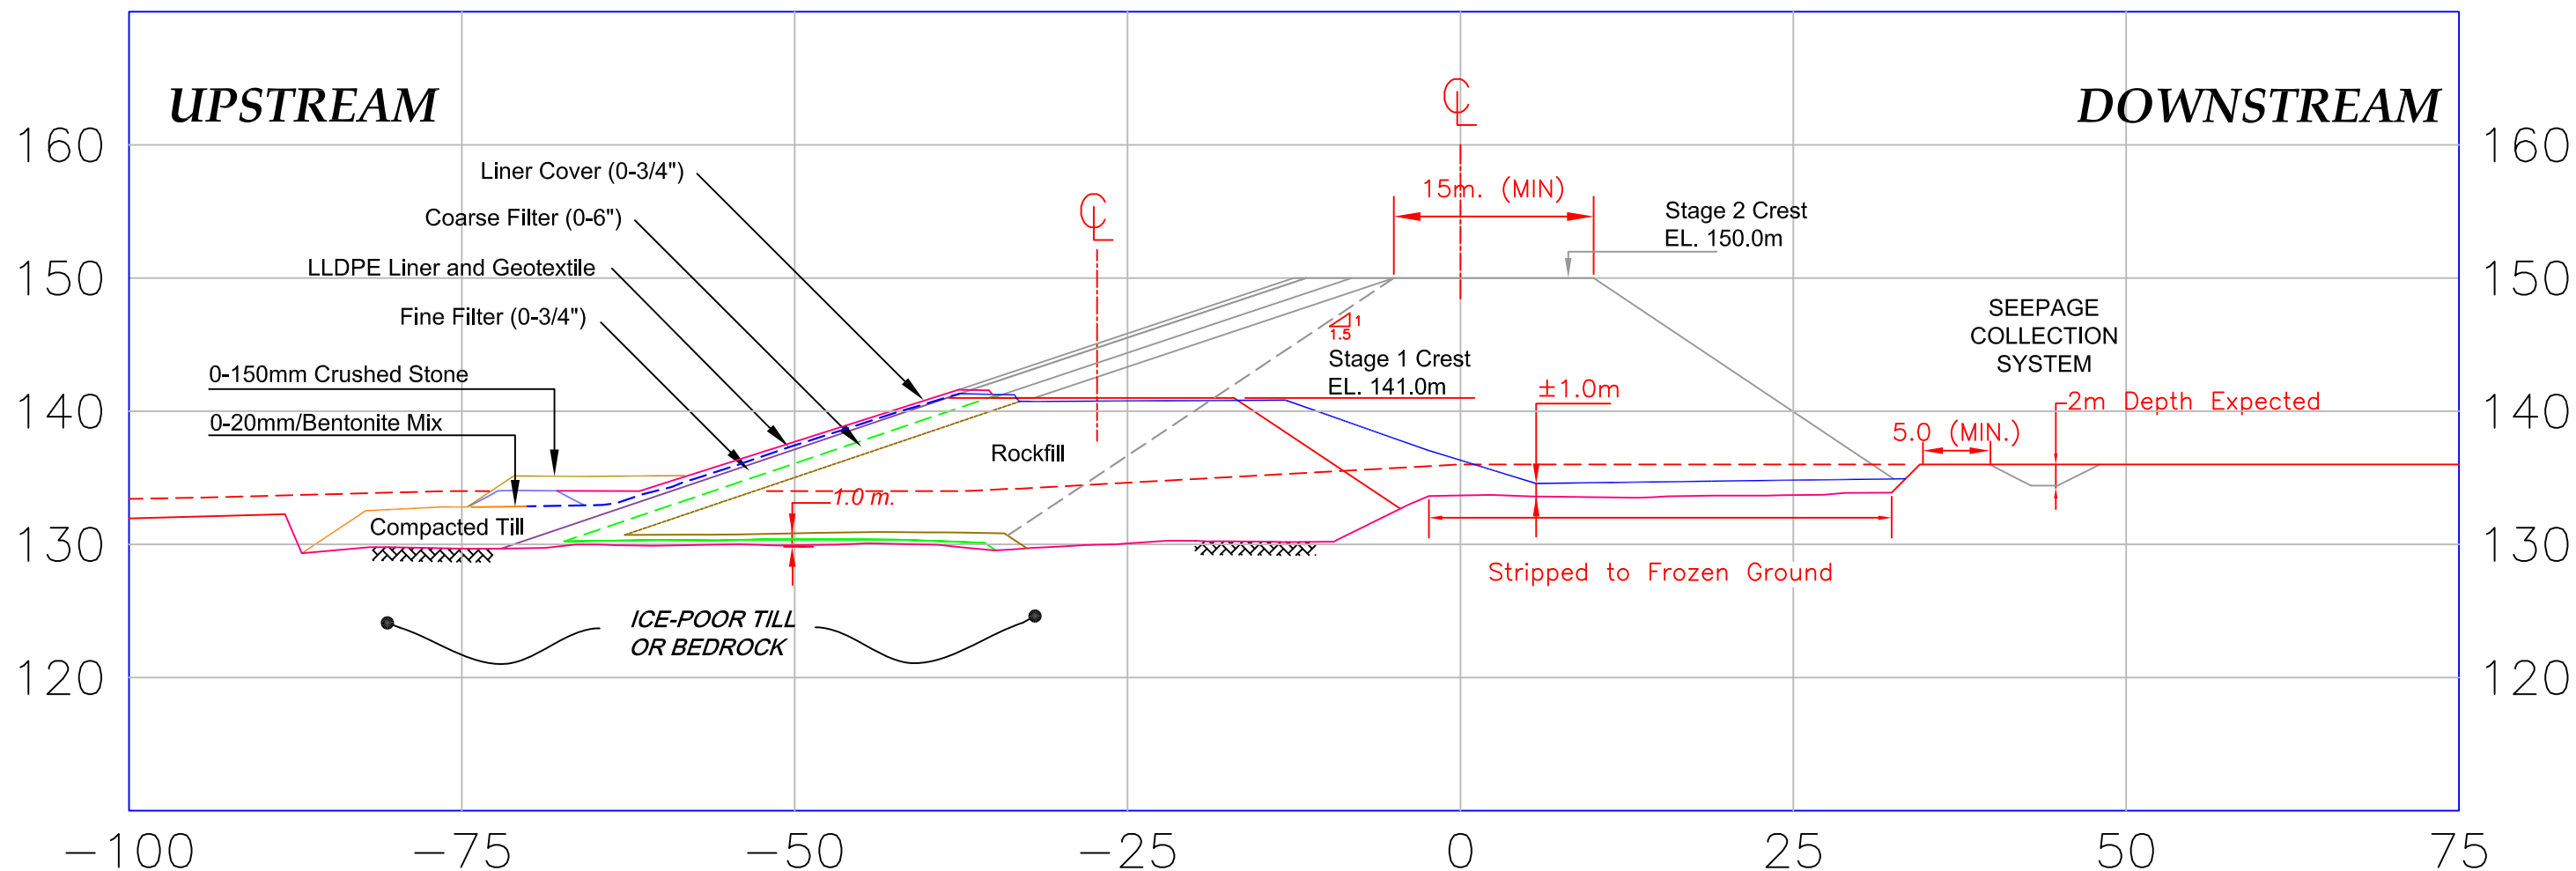


## **APPENDIX C – AS-BUILT DRAWINGS**

# **Saddle Dam 1 – As Built Drawings**

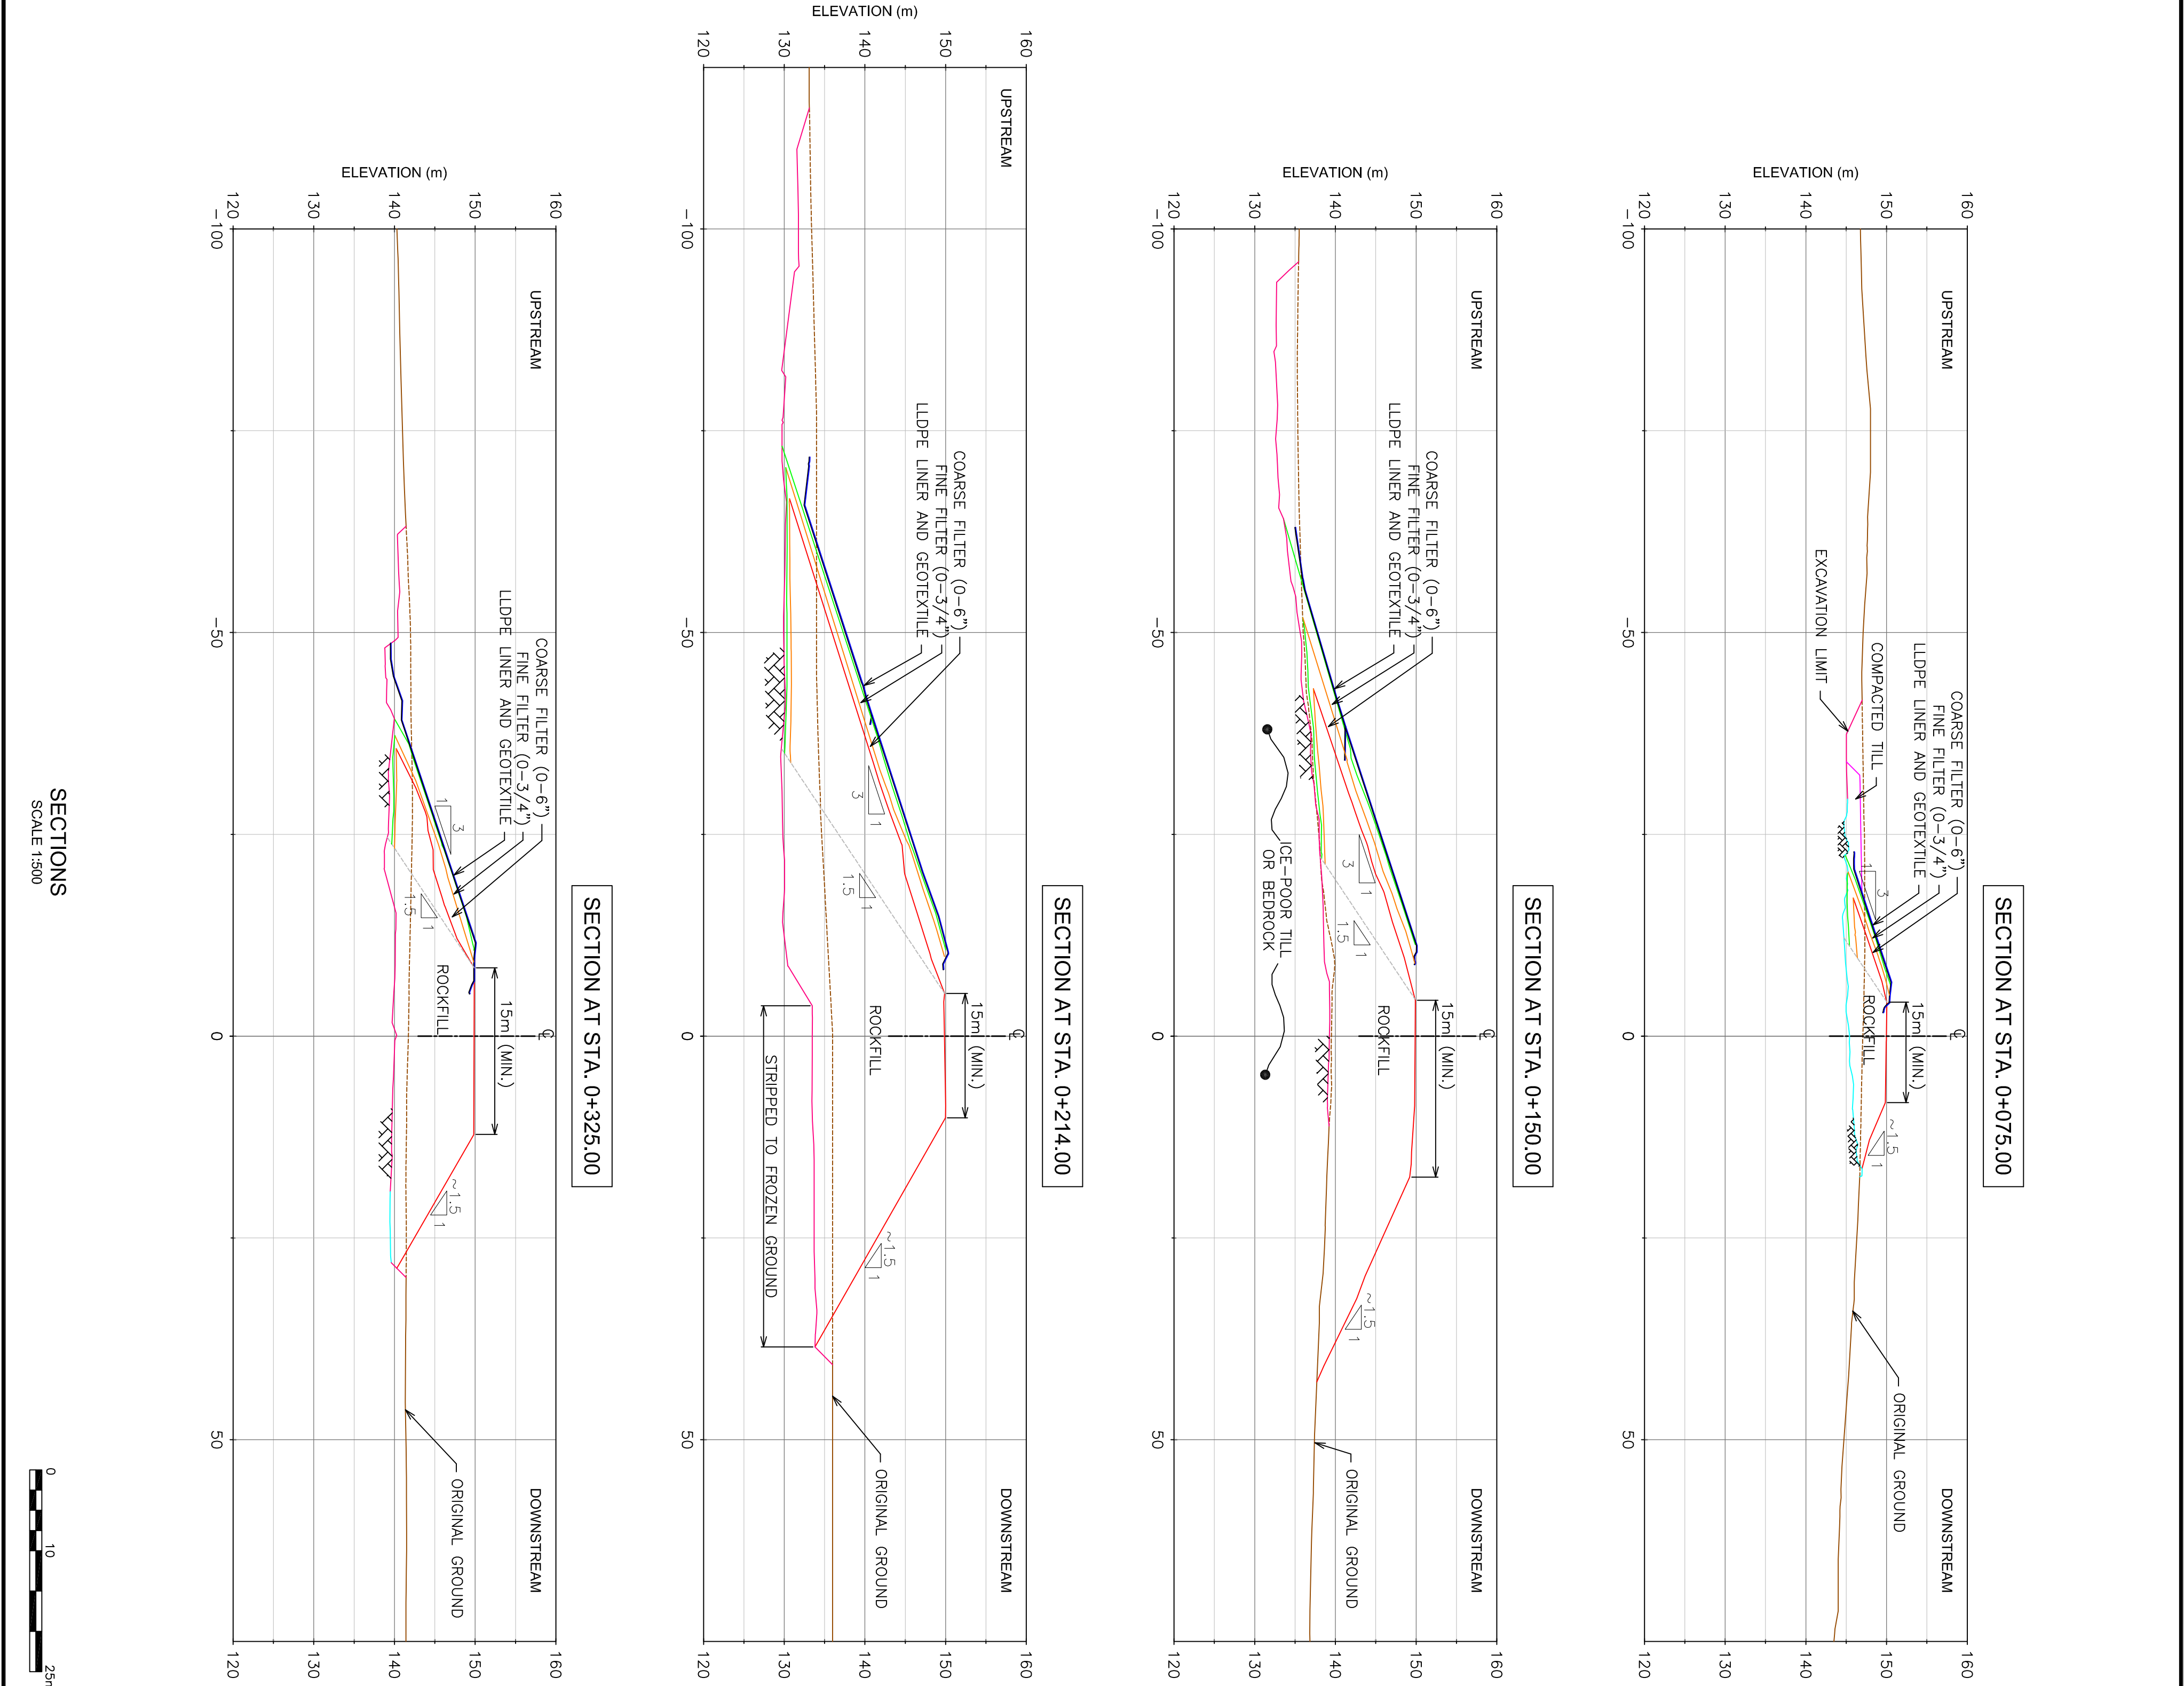

**SADDLE DAM# 1**  
**AS- BUILT INSTRUMENTED SECTION**  
**ST. 0+212**  
**(1:500 SCALE)**

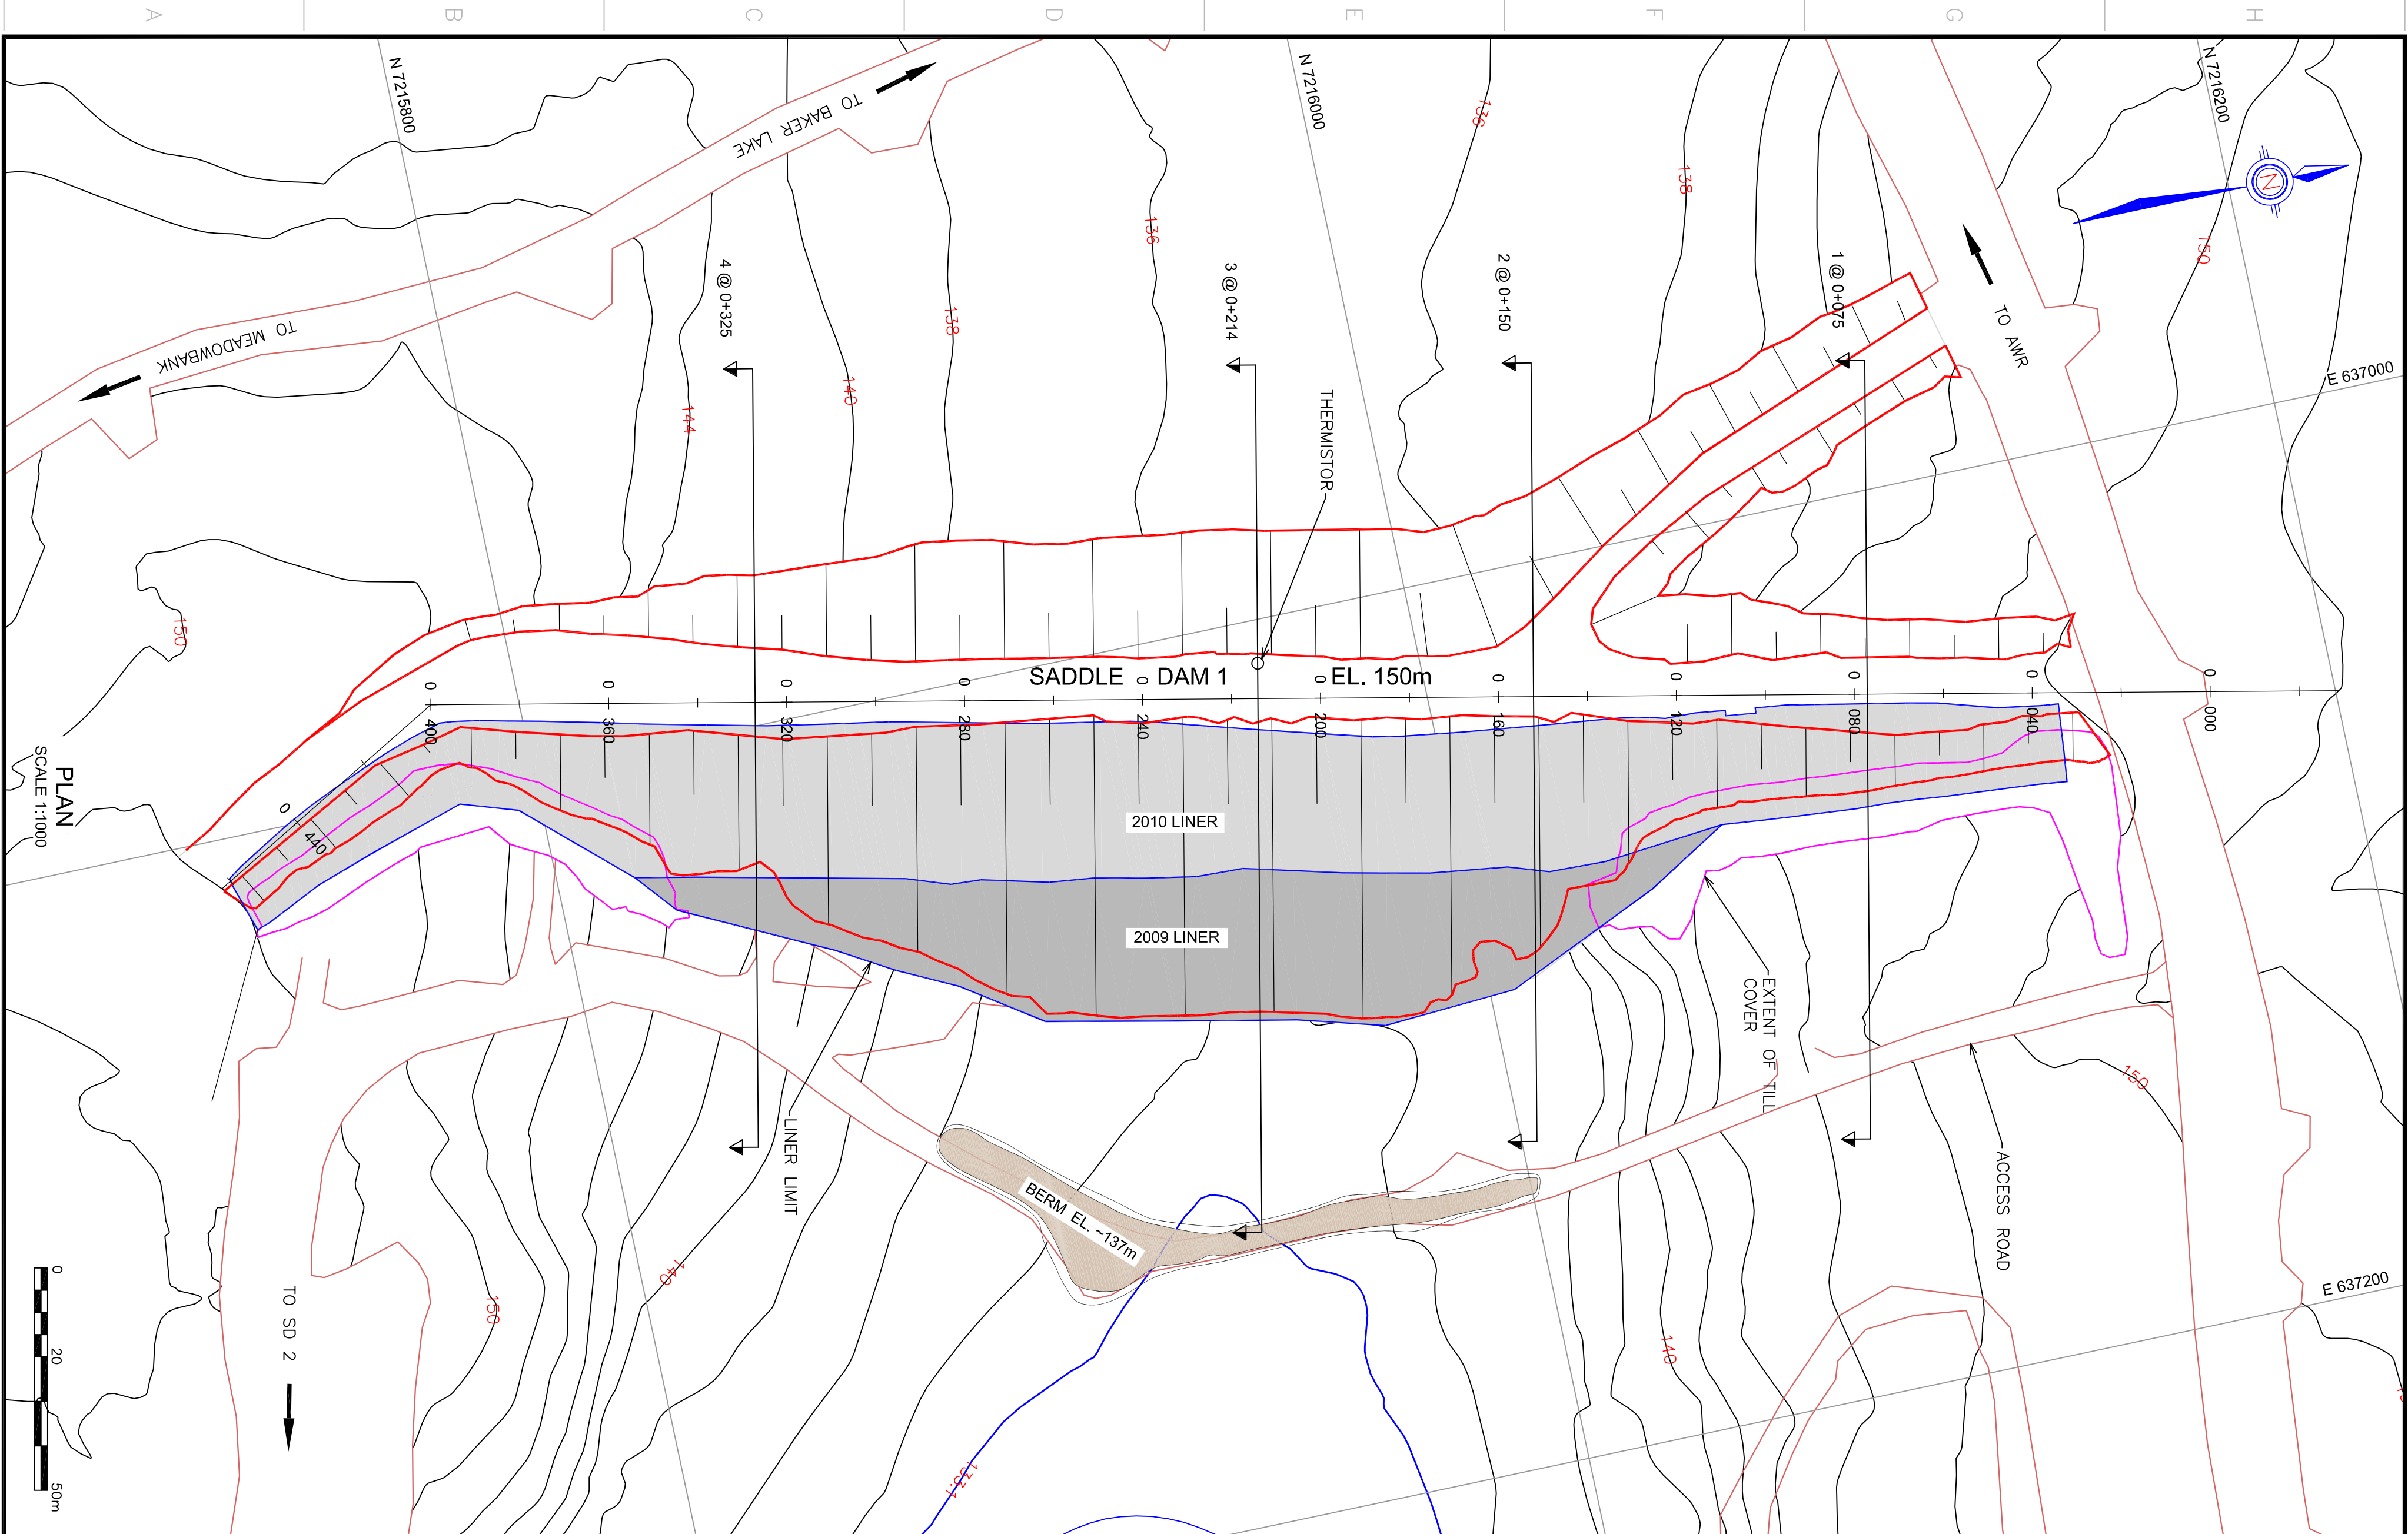

**KEY PLAN**

**GENERAL NOTES**

**LEGEND:**

- LINER COVER 2010
- LINER COVER 2009
- COFFERDAM
- CREST / TOE LINE
- EXTENT OF TILL
- ROADS

**FOR SECTIONS:**

- FINE FILTER
- COARSE FILTER
- BEDROCK
- FOUNDATION
- LINER
- GEOTEXTILE
- ORIGINAL GROUND
- ROCKFILL
- TILL

**REVISIONS**

REV.	DATE	DESCRIPTION	BY	APP.	DATE

**REFERENCE DRAWINGS**

TITLE	DATE

**PROJECT INFORMATION**

**TITLE:** AGNICO-EAGLE - MEADOWBANK DIVISION  
**SADDLE DAM 1**  
**PLAN**  
**AS BUILT 2010**

**DRAWN BY:** K. Moogline  
**CHECKED BY:** Y. Jobert  
**APPROVED BY:** Y. Jobert


**SCALE:** AS SHOWN  
**DRAWING NO.:**

**PROJECT NO.:**




 





**REVISION SHEET:** 1 / 1

**DATE:** 2010/09/28



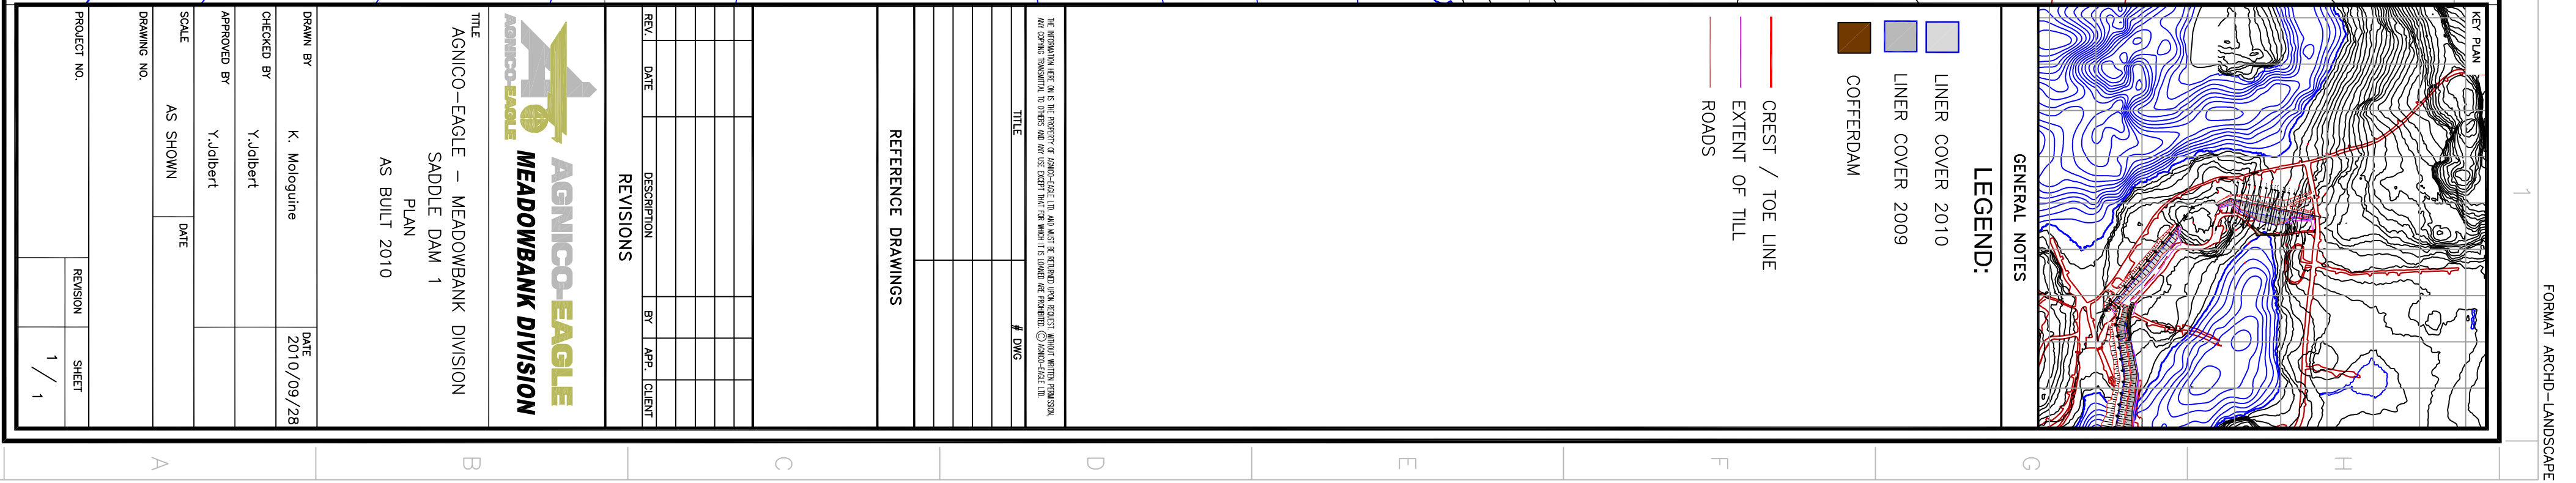






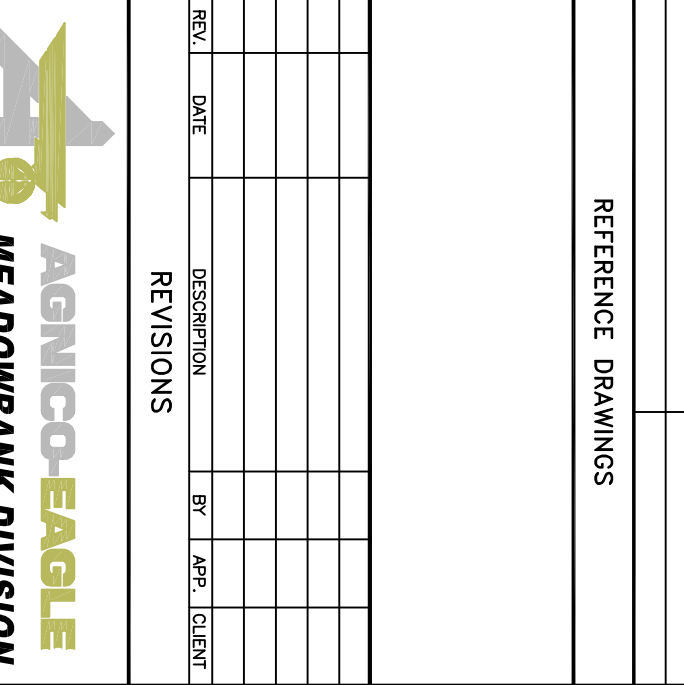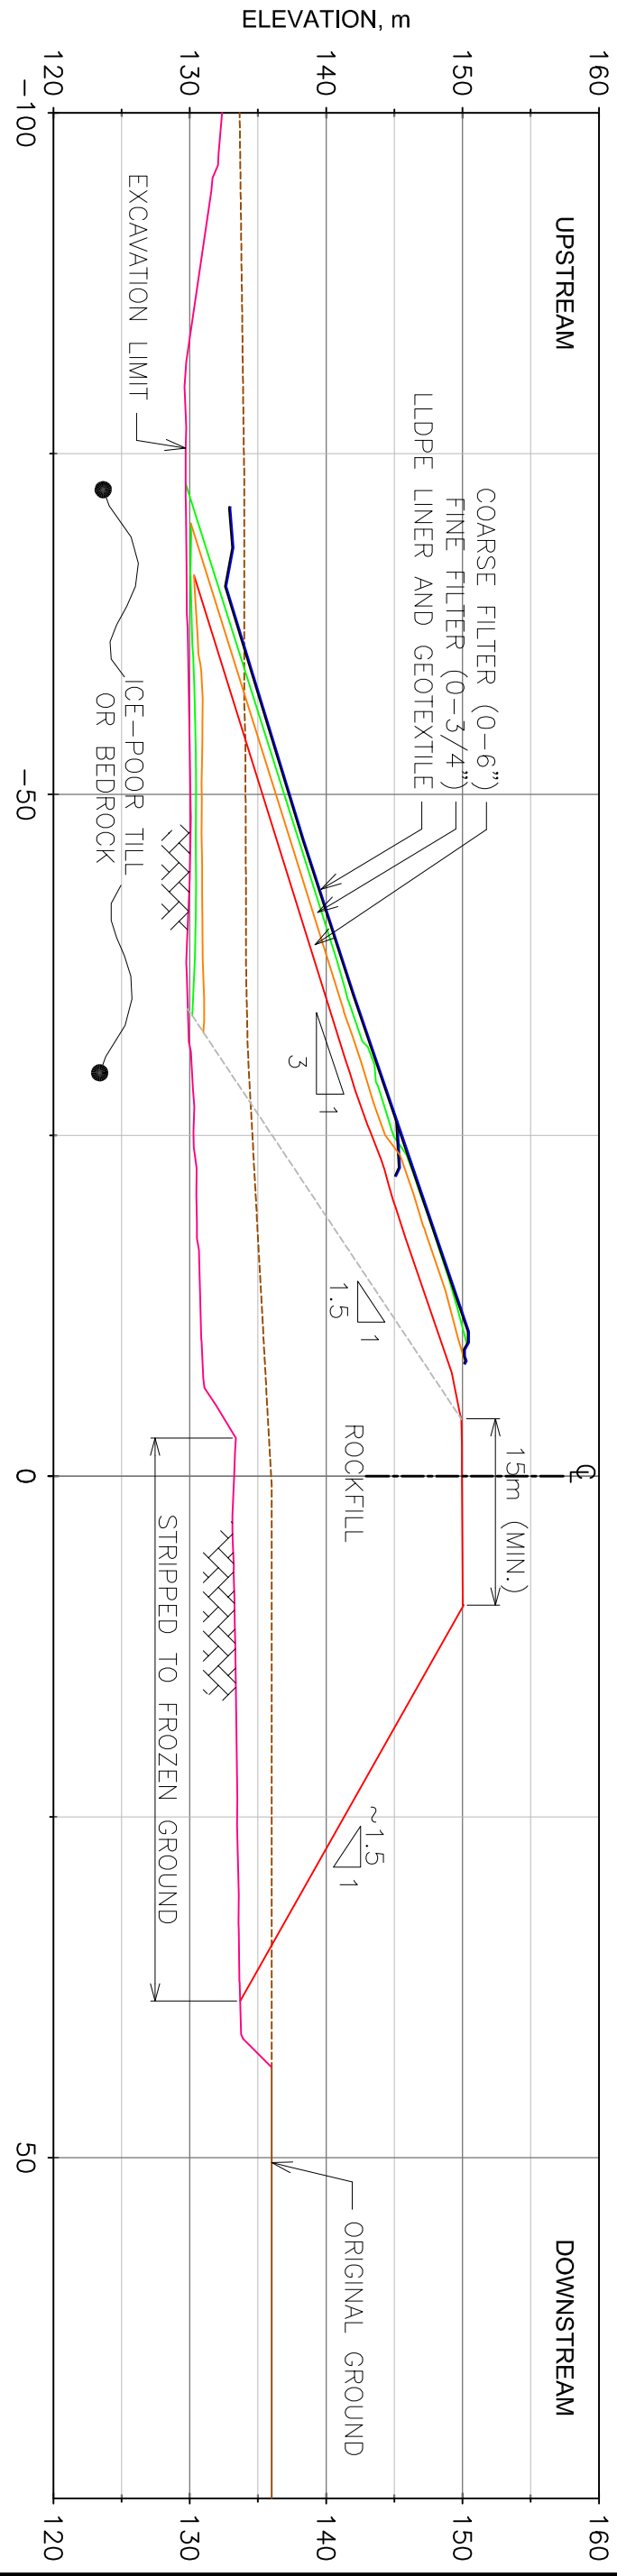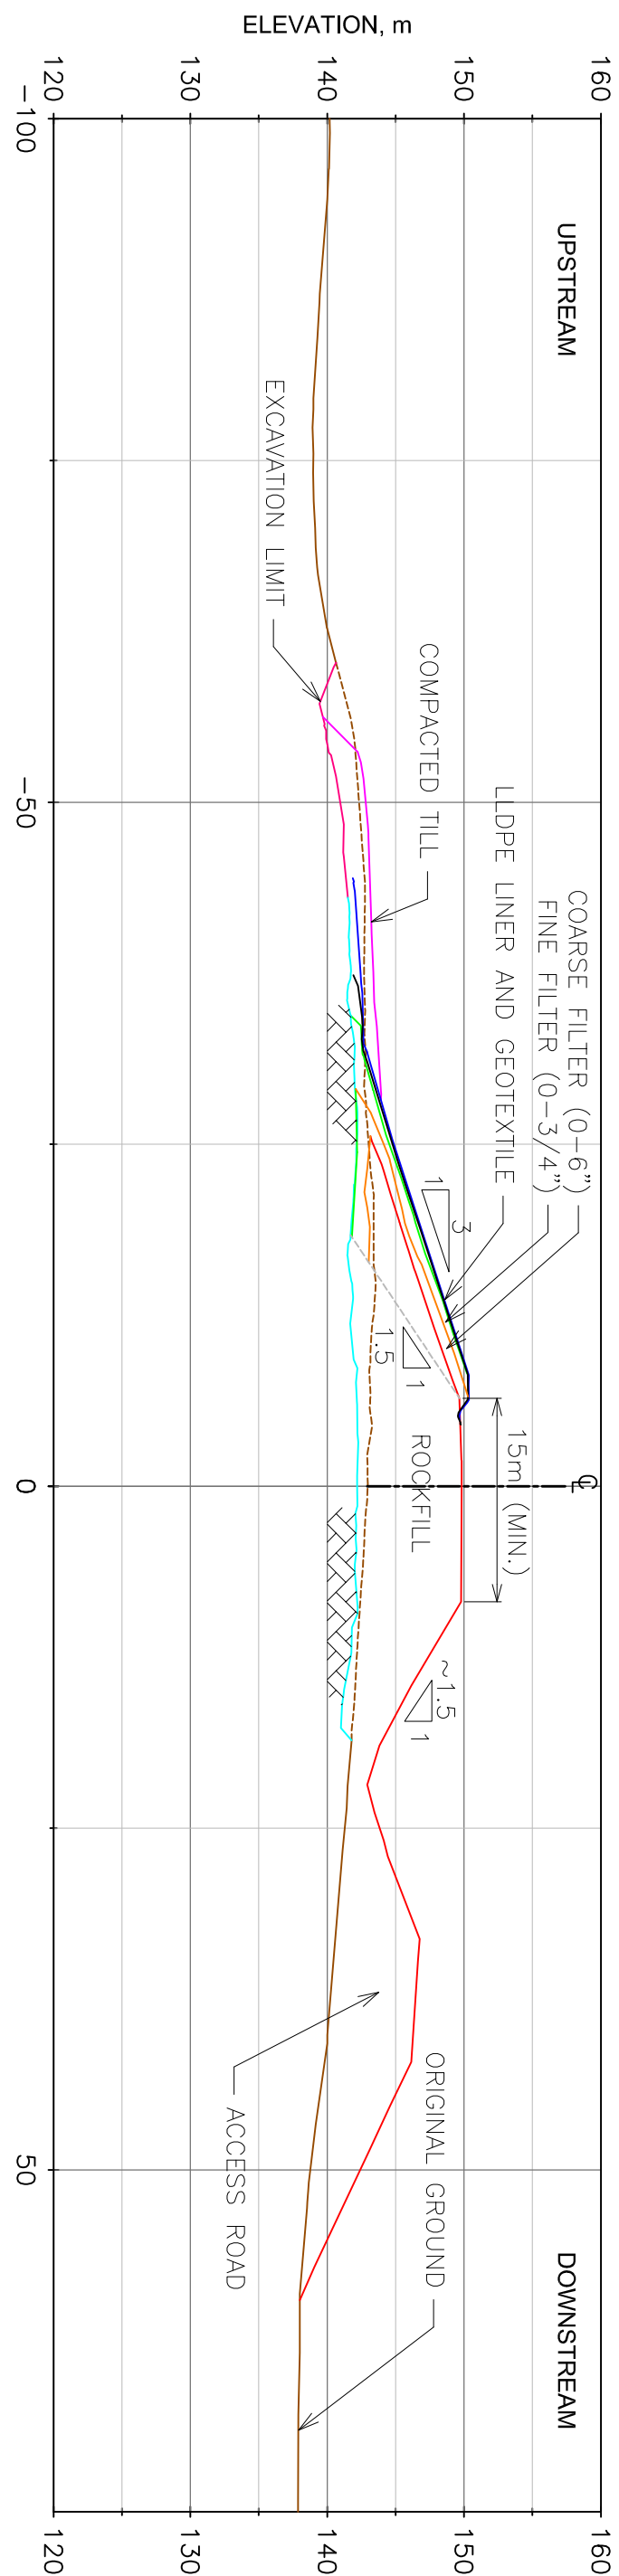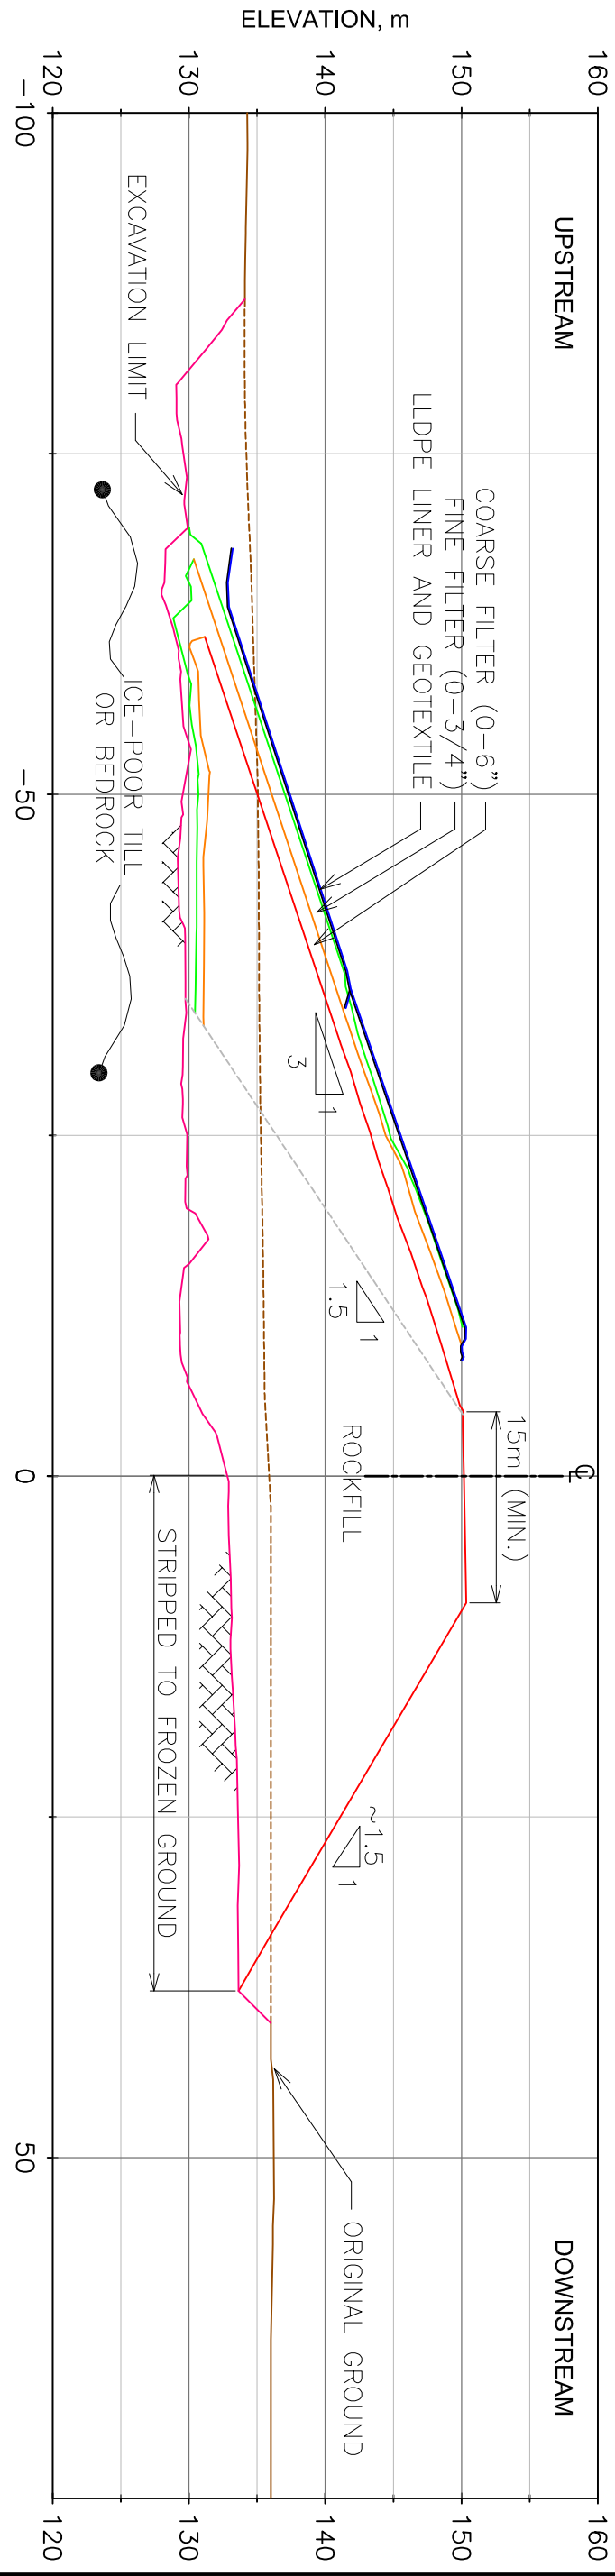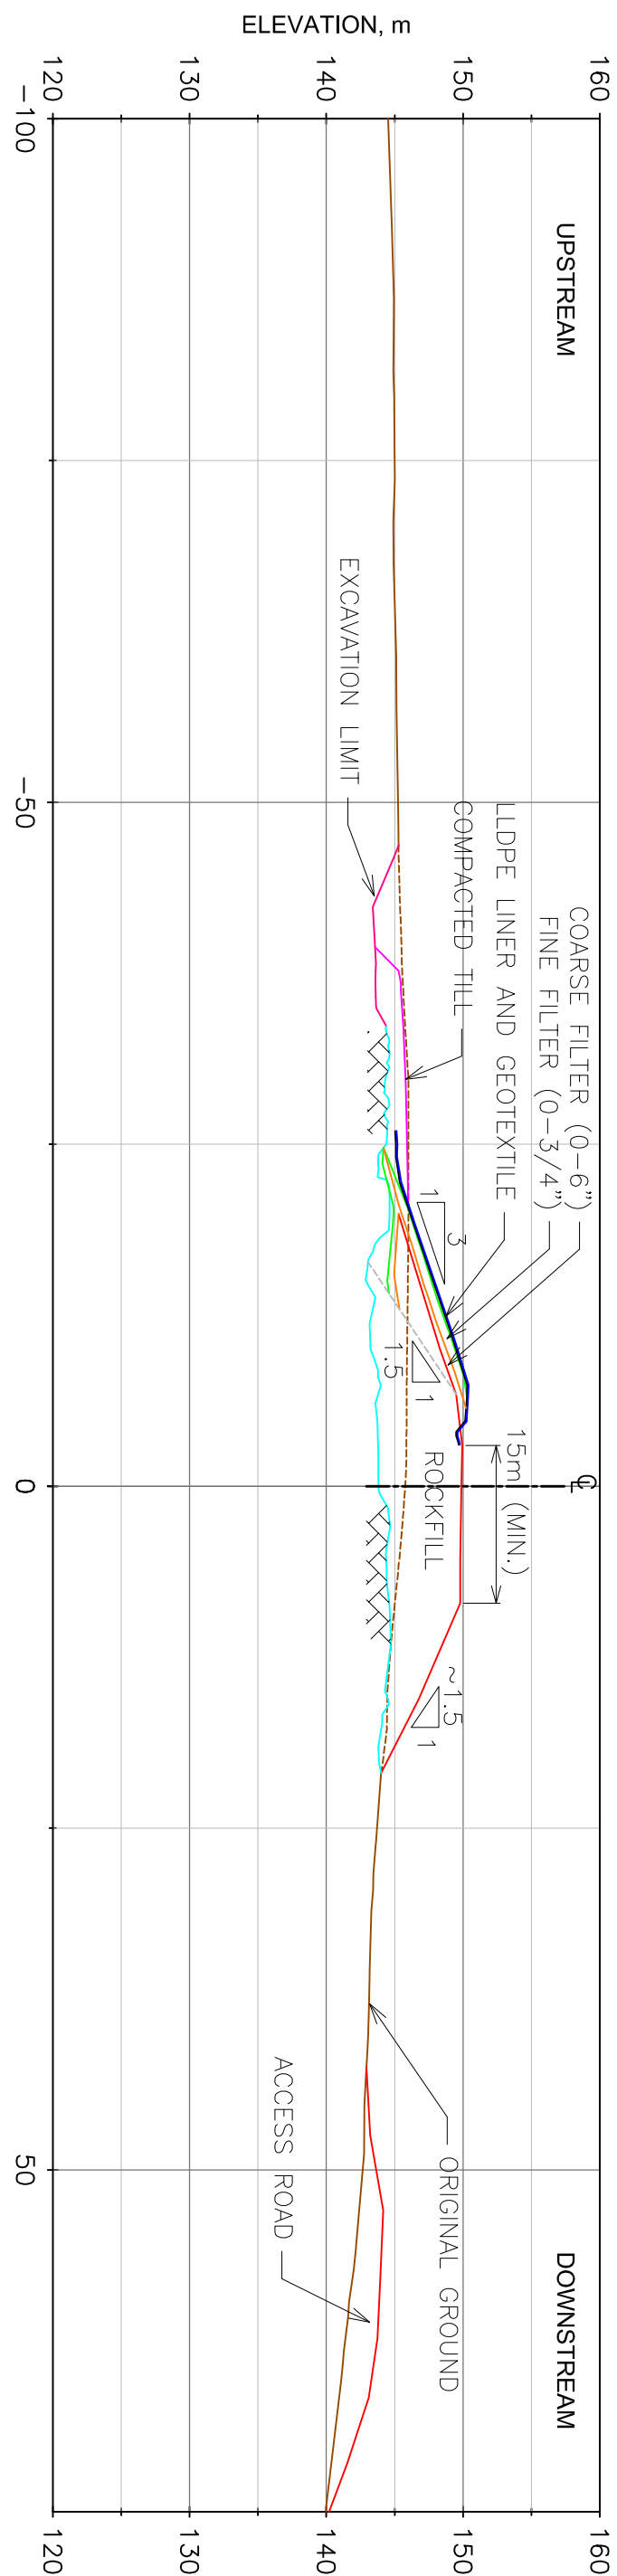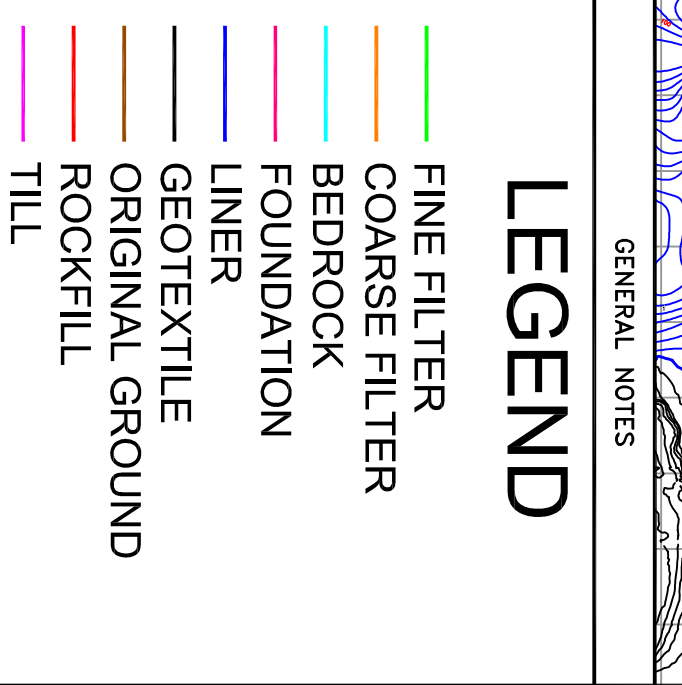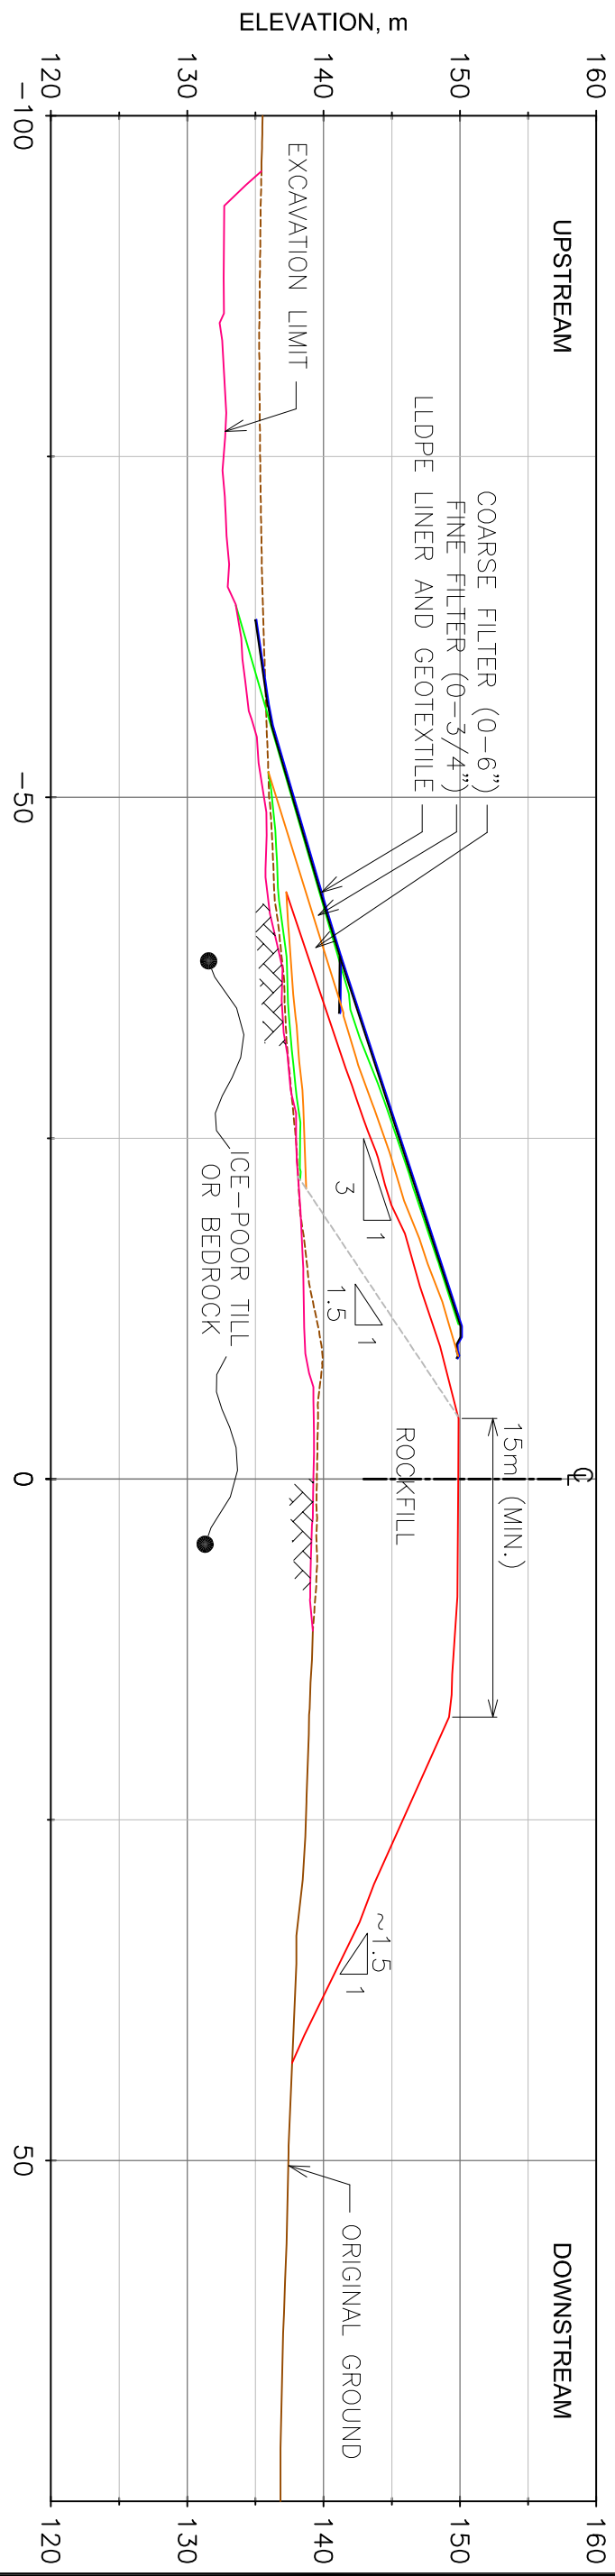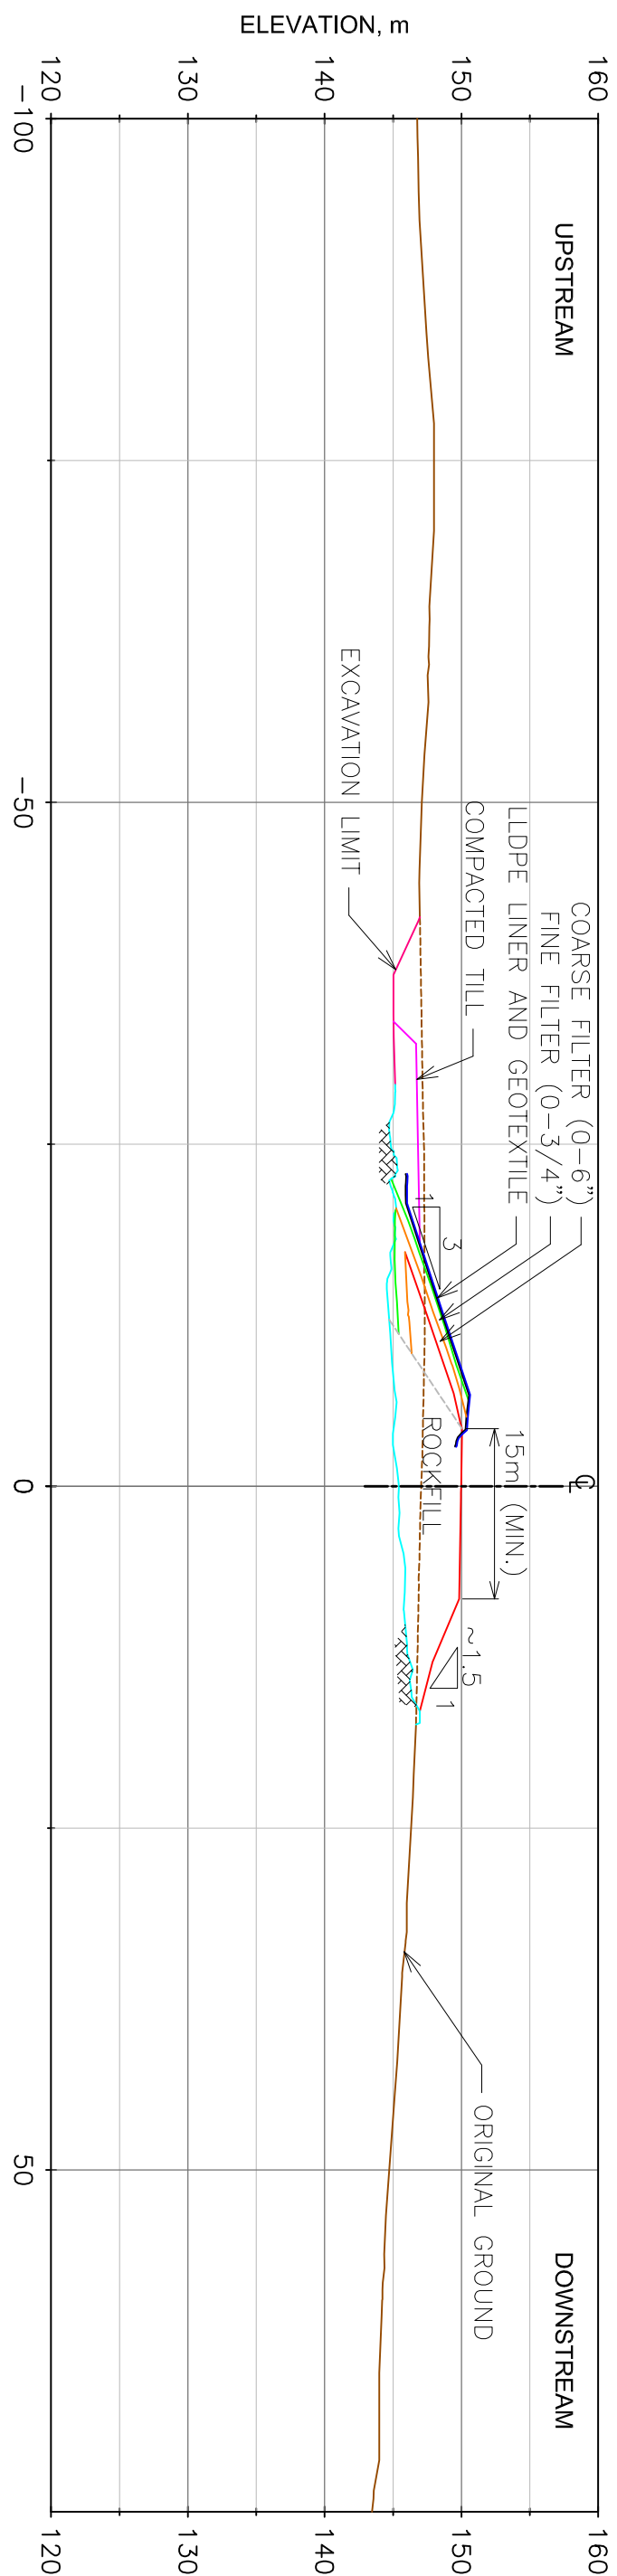



TITLE  
AGNICO-EAGLE — MEADOWBANK DIVISION  
SADDLE DAM 1  
SECTIONS  
AS BUILT 2010

DESIGNED BY K. Macgillivray  
CHECKED BY Y. Jolbert  
APPROVED BY Y. Jolbert  
SCALE 1:500  
DRAWING NO.



PROJECT NO. REVISION SHEET  
1 / 2

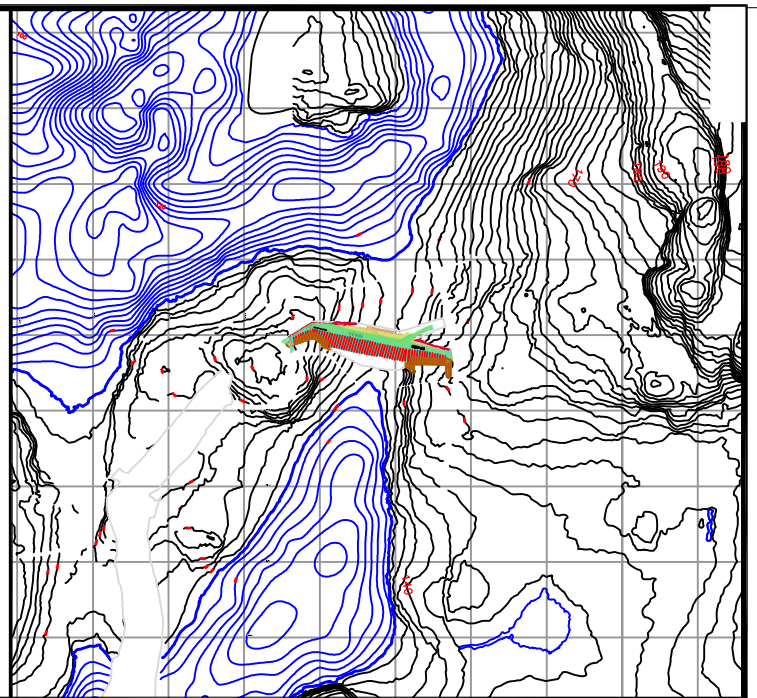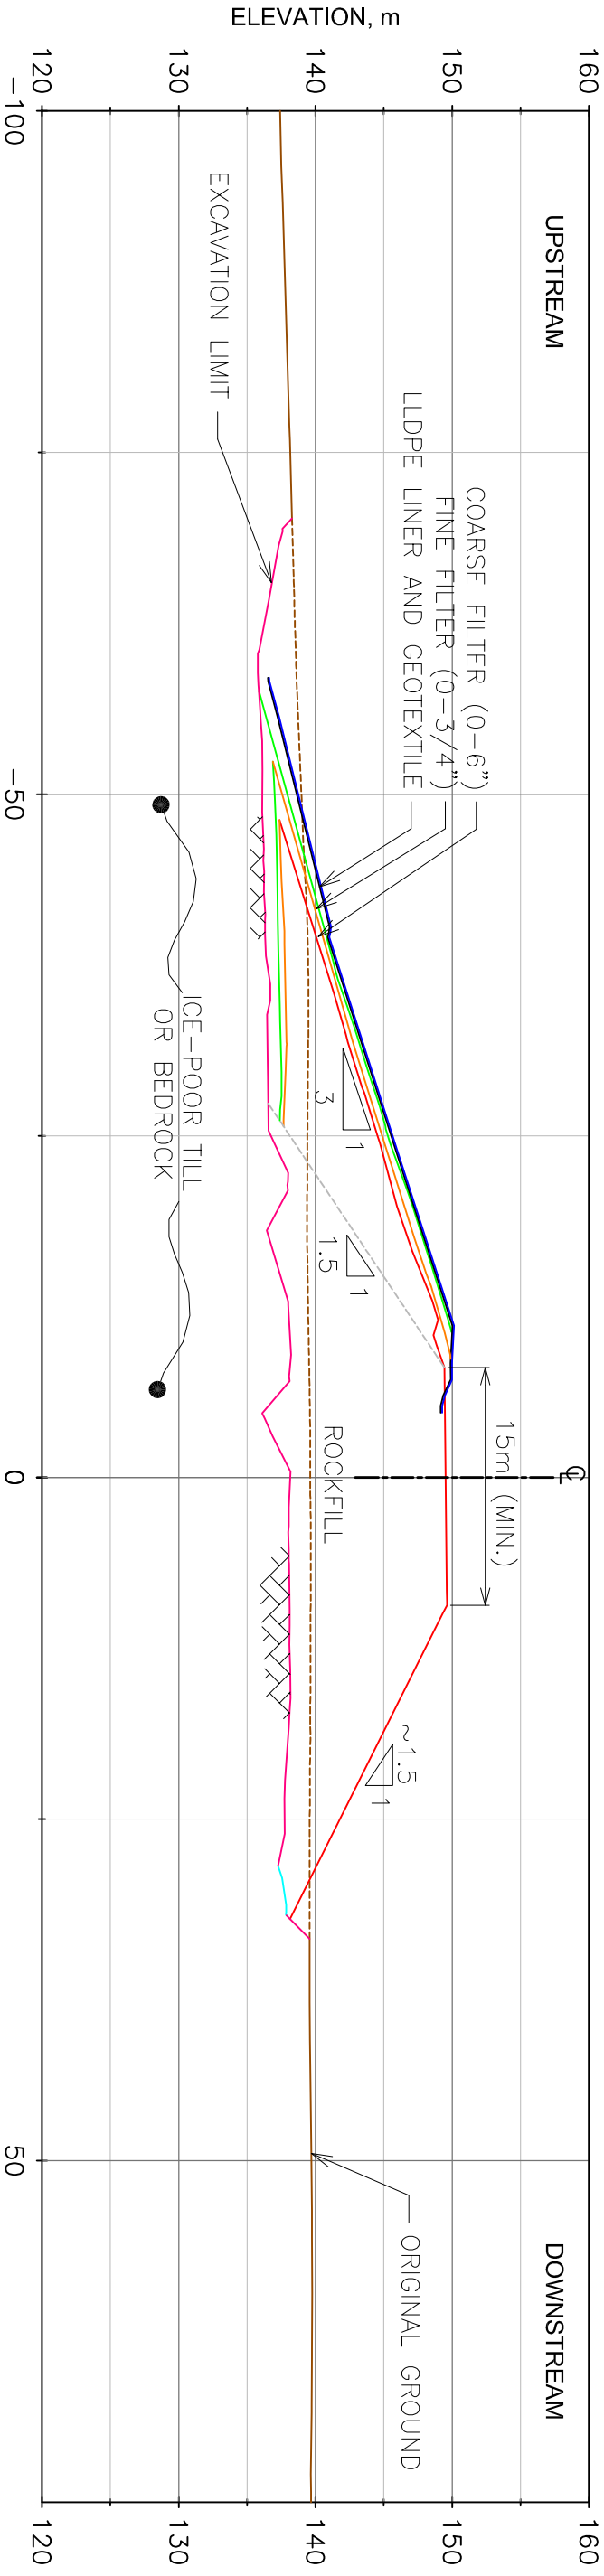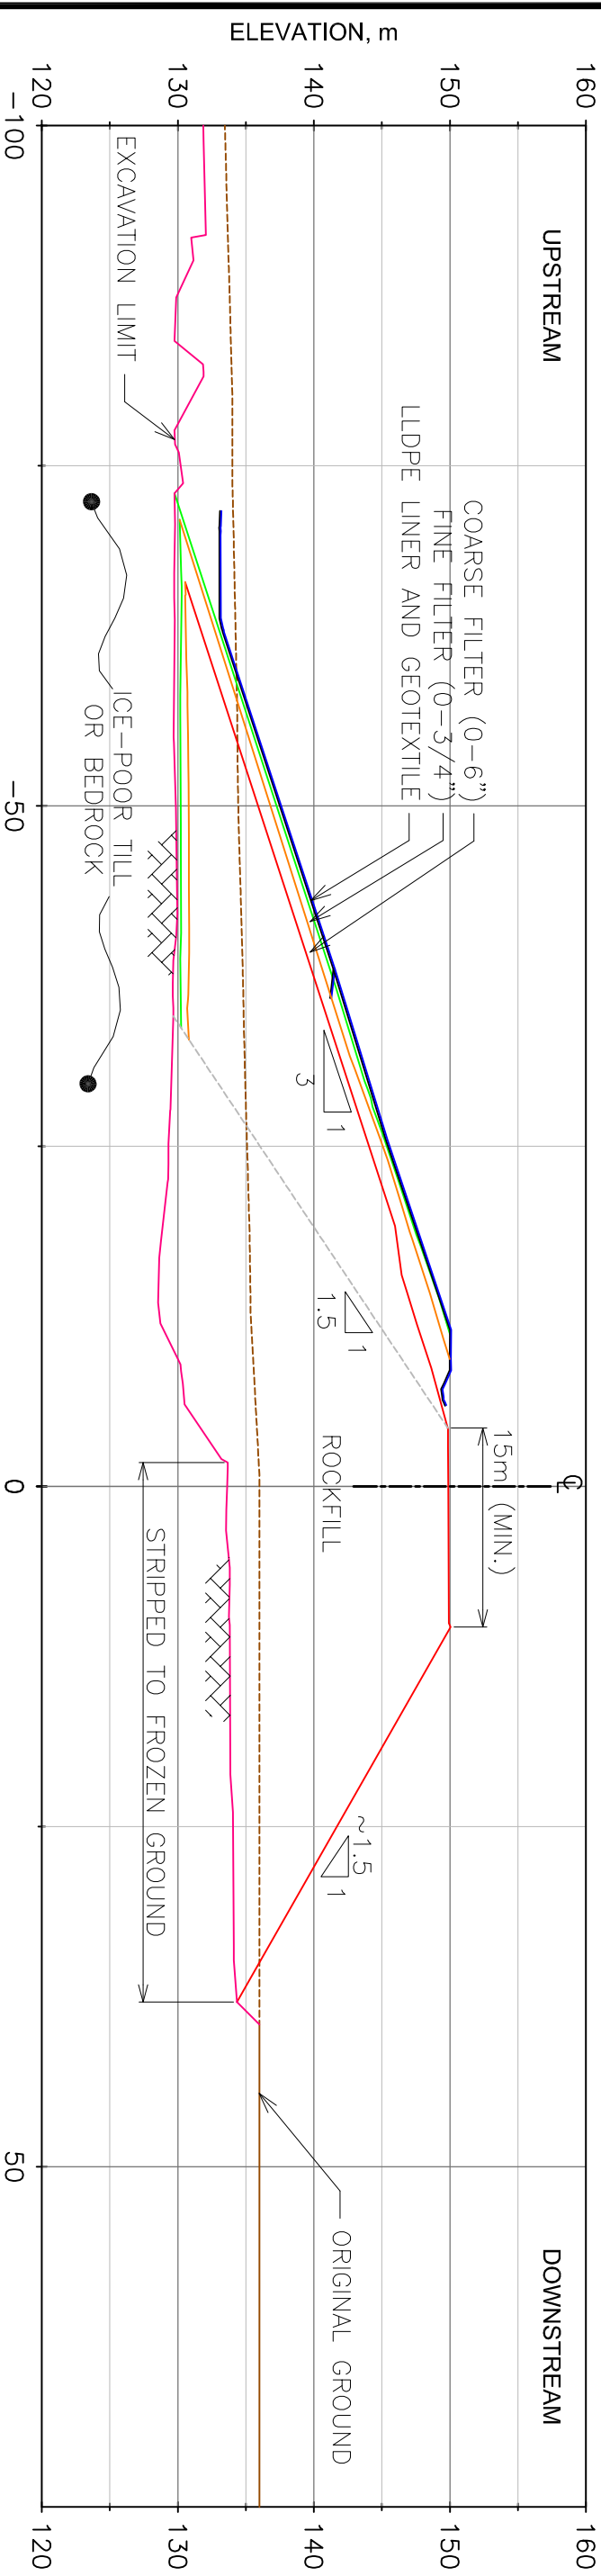


SECTION AT STA. 0+250.00

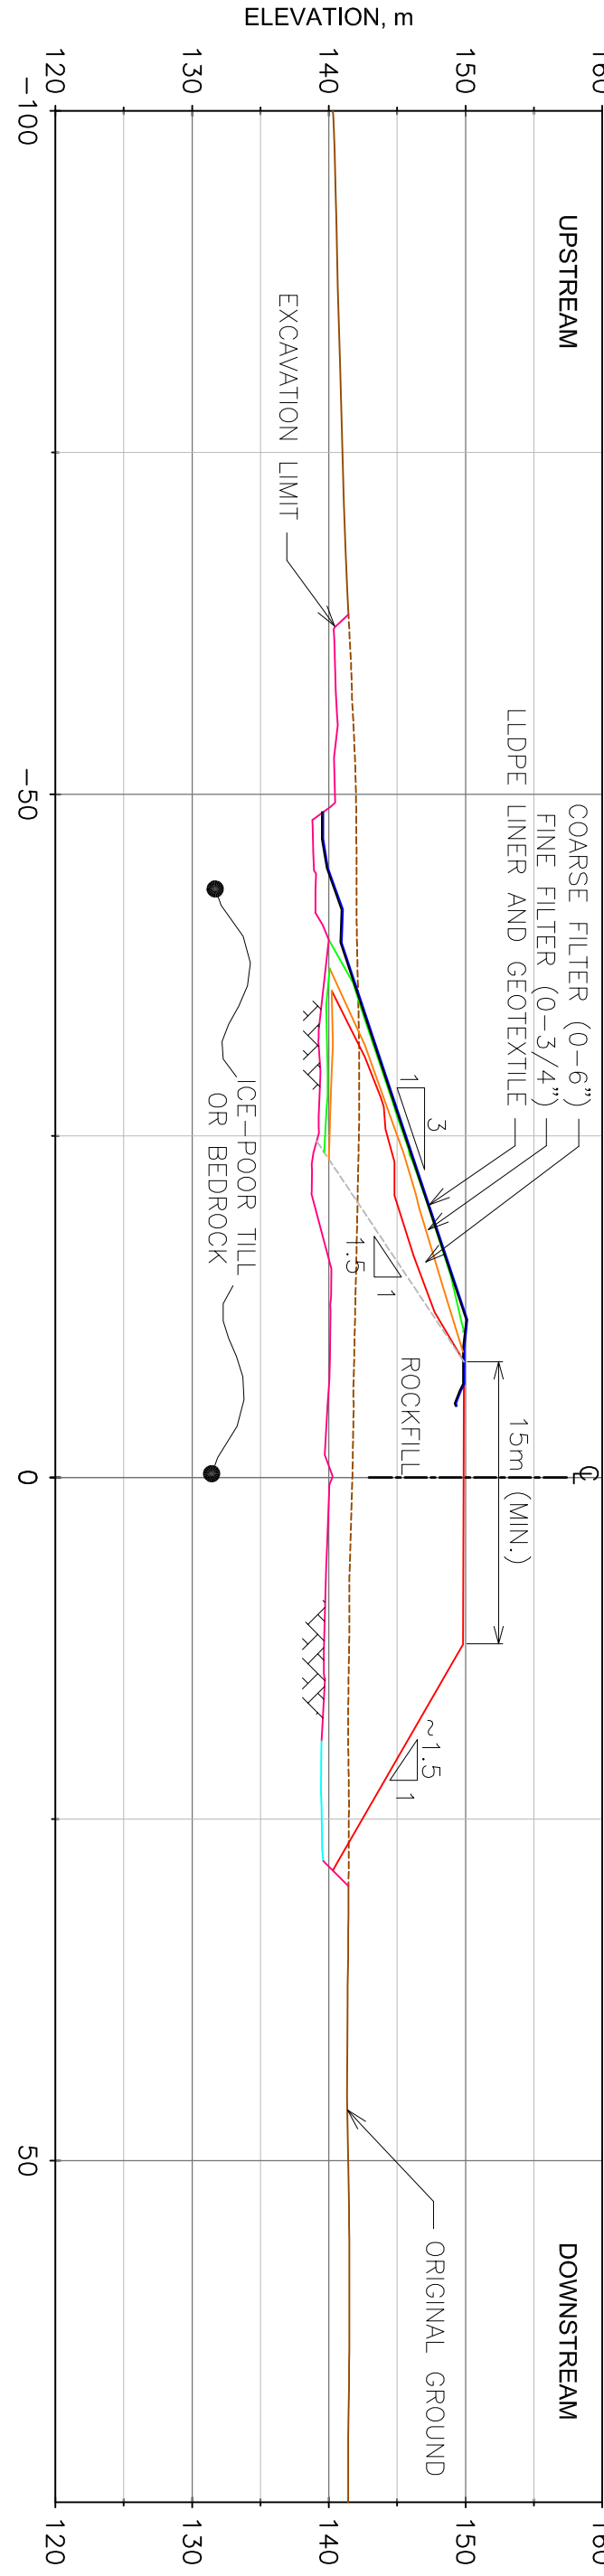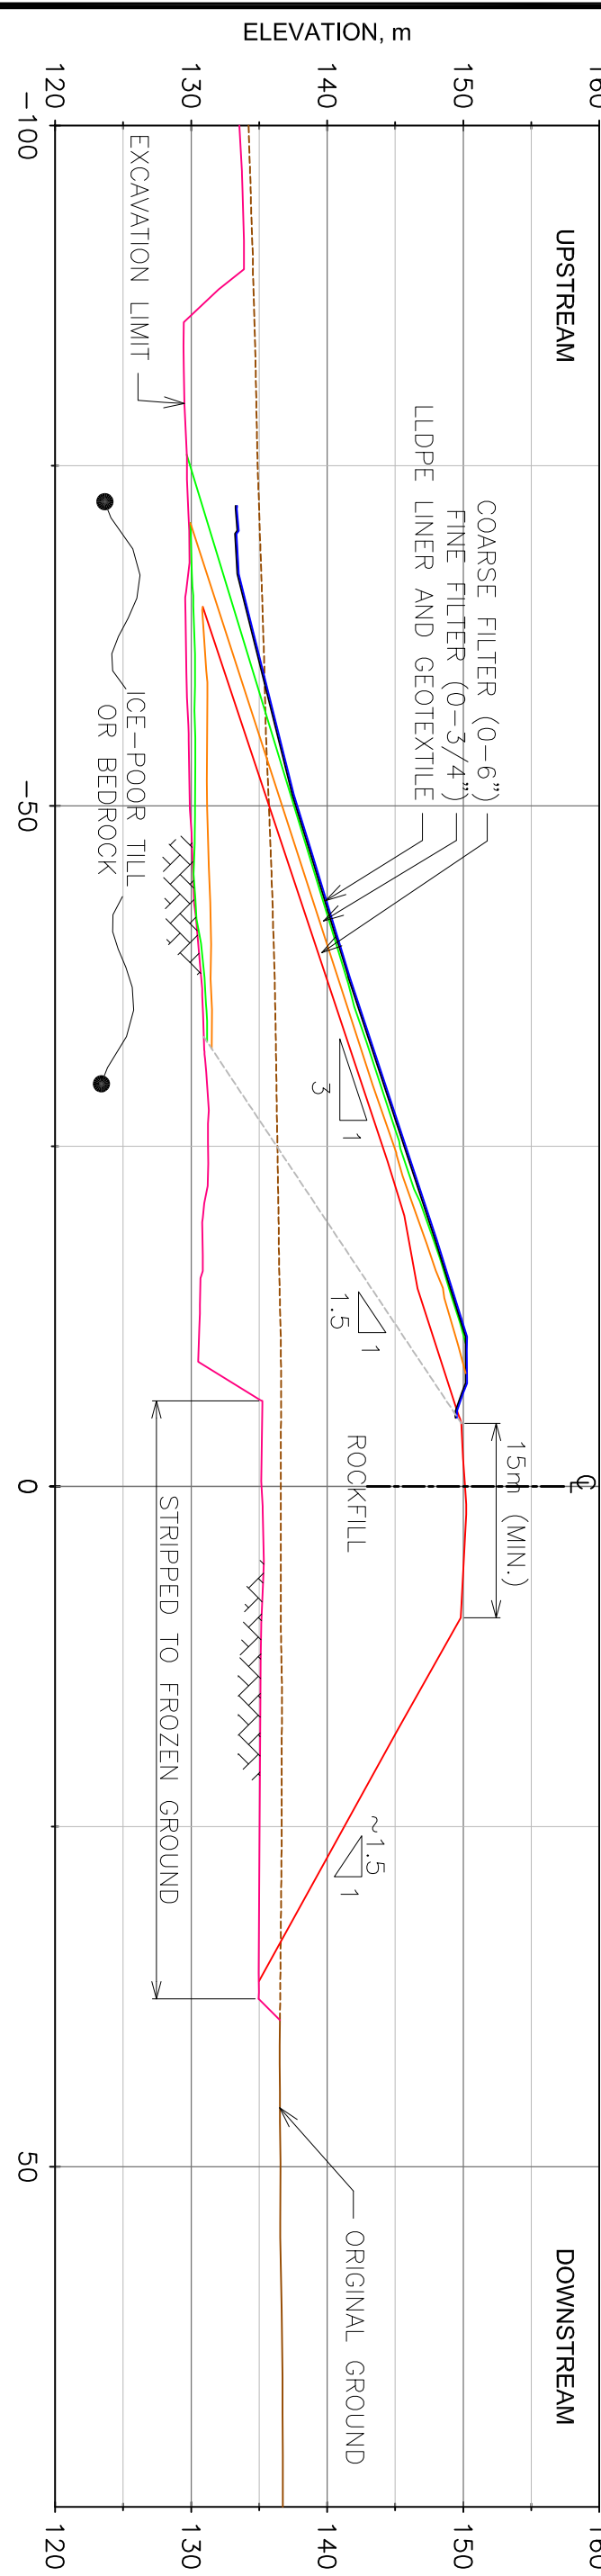

SECTION AT STA. 0+350.00

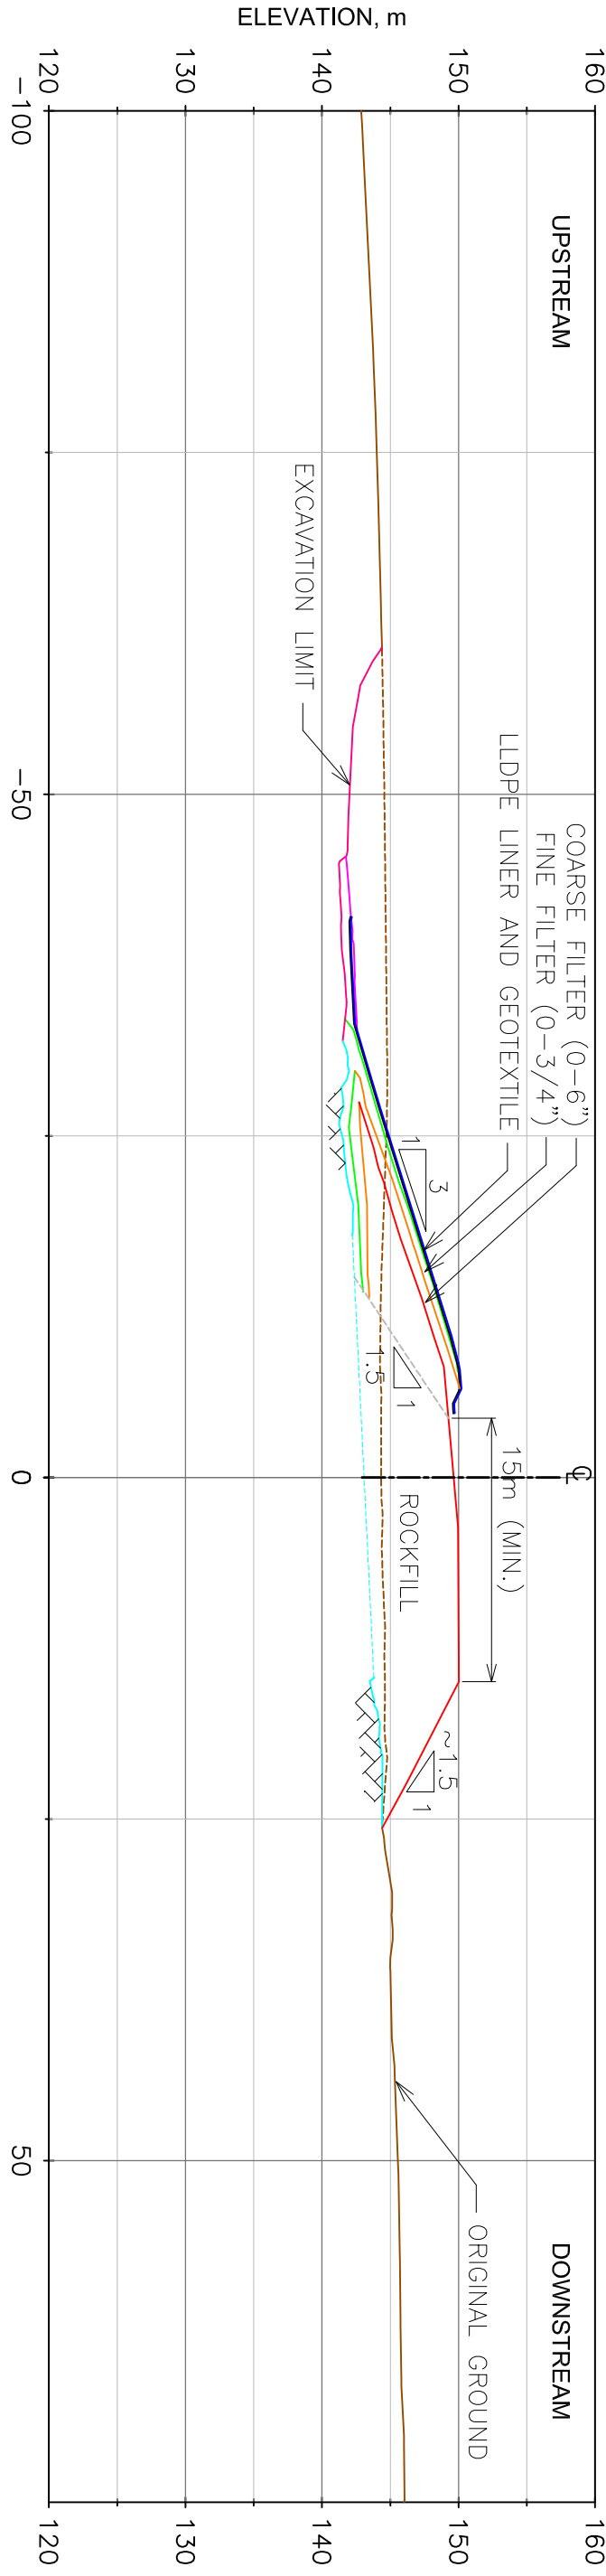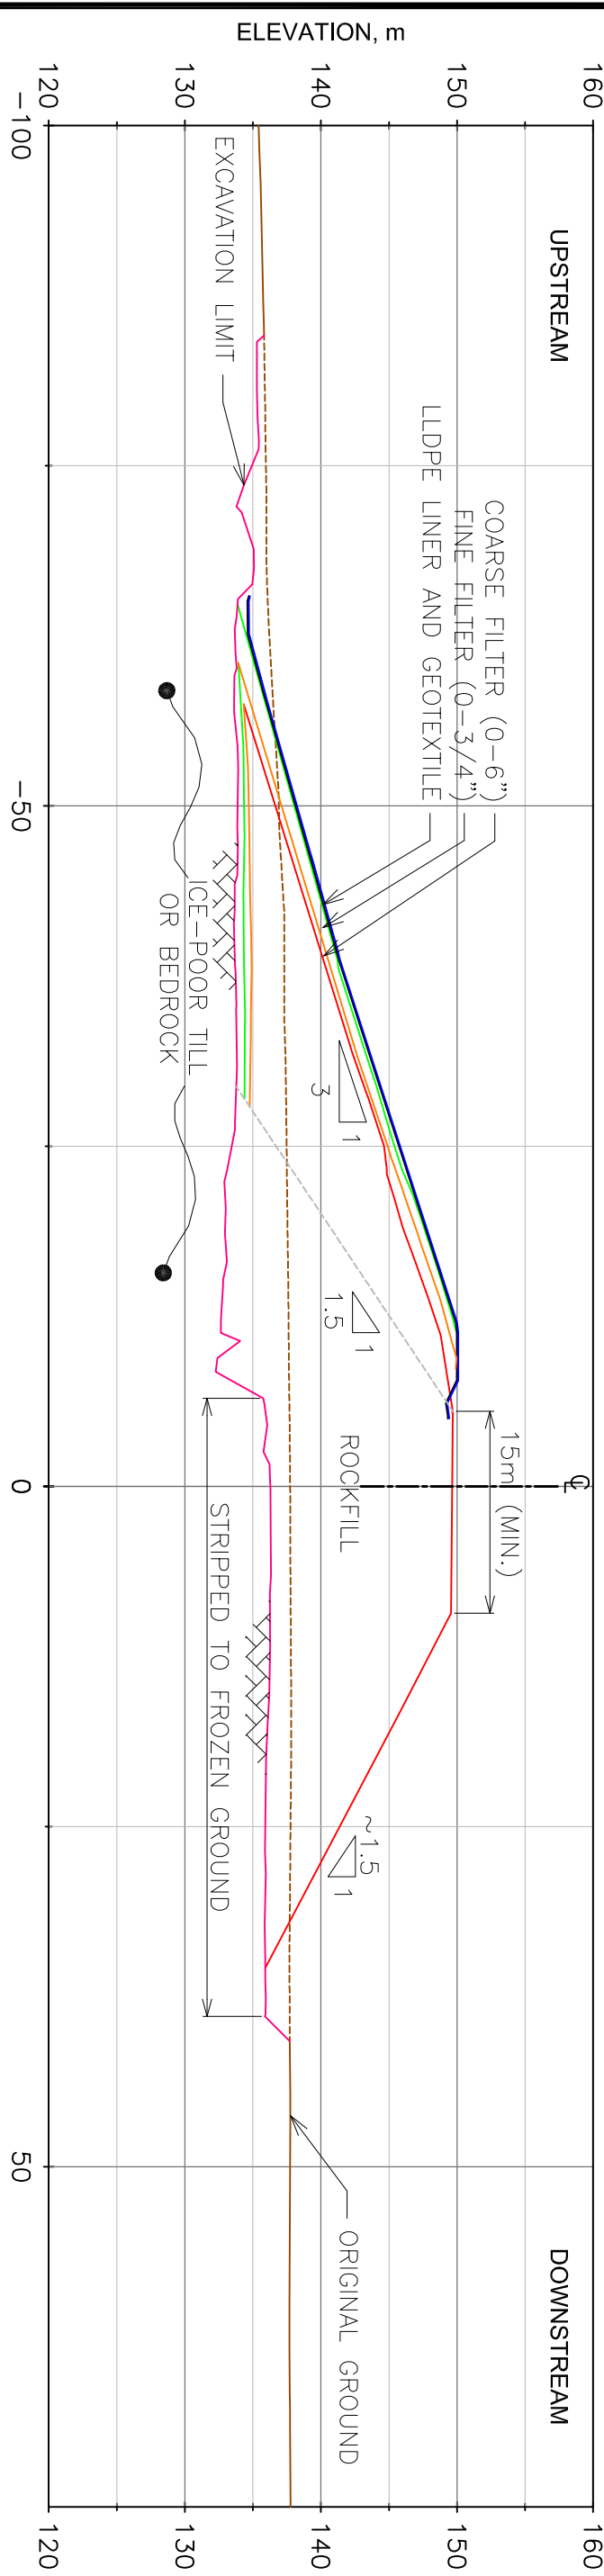

SECTION AT STA. 0+375.00

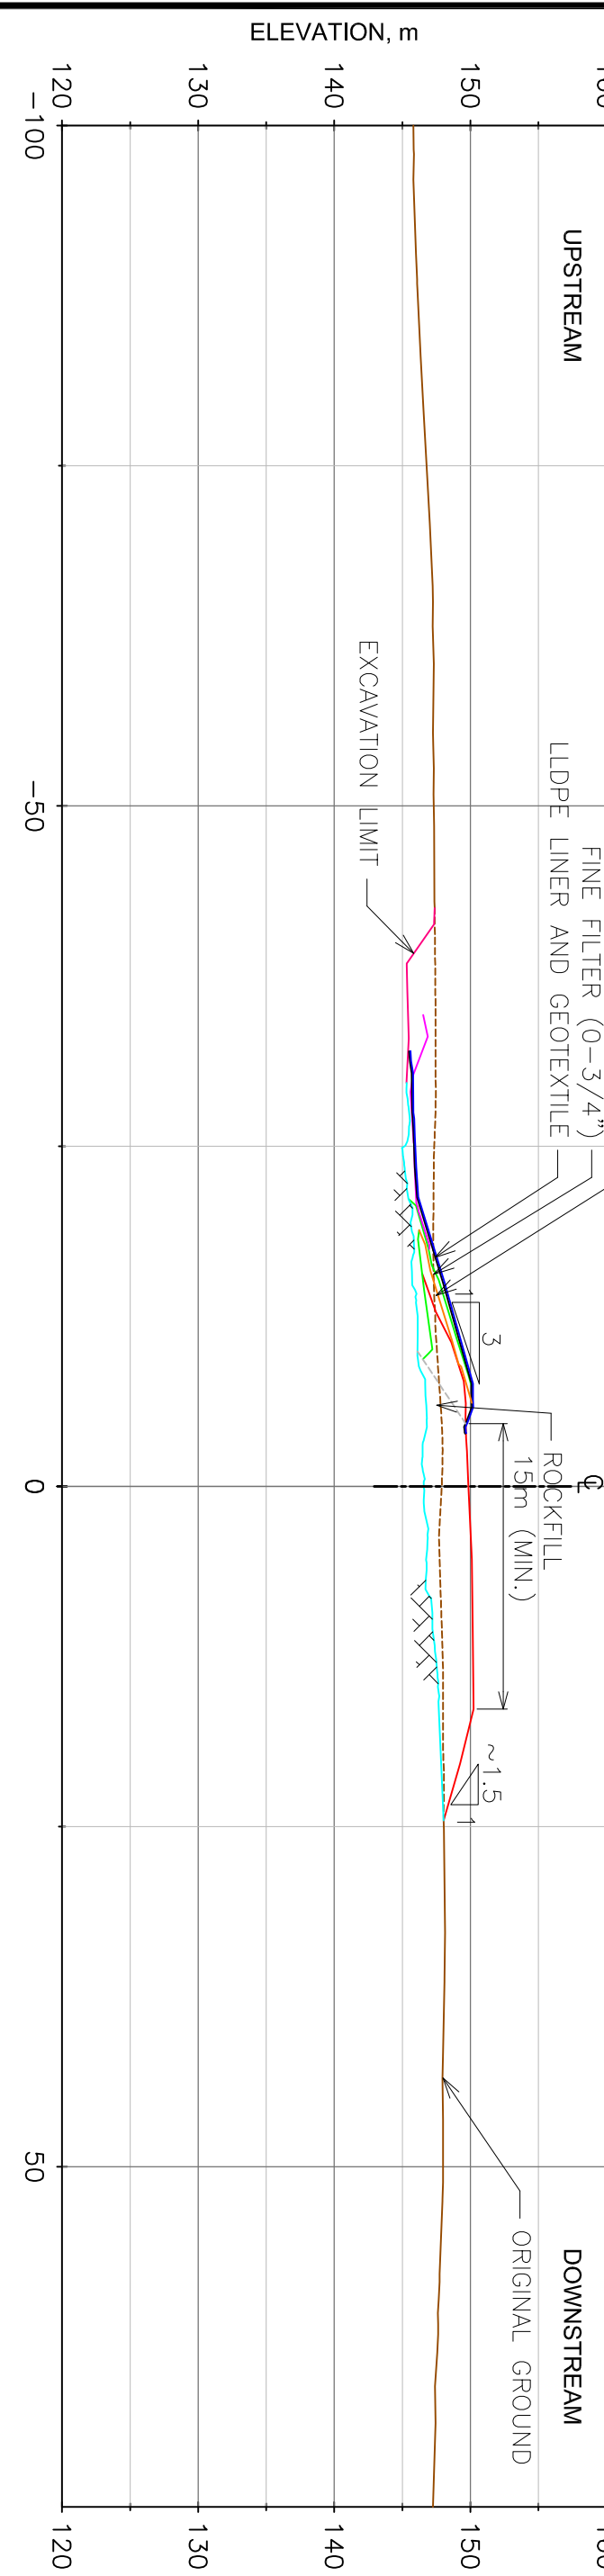


TITLE  
AGNICO-EAGLE — MEADOWBANK DIVISION  
SADDLE DAM 1  
SECTIONS  
AS BUILT 2010

DRAWN BY	K. Moogline	DATE	2010/09/28
CHECKED BY	V. Jobert		
APPROVED BY	V. Jobert		
SCALE	1:500	DATE	
DRAWING NO.			

PROJECT NO.		REVISION	
		SHEET	2 / 2



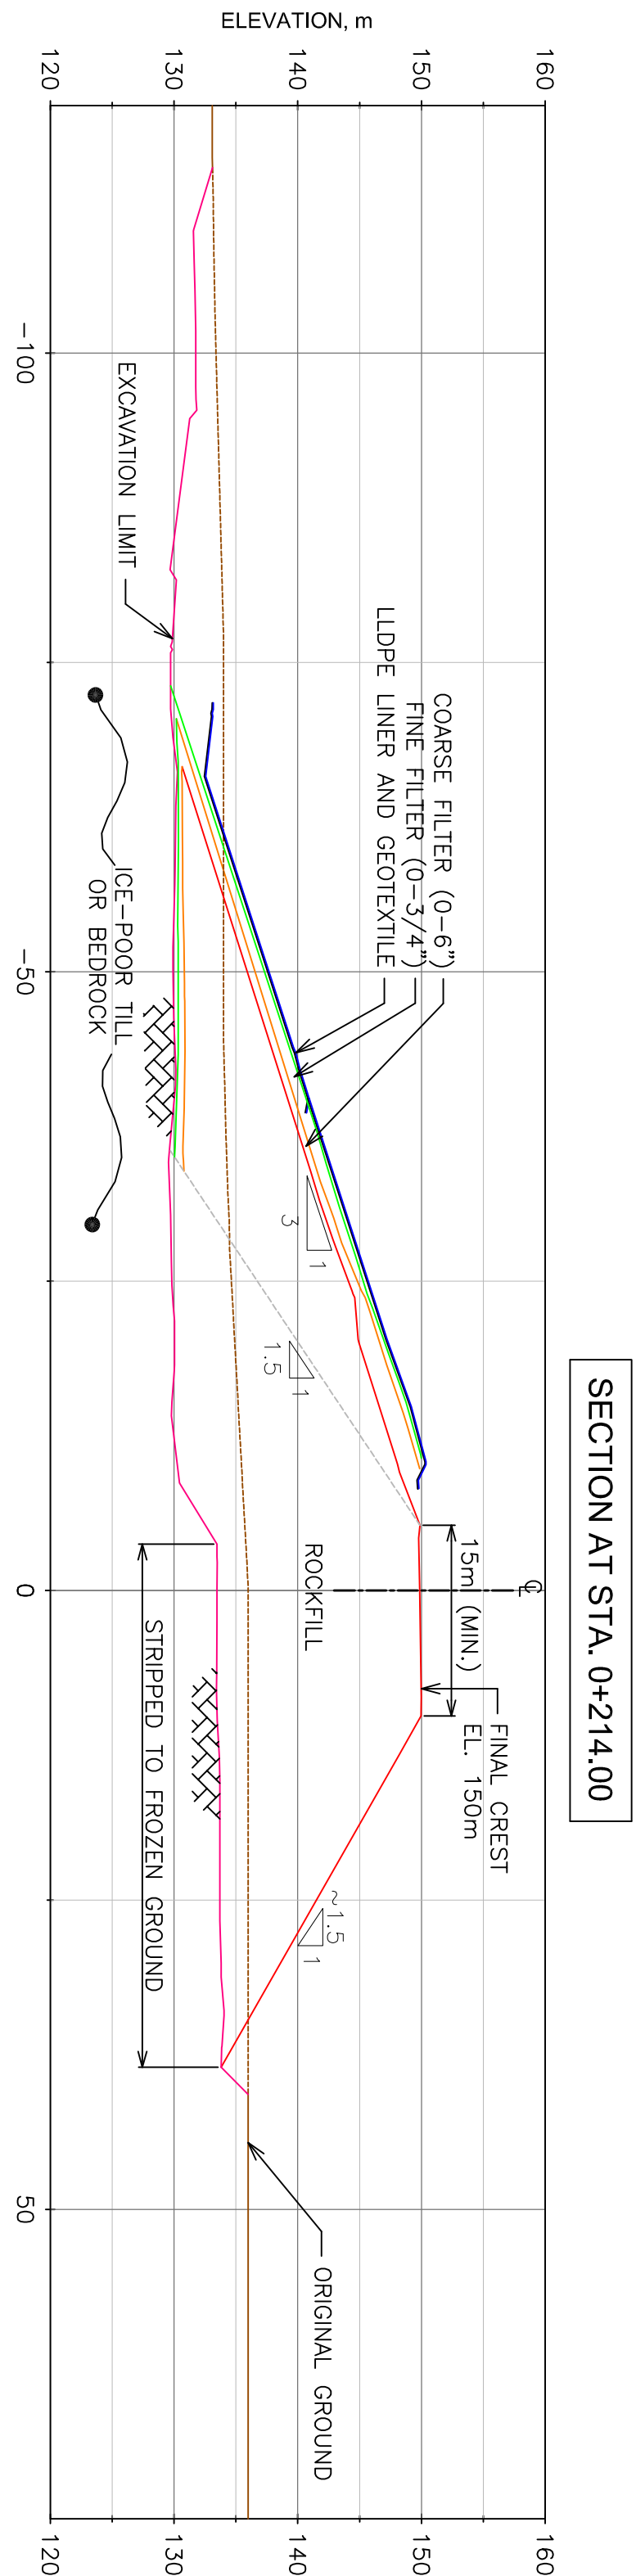

- LEGEND
- FINE FILTER
  - COARSE FILTER
  - BEDROCK
  - FOUNDATION
  - LINER
  - GEOTEXTILE
  - ORIGINAL GROUND
  - ROCKFILL
  - TILL

