


Saddle Dam 2 – As Built Drawings

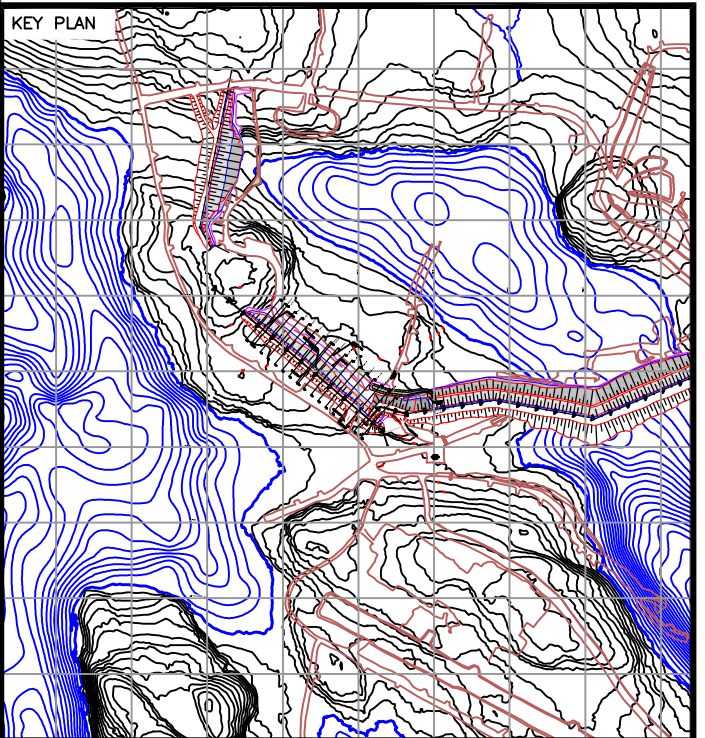

GENERAL NOTES

LEGEND:

-  LINER COVER 2010
 LINER COVER 2009
 LINER COVER TO BE COMPLETED
 COFFERDAM
 CREST / TOE LINE
 EXTENT OF TILL
 ROADS

THE INFORMATION HERE ON IS THE PROPERTY OF AGNICO-EAGLE LTD. AND MUST BE RETURNED UPON REQUEST. WITHOUT WRITTEN PERMIT NO COPYING TRANSMITTAL TO OTHERS AND ANY USE EXCEPT THAT FOR WHICH IT IS ISSUED ARE PROHIBITED. © AGNICO-EAGLE LTD.

TITLE	# DWG

REFERENCE DRAWINGS

PY	DATE	DESCRIPTION	BK	LBB	CUSP

REVISIONS



FILE
AGNICO-EAGLE - MEADOWBANK DIVISION
SADDLE DAM 2
PLAN
AS BUILT 2010

RAWN BY	K. Moloquine	DATE	2010/09
---------	--------------	------	---------

CHECKED BY	Y.Jalbert
------------	-----------


APPROVED BY	Y.Jalbert
-------------	-----------

SCALE	AS SHOWN	DATE
-------	----------	------

DRAWING NO.

PROJECT NO.	REVISION	SHEET

 $\frac{1}{1}$

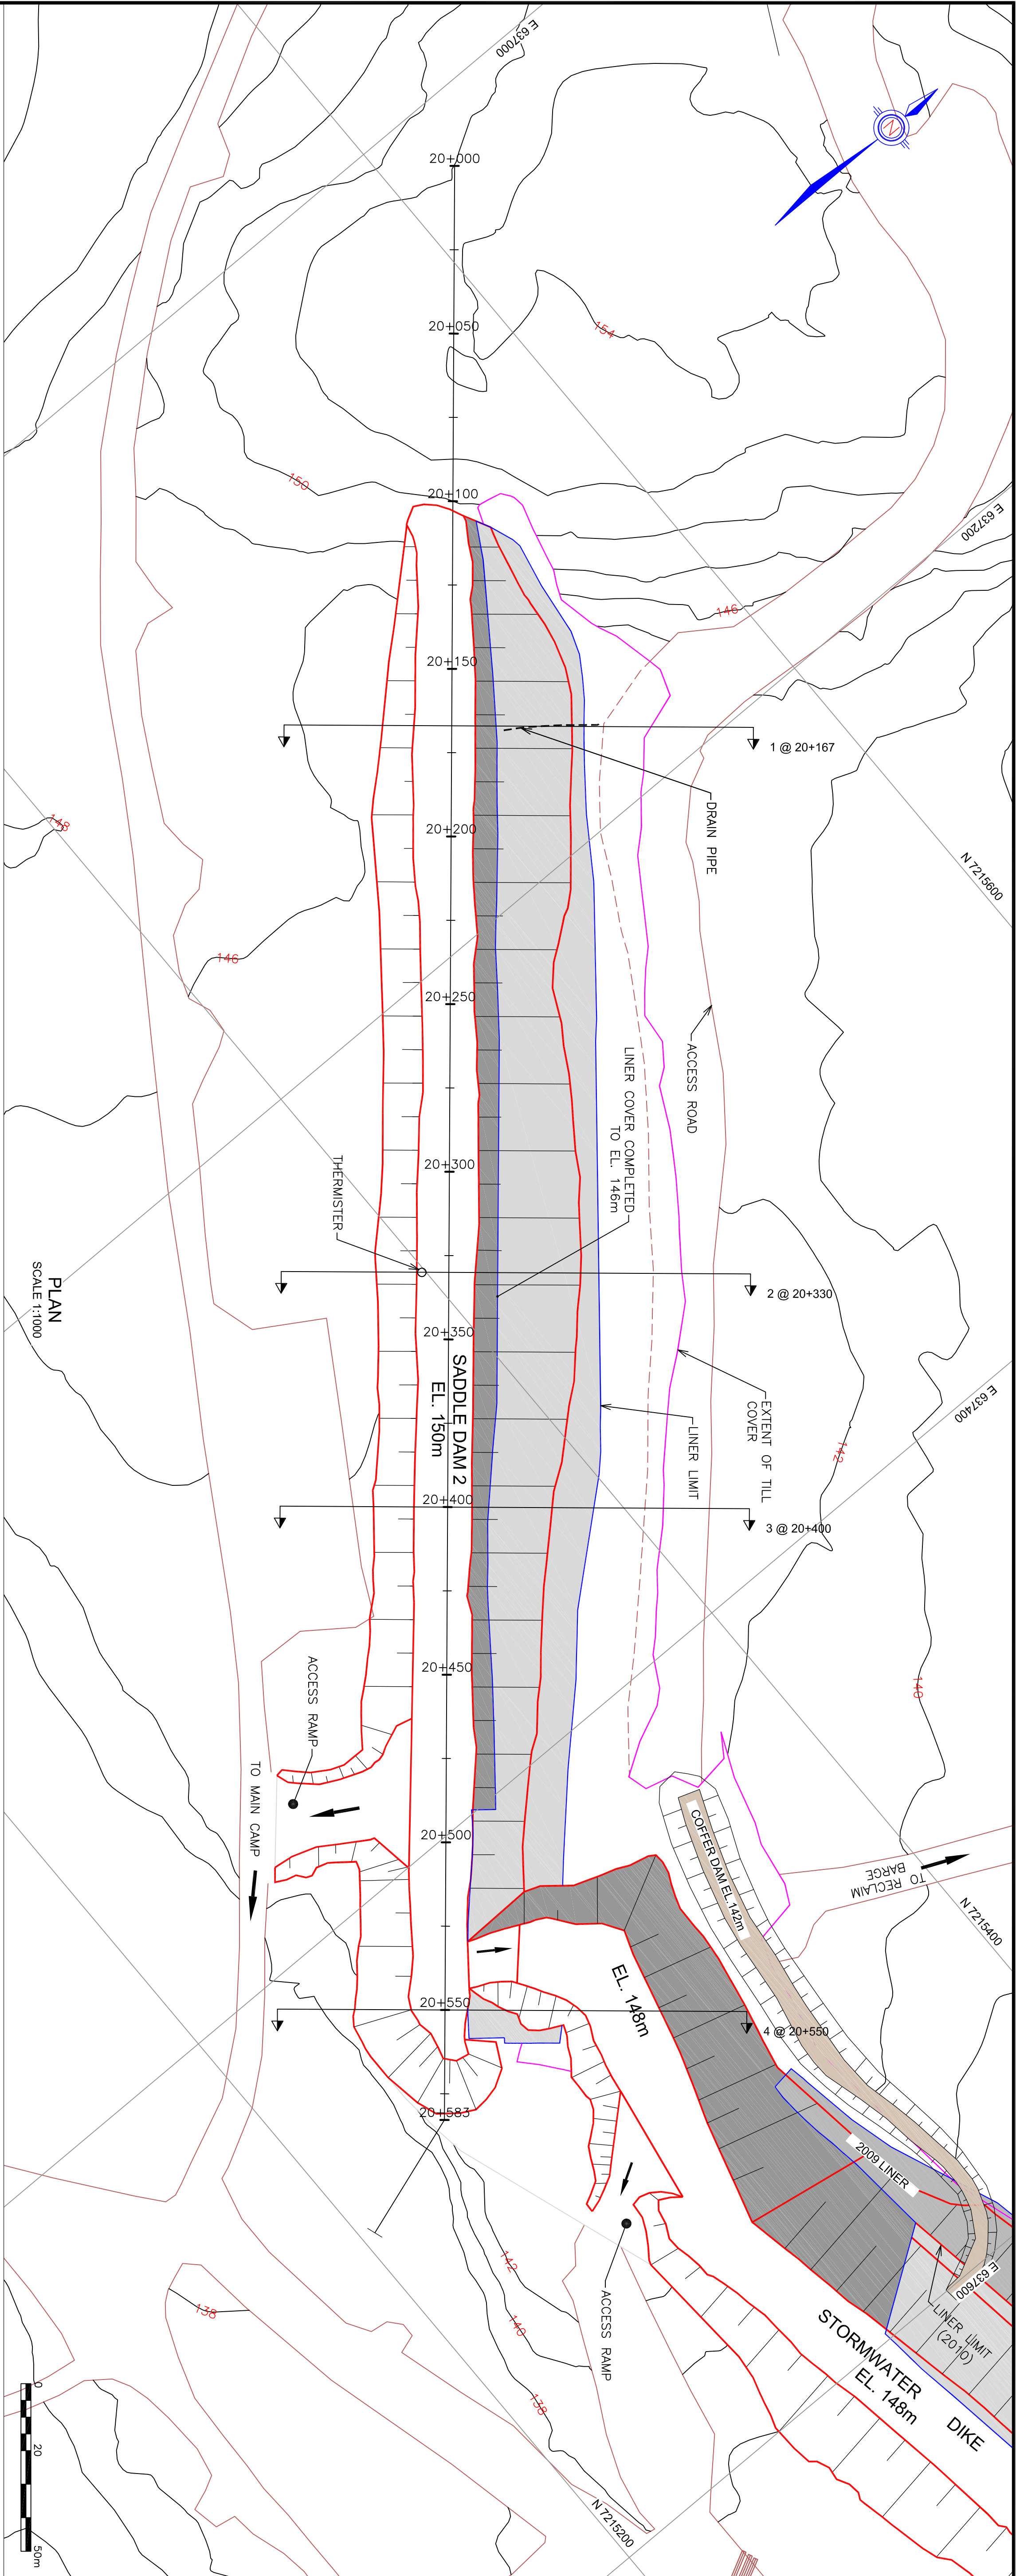

PLAN
SCALE 1:1000



- FOR SECTIONS:
- FINE FILTER
 - COARSE FILTER
 - BEDROCK
 - FOUNDATION
 - LINER
 - GEOTEXTILE
 - ORIGINAL GROUND
 - ROCKFILL
 - TILL
- LEGEND:
- LINER COVER 2010
 - LINER COVER 2009
 - LINER COVER TO BE COMPLETED
 - COFFERDAM
 - CREST / TOE LINE
 - EXTENT OF TILL
 - ROADS

REVISIONS

REV.	DATE	DESCRIPTION	BY	APP.	CLIENT

REFERENCE DRAWINGS

REV.	DATE	DESCRIPTION	BY	APP.	CLIENT


AGNICO-EAGLE
MEADOWBANK DIVISION

TITLE
AGNICO-EAGLE — MEADOWBANK DIVISION
SADDLE DAM 2
PLAN
AS BUILT 2010


DRAWN BY K. Moogline
CHECKED BY V. Jolbert
APPROVED BY V. Jolbert
SCALE AS SHOWN
DATE 2010/09/28

PROJECT NO. REVISION SHEET
1 / 1


SECTION AT STA. 20+167.00

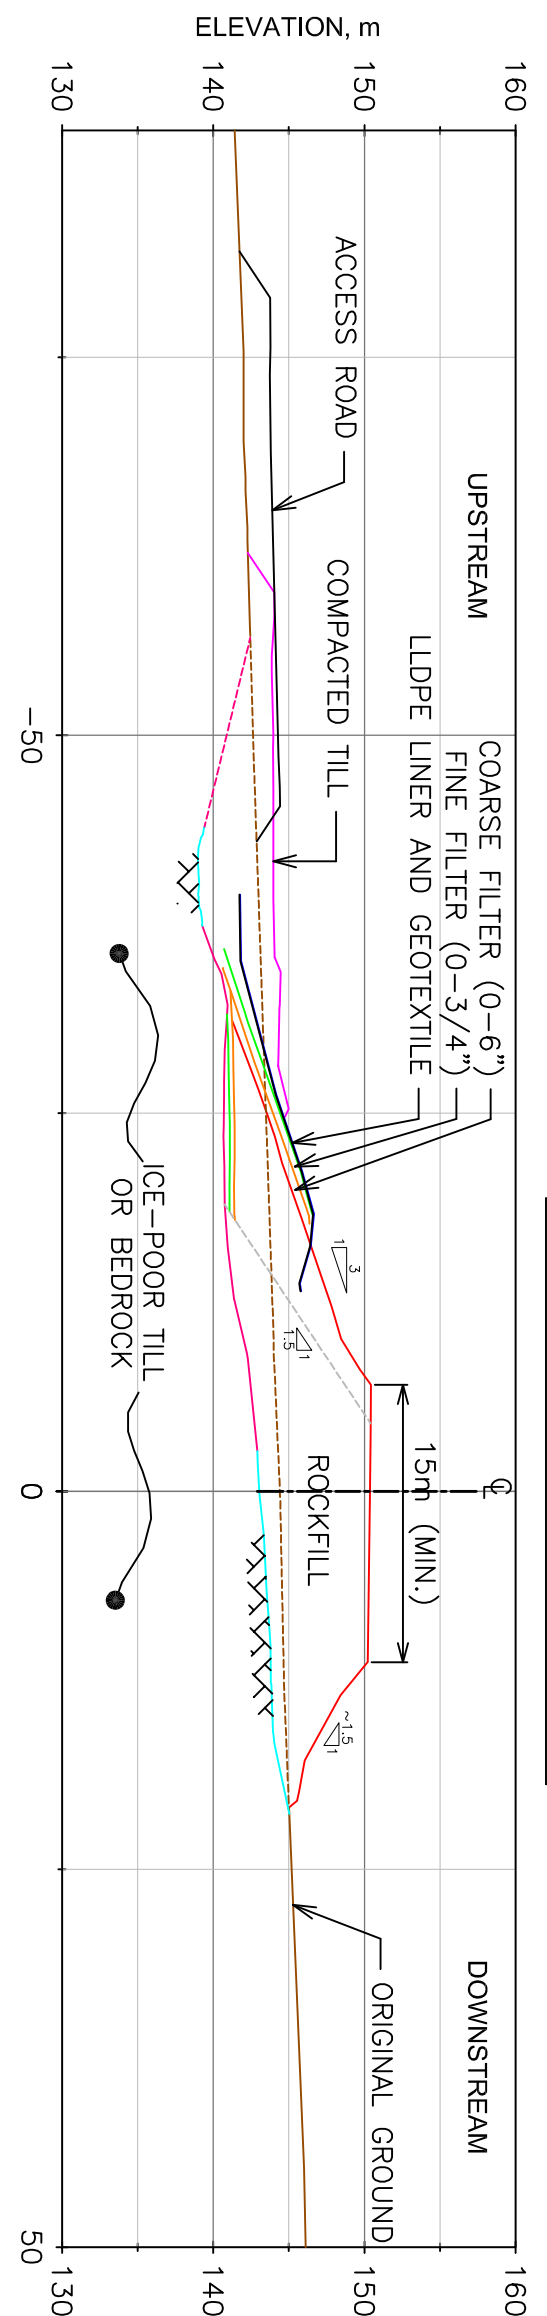


SECTION AT STA. 20+400.00

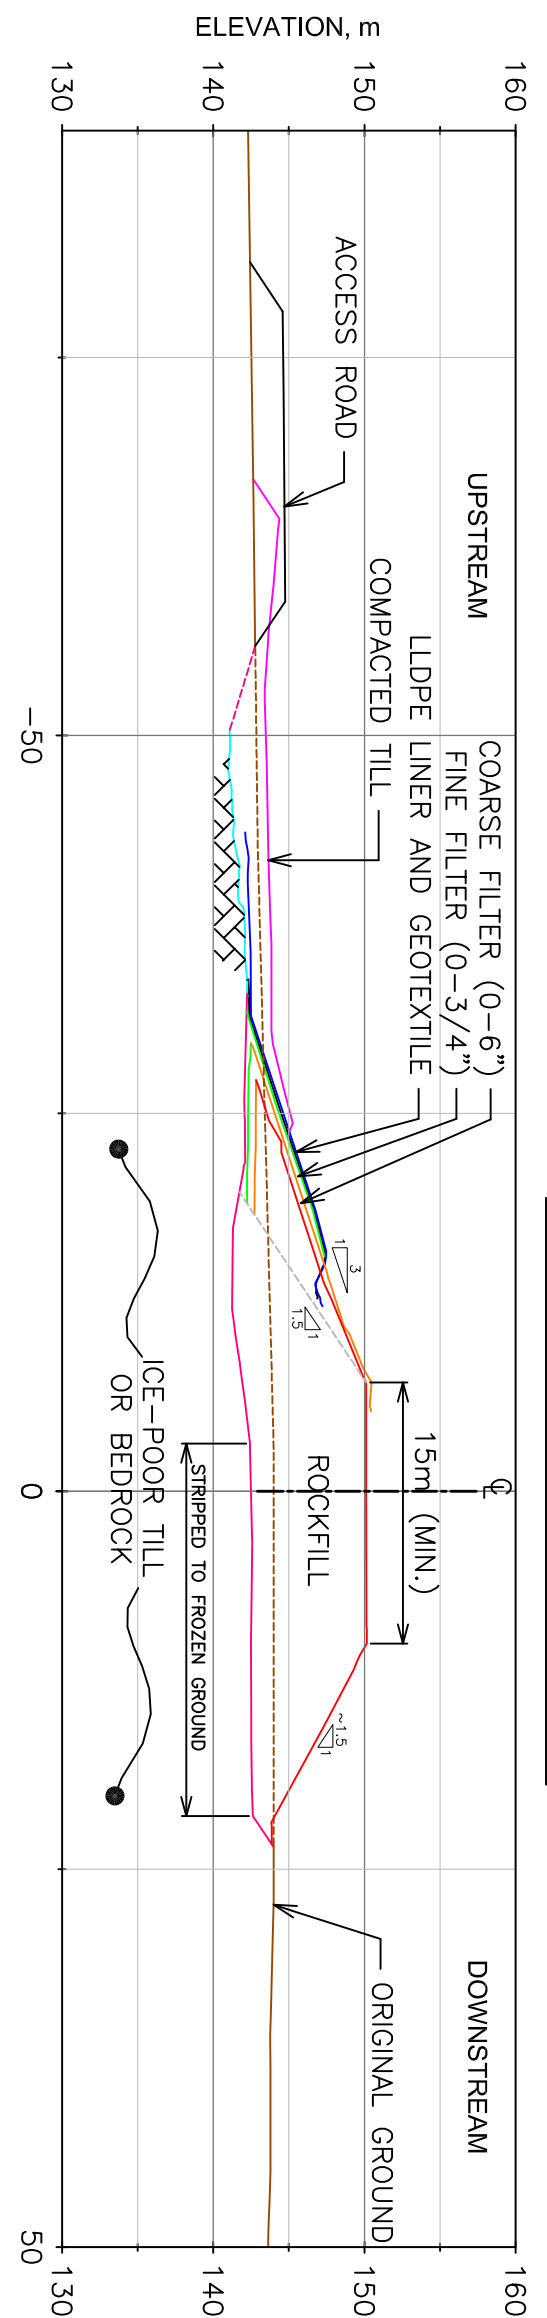


SECTION AT STA. 20+550.00

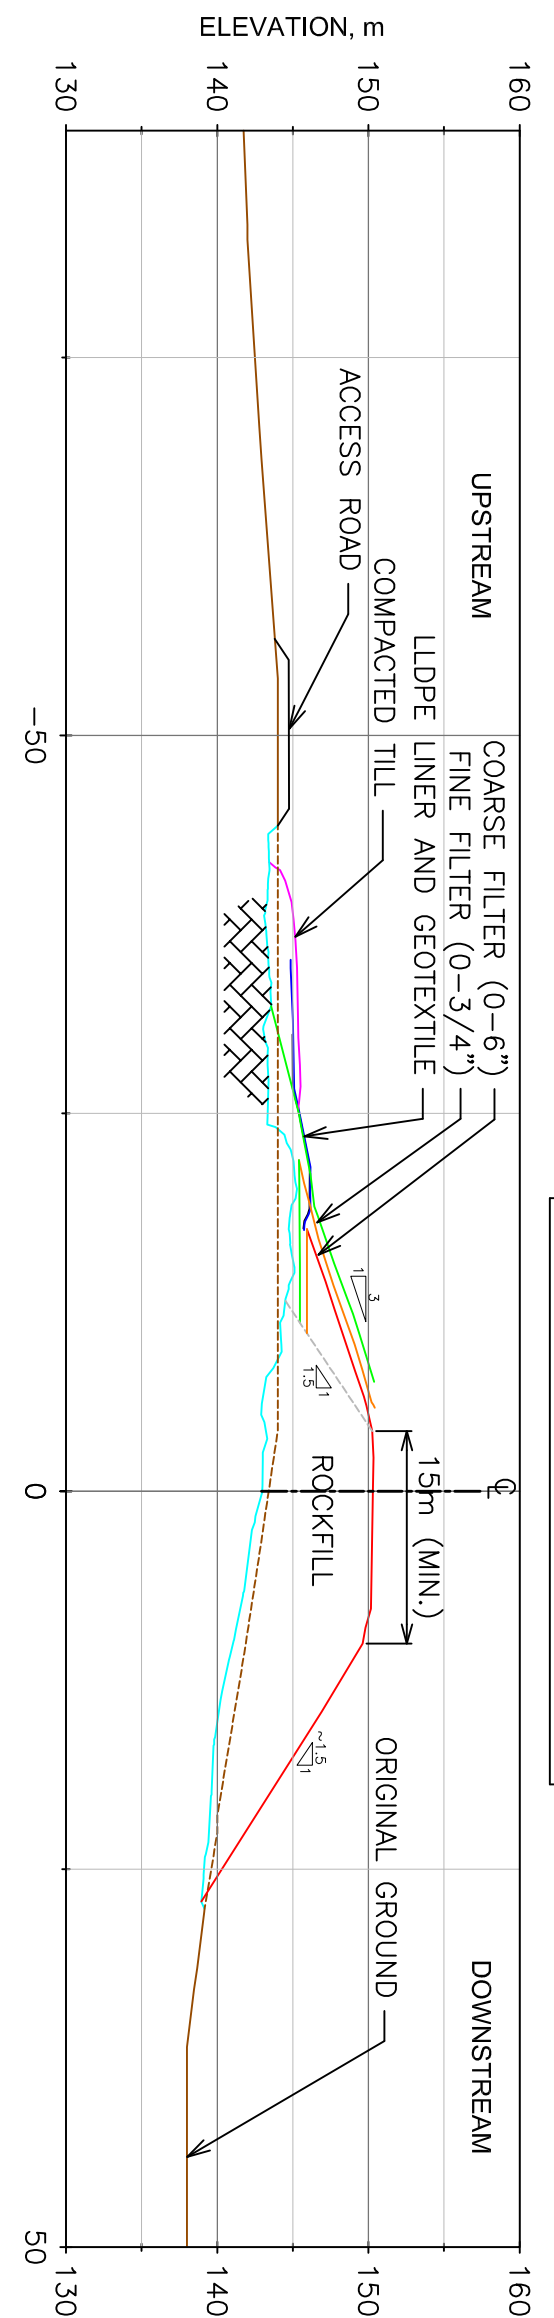


SECTION AT STA. 20+330.00

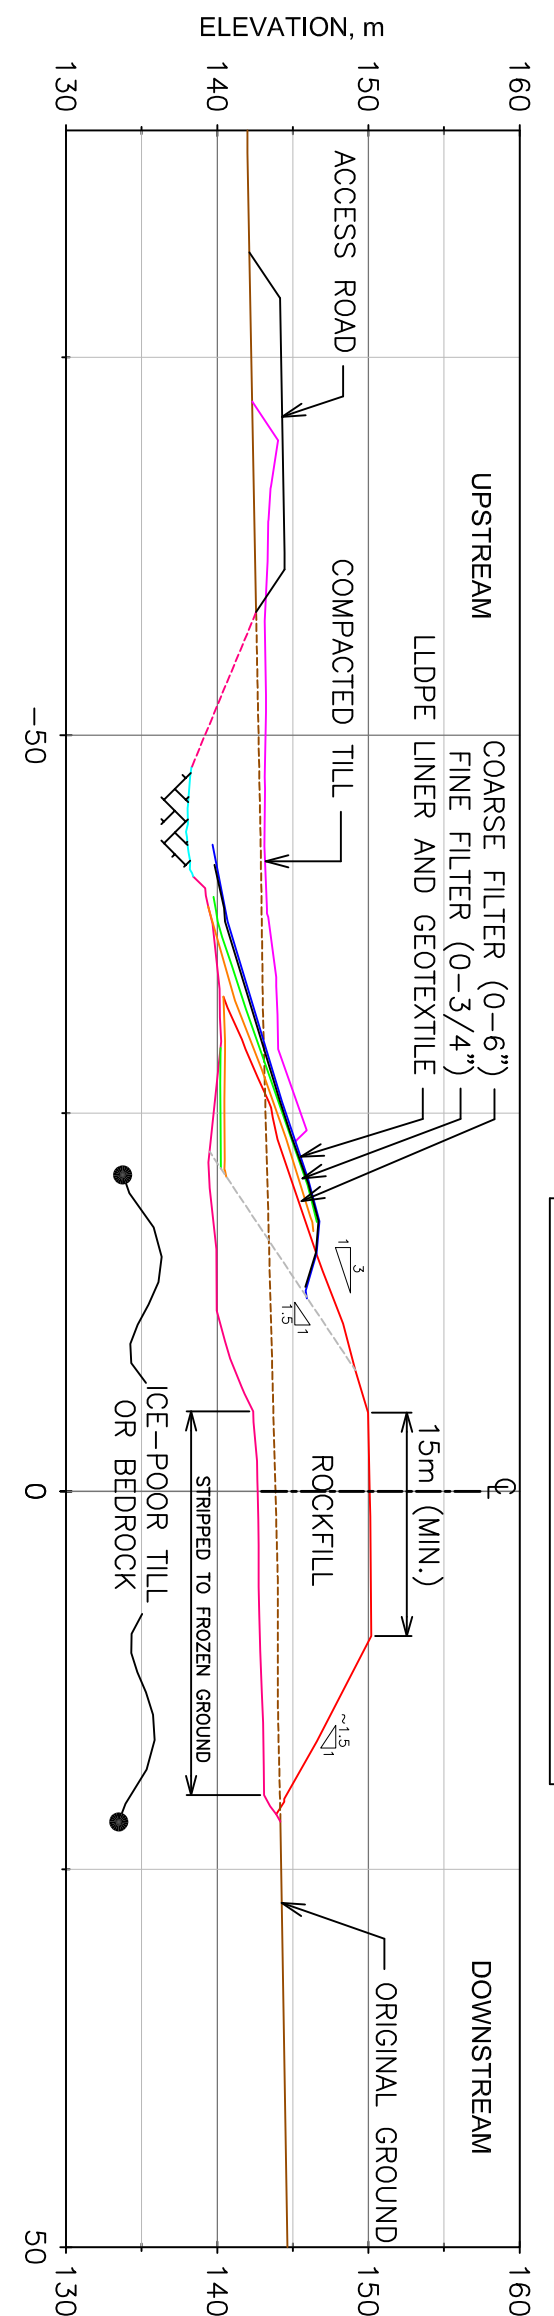

SECTIONS
SCALE 1:500

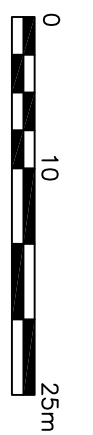

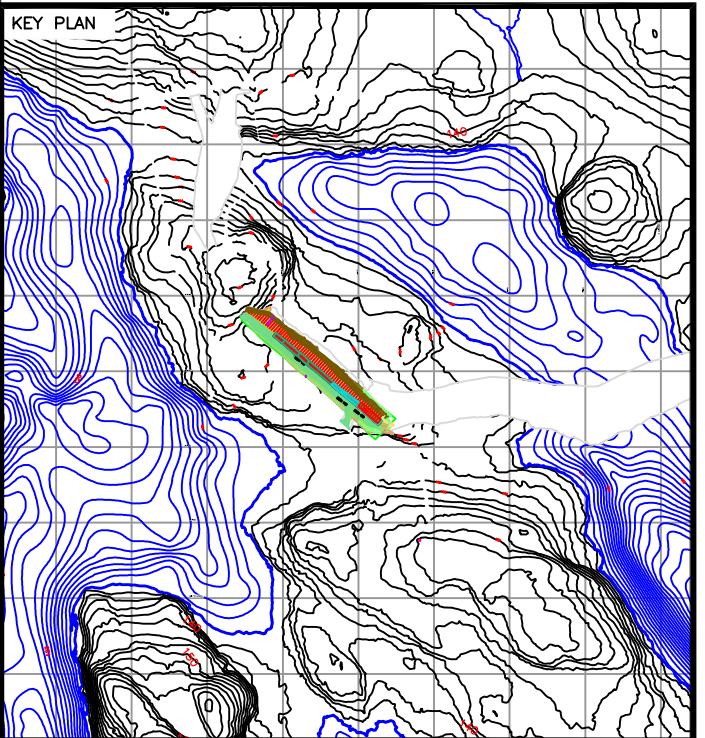

GENERAL NOTES

LEGEND

- FINE FILTER
- COARSE FILTER
- BEDROCK
- FOUNDATION
- LINER
- GEOTEXTILE
- ORIGINAL GROUND
- ROCKFILL
- TILL

ALL INFORMATION HEREIN IS THE PROPERTY OF AGNICO-EAGLE LTD. AND MUST BE RETURNED UPON REQUEST. REPEAT WRITER PERMISSION AND COPYING TRANSMITTAL TO OTHERS AND ANY USE EXCEPT THAT FOR WHICH IT IS ISSUED ARE PROHIBITED. © AGNICO-EAGLE LTD.

TITLE	# DWG

REFERENCE DRAWINGS

REV.	DATE	DESCRIPTION	BY	APP.	CLIENT

REVISIONS



TITLE
AGNICO-EAGLE - MEADOWBANK DIVISION
SADDLE DAM 2
SECTIONS
AS BUILT 2010

DRAWN BY K. Mologuine DATE 2010/09/28

CHECKED BY Y.Jalbert

APPROVED BY Y.Jalbert

SCALE 1:500 DATE

DRAWING NO.


PROJECT NO.

REVISION


SHEET

1 / 2


SECTION AT STA. 20+150.00

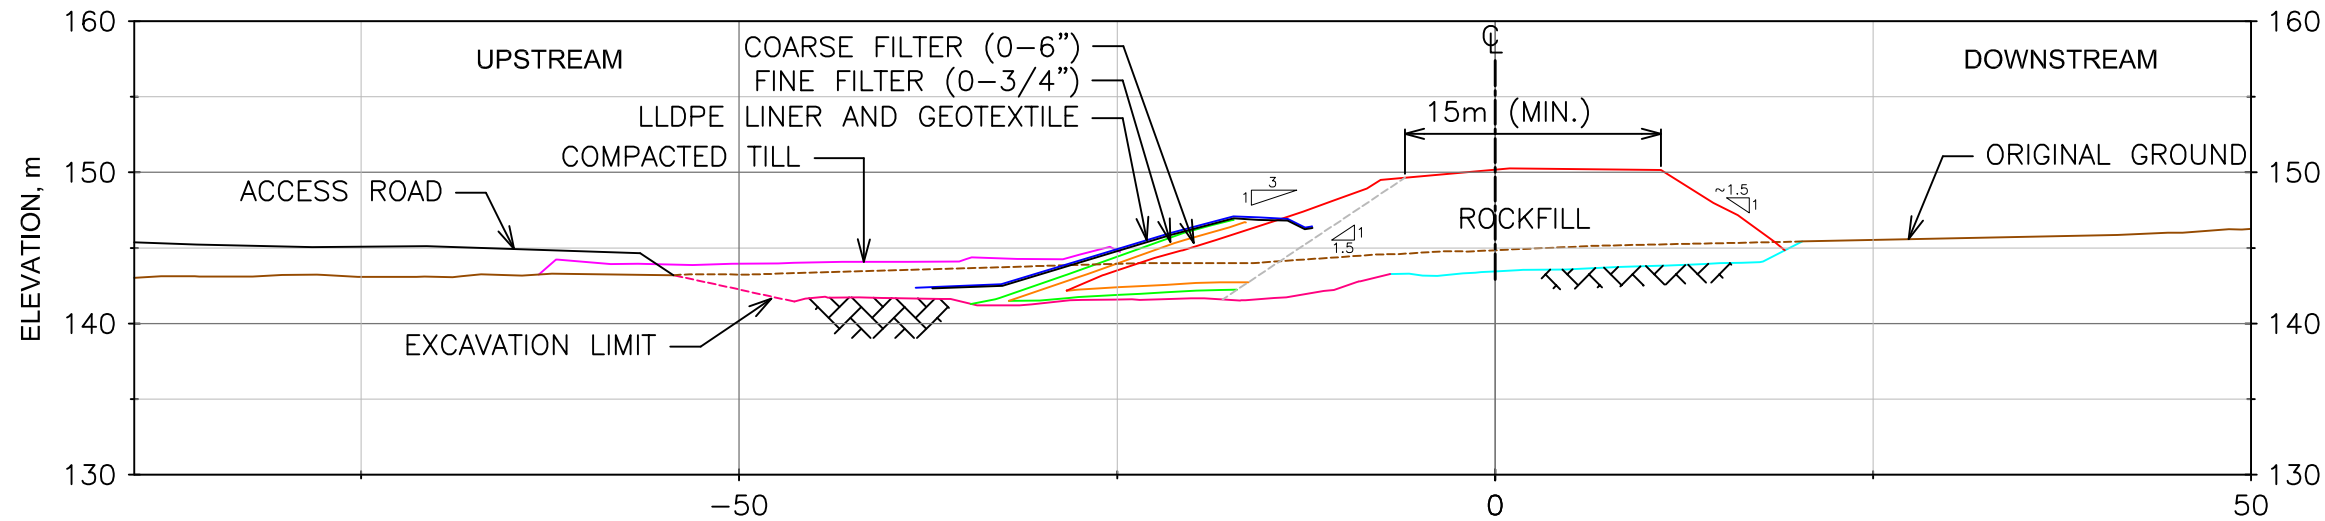


SECTION AT STA. 20+250.00

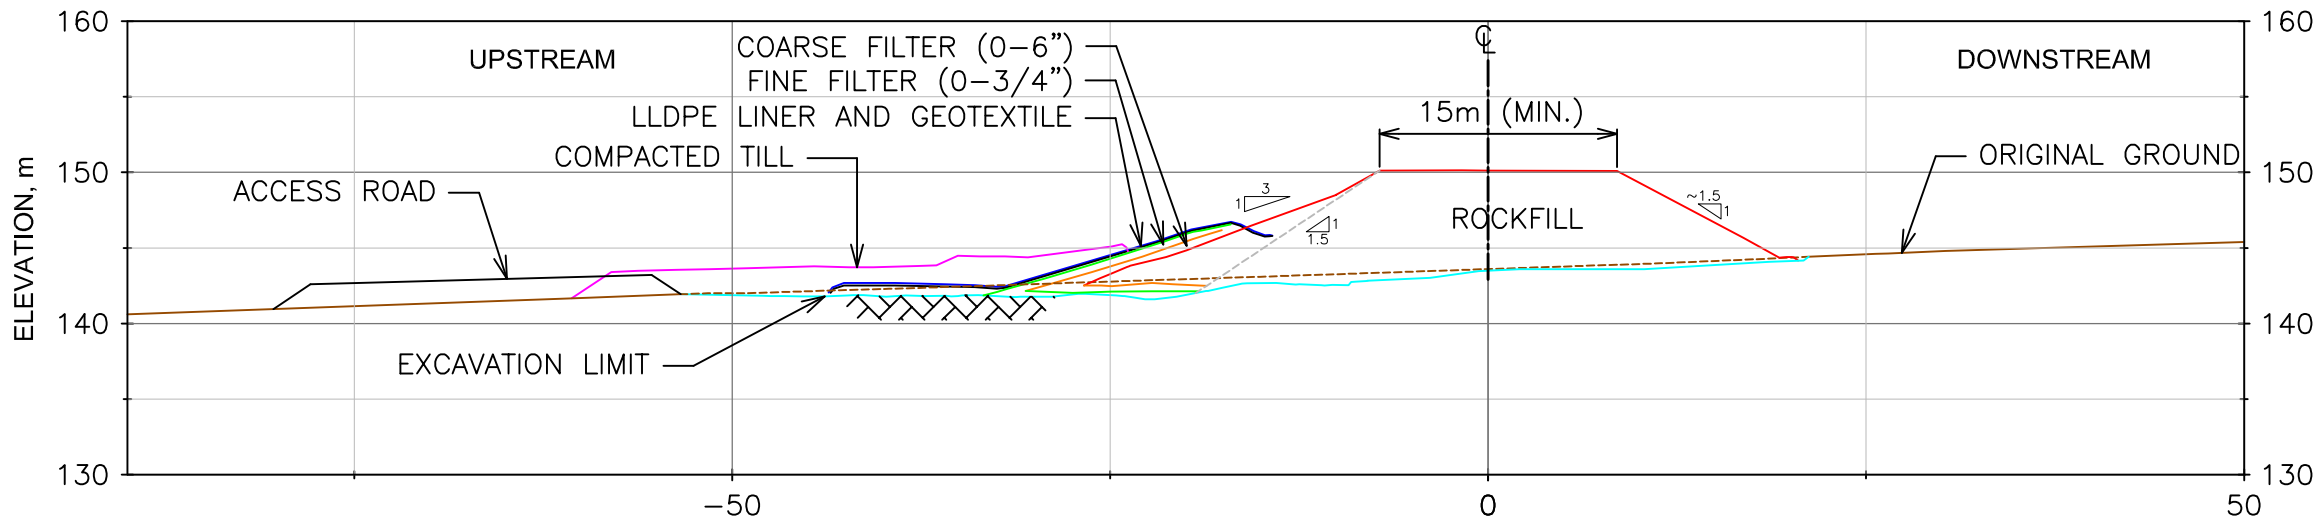


SECTION AT STA. 20+175.00

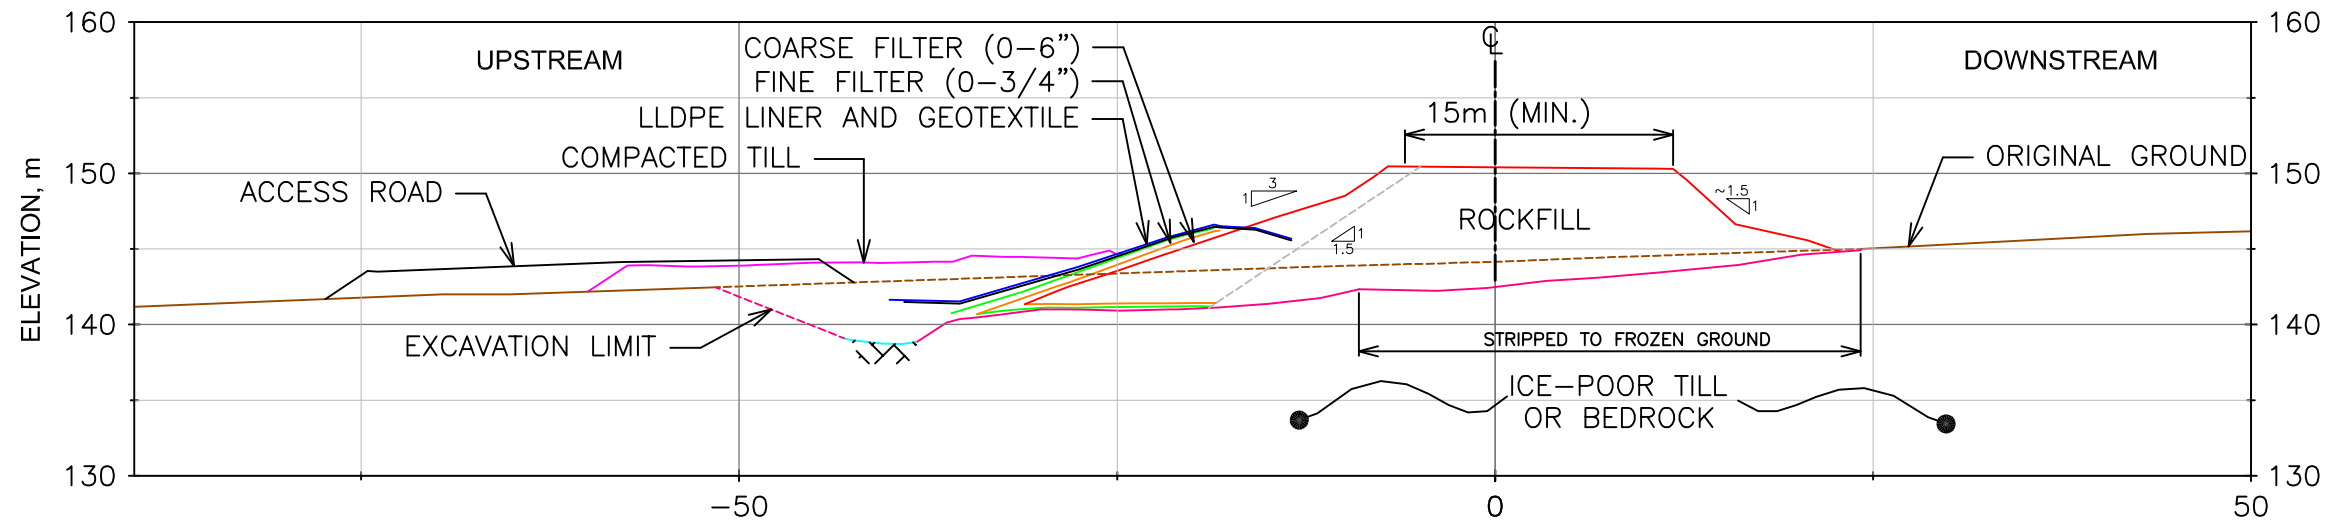


SECTION AT STA. 20+275.00

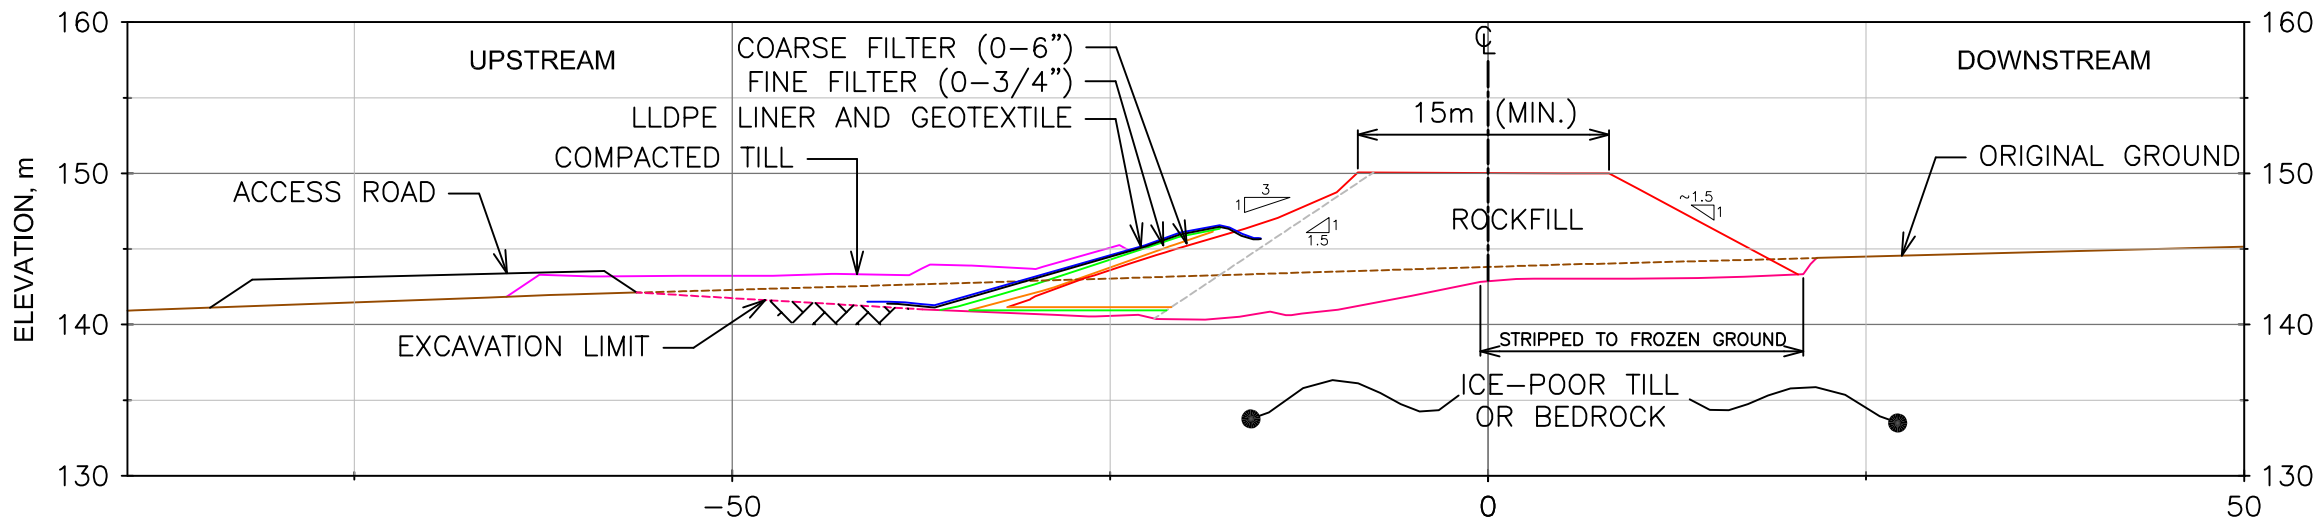


SECTION AT STA. 20+200.00

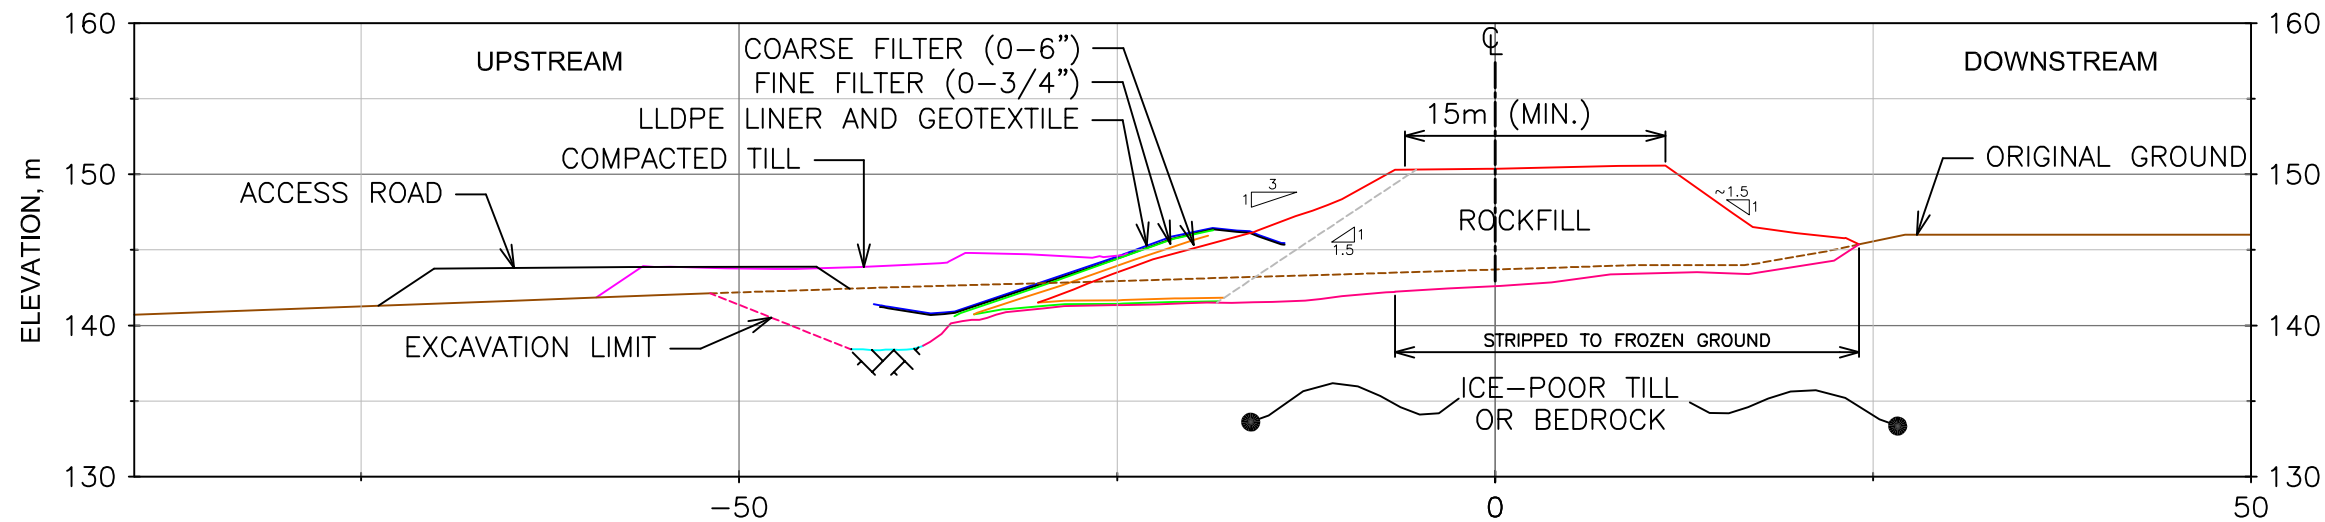


SECTION AT STA. 20+300.00










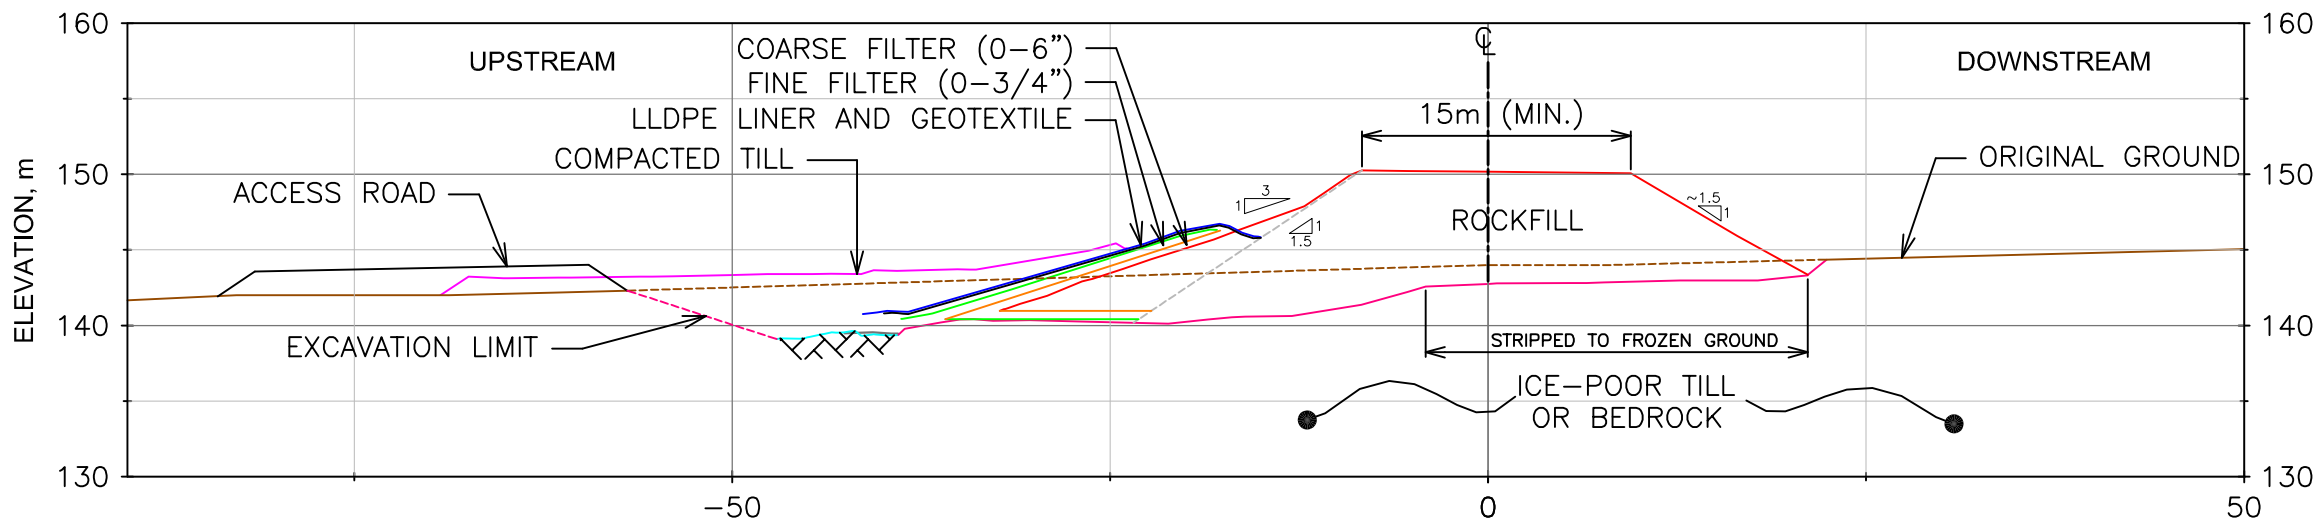


SECTION AT STA. 20+225.00

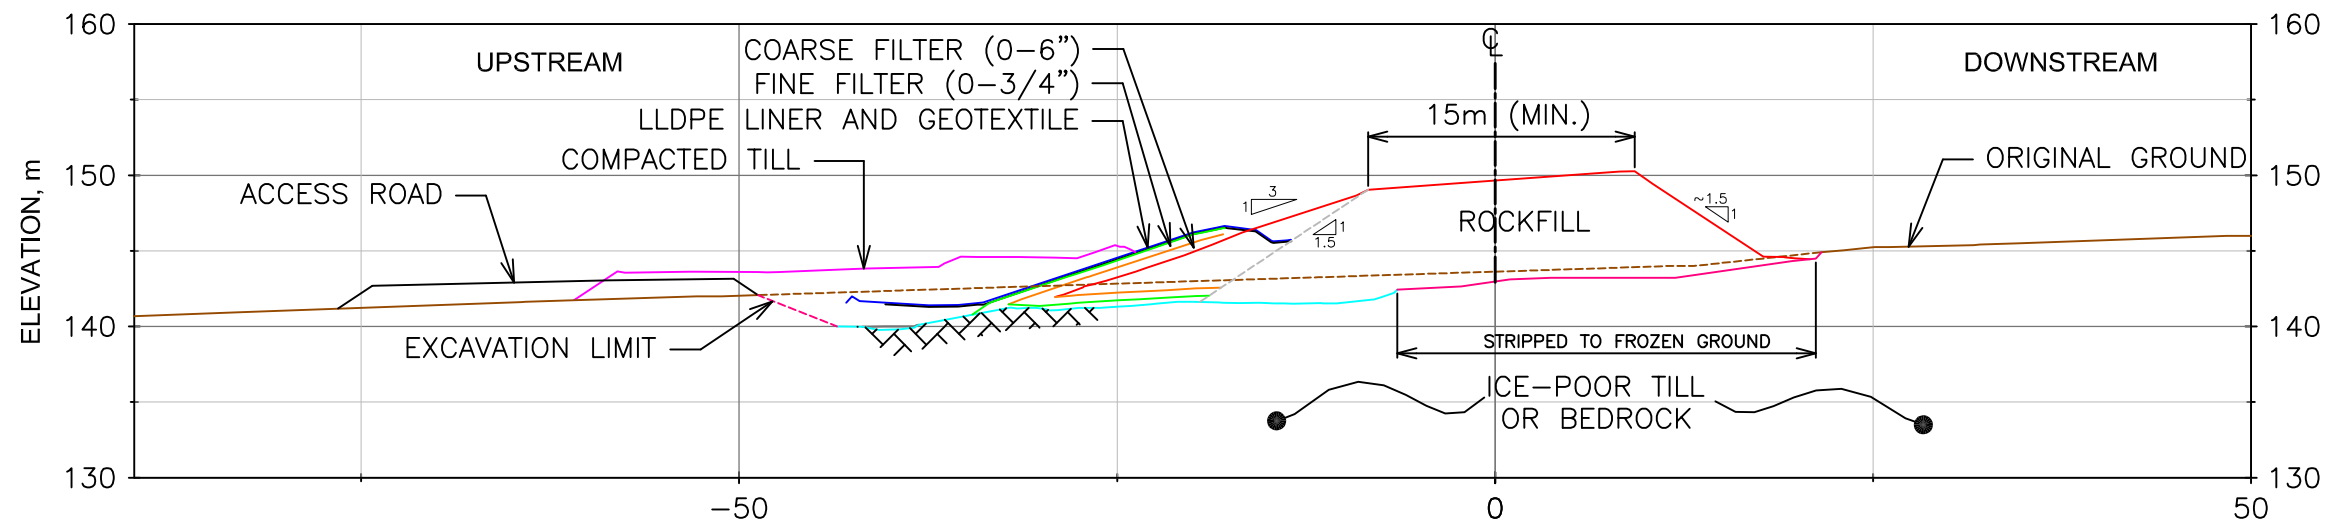

SECTION AT STA. 20+325.00

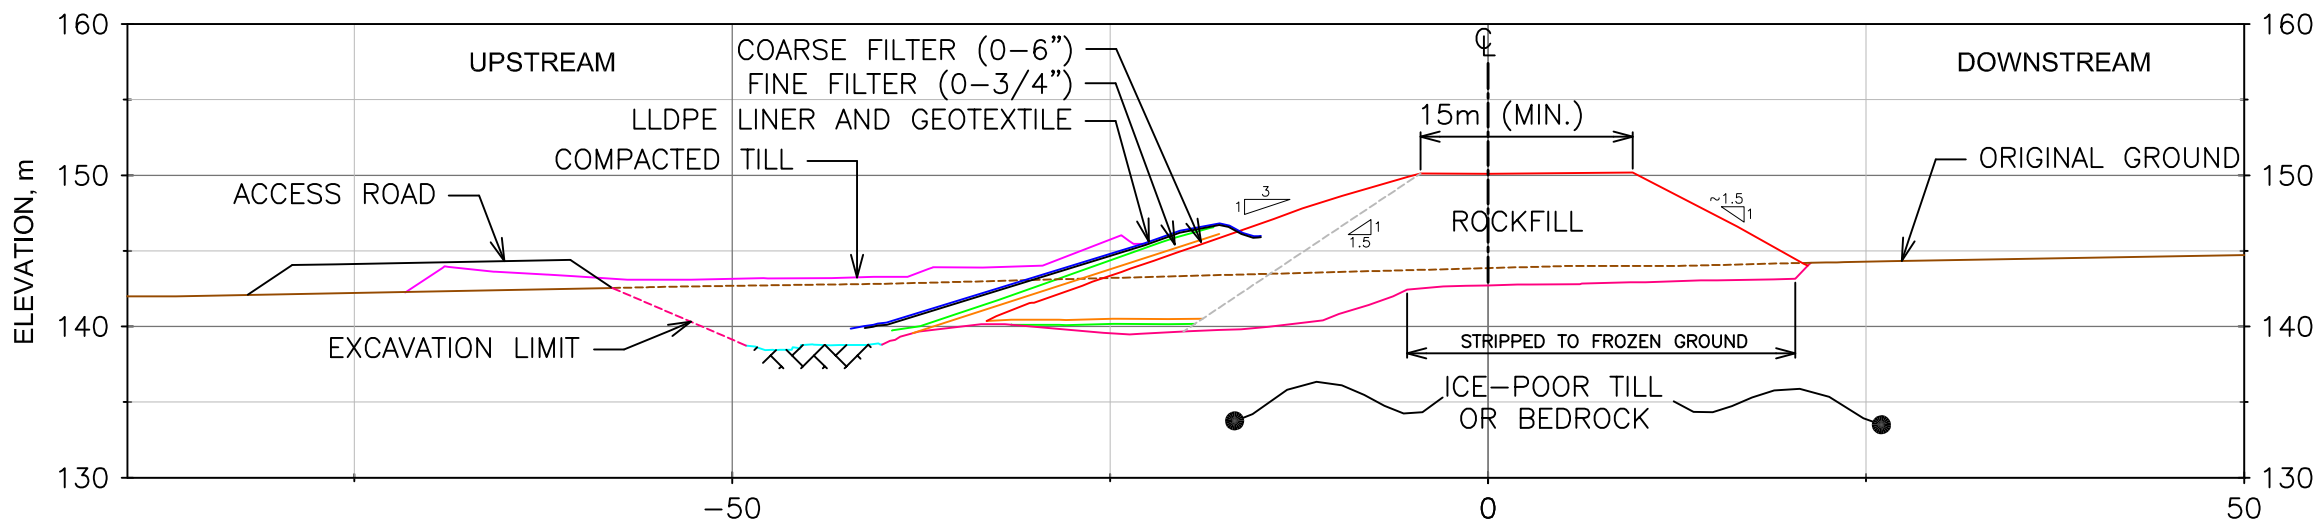

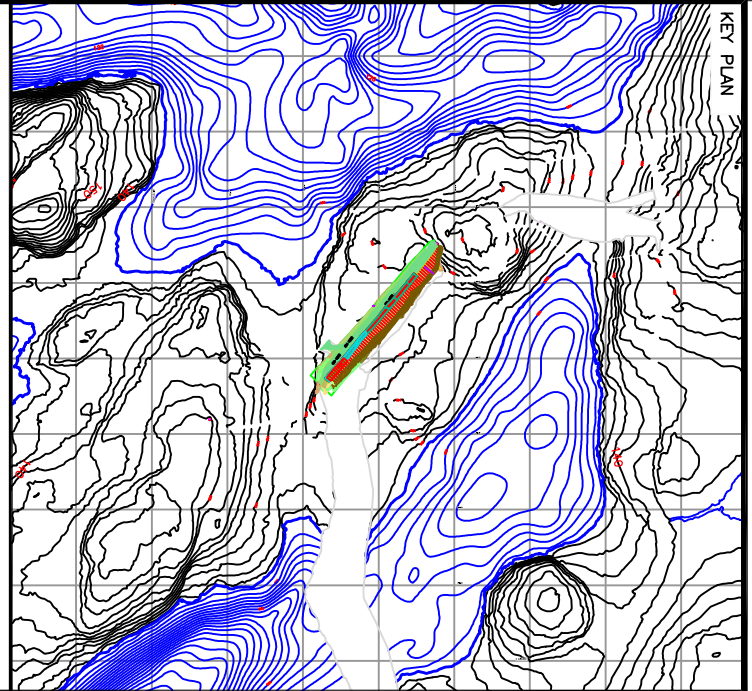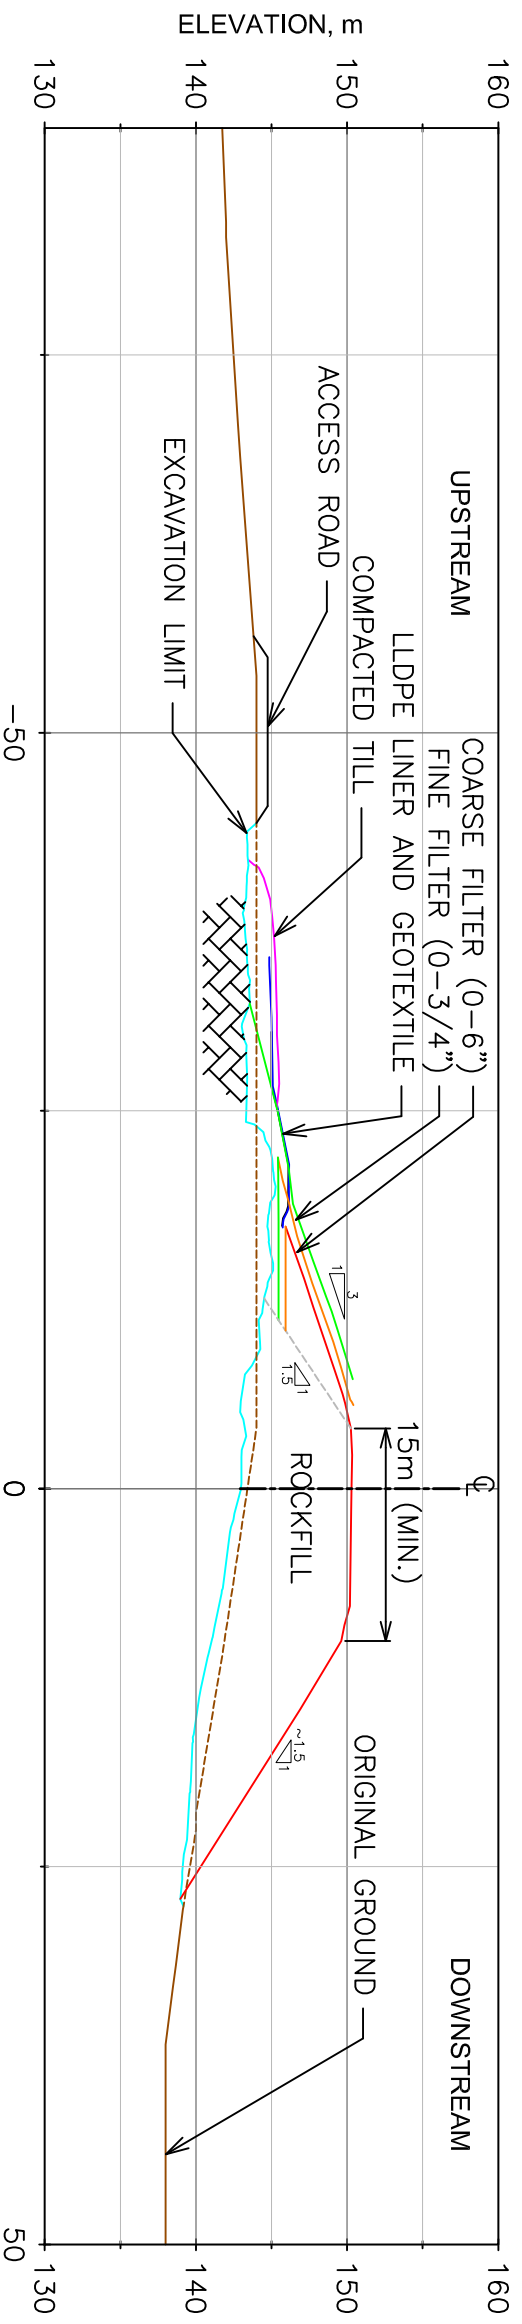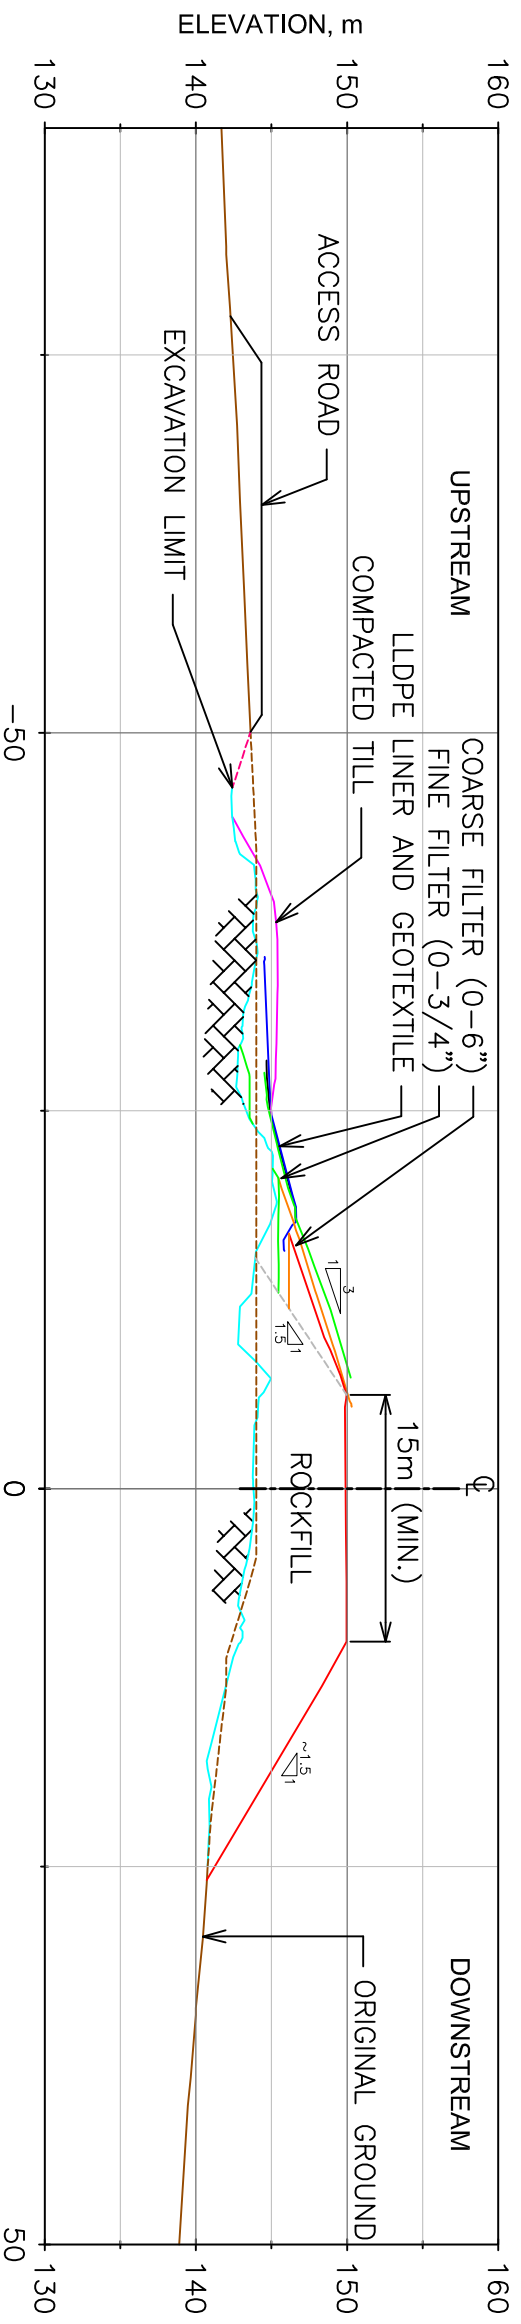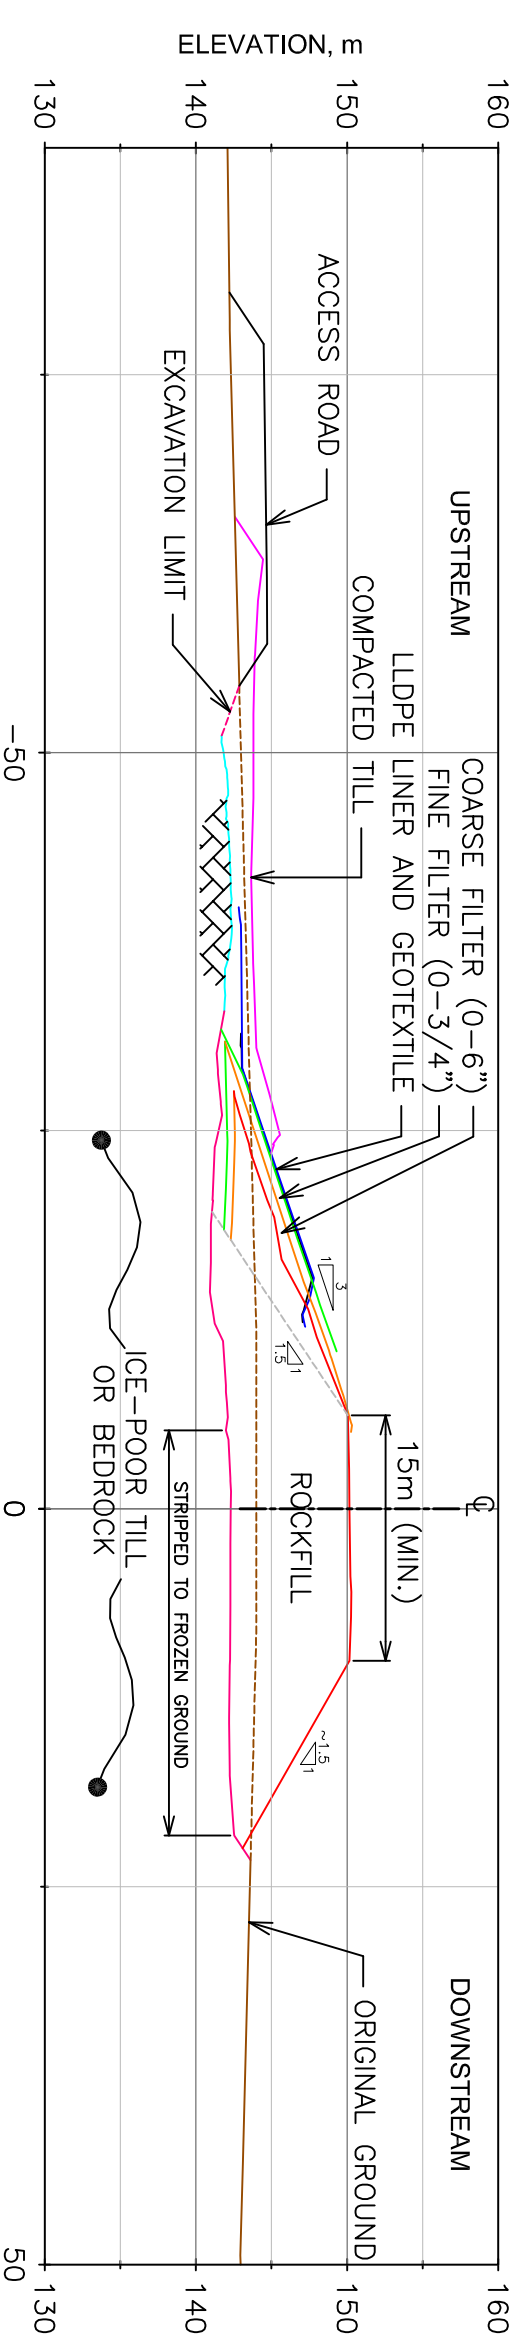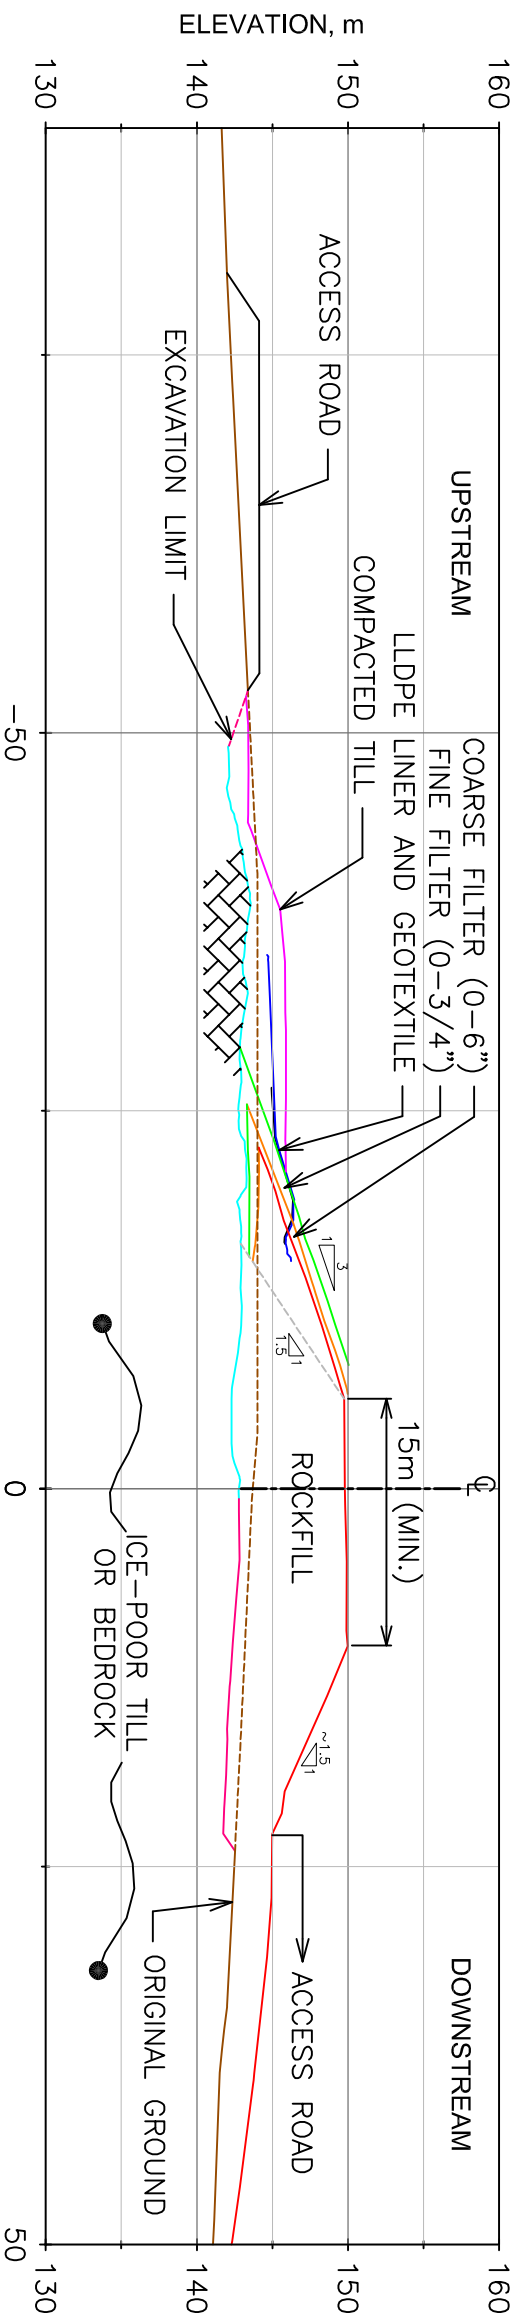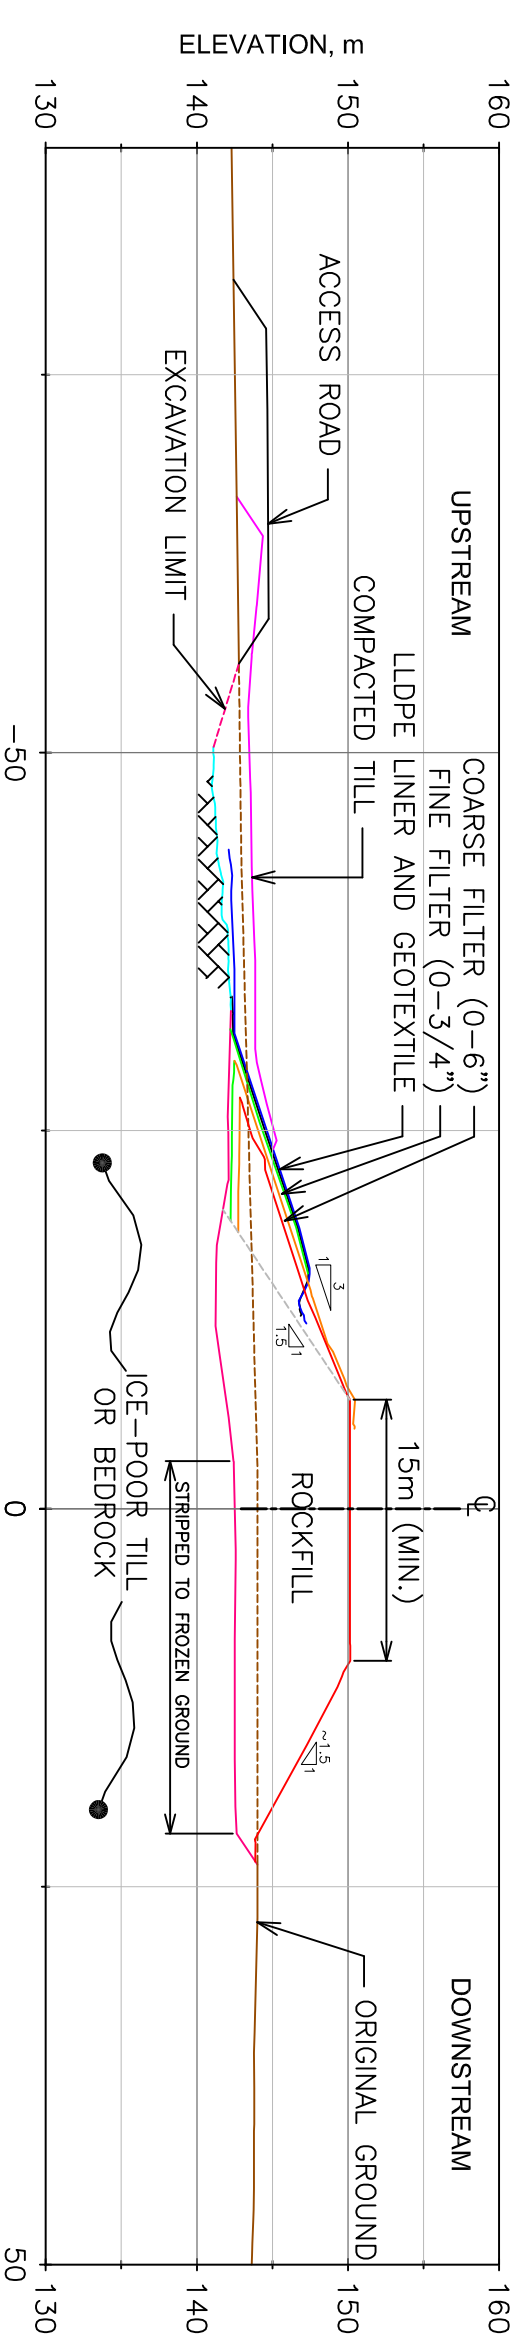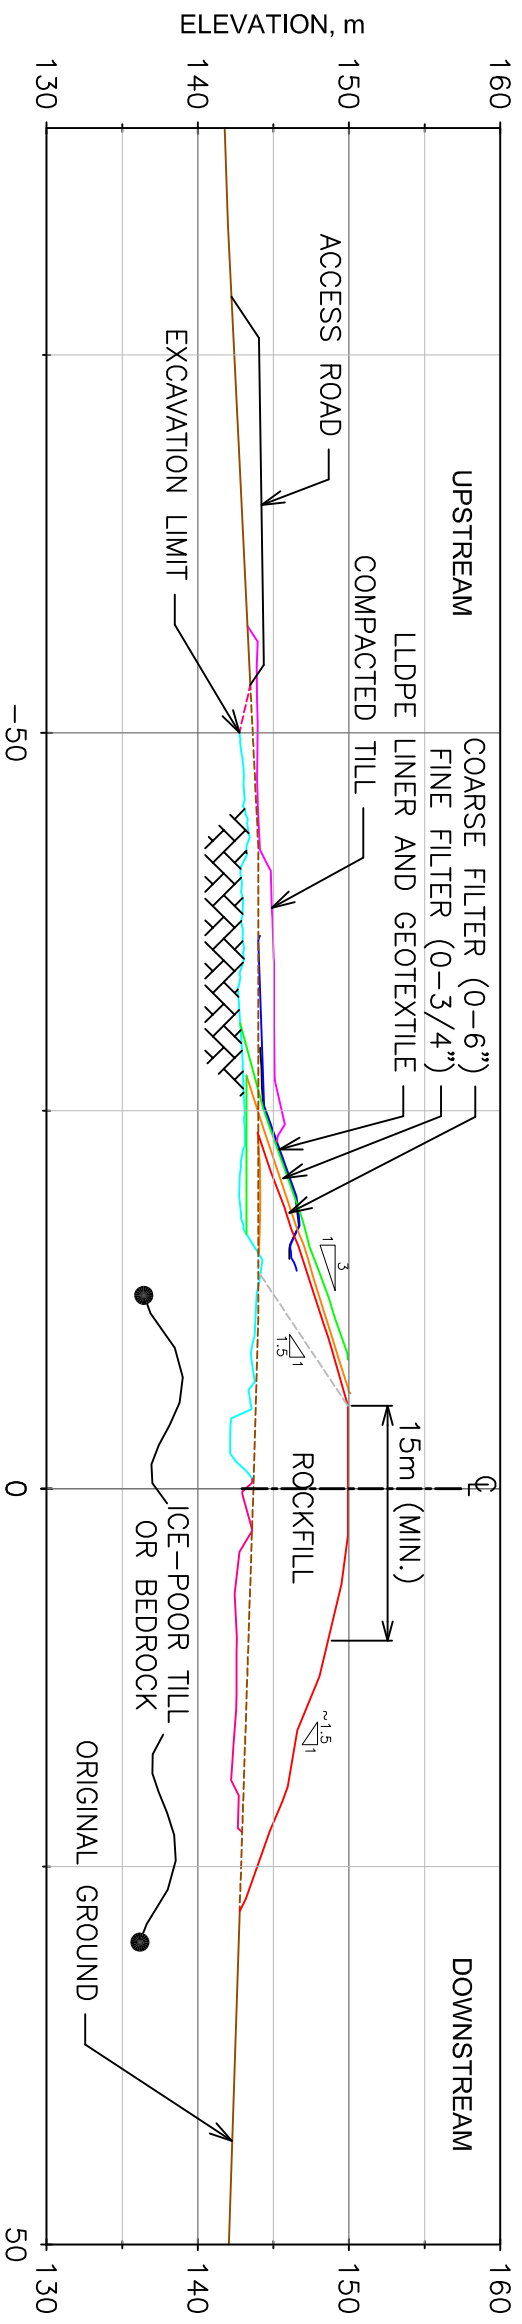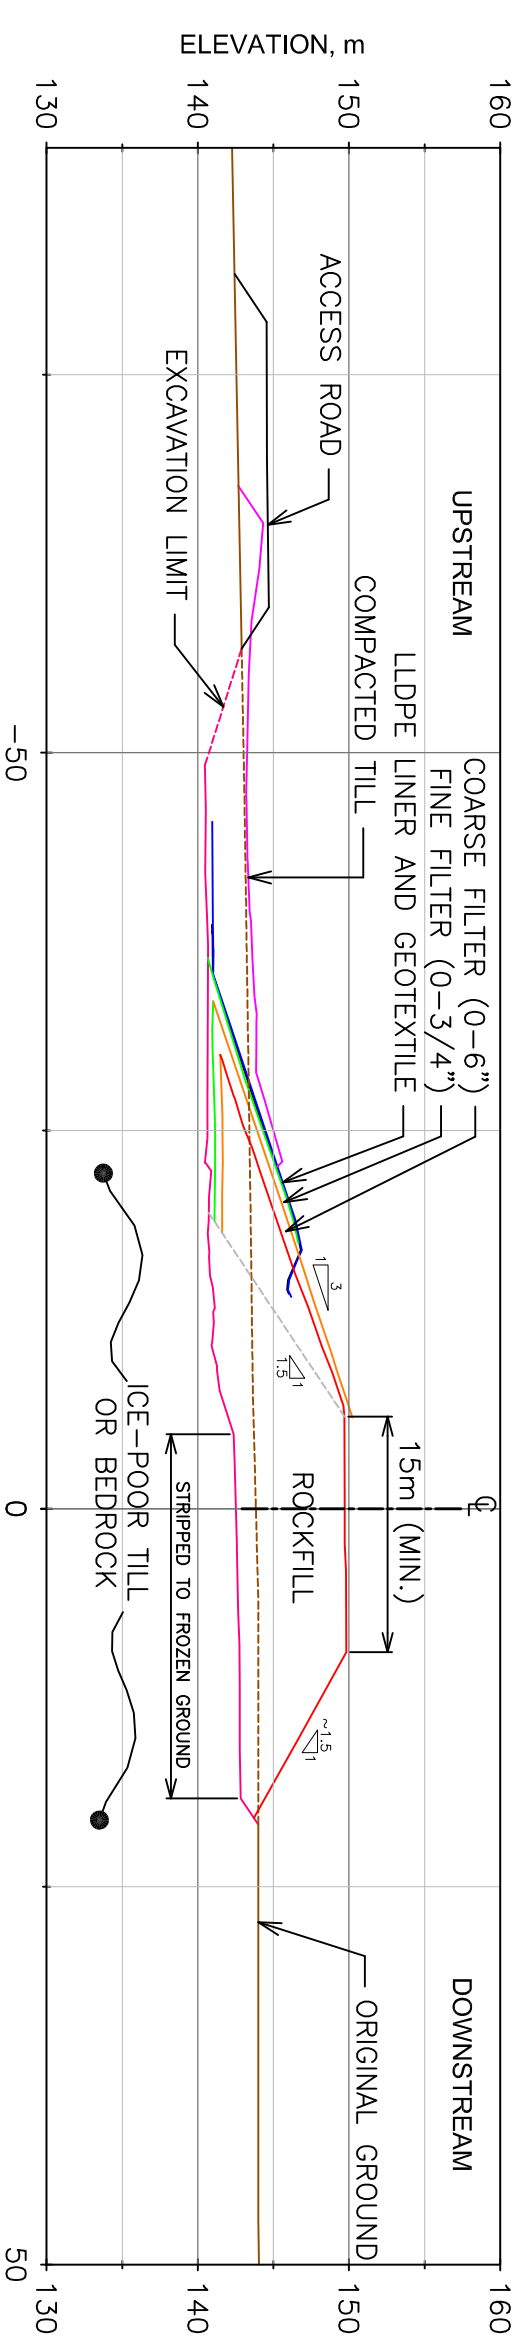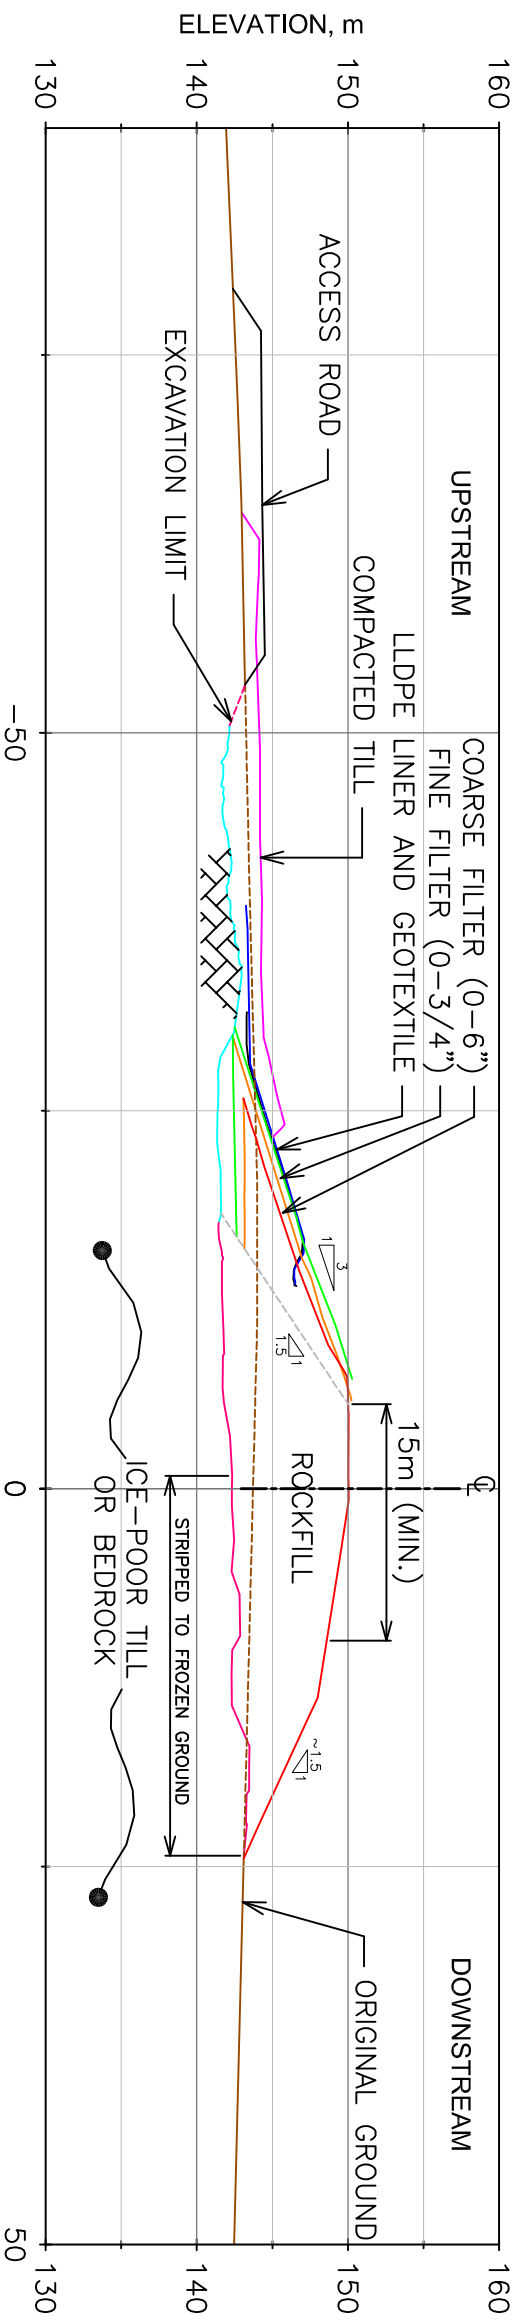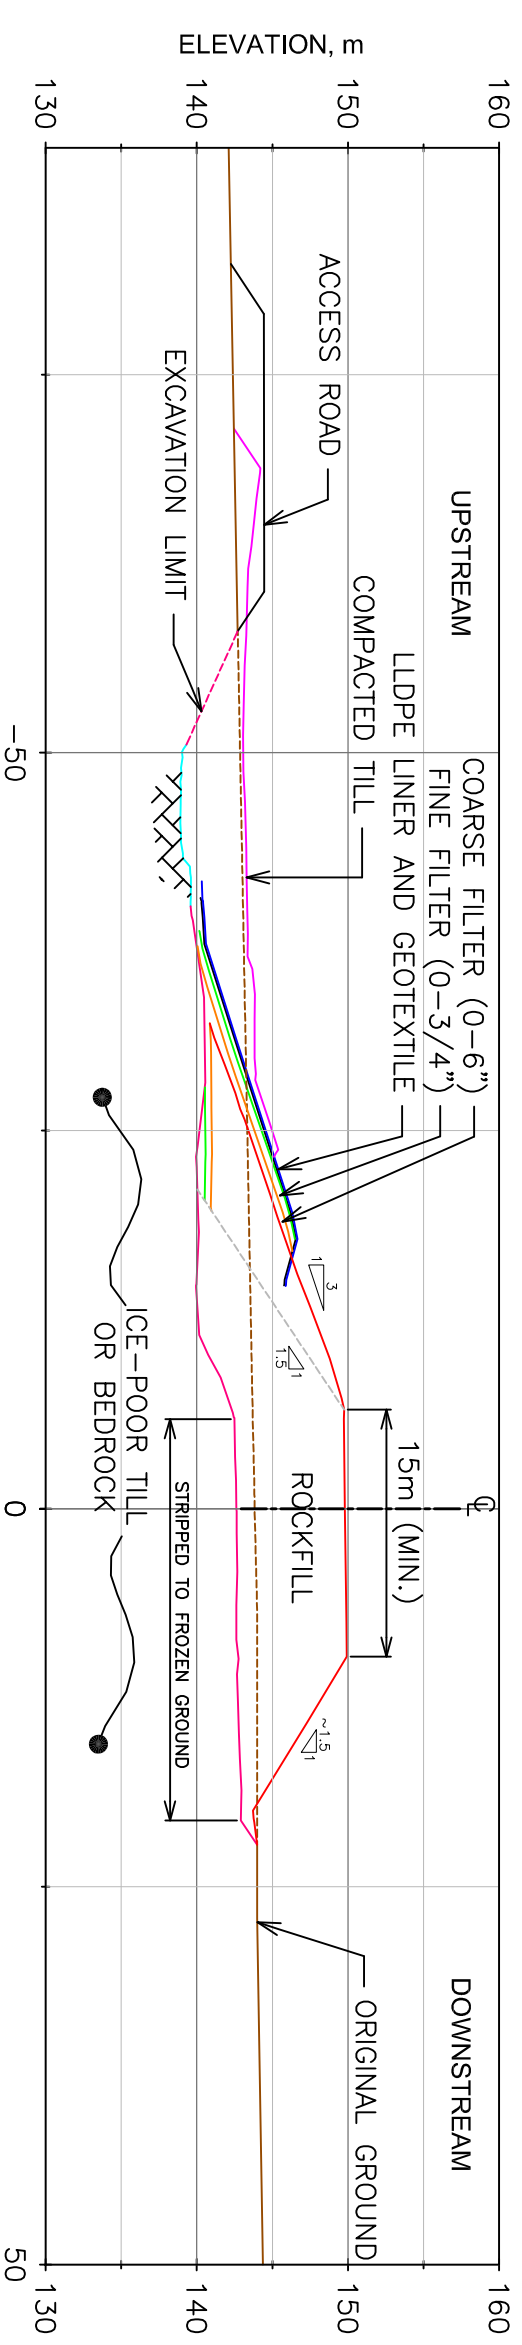

- LEGEND**
- FINE FILTER
 - COARSE FILTER
 - BEDROCK
 - FOUNDATION
 - LINER
 - GEOTEXTILE
 - ORIGINAL GROUND
 - ROCKFILL
 - TILL

REVISIONS

REV.	DATE	DESCRIPTION	BY	APP.	DATE
1	2010/09/28	AS BUILT	Y. Jolbert		
2	2010/09/28	AS BUILT	Y. Jolbert		
3	2010/09/28	AS BUILT	Y. Jolbert		
4	2010/09/28	AS BUILT	Y. Jolbert		
5	2010/09/28	AS BUILT	Y. Jolbert		
6	2010/09/28	AS BUILT	Y. Jolbert		
7	2010/09/28	AS BUILT	Y. Jolbert		
8	2010/09/28	AS BUILT	Y. Jolbert		
9	2010/09/28	AS BUILT	Y. Jolbert		
10	2010/09/28	AS BUILT	Y. Jolbert		

AGNICO-EAGLE
MEADOWBANK DIVISION



TITLE
AGNICO-EAGLE — MEADOWBANK DIVISION
SADDLE DAM Z
SECTIONS
AS BUILT 2010

DRAWN BY
K. Moogline
CHECKED BY
Y. Jolbert
APPROVED BY
Y. Jolbert
SCALE
1:500
DATE
2010/09/28

PROJECT NO.
REVISION
SHEET
2 / 2

DRAWING NO.

FORMAT ARCHD-LANDSCAPE

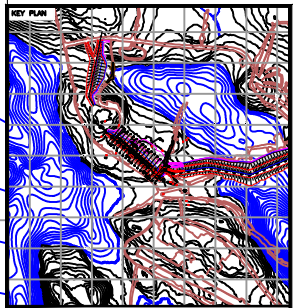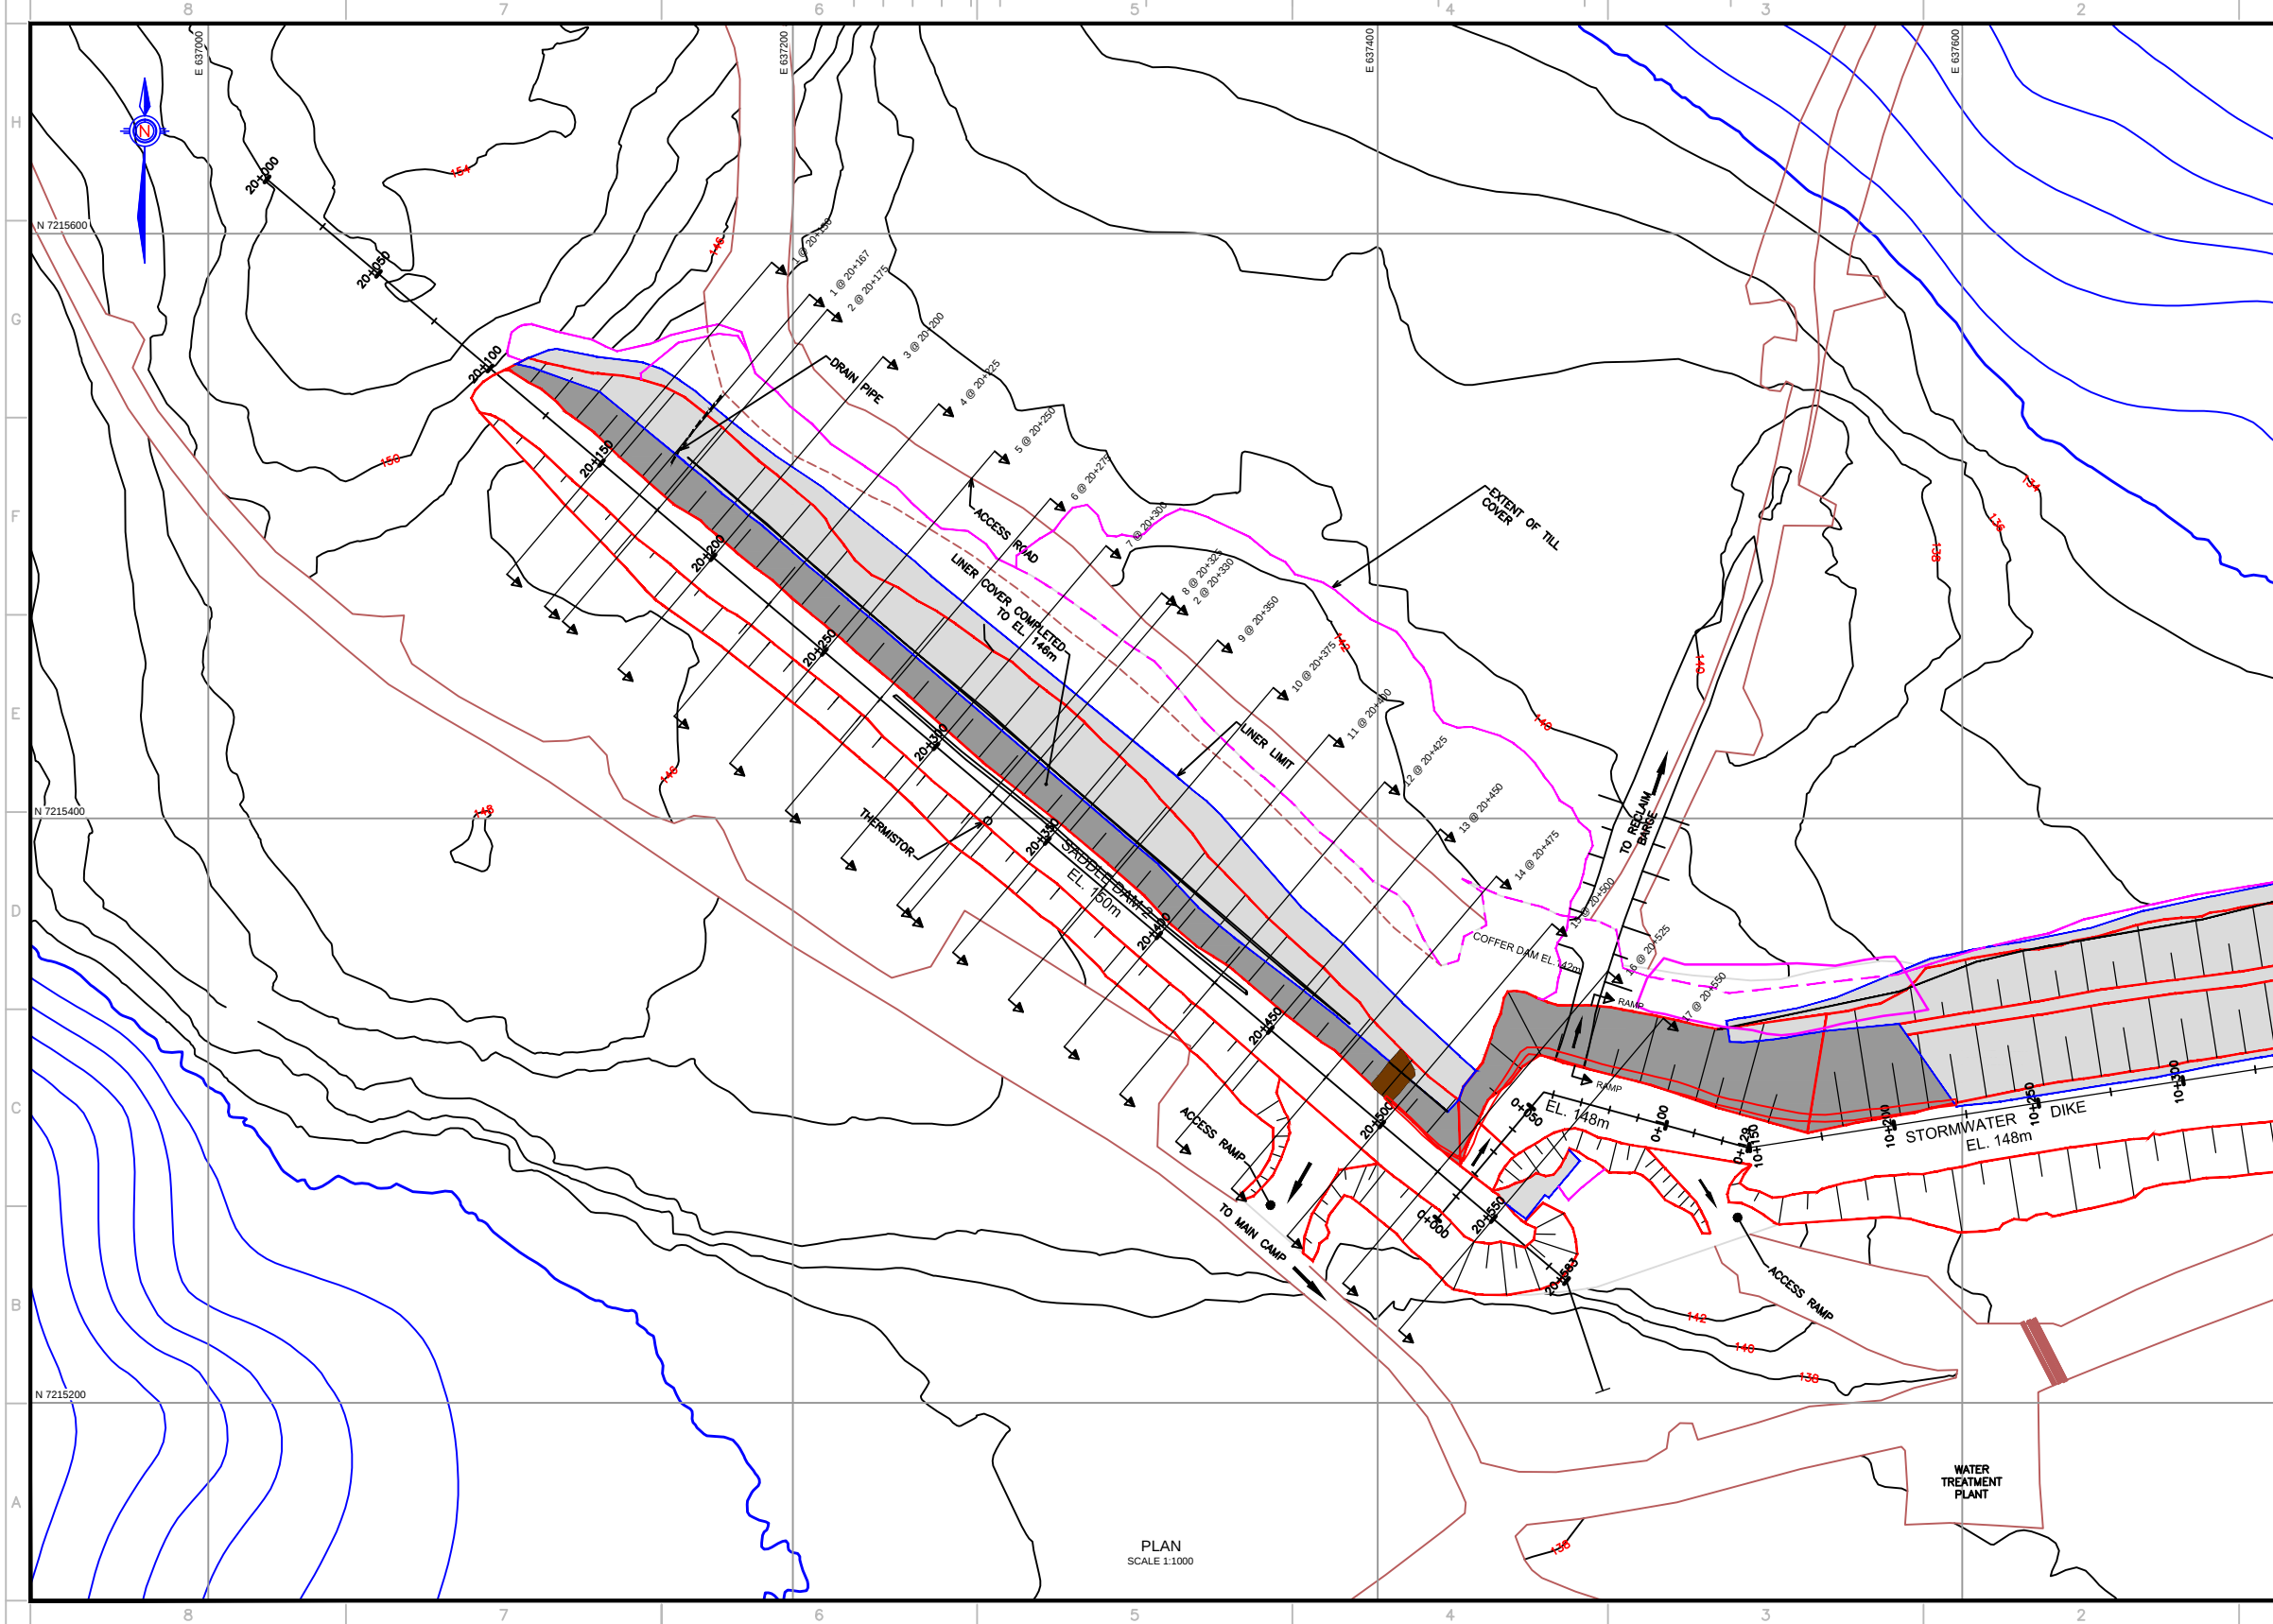

GENERAL NOTES

LEGEND:

- LINER COVER 2009/2010
- LINER COVER 2011
- COFFERDAM
- CREST / TOE LINE
- EXTENT OF TILL
- ROADS

ALL INFORMATION HEREON IS THE PROPERTY OF AGNICO-EAGLE LTD. AND MAY BE REPRODUCED OR TRANSMITTED IN ANY FORM OR BY ANY MEANS, WITHOUT PERMISSION, EXCEPT AS MAY BE PROVIDED IN WRITING BY AGNICO-EAGLE LTD.

TITLE		#	DATE

REFERENCE DRAWINGS

G		Feb. /12		As Built Drawings		TD	
REV.		DATE		DESCRIPTION		BY	

REVISIONS



TITLE
AGNICO-EAGLE - MEADOWBANK DIVISION
SADDLE DAM 2
PLAN
AS BUILT 2011

DRAWN BY
T.DAHM

DATE
2012/04/28

CHECKED BY
E.VOYER/TLEPINE










APPROVED BY

SCALE
AS SHOWN

DRAWING NO.

PROJECT NO.

REVISION
1 / 1

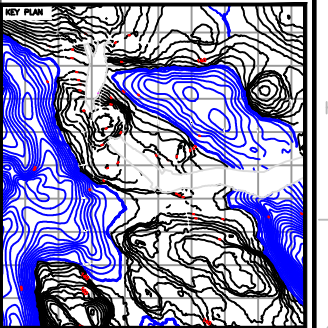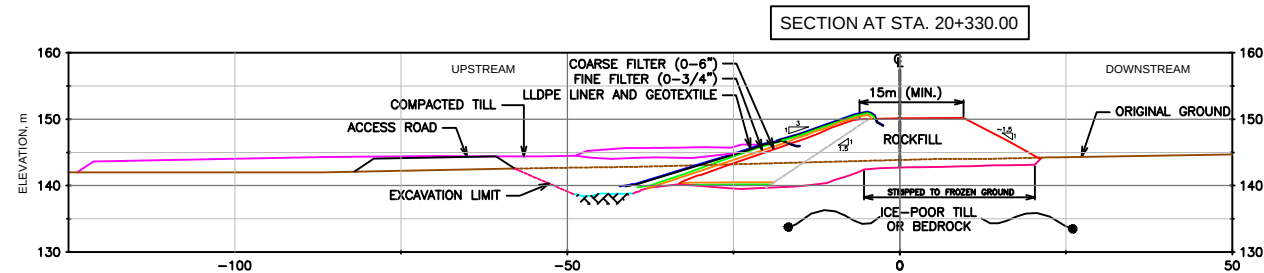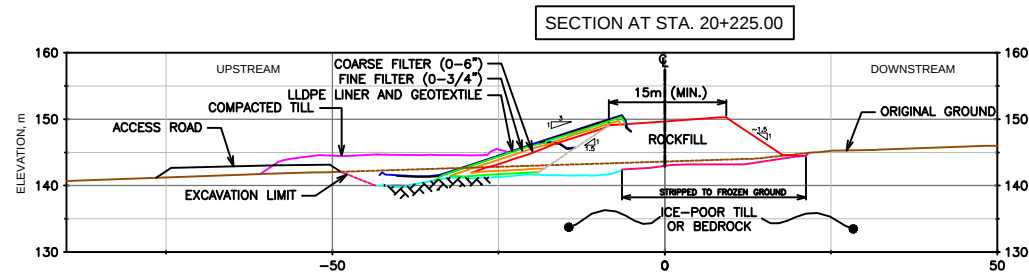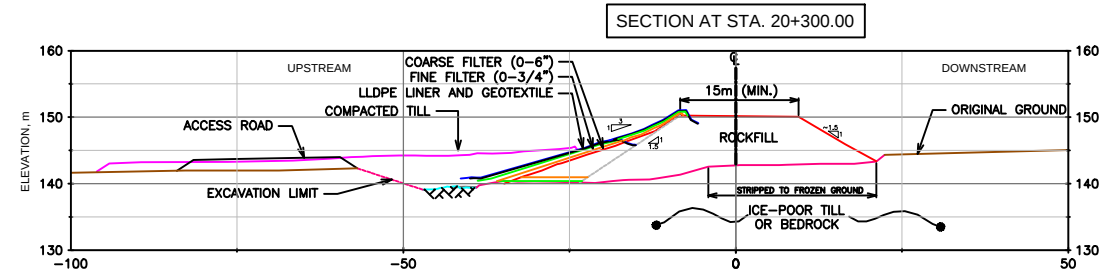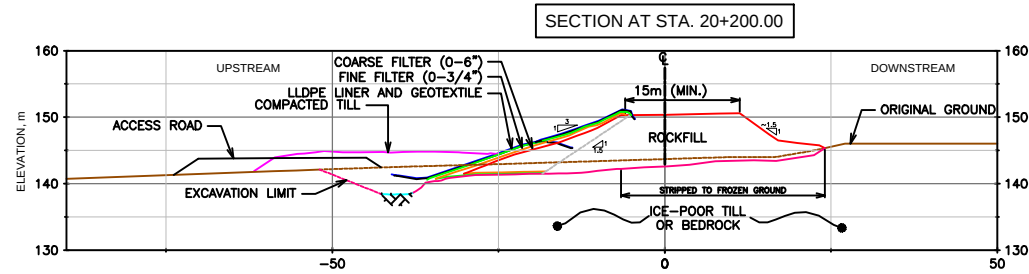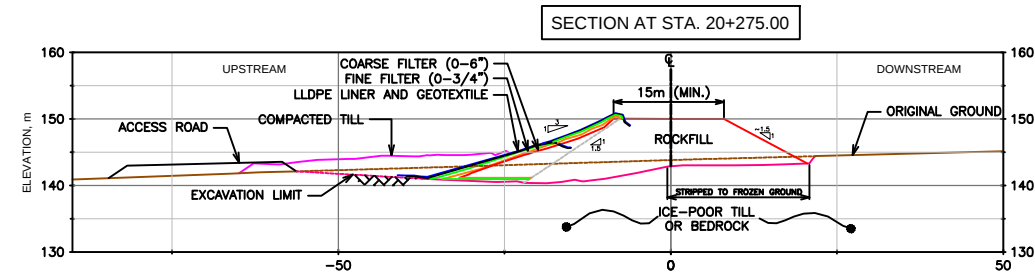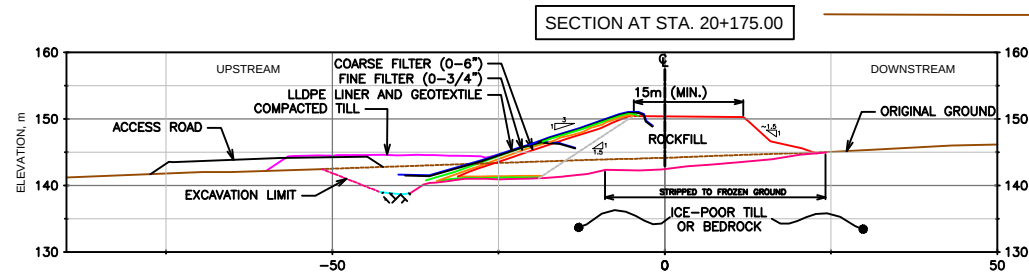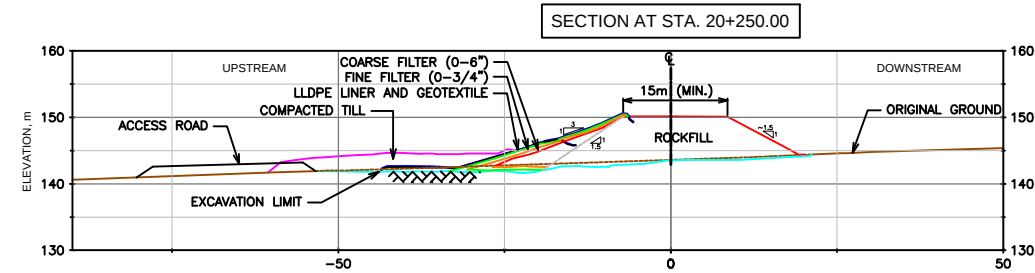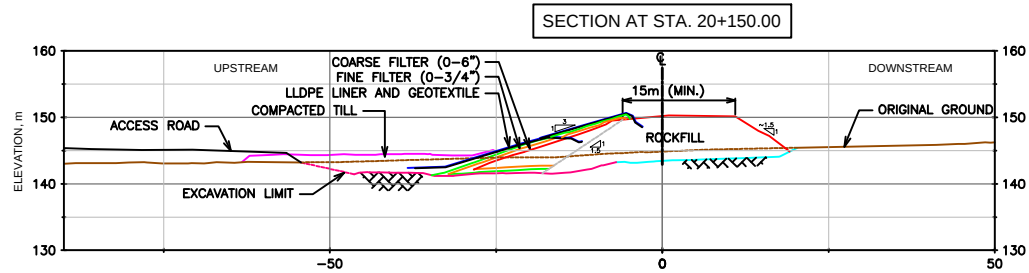

GENERAL NOTES

LEGEND

- FINE FILTER
- COARSE FILTER
- BEDROCK
- FOUNDATION
- LINER
- GEOTEXTILE
- ORIGINAL GROUND
- ROCKFILL
- TILL

THE INFORMATION HEREON IS THE PROPERTY OF AGNICO-EAGLE LTD. AND MUST BE KEPT UNDER STRICTLY CONFIDENTIALITY. ANY REPRODUCTION OR DISSEMINATION OF THIS INFORMATION WITHOUT THE WRITTEN PERMISSION OF AGNICO-EAGLE LTD. IS PROHIBITED.

TITLE	DATE

REFERENCE DRAWINGS

NO.	DATE	DESCRIPTION

REV.	DATE	DESCRIPTION	BY	APP.	CLIENT



TITLE
AGNICO-EAGLE - MEADOWBANK DIVISION
SADDLE DAM 2
SECTIONS
AS BUILT 2011

DRAWN BY: T.DAHM DATE: 2012/04/28

CHECKED BY: EVOYER/T.LEPINE

APPROVED BY:



SCALE: 1:500 DATE:

DRAWING NO.

PROJECT NO. REVISION SHEET 1 / 2

DRAWING NO.

FORMAT ARCHD-LANDSCAPE

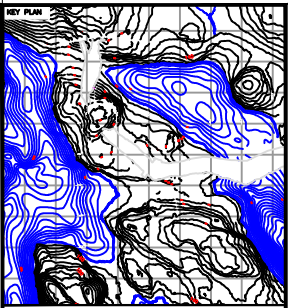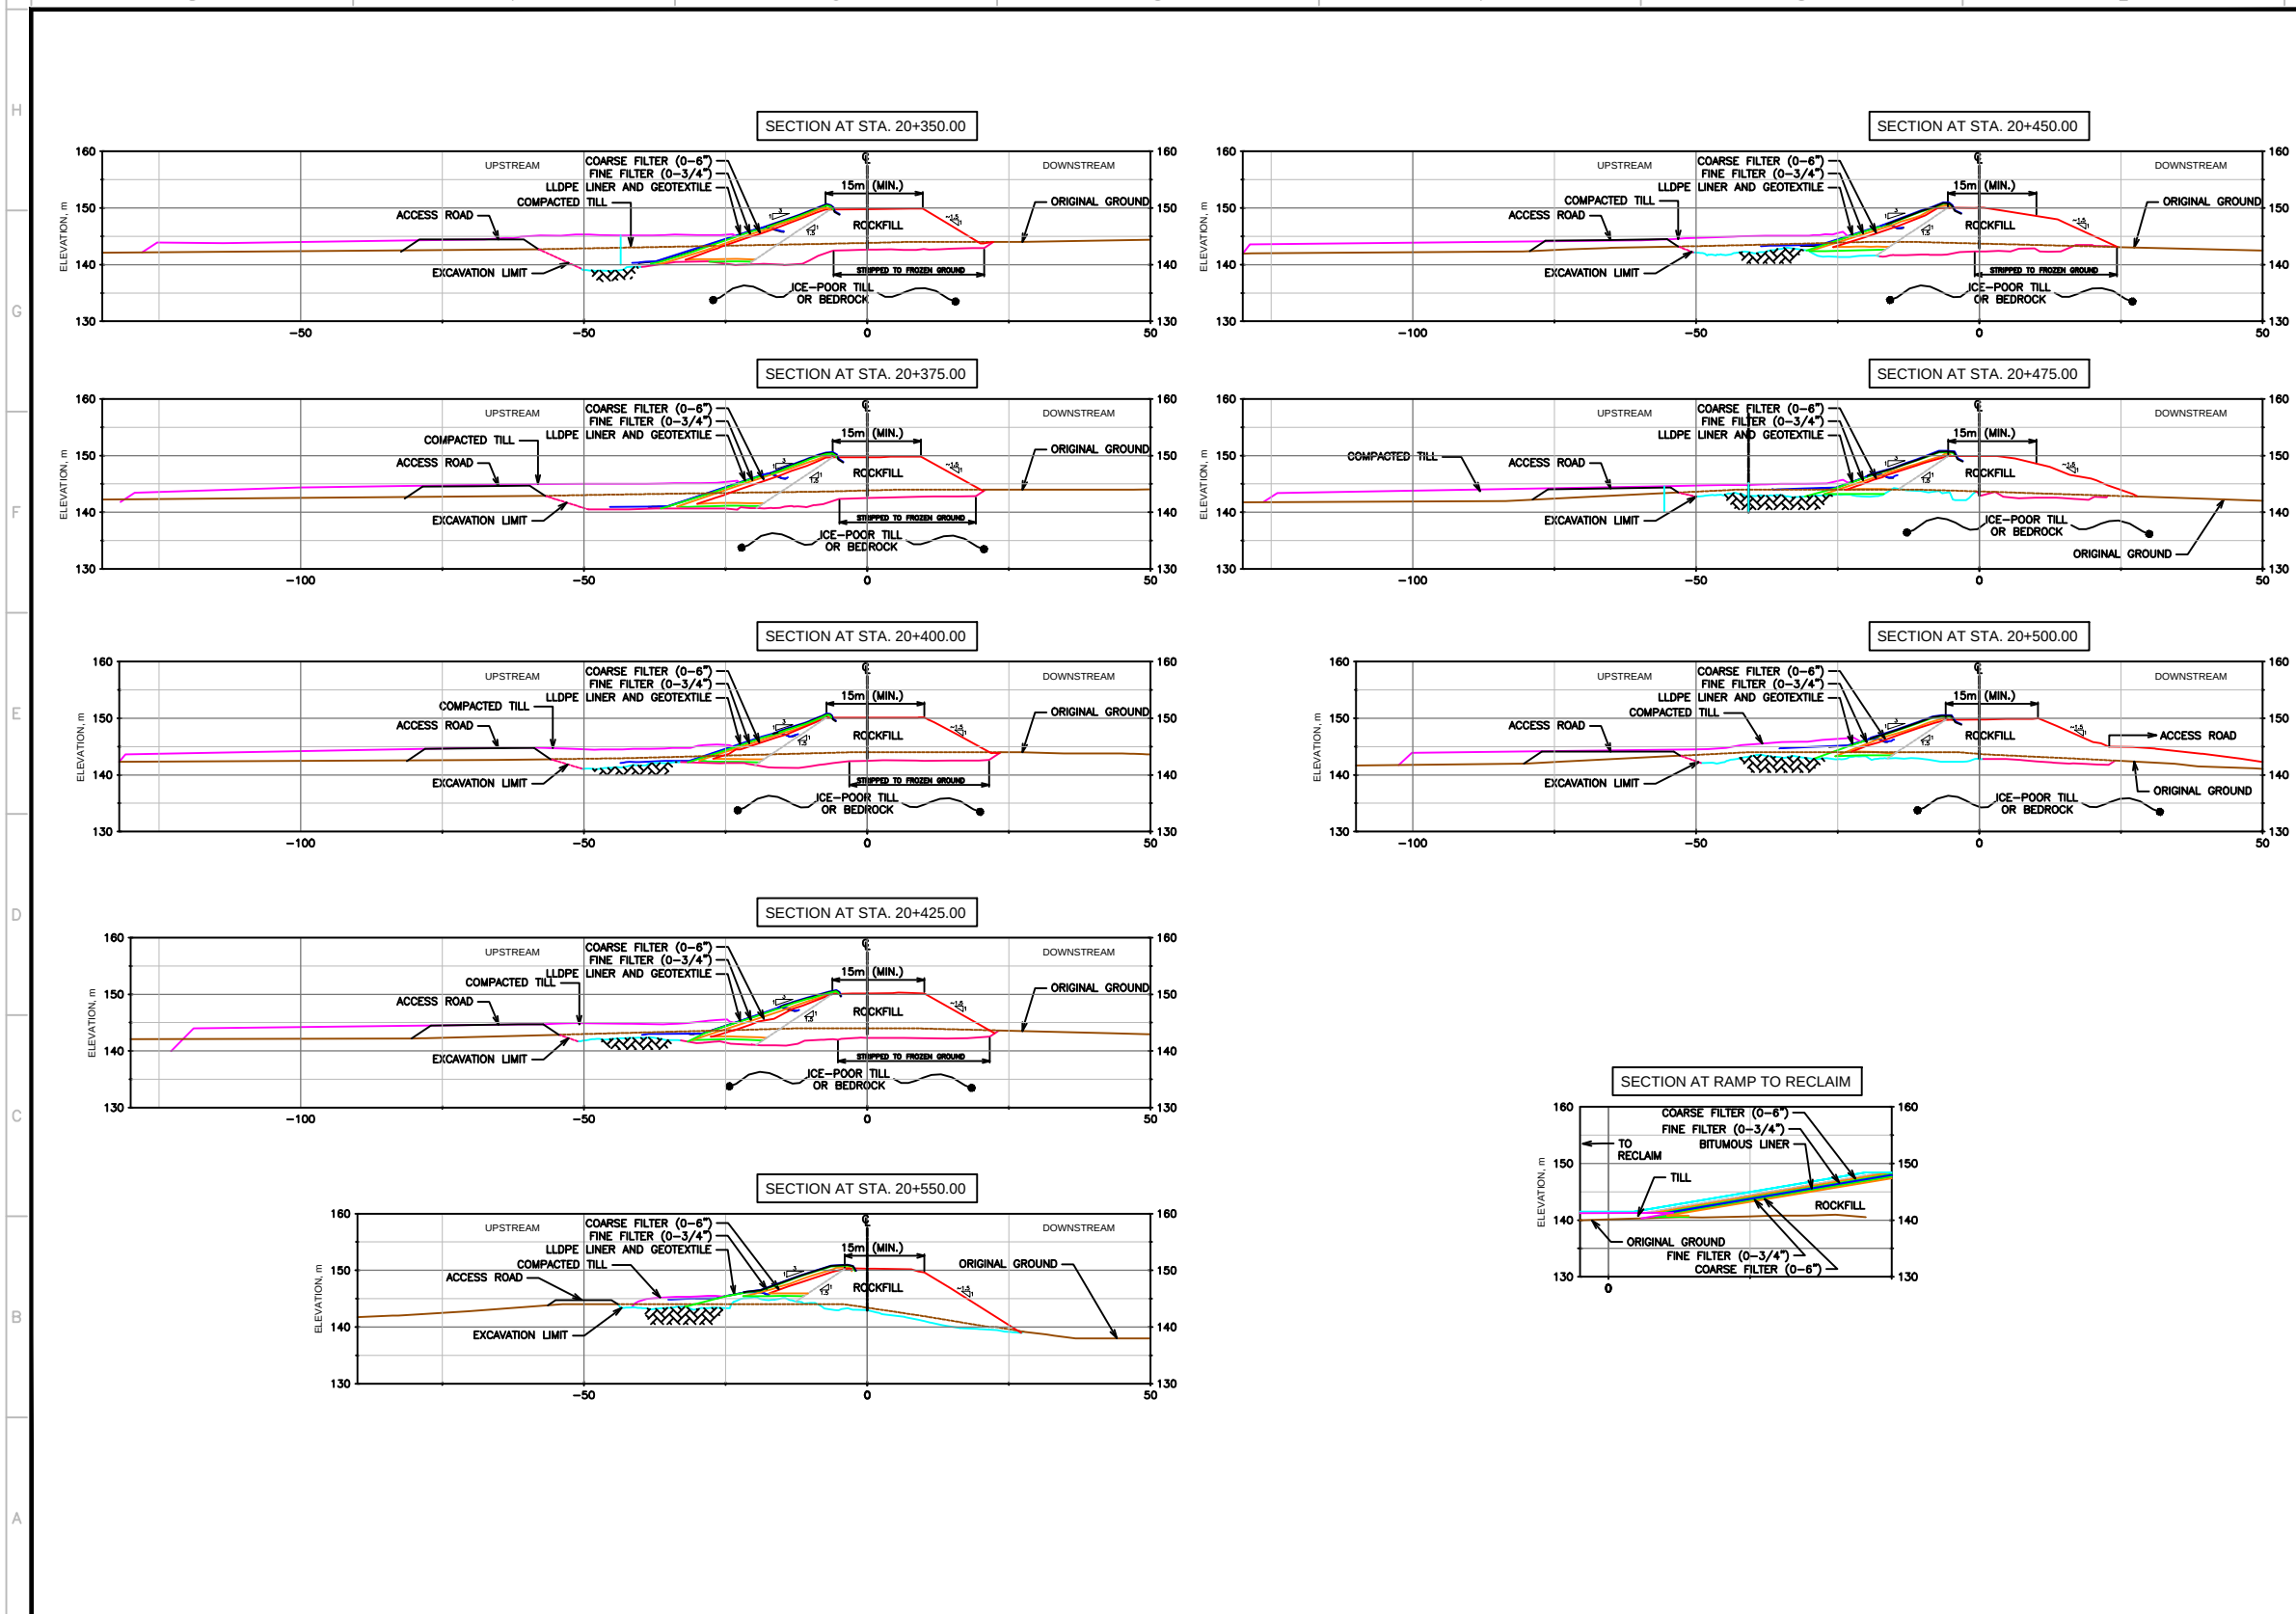

LEGEND

- FINE FILTER
- COARSE FILTER
- BEDROCK
- FOUNDATION
- LINER
- GEOTEXTILE
- ORIGINAL GROUND
- ROCKFILL
- TILL

THE INFORMATION HEREON IS THE PROPERTY OF AGNICO-EAGLE LTD. AND MUST BE RETURNED UPON REQUEST. WITHOUT WRITTEN PERMISSION, ANY COPIES, REPRODUCTIONS, OR DISSEMINATIONS ARE STRICTLY PROHIBITED. © 2012 AGNICO-EAGLE LTD.

TITLE	#

REFERENCE DRAWINGS

REV.	DATE	As Built Drawings	TO	BY	APP.	LODGE
0	Feb. /12					

REVISIONS



TITLE
AGNICO-EAGLE - MEADOWBANK DIVISION
SADDLE DAM 2
SECTIONS
AS BUILT 2011

DRAWN BY	T.DAHM	DATE	2012/04/18
CHECKED BY	E.VOYER/T.LEPINE		
APPROVED BY			
SCALE	1:500	DATE	
DRAWING NO.			
PROJECT NO.		REVISION	SHEET
			2 / 2