

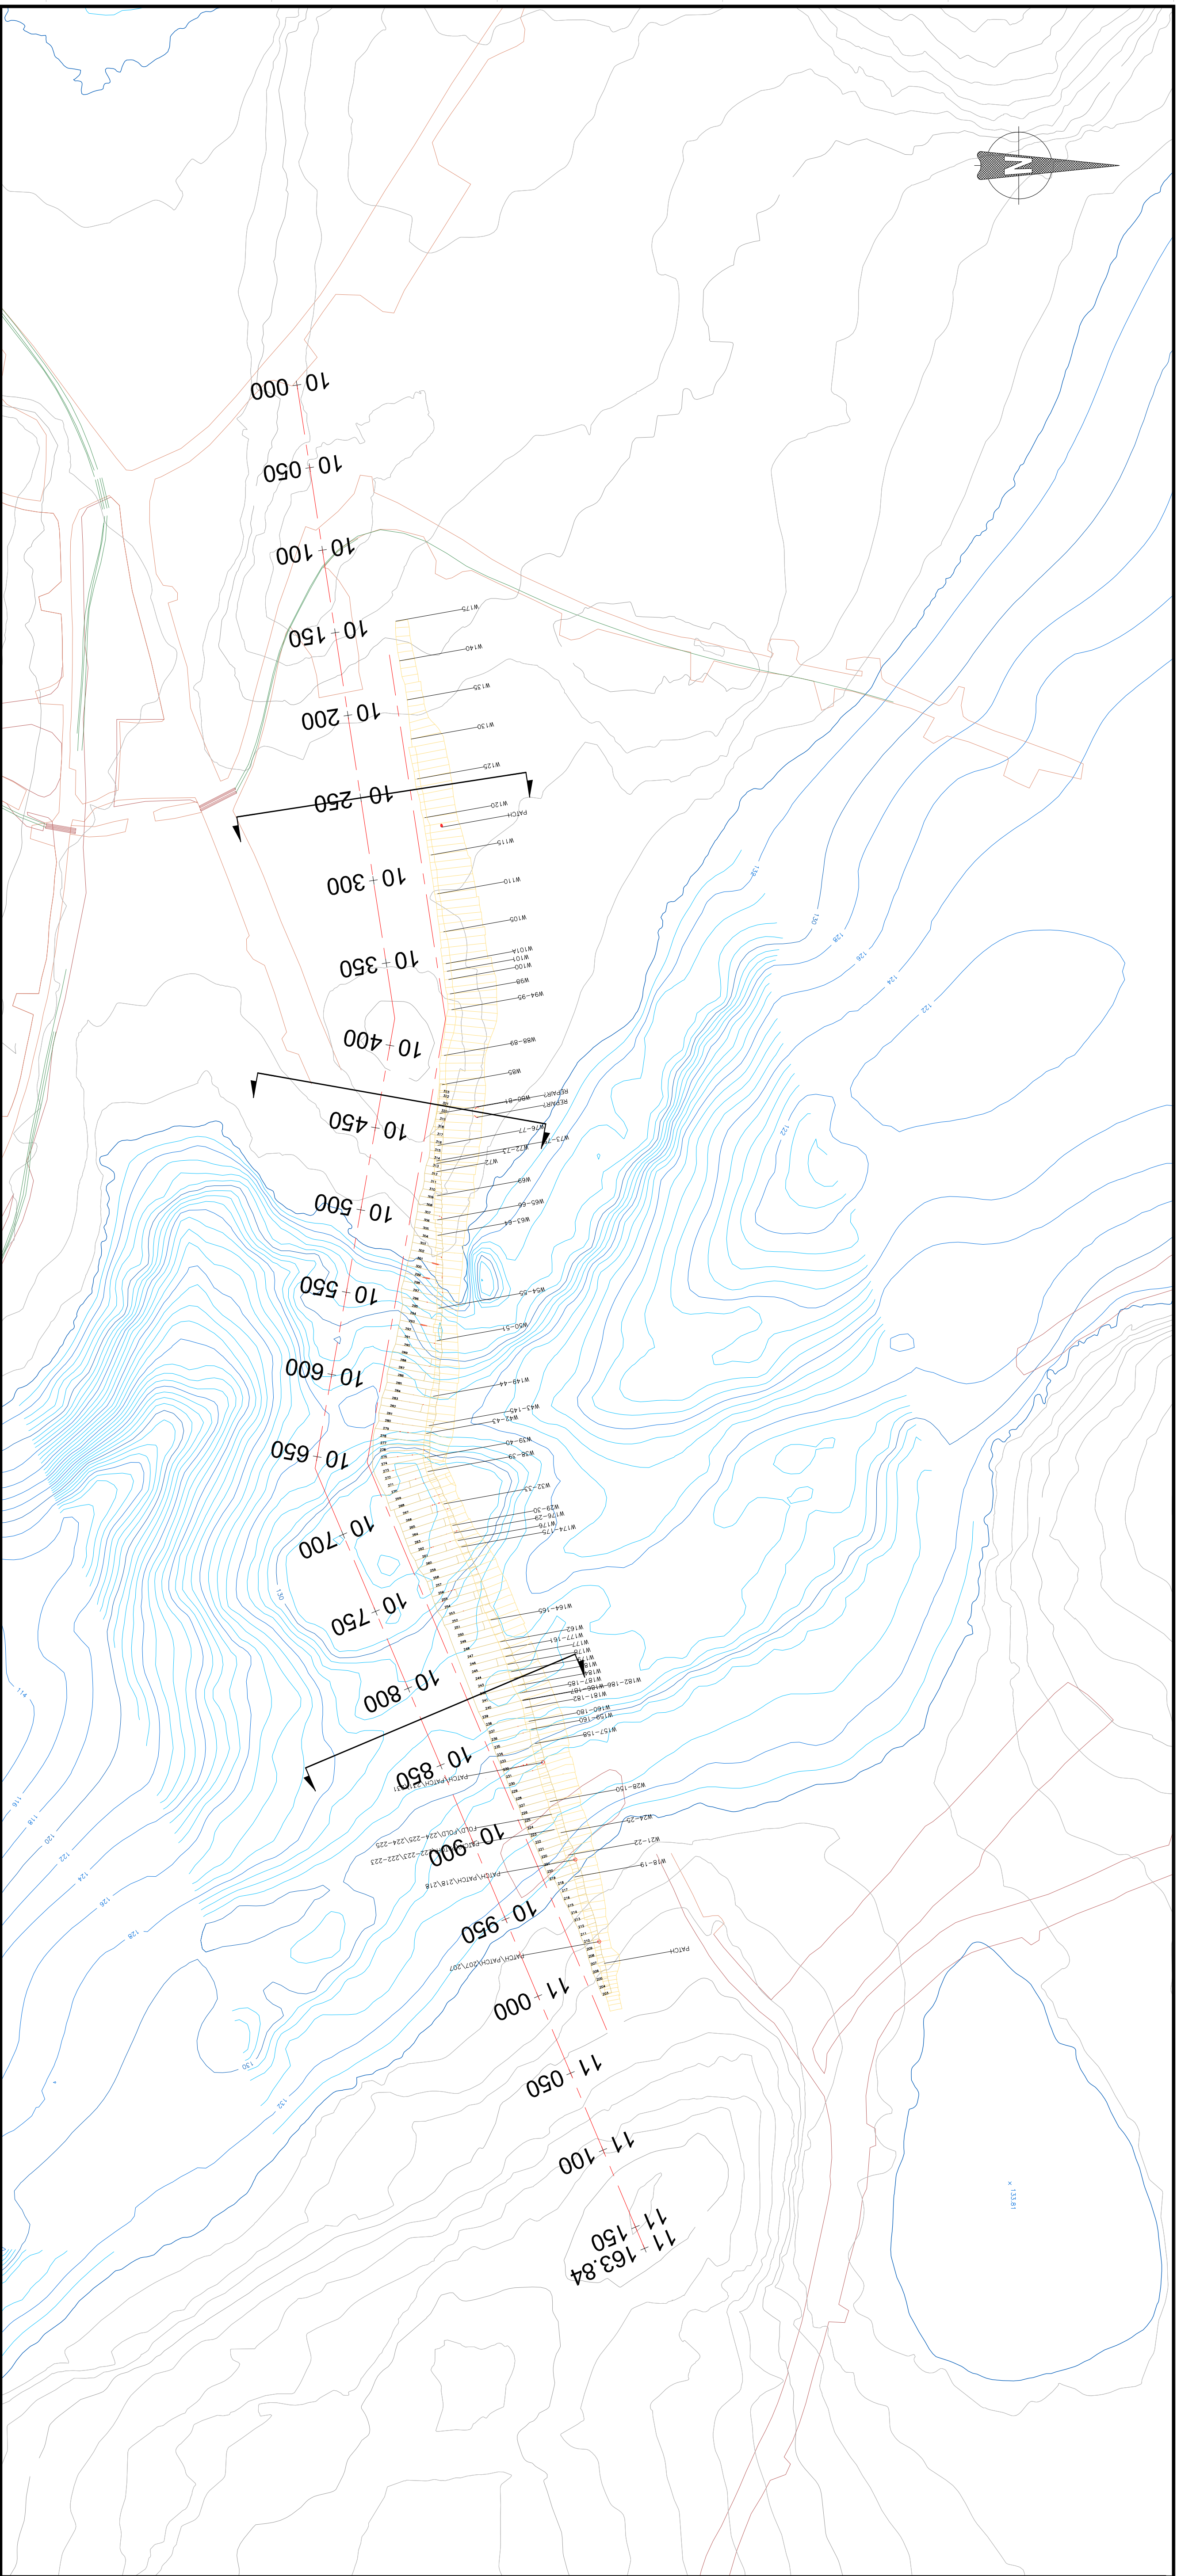
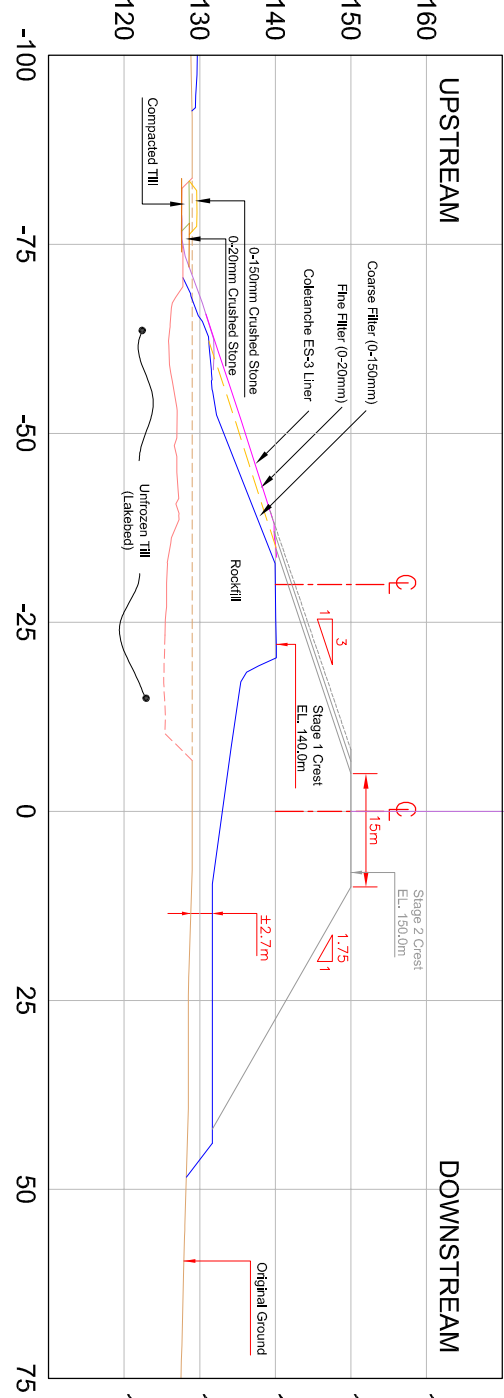


# **Stormwater Dike– As Built Drawings**

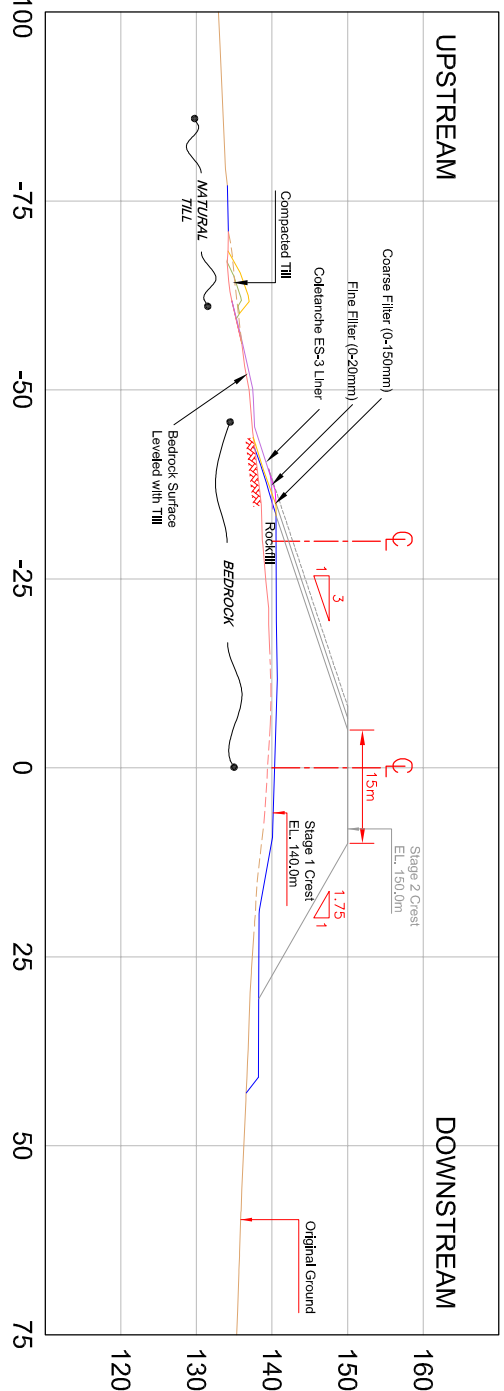

PLAN VIEW  
Scale 1:2000

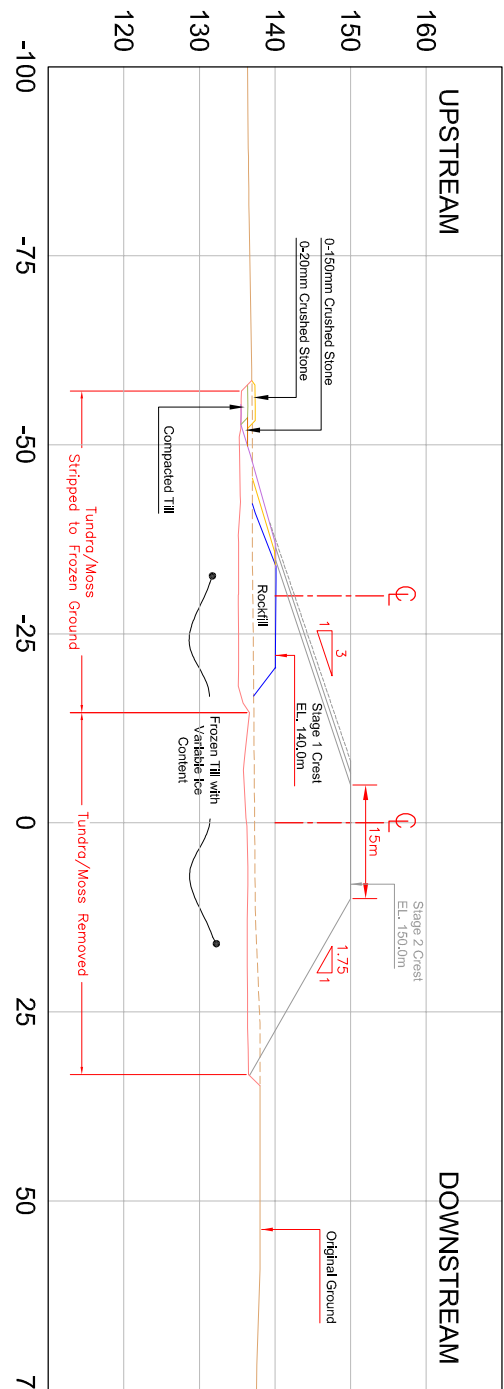

KEY PLAN

GENERAL NOTES

AGNICO-EAGLE  
MEADOWBANK DIVISION

AGNICO-EAGLE – MEADOWBANK DIVISION  
TAILINGS STORAGE FACILITY  
ENGINEERING  
AS-BUILT SURVEY  
STORMWATER DITCH – STAGE 1  
PLAN AND SECTIONS

DATE  
17/12/2009



PROJECT NO.

REGION

SHEET

1 / 1



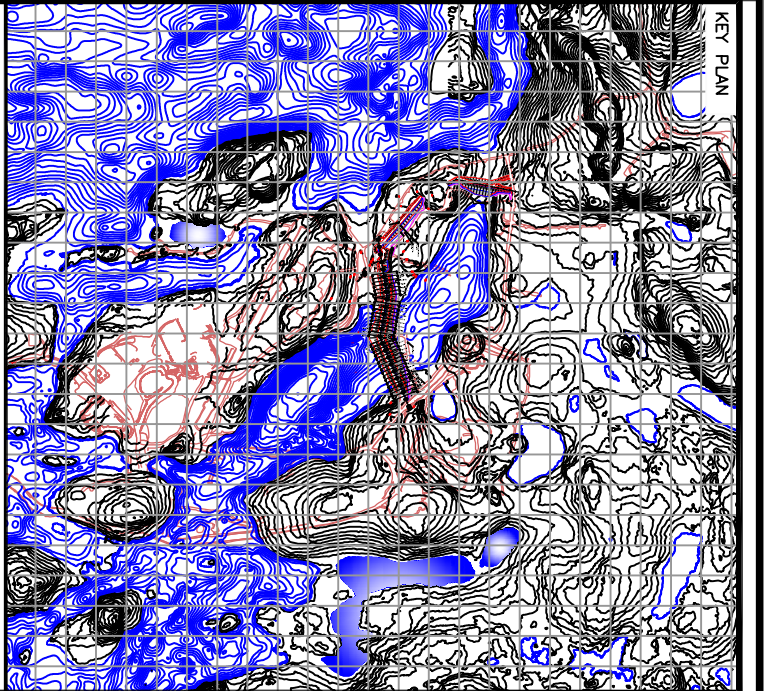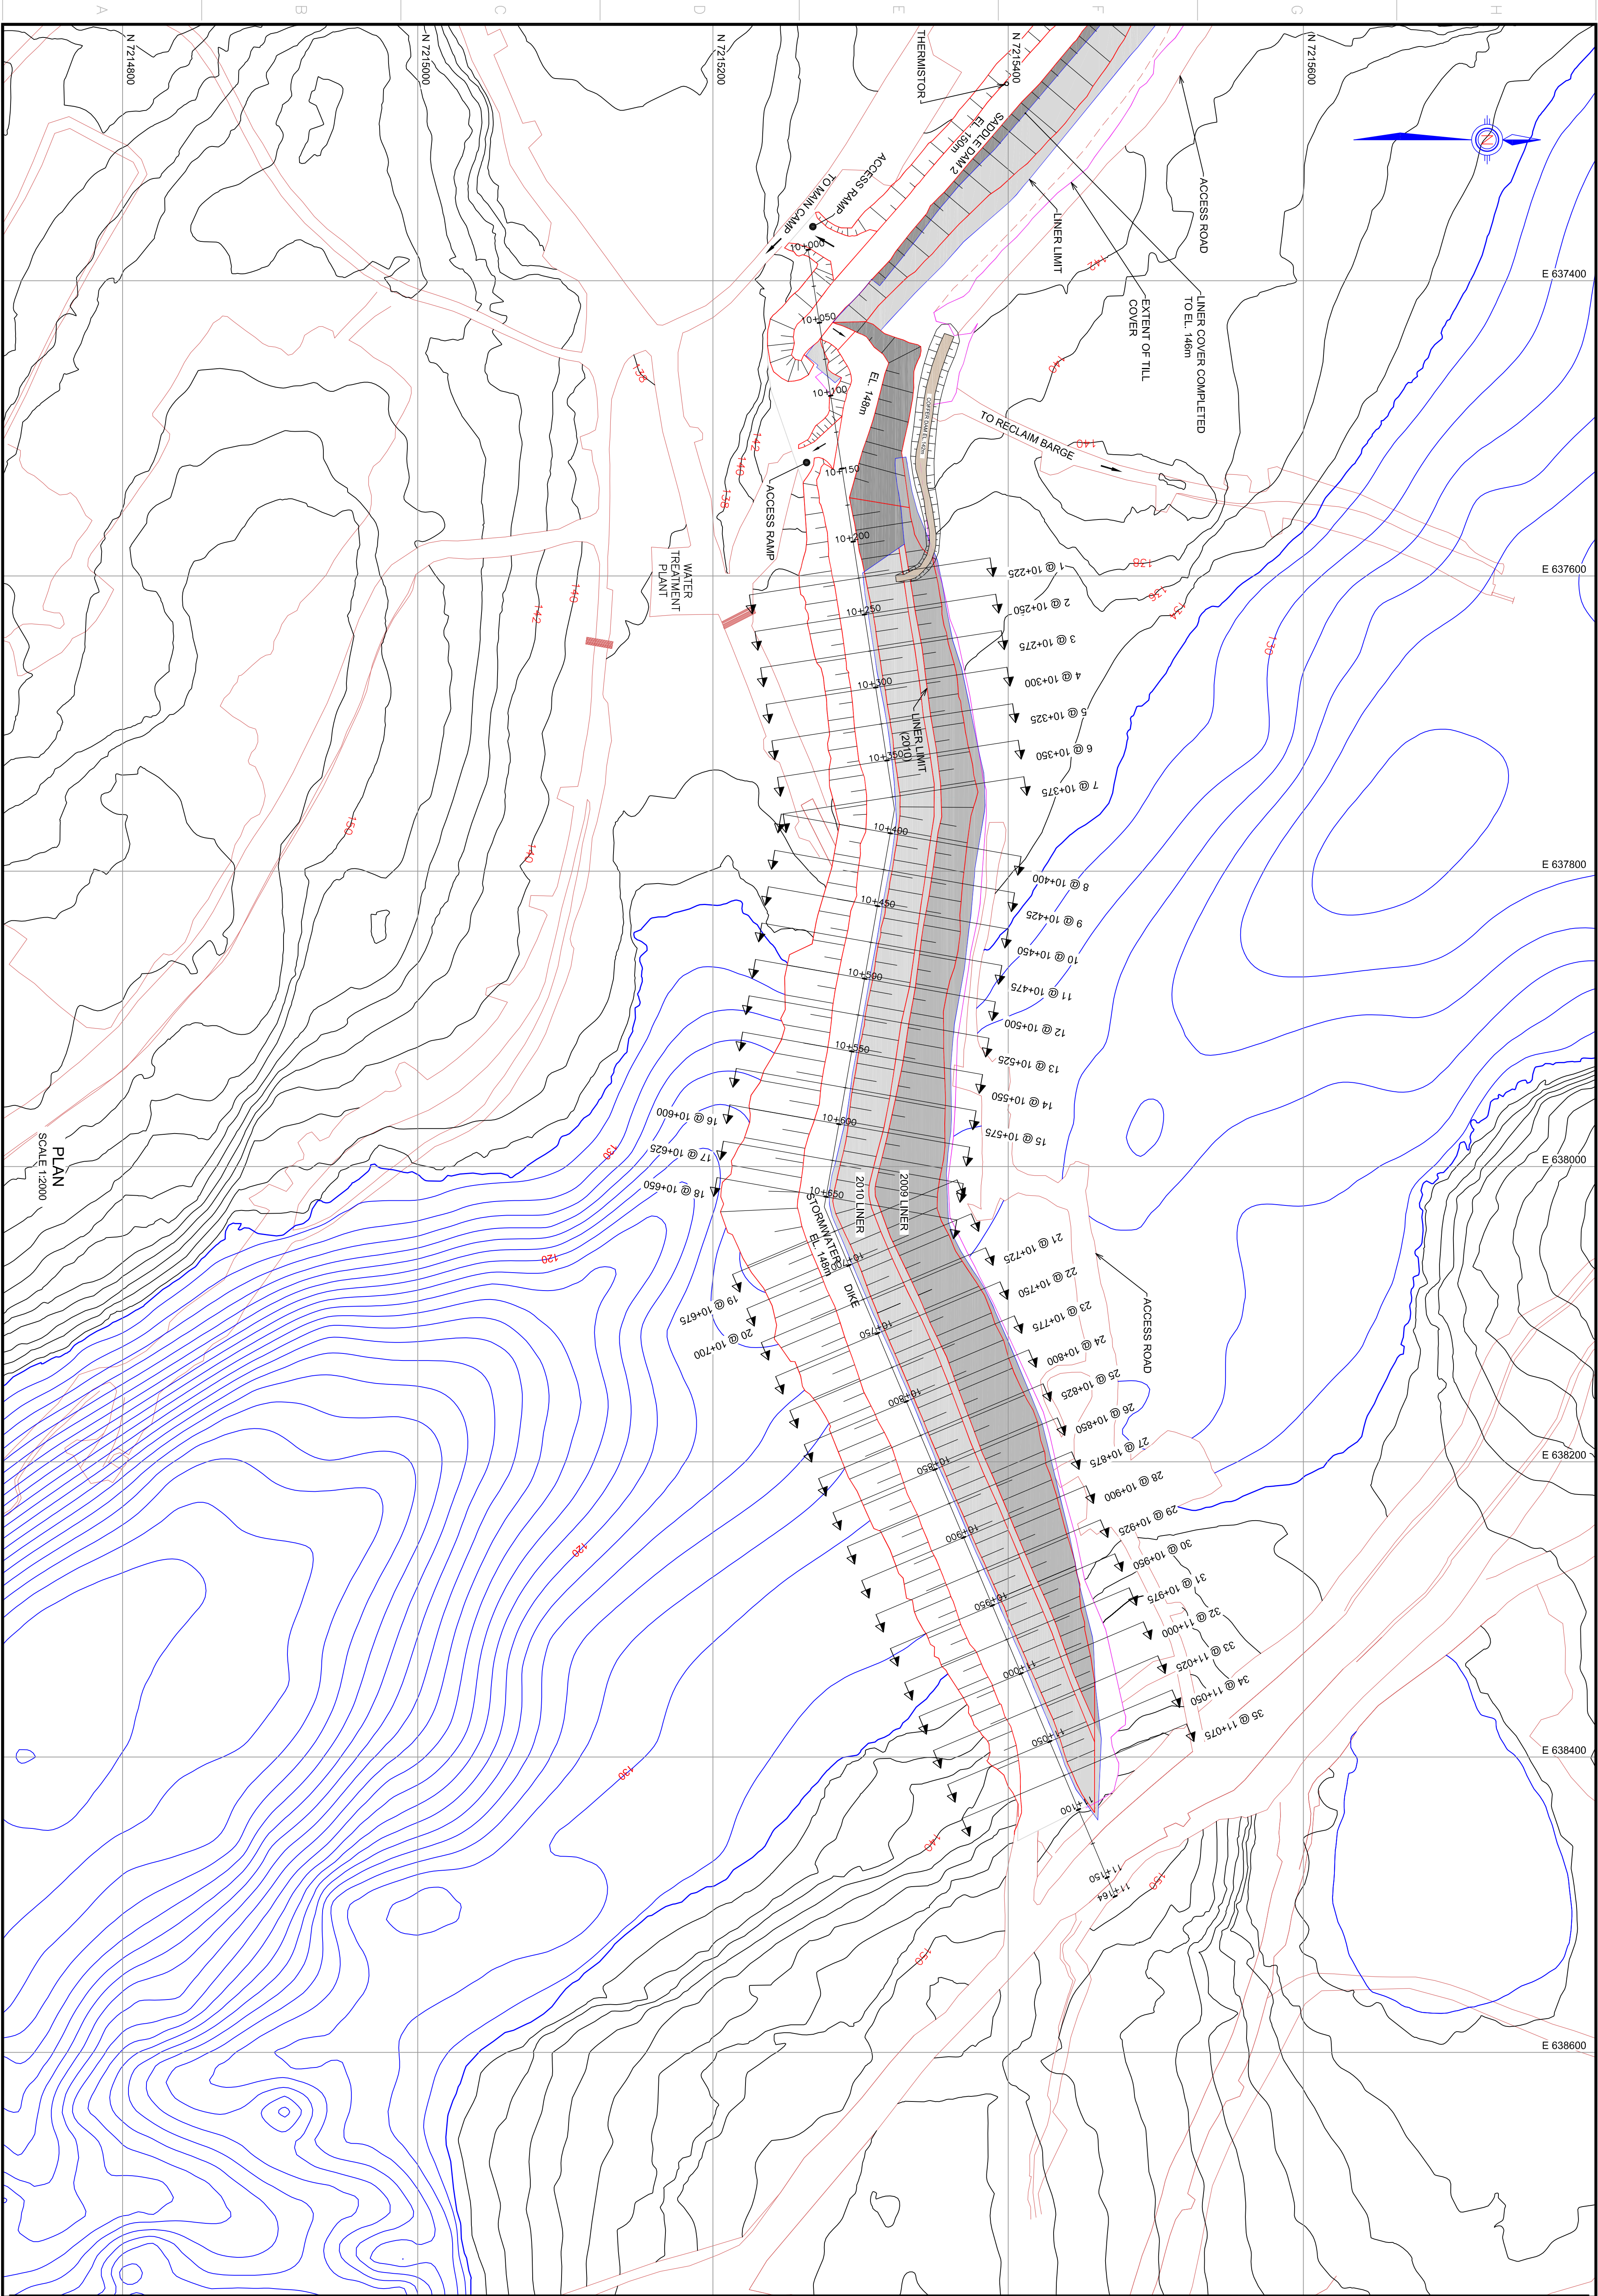

GENERAL NOTES

LEGEND:

- LINER COVER 2010
- LINER COVER 2009
- LINER COVER TO BE COMPLETED
- COFFERDAM
- CREST / TOE LINE
- EXTENT OF TILL COVER
- ROADS

REVISIONS

REFERENCE DRAWINGS


AGNICO-EAGLE  
MEADOWBANK DIVISION

TITLE  
AGNICO-EAGLE - MEADOWBANK DIVISION  
STORMWATER DIKE  
PLAN  
AS BUILT 2010

DESIGNED BY  
Y. Jobert  
APPROVED BY  
Y. Jobert  
DATE  
2010/09/28  
SCALE  
AS SHOWN

PROJECT NO.  
REVISION  
SHEET  
1 / 1



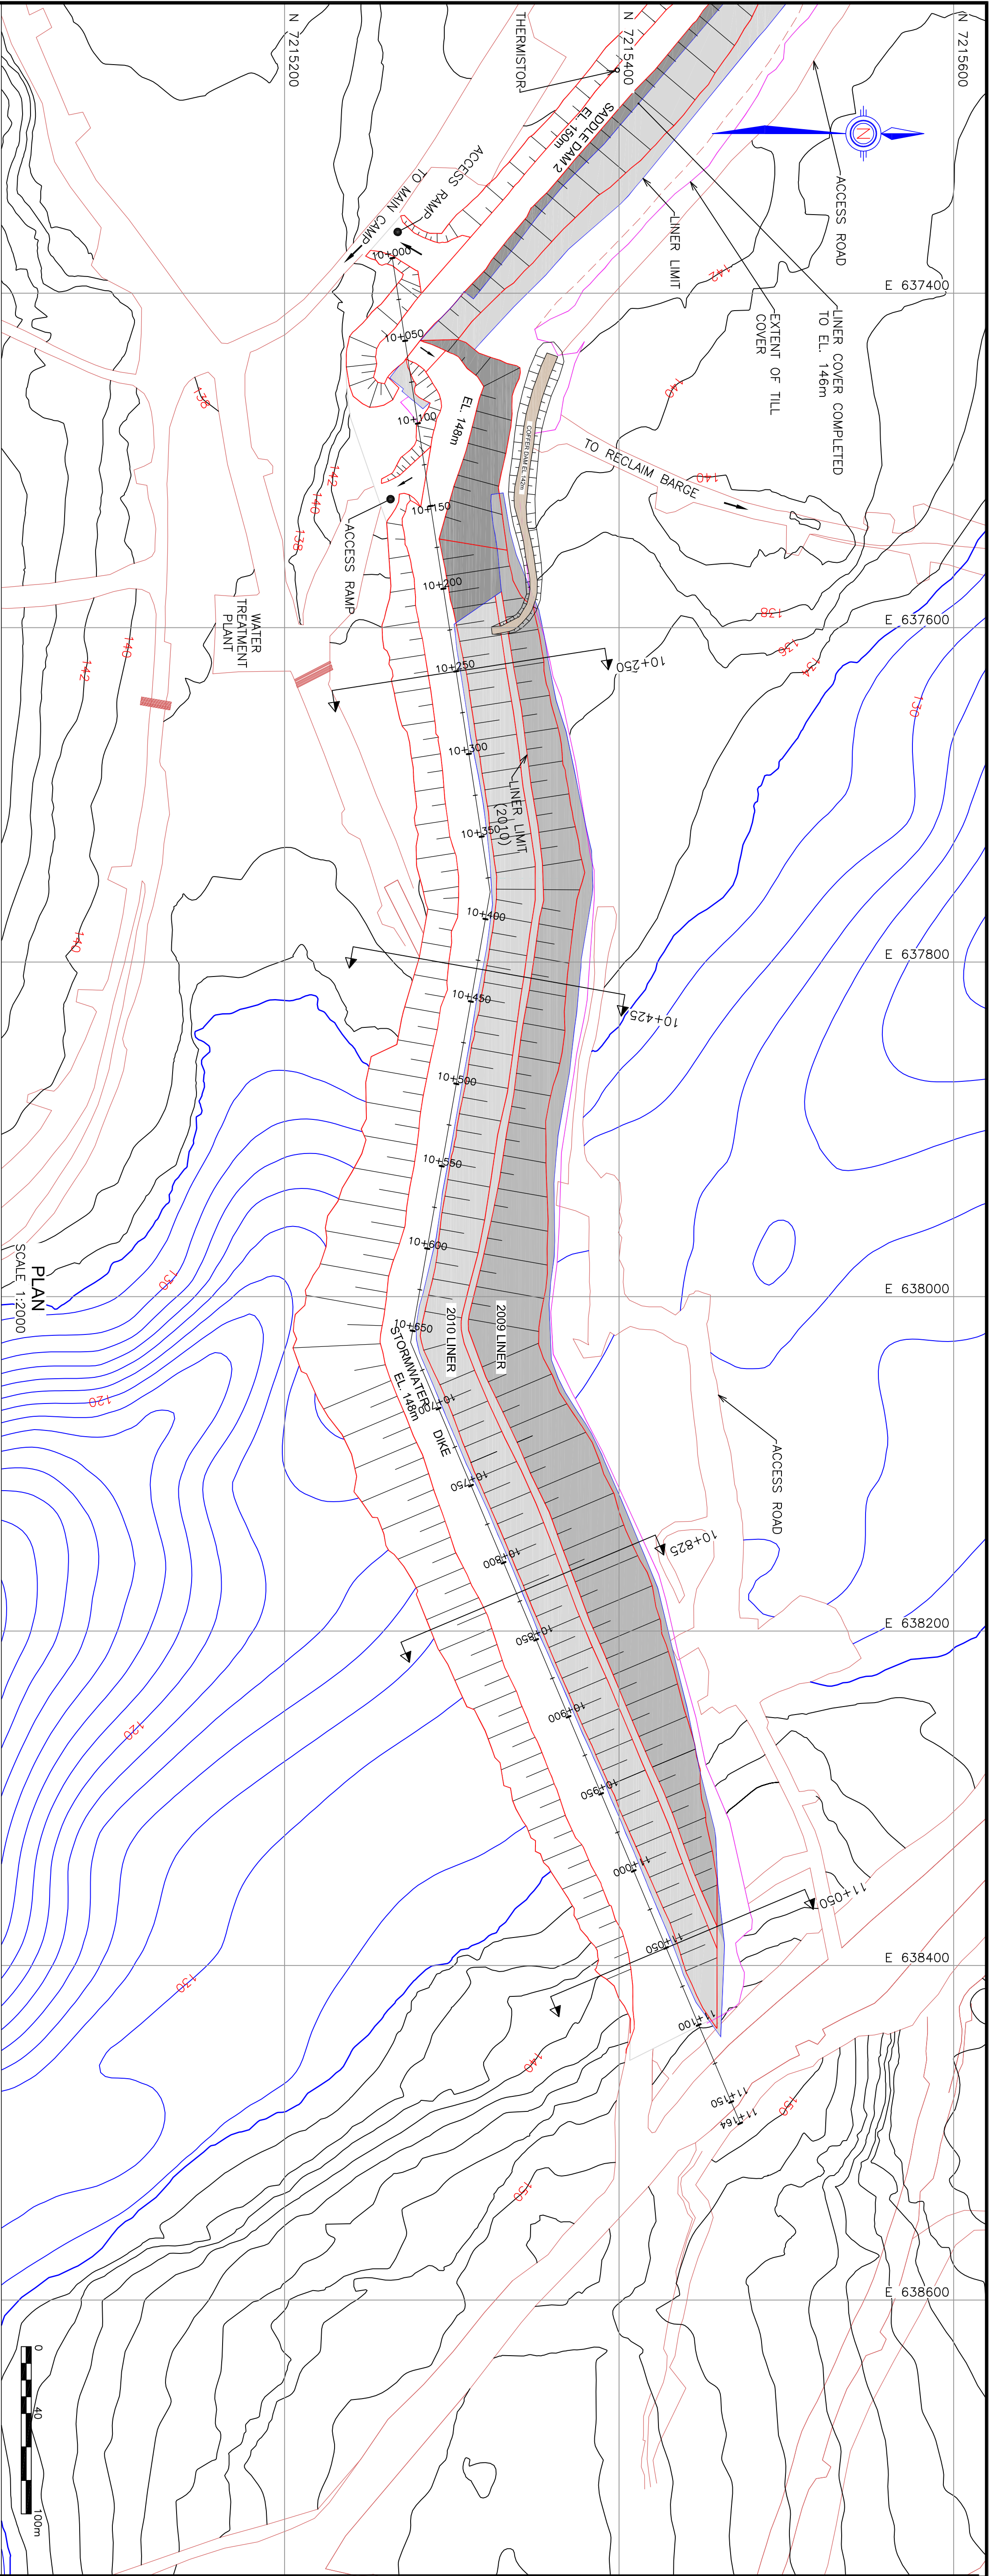

GENERAL NOTES


LEGEND:

- LINER COVER 2010
- LINER COVER 2009
- LINER COVER TO BE COMPLETED
- COFFERDAM
- CREST / TOE LINE
- EXTENT OF TILL
- ROADS


FOR SECTIONS:

- FINE FILTER
- COARSE FILTER
- BEDROCK
- FOUNDATION
- LINER
- GEOTEXTILE
- ORIGINAL GROUND
- ROCKFILL
- TILL


SECTION AT STA. 10+250.00

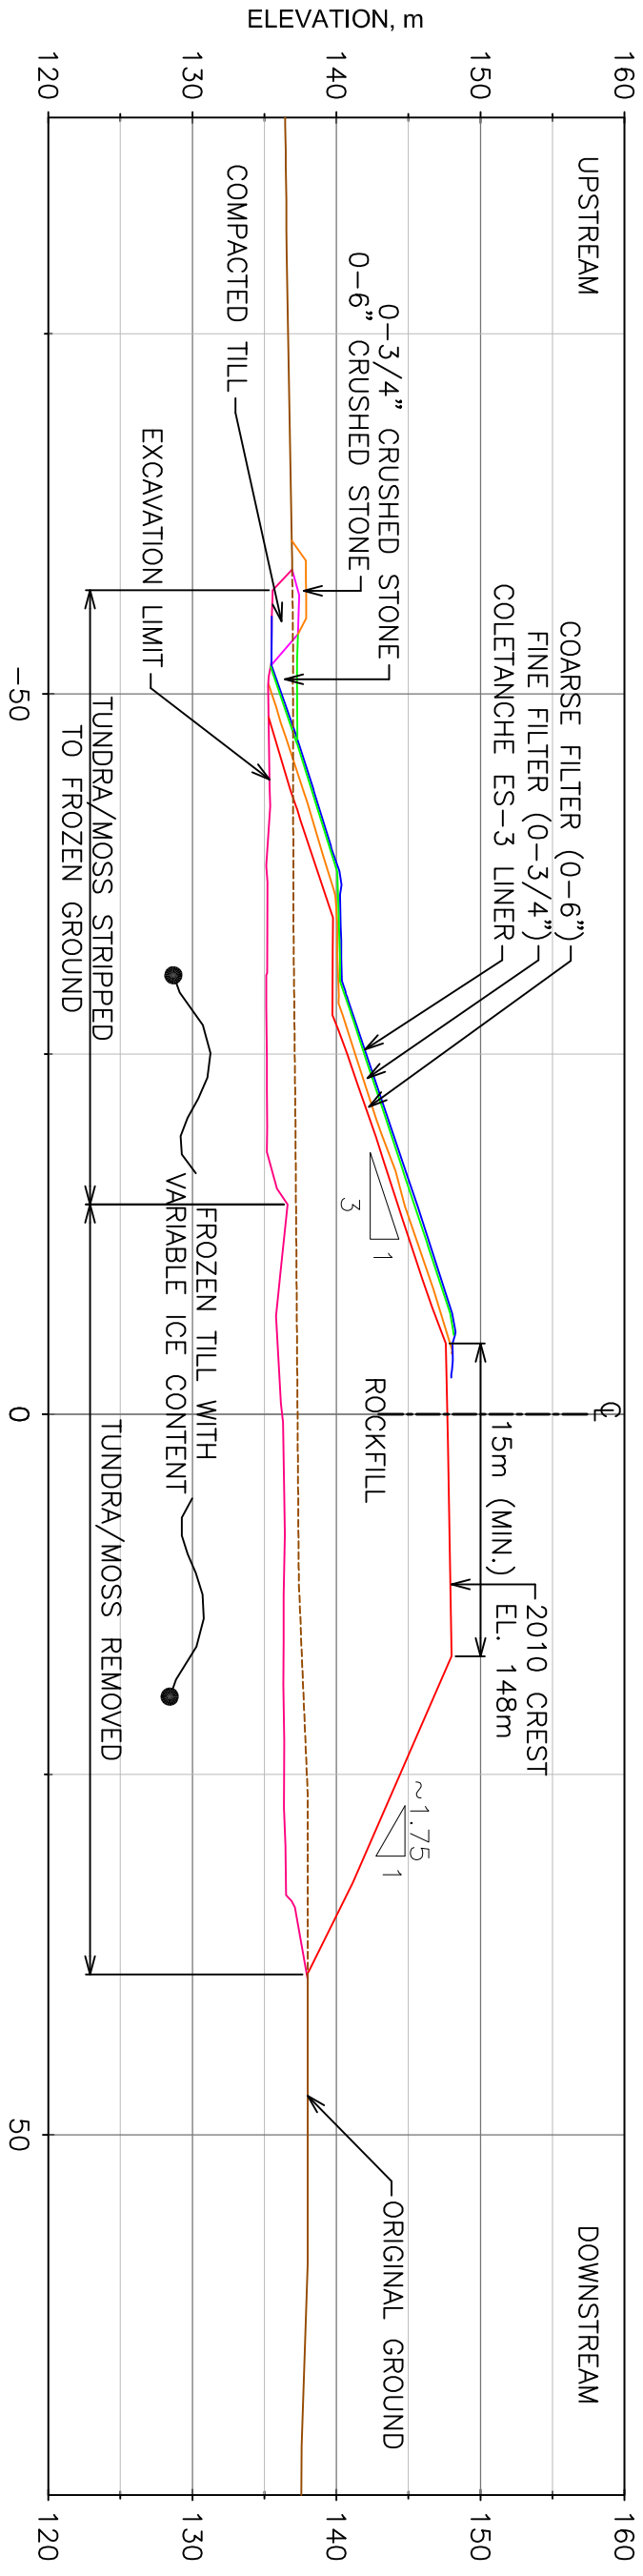


SECTION AT STA. 10+430.00

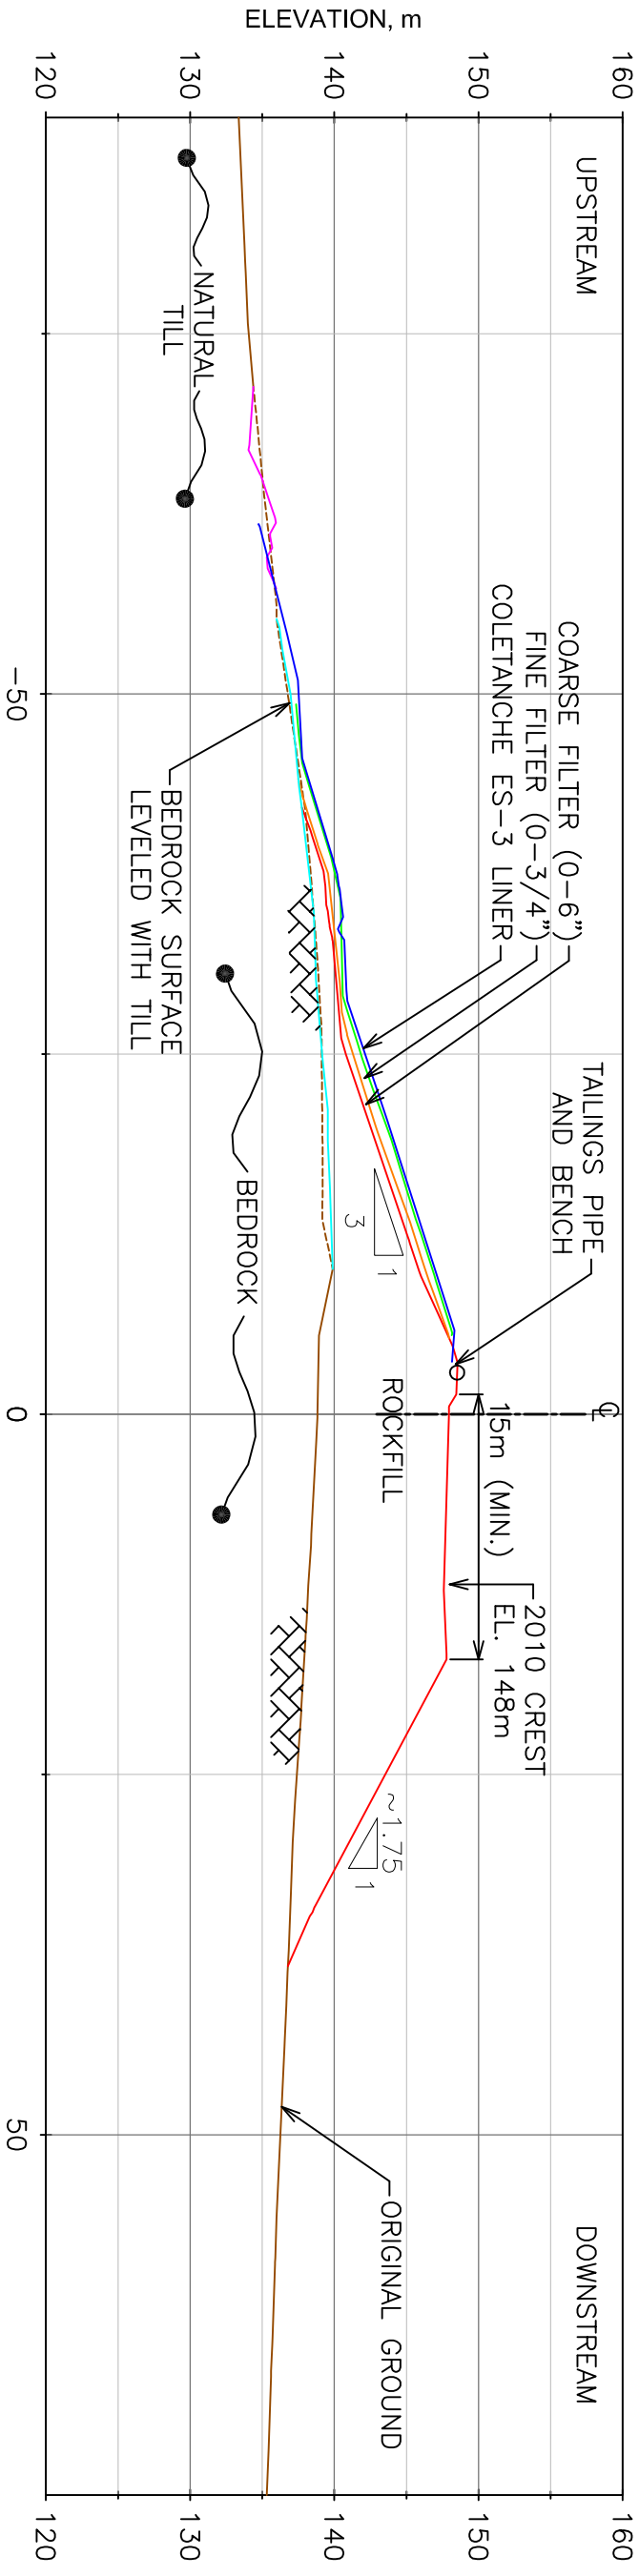


SECTION AT STA. 10+820.00

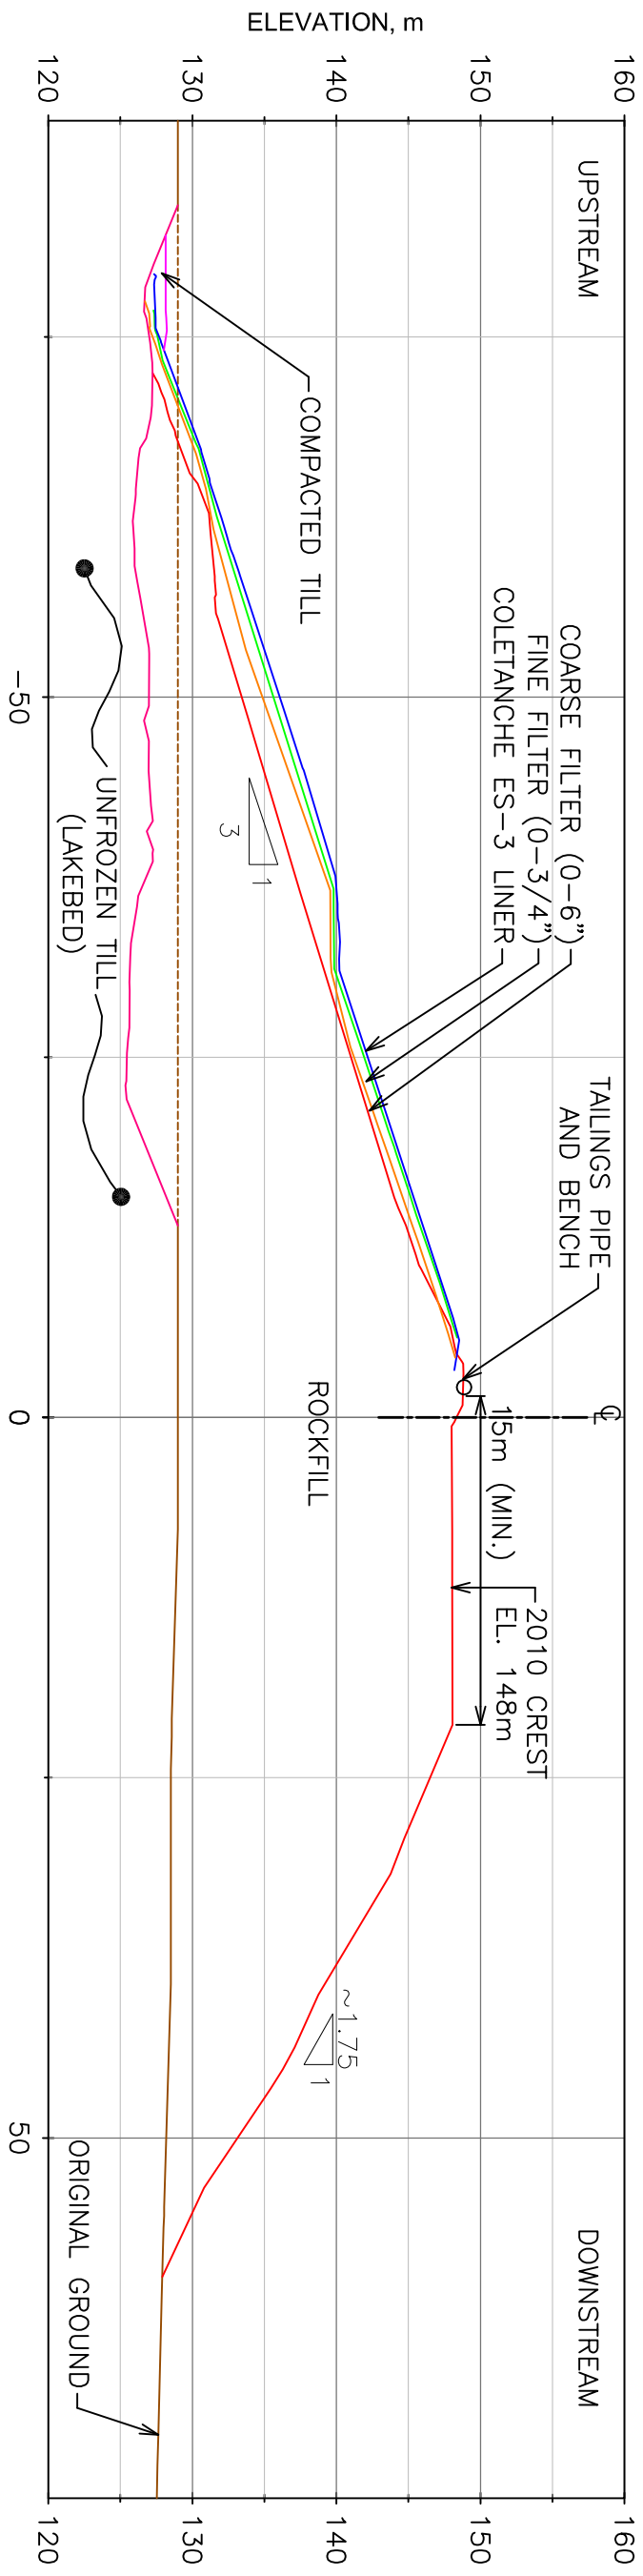

SECTION AT STA. 11+050.00

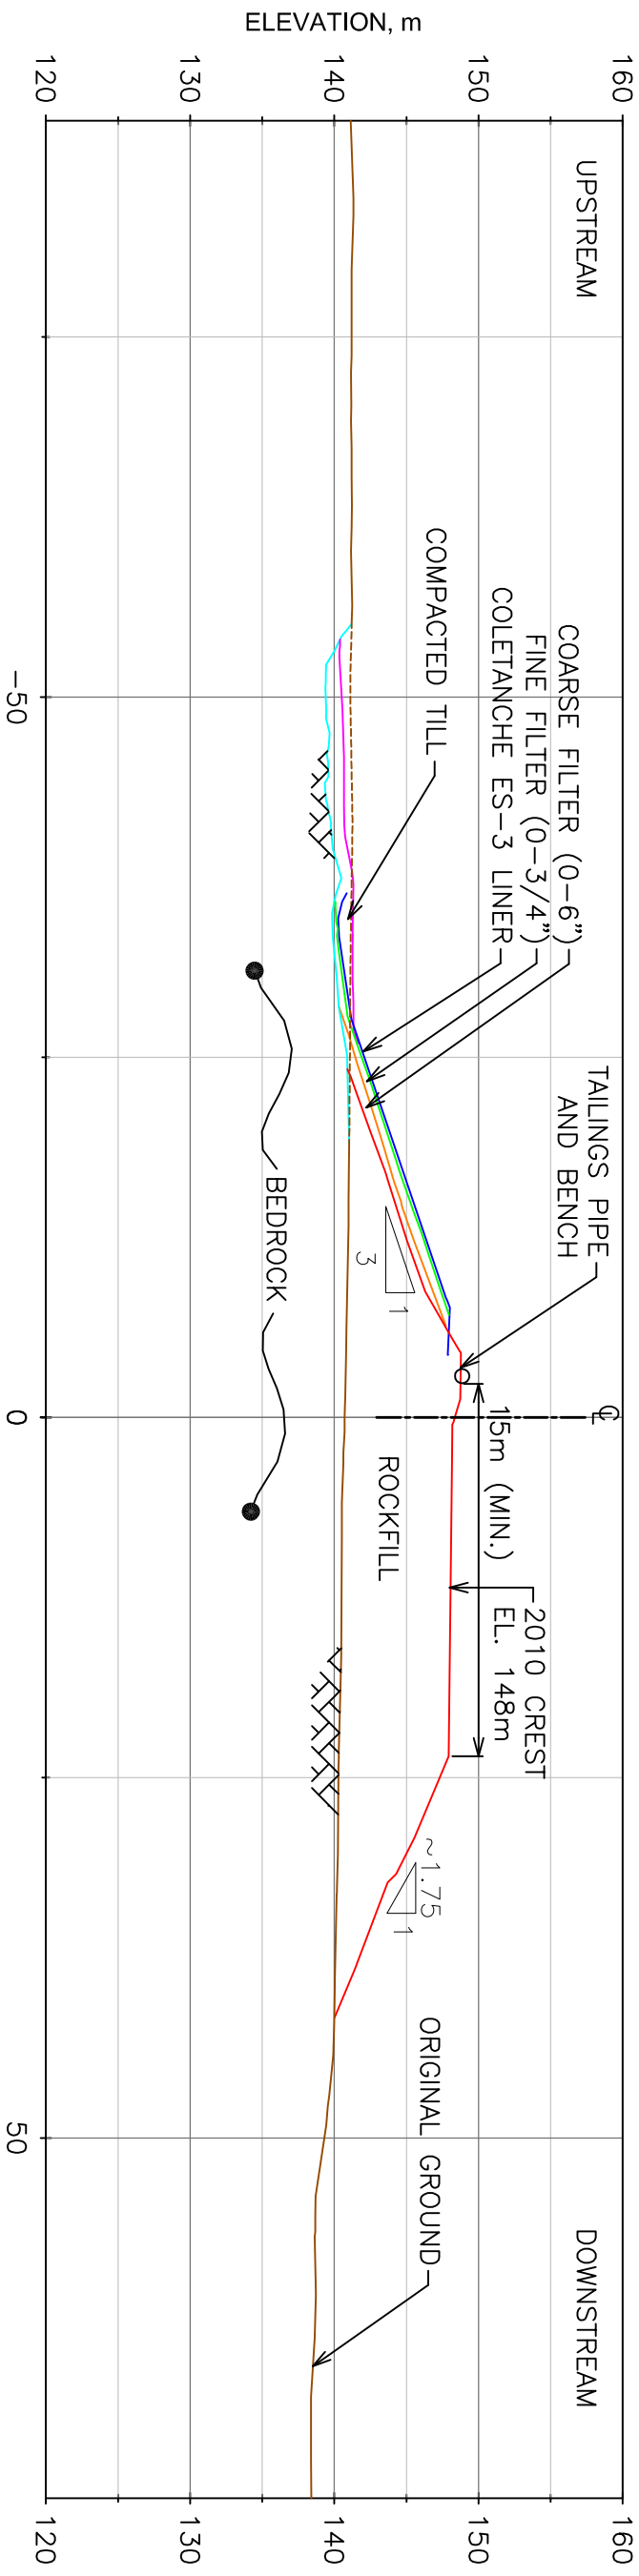

SECTIONS  
SCALE 1:500

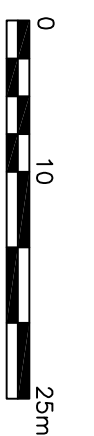

**AGNICO-EAGLE**  
MEADOWBANK DIVISION

TITLE  
AGNICO-EAGLE - MEADOWBANK DIVISION  
STORMWATER DIKE  
PLAN  
AS BUILT 2010

DESIGNED BY  
K. Macgillivray

CHECKED BY  
Y. Jobert

APPROVED BY  
Y. Jobert

SCALE  
AS SHOWN

DRAWING NO.  
DATE  
2010/09/28

PROJECT NO.  
REVISION  
SHEET  
1 / 1