

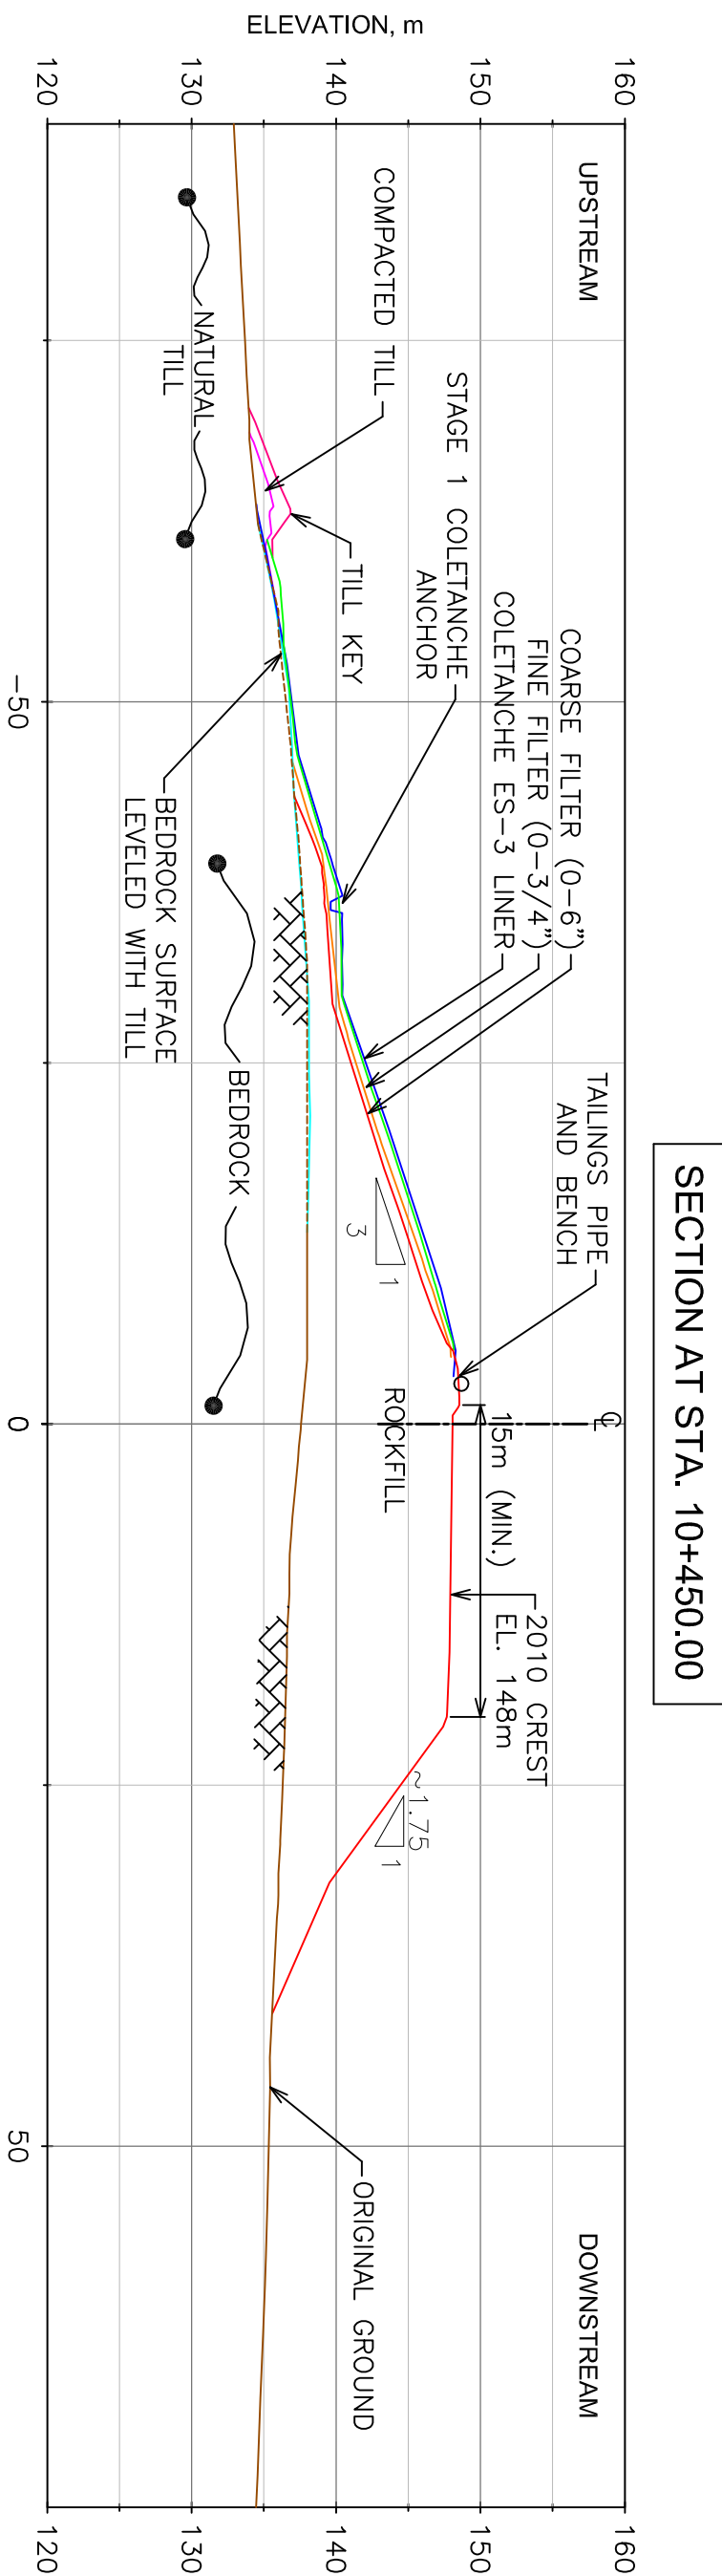
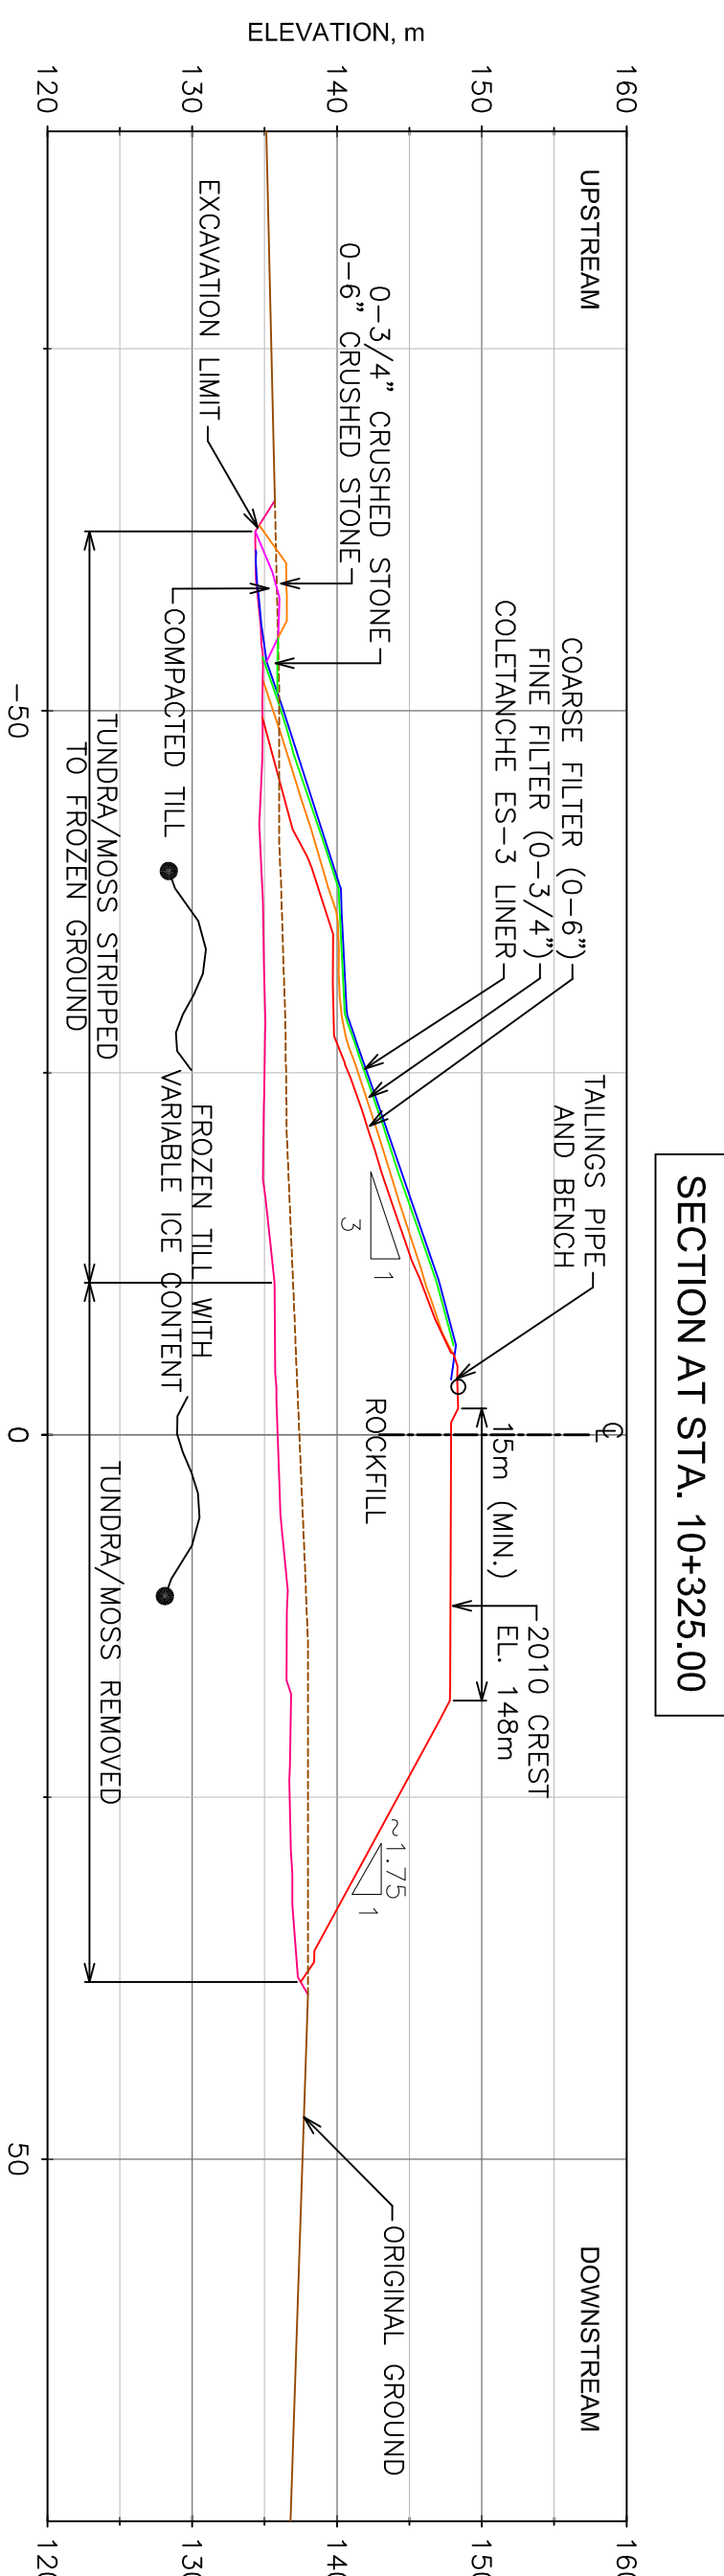
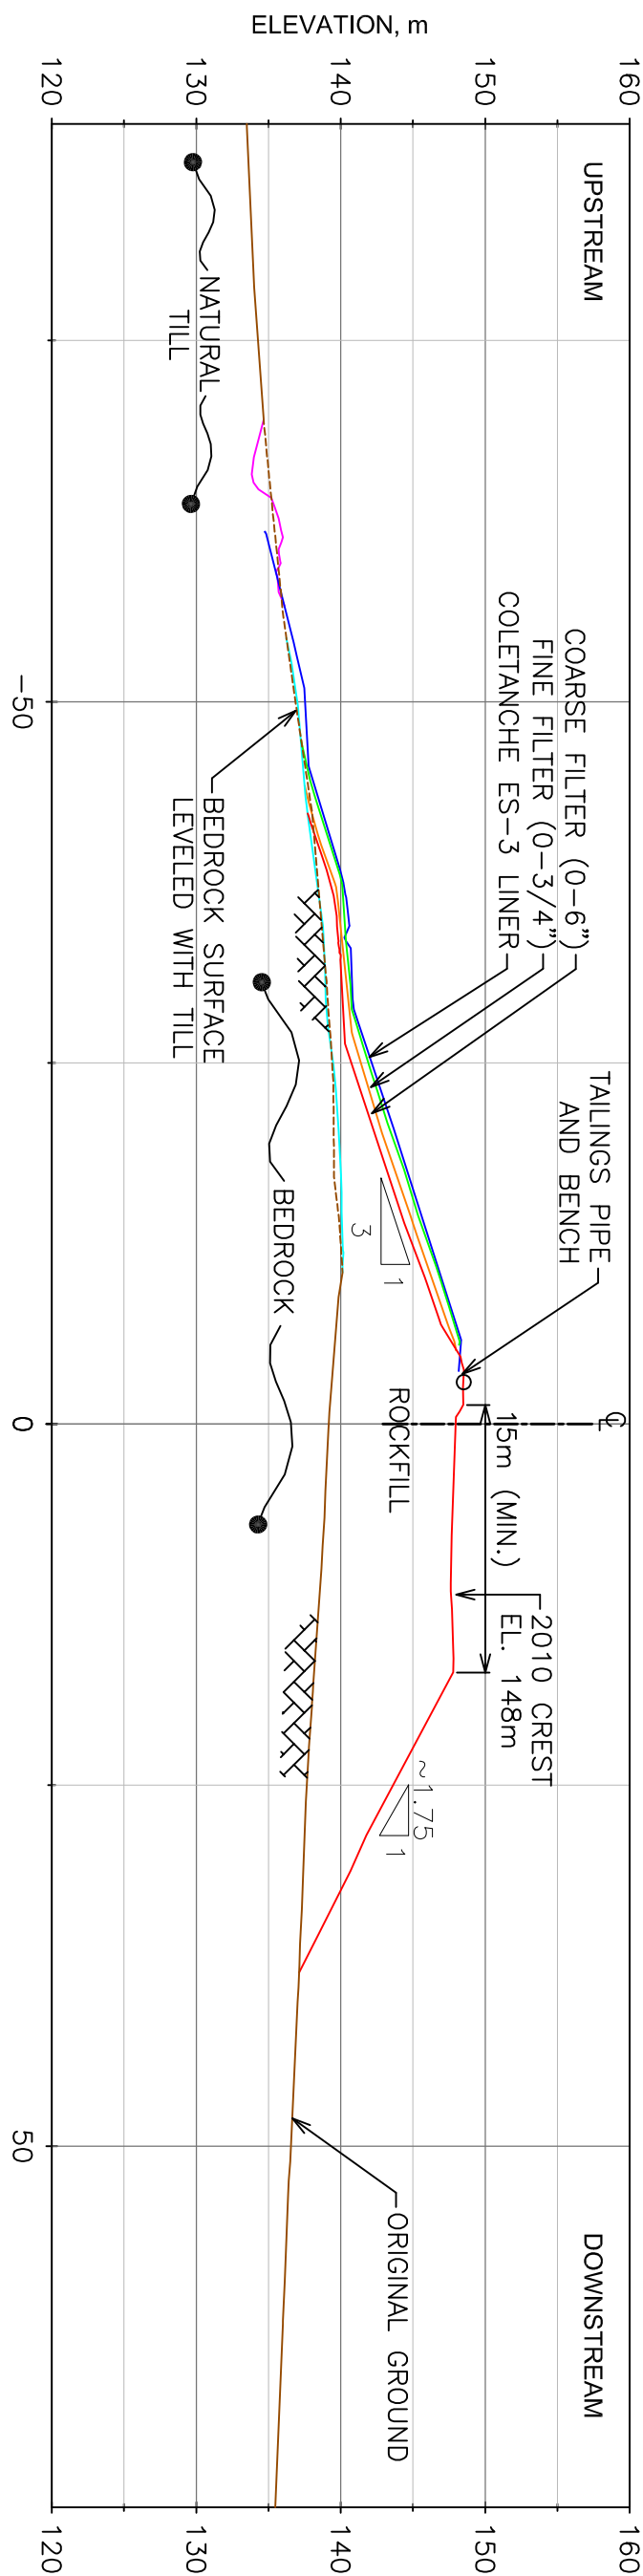
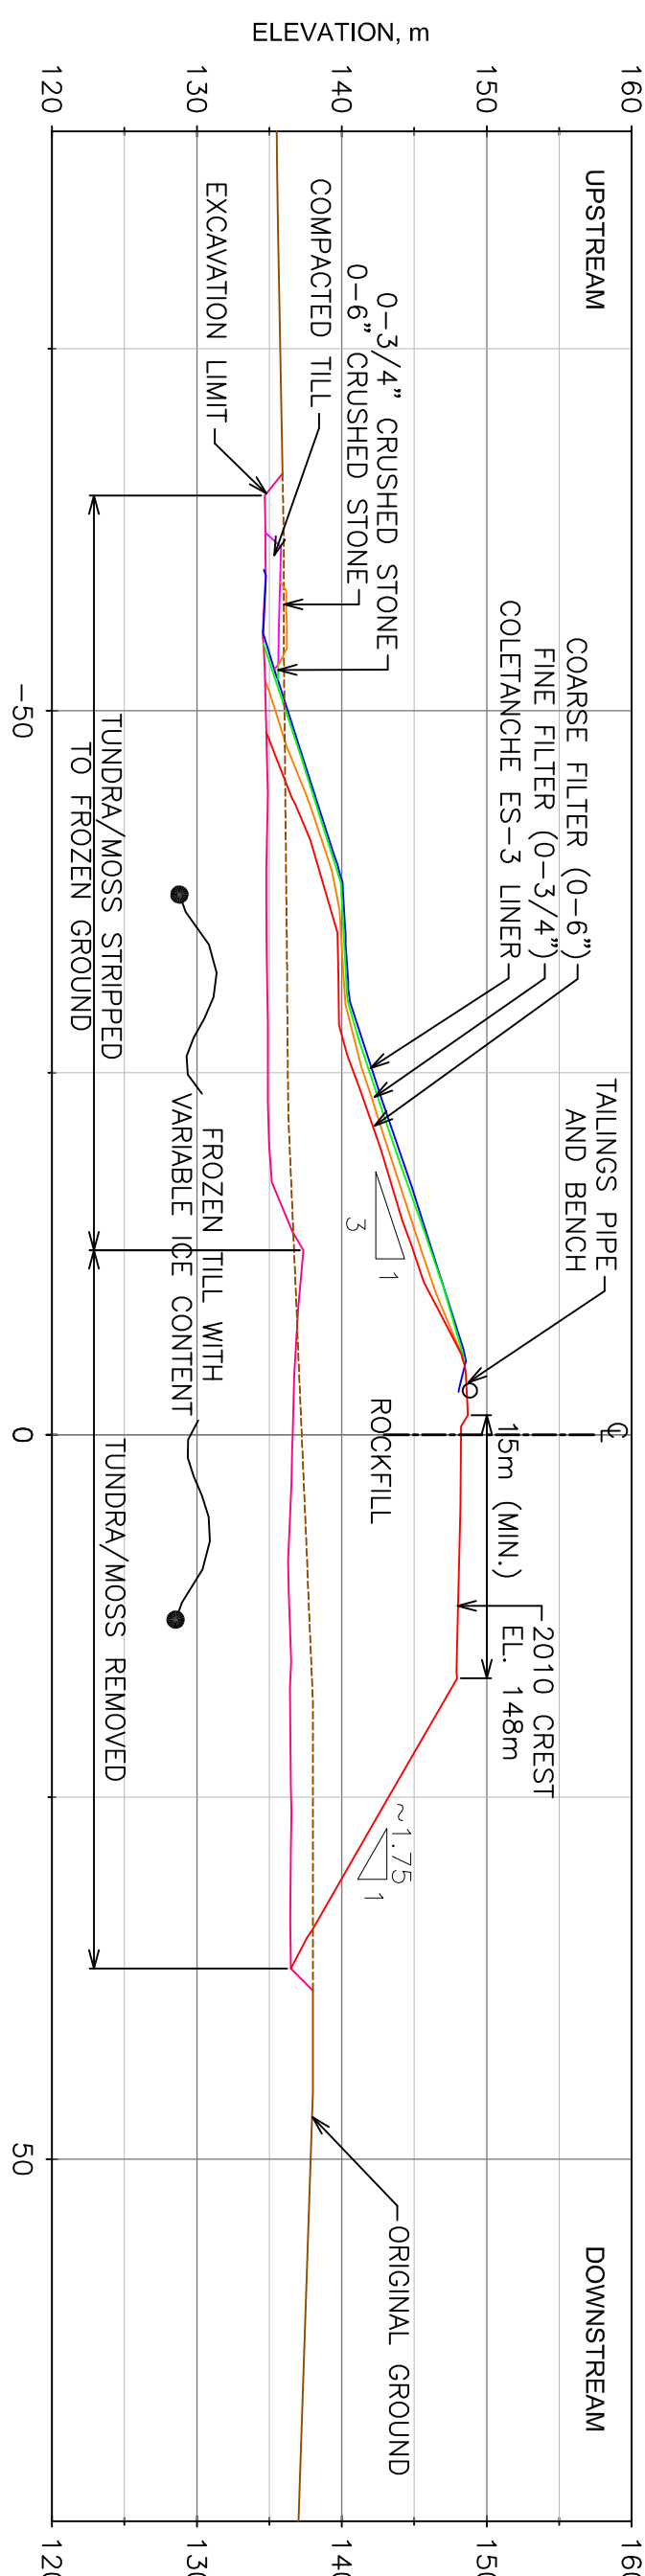
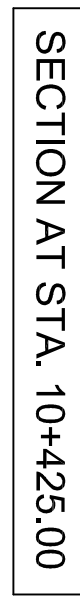
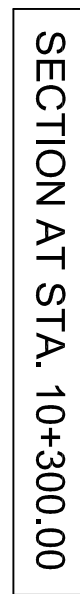
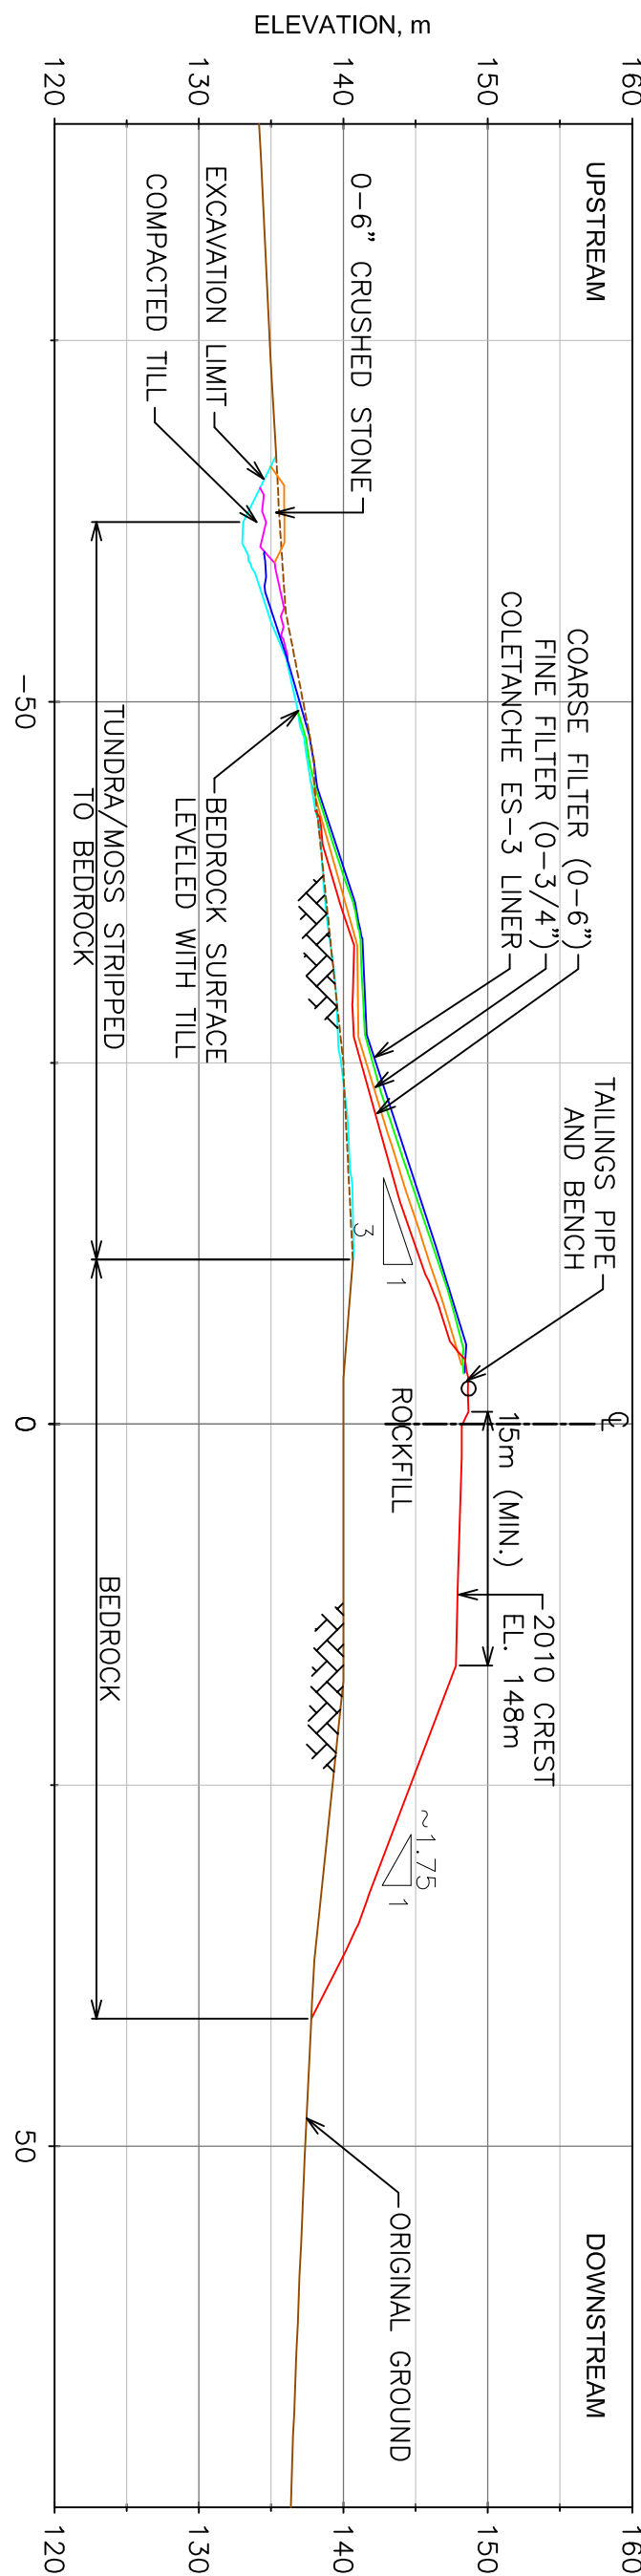
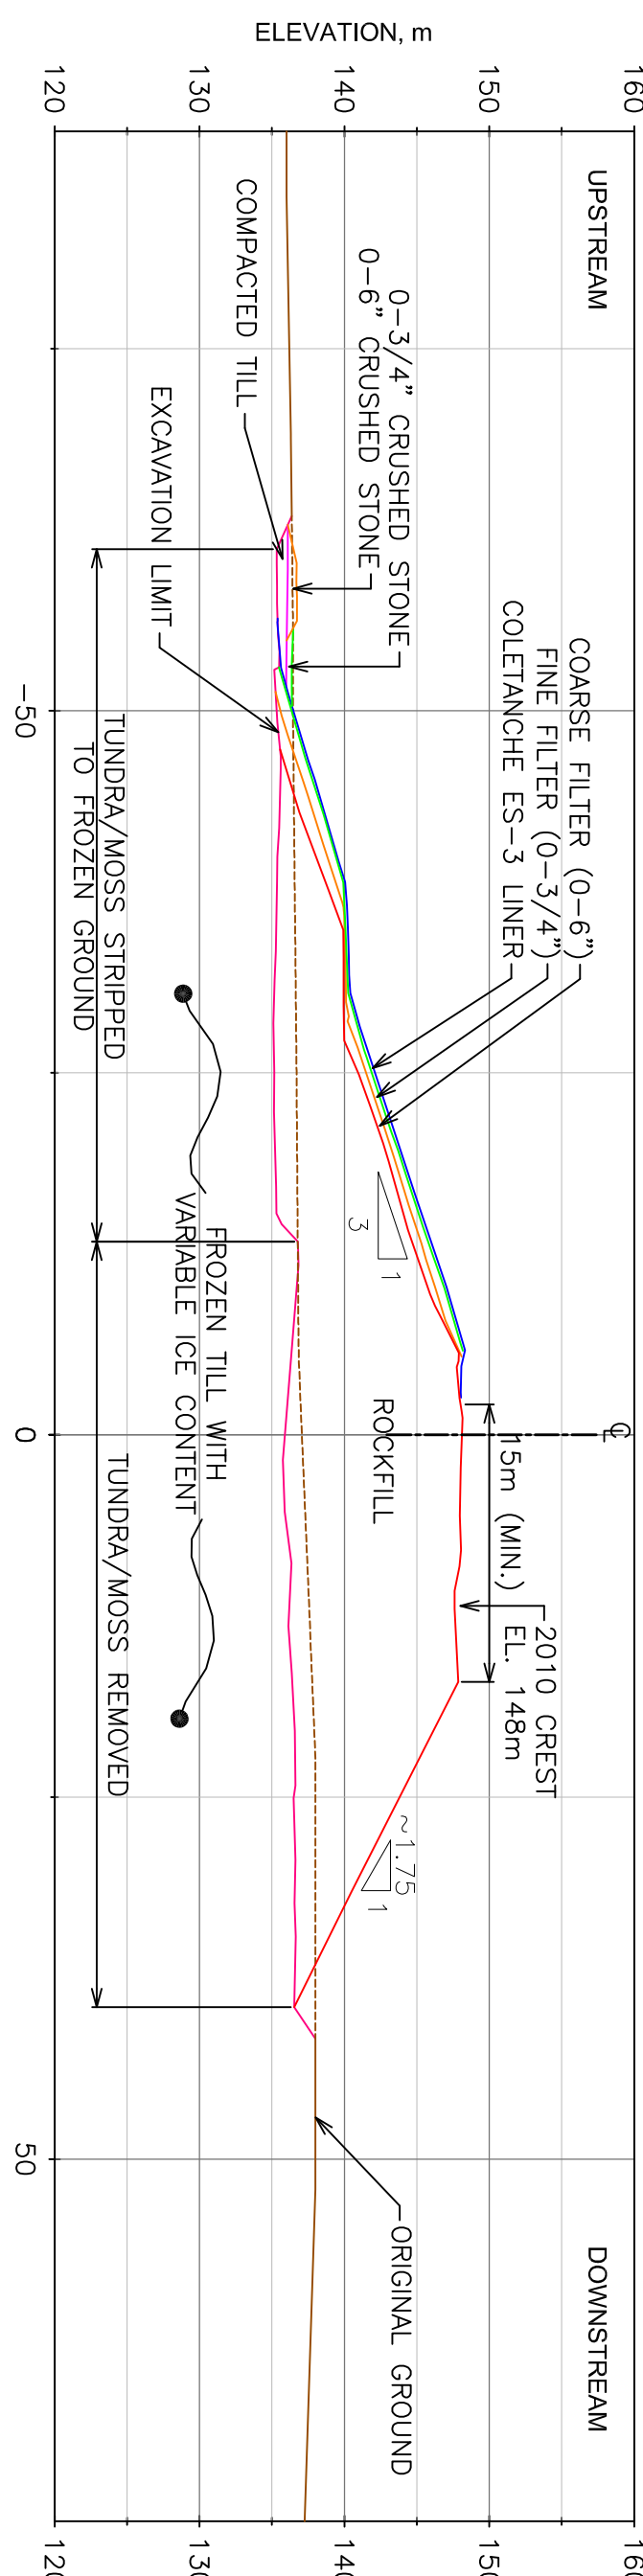
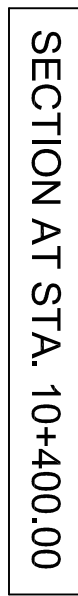
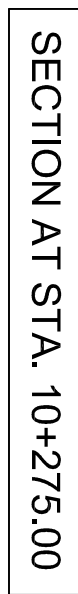
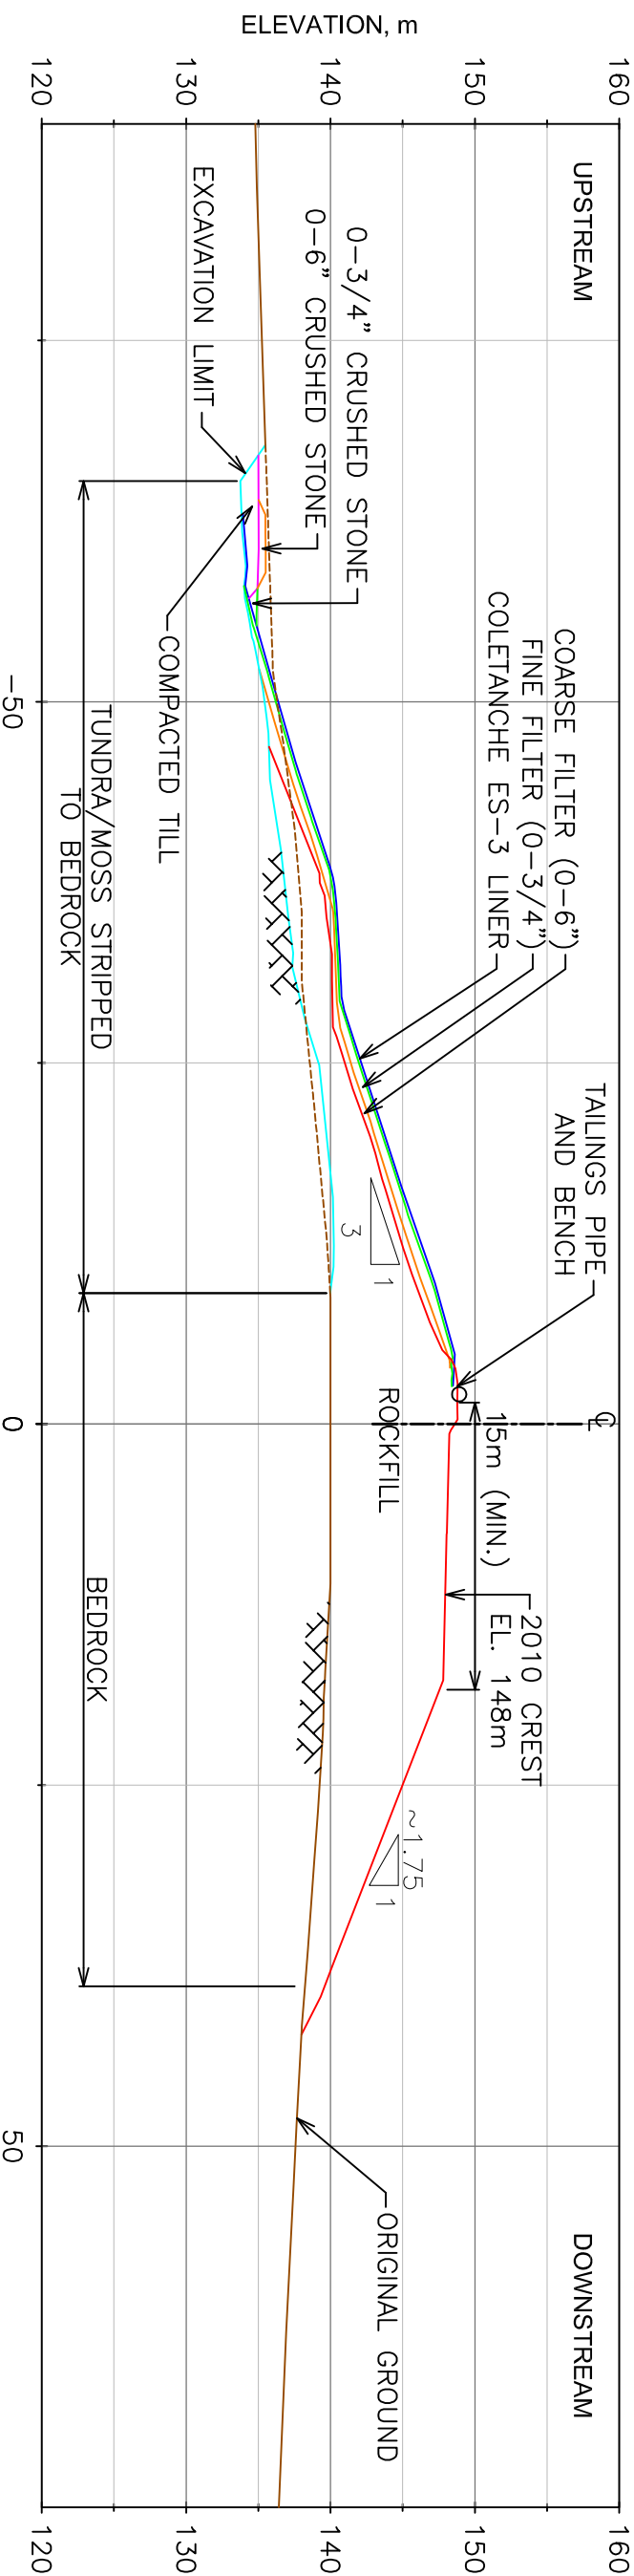
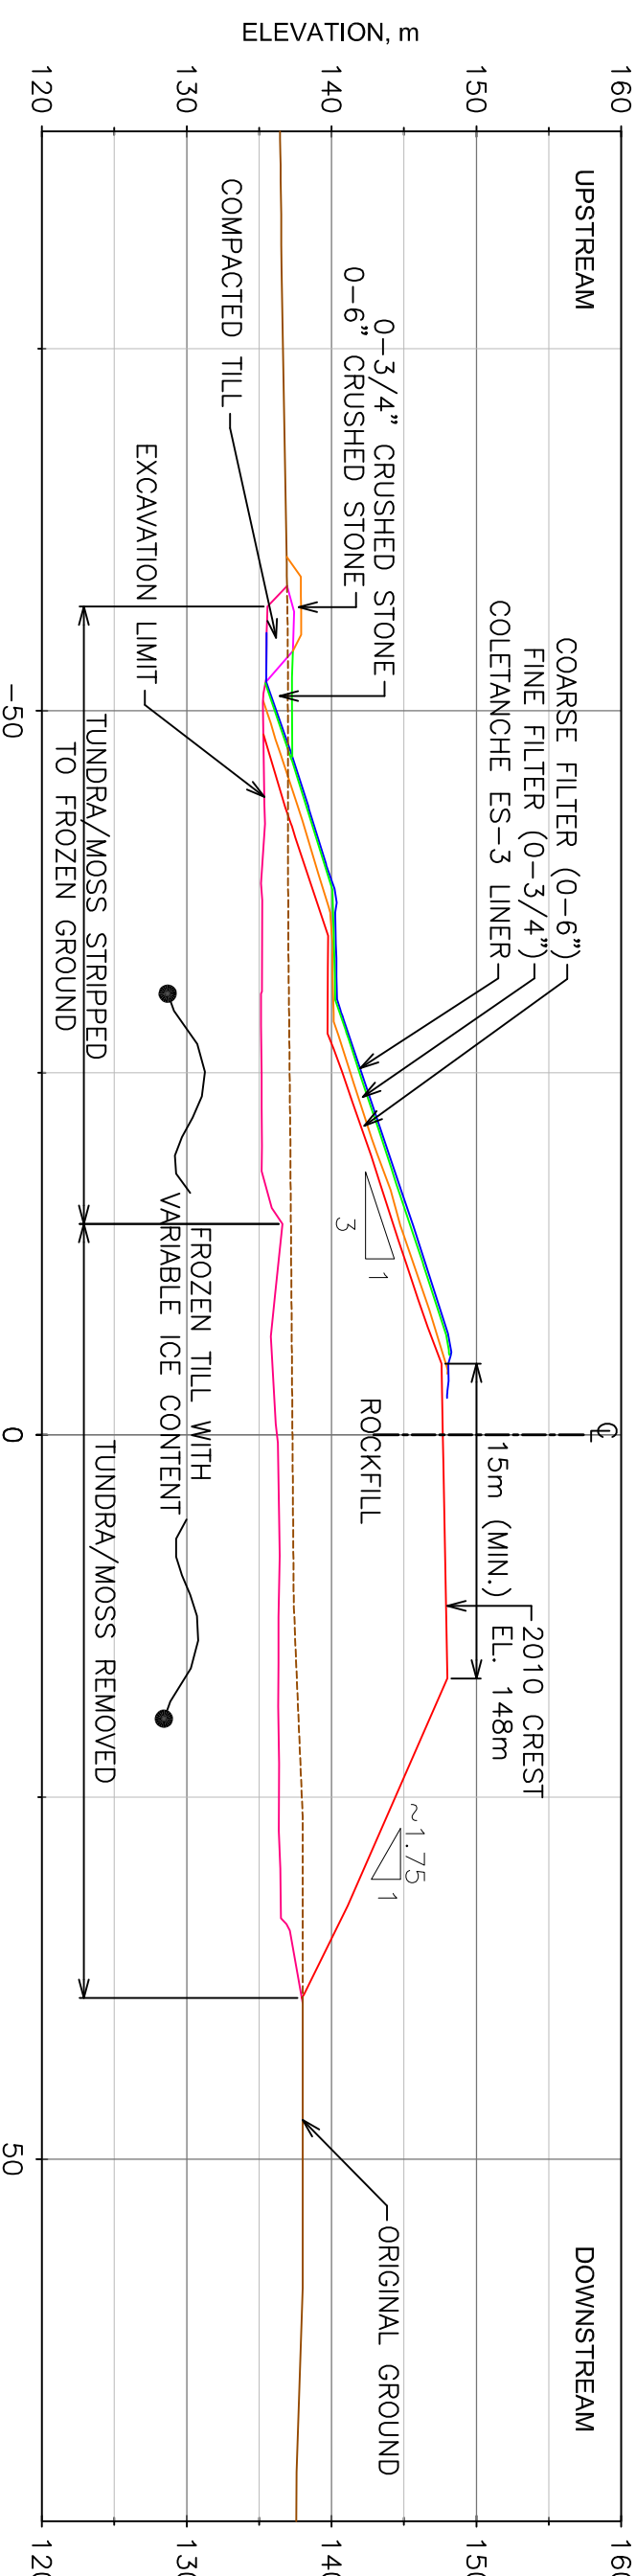
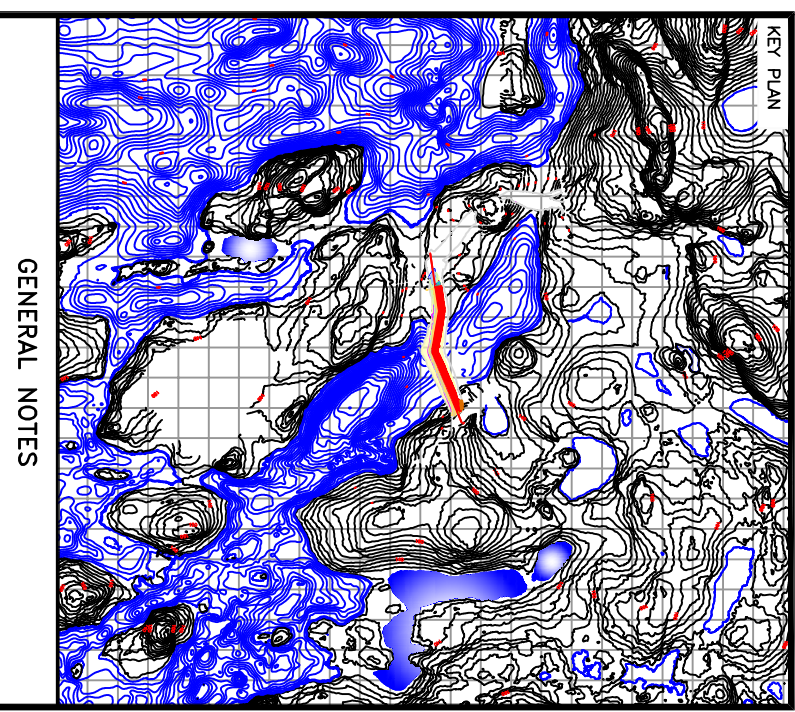


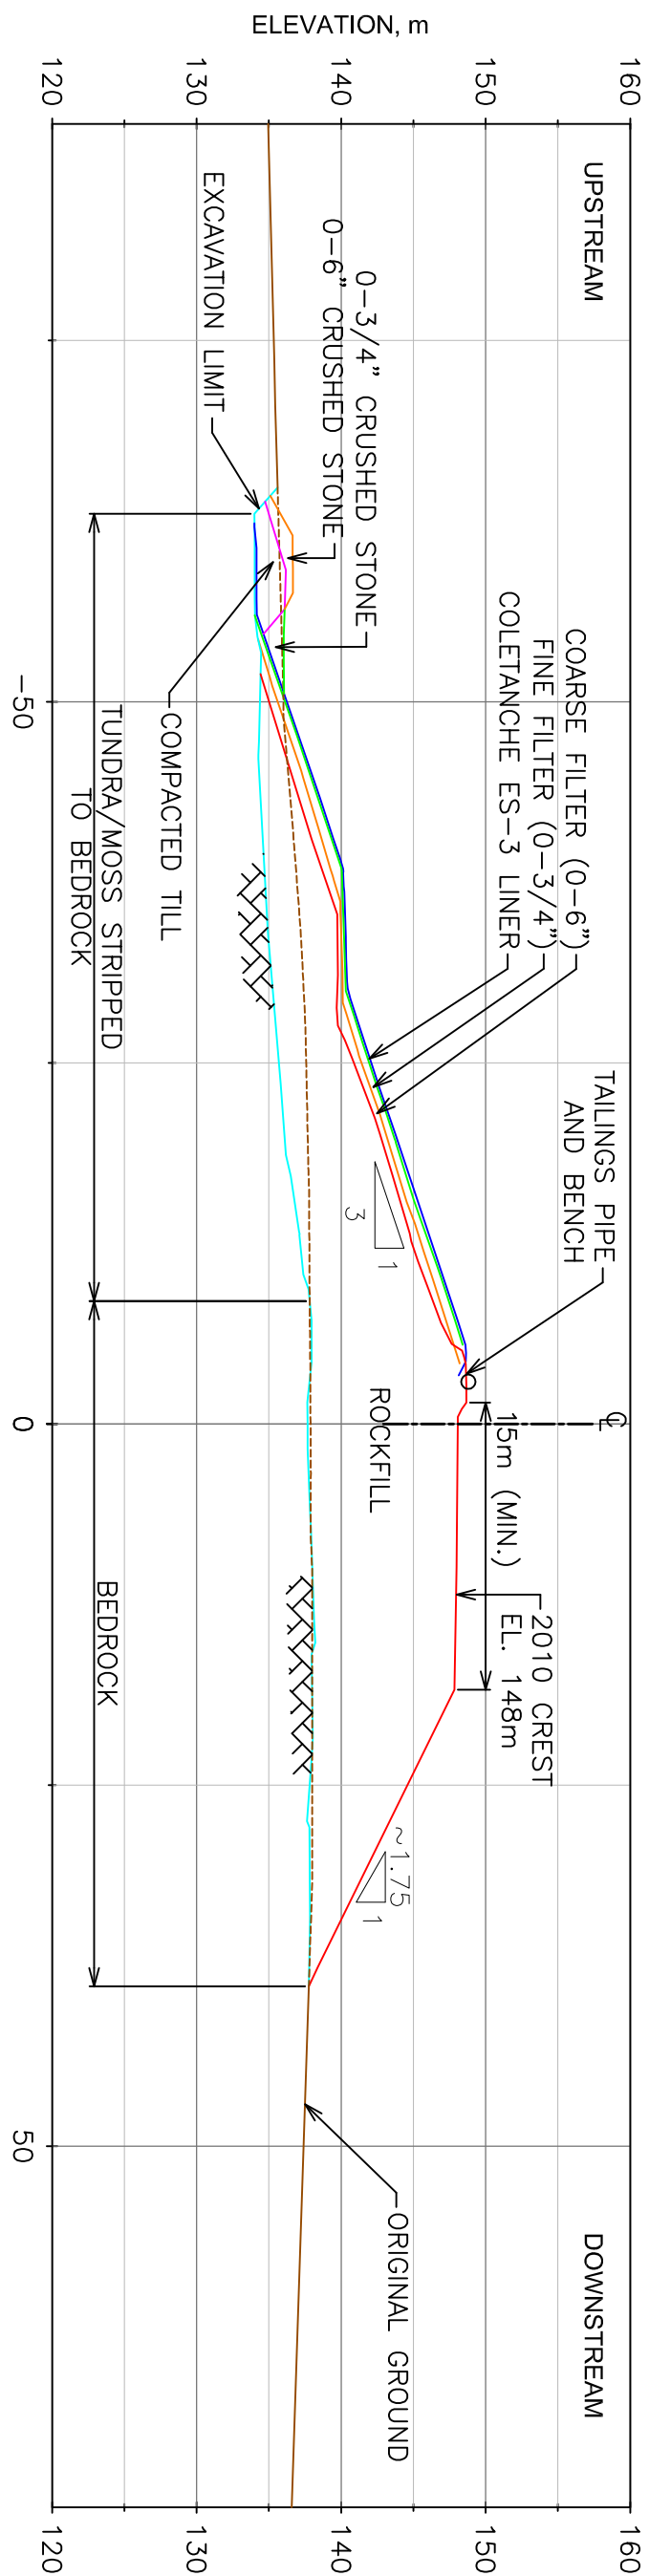

ANY OTHER, PRACTICAL TO OTHERS AND ARE USE D0271 THAT FOR WHICH IT IS (LAND) ARE 99200111. © KAND-SCALE LTD.

--	--	--

[illegible]

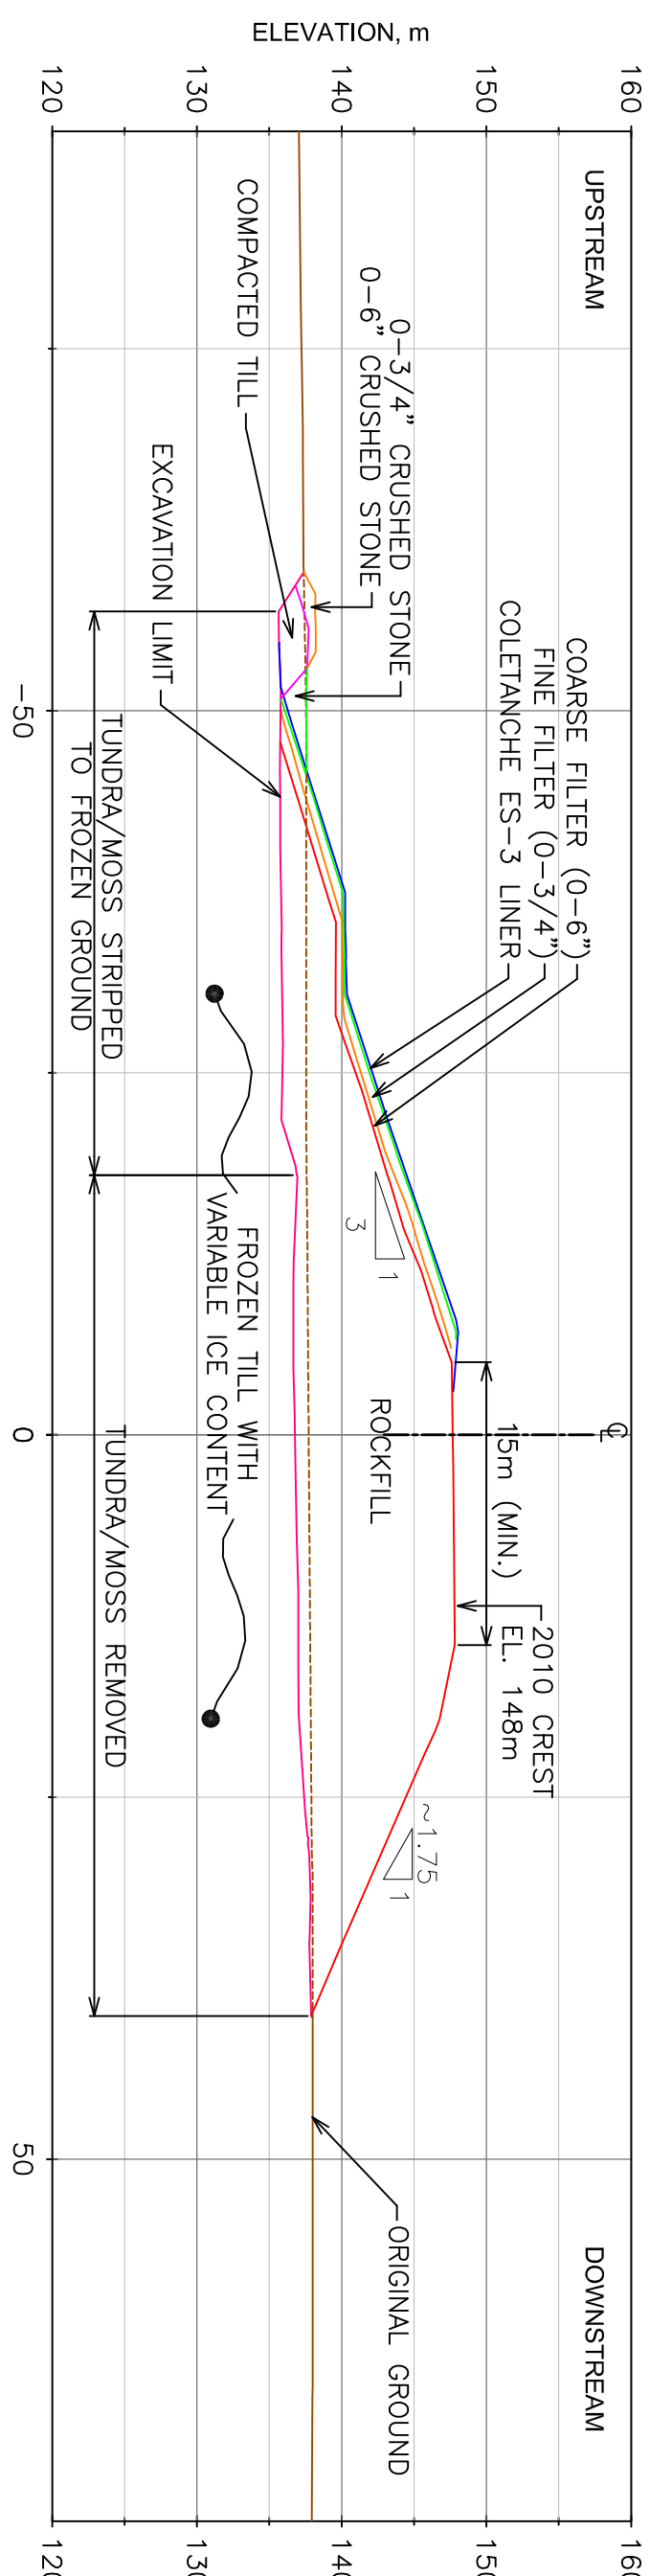

AGNICO-EAGLE
MEADOWBANK DIVISION

AGNICO-EAGLE

PROJECT NO.	DRAWING NO.	SCALE	DATE	DATE

AGNICO-EAGLE – MEADOWBANK DIVISION

STORMWATER DIKE

SECTIONS

AS BUILT 2010

DATE

2010/09/28

CHECKED BY Y. Jolbert	DRAWN BY K. MacGougane	DATE 2010/09/28

APPROVED BY

Y. Jolbert

DATE

REVISION	SHEET
	1 / 4

