
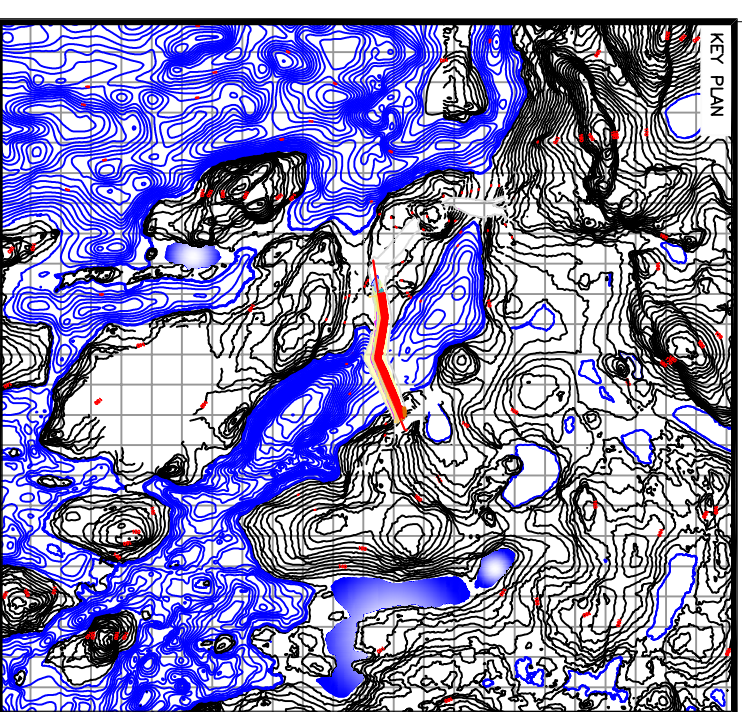
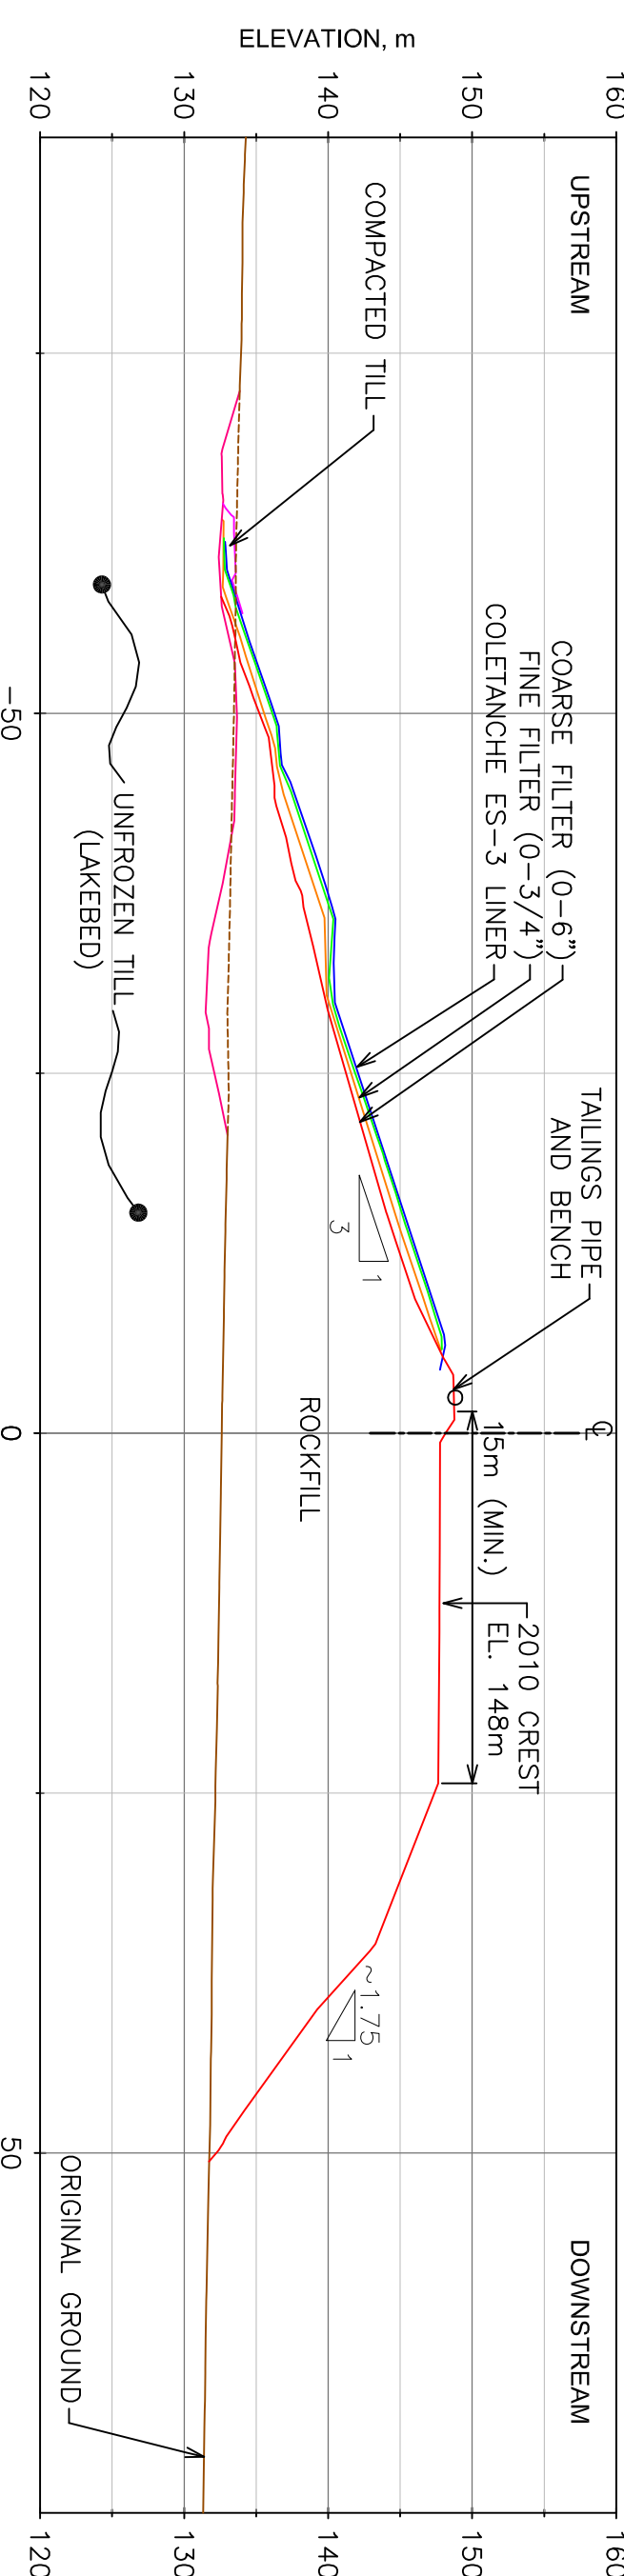
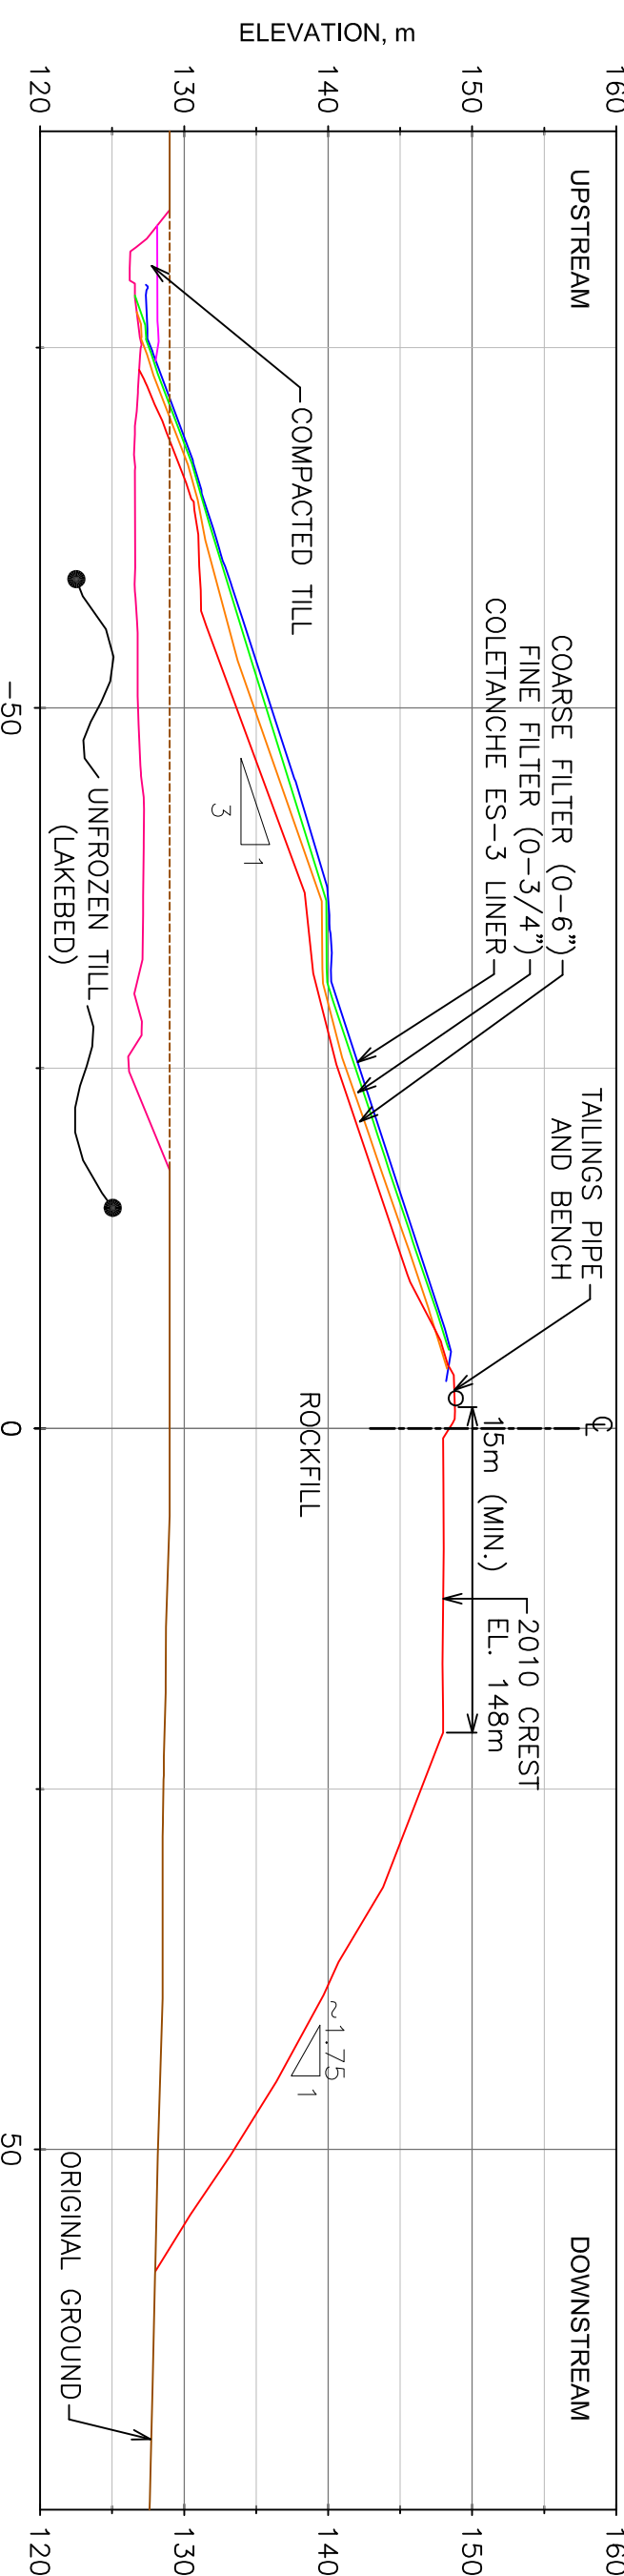
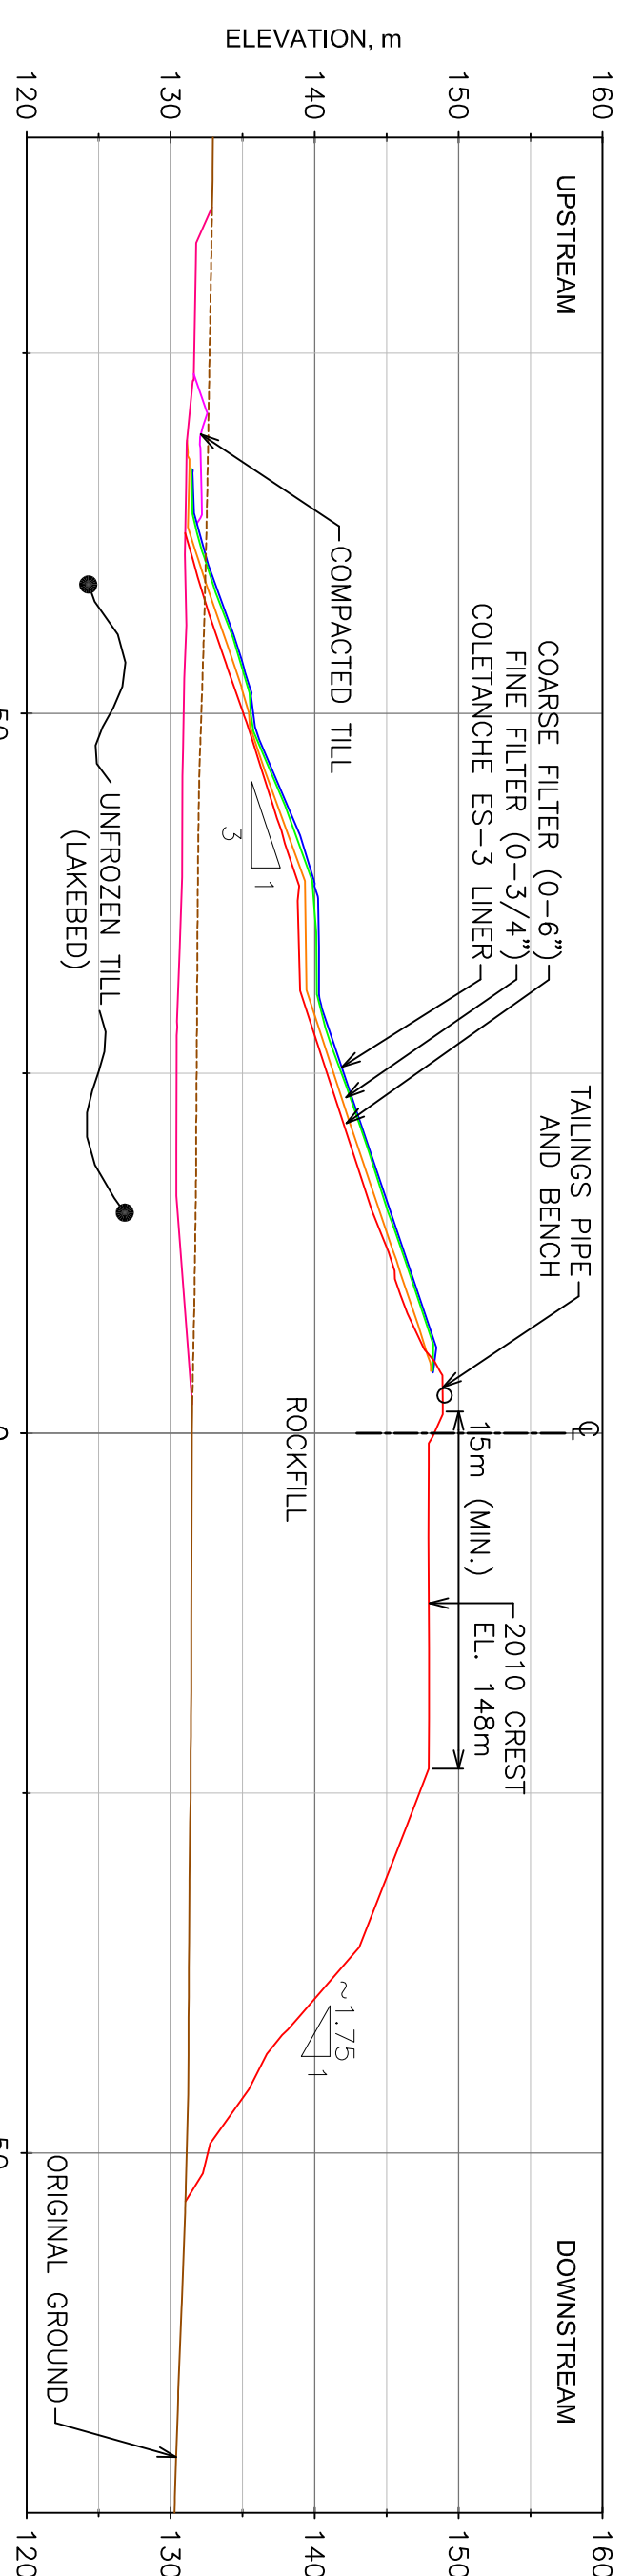
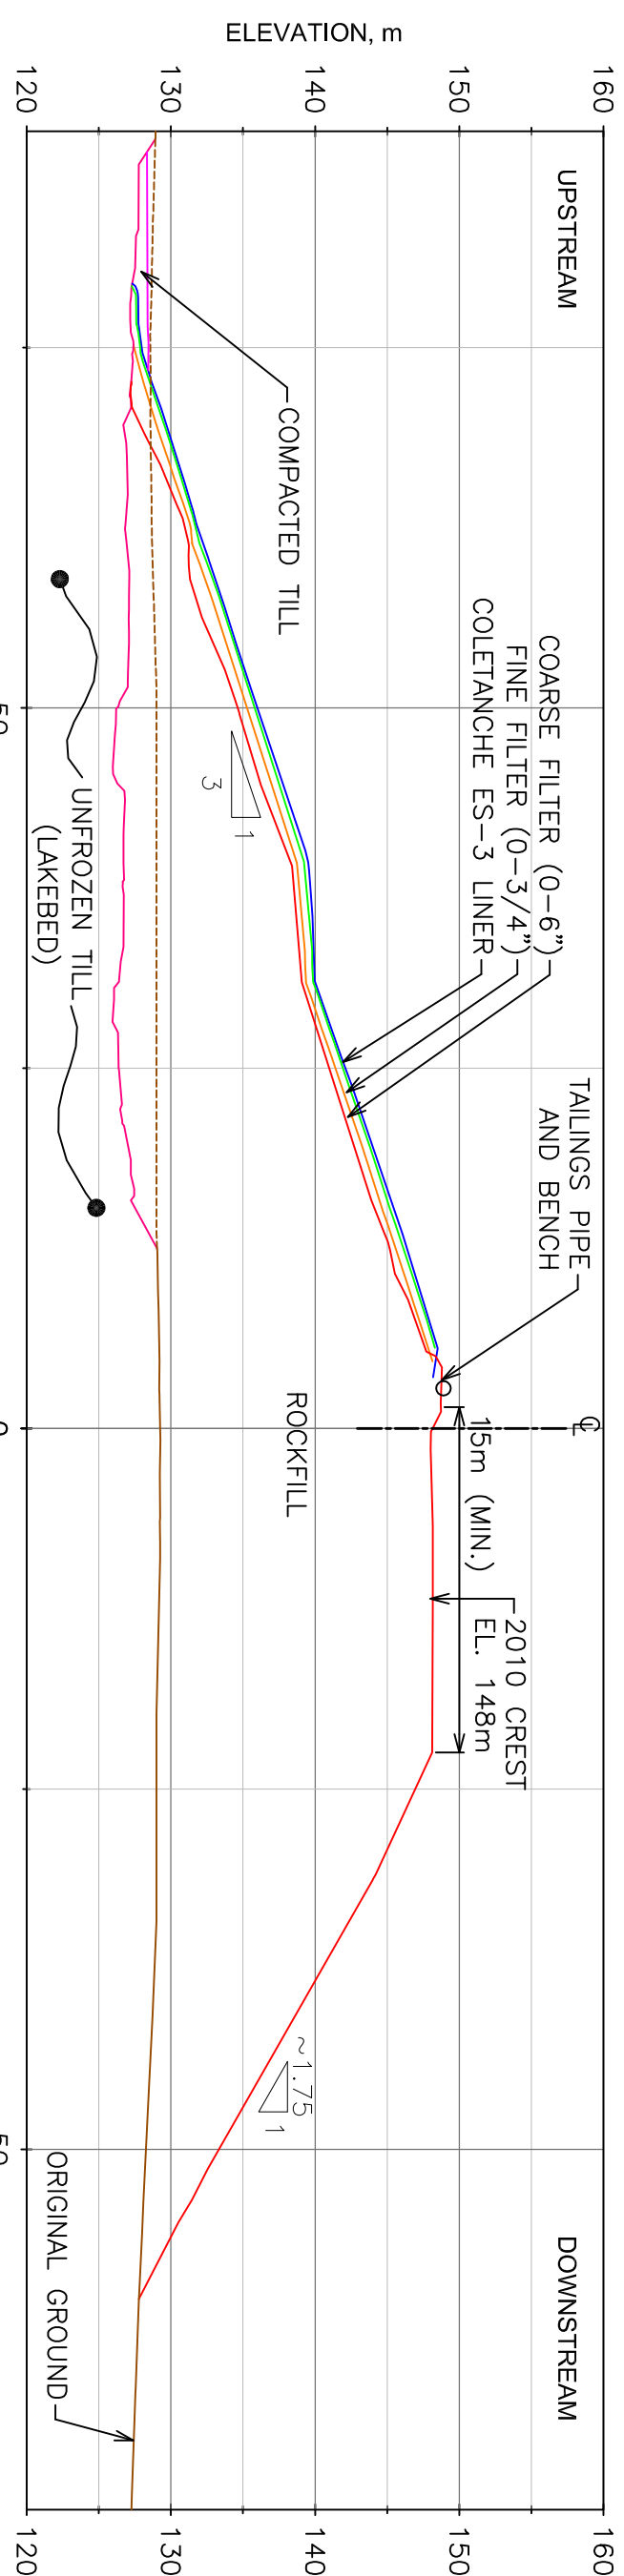
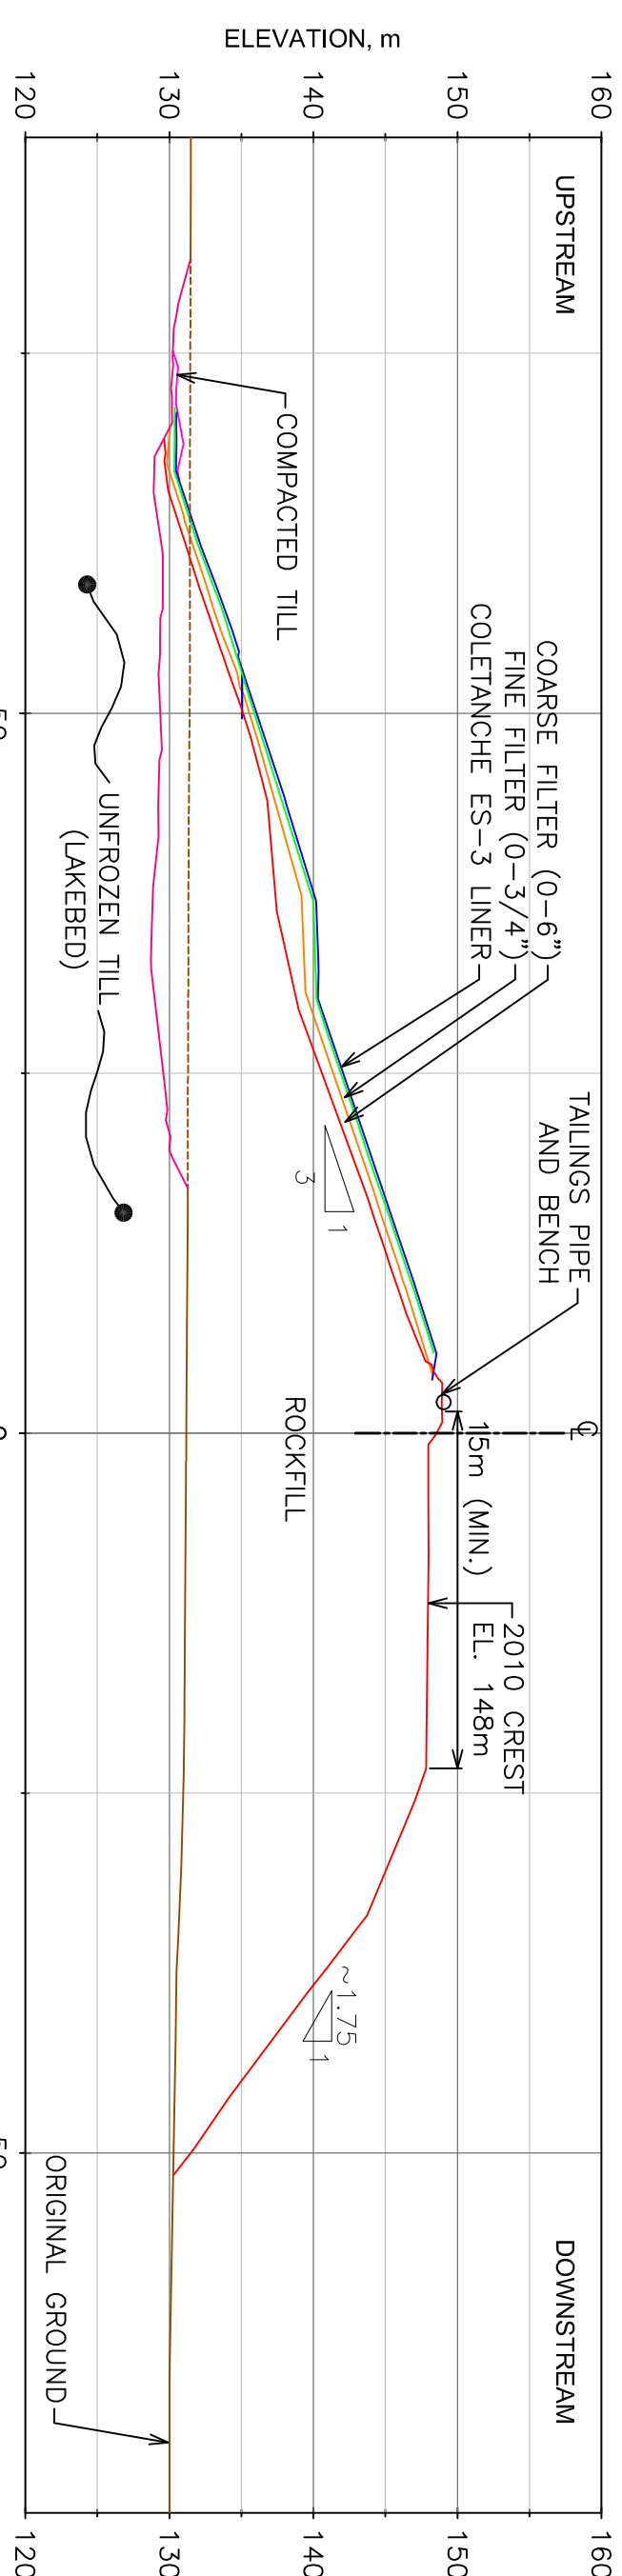
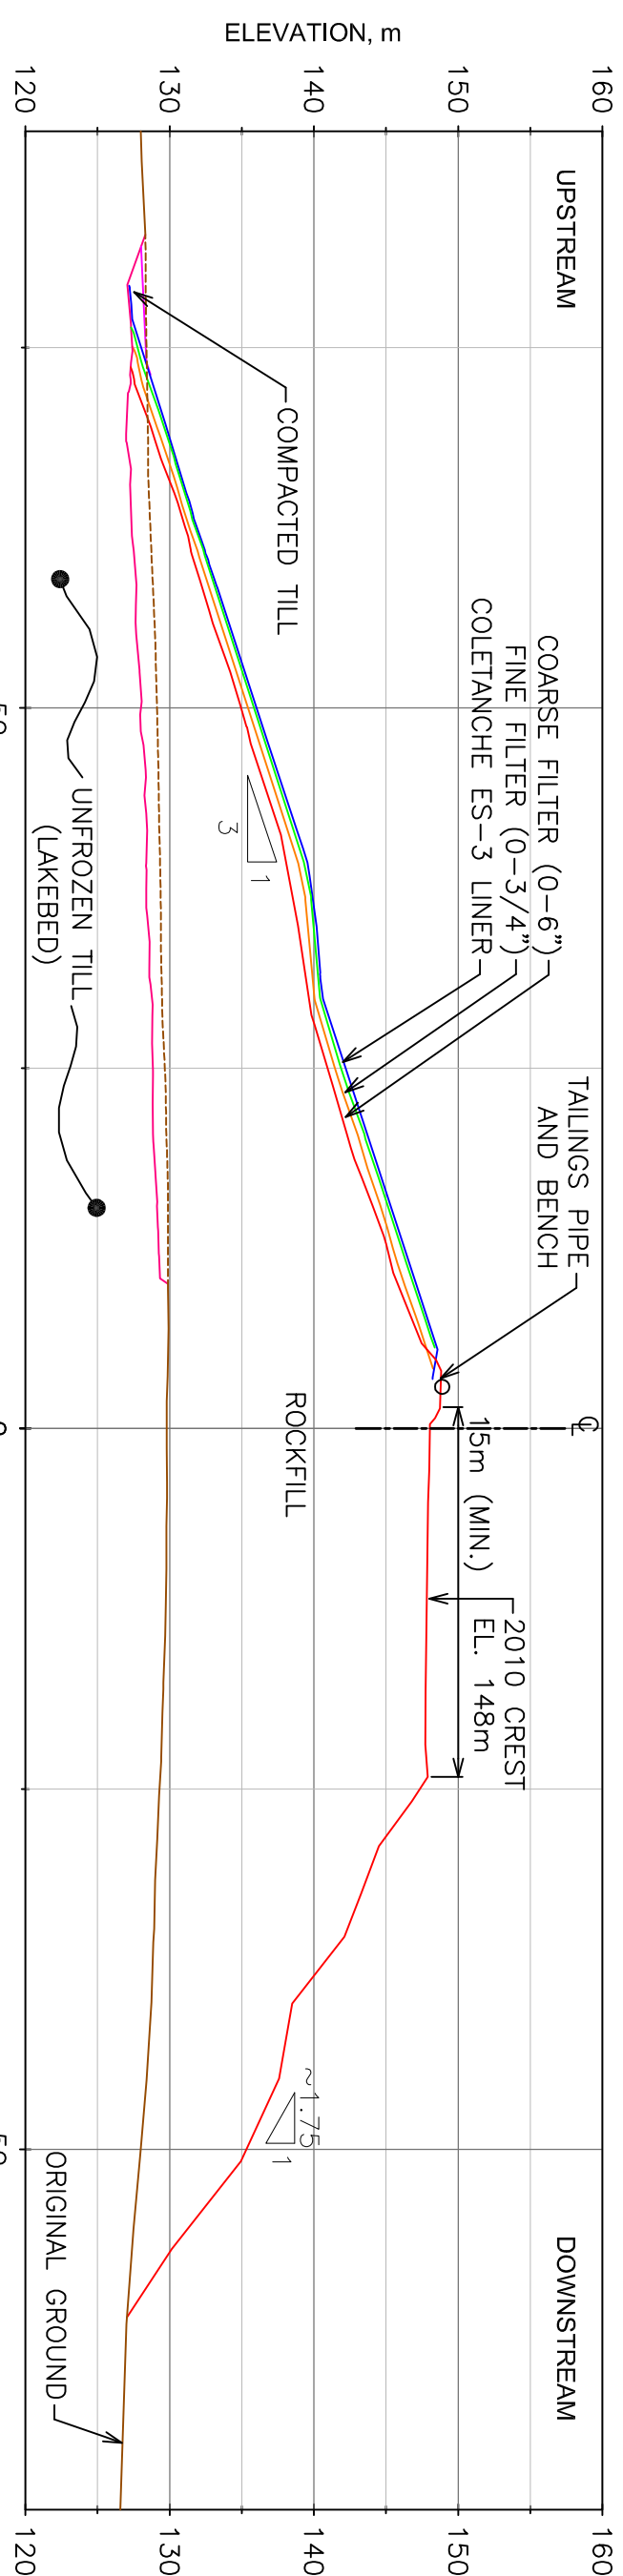
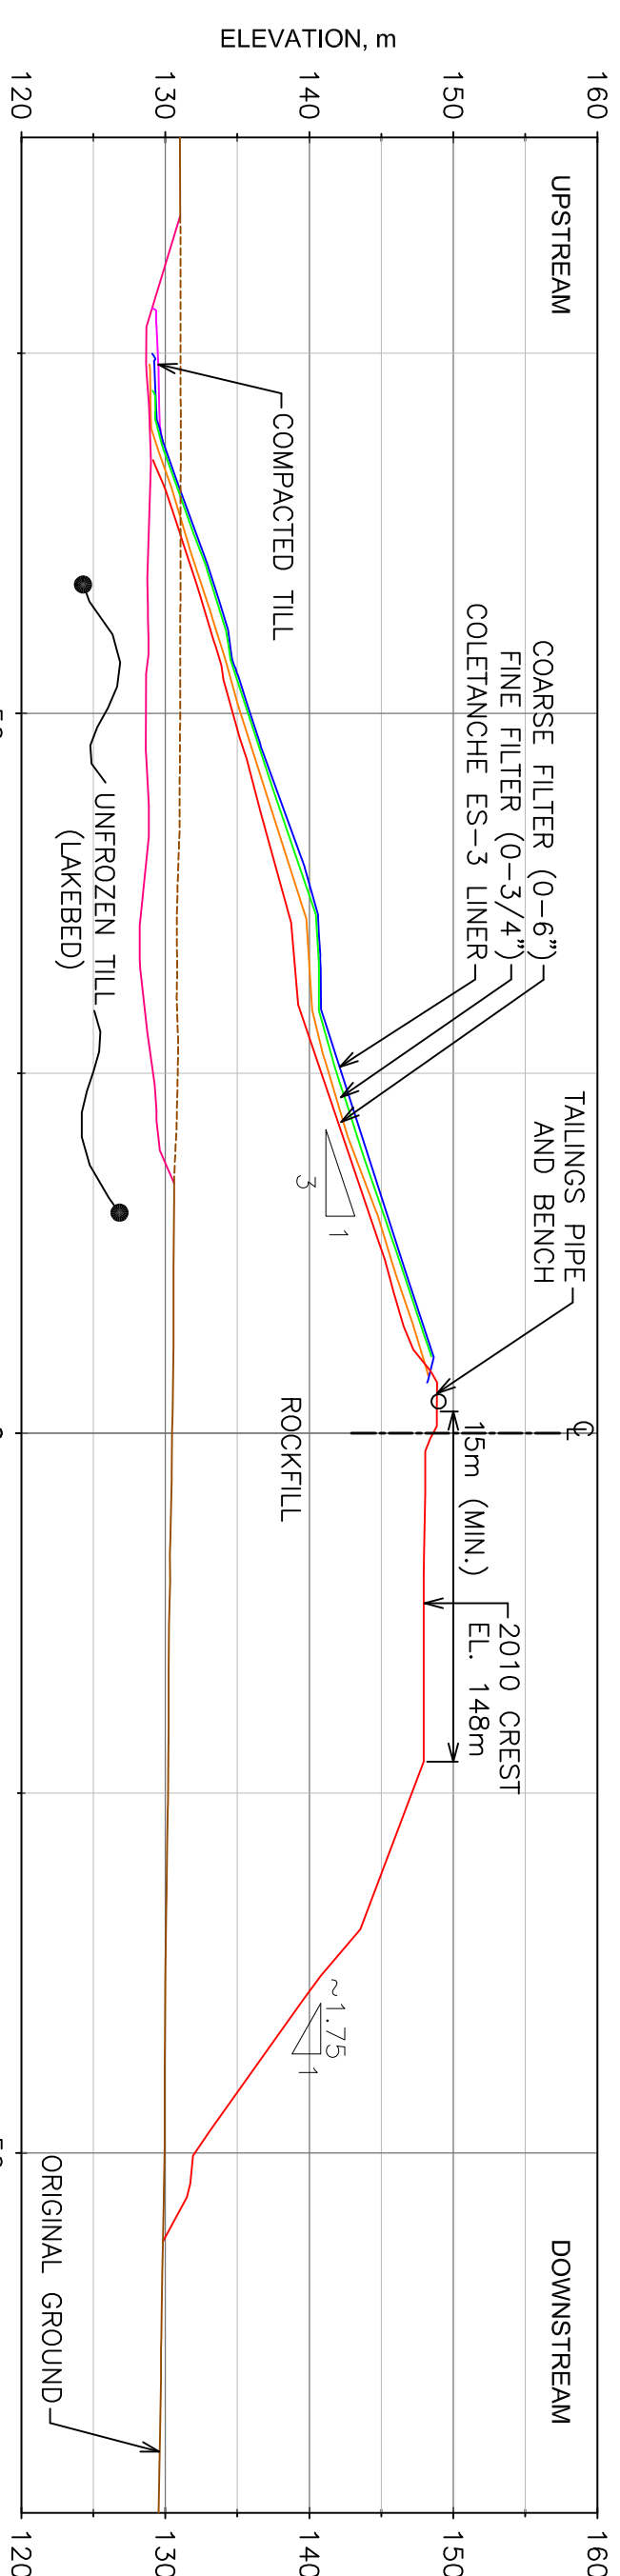
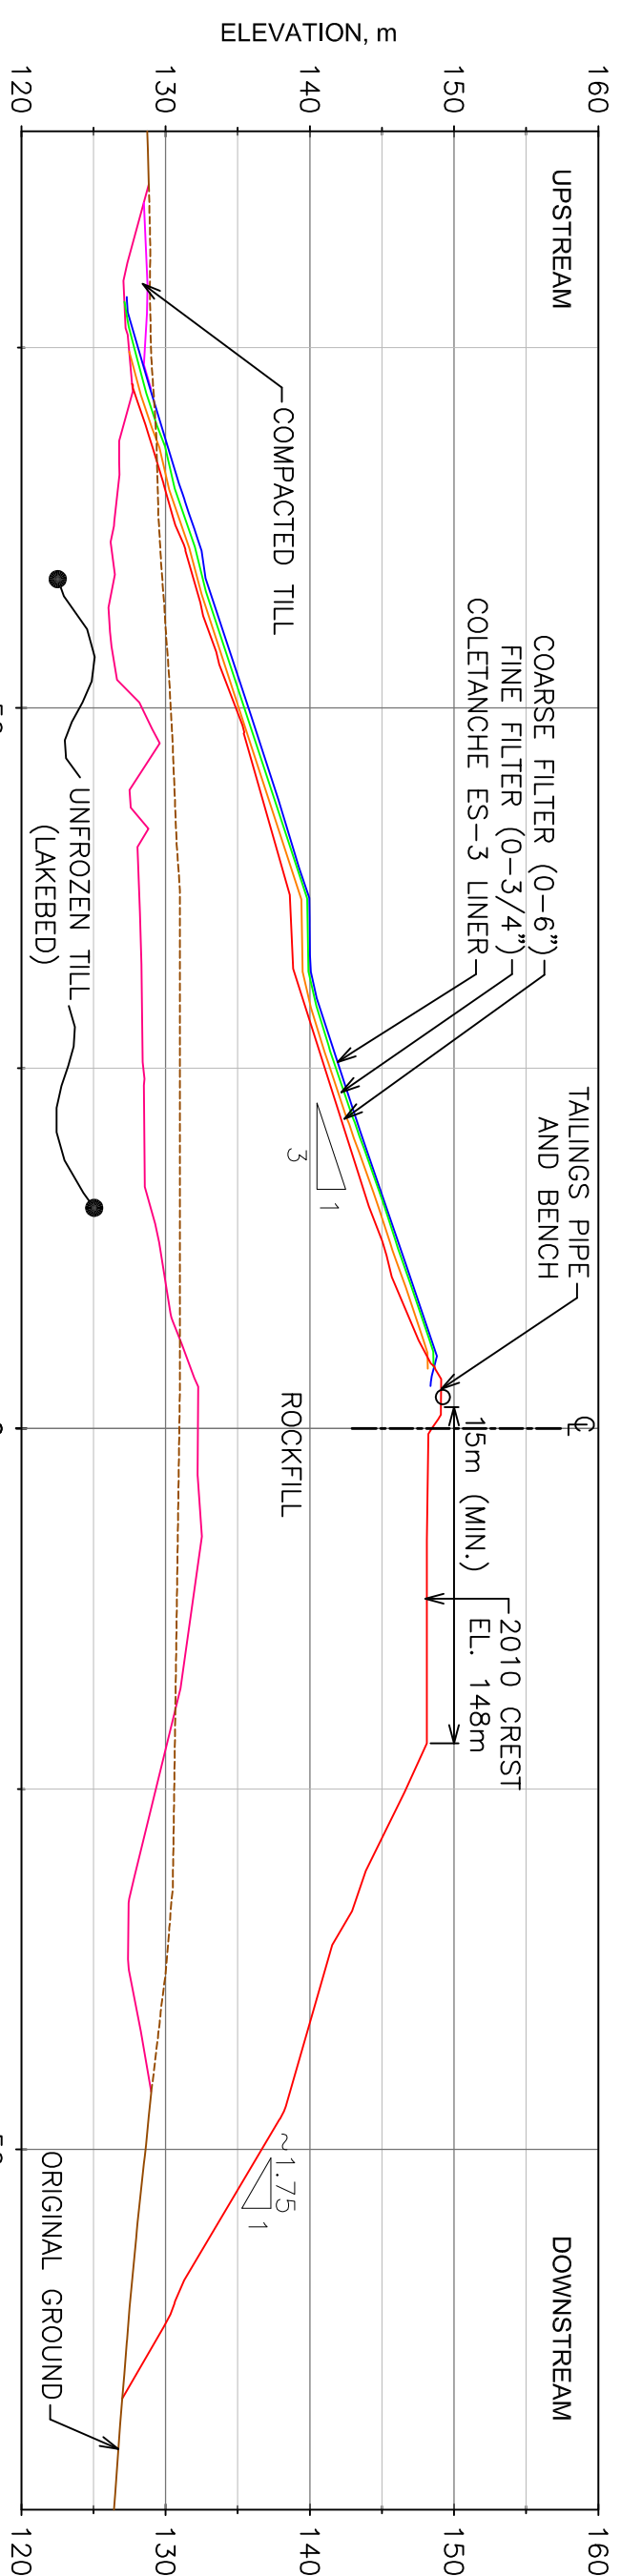
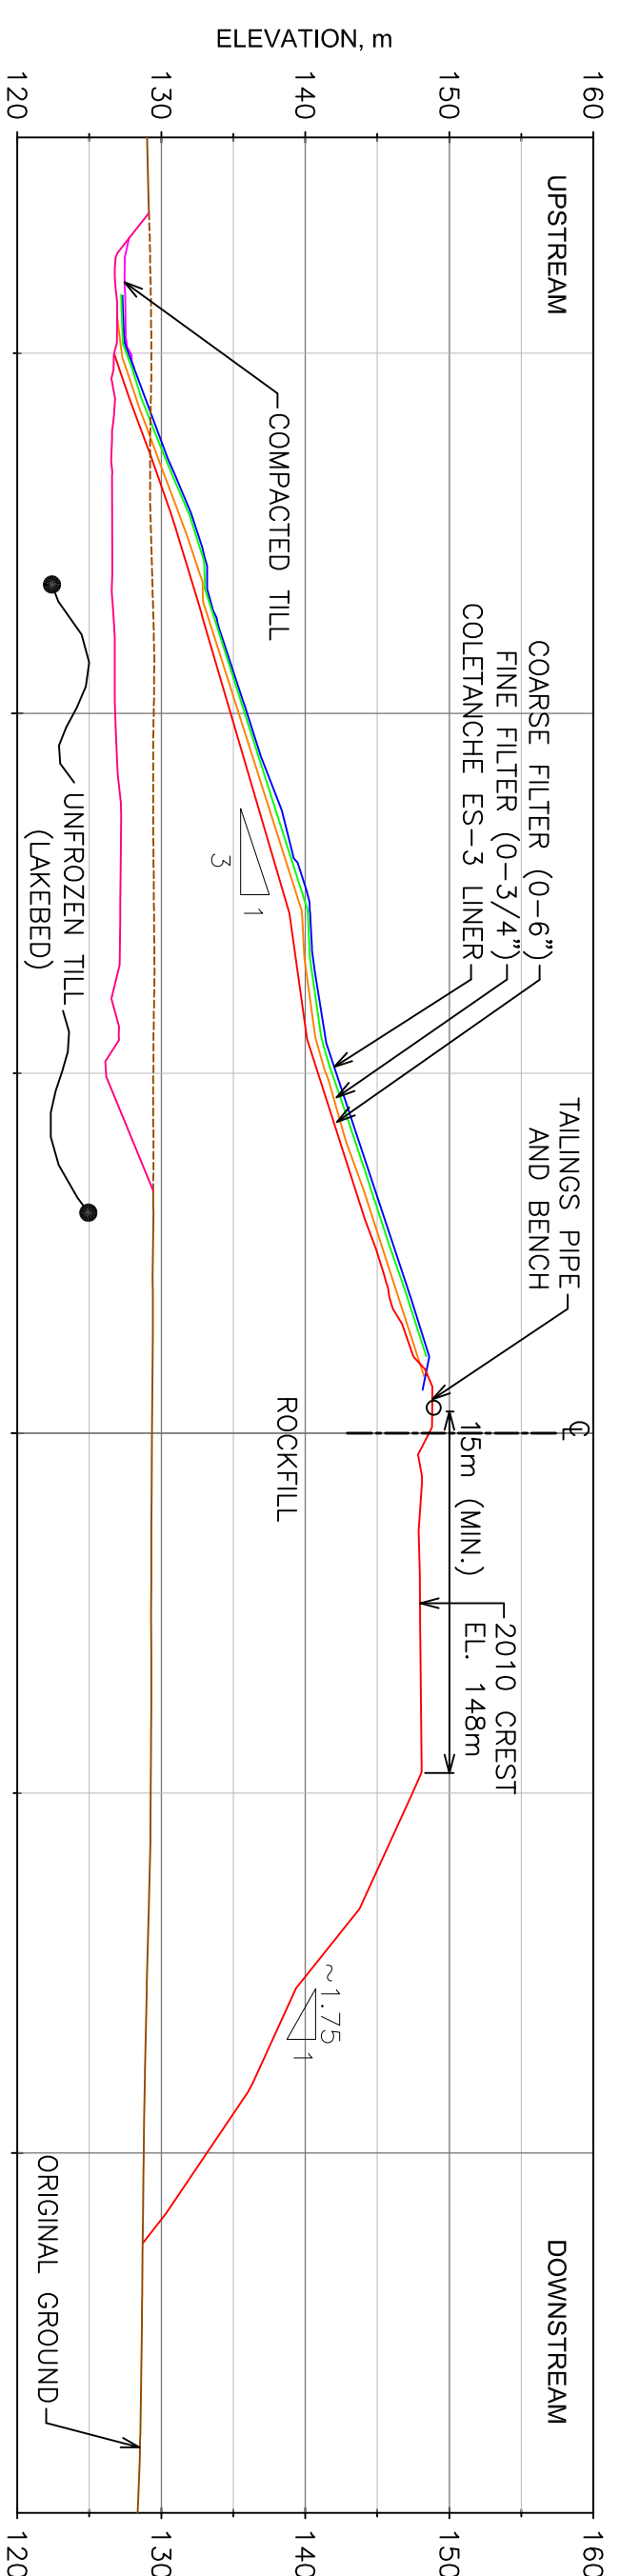


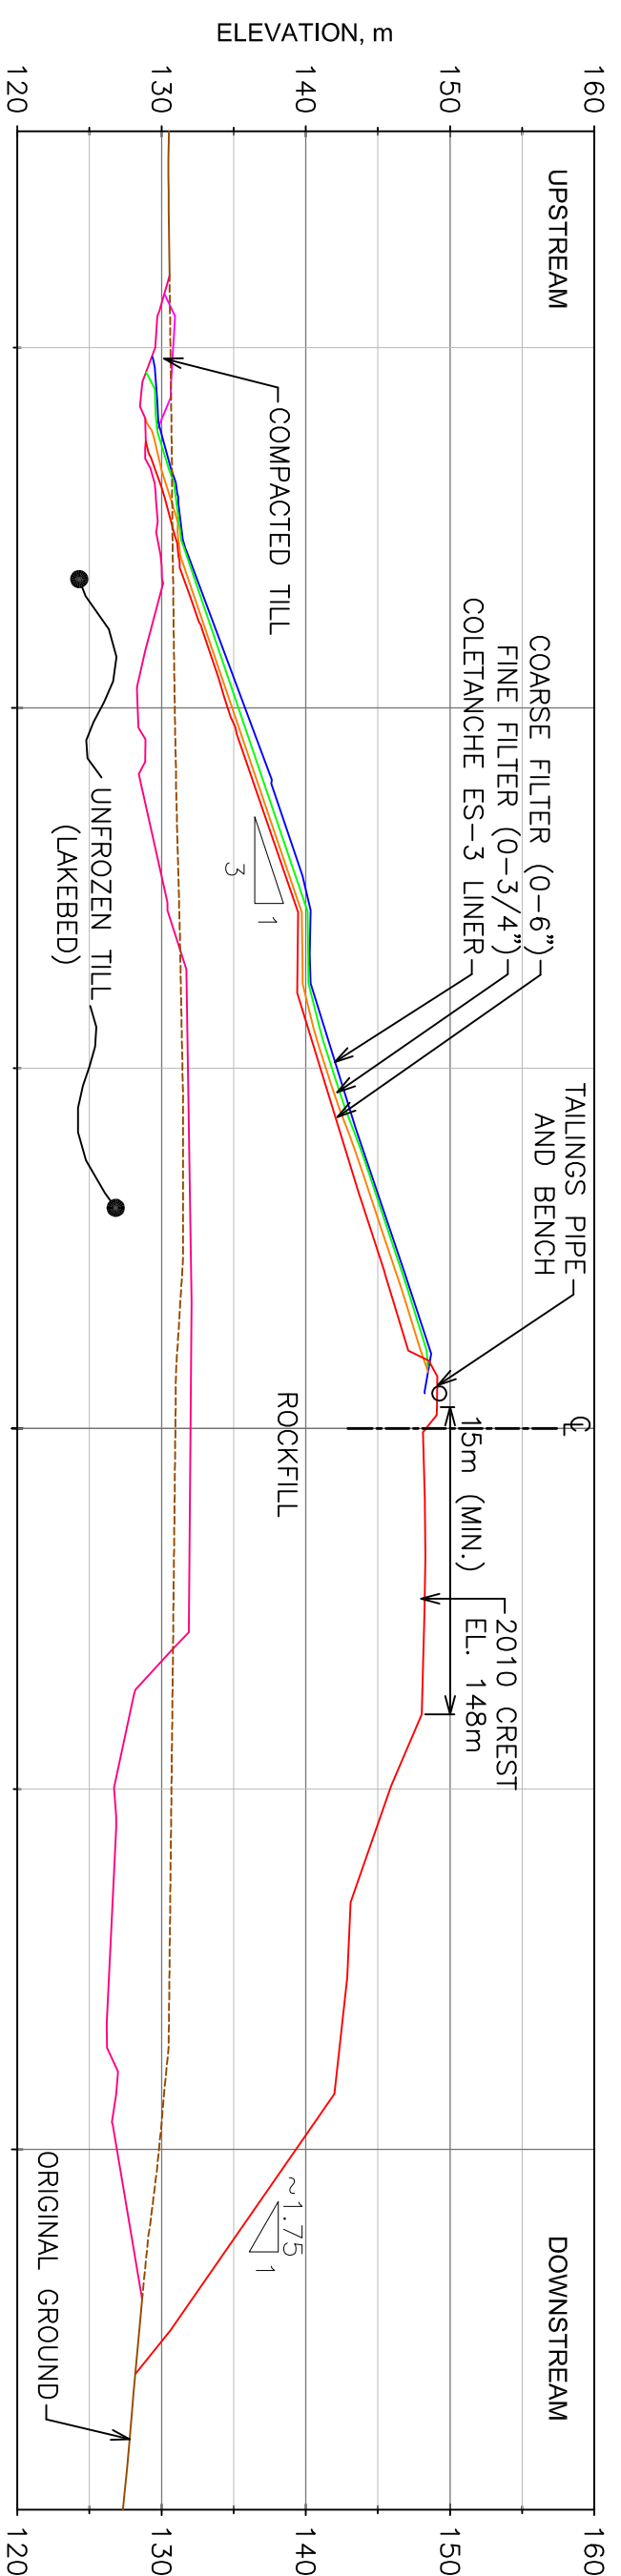

- ## LEGEND
- FINE FILTER
 - COARSE FILTER
 - BEDROCK
 - FOUNDATION
 - LINER
 - ORIGINAL GROUND
 - ROCKFILL
 - TILL
 - KEY

THE INFORMATION HEREON IS THE PROPERTY OF KNOX-DALZIEL, U.S. AND MUST BE RETURNED UPON REQUEST. WHOI WRITERS PERMISSION NOT COPYING, REPRODUCING, OR ANY USE (COPY) THAT FOR WHICH IT IS LOANED AND 978-881816. © KNOX-DALZIEL, U.S.

[illegible][illegible]

DRAWN BY	K. McLaughlin	DATE	20/0/09/28
CHECKED BY	V. Jobbert		
APPROVED BY	V. Jobbert		
SCALE	1:500	DATE	

PROJECT NO.	REVISION	SHEET
		3 / 4

