

Original, Full Sized, Signed and Sealed As-built Construction Drawings have been Provided Separate from Volume 1 Binder as Part of this Report Submission,

Drawings Provided Within Appendix D of Volume 1 Binder (11x17 printouts) are Copies Only.



APPENDIX D

As-Built Drawings Bay-Goose Dike
4200 Series North Portion
4300 Series South Portion

Drawing File: N:\Bor-Geophysics\Projects\2009\1428\09-1428-007\Drawings\0000 Meadowbank - Bay-Goose (North).DWG As-Built 0814280028-4200_3_00.dwg Wednesday, April 03, 2013 11:17:21 AM By: TKlassen

AGNICO-EAGLE MINES LIMITED

MEADOWBANK DIVISION

MEADOWBANK GOLD PROJECT

BAY-GOOSE DIKE AS-BUILT - NORTH PORTION

DRAWING INDEX			
DWG. NO.	DRAWING TITLE		REVISION TITLE
4200-00	BAY-GOOSE DIKE LOCATION MAP AND DRAWING INDEX	4	REVISED AS-BUILT
4200-01	BAY-GOOSE DIKE SITE PLAN	1	AS-BUILT
4200-02	BAY-GOOSE DIKE BOREHOLE LOCATION PLAN	1	AS-BUILT
4200-03	BAY-GOOSE DIKE CUTOFF WALL CENTRELINE SETOUT PLAN	1	AS-BUILT
4200-04	BAY-GOOSE DIKE INITIAL ROCKFILL AND TURBIDITY BARRIERS LAYOUT PLAN	2	AS-BUILT
4200-05	BAY-GOOSE DIKE TYPICAL MATERIAL PLACEMENT PLAN	2	AS-BUILT
4200-06	BAY-GOOSE DIKE TYPICAL MATERIAL PLACEMENT SECTIONS (NORTH PORTION)	2	AS-BUILT
4200-07	BAY-GOOSE DIKE TYPICAL MEDIUM DEPTH PLAN AND SECTION	2	CANCELLED
4200-08	BAY-GOOSE DIKE GOOSE ISLAND ABUTMENT DETAILS - TILL OPTION	1	CANCELLED
4200-09	BAY-GOOSE DIKE GOOSE ISLAND ABUTMENT SECTIONS - TILL OPTION	1	CANCELLED
4200-10	BAY-GOOSE DIKE NORTH ABUTMENT PLAN AND DETAILS	1	AS-BUILT
4200-11A	BAY-GOOSE DIKE INSTRUMENTATION PLAN (NORTH PORTION)	2	AS-BUILT
4200-11B	BAY-GOOSE DIKE INSTRUMENTATION PROFILE (NORTH PORTION)	2	AS-BUILT
4200-12	BAY-GOOSE DIKE INSTRUMENTATION SECTION DETAILS (NORTH PORTION)	3	AS-BUILT
4200-13	BAY-GOOSE DIKE GOOSE ISLAND ABUTMENT CUTOFF WALL OPTION	1	AS-BUILT
4200-14	BAY-GOOSE DIKE CROSS SECTIONS (NORTH PORTION) (1 OF 2)	2	AS-BUILT
4200-15	BAY-GOOSE DIKE CROSS SECTIONS (NORTH PORTION) (2 OF 2)	2	AS-BUILT
4200-17	BAY-GOOSE DIKE NORTH PORTION TYPICAL SECTION	1	AS-BUILT
4200-18	BAY-GOOSE DIKE LONGITUDINAL SECTION (NORTH PORTION)	1	AS-BUILT
4200-20	BAY-GOOSE DIKE GROUTING WORK AREAS - PLAN	1	AS-BUILT
4200-21	BAY-GOOSE DIKE GROUTING WORK AREAS - PROFILE	1	AS-BUILT
4200-22	BAY-GOOSE DIKE GROUTING DETAILS	1	AS-BUILT
4200-23	BAY-GOOSE DIKE GROUTING PROCEDURE PERFORATED CASING	1	AS-BUILT
4200-30	BAY-GOOSE DIKE DENSIFICATION PLAN - PHASE 1 AND 2 (NORTH PORTION) (1 OF 2)	0	AS-BUILT
4200-31	BAY-GOOSE DIKE DENSIFICATION PLAN - PHASE 1 AND 2 (NORTH PORTION) (2 OF 2)	0	AS-BUILT
4200-32	BAY-GOOSE DIKE DENSIFICATION PLAN - PHASE 3 (NORTH PORTION) (1 OF 2)	0	AS-BUILT
4200-33	BAY-GOOSE DIKE DENSIFICATION PLAN - PHASE 3 (NORTH PORTION) (2 OF 2)	0	AS-BUILT
4200-34	BAY-GOOSE DIKE DENSIFICATION PLAN - PHASE 4 (NORTH PORTION) (1 OF 2)	0	AS-BUILT
4200-35	BAY-GOOSE DIKE DENSIFICATION PLAN - PHASE 4 (NORTH PORTION) (2 OF 2)	0	AS-BUILT

DRAWING NUMBERS NOT USED:
4200-16, 4200-19, 4200-24 TO 4200-29




LOCATION PLAN
NTS

LIST OF SPECIFICATIONS		
SPECIFICATION NO.	TITLE	REVISION
4200-S1	GENERAL	1
4200-S2	SCOPE	1
4200-S3	COMMERCIAL CONDITIONS	1
4200-S4	EXCAVATION AND FOUNDATION PREPARATION	1
4200-S5	FILL PLACEMENT	1
4200-S6	CUTOFF WALL	1
4200-S7	DRILLING AND GROUTING	1
4200-S8	INSTRUMENTATION	1
4200-S9	QC AND QA REQUIREMENTS	1

THIS DRAWING IS THE INTELLECTUAL PROPERTY OF GOLDER ASSOCIATES LTD. AND IS TO BE USED SOLELY FOR THE INTENT FOR WHICH IT WAS PREPARED. MODIFICATIONS OR DEVIATIONS FROM THIS DRAWING SHALL OCCUR WITH WRITTEN APPROVAL OF GOLDER ASSOCIATED LTD.

PROJECT		AGNICO-EAGLE MINES LIMITED MEADOWBANK GOLD PROJECT NUNAVUT	
TITLE		BAY-GOOSE DIKE LOCATION MAP AND DRAWING INDEX	
		PROJECT No.	08-1428-0028/4200
		FILE No.	0814280028-4200_3_00
		DESIGN	JU 04JUL08
		CADD	EA 04DEC08
		CHECK	JU 24DEC08
		REVIEW	JCC 24DEC08
		SCALE	AS SHOWN
		REV.	4
		4200-00	

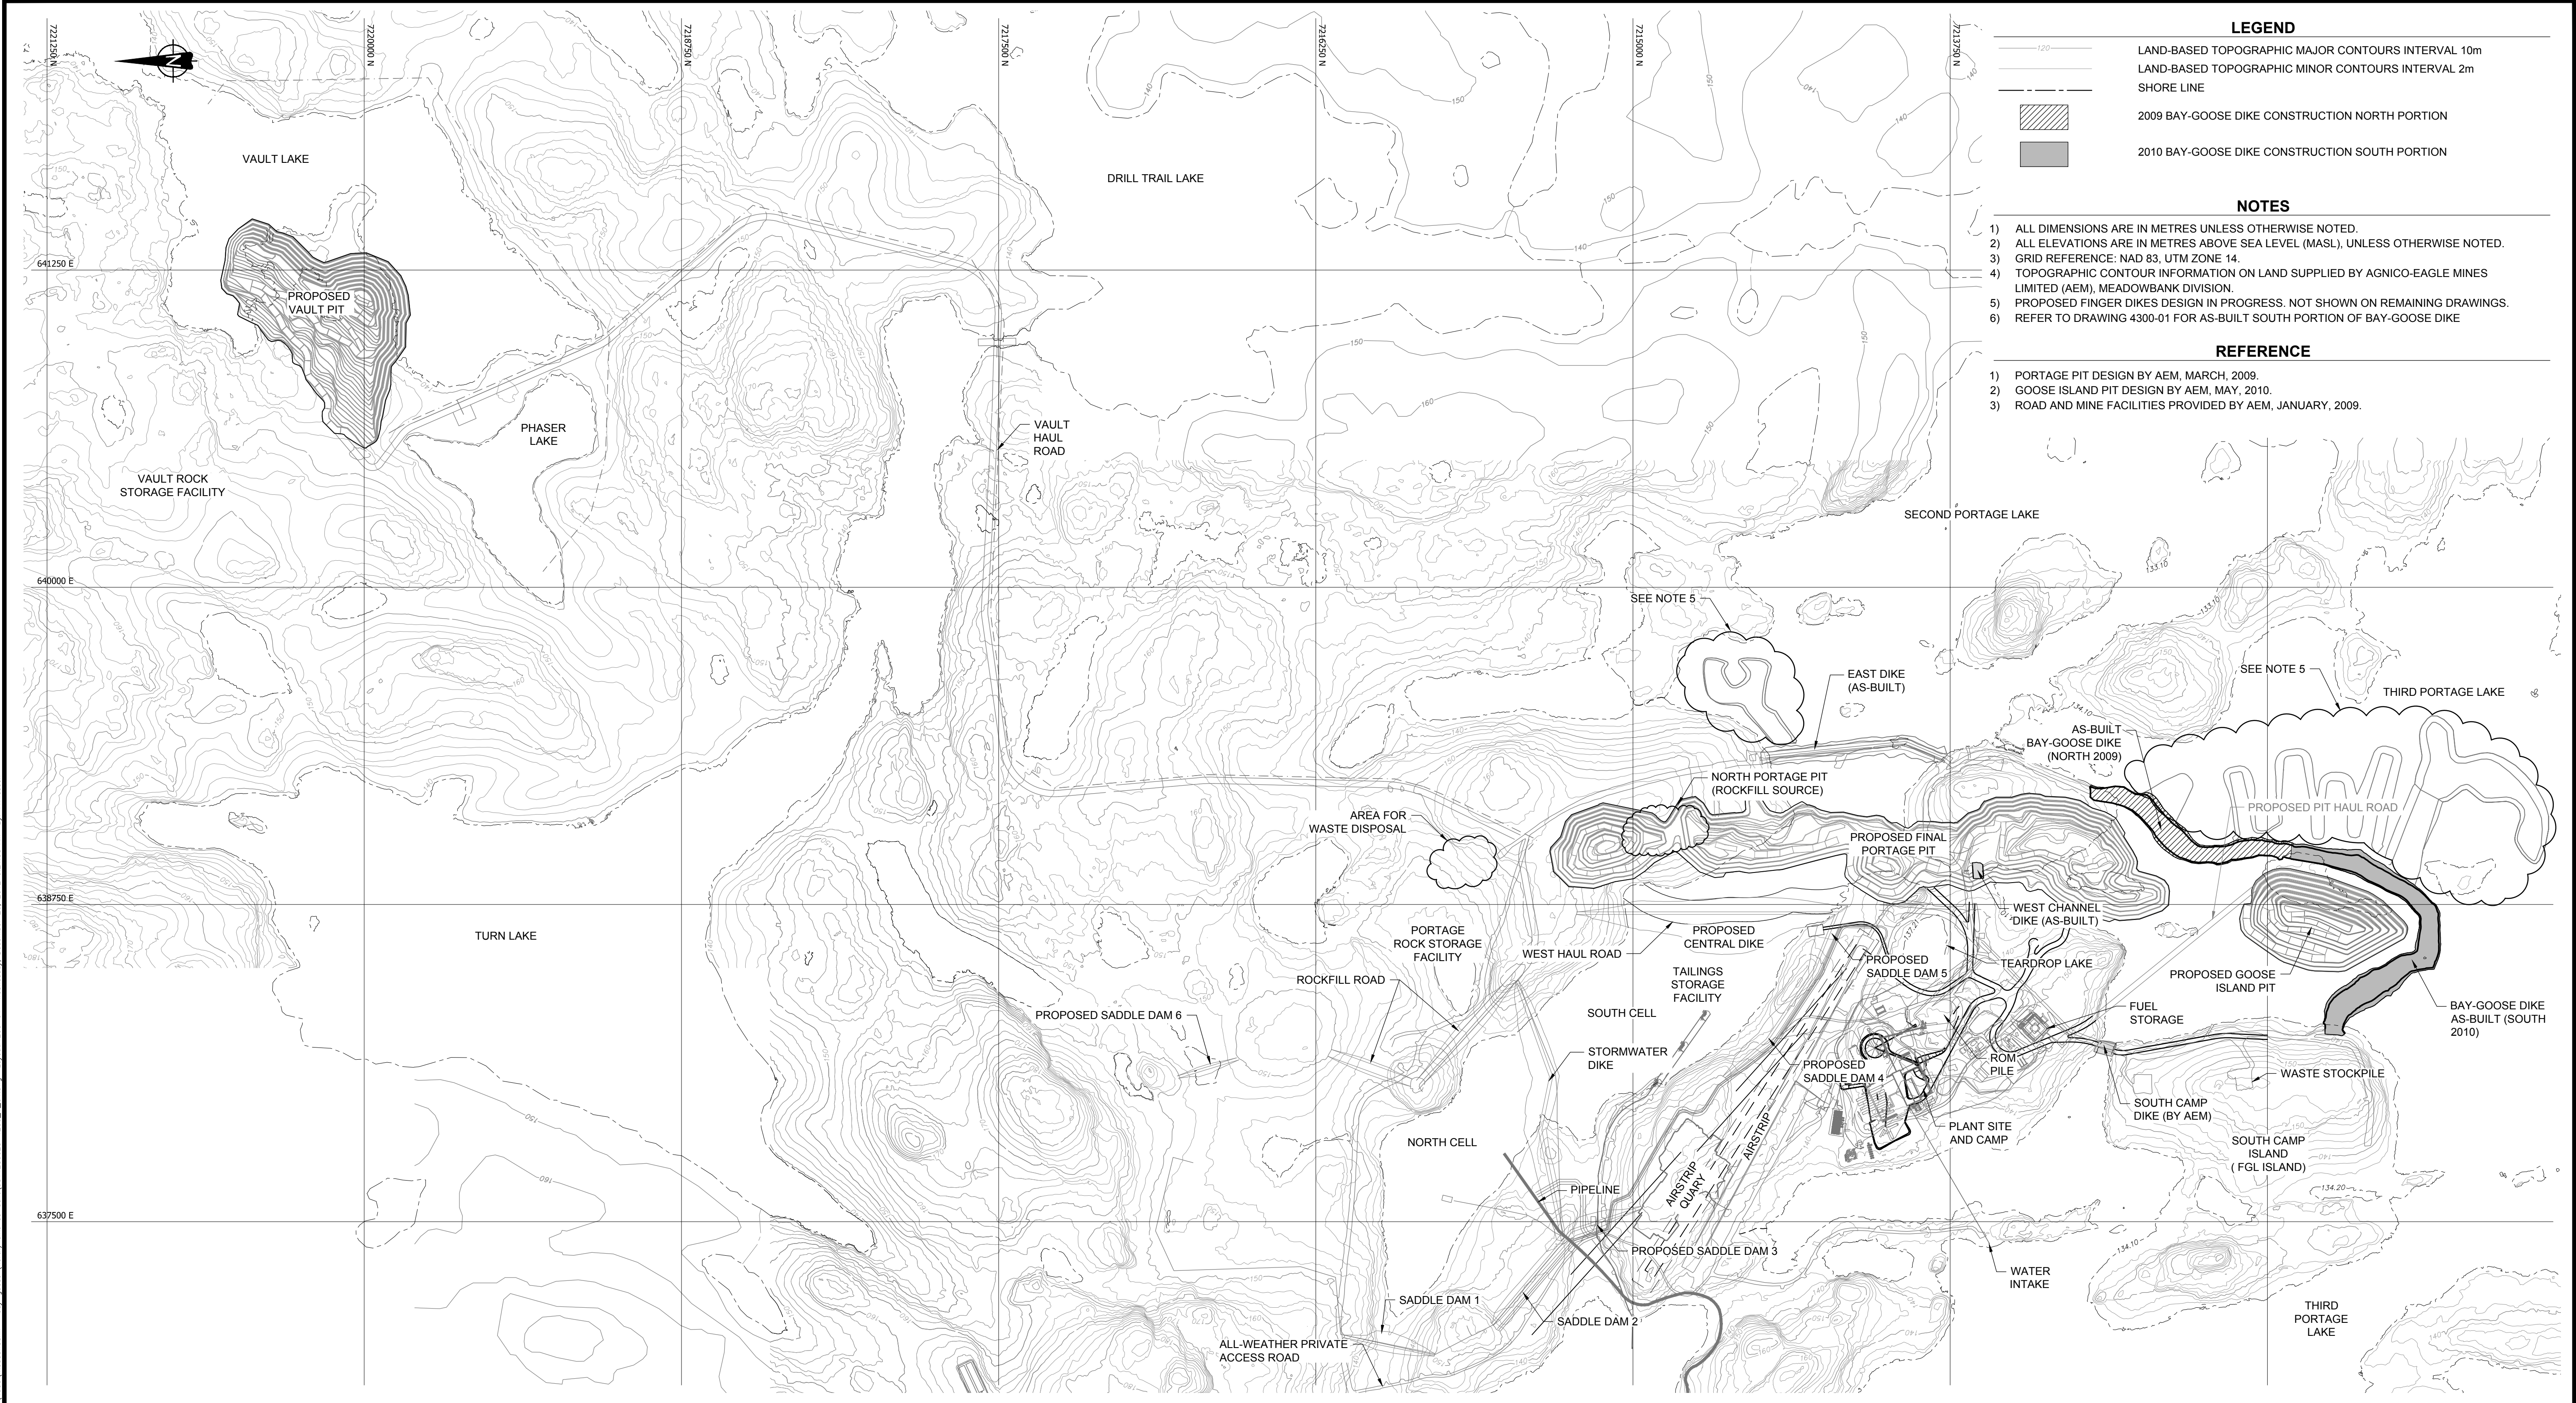

LEGEND

120

LAND-BASED TOPOGRAPHIC MAJOR CONTOURS INTERVAL 10m

LAND-BASED TOPOGRAPHIC MINOR CONTOURS INTERVAL 2m

SHORE LINE

2009 BAY-GOOSE DIKE CONSTRUCTION NORTH PORTION

2010 BAY-GOOSE DIKE CONSTRUCTION SOUTH PORTION

- NOTES
- 1)

ALL DIMENSIONS ARE IN METRES UNLESS OTHERWISE NOTED.
- 2)

ALL ELEVATIONS ARE IN METRES ABOVE SEA LEVEL (MASL), UNLESS OTHERWISE NOTED.
- 3)

GRID REFERENCE: NAD 83, UTM ZONE 14.
- 4)

TOPOGRAPHIC CONTOUR INFORMATION ON LAND SUPPLIED BY AGNICO-EAGLE MINES LIMITED (AEM), MEADOWBANK DIVISION.
- 5)

PROPOSED FINGER DIKES DESIGN IN PROGRESS. NOT SHOWN ON REMAINING DRAWINGS.
- 6)

REFER TO DRAWING 4300-01 FOR AS-BUILT SOUTH PORTION OF BAY-GOOSE DIKE

- REFERENCE
- 1)

PORTAGE PIT DESIGN BY AEM, MARCH, 2009.
- 2)

GOOSE ISLAND PIT DESIGN BY AEM, MAY, 2010.
- 3)

ROAD AND MINE FACILITIES PROVIDED BY AEM, JANUARY, 2009.

Drawing File: N:\User-graphics\Projects\2009\1428\09-1428-0007\Drawings\4200\meadowbank - bay-goose (north) - dike as-built\0814280028-4200_1_01.dwg Layout:4200-01 Wednesday, December 26, 2012 8:21:35 AM By: TTKlassen

PROJECT

AEM

AGNICO-EAGLE MINES LIMITED
MEADOWBANK GOLD PROJECT
NUNAVUT

TITLE

BAY-GOOSE DIKE
SITE PLAN

Golder
Associates

PROJECT No. 08-1428-0028/4200

FILE No. 0814280028-4200_1_01

DESIGN

JU

01DEC08

CADD

EA

05DEC08

CHECK

JU

24DEC08

REVIEW

JCC

24DEC08

SCALE AS SHOWN

REV. 1

4200-01

15DEC12

KD

AS-BUILT

JD

GRB

FE

17JUL09

FE

ISSUED FOR CONSTRUCTION

EA

FE

MRJ

22MAY09

FE

REVISED ISSUED FOR TENDER

JK

DRW

MRJ

08MAY09

FE

ISSUED FOR TENDER

JK

DRW

MRJ

02FEB09

JU

ISSUED FOR REVIEW

SD

FE

JCC

24DEC08

JU

ISSUED FOR REVIEW

SD

JU

JCC

REV

DATE

DES

REVISION DESCRIPTION

CADD


CHK

RVW

DRAWING NO.

REFERENCES

STAMP

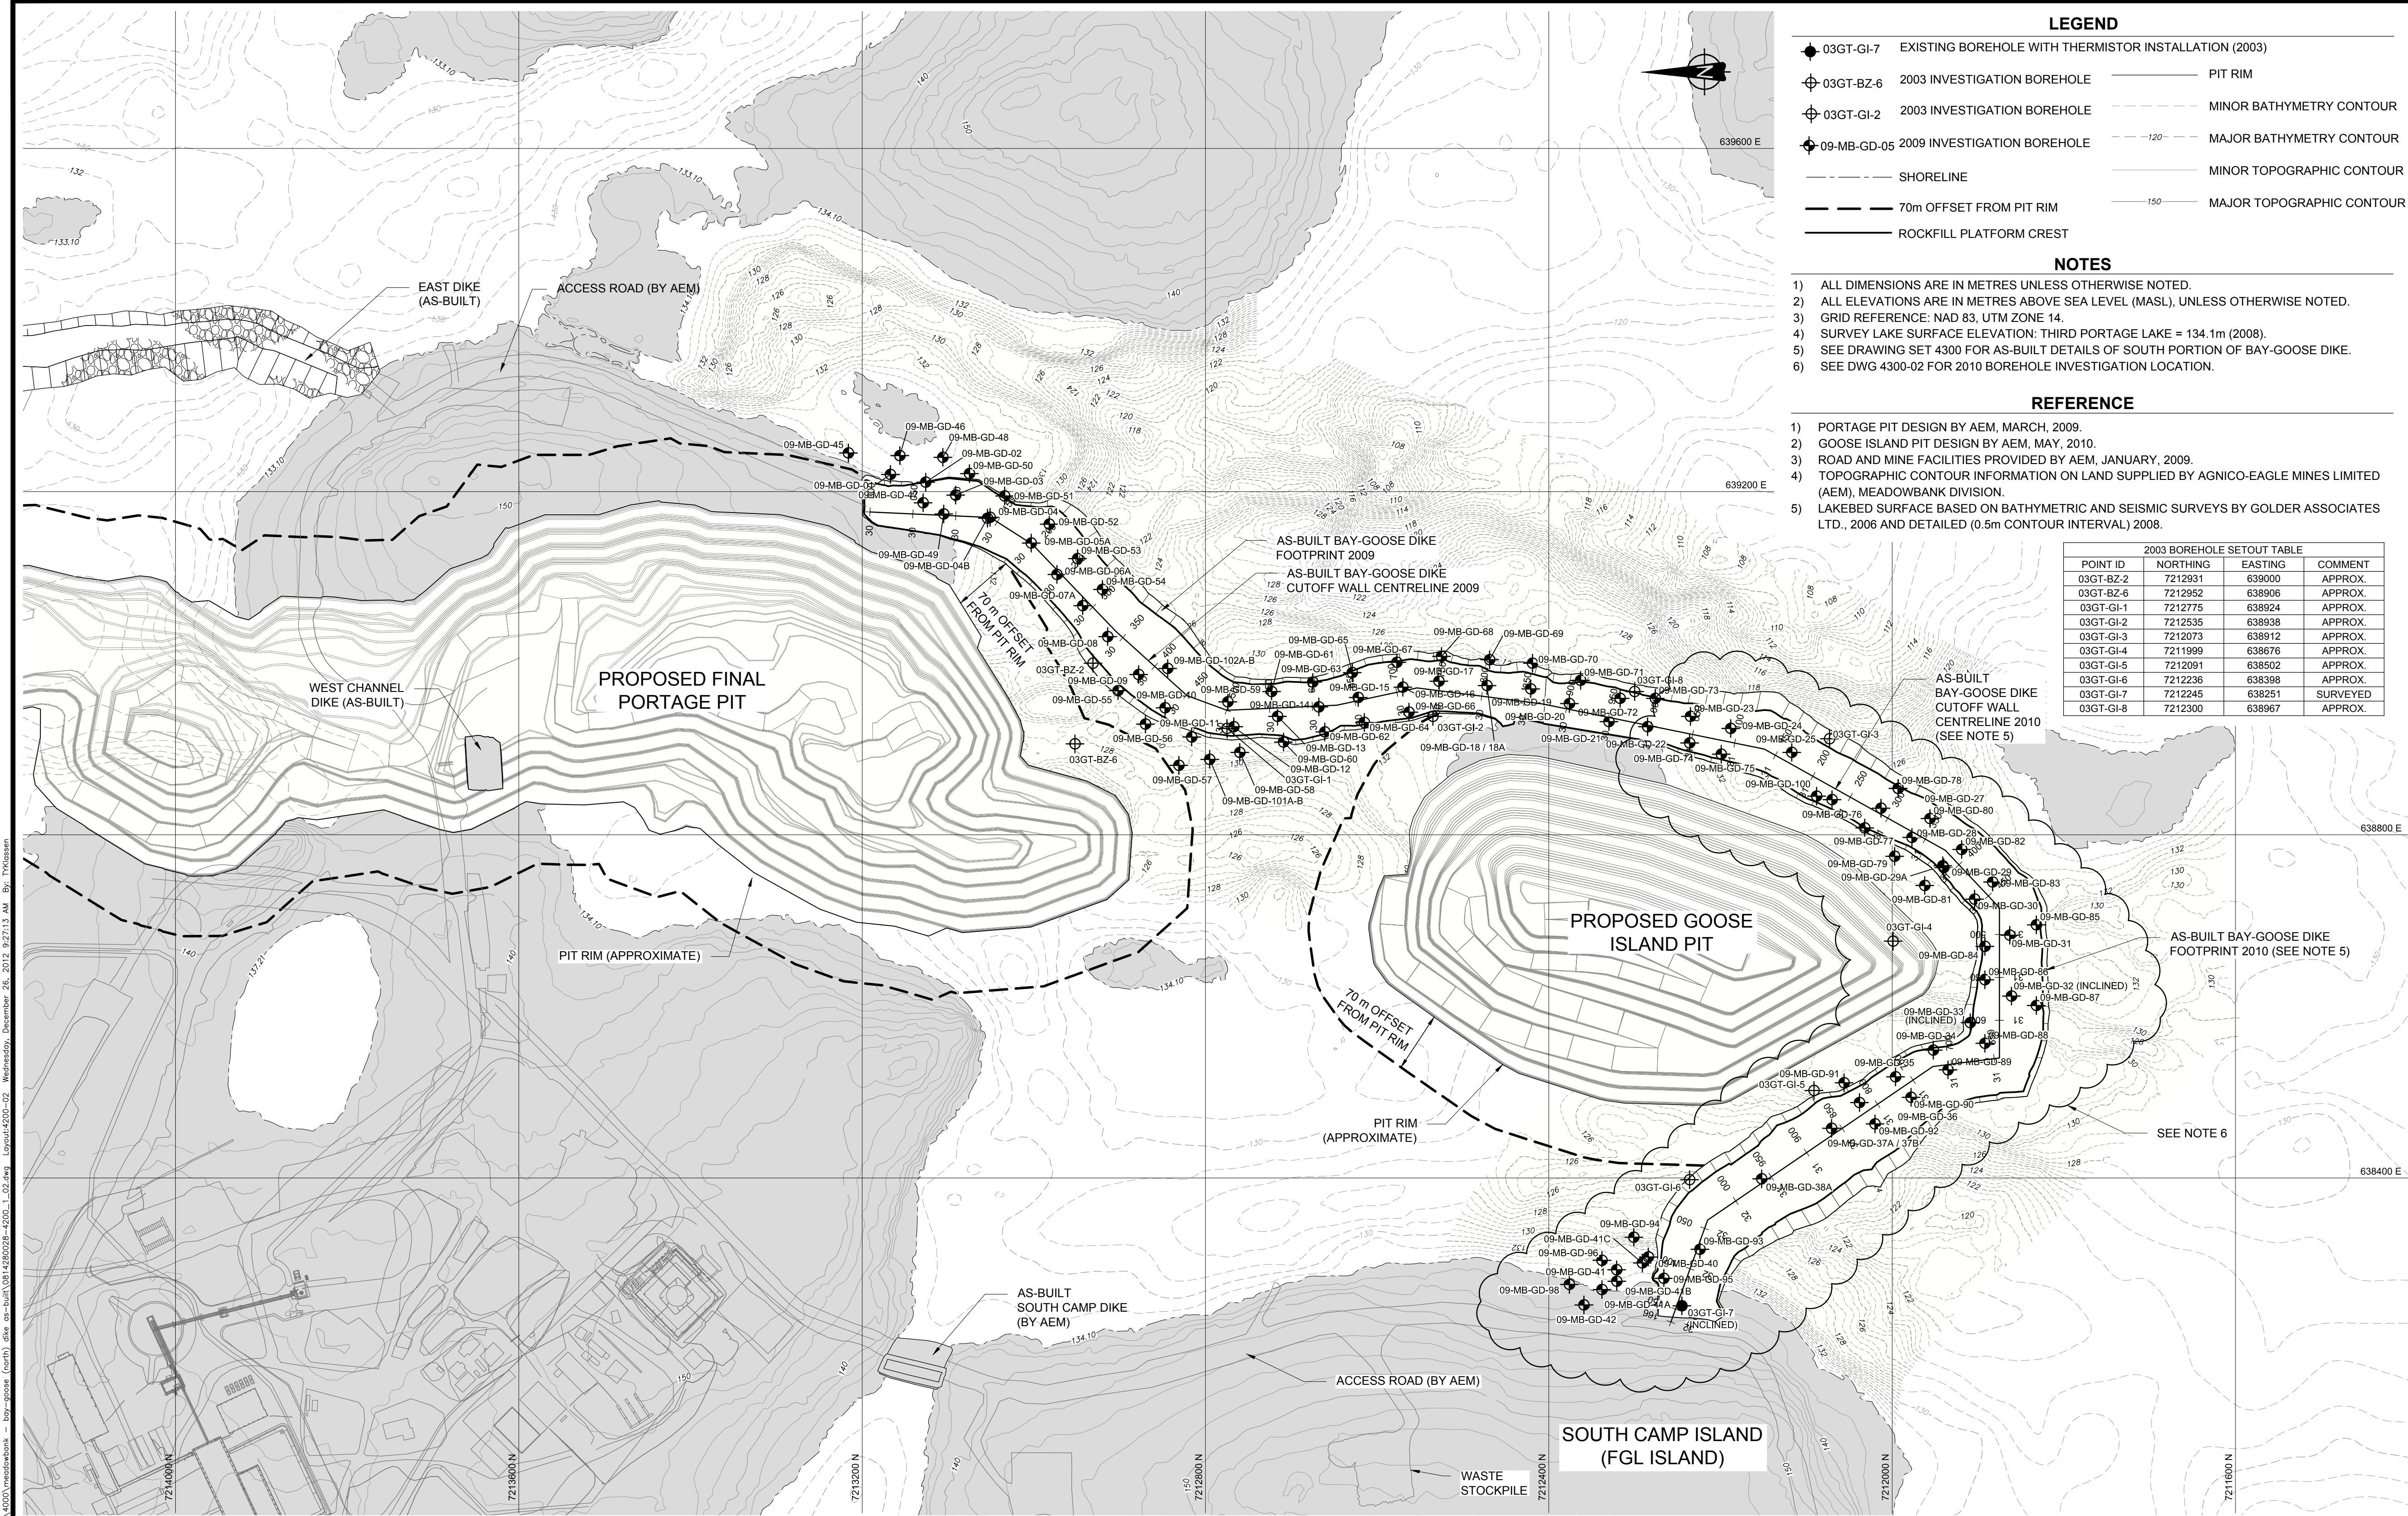

LEGEND

◆ 03GT-GI-7

EXISTING BOREHOLE WITH THERMISTOR INSTALLATION (2003)

⊕ 03GT-BZ-6

2003 INVESTIGATION BOREHOLE

⊕ 03GT-GI-2

2003 INVESTIGATION BOREHOLE

◆ 09-MB-GD-05

2009 INVESTIGATION BOREHOLE

SHORELINE

70m OFFSET FROM PIT RIM

ROCKFILL PLATFORM CREST

PIT RIM

MINOR BATHYMETRY CONTOUR

MAJOR BATHYMETRY CONTOUR

MINOR TOPOGRAPHIC CONTOUR

MAJOR TOPOGRAPHIC CONTOUR

- NOTES**
- 1) ALL DIMENSIONS ARE IN METRES UNLESS OTHERWISE NOTED.

2) ALL ELEVATIONS ARE IN METRES ABOVE SEA LEVEL (MASL), UNLESS OTHERWISE NOTED.

3) GRID REFERENCE: NAD 83, UTM ZONE 14.

4) SURVEY LAKE SURFACE ELEVATION: THIRD PORTAGE LAKE = 134.1m (2008).

5) SEE DRAWING SET 4300 FOR AS-BUILT DETAILS OF SOUTH PORTION OF BAY-GOOSE DIKE.

6) SEE DWG 4300-02 FOR 2010 BOREHOLE INVESTIGATION LOCATION.

- REFERENCE**
- 1) PORTAGE PIT DESIGN BY AEM, MARCH, 2009.

2) GOOSE ISLAND PIT DESIGN BY AEM, MAY, 2010.

3) ROAD AND MINE FACILITIES PROVIDED BY AEM, JANUARY, 2009.

4) TOPOGRAPHIC CONTOUR INFORMATION ON LAND SUPPLIED BY AGNICO-EAGLE MINES LIMITED (AEM), MEADOWBANK DIVISION.

5) LAKEBED SURFACE BASED ON BATHYMETRIC AND SEISMIC SURVEYS BY GOLDER ASSOCIATES LTD., 2006 AND DETAILED (0.5m CONTOUR INTERVAL) 2008.

2003 BOREHOLE SETOUT TABLE			
POINT ID	NORTHING	EASTING	COMMENT
03GT-BZ-2	7212931	638000	APPROX.
03GT-BZ-6	7212952	638906	APPROX.
03GT-GI-1	7212775	638924	APPROX.
03GT-GI-2	7212535	638938	APPROX.
03GT-GI-3	7212073	638912	APPROX.
03GT-GI-4	7211999	638676	APPROX.
03GT-GI-5	7212091	638502	APPROX.
03GT-GI-6	7212236	638398	APPROX.
03GT-GI-7	7212245	638251	SURVEYED
03GT-GI-8	7212300	638967	APPROX.

2009 BOREHOLE COORDINATES TABLE			
POINT ID	NORTHING	EASTING	COMMENT
09-MB-GD-01	7213167	639220	SURVEYED
09-MB-GD-02	7213126	639211	SURVEYED
09-MB-GD-03	7213091	639196	SURVEYED
09-MB-GD-04	7213051	639170	SURVEYED
09-MB-GD-04B	7213054	639169	SURVEYED
09-MB-GD-05A	7213003	639140	SURVEYED
09-MB-GD-06A	7212973	639103	SURVEYED
09-MB-GD-07A	7212943	639067	SURVEYED
09-MB-GD-08	7212914	639031	SURVEYED
09-MB-GD-09	7212878	638987	SURVEYED
09-MB-GD-10	7212847	638948	SURVEYED
09-MB-GD-11	7212816	638914	SURVEYED
09-MB-GD-12	7212767	638926	SURVEYED
09-MB-GD-13	7212716	638938	APPROX.
09-MB-GD-14	7212668	638949	SURVEYED
09-MB-GD-15	7212622	638960	SURVEYED
09-MB-GD-16	7212570	638972	SURVEYED
09-MB-GD-17	7212528	638979	APPROX.
09-MB-GD-18	7212471	638974	APPROX.
09-MB-GD-18A	7212472	638974	SURVEYED
09-MB-GD-19	7212421	638970	APPROX.
09-MB-GD-20	7212376	638953	APPROX.
09-MB-GD-21	7212330	638932	APPROX.
09-MB-GD-22	7212285	638926	APPROX.
09-MB-GD-23	7212235	638938	SURVEYED
09-MB-GD-24	7212188	638924	SURVEYED
09-MB-GD-25	7212117	638896	SURVEYED
09-MB-GD-27	7212013	638831	APPROX.
09-MB-GD-28	7211977	638797	APPROX.
09-MB-GD-29	7211940	638762	SURVEYED
09-MB-GD-29A	7211941	638764	SURVEYED
09-MB-GD-30	7211904	638725	SURVEYED
09-MB-GD-31	7211863	638683	SURVEYED
09-MB-GD-32	7211861	638612	SURVEYED
09-MB-GD-33	7211909	638581	SURVEYED
09-MB-GD-34	7211952	638549	SURVEYED
09-MB-GD-35	7211996	638518	SURVEYED
09-MB-GD-36	7212038	638488	SURVEYED
09-MB-GD-37A	7212070	638458	SURVEYED
09-MB-GD-37B	7212071	638460	SURVEYED
09-MB-GD-38A	7212152	638399	SURVEYED
09-MB-GD-40	7212284	638308	SURVEYED
09-MB-GD-41	7212321	638293	SURVEYED
09-MB-GD-41A	7212338	638270	SURVEYED
09-MB-GD-41B	7212298	638293	SURVEYED
09-MB-GD-41C	7212291	638301	SURVEYED
09-MB-GD-42	7212359	638252	SURVEYED
09-MB-GD-45	7213216	639245	SURVEYED
09-MB-GD-46	7213156	639242	SURVEYED
09-MB-GD-47	7213129	639187	SURVEYED
09-MB-GD-48	7213106	639240	SURVEYED
09-MB-GD-49	7213105	639174	SURVEYED
09-MB-GD-50	7213075	639221	SURVEYED
09-MB-GD-51	7213034	639195	SURVEYED
09-MB-GD-52	7212982	639162	SURVEYED
09-MB-GD-53	7212949	639122	SURVEYED
09-MB-GD-54	7212920	639086	SURVEYED
09-MB-GD-55	7212902	638968	SURVEYED
09-MB-GD-56	7212870	638929	SURVEYED
09-MB-GD-57	7212831	638881	SURVEYED
09-MB-GD-58	7212760	638896	SURVEYED
09-MB-GD-59	7212774	638955	SURVEYED
09-MB-GD-60	7212709	638908	SURVEYED
09-MB-GD-61	7212723	638967	SURVEYED
09-MB-GD-62	7212661	638920	SURVEYED
09-MB-GD-63	7212675	638978	SURVEYED
09-MB-GD-64	7212615	638931	SURVEYED
09-MB-GD-65	7212629	638989	SURVEYED
09-MB-GD-66	7212563	638943	SURVEYED
09-MB-GD-67	7212577	639001	SURVEYED
09-MB-GD-68	7212525	639008	SURVEYED
09-MB-GD-69	7212469	639004	SURVEYED
09-MB-GD-70	7212419	639000	SURVEYED
09-MB-GD-71	7212363	638980	SURVEYED
09-MB-GD-72	7212317	638959	SURVEYED
09-MB-GD-73	7212276	638959	SURVEYED
09-MB-GD-74	7212236	638907	SURVEYED
09-MB-GD-75	7212199	638894	SURVEYED
09-MB-GD-76	7212070	638841	SURVEYED
09-MB-GD-77	7212032	638808	SURVEYED
09-MB-GD-78	7211993	638854	SURVEYED
09-MB-GD-79	7211997	638775	SURVEYED
09-MB-GD-80	7211956	638819	SURVEYED
09-MB-GD-81	7211962	638741	SURVEYED
09-MB-GD-82	7211919	638763	SURVEYED
09-MB-GD-83	7211883	638745	SURVEYED
09-MB-GD-84	7211892	638670	SURVEYED
09-MB-GD-85	7211832	638695	SURVEYED
09-MB-GD-86	7211892	638631	SURVEYED
09-MB-GD-87	7211832	638601	SURVEYED
09-MB-GD-88	7211892	638557	SURVEYED
09-MB-GD-89	7211935	638526	SURVEYED
09-MB-GD-90	7211978	638494	SURVEYED
09-MB-GD-91	7212056	638511	SURVEYED
09-MB-GD-92	7212020	638463	SURVEYED
09-MB-GD-93	7212224	638317	SURVEYED
09-MB-GD-94	7212301	638331	SURVEYED
09-MB-GD-95	7212266	638283	SURVEYED
09-MB-GD-96	7212338	638304	SURVEYED
09-MB-GD-98	7212376	638276	SURVEYED
09-MB-GD-100	7212088	638845	SURVEYED
09-MB-GD-101A-B	7212795	638888	APPROX.
09-MB-GD-102A-B	7212844	638994	SURVEYED

Drawing File: N:\User-graphics\Projects\2009\1428\09-1428-0007A\Drawings\4200\1_02.dwg Layout:4200-02 Wednesday, December 26, 2012 8:27:13 AM By: TTKlausen

DRAWING NO.

REV

DATE

DES

REFERENCES

15DEC12

KD

AS-BUILT

JD

GRB

FE

17JUL09

FE

ISSUED FOR CONSTRUCTION

EA

FE

MRJ

22MAY09

FE

REVISED ISSUED FOR TENDER

MSH

DRW

MRJ

08MAY09

FE

ISSUED FOR TENDER

JK

DRW

MRJ

02FEB09

JU

ISSUED FOR REVIEW

EA

FE

JCC

24DEC08

JU

ISSUED FOR REVIEW

SD

JU

JCC

03GT-GI-7

EXISTING BOREHOLE WITH THERMISTOR INSTALLATION (2003)

JD

GRB

FE

03GT-BZ-6

2003 INVESTIGATION BOREHOLE

EA

FE

MRJ

03GT-GI-2

2003 INVESTIGATION BOREHOLE

MSH

DRW

MRJ

09-MB-GD-05

2009 INVESTIGATION BOREHOLE

JK

DRW

MRJ

03GT-GI-7

EXISTING BOREHOLE WITH THERMISTOR INSTALLATION (2003)

EA

FE

JCC

03GT-BZ-6

2003 INVESTIGATION BOREHOLE

EA

FE

JCC

03GT-GI-2

2003 INVESTIGATION BOREHOLE

SD

JU

JCC

09-MB-GD-05

2009 INVESTIGATION BOREHOLE

CADD

CHK

RVW

PROJECT

AEM

AGNICO-EAGLE MINES LIMITED
MEADOWBANK GOLD PROJECT
NUNAVUT

TITLE

BAY-GOOSE DIKE
BOREHOLE LOCATION PLAN

STAMP

PROJECT No. 08-1428-0028/4200

FILE No. 0814280028-4200_1_02

DESIGN

EA

04JUL08

SCALE

AS SHOWN

REV.

1

CADD

JU

05DEC08

CHECK

JU


24DEC08


REVIEW

JCC

24DEC08



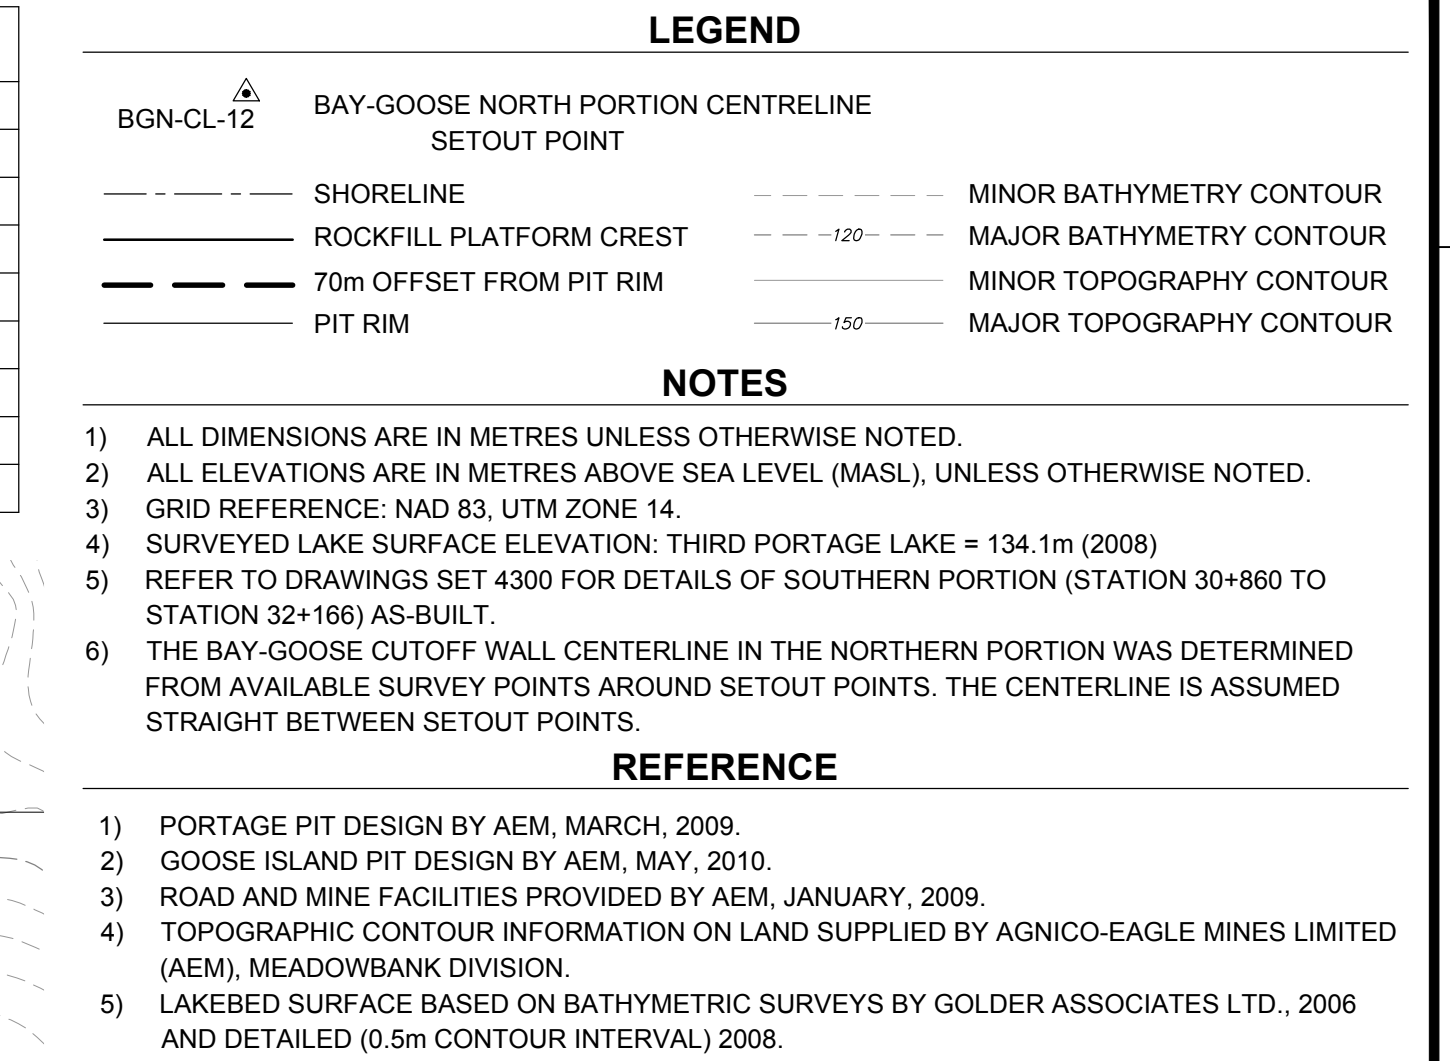

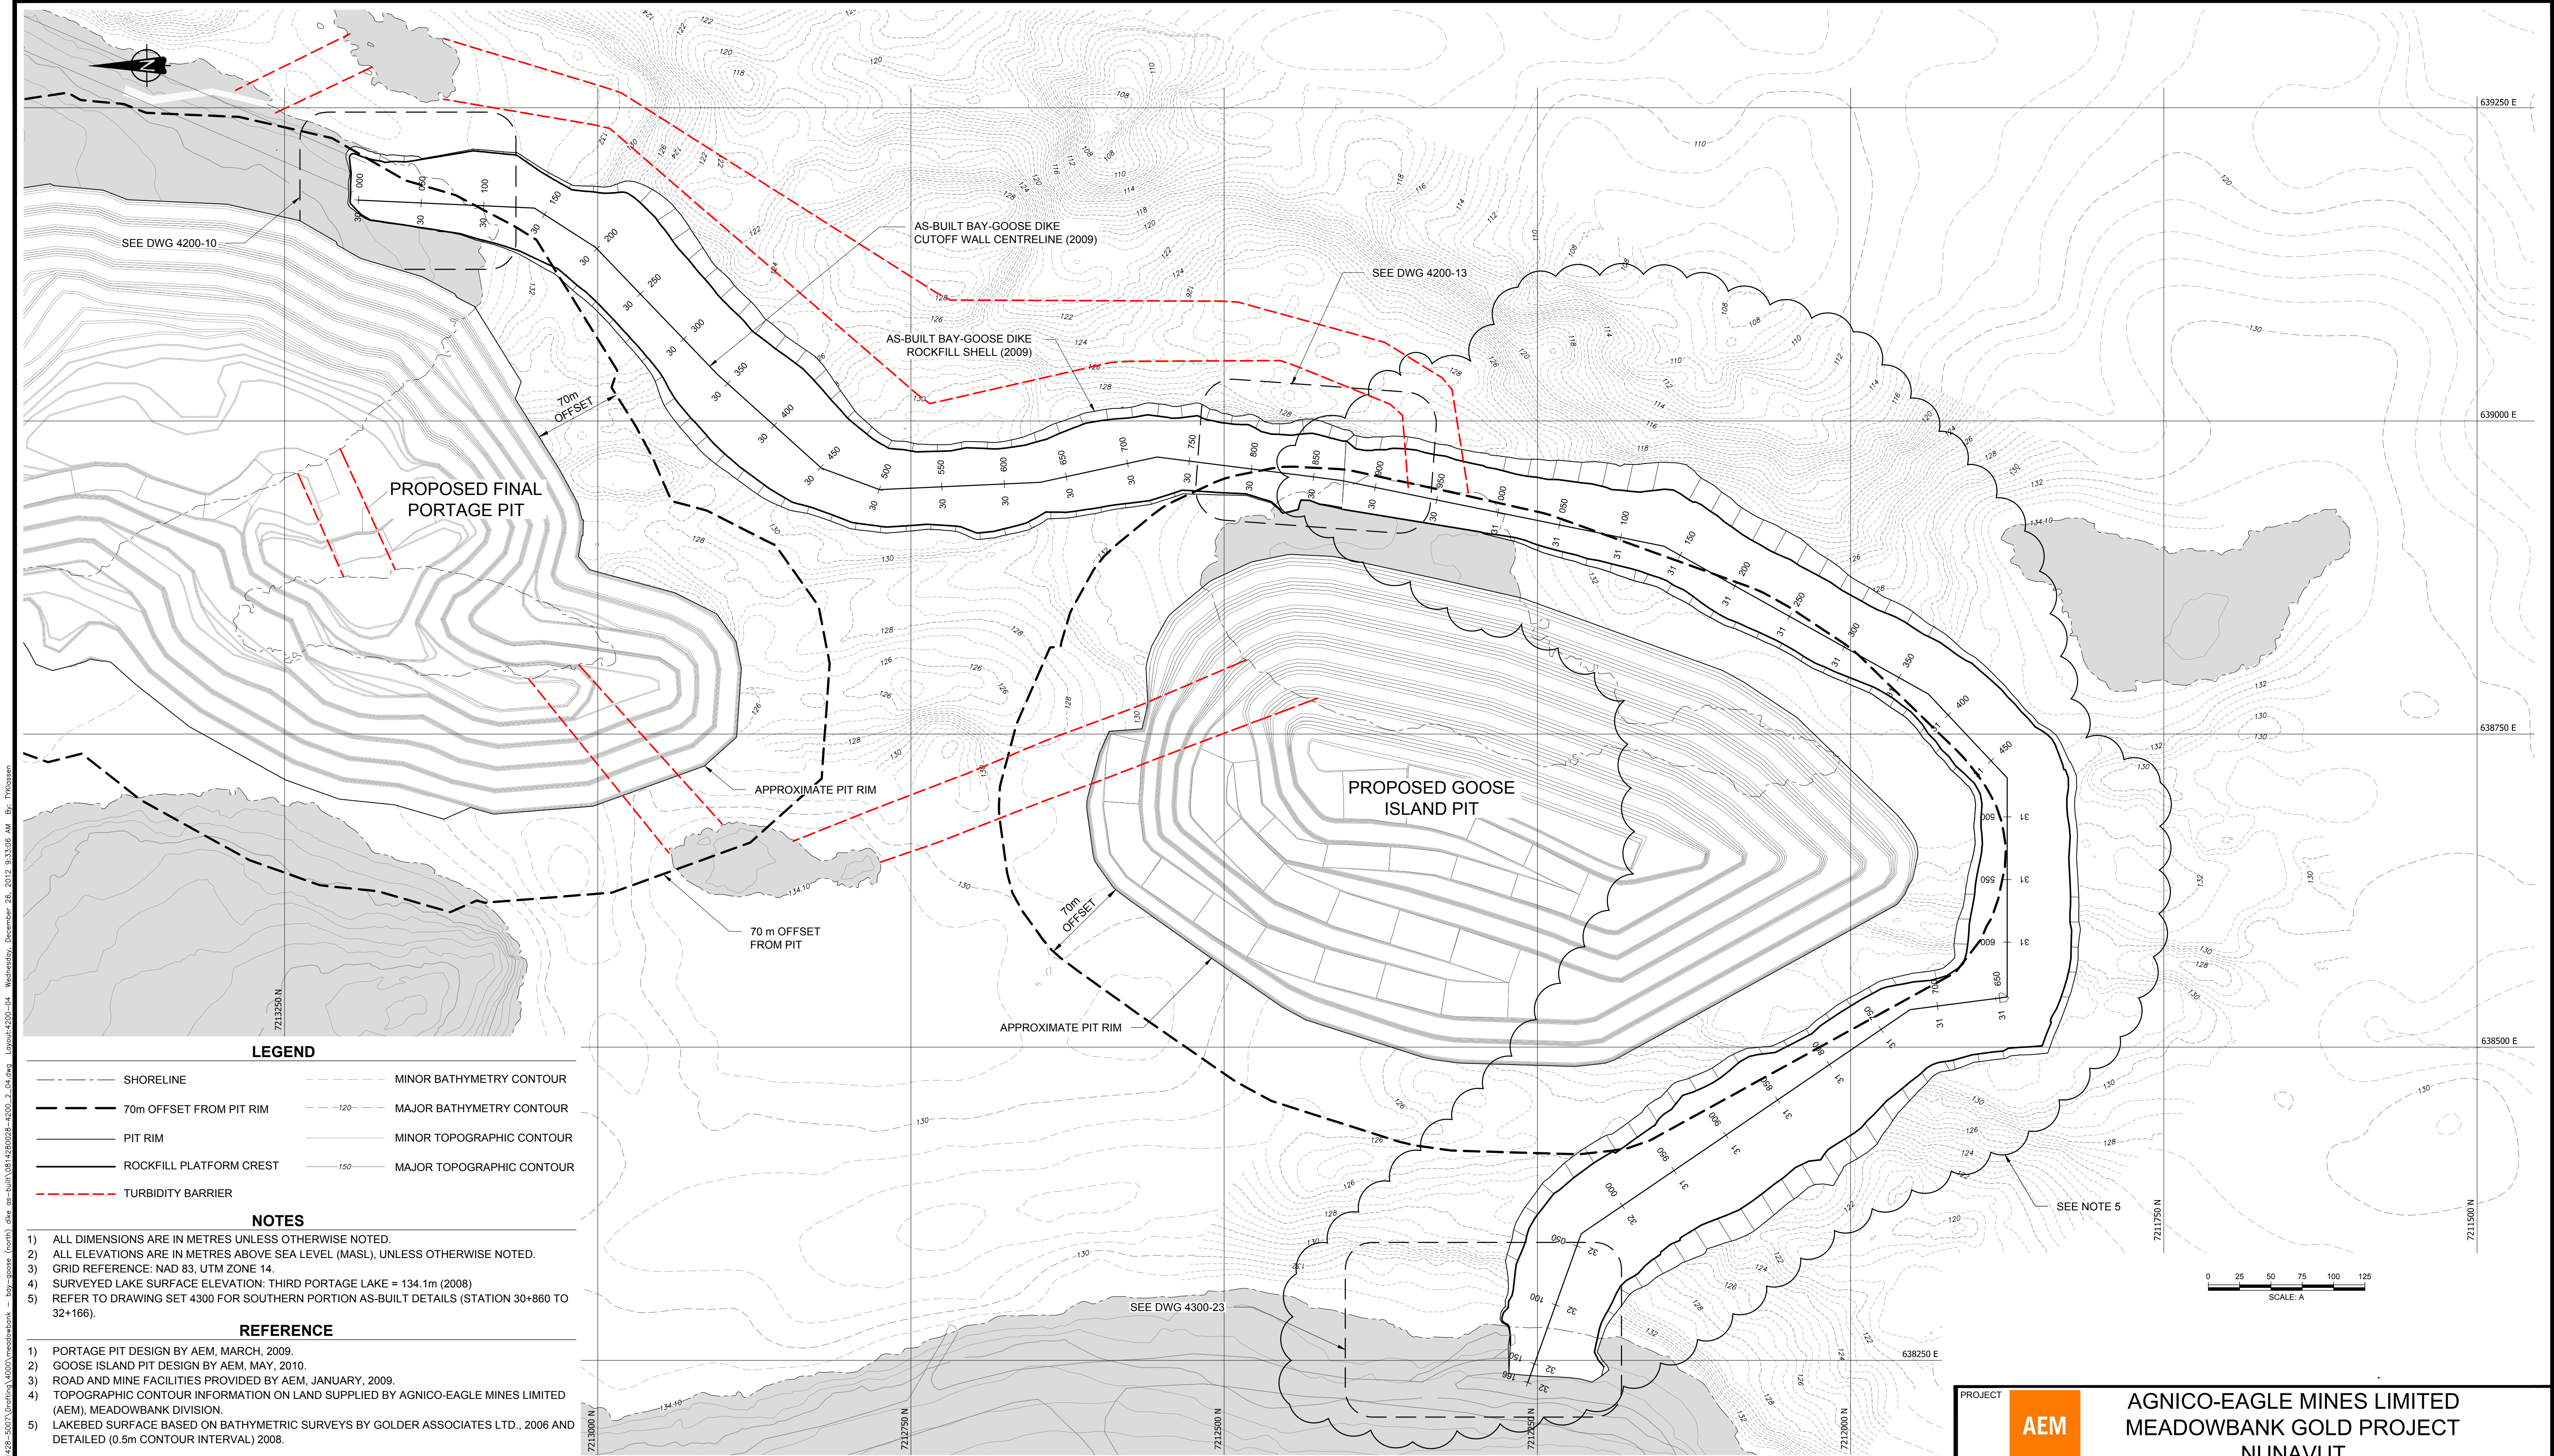

DRAWING NO.	REFERENCES	REV	DATE	DES	REVISION DESCRIPTION	CADD	CHK	RVW	STAMP
		A	15DEC12	KD	AS-BUILT		JD	GRB	FE
		B	31JUL09	FE	REVISED ROCKFILL CREST WIDTH		JK	FE	MRJ
		C	17JUL09	FE	ISSUED FOR CONSTRUCTION		EA	FE	MRJ
		D	22MAY09	FE	REVISED ISSUED FOR TENDER		JK/MSH	DRW	MRJ
		E	08MAY09	FE	ISSUED FOR TENDER		JK	DRW	MRJ
		F	02FEB09	JU	ISSUED FOR REVIEW		SD	FE	JCC
		G	24DEC08	JU	ISSUED FOR REVIEW		SD	JU	JCC

PROJECT



AGNICO-EAGLE MINES LIMITED
MEADOWBANK GOLD PROJECT
NUNAVUT

TITLE


**BAY-GOOSE DIKE
INITIAL ROCKFILL AND TURBIDITY
BARRIERS LAYOUT PLAN**




PROJECT No.	08-1428-0028/4200	FILE No.	0814280028-4200_2_04
DESIGN	JU	04JUL08	SCALE AS SHOWN
CADD	EA	05DEC08	REV. 2
CHECK	JU	24DEC08	
REVIEW	JCC	24DEC08	

4200-04


REVISION DATE: 12/6/2012 2:50:04 PM BY: TKLASSEN CADD FILE: N:\bur-graphics\Projects\2009\1428\09-1428-5007\Drafting\4200\meadowbank - bay-goose (north) dike as-built\0814280028-4200_2_05.dwg

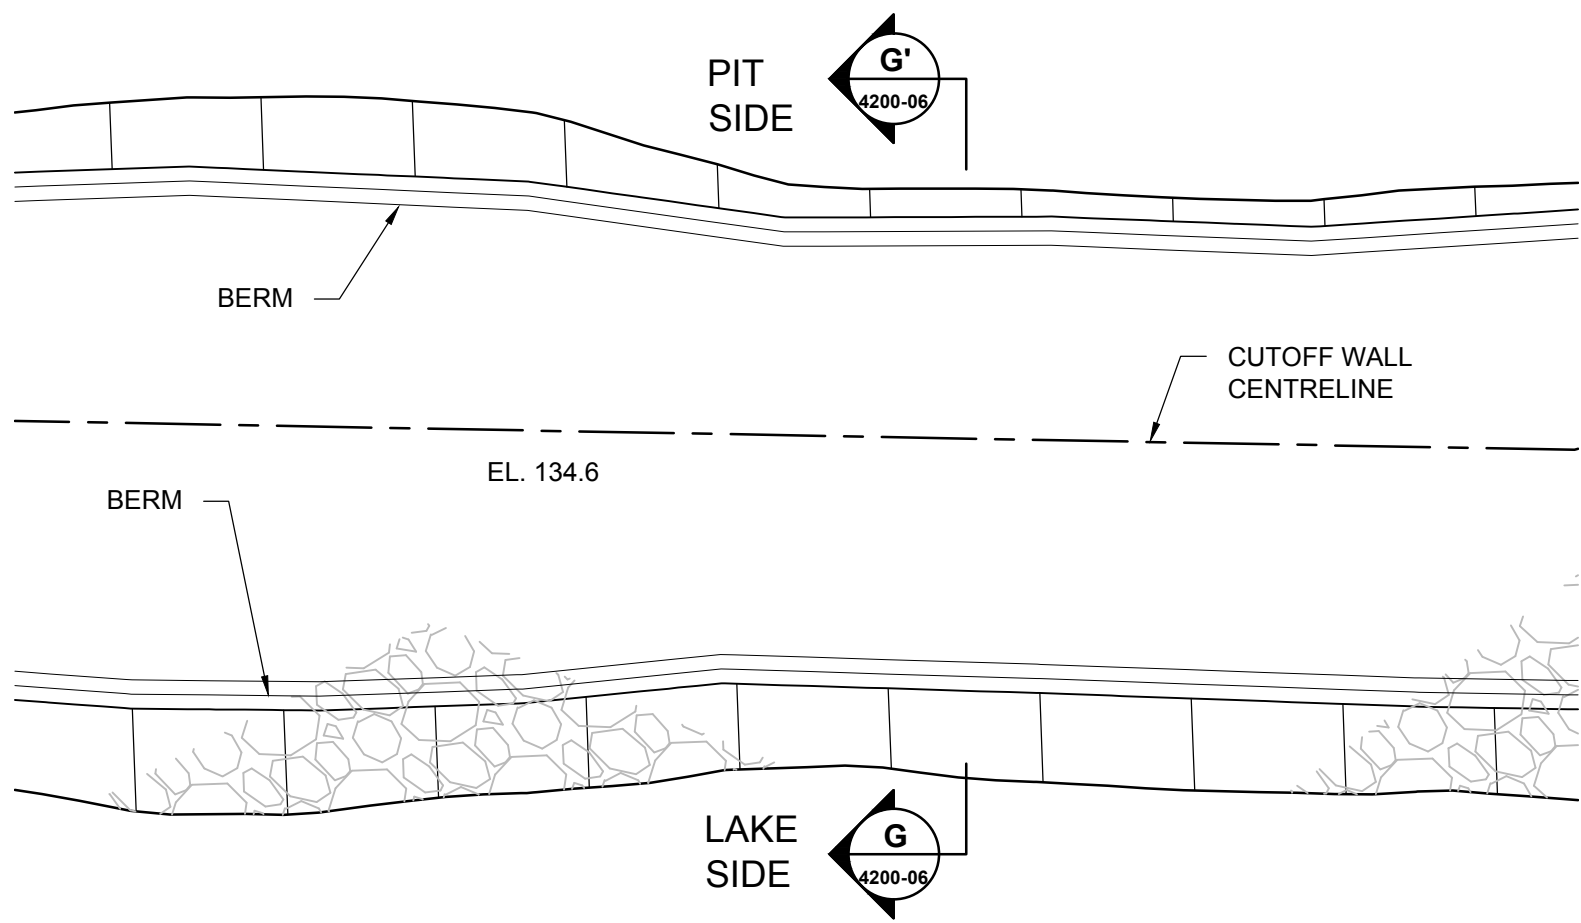


1 INITIAL ROCKFILL PLACEMENT PLAN
SCALE: A

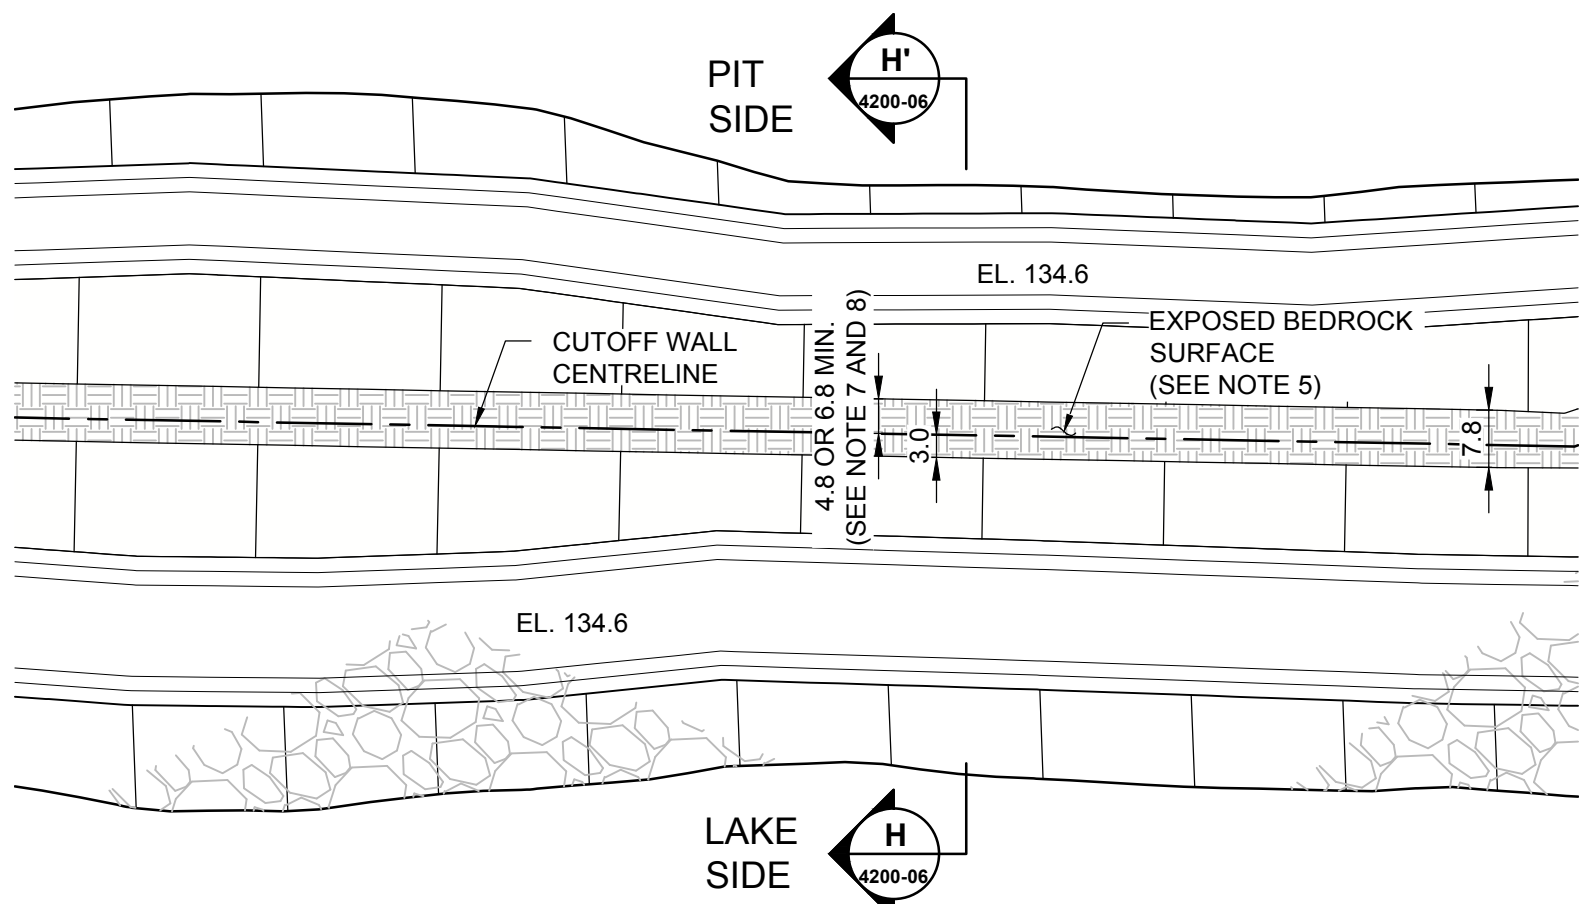


2 EXCAVATION TO BEDROCK PLAN
SCALE: A

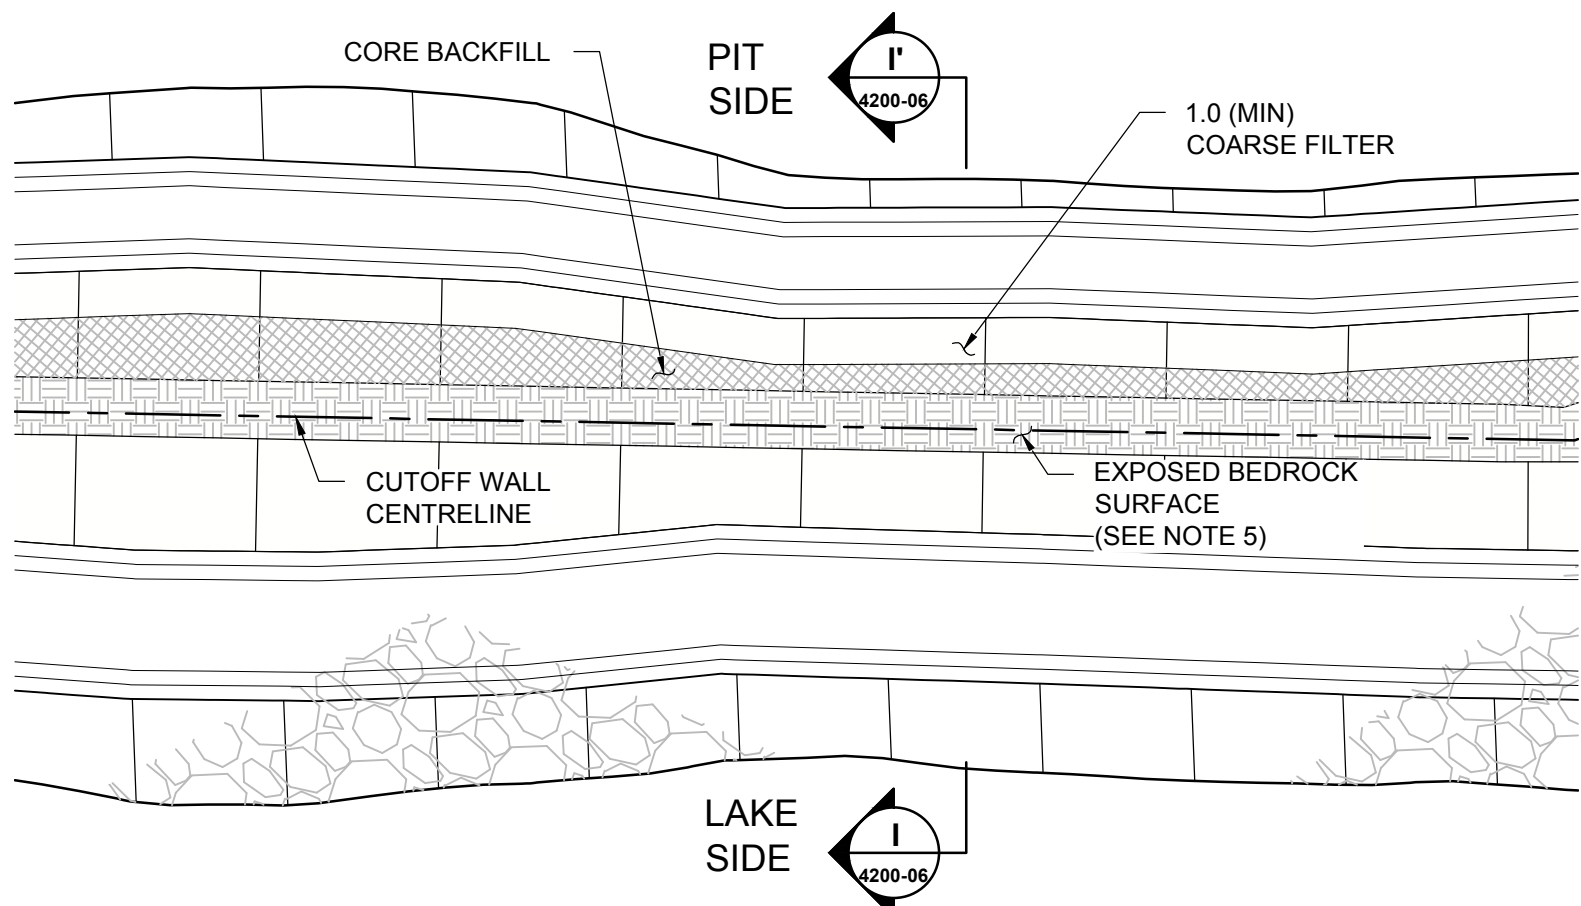


3 CORE BACKFILL PLACEMENT PLAN
SCALE: A

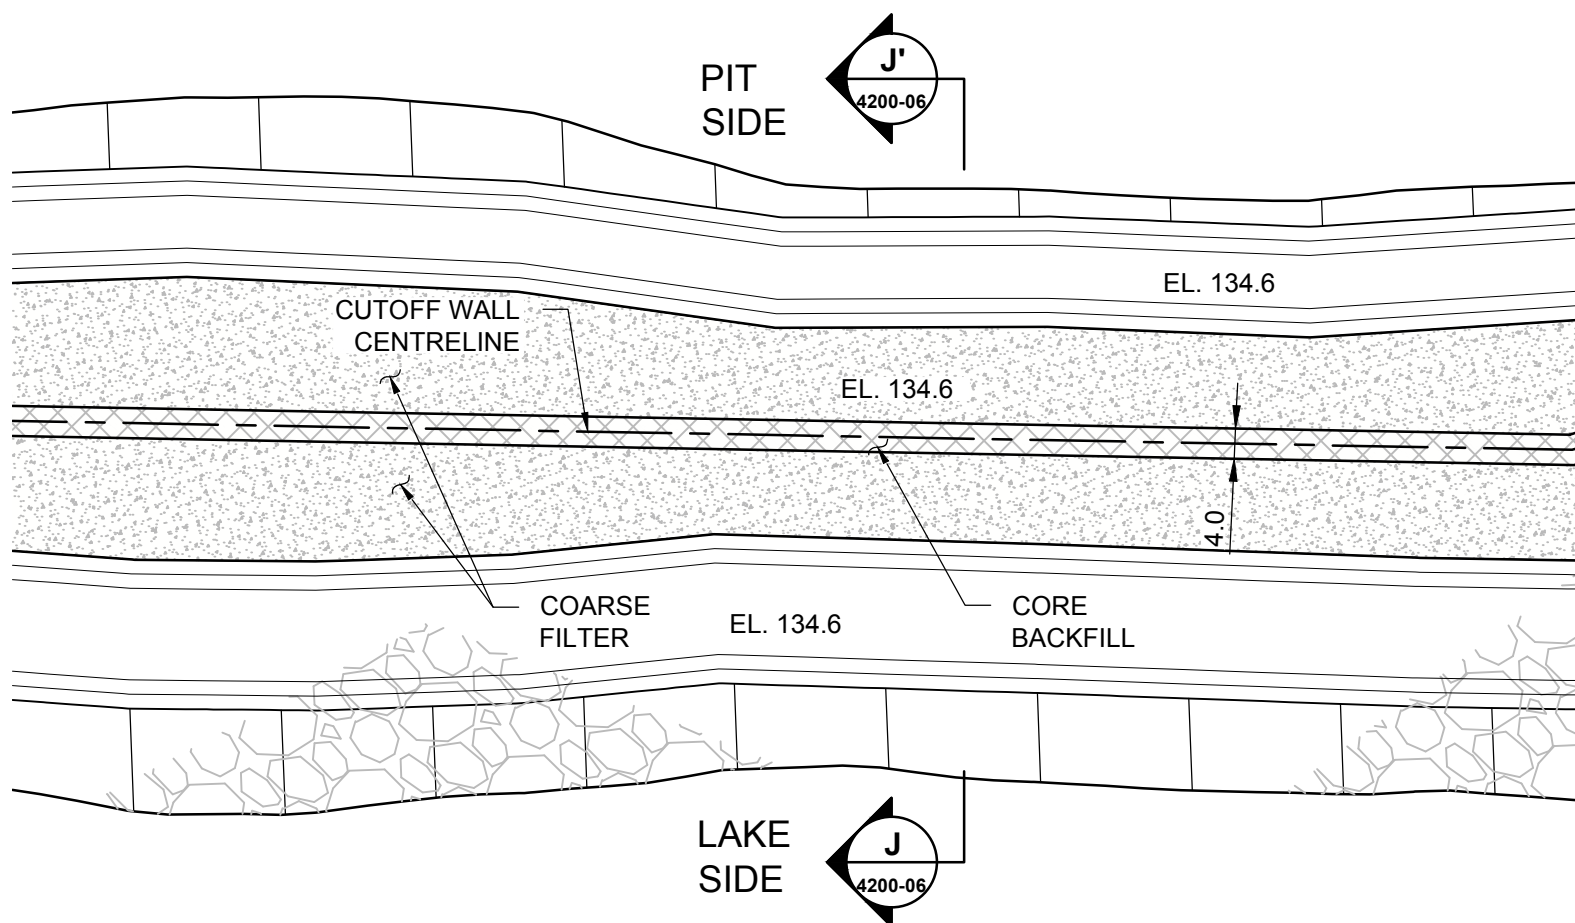


4 CORE BACKFILL AND COARSE FILTER PLACEMENT PLAN
SCALE: A

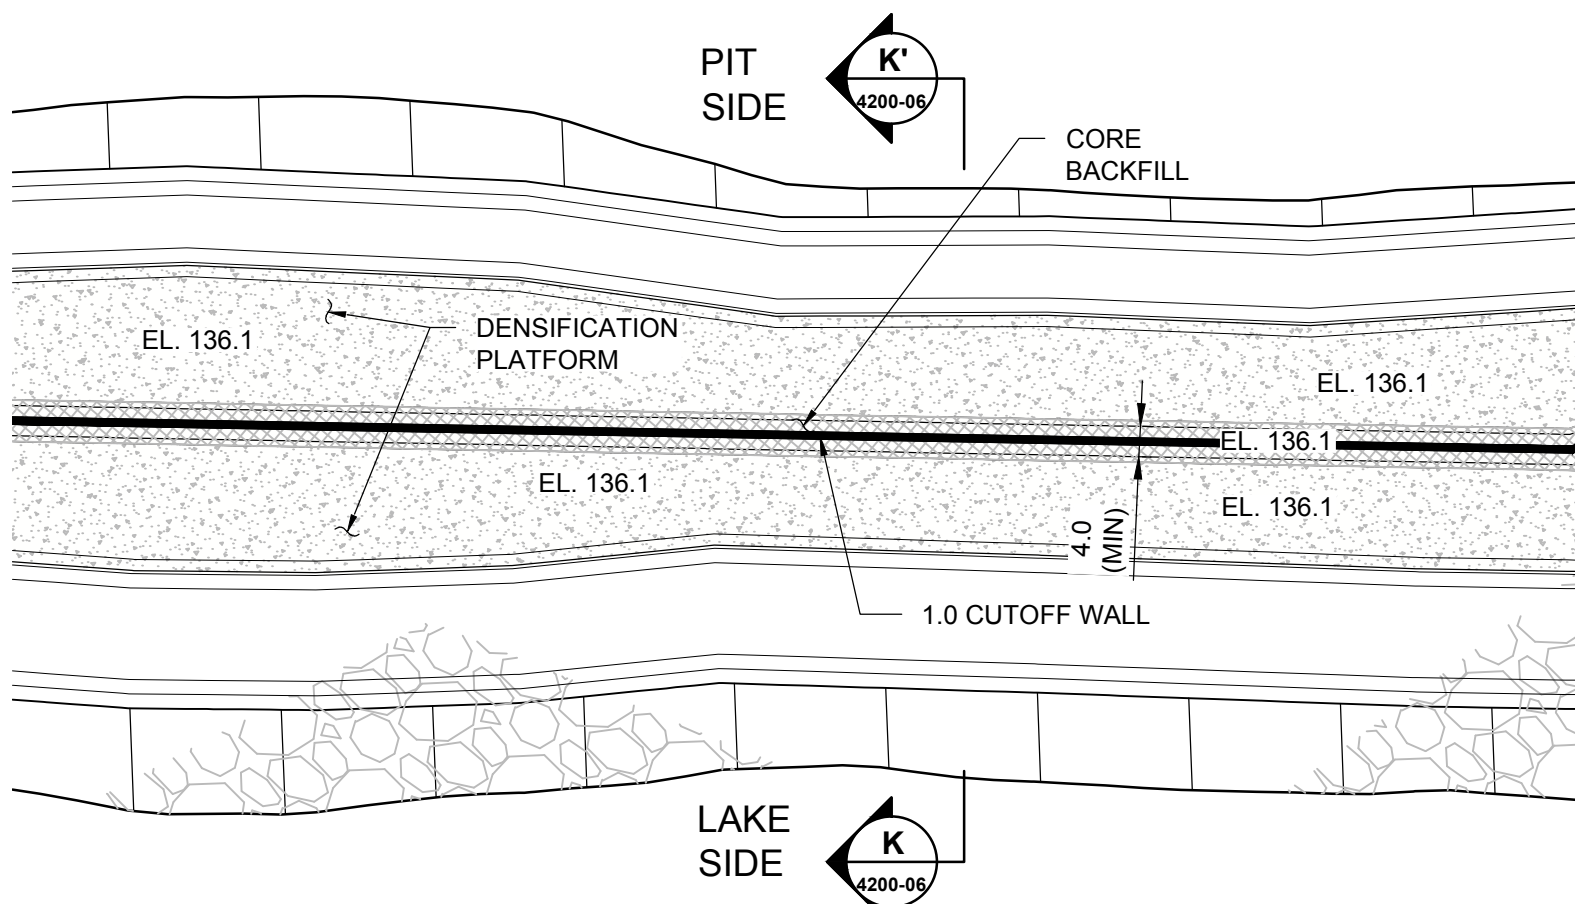


5 DENSIFICATION PLATFORM AND CUTOFF WALL PLACEMENT PLAN
SCALE: A

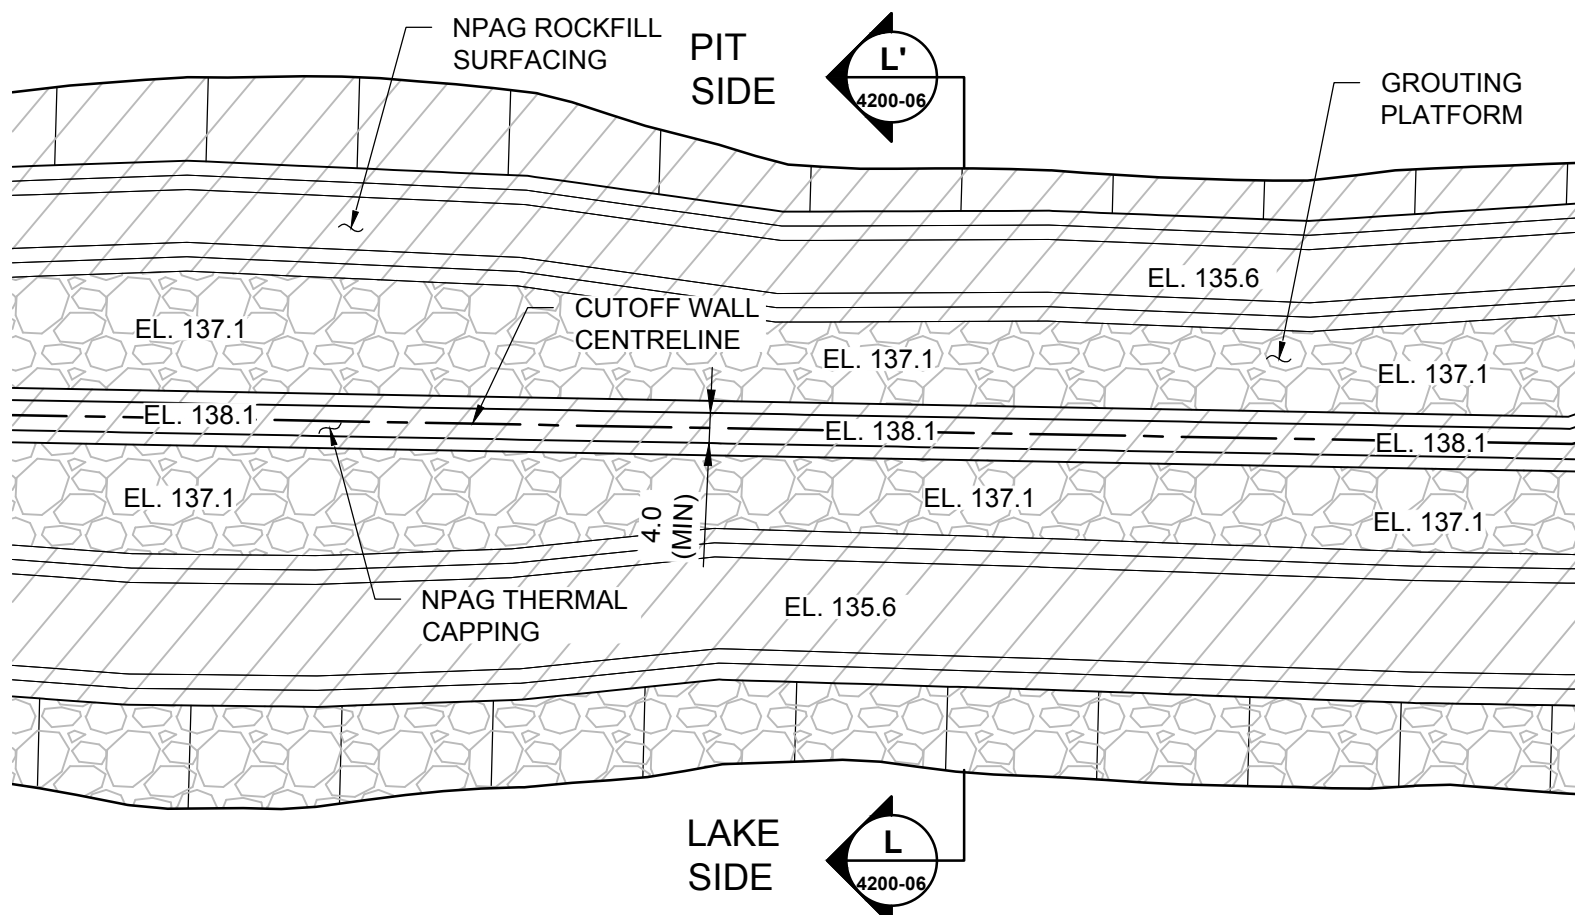

6 ROCKFILL SURFACING AND GROUTING PLATFORM PLACEMENT PLAN
SCALE: A

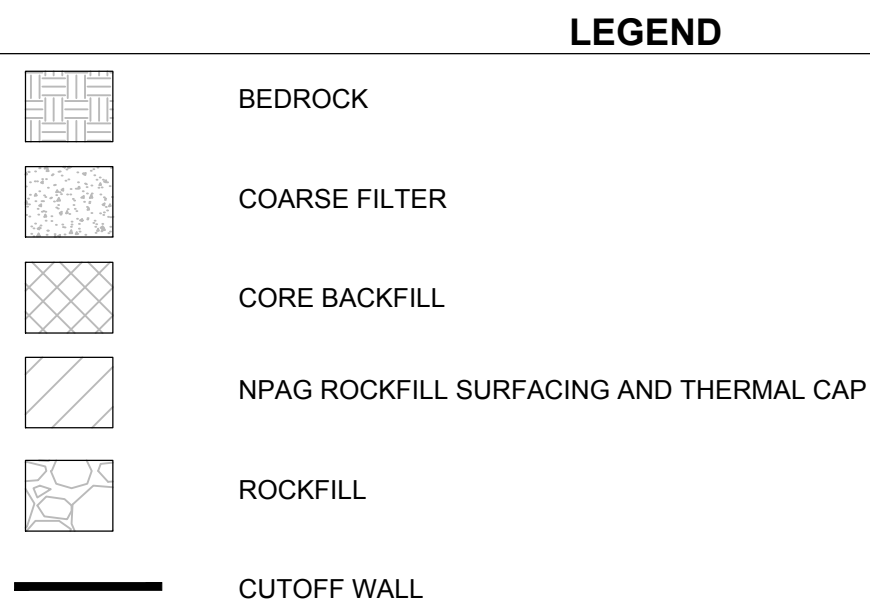


- NOTES
- ALL DIMENSIONS ARE IN METRES UNLESS OTHERWISE NOTED.
 - ALL ELEVATIONS ARE IN METRES ABOVE SEA LEVEL (MASL), UNLESS OTHERWISE NOTED.
 - NPAG ROCKFILL SURFACING ON DOWNSTREAM SLOPE TO BE PLACED BY AEM FOLLOWING DEWATERING. PLACEMENT IN PROGRESS AS OF APRIL 2013.
 - GEOCHEMICAL CLASSIFICATION OF NPAG MATERIALS IS THE RESPONSIBILITY OF AEM.
 - EXCAVATION TO COMPETENT BEDROCK SURFACE APPROVED BY ENGINEER FOR NORTHERN PORTION OF THE DIKE (STA 30+000 TO STA 30+860).
 - ALL ICE RICH MATERIAL BENEATH CUTOFF WALL EXCAVATED.
 - DOWNSTREAM EXCAVATION WIDTH WAS 4.8 MIN. WHERE THE BEDROCK ELEVATION WAS ABOVE 129.1 AND 6.8 MIN. WHERE THE ELEVATION WAS LESS THAN 129.1.
 - DOWNSTREAM EXCAVATION WIDTH OF 4.8 APPLIED TO:
- | STATION | |
|---------|--------|
| 30+000 | 30+140 |
| 30+475 | 30+860 |
- THERMAL CAP TO BE PLACED BY AEM. PLACEMENT IN PROGRESS AS OF APRIL 2013.

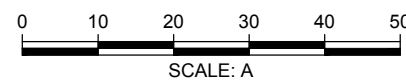


PROJECT	AGNICO-EAGLE MINES LIMITED MEADOWBANK GOLD PROJECT NUNAVUT		
AEM			
TITLE	BAY-GOOSE DIKE TYPICAL MATERIAL PLACEMENT PLAN		
	PROJECT No.	08-1428-0028/4200	FILE No.
	DESIGN	JU	04JUL08
	CADD	EA	05DEC08
	CHECK	JU	24DEC08
	REVIEW	JCC	24DEC08
SCALE		AS SHOWN	REV. 2
		4200-05	

DRAWING NO.	REFERENCES	REV	DATE	DES	REVISION DESCRIPTION	CADD	CHK	RVW	STAMP
		△	15DEC12	KD	AS-BUILT	JD	GRB	FE	
		△	31JUL09	FE	REVISED COARSE FILTER PLAN	JK	FE	MRJ	
		△	17JUL09	FE	ISSUED FOR CONSTRUCTION	EA	FE	MRJ	
		△	22MAY09	FE	REVISED ISSUED FOR TENDER	JK	DRW	MRJ	
		△	08MAY09	FE	ISSUED FOR TENDER	JK	DRW	MRJ	
		△	02FEB09	JU	ISSUED FOR REVIEW	SD	FE	JCC	
		△	24DEC08	JU	ISSUED FOR REVIEW	SD	JU	JCC	


REVISION DATE: 12/6/2012 2:53:56 PM By: T.Y.K. LASSON CADD FILE: N:\bur-graphics\Projects\2009\1428-5007\Drafting\4000\meadowbank - bay-goose (north) dfile as-built\0814280028-4200_2_06.dwg

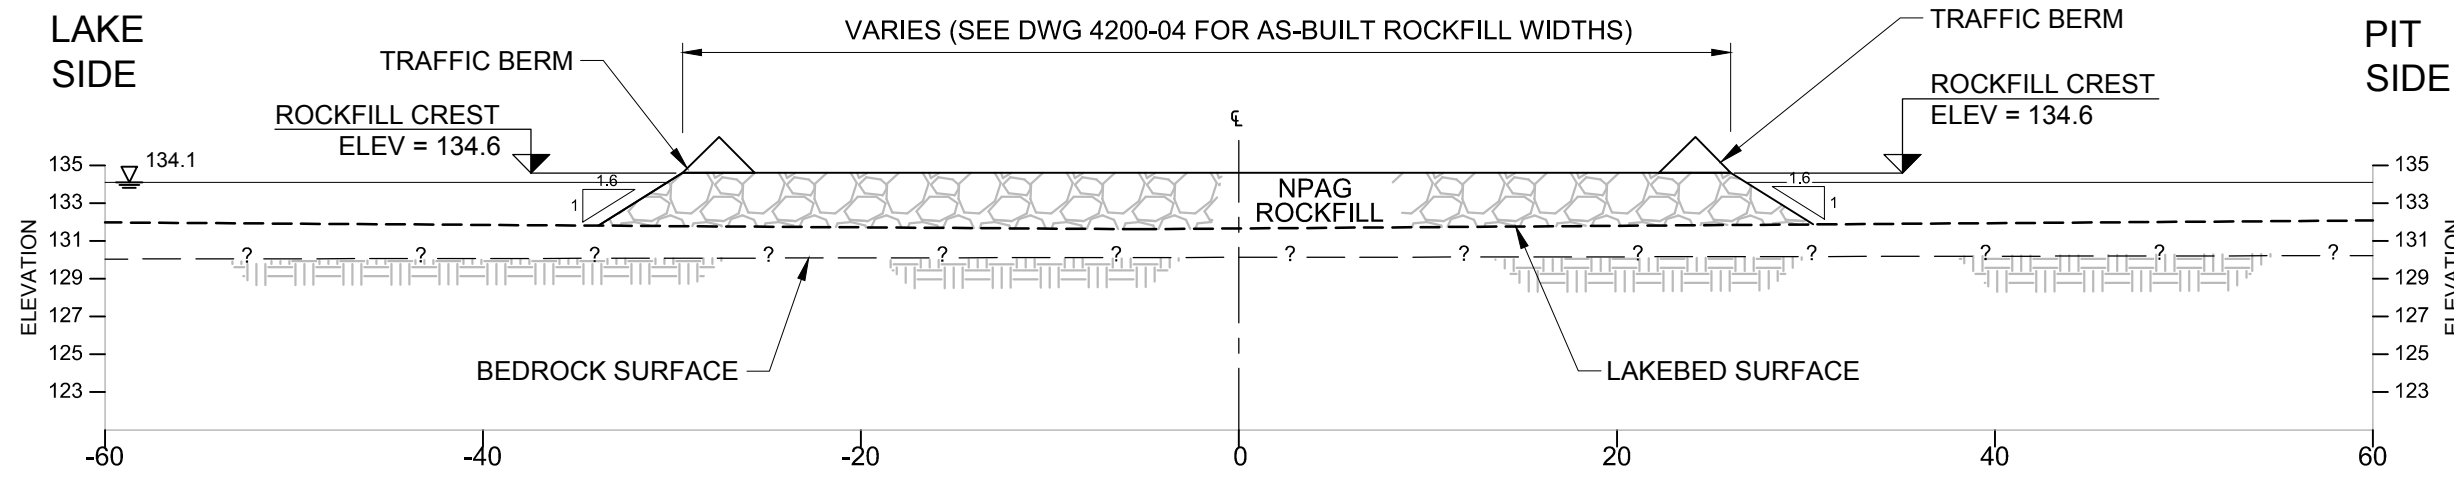


G-G'
4200-05
SCALE: A
INITIAL ROCKFILL PLACEMENT SECTION

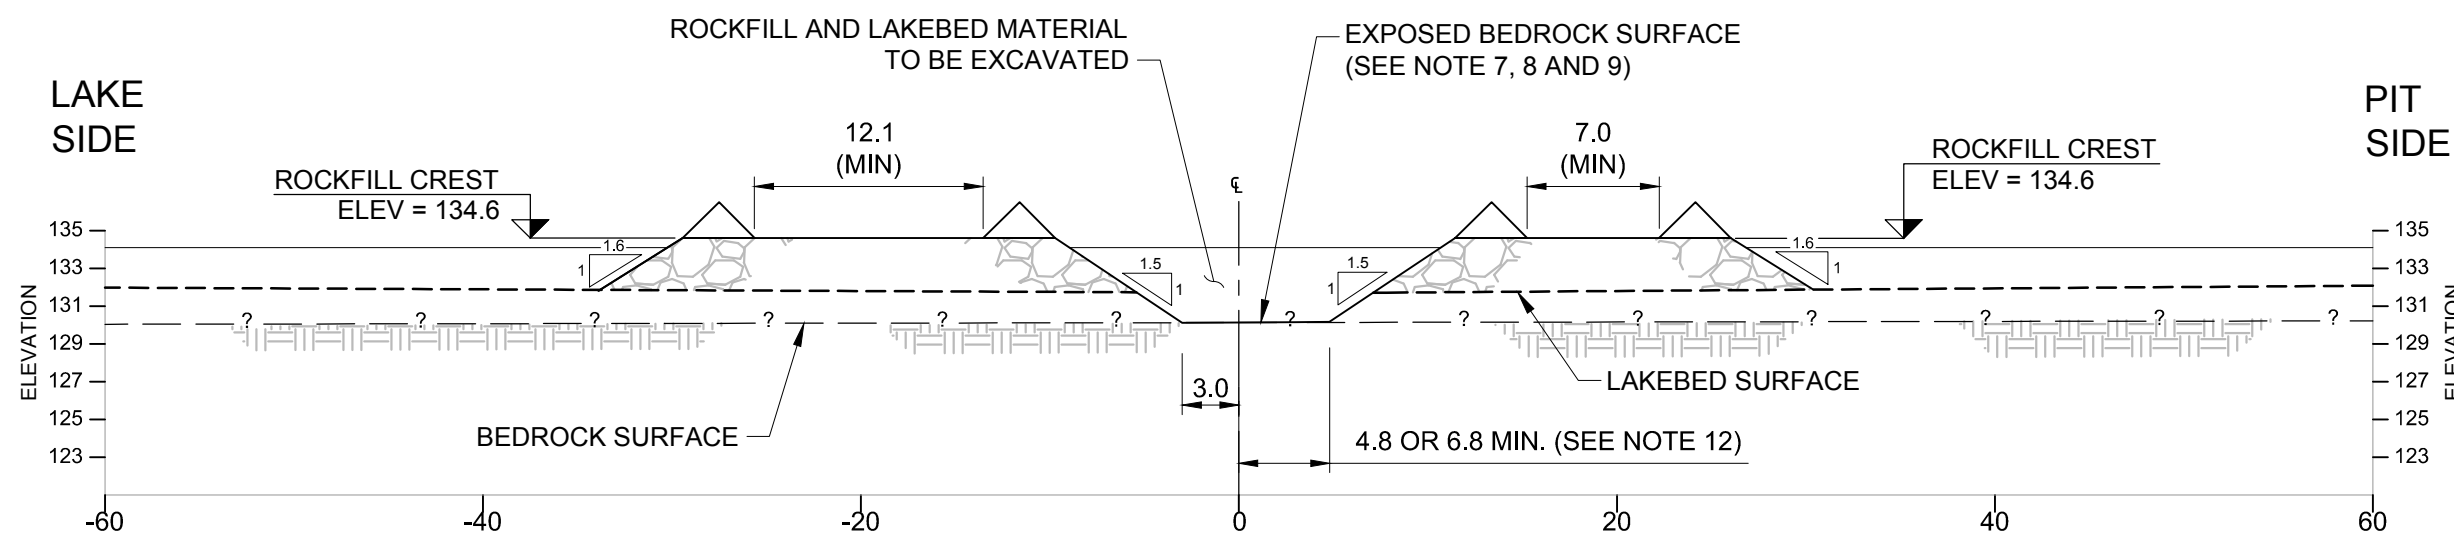


H-H'
4200-05
SCALE: A
EXCAVATION TO BEDROCK SECTION

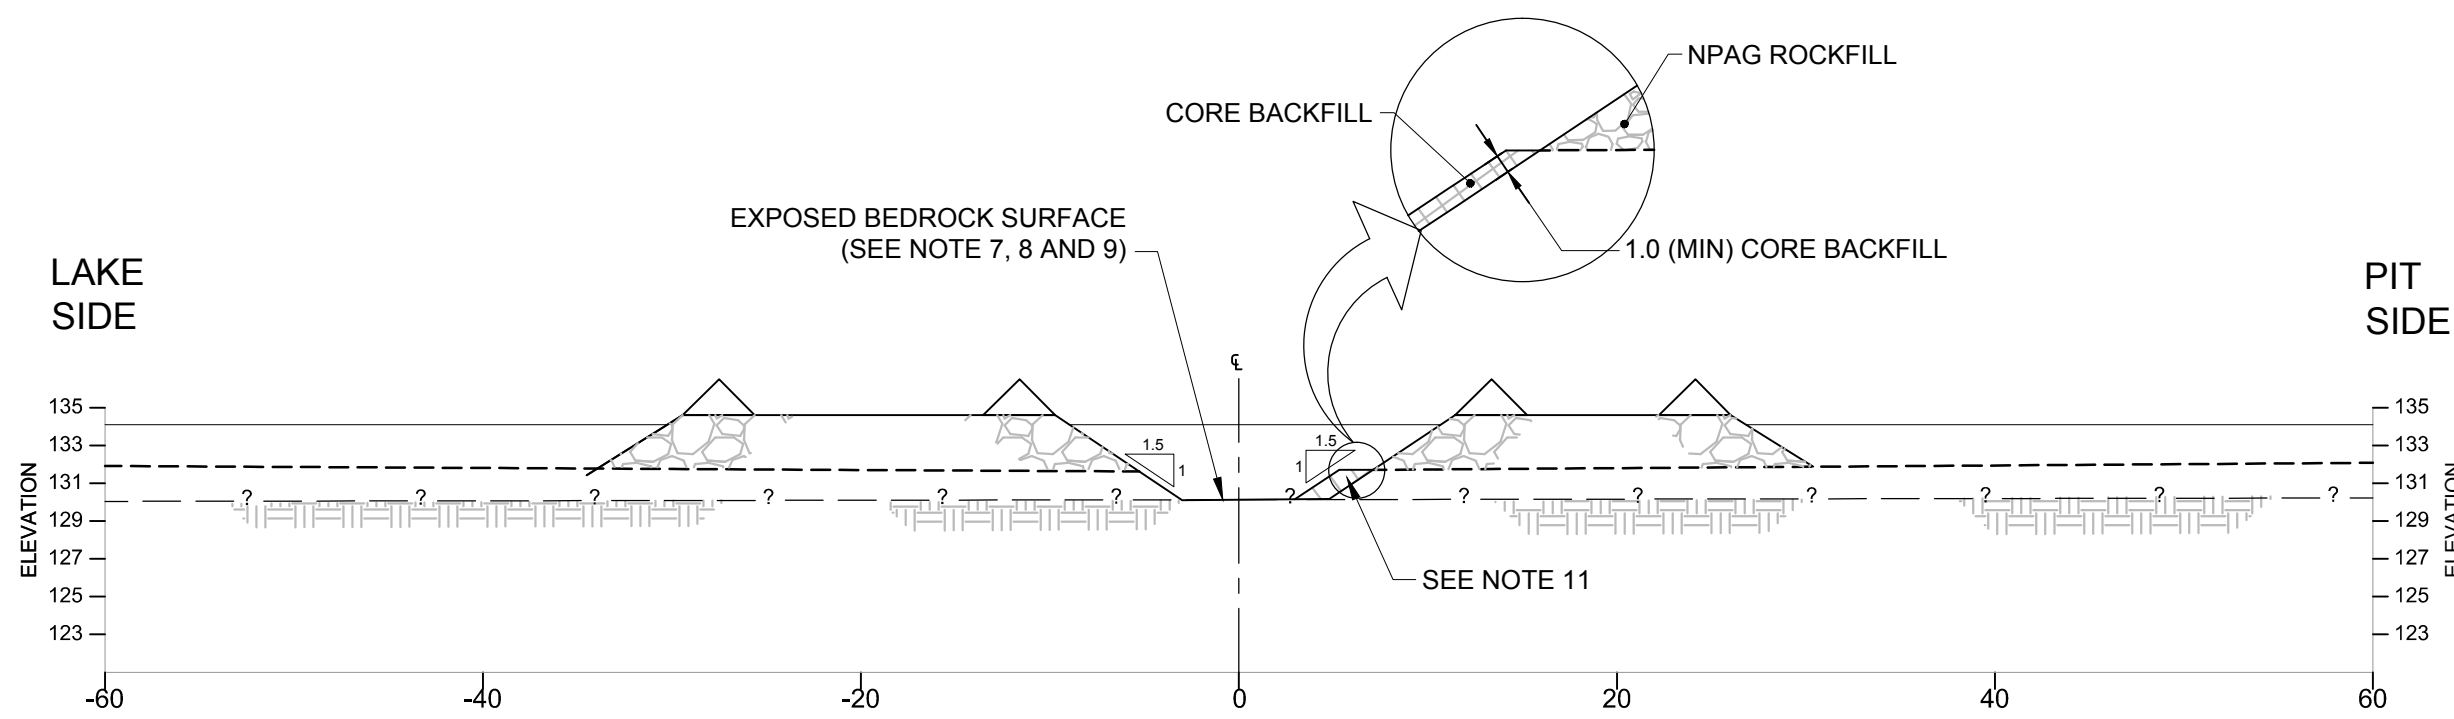


I-I'
4200-05
SCALE: A
CORE BACKFILL PLACEMENT SECTION

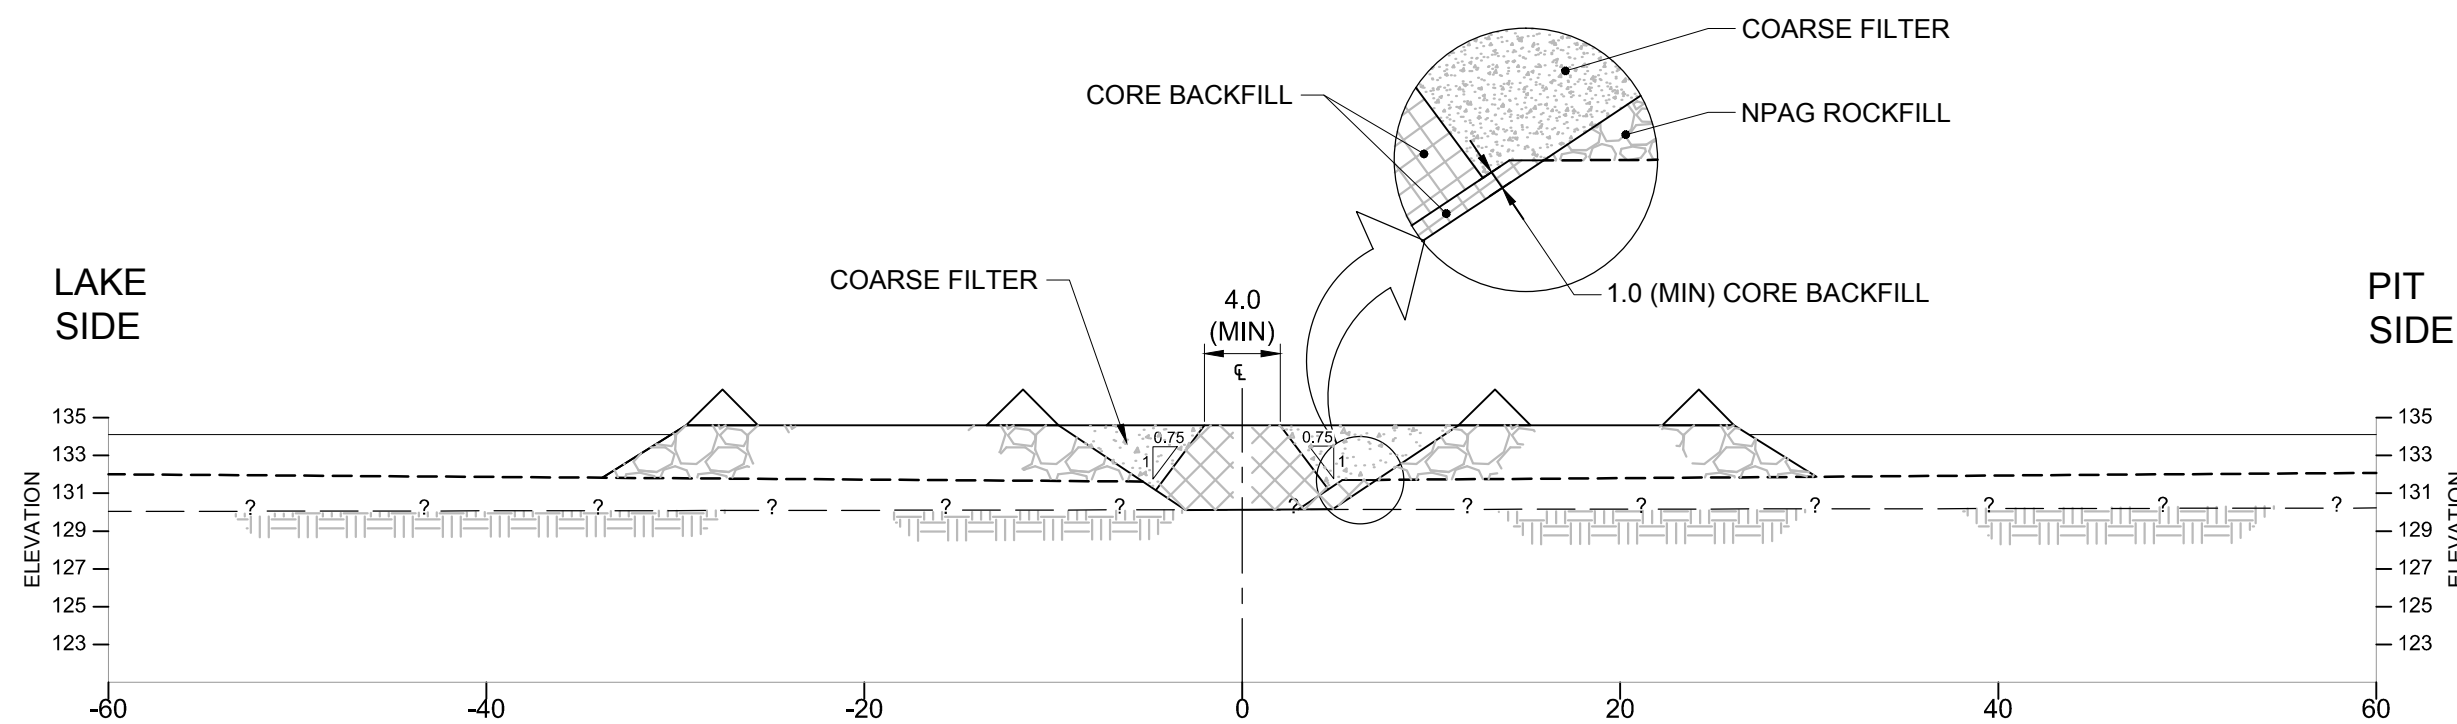


J-J'
4200-05
SCALE: A
CORE BACKFILL AND COARSE FILTER PLACEMENT SECTION

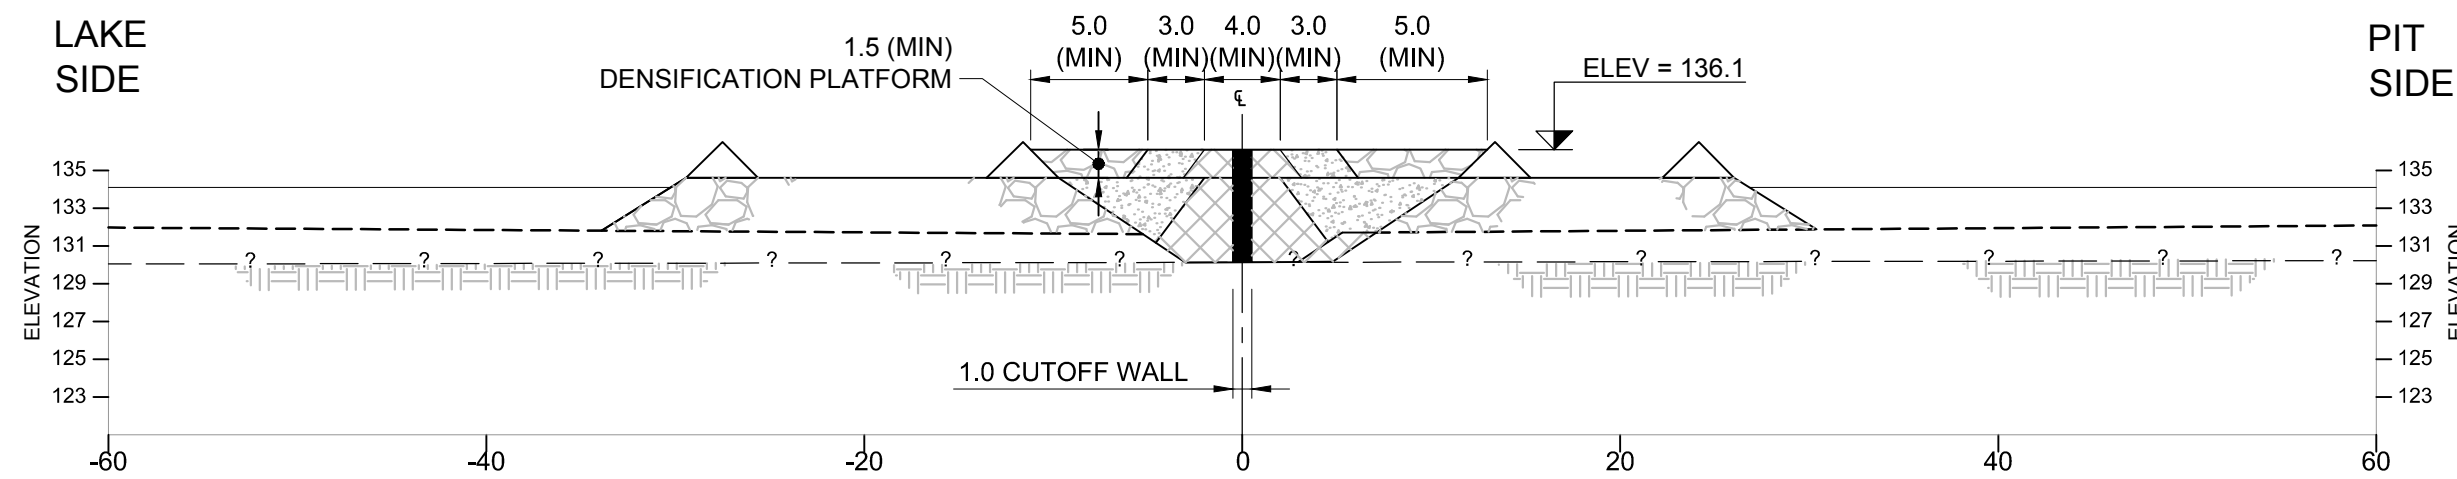

K-K'
4200-05
SCALE: A
DENSIFICATION PLATFORM AND CUTOFF WALL PLACEMENT SECTION

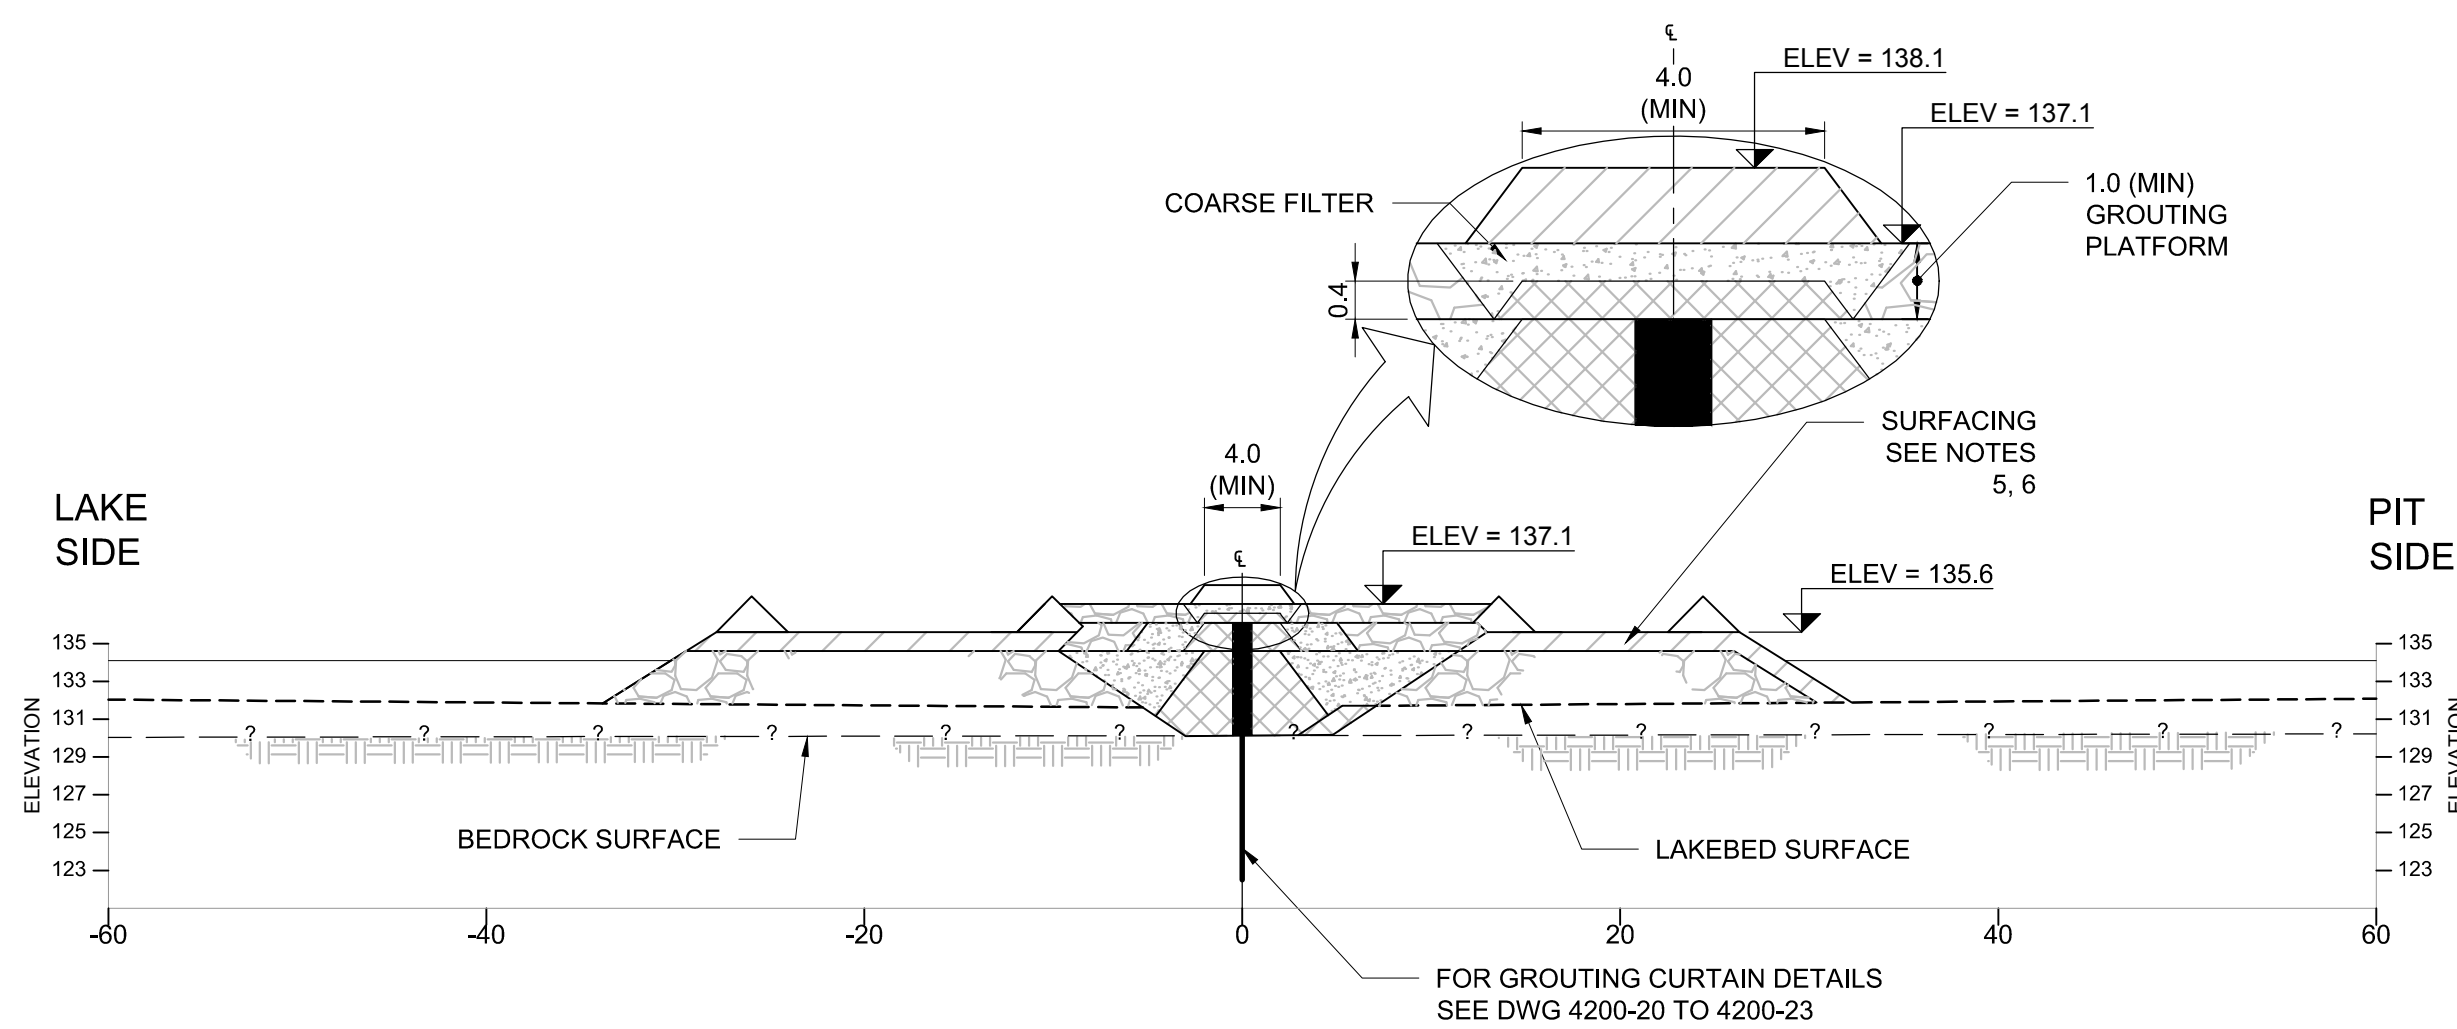

L-L'
4200-05
SCALE: A
ROCKFILL SURFACING AND GROUTING PLATFORM PLACEMENT SECTION

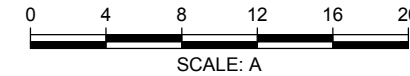

NOTES




- 1) ALL DIMENSIONS ARE IN METRES UNLESS OTHERWISE NOTED.
- 2) ALL ELEVATIONS ARE IN METRES ABOVE SEA LEVEL (MASL), UNLESS OTHERWISE NOTED.
- 3) LAKEBED SURFACE BASED ON BATHYMETRIC SURVEY BY GOLDER ASSOCIATES LTD. 2008. DEPTH TO LAKEBED AND BEDROCK BENEATH CUTOFF WALL CENTRELINE INFERRED, BASED ON GEOTECHNICAL INVESTIGATIONS.
- 4) WIDTH OF ROCKFILL ADJUSTED IN FIELD TO SUIT CONDITIONS.
- 5) NPAG ROCKFILL SURFACING ON DOWNSTREAM SLOPE TO BE PLACED BY AEM FOLLOWING DEWATERING. PLACEMENT IN PROGRESS AS OF APRIL 2013.
- 6) GEOCHEMICAL CLASSIFICATION OF NPAG MATERIALS WAS THE RESPONSIBILITY OF AEM.
- 7) EXCAVATION TO COMPETENT BEDROCK SURFACE APPROVED BY ENGINEER BETWEEN STA. 30+000 AND STA. 30+860.
- 8) ALL ICE RICH MATERIAL BENEATH THE CUTOFF WALL WAS EXCAVATED BETWEEN STA. 30+000 AND 30+860.
- 9) BEDROCK AND LAKEBED SURFACES ARE SHOWN AS SMOOTH LINES FOR ILLUSTRATIVE PURPOSES.
- 10) MATERIAL PLACEMENT ANGLES FOR THE COARSE FILTER AND CORE BACKFILL ARE APPROXIMATE.
- 11) LATERAL PLACEMENT OF CORE BACKFILL ON THE DOWNSTREAM SIDE OF THE EXCAVATION WAS REQUIRED IN ADVANCE OF THE PROGRESSIVE BACKFILLING OF CORE BACKFILL AND COARSE FILTER.
- 12) DOWNSTREAM EXCAVATION WIDTH WAS 4.8 MINIMUM WHERE THE BEDROCK ELEVATION WAS ABOVE 129.1 AND 6.8 MINIMUM ELSEWHERE.
- 13) THERMAL CAP AND ROCKFILL SURFACING TO BE PLACED BY AEM. PLACEMENT IN PROGRESS AS OF APRIL 2013.

LEGEND

- INFERRED BEDROCK
- COARSE FILTER / DENSIFICATION PLATFORM
- CORE BACKFILL
- NPAG ROCKFILL SURFACING AND THERMAL CAP
- ROCKFILL
- CUTOFF WALL (SOIL BENTONITE AND/OR CEMENT SOIL BENTONITE)

--	--	
CADD FILE: N:\bur-graphics\Projects\2009\1428\09-1428-5007\Drafting\4000\meadowbank - Bay-goose (north) Dike As-built\0814280028-4200_1_07.dwg
REVISION DATE: 4/8/2013 3:54:04 PM By: TYKLASSEN

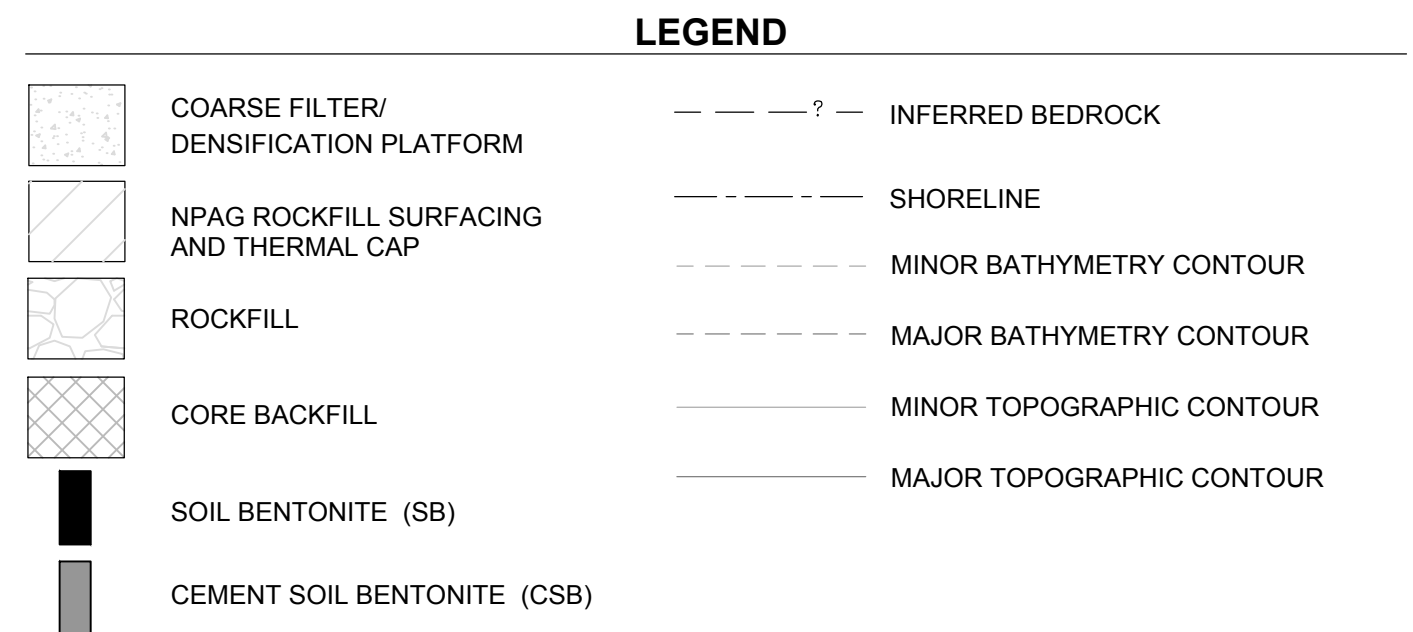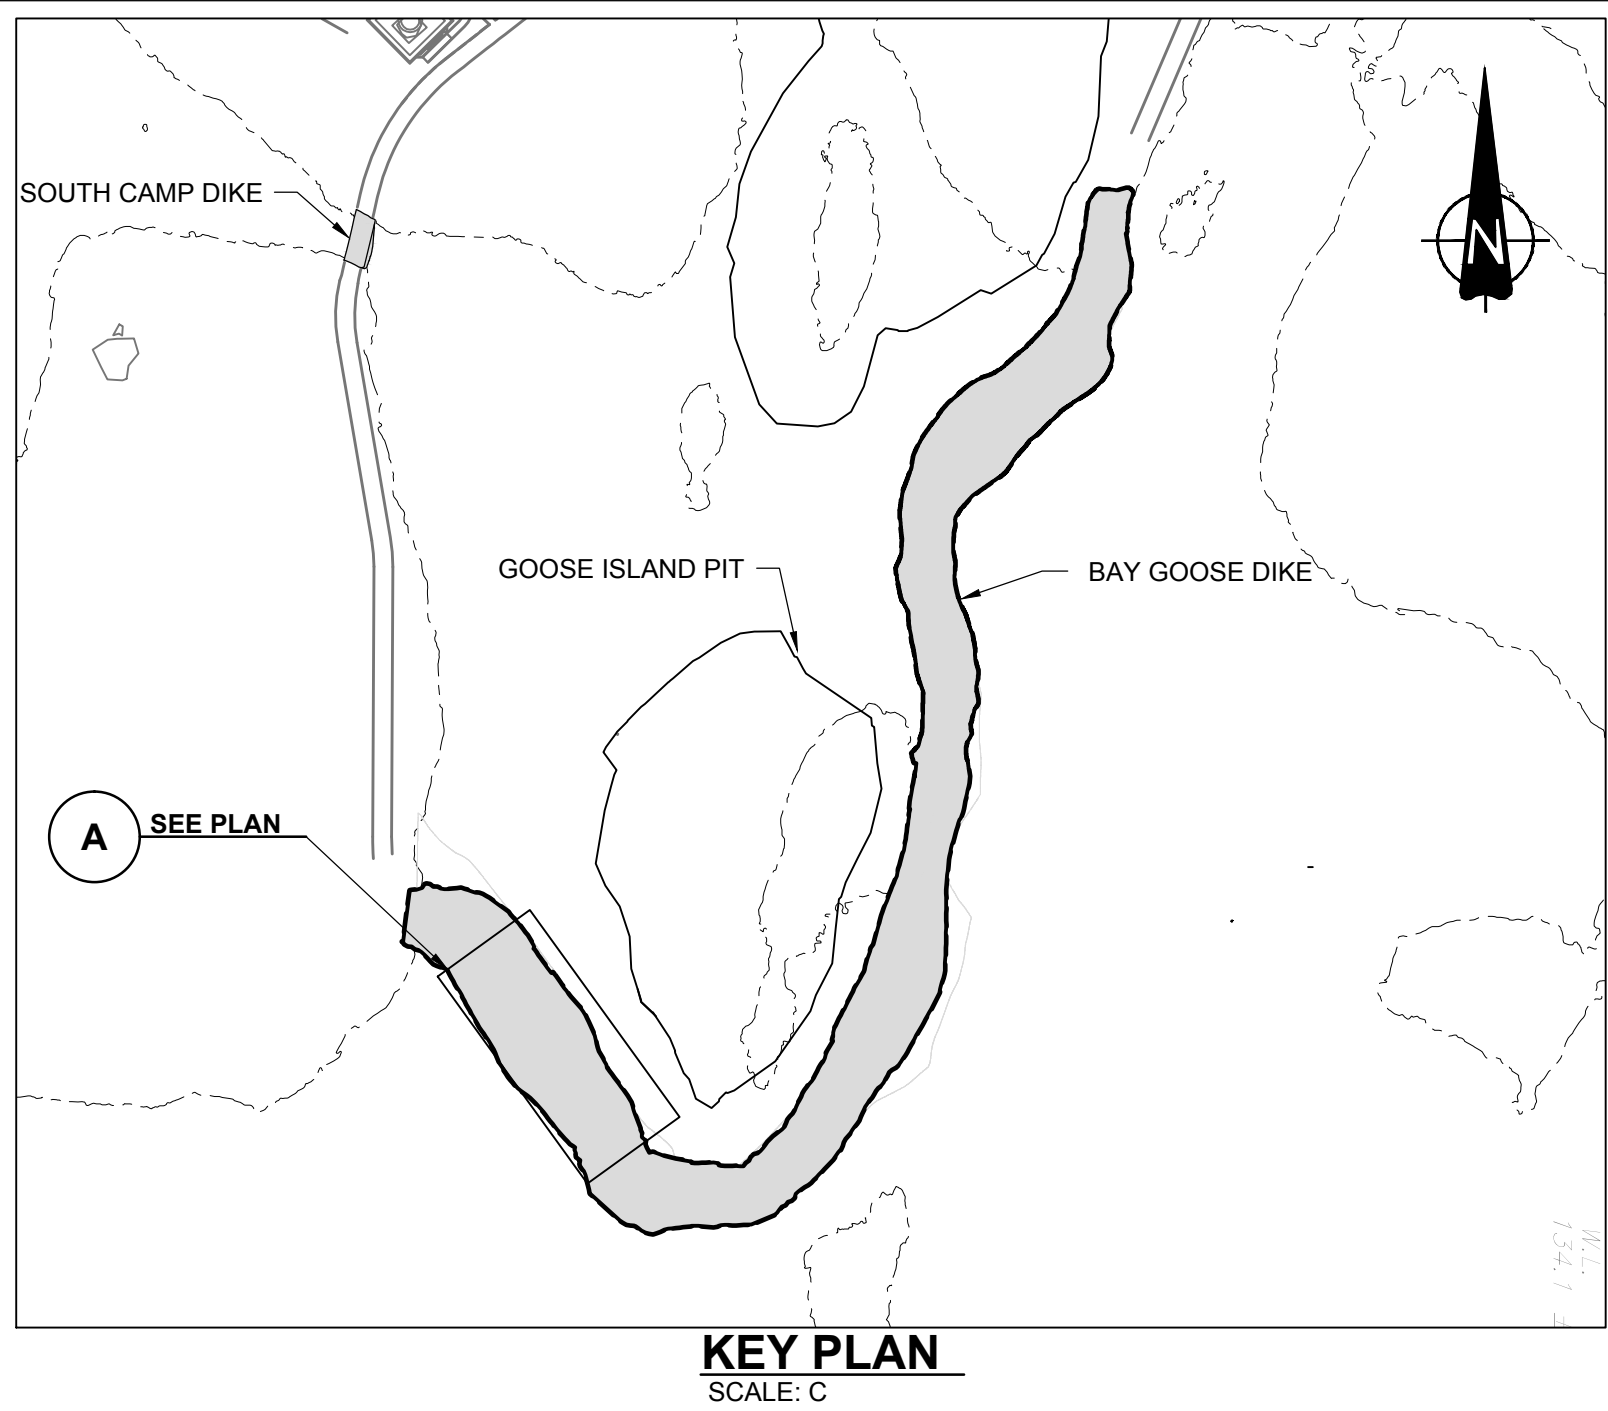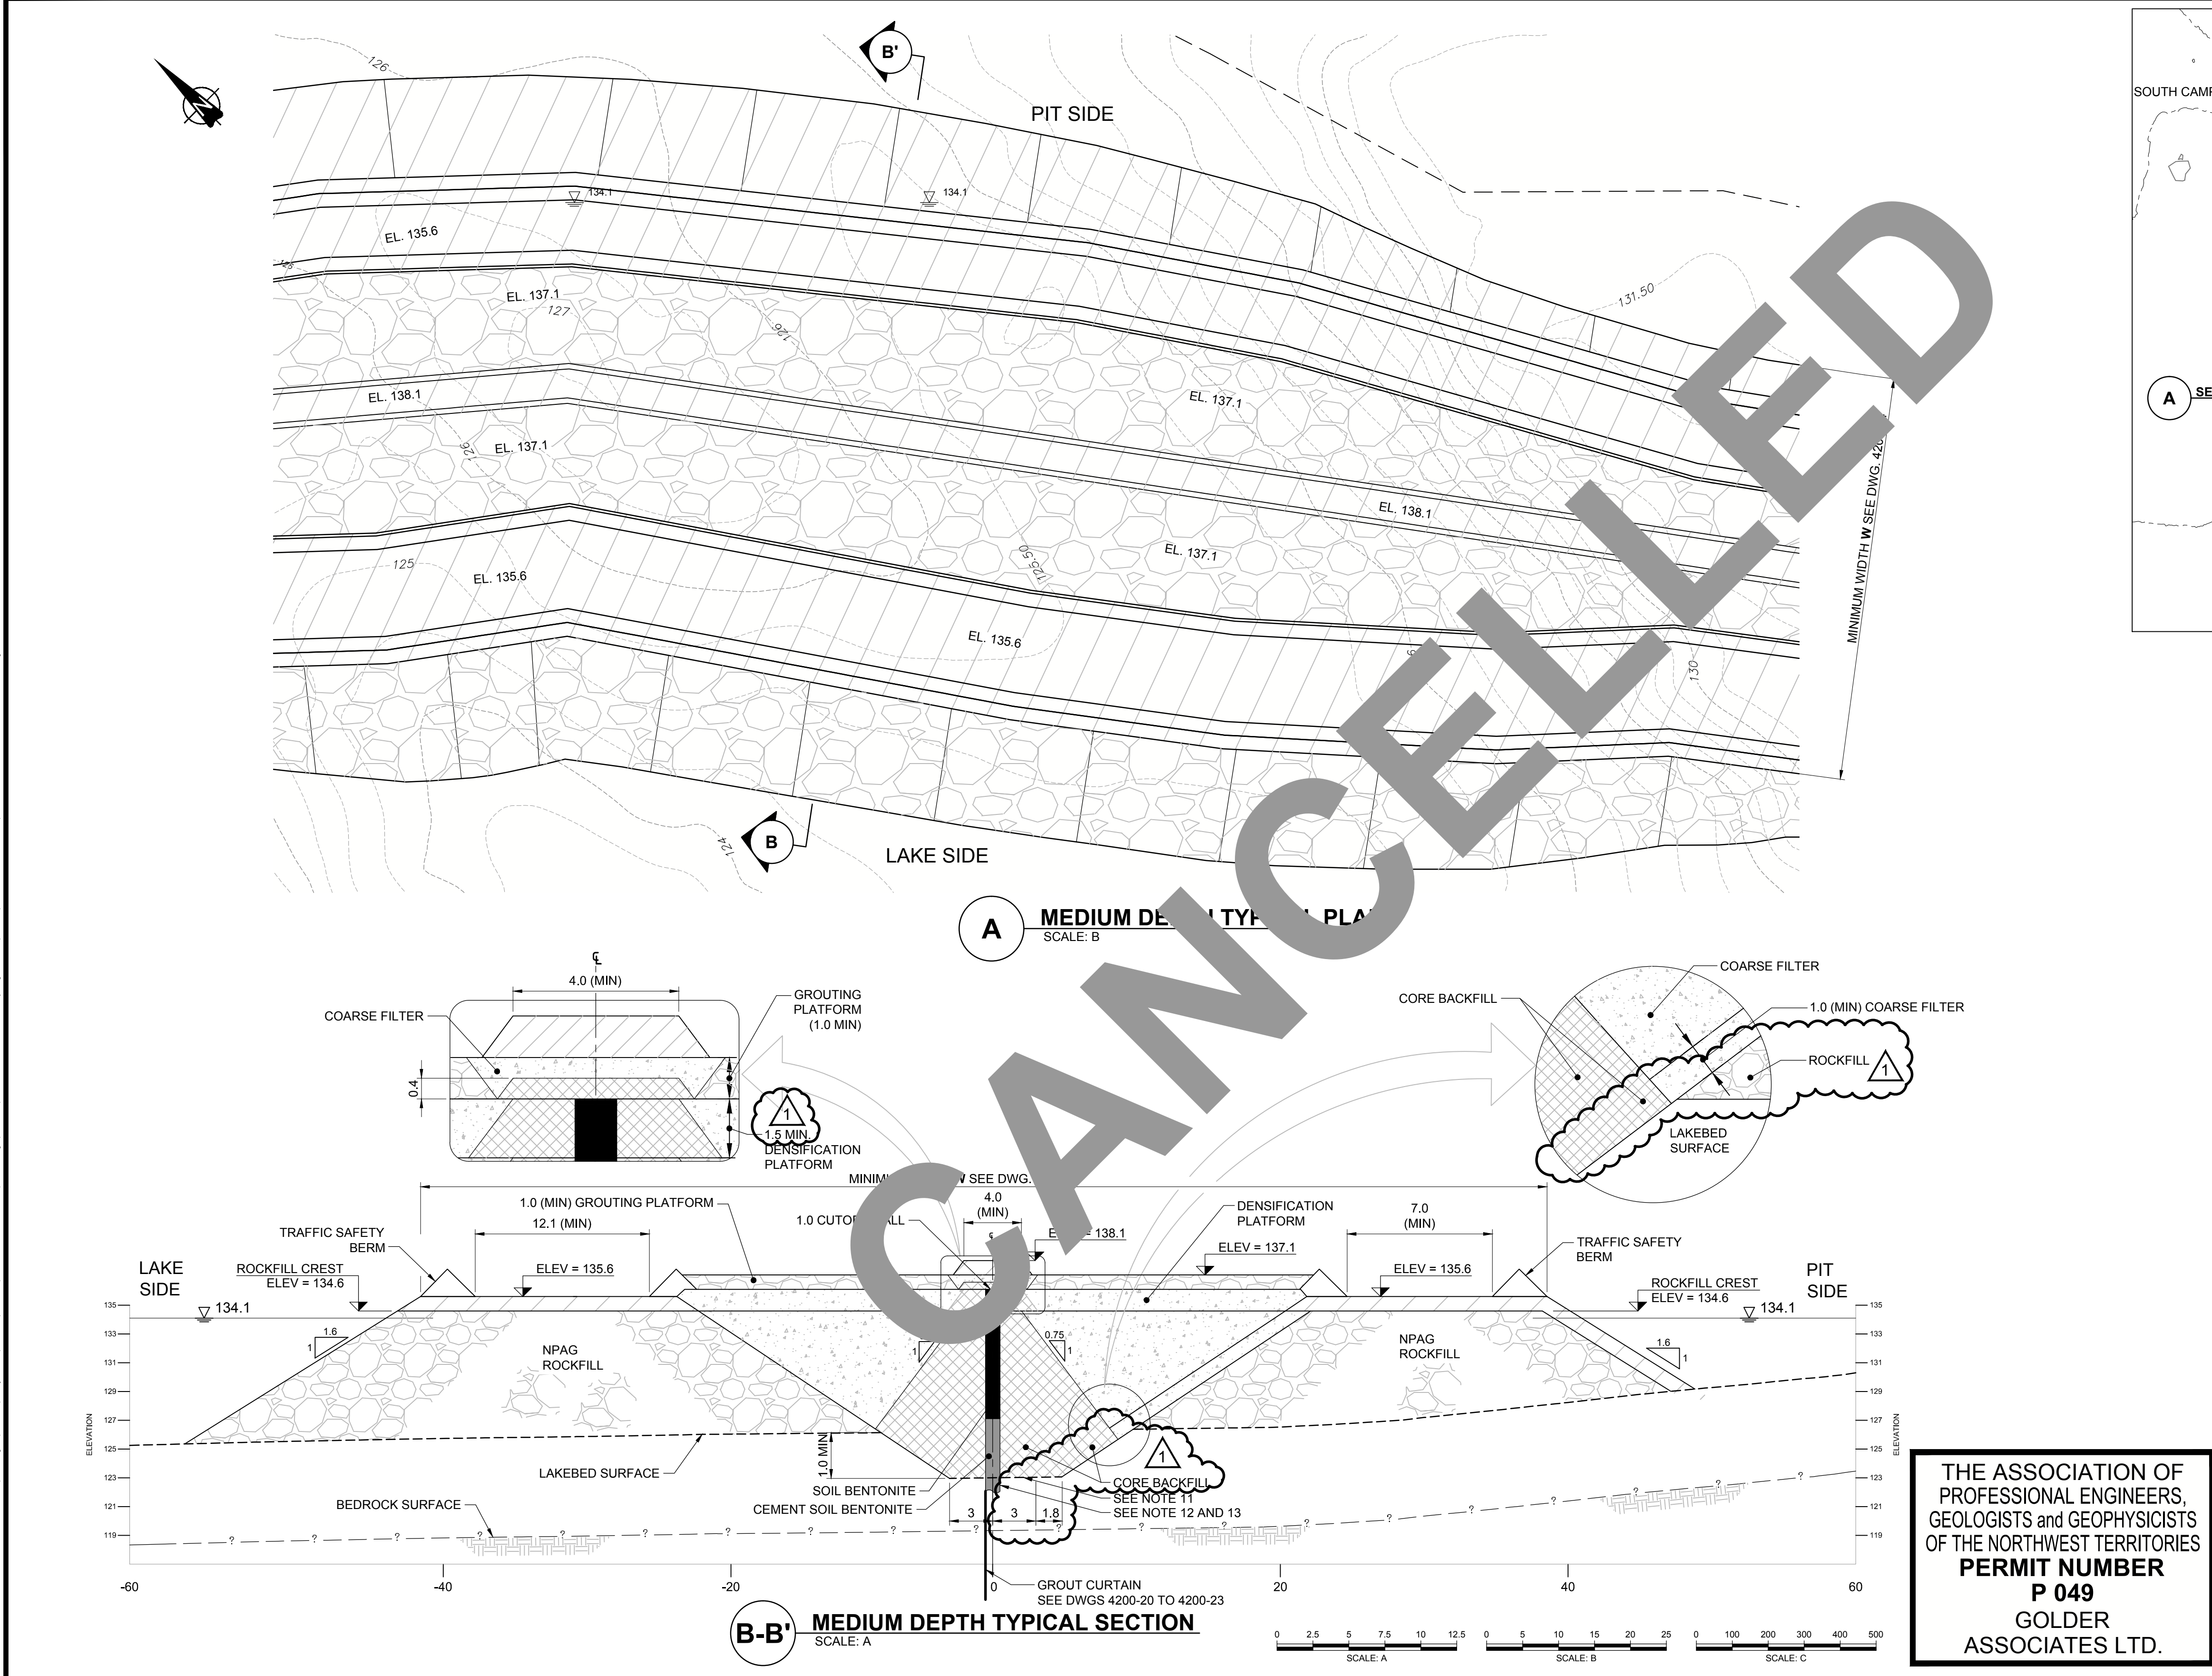

- NOTES**
- 1) ALL DIMENSIONS ARE IN METERS UNLESS OTHERWISE NOTED.
 - 2) ALL ELEVATIONS ARE IN METERS ABOVE SEA LEVEL (MASL), UNLESS OTHERWISE NOTED.
 - 3) GRID REFERENCE: NAD 83, UTM ZONE 14.
 - 4) LAKEBED SURFACE BASED ON BATHYMETRIC SURVEY BY GOLDER ASSOCIATES LTD. 2008. DEPTH TO LAKEBED AND BEDROCK BENEATH CUTOFF WALL CENTRELINE INFERRED BASED ON GEOTECHNICAL INVESTIGATIONS. BEDROCK SURFACE INFORMATION TO BE UPDATED FOR THE SOUTHERN PORTION (STATION 31+000 TO STATION 32+213.69) OF THE DIKE FOLLOWING COMPLETION OF THE 2009/2010 INVESTIGATION PROGRAM (BY ENGINEER).
 - 5) NPAG ROCKFILL SURFACING AND THERMAL CAP TO BE PLACED BY AEM. SURFACING ON DOWNSTREAM SLOPE TO BE PLACED FOLLOWING DEWATERING. PLACEMENT IN PROGRESS AS OF APRIL 2013.
 - 6) GEOCHEMICAL CLASSIFICATION OF NPAG MATERIALS IS THE RESPONSIBILITY OF AEM.
 - 7) USE OF COARSE FILTER AGAINST PIT SIDE FACE OF EXCAVATION IS REQUIRED, UNLESS APPROVED IN WRITING BY THE ENGINEER.
 - 8) ALL SLOPES SHOWN ARE NOMINAL VALUES.
 - 9) ADDITIONAL ROCKFILL MAY BE REQUIRED TO MAINTAIN HAUL ROAD MINIMUM WIDTH.
 - 10) WIDTH OF ROCKFILL TO BE ADJUSTED IN FIELD TO SUIT CONDITIONS. ADDITIONAL WIDTH MAY BE REQUIRED TO PROVIDE STABLE UPSTREAM EXCAVATION SLOPE.
 - 11) EXCAVATION FOR NORTHERN PORTION OF THE DIKE TO BE TO COMPETENT BEDROCK SURFACE, APPROVED BY ENGINEER (STATION 30+000 TO 31+000).
 - 12) EXCAVATION FOR SOUTHERN PORTION OF THE DIKE (STATION 31+000 TO 32+213.69) TO BE TO COMPETENT BEDROCK SURFACE OR COMPETENT LAKEBED SOILS, TO BE APPROVED BY ENGINEER.
 - 13) PARTIAL CUTOFF SHOWN FOR SOUTHERN PORTION OF THE DIKE. DEPTH OF CUTOFF TO BE CONFIRMED BASED ON 2009/2010 GEOTECHNICAL INVESTIGATIONS (BY ENGINEER).
 - 14) MATERIAL PLACEMENT ANGLES FOR THE COARSE FILTER AND CORE BACKFILL ARE APPROXIMATE.
 - 15) BEDROCK AND LAKEBED SURFACES ARE SHOWN AS SMOOTH LINES FOR ILLUSTRATIVE PURPOSES. CONTRACTOR SHOULD ANTICIPATE UNDULATING AND UNEVEN SURFACES.
 - 16) THIS DESIGN SECTION WILL APPLY IN MEDIUM DEPTH AREAS WHERE DEPTH OF BEDROCK IS AT OR BELOW ELEVATION 126.
 - 17) IF SLURRY WALL TO BE CONSTRUCTED BELOW ELEVATION 126.0 A CEMENT SOIL BENTONITE (CSB) SLURRY SHALL BE USED AT THE BASE OF THE WALL. THE CSB SHALL EXTEND TO 127.0 OR HIGHER AND SHOULD BE CONSTRUCTED IN SUCH A WAY AS TO AVOID THE PRESENCE OF ABRUPT CHANGE, WEAK ZONE, OR JOINT AT INTERFACE BETWEEN SB AND CSB.


THE ASSOCIATION OF
PROFESSIONAL ENGINEERS,
GEOLOGISTS and GEOPHYSICISTS
OF THE NORTHWEST TERRITORIES
PERMIT NUMBER
P 049
GOLDER
ASSOCIATES LTD.

4200-04	INITIAL ROCKFILL LAYOUT PLAN
4200-06	TYPICAL SHALLOW DEPTH MATERIAL PLACEMENT SECTIONS
4200-14, 4200-15, 4200-16	CROSS SECTIONS (1 OF 3), (2 OF 3), (3 OF 3)
4200-18	LONGITUDINAL SECTION
4200-20	GROUTING WORK AREAS - PLAN
4200-21	GROUTING WORK AREAS - PROFILE
4200-22	GROUTING DETAILS
4200-23	GROUTING PROCEDURE PERFORATED CASING AND TAM
DRAWING NO.	REFERENCES


REV	DATE	DES	REVISION DESCRIPTION
2	03APR13	FE	CANCELLED
3	31JUL09	FE	REVISED MEDIUM DEPTH SECTION
4	17JUL09	FE	ISSUED FOR CONSTRUCTION
5	22MAY09	FE	REVISED ISSUED FOR TENDER
6	08MAY09	FE	ISSUED FOR TENDER
7	02FEB09	JU	ISSUED FOR REVIEW
8	24DEC08	JU	ISSUED FOR REVIEW

STAMP		
ORIGINAL SIGNED AND SEALED		
TK	FE	MRJ
JK	FE	MRJ
MSH	FE	MRJ
JK	FE	MRJ
EA	FE	JCC
EA	JU	JCC
CADD	CHK	RVW


PROJECT		AGNICO-EAGLE MINES LIMITED MEADOWBANK GOLD PROJECT NUNAVUT						
AEM								
TITLE		BAY-GOOSE DIKE TYPICAL MEDIUM DEPTH PLAN AND SECTION						
 Golder Associates		PROJECT No.		08-1428-0028/4200	FILE No.	0814280028-4200_1_07		
		DESIGN	JU	04JUL08	SCALE	AS SHOWN	REV.	2
		CADD	EA	03DEC08	4200-07			
		CHECK						
		REVIEW						

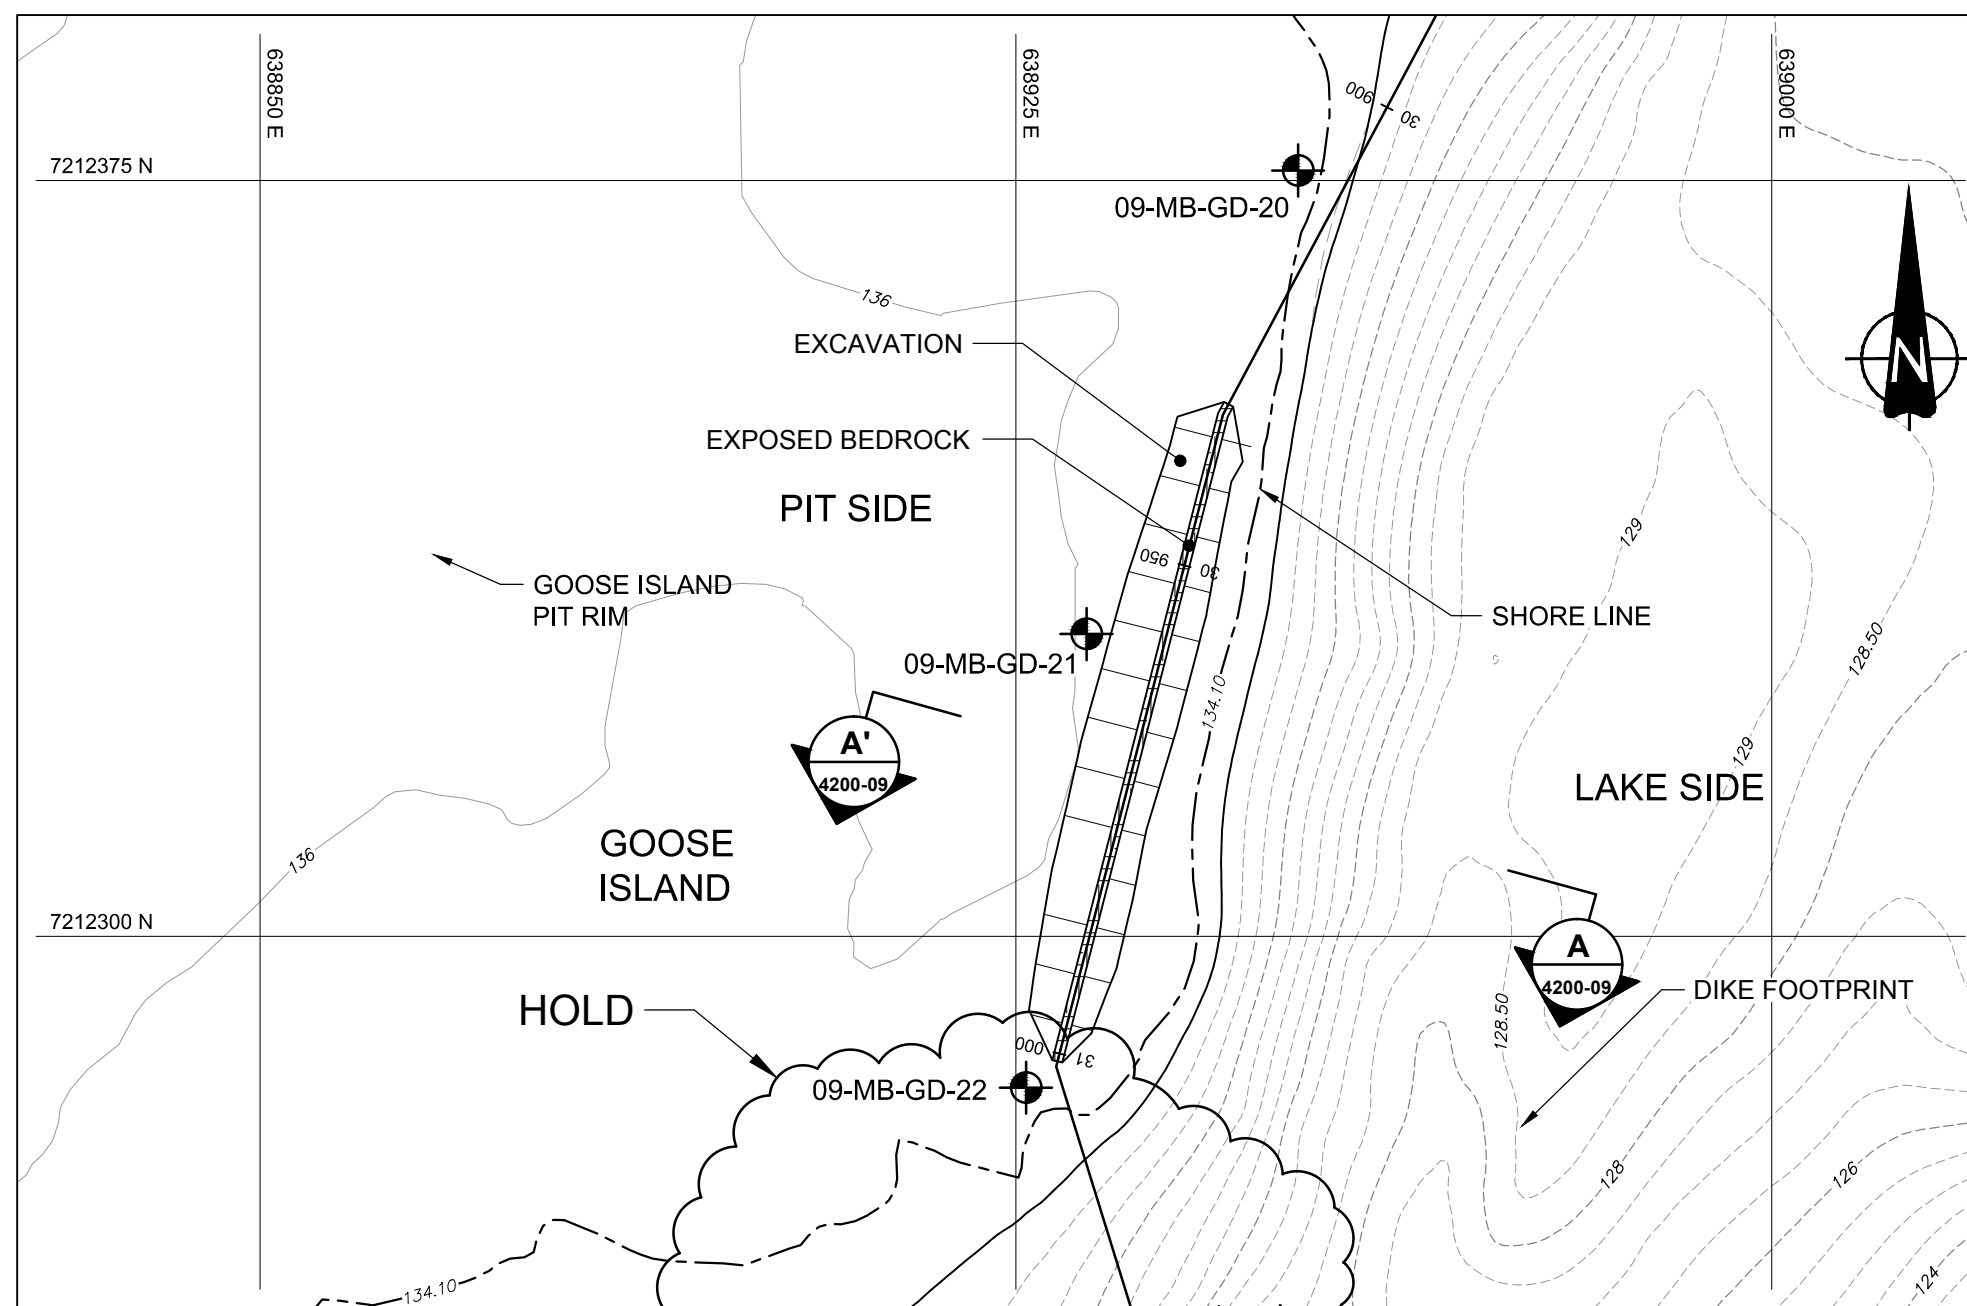

1 EXCAVATION PLAN

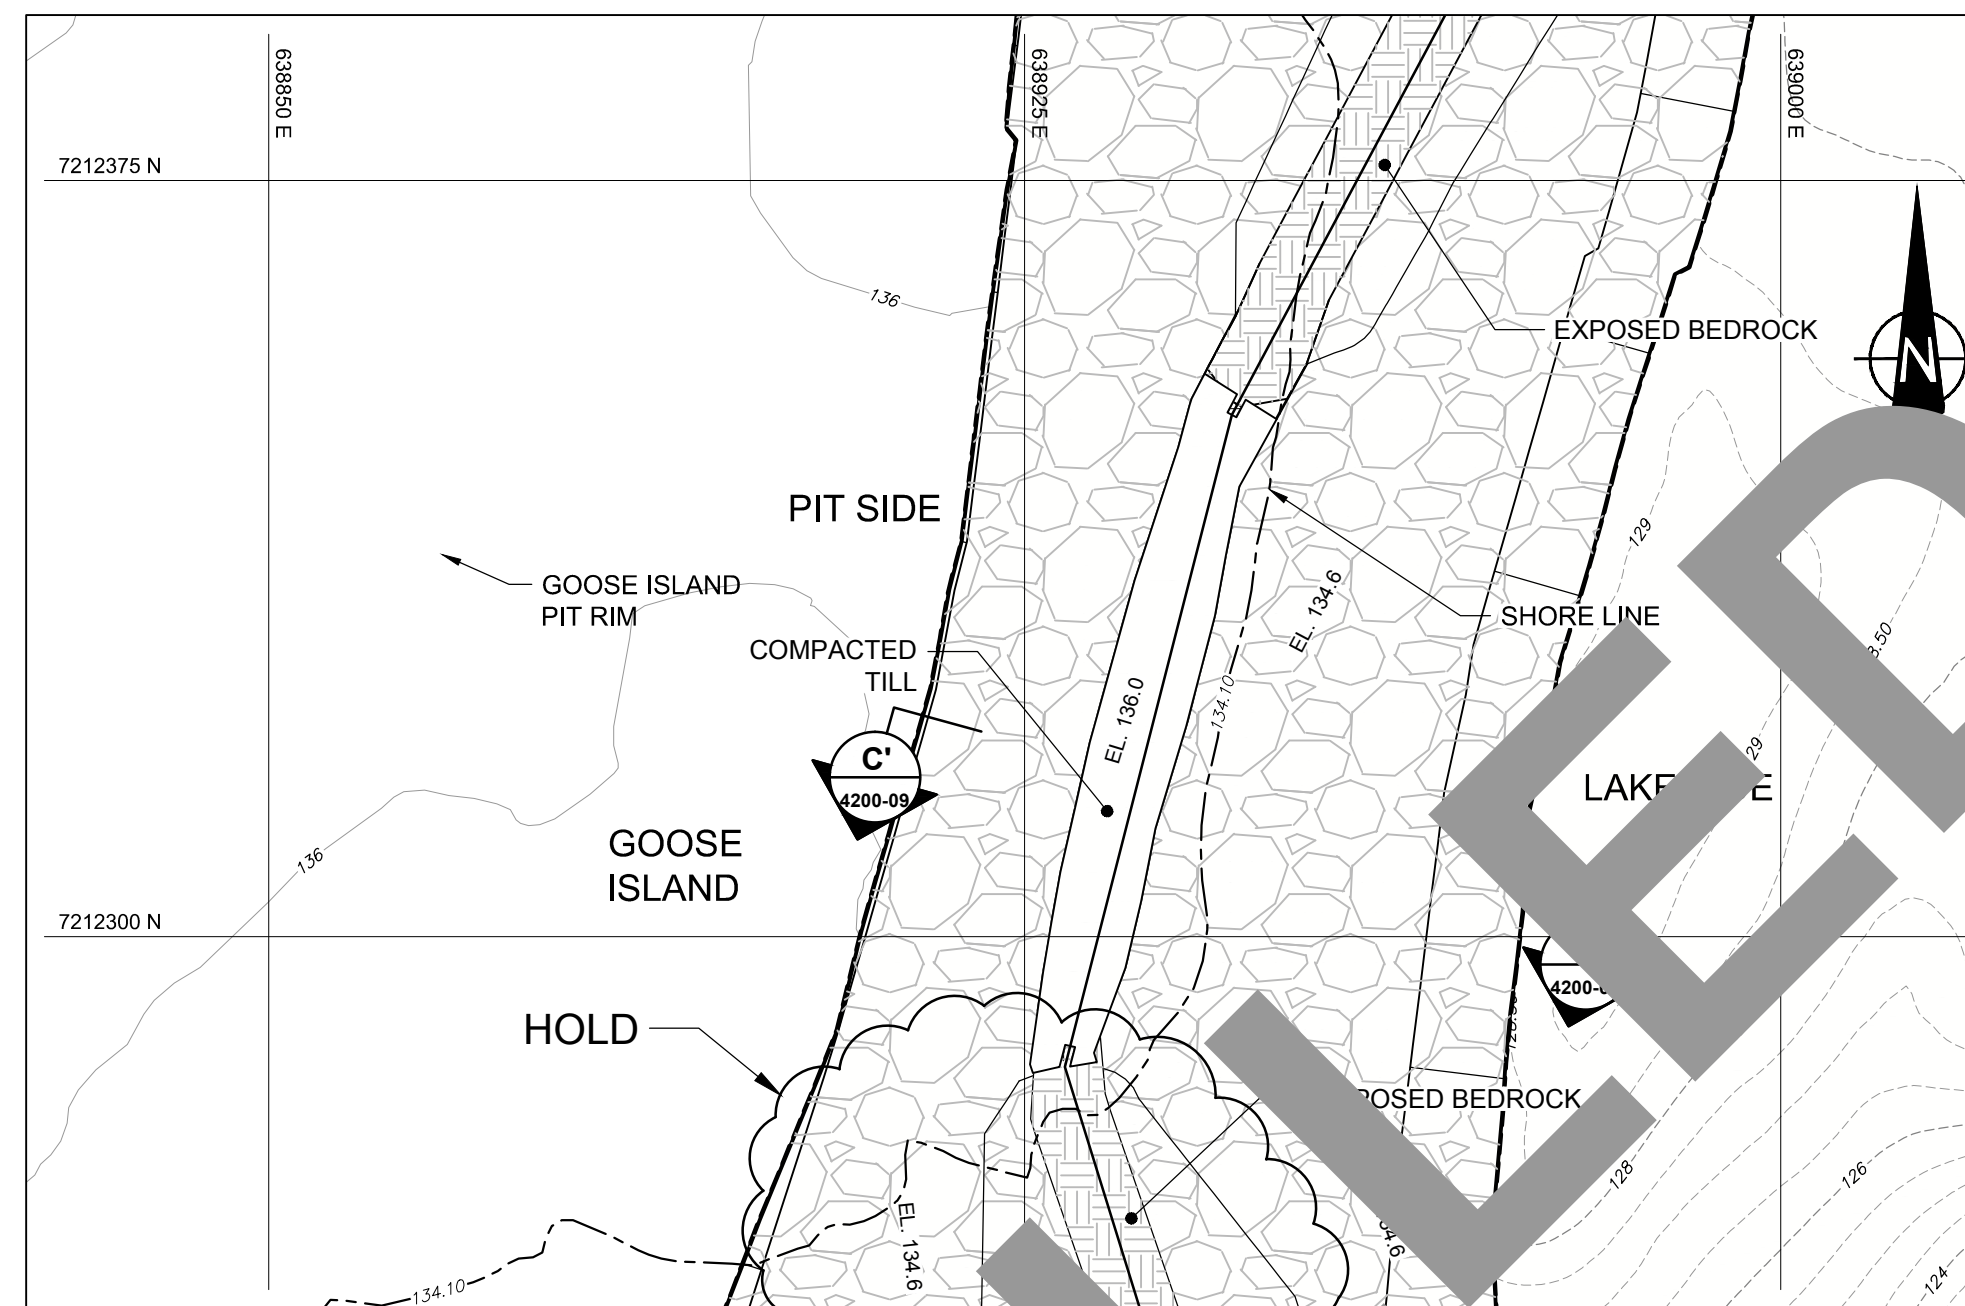


3 **COMPACTED TOP PLACEMENT PLAN**
SCALE: A

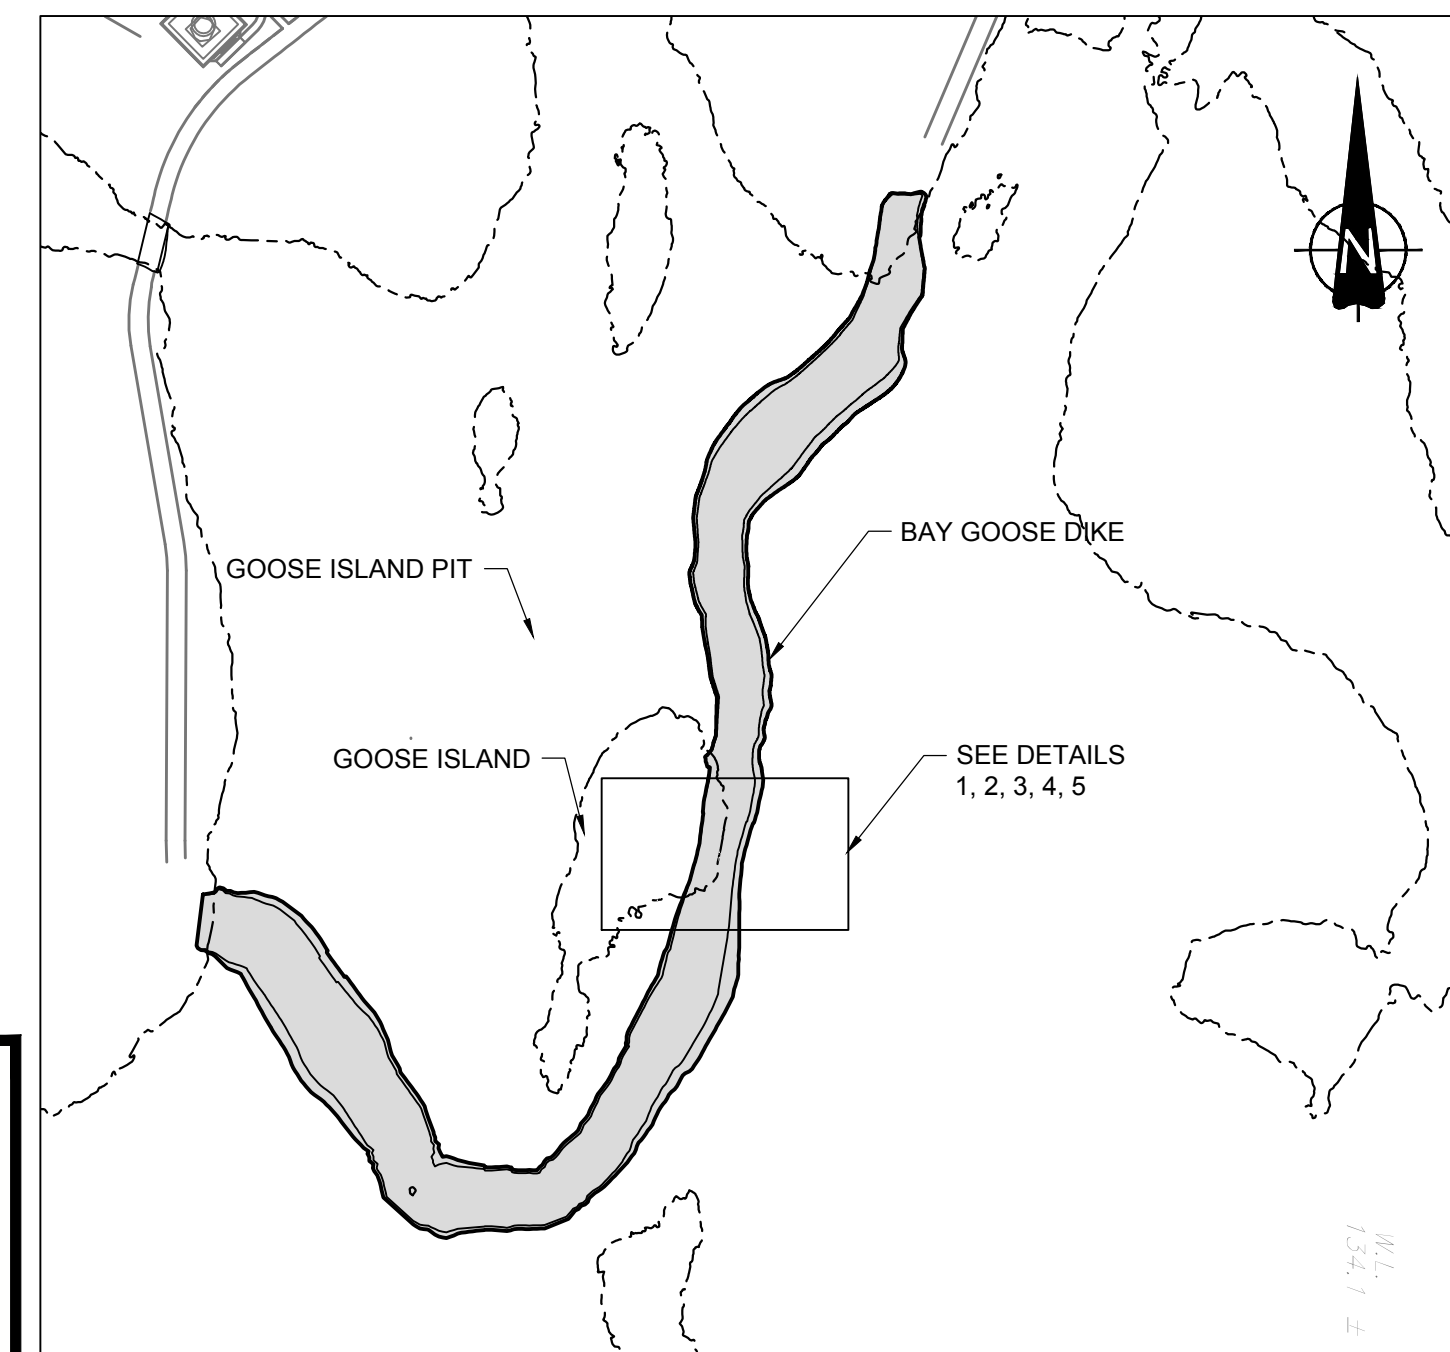


KEY PLAN
SCALE: B


THE ASSOCIATION OF
PROFESSIONAL ENGINEERS,
GEOLOGISTS and GEOPHYSICISTS
OF THE NORTHWEST TERRITORIES
PERMIT NUMBER
P 049
GOLDER
ASSOCIATES LTD.

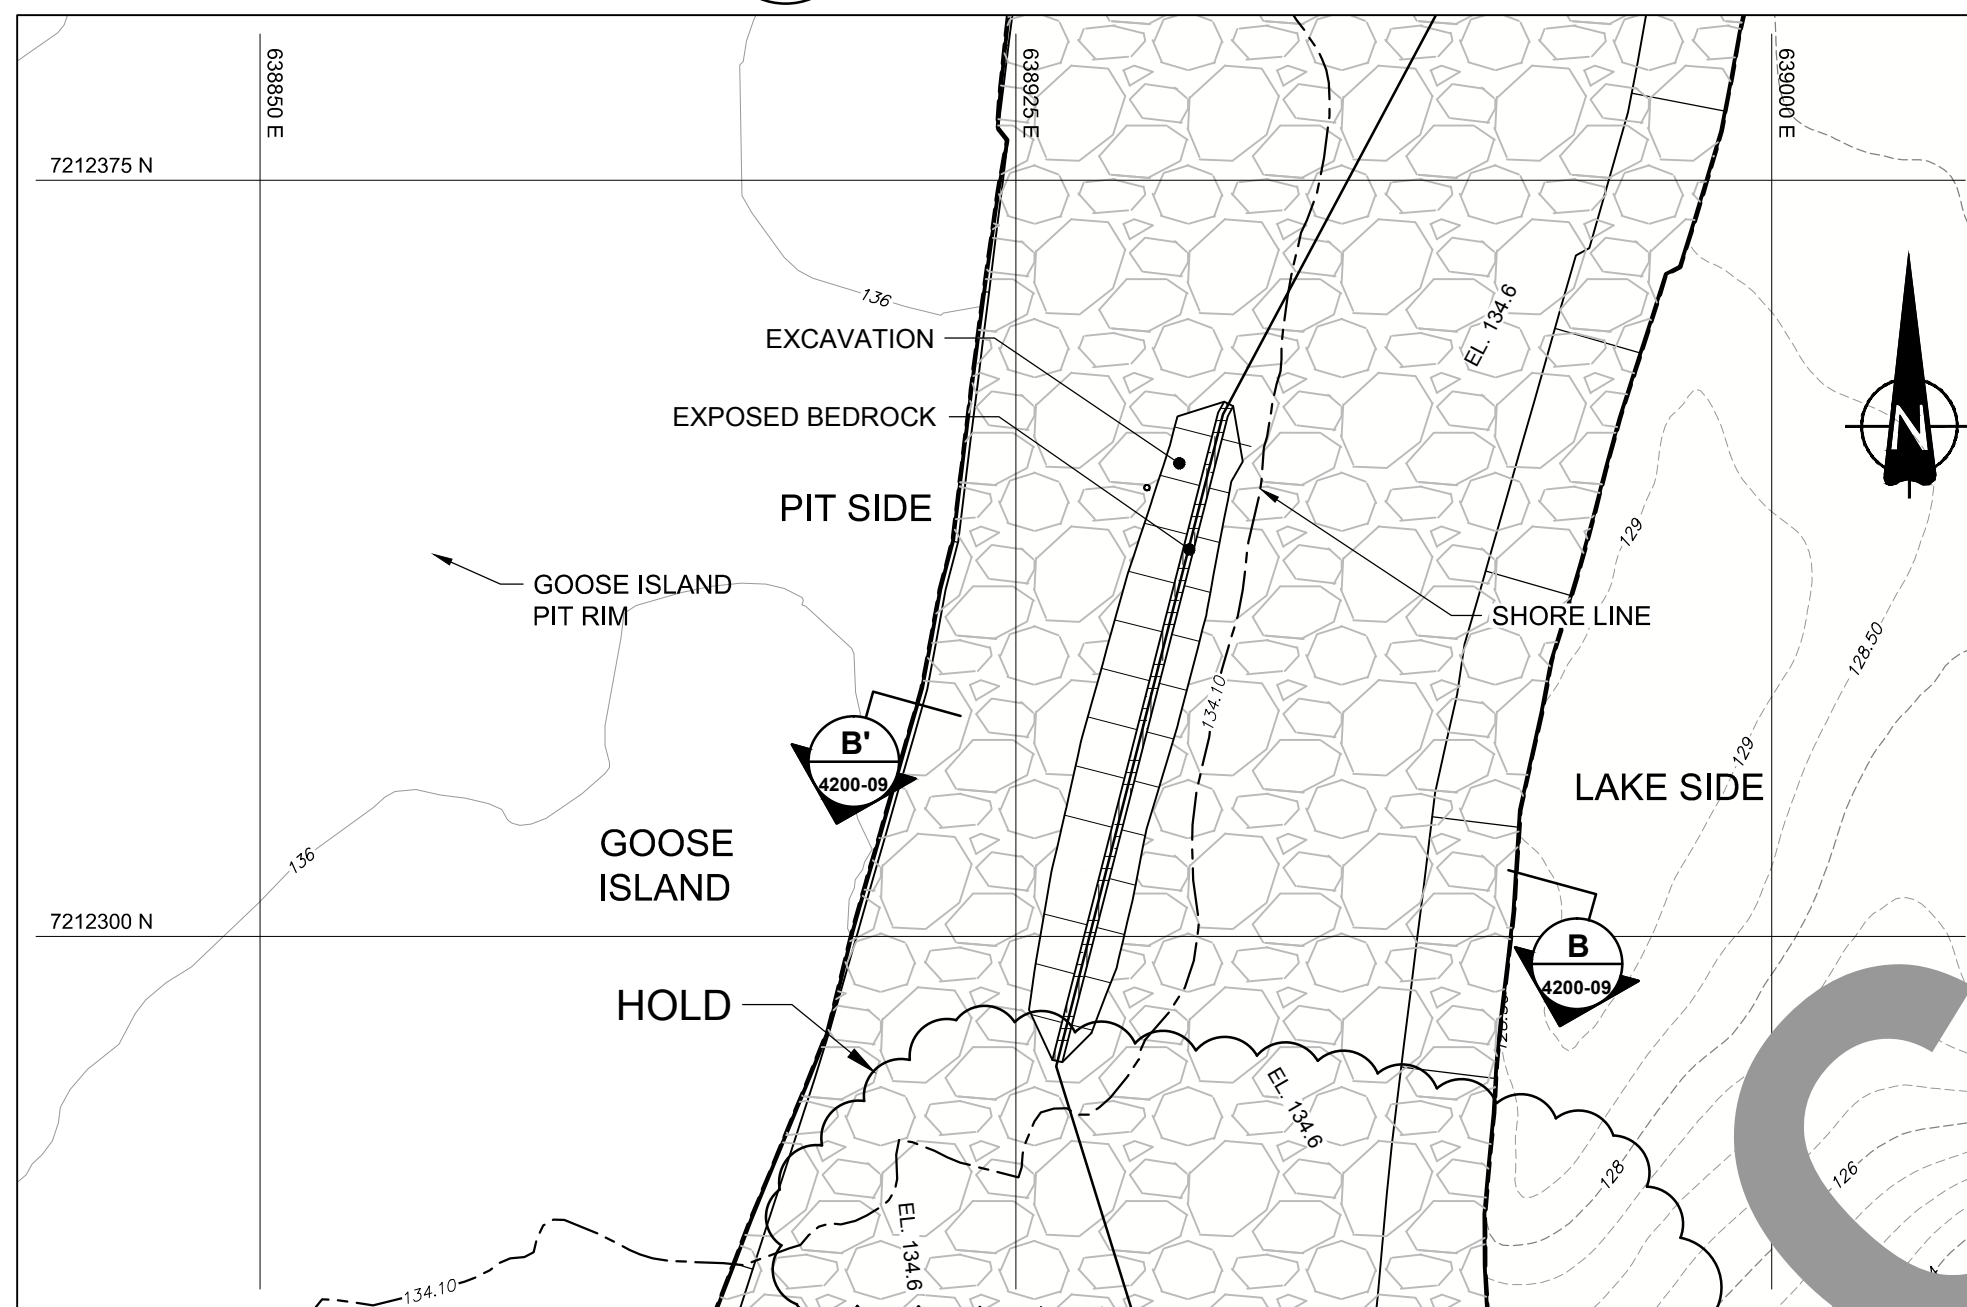

2 ROCKFILL PLACEMENT PLAN

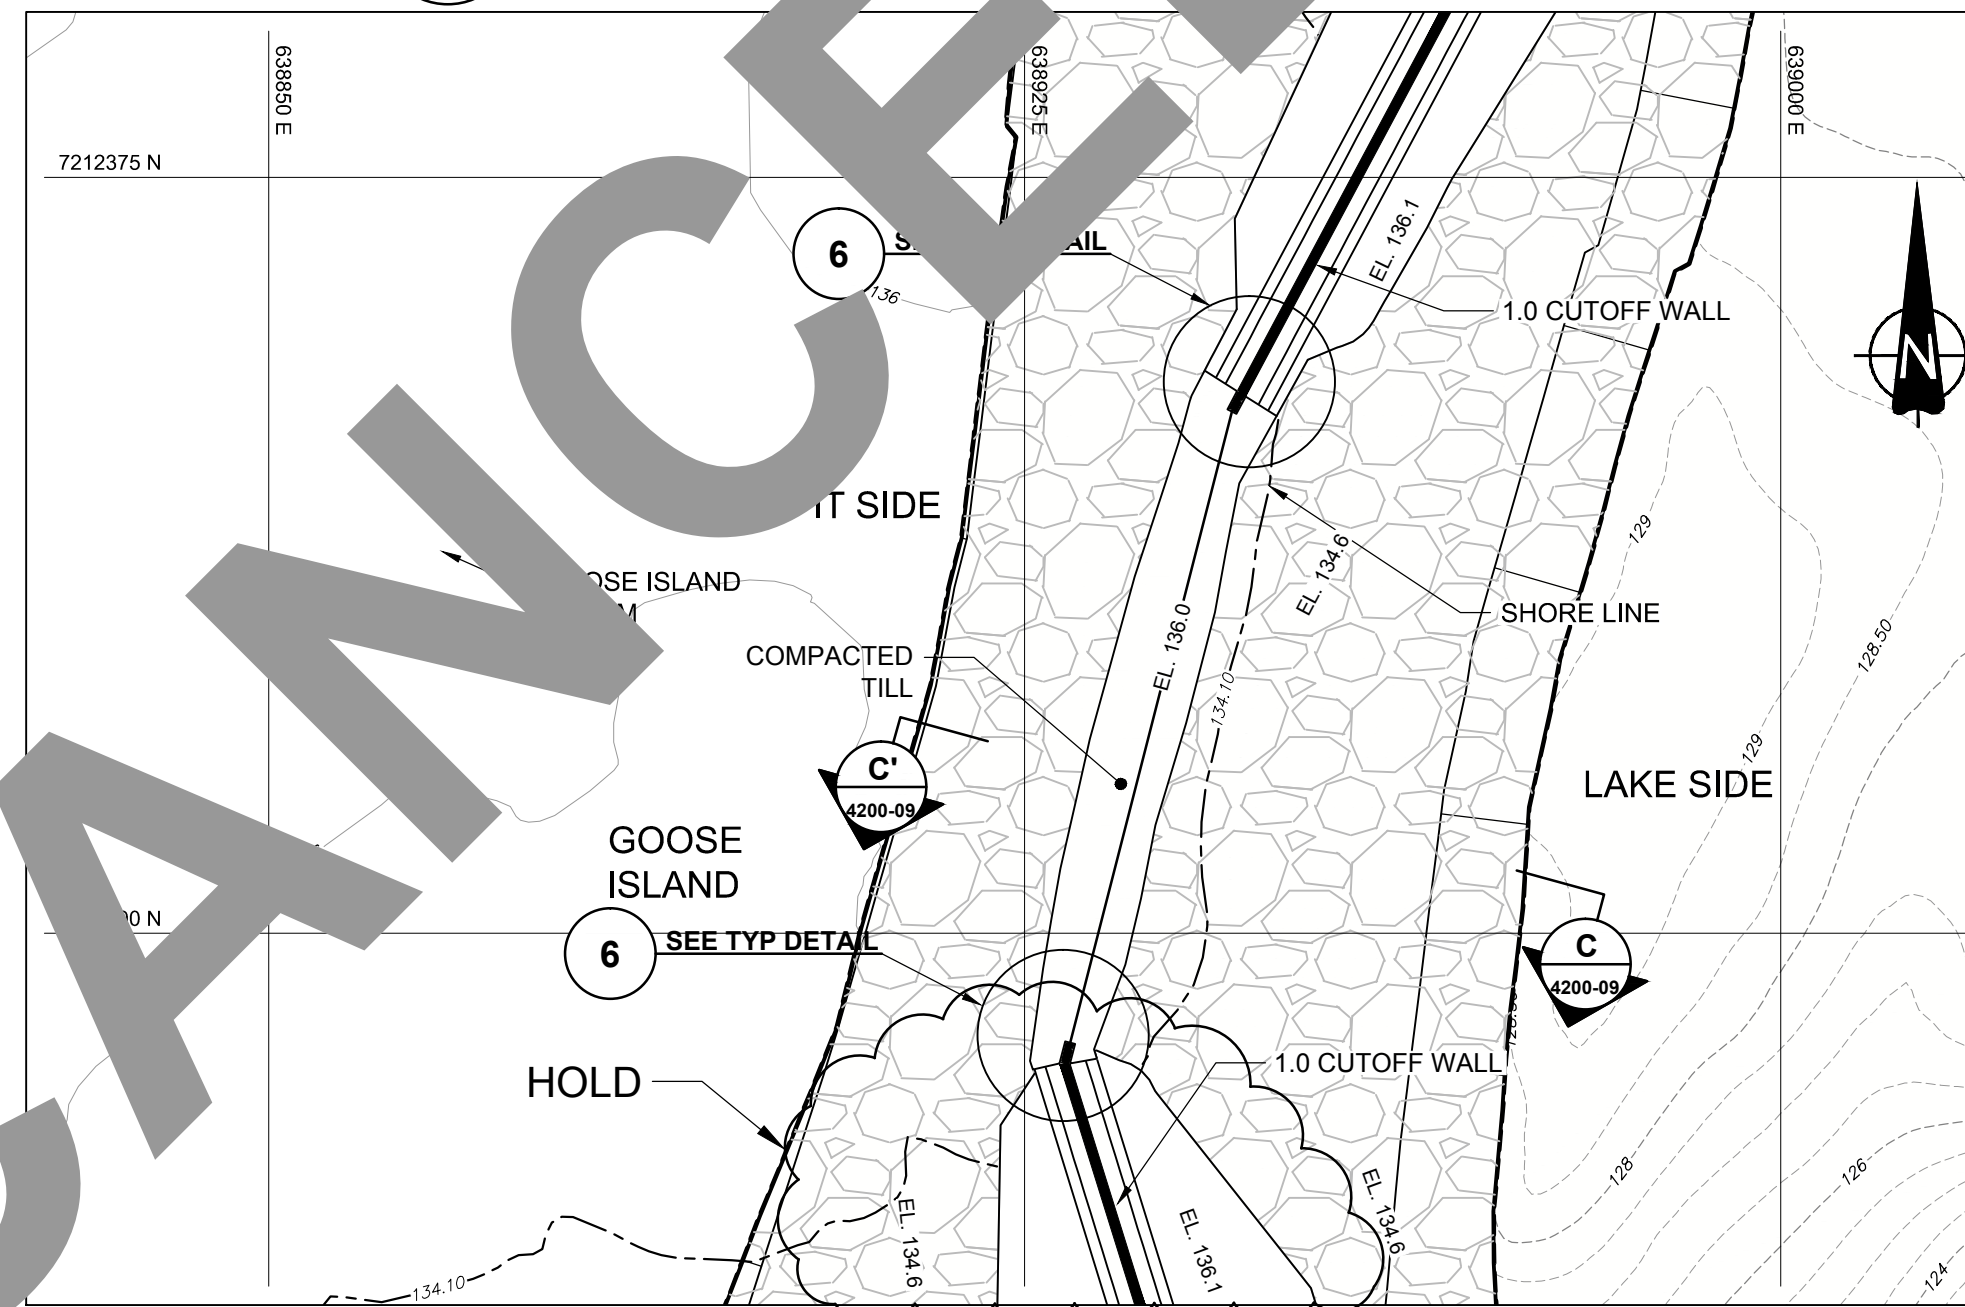

4 CUTOFF WALL TIE-IN TO TILL PLAN

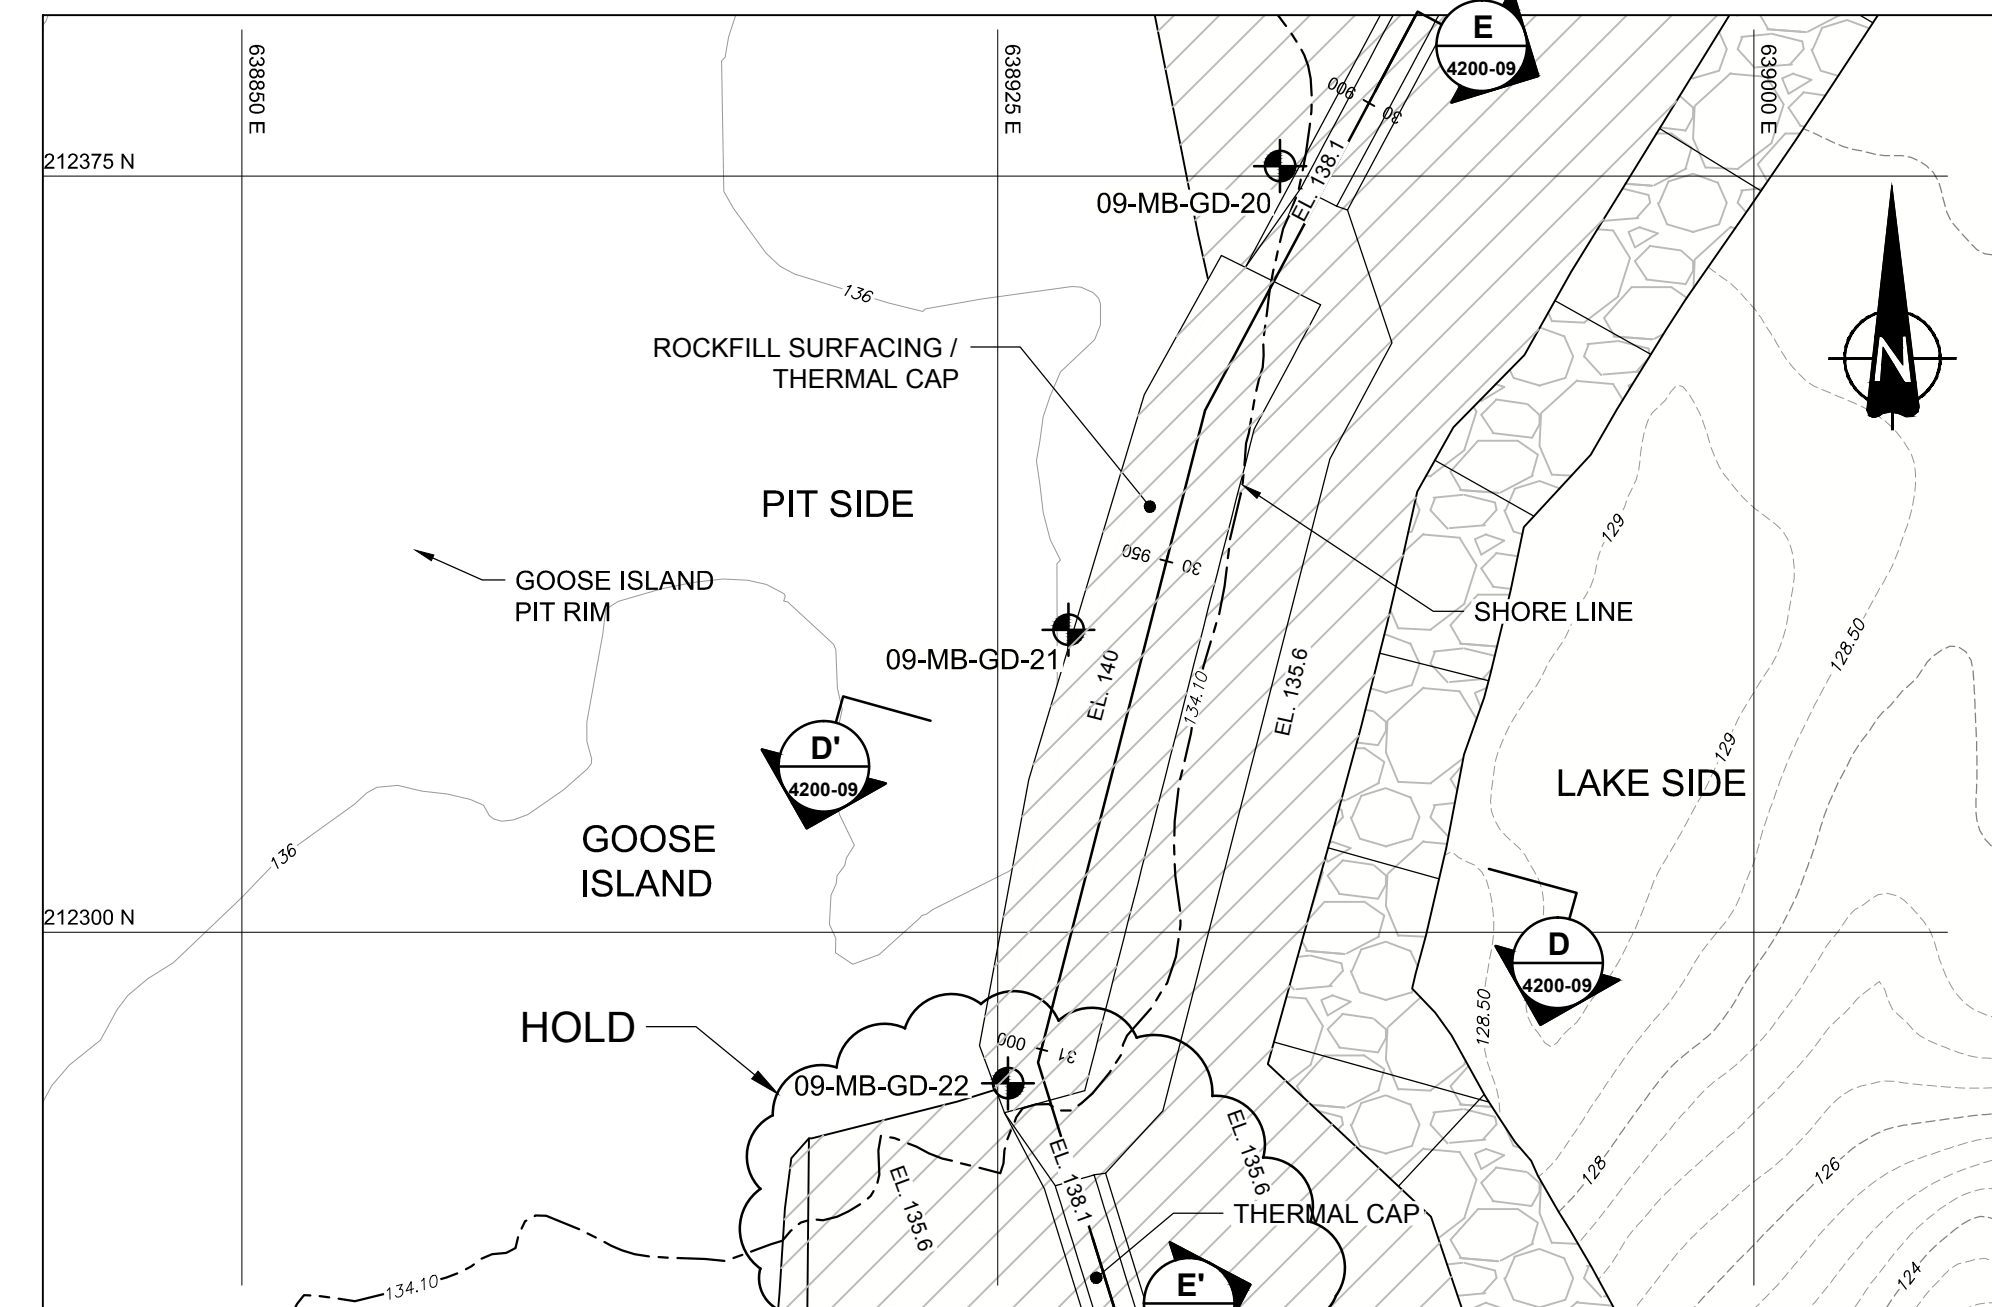



5 ROCKFILL SURFACING PLACEMENT PLAN

NOTES

- 1) ALL DIMENSIONS ARE IN METERS UNLESS OTHERWISE NOTED.
- 2) ALL ELEVATIONS ARE IN METERS ABOVE SEA LEVEL (MASL), UNLESS OTHERWISE NOTED.
- 3) GRID REFERENCE: NAD 83, UTM ZONE 14.
- 4) GOOSE ISLAND ABUTMENT MAY BE CONSTRUCTED AS SHOWN ON 4200-08 AND 4200-09 USING COMPACTED TILL OR AS SHOWN ON 4200-13.
- 5) LAKEBED SURFACE BASED ON BATHYMETRIC SURVEY BY GOLDER ASSOCIATES LTD. 2008. DEPTH TO LAKEBED AND BEDROCK BENEATH CUTOFF WALL CENTRAL LINE INFERRED BASED ON GEOTECHNICAL INVESTIGATIONS. BEDROCK SURFACE INFORMATION TO BE UPDATED FOR THE SOUTHERN PORTION OF THE DIKE (STATION 31+000 TO STATION 32+213.69) FOLLOWING COMPLETION OF THE 2009/2010 INVESTIGATION PROGRAM (BY ENGINEER).
- 6) NPAG ROCKFILL SURFACING AND THERMAL CAP TO BE PLACED BY AEM. SURFACING ON DOWNSTREAM SLOPE TO BE PLACED FOLLOWING DEWATERING.
- 7) USE OF COARSE FILTER AGAINST PIT SIDE FACE OF EXCAVATION IS REQUIRED, UNLESS APPROVED IN WRITING BY THE ENGINEER.
- 8) ADDITIONAL ROCKFILL MAY BE REQUIRED TO MAINTAIN HAUL ROAD MINIMUM WIDTH.
- 9) GEOCHEMICAL CLASSIFICATION OF NPAG MATERIALS WAS THE RESPONSIBILITY OF AEM.
- 10) CUTOFF WALL FOUNDED ON COMPETENT BEDROCK SURFACE APPROVED BY ENGINEER. ALL ICE RICH MATERIAL (SOIL AND ROCK) TO BE EXCAVATED. THE EXTENT OF PERMAFROST AT ABUTMENTS TO BE CONFIRMED WITH THERMISTORS.
- 11) TRANSITION BETWEEN CUTOFF WALL AND COMPACTED TILL IS CRITICAL. TILL SHALL BE PLACED PRIOR TO CUTOFF WALL CONSTRUCTION. TILL SHALL NOT BE PERMITTED TO FREEZE PRIOR TO CUTOFF WALL CONSTRUCTION.
- 12) SAFETY BERMS NOT SHOWN FOR CLARITY.

LEGEND

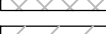- | | | | |
|---|--|---|----------------|
|  | BEDROCK |  | COARSE FILTER |
|  | CORE BACKFILL | | |
|  | NPAG ROCKFILL SURFACING
AND THERMAL CAP | | |
|  | ROCKFILL | | |
|  | CUTOFF WALL | 09-MB-GD-22 | |
|  | COMPACTED TILL |  | 2009 BOREHOLE |
| | |  | DIKE FOOTPRINT |

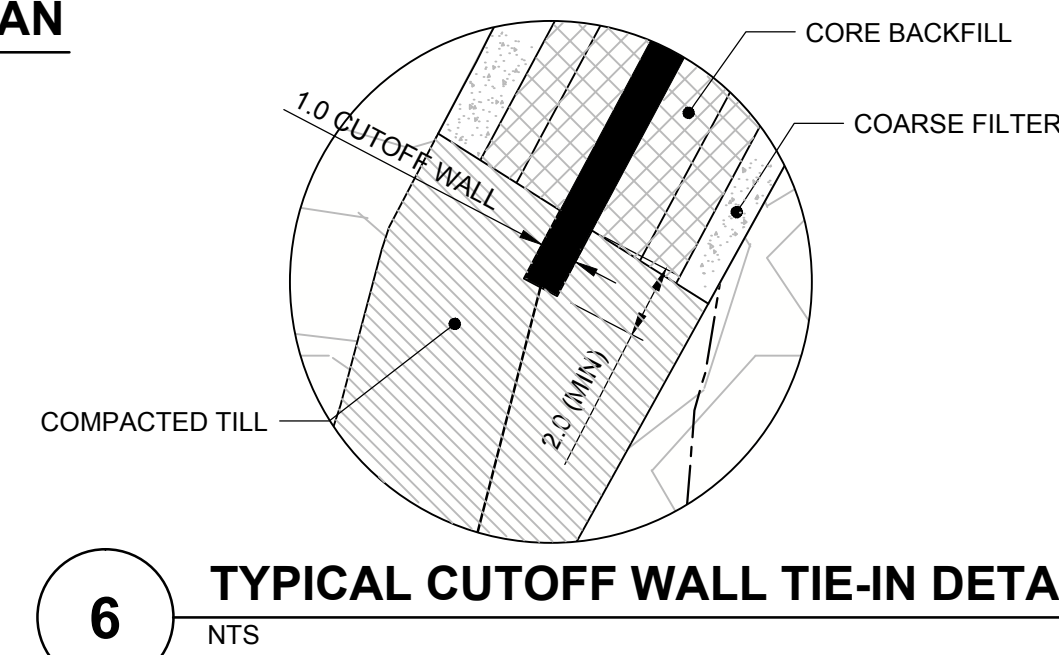


6 TYPICAL CUTOFF WALL TIE-IN DETAIL

REFERENCE


- 1) PORTAGE PIT DESIGN BY AEM, MARCH, 2009.
- 2) GOOSE ISLAND PIT DESIGN BY AEM, MAY, 2010.
- 3) ROAD AND MINE FACILITIES PROVIDED BY AEM, JANUARY, 2009.

[illegible]


PROJECT	AEM	AGNICO-EAGLE MINES LIMITED MEADOWBANK GOLD PROJECT NUNAVUT																					
TITLE	BAY-GOOSE DIKE GOOSE ISLAND ABUTMENT DETAILS - TILL OPTION																						
 Golder Associates	<table border="1" style="width: 100%; border-collapse: collapse;"> <tr> <td style="width: 15%;">PROJECT No.</td> <td colspan="2">08-1428-0028/4200</td> </tr> <tr> <td>DESIGN</td> <td>JU</td> <td>04JUL08</td> </tr> <tr> <td>CADD</td> <td>SWD</td> <td>03DEC08</td> </tr> <tr> <td>CHECK</td> <td></td> <td></td> </tr> <tr> <td>REVIEW</td> <td></td> <td></td> </tr> </table>	PROJECT No.	08-1428-0028/4200		DESIGN	JU	04JUL08	CADD	SWD	03DEC08	CHECK			REVIEW			<table border="1" style="width: 100%; border-collapse: collapse;"> <tr> <td style="width: 15%;">FILE No.</td> <td colspan="2">0814280028-4200_0_0</td> </tr> <tr> <td>SCALE</td> <td>AS SHOWN</td> <td>REV.</td> </tr> </table> 4200-08	FILE No.	0814280028-4200_0_0		SCALE	AS SHOWN	REV.
PROJECT No.	08-1428-0028/4200																						
DESIGN	JU	04JUL08																					
CADD	SWD	03DEC08																					
CHECK																							
REVIEW																							
FILE No.	0814280028-4200_0_0																						
SCALE	AS SHOWN	REV.																					

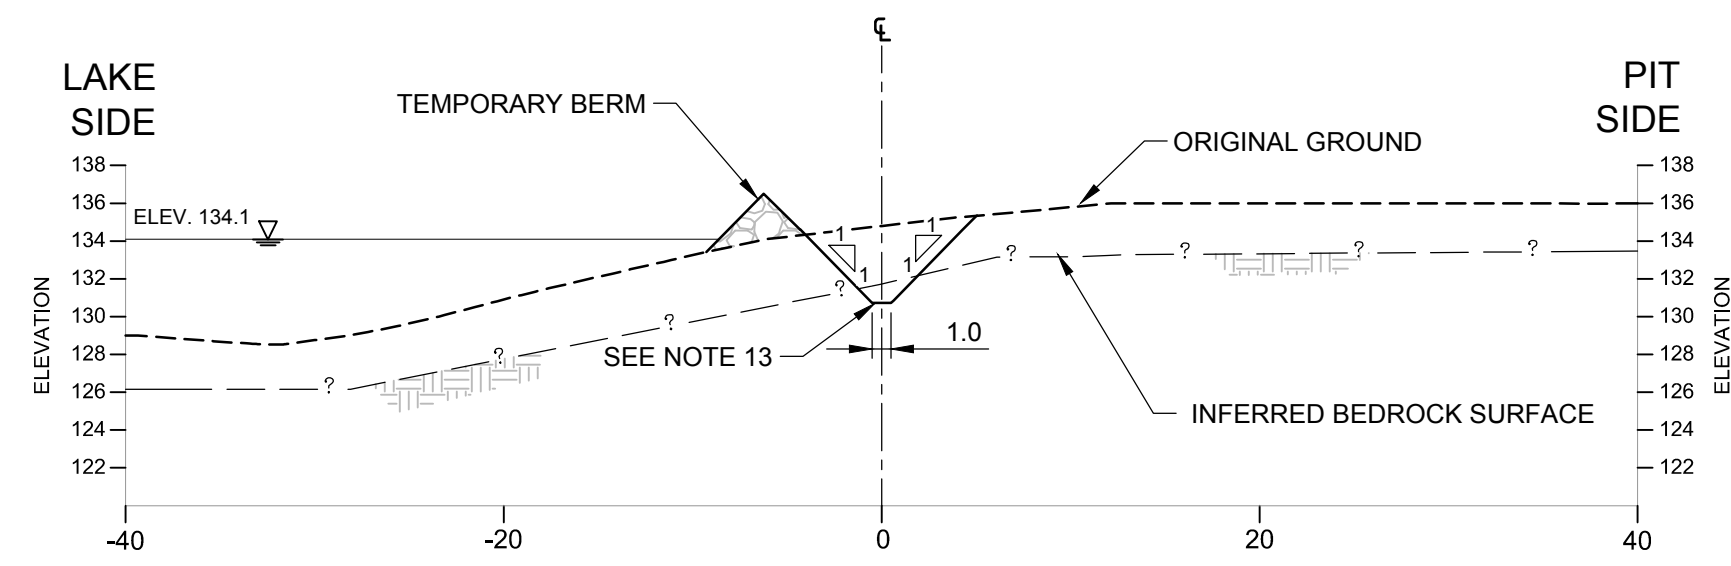


EXCAVATION SECTION

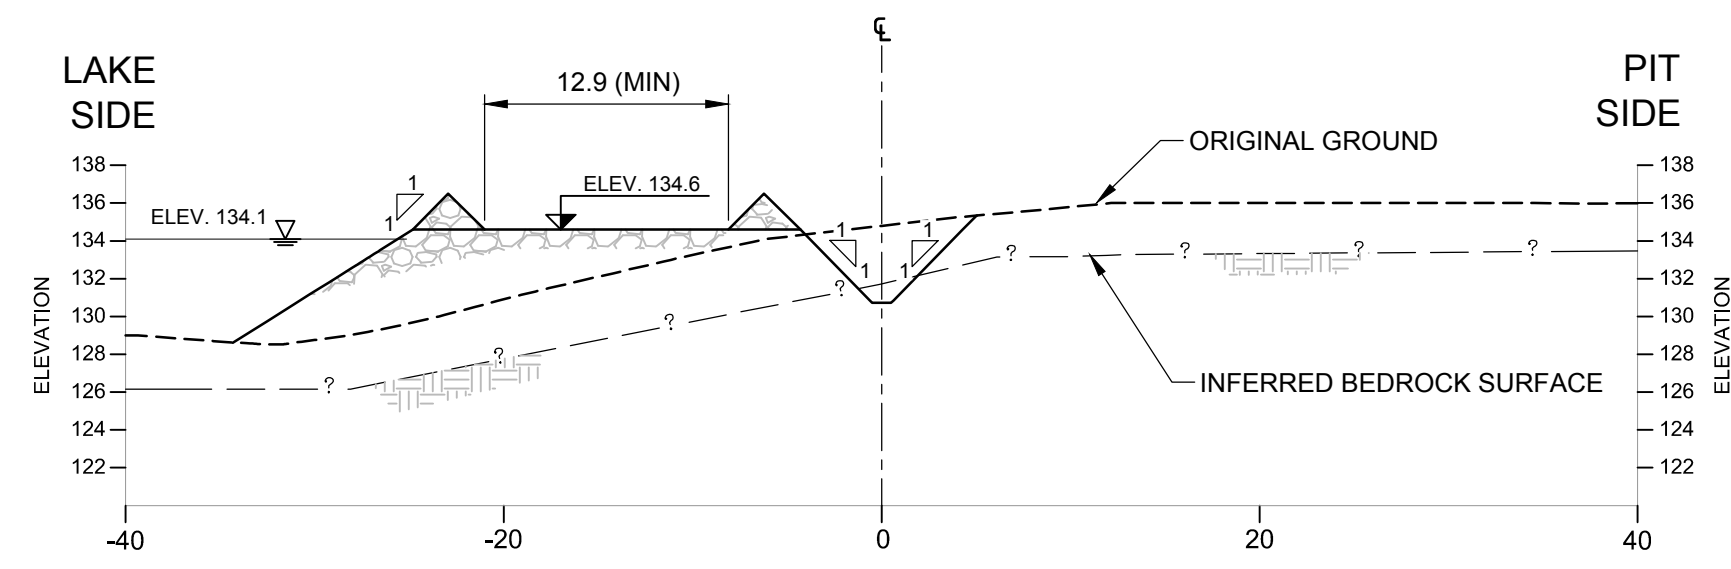


B **ROCKFILL PLACEMENT SECTION** (SCALE B)

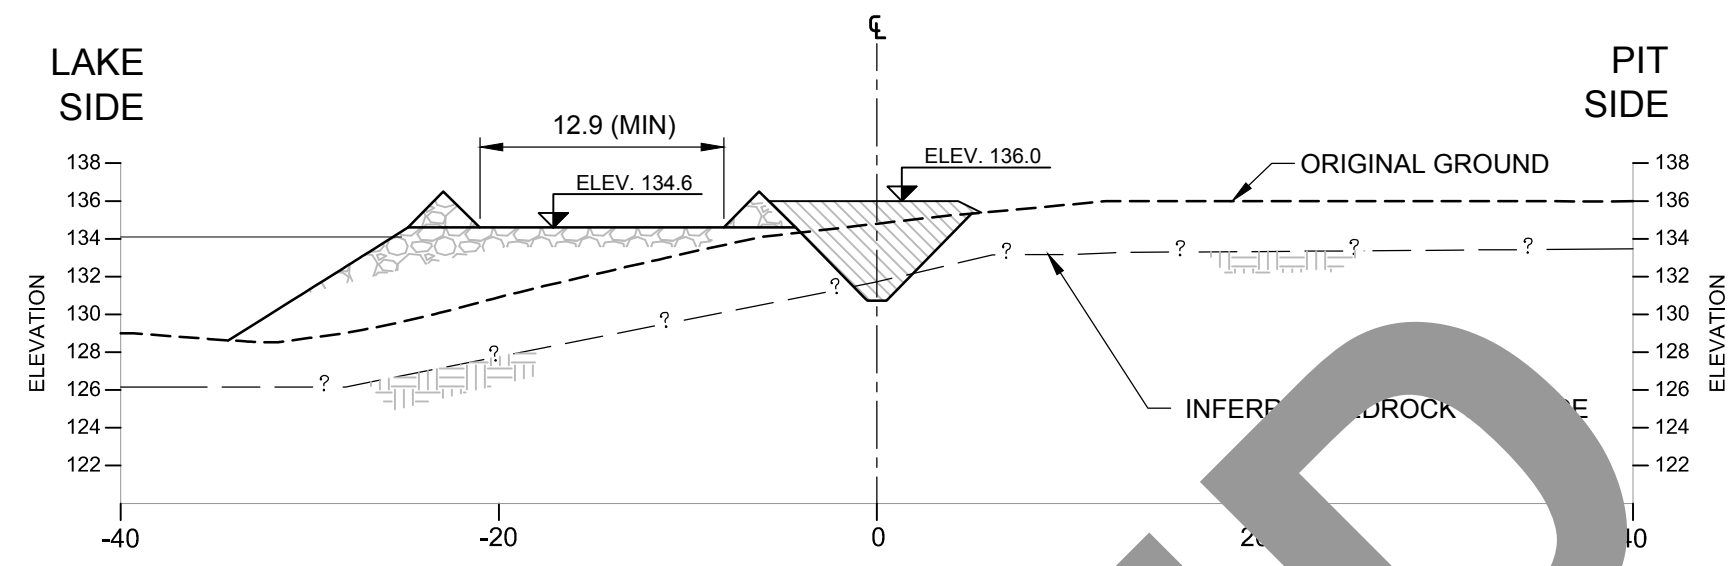


C **COMPACTED TILL PLACEMENT SECTION**
4200-13 (SCALE B)

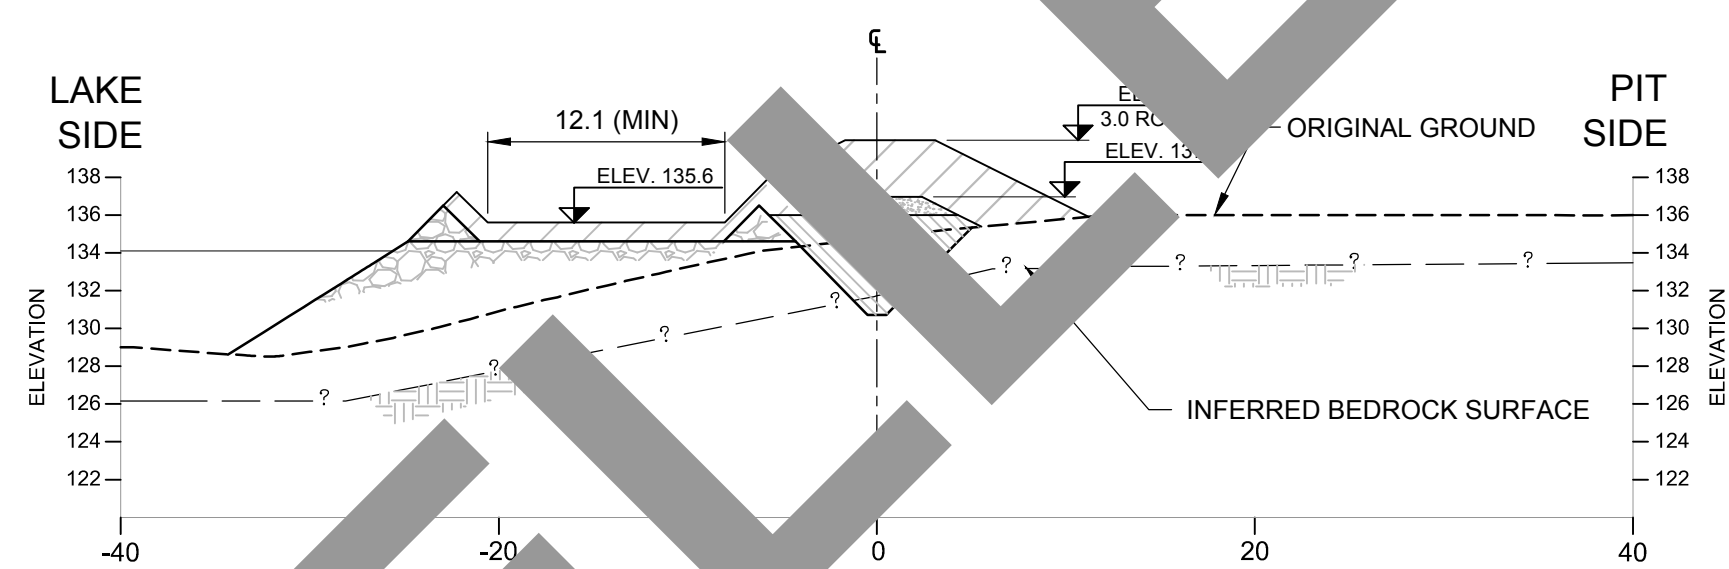

PAVEMENT SURFACING PLACEMENT SECTION

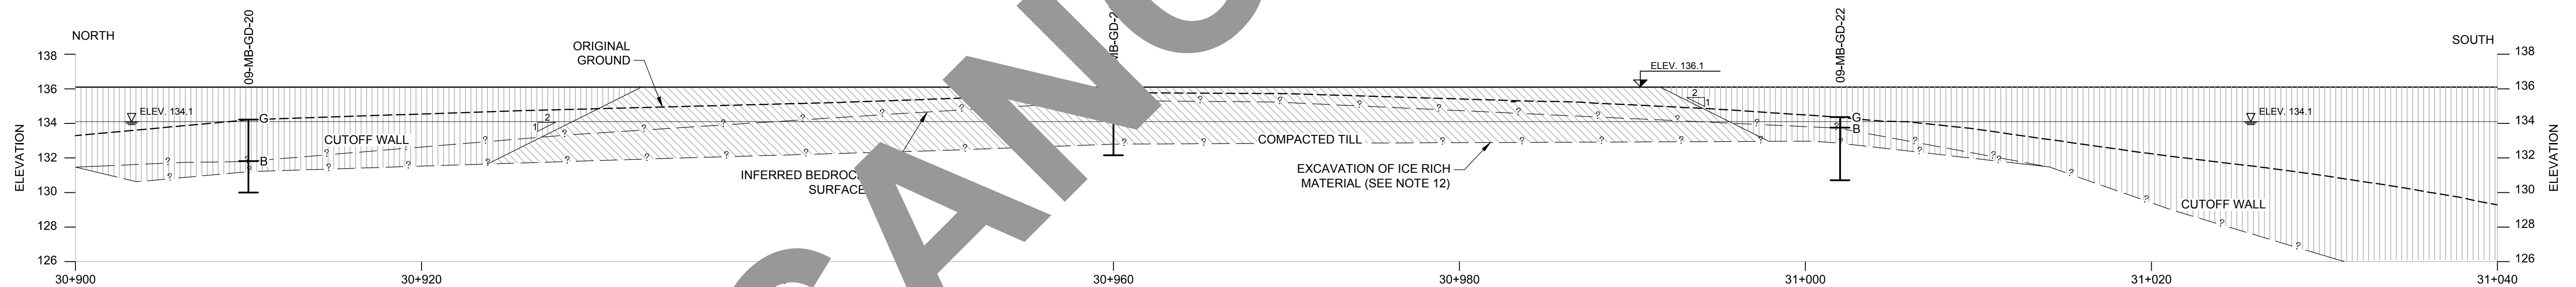

ISLAND ABUTMENT PROFILE



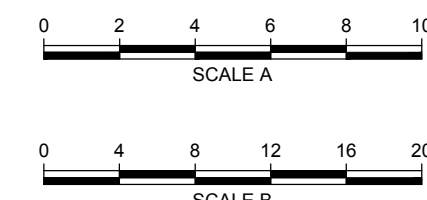


THE ASSOCIATION OF
PROFESSIONAL ENGINEERS,
GEOLOGISTS and GEOPHYSICISTS
OF THE NORTHWEST TERRITORIES
PERMIT NUMBER
P 049
GOLDER
ASSOCIATES LTD.

PROJECT		AEM AGNICO-EAGLE MINES LIMITED MEADOWBANK GOLD PROJECT NUNAVUT				
TITLE		BAY-GOOSE DIKE GOOSE ISLAND ABUTMENT SECTIONS - TILL OPTION				
Golder Associates		PROJECT No. 08-1418-0028/4200		FILE No. 0814280028-4200_0_09		
		DESIGN	JU	03DEC08	SCALE	AS SHOWN REV. 1
		CADD	SWD	03DEC08	4200-09	
		CHECK				
		REVIEW				

[illegible]

REVISION DATE: 4/8/2013 3:24:54 PMby: TYKLASSEN
CADD FILE: N:\Bur-Graphics\Projects\2009\1428\09-1428-5007\Drafting\4000\Meadowbank - Bay-Goose (NORTH) Dike 4s-Built\0814280028-4200_0_09.dwg

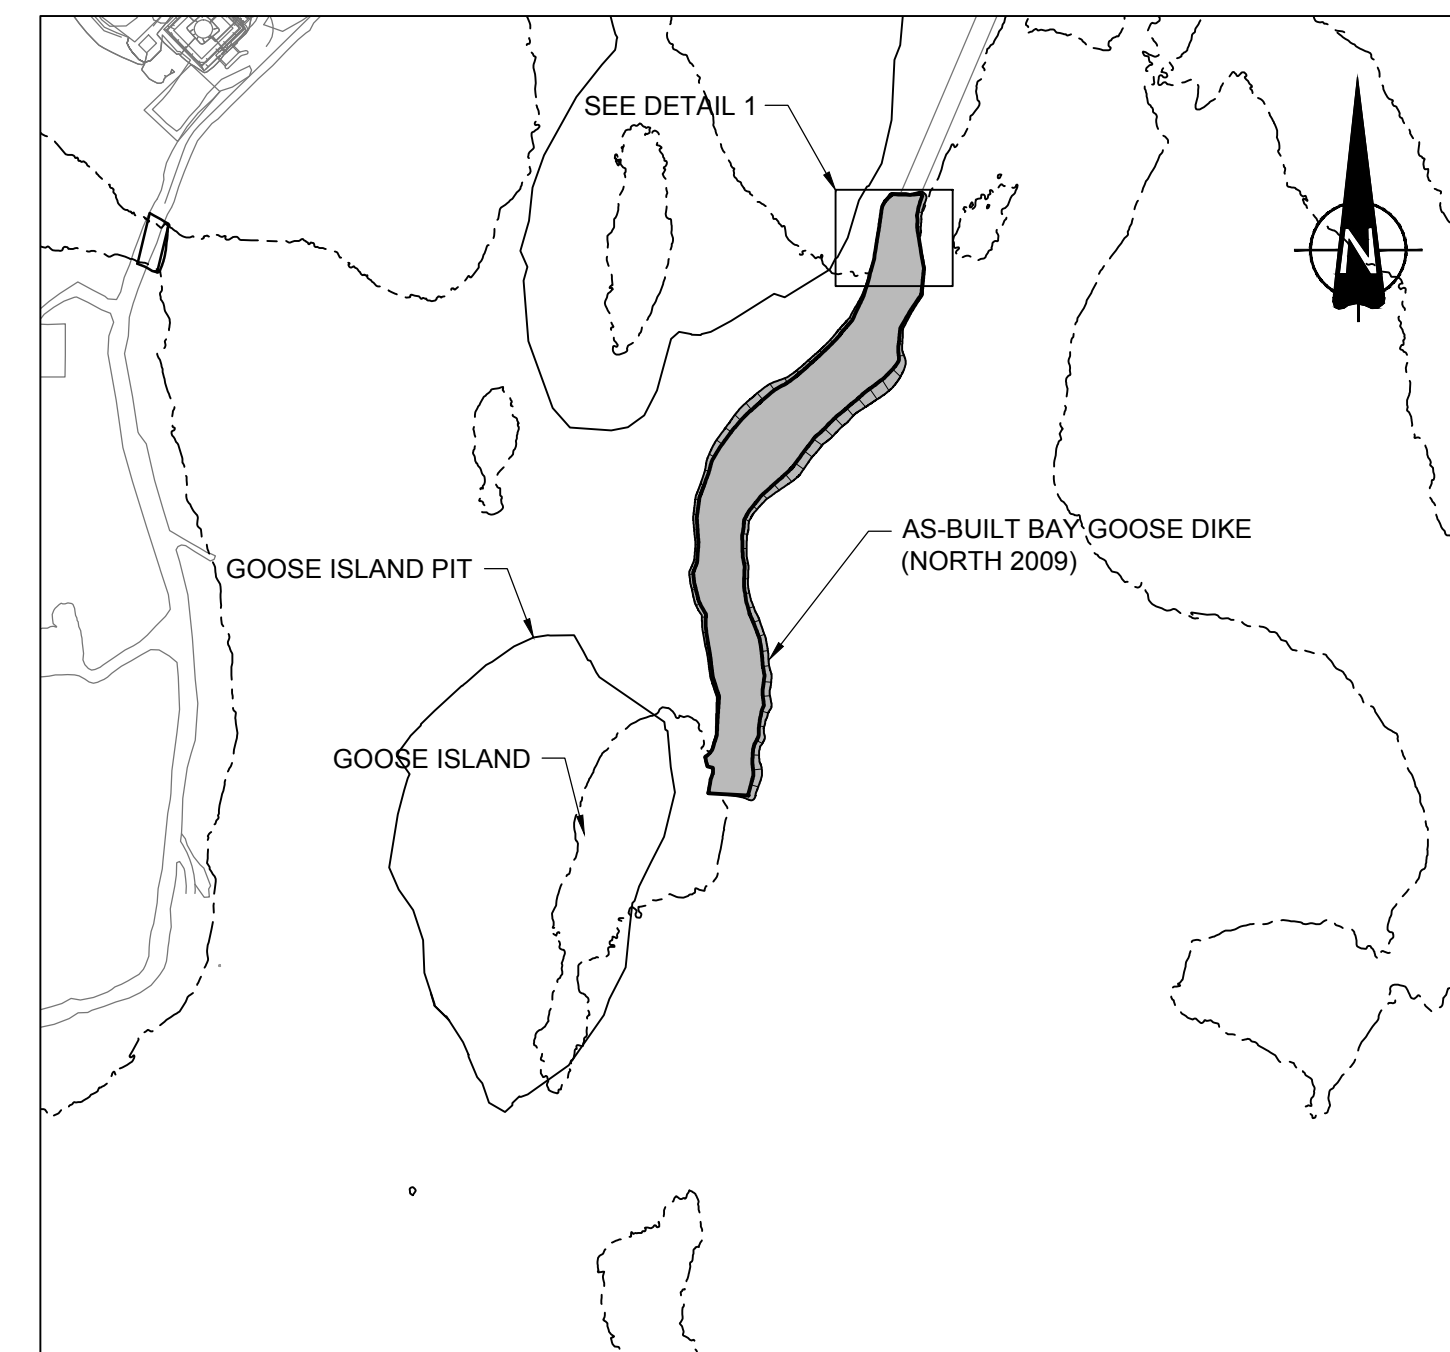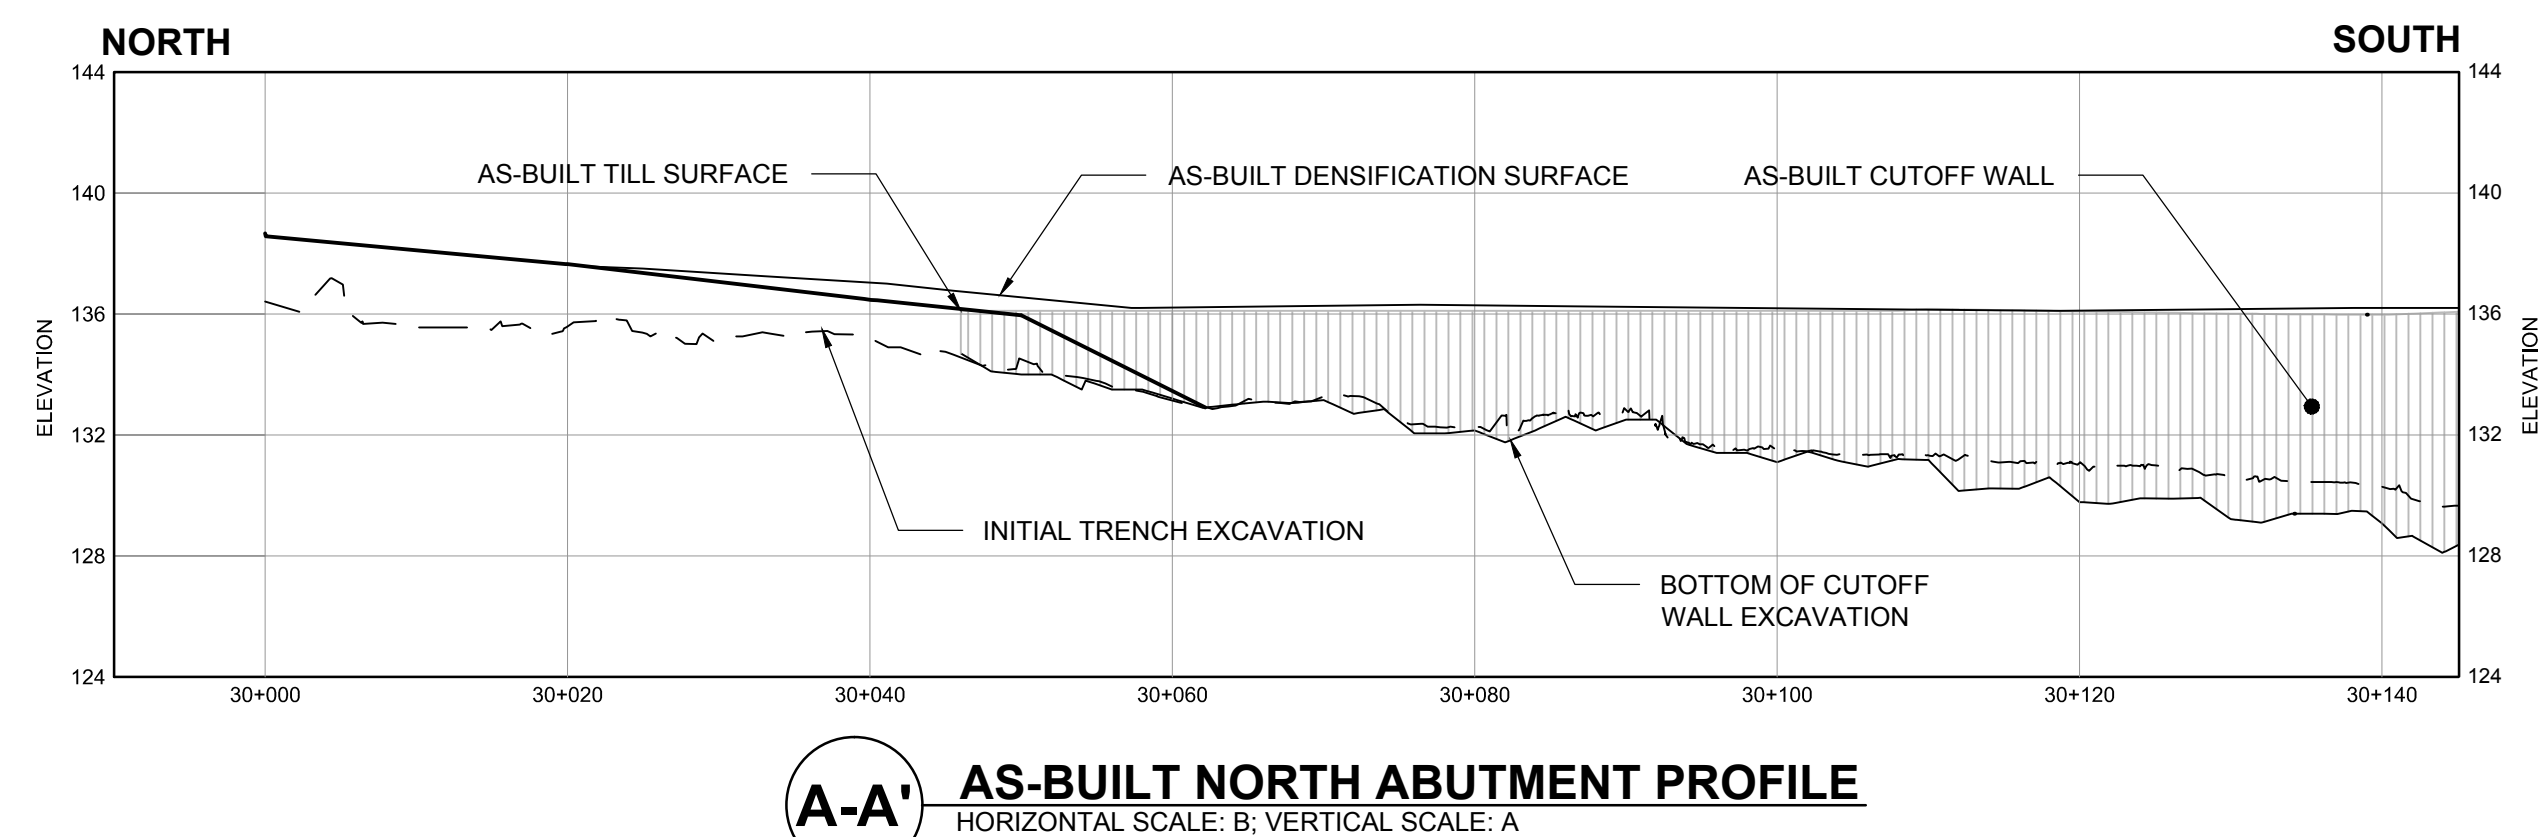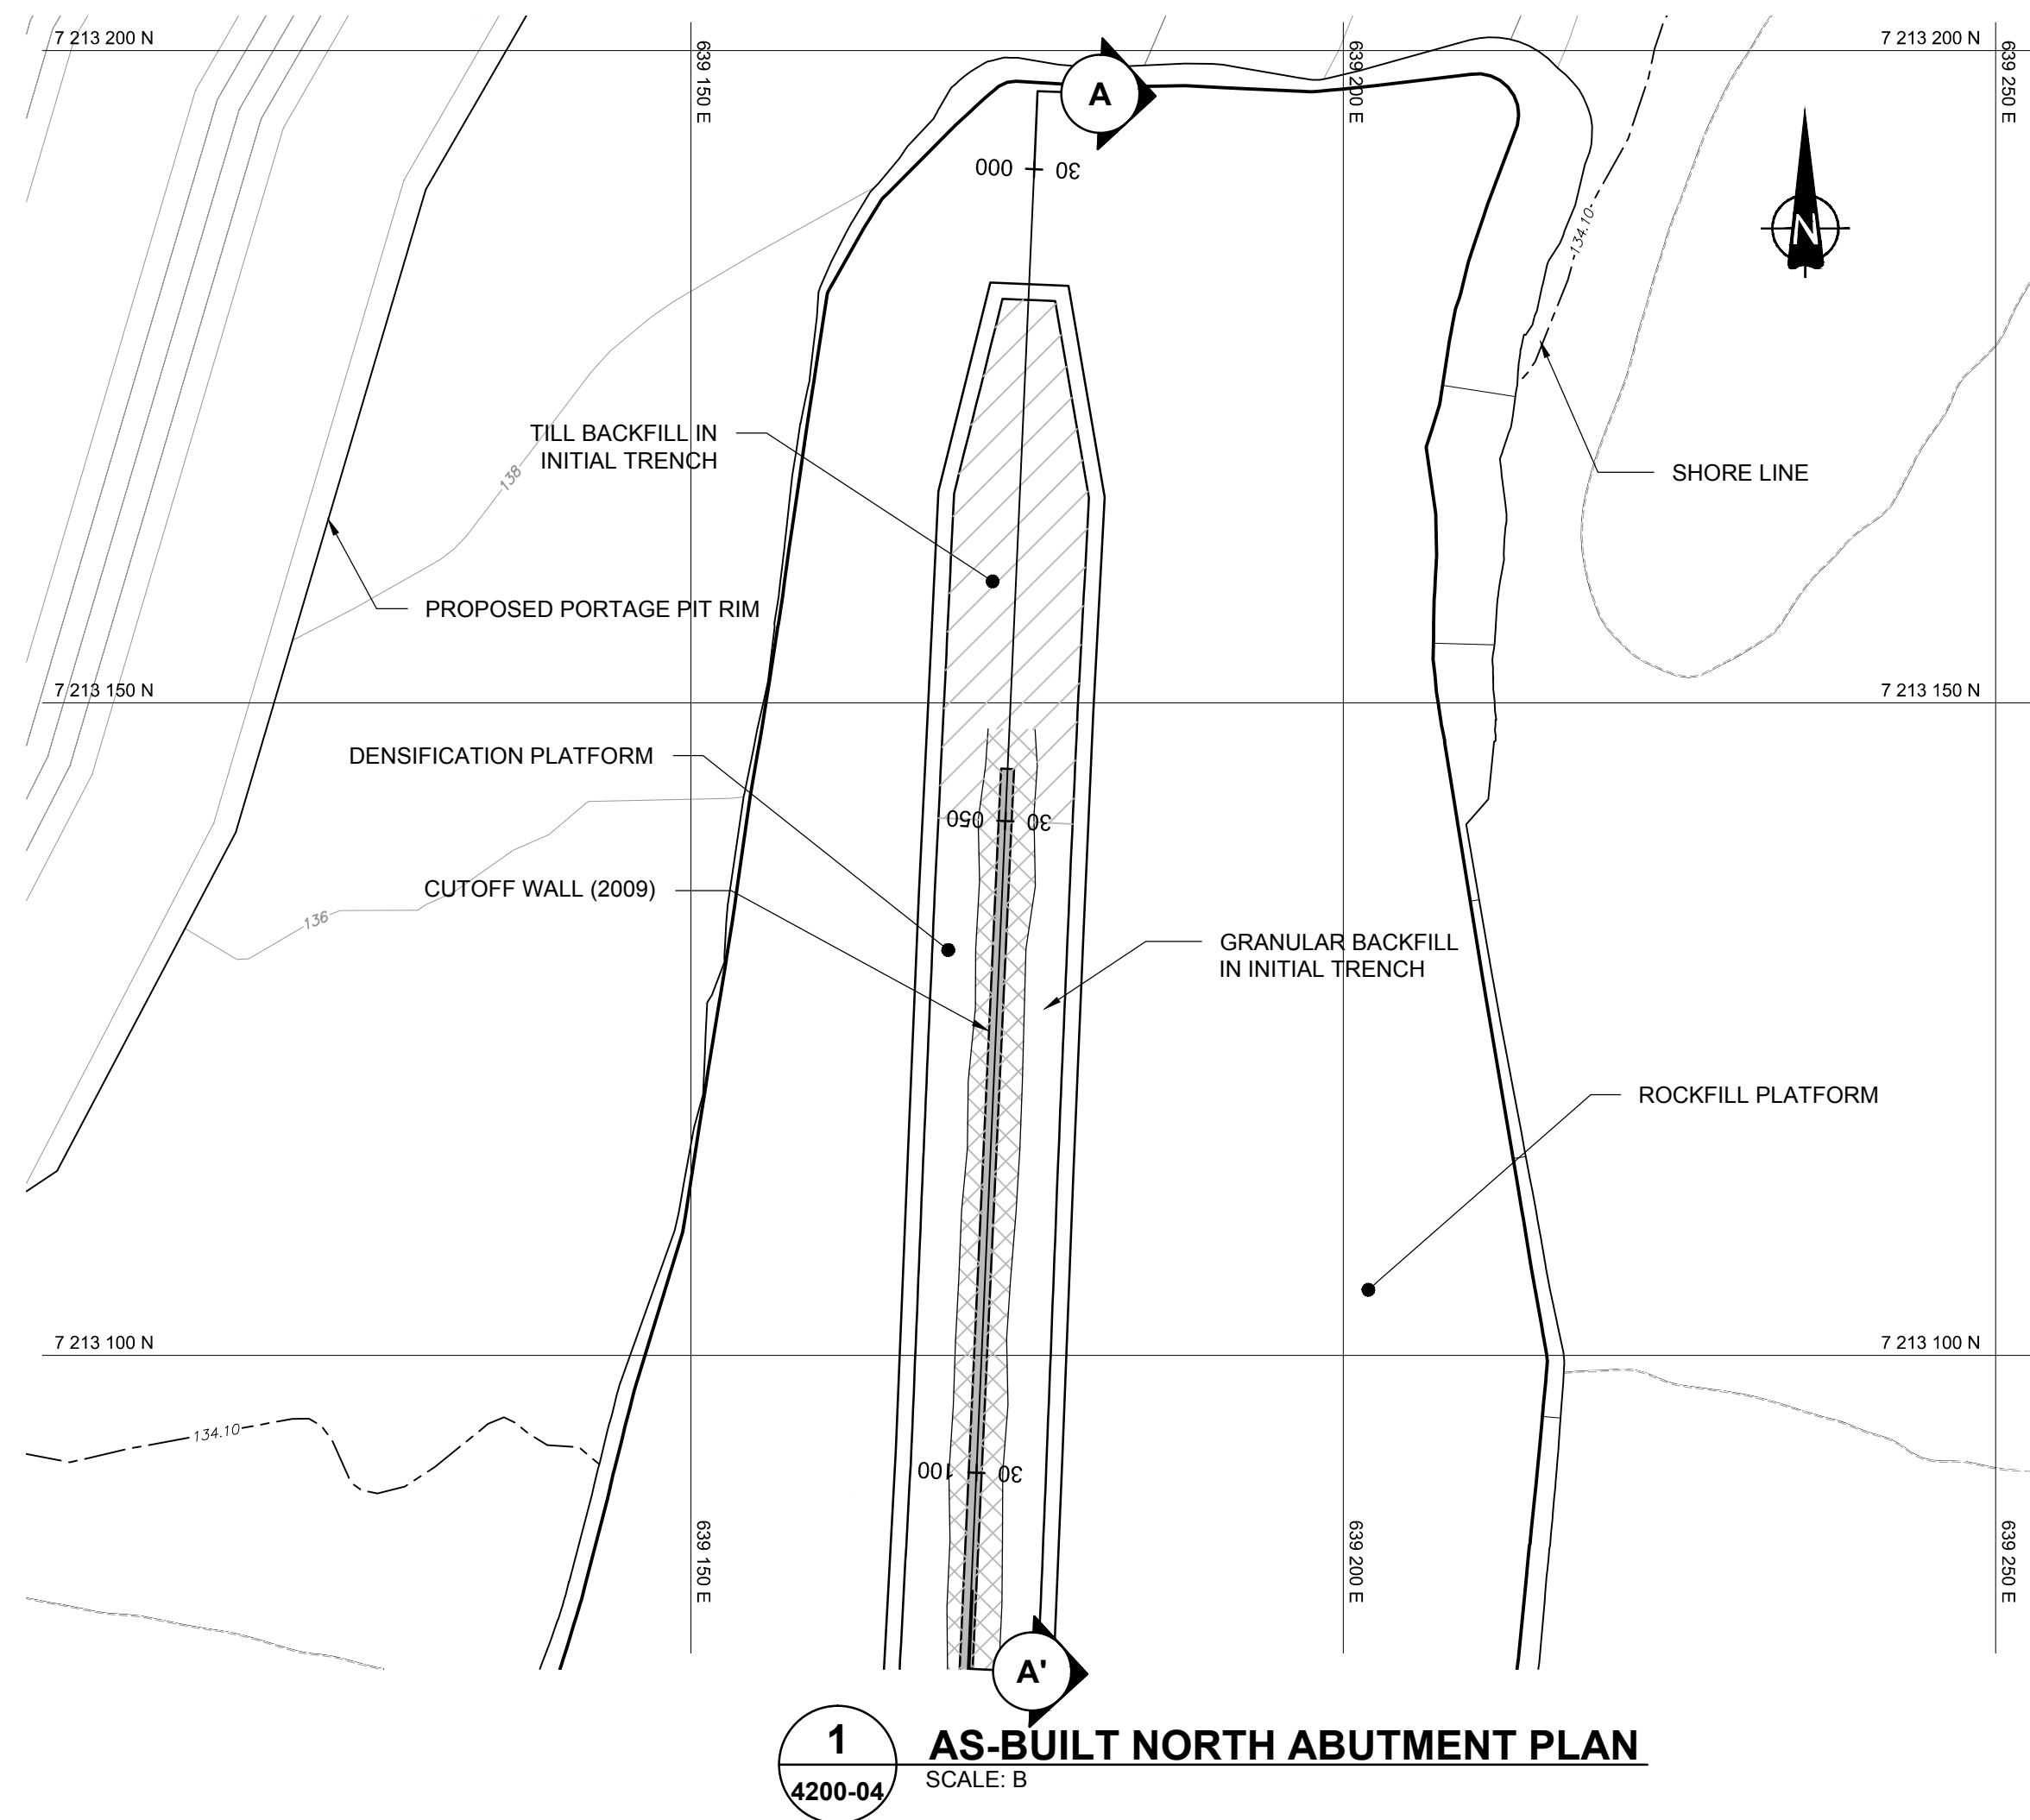

KEY PLAN
SCALE: C

LEGEND


	CORE BACKFILL		MINOR BATHYMETRY CONTOUR
	TILL BACKFILL		MAJOR BATHYMETRY CONTOUR
	CUTOFF WALL (PROFILE)		MINOR TOPOGRAPHY CONTOUR
	SHORELINE		MAJOR TOPOGRAPHY CONTOUR

NOTES

- 1) ALL DIMENSIONS ARE IN METRES UNLESS OTHERWISE NOTED.
- 2) ALL ELEVATIONS ARE IN METRES ABOVE SEA LEVEL (MSL), UNLESS OTHERWISE NOTED.
- 3) GRID REFERENCE: NAD 83, UTM ZONE 14.
- 4) TILL PLACED ON BEDROCK BETWEEN STA. 30+000 AND 30+050. CUTOFF WALL EXCAVATED INTO PLACED TILL BETWEEN STA. 30+046 AND 30+050.
- 5) CUTOFF WALL FOUNDATION ON BEDROCK, APPROVED BY THE ENGINEER. ALL ICE RICH MATERIAL (SOIL AND ROCK) WAS EXCAVATED BETWEEN STA. 30+000 TO STA. 30+860.
- 6) GROUTING PLATFORM, THERMAL CAP AND ROCKFILL SURFACING LAYERS NOT SHOWN.


REFERENCE

- 1) PORTAGE PIT DESIGN BY AEM, MARCH, 2009.
- 2) GOOSE ISLAND PIT DESIGN BY AEM, MAY, 2010.
- 3) ROAD AND MINE FACILITIES PROVIDED BY AEM, JANUARY, 2009.
- 4) TOPOGRAPHIC CONTOUR INFORMATION ON LAND SUPPLIED BY AGNICO-EAGLE MINES LIMITED (AEM), MEADOWBANK DIVISION.
- 5) LAKEBED SURFACE BASED ON BATHYMETRIC SURVEYS BY GOLDER ASSOCIATES LTD., 2006 AND DETAILED (0.5m CONTOUR INTERVAL) 2008.

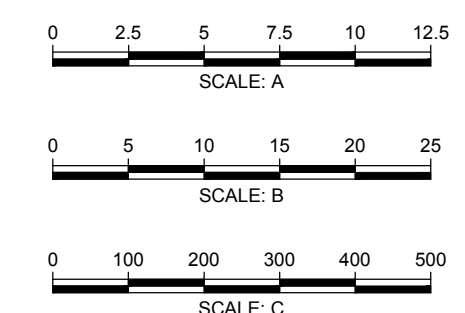

PROJECT										AEM AGNICO-EAGLE MINES LIMITED MEADOWBANK GOLD PROJECT NUNAVUT									
TITLE										BAY-GOOSE DIKE NORTH ABUTMENT PLAN AND DETAILS									
PROJECT No. 08-1428-0028/4200 FILE No. 0814280028-4200_1_10										DESIGN JU 04JUL08 SCALE AS SHOWN REV. 1									
CADD MJH 04JUL08										4200-10									
CHECK JU 24DEC08																			
REVIEW JCC 24DEC08																			

Drawing File: N:\bur-graphics\Projects\2009\1428\09-1428-5007\Drafting\4000\meadowbank - bay-goose (north) dike as-built\0814280028-4200_1_11A.dwg Layout:4200-11A Wednesday, December 26, 2012 10:17:36 AM By: TYKlassen

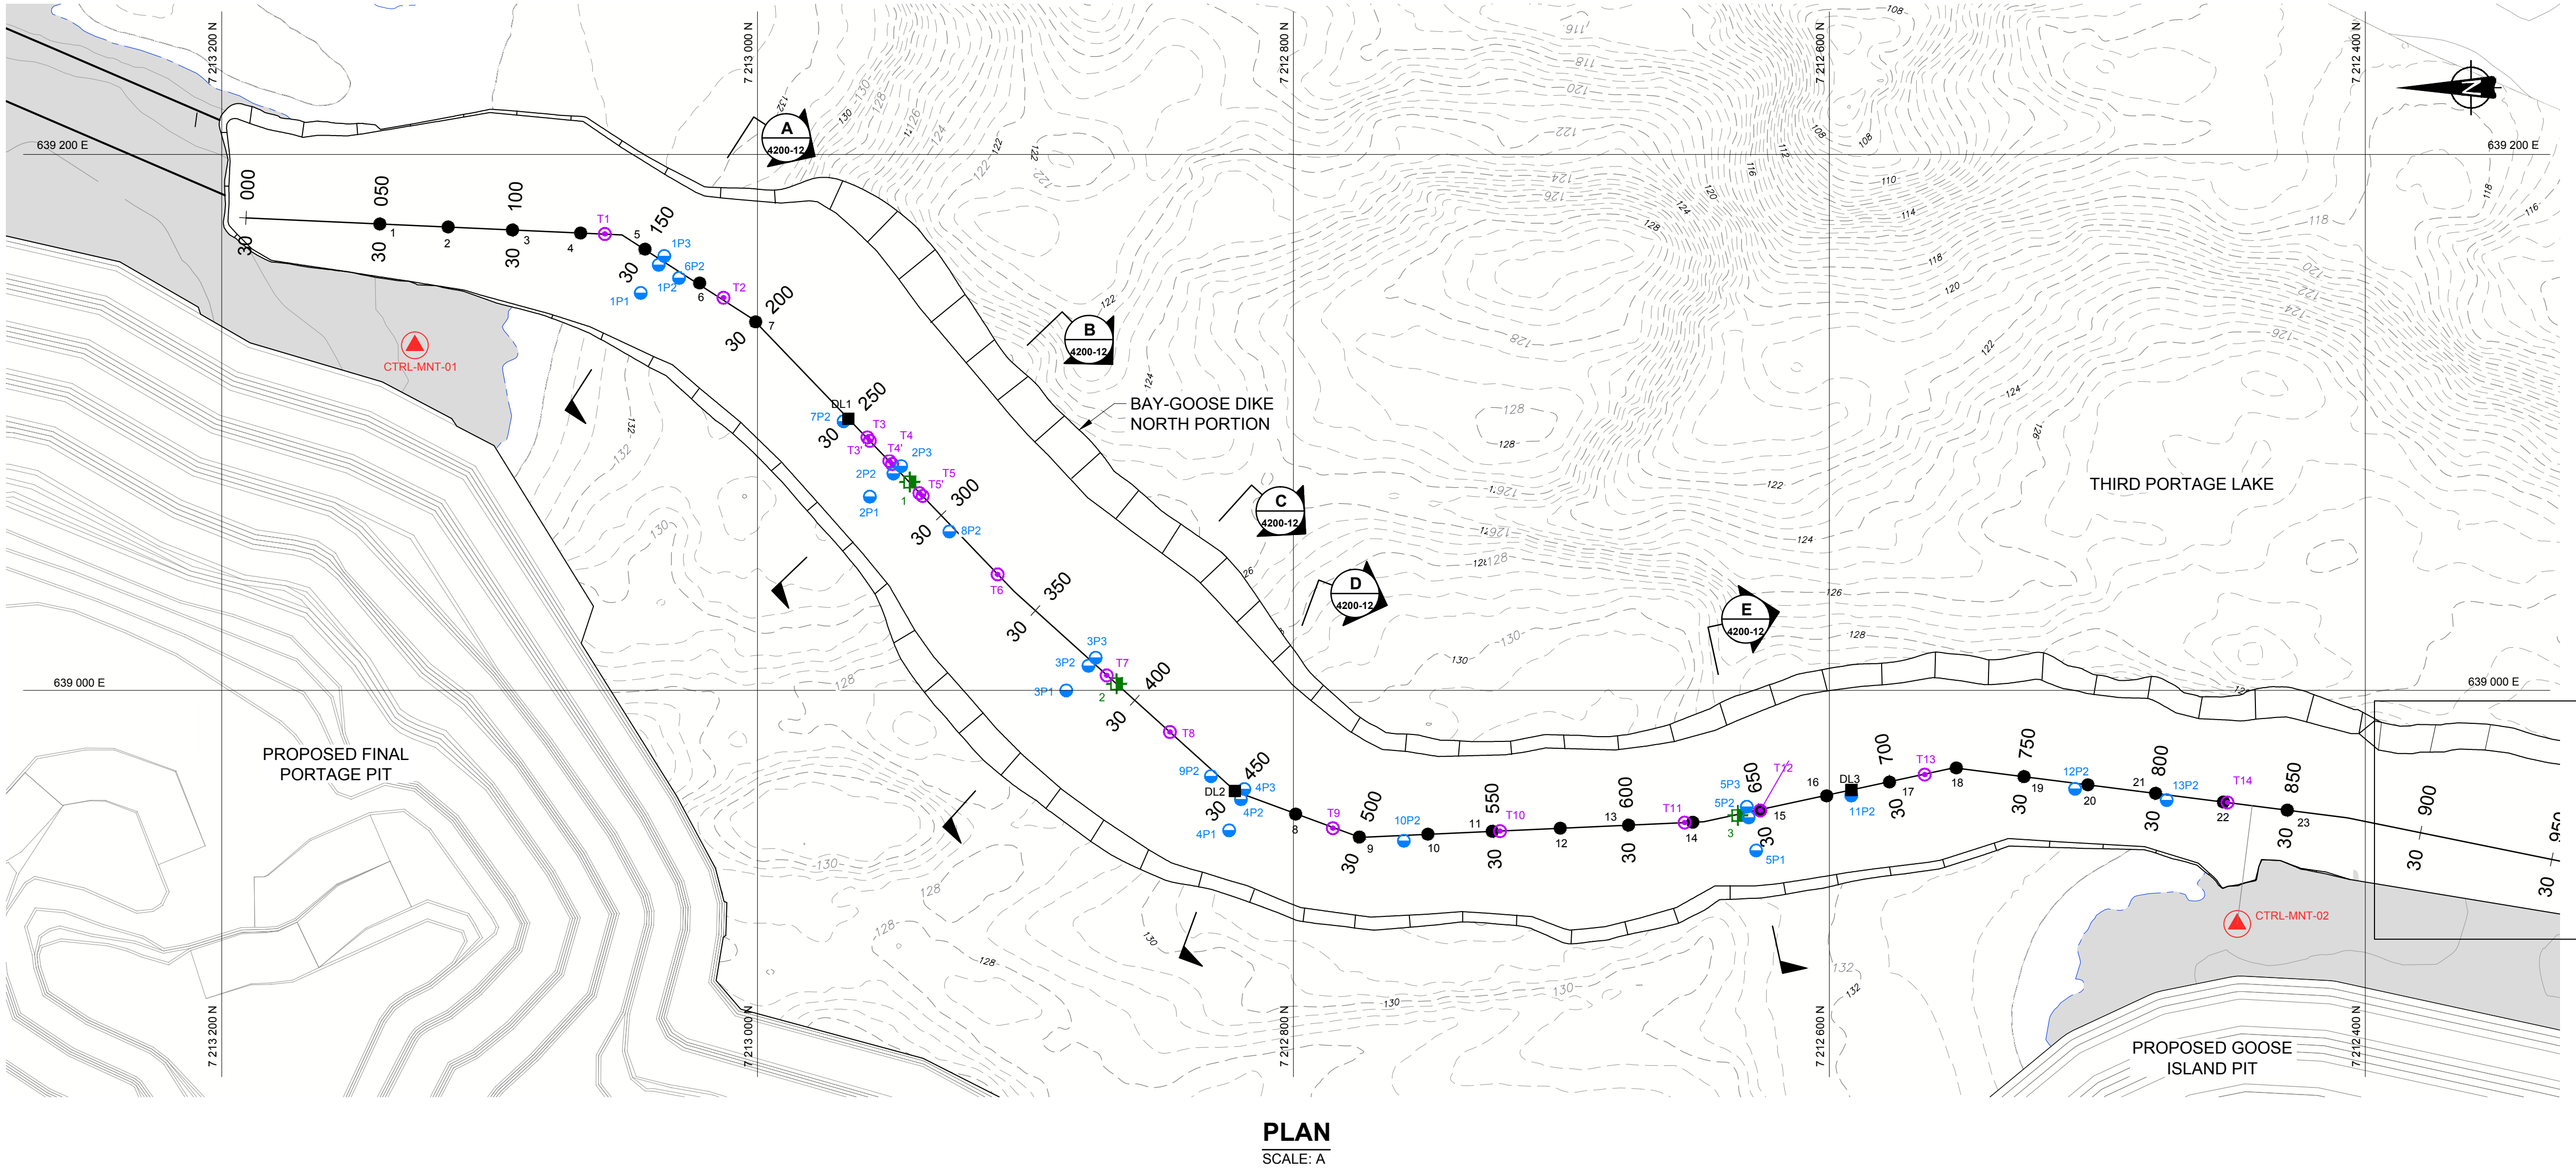

INCLINOMETER LOCATION TABLE			
POINT	EASTING	NORTHING	ELEV. (m)
1	639077.8	7212943.2	139.81
2	639002.5	7212866.0	140.47
3	638953.4	7212634.1	139.27

SURVEY MONUMENT TABLE			
STATION	EASTING	NORTHING	ELEV. (m)
30+050	639174.0	7213141.0	139.58
30+075	639172.9	7213115.5	139.45
30+100	639171.8	7213091.5	139.70
30+125	639170.6	7213068.0	139.46
30+150	639164.6	7213042.0	139.38
30+175	639152.0	7213021.6	139.66
30+200	639137.5	7213000.7	139.56
30+225	638963.9	7212799.2	140.26
30+250	638945.3	7212775.4	140.07
30+275	638946.3	7212749.8	140.14
30+300	638947.5	7212725.8	140.01
30+325	638948.6	7212700.4	139.82
30+350	638949.7	7212674.9	139.82
30+375	638950.8	7212651.0	139.60
30+400	638955.2	7212625.9	139.70
30+425	638960.7	7212601.0	139.88
30+450	638965.8	7212577.6	140.11
30+475	638971.1	7212552.6	140.19
30+500	638967.8	7212527.3	139.95
30+525	638964.8	7212503.5	139.67
30+550	638961.6	7212478.2	140.01
30+575	638958.4	7212452.9	139.63
30+600	638955.3	7212429.1	139.68

THERMISTOR TABLE		
POINT	EASTING	NORTHING
T1	639110.3	7213057.0
T2	639146.5	7213012.7
T3	639094.4	7212998.0
T4	639085.6	7212950.8
T5	639073.6	7212938.6
T6	639043.3	7212910.4
T7	639005.6	7212889.7
T8	638984.5	7212846.1
T9	638948.6	7212785.3
T10	638947.5	7212722.9
T11	638950.7	7212654.0
T12	638955.2	7212625.8
T13	638968.8	7212564.4
T14	638958.2	7212451.4

PIEZOMETER TABLE					
POINT	EASTING	NORTHING	ELEV. (A)	ELEV. (B)	ELEV. (C)
1P1	639148.3	7213043.6	116.41	121.41	127.41
1P2	639158.8	7213036.9	117.05	122.05	128.05
1P3	639162.1	7213034.8	117.13	122.13	-
2P1	639072.3	7212958.1	119.25	124.25	130.25
2P2	639080.9	7212948.3	119.10	124.10	130.10
2P3	639083.7	7212946.4	119.70	124.70	-
3P1	639000.0	7212894.8	113.12	118.12	124.12
3P2	639009.2	7212876.5	113.10	118.10	124.10
3P3	639012.2	7212873.8	113.58	118.58	-
4P1	638947.8	7212824.0	116.61	118.61	124.61
4P2	638959.4	7212819.6	115.13	120.13	126.13
4P3	638963.2	7212818.3	115.25	122.80	-
5P1	638940.3	7212627.3	118.00	123.00	129.00
5P2	638952.6	7212630.1	117.85	122.85	128.85
5P3	638956.6	7212630.8	115.15	120.15	-
6P2	639153.9	7213029.3	127.57	-	-
7P2	639100.4	7212867.8	128.85	-	-
8P2	639050.3	7212828.4	129.65	-	-
9P2	638968.0	7212830.8	126.73	-	-
10P2	638943.9	7212758.8	130.26	-	-
11P2	638960.8	7212591.8	130.65	-	-
12P2	638963.3	7212508.3	132.16	-	-
13P2	638959.1	7212474.1	132.05	-	-

LEGEND


●	SURVEY MONUMENT	---	MINOR BATHYMETRY CONTOUR
○	THERMISTOR	---	MAJOR BATHYMETRY CONTOUR
▲	SURVEY CONTROL MONUMENT	---	MINOR TOPOGRAPHIC CONTOUR
●	PIEZOMETER	---	MAJOR TOPOGRAPHIC CONTOUR
+	INCLINOMETER	---	PIT RIM
■	INSTRUMENT CABIN	---	
---	SHORELINE	---	

NOTES

- 1) ALL DIMENSIONS ARE IN METRES UNLESS OTHERWISE NOTED.
- 2) ALL ELEVATIONS ARE IN METRES ABOVE SEA LEVEL (MASL), UNLESS OTHERWISE NOTED.
- 3) GRID REFERENCE: NAD 83, UTM ZONE 14.
- 4) SURVEYED LAKE SURFACE ELEVATION: THIRD PORTAGE LAKE = 134.1m (2008)
- 5) SURVEY INSTRUMENT CABIN LOCATION INFORMATION PROVIDED BY AEM.
- 6) SEISMOGRAPH LOCATIONS NOT SHOWN.
- 7) BAY-GOOSE DIKE SOUTH INSTRUMENTATION PLAN AND SECTIONS SHOWN ON DRAWINGS 4300-30, 4300-31 AND 4300-32.
- 8) SURVEYED AND INSTALLED INSTRUMENTATION LOCATION INFORMATION PROVIDED BY AEM.

REFERENCE


- 1) PORTAGE PIT DESIGN BY AEM, MARCH, 2009.
- 2) GOOSE ISLAND PIT DESIGN BY AEM, MAY, 2010.
- 3) ROAD AND MINE FACILITIES PROVIDED BY AEM, JANUARY, 2009.
- 4) TOPOGRAPHIC CONTOUR INFORMATION ON LAND SUPPLIED BY AGNICO-EAGLE MINES LIMITED (AEM), MEADOWBANK DIVISION.
- 5) LAKEBED SURFACE BASED ON BATHYMETRIC SURVEYS BY GOLDBER ASSOCIATES LTD., 2006 AND DETAILED (0.5m CONTOUR INTERVAL) 2008.

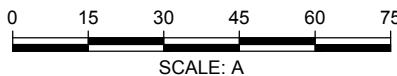

PROJECT	AGNICO-EAGLE MINES LIMITED MEADOWBANK GOLD PROJECT NUNAVUT		
TITLE	BAY-GOOSE DIKE INSTRUMENTATION PLAN (NORTH PORTION)		
	PROJECT No.	08-1428-0028/4200	FILE No. 0814280028-4200_1_11A
	DESIGN	JU	01DEC08
	CADD	EA	05DEC08
	CHECK	JU	24DEC08
REVIEW	JCC	24DEC08	4200-11A

DRAWING NO.	REV	DATE	DES	REVISION DESCRIPTION	CADD	CHK	RVW	STAMP
				AS-BUILT	JD	GRB	FE	
				REVISED INSTRUMENTATION LAYOUT	JK	FE	MRJ	
				ISSUED FOR CONSTRUCTION	EA	FE	MRJ	
				REVISED ISSUED FOR TENDER	JK	DRW	MRJ	
				ISSUED FOR TENDER	JK	DRW	MRJ	
				ISSUED FOR REVIEW	EA	FE	JCC	
				ISSUED FOR REVIEW	EA	JU	JCC	

Drawing File: N:\bur-graphics\Projects\2009\1428\09-1428-5007\Drafting\4000\meadowbank - bay-goose (north) dike as-built\0814280028-4200_1_11B.dwg Layout:4200-11 Wednesday, December 26, 2012 10:24:33 AM By: TYKlassen

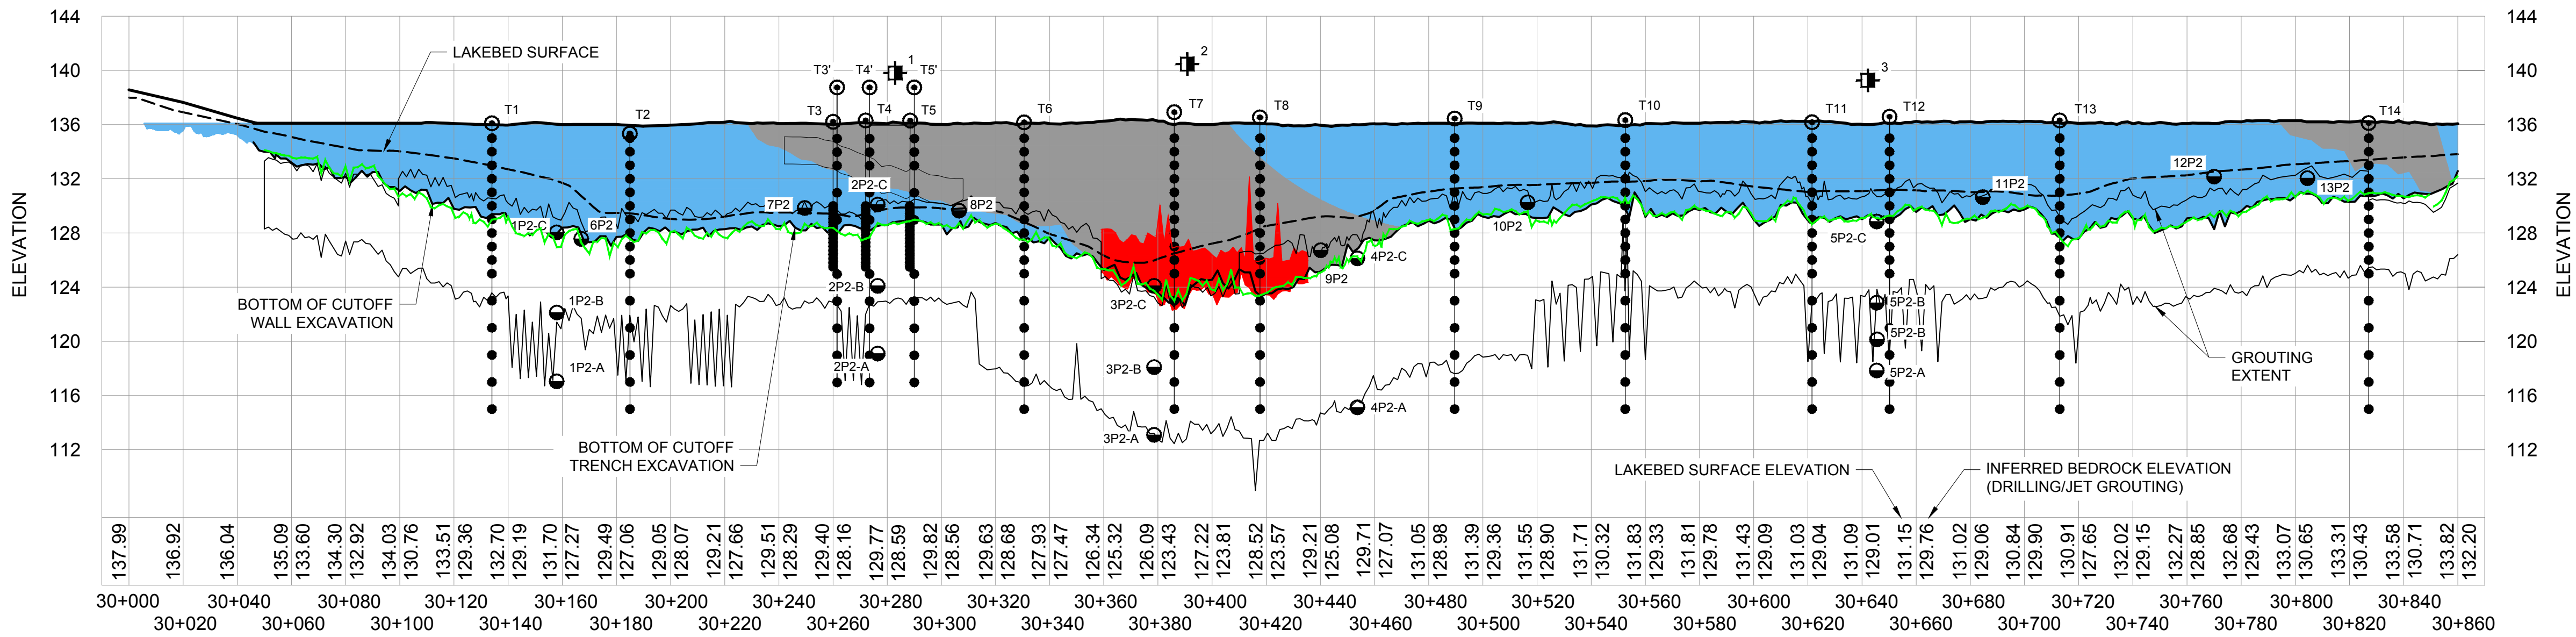

BAY-GOOSE NORTH CENTRELINE PROFILE
SCALE: 5x VERTICAL EXAGGERATION

LEGEND


- | | | | |
|--|-----------------|--|---|
| | THERMISTOR | | BERM CREST |
| | PIEZOMETER | | LAKEBED |
| | INCLINOMETER | | INFERRED BEDROCK (CUTOFF TRENCH EXCAVATION) |
| | THERMISTOR BEAD | | GROUTING EXTENT |
| | | | INFERRED BEDROCK (DRILLING/JET GROUTING) |
| | | | CEMENT SOIL BENTONITE (CSB) |
| | | | SOIL BENTONITE (SB) |
| | | | JET GROUTING |

NOTES

- 1) ALL DIMENSIONS ARE IN METRES UNLESS OTHERWISE NOTED.
- 2) ALL ELEVATIONS ARE IN METRES ABOVE SEA LEVEL (MASL), UNLESS OTHERWISE NOTED.
- 3) BAY-GOOSE DIKE SOUTH INSTRUMENTATION PLAN AND SECTIONS SHOWN ON DRAWINGS 4300-30, 4300-31 AND 4300-32.
- 4) SURVEYED AND INSTALLED INSTRUMENTATION LOCATION INFORMATION PROVIDED BY AEM.
- 5) CUTOFF TRENCH EXCAVATED TO BEDROCK.
- 6) BEDROCK SURFACE INFERRED BASED ON DATA OBTAINED DURING DRILLING AND JET GROUTING.


REFERENCE

- 1) TOPOGRAPHIC CONTOUR INFORMATION ON LAND SUPPLIED BY AGNICO-EAGLE MINES LIMITED (AEM), MEADOWBANK DIVISION.
- 2) LAKEBED SURFACE BASED ON BATHYMETRIC SURVEYS BY GOLDER ASSOCIATES LTD., 2006 AND DETAILED (0.5m CONTOUR INTERVAL) 2008.

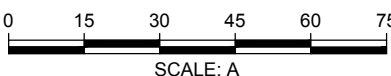


DRAWING NO.	REFERENCES	REV	DATE	DES	REVISION DESCRIPTION	CADD	CHK	RVW	STAMP
		1	15DEC12	KD	AS-BUILT		JD	GRB	FE
		2	25AUG10	FE	REVISED INSTRUMENTATION LAYOUT		JK	FE	MRJ
		3	17JUL09	FE	ISSUED FOR CONSTRUCTION		EA	FE	MRJ
		4	22MAY09	FE	REVISED ISSUED FOR TENDER		JK	DRW	MRJ
		5	08MAY09	FE	ISSUED FOR TENDER		JK	DRW	MRJ
		6	02FEB09	JU	ISSUED FOR REVIEW		EA	FE	JCC
		7	25DEC08	JU	ISSUED FOR REVIEW		EA	JU	JCC


PROJECT		AGNICO-EAGLE MINES LIMITED MEADOWBANK GOLD PROJECT NUNAVUT			
TITLE		BAY-GOOSE DIKE INSTRUMENTATION PROFILE (NORTH PORTION)			
		PROJECT No. 08-1428-0028/4200		FILE No. 0814280028-4200_1_11B	
		DESIGN	JU	01DEC08	
		CADD	EA	05DEC08	
		CHECK	JU	24DEC08	
		REVIEW	JCC	24DEC08	
		SCALE AS SHOWN		REV. 2	4200-11B

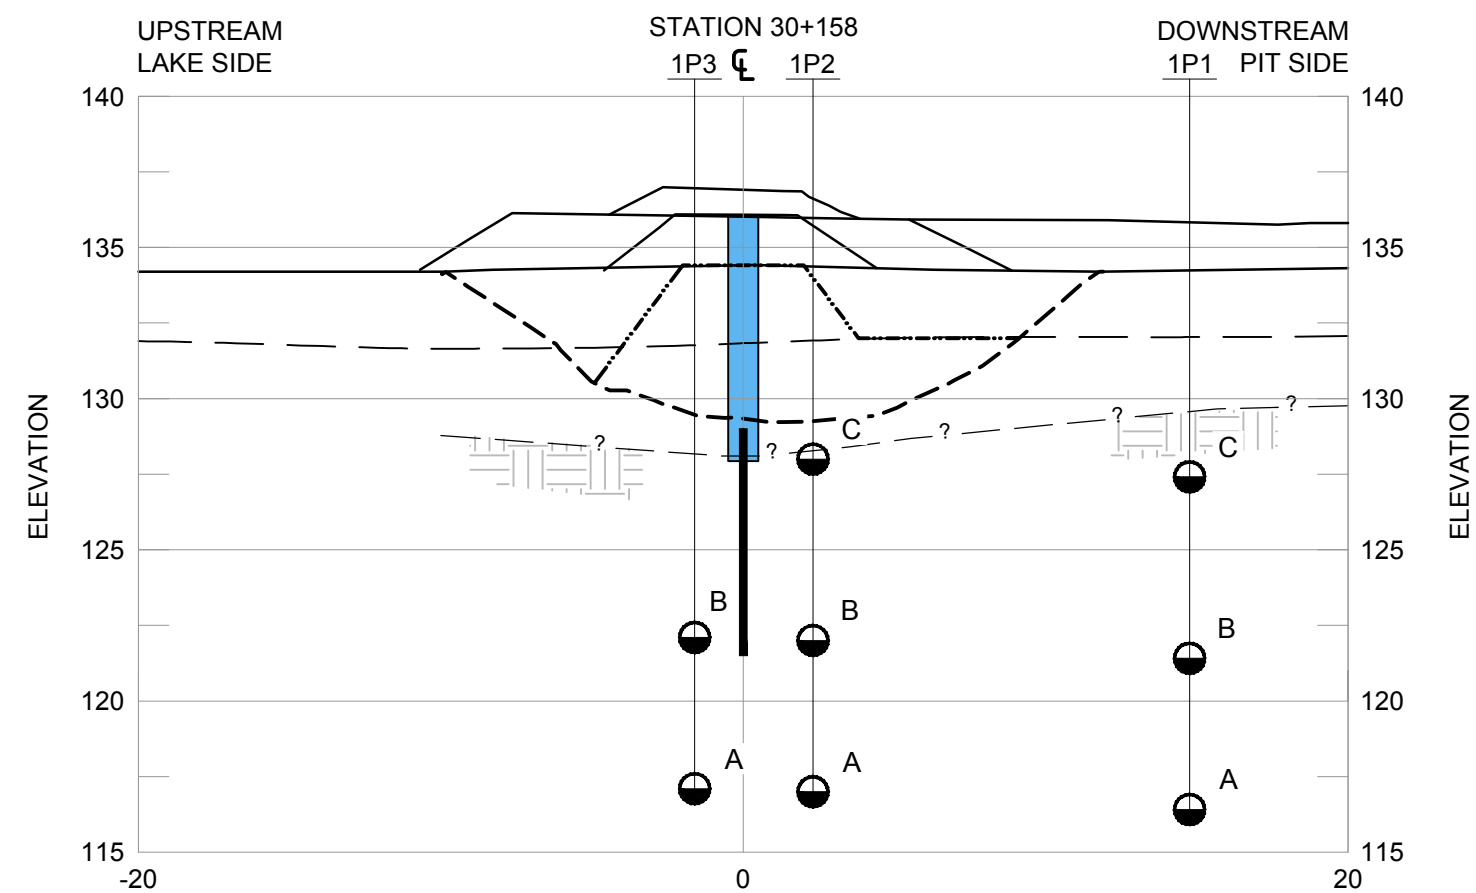


A INSTRUMENTATION SECTIONS
4200-11A SCALE: A

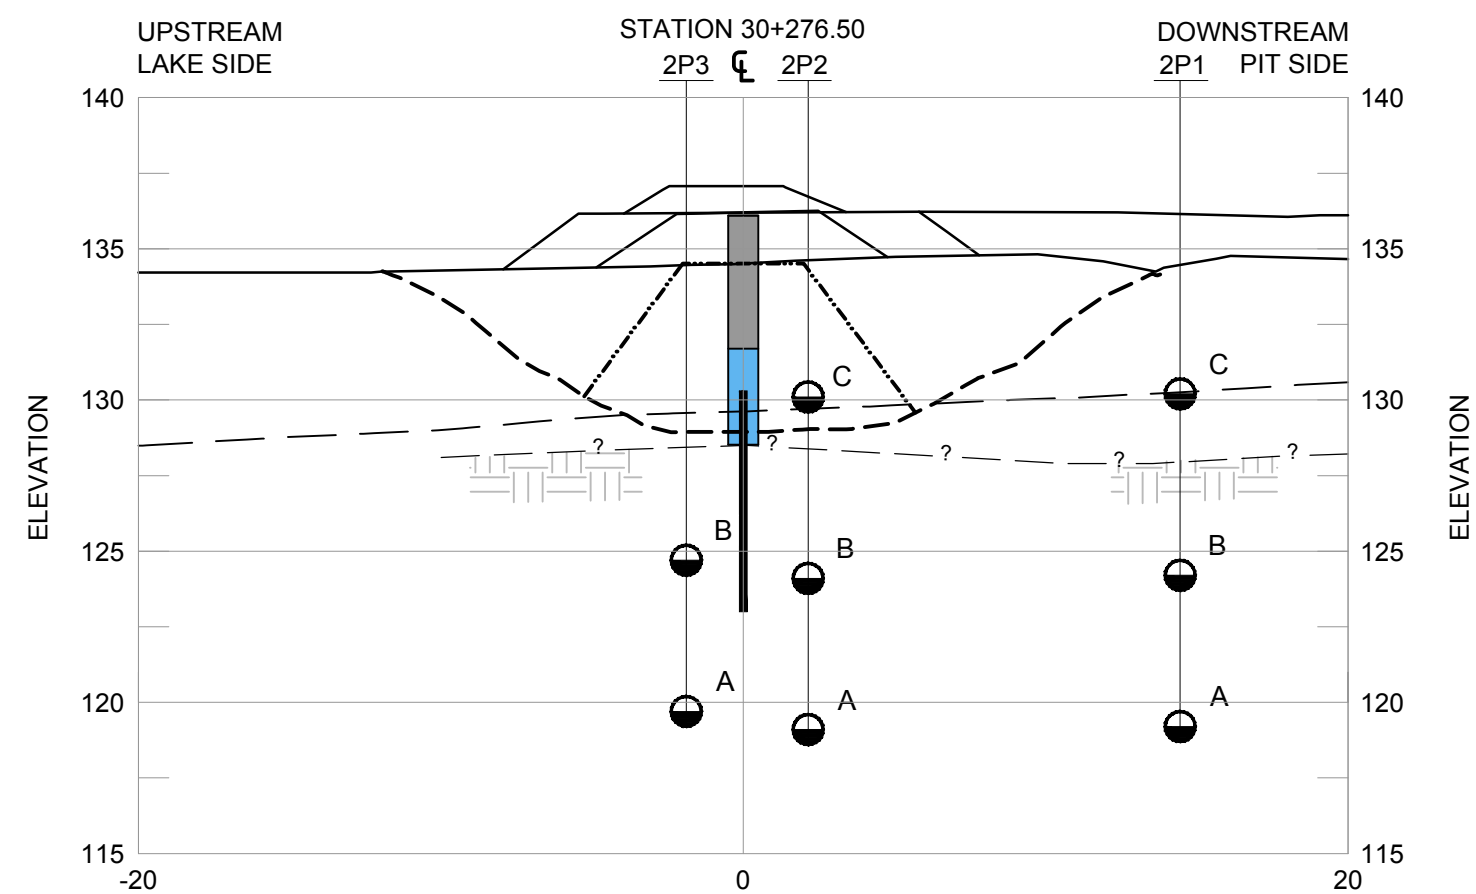


B INSTRUMENTATION SECTIONS
 4200-11A SCALE: A

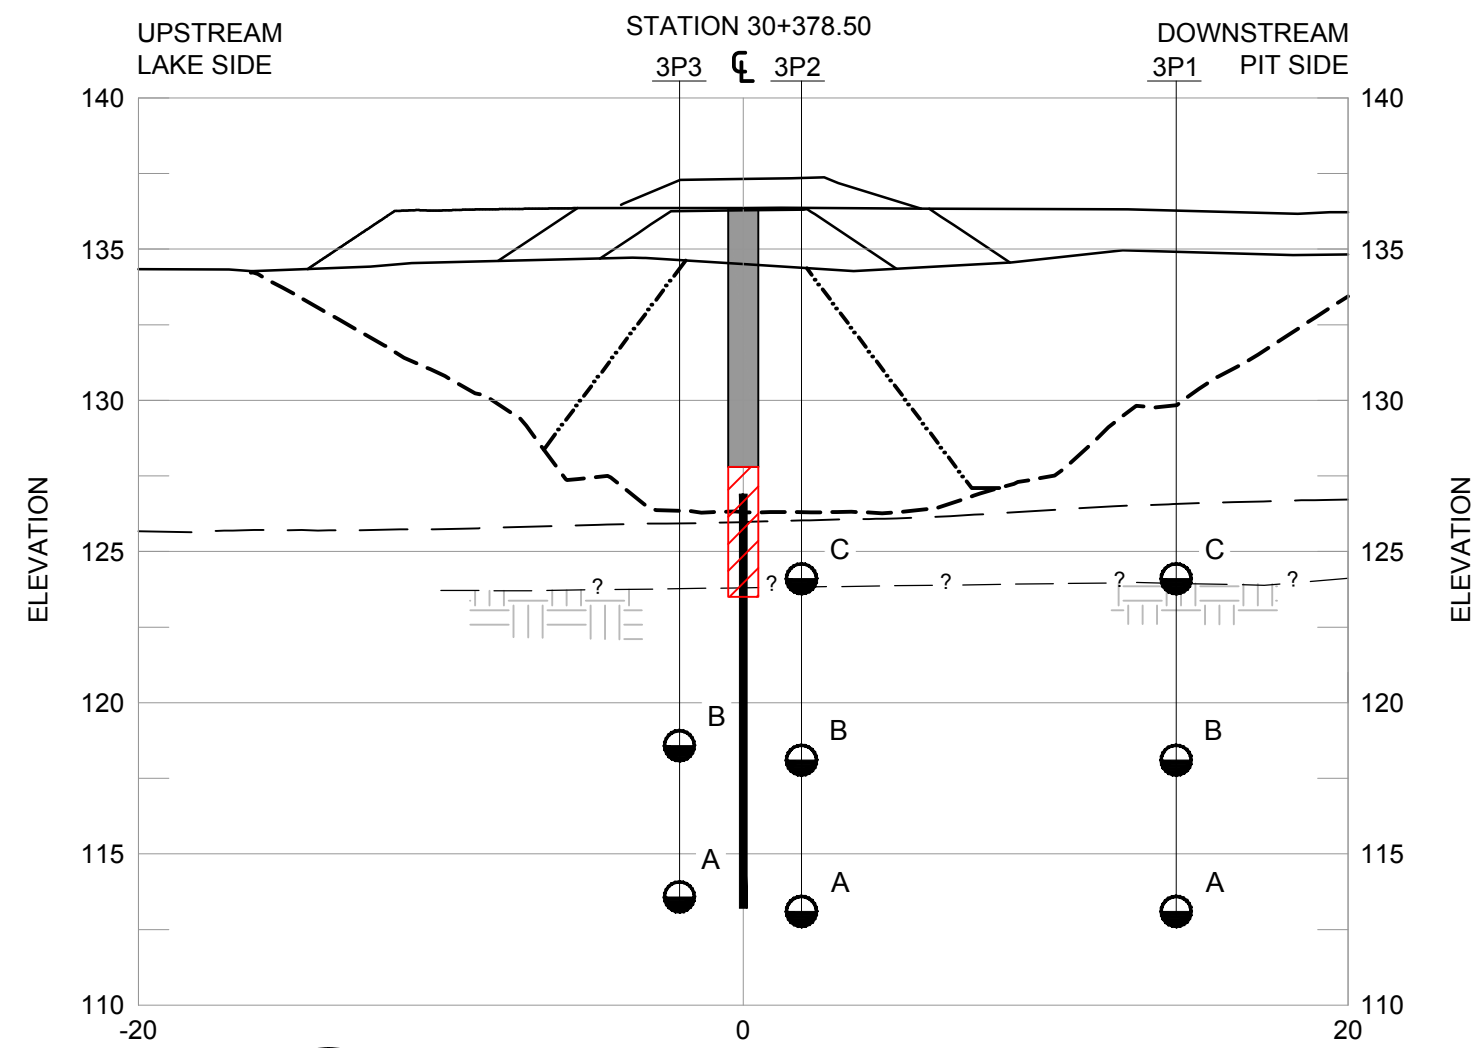


C INSTRUMENTATION SECTIONS
4200-11A SCALE: A

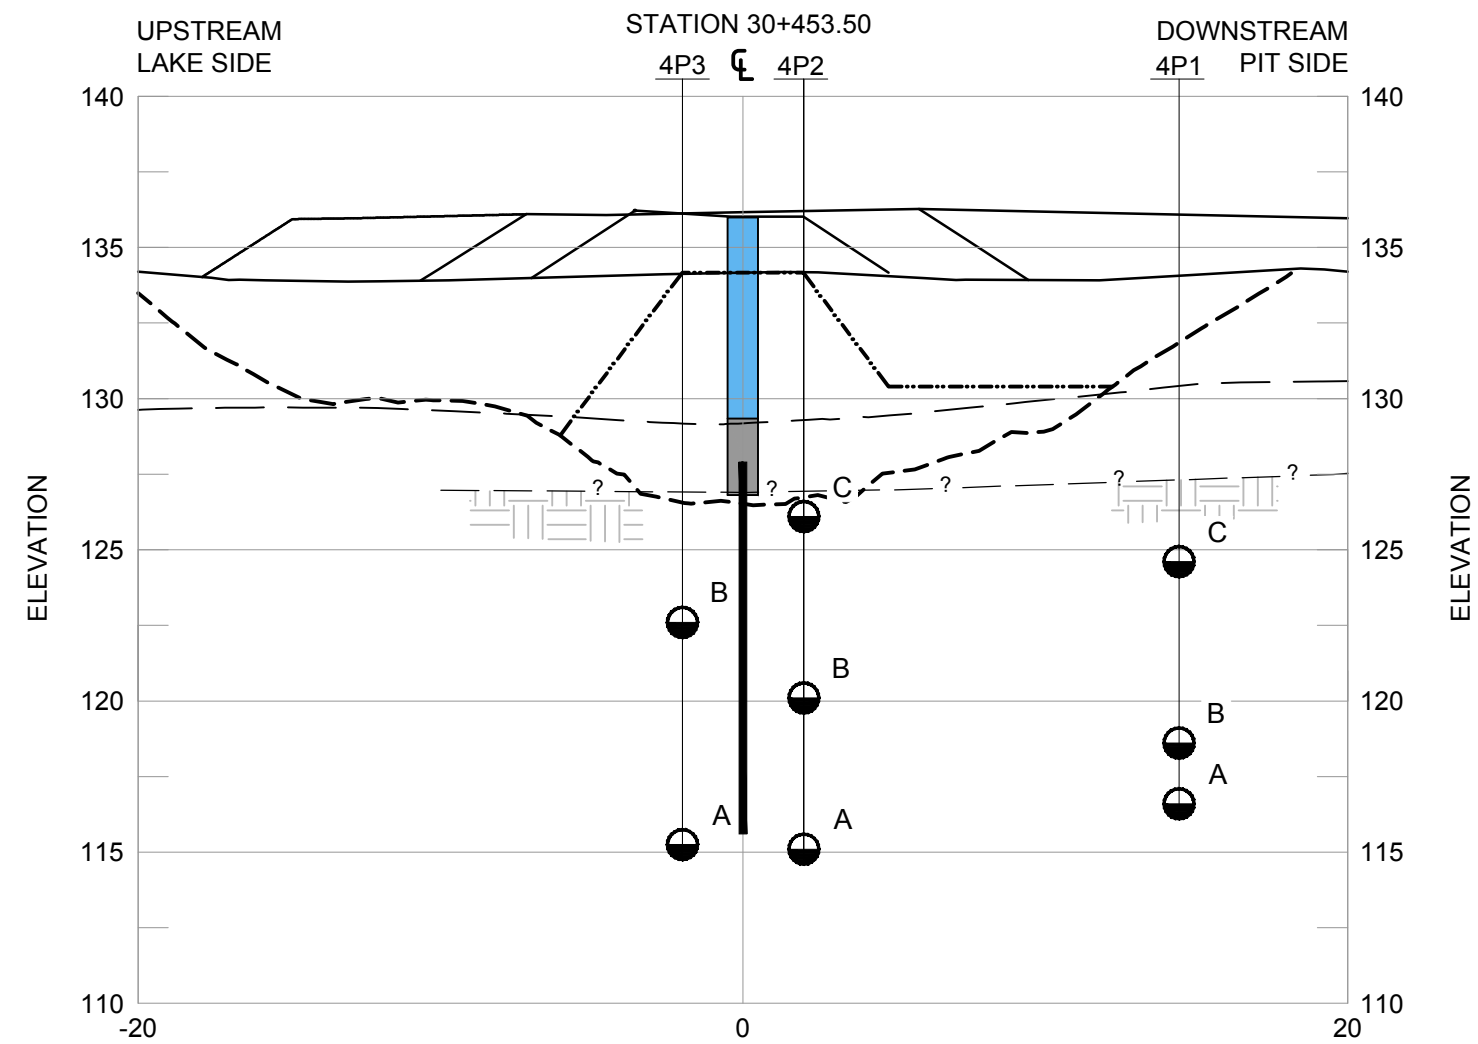


D INSTRUMENTATION SECTIONS
4200-11A SCALE: A

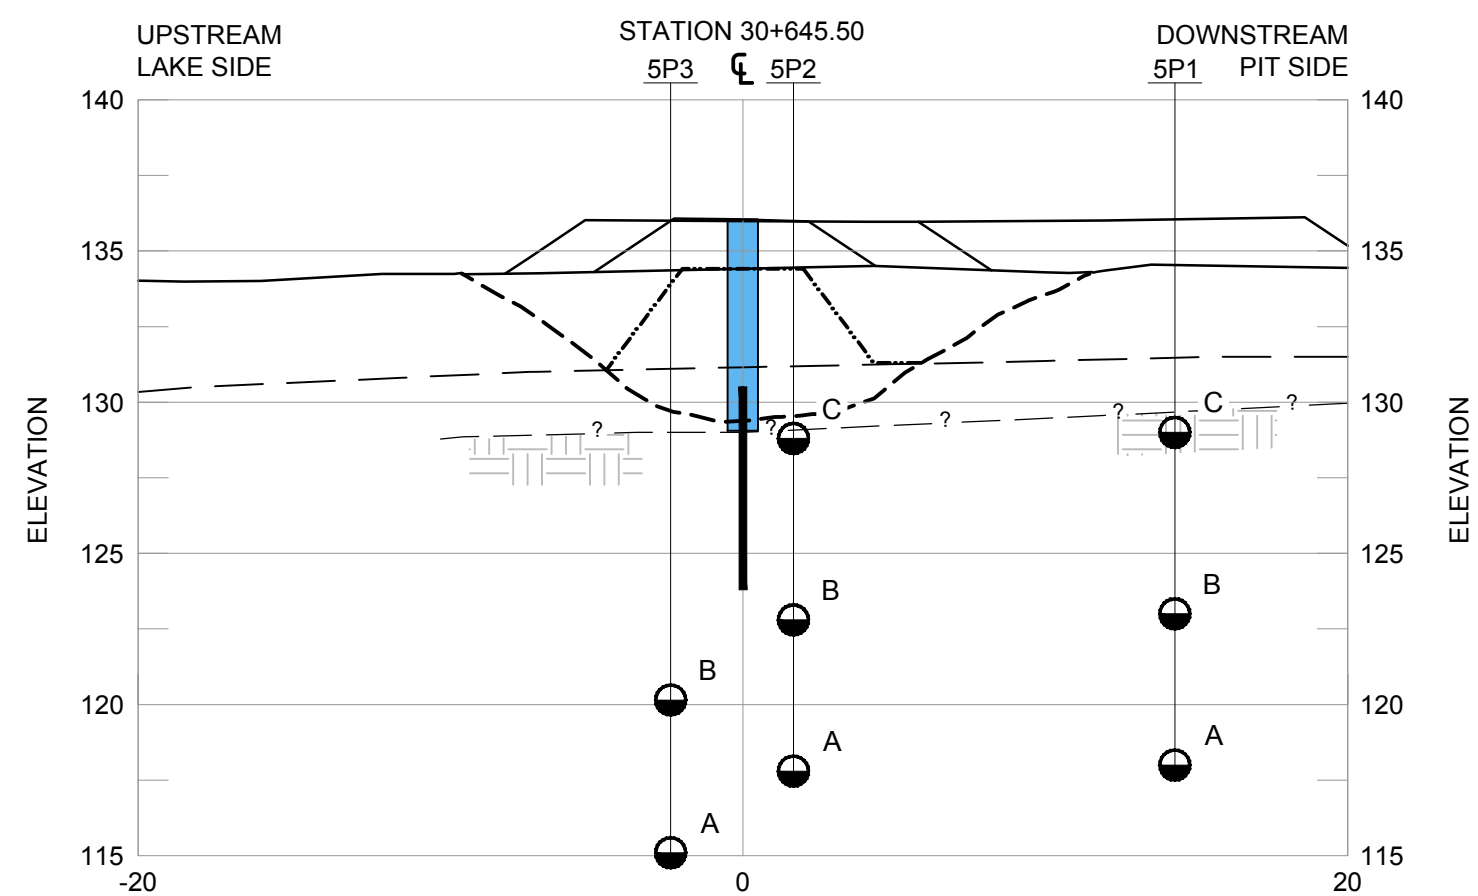

E INSTRUMENTATION SECTIONS
4200-11A SCALE: A

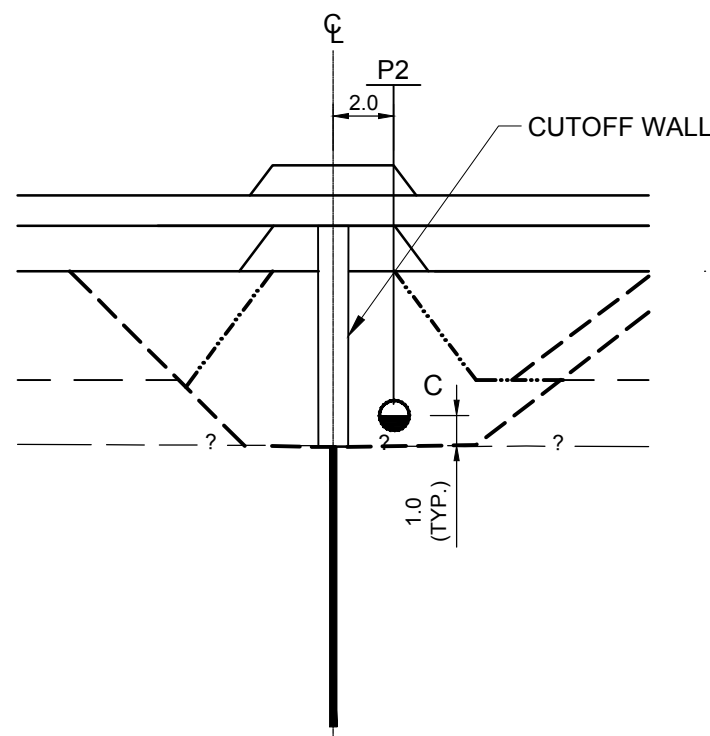

TYPICAL SECTION - INSTRUMENTATION
NORTH PORTION (DOWNSTREAM PIEZOMETER)
 SCALE: A

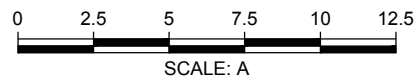

LEGEND

	CUTOFF WALL (CSB)		JET GROUT
	CUTOFF WALL (SB)		GROUTING CURTAIN
	INITIAL ROCKFILL		PIEZOMETER
	LAKEBED		
	BEDROCK		
	INFERRED CORE BACKFILL		
	AS-BUILT TRENCH EXCAVATION		











NOTES

- 1) ALL DIMENSIONS ARE IN METRES UNLESS OTHERWISE NOTED.
- 2) ALL ELEVATIONS ARE IN METRES ABOVE SEA LEVEL (MASL), UNLESS OTHERWISE NOTED.
- 3) TOPOGRAPHIC CONTOUR INFORMATION ON LAND SUPPLIED BY AGNICO-EAGLE MINES LIMITED (AEM), MEADOWBANK DIVISION.
- 4) LAKEBED SURFACE BASED ON BATHYMETRIC SURVEYS BY GOLDER ASSOCIATES LTD., 2006 AND DETAILED (0.5m CONTOUR INTERVAL) 2008.
- 5) SURVEYED LAKE SURFACE ELEVATION: THIRD PORTAGE LAKE = 134.1m (2008).
- 6) GEOLOGIC INFORMATION INFERRED BASED ON DRILLING INVESTIGATION RESULTS AND CUTOFF TRENCH EXCAVATION AND DRILLING ACTIVITIES ASSOCIATED WITH GROUTING AND JET GROUTING WORKS.
- 7) ALL SLOPES SHOWN ARE NOMINAL.
- 8) CUTOFF WALL FOUNDED ON BEDROCK SURFACE APPROVED BY THE ENGINEER. ALL ICE RICH MATERIAL (SOIL AND ROCK) WERE EXCAVATED BETWEEN STA. 30+000 TO 30+ 860.
- 9) BEDROCK AND LAKEBED SURFACES ARE SHOWN AS SMOOTH LINES FOR ILLUSTRATIVE PURPOSES.
- 10) GROUTING PLATFORM, THERMAL CAP, AND ROCKFILL SURFACING MAY NOT BE SHOWN. ROCKFILL SURFACING AND THERMAL CAP TO BE PLACED BY AEM. PLACEMENT IN PROGRESS AS OF APRIL 2013.

[illegible]

PROJECT AEM	AGNICO-EAGLE MINES LIMITED MEADOWBANK GOLD PROJECT NUNAVUT
TITLE BAY-GOOSE DIKE INSTRUMENTATION SECTION DETAILS (NORTH PORTION)	

	PROJECT No. 08-1428-0028/4200		FILE No. 0814280028-4200_2_12	
	DESIGN	JU	01DEC08	SCALE
	CADD	EA	05DEC08	AS SHOWN
	CHECK	JU	24DEC08	REV.
	REVIEW	JCC	24DEC08	3
			4200-12	

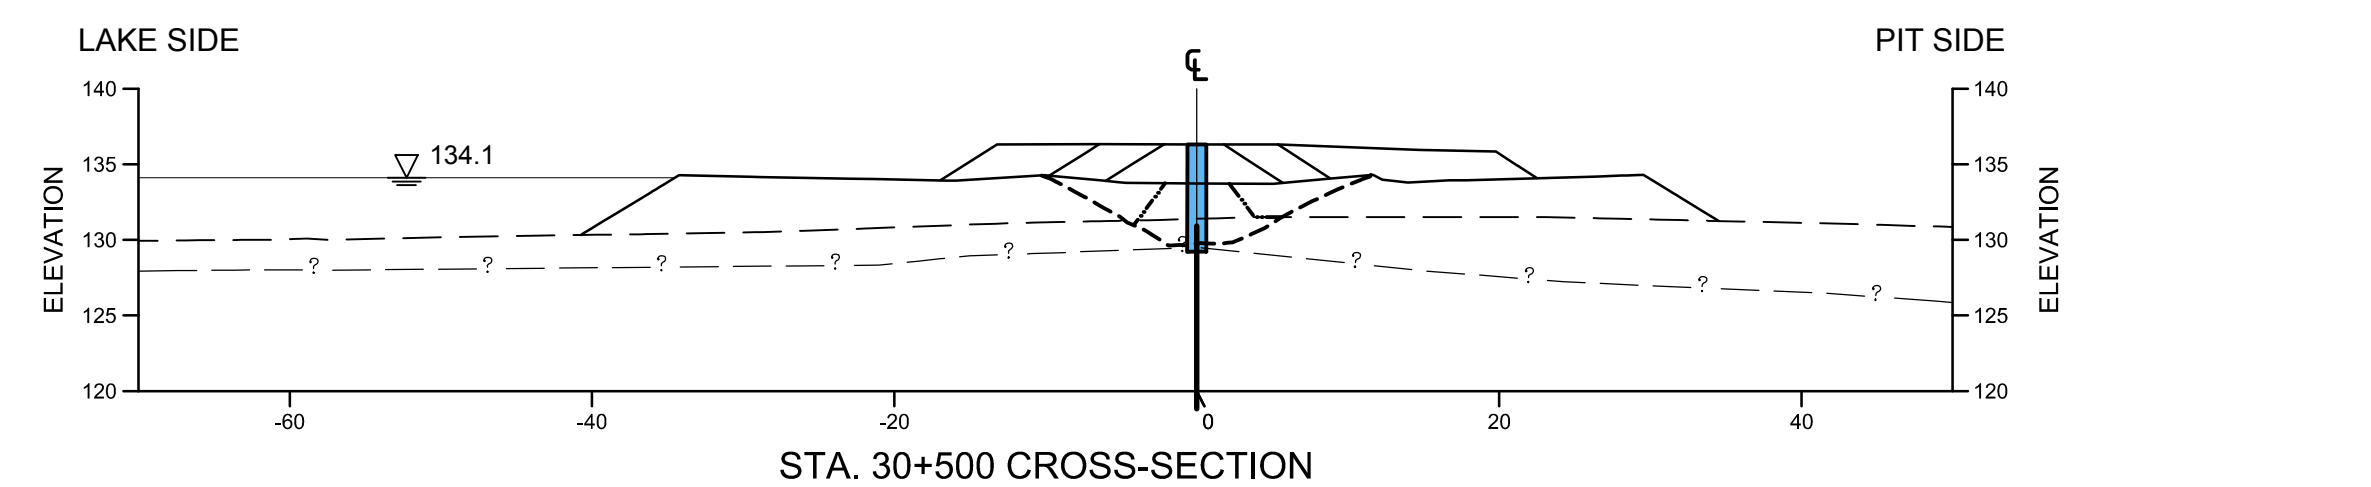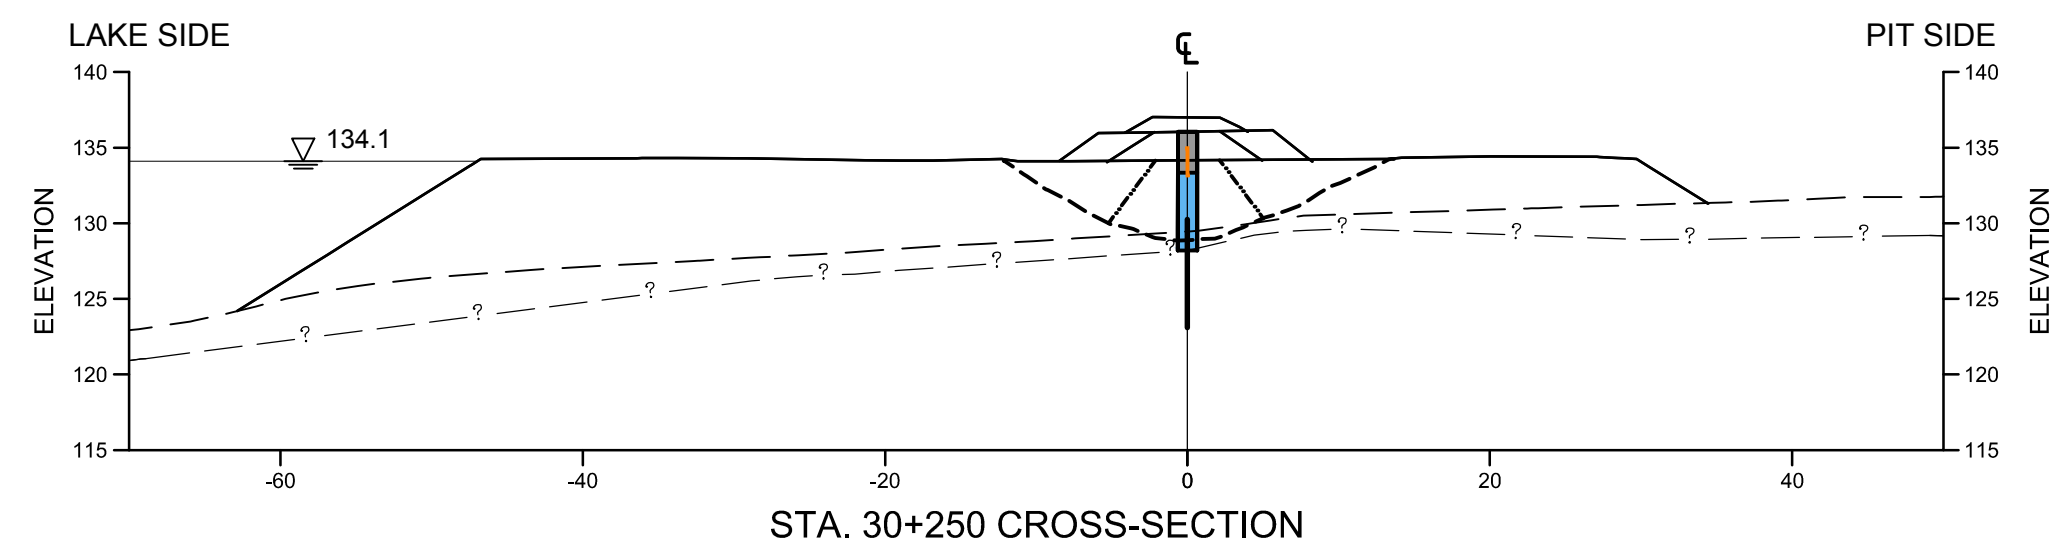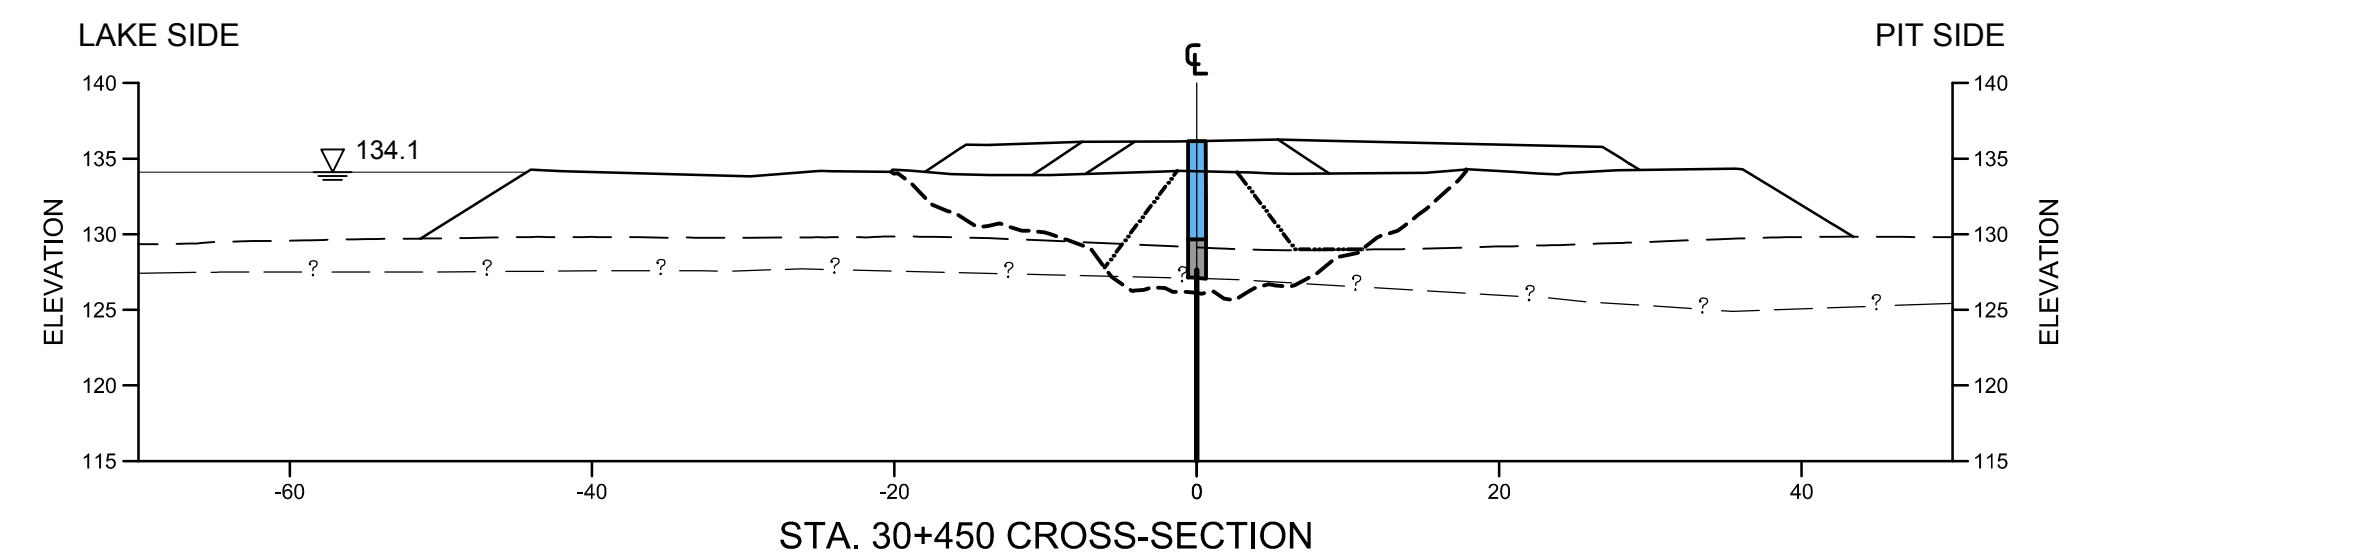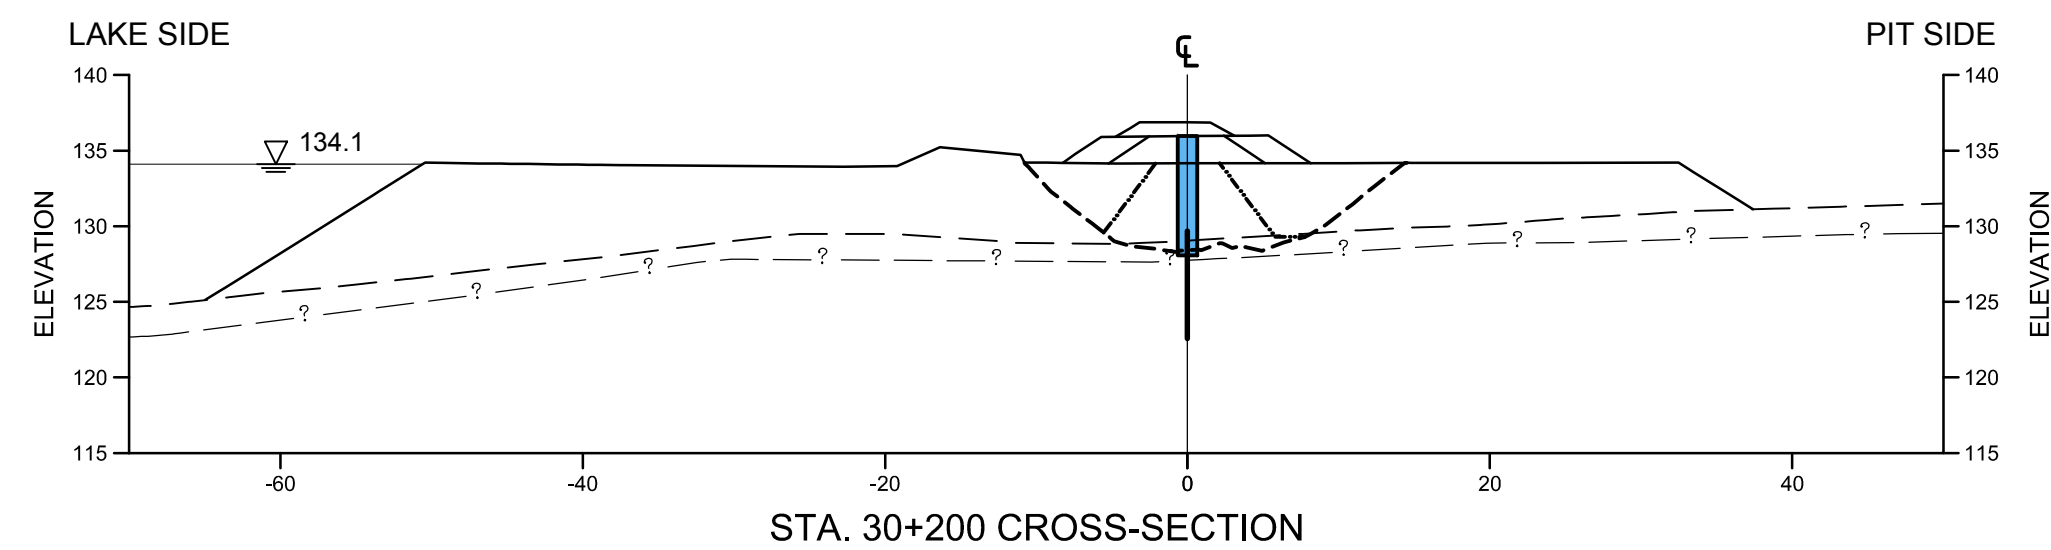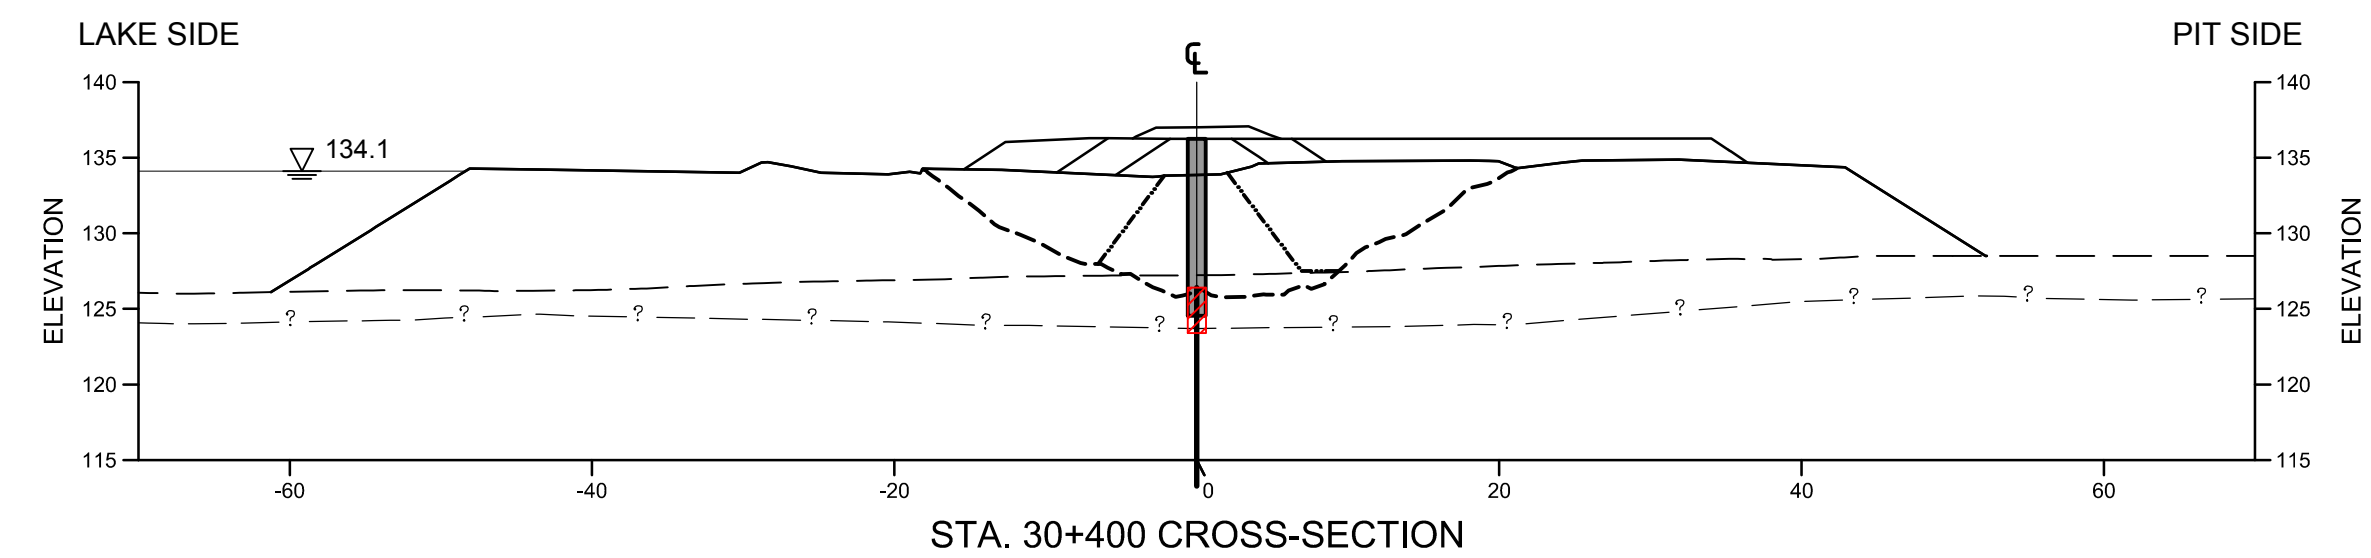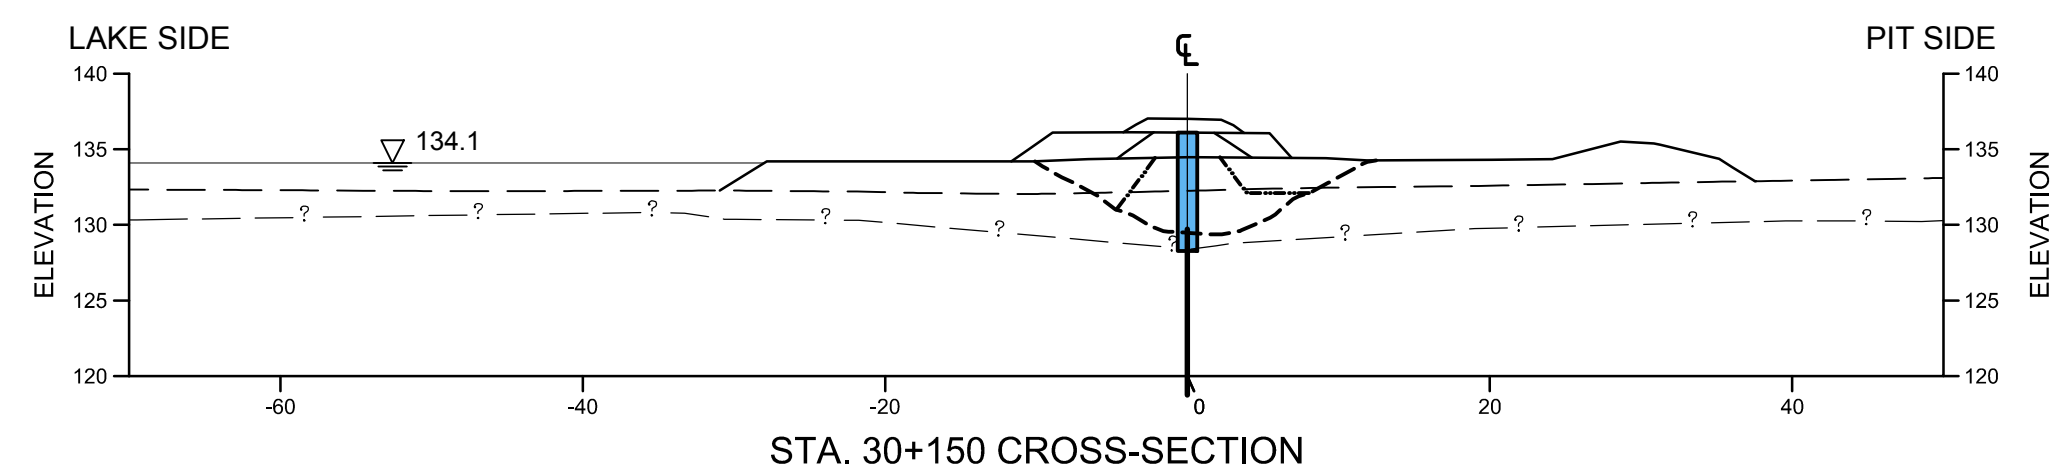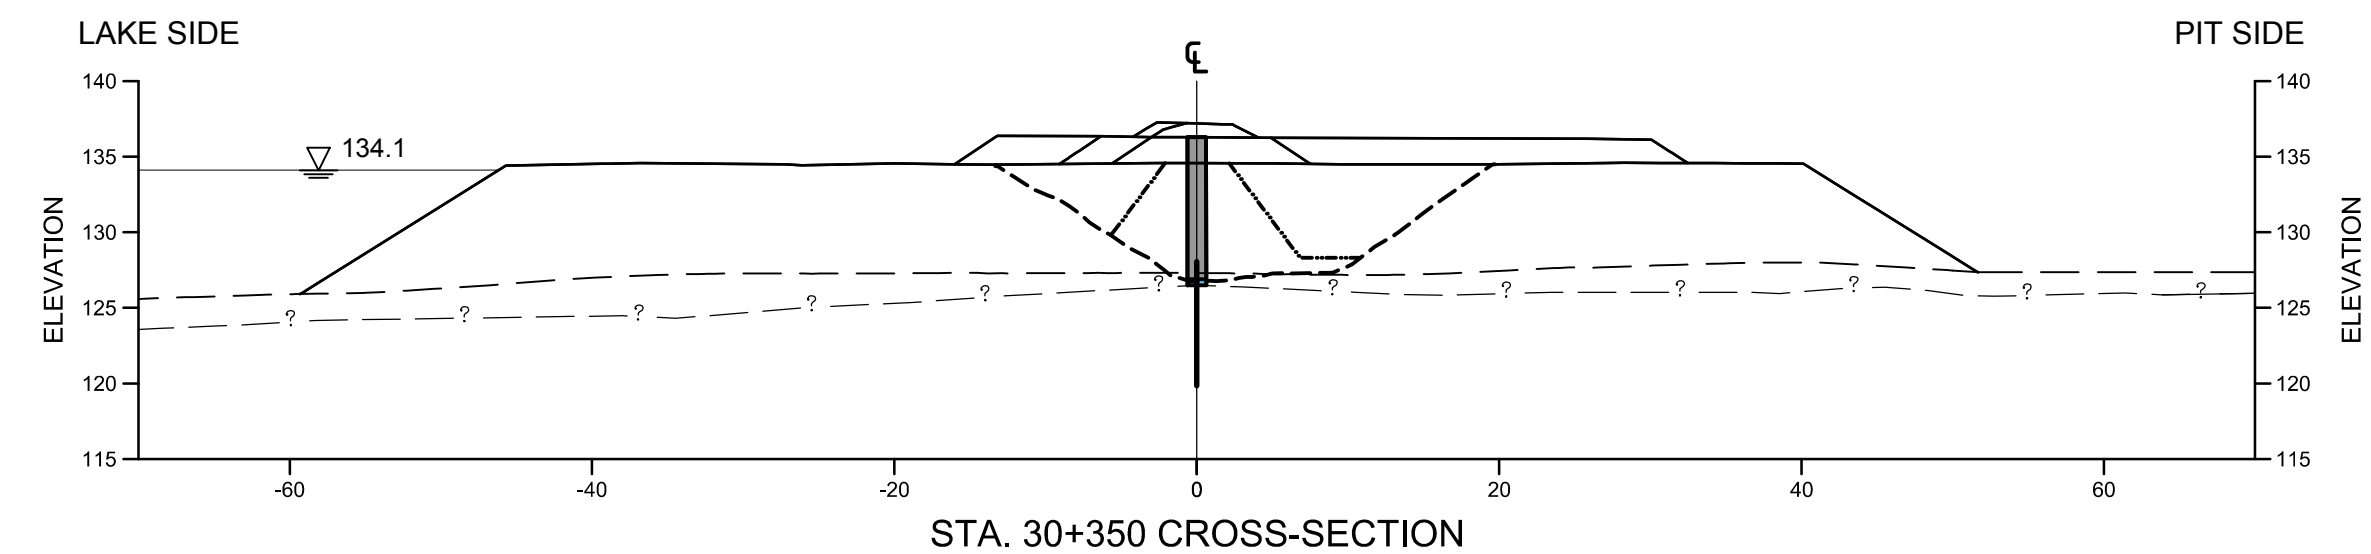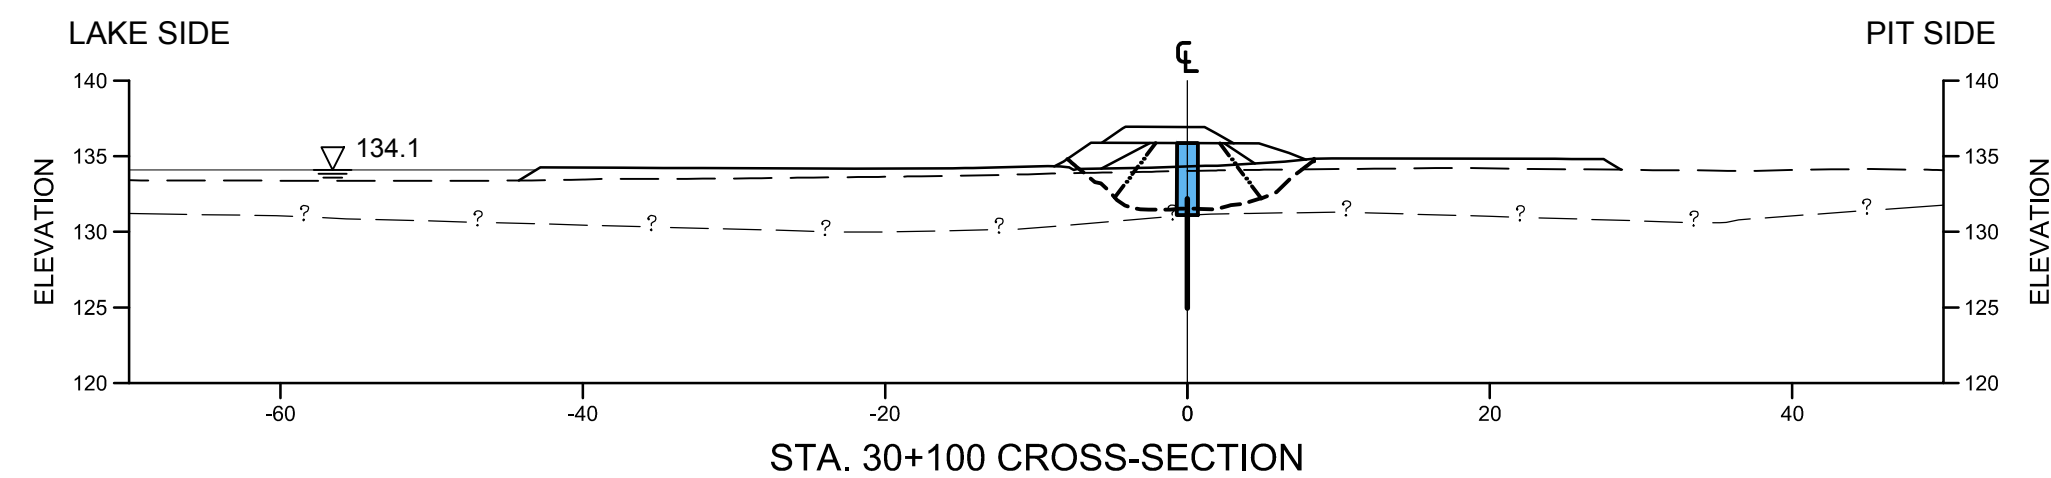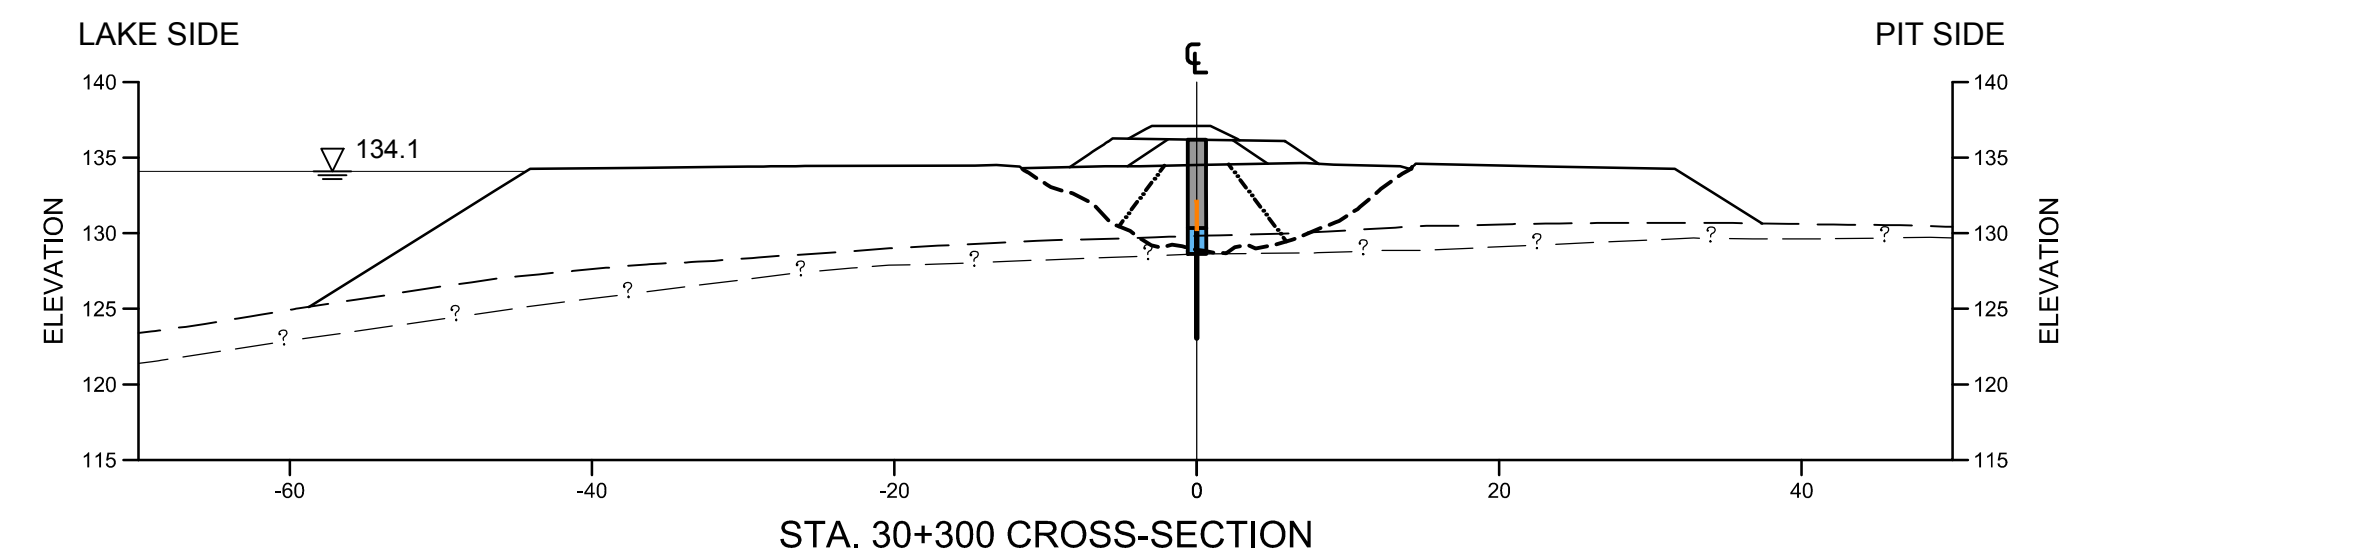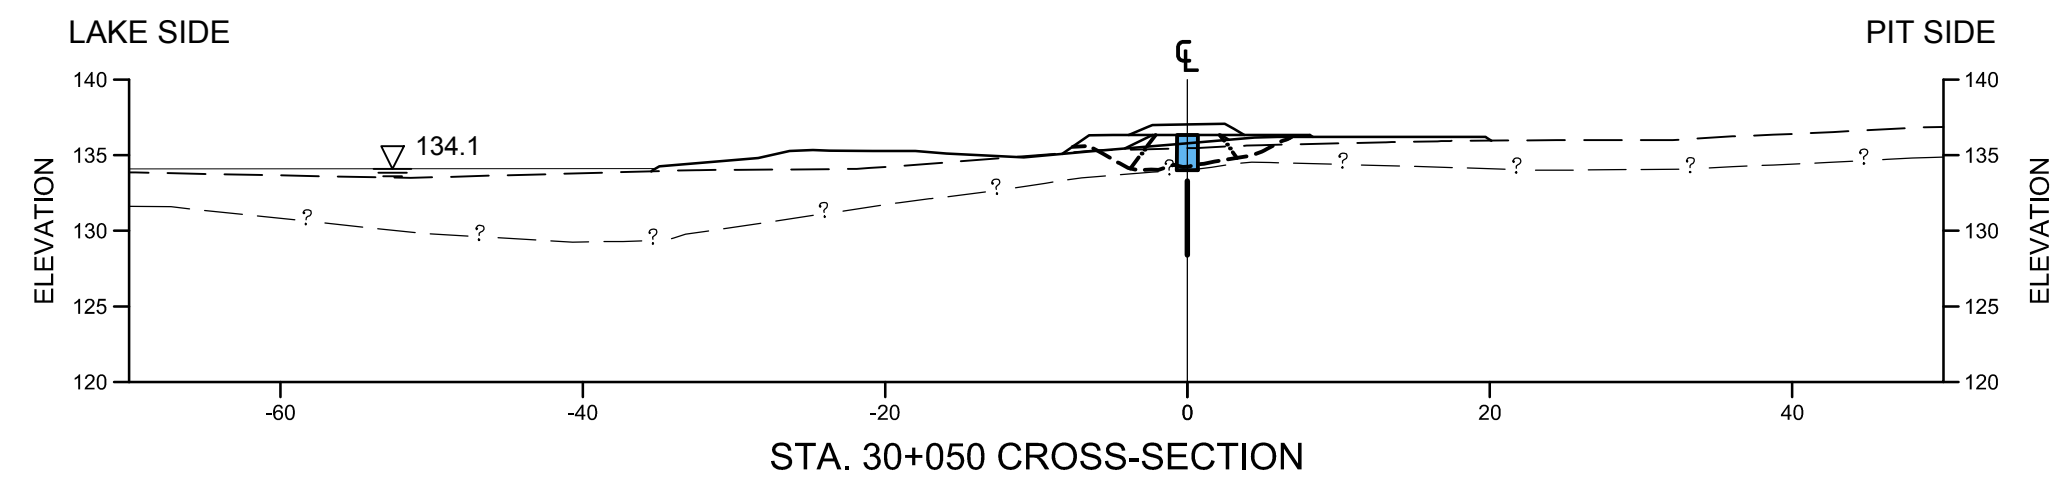


NOTES

- 1) ALL DIMENSIONS ARE IN METRES UNLESS OTHERWISE NOTED.
- 2) ALL ELEVATIONS ARE IN METRES ABOVE SEA LEVEL (MASL), UNLESS OTHERWISE NOTED.
- 3) TOPOGRAPHIC CONTOUR INFORMATION ON LAND SUPPLIED BY AGNICO-EAGLE MINES LIMITED (AEM), MEADOWBANK DIVISION.
- 4) LAKEBED SURFACE BASED ON BATHYMETRIC SURVEYS BY GOLDER ASSOCIATES LTD., 2006 AND DETAILED (0.5m CONTOUR INTERVAL) 2008.
- 5) SURVEYED LAKE SURFACE ELEVATION: THIRD PORTAGE LAKE = 134.1m (2008).
- 6) GEOLOGIC INFORMATION INFERRED BASED ON DRILLING INVESTIGATION RESULTS AND CUTOFF TRENCH EXCAVATION. ACTUAL CONDITIONS MAY VARY.
- 7) ALL SLOPES SHOWN ARE NOMINAL.
- 8) CUTOFF WALL FOUNDED ON BEDROCK SURFACE APPROVED BY THE ENGINEER. ALL ICE RICH MATERIAL (SOIL AND ROCK) WERE EXCAVATED BETWEEN STA. 30+000 TO 30+860.
- 9) BEDROCK AND LAKEBED SURFACES ARE SHOWN AS SMOOTH LINES FOR ILLUSTRATIVE PURPOSES.
- 10) ADDITIONAL ROCKFILL HAS BEEN PLACED ON THE DIKE PLATFORM, NOT SURVEYED.
- 11) GROUTING PLATFORM, THERMAL CAP AND ROCKFILL SURFACING NOT SHOWN ON ALL SECTIONS. ADDITIONAL ROCKFILL HAS BEEN PLACED BUT NOT SURVEYED NOR SHOWN IN SECTION. THERMAL CAP AND ROCKFILL PLACEMENT ARE IN PROGRESS AS OF APRIL 2013.


LEGEND

- | | | | |
|---|---|---|----------------------------|
|  | LAKEBED BATHYMETRY OR LAND SURFACE SURVEY |  | AS-BUILT CUTOFF WALL (CSB) |
|  | AS-BUILT ROCKFILL (SEE NOTE 11) |  | AS-BUILT CUTOFF WALL (SB) |
|  | AS-BUILT TRENCH EXCAVATION |  | AS-BUILT JET GROUT |
|  | INFERRED BEDROCK |  | CSB/SB INTERFACE GROUTING |
|  | AS-BUILT COMPACTION PLATFORM |  | GROUT CURTAIN |
|  | INFERRED CORE BACKFILL | | |

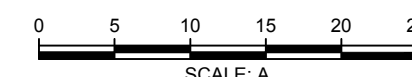
[illegible]

PROJECT	AEM	AGNICO-EAGLE MINES LIMITED MEADOWBANK GOLD PROJECT NUNAVUT
TITLE	BAY-GOOSE DIKE CROSS SECTIONS (NORTH PORTION) (1 OF 2)	


 Golder Associates	PROJECT No. 08-1428-0028/4200	FILE No. 0814280028-4200_2_14
	DESIGN FE 17APR09	SCALE AS SHOWN REV. 2
	CADD JK 29APR09	4200-14
	CHECK DRW 08MAY09	
	REVIEW MRJ 08MAY09	

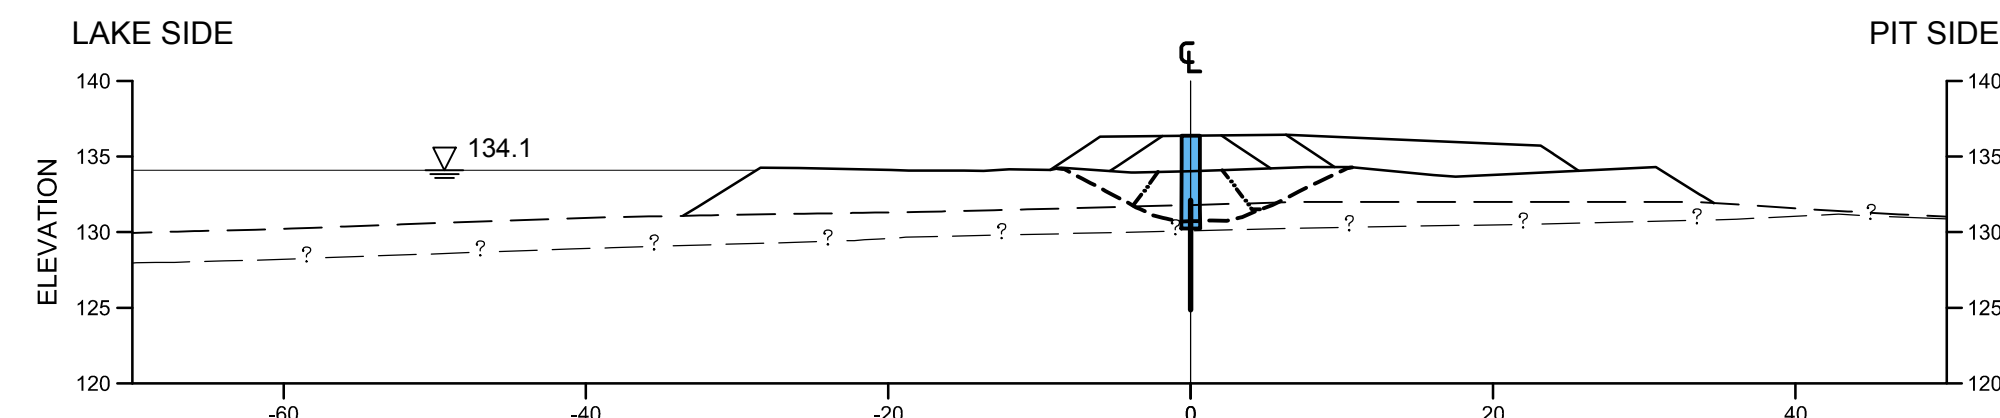


STA. 30+550 CROSS-SECTION

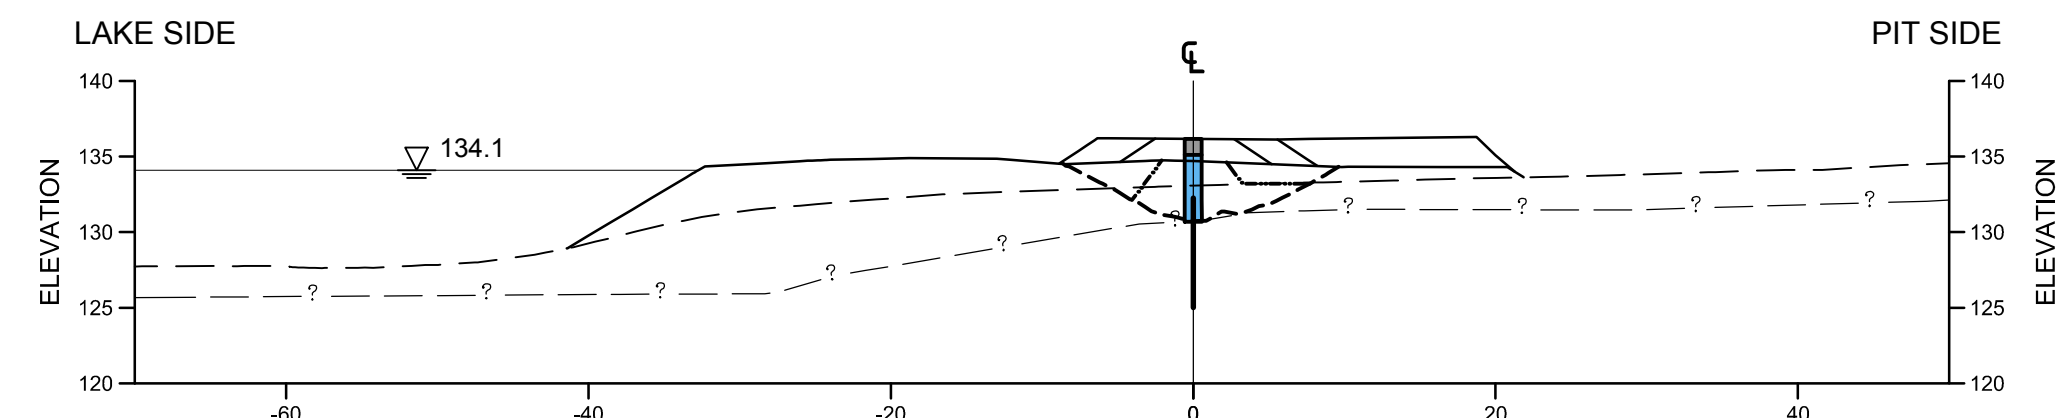


STA. 30+800 CROSS-SECTION

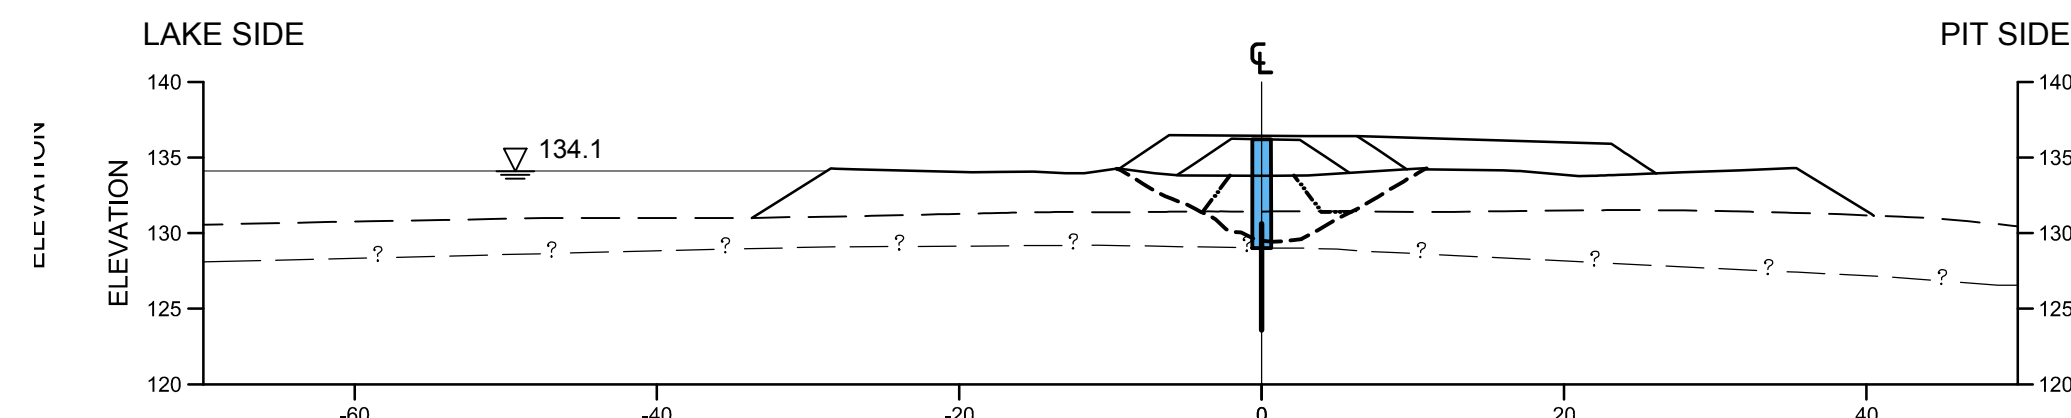


STA. 30+600 CROSS-SECTION

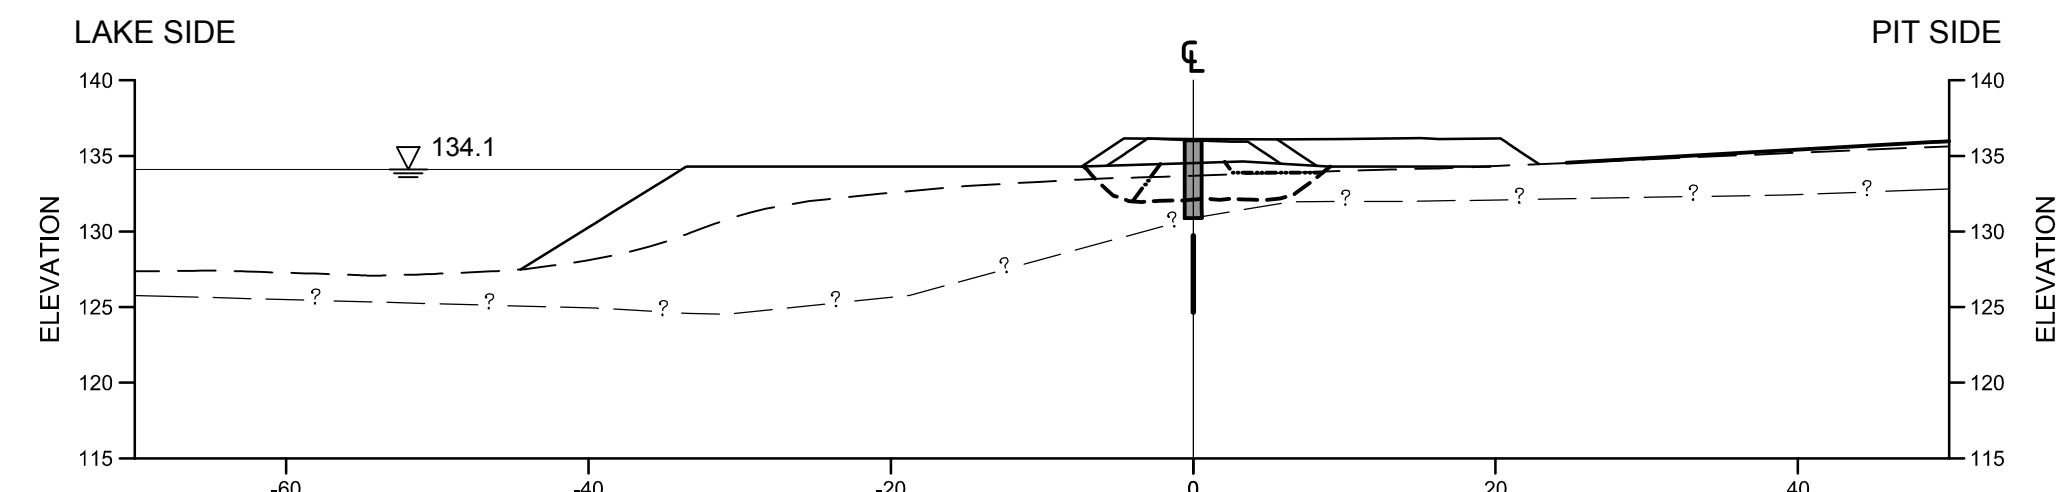


STA. 30+850 CROSS-SECTION

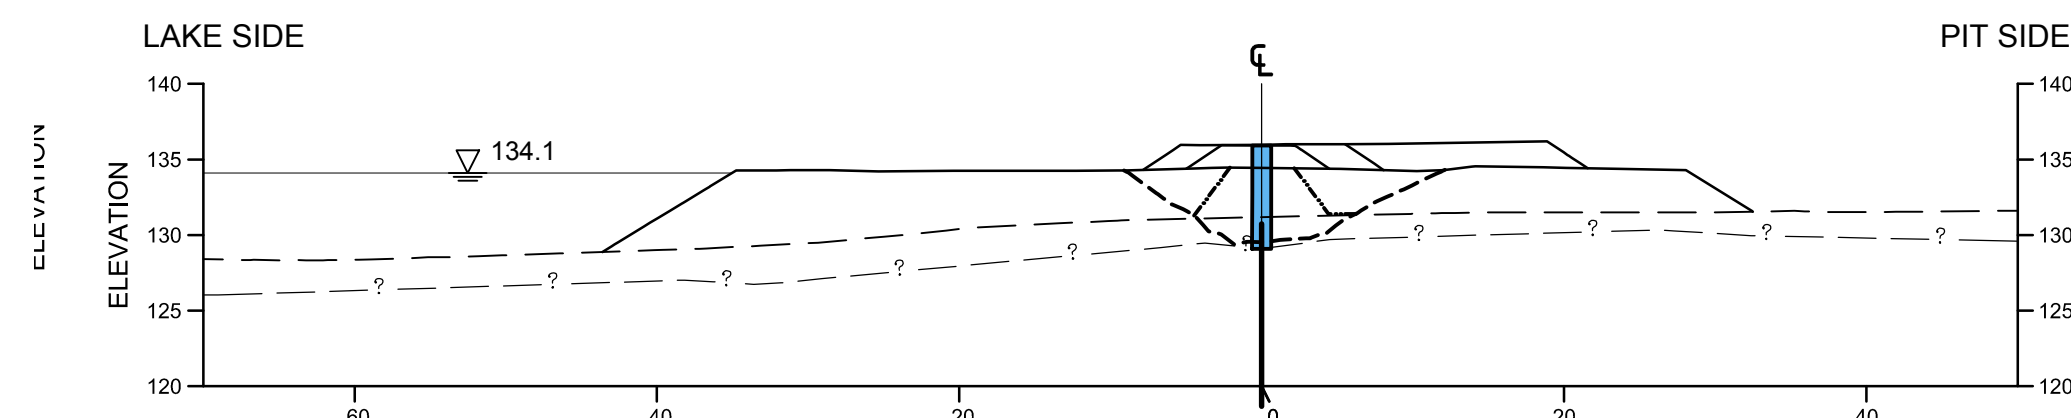

STA. 30+650 CROSS-SECTION

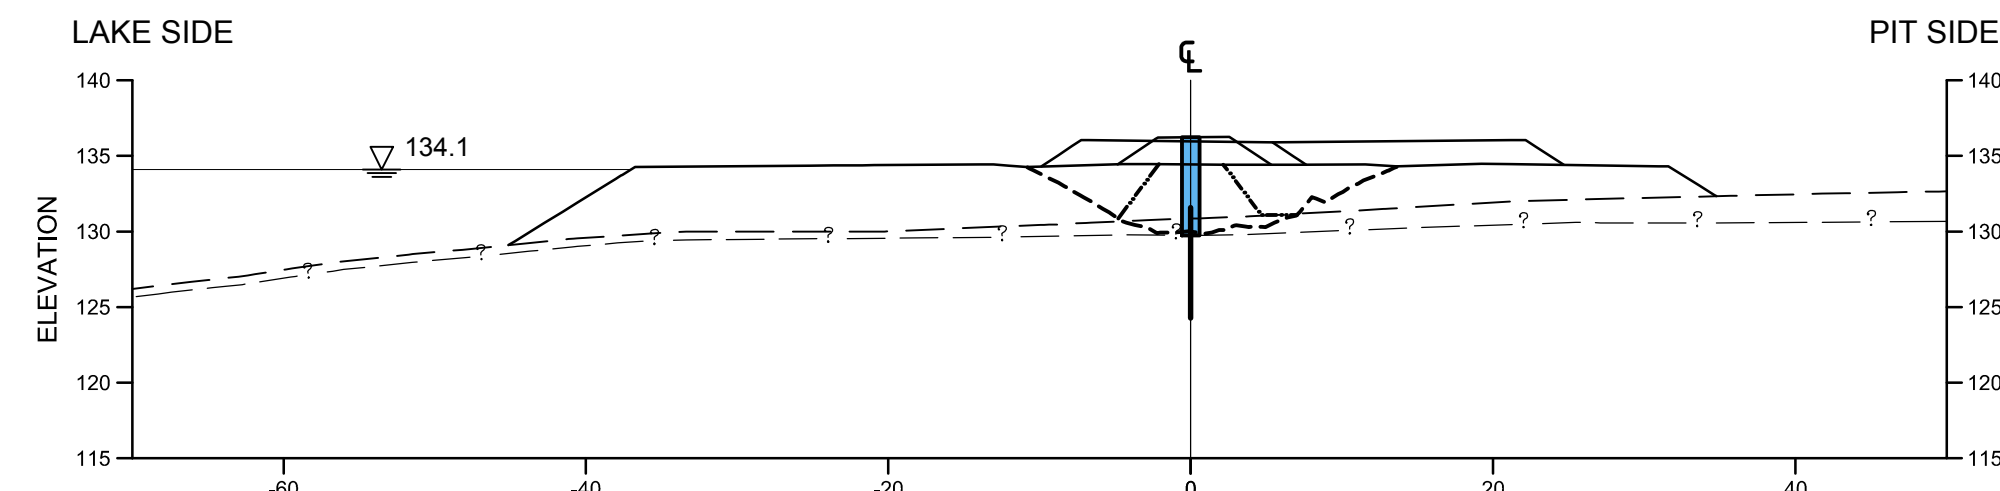

STA. 30+700 CROSS-SECTION

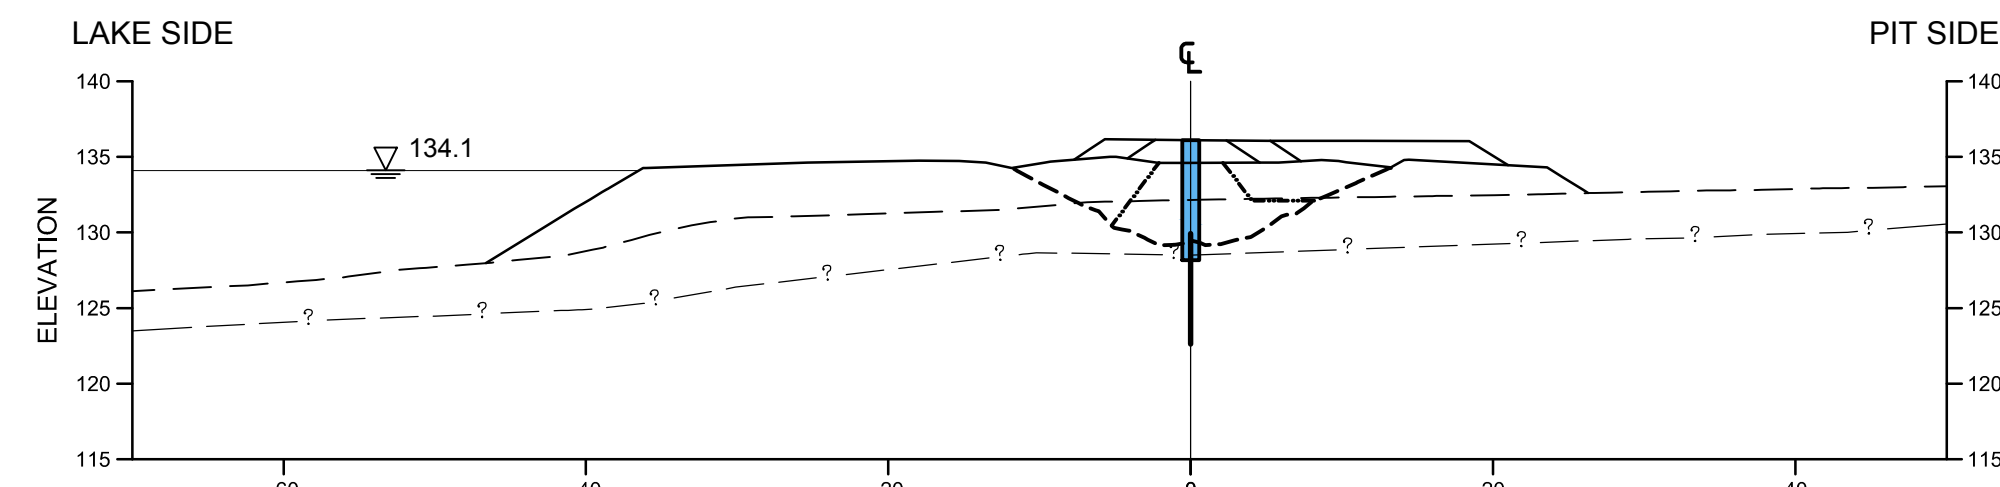


STA. 30+750 CROSS-SECTION

NOTES


- 1) ALL DIMENSIONS ARE IN METRES UNLESS OTHERWISE NOTED.
- 2) ALL ELEVATIONS ARE IN METRES ABOVE SEA LEVEL (MASL), UNLESS OTHERWISE NOTED.
- 3) TOPOGRAPHIC CONTOUR INFORMATION ON LAND SUPPLIED BY AGNICO-EAGLE MINES LIMITED (AEM), MEADOWBANK DIVISION.
- 4) LAKEBED SURFACE BASED ON BATHYMETRIC SURVEYS BY GOLDER ASSOCIATES LTD., 2006 AND DETAILED (0.5m CONTOUR INTERVAL) 2008.
- 5) SURVEYED LAKE SURFACE ELEVATION: THIRD PORTAGE LAKE = 134.1m (2008).
- 6) GEOLOGIC INFORMATION INFERRED BASED ON DRILLING INVESTIGATION RESULTS AND CUTOFF TRENCH EXCAVATION. ACTUAL CONDITIONS MAY VARY.
- 7) ALL SLOPES SHOWN ARE NOMINAL.
- 8) CUTOFF WALL FOUNDED ON BEDROCK SURFACE APPROVED BY THE ENGINEER. ALL ICE RICH MATERIAL (SOIL AND ROCK) WERE EXCAVATED BETWEEN STA. 30+000 TO 30+860.
- 9) BEDROCK AND LAKEBED SURFACES ARE SHOWN AS SMOOTH LINES FOR ILLUSTRATIVE PURPOSES.
- 10) ADDITIONAL ROCKFILL HAS BEEN PLACED ON THE DIKE PLATFORM, NOT SURVEYED.
- 11) GROUTING PLATFORM, THERMAL CAP AND ROCKFILL SURFACING NOT SHOWN ON ALL SECTIONS. ADDITIONAL ROCKFILL HAS BEEN PLACED BUT NOT SURVEYED NOR SHOWN IN SECTION. THERMAL CAP AND ROCKFILL PLACEMENT ARE IN PROGRESS AS OF APRIL 2013.

LEGEND

- | | | | |
|---|---|---|----------------------------|
|  | LAKEBED BATHYMETRY OR LAND SURFACE SURVEY |  | AS-BUILT CUTOFF WALL (CSB) |
|  | AS-BUILT ROCKFILL (SEE NOTE 11) |  | AS-BUILT CUTOFF WALL (SB) |
|  | AS-BUILT TRENCH EXCAVATION |  | AS-BUILT JET GROUT |
|  | INFERRED BEDROCK |  | GROUT CURTAIN |
|  | AS-BUILT COMPACTION PLATFORM | | |
|  | INFERRED CORE BACKFILL | | |

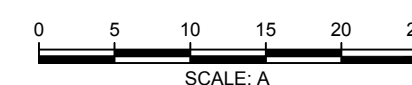
[illegible]

PROJECT	 AGNICO-EAGLE MINES LIMITED MEADOWBANK GOLD PROJECT NUNAVUT
TITLE	BAY-GOOSE DIKE CROSS SECTIONS (NORTH PORTION) (2 OF 2)

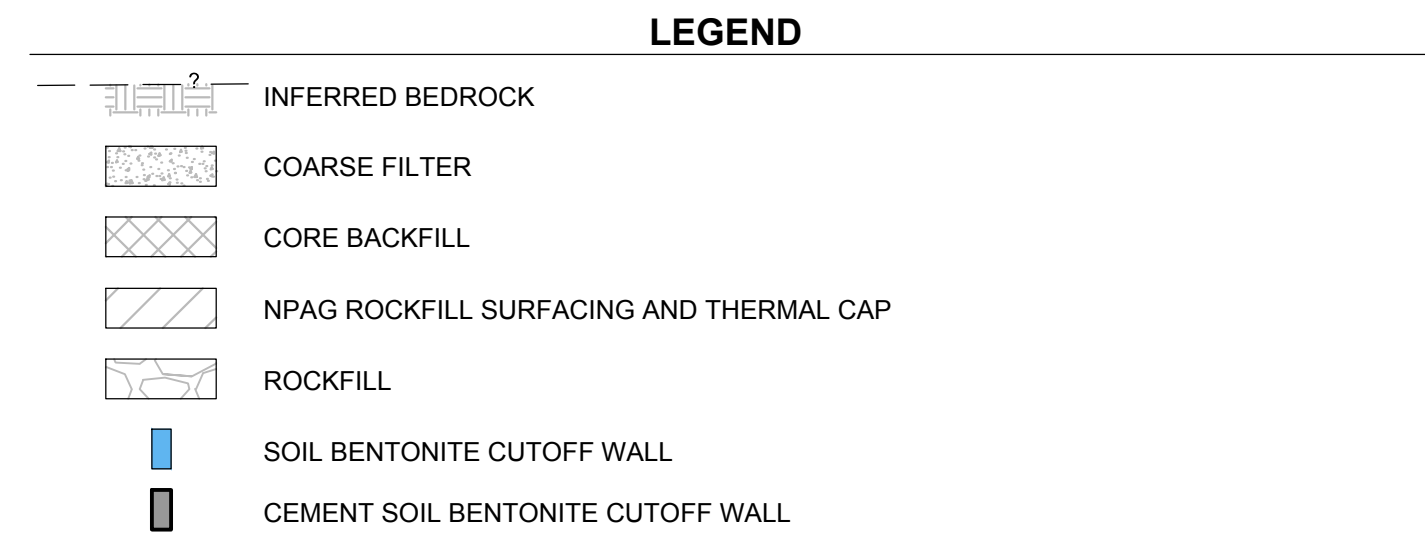

NOTES

- 1) ALL DIMENSIONS ARE IN METRES UNLESS OTHERWISE NOTED.
- 2) ALL ELEVATIONS ARE IN METRES ABOVE SEA LEVEL (MASL), UNLESS OTHERWISE NOTED.
- 3) LAKEBED SURFACE BASED ON BATHYMETRIC SURVEY BY GOLDER ASSOCIATES LTD. 2008.
- 4) ALL SLOPES SHOWN ARE NOMINAL VALUES.
- 5) GEOCHEMICAL CLASSIFICATION OF NPAG MATERIALS WAS THE RESPONSIBILITY OF AEM.
- 6) EXCAVATION TO COMPETENT BEDROCK SURFACE APPROVED BY ENGINEER.
- 7) ALL ICE RICH MATERIAL BENEATH THE CUTOFF WALL WAS EXCAVATED FROM STA. 30+000 TO 30+860.
- 8) BEDROCK AND LAKEBED SURFACES ARE SHOWN AS SMOOTH LINES FOR ILLUSTRATIVE PURPOSES.
- 9) MATERIAL PLACEMENT ANGLES FOR THE COARSE FILTER AND CORE BACKFILL ARE APPROXIMATE.

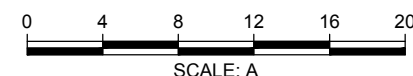


C **TYPICAL SECTION - BEDROCK ELEVATION BELOW 127.6**
4200-05 SCALE: A

[illegible]

PROJECT	 AGNICO-EAGLE MINES LIMITED MEADOWBANK GOLD PROJECT NUNAVUT				
	BAY-GOOSE DIKE NORTH PORTION TYPICAL SECTION				
 Golder Associates	PROJECT No. 08-1428-0028-4200			FILE No. 0814280028-4200_1-17	
	DESIGN	FE	29JUL09	SCALE	AS SHOWN
	CADD	JK	29JUL09	REV.	1
	CHECK	FE	31JUL09	4200-17	
	REVIEW	MRJ	31JUL09		

Drawing File: N:\User-graphics\Projects\4200\1428\09-1428-5007A\Drawings\4200-18.dwg Layout:4200-18 Wednesday, December 26, 2012 11:27:28 AM By: TKlassen

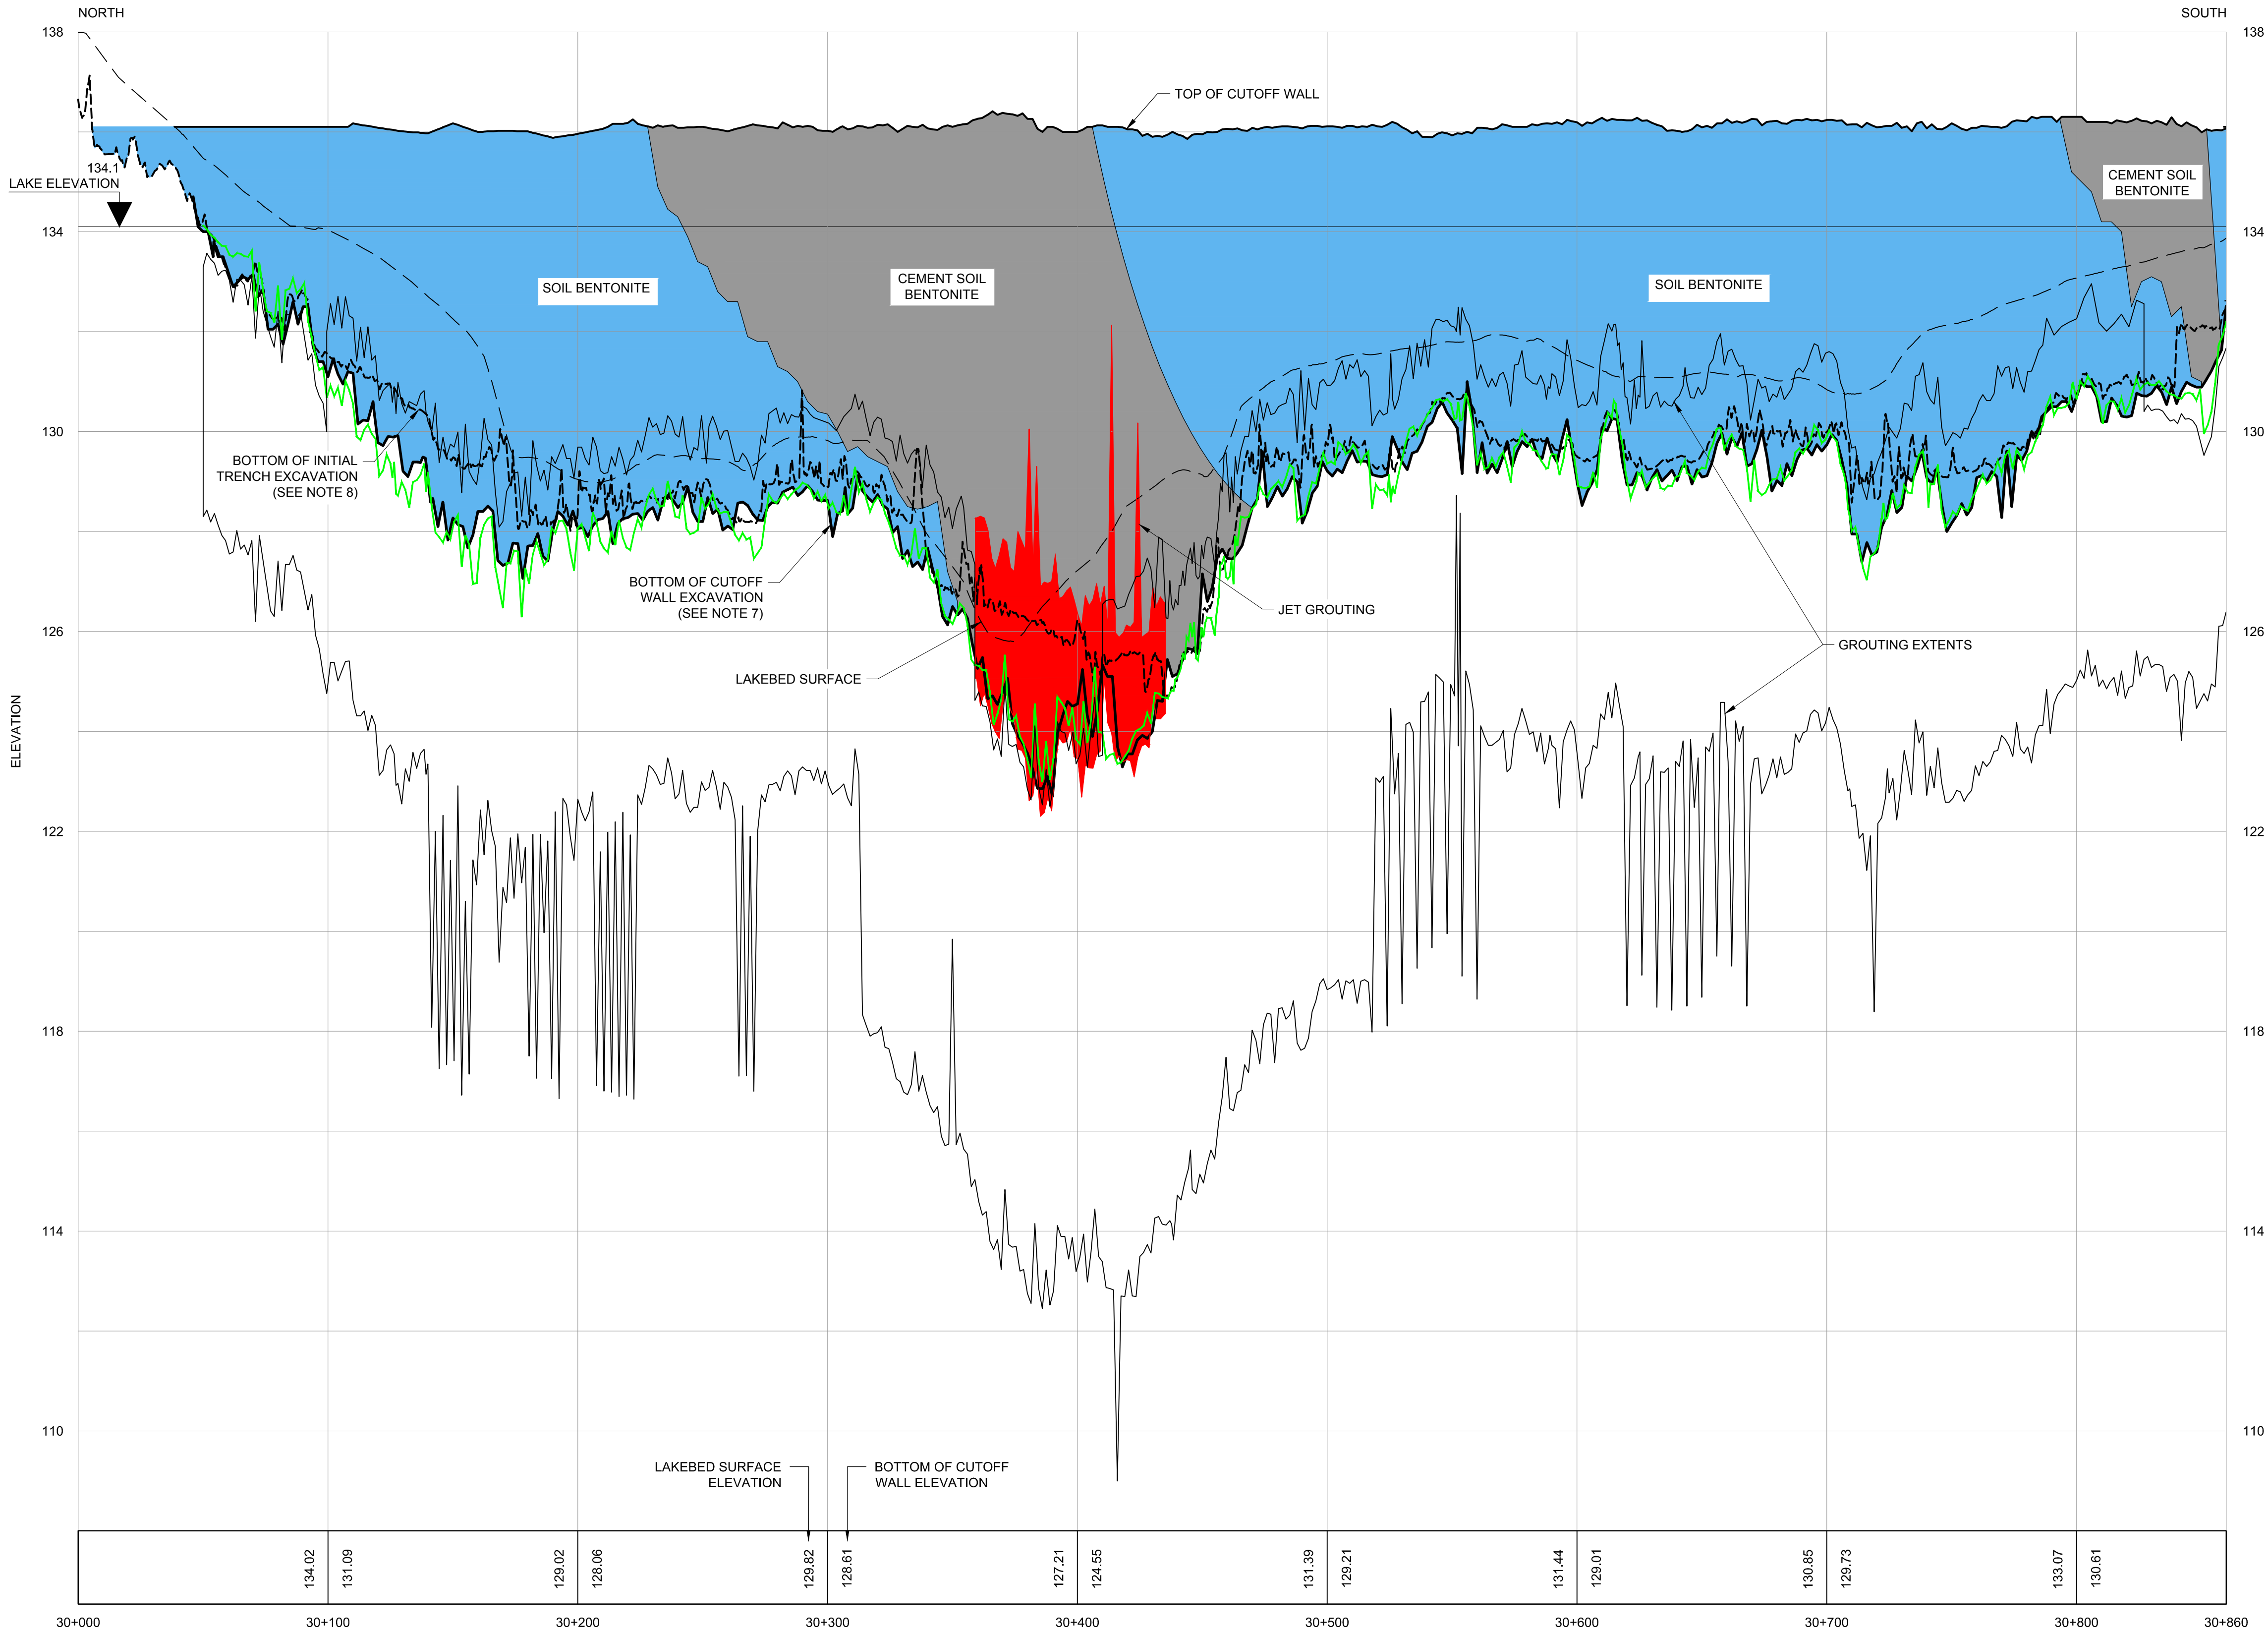

LEGEND

LAKEBED SURFACE

TOP OF CUTOFF WALL

BOTTOM OF CUTOFF WALL

INITIAL TRENCH EXCAVATION SURFACE

GROUTING EXTENT

INFERRED BEDROCK (DRILLING/JET GROUTING)

CEMENT SOIL BENTONITE

SOIL BENTONITE

JET GROUTING

- NOTES**
- 1) ALL DIMENSIONS ARE IN METERS UNLESS OTHERWISE NOTED.

2) ALL ELEVATIONS ARE IN METERS ABOVE SEA LEVEL (MASL), UNLESS OTHERWISE NOTED.

3) TOPOGRAPHIC CONTOUR INFORMATION ON LAND SUPPLIED BY AGNICO-EAGLE MINES LIMITED (AEM), MEADOWBANK DIVISION.

4) LAKEBED SURFACE BASED ON OCTOBER 2008 BATHYMETRIC SURVEY.


5) LAKE CONTOURS ARE BASED ON SURVEYED LAKE SURFACE ELEVATIONS: THIRD PORTAGE LAKE = 134.1m (2008)

6) REFER TO DWG 4300-26 FOR SOUTHERN PORTION AS-BUILT LONGITUDINAL SECTION.

7) CUTOFF WALL TRENCH EXCAVATION TO COMPETENT BEDROCK SURFACE APPROVED BY ENGINEER FOR NORTHERN PORTION OF THE DIKE (STA. 30+000 TO 31+860). EXCAVATION DEPTH BASED ON PLUMB-BOB SURVEY AT 2m INCREMENTS.

8) BOTTOM OF INITIAL TRENCH EXCAVATION BASED ON BATHYMETRIC SURVEY DATA OBTAINED DURING CONSTRUCTION.

9) BEDROCK ELEVATION INFERRED BASED ON INFORMATION FROM CASING INSTALLATION FOR GROUTING AND JET GROUTING.

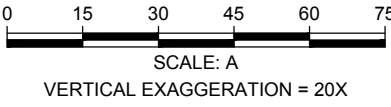

DRAWING NO.		REFERENCES		REV	DATE	DES	REVISION DESCRIPTION	CADD	CHK	RVW	STAMP		
				1	15DEC12	KD	AS-BUILT	JD	GRB	FE			
				2	17JUL09	FE	ISSUED FOR CONSTRUCTION	MSH	FE	MRJ			
				3	22MAY09	FE	REVISED ISSUED FOR TENDER	MSH	DRW	MSH			
				4	08MAY09	FE	ISSUED FOR TENDER	MSH	DRW	MRJ			
				5	02FEB09	JU	ISSUED FOR REVIEW	EA	FE	JCC			
				6	24DEC08	JU	ISSUED FOR REVIEW	EA	JU	JCC			

PROJECT

AEM

AGNICO-EAGLE MINES LIMITED
MEADOWBANK GOLD PROJECT
NUNAVUT

TITLE

BAY-GOOSE DIKE
LONGITUDINAL SECTION (NORTH PORTION)

Golder Associates

PROJECT No.

08-1428-0028/4200

FILE No.

0814280028-4200_1_18

DESIGN

JU

04JUL08

CADD

EA

09DEC08

CHECK

JU

24DEC08

REVIEW

JCC

24DEC08


SCALE

AS SHOWN

REV.

1

4200-18

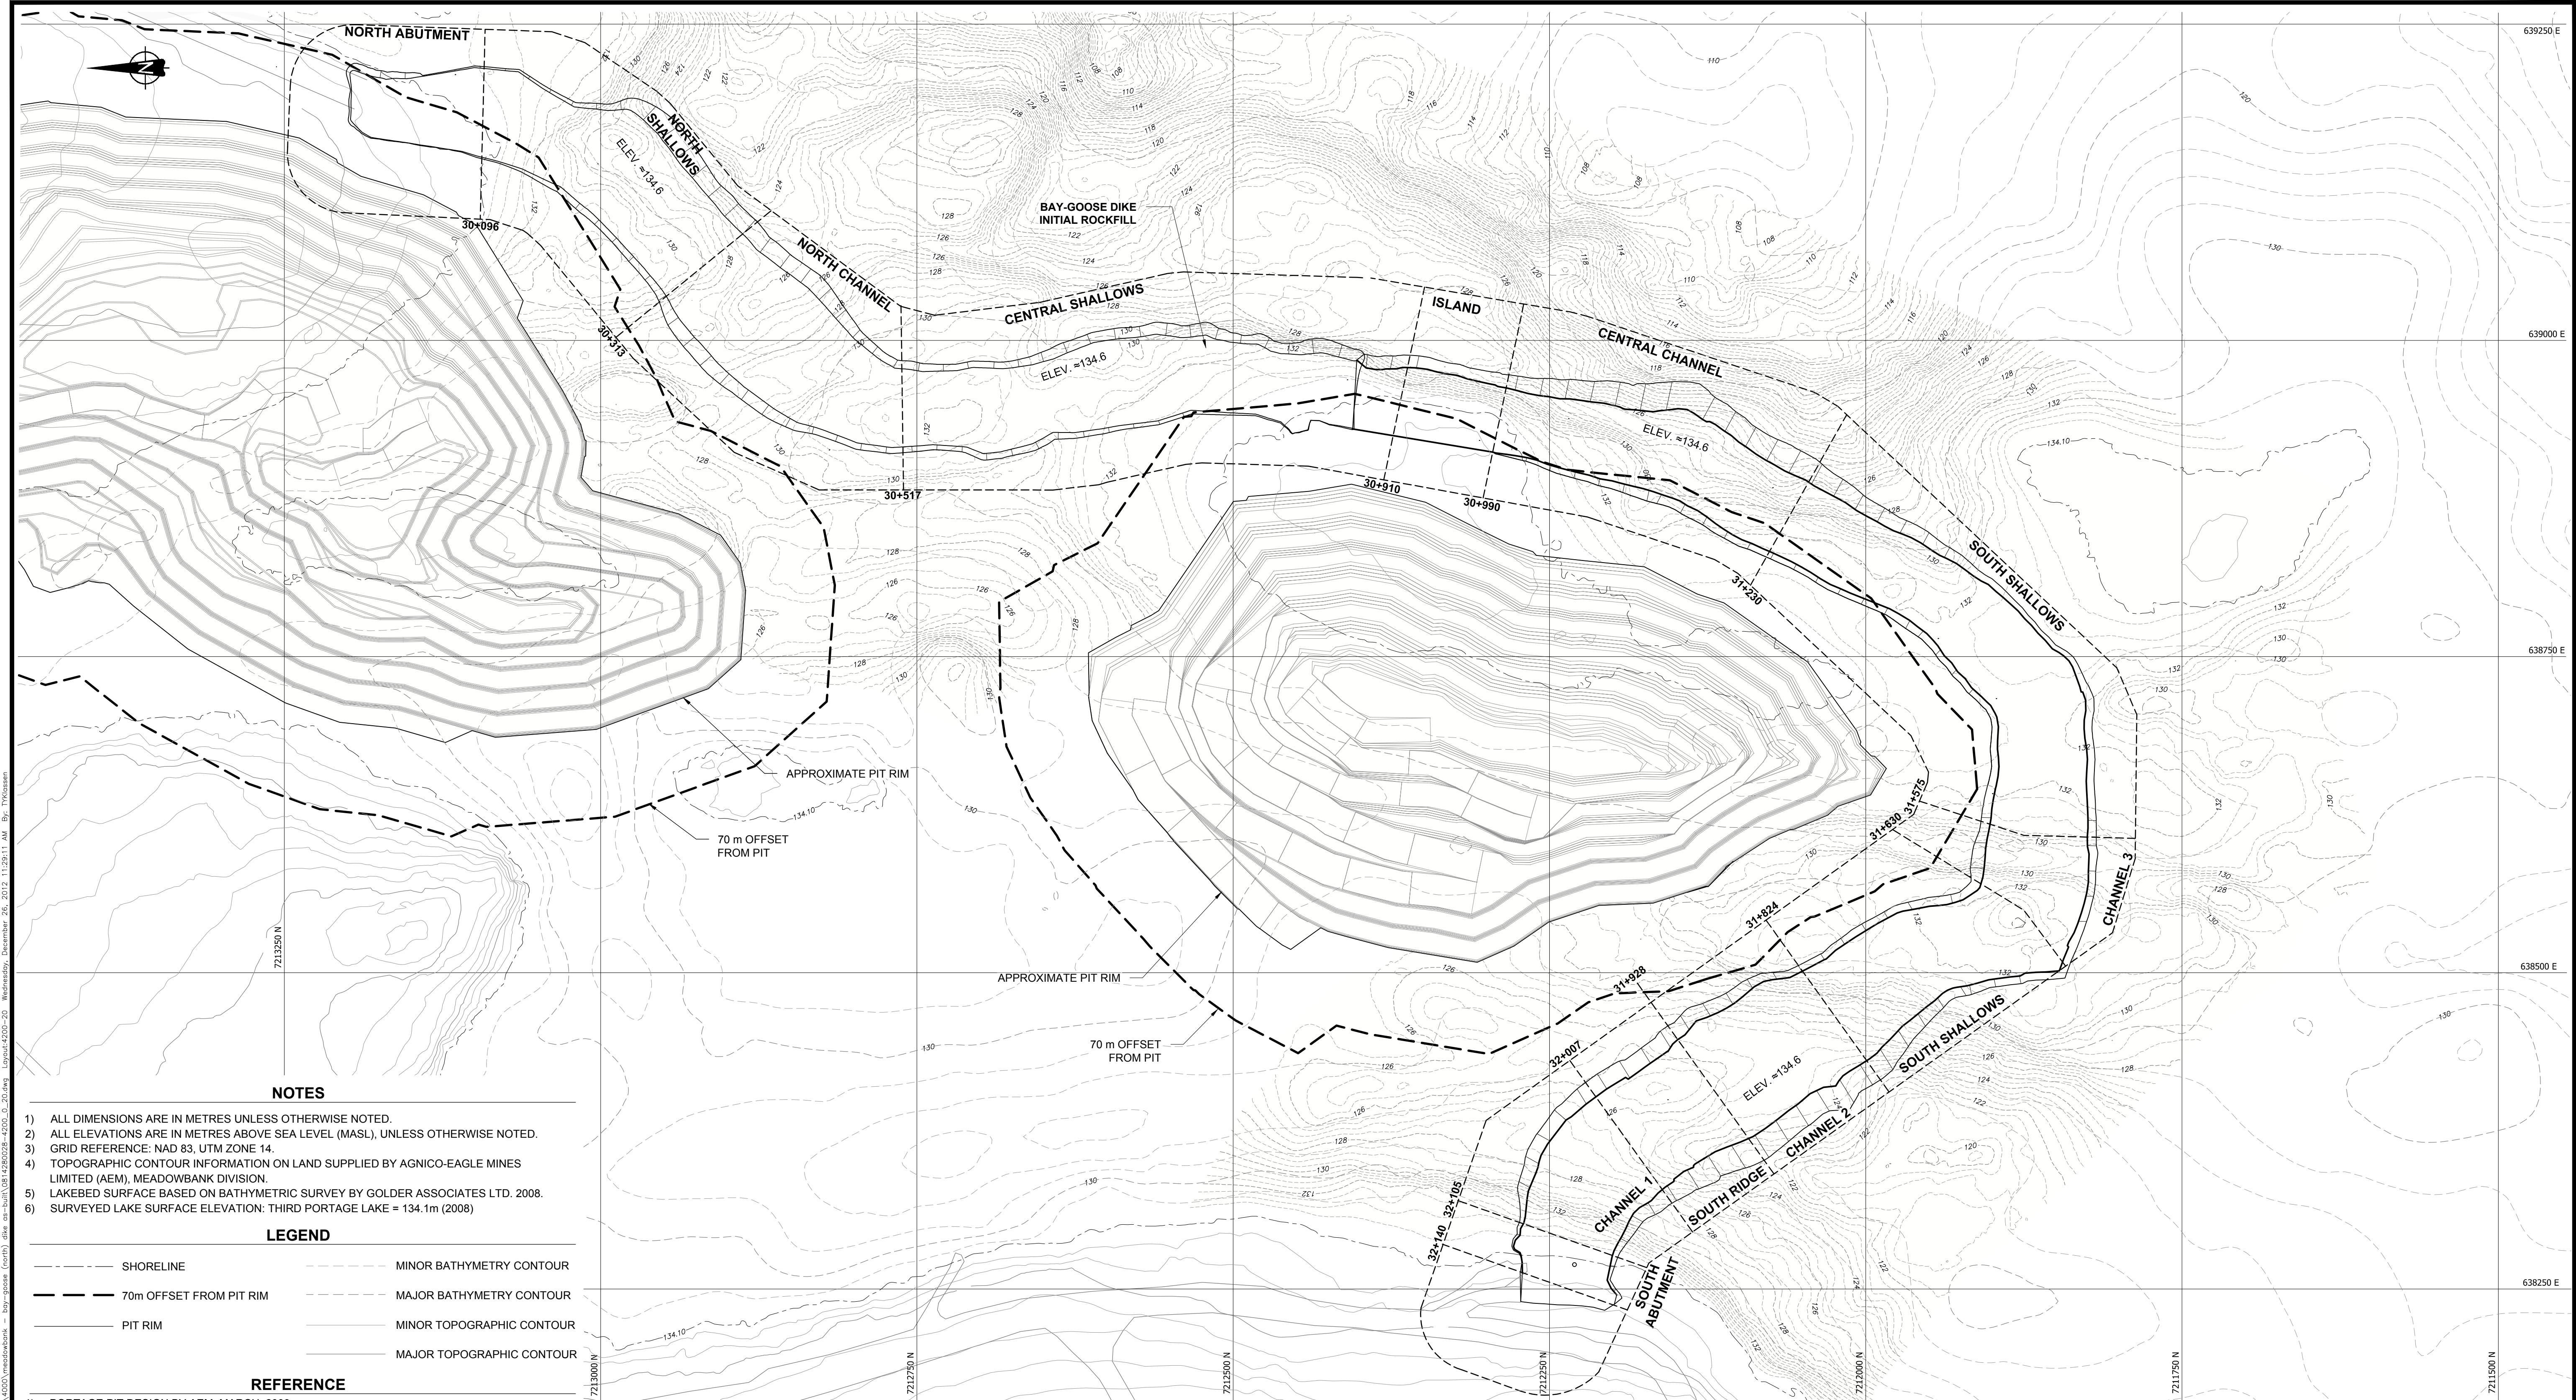

NOTES


- 1) ALL DIMENSIONS ARE IN METRES UNLESS OTHERWISE NOTED.
- 2) ALL ELEVATIONS ARE IN METRES ABOVE SEA LEVEL (MASL), UNLESS OTHERWISE NOTED.
- 3) GRID REFERENCE: NAD 83, UTM ZONE 14.
- 4) TOPOGRAPHIC CONTOUR INFORMATION ON LAND SUPPLIED BY AGNICO-EAGLE MINES LIMITED (AEM), MEADOWBANK DIVISION.
- 5) LAKEBED SURFACE BASED ON BATHYMETRIC SURVEY BY GOLDER ASSOCIATES LTD. 2008.
- 6) SURVEYED LAKE SURFACE ELEVATION: THIRD PORTAGE LAKE = 134.1m (2008)

LEGEND

- | | | | |
|-------|-------------------------|-------|---------------------------|
| ----- | SHORELINE | ----- | MINOR BATHYMETRY CONTOUR |
| ----- | 70m OFFSET FROM PIT RIM | ----- | MAJOR BATHYMETRY CONTOUR |
| ----- | PIT RIM | ----- | MINOR TOPOGRAPHIC CONTOUR |
| ----- | | ----- | MAJOR TOPOGRAPHIC CONTOUR |


REFERENCE

- 1) PORTAGE PIT DESIGN BY AEM, MARCH, 2009.
- 2) GOOSE ISLAND PIT DESIGN BY AEM, MARCH, 2009.
- 3) ROAD AND MINE FACILITIES PROVIDED BY AEM, JANUARY, 2009.

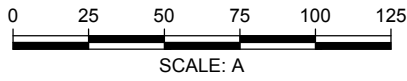

	PROJECT				AGNICO-EAGLE MINES LIMITED MEADOWBANK GOLD PROJECT NUNAVUT			
	TITLE				BAY-GOOSE DIKE GROUTING WORK AREAS - PLAN			
					4200-20			
PROJECT No.		08-1428-0028/4200		FILE No.		0814280028-4200_0_20		
DESIGN	GRB	07MAY09		SCALE	AS SHOWN	REV.	1	
CADD	MSH	07MAY09		CHECK	DRW	08MAY09		
REVIEW	MRJ	08MAY09						

Drawing File: N:\aem-graphics\Projects\2009\1428\08-1428-5007\Grouting\4200\meadowbank - bay-goose (corr).dwg as-built\0814280028-4200_0_20.dwg Layout: 4200-20 Wednesday, December 26, 2012 11:28:11 AM By: TKG:asem

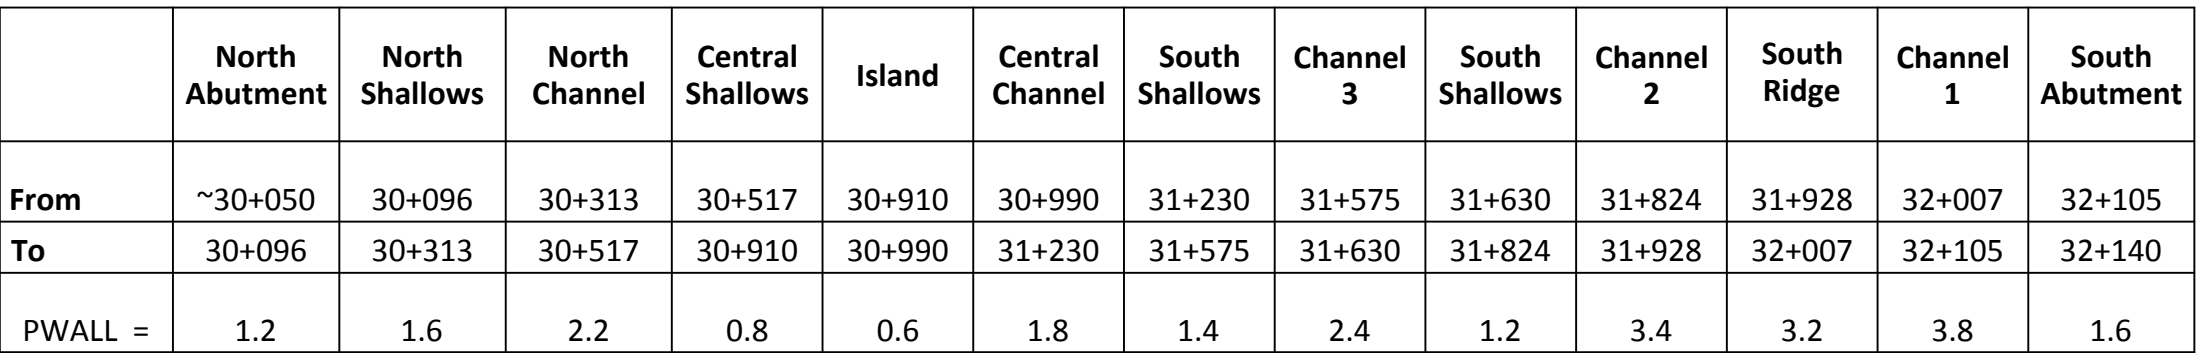

LEGEND

- | | |
|---|------------------|
| --- | LAKE BED SURFACE |
| --- | BEDROCK SURFACE |
|  | JET GROUTING |
|  | CONTACT GROUTING |
|  | CSB/SB GROUTING |
|  | BEDROCK GROUTING |

PROJECT

AEM

AGNICO-EAGLE MINES LIMITED
MEADOWBANK GOLD PROJECT
NUNAVUT


TITLE

BAY-GOOSE DIKE
GROUTING WORK AREAS - PROFILE



Golder
Associates

PROJECT No. 08-1428-0028/4200		FILE No. 0814280028-4200_0_21	
DESIGN	JU	04JUL08	4200-21
CADD	EA	09DEC08	
CHECK	JU	24DEC08	
REVIEW	JCC	24DEC08	
SCALE		AS SHOWN	REV. 1

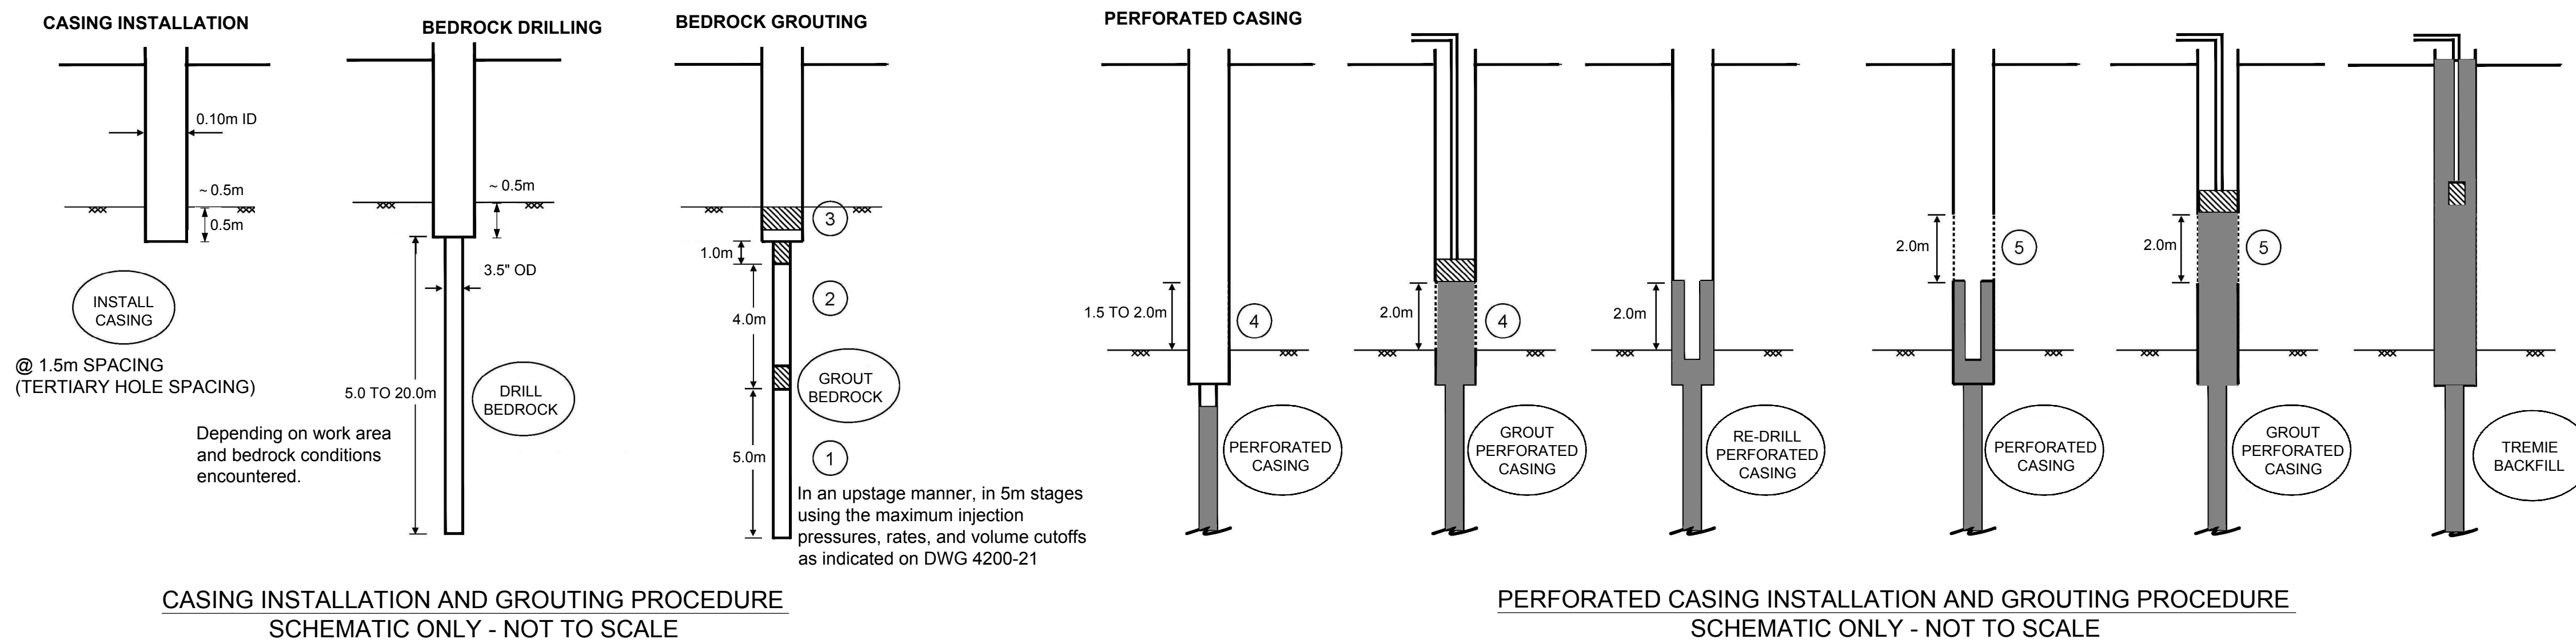





LEGEND

- | | |
|---|---------|
| 1 | STAGE 1 |
| 2 | STAGE 2 |
| 3 | STAGE 3 |
| 4 | STAGE 4 |
| 5 | STAGE 5 |

NOTES

- 1) ALL DRILLING AND GROUTING ACTIVITIES WERE CARRIED OUT AS PER SECTION S7 OF THE SPECIFICATIONS AND SITE INSTRUCTIONS S1-001, AND S1-003 THROUGH S1-011, INCLUSIVE.
- 2) AS SHOWN ON DWG. 4200-21 AND 4200-22, THE NUMBER OF STAGES GROUTED DEPENDED ON THE DEPTH OF WATER, BEDROCK CONDITIONS ENCOUNTERED, AND THICKNESS OF SOIL MATERIALS. IF ANY, LEFT IN PLACE BENEATH THE CUTOFF WALL DURING CONSTRUCTION.


[illegible]

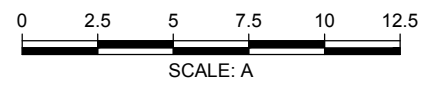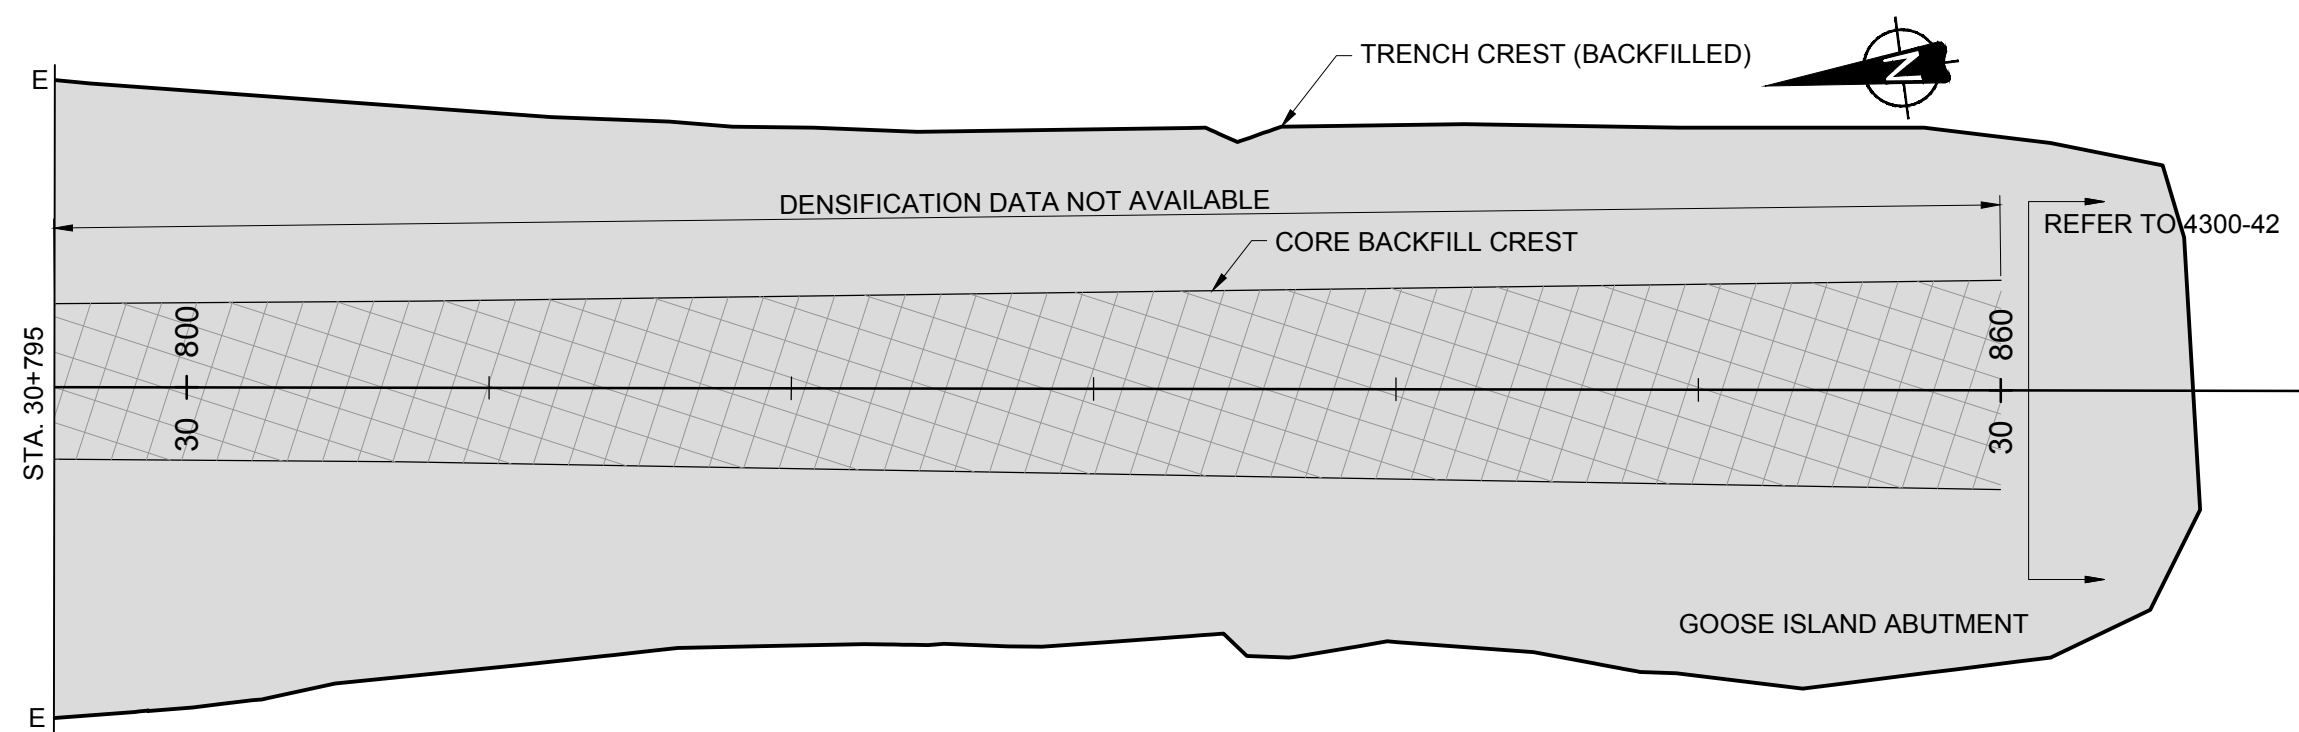
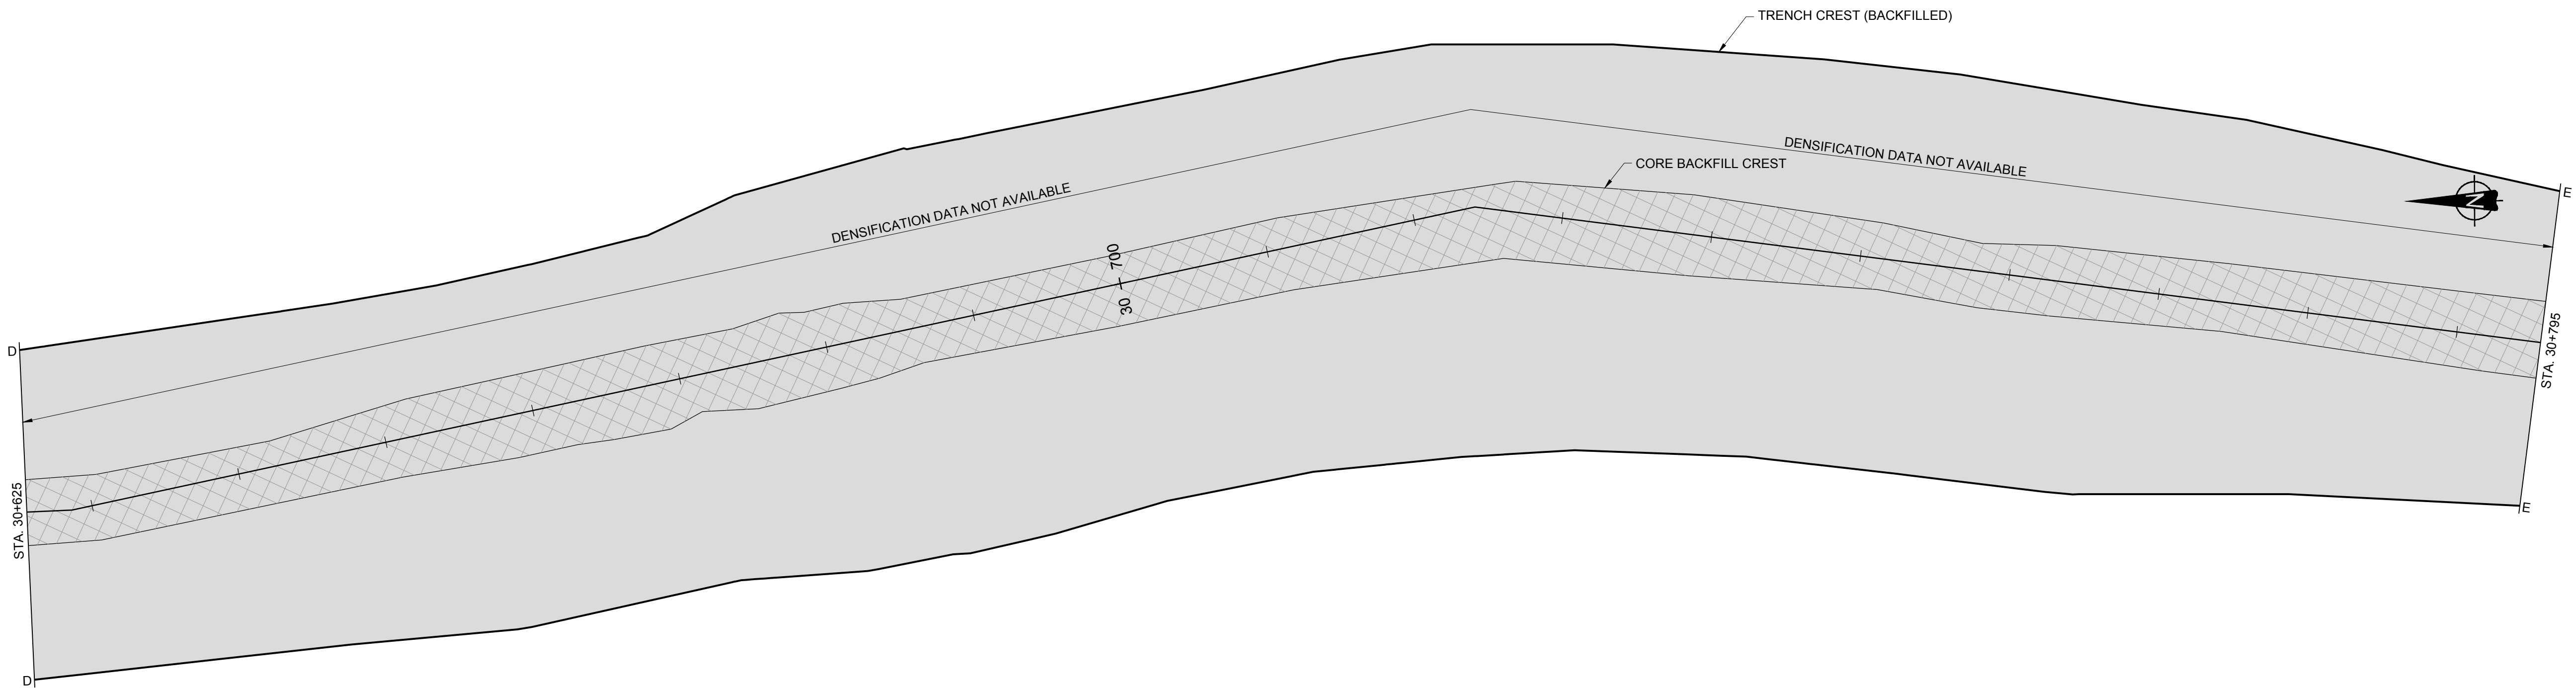
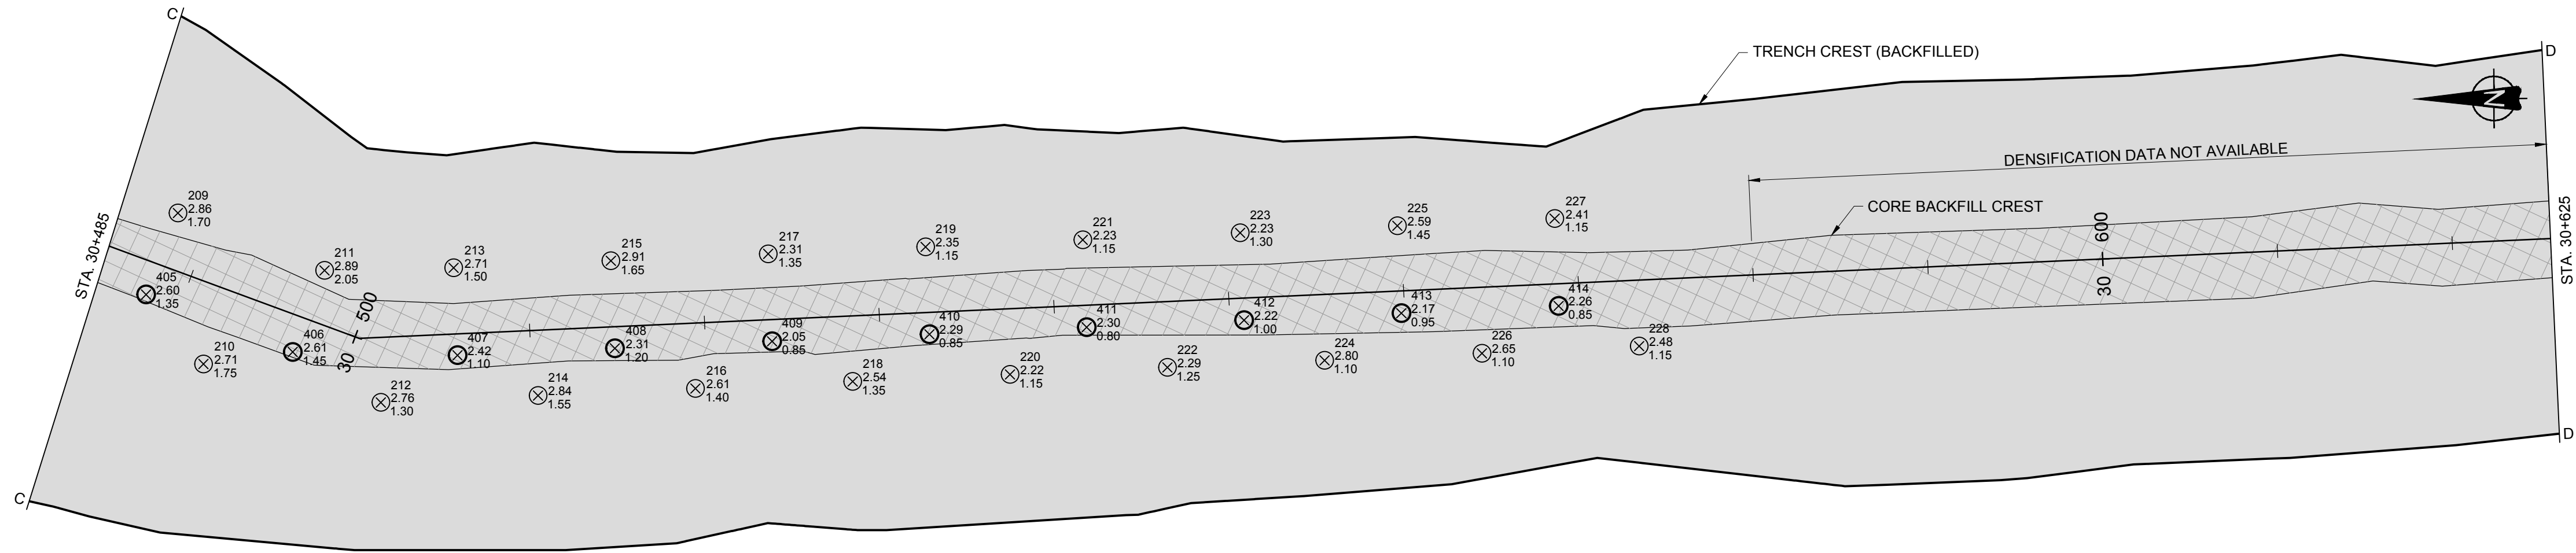
[illegible]


	15DEC12	KD	AS-BUILT	JD	GRB
REV	DATE	DES	REVISION DESCRIPTION	CADD	CHK


STAMP

PROJECT	AEM AGNICO-EAGLE MINES LIMITED MEADOWBANK GOLD PROJECT NUNAVUT					
	TITLE BAY-GOOSE DIKE DENSIFICATION PLAN - PHASE 1 AND 2 (NORTH PORTION) (2 OF 2)					
 Golder Associates	PROJECT No. 08-1428-0028/4200		FILE No. 0814280028-4200_0_31			
	DESIGN	FA	27FEB12	SCALE	AS SHOWN	REV. 0
	CADD	JD	28FEB12	4200-31		
	CHECK	GRB	15DEC12			
	REVIEW	FE	15DEC12			

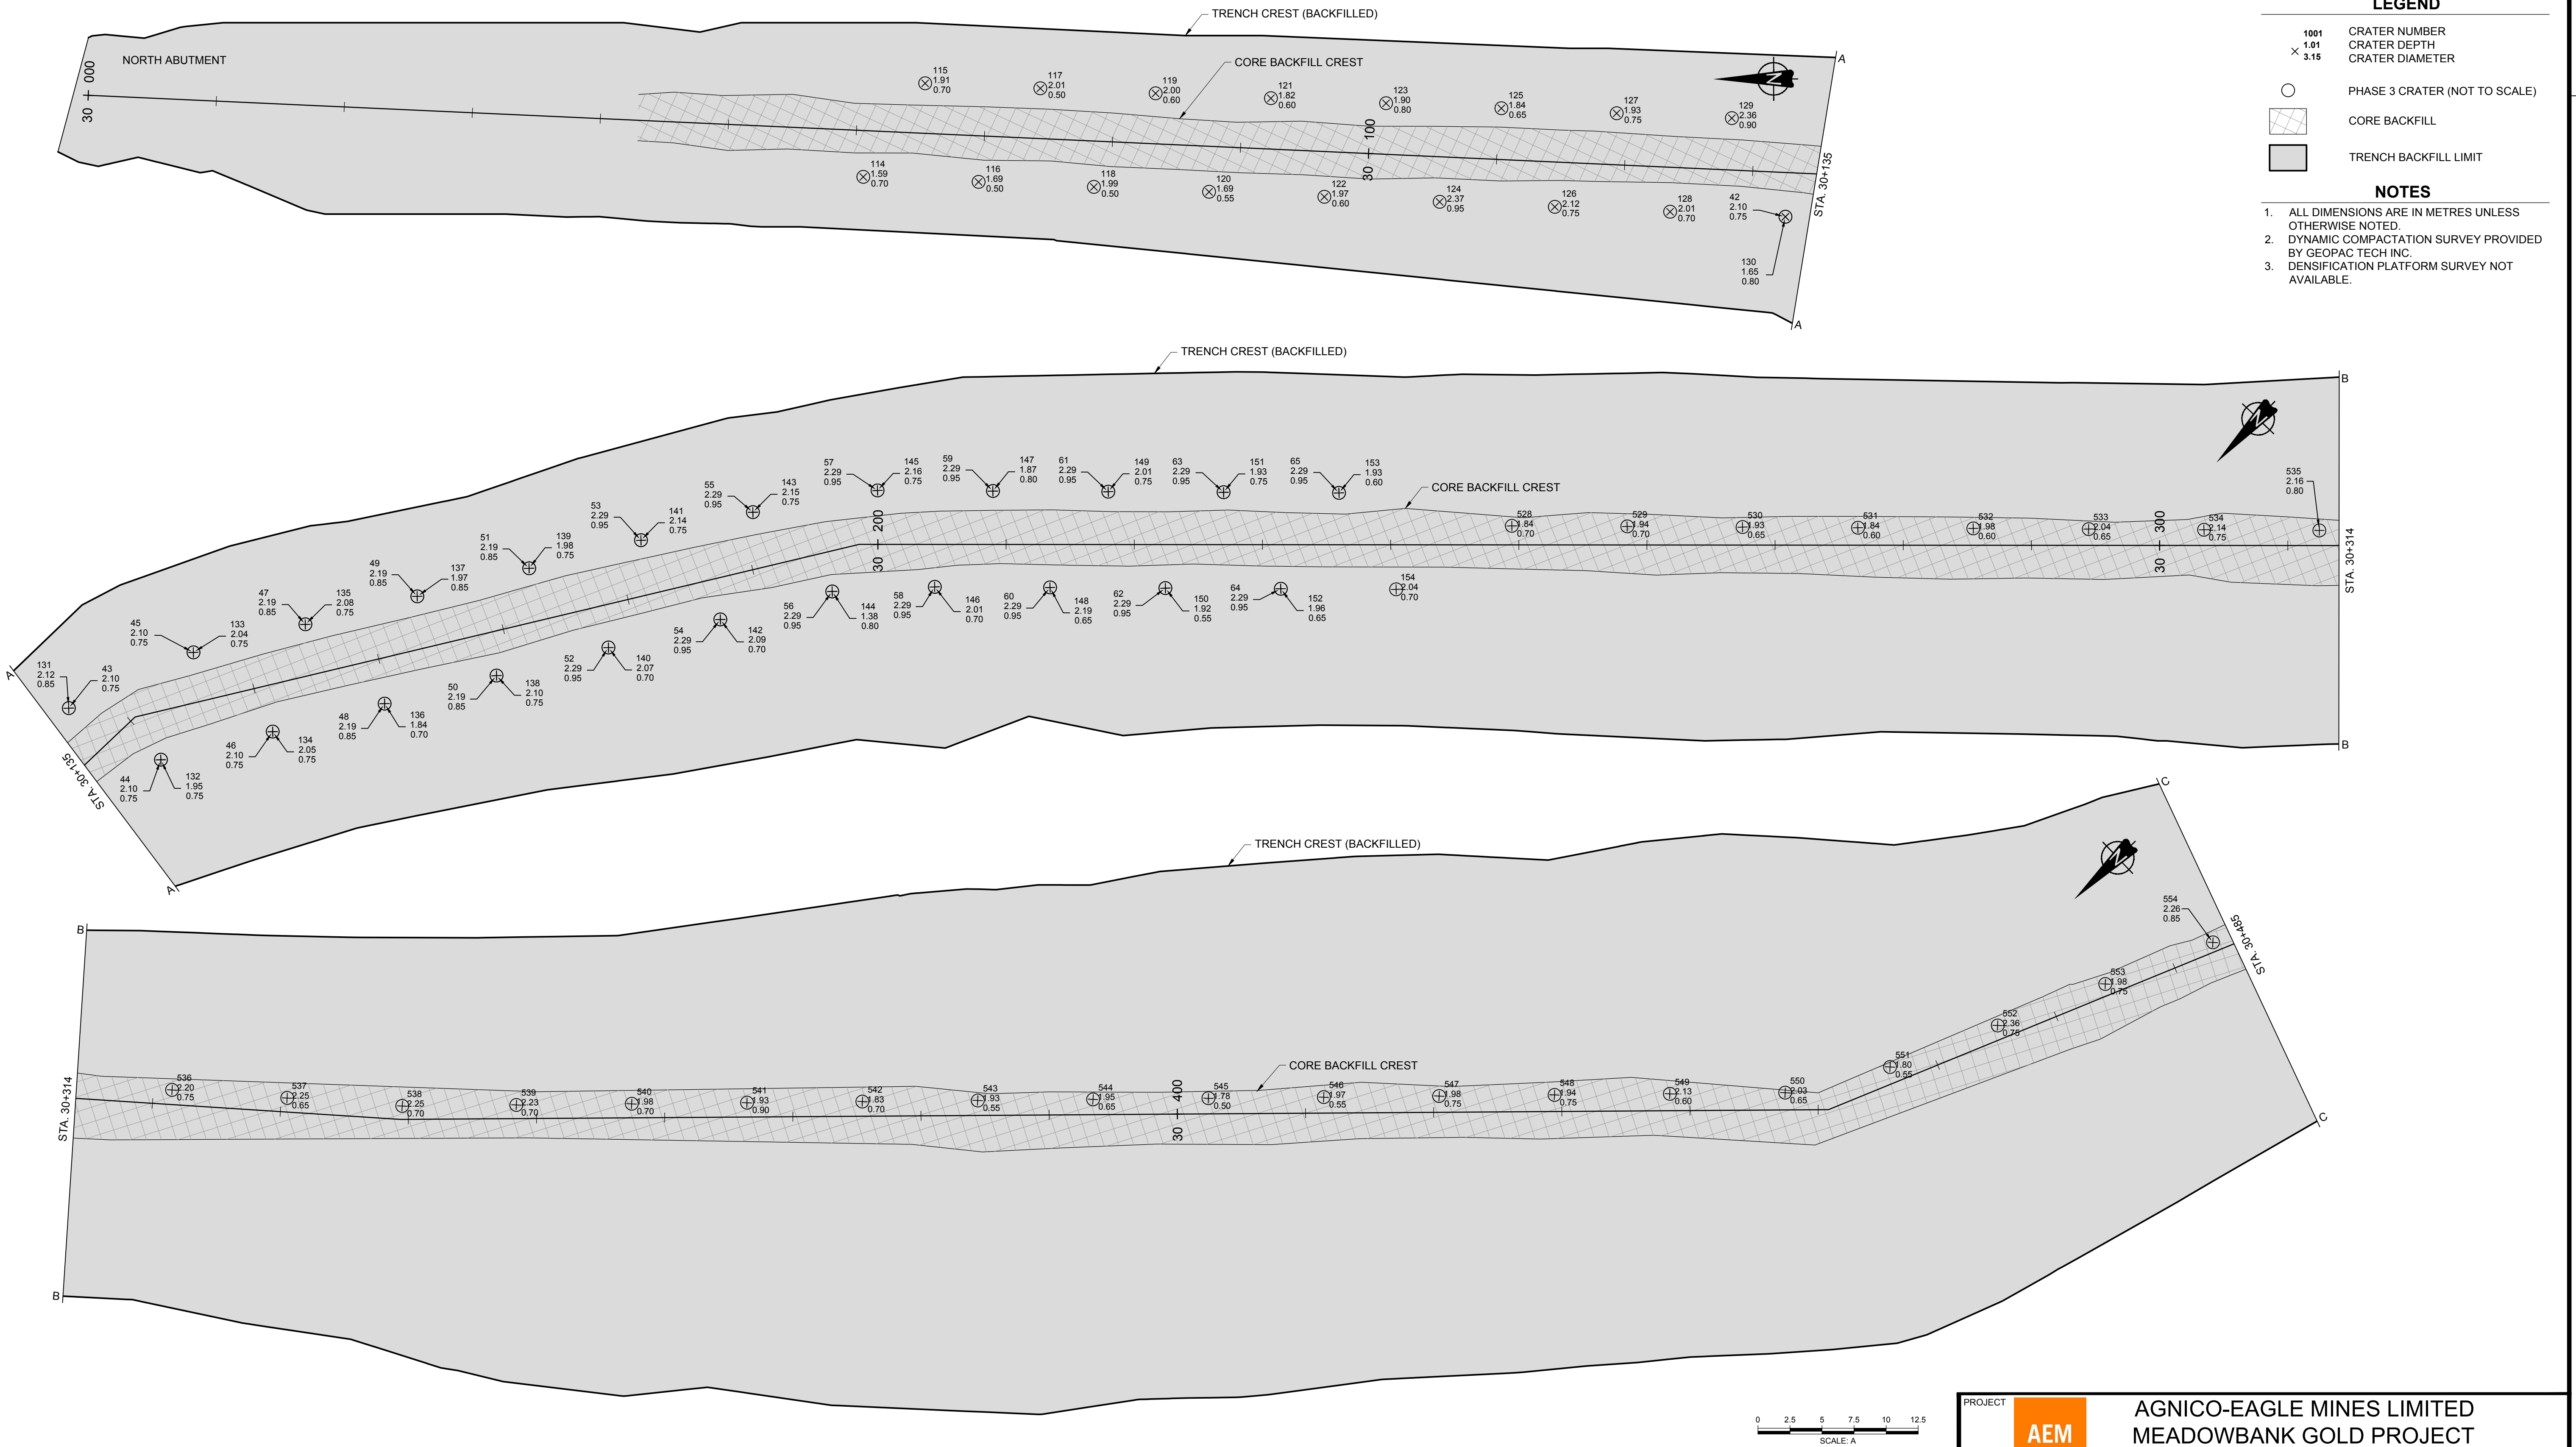[illegible]


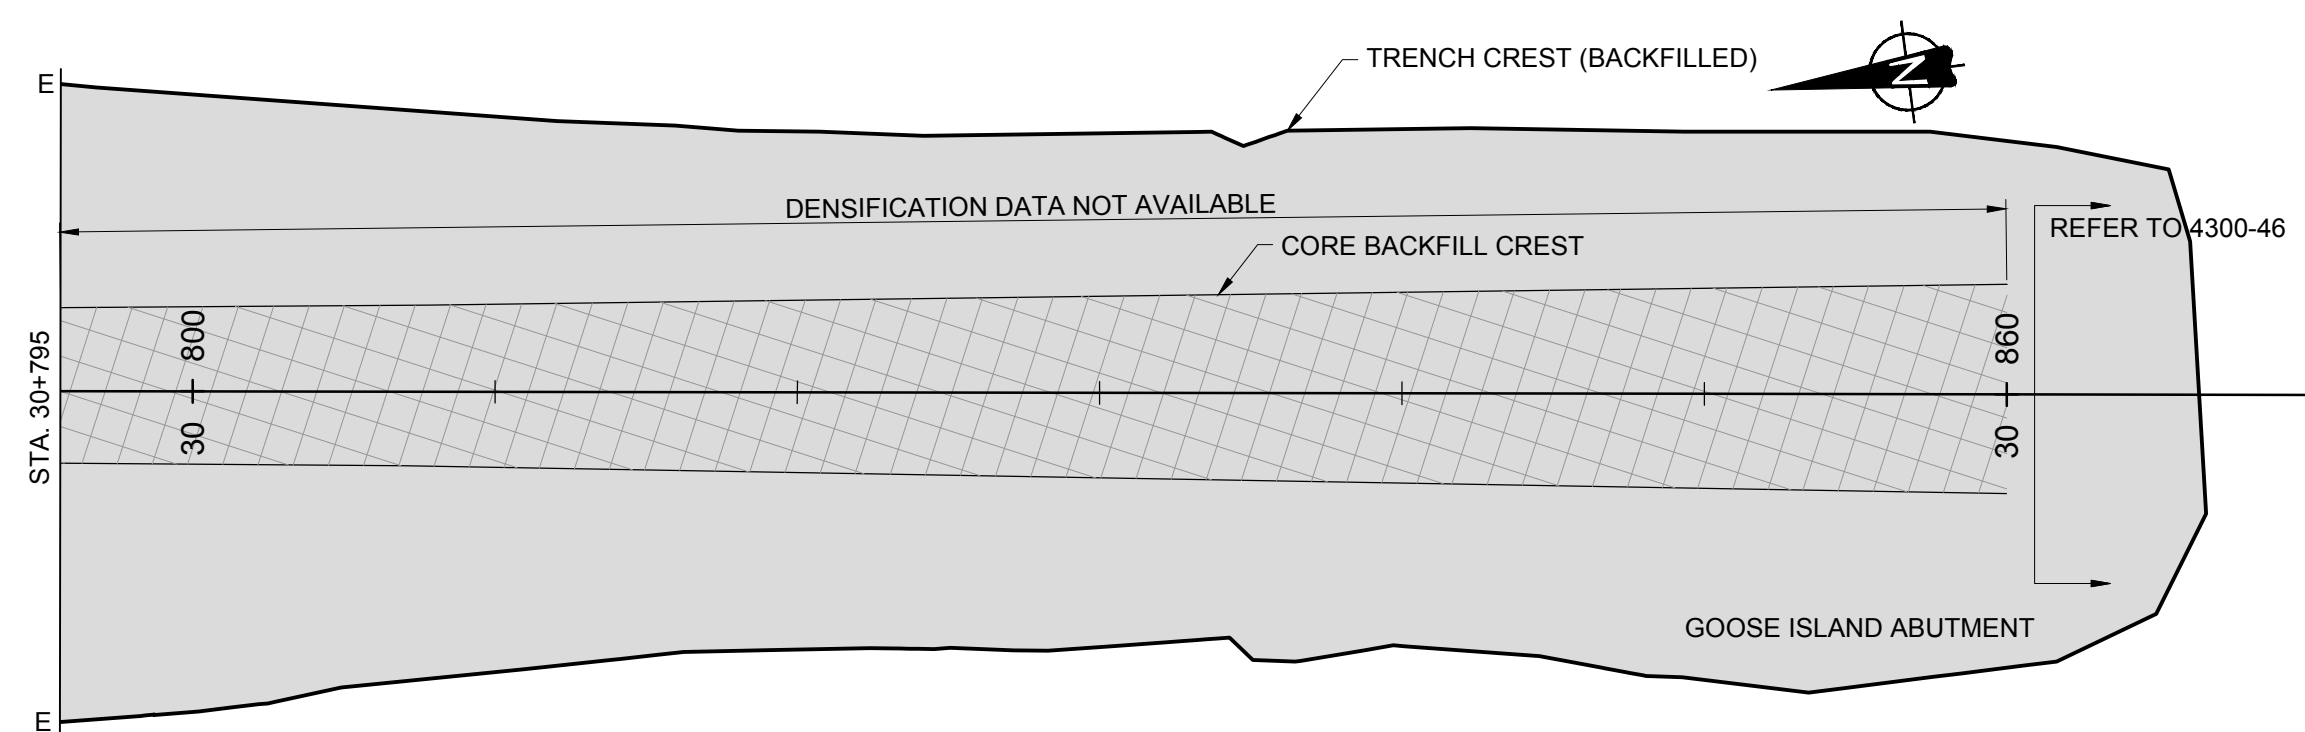
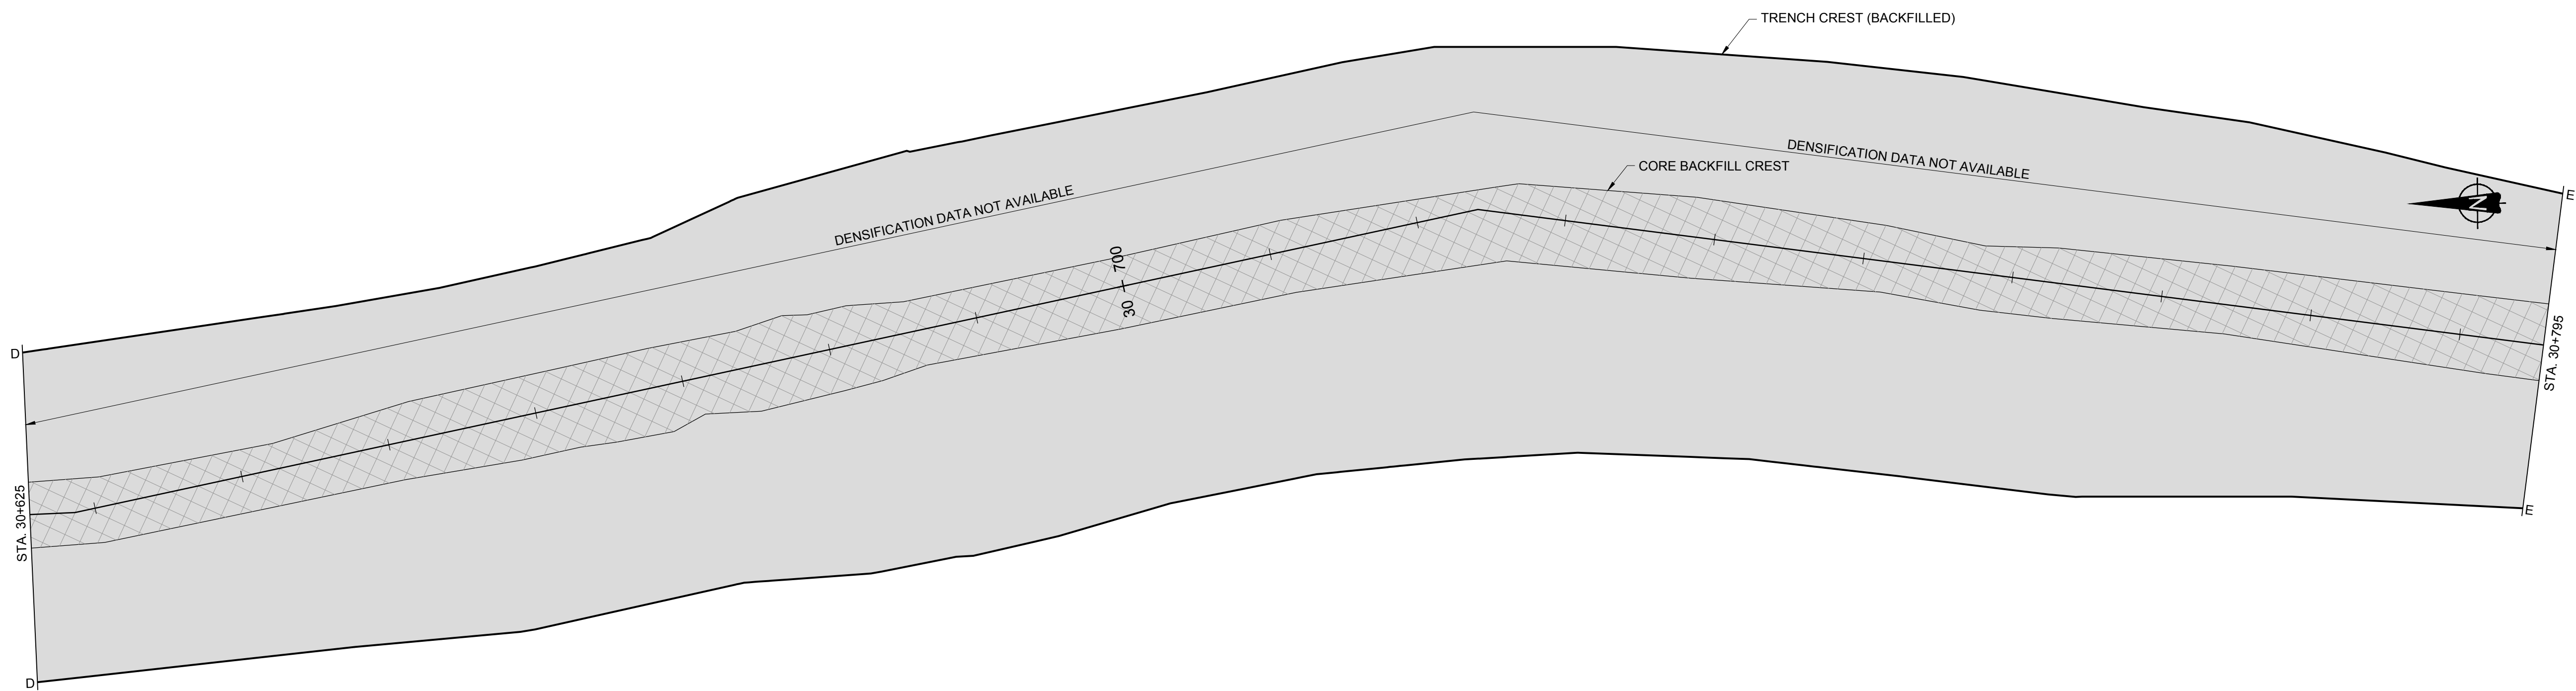
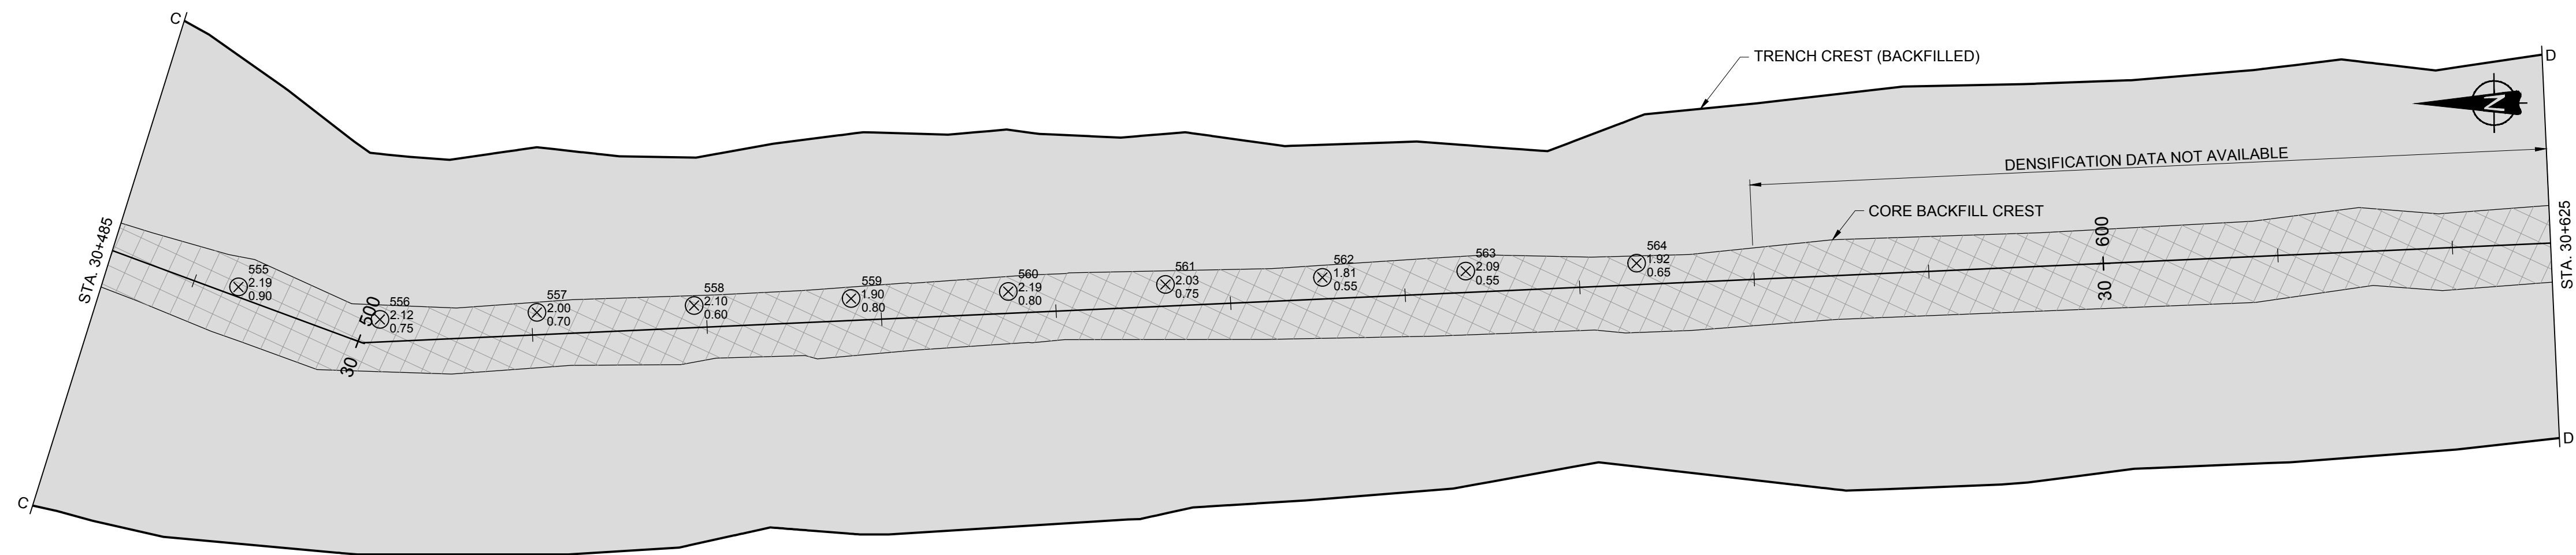


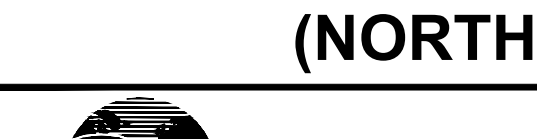										PROJECT  AGNICO-EAGLE MINES LIMITED MEADOWBANK GOLD PROJECT NUNAVUT	
										TITLE BAY-GOOSE DIKE DENSIFICATION PLAN - PHASE 3 (NORTH PORTION) (2 OF 2)	
											
										PROJECT No. 08-1428-0028/4200 FILE No. 0814280028-4200_0_33	
										DESIGN FA 27FEB12 SCALE AS SHOWN REV. 0	
										CADD JD 28FEB12	
										CHECK GRB 15DEC12 4200-33	
										REVIEW FE 15DEC12	
DRAWING NO. REFERENCES										 15DEC12 KD AS-BUILT JD GRB FE	
REV DATE DES REVISION DESCRIPTION CADD CHK RVW											

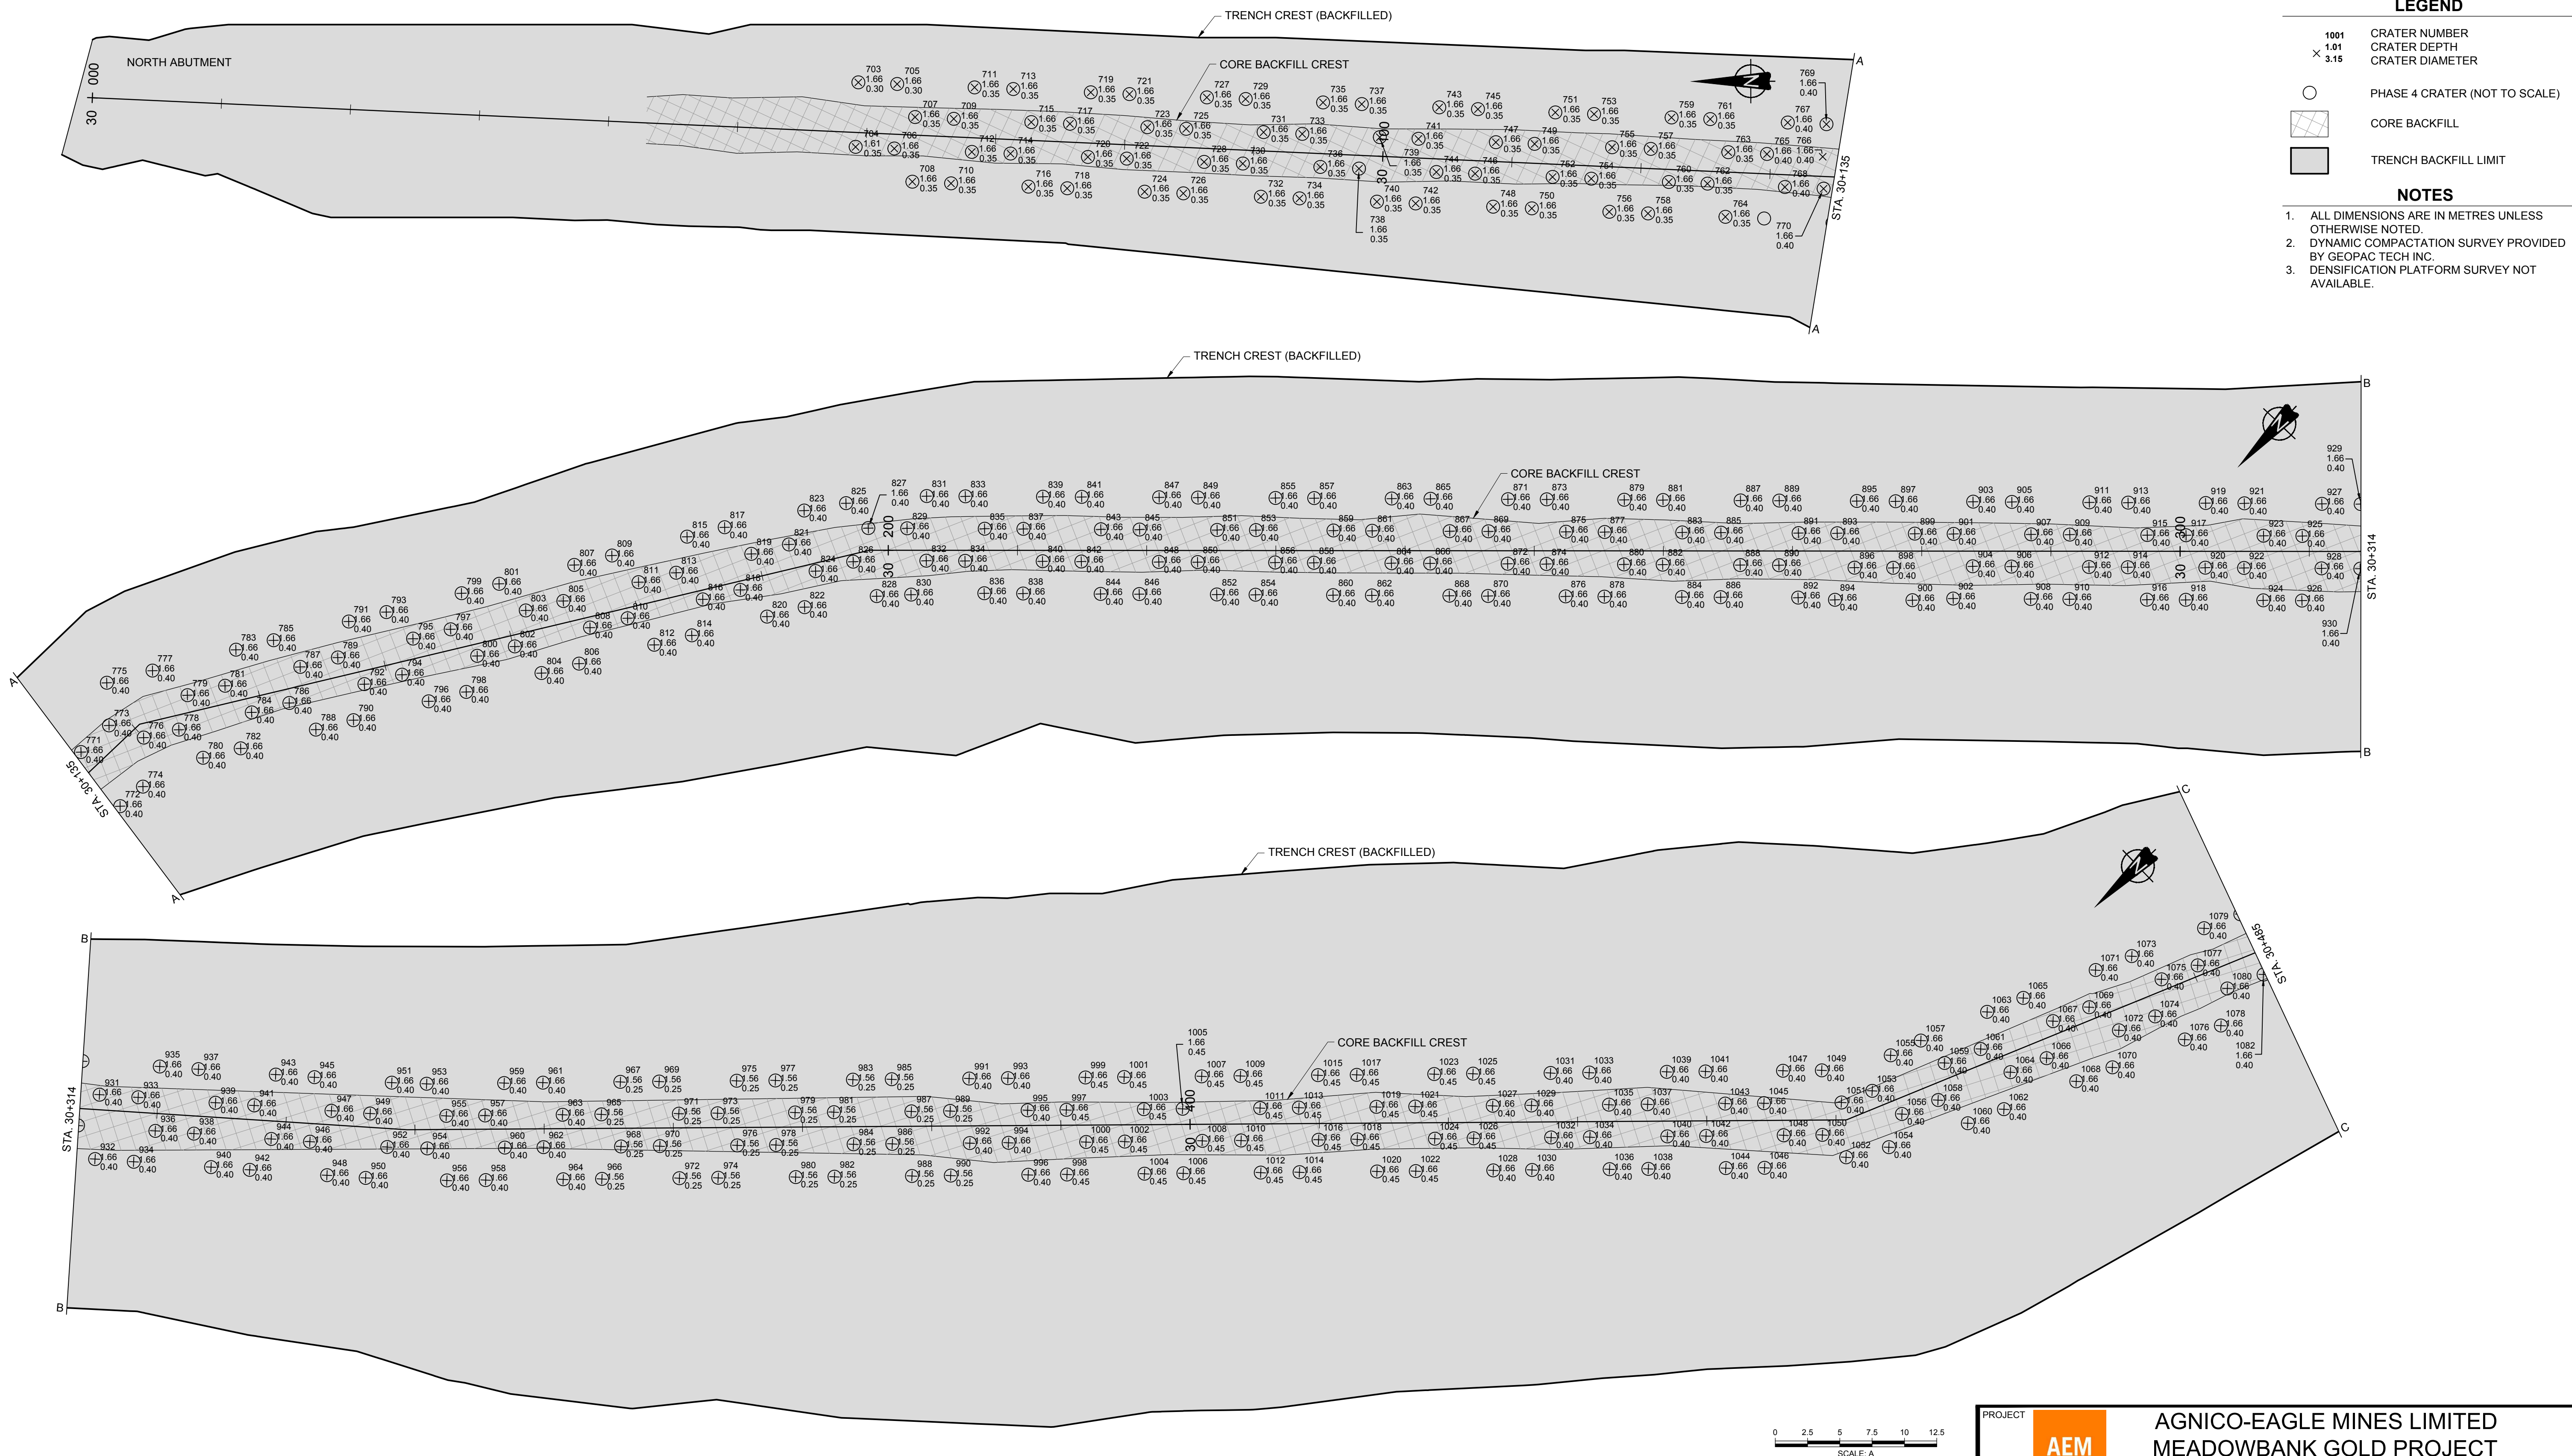

02.557.51012.5 SCALE: A										PROJECT AEM AGNICO-EAGLE MINES LIMITED MEADOWBANK GOLD PROJECT NUNAVUT														
										TITLE BAY-GOOSE DIKE DENSIFICATION PLAN - PHASE 4 (NORTH PORTION) (1 OF 2)														
										Golder Associates					PROJECT No. 08-1428-0028/4200					FILE No. 0814280028-4200_0_34				
															DESIGN	FA	27FEB12	SCALE	AS SHOWN	REV.	0			
															CADD	JD	28FEB12	4200-34						
															CHECK	GRB	15DEC12							
DRAWING NO.	REFERENCES										15DEC12	KD	AS-BUILT					JD	GRB	FE				
										REV	DATE	DES	REVISION DESCRIPTION					CADD	CHK	RVW				

Drawing File: N:\bur-graphics\Projects\2009\1428\09-1428-5007\Drafting\4000\meadowbank - bay-goose (north) dlke as-built\0814280028-4200_0_35.dwg Layout:DENSIFICATION PLAN PHASE 4 (2 OF 2) Friday, December 14, 2012 3:45:16 PM By: TYKlassen

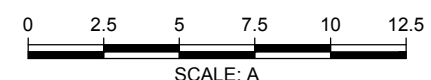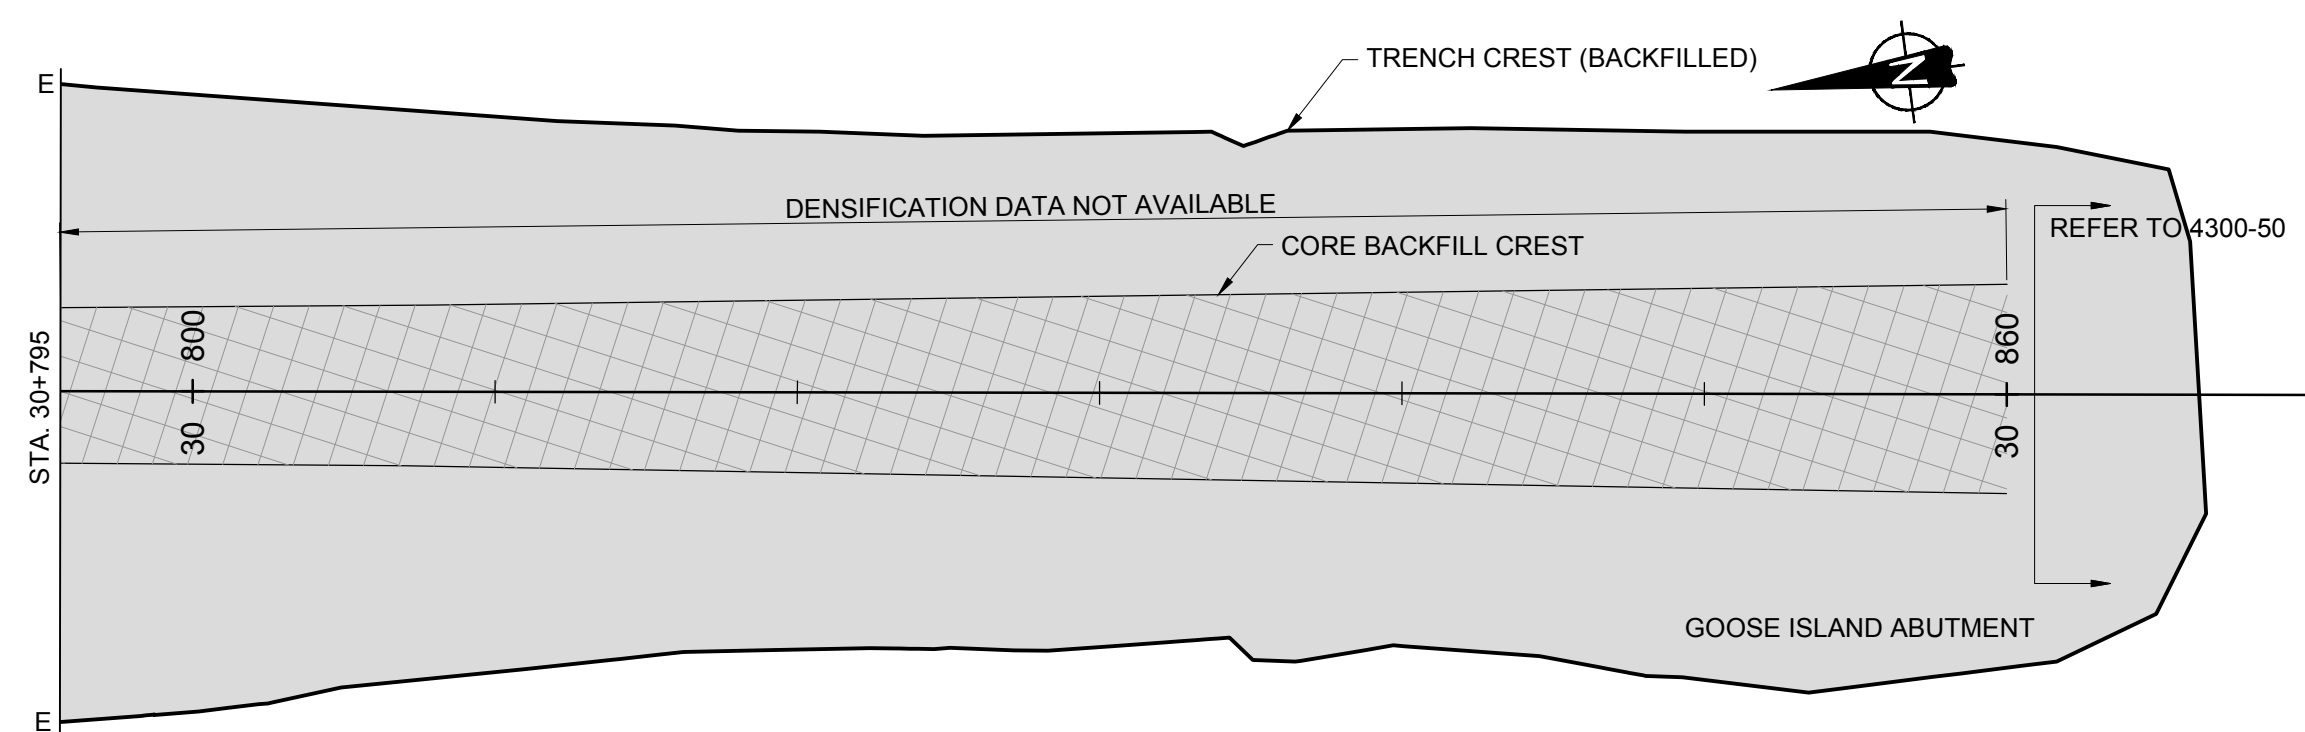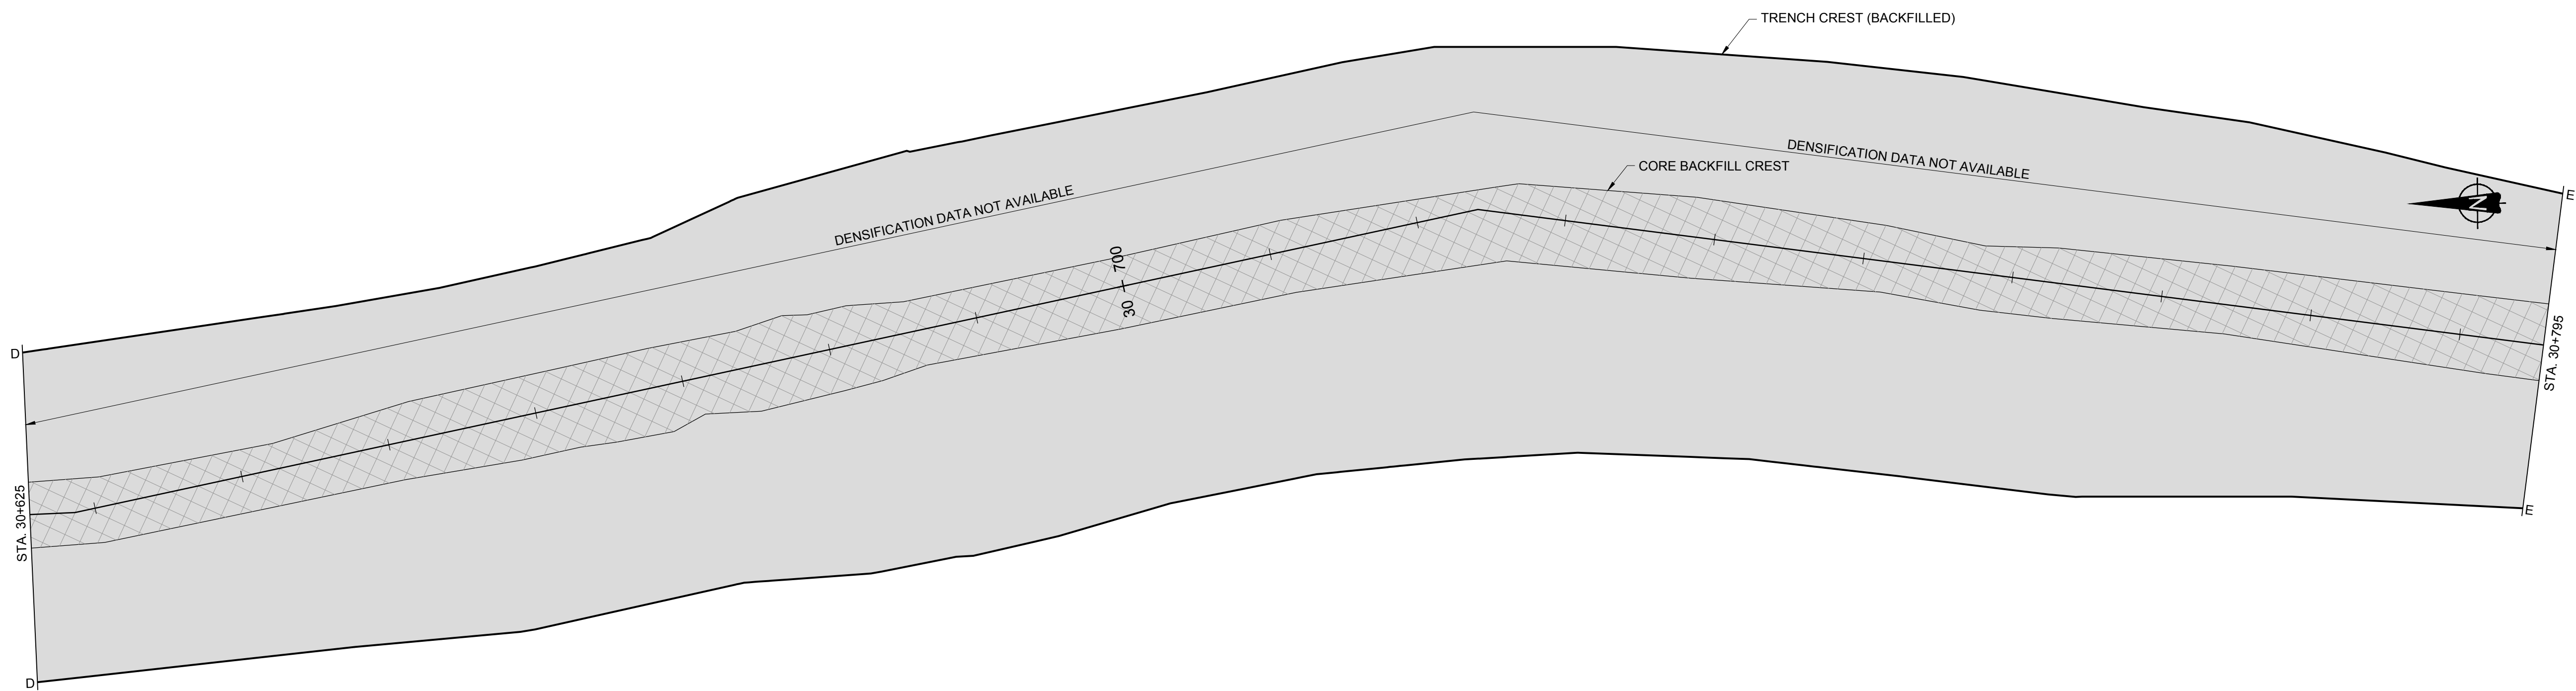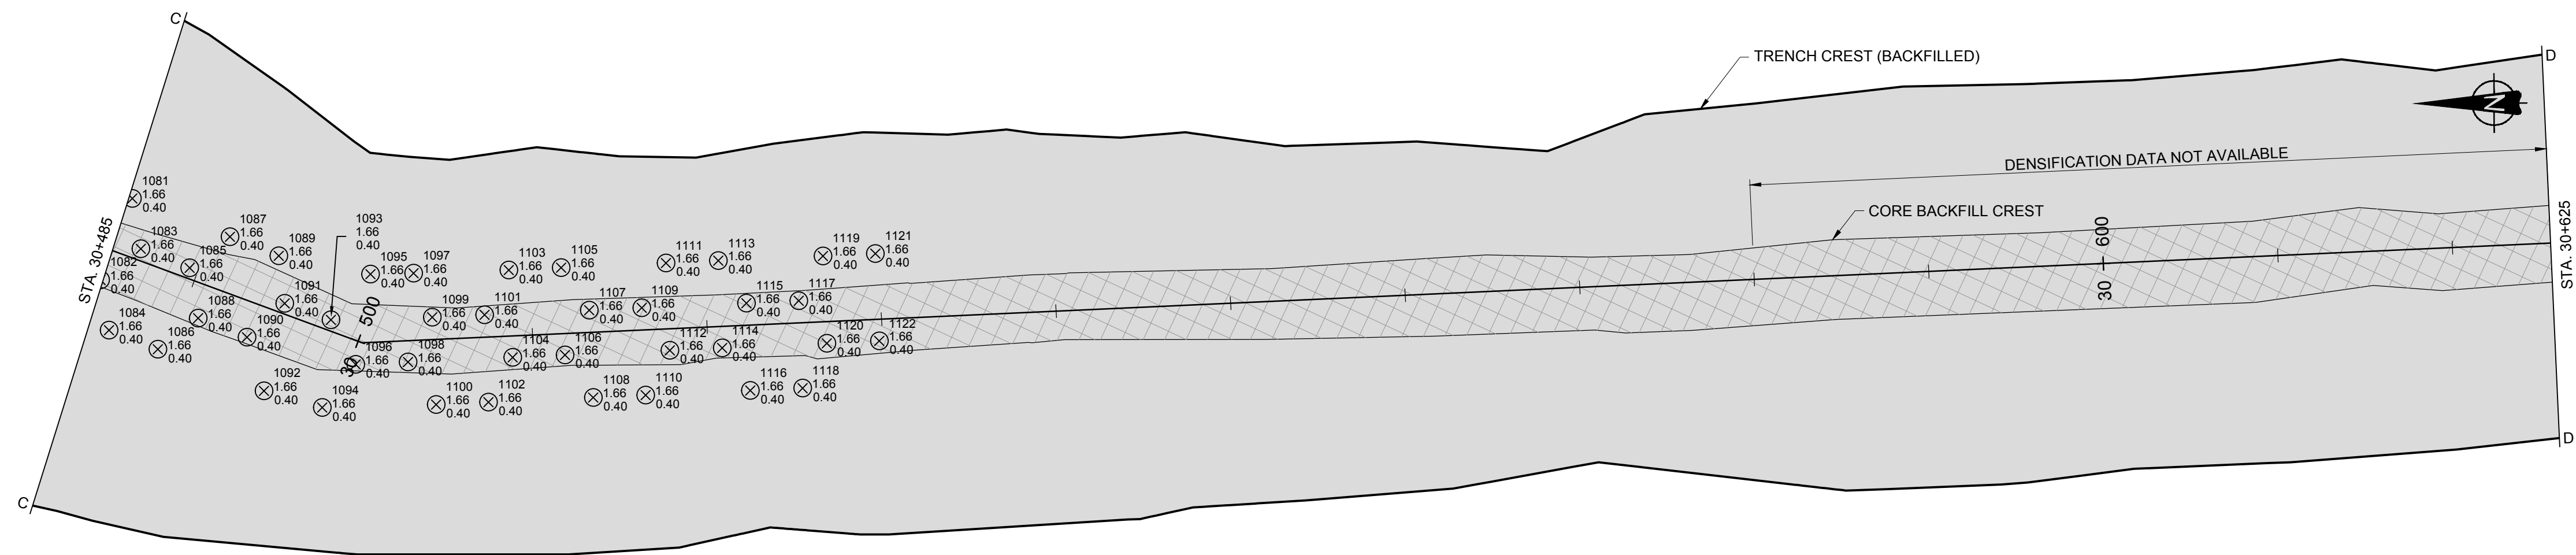

02.55.2024 0 2.5 5 7.5 10 12.5 SCALE: A										PROJECT AEM AGNICO-EAGLE MINES LIMITED MEADOWBANK GOLD PROJECT NUNAVUT									
										TITLE BAY-GOOSE DIKE DENSIFICATION PLAN - PHASE 4 (NORTH PORTION) (2 OF 2)									
										 PROJECT No. 08-1428-0028/4200 DESIGN FA 27FEB12 CADD JD 28FEB12 CHECK GRB 15DEC12 REVIEW FE 15DEC12 FILE No. 0814280028-4200_0_35 SCALE AS SHOWN REV. 0 4200-35									
										 15DEC12 KD AS-BUILT JD GRB FE REV DATE DES REVISION DESCRIPTION CADD CHK RVW									
DRAWING NO.										REFERENCES									



 AGNICO-EAGLE MINES LIMITED
MEADOWBANK DIVISION
MEADOWBANK GOLD PROJECT
BAY-GOOSE DIKE AS-BUILT - SOUTH PORTION

DRAWING INDEX			
DWG NO.	DRAWING TITLE	REVISION	REVISION TITLE
4300-00	BAY-GOOSE DIKE SOUTH PORTION LOCATION MAP AND DRAWING INDEX	4	AS-BUILT
4300-01	BAY-GOOSE DIKE SOUTH PORTION SITE AND TURBIDITY BARRIER PLAN	1	AS-BUILT
4300-02	BAY-GOOSE DIKE SOUTH PORTION BOREHOLE LOCATION PLAN	1	AS-BUILT
4300-03	BAY-GOOSE DIKE SOUTH PORTION BEDROCK PROFILE	2	AS-BUILT
4300-04	BAY-GOOSE DIKE SOUTH PORTION STRATIGRAPHY PROFILE BETWEEN STA. 31+500 AND STA. 32+160	2	AS-BUILT
4300-05	BAY-GOOSE DIKE SOUTH PORTION ROCKFILL PLATFORM PLAN	2	AS-BUILT
4300-06	BAY-GOOSE DIKE SOUTH PORTION CUTOFF WALL CENTRELINE SETOUT PLAN	1	AS-BUILT
4300-07	BAY-GOOSE DIKE SOUTH PORTION UPDATED BEDROCK PROFILE	0	AS-BUILT
4300-10	BAY-GOOSE DIKE SOUTH PORTION TYPICAL SECTIONS	1	AS-BUILT
4300-12	BAY-GOOSE DIKE SOUTH PORTION TYPICAL MATERIAL PLACEMENT SECTIONS	2	AS-BUILT
4300-13	BAY-GOOSE DIKE SOUTH PORTION PLAN VIEW OF INITIAL TRENCH EXCAVATION	1	AS-BUILT
4300-14	BAY-GOOSE DIKE SOUTH PORTION INITIAL TRENCH EXCAVATION PROFILE	1	AS-BUILT
4300-15	BAY-GOOSE DIKE SOUTH PORTION CROSS-SECTIONS (1 OF 5)	1	AS-BUILT
4300-16	BAY-GOOSE DIKE SOUTH PORTION CROSS-SECTIONS (2 OF 5)	1	AS-BUILT
4300-17	BAY-GOOSE DIKE SOUTH PORTION CROSS-SECTIONS (3 OF 5)	1	AS-BUILT
4300-18	BAY-GOOSE DIKE SOUTH PORTION CROSS-SECTIONS (4 OF 5)	1	AS-BUILT
4300-19	BAY-GOOSE DIKE SOUTH PORTION CROSS SECTIONS (5 OF 5)	1	AS-BUILT
4300-20	BAY-GOOSE DIKE SOUTH PORTION 2009 TO 2010 TIE-IN PLAN AND SECTION	1	AS-BUILT
4300-21	BAY-GOOSE DIKE SOUTH PORTION GOOSE ISLAND ABUTMENT PLAN AND SECTION	1	AS-BUILT
4300-22	BAY-GOOSE DIKE SOUTH PORTION OUTCROP KEY-IN PLAN AND SECTION	1	AS-BUILT
4300-23	BAY-GOOSE DIKE SOUTH PORTION SOUTH ABUTMENT PLAN AND DETAILS	1	AS-BUILT
4300-25	BAY-GOOSE DIKE SOUTH PORTION PLAN VIEW OF SB AND CSB PLACEMENT ZONES	1	AS-BUILT
4300-26	BAY-GOOSE DIKE SOUTH PORTION PROFILE VIEW OF SB AND CSB PLACEMENT ZONES	1	AS-BUILT
4300-27	BAY-GOOSE DIKE SOUTH PORTION LOW PERMEABILITY SYSTEM	0	AS-BUILT
4300-30	BAY-GOOSE DIKE SOUTH PORTION INSTRUMENTATION PLAN	1	AS-BUILT
4300-31	BAY-GOOSE DIKE SOUTH PORTION INSTRUMENTATION PLAN AND PROFILE STA. 30+900 TO STA. 32+160	1	AS-BUILT
4300-32	BAY-GOOSE DIKE SOUTH PORTION INSTRUMENTATION SECTIONS	1	AS-BUILT
4300-42	BAY-GOOSE DIKE SOUTH PORTION DENSIFICATION PLAN - PHASE 1 AND 2 (1 OF 4)	0	AS-BUILT
4300-43	BAY-GOOSE DIKE SOUTH PORTION DENSIFICATION PLAN - PHASE 1 AND 2 (2 OF 4)	0	AS-BUILT
4300-44	BAY-GOOSE DIKE SOUTH PORTION DENSIFICATION PLAN - PHASE 1 AND 2 (3 OF 4)	0	AS-BUILT
4300-45	BAY-GOOSE DIKE SOUTH PORTION DENSIFICATION PLAN - PHASE 1 AND 2 (4 OF 4)	0	AS-BUILT
4300-46	BAY-GOOSE DIKE SOUTH PORTION DENSIFICATION PLAN - PHASE 3 (1 OF 4)	0	AS-BUILT
4300-47	BAY-GOOSE DIKE SOUTH PORTION DENSIFICATION PLAN - PHASE 3 (2 OF 4)	0	AS-BUILT

UNUSED DWG. NOS. 4300-08, 4300-09, 4300-11, 4300-24, 4300-28, 4300-29, 4300-33 TO 4300-41

[illegible]

LIST OF SPECIFICATIONS		
SPECIFICATION NO.	TITLE	REVISION
4300-S1	GENERAL	0
4300-S2	SCOPE	0
4300-S3	COMMERCIAL CONDITIONS	0
4300-S4	EXCAVATION AND FOUNDATION PREPARATION	0
4300-S5	FILL PLACEMENT	0
4300-S6	CUTOFF WALL	0
4300-S9	QC AND QA REQUIREMENTS	0



LOCATION PLAN

DRAWING INDEX			
DWG NO.	DRAWING TITLE	REVISION	REVISION TITLE
4300-48	BAY-GOOSE DIKE SOUTH PORTION DENSIFICATION PLAN - PHASE 3 (3 OF 4)	0	AS-BUILT
4300-49	BAY-GOOSE DIKE SOUTH PORTION DENSIFICATION PLAN - PHASE 3 (4 OF 4)	0	AS-BUILT
4300-50	BAY-GOOSE DIKE SOUTH PORTION DENSIFICATION PLAN - PHASE 4 (1 OF 4)	0	AS-BUILT
4300-51	BAY-GOOSE DIKE SOUTH PORTION DENSIFICATION PLAN - PHASE 4 (2 OF 4)	0	AS-BUILT
4300-52	BAY-GOOSE DIKE SOUTH PORTION DENSIFICATION PLAN - PHASE 4 (3 OF 4)	0	AS-BUILT
4300-53	BAY-GOOSE DIKE SOUTH PORTION DENSIFICATION PLAN - PHASE 4 (4 OF 4)	0	AS-BUILT
4300-54	BAY-GOOSE DIKE SOUTH PORTION VIBRO COMPACTION PLAN	0	AS-BUILT

PROJECT

AEM

AGNICO-EAGLE MINES LIMITED
MEADOWBANK GOLD PROJECT
NUNAVUT

TITLE

BAY-GOOSE DIKE SOUTH PORTION
LOCATION MAP AND DRAWING INDEX





Golder

Associates

PROJECT No.	09-1428-5007	FILE No.	4300_2_00	
DESIGN	KD	02MAY10	SCALE	AS SHOWN
CADD	EA	10MAY10	REV.	4
CHECK	FE	31MAY10	4300-00	
REVIEW	MRJ	31MAY10		

By: TYKKLASSEN
 CADD FILE: N:\Bur-Graphics\Projects\2009\1428\09-1428-5007\Drafting\4000\Meadowbank - Boy-Goose (SOUTH) Dike As-Built\4300_2_00.dwg
 REVISION DATE: 05/12/2012

CADD FILE: N:\bur-graphics\Projects\2009\1428-5007\Drafting\4000\meadowbank - bay-goose (south) dike as-built\4300_1_01.dwg
REVISION DATE: 05/12/2012 3:39 PM BY: TYK/LASSEN

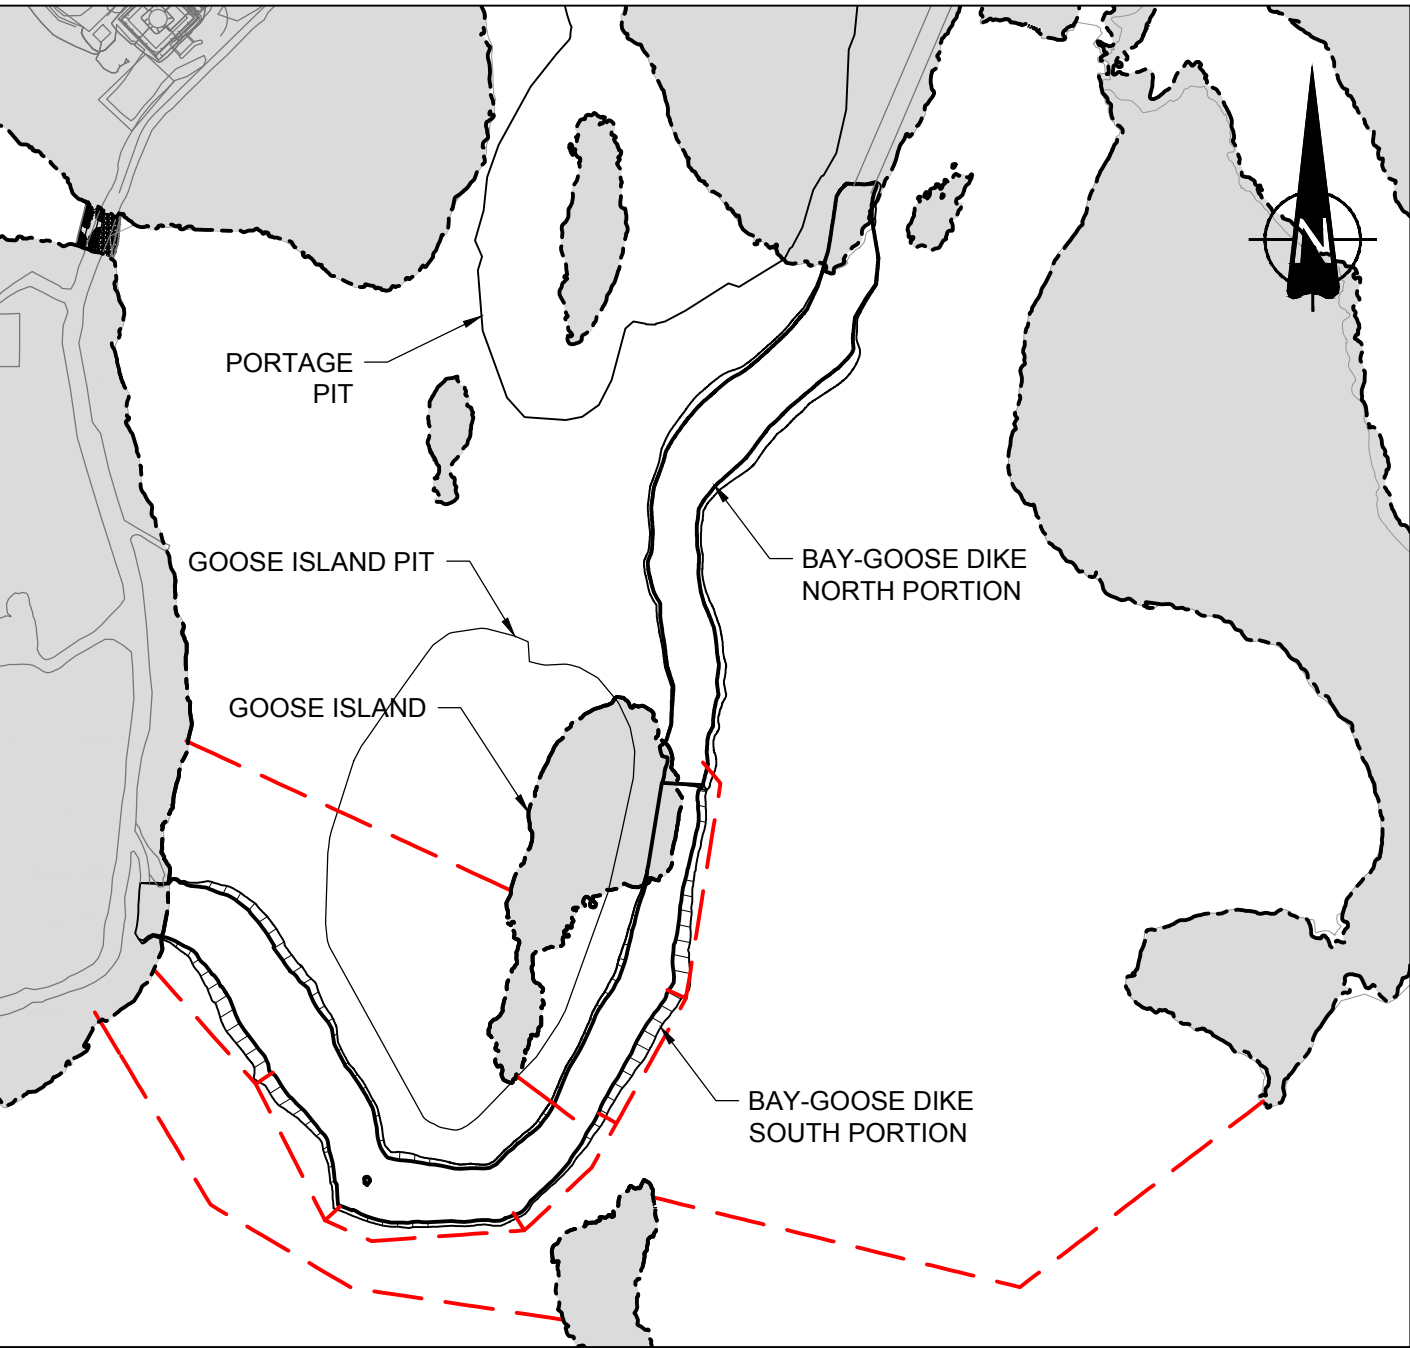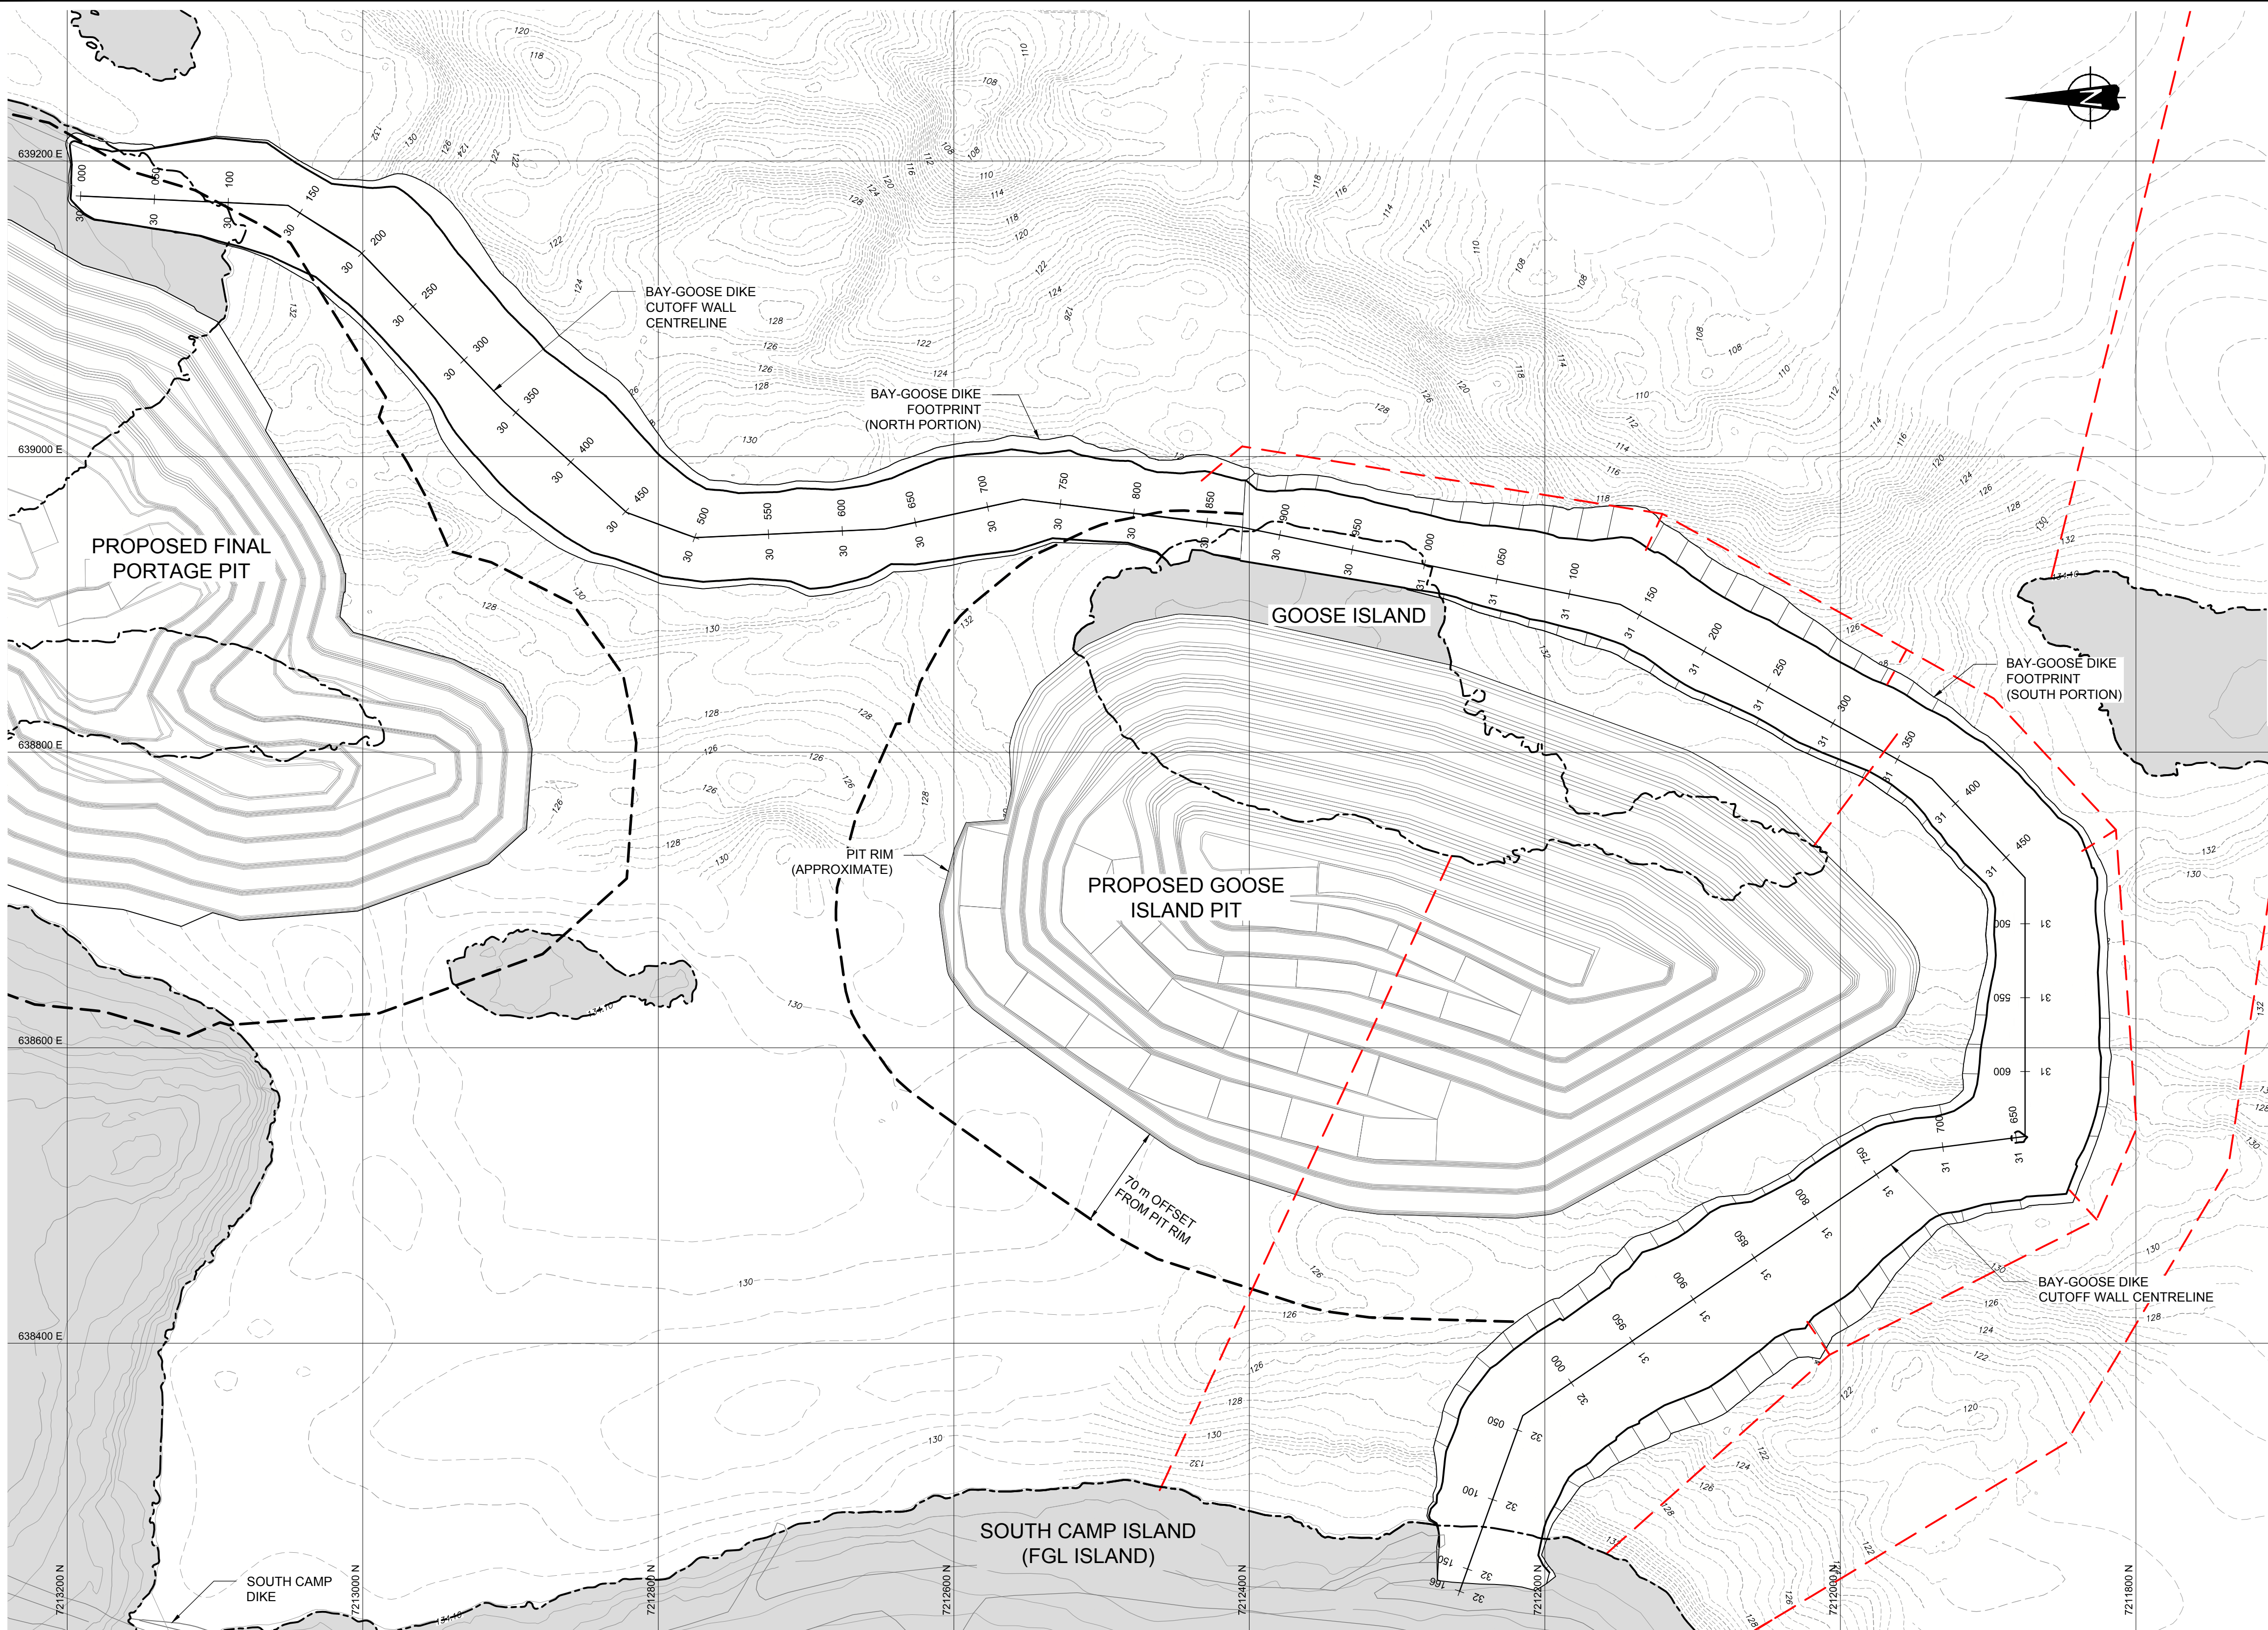

KEY PLAN
(SCALE: B)

LEGEND

- PIT RIM
- MINOR BATHYMETRY CONTOUR
- MAJOR BATHYMETRY CONTOUR
- MINOR TOPOGRAPHIC CONTOUR
- MAJOR TOPOGRAPHIC CONTOUR
- SHORELINE
- 70m OFFSET FROM PIT RIM
- ROCKFILL PLATFORM CREST
- TURBIDITY BARRIER

NOTES

- 1) ALL DIMENSIONS ARE IN METRES UNLESS OTHERWISE NOTED.
- 2) ALL ELEVATIONS ARE IN METRES ABOVE SEA LEVEL (MASL), UNLESS OTHERWISE NOTED.
- 3) GRID REFERENCE: NAD 83, UTM ZONE 14.
- 4) SURVEYED LAKE SURFACE ELEVATION: THIRD PORTAGE LAKE = 134.1m (2008).
- 5) REFER TO DRAWING PACKAGE 4200 FOR BAY-GOOSE NORTH PORTION AS-BUILT DETAILS.

REFERENCE

- 1) PORTAGE PIT DESIGN BY AEM, MARCH, 2009.
- 2) GOOSE ISLAND PIT DESIGN BY AEM, MAY, 2010.
- 3) TOPOGRAPHIC CONTOUR INFORMATION ON LAND SUPPLIED BY AEM.
- 4) LAKEBED SURFACE BASED ON BATHYMETRIC SURVEYS BY GOLDER ASSOCIATES LTD., 2006 AND DETAILED (0.5m CONTOUR INTERVAL) 2008.
- 5) ROAD AND MINE FACILITIES PROVIDED BY AEM, JANUARY, 2009.

SITE PLAN
(SCALE: A)



PROJECT

AEM

AGNICO-EAGLE MINES LIMITED
MEADOWBANK GOLD PROJECT
NUNAVUT

TITLE


BAY-GOOSE DIKE SOUTH PORTION
SITE AND TURBIDITY BARRIER PLAN



**Golder
Associates**

PROJECT No.		09-1428-5007	FILE No.		4300_1_0
DESIGN	KD	02MAY10	SCALE	AS SHOWN	REV.
CADD	JK	10MAY10	4300-01		
CHECK	FE	31MAY10			
REVIEW	MRJ	31MAY10			

DRAWING NO.	REFERENCES			REV	DATE	DES	REVISION DESCRIPTION	CADD	CHK	RVW	STAMP
				15DEC12	FE		AS-BUILT	EA	GRB	FE	
				06JUL10	KD		ISSUED FOR CONSTRUCTION	JK	FE	MRJ	
				18JUN10	KD		ISSUED FOR CLIENT REVIEW	JK	FE	MRJ	
				31MAY10	KD		ISSUED FOR CLIENT REVIEW	JK	FE	MRJ	

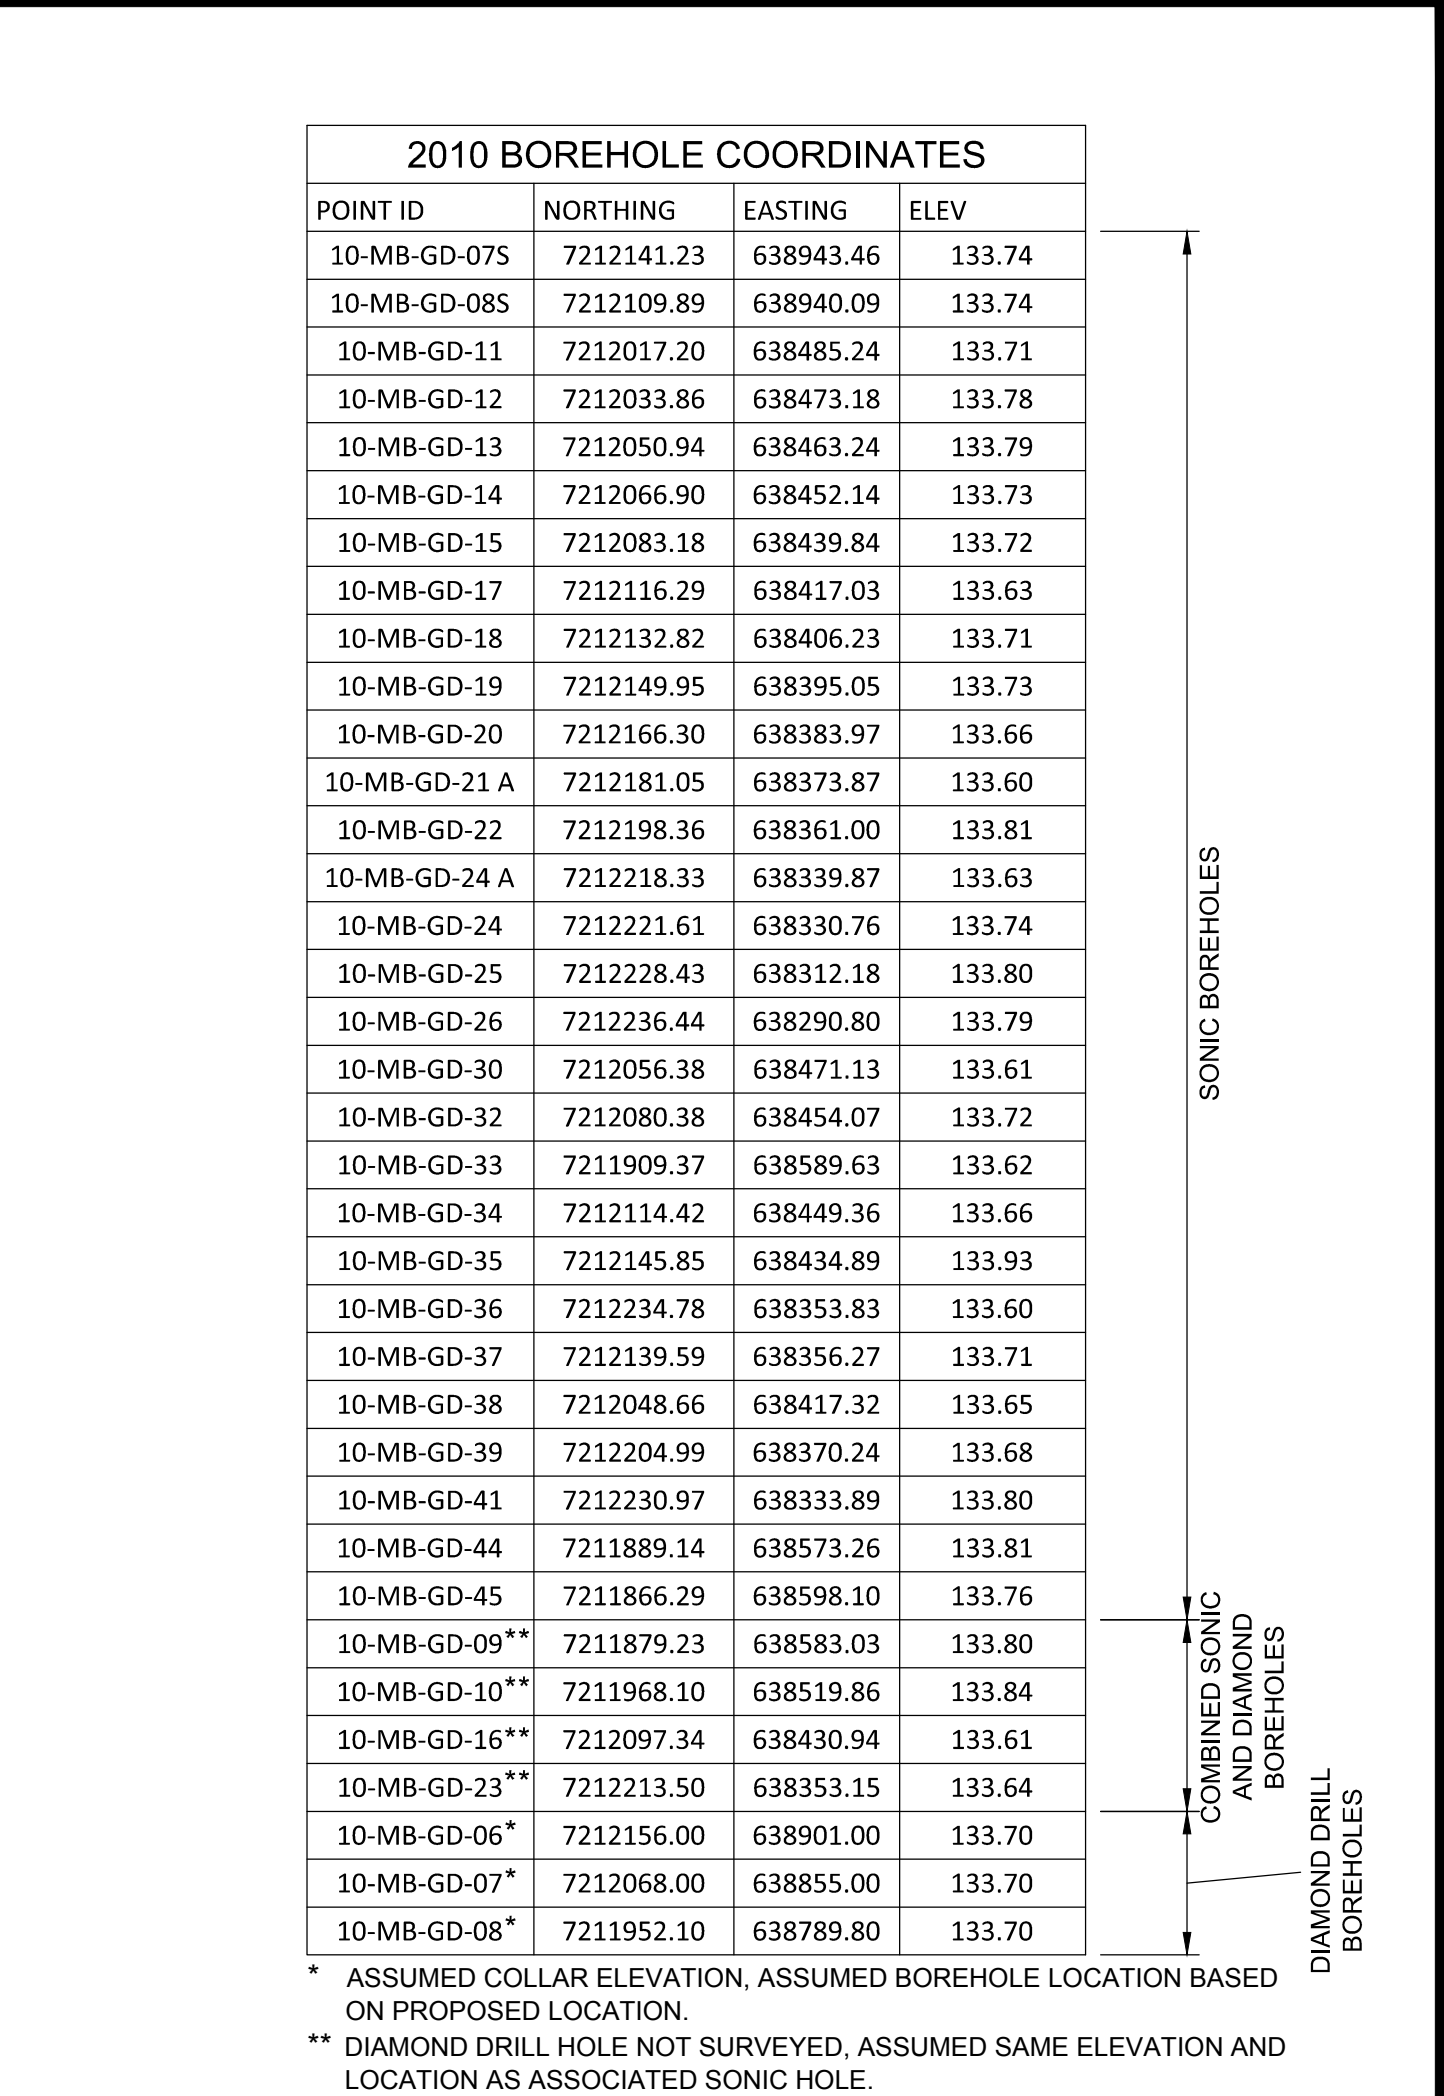

LEGEND

	PIT RIM		2009 BOREHOLE LOCATION (DIAMOND DRILL RIG)
	MINOR BATHYMETRY CONTOUR		2010 BOREHOLE LOCATION (AIR ROTARY DRILL RIG)
	MAJOR BATHYMETRY CONTOUR		2010 BOREHOLE LOCATION (DIAMOND DRILL RIG)
	MINOR TOPOGRAPHIC CONTOUR		2010 BOREHOLE LOCATION (SONIC DRILL RIG)
	MAJOR TOPOGRAPHIC CONTOUR		2010 STANDPIPE PIEZOMETER LOCATION
	70m OFFSET FROM PIT RIM		2010 BOREHOLE LOCATION (DIAMOND AND SONIC DRILL RIG)
	SHORELINE		
	ROCKFILL PLATFORM CREST		
	2003 BOREHOLE LOCATION		
	2009 BOREHOLE LOCATION (AIR ROTARY DRILL RIG)		

NOTES

- 1) ALL DIMENSIONS ARE IN METRES UNLESS OTHERWISE NOTED.
- 2) ALL ELEVATIONS ARE IN METRES ABOVE SEA LEVEL (MASL), UNLESS OTHERWISE NOTED.
- 3) GRID REFERENCE: NAD 83, UTM ZONE 14.
- 4) REFER TO DWG 4200-02 FOR 2003 AND 2009 BOREHOLE COORDINATES.
- 5) EXPLORATION DRILL HOLES ARE NOT SHOWN ON THIS DRAWING.
- 6) SURVEY LAKE SURFACE ELEVATION: THIRD PORTAGE LAKE = 134.1m (2008).

REFERENCE


- 1) GOOSE ISLAND PIT DESIGN BY AEM, MAY, 2010.
- 2) TOPOGRAPHIC CONTOUR INFORMATION ON LAND SUPPLIED BY AEM.
- 3) LAKEBED SURFACE BASED ON BATHYMETRIC SURVEY BY GOLDER ASSOCIATES LTD., 2006 AND DETAILED (0.5m CONTOUR INTERVAL) 2008.

					STAMP
DRAWING NO.	REFERENCES	REV	DATE	DES	REVISION DESCRIPTION CADD CHK RVW
		A	15DEC12	FE	AS-BUILT EA GRB FE
		B	06JUL10	KD	ISSUED FOR CONSTRUCTION JK FE MRJ
		C	18JUN10	KD	ISSUED FOR CLIENT REVIEW JK FE MRJ
		D	31MAY10	KD	ISSUED FOR CLIENT REVIEW EA FE MRJ

PROJECT		AEM AGNICO-EAGLE MINES LIMITED MEADOWBANK GOLD PROJECT NUNAVUT			
TITLE					
BAY-GOOSE DIKE SOUTH PORTION BOREHOLE LOCATION PLAN					
Golder Associates		PROJECT No.		09-1428-5007	
		DESIGN		KD	02MAY10
		CADD		EA	10MAY10
		CHECK		FE	31MAY10
		REVIEW		MRJ	31MAY10
		FILE No.		4300_1-02	
		SCALE		AS SHOWN	REV. 1
		4300-02			

CADD FILE: N:\bur-graphics\Projects\2009\1428\09-1428-5007\Drafting\4000\meadowbank - boy-goose (south) dike as-built\4300_2_04.dwg
 REVISION DATE: 12/5/2012 3:53:15 PM BY: TYK/CLASSEN

REVISION DATE: 12/5/2012 4:03:38 PM BY: TTK/LASSEN CADD FILE: N:\bur-graphics\Projects\2009\1428-5007\Drafting\4000\meadowbank - bay-goose (south) dike as-built\4300_1_06.dwg

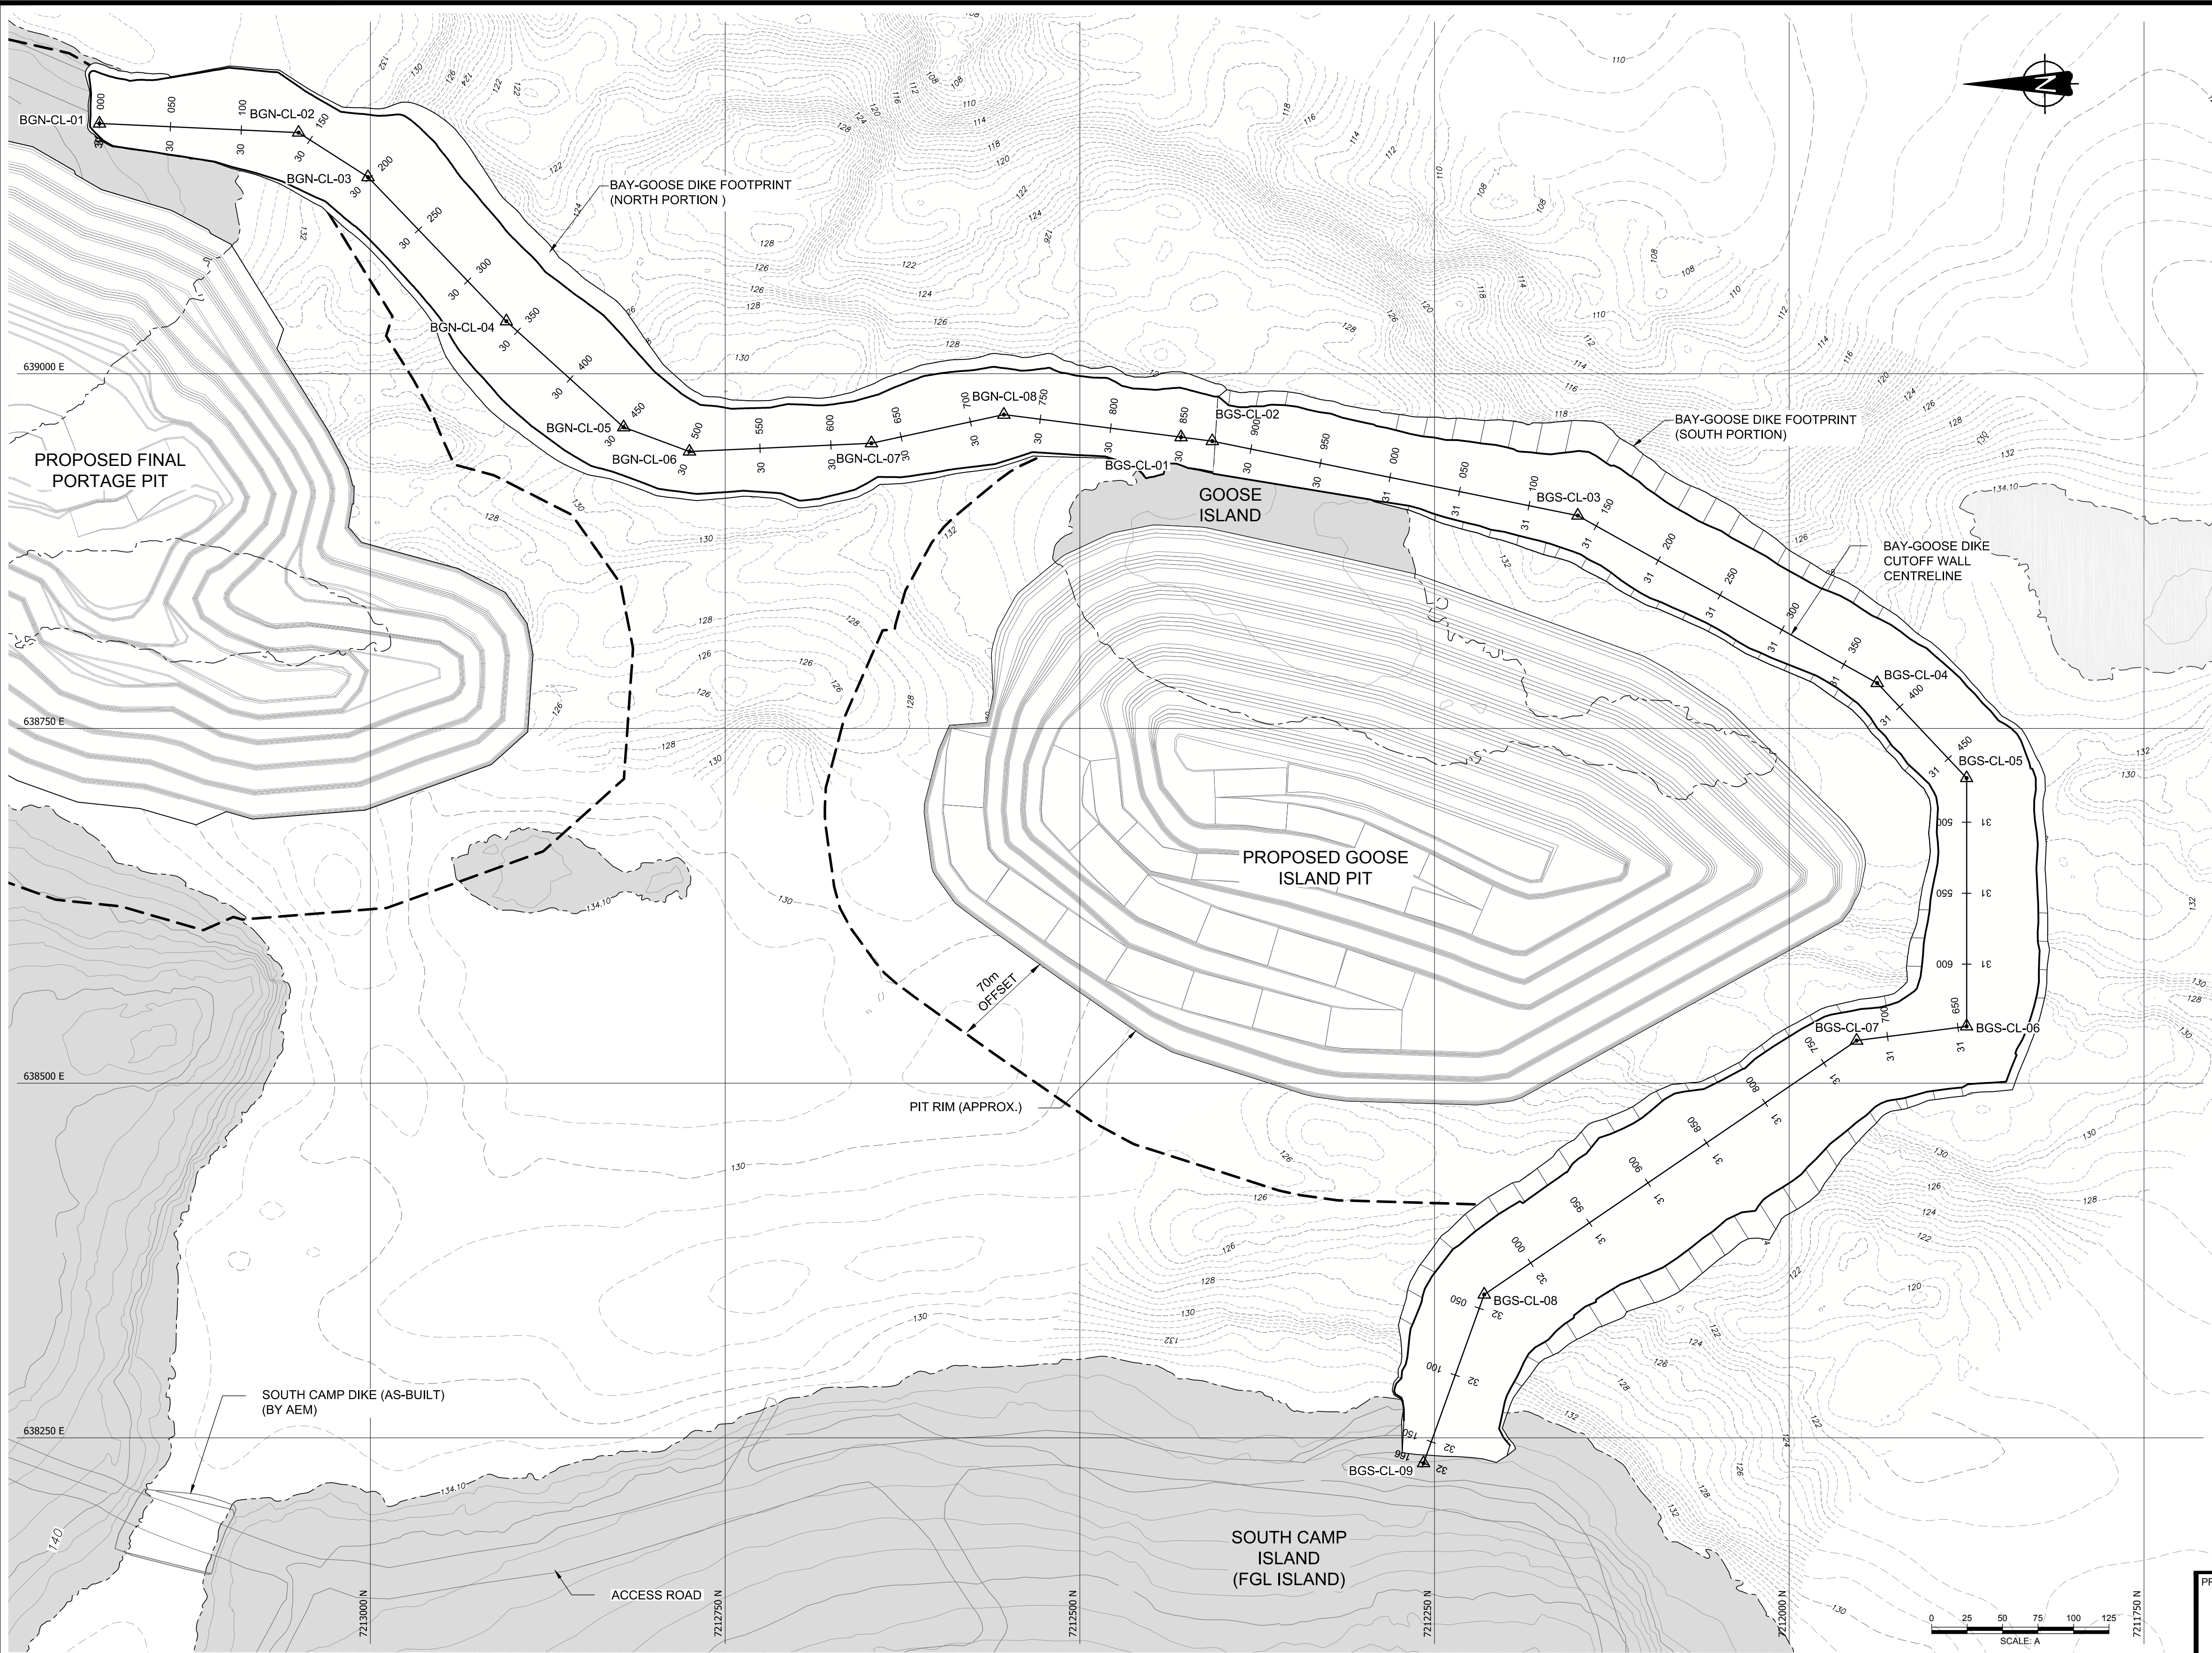

BAY-GOOSE DIKE NORTH PORTION CUTOFF WALL CENTRELINE AS-BUILT			
POINT ID	STATION	NORTHING	EASTING
BGN-CL-01	30+000.00	7213190.91	639176.31
BGN-CL-02	30+140.47	7213050.58	639169.93
BGN-CL-03	30+198.55	7213001.72	639138.54
BGN-CL-04	30+339.38	7212904.19	639036.94
BGN-CL-05	30+450.80	7212821.50	638962.27
BGN-CL-06	30+500.24	7212775.11	638945.16
BGN-CL-07	30+628.64	7212646.85	638951.00
BGN-CL-08	30+724.14	7212553.50	638971.16

BAY-GOOSE DIKE SOUTH PORTION CUTOFF WALL CENTRELINE AS-BUILT			
POINT ID	STATION	NORTHING	EASTING
BGS-CL-01	30+850.00	7212428.64	638955.28
BGS-CL-02	30+872.17	7212406.65	638952.48
BGS-CL-03	31+135.11	7212149.00	638900.00
BGS-CL-04	31+376.86	7211938.00	638782.00
BGS-CL-05	31+468.83	7211875.00	638715.00
BGS-CL-06	31+643.83	7211875.00	638540.00
BGS-CL-07	31+721.97	7211952.50	638530.00
BGS-CL-08	32+039.69	7212215.00	638351.00
BGS-CL-09	32+166.00	7212257.74	638232.15

LEGEND

BGS-CL-01	BAY-GOOSE SOUTH PORTION CENTRELINE AS-BUILT SETOUT POINT		
BGN-CL-01	BAY-GOOSE NORTH PORTION CENTRELINE AS-BUILT POINT		
-----	SHORELINE	-----	MINOR BATHYMETRY CONTOUR
-----	70m OFFSET FROM PIT RIM	-----	MAJOR BATHYMETRY CONTOUR
-----	PIT RIM	-----	MINOR TOPOGRAPHIC CONTOUR
-----	ROCKFILL PLATFORM CREST	-----	MAJOR TOPOGRAPHIC CONTOUR

NOTES




- 1) ALL DIMENSIONS ARE IN METRES UNLESS OTHERWISE NOTED.
- 2) ALL ELEVATIONS ARE IN METRES ABOVE SEA LEVEL (MASL), UNLESS OTHERWISE NOTED.
- 3) GRID REFERENCE: NAD 83, UTM ZONE 14.
- 4) SURVEYED LAKE SURFACE ELEVATION: THIRD PORTAGE LAKE = 134.1m (2008)
- 5) DIKE AXIS AND CUTOFF WALL CENTRELINE ARE THE SAME.

REFERENCE

- 1) PORTAGE PIT DESIGN BY AEM, MARCH, 2009.
- 2) GOOSE ISLAND PIT DESIGN BY AEM, MAY, 2010.
- 3) ROAD AND MINE FACILITIES PROVIDED BY AEM, JANUARY, 2009.
- 4) TOPOGRAPHIC CONTOUR INFORMATION ON LAND SUPPLIED BY AEM.
- 5) LAKEBED SURFACE BASED ON BATHYMETRIC SURVEYS BY GOLDER ASSOCIATES LTD., 2006 AND DETAILED (0.5m CONTOUR INTERVAL) 2008.

PROJECT	AEM		AGNICO-EAGLE MINES LIMITED MEADOWBANK GOLD PROJECT NUNAVUT	
	TITLE		BAY-GOOSE DIKE SOUTH PORTION CUTOFF WALL CENTRELINE SETOUT PLAN	
Golder Associates	PROJECT No.		09-1428-5007	
	FILE No.		4300_1_06	
	DESIGN	KD	02MAY10	SCALE AS SHOWN
	CADD	JK	10MAY10	REV. 1
	CHECK	FE	31MAY10	4300-06
	REVIEW	MRJ	31MAY10	

																																																																																																																																																																																																																																																																																																																																																																																																																																																																																																																																																																																																																																																																																																																																																																																																																																																																																																																																																																																																																																																																																																																																																																																																																																																																																																																																																																																																																					</
--	--	----

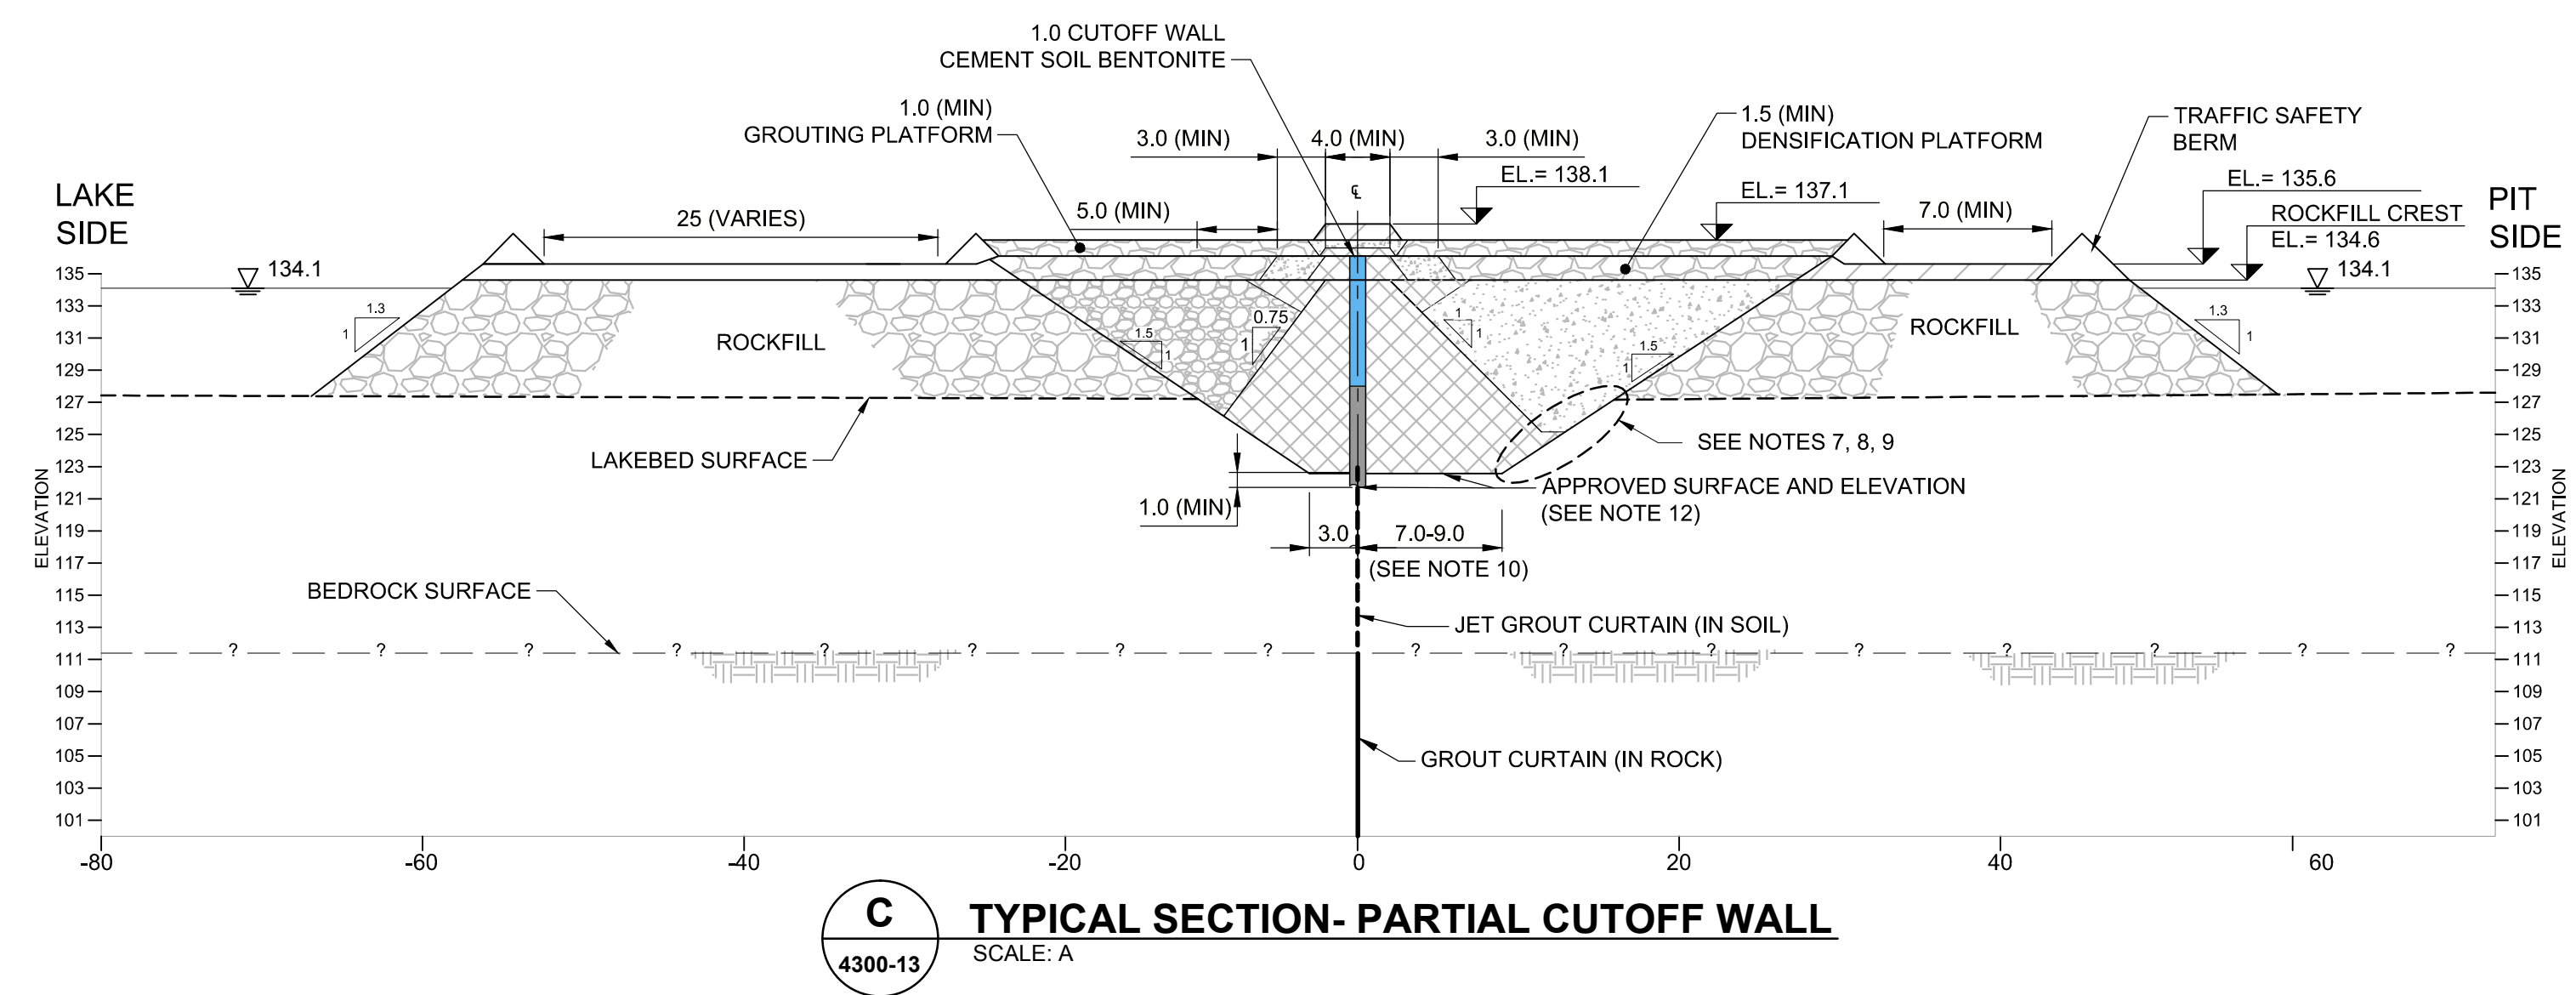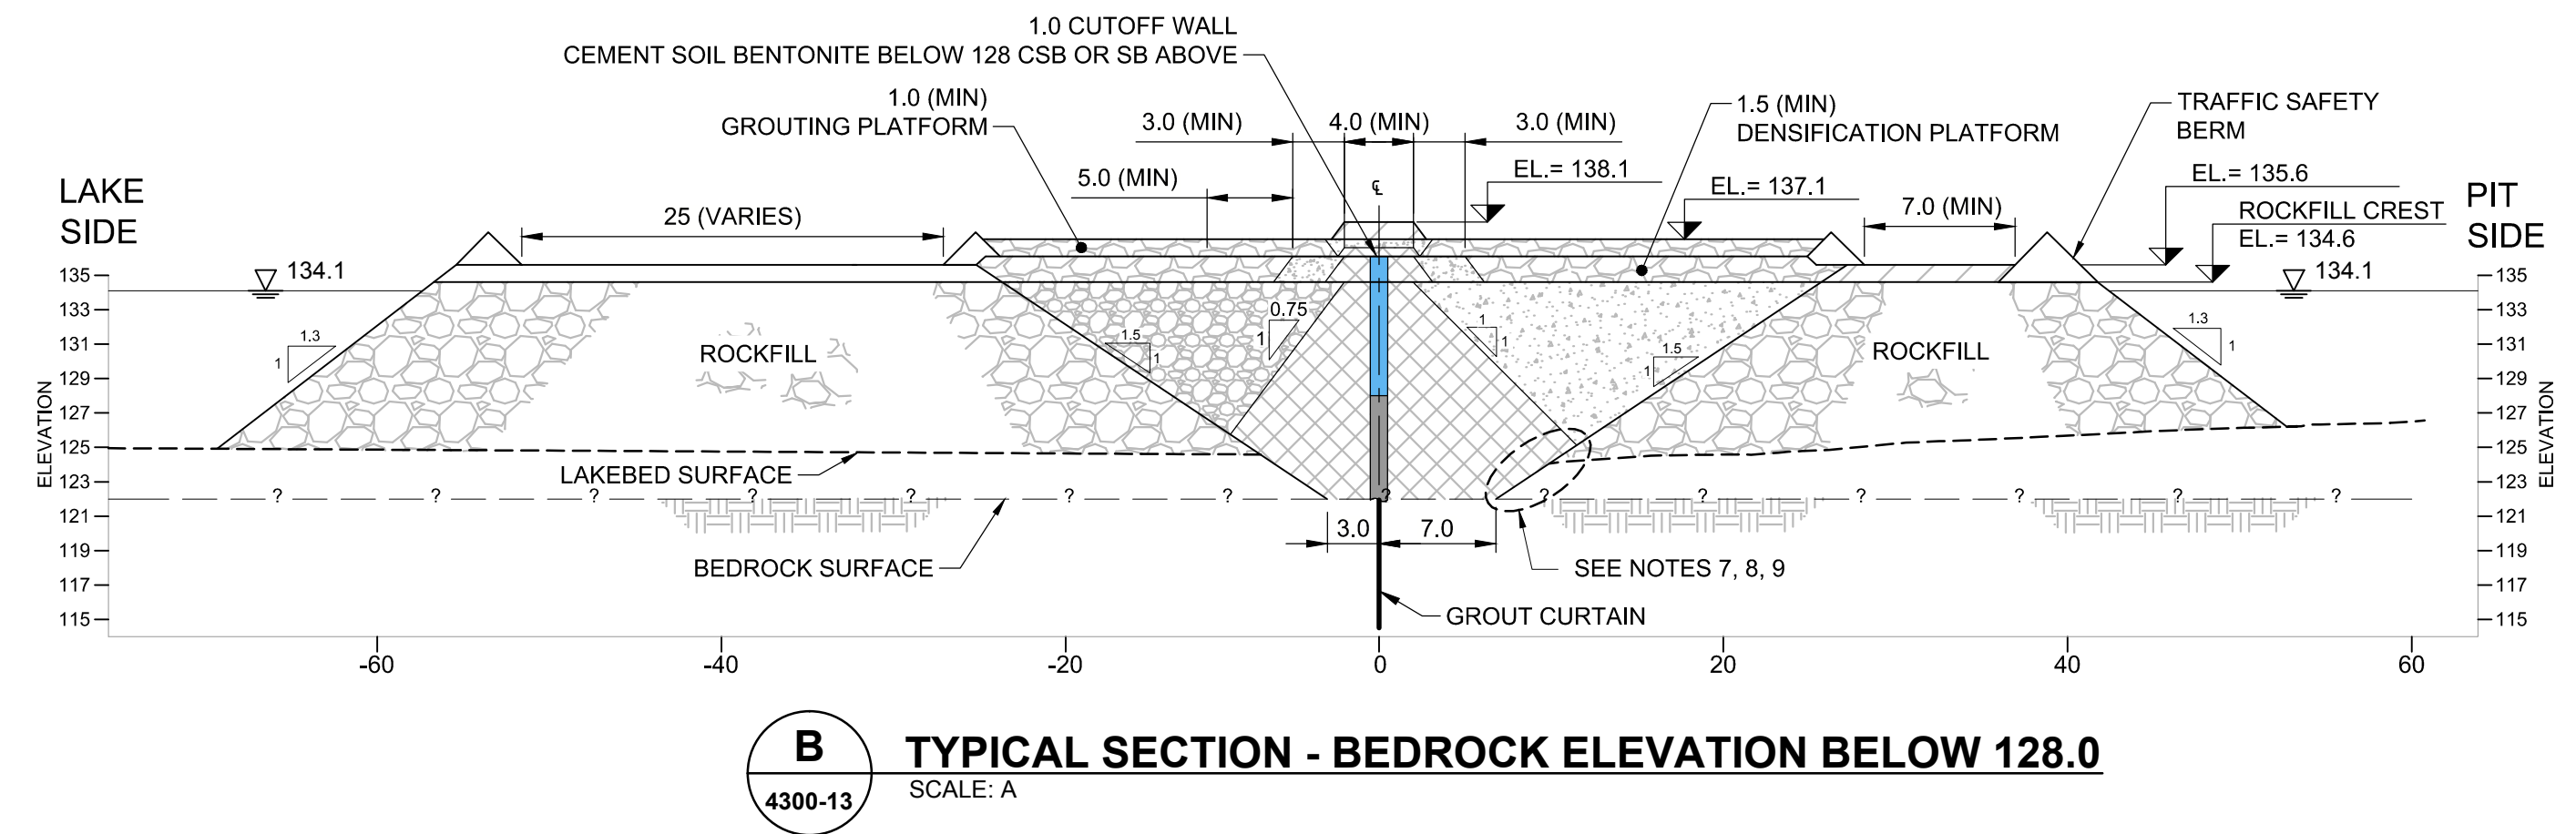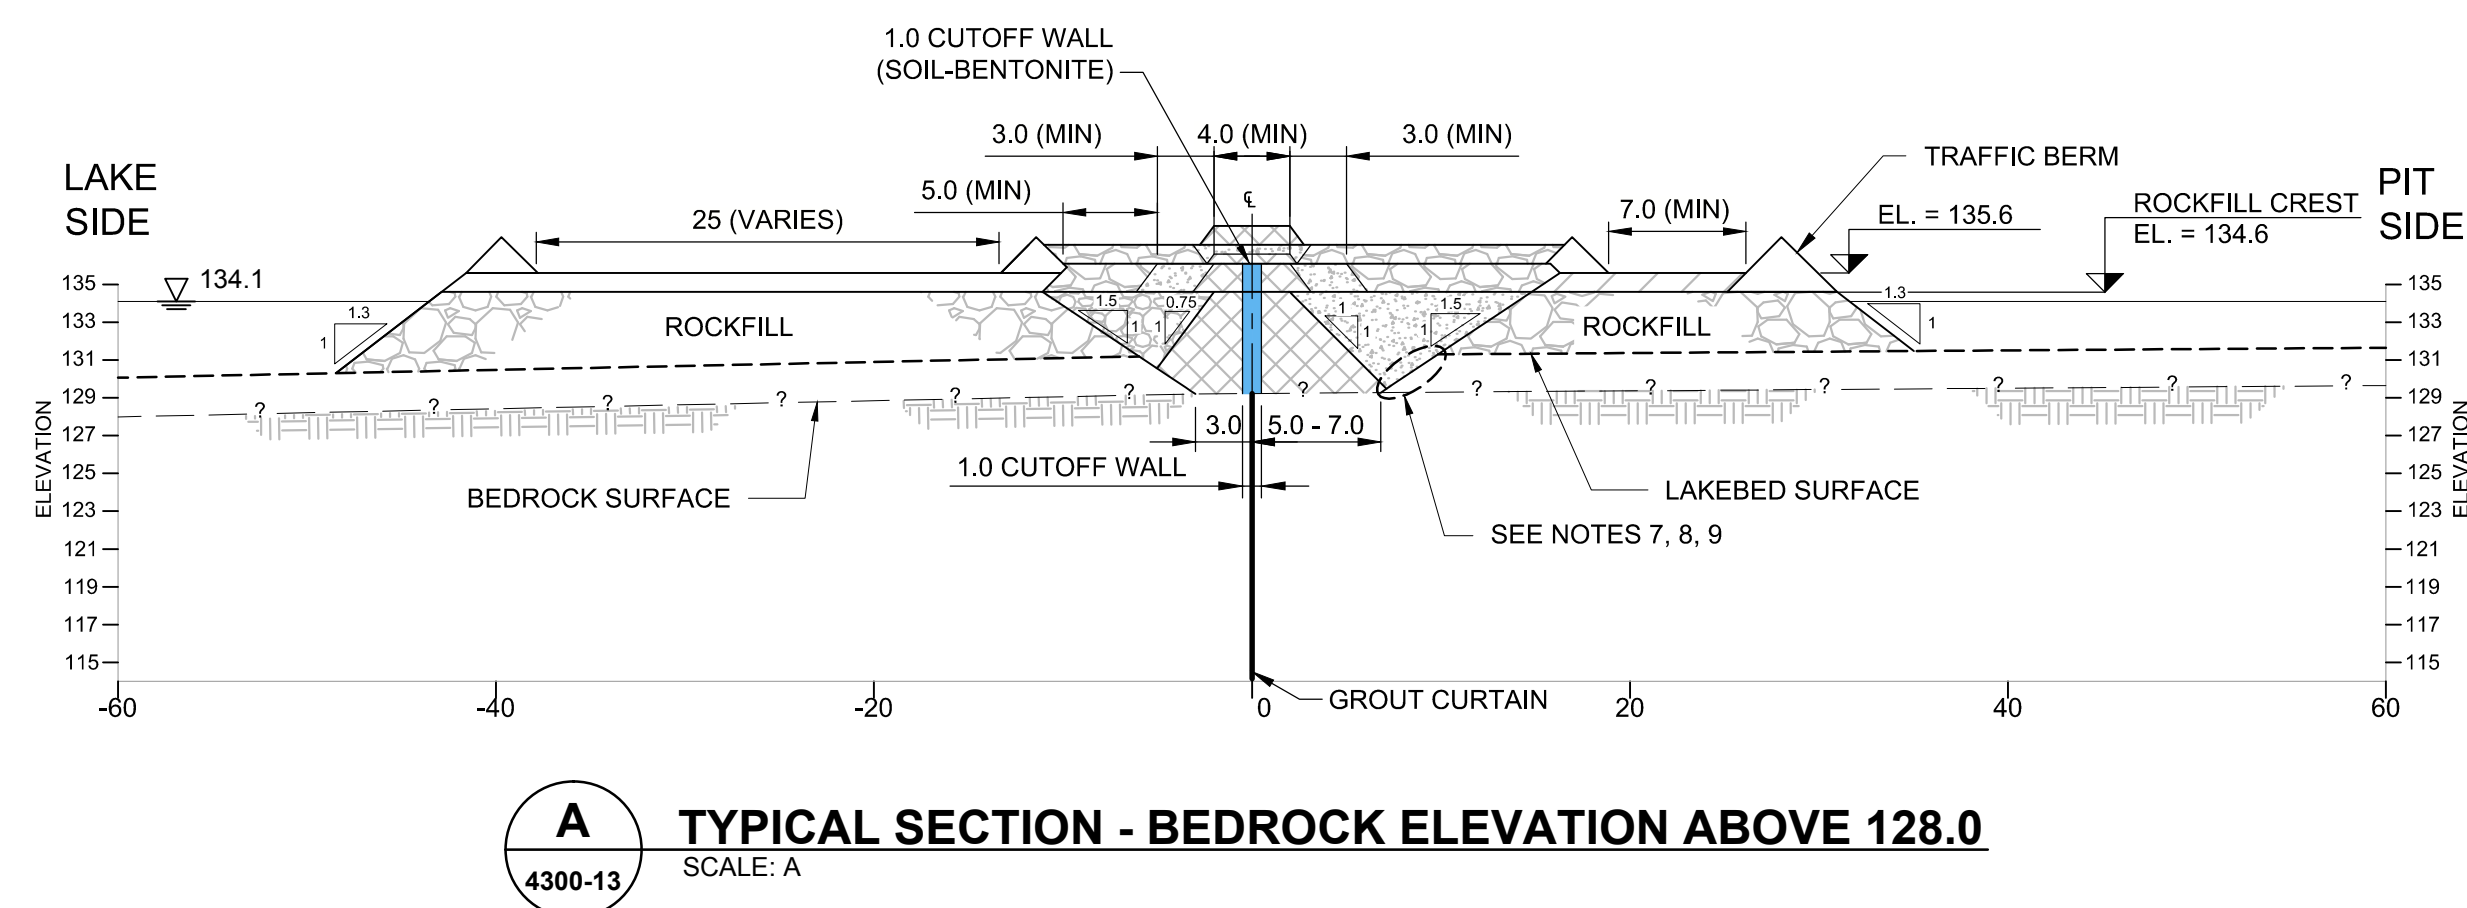


- ## NOTES


- 1) ALL DIMENSIONS ARE IN METRES UNLESS OTHERWISE NOTED.
- 2) ALL ELEVATIONS ARE IN METRES ABOVE SEA LEVEL (MASL), UNLESS OTHERWISE NOTED.
- 3) ALL SLOPES SHOWN ARE NOMINAL VALUES.
- 4) GEOCHEMICAL CLASSIFICATION OF NPAG MATERIALS IS THE RESPONSIBILITY OF AEM. ALL MATERIALS USED IN CONSTRUCTION ARE TO BE NPAG.
- 5) ALL ICE RICH MATERIAL BENEATH THE CUTOFF WALL WAS EXCAVATED, EXCEPT BETWEEN STA 32+112 AND 32+166.
- 6) BEDROCK AND LAKEBED SURFACES ARE SHOWN AS SMOOTH LINES FOR ILLUSTRATIVE PURPOSES. UNDULATING AND UNEVEN SURFACES EXIST.
- 7) CORE BACKFILL WITH THE DOWNSTREAM SIDE OF THE TRENCH WAS PLACED WITHIN 2m OF THE LAKEBED SEDIMENT ELEVATION.
- 8) MATERIAL PLACEMENT ANGLES FOR THE CORE BACKFILL AND COARSE FILTER ARE APPROXIMATE. DOWNSTREAM CORE BACKFILL SLOPE WAS MONITORED TO ENSURE THE 2m LIMIT (SEE NOTE 7) WAS ACHIEVED.
- 9) ALONG PORTIONS OF THE ALIGNMENT, LATERAL PLACEMENT OF CORE BACKFILL ON THE DOWNSTREAM SIDE OF THE EXCAVATION WAS REQUIRED IN ADVANCE OF THE PROGRESSIVE BACKFILLING OF CORE BACKFILL AND COARSE FILTER/FINE ROCKFILL. THE ENGINEER DETERMINED WHERE LATERAL PLACEMENT WAS REQUIRED.
- 10) IN PARTIAL CUTOFF WALL SECTIONS, WHERE DEPTH OF SOIL LEFT IN PLACE IS LESS THAN 4m BELOW BASE OF INITIAL EXCAVATION THEN DIMENSION IS 7.0m OTHERWISE 9.0m, IN CHANNEL 1 DIMENSIONS WERE APPROXIMATELY 7m.
- 11) BASE WIDTH OF EXCAVATION ON UPSTREAM SIDE OF CENTRELINE WAS INCREASED LOCALLY TO 6m TO ACCOMMODATE CORNER CONSTRUCTION OF CUTOFF WALL.
- 12) IN PARTIAL CUTOFF SECTIONS THE INITIAL EXCAVATION WAS EXCAVATED UNTIL COMPETENT SOILS ENCOUNTERED, AND CUTOFF TRENCH EXTENDED GENERALLY 1.0m INTO COMPETENT MATERIAL BELOW INITIAL TRENCH EXCAVATION, AS APPROVED BY ENGINEER.

- ## LEGEND


- | | |
|--|------------------------------------|
| | INFERRED BEDROCK |
| | COARSE FILTER |
| | CORE BACKFILL |
| | ROCKFILL SURFACING AND THERMAL CAP |
| | ROCKFILL |
| | FINE ROCKFILL |
| | SOIL BENTONITE (SB) |
| | CEMENT SOIL BENTONITE (CSB) |

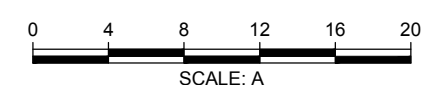[illegible]


REVISION DATE: 12/15/2012 4:15:40 PM By: T.Y.KLASSEN CADD FILE: \\s:\bur-graphics\Projects\2009\1428-5007\Drafting\4300\meadowbank - bay-goose (south) dike as-built\4300_2_12.dwg

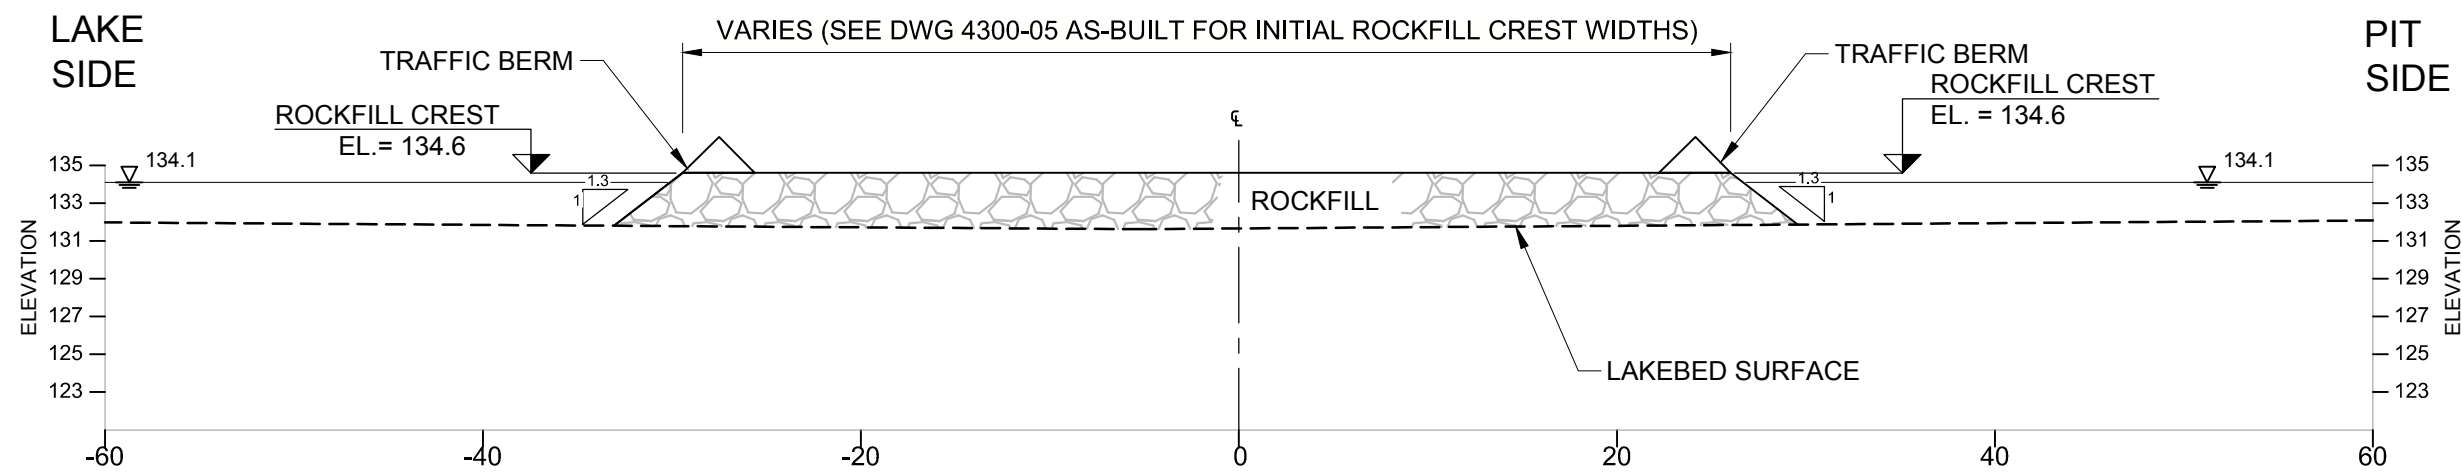

A INITIAL ROCKFILL PLACEMENT SECTION
SCALE: A

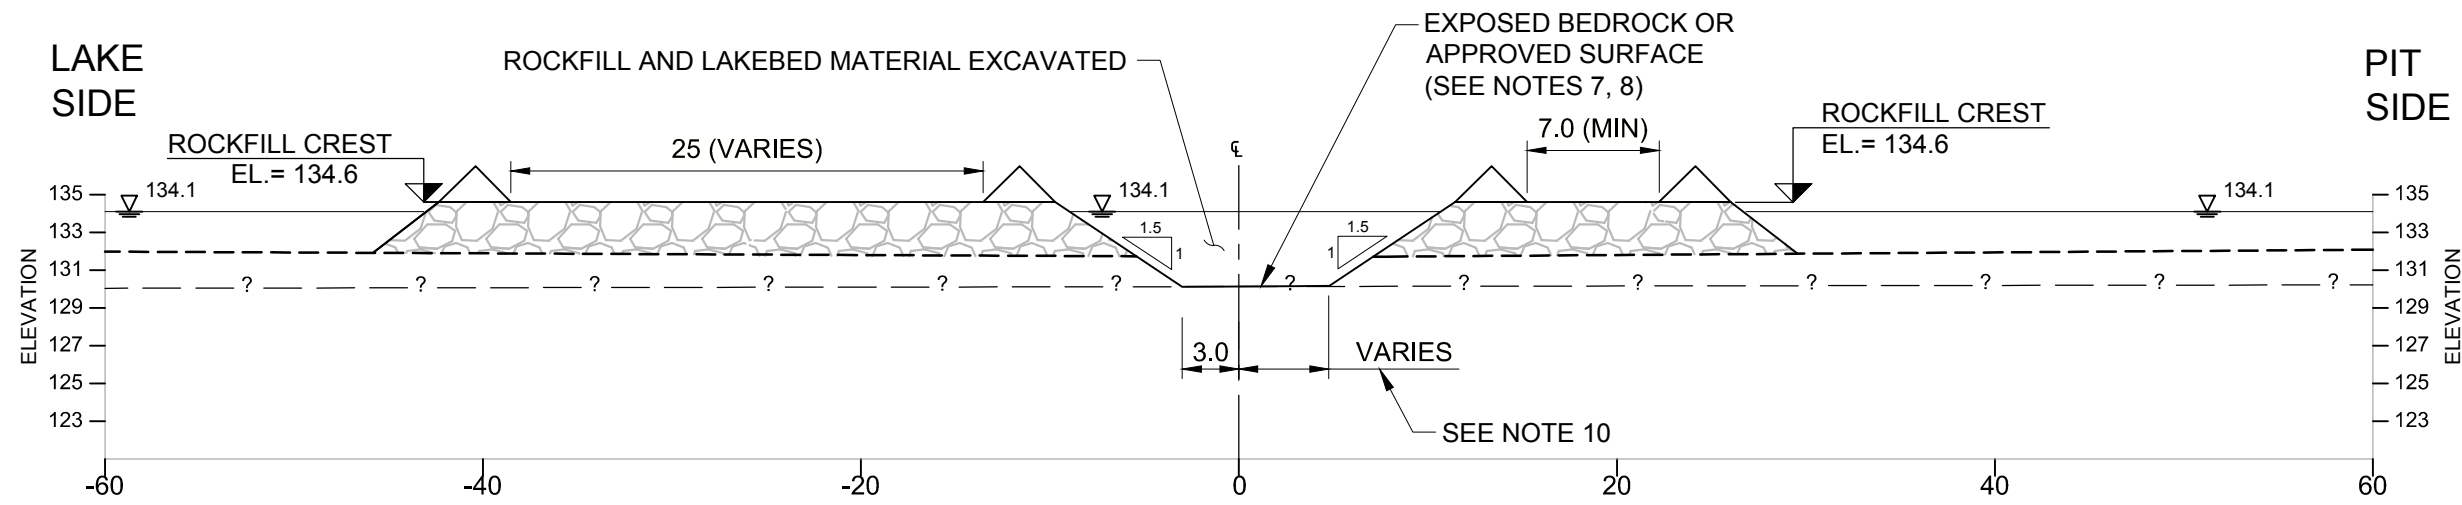

B EXCAVATION TO BEDROCK OR APPROVED SURFACE SECTION
SCALE: A

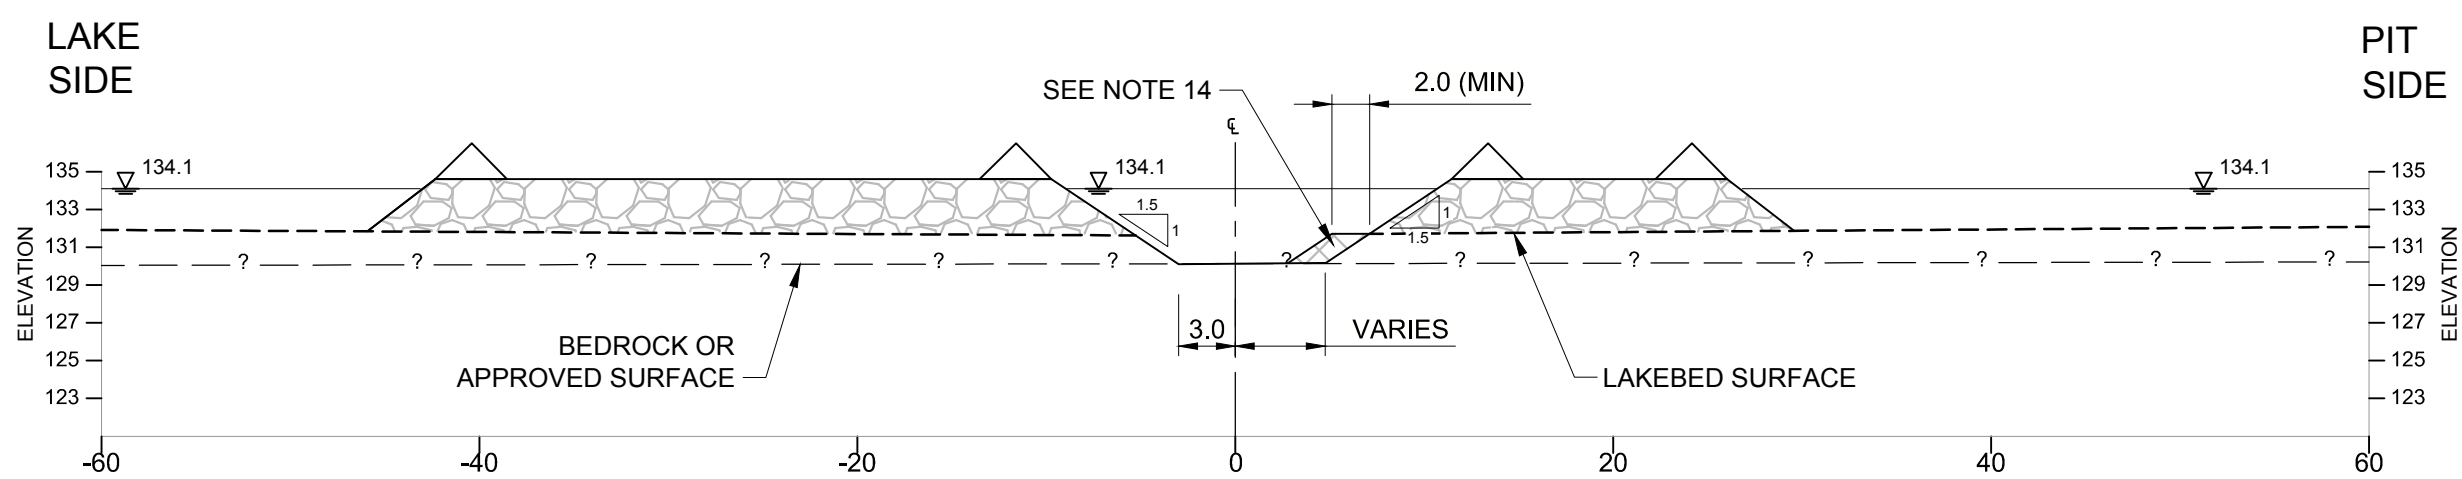


C CORE BACKFILL FILTER PLACEMENT SECTION (WHEN NEEDED)
SCALE: A

NOTES


- 1) ALL DIMENSIONS ARE IN METRES UNLESS OTHERWISE NOTED.
- 2) ALL ELEVATIONS ARE IN METRES ABOVE SEA LEVEL (MASL), UNLESS OTHERWISE NOTED.
- 3) LAKEBED SURFACE BASED ON BATHYMETRIC SURVEY BY GOLDER ASSOCIATES LTD. 2008. DEPTH TO LAKEBED AND BEDROCK BENEATH CUTOFF WALL CENTRELINE INFERRED, BASED ON GEOTECHNICAL INVESTIGATIONS.
- 4) WIDTH OF ROCKFILL TO BE ADJUSTED IN FIELD TO SUIT CONDITIONS, IF NECESSARY.
- 5) ROCKFILL SURFACING AND THERMAL CAP TO BE PLACED BY AEM. PLACEMENT IN PROGRESS AS OF APRIL 2013.
- 6) GEOCHEMICAL CLASSIFICATION OF NPAG MATERIALS IS THE RESPONSIBILITY OF AEM. ALL MATERIALS USED IN CONSTRUCTION ARE TO BE NPAG.
- 7) EXCAVATION TO BEDROCK SURFACE OR SURFACE APPROVED BY ENGINEER.
- 8) ALL ICE RICH MATERIAL BENEATH THE CUTOFF WALL TO BE EXCAVATED, EXCEPT BETWEEN STA. 32+112 AND 32+166.
- 9) BEDROCK AND LAKEBED SURFACES ARE SHOWN AS SMOOTH LINES FOR ILLUSTRATIVE PURPOSES. CONTRACTOR SHOULD ANTICIPATE UNDULATING AND UNEVEN SURFACES.
- 10) WIDTH OF EXCAVATION VARIES. SEE DRAWINGS 4300-10, 4300-15, 4300-16, 4300-17, 4300-18 AND 4300-19 FOR DETAILS.
- 11) BASE WIDTH OF EXCAVATION ON UPSTREAM SIDE OF CENTRELINE NEEDS TO BE INCREASED LOCALLY TO 6m TO ACCOMMODATE CORNER CONSTRUCTION OF CUTOFF WALL.
- 12) CORE BACKFILL WITHIN THE DOWNSTREAM SIDE OF THE TRENCH IS TO BE PLACED AT LEAST WITHIN 2m OF THE LAKEBED SEDIMENT ELEVATION.
- 13) MATERIAL PLACEMENT ANGLES FOR THE COARSE FILTER AND CORE BACKFILL ARE APPROXIMATE. DOWNSTREAM CORE BACKFILL SLOPE IS TO BE MONITORED TO ENSURE THE 2m LIMIT (SEE NOTE 12) IS ACHIEVED.
- 14) ALONG PORTIONS OF THE ALIGNMENT, LATERAL PLACEMENT OF CORE BACKFILL ON THE DOWNSTREAM SIDE OF THE EXCAVATION WAS REQUIRED IN ADVANCE OF THE PROGRESSIVE BACKFILLING OF CORE BACKFILL AND COARSE FILTER/FINE ROCKFILL. THE ENGINEER DETERMINED WHERE LATERAL PLACEMENT WAS REQUIRED.
- 15) COARSE FILTER/FINE ROCKFILL MATERIAL WAS LOCALLY EXCAVATED AND REPLACED WITH CORE BACKFILL FOR VIBRO-DENSIFICATION.

LEGEND


- COARSE FILTER
- CORE BACKFILL
- ROCKFILL SURFACING AND THERMAL CAP
- ROCKFILL
- FINE ROCKFILL
- CUTOFF WALL (SOIL BENTONITE AND/OR CEMENT SOIL BENTONITE)

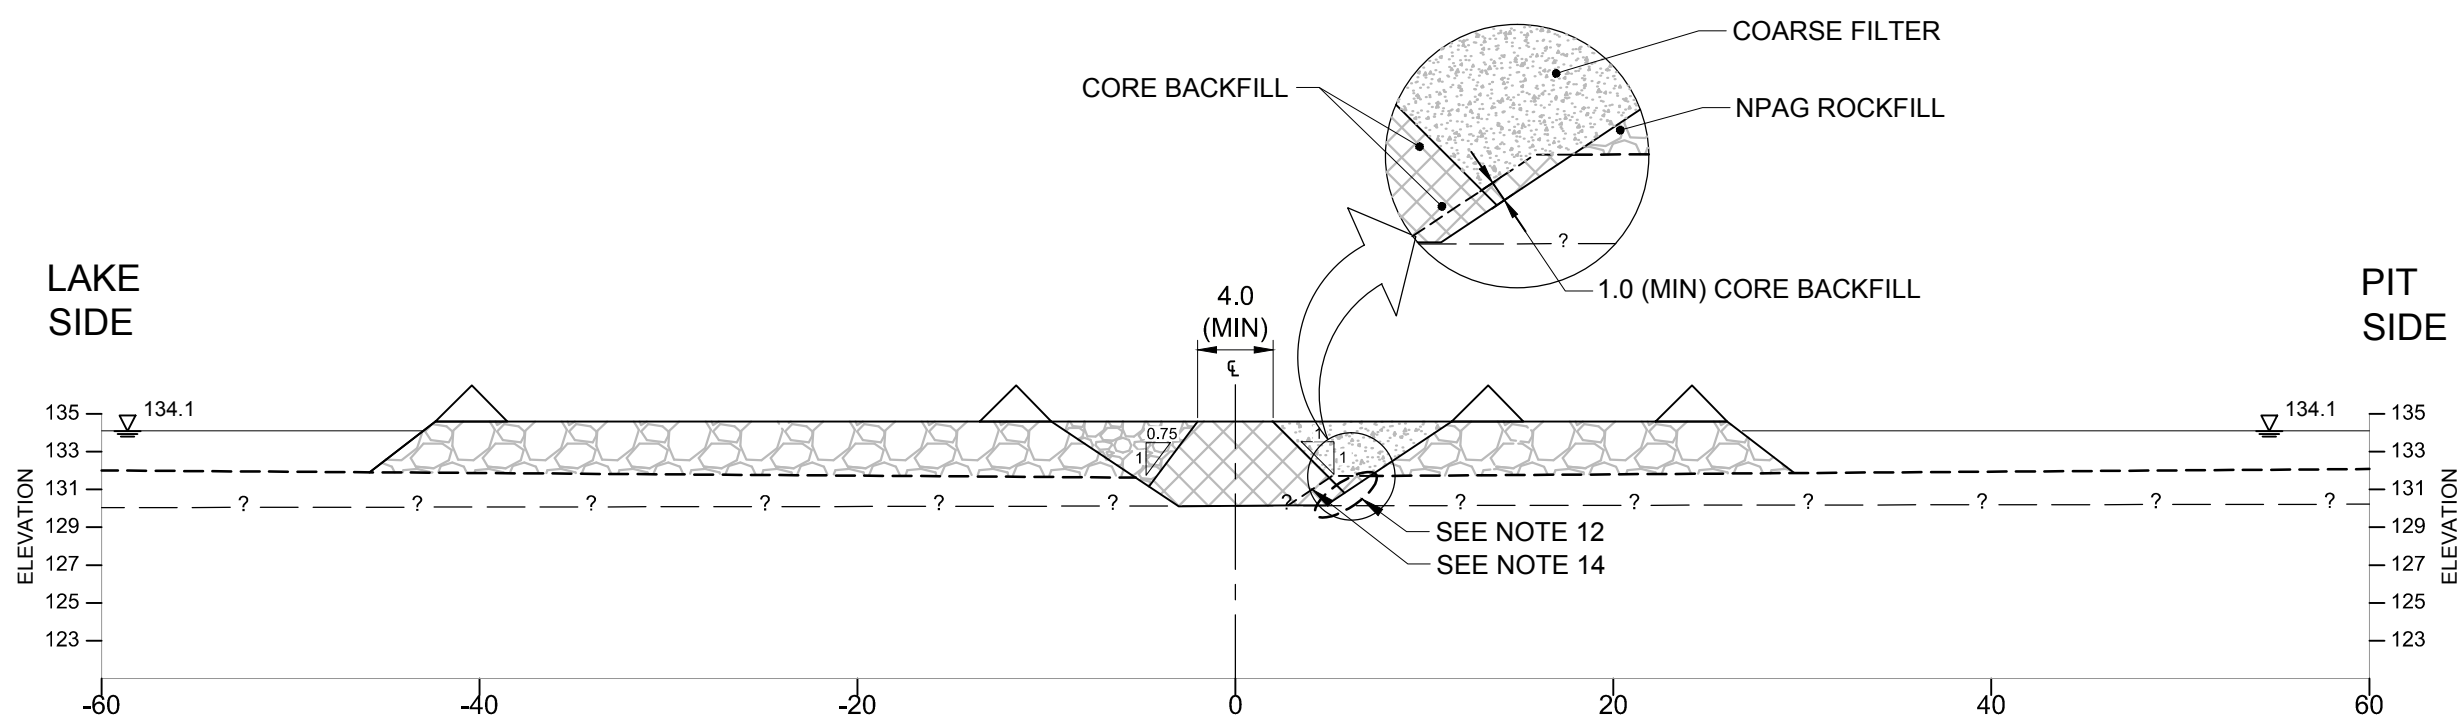


D CORE BACKFILL, COARSE FILTER AND FINE ROCKFILL PLACEMENT SECTION
SCALE: A

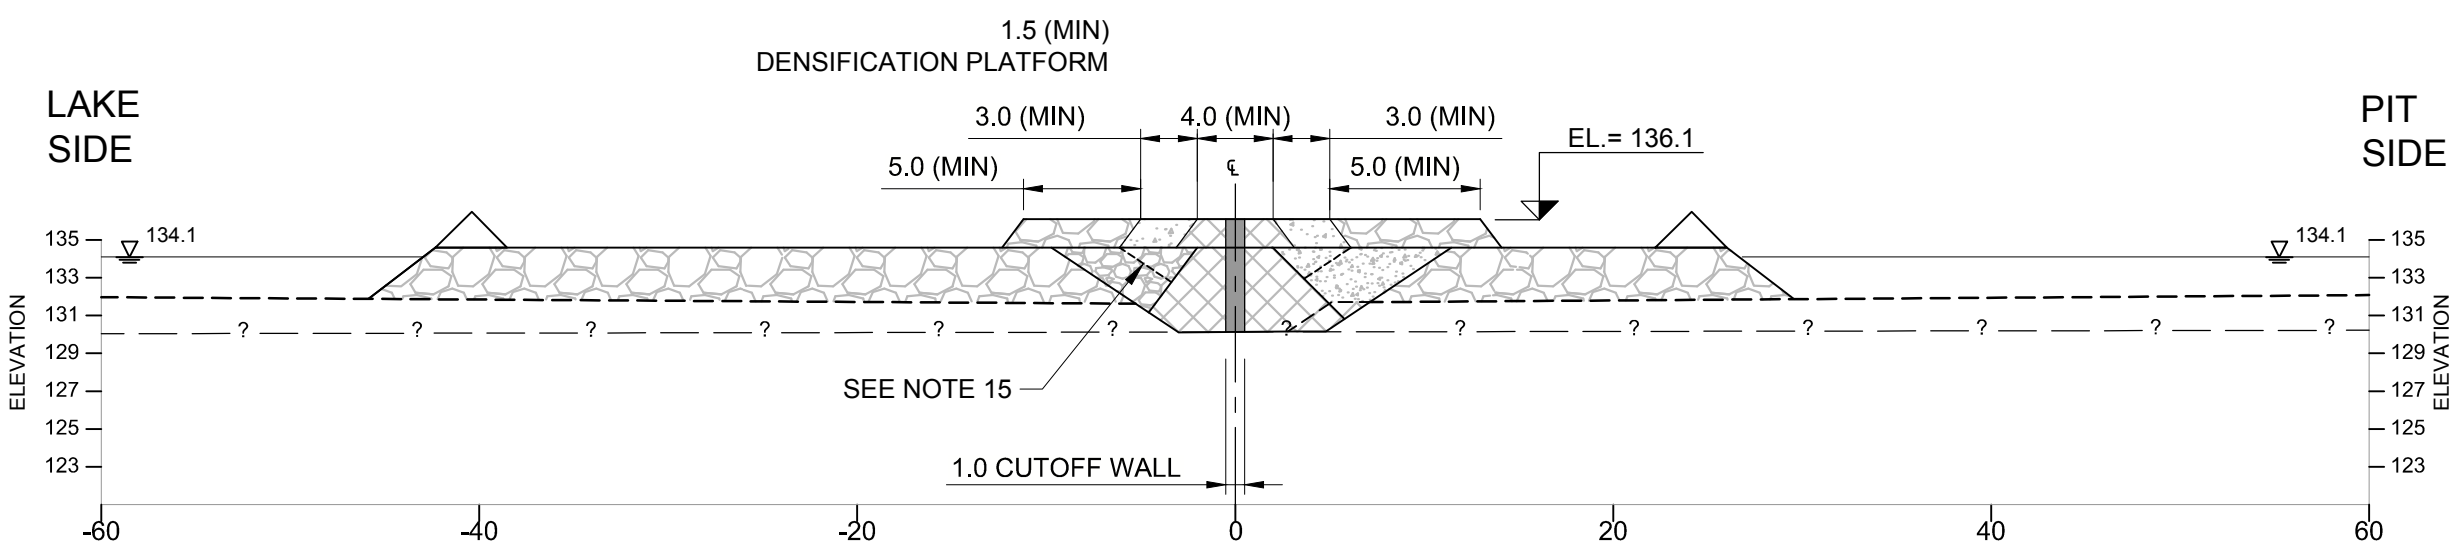

E DENSIFICATION PLATFORM AND CUTOFF WALL PLACEMENT SECTION
SCALE: A

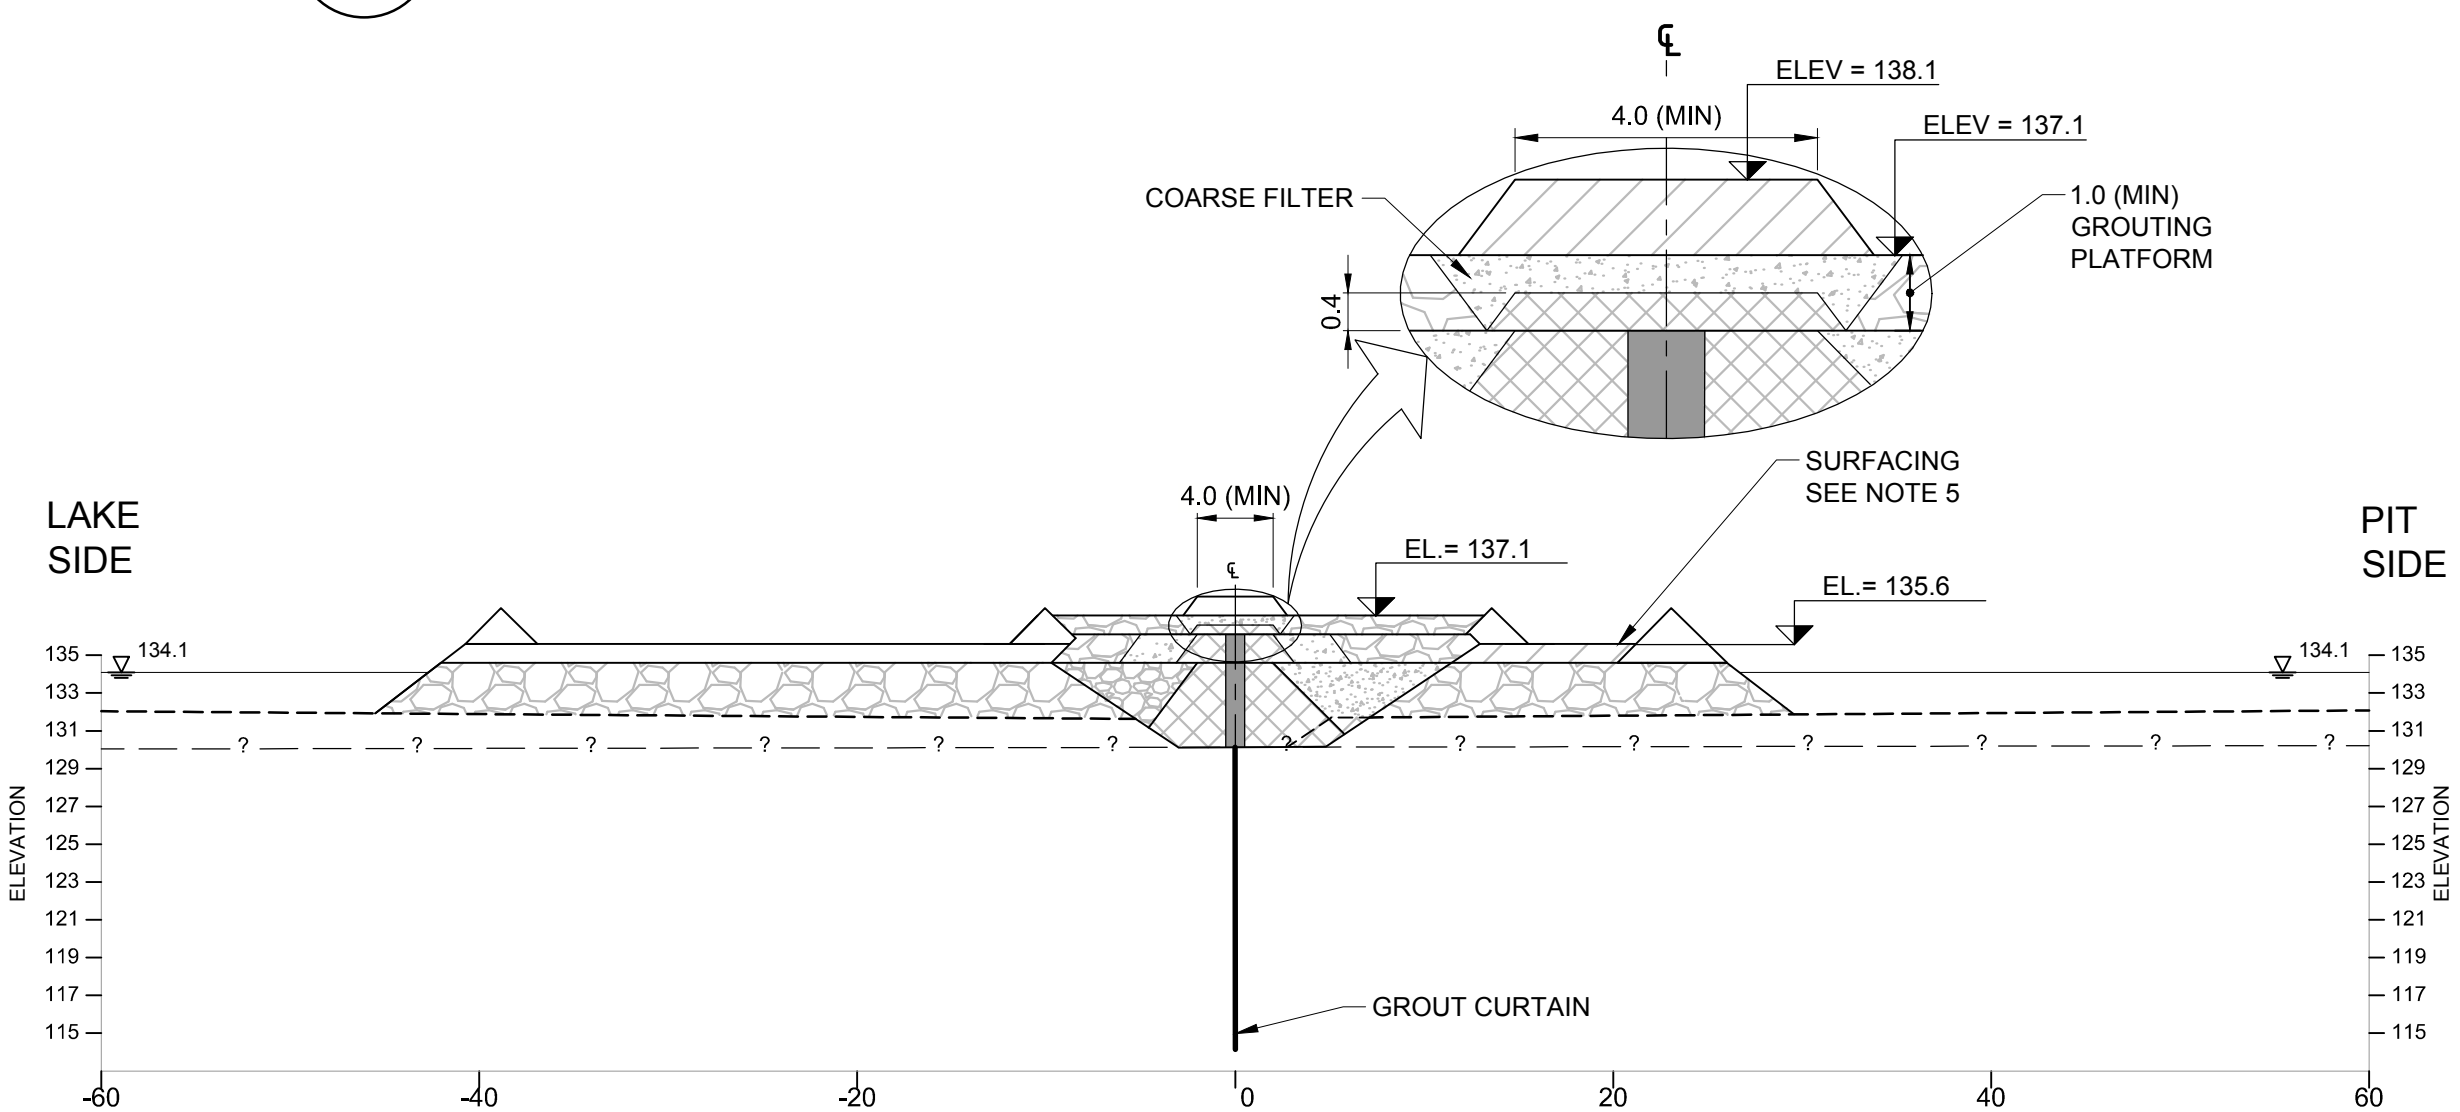

F ROCKFILL SURFACING AND GROUTING PLATFORM PLACEMENT SECTION
SCALE: A

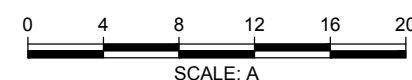


REVISION DATE: 12/15/2012 4:15:40 PM By: T.Y.KLASSEN CADD FILE: \\s:\bur-graphics\Projects\2009\1428-5007\Drafting\4300\meadowbank - bay-goose (south) dike as-built\4300_2_12.dwg


DRAWING NO.	REFERENCES	REV	DATE	DES	REVISION DESCRIPTION	CADD	CHK	RVW	STAMP
		2	15DEC12	FE	AS-BUILT	EA	GRB	FE	
		3	20AUG10	DW	REVISED NOTE 15 AND SECTION TITLE	JK	FE	MRJ	
		4	06JUL10	KD	ISSUED FOR CONSTRUCTION	JK	FE	MRJ	
		5	18JUN10	KD	ISSUED FOR CLIENT REVIEW	JK	FE	MRJ	
		6	31MAY10	KD	ISSUED FOR CLIENT REVIEW	NS	FE	MRJ	

PROJECT	AGNICO-EAGLE MINES LIMITED MEADOWBANK GOLD PROJECT NUNAVUT		
TITLE			
BAY-GOOSE DIKE SOUTH PORTION TYPICAL MATERIAL PLACEMENT SECTIONS			
 Golder Associates	PROJECT No.		09-1428-5007
	DESIGN		KD 02MAY10
	CADD		NS 10MAY10
	CHECK		FE 31MAY10
	REVIEW		MRJ 31MAY10
FILE No.		4300_2_12	
SCALE		AS SHOWN	REV. 2
		4300-12	

Drawing File: N:\User-graphics\Projects\4300-1-14.dwg Date: 2012-12-03 14:28:5007\Drafting\4300\meadowbank - bay-goose (south) file: as-built\4300-1-14.dwg Layout: 4300-1-14 Thursday, December 06, 2012 12:08:33 PM By: T.Y. Jensen

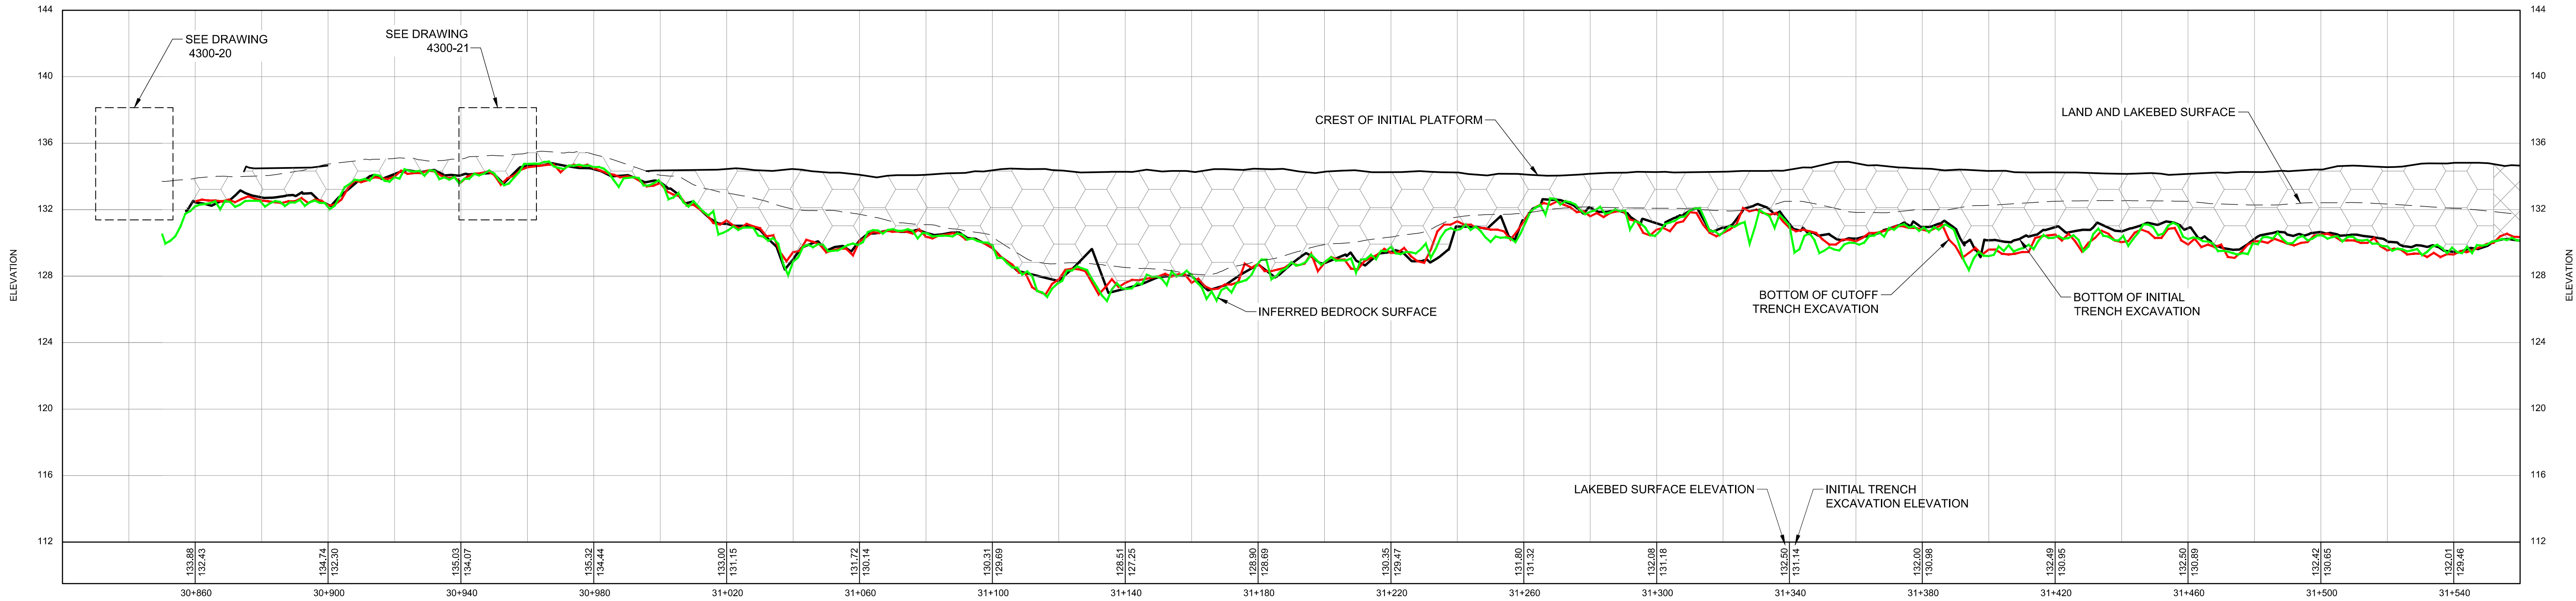

INITIAL TRENCH EXCAVATION PROFILE
VERTICAL EXAGGERATION 5X

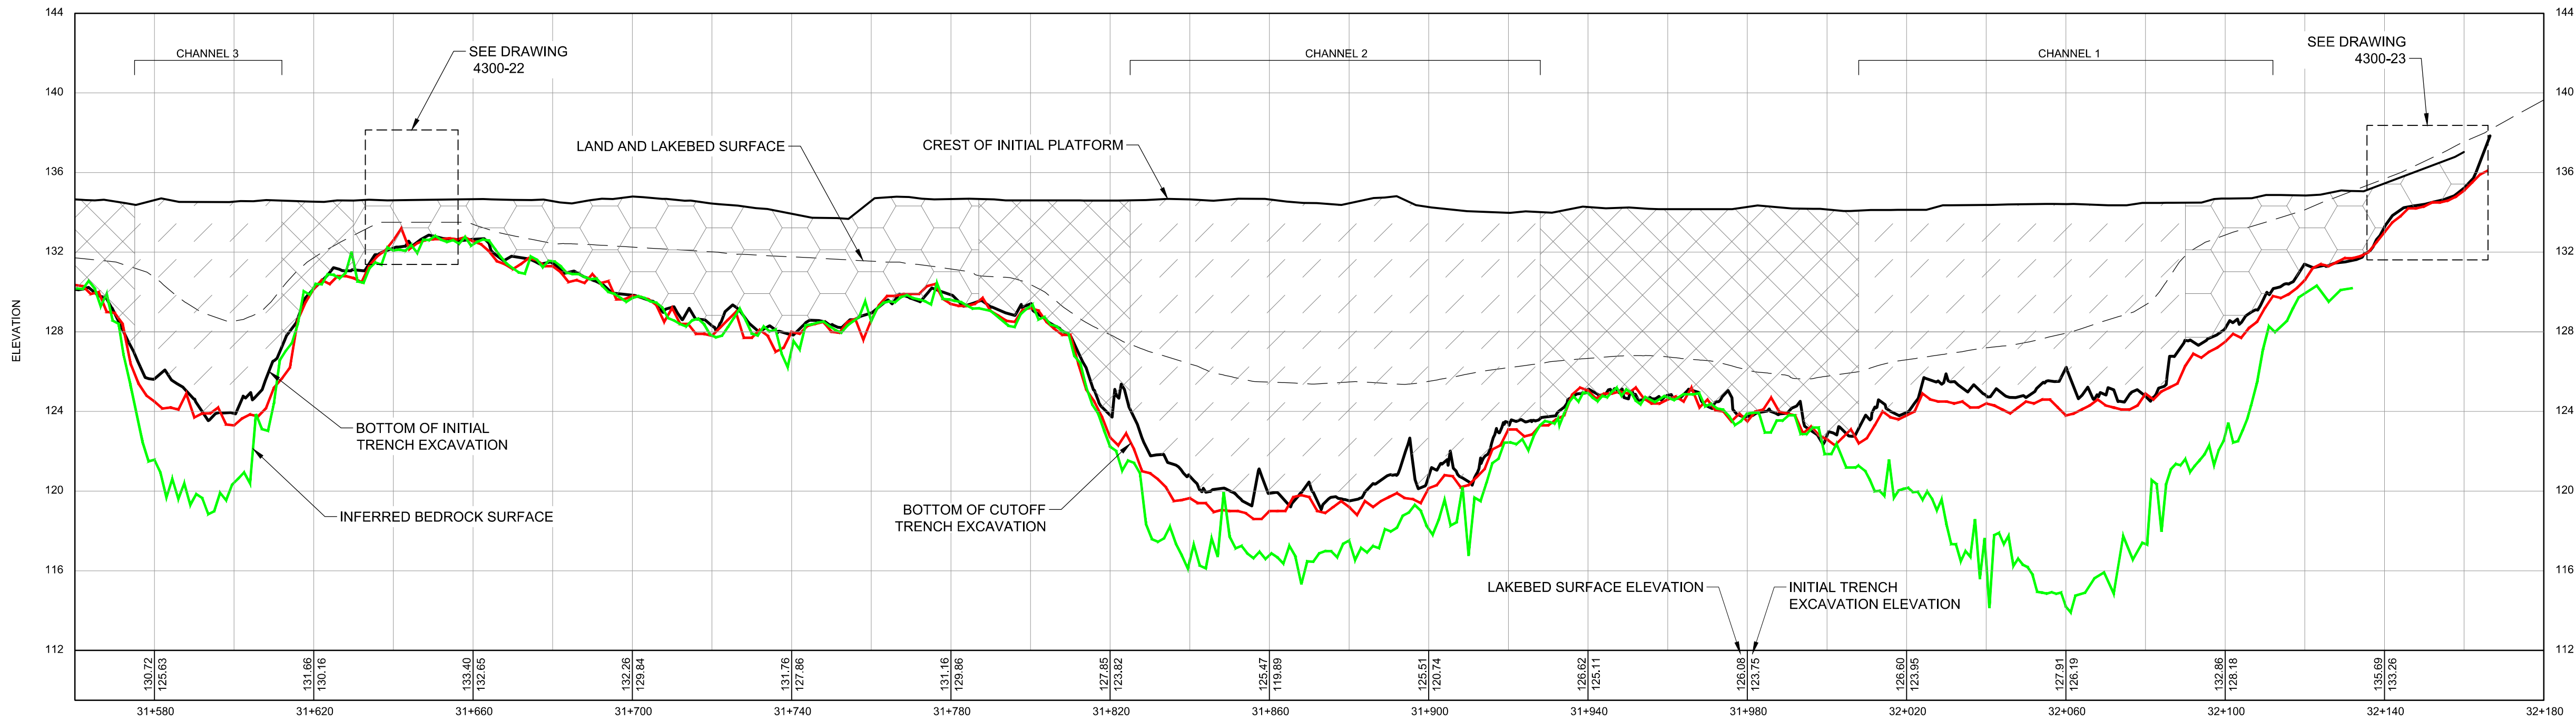


INITIAL TRENCH EXCAVATION PROFILE
VERTICAL EXAGGERATION 5X

LEGEND



	SECTION A DWG 4300-10
	SECTION B DWG 4300-10
	SECTION C DWG 4300-10 (PARTIAL CUTOFF)
	CREST OF INITIAL PLATFORM
	INITIAL TRENCH EXCAVATION
	LAND AND LAKEBED SURFACE
	INFERRED BEDROCK (DRILLING/JET GROUTING)
	BOTTOM OF CUTOFF TRENCH EXCAVATION (BEDROCK OR COMPETENT SOIL)

- NOTES**
- 1) ALL DIMENSIONS ARE IN METRES UNLESS OTHERWISE NOTED.
 - 2) ALL ELEVATIONS ARE IN METRES ABOVE SEA LEVEL (MASL), UNLESS OTHERWISE NOTED.
 - 3) TOPOGRAPHIC CONTOUR INFORMATION ON LAND SUPPLIED BY AEM.
 - 4) LAKEBED SURFACE BASED ON BATHYMETRIC SURVEYS BY GOLDER ASSOCIATES LTD., 2006 AND DETAILED (0.5m CONTOUR INTERVAL) 2008.
 - 5) INFERRED BEDROCK BASED ON INFORMATION OBTAINED DURING JET GROUTING AND CASING INSTALLATION FOR GROUTING.
 - 6) INITIAL TRENCH EXCAVATED TO BEDROCK, EXCEPT IN PARTIAL CUTOFF ZONES (CHANNEL 1, 2, AND 3). IN PARTIAL CUTOFF ZONES, EXCAVATION WAS EXTENDED UNTIL COMPETENT SOILS REACHED, AS APPROVED BY ENGINEER.
 - 7) CUTOFF TRENCH EXCAVATION TO BEDROCK, EXCEPT IN CHANNEL 1, 2, AND 3 WHERE EXCAVATION STOPPED IN COMPETENT SOIL.

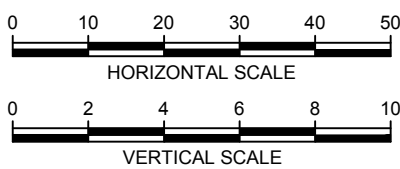

PROJECT		AGNICO-EAGLE MINES LIMITED MEADOWBANK GOLD PROJECT NUNAVUT			
TITLE	BAY-GOOSE DIKE SOUTH PORTION INITIAL TRENCH EXCAVATION PROFILE				
	PROJECT No.	09-1428-5007	FILE No.	4300_1_14	
	DESIGN	KD	02MAY10	SCALE	AS SHOWN
	CADD	NS	10MAY10	REV.	1
	CHECK	FE	31MAY10	4300-14	
	REVIEW	MRJ	31MAY10		


DRAWING NO.	REFERENCES	REV	DATE	DES	REVISION DESCRIPTION	CADD	CHK	RVW	STAMP
		A	15DEC12	FE	AS-BUILT	EA	GRB	FE	
		B	06JUL10	KD	ISSUED FOR CONSTRUCTION	JK	FE	MRJ	
		C	18JUN10	KD	ISSUED FOR CLIENT REVIEW	JK	FE	MRJ	
		D	31MAY10	KD	ISSUED FOR CLIENT REVIEW	JK	FE	MRJ	

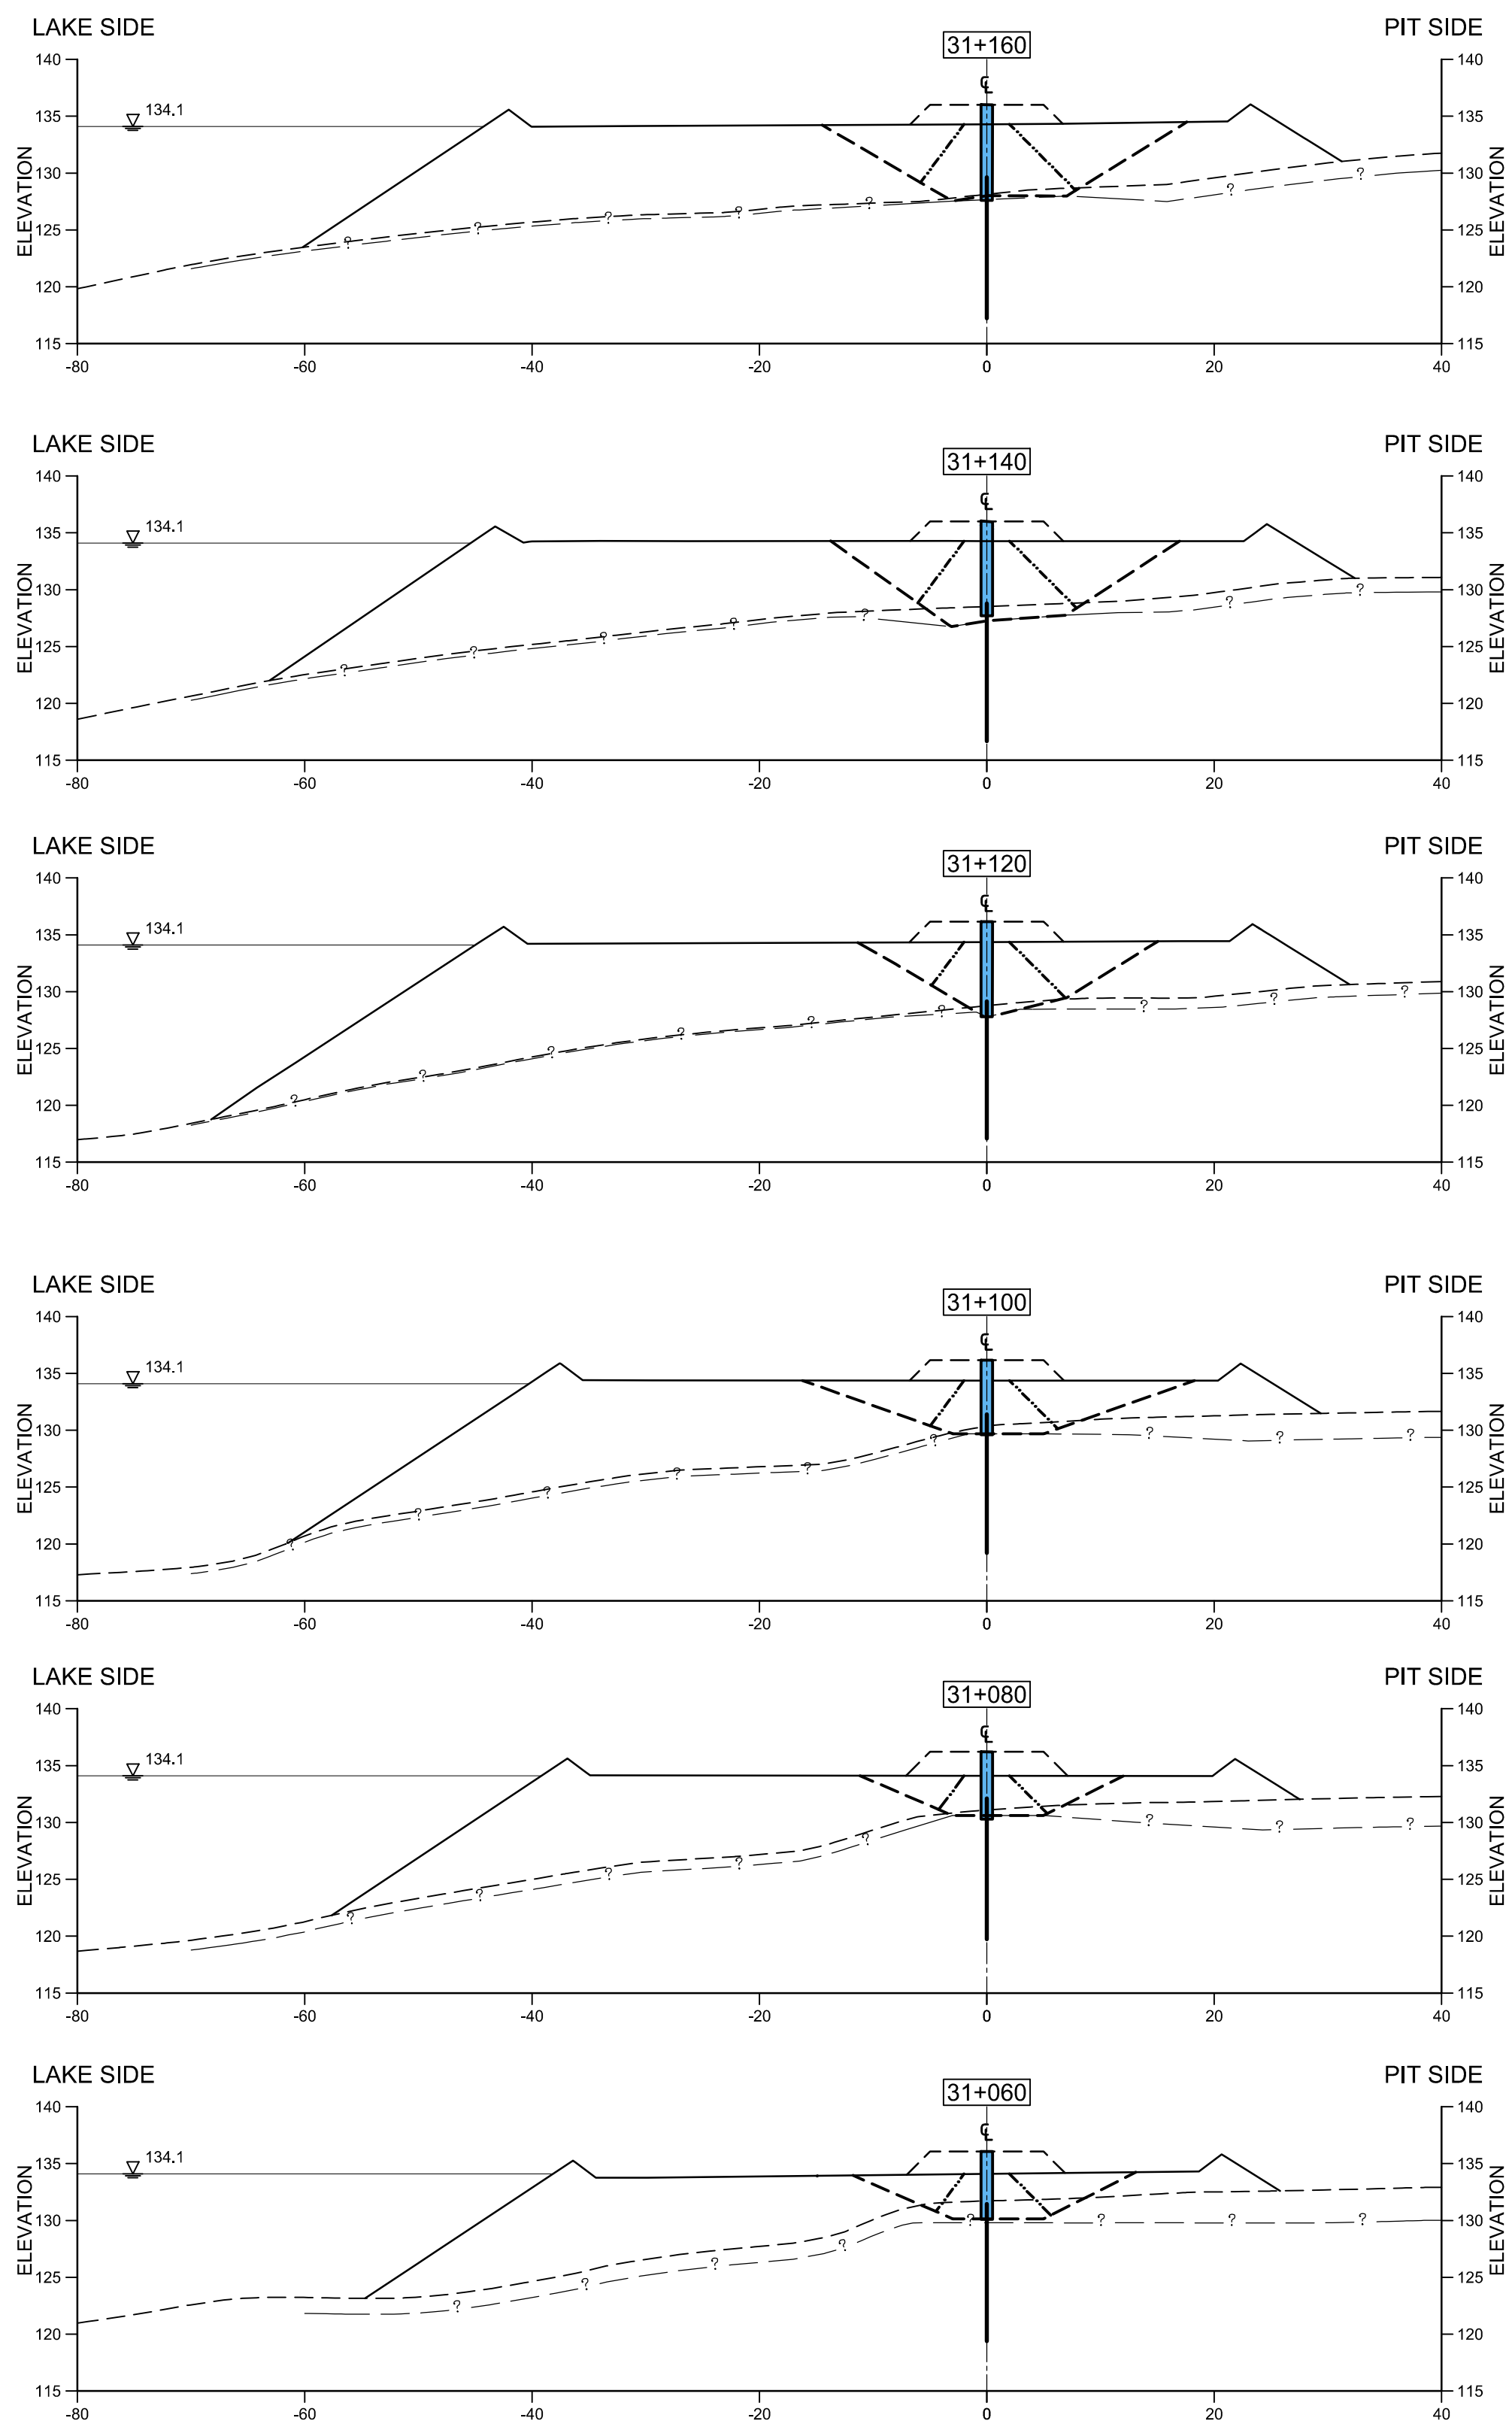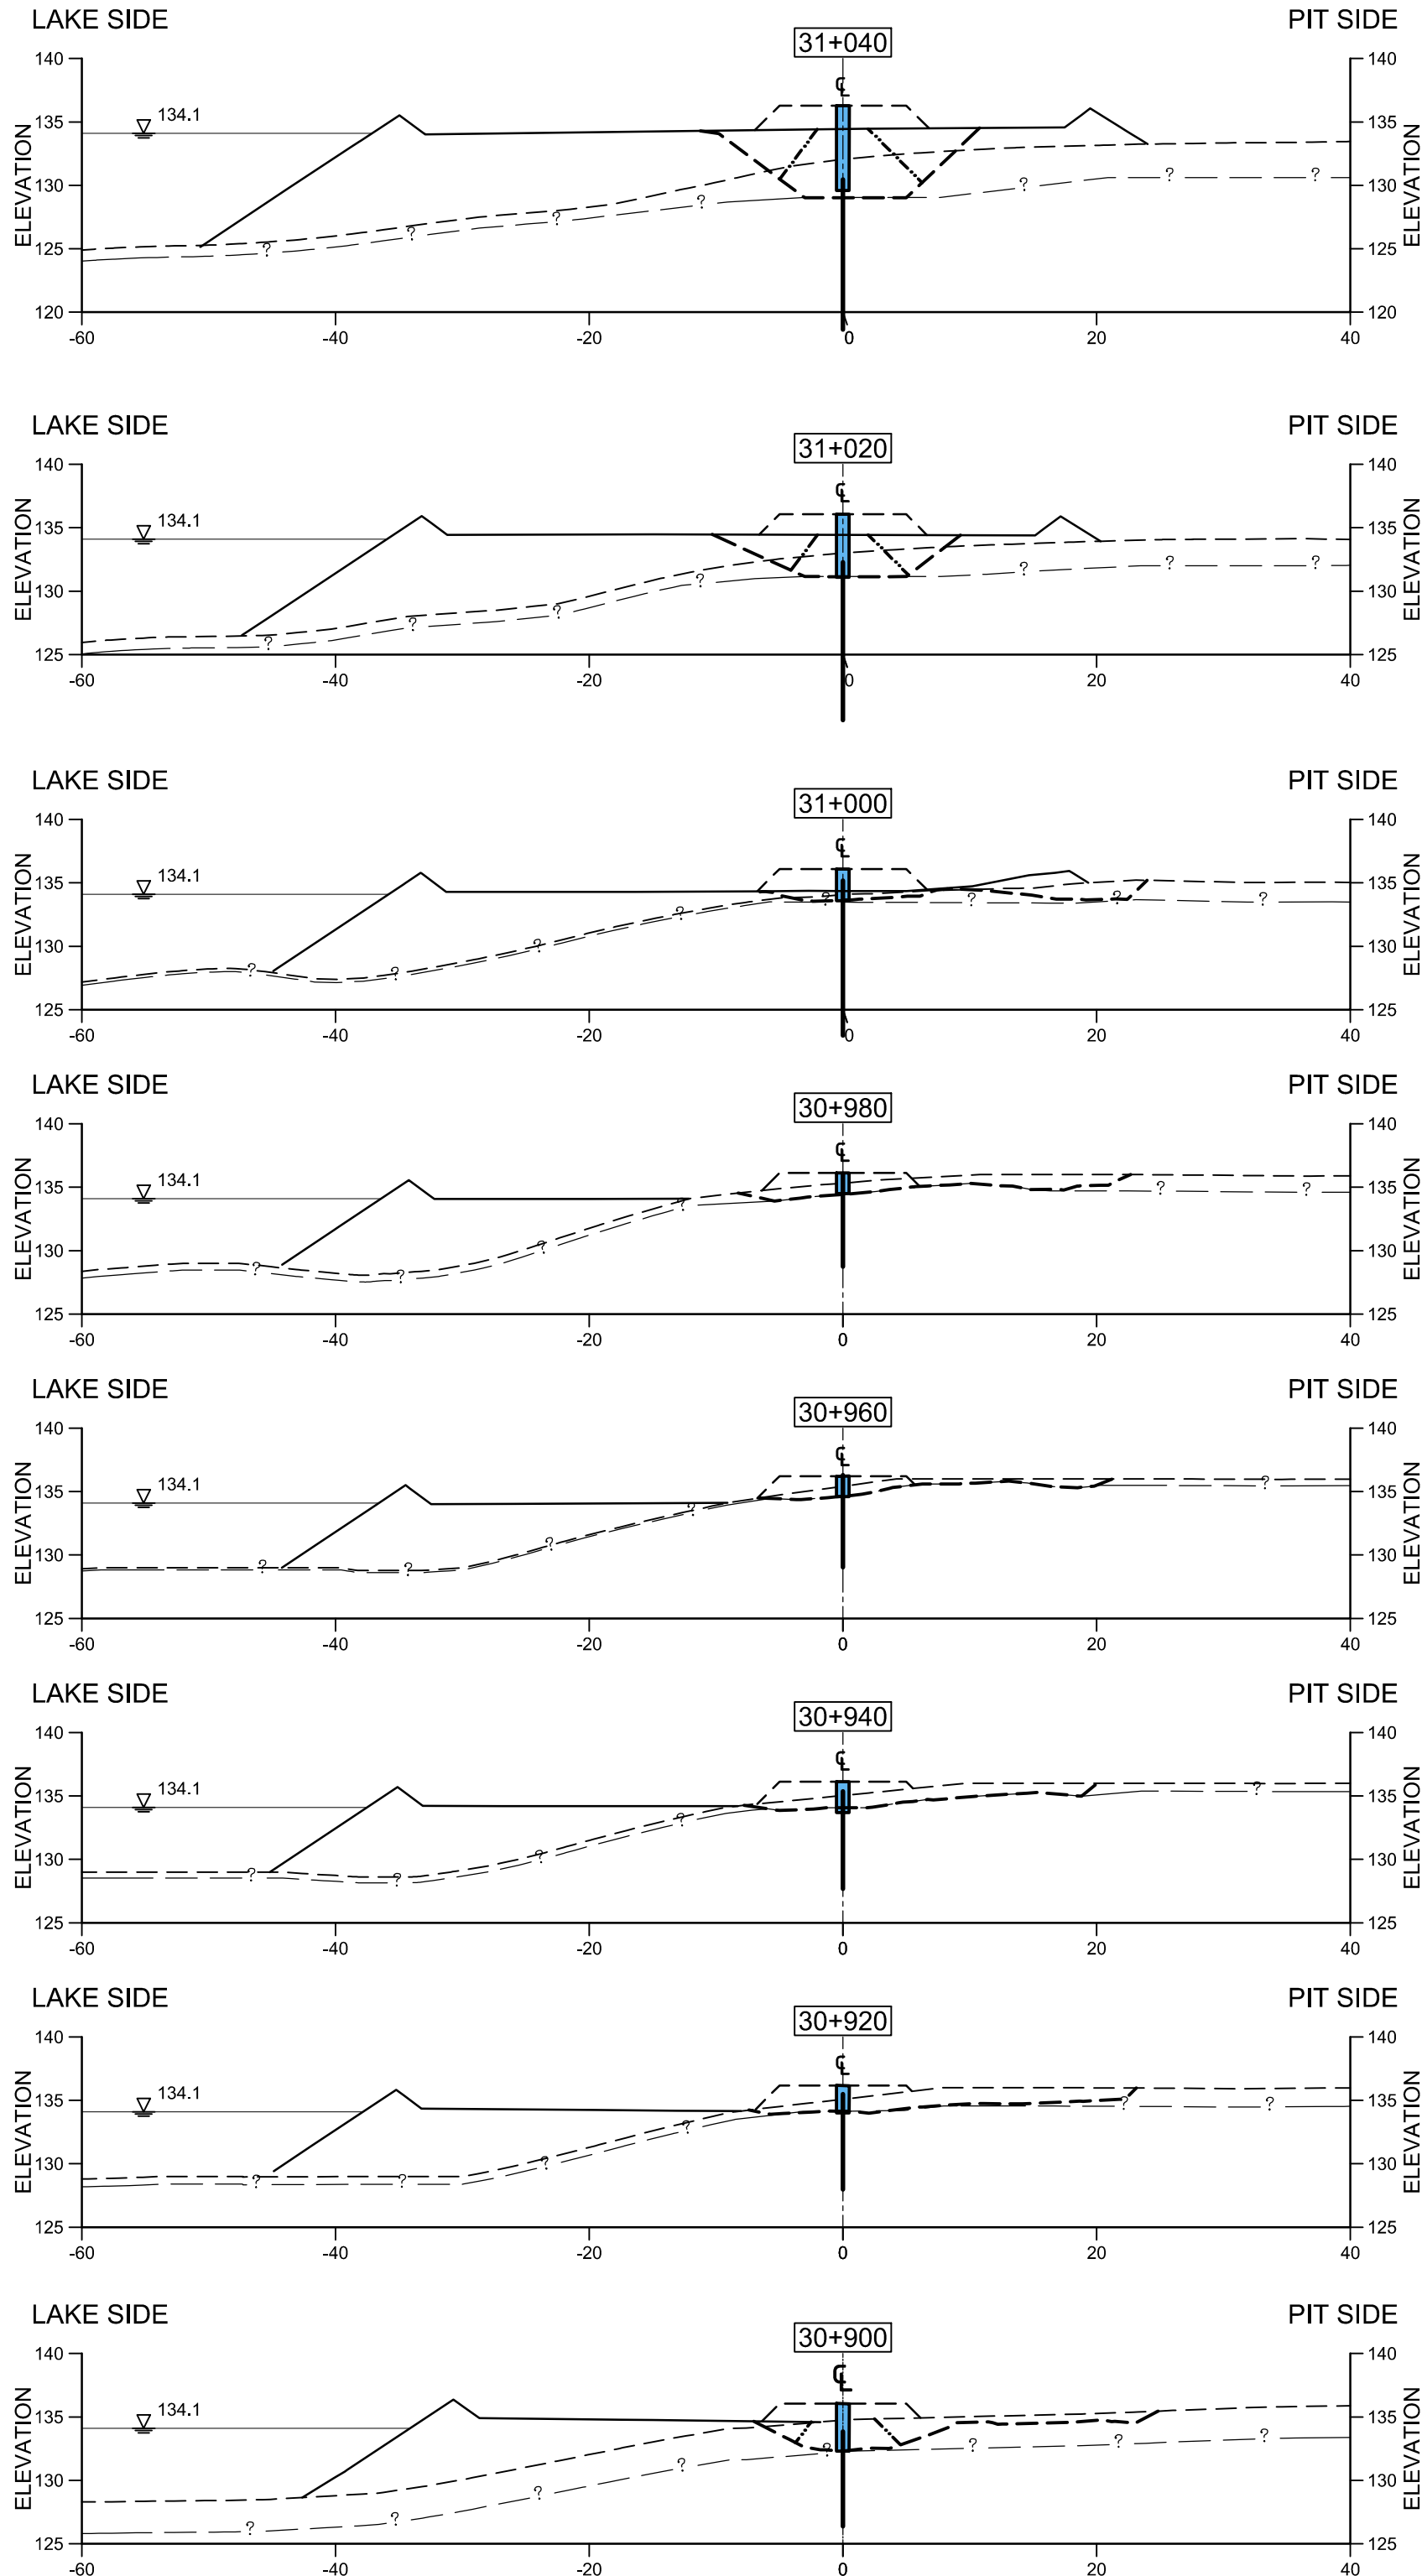












- ## LEGEND
- | | |
|---|---|
|  | LAKEBED BATHYMETRY OR LAND SURFACE SURVEY |
|  | AS-BUILT ROCKFILL (SEE NOTE 13) |
|  | AS-BUILT TRENCH EXCAVATION |
|  | INFERRED BEDROCK (FROM INVESTIGATION) |
|  | AS-BUILT DENSIFICATION PLATFORM
(SHOWING ONLY CORE BACKFILL AND COARSE FILTER PORTION) |
|  | INFERRED DENSIFICATION PLATFORM
(SHOWING ONLY CORE BACKFILL AND COARSE FILTER PORTION) |
|  | INFERRED CORE BACKFILL |
|  | AS-BUILT CORE BACKFILL/REPLACEMENT |
|  | AS-BUILT CUTOFF WALL (SB) |
|  | AS-BUILT CUTOFF WALL (CSB) |
|  | AS-BUILT JET GROUT |
|  | GROUT CURTAIN |

NOTES

- 1) ALL DIMENSIONS ARE IN METRES UNLESS OTHERWISE NOTED.
- 2) ALL ELEVATIONS ARE IN METRES ABOVE SEA LEVEL (MASL), UNLESS OTHERWISE NOTED.
- 3) CONTOUR INFORMATION ON LAND SUPPLIED BY AEM.
- 4) SURVEYED LAKE SURFACE ELEVATION : THIRD PORTAGE LAKE = 134.1m (2008)
- 5) LAKEBED SURFACE BASED ON BATHYMETRIC SURVEY BY GOLDER ASSOCIATES LTD., 2006 AND DETAILED (0.5m CONTOUR INTERVAL) 2008.
- 6) BEDROCK SURFACE INFERRED FROM 2009 AND 2010 AIR-TRACK INVESTIGATION, 2010 BOREHOLE INVESTIGATION AND CUTOFF TRENCH EXCAVATION, GROUTING AND JET GROUTING DATA.
- 7) ALL SLOPES ARE NOMINAL.
- 8) CORE BACKFILL WITHIN THE DOWNSTREAM SIDE OF THE TRENCH PLACED AT LEAST WITHIN 2m OF THE LAKEBED SEDIMENT ELEVATION.
- 9) MATERIAL PLACEMENT ANGLES FOR THE CORE BACKFILL AND COARSE FILTER/FINE ROCKFILL ARE APPROXIMATE. DOWNSTREAM CORE BACKFILL SLOPE WAS MONITORED TO ENSURE THE 2m Limit (NOTE 8) WAS ACHIEVED.
- 10) ALONG PORTIONS OF THE ALIGNMENT, LATERAL PLACEMENT OF CORE BACKFILL ON THE DOWNSTREAM SIDE OF THE EXCAVATION (SEE 4300-12, SECTION C) IN ADVANCE OF THE PROGRESSIVE BACKFILLING OF CORE BACKFILL AND COARSE FILTER/ FINE ROCKFILL WAS REQUIRED BY THE ENGINEER.
- 11) INITIAL TRENCH EXCAVATION SURFACE SHOWN BETWEEN STA. 31+020 TO 31+120 IS ESTIMATED. NO SOUNDING MEASUREMENTS WERE COMPLETED PRIOR TO CORE BACKFILL PLACEMENT.
- 12) ADDITIONAL ROCKFILL HAS BEEN PLACED OVER THE DIKE PLATFORM, NOT SURVEYED.
- 13) ONLY THE CORE BACKFILL AND COARSE FILTER COMPONENTS OF THE DENSIFICATION PLATFORM ARE SHOWN.

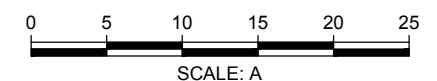


PROJECT	AEM	AGNICO-EAGLE MINES LIMITED MEADOWBANK GOLD PROJECT NUNAVUT
TITLE	BAY-GOOSE DIKE SOUTH PORTION CROSS-SECTIONS (1 OF 5)	

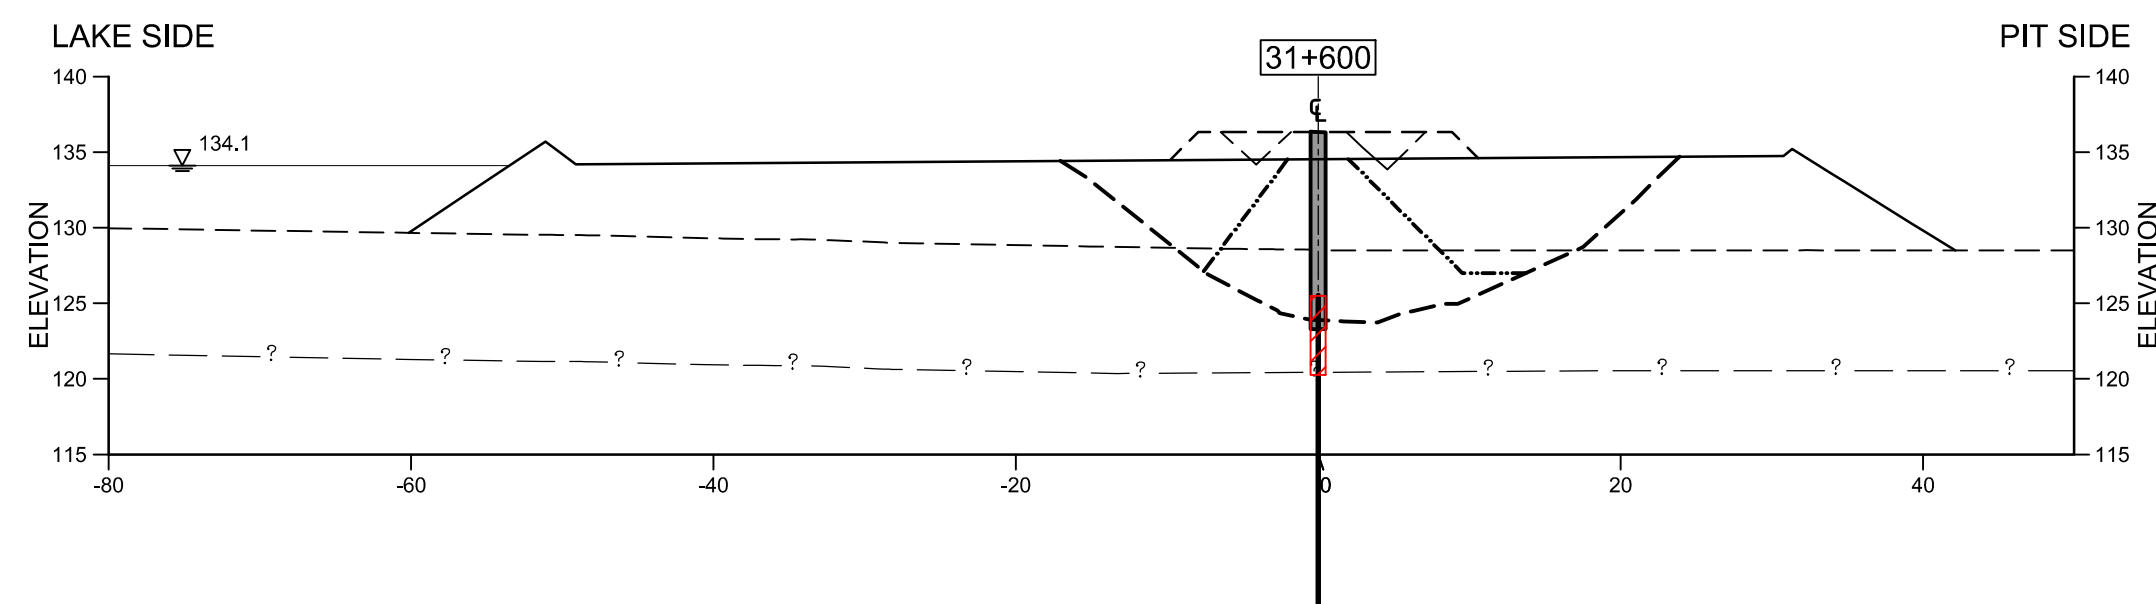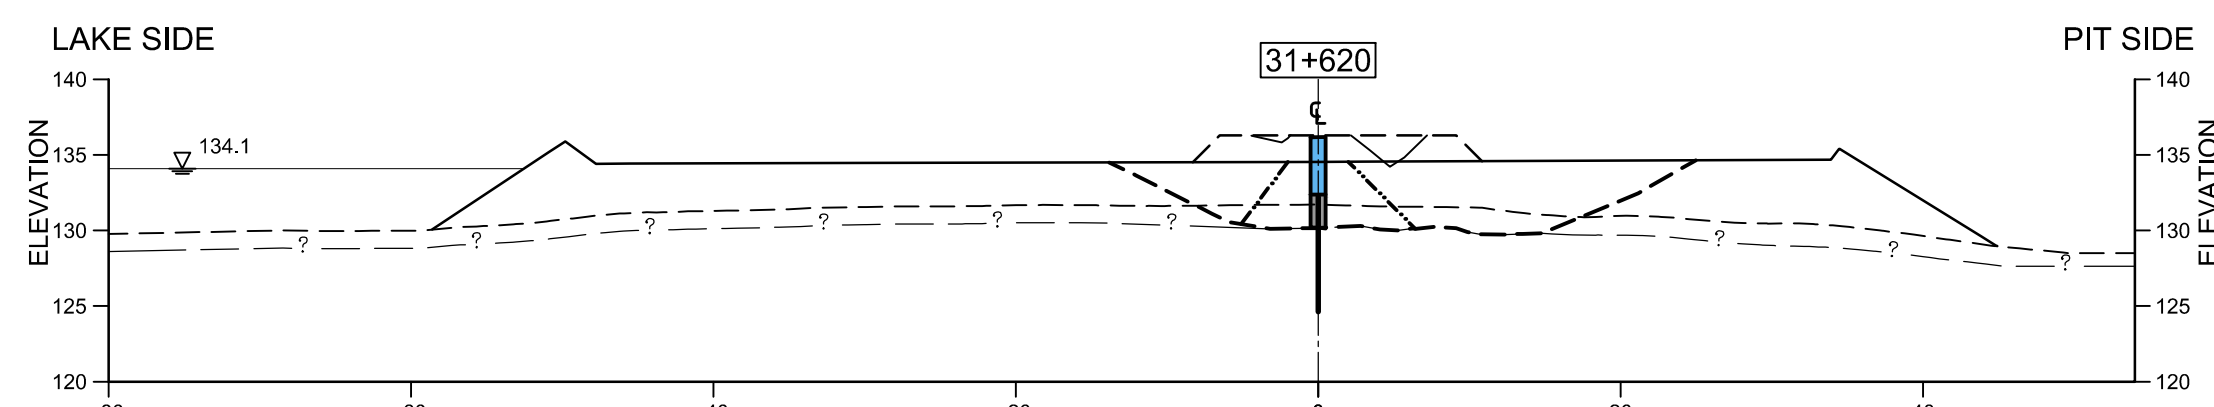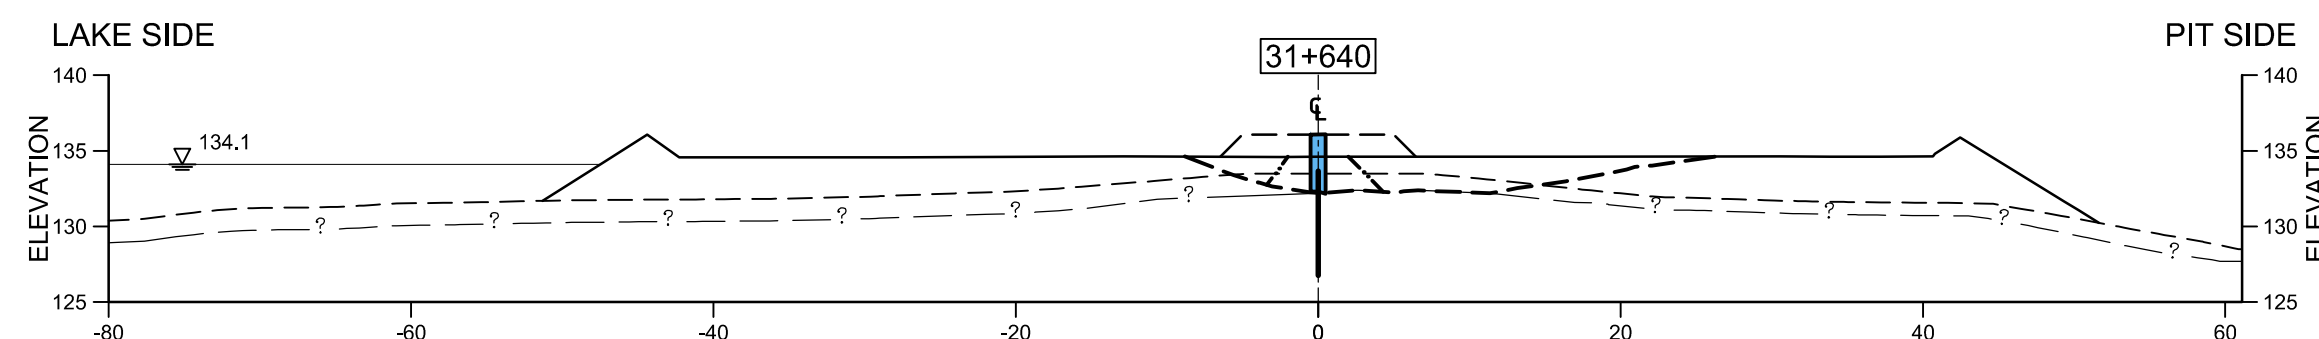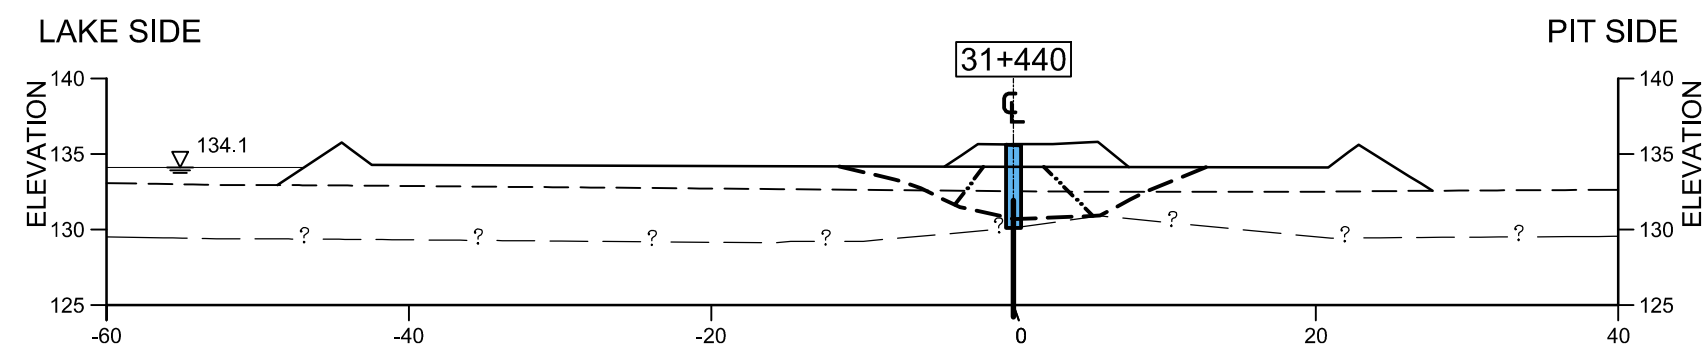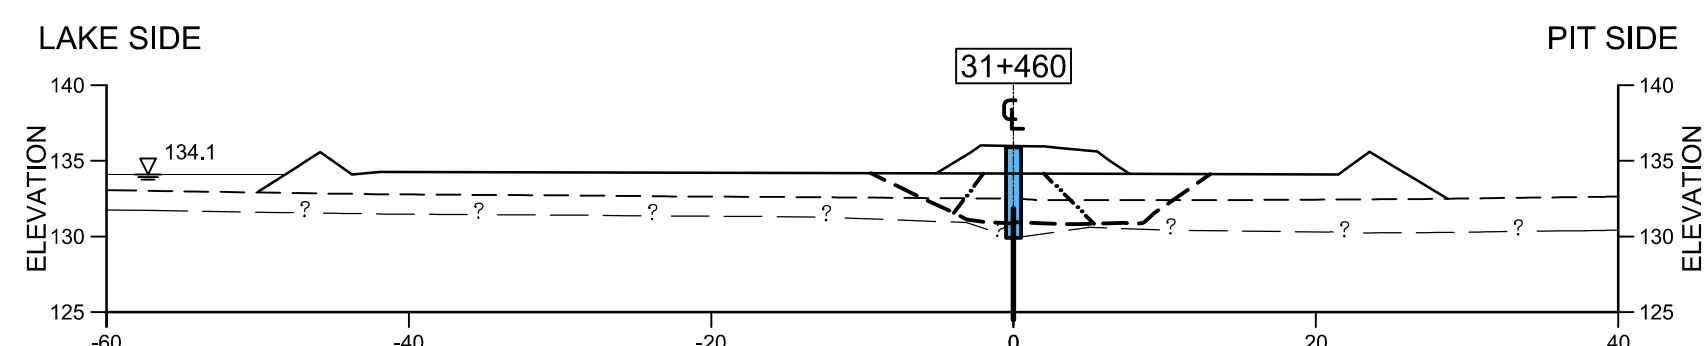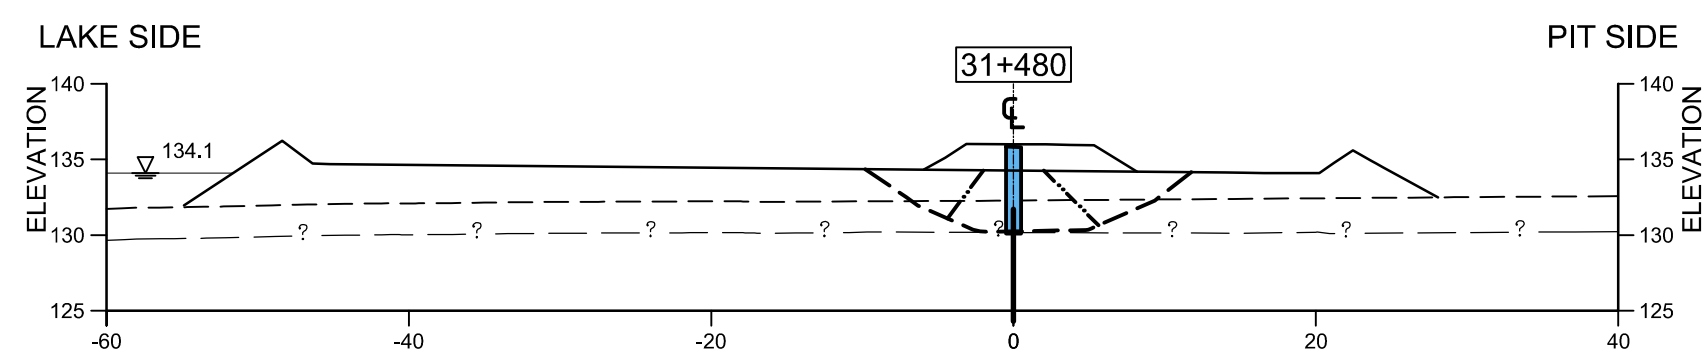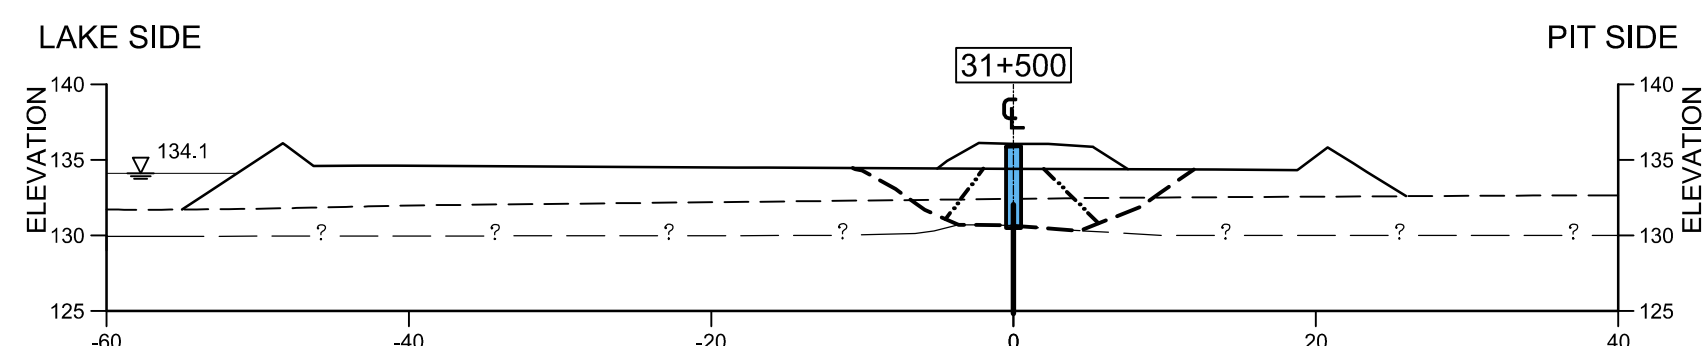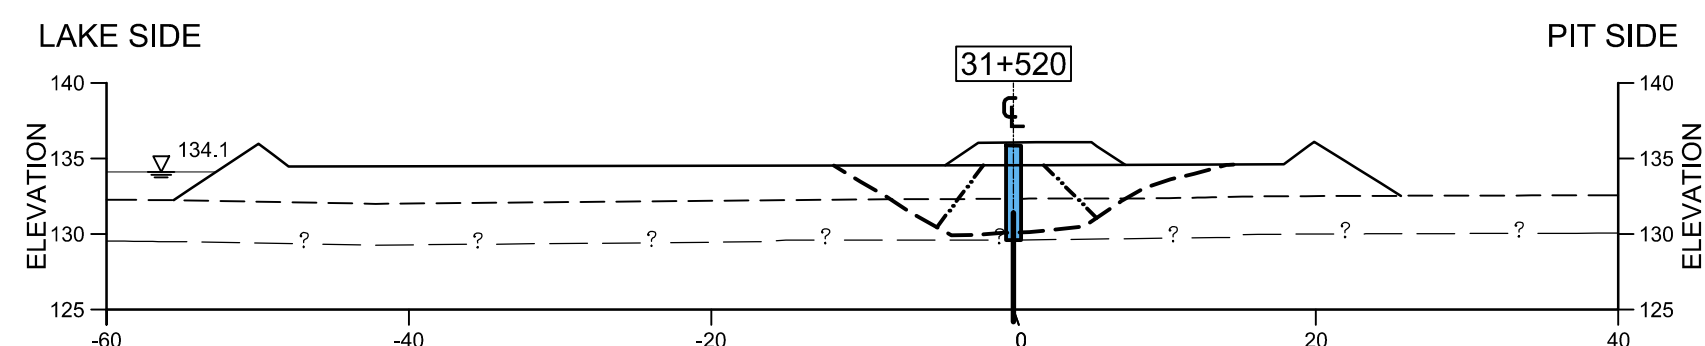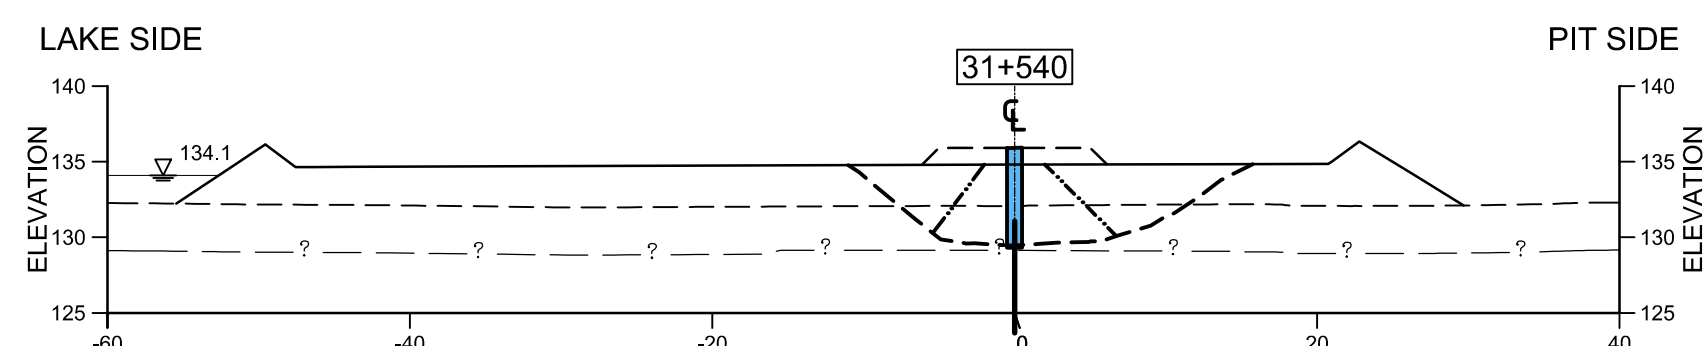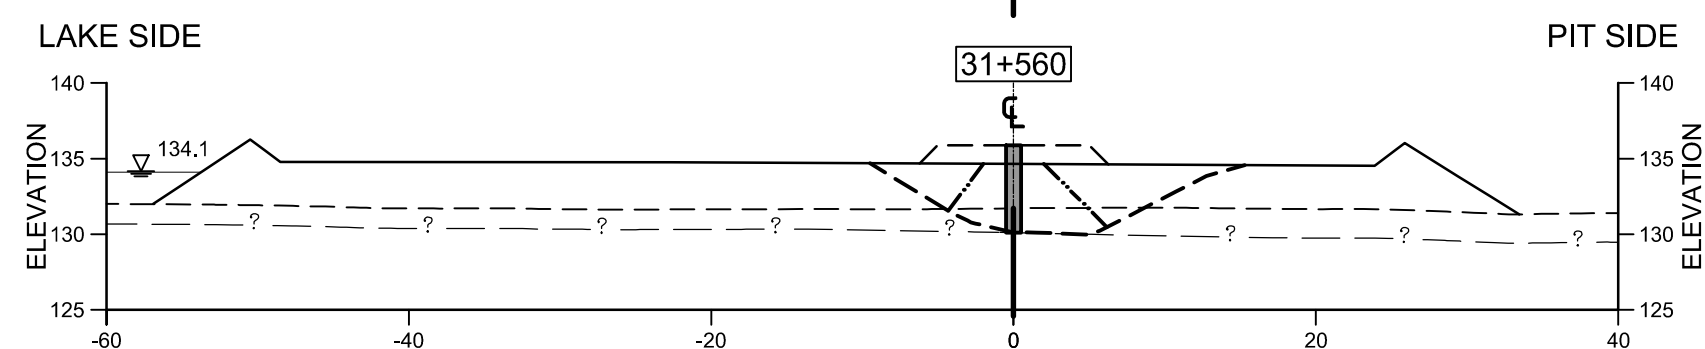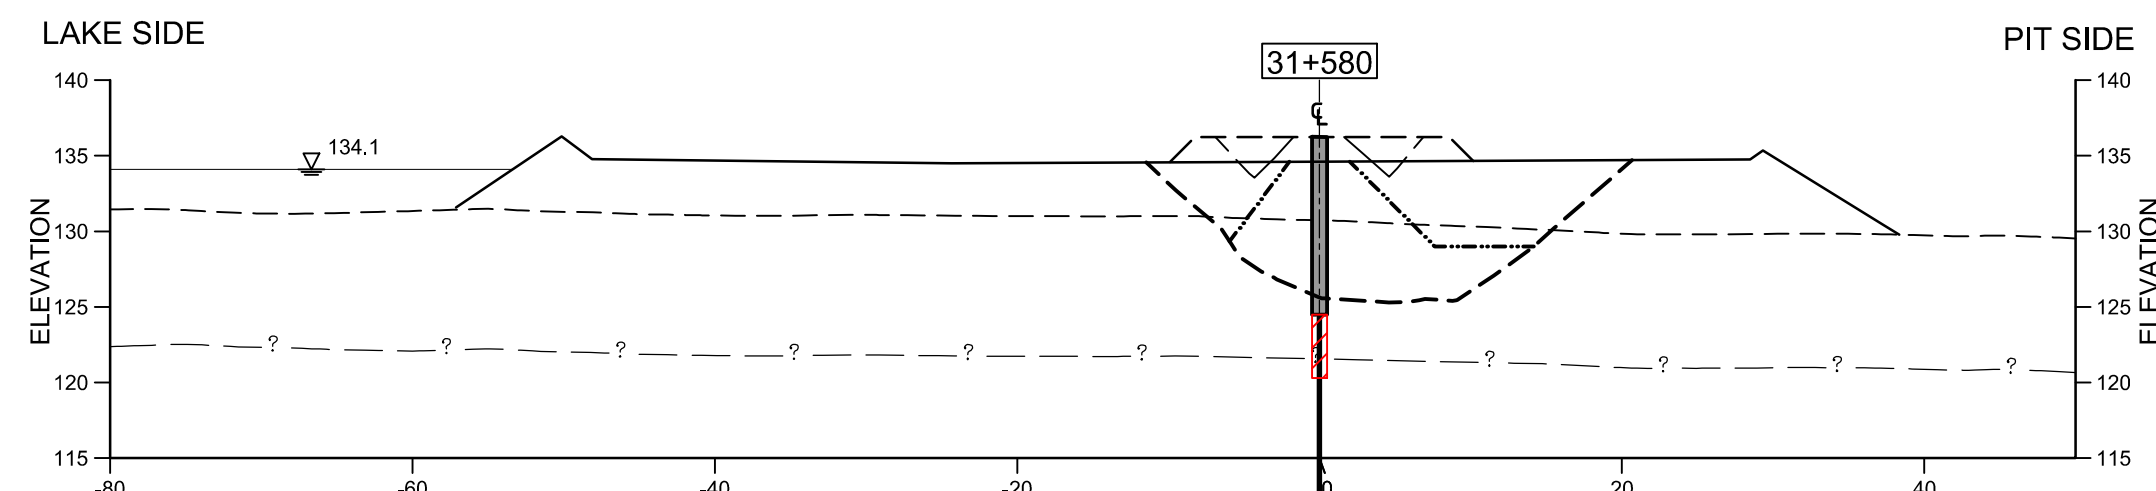

- ## LEGEND
- | | |
|---|---|
|  | LAKEBED BATHYMETRY OR LAND SURFACE SURVEY |
|  | AS-BUILT ROCKFILL (SEE NOTE 13) |
|  | AS-BUILT TRENCH EXCAVATION |
|  | INFERRED BEDROCK (FROM INVESTIGATION) |
|  | AS-BUILT DENSIFICATION PLATFORM
(SHOWING ONLY CORE BACKFILL AND COARSE FILTER PORTION) |
|  | INFERRED DENSIFICATION PLATFORM
(SHOWING ONLY CORE BACKFILL AND COARSE FILTER PORTION) |
|  | INFERRED CORE BACKFILL |
|  | AS-BUILT CORE BACKFILL/REPLACEMENT |
|  | AS-BUILT CUTOFF WALL (SB) |
|  | AS-BUILT CUTOFF WALL (CSB) |
|  | AS-BUILT JET GROUT |
|  | GROUT CURTAIN |















NOTES

- 1) ALL DIMENSIONS ARE IN METRES UNLESS OTHERWISE NOTED.
- 2) ALL ELEVATIONS ARE IN METRES ABOVE SEA LEVEL (MASL), UNLESS OTHERWISE NOTED.
- 3) CONTOUR INFORMATION ON LAND SUPPLIED BY AEM.
- 4) SURVEYED LAKE SURFACE ELEVATION : THIRD PORTAGE LAKE = 134.1m (2008)
- 5) LAKEBED SURFACE BASED ON BATHYMETRIC SURVEY BY GOLDER ASSOCIATES LTD., 2006 AND DETAILED (0.5m CONTOUR INTERVAL) 2008.
- 6) BEDROCK SURFACE INFERRED FROM 2009 AND 2010 AIR-TRACK INVESTIGATION, 2010 BOREHOLE INVESTIGATION AND CUTOFF TRENCH EXCAVATION, GROUTING AND JET GROUTING DATA.
- 7) SLOPES ARE NOMINAL.
- 8) CORE BACKFILL WITHIN THE DOWNSTREAM SIDE OF THE TRENCH PLACED AT LEAST WITHIN 2m OF THE LAKEBED SEDIMENT ELEVATION.
- 9) MATERIAL PLACEMENT ANGLES FOR THE CORE BACKFILL AND COARSE FILTER/FINE ROCKFILL ARE APPROXIMATE. DOWNSTREAM CORE BACKFILL SLOPE WAS MONITORED TO ENSURE THE 2m LIMIT (NOTE 8) WAS ACHIEVED.
- 10) ALONG PORTIONS OF THE ALIGNMENT, LATERAL PLACEMENT OF CORE BACKFILL ON THE DOWNSTREAM SIDE OF THE EXCAVATION (SEE 4300-12, SECTION C) IN ADVANCE OF THE PROGRESSIVE BACKFILLING OF CORE BACKFILL AND COARSE FILTER/ FINE ROCKFILL WAS REQUIRED BY THE ENGINEER.
- 11) INITIAL TRENCH EXCAVATION SURFACE SHOWN BETWEEN STA. 31+020 TO 31+025 IS ESTIMATED, NO SOUNDING MEASUREMENTS WERE COMPLETED PRIOR TO CORE BACKFILL PLACEMENT.
- 12) ADDITIONAL ROCKFILL HAS BEEN PLACED OVER THE DIKE PLATFORM, NOT SURVEYED.
- 13) ONLY THE CORE BACKFILL AND COARSE FILTER COMPONENTS OF THE DENSIFICATION PLATFORM ARE SHOWN.

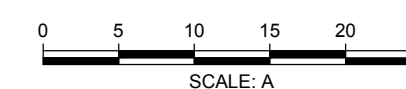


PROJECT		AGNICO-EAGLE MINES LIMITED MEADOWBANK GOLD PROJECT NUNAVUT
TITLE	BAY-GOOSE DIKE SOUTH PORTION CROSS-SECTIONS (3 OF 5)	

CADD FILE: N:\bur-graphics\Projects\2009\1428\09-1428-5007\Drafting\4300\meadowbank - bay-goose (south) dike as-built\4300_0_15.dwg
REVISION DATE: 12/5/2012 4:29:18 PM By: TYKLASSEN

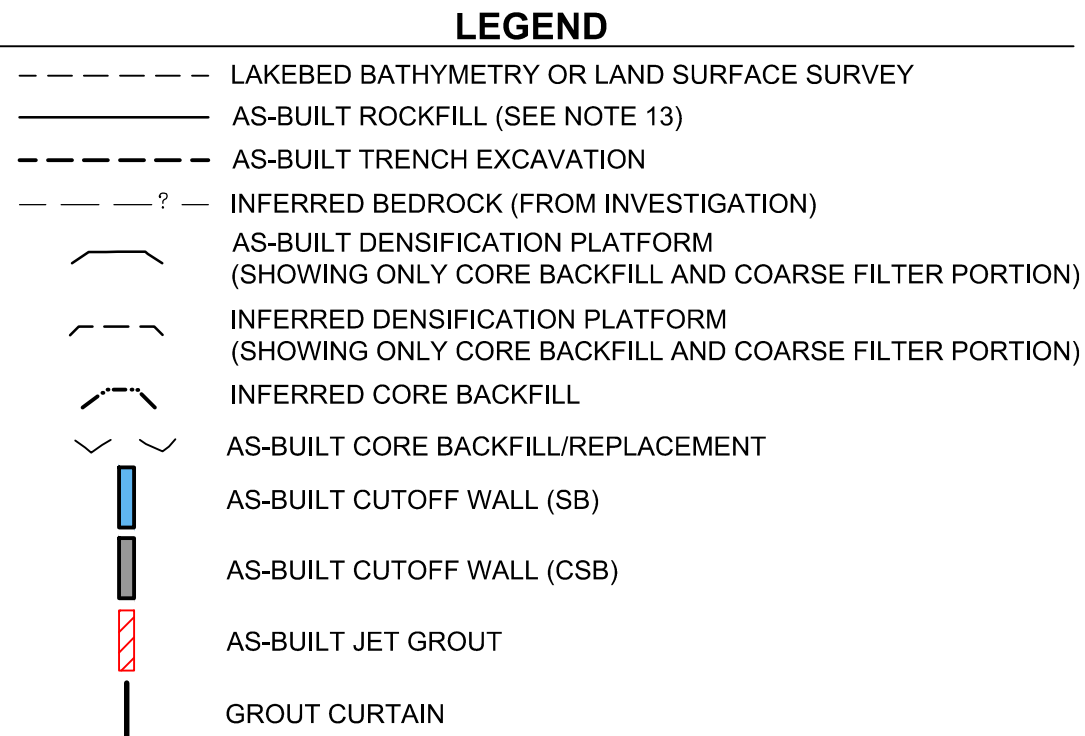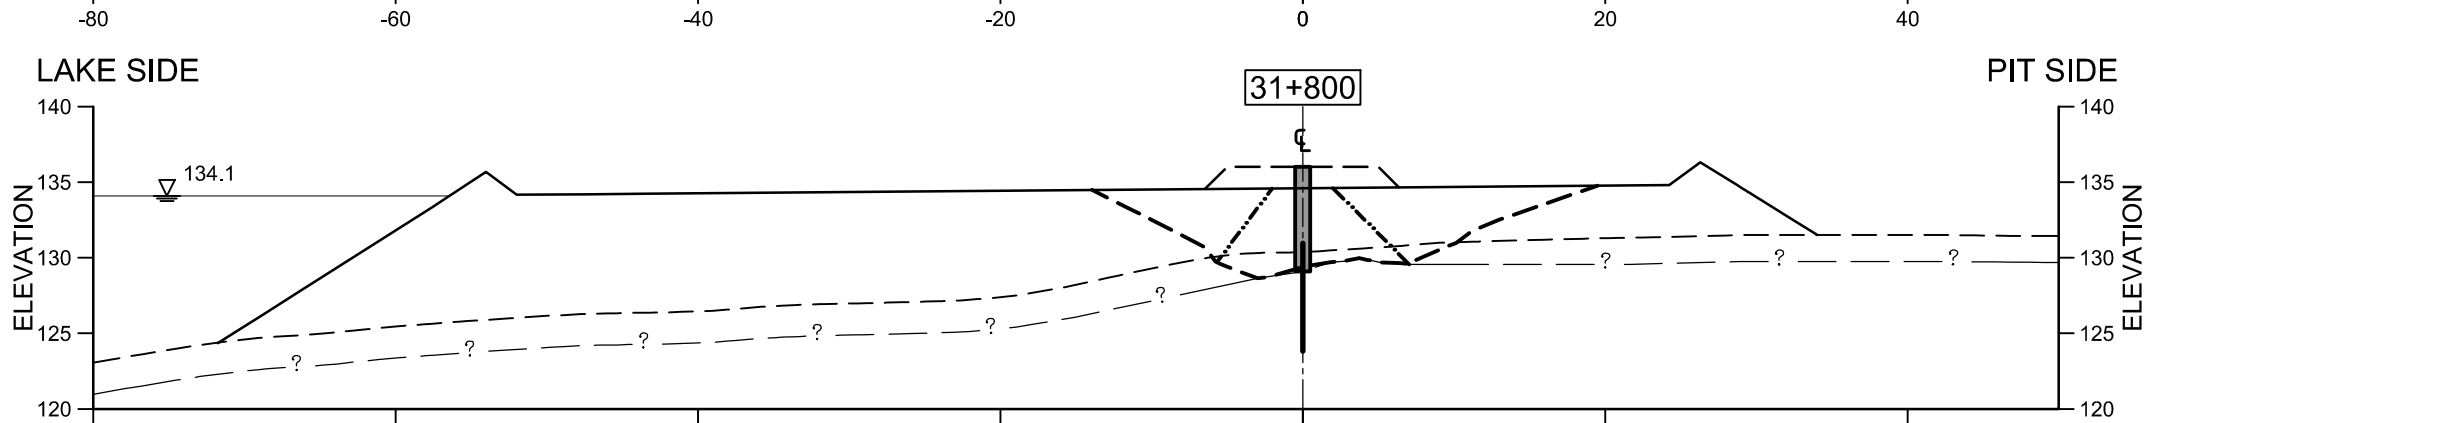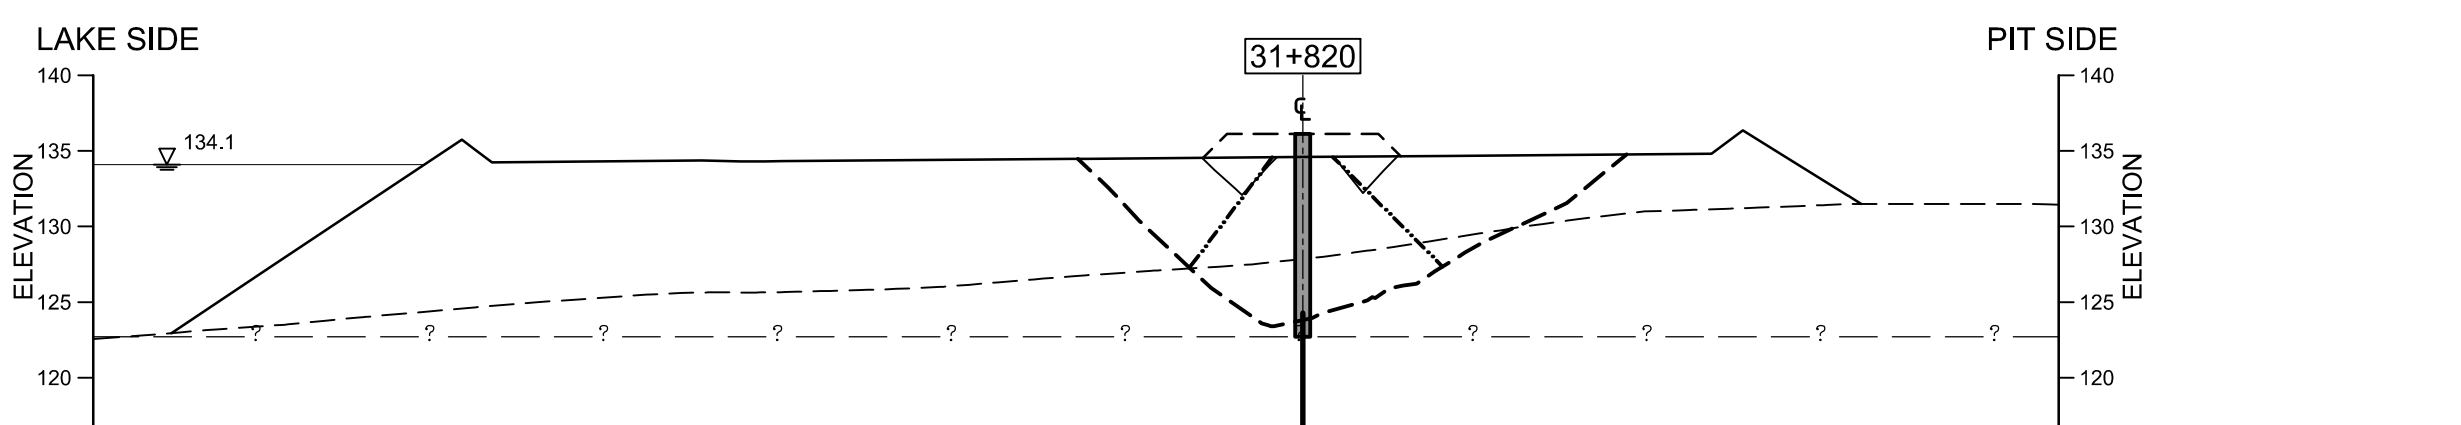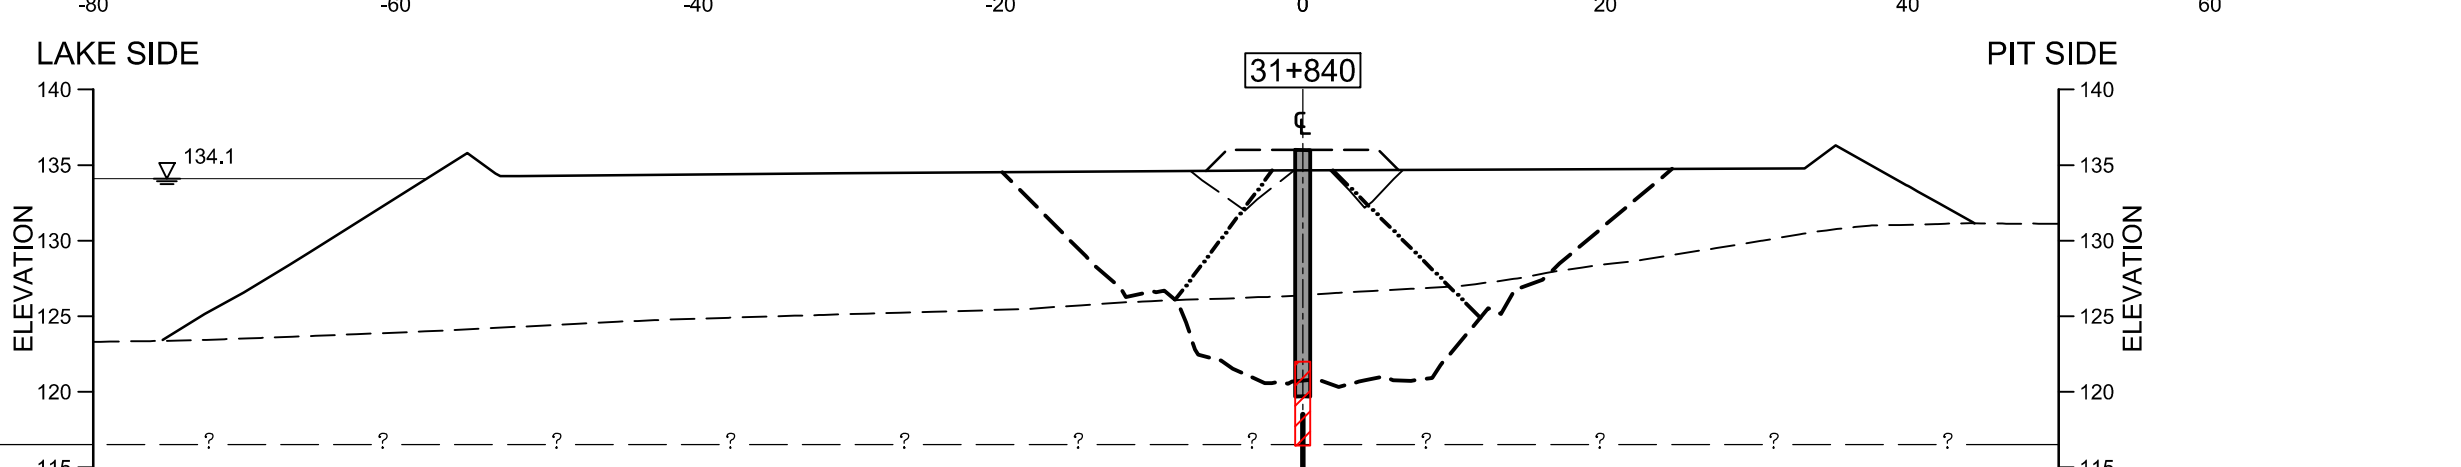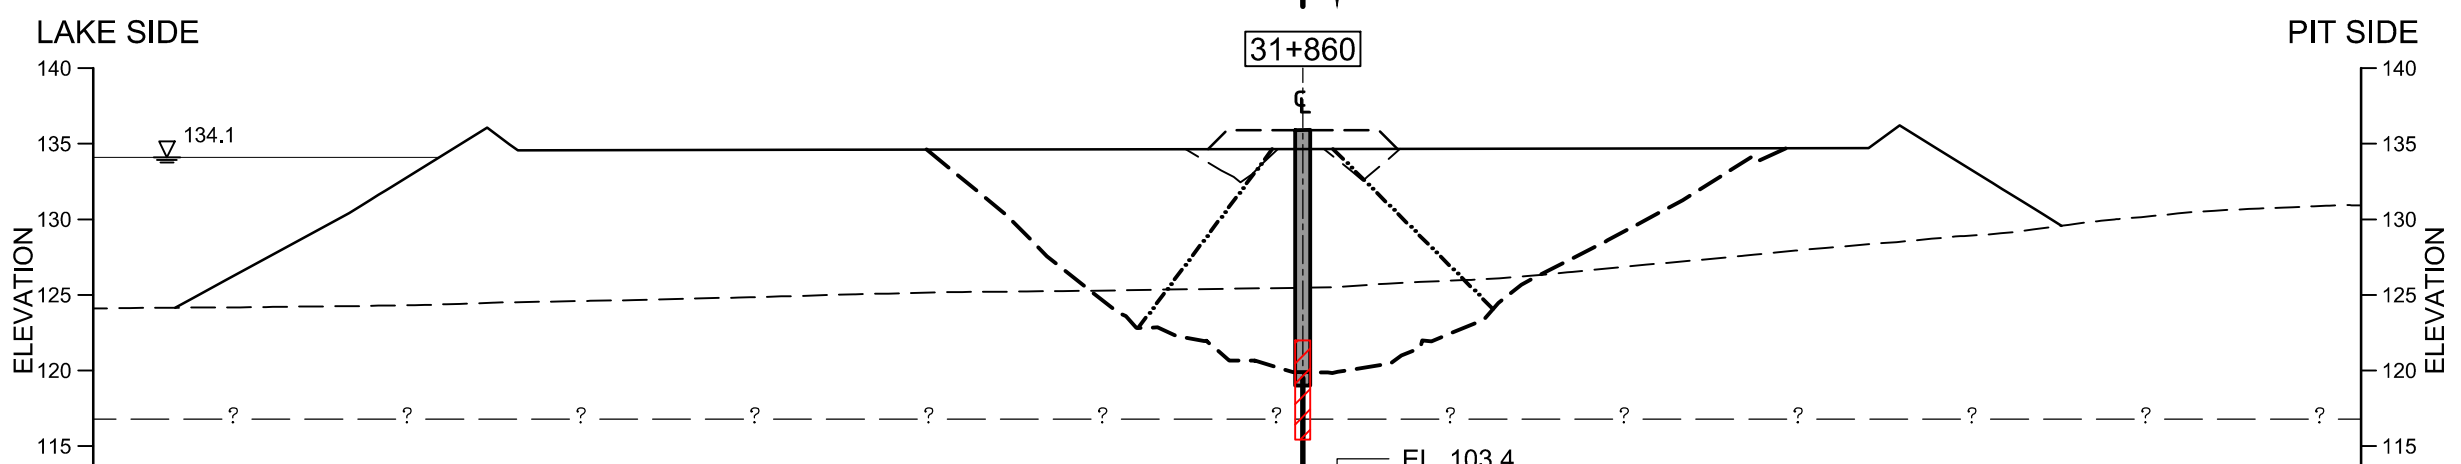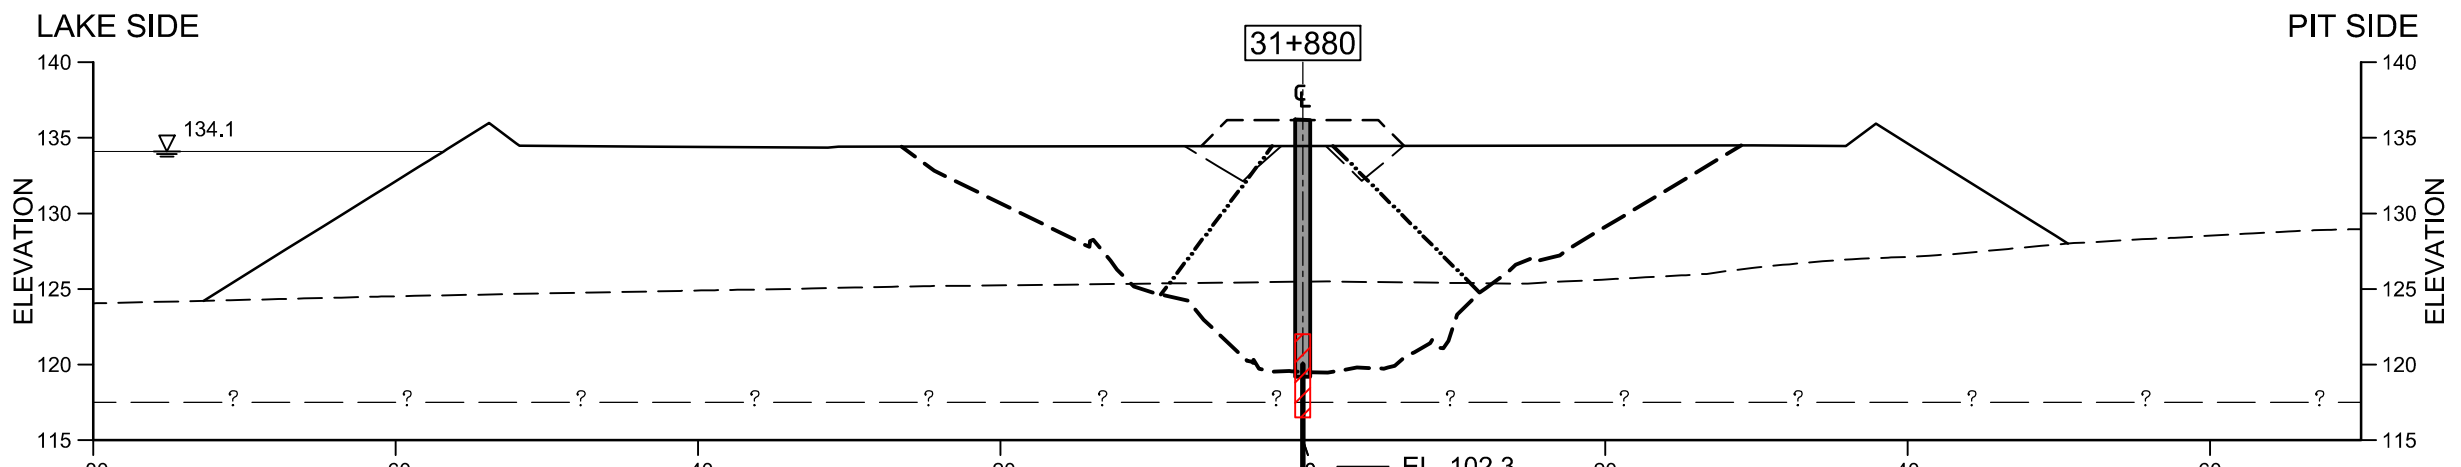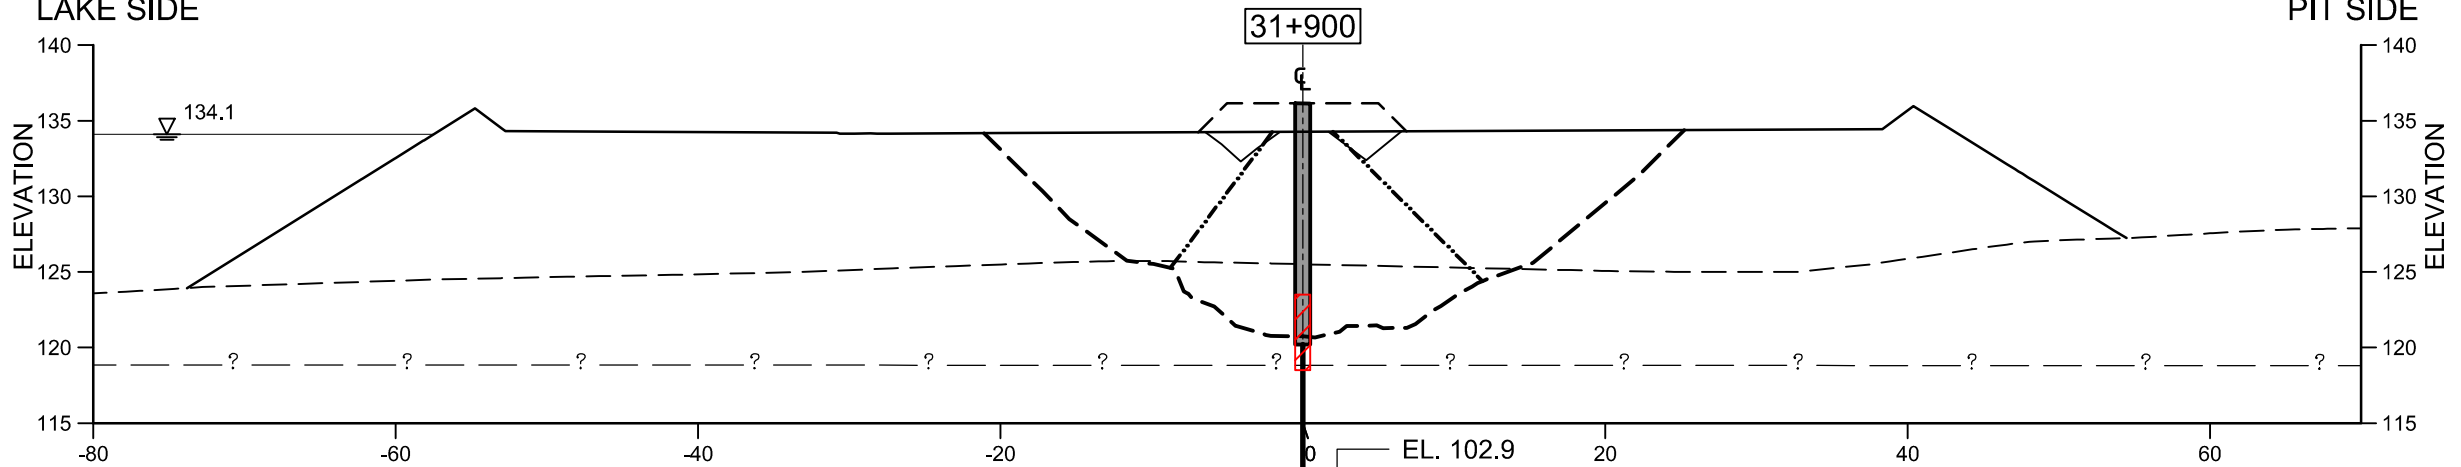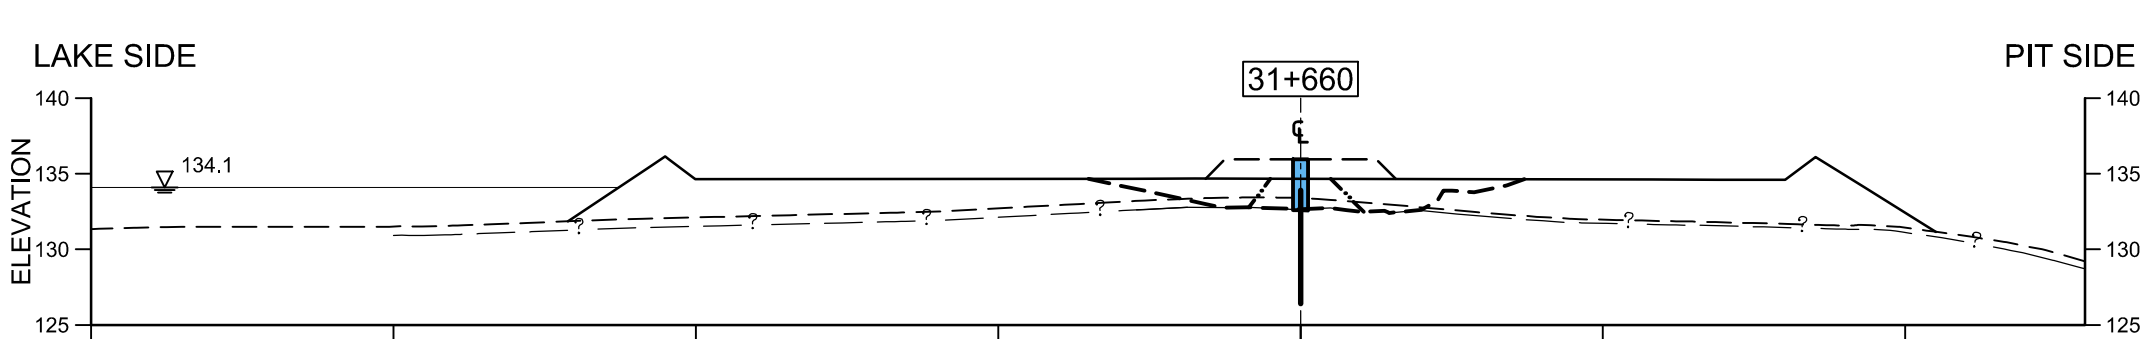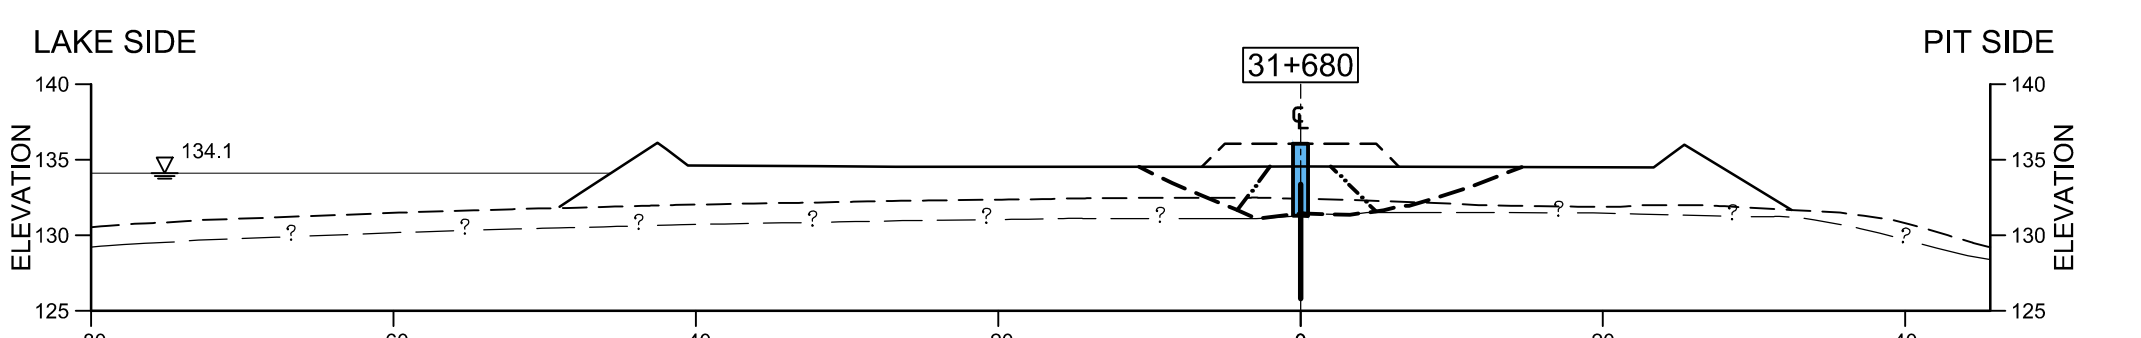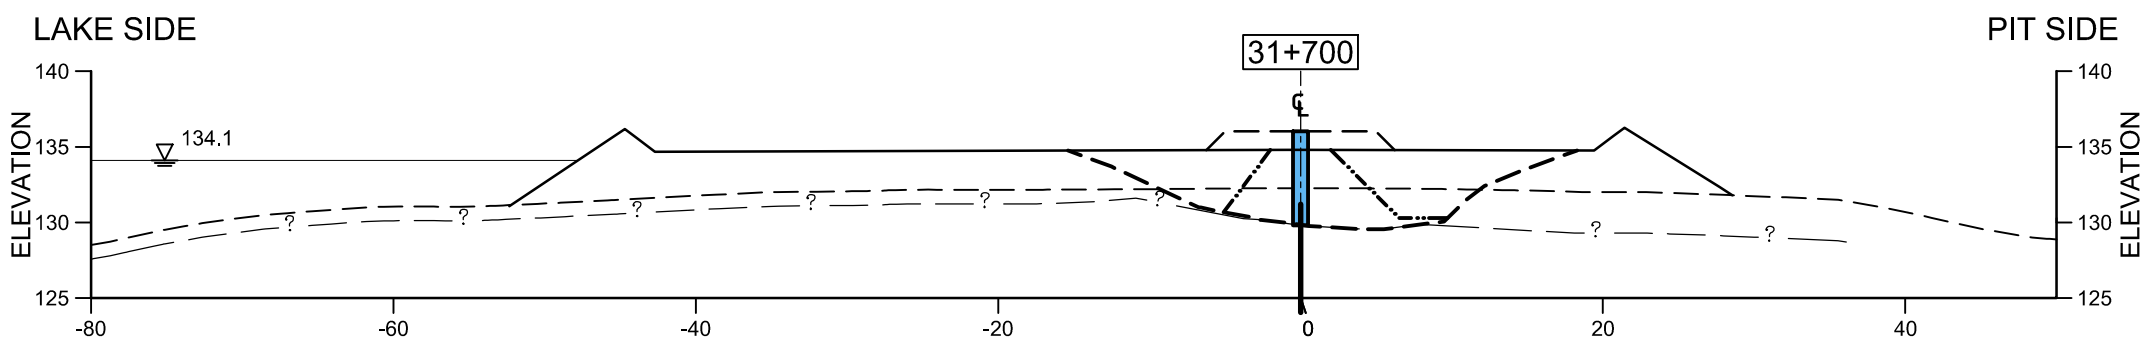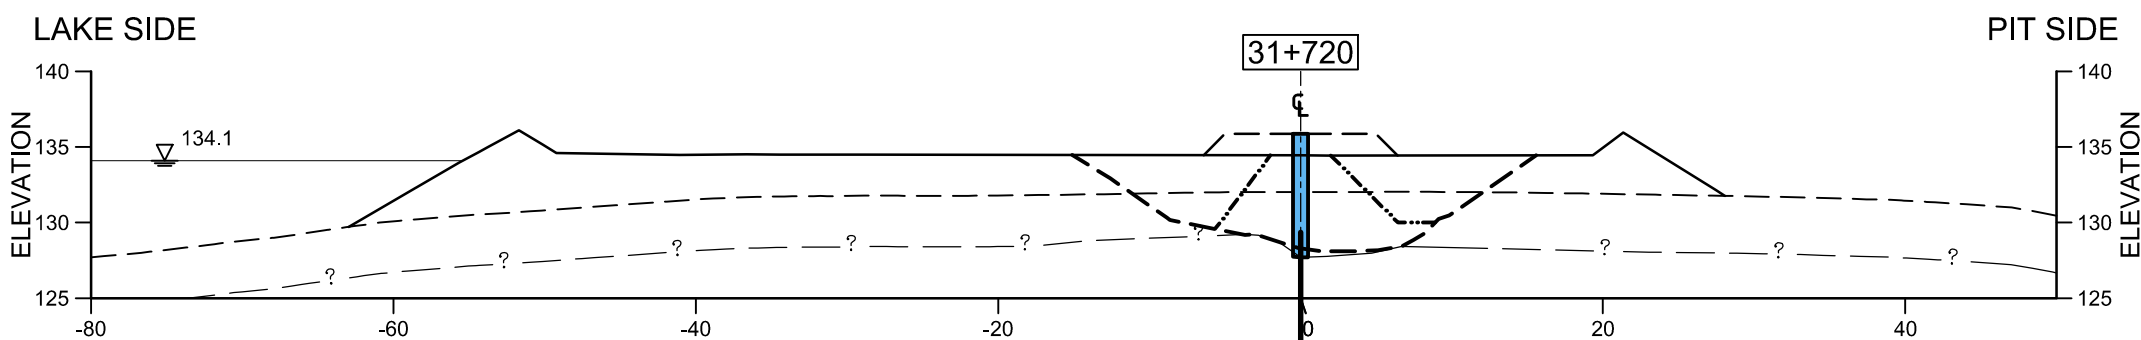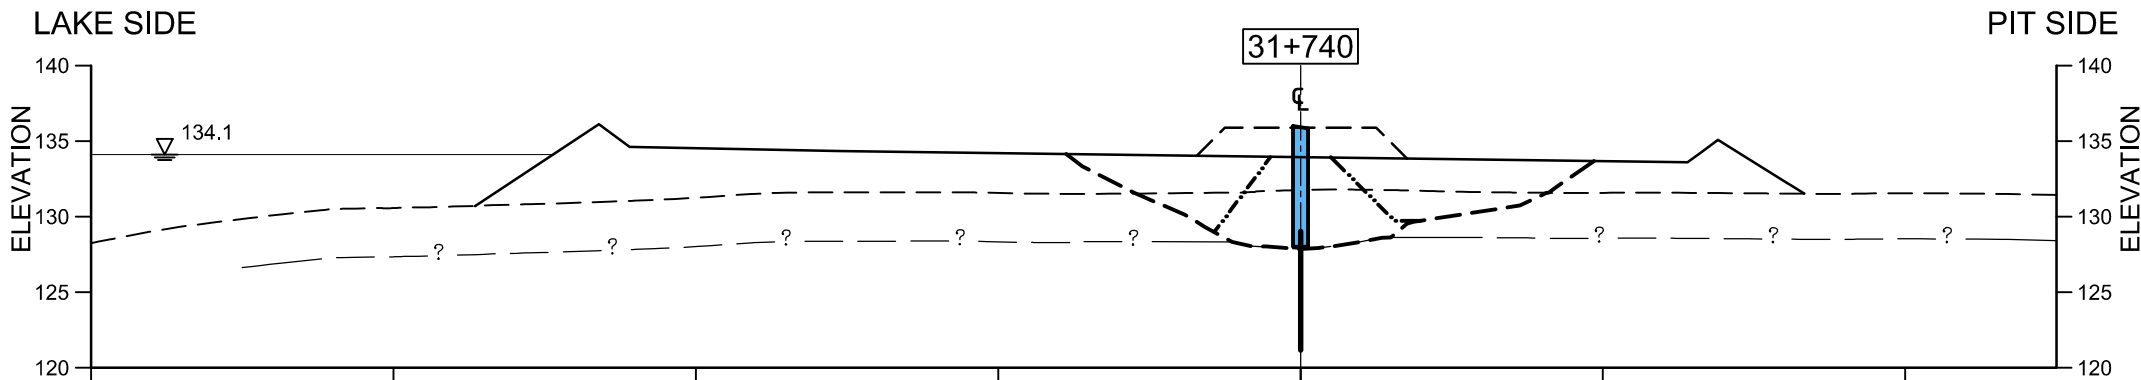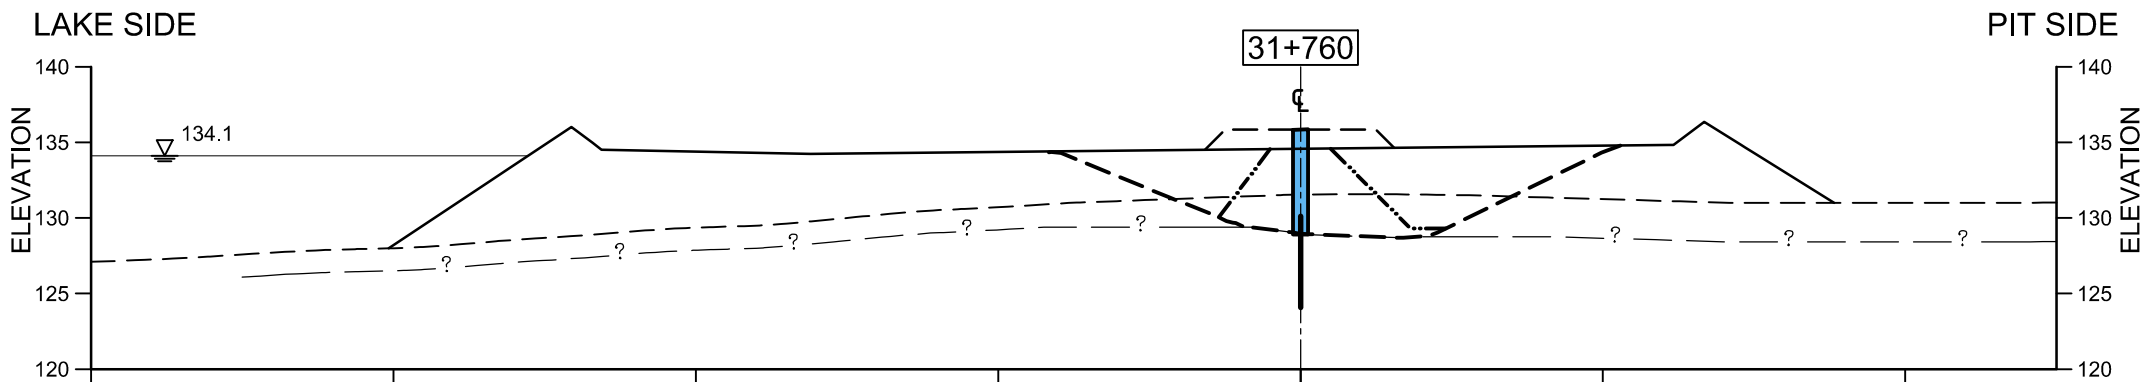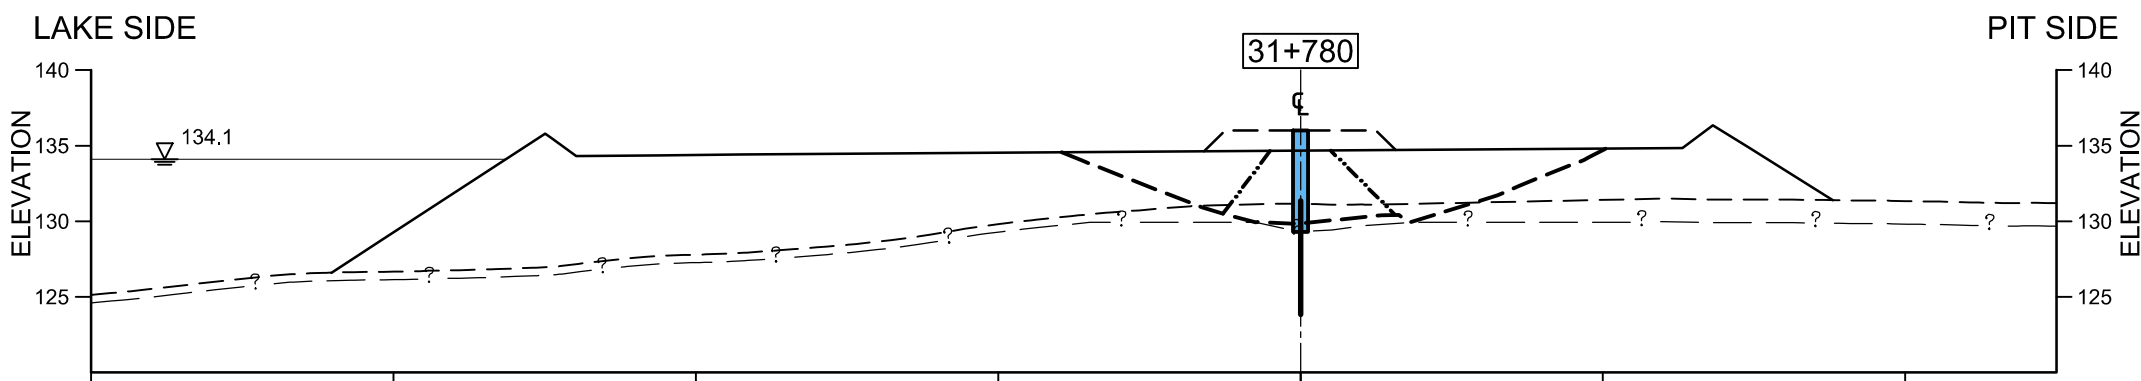

NOTES

- ALL DIMENSIONS ARE IN METRES UNLESS OTHERWISE NOTED.
- ALL ELEVATIONS ARE IN METRES ABOVE SEA LEVEL (MASL), UNLESS OTHERWISE NOTED.
- CONTOUR INFORMATION ON LAND SUPPLIED BY AEM.
- SURVEYED LAKE SURFACE ELEVATION : THIRD PORTAGE LAKE = 134.1m (2008)
- LAKEBED SURFACE BASED ON BATHYMETRIC SURVEY BY GOLDER ASSOCIATES LTD., 2006 AND DETAILED (0.5m CONTOUR INTERVAL) 2008.
- BEDROCK SURFACE INFERRED FROM 2009 AND 2010 AIR-TRACK INVESTIGATION, 2010 BOREHOLE INVESTIGATION AND CUTOFF TRENCH EXCAVATION, GROUTING AND JET GROUTING DATA.
- ALL SLOPES ARE NOMINAL.
- CORE BACKFILL WITHIN THE DOWNSTREAM SIDE OF THE TRENCH PLACED AT LEAST WITHIN 2m OF THE LAKEBED SEDIMENT ELEVATION.
- MATERIAL PLACEMENT ANGLES FOR THE CORE BACKFILL AND COARSE FILTER/FINE ROCKFILL ARE APPROXIMATE. DOWNSTREAM CORE BACKFILL SLOPE WAS MONITORED TO ENSURE THE 2m LIMIT (NOTE 8) WAS ACHIEVED.
- ALONG PORTIONS OF THE ALIGNMENT, LATERAL PLACEMENT OF CORE BACKFILL ON THE DOWNSTREAM SIDE OF THE EXCAVATION (SEE 4300-12, SECTION C) IN ADVANCE OF THE PROGRESSIVE BACKFILLING OF CORE BACKFILL AND COARSE FILTER/ FINE ROCKFILL WAS REQUIRED BY THE ENGINEER.
- INITIAL TRENCH EXCAVATION SURFACE SHOWN BETWEEN STA. 31+020 TO 31+120 IS ESTIMATED. NO SOUNDING MEASUREMENTS WERE COMPLETED PRIOR TO CORE BACKFILL PLACEMENT.
- ADDITIONAL ROCKFILL HAS BEEN PLACED OVER THE DIKE PLATFORM, NOT SURVEYED.
- ONLY THE CORE BACKFILL AND COARSE FILTER COMPONENTS OF THE DENSIFICATION PLATFORM ARE SHOWN.

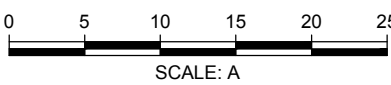

PROJECT

AEM

AGNICO-EAGLE MINES LIMITED
MEADOWBANK GOLD PROJECT
NUNAVUT

TITLE

BAY-GOOSE DIKE SOUTH PORTION
CROSS-SECTIONS (4 OF 5)



PROJECT No.	09-1428-5007	FILE No.	4300_0_15
DESIGN	KD	02MAY10	SCALE AS SHOWN
CADD	NS	10MAY10	REV. 1
CHECK	FE	31MAY10	
REVIEW	MRJ	31MAY10	



4300-18





STAMP

15DEC12	FE	AS-BUILT	EA	GRB	FE
06JUL10	KD	ISSUED FOR CONSTRUCTION	JK	FE	MRJ
18JUN10	KD	ISSUED FOR CLIENT REVIEW	JK	FE	MRJ
31MAY10	KD	ISSUED FOR CLIENT REVIEW	NS	FE	MRJ
REV	DATE	DES	CADD	CHK	RVW
		REVISION DESCRIPTION			


DRAWING NO.

    REFERENCES

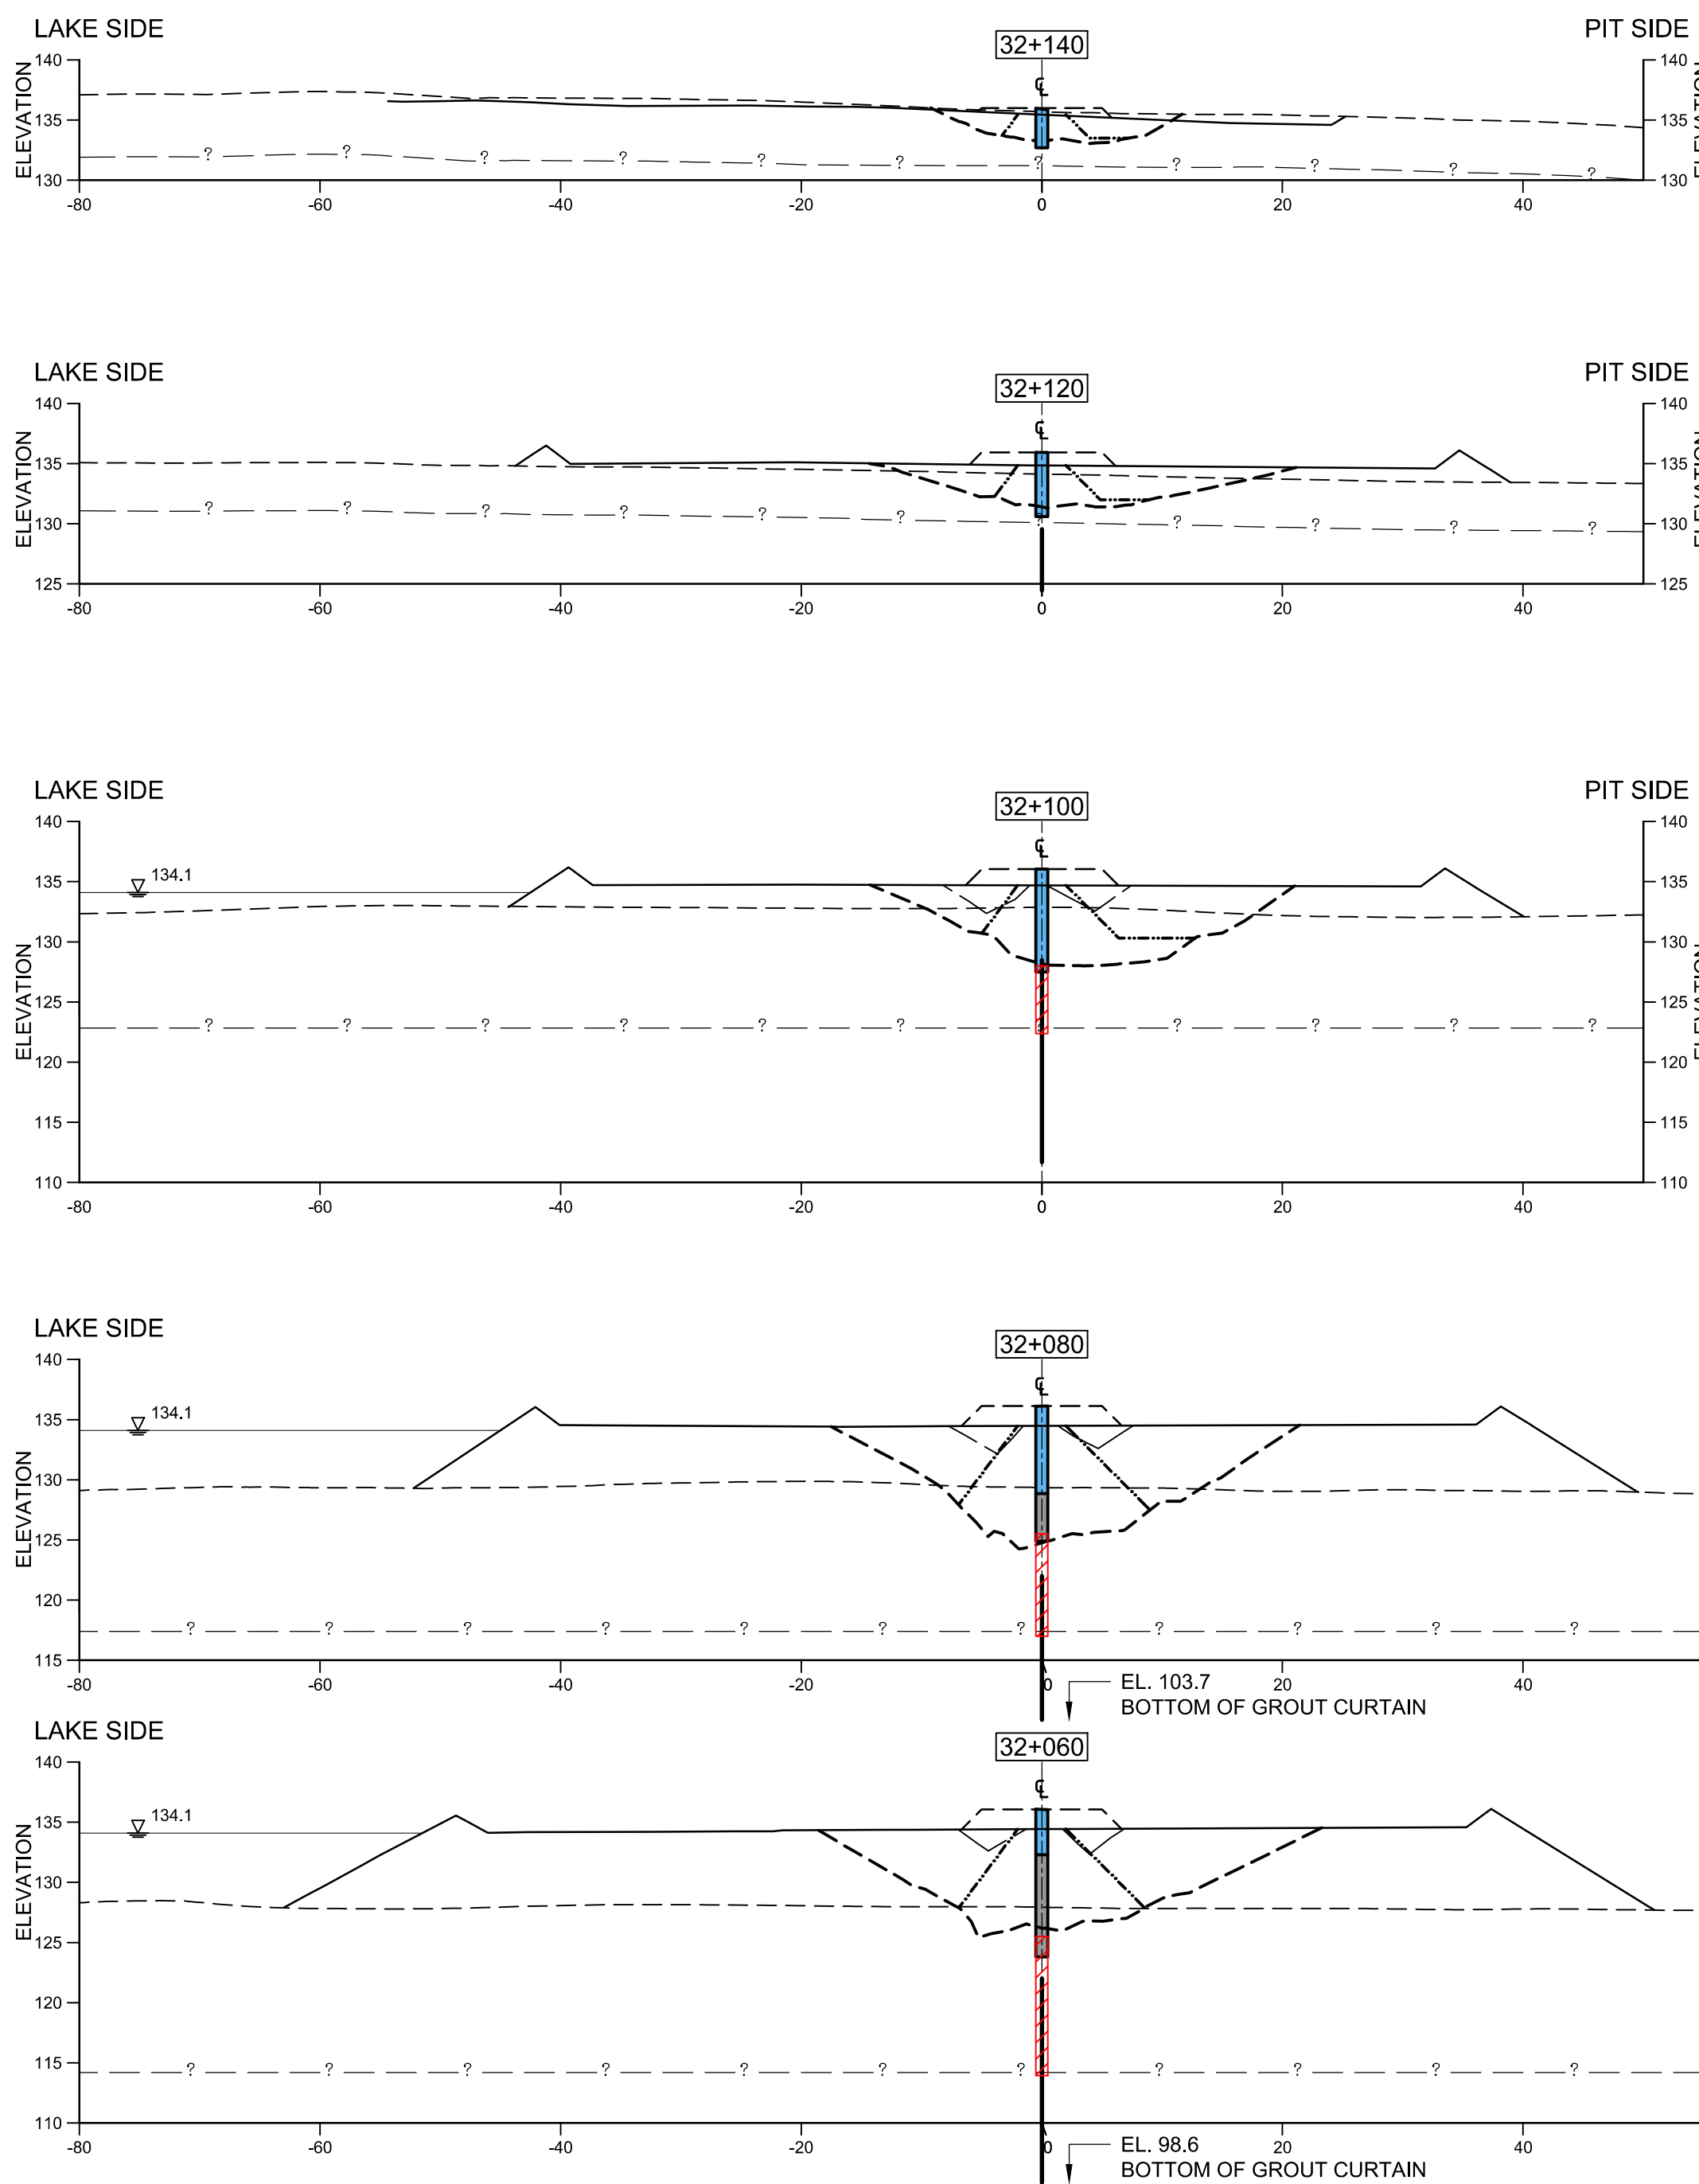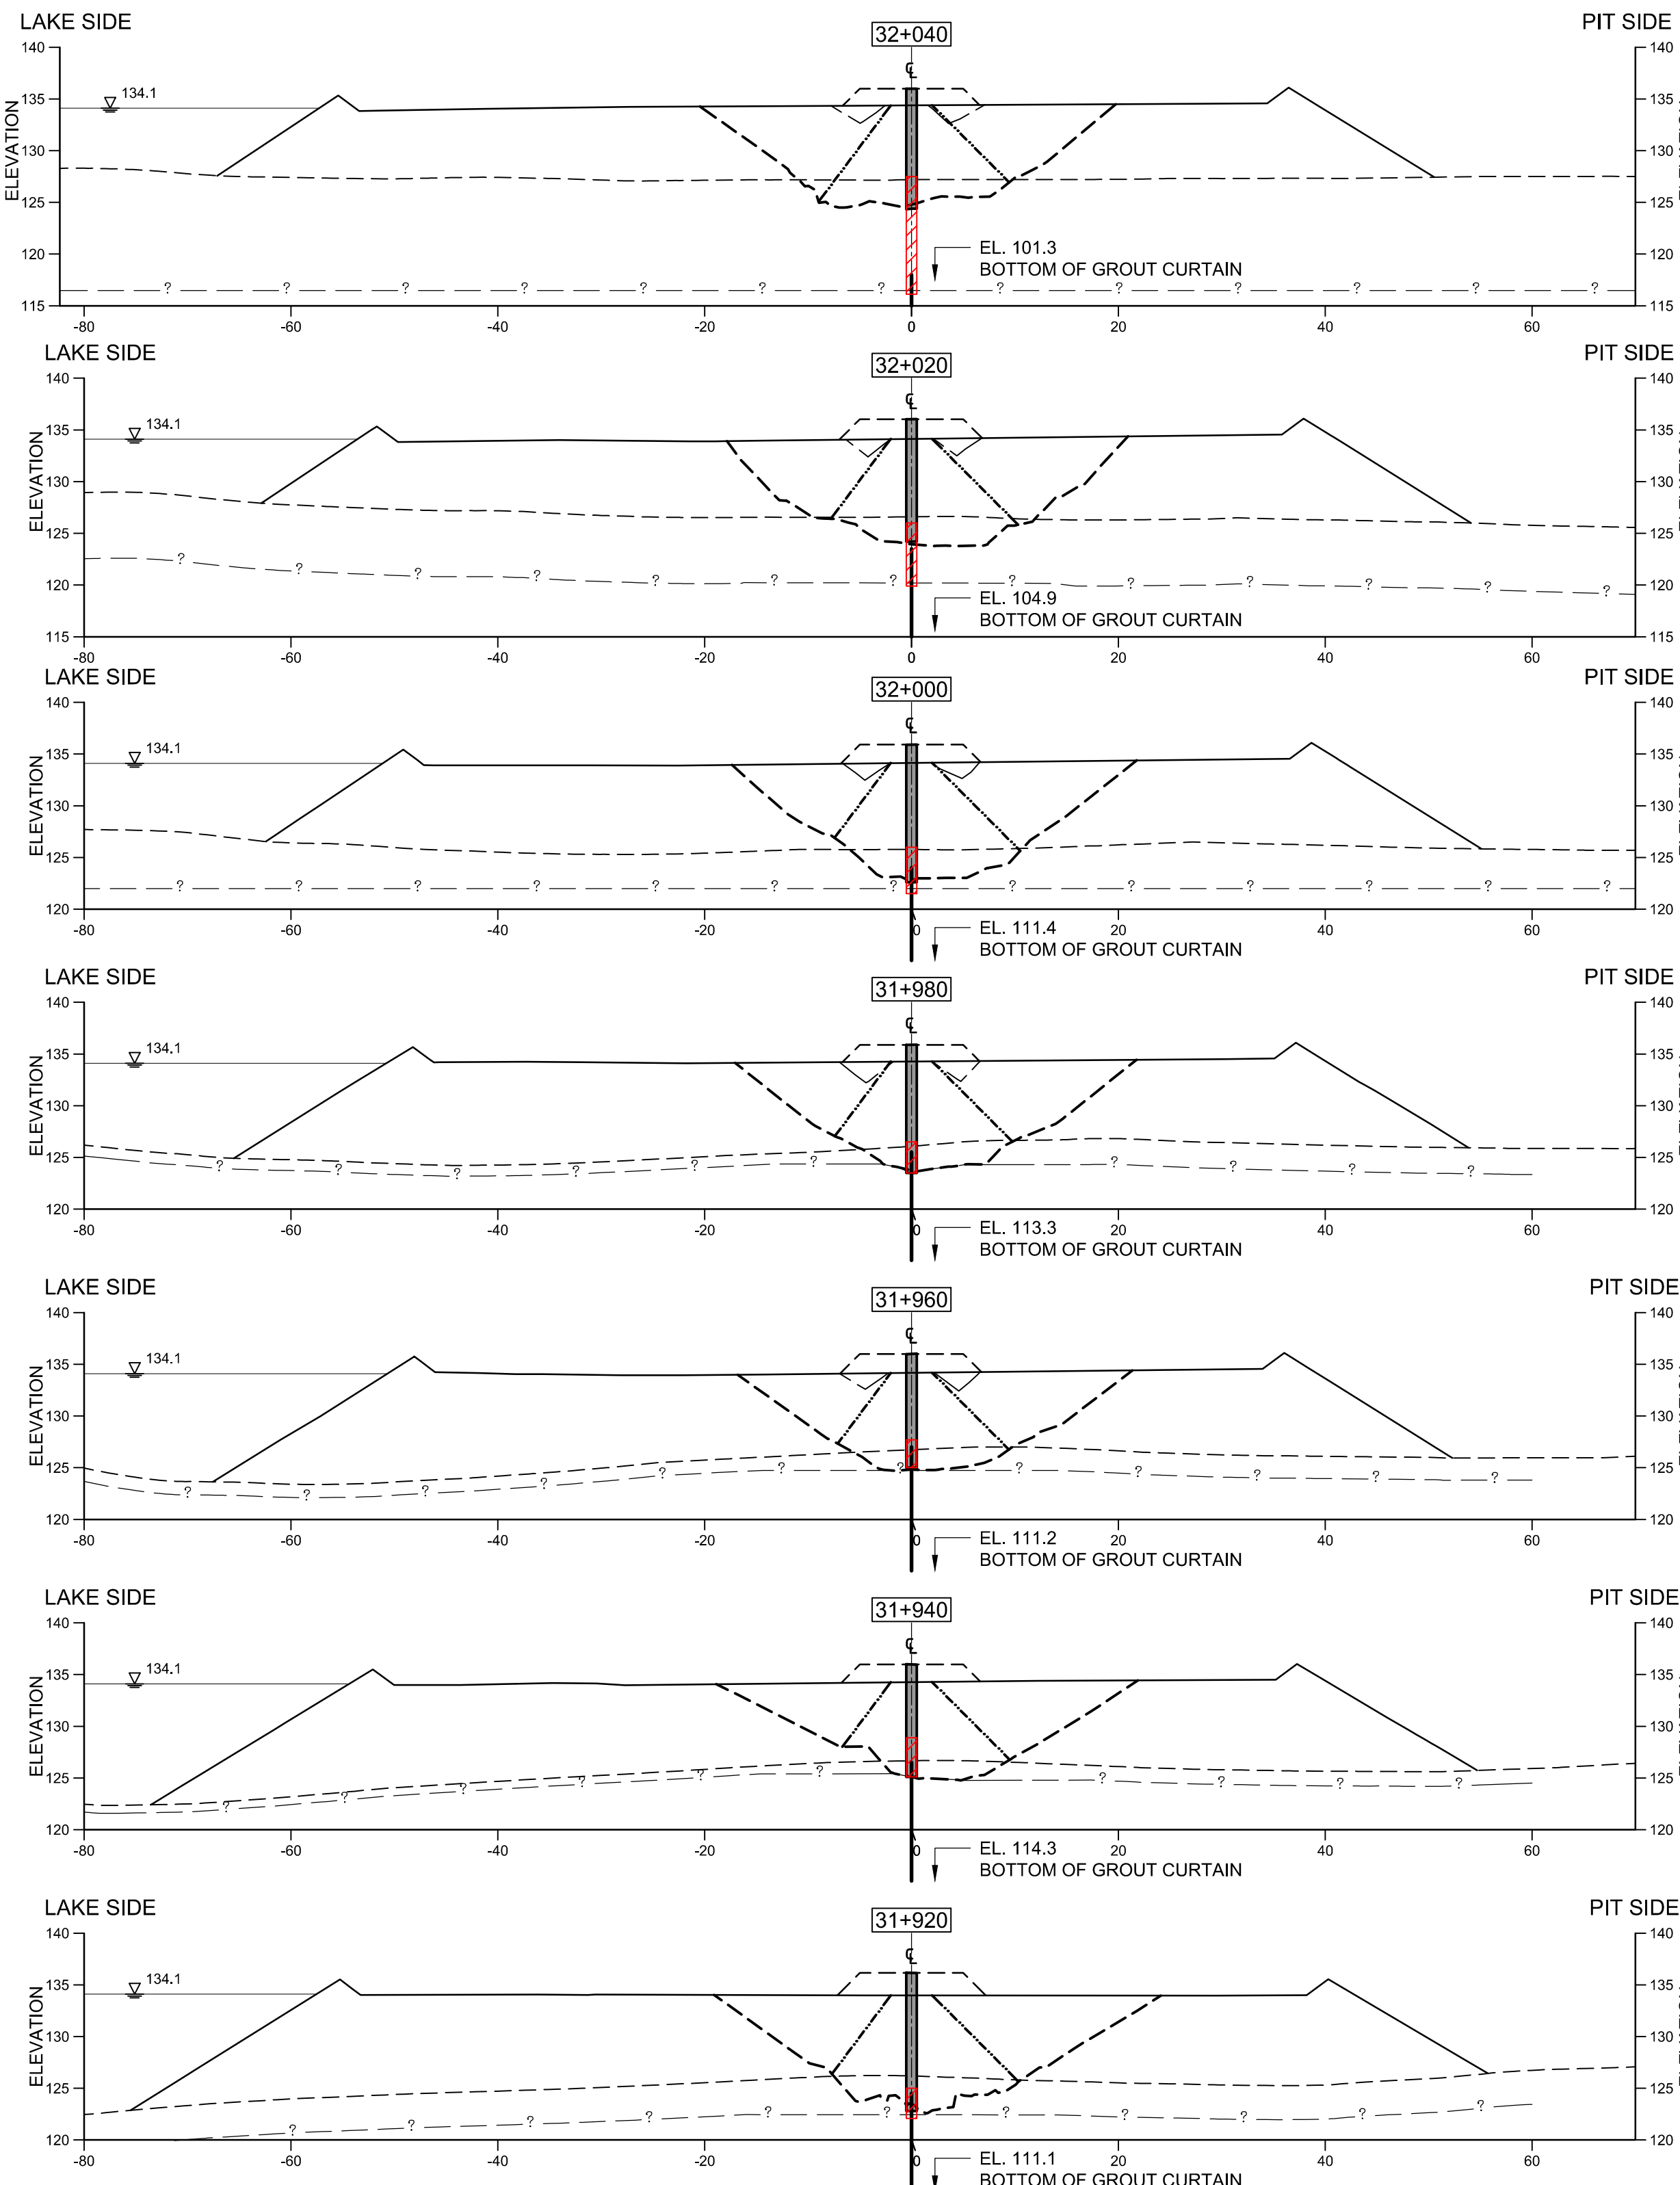

- ## LEGEND
- | | |
|---|---|
| ----- | LAKEBED BATHYMETRY OR LAND SURFACE SURVEY |
| ===== | AS-BUILT ROCKFILL (SEE NOTE 13) |
| ----- | AS-BUILT TRENCH EXCAVATION |
| --- ? --- | INFERRED BEDROCK (FROM INVESTIGATION) |
|  | AS-BUILT DENSIFICATION PLATFORM
(SHOWING ONLY CORE BACKFILL AND COARSE FILTER PORTION) |
|  | INFERRED DENSIFICATION PLATFORM
(SHOWING ONLY CORE BACKFILL AND COARSE FILTER PORTION) |
|  | INFERRED CORE BACKFILL |
|  | AS-BUILT CORE BACKFILL/REPLACEMENT |
|  | AS-BUILT CUTOFF WALL (SB) |
|  | AS-BUILT CUTOFF WALL (CSB) |
|  | AS-BUILT JET GROUT |
|  | GROUT CURTAIN |
- LAKE SIDE = UPSTREAM
PIT SIDE = DOWNSTREAM


- ## **NOTES**
-
- 1) ALL DIMENSIONS ARE IN METRES UNLESS OTHERWISE NOTED.
 - 2) ALL ELEVATIONS ARE IN METRES ABOVE SEA LEVEL (MASL), UNLESS OTHERWISE NOTED.
 - 3) CONTOUR INFORMATION ON LAND SUPPLIED BY AEM.
 - 4) SURVEYED LAKE SURFACE ELEVATION : THIRD PORTAGE LAKE = 134.1m (2008)
 - 5) LAKEBED SURFACE BASED ON BATHYMETRIC SURVEY BY GOLDER ASSOCIATES LTD., 2006 AND DETAILED (0.5m CONTOUR INTERVAL) 2008.
 - 6) BEDROCK SURFACE INFERRED FROM 2009 AND 2010 AIR-TRACK INVESTIGATION, 2010 BOREHOLE INVESTIGATION AND CUTOFF TRENCH EXCAVATION, GROUTING AND JET GROUTING DATA.
 - 7) ALL SLOPES ARE NOMINAL.
 - 8) CORE BACKFILL WITHIN THE DOWNSTREAM SIDE OF THE TRENCH PLACED AT LEAST WITHIN 2m OF THE LAKEBED SEDIMENT ELEVATION.
 - 9) MATERIAL PLACEMENT ANGLES FOR THE CORE BACKFILL AND COARSE FILTER/FINE ROCKFILL ARE APPROXIMATE. DOWNSTREAM CORE BACKFILL SLOPE WAS MONITORED TO ENSURE THE 2m Limit (NOTE 8) WAS ACHIEVED.
 - 10) ALONG PORTIONS OF THE ALIGNMENT, LATERAL PLACEMENT OF CORE BACKFILL ON THE DOWNSTREAM SIDE OF THE EXCAVATION (SEE 4300-12, SECTION C) IN ADVANCE OF THE PROGRESSIVE BACKFILLING OF CORE BACKFILL AND COARSE FILTER/ FINE ROCKFILL WAS REQUIRED BY THE ENGINEER.
 - 11) INITIAL TRENCH EXCAVATION SURFACE SHOWN BETWEEN STA. 31+020 TO 31+030 ESTIMATED, NO SOUNDING MEASUREMENTS WERE COMPLETED PRIOR TO CORE BACKFILL PLACEMENT
 - 12) ADDITIONAL ROCKFILL HAS BEEN PLACED OVER THE DIKE PLATFORM, NOT SURVEYED.
 - 13) ONLY THE CORE BACKFILL AND COARSE FILTER COMPONENTS OF THE DENSIFICATION PLATFORM ARE SHOWN.

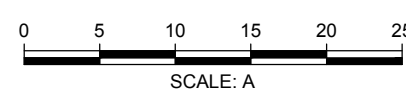


PROJECT	AEM	AGNICO-EAGLE MINES LIMITED MEADOWBANK GOLD PROJECT NUNAVUT
TITLE	BAY-GOOSE DIKE SOUTH PORTION CROSS SECTIONS (5 OF 5)	

 Golder Associates	PROJECT No. 09-1428-5007	FILE No. 4300_0_
	DESIGN KD 02MAY10	SCALE AS SHOWN REV.
	CADD NS 10MAY10	
	CHECK FE 31MAY10	4300-19
	REVIEW MRJ 31MAY10	


CADD FILE: N:\bur-graphics\Projects\2009\1428\09-1428-5007\Drafting\4000\meadowbank - bay-goose (south) dike as-built\4300_1_20.dwg
REVISION DATE: 12/5/2012 4:33:53 PM By: TYKLASSEN

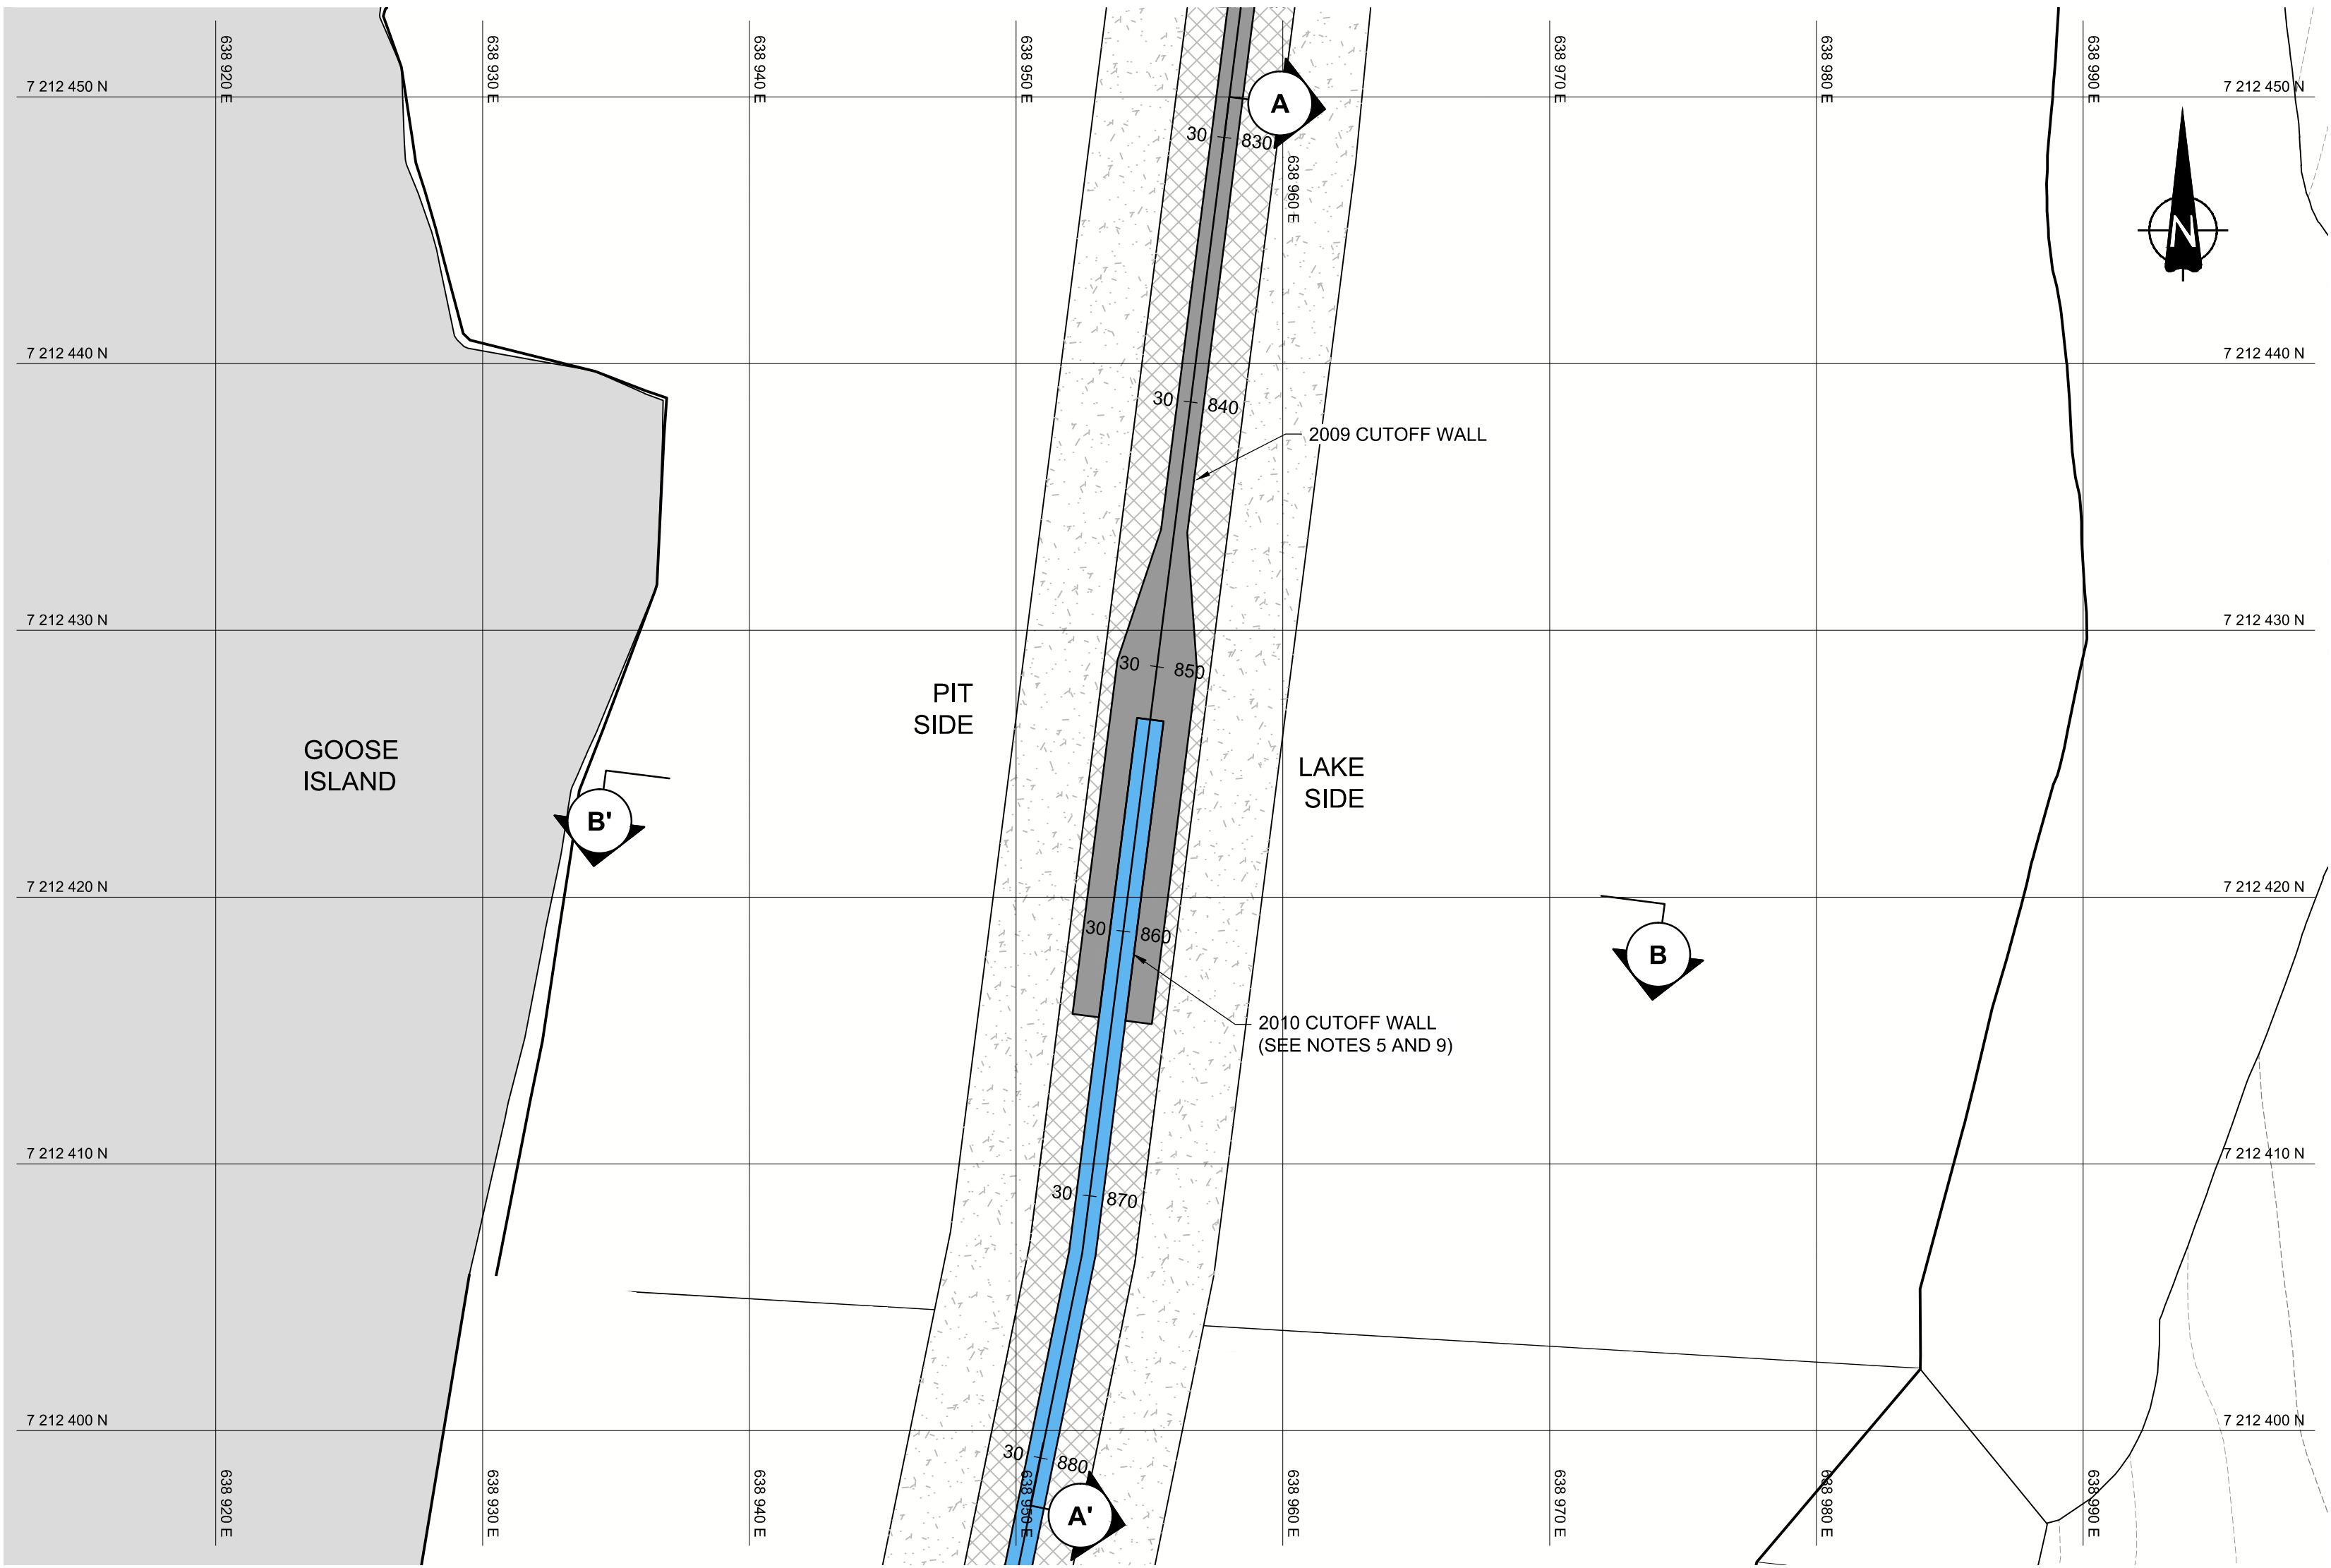


1 SB TO CSB KEY-IN DETAIL
SCALE: A

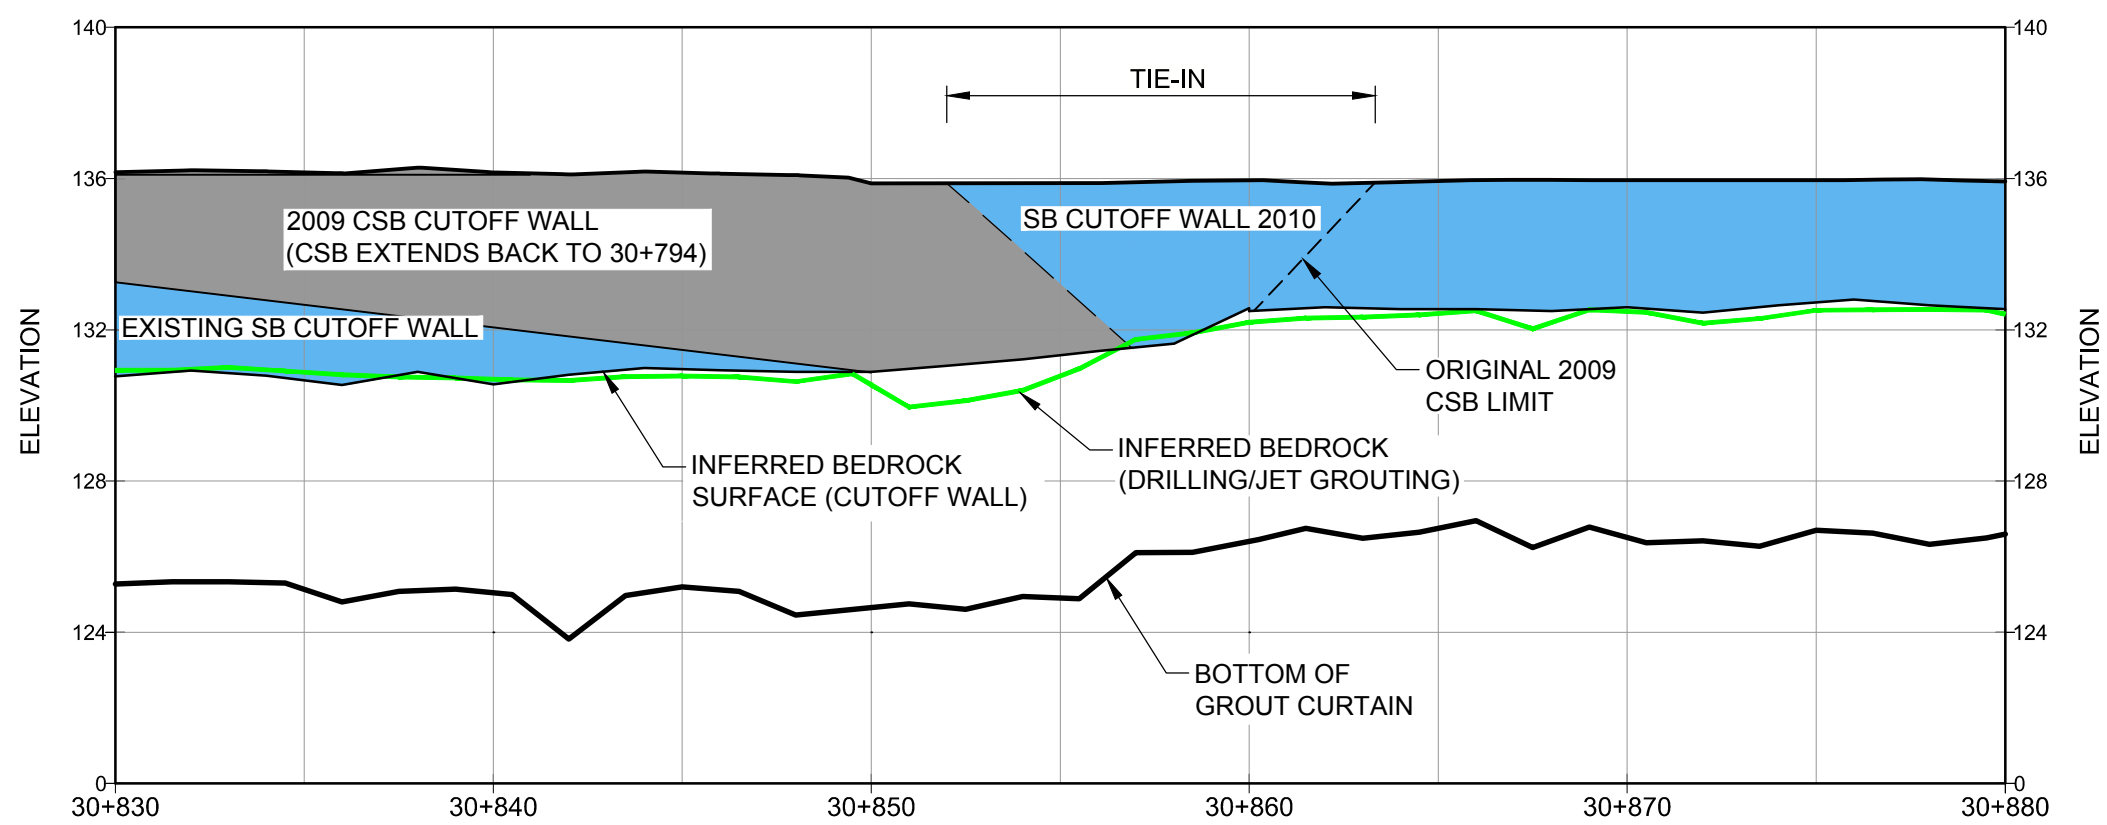

A-A' SB TO CSB KEY-IN PROFILE
SCALE: A

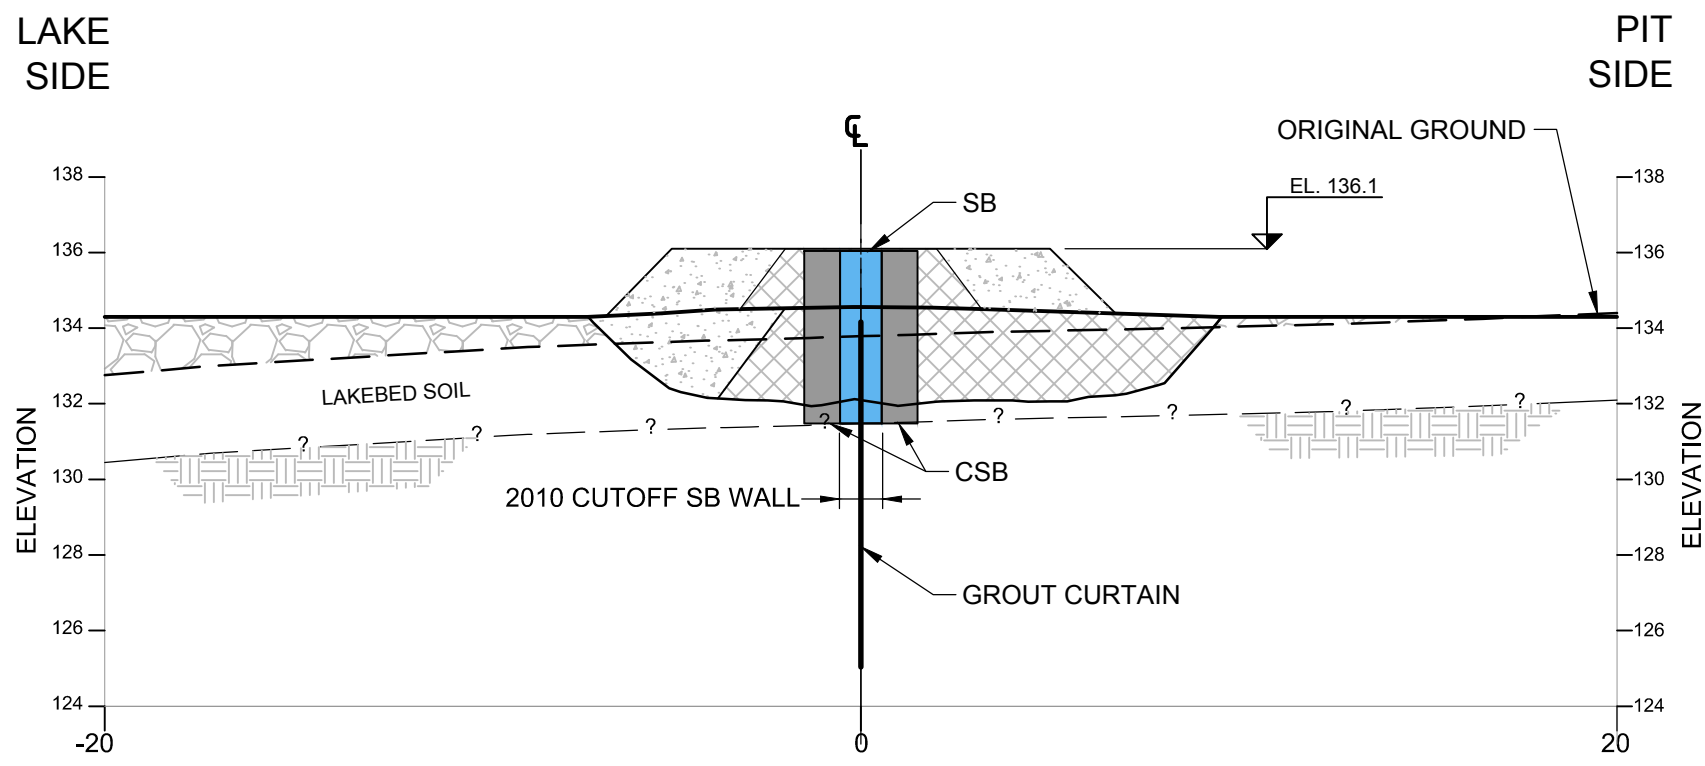

B-B' SB TO CSB KEY-IN SECTION
SCALE: A

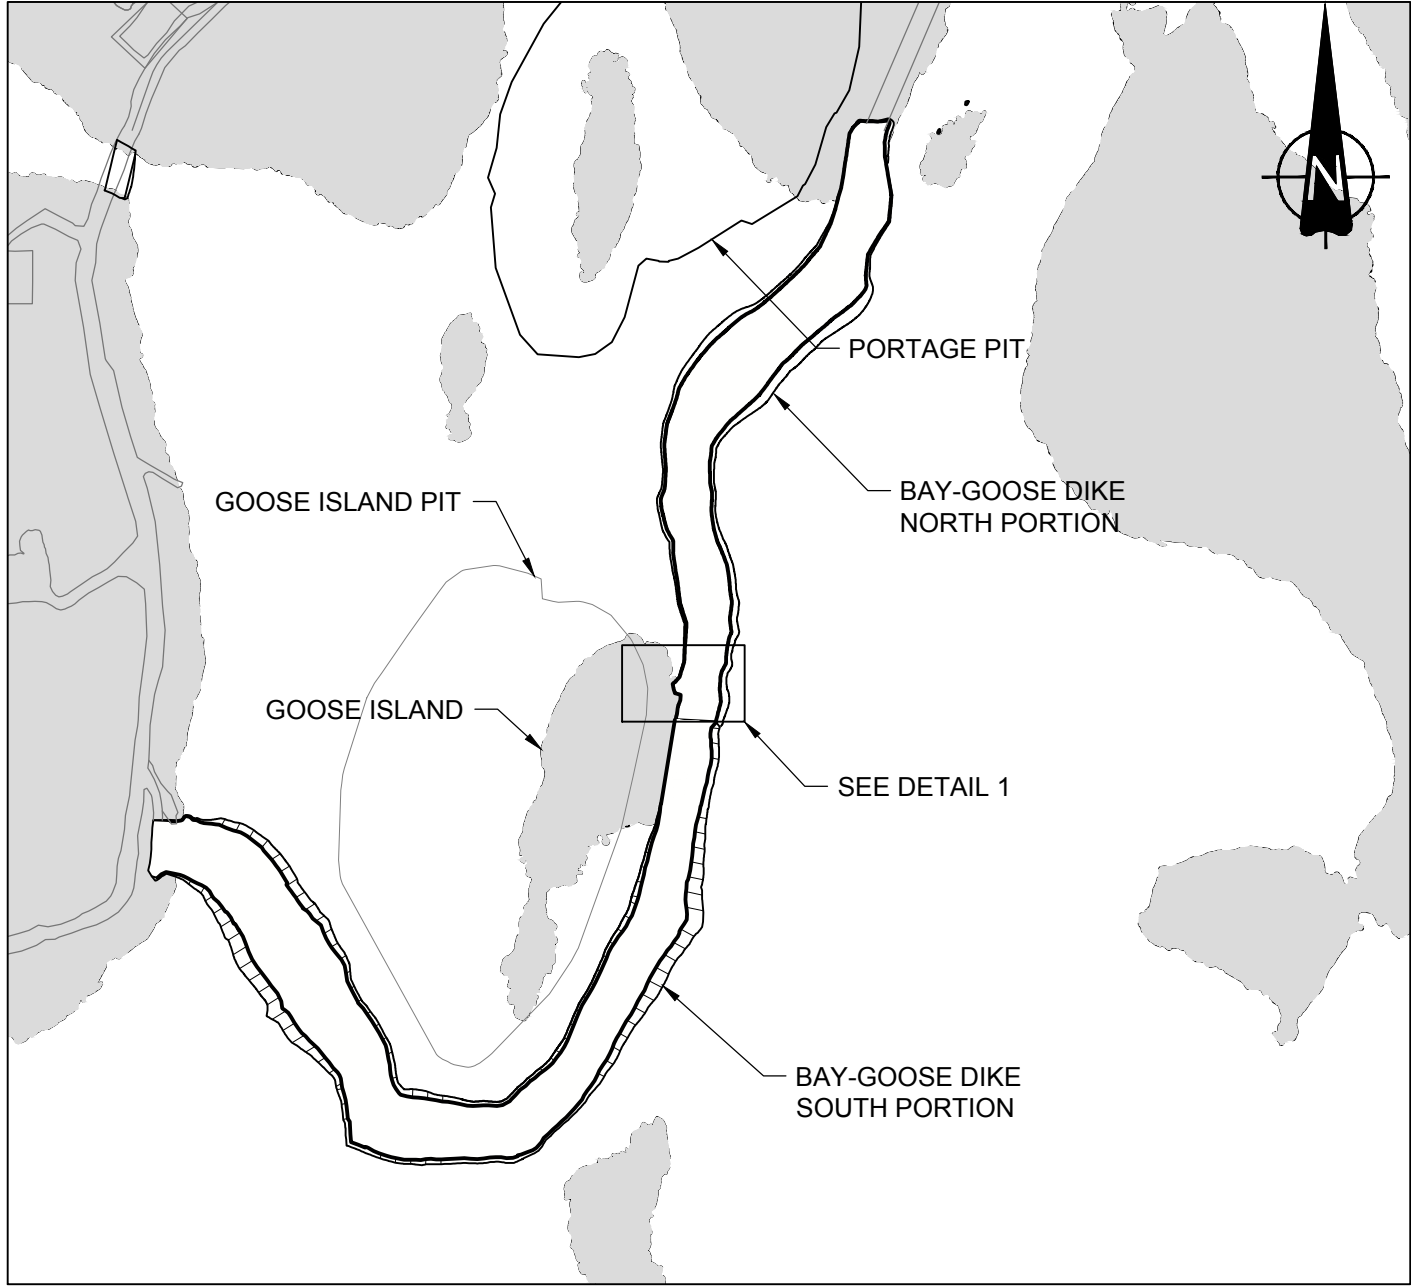


KEY PLAN
SCALE: B

LEGEND	
	INFERRED BEDROCK
	CORE BACKFILL
	ROCKFILL
	COARSE FILTER
	CEMENT-SOIL-BENTONITE (CSB) CUTOFF WALL (2009)
	SOIL-BENTONITE (SB) CUTOFF WALL
	MINOR BATHYMETRY CONTOUR
	MAJOR BATHYMETRY CONTOUR
	SHORELINE
	ROCKFILL PLATFORM CREST
	GROUT CURTAIN
	INFERRED BEDROCK (DRILLING/JET GROUTING)

- NOTES**
- 1) ALL DIMENSIONS ARE IN METRES UNLESS OTHERWISE NOTED.
 - 2) ALL ELEVATIONS ARE IN METRES ABOVE SEA LEVEL (MASL), UNLESS OTHERWISE NOTED.
 - 3) GRID REFERENCE: NAD 83, UTM ZONE 14.
 - 4) LAKEBED SURFACE BASED ON BATHYMETRIC SURVEY BY GOLDER ASSOCIATES LTD. 2008. DEPTH TO BEDROCK BENEATH CUTOFF WALL BASED ON INFORMATION OBTAINED DURING CONSTRUCTION.
 - 5) CUTOFF WALL FOUNDED ON BEDROCK SURFACE APPROVED BY ENGINEER. ALL ICE RICH MATERIAL (SOIL AND ROCK) WAS EXCAVATED BETWEEN STA. 30+830 TO 30+880.
 - 6) SAFETY BERMS IN PLAN NOT SHOWN FOR CLARITY.
 - 7) BEDROCK AND LAKEBED SURFACES ARE SHOWN AS SMOOTH LINES FOR ILLUSTRATIVE PURPOSES.
 - 8) MATERIAL PLACEMENT ANGLES FOR THE CORE BACKFILL, COARSE FILTER AND ROCKFILL ARE APPROXIMATE.
 - 9) 2009 CSB CUTOFF WALL WAS WIDENED TO ALLOW CONNECTION WITH 2010 SB CUTOFF WALL. CEMENT CONTENT WAS REDUCED TO 2-3% WITHIN THE CSB TO ALLOW MATERIALS TO BE EXCAVATED IN 2010.
 - 10) GROUTING PLATFORM AND THERMAL CAP NOT SHOWN IN SECTION OR PROFILE FOR CLARITY.

- REFERENCE**
- 1) PORTAGE PIT DESIGN BY AEM, MARCH, 2009.
 - 2) GOOSE ISLAND PIT DESIGN BY AEM, MAY, 2010.
 - 3) ROAD AND MINE FACILITIES PROVIDED BY AEM, JANUARY, 2009.

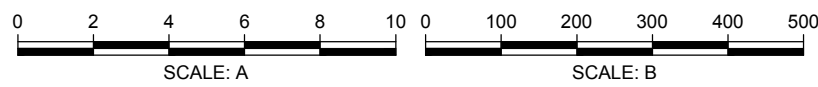

PROJECT	AEM	AGNICO-EAGLE MINES LIMITED MEADOWBANK GOLD PROJECT NUNAVUT
TITLE	BAY-GOOSE DIKE SOUTH PORTION 2009 TO 2010 TIE-IN PLAN AND SECTION	
	PROJECT No.	09-1428-5007
	FILE No.	4300_1_20
	DESIGN	KD 02MAY10
	CADD	NS 10MAY10
	CHECK	FE 31MAY10
	REVIEW	MRJ 31MAY10
SCALE		AS SHOWN
		REV. 1
4300-20		



DRAWING NO.	REFERENCES	REV	DATE	DES	REVISION DESCRIPTION	CADD	CHK	RVW	STAMP
		1	15DEC12	FE	AS-BUILT	EA	GRB	FE	
		2	06JUL10	KD	ISSUED FOR CONSTRUCTION	JK	FE	MRJ	
		3	18JUN10	KD	ISSUED FOR CLIENT REVIEW	JK	FE	MRJ	
		4	31MAY10	KD	ISSUED FOR CLIENT REVIEW	NS	FE	MRJ	




- 1) ALL DIMENSIONS ARE IN METRES UNLESS OTHERWISE NOTED.
- 2) ALL ELEVATIONS ARE IN METRES ABOVE SEA LEVEL (MASL), UNLESS OTHERWISE NOTED.
- 3) GRID REFERENCE: NAD 83, UTM ZONE 14.
- 4) LAKEBED SURFACE BASED ON BATHYMETRIC SURVEY BY GOLDER ASSOCIATES LTD. 2008. DEPTH TO ROCKFILL SURFACE WITH CUTOFF WALL BASED ON INFORMATION OBTAINED DURING CONSTRUCTION.
- 5) ROCKFILL BENEATHING THERMAL CAP TO BE PLACED BY AEM. PLACEMENT IN PROGRESS AS OF APRIL 2013.
- 6) CUTOFF WALL FOUNDED ON BEDROCK SURFACE APPROVED BY ENGINEER. ALL ICE RICH MATERIAL WAS EXCAVATED UNDER CUTOFF WALL. FOOTPRINT BETWEEN STA. 30+860 TO 31+020.

REFERENCE


- 1) PORTAGE PIT DESIGN BY AEM, MARCH, 2009.
- 2) GOOSE ISLAND PIT DESIGN BY AEM, MAY, 2010.
- 3) ROAD AND MINE FACILITIES PROVIDED BY AEM, JANUARY, 2009.

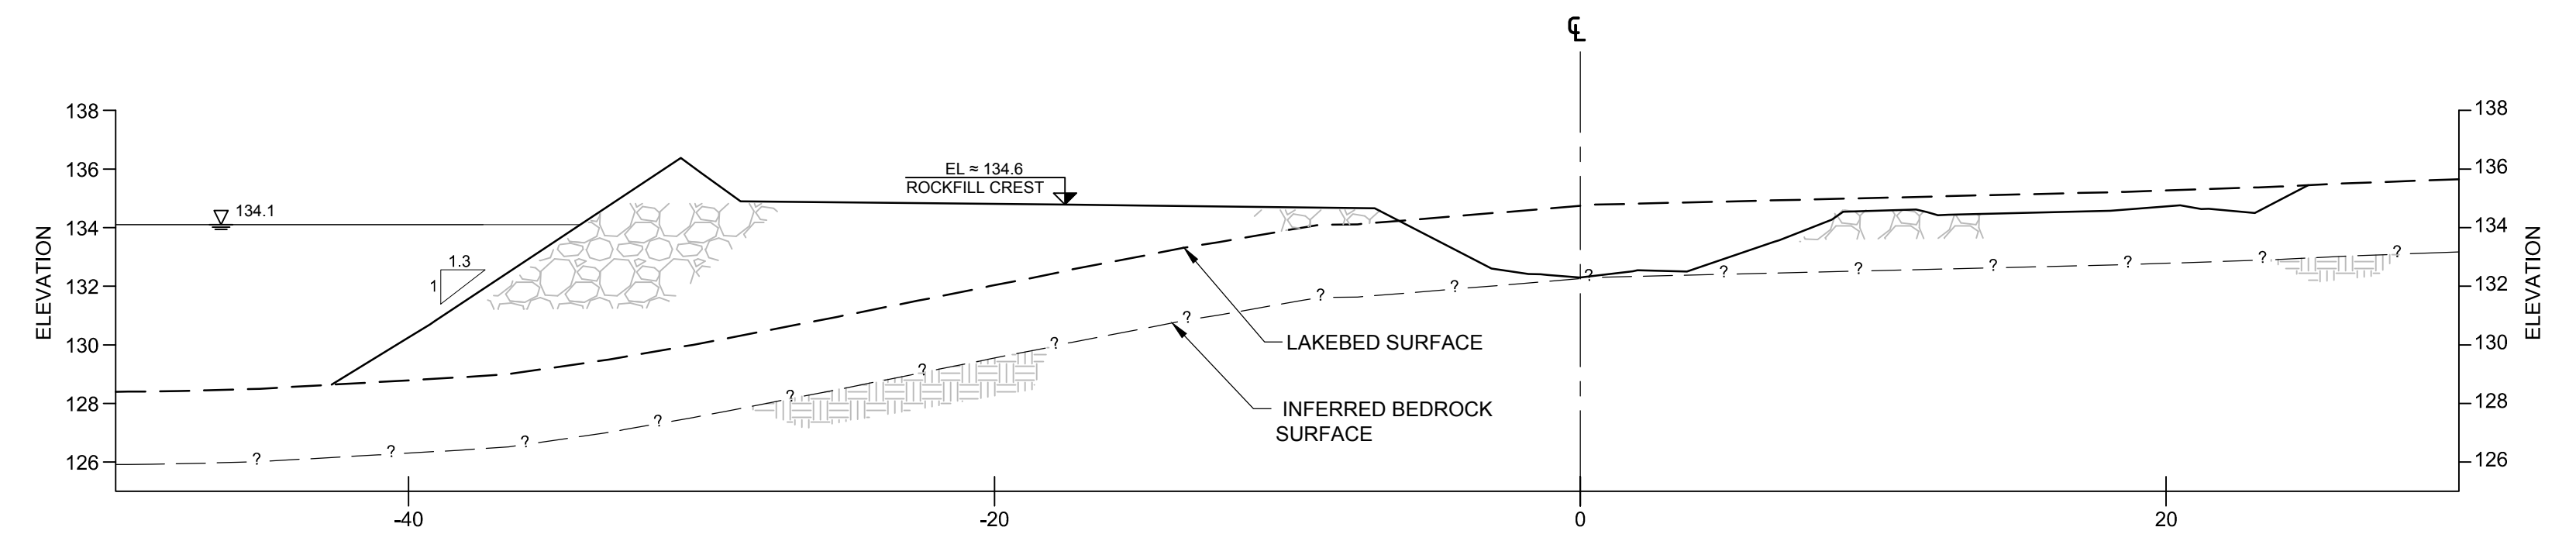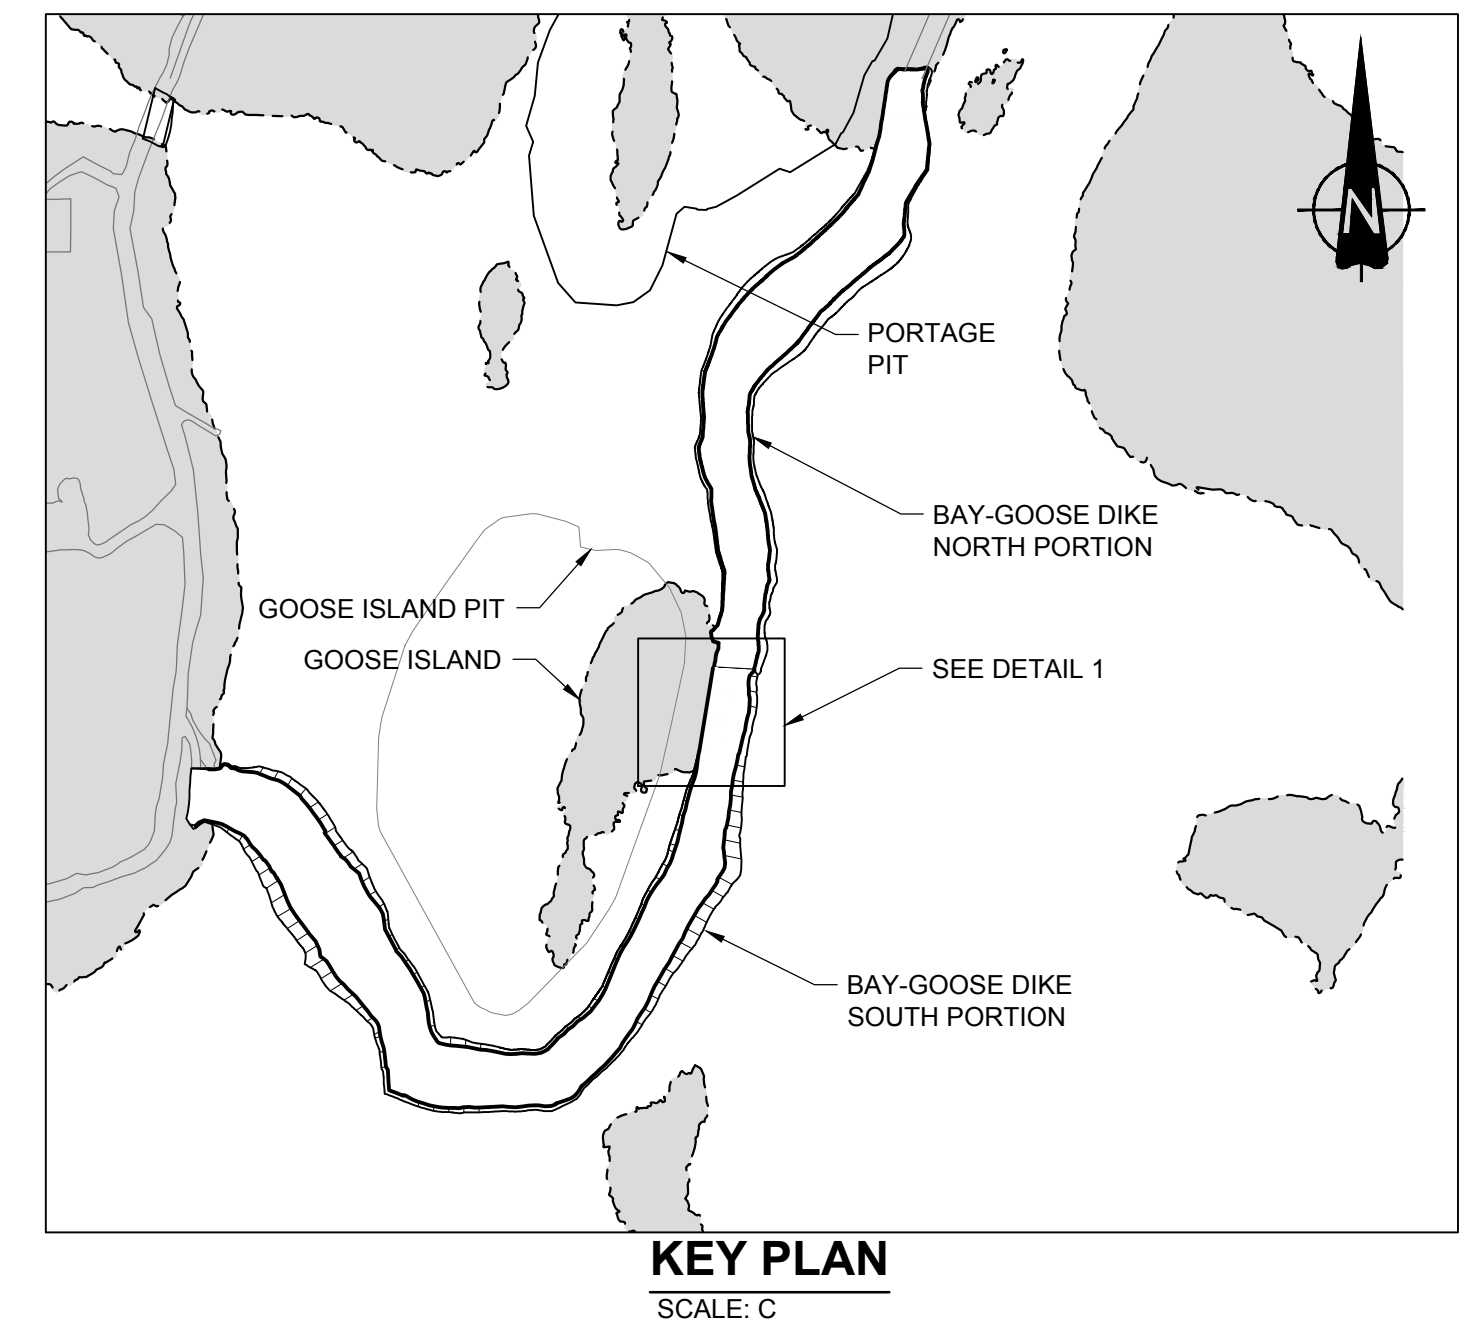

A-A' **TYPICAL ISLAND ABUTMENT SECTION - EXCAVATION**
SCALE: A

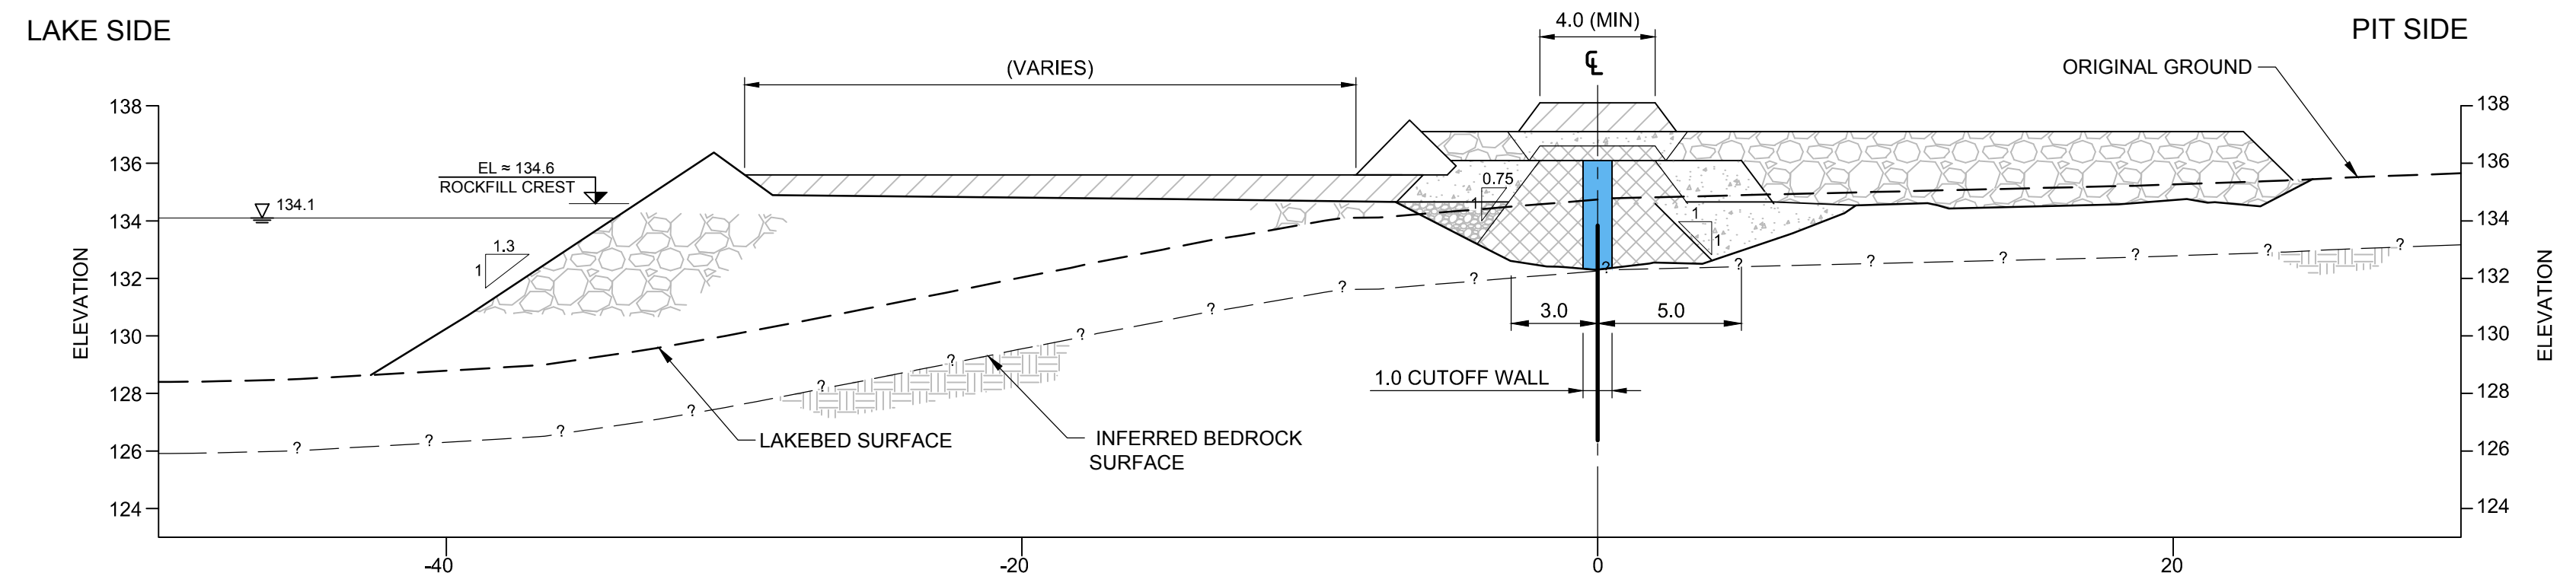

B-B' **TYPICAL ISLAND ABUTMENT SECTION - MATERIAL PLACEMENT**
SCALE: A

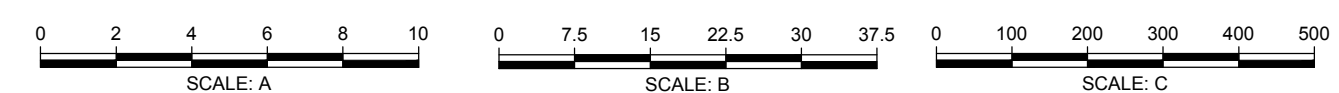

PROJECT

AEM

AGNICO-EAGLE MINES LIMITED
MEADOWBANK GOLD PROJECT
NUNAVUT

TITLE

BAY-GOOSE DIKE SOUTH PORTION GOOSE
ISLAND ABUTMENT PLAN AND SECTION




Golder


Associates

PROJECT No.		09-1428-5007	FILE No.		4300_1_21
DESIGN	KD	02MAY10	SCALE	AS SHOWN	REV. 1
CADD	NS	10MAY10	4300-21		
CHECK	FE	31MAY10			
REVIEW	MRJ	31MAY10			



REVISION DATE: 12/5/2012 4:57:45 PM By: TTK/LASSEN CADD FILE: N:\bur-graphics\Projects\2009\1428-5007\Drafting\4000\meadowbank - bay-goose (south) dike as-built\4300_1_23.dwg

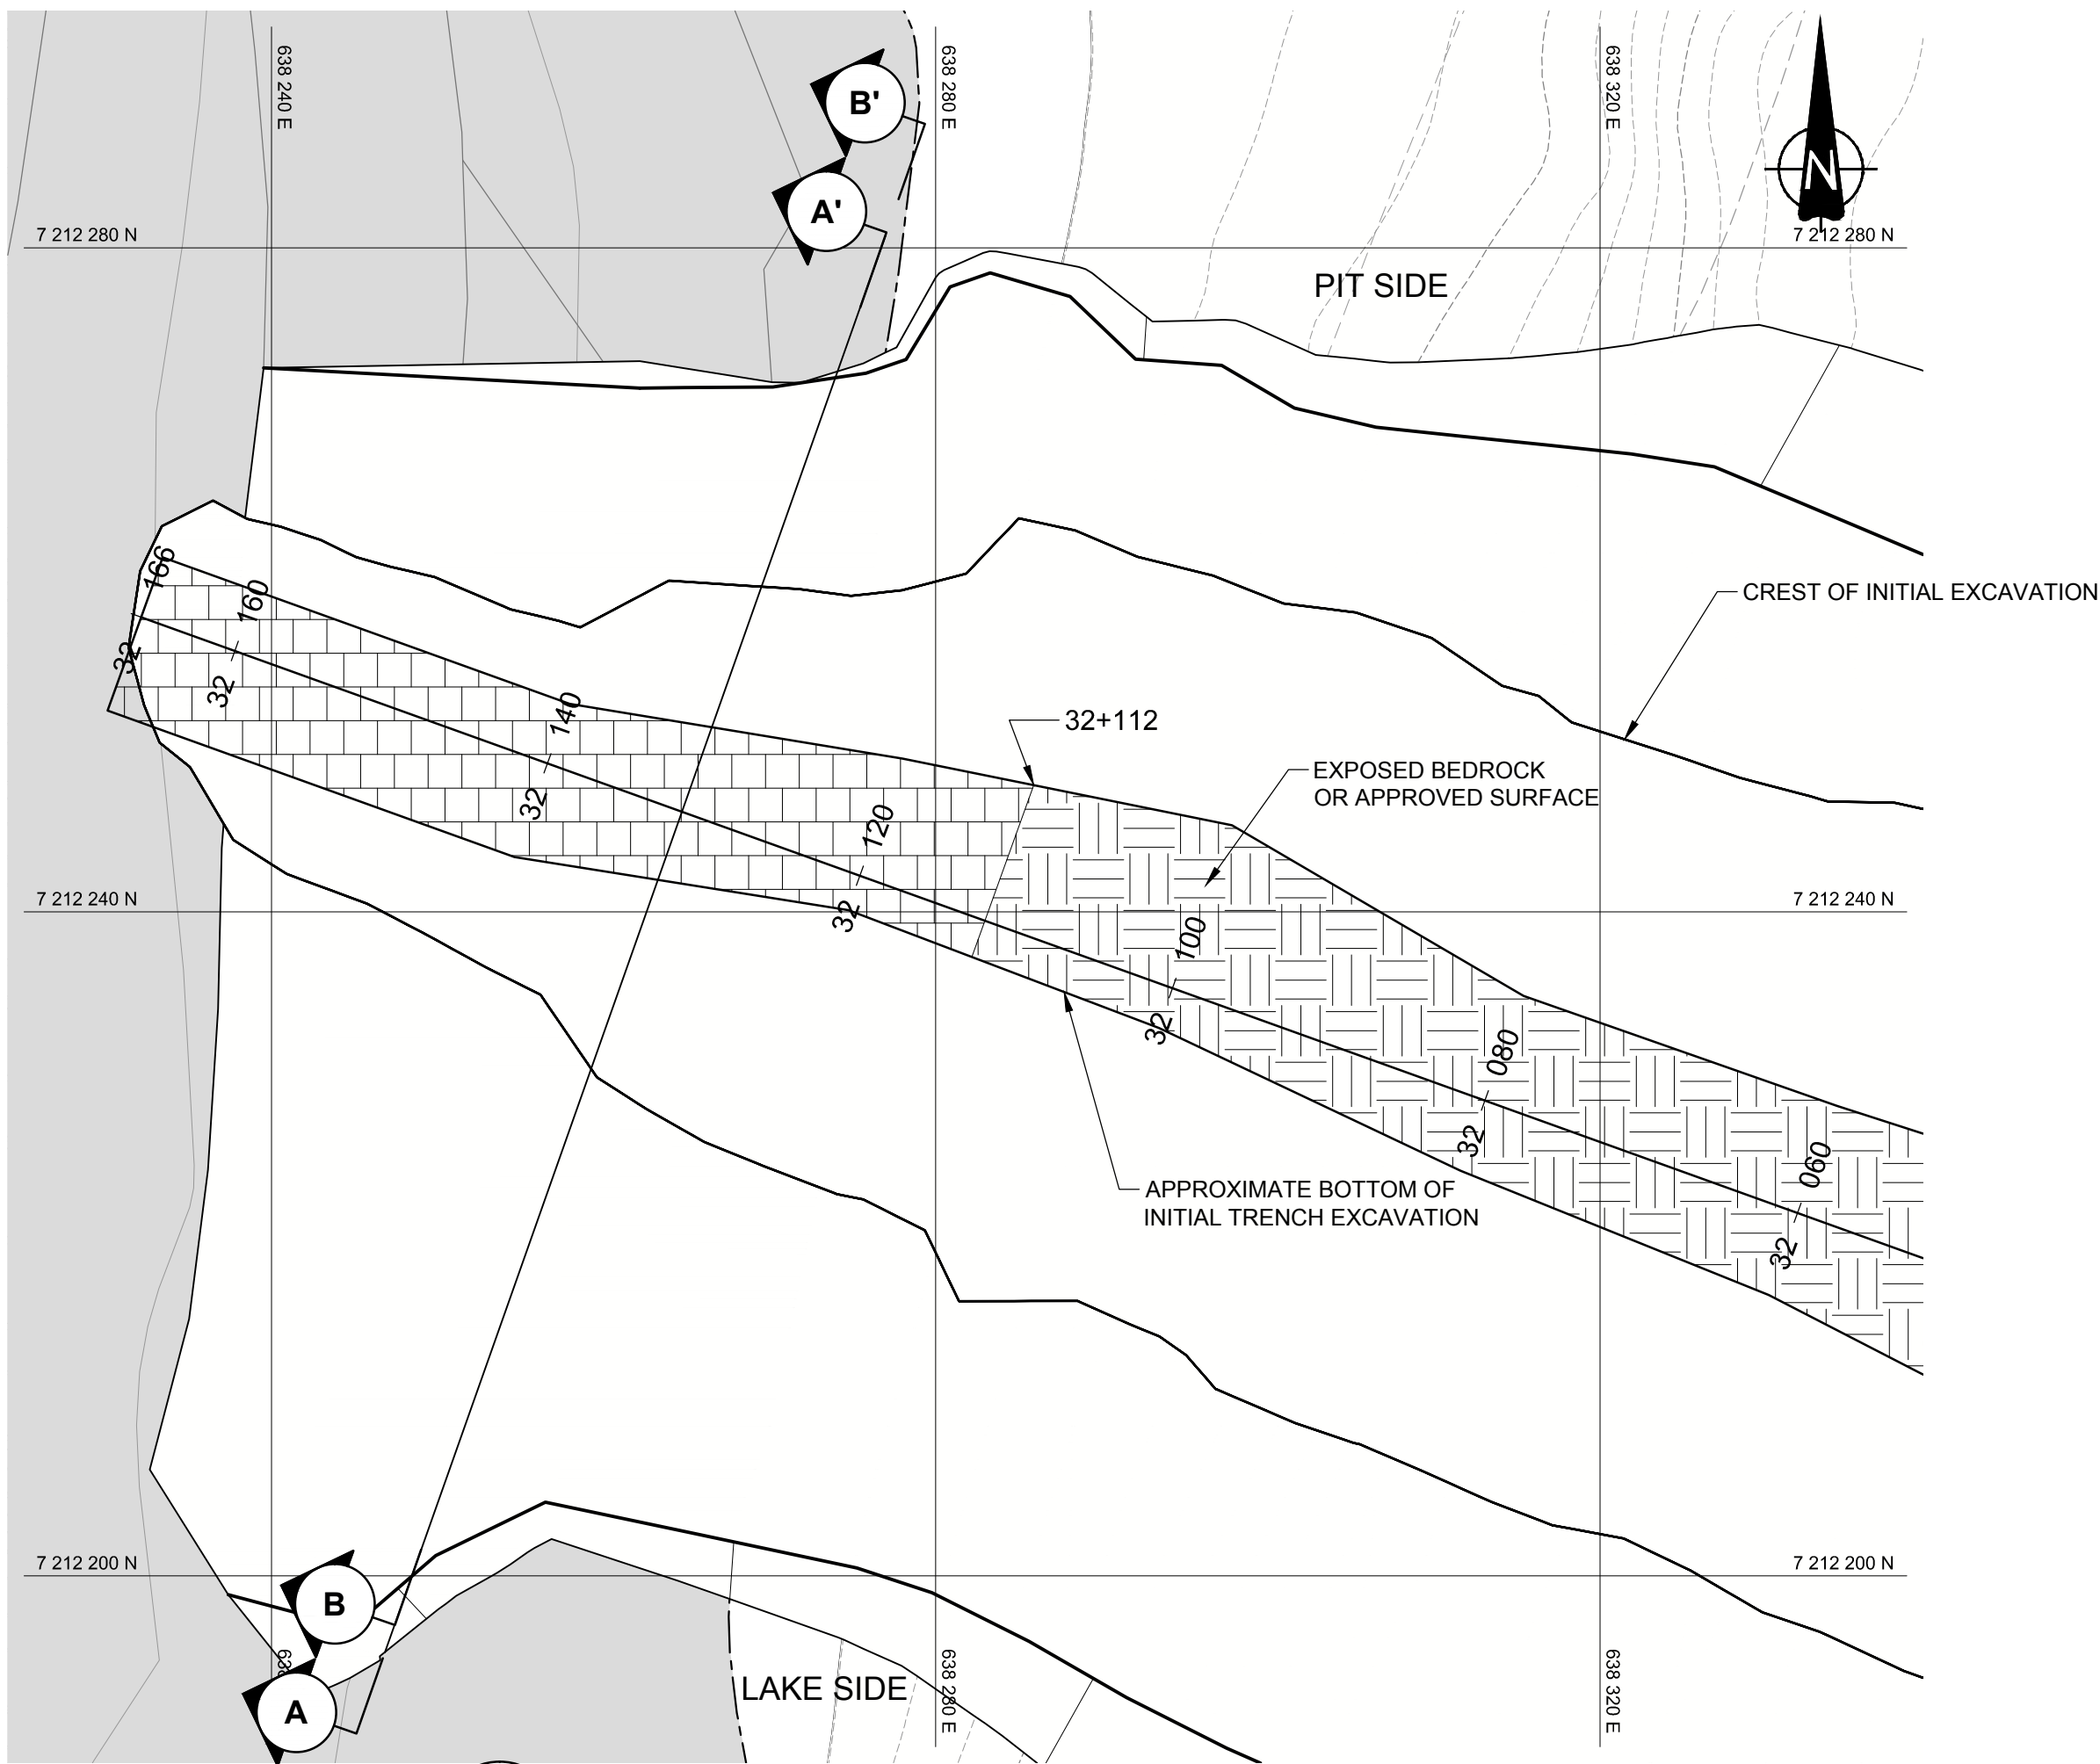

1 SOUTH ABUTMENT EXCAVATION PLAN
SCALE: B


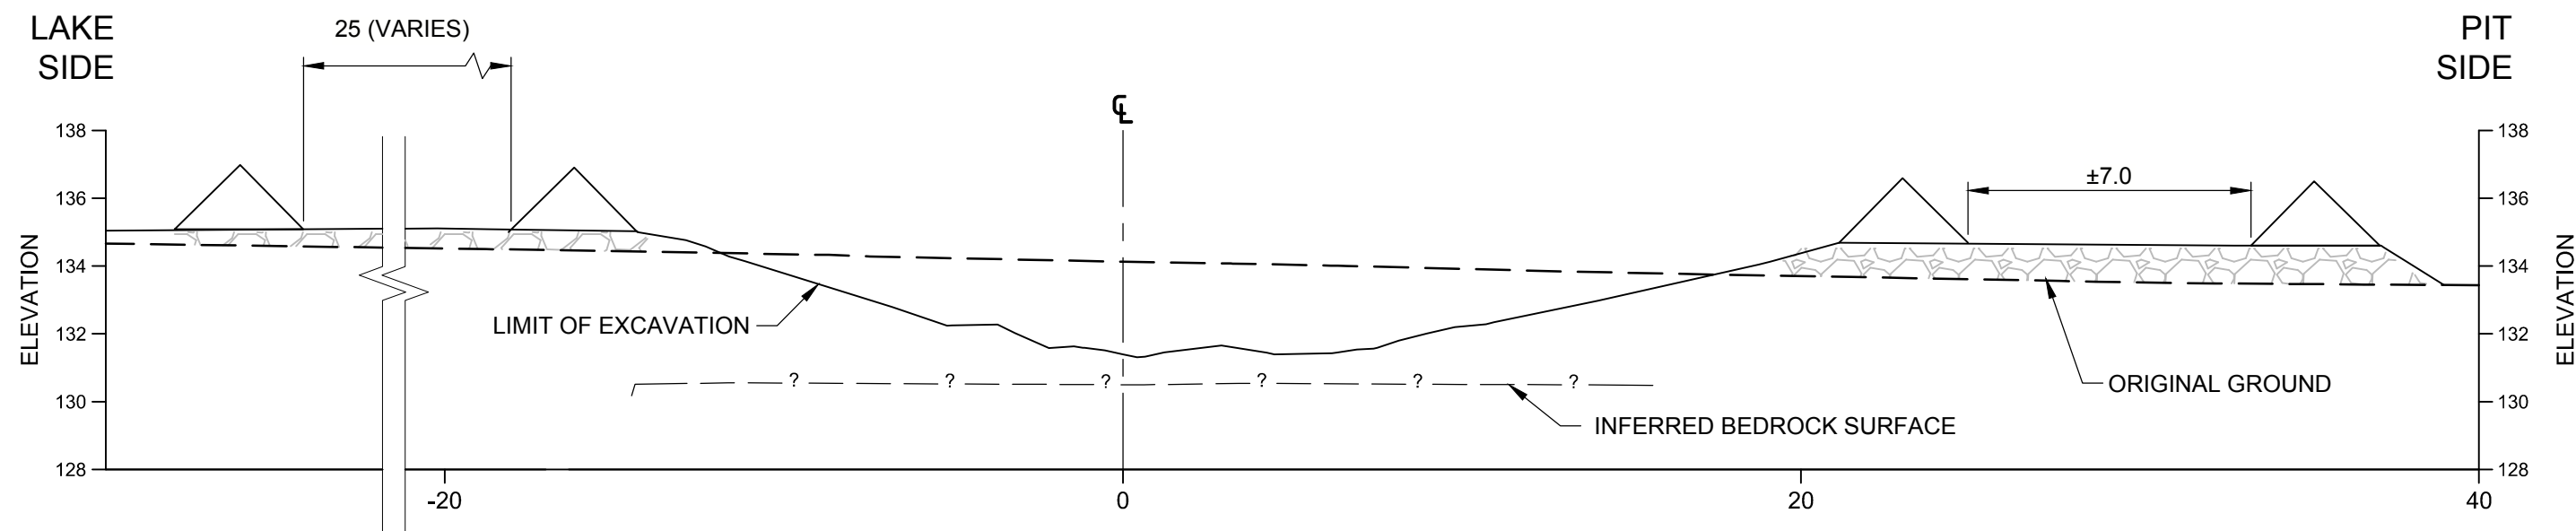


A-A' TYPICAL SOUTH ABUTMENT EXCAVATION SECTION
SCALE: A

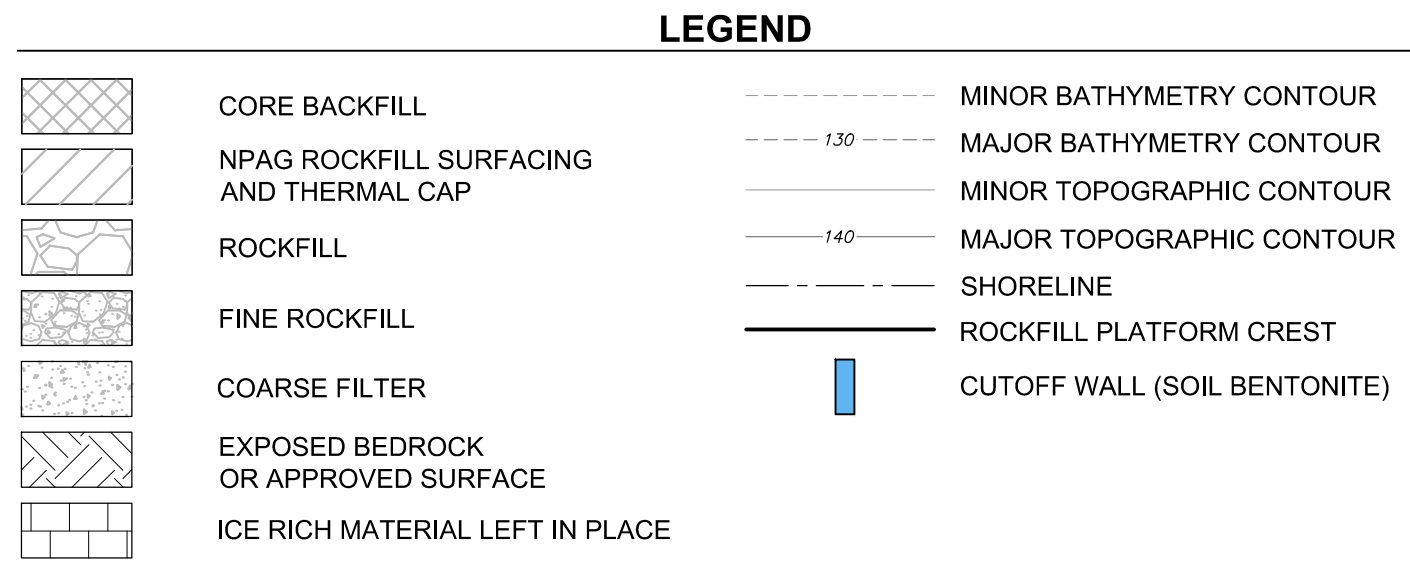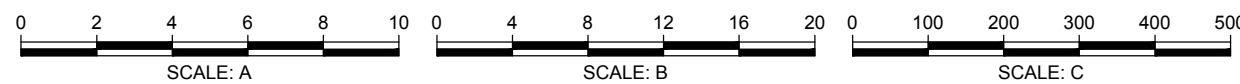

- NOTES**
- 1) ALL DIMENSIONS ARE IN METRES UNLESS OTHERWISE NOTED.
 - 2) ALL ELEVATIONS ARE IN METRES ABOVE SEA LEVEL (MASL), UNLESS OTHERWISE NOTED.
 - 3) GRID REFERENCE: NAD 83, UTM ZONE 14.
 - 4) LAKEBED SURFACE BASED ON BATHYMETRIC SURVEY BY GOLDER ASSOCIATES LTD. 2008. DEPTH TO BEDROCK BENEATH CUTOFF WALL CENTRELINE BASED ON INFORMATION OBTAINED DURING CONSTRUCTION.
 - 5) ROCKFILL SURFACING AND THERMAL CAP TO BE PLACED BY AEM. PLACEMENT IN PROGRESS AS OF APRIL 2013.
 - 6) CUTOFF WALL FOUNDED ON BEDROCK OR SURFACE APPROVED BY ENGINEER. ALL ICE RICH MATERIAL WAS EXCAVATED, EXCEPT BETWEEN STA. 32+112 AND 32+166.

- REFERENCE**
- 1) PORTAGE PIT DESIGN BY AEM, MARCH, 2009.
 - 2) GOOSE ISLAND PIT DESIGN BY AEM, MAY, 2010.

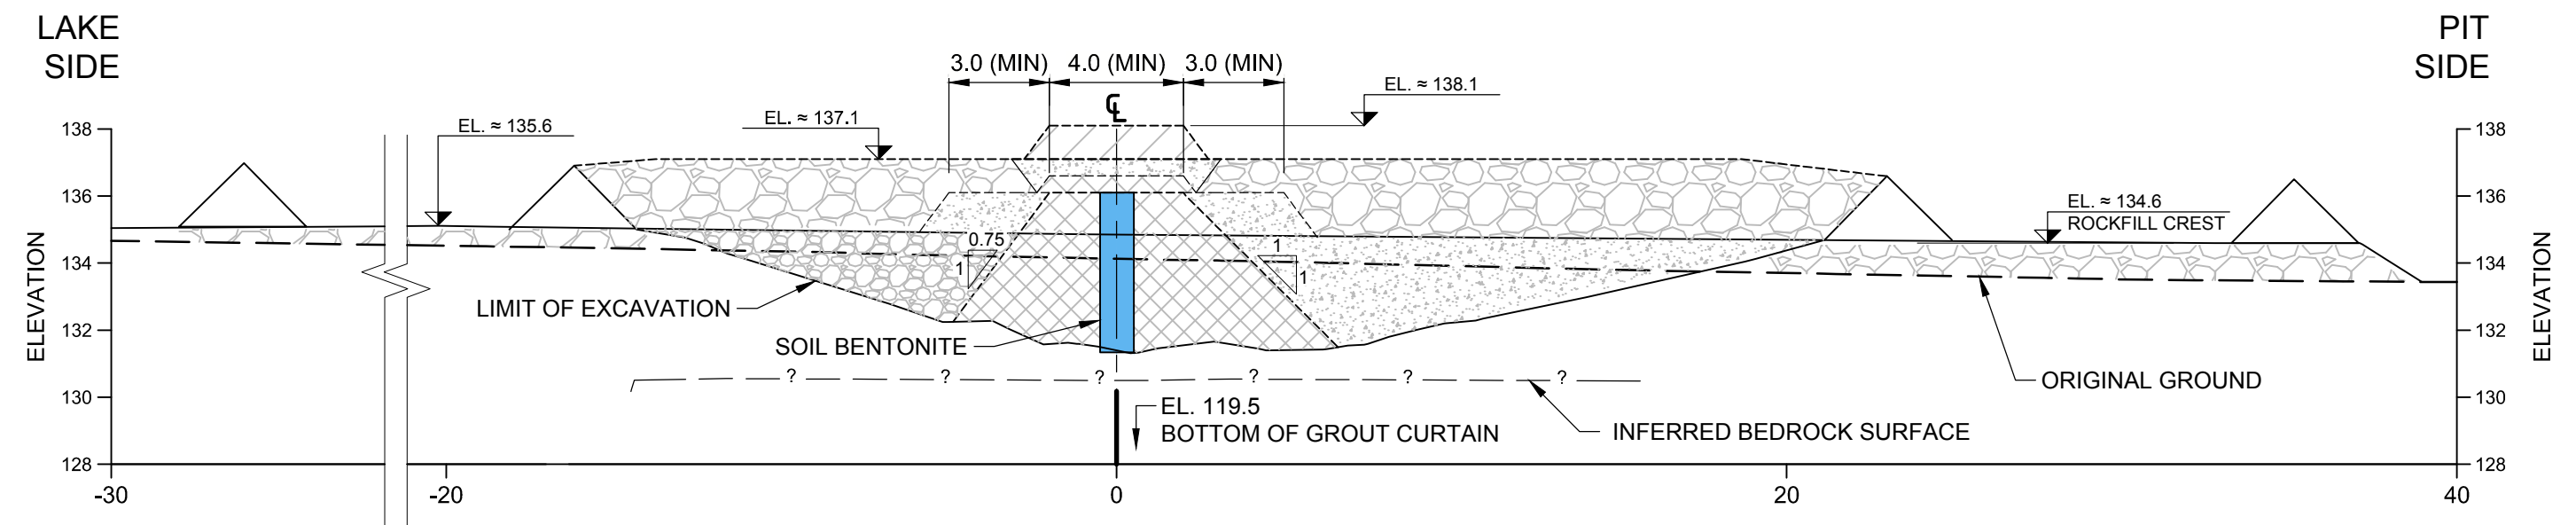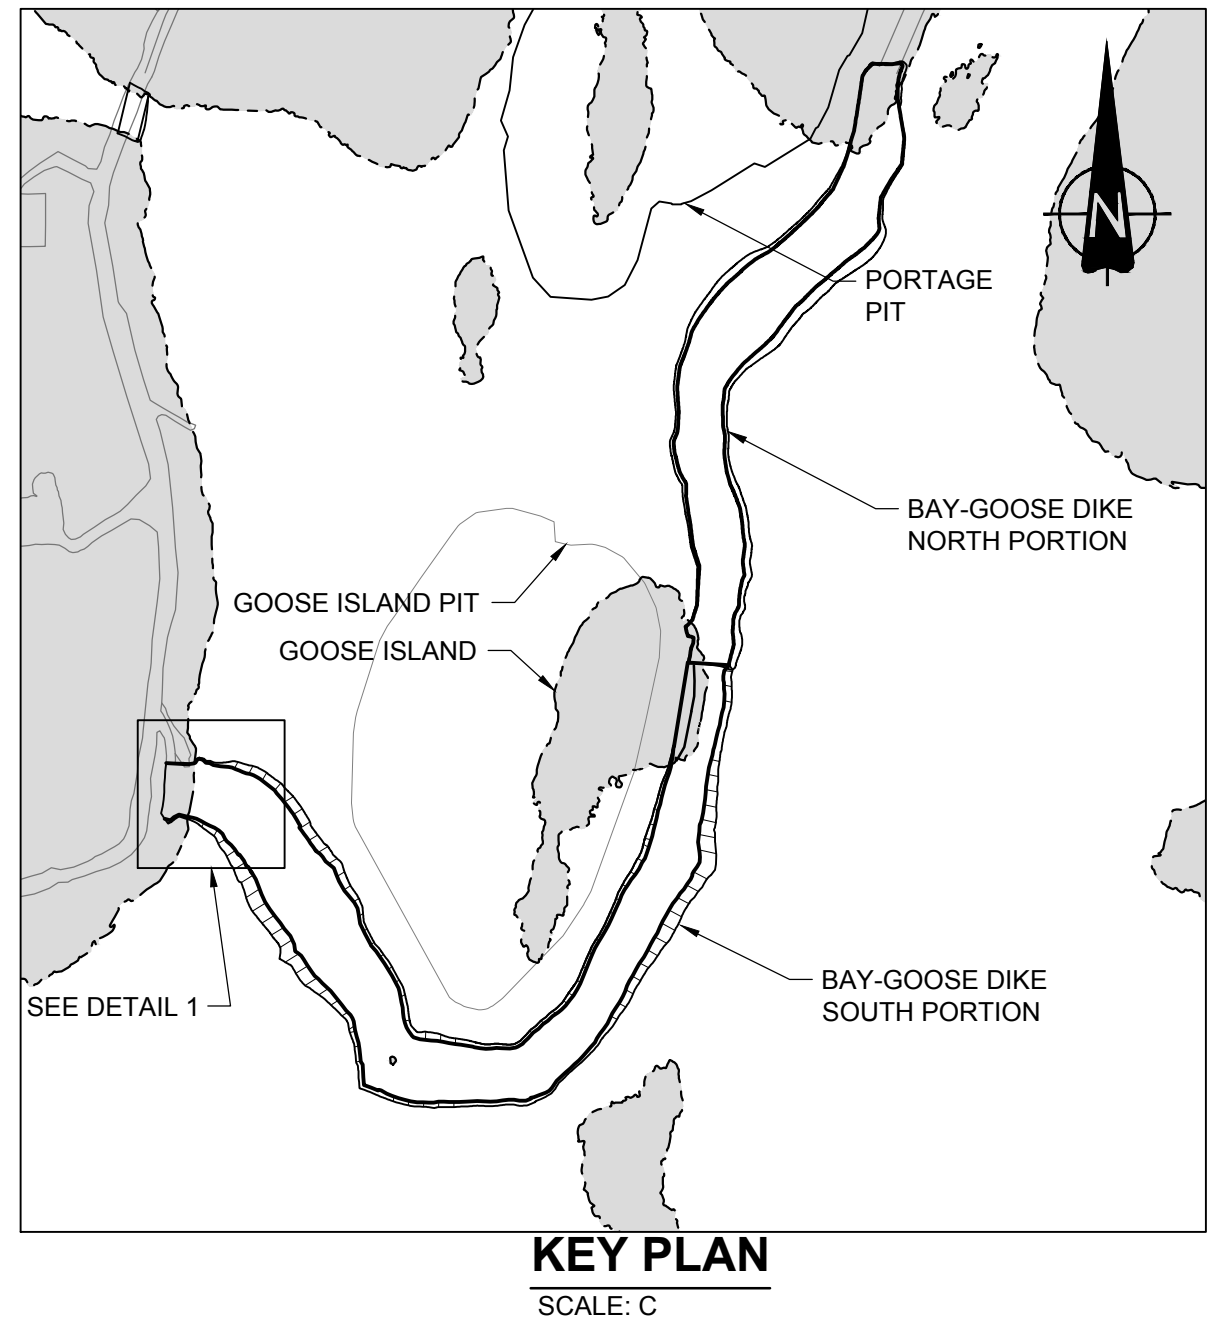


B-B' TYPICAL SOUTH ABUTMENT MATERIAL PLACEMENT SECTION
SCALE: A

REVISION DATE: 12/5/2012 4:57:45 PM By: TTK/LASSEN CADD FILE: N:\bur-graphics\Projects\2009\1428-5007\Drafting\4000\meadowbank - bay-goose (south) dike as-built\4300_1_23.dwg

DRAWING NO.	REFERENCES	REV	DATE	DES	REVISION DESCRIPTION	CADD	CHK	RVW	STAMP
		1	15DEC12	FE	AS-BUILT	EA	GRB	FE	
		2	06JUL10	KD	ISSUED FOR CONSTRUCTION	JK	FE	MRJ	
		3	18JUN10	KD	ISSUED FOR CLIENT REVIEW	JK	FE	MRJ	
		4	31MAY10	KD	ISSUED FOR CLIENT REVIEW	NS	FE	MRJ	

PROJECT		AGNICO-EAGLE MINES LIMITED MEADOWBANK GOLD PROJECT NUNAVUT	
TITLE		BAY-GOOSE DIKE SOUTH PORTION SOUTH ABUTMENT PLAN AND DETAILS	
PROJECT No.		09-1428-5007	FILE No.
DESIGN		KD	02MAY10
CADD		NS	21MAY10
CHECK		FE	31MAY10
REVIEW		MRJ	31MAY10
SCALE		AS SHOWN	REV. 1
4300-23			

REVISION DATE: 12/6/2012 9:17:40 AM By: TYKLASSEN CADD FILE: N:\bur-graphics\Projects\2009\1428-5007\Drafting\4000\meadowbank - bay-goose (south) dike as-built\4300_0_27.dwg

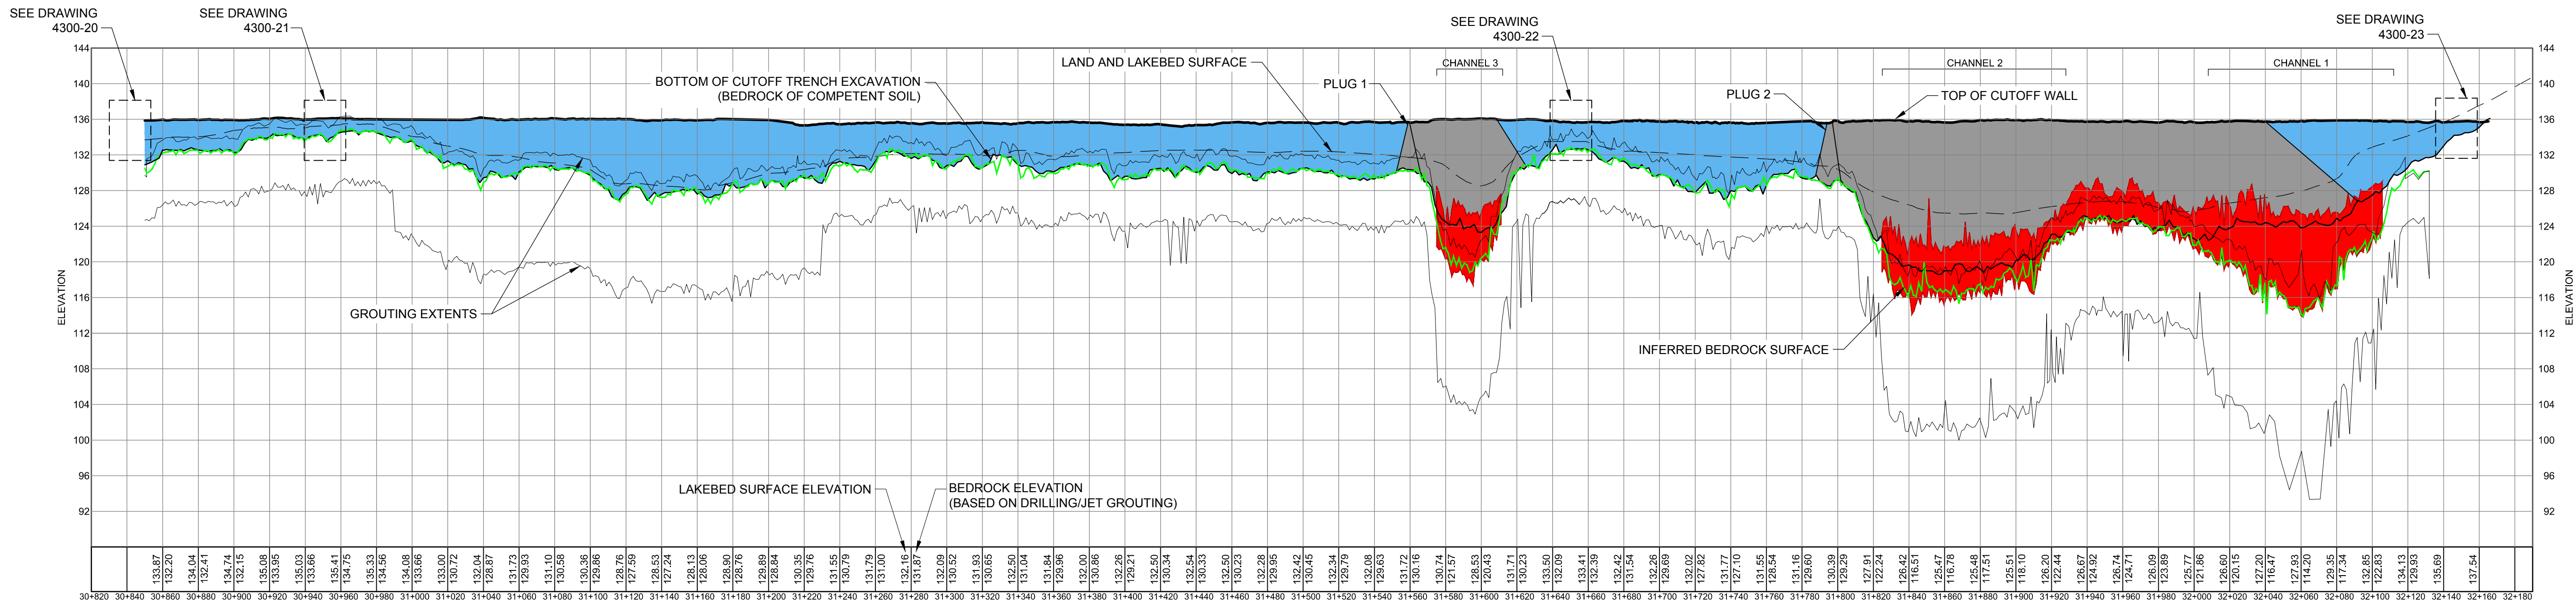

PROFILE OF CUTOFF WALL MATERIAL ZONES
VERTICAL EXAGGERATION 5X





- LEGEND**
- ZONE OF CEMENT-SOIL-BENTONITE (CSB) PLACEMENT
 - ZONE OF SOIL-BENTONITE (SB) PLACEMENT
 - JET GROUTING
 - BOTTOM OF CUTOFF TRENCH EXCAVATION (BEDROCK OR COMPETENT SOIL)
 - INFERRED BEDROCK (DRILLING/JET GROUTING)
 - GROUTING EXTENTS
 - LAND AND LAKEBED SURFACE

- NOTES**
- ALL ELEVATIONS ARE IN METRES ABOVE SEA LEVEL (MASL), UNLESS OTHERWISE NOTED.
 - ALL DIMENSIONS ARE IN METRES UNLESS OTHERWISE NOTED.
 - CONTOUR INFORMATION ON LAND SUPPLIED BY AEM.
 - LAKEBED SURFACE BASED ON BATHYMETRIC SURVEY BY GOLDER ASSOCIATES LTD., 2006 AND DETAILED (0.5m CONTOUR INTERVAL) 2008.
 - BEDROCK SURFACE INFERRED BASED ON DATA OBTAINED DURING JET GROUTING AND CASING INSTALLATION FOR GROUTING.
 - CUTOFF TRENCH EXCAVATED TO BEDROCK, EXCEPT IN CHANNEL 1, 2, AND 3 WHERE EXCAVATION STOPPED IN COMPETENT SOIL.


PROJECT		AGNICO-EAGLE MINES LIMITED MEADOWBANK GOLD PROJECT NUNAVUT	
TITLE		BAY-GOOSE DIKE SOUTH PORTION LOW PERMEABILITY SYSTEM	
DRAWING NO.		4300-27	
REFERENCES		PROJECT No. 09-1428-5007 DESIGN KD 02MAY10 CADD NS 10MAY10 CHECK FE 31MAY10 REVIEW MRJ 31MAY10	
REV		15DEC12 FE AS-BUILT DATE DES REVISION DESCRIPTION CADD CHK RVW	
STAMP		Golder Associates	

REVISION DATE: 12/6/2012 9:21:05 AM By: TJK/ASSEN CADD FILE: \\n:\bur-graphics\Projects\2009\1428-5007\Drafting\4000\meadowbank - bay-goose (south) dike as-built\4300_0_30.dwg

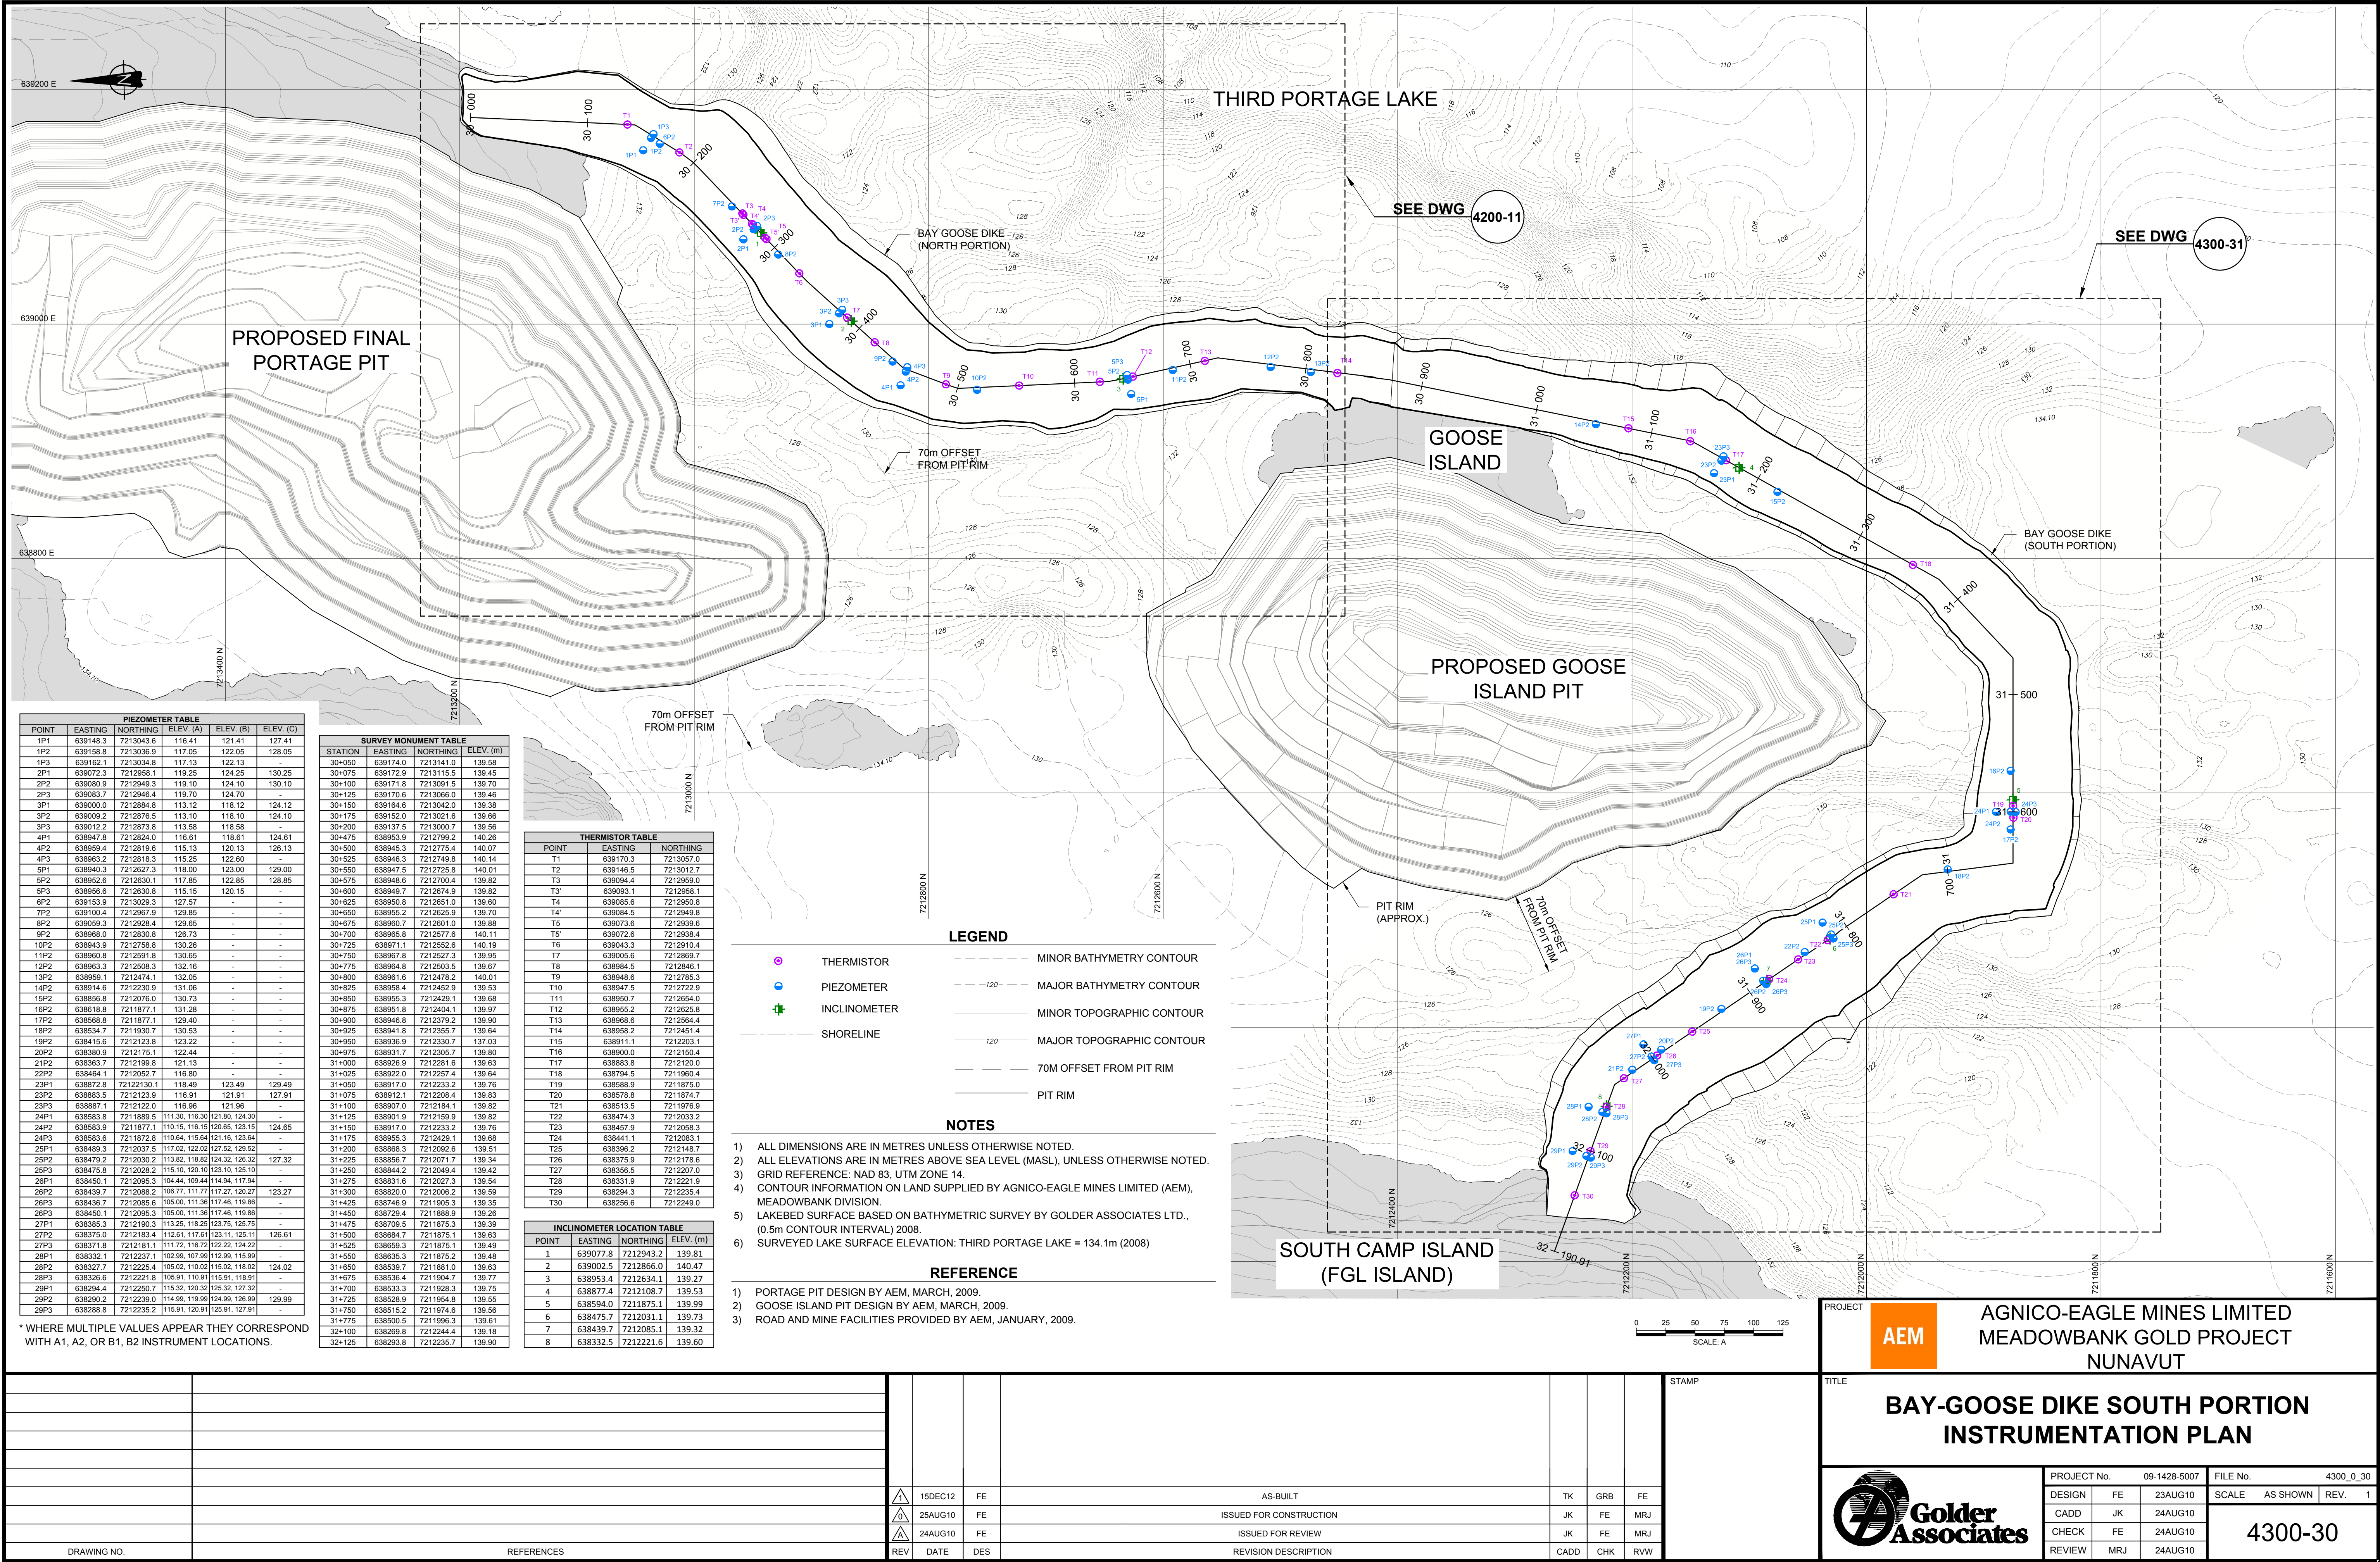


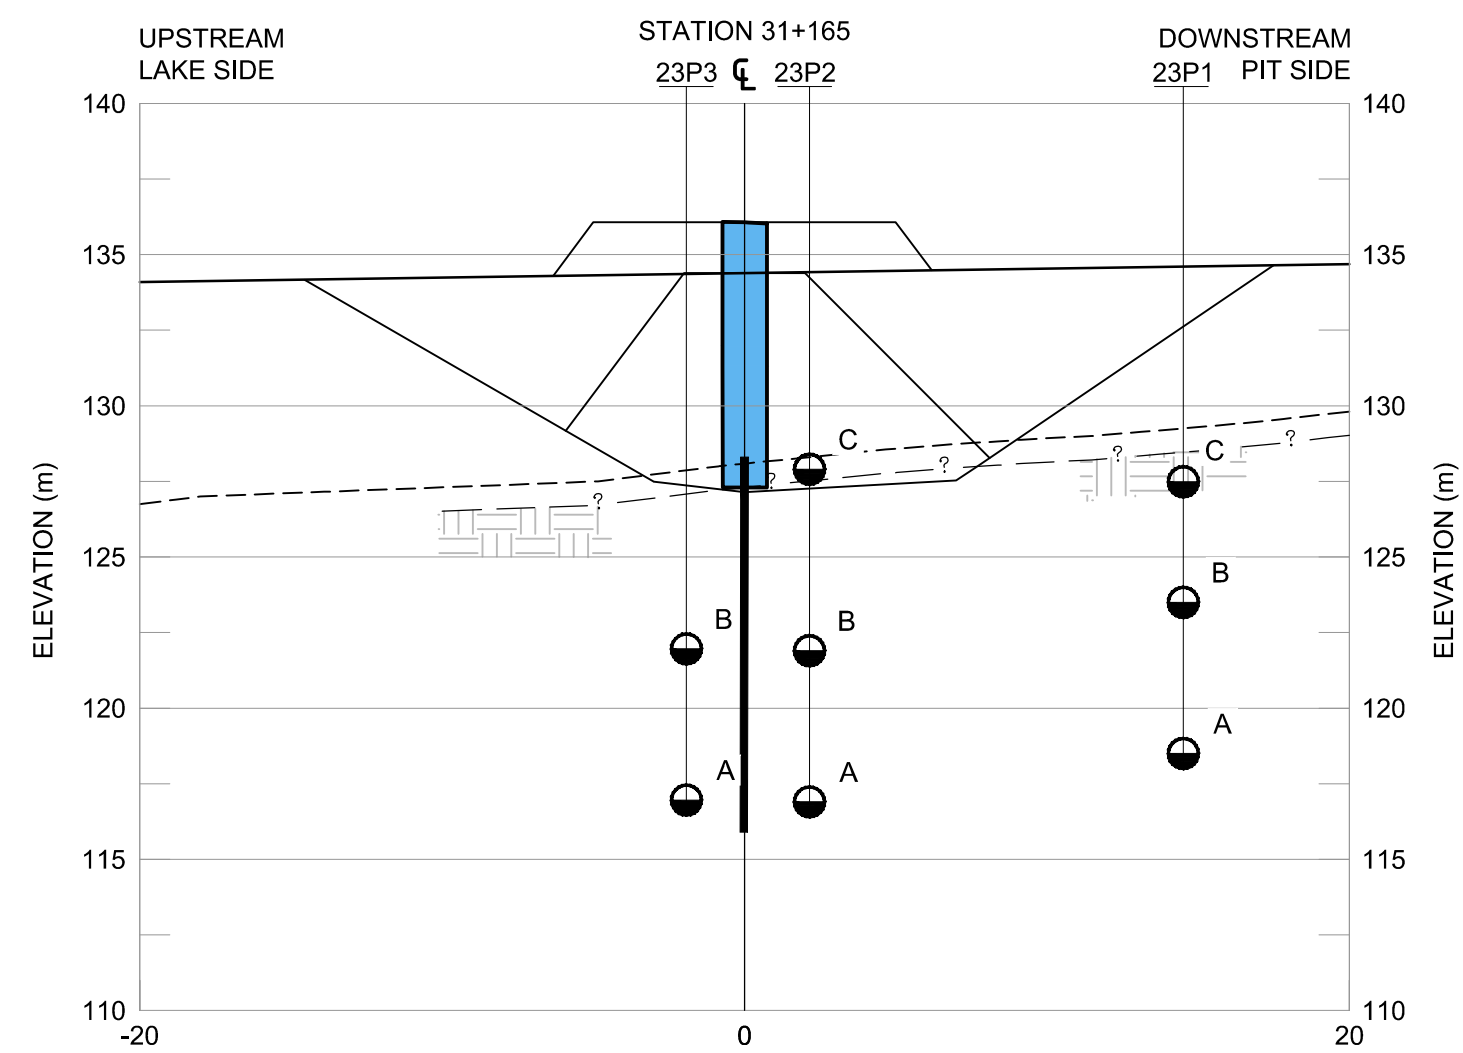


A INSTRUMENTATION SECTION
4300-31

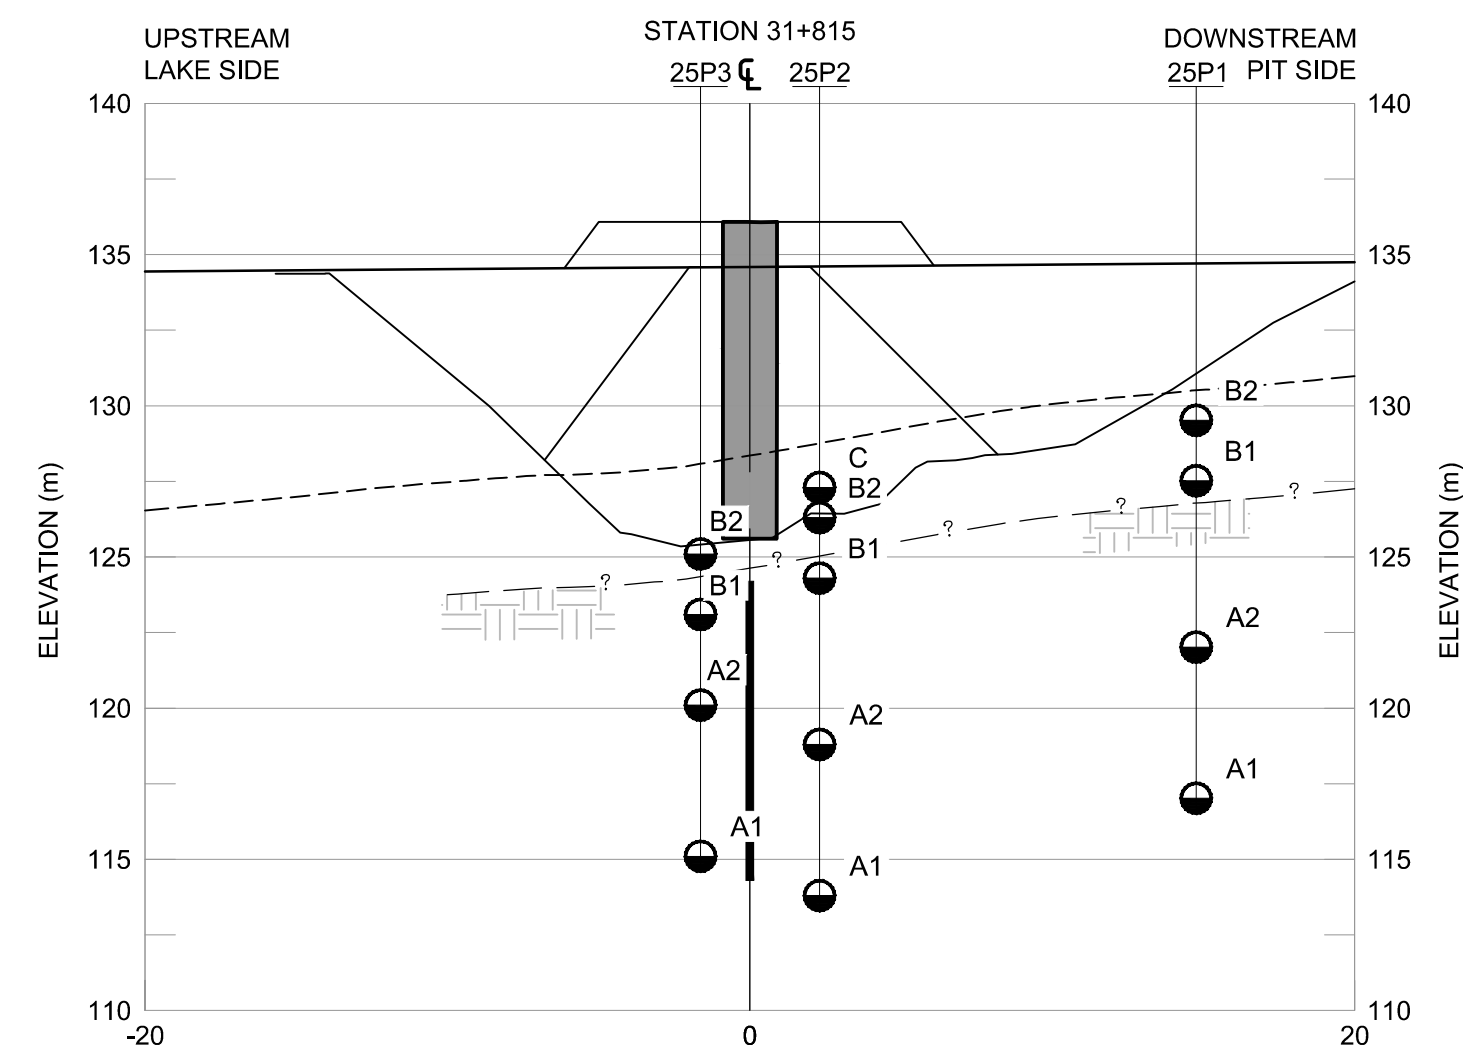


C INSTRUMENTATION SECTION
4300-31

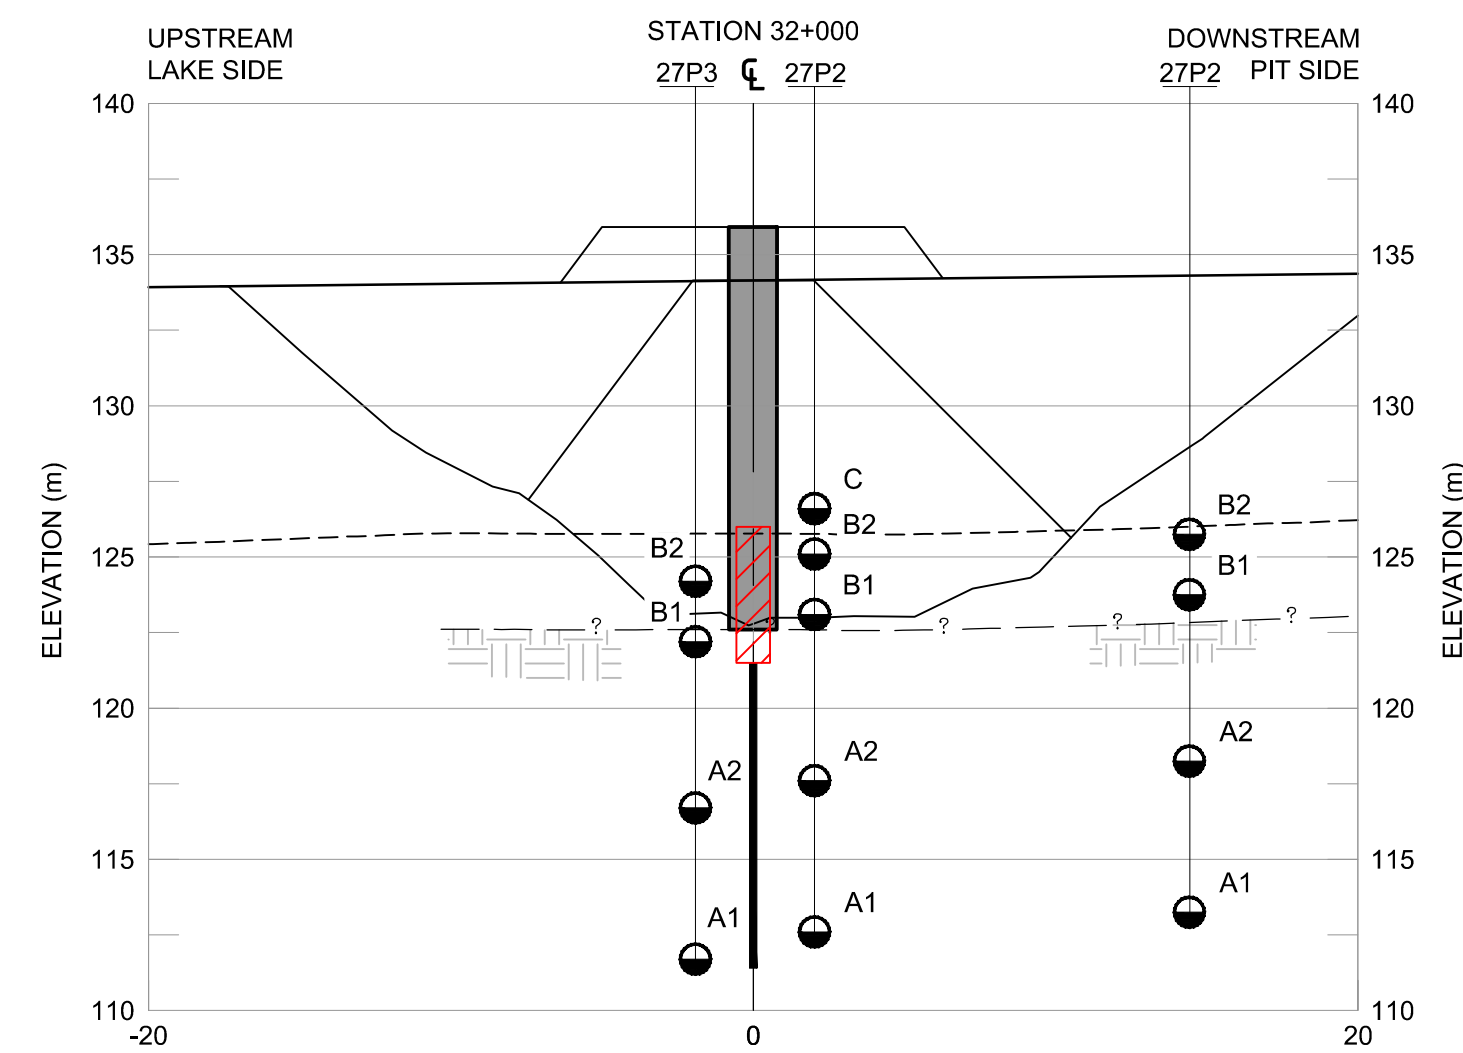


E INSTRUMENTATION SECTION
4300-31

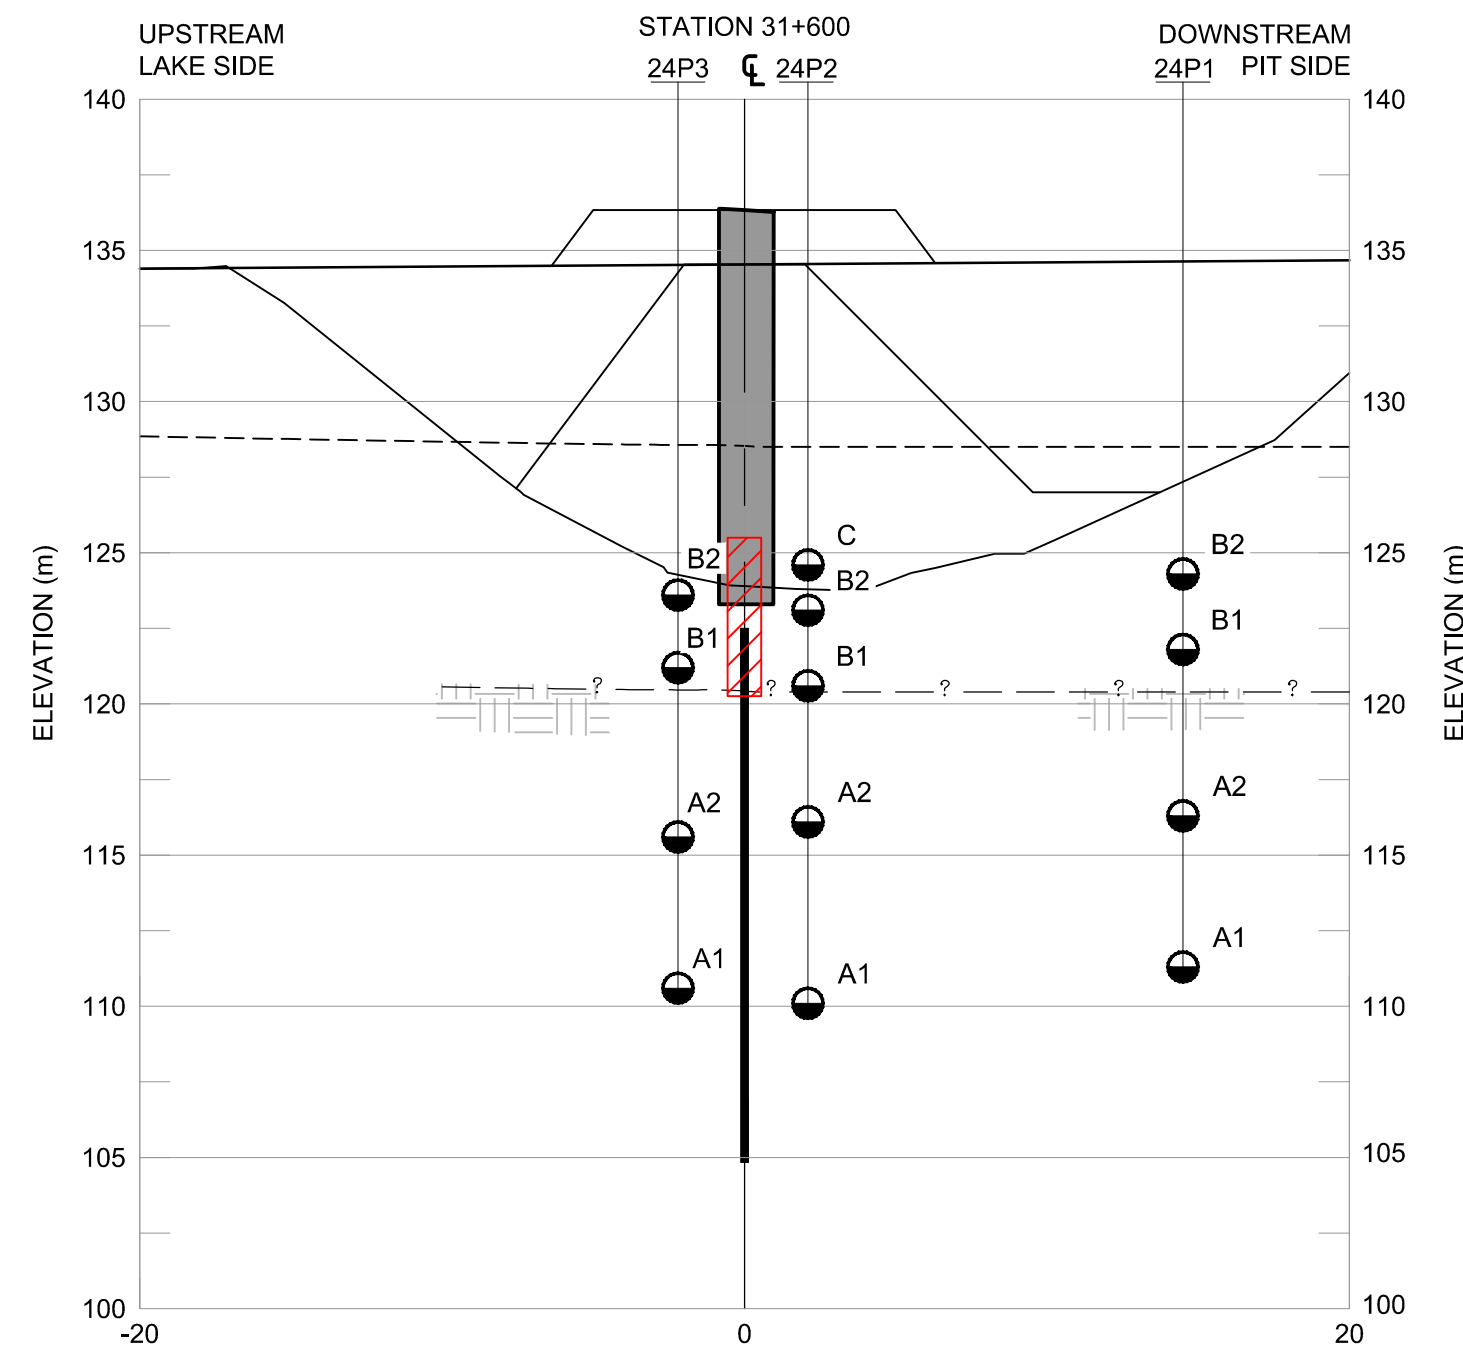


B INSTRUMENTATION SECTION
4300-31

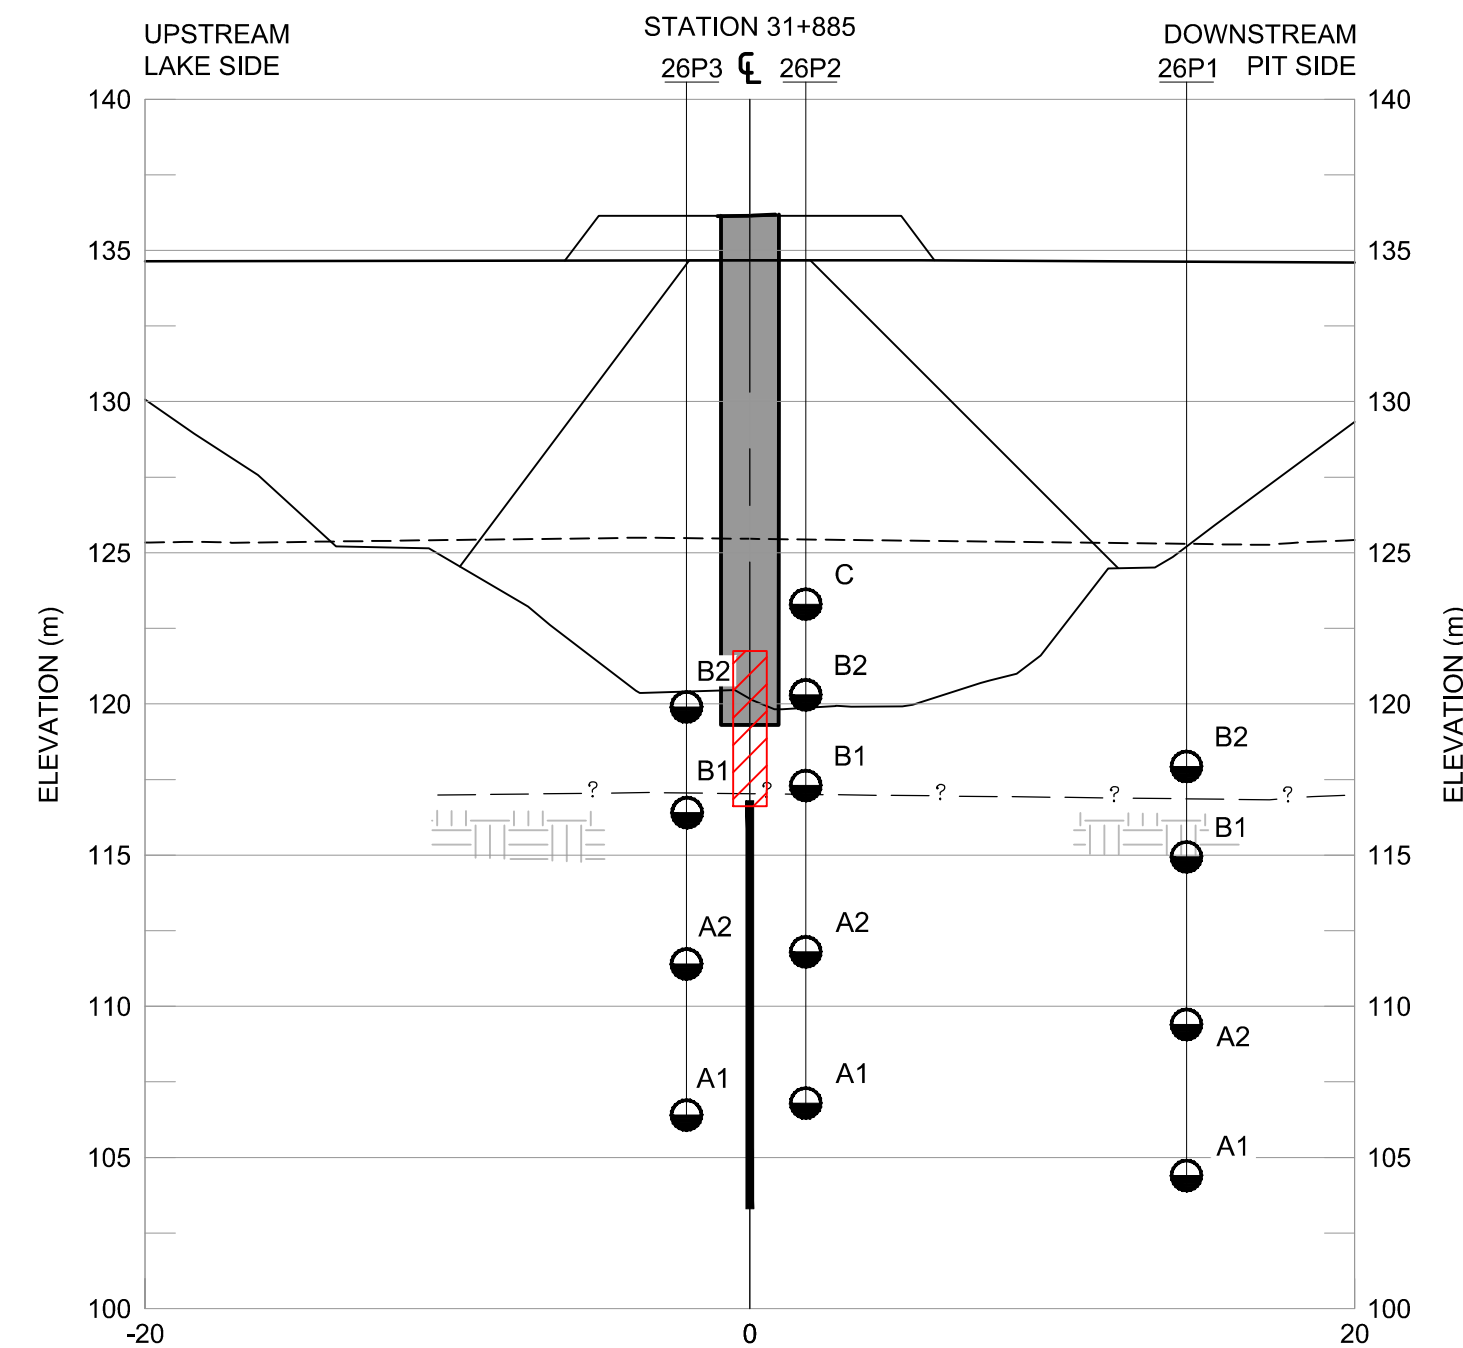


D INSTRUMENTATION SECTION
4300-31

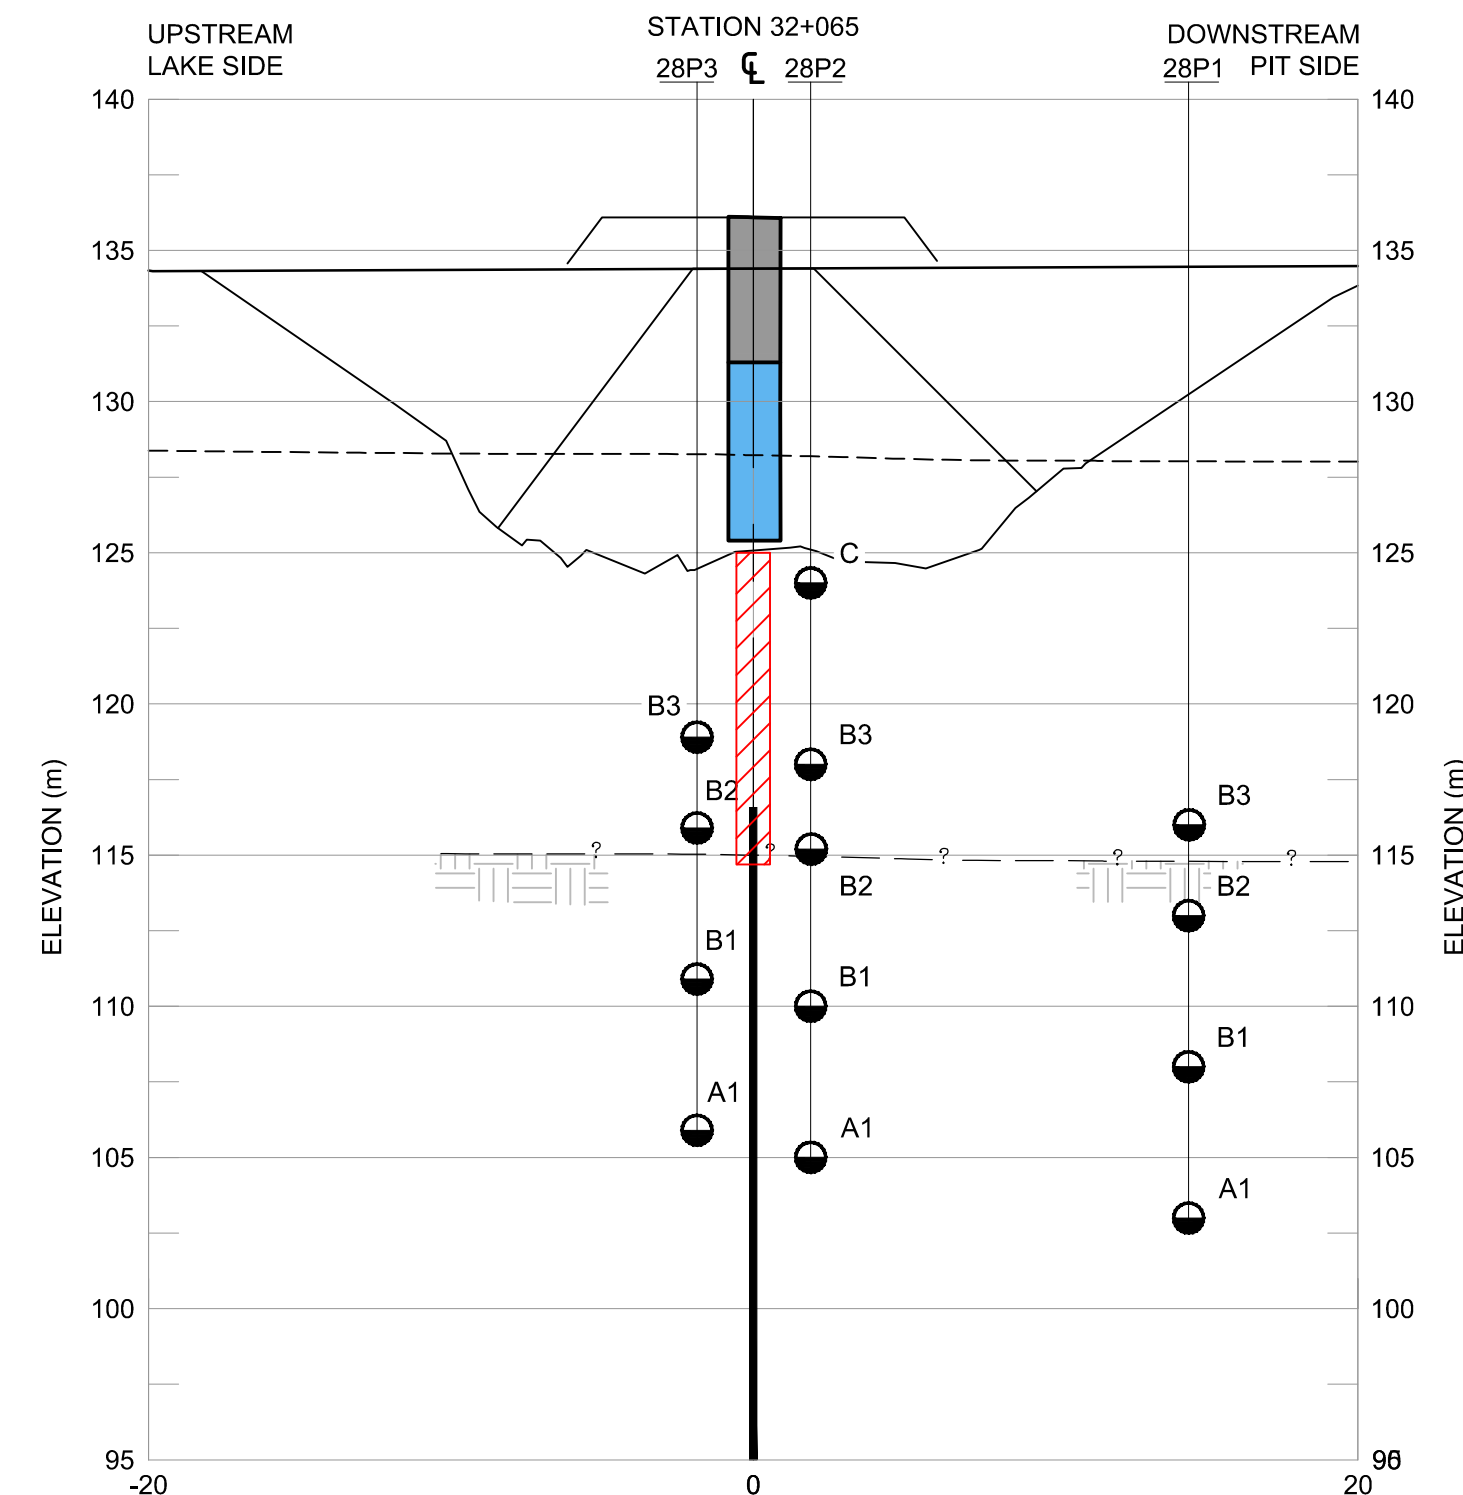

F INSTRUMENTATION SECTION
4300-31

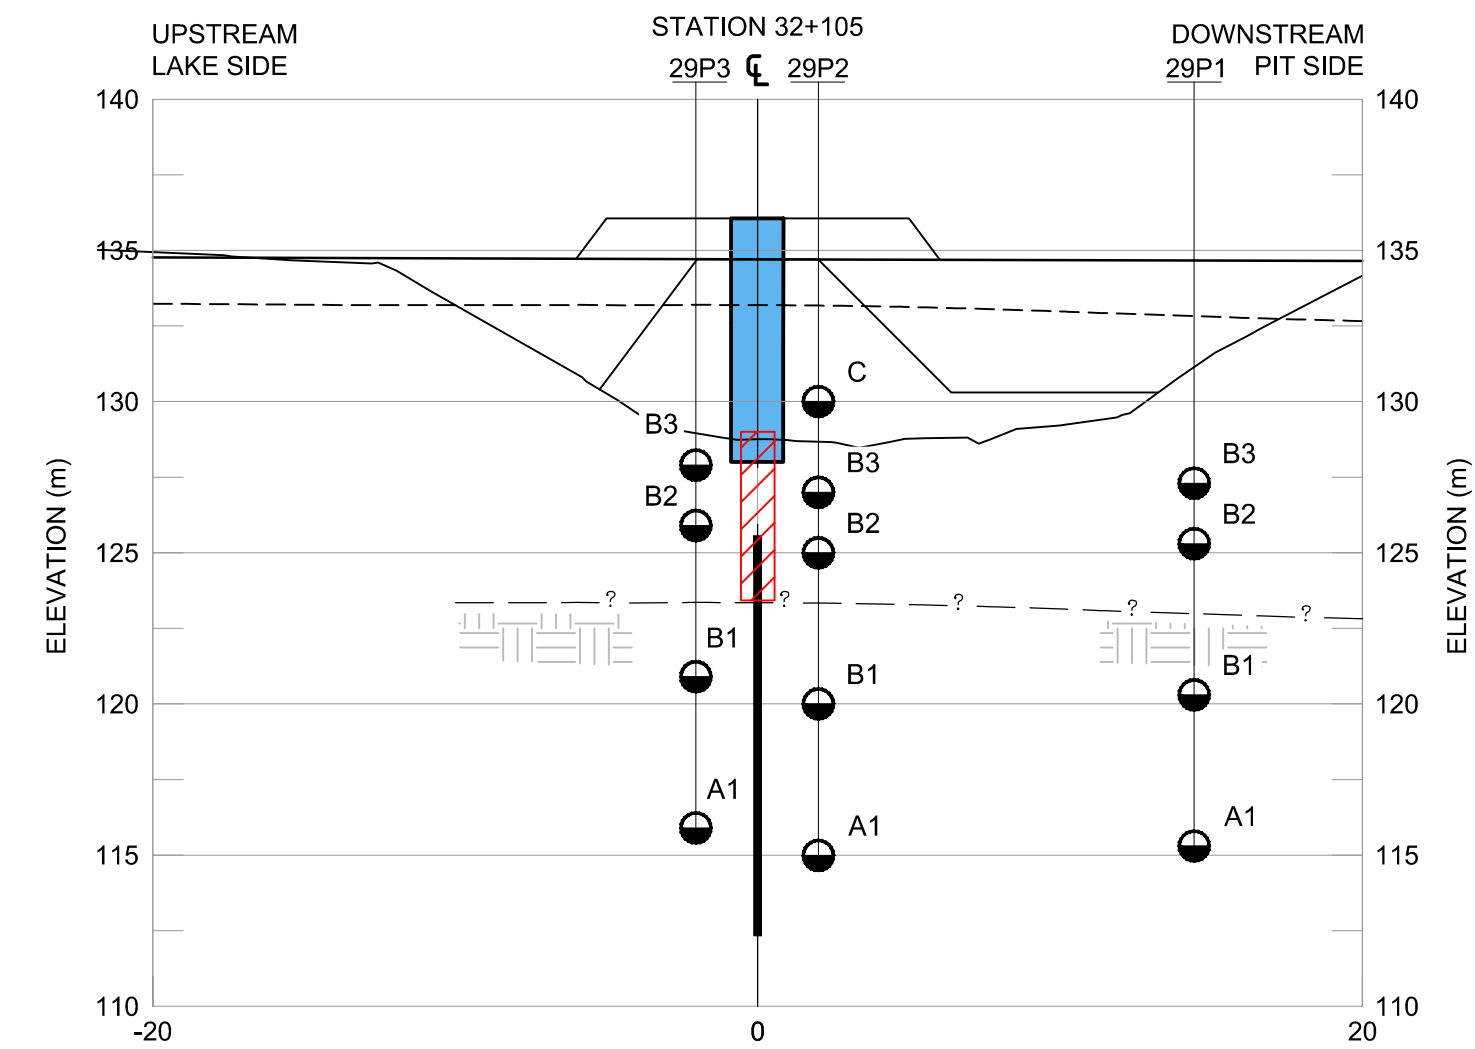


G INSTRUMENTATION SECTION
4300-31

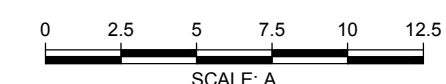[illegible]

PROJECT	AEM	AGNICO-EAGLE MINES LIMITED MEADOWBANK GOLD PROJECT NUNAVUT			
		TITLE			
BAY-GOOSE DIKE SOUTH PORTION INSTRUMENTATION SECTIONS					
Golder Associates	PROJECT No.		09-1428-5007	FILE No.	4300_0_3
	DESIGN	FE	23AUG10	SCALE	AS SHOWN
	CADD	JK	24AUG10	REV.	
	CHECK	FE	24AUG10	4300-32	
	REVIEW	MRJ	24AUG10		


REVISION DATE: 12/6/2012 9:29:41 AM By: TYKLASSEN
CADD FILE: N:\bur-graphics\Projects\2009\1428\09-1428-5007\Drafting\4000\meadowbank - boy-goose (south) dike as-built\4300_0_32.dwg

Drawing File: N:\bur-graphics\Projects\2009\1428\09-1428-5007\Drafting\4000\meadowbank - bay-goose (south) dike as-built\4300_0_42.dwg Layout:DENSIFICATION PLAN PHASE 1 AND PHASE 2 (1 OF 4) Friday, December 14, 2012 4:50:46 PM By: RHorlyck

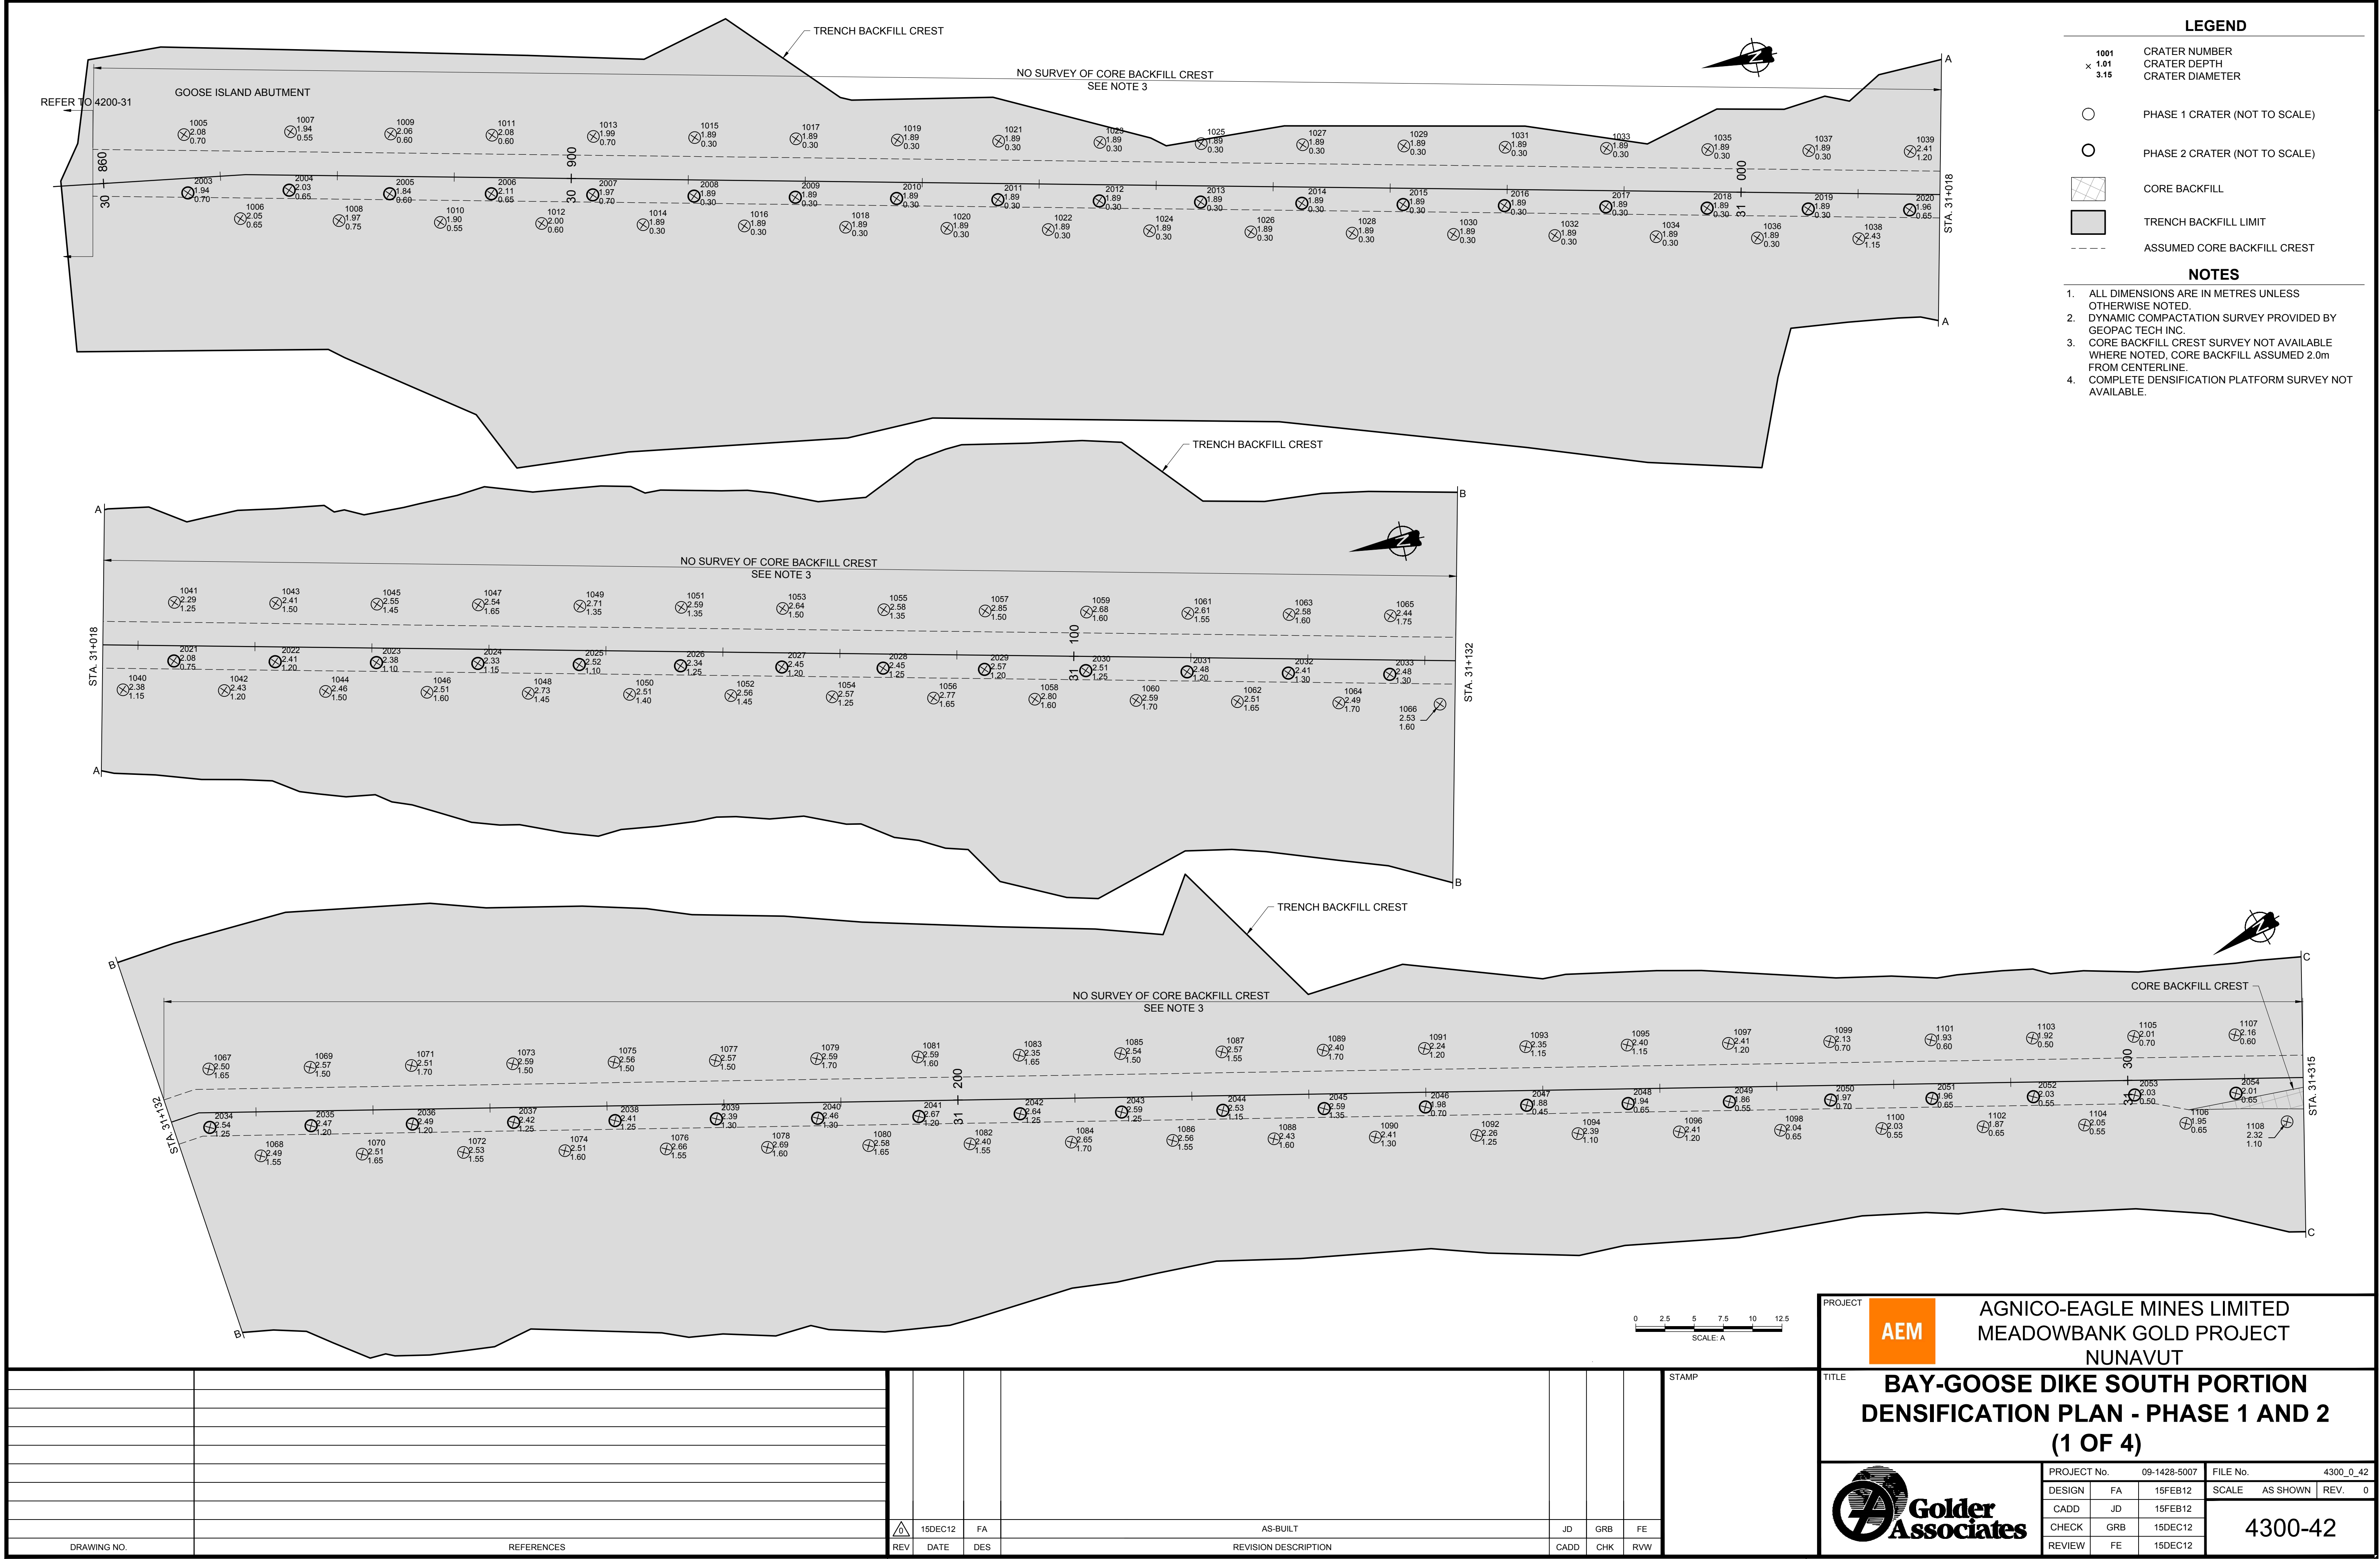

1001 $\times \frac{1.01}{3.15}$ CRATER NUMBER CRATER DEPTH CRATER DIAMETER
PHASE 1 CRATER (NOT TO SCALE)
PHASE 2 CRATER (NOT TO SCALE)
CORE BACKFILL
TRENCH BACKFILL LIMIT
ASSUMED CORE BACKFILL CREST

1. ALL DIMENSIONS ARE IN METRES UNLESS OTHERWISE NOTED.
2. DYNAMIC COMPACTION SURVEY PROVIDED BY GEOPAC TECH INC.
3. CORE BACKFILL CREST SURVEY NOT AVAILABLE WHERE NOTED, CORE BACKFILL ASSUMED 2.0m FROM CENTERLINE.
4. COMPLETE DENSIFICATION PLATFORM SURVEY NOT AVAILABLE.

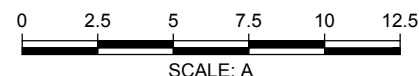


02.557.512.5 SCALE: A										PROJECT AEM AGNICO-EAGLE MINES LIMITED MEADOWBANK GOLD PROJECT NUNAVUT									
										TITLE BAY-GOOSE DIKE SOUTH PORTION DENSIFICATION PLAN - PHASE 1 AND 2 (2 OF 4)									
										Golder Associates					PROJECT No. 09-1428-5007		FILE No. 4300_0_43		
										DESIGN FA		15FEB12		SCALE AS SHOWN		REV. 0			
										CADD JD		15FEB12		4300-43					
										CHECK GRB		15DEC12							
										REVIEW FE		15DEC12							
DRAWING NO.										REFERENCES									



The image displays three plan views of a trench and its backfill crest, showing stationing, elevations, and survey notes.

Top Left View: Shows a trench section with stationing from STA 31+634.5 to STA 31+721. The trench backfill crest is indicated by a dashed line. A north arrow is present. The text "NO SURVEY OF CORE BACKFILL CREST SEE NOTE 3" is visible. Elevation data points are provided for various locations along the crest and within the trench.

Top Right View: Shows a continuation of the trench section, with stationing from STA 31+721 to STA 31+721. The trench backfill crest is indicated by a dashed line. The text "NO SURVEY OF CORE BACKFILL CREST SEE NOTE 3" is visible. Elevation data points are provided for various locations along the crest and within the trench.

Bottom View: Shows a trench section with stationing from STA 31+792.5 to STA 31+792.5. The trench backfill crest is indicated by a dashed line. The text "NO SURVEY OF CORE BACKFILL CREST SEE NOTE 3" is visible. Elevation data points are provided for various locations along the crest and within the trench.

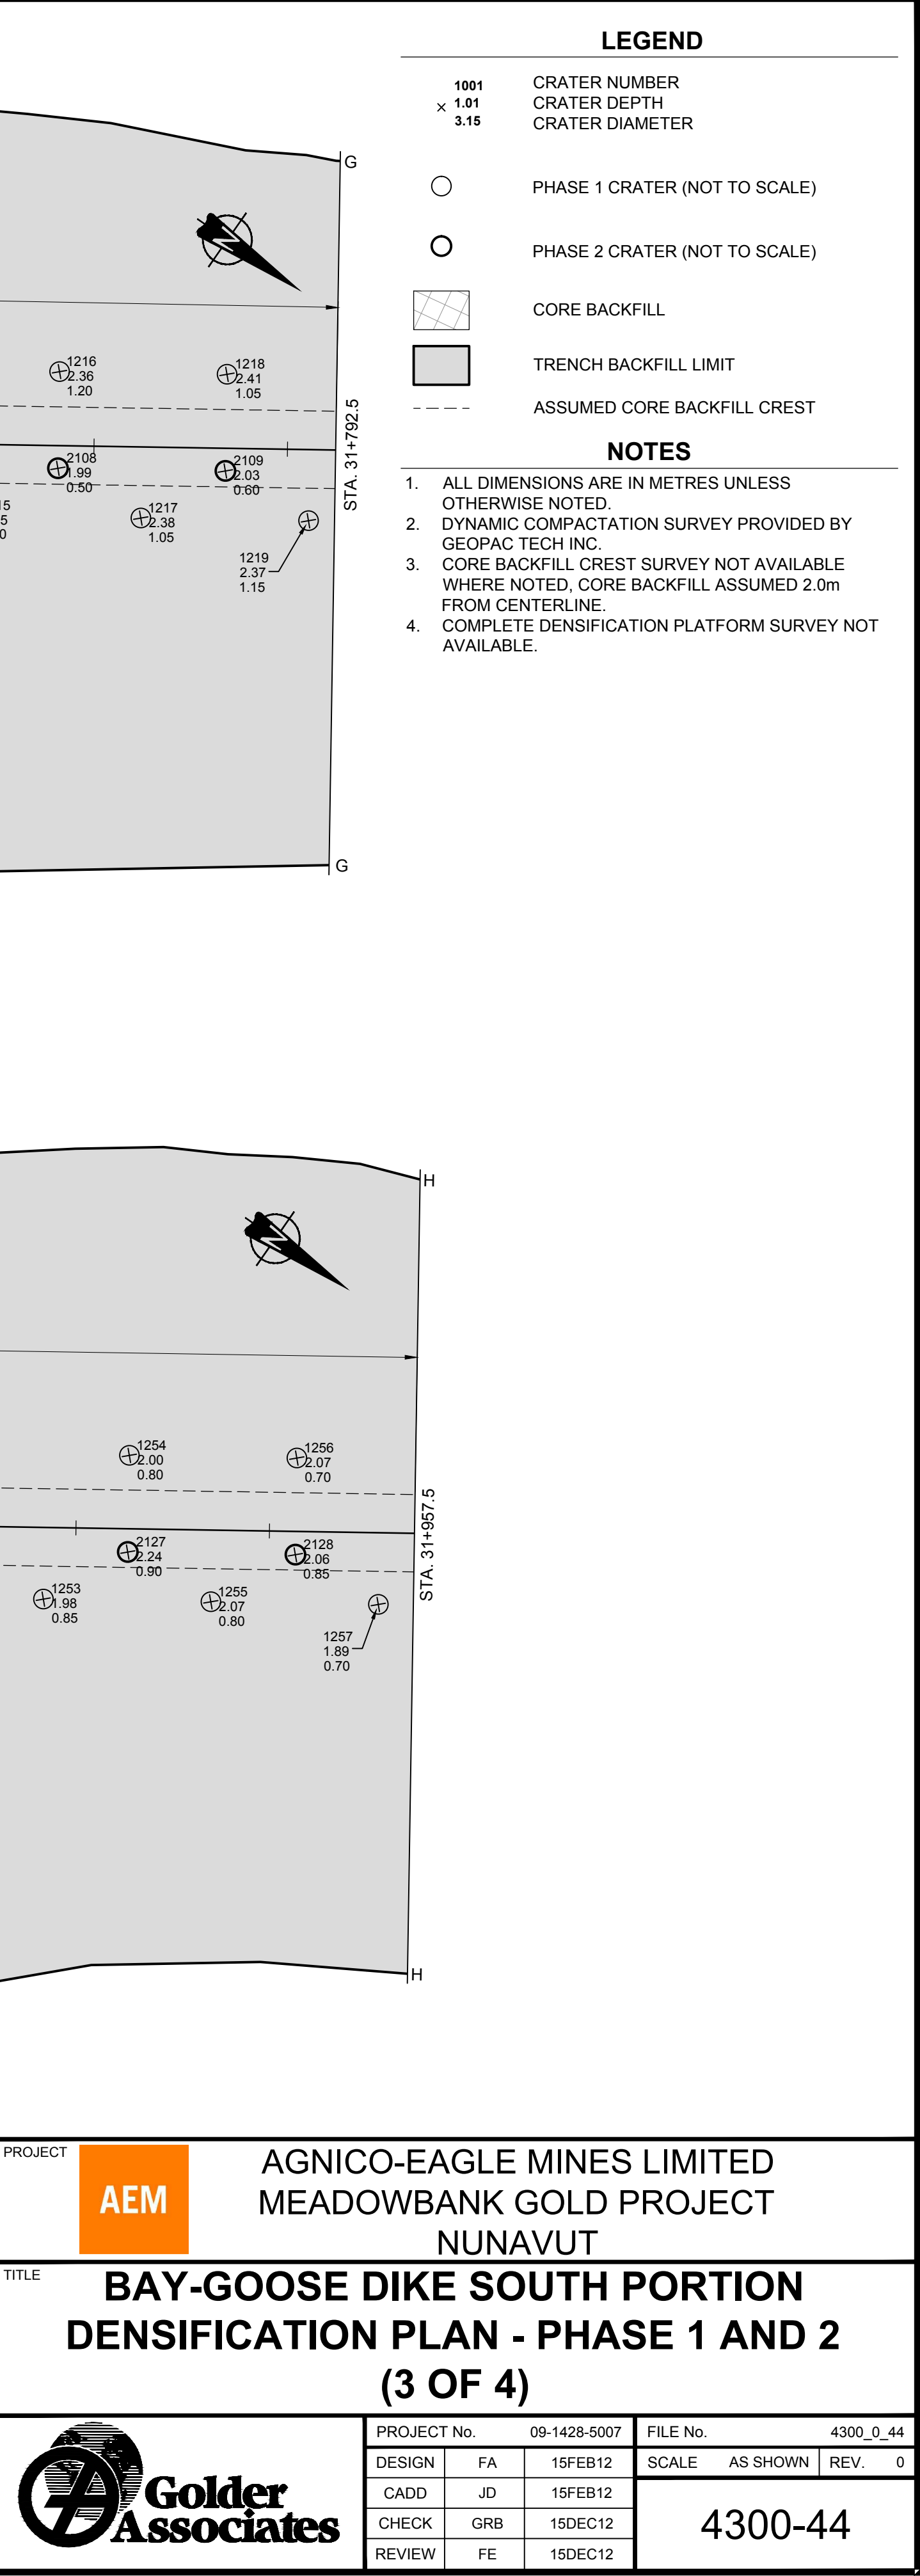

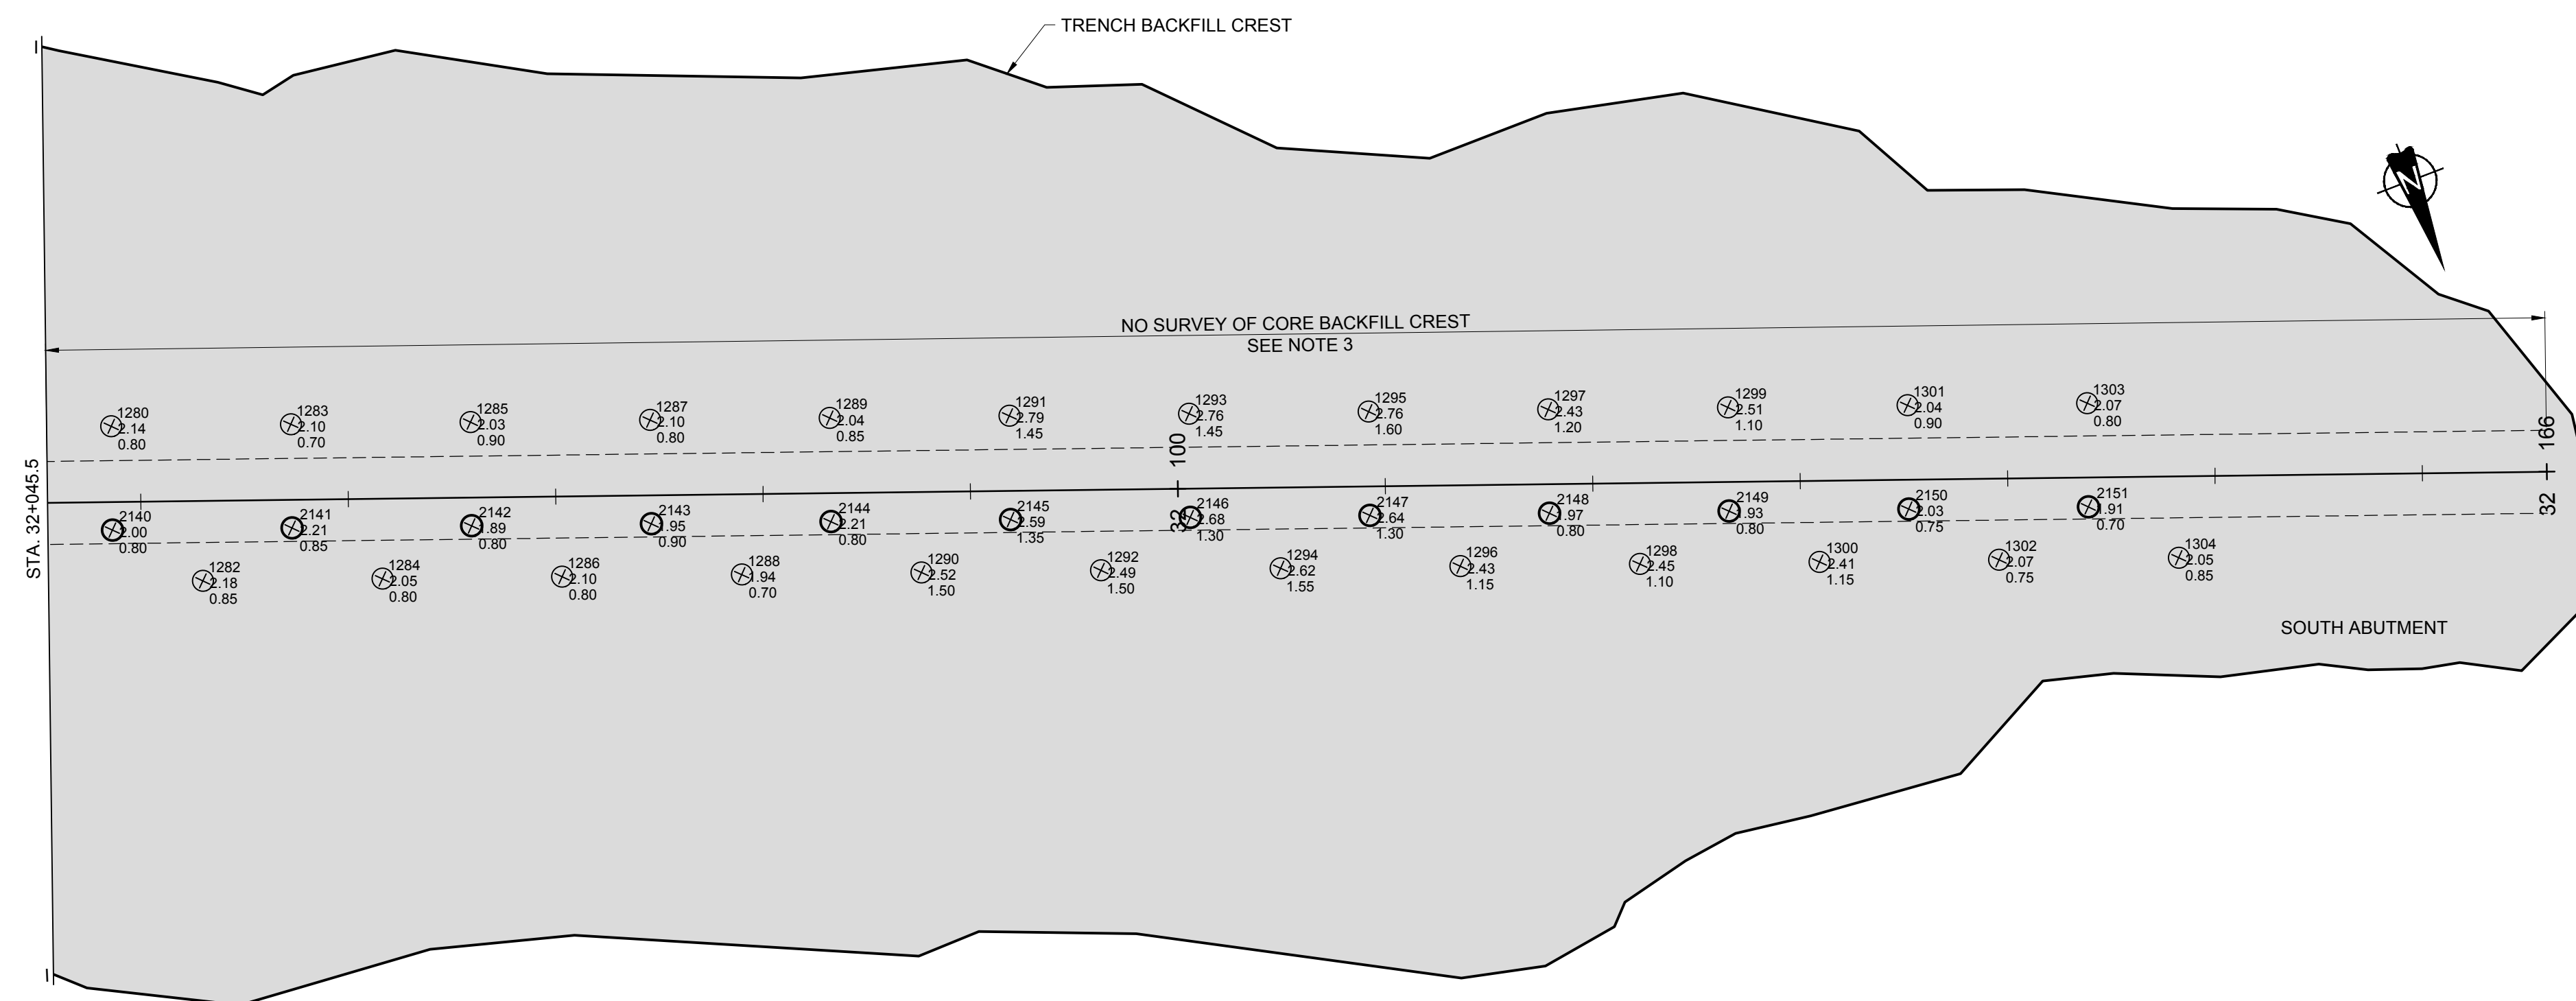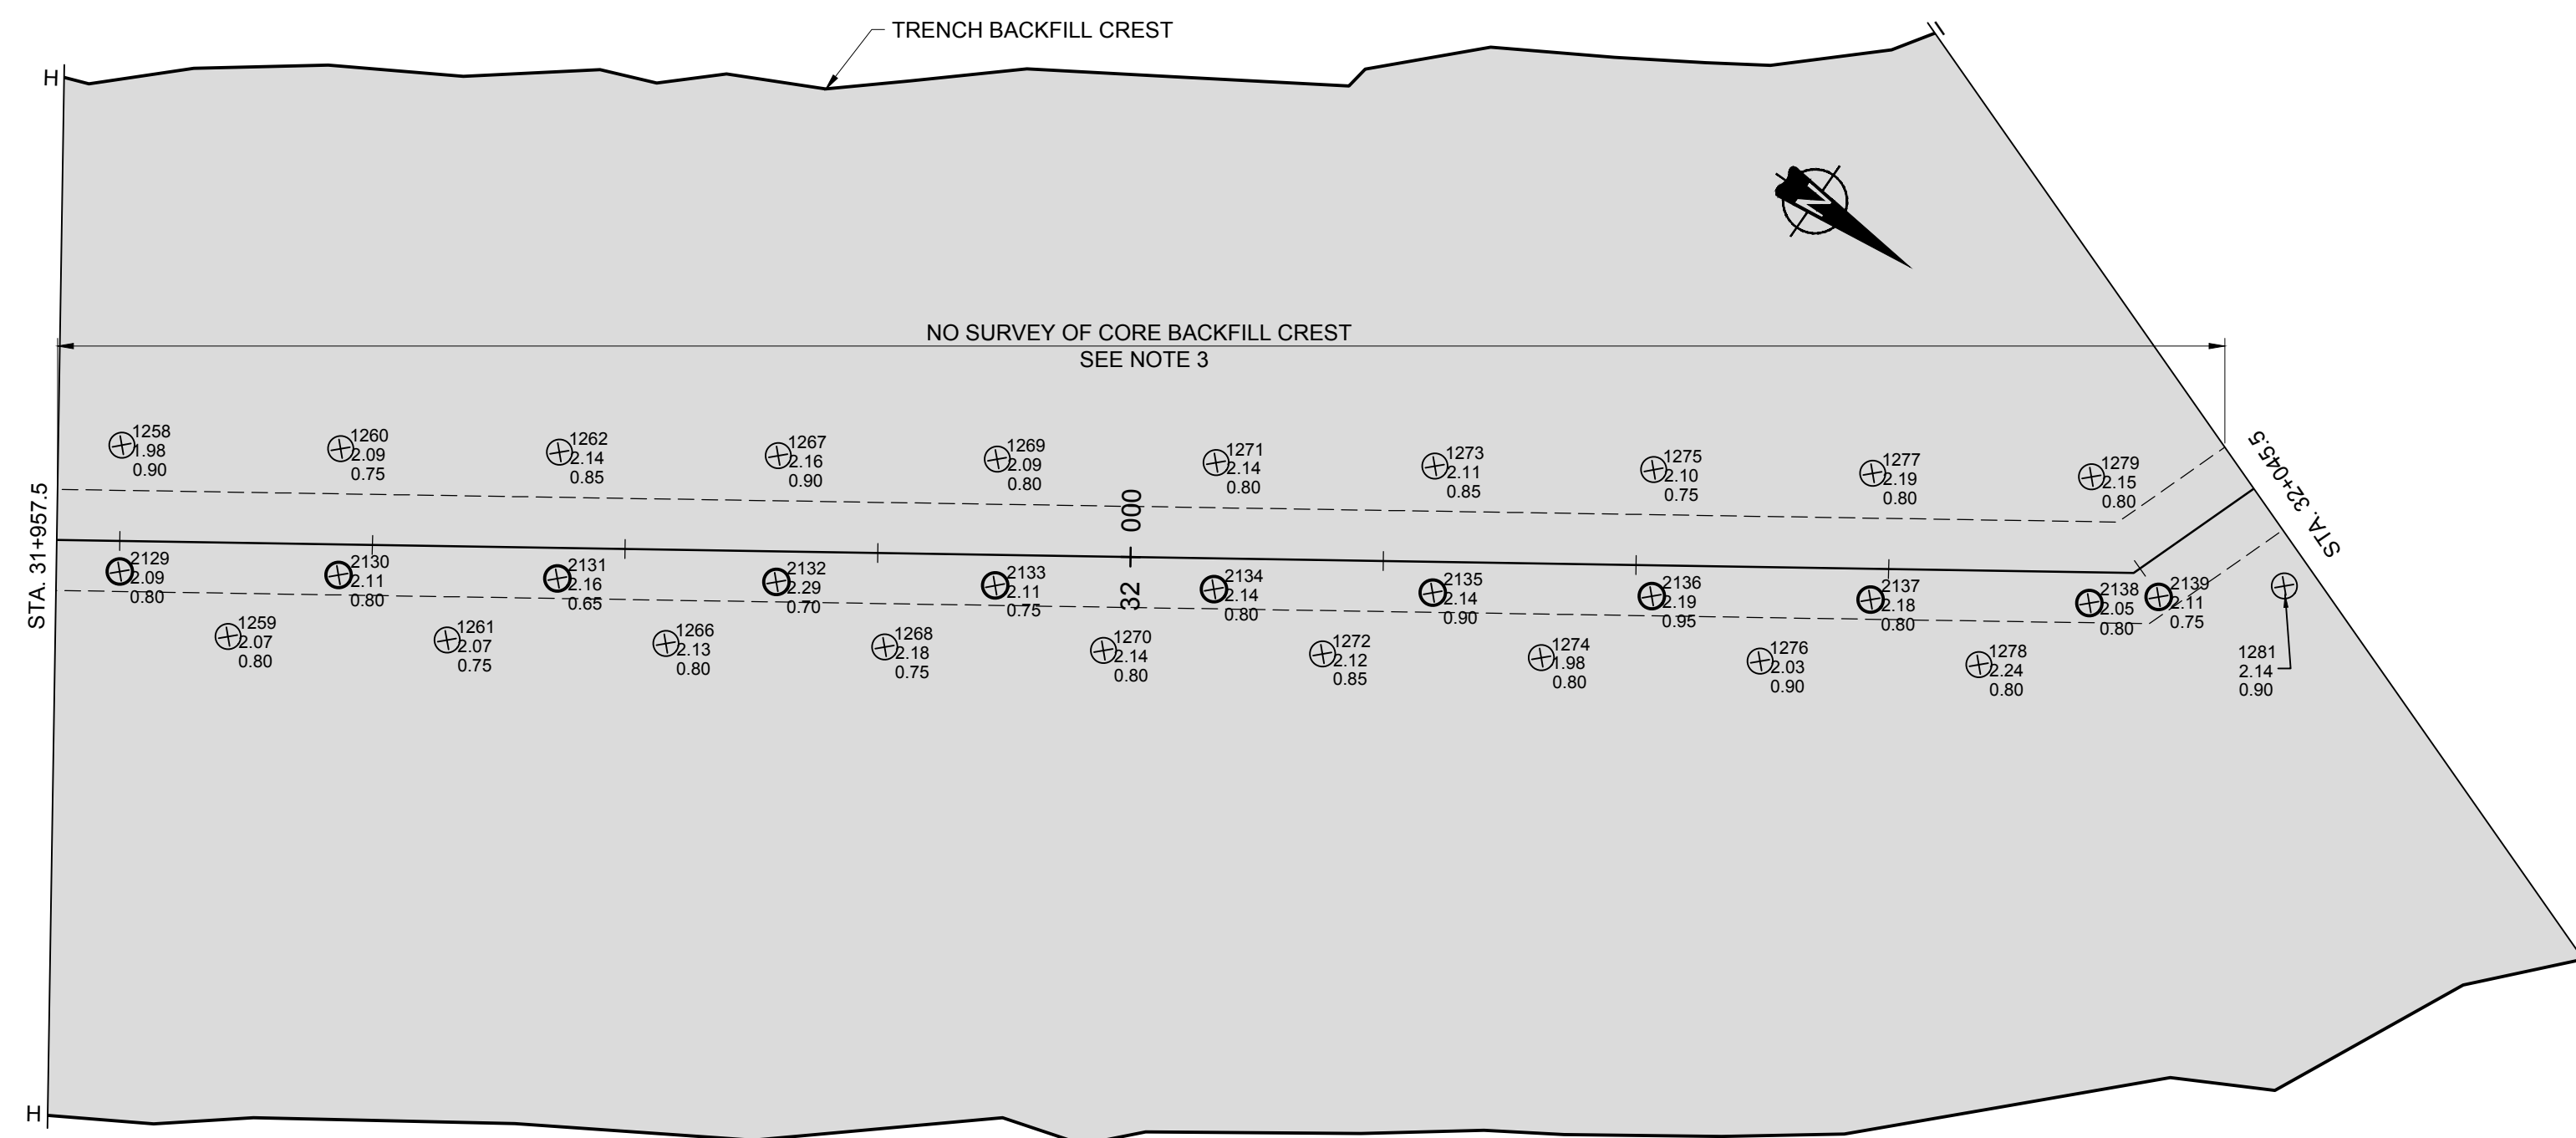

LEGEND	
1001	CRATER NUMBER
x 1.01	CRATER DEPTH
3.15	CRATER DIAMETER
	PHASE 1 CRATER (NOT TO SCALE)
	PHASE 2 CRATER (NOT TO SCALE)
	CORE BACKFILL
	TRENCH BACKFILL LIMIT
- - - -	ASSUMED CORE BACKFILL CREST
NOTES	

1. ALL DIMENSIONS ARE IN METRES UNLESS OTHERWISE NOTED.
2. DYNAMIC COMPACTION SURVEY PROVIDED BY GEOPAC TECH INC.
3. CORE BACKFILL CREST SURVEY NOT AVAILABLE WHERE NOTED, CORE BACKFILL ASSUMED 2.0m FROM CENTERLINE.
4. COMPLETE DENSIFICATION PLATFORM SURVEY NOT AVAILABLE.

[illegible]

PROJECT

AEM

AGNICO-EAGLE MINES LIMITED
MEADOWBANK GOLD PROJECT
NUNAVUT

TITLE


BAY-GOOSE DIKE SOUTH PORTION
DENSIFICATION PLAN - PHASE 1 AND 2
(4 OF 4)





Golder





Associates




PROJECT No.	09-1428-5007	FILE No.	4300_0_45
DESIGN	FA	15FEB12	SCALE AS SHOWN REV. 0
CADD	JD	15FEB12	4300-45
CHECK	GRB	15DEC12	
REVIEW	FE	15DEC12	

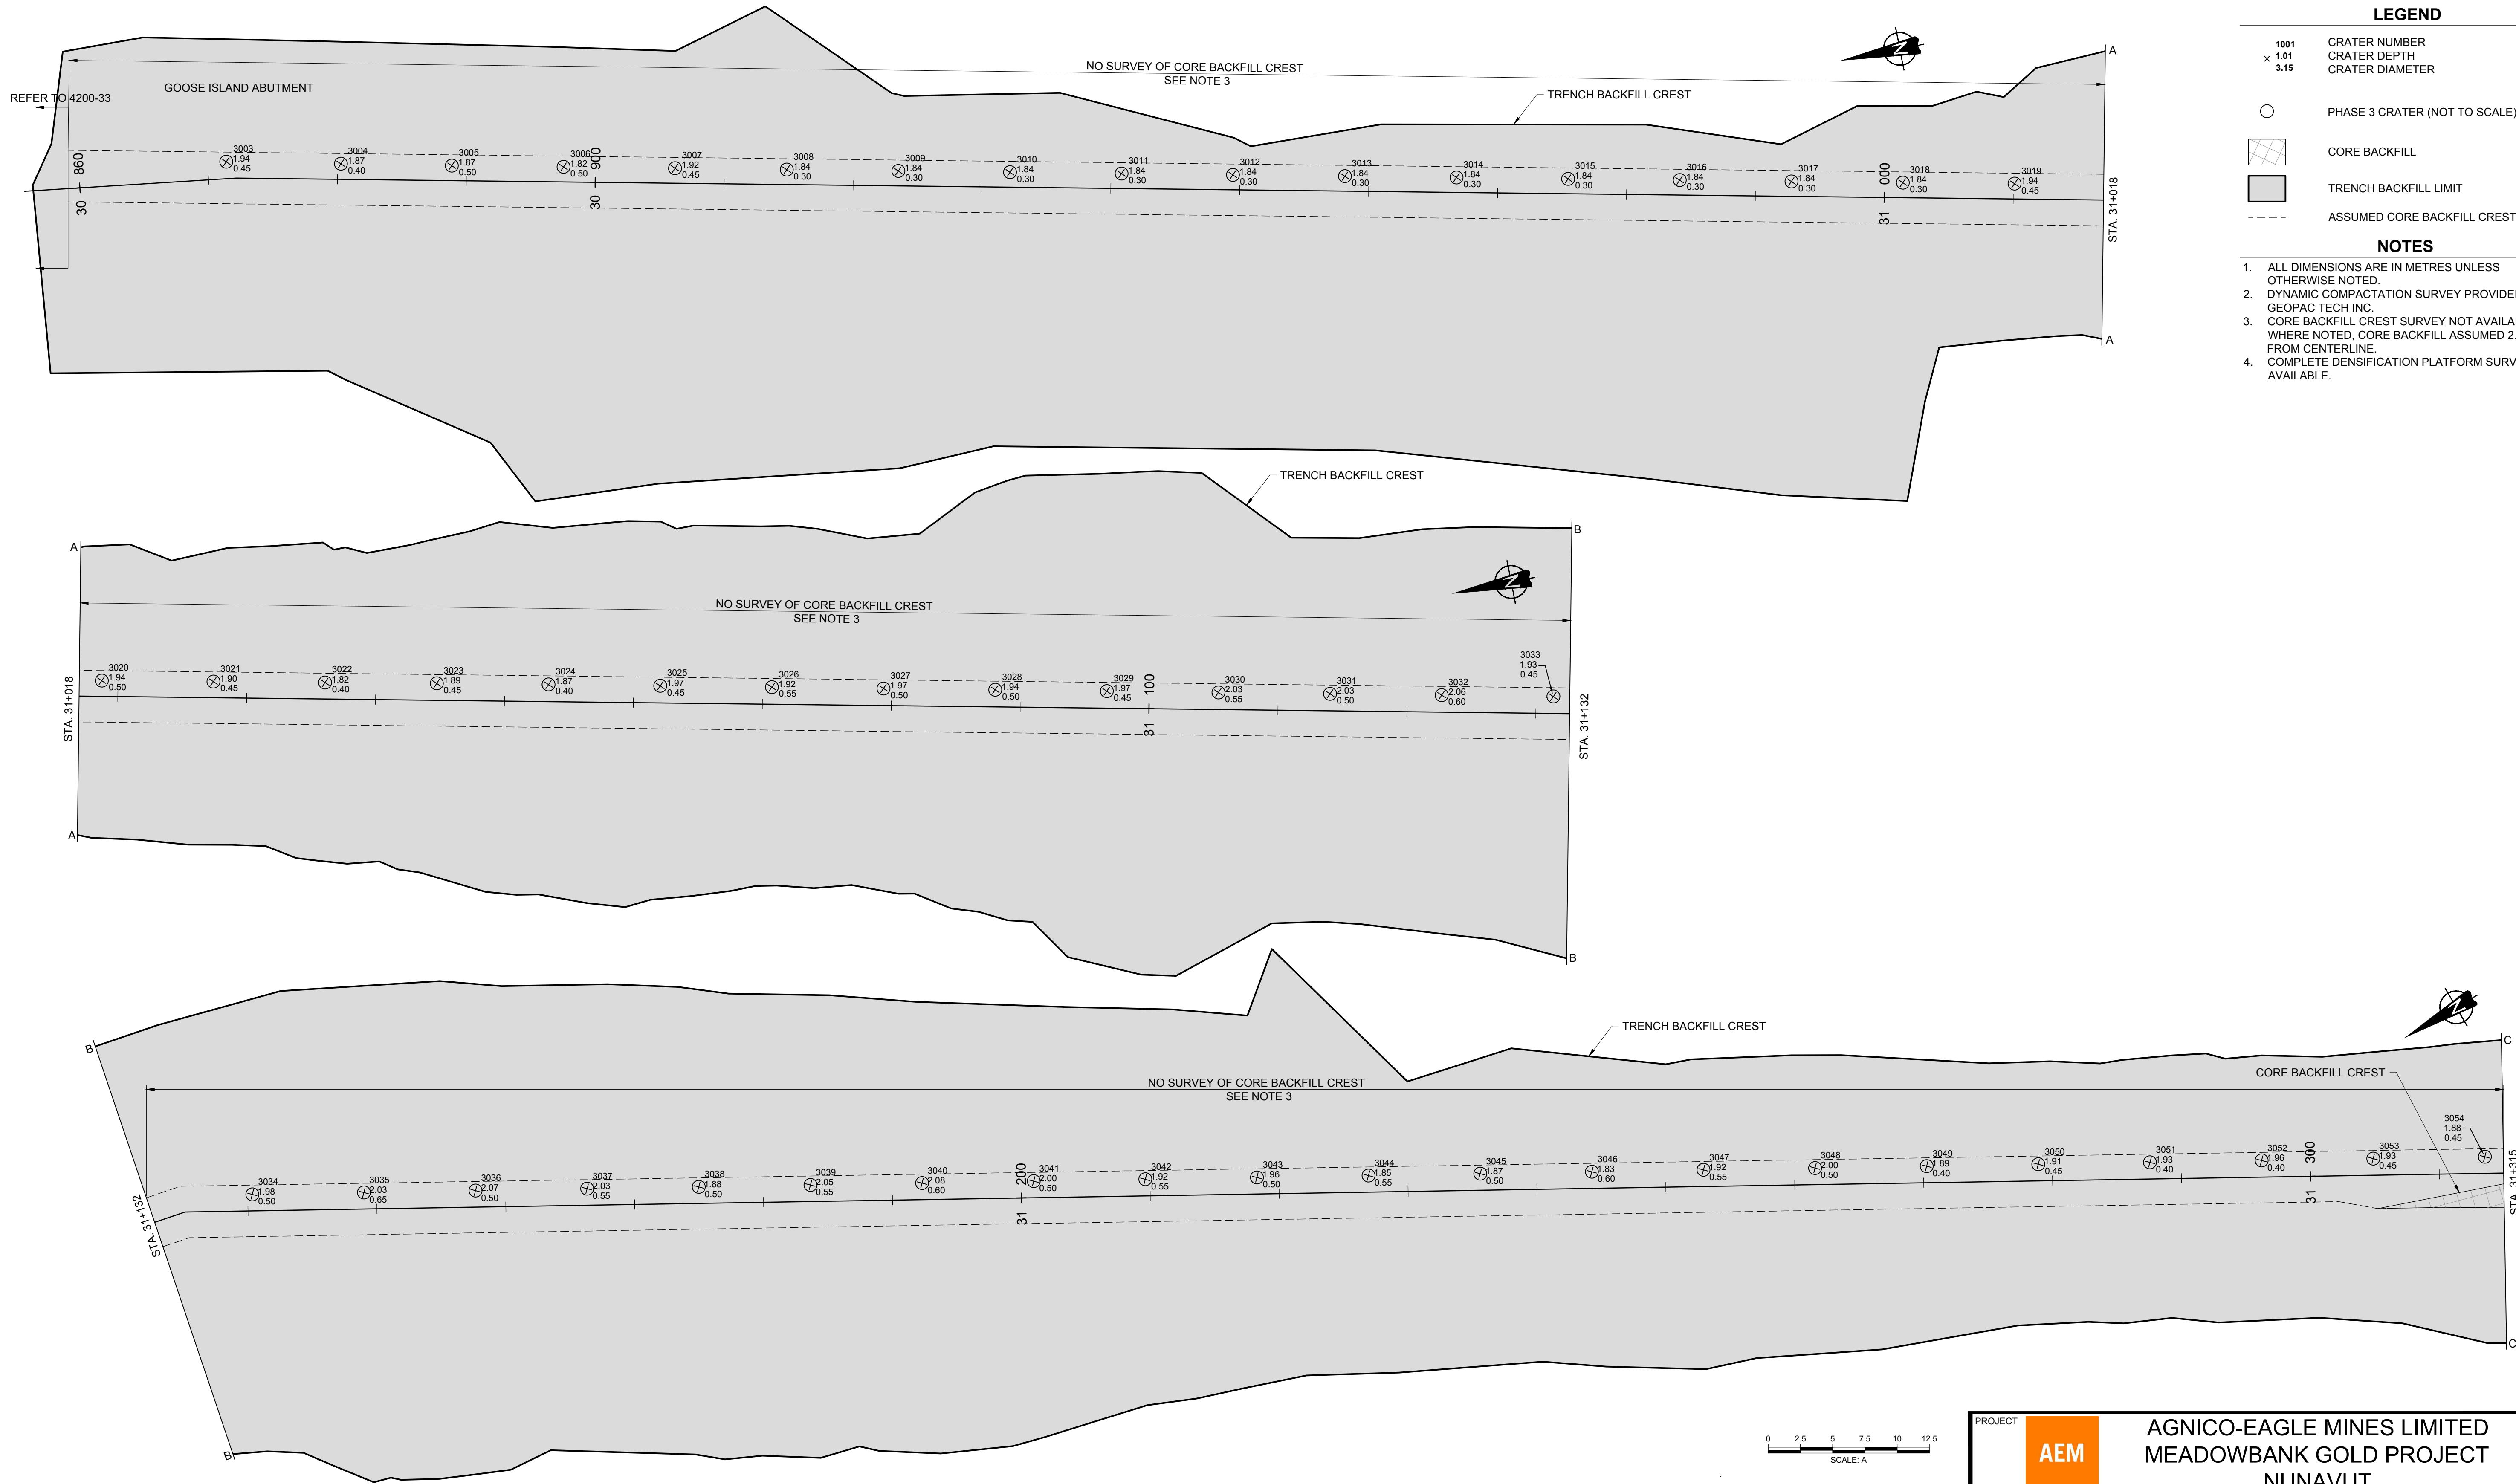[illegible]

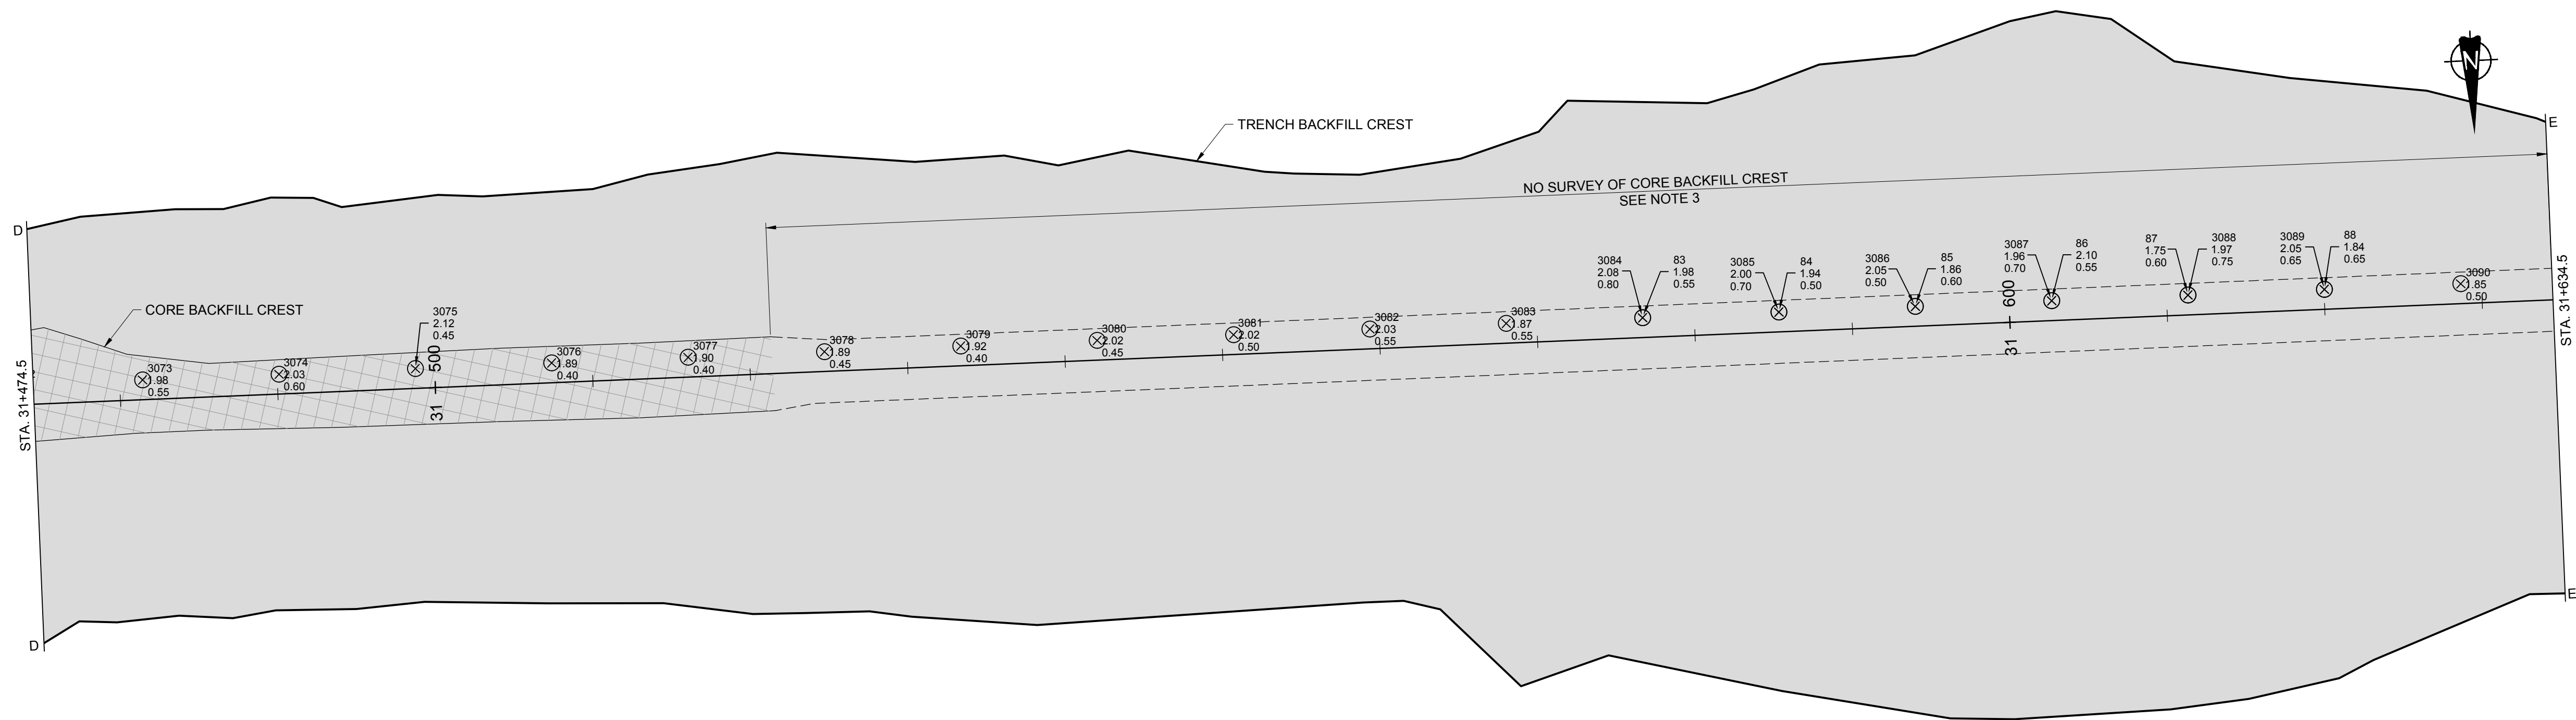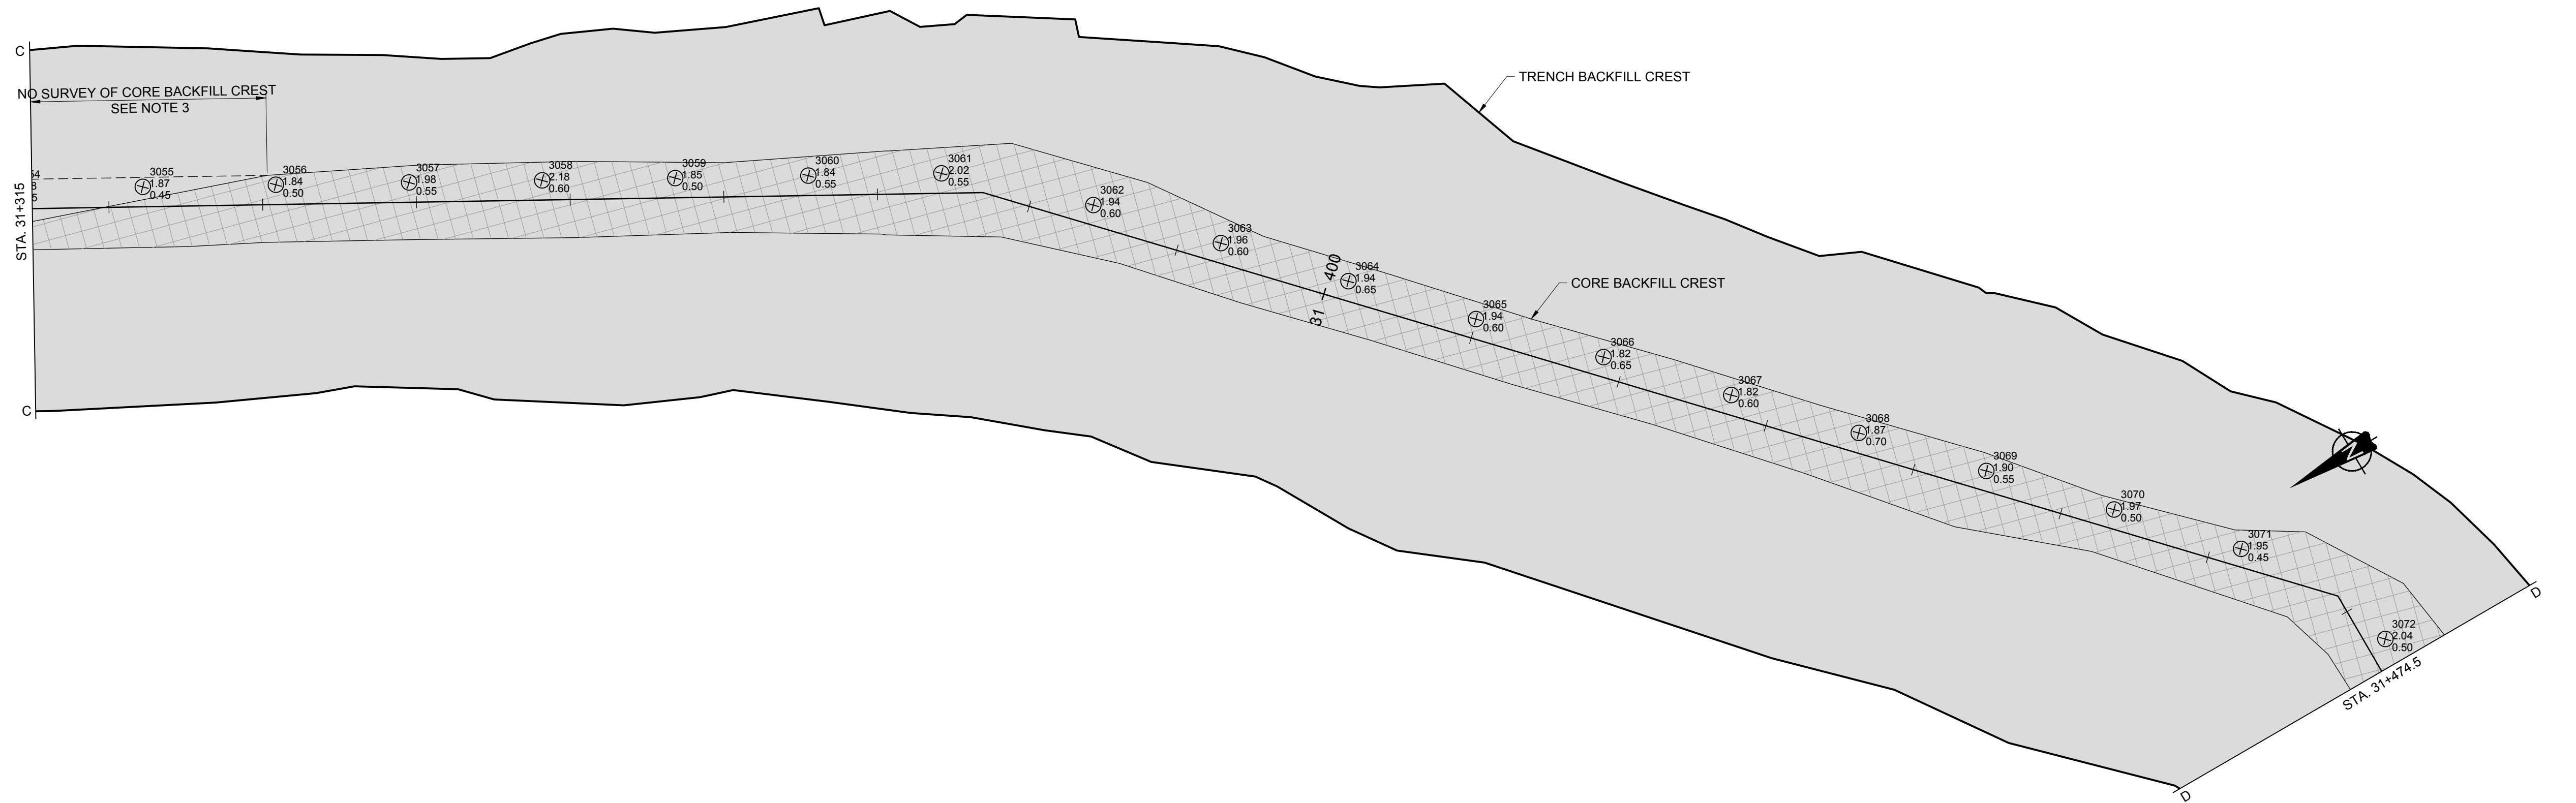

PROJECT	AEM AGNICO-EAGLE MINES LIMITED MEADOWBANK GOLD PROJECT NUNAVUT							
	TITLE							
BAY-GOOSE DIKE SOUTH PORTION DENSIFICATION PLAN - PHASE 3 (2 OF 4)								
 Golder Associates	PROJECT No.		09-1428-5007		FILE No.	4300_0_47		
	DESIGN	FA	15FEB12		SCALE	AS SHOWN	REV.	0
	CADD	JD	15FEB12		4300-47			
	CHECK	GRB	15DEC12					
	REVIEW	FE	15DEC12					

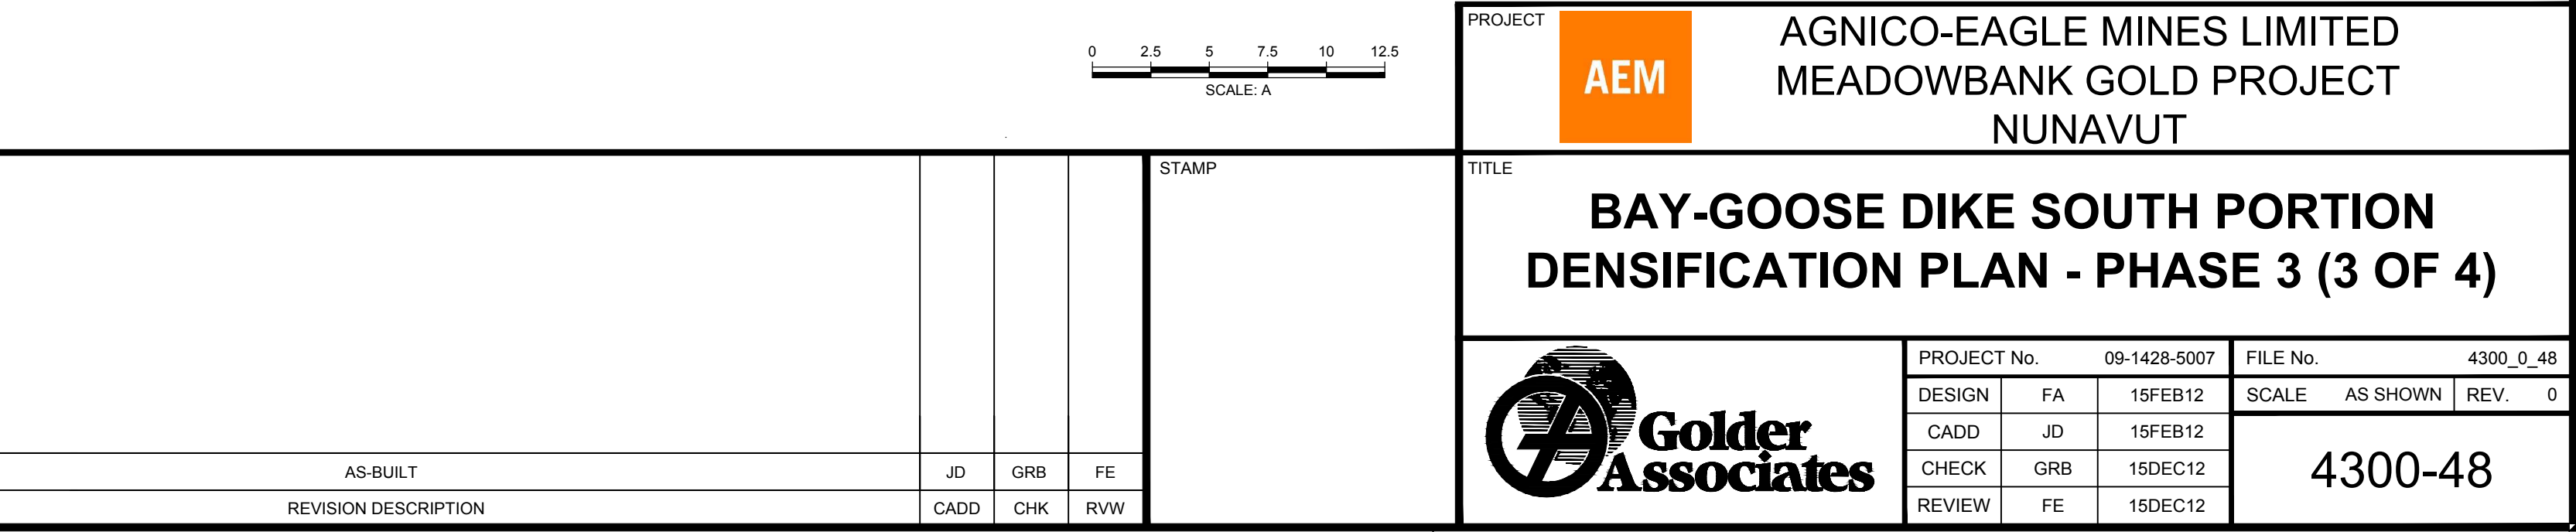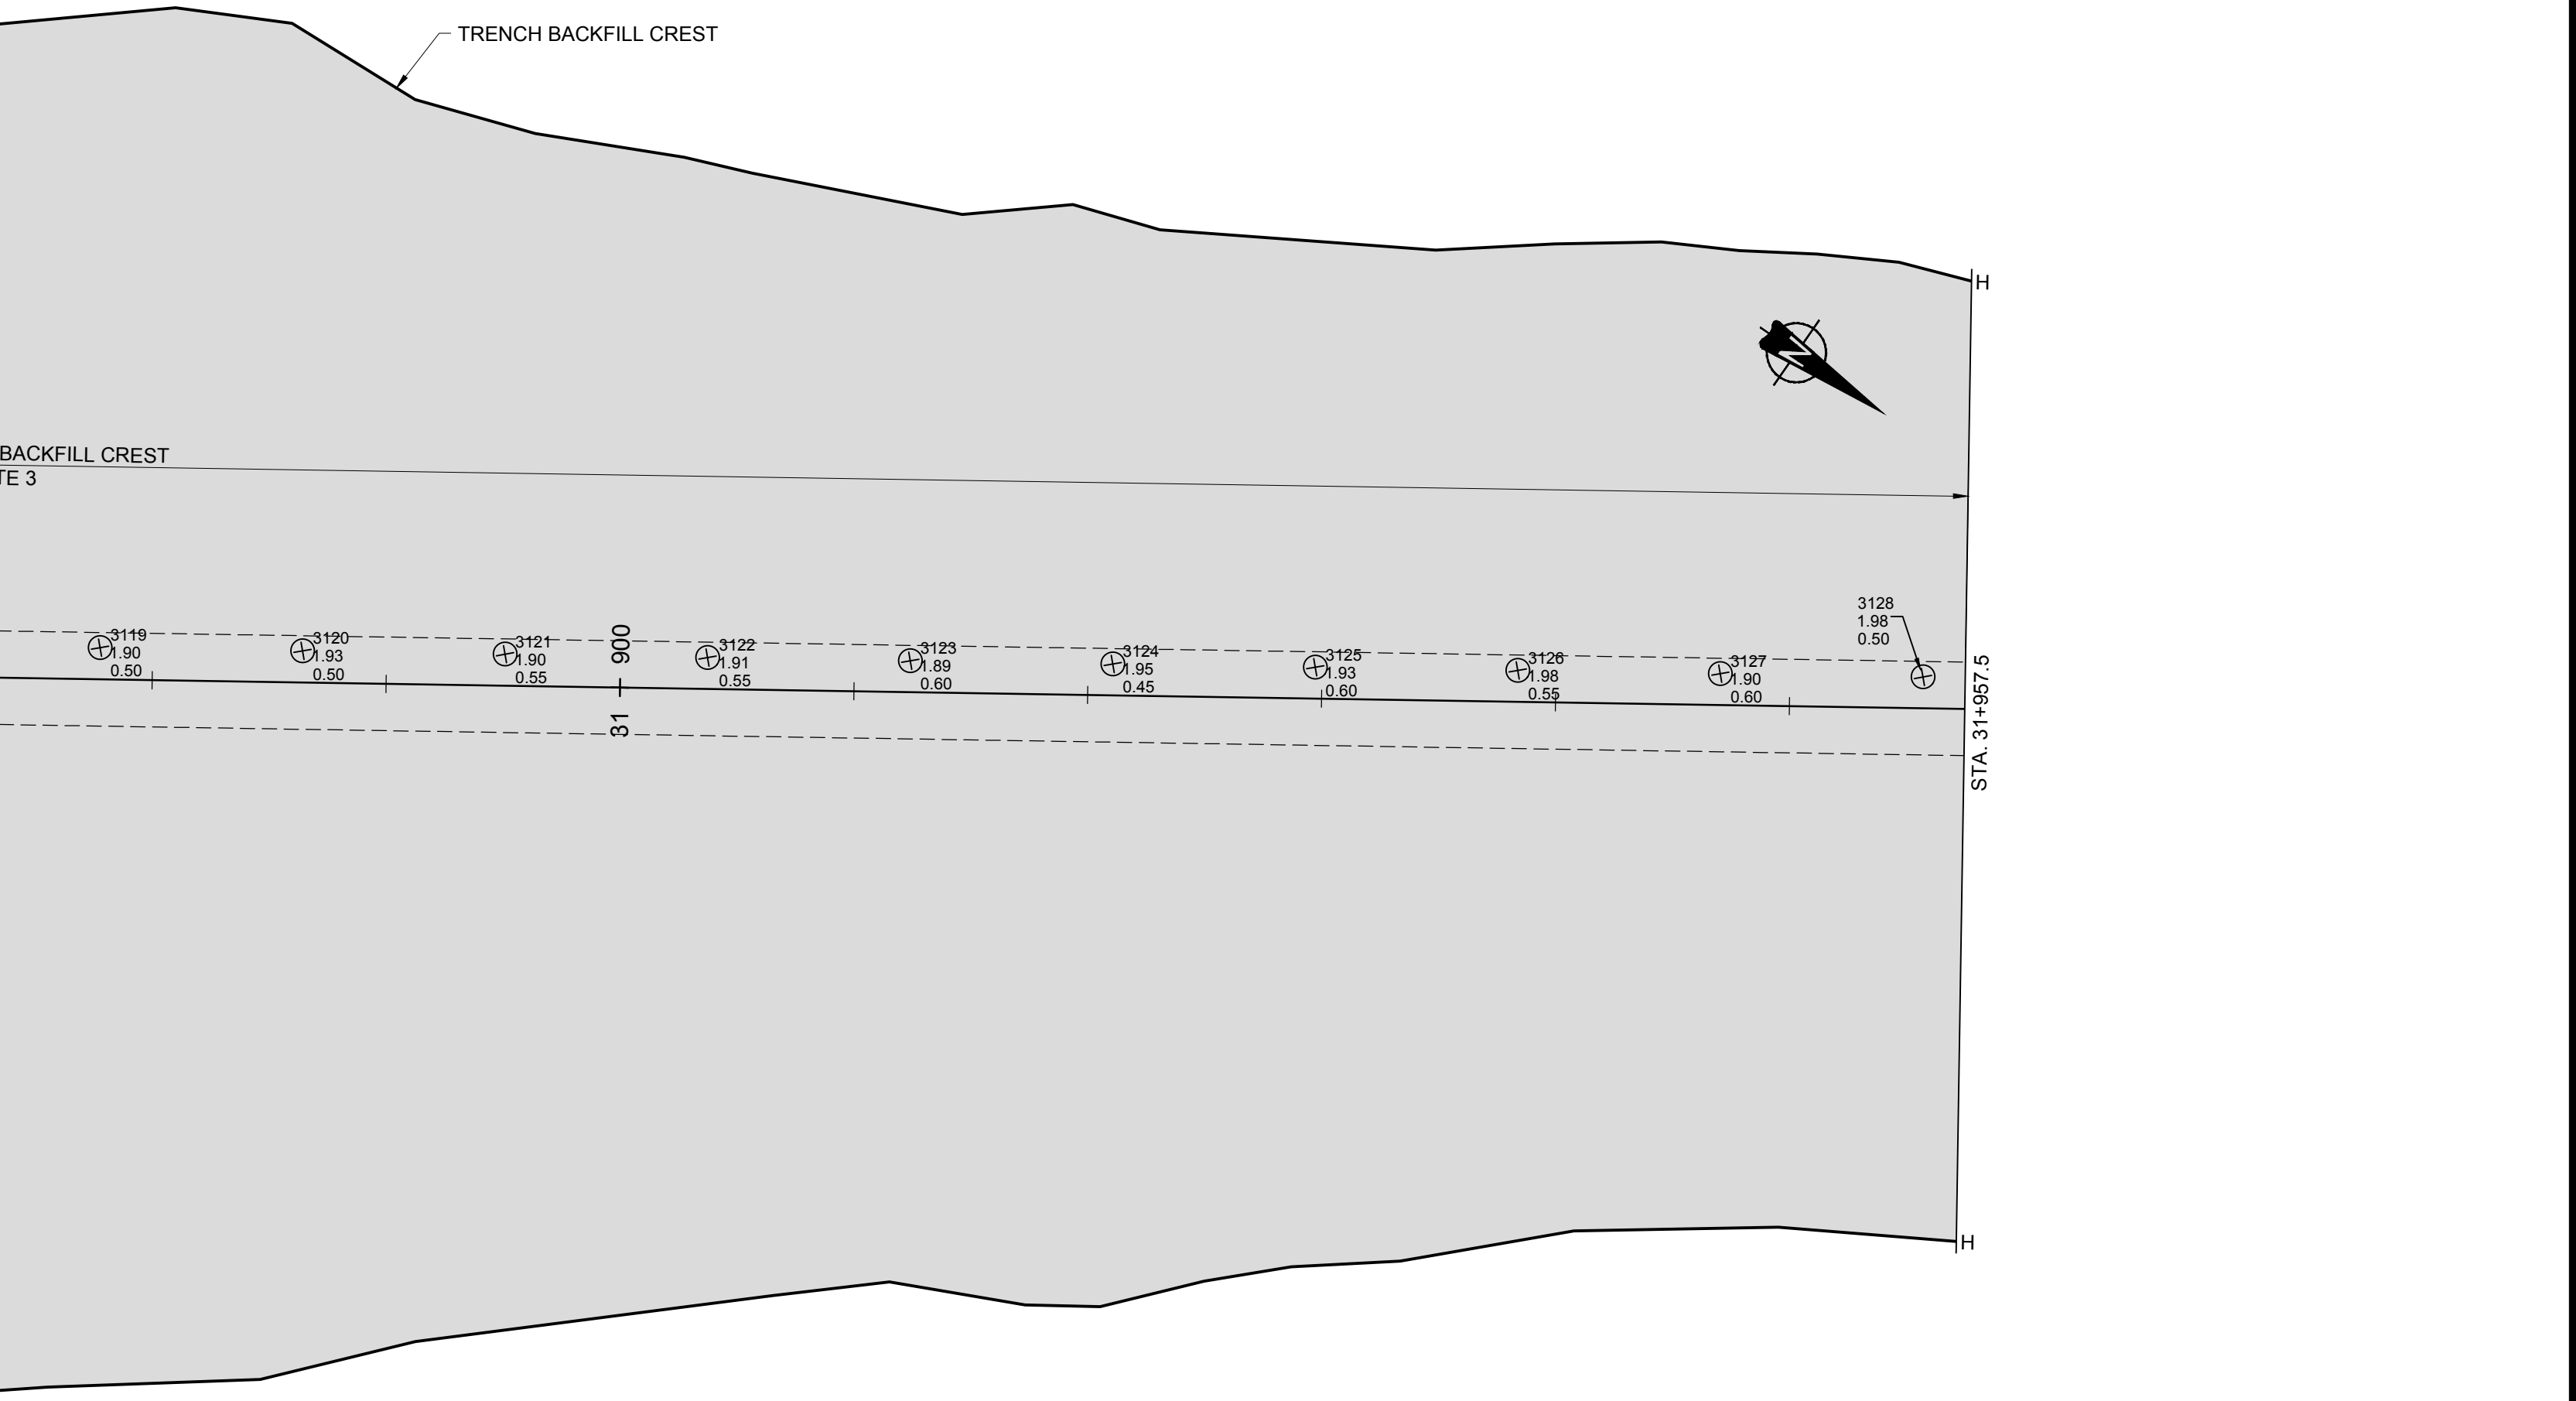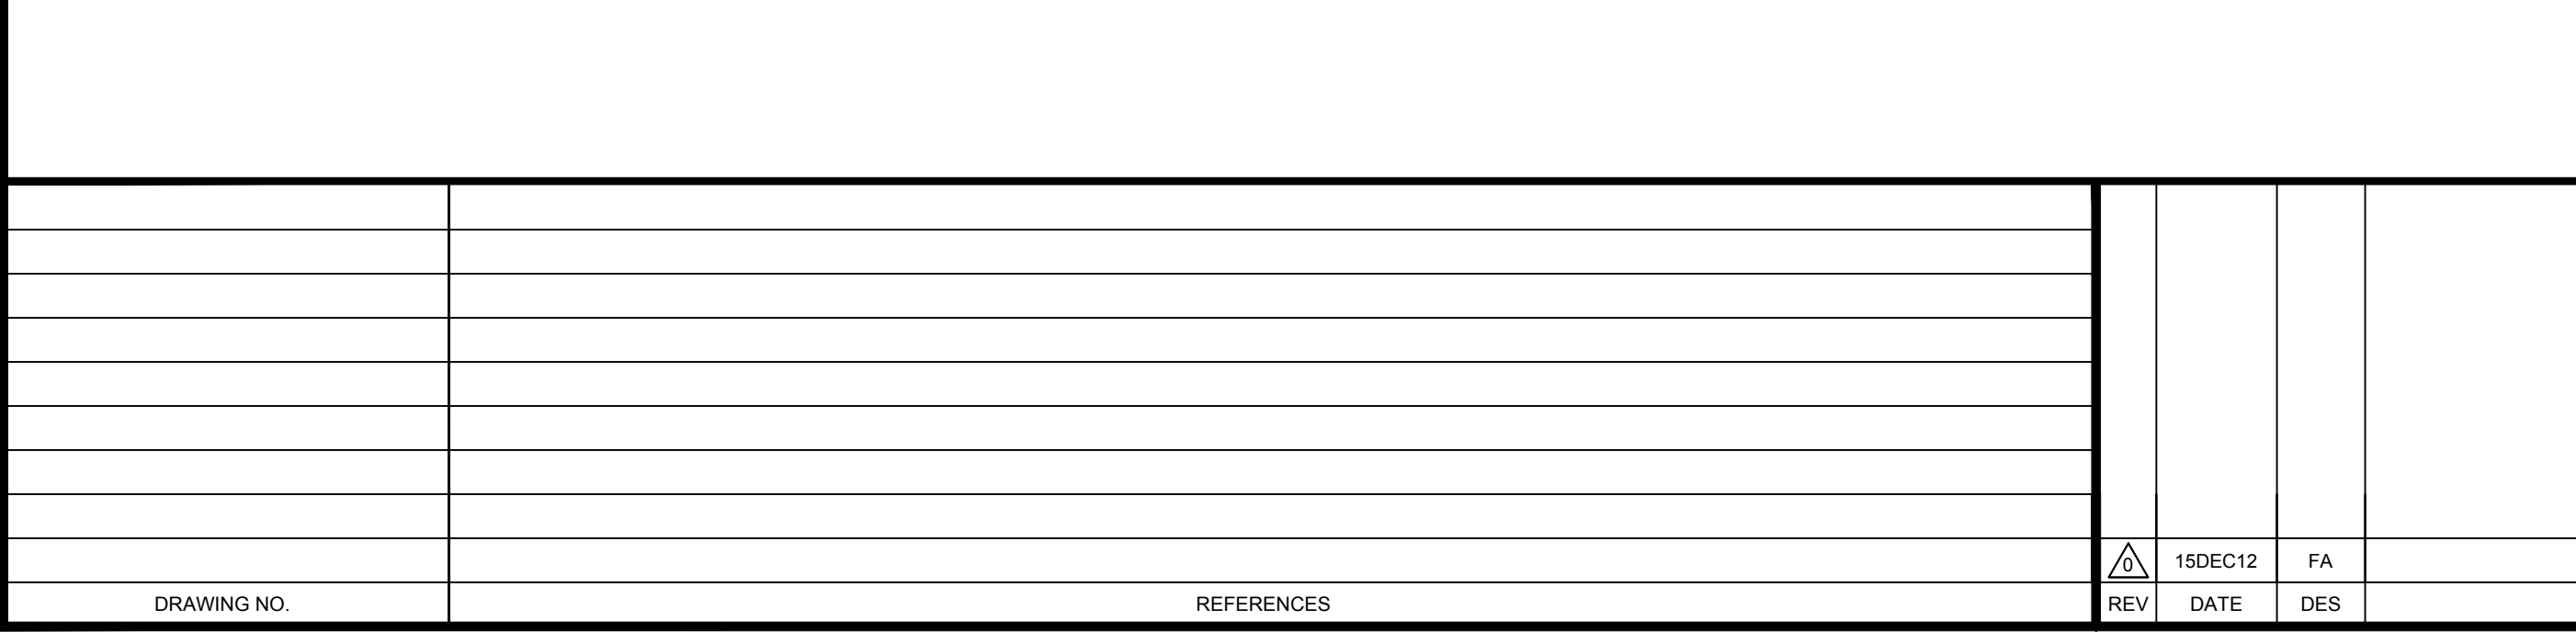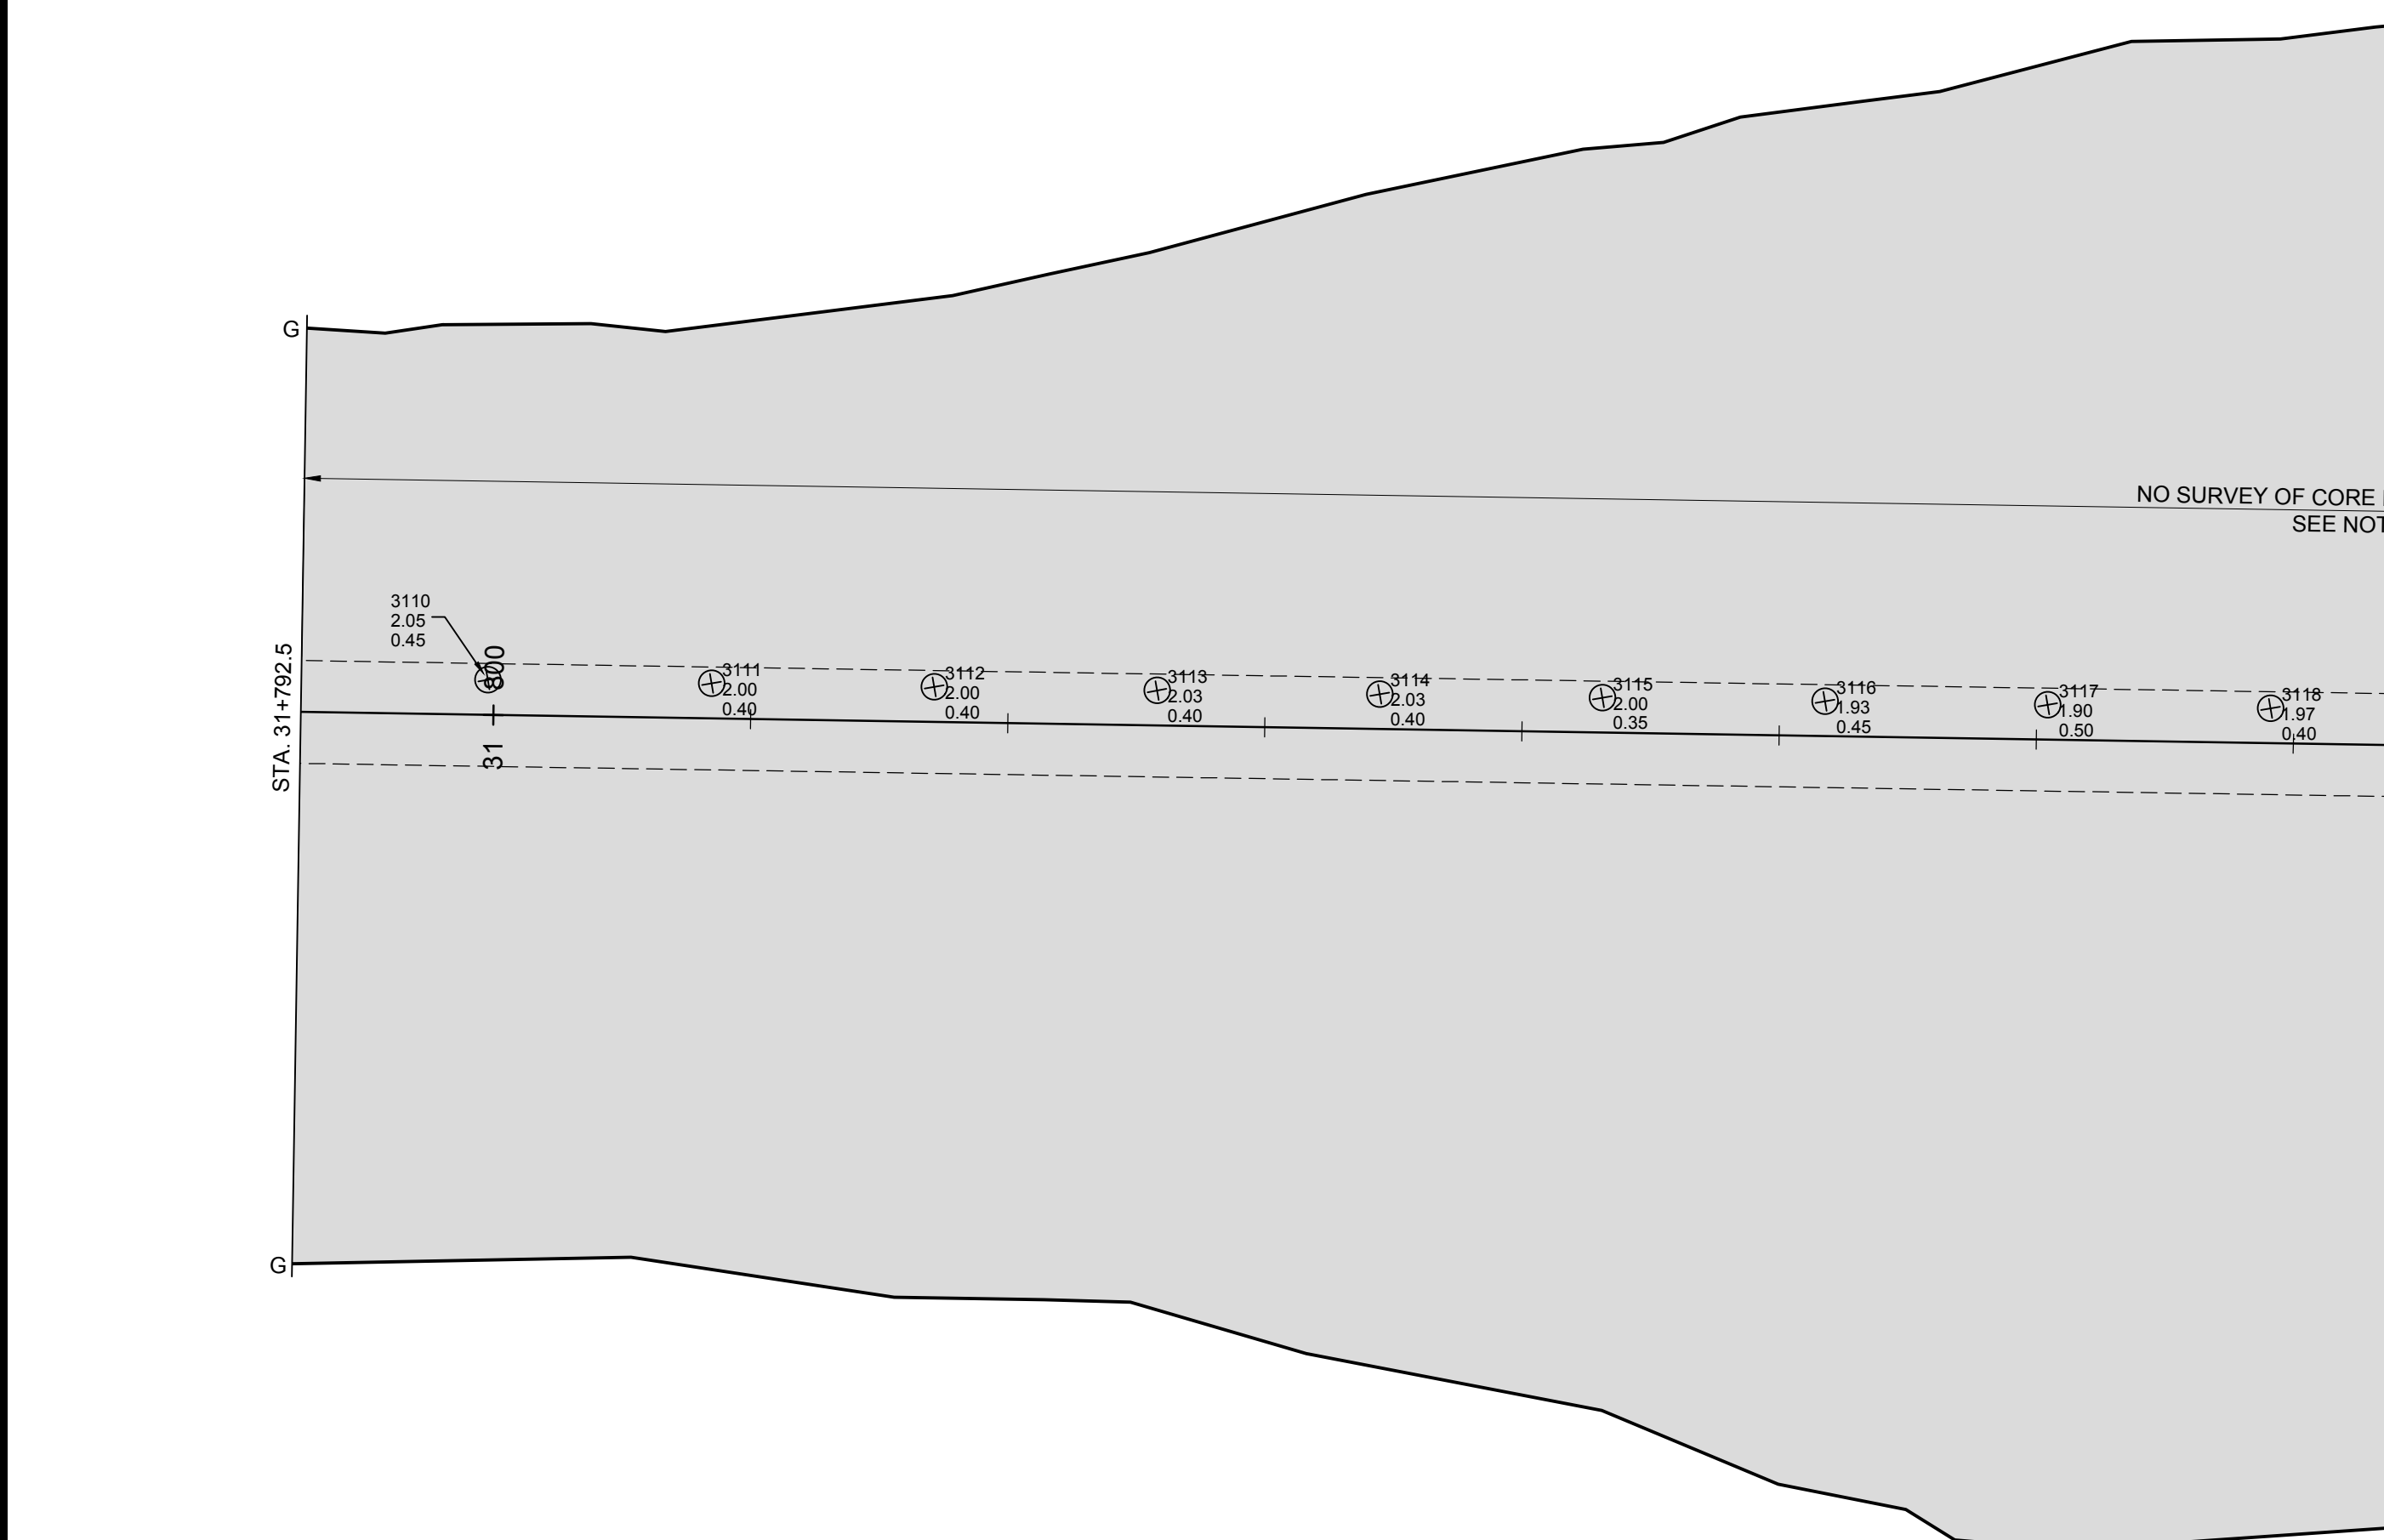

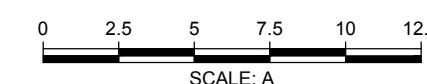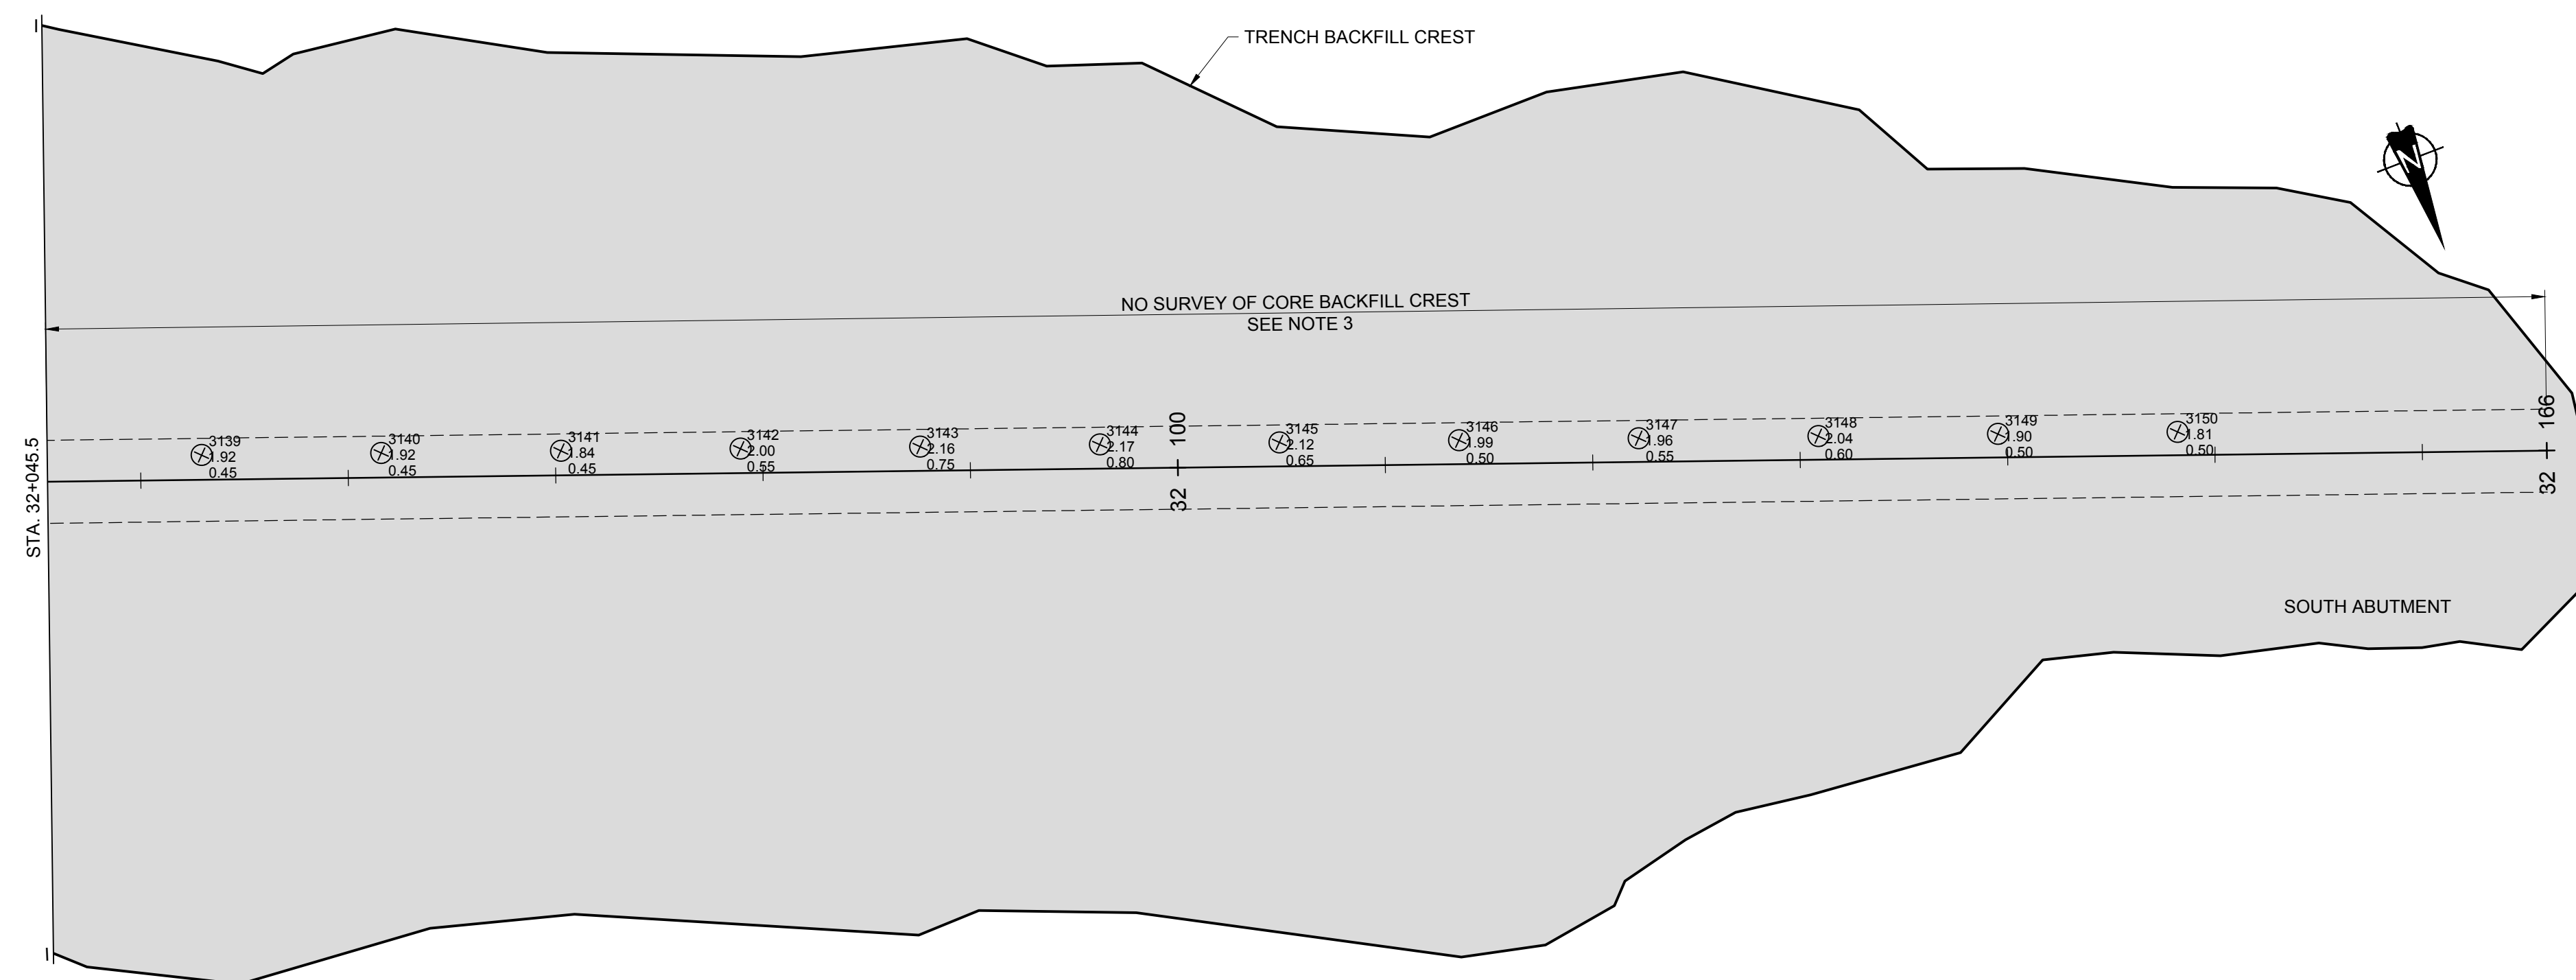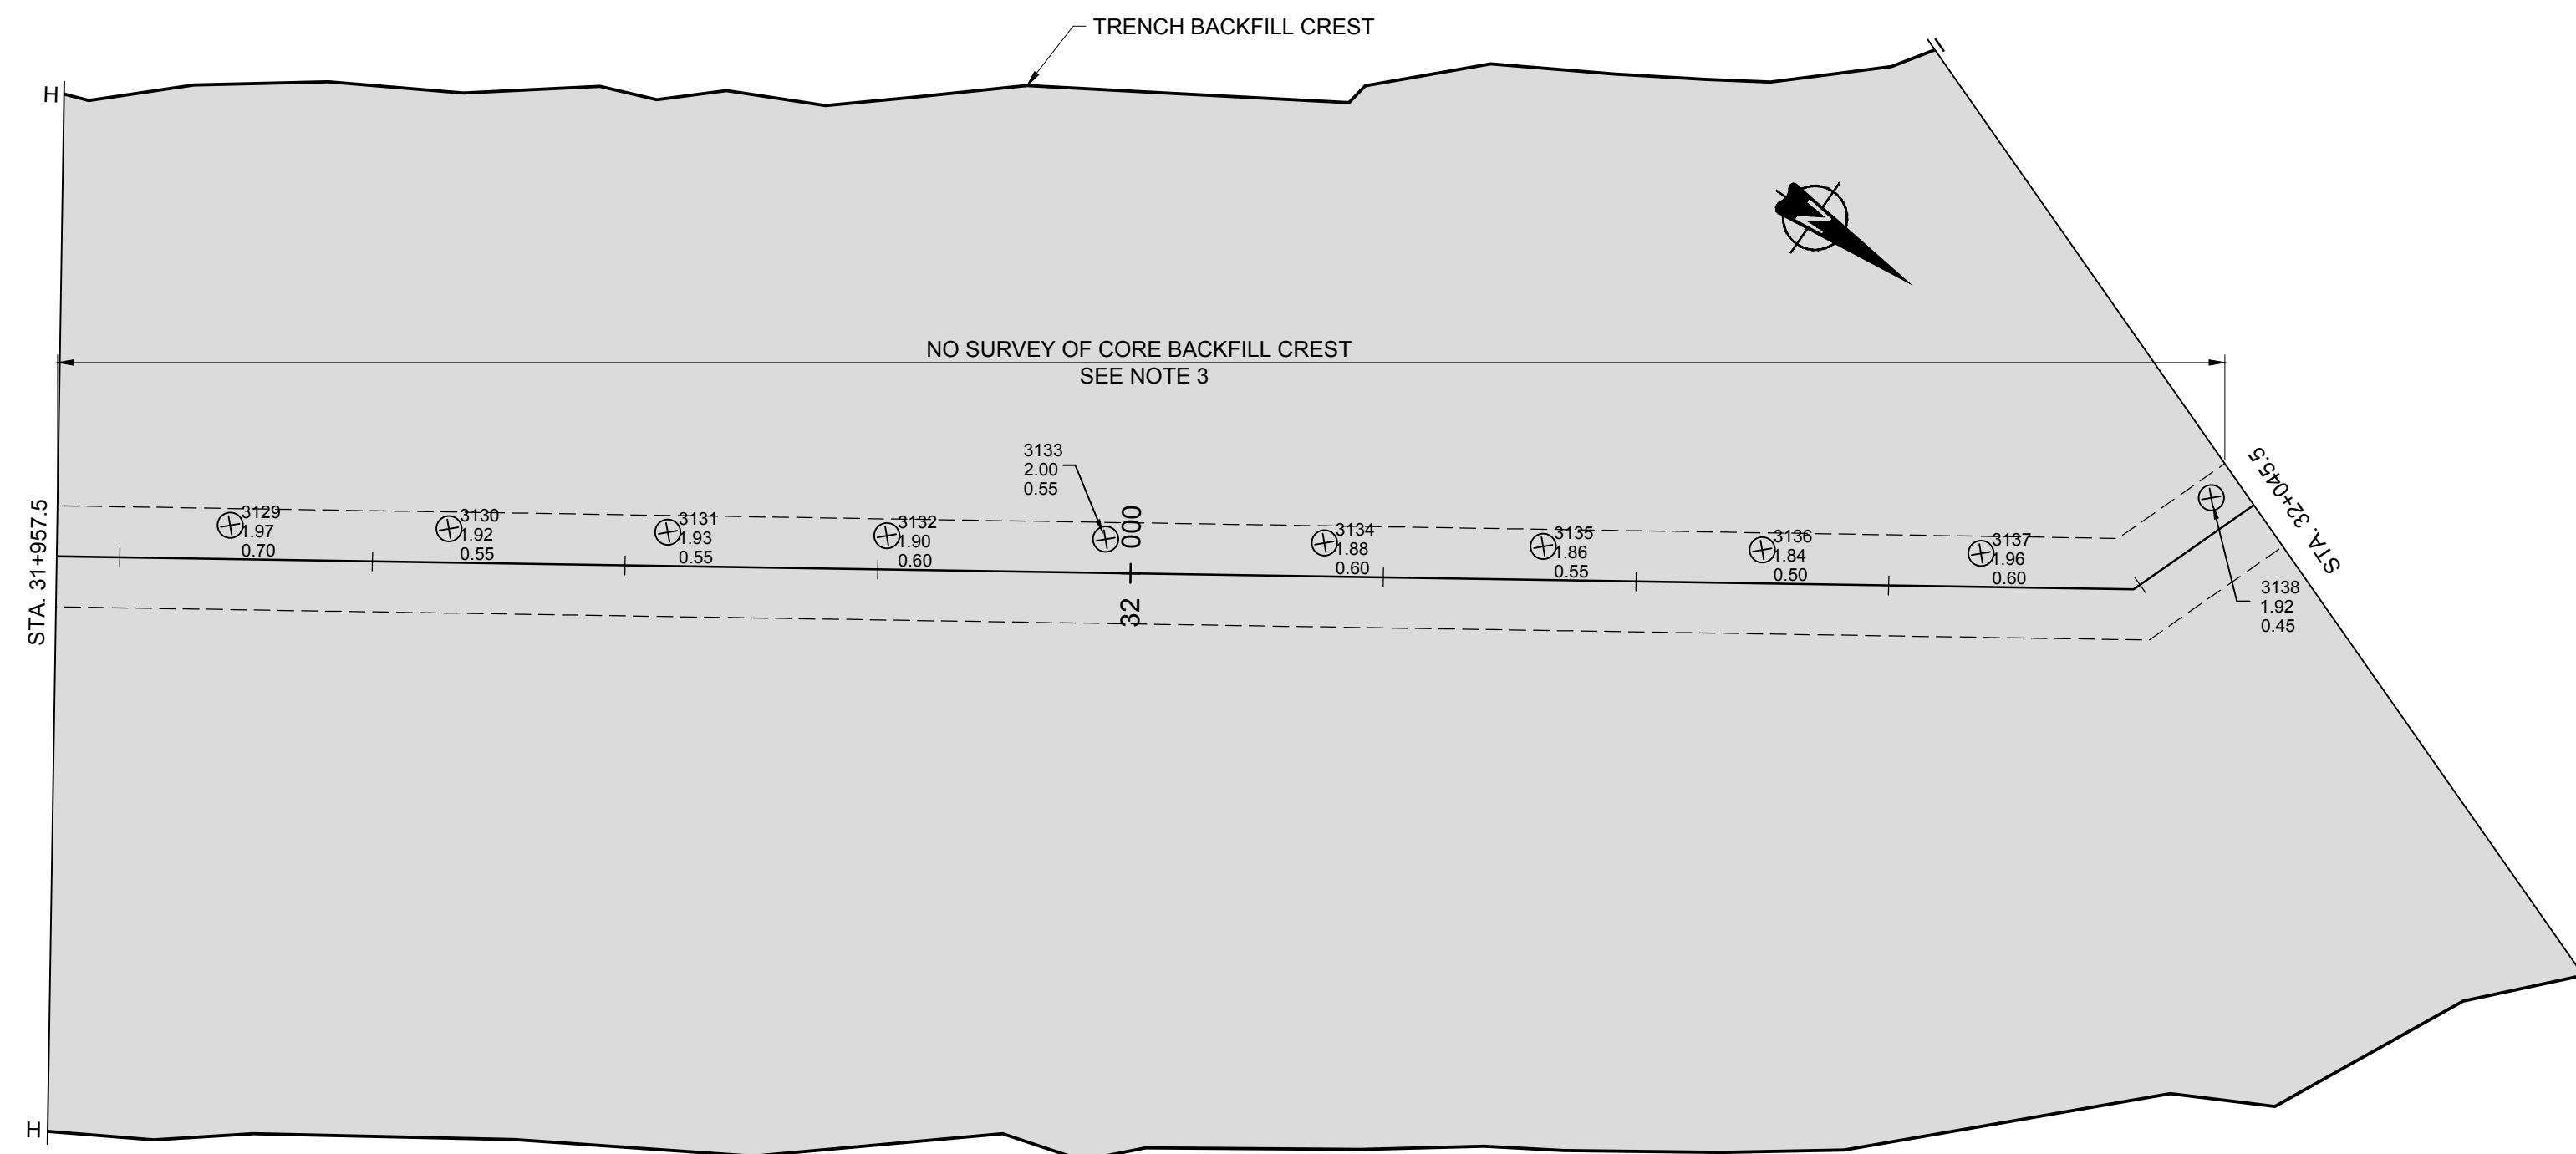


	LEGEND
2001	CRATER NUMBER
x 1.01	CRATER DEPTH
3.15	CRATER DIAMETER
	PHASE 3 CRATER (NOT TO SCALE)
	CORE BACKFILL
	TRENCH BACKFILL LIMIT
	ASSUMED CORE BACKFILL CREST
	NOTES

- ## NOTES
-
1. ALL DIMENSIONS ARE IN METRES UNLESS OTHERWISE NOTED.
 2. DYNAMIC COMPACTIONATION SURVEY PROVIDED BY GEOPAC TECH INC.
 3. CORE BACKFILL CREST SURVEY NOT AVAILABLE WHERE NOTED. CORE BACKFILL ASSUMED 2.0m FROM CENTERLINE.
 4. COMPLETE DENSIFICATION PLATFORM SURVEY NOT AVAILABLE.



[illegible]

PROJECT	AEM	AGNICO-EAGLE MINES LIMITED MEADOWBANK GOLD PROJECT NUNAVUT
TITLE	BAY-GOOSE DIKE SOUTH PORTION DENSIFICATION PLAN - PHASE 3 (4 OF 4)	

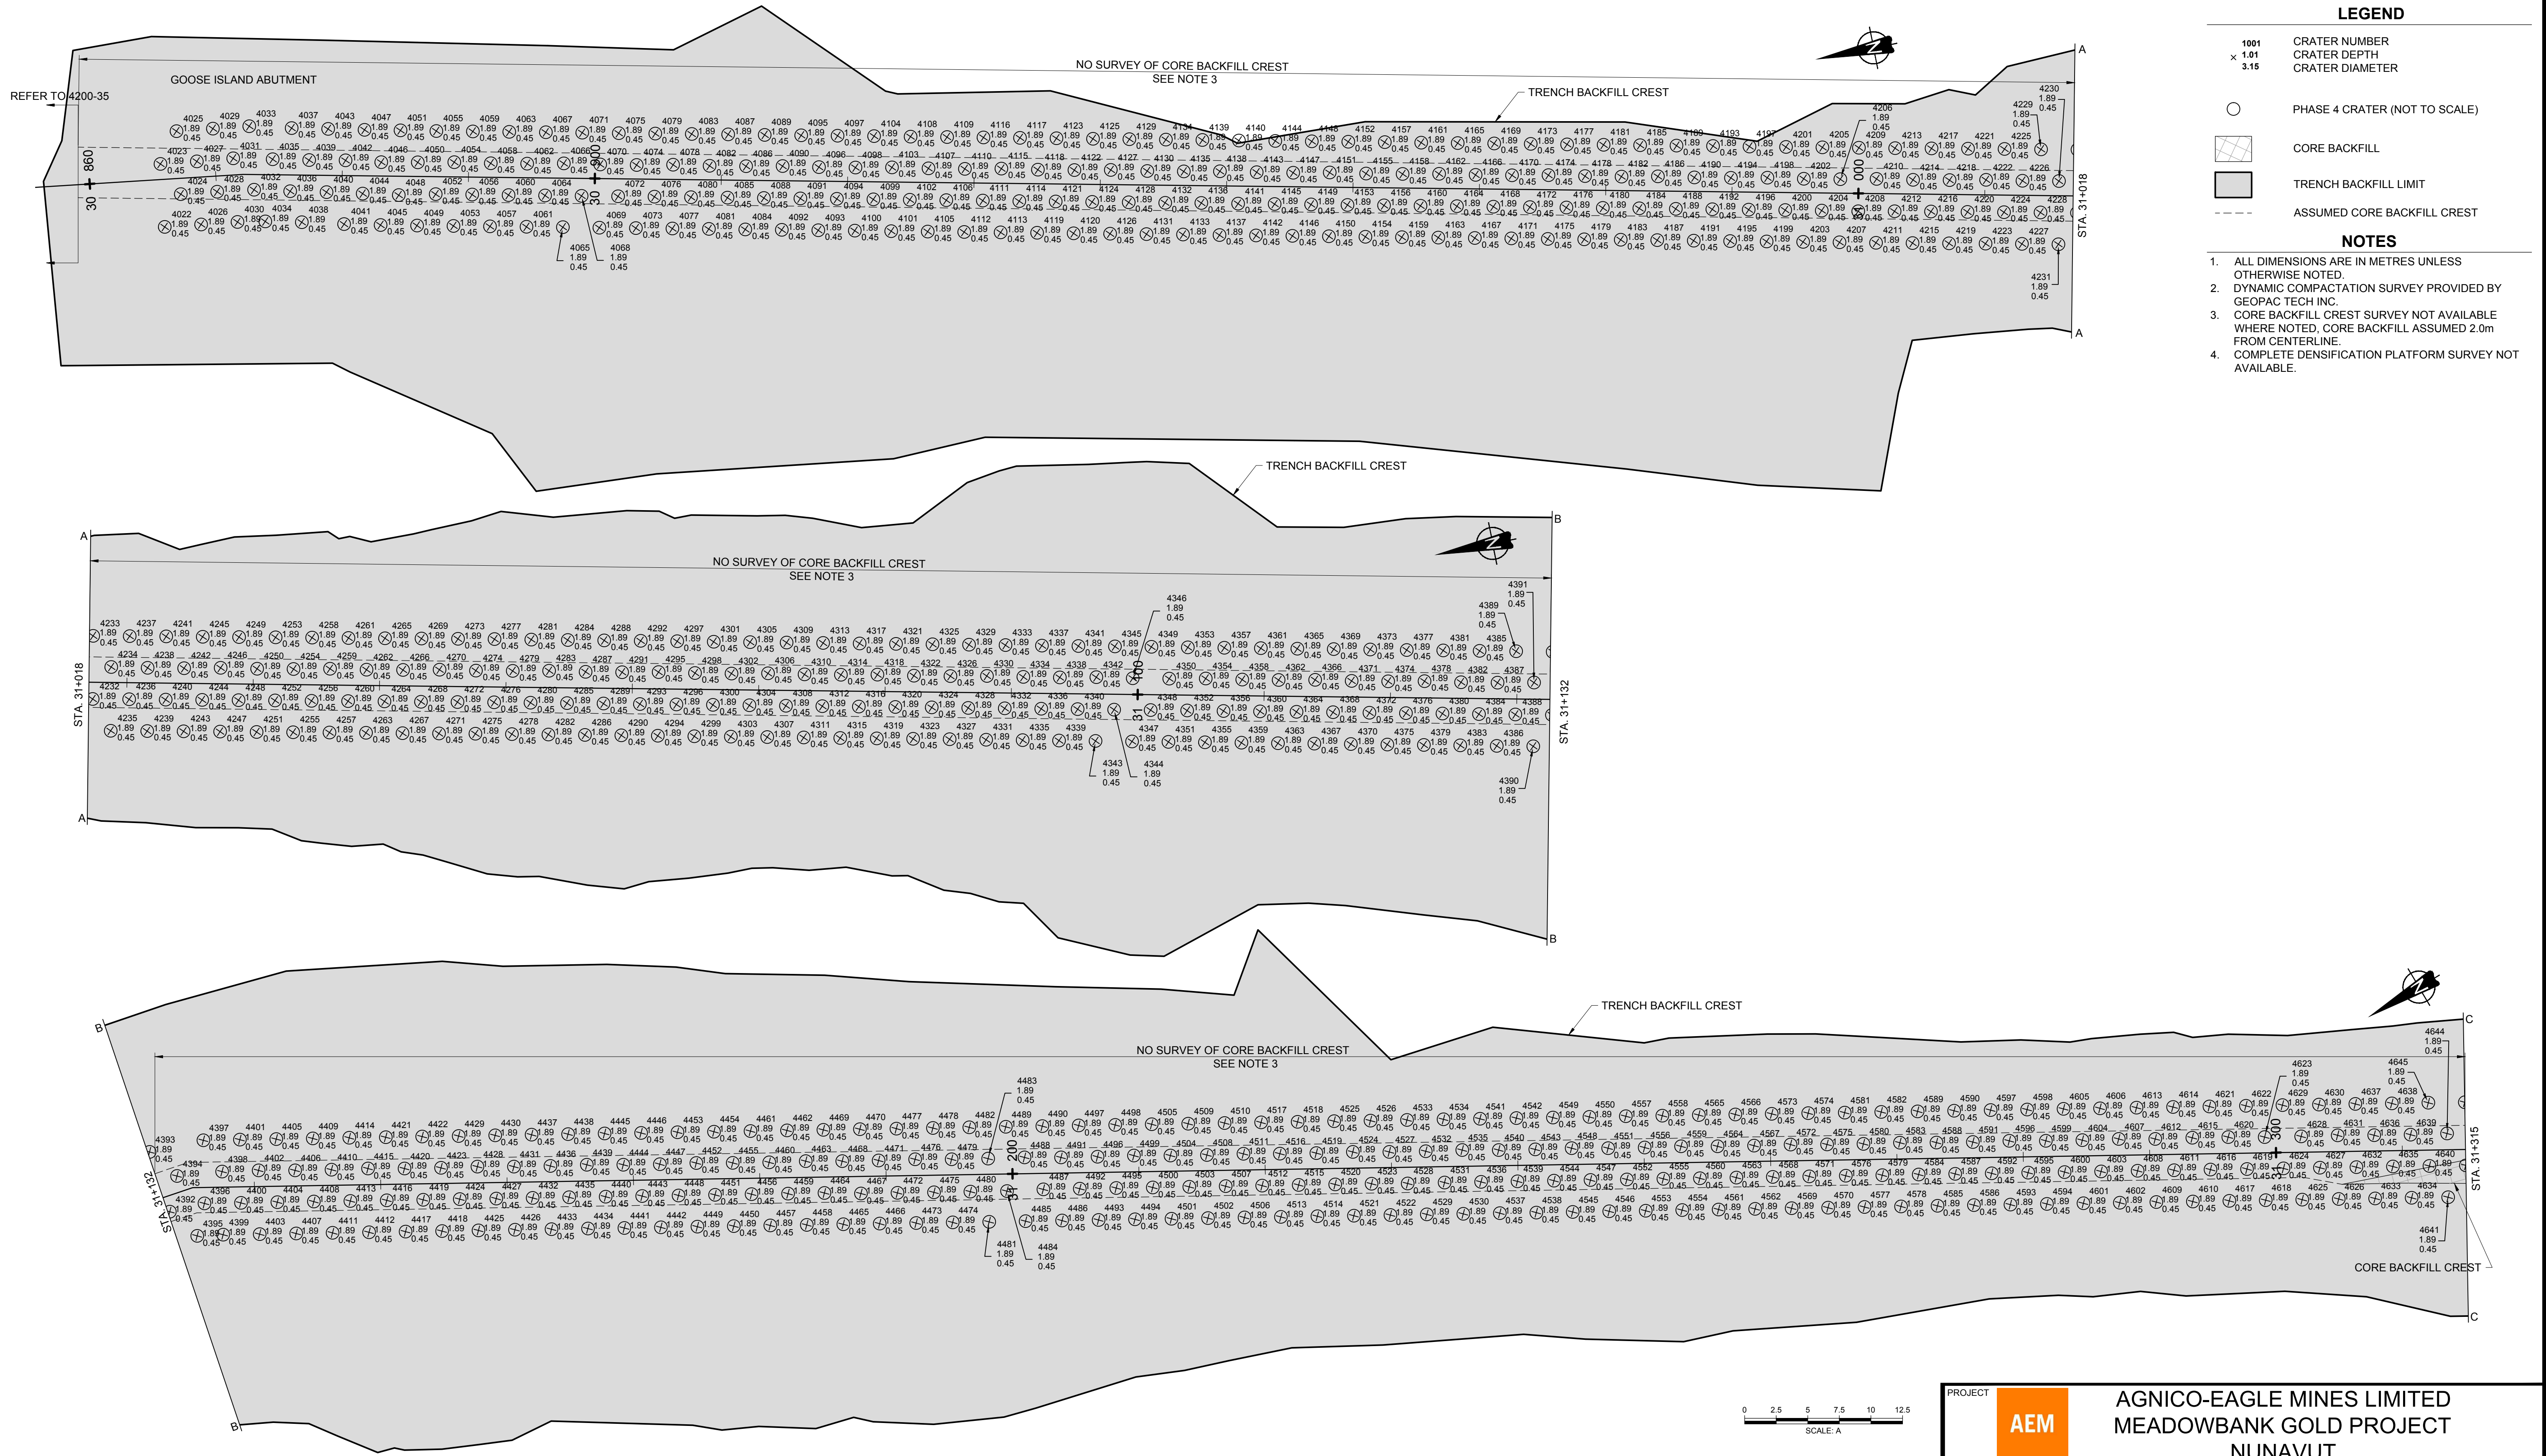

--	--	
Drawing File: N:\bur-graphics\Projects\2009\1428\09-1428-5007\Drafting\4000\meadowbank - bay-goose (south) dike as-built\4300_0_52.dwg Layout:DENSIFICATION PLAN PHASE 4 (3 OF 4) Monday, December 17, 2012 10:30:18 AM By: R.Horlyck

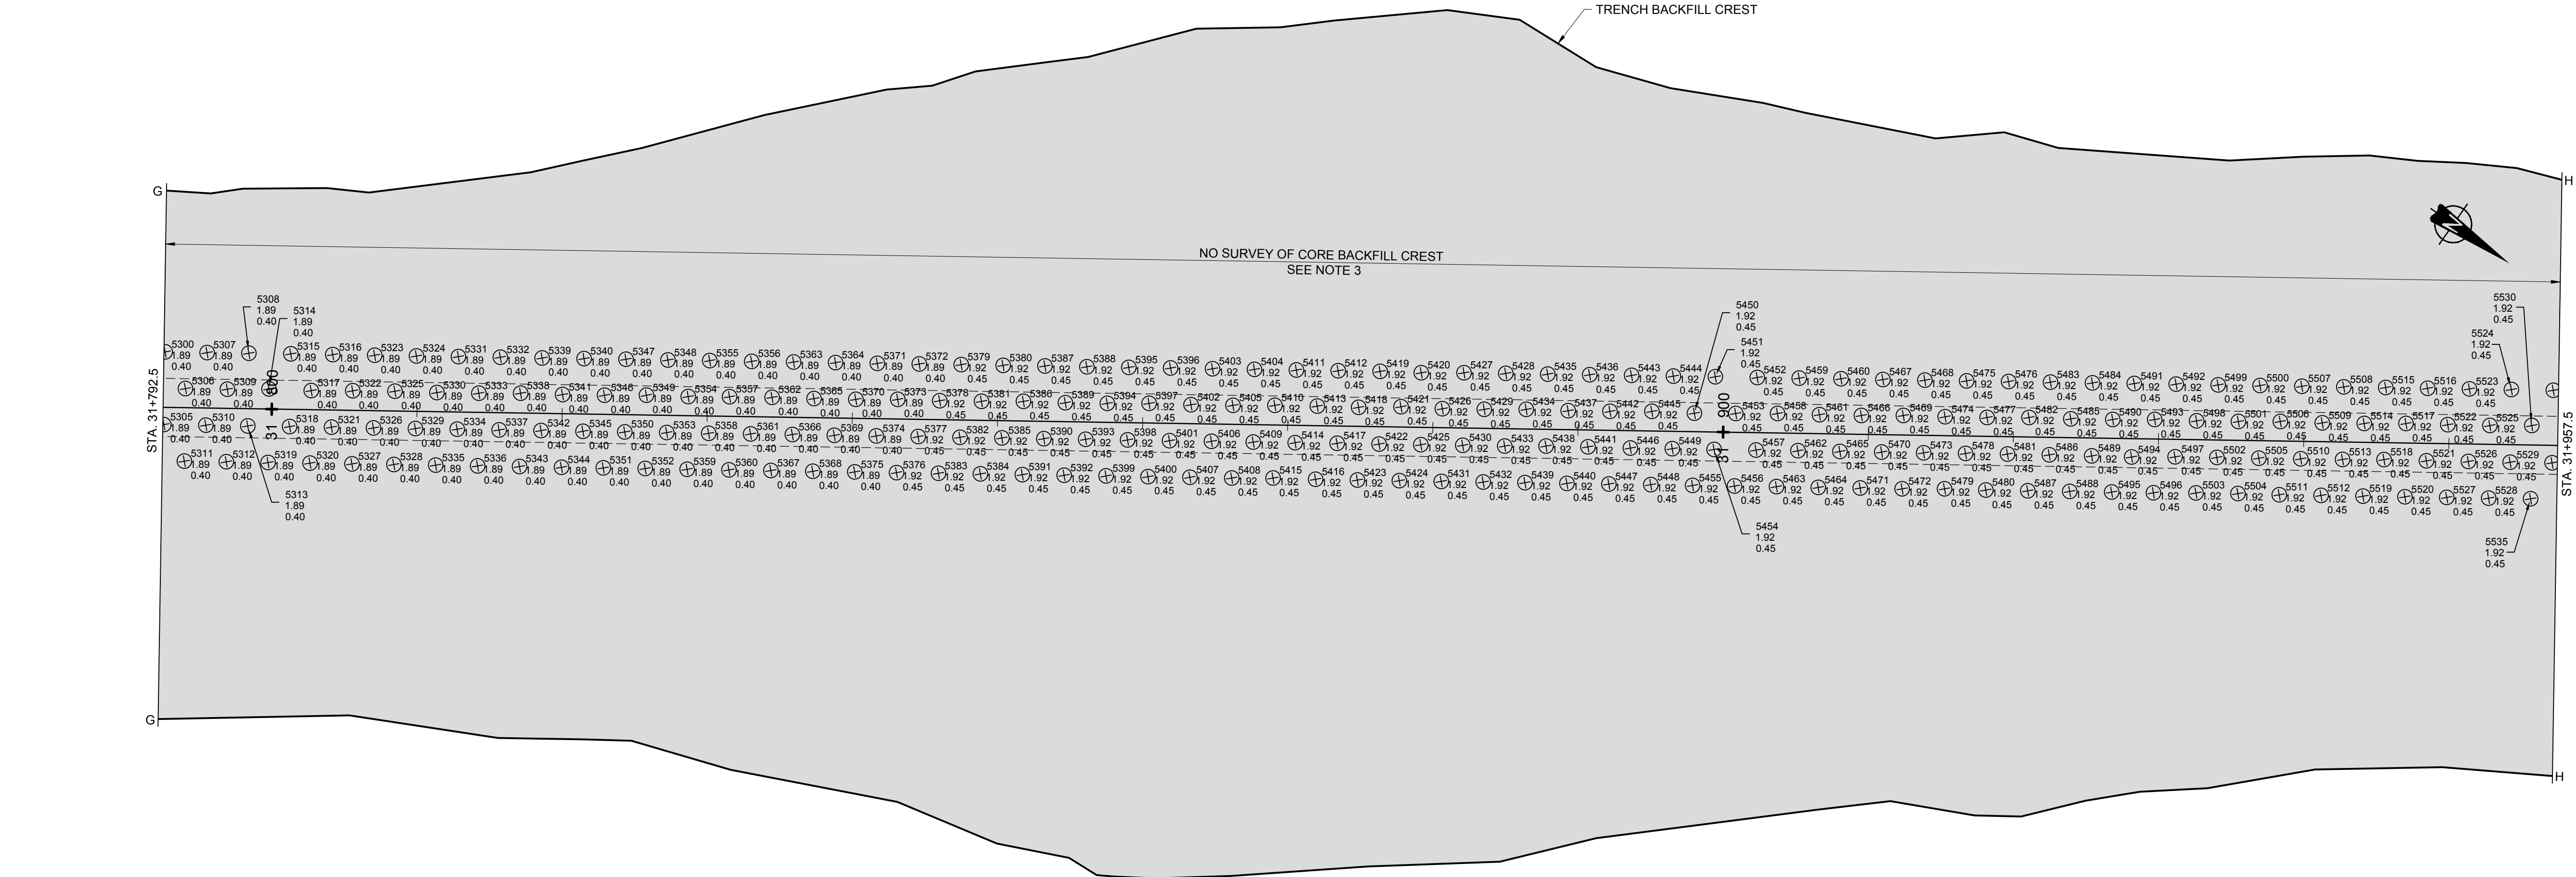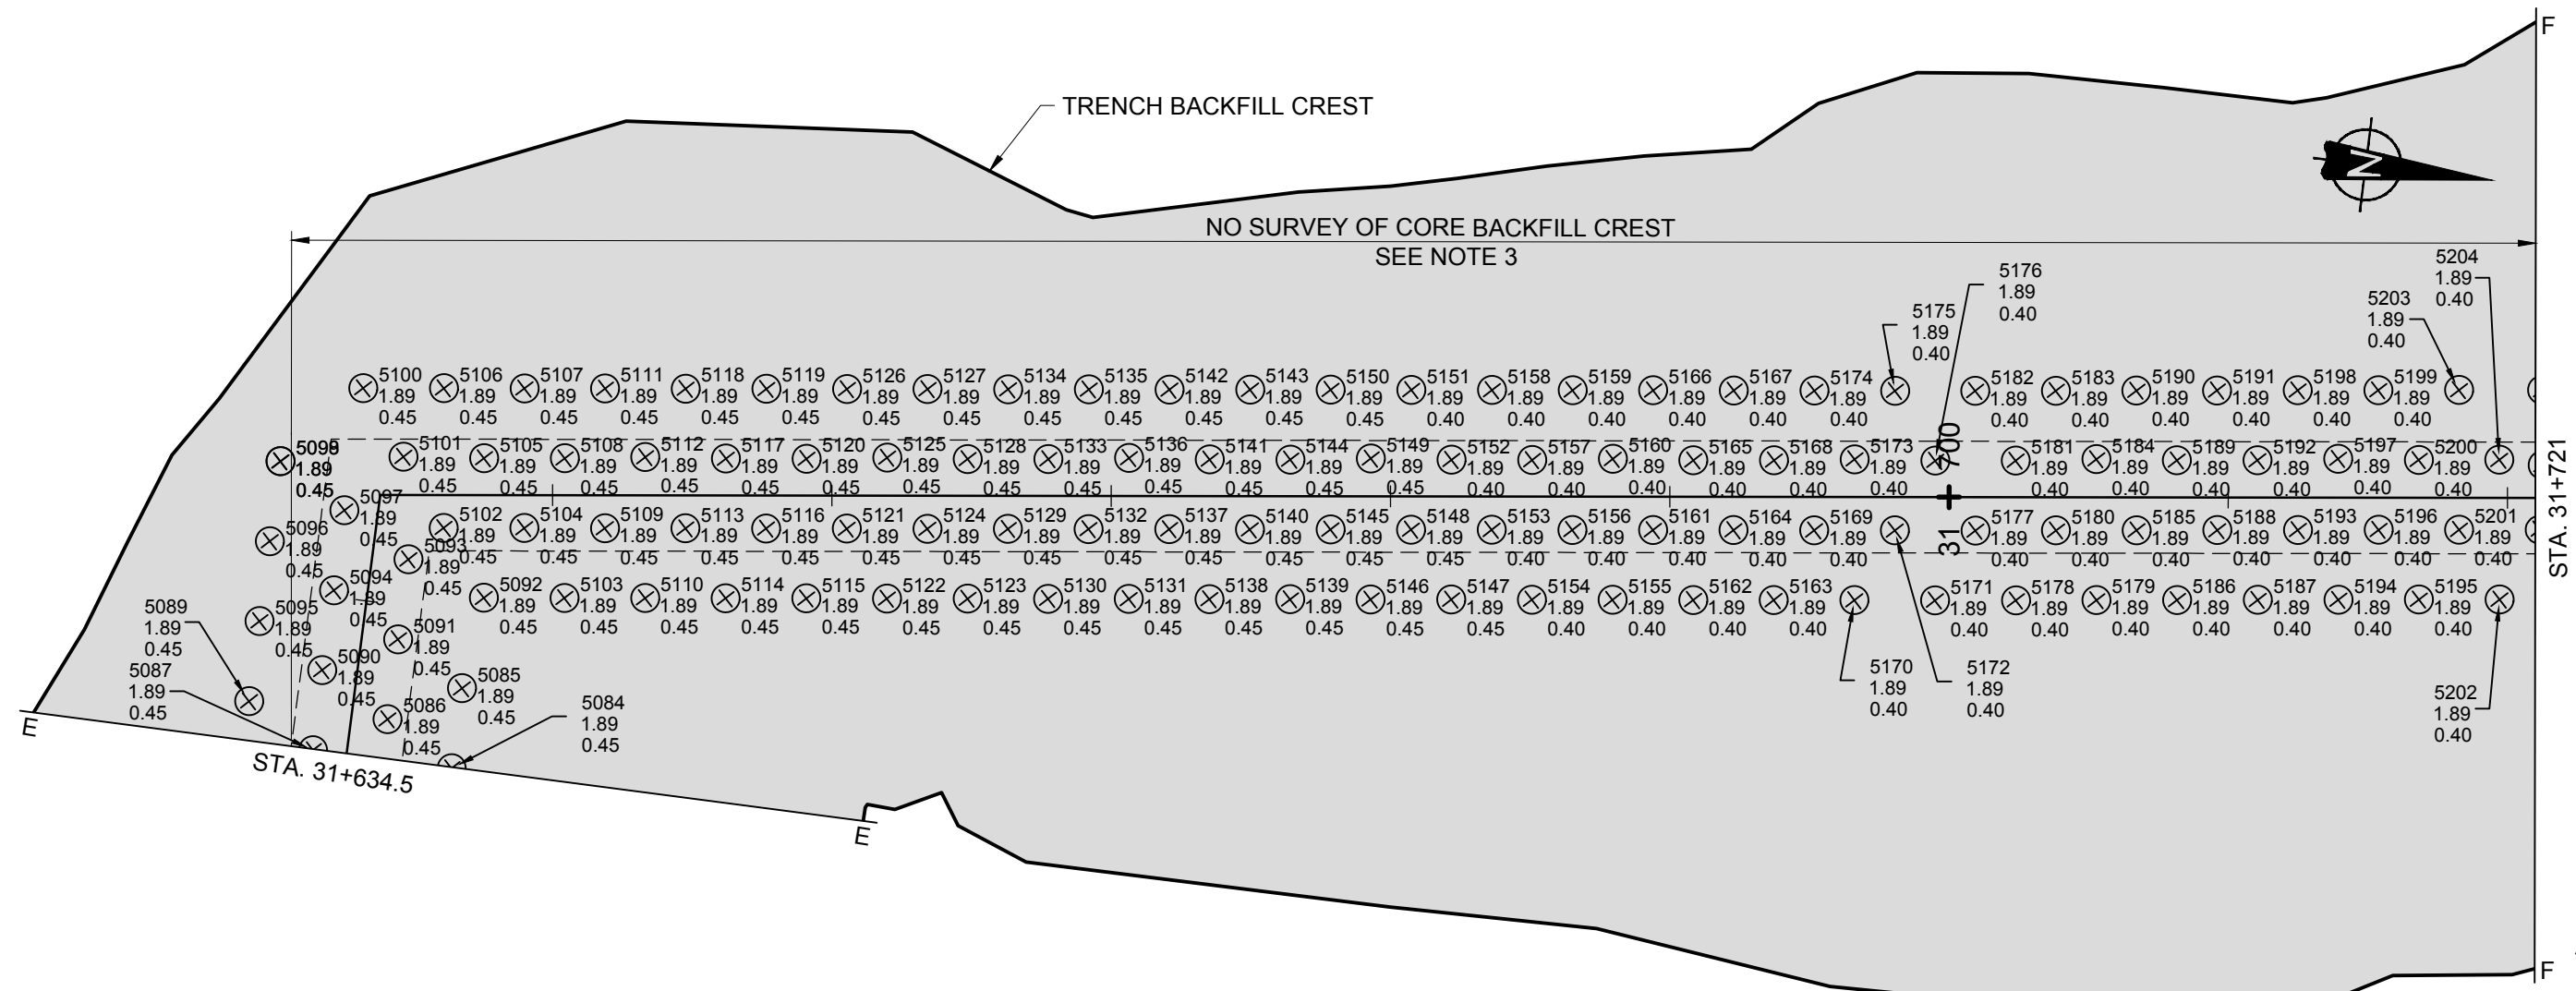

LEGEND

1001

×

1.01

3.15

CRATER NUMBER
CRATER DEPTH
CRATER DIAMETER

○

PHASE 4 CRATER (NOT TO SCALE)

CORE BACKFILL

TRENCH BACKFILL LIMIT

ASSUMED CORE BACKFILL CREST


- NOTES
1.

ALL DIMENSIONS ARE IN METRES UNLESS OTHERWISE NOTED.
2.

DYNAMIC COMPACTION SURVEY PROVIDED BY GEOPAC TECH INC.
3.

CORE BACKFILL CREST SURVEY NOT AVAILABLE WHERE NOTED, CORE BACKFILL ASSUMED 2.0m FROM CENTERLINE.
4.

COMPLETE DENSIFICATION PLATFORM SURVEY NOT AVAILABLE.

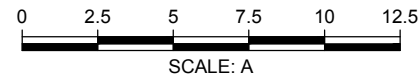

PROJECT

AEM

AGNICO-EAGLE MINES LIMITED
MEADOWBANK GOLD PROJECT
NUNAVUT

TITLE

BAY-GOOSE DIKE SOUTH PORTION
DENSIFICATION PLAN - PHASE 4 (3 OF 4)



Golder

Associates

PROJECT No.

09-1428-5007

DESIGN

FA

15FEB12

CADD

JD

15FEB12

CHECK

GRB

15DEC12

REVIEW

FE

15DEC12

FILE No.

4300_0_52

SCALE



AS SHOWN

REV.

0

4300-52

DRAWING NO.			
REFERENCES			
REV			
DATE			
DES			
AS-BUILT			
JD			
GRB			
FE			
CADD			
CHK			
RVW			

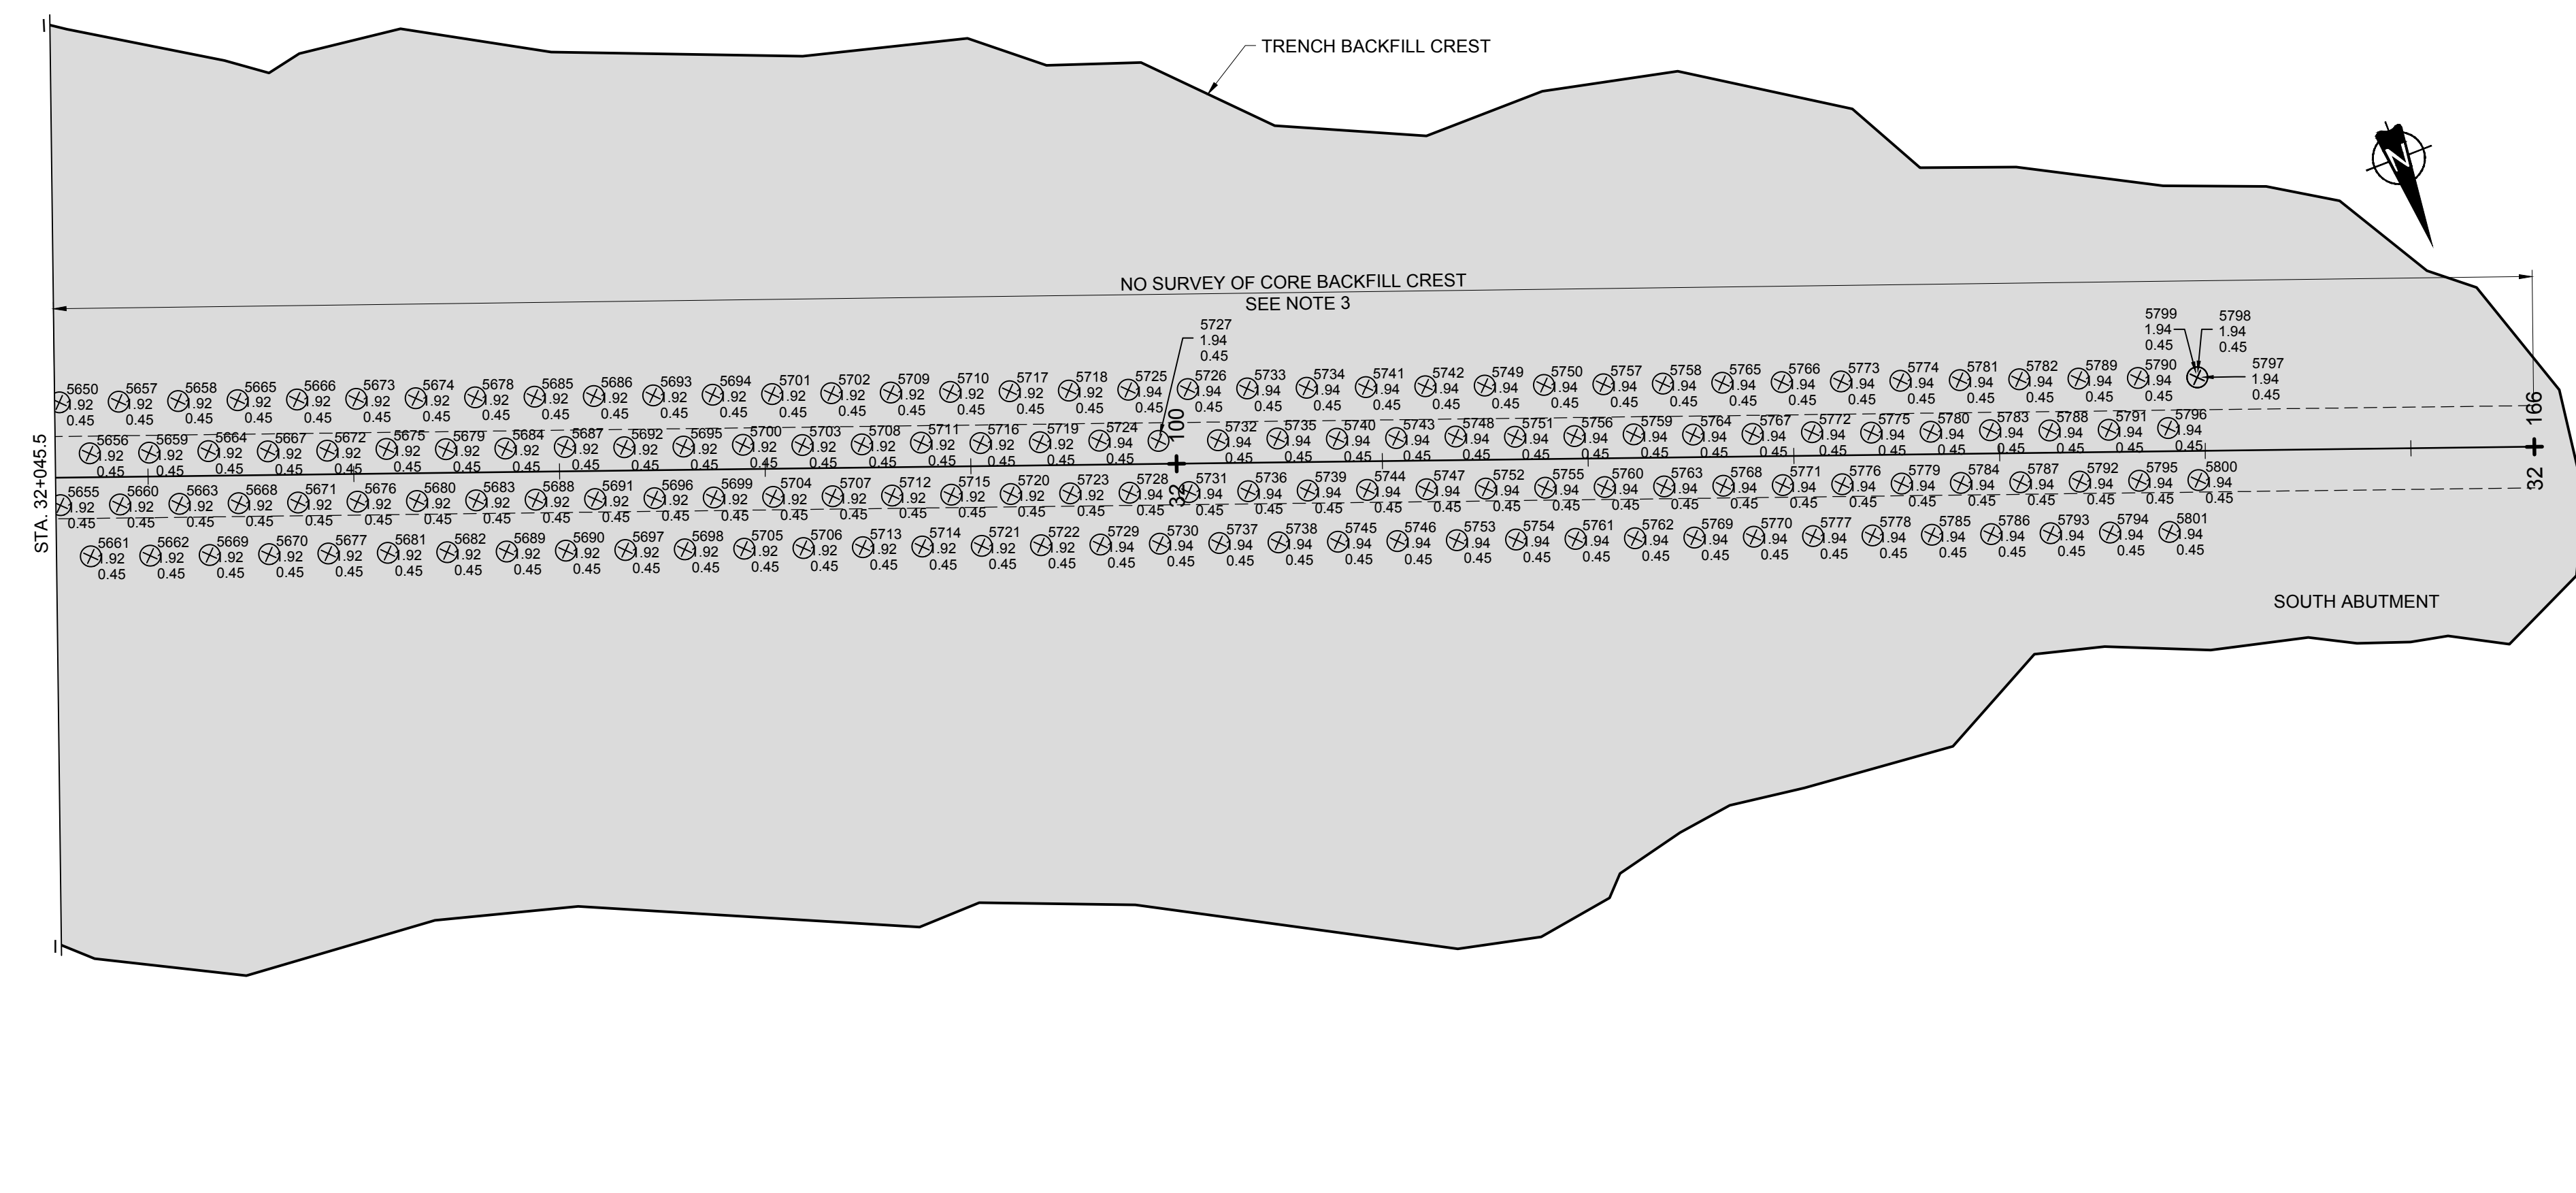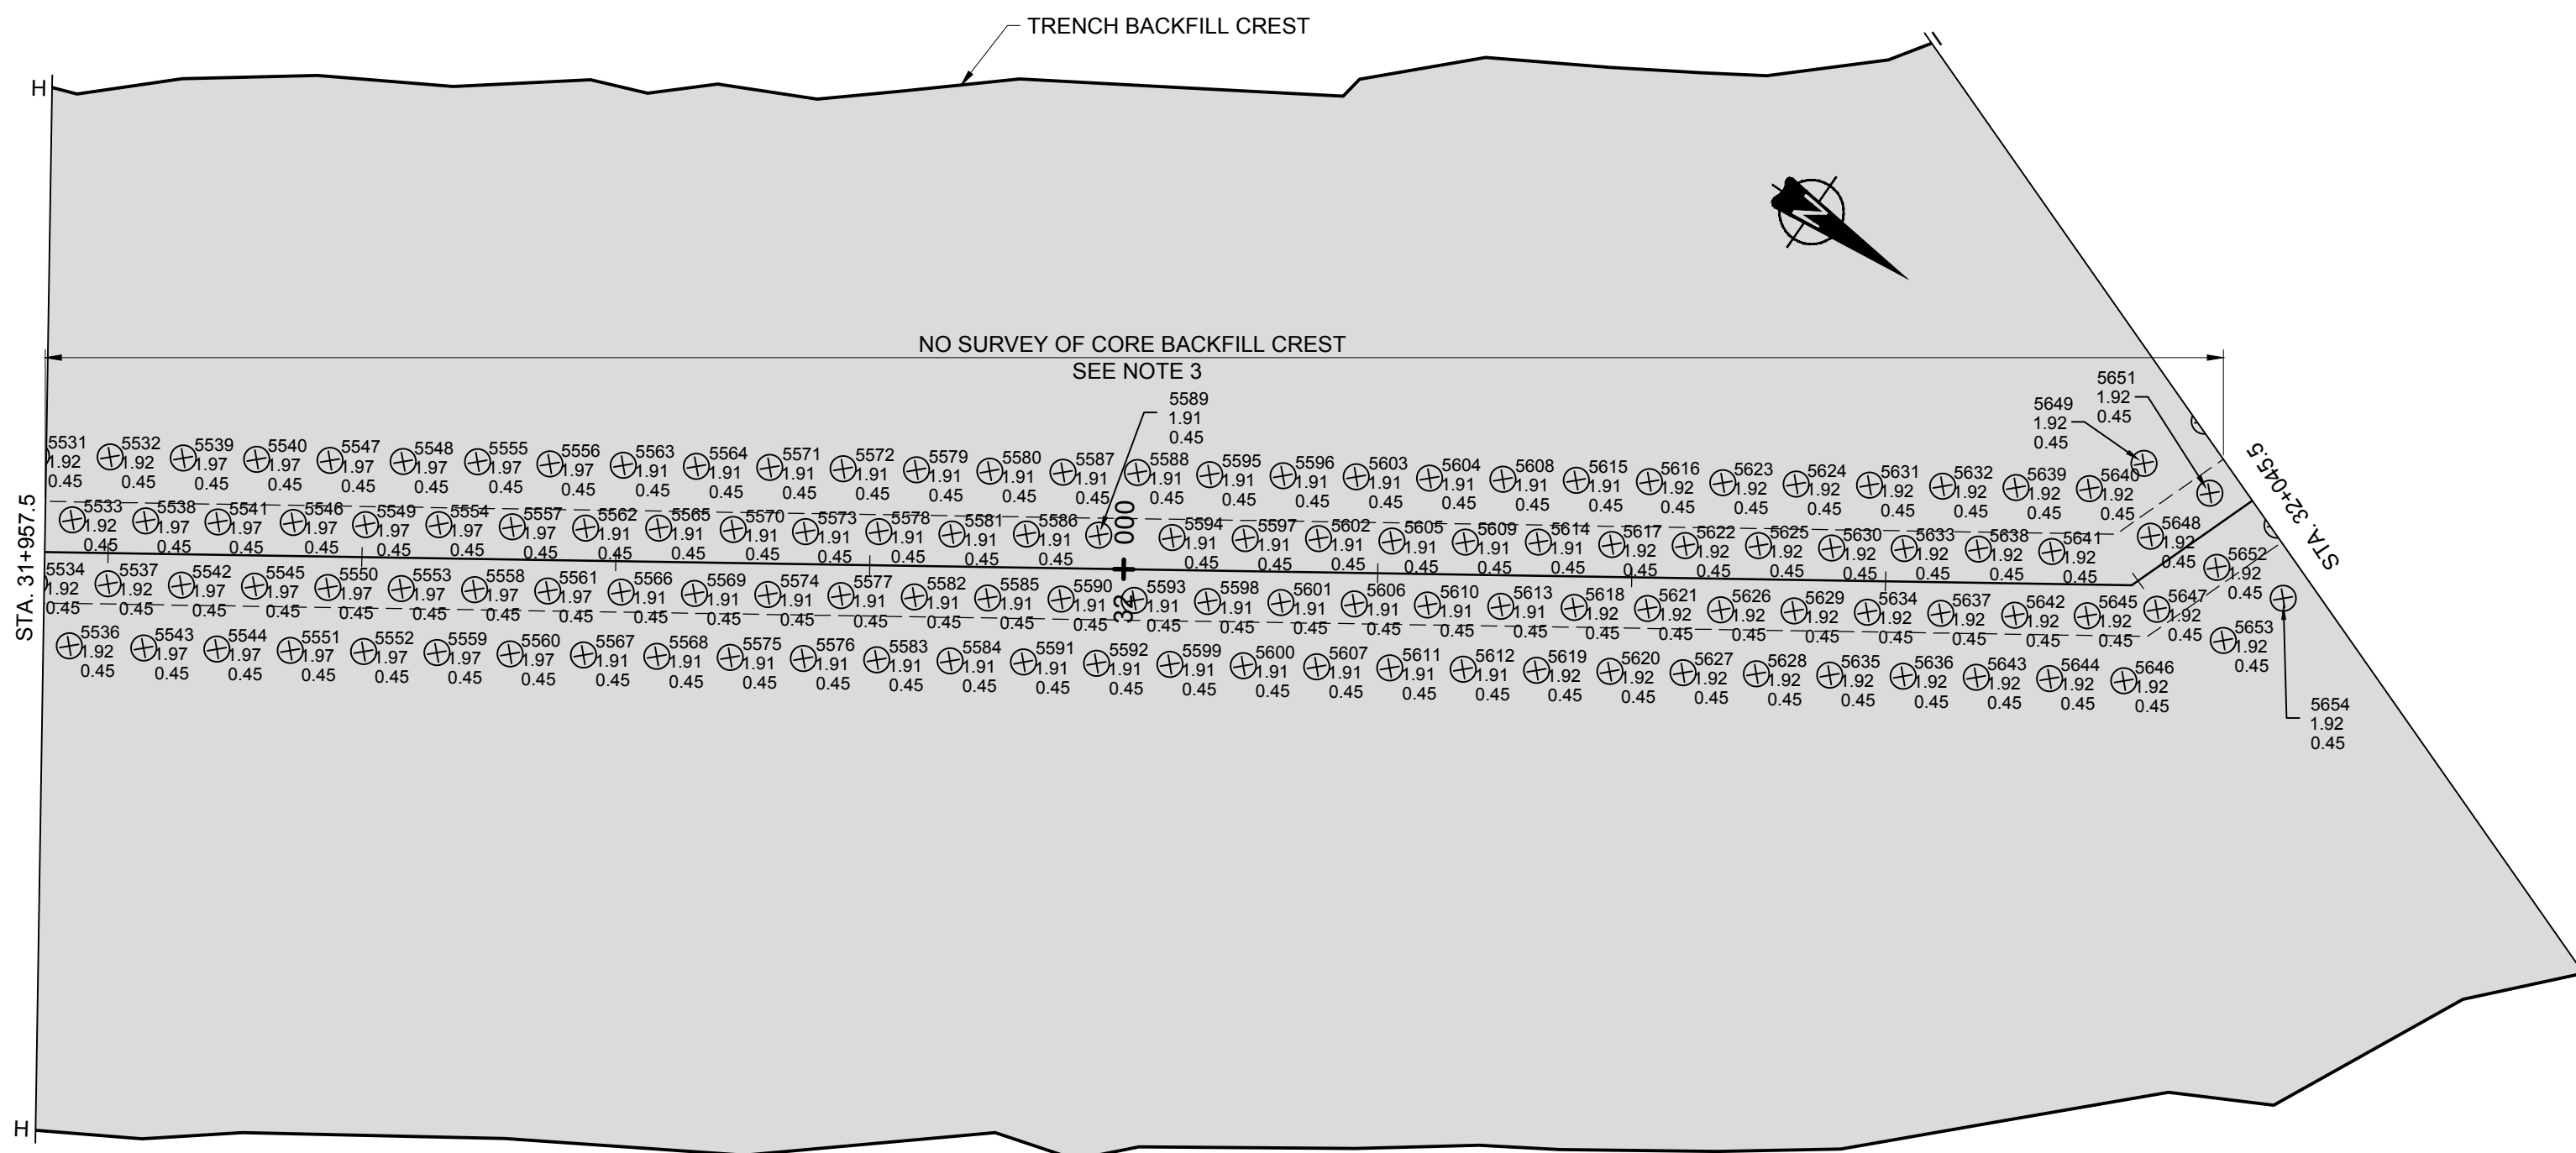

LEGEND	
1001	CRATER NUMBER
x 1.01	CRATER DEPTH
3.15	CRATER DIAMETER
	PHASE 4 CRATER (NOT TO SCALE)
	CORE BACKFILL
	TRENCH BACKFILL LIMIT
----	ASSUMED CORE BACKFILL CREST
NOTES	

NOTES

1. ALL DIMENSIONS ARE IN METRES UNLESS OTHERWISE NOTED.
2. DYNAMIC COMPACTION SURVEY PROVIDED BY GEOPAC TECH INC.
3. CORE BACKFILL CREST SURVEY NOT AVAILABLE WHERE NOTED, CORE BACKFILL ASSUMED 2.0m FROM CENTERLINE.
4. COMPLETE DENSIFICATION PLATFORM SURVEY NOT AVAILABLE.

[illegible]

PROJECT

AEM

AGNICO-EAGLE MINES LIMITED
MEADOWBANK GOLD PROJECT
NUNAVUT

TITLE

BAY-GOOSE DIKE SOUTH PORTION
DENSIFICATION PLAN - PHASE 4 (4 OF 4)



Golder

Associates

PROJECT No.

09-1428-5007

DESIGN

FA

15FB812

CADD

JD

15FB812

CHECK

GRB

15DEC12

REVIEW

FE

15DEC12

FILE No.

4300_0_53

SCALE





AS SHOWN

REV.

0

4300-53


Drawing File: N:\bur-graphics\Projects\2009\1428\09-1428-5007\Drafting\4000\meadowbank - bay-goose (south) dike as-built\4300_0_54.dwg Layout: VIBRO COMPACTION PLAN Wednesday, April 03, 2013 10:31:35 AM By: TYKlassen

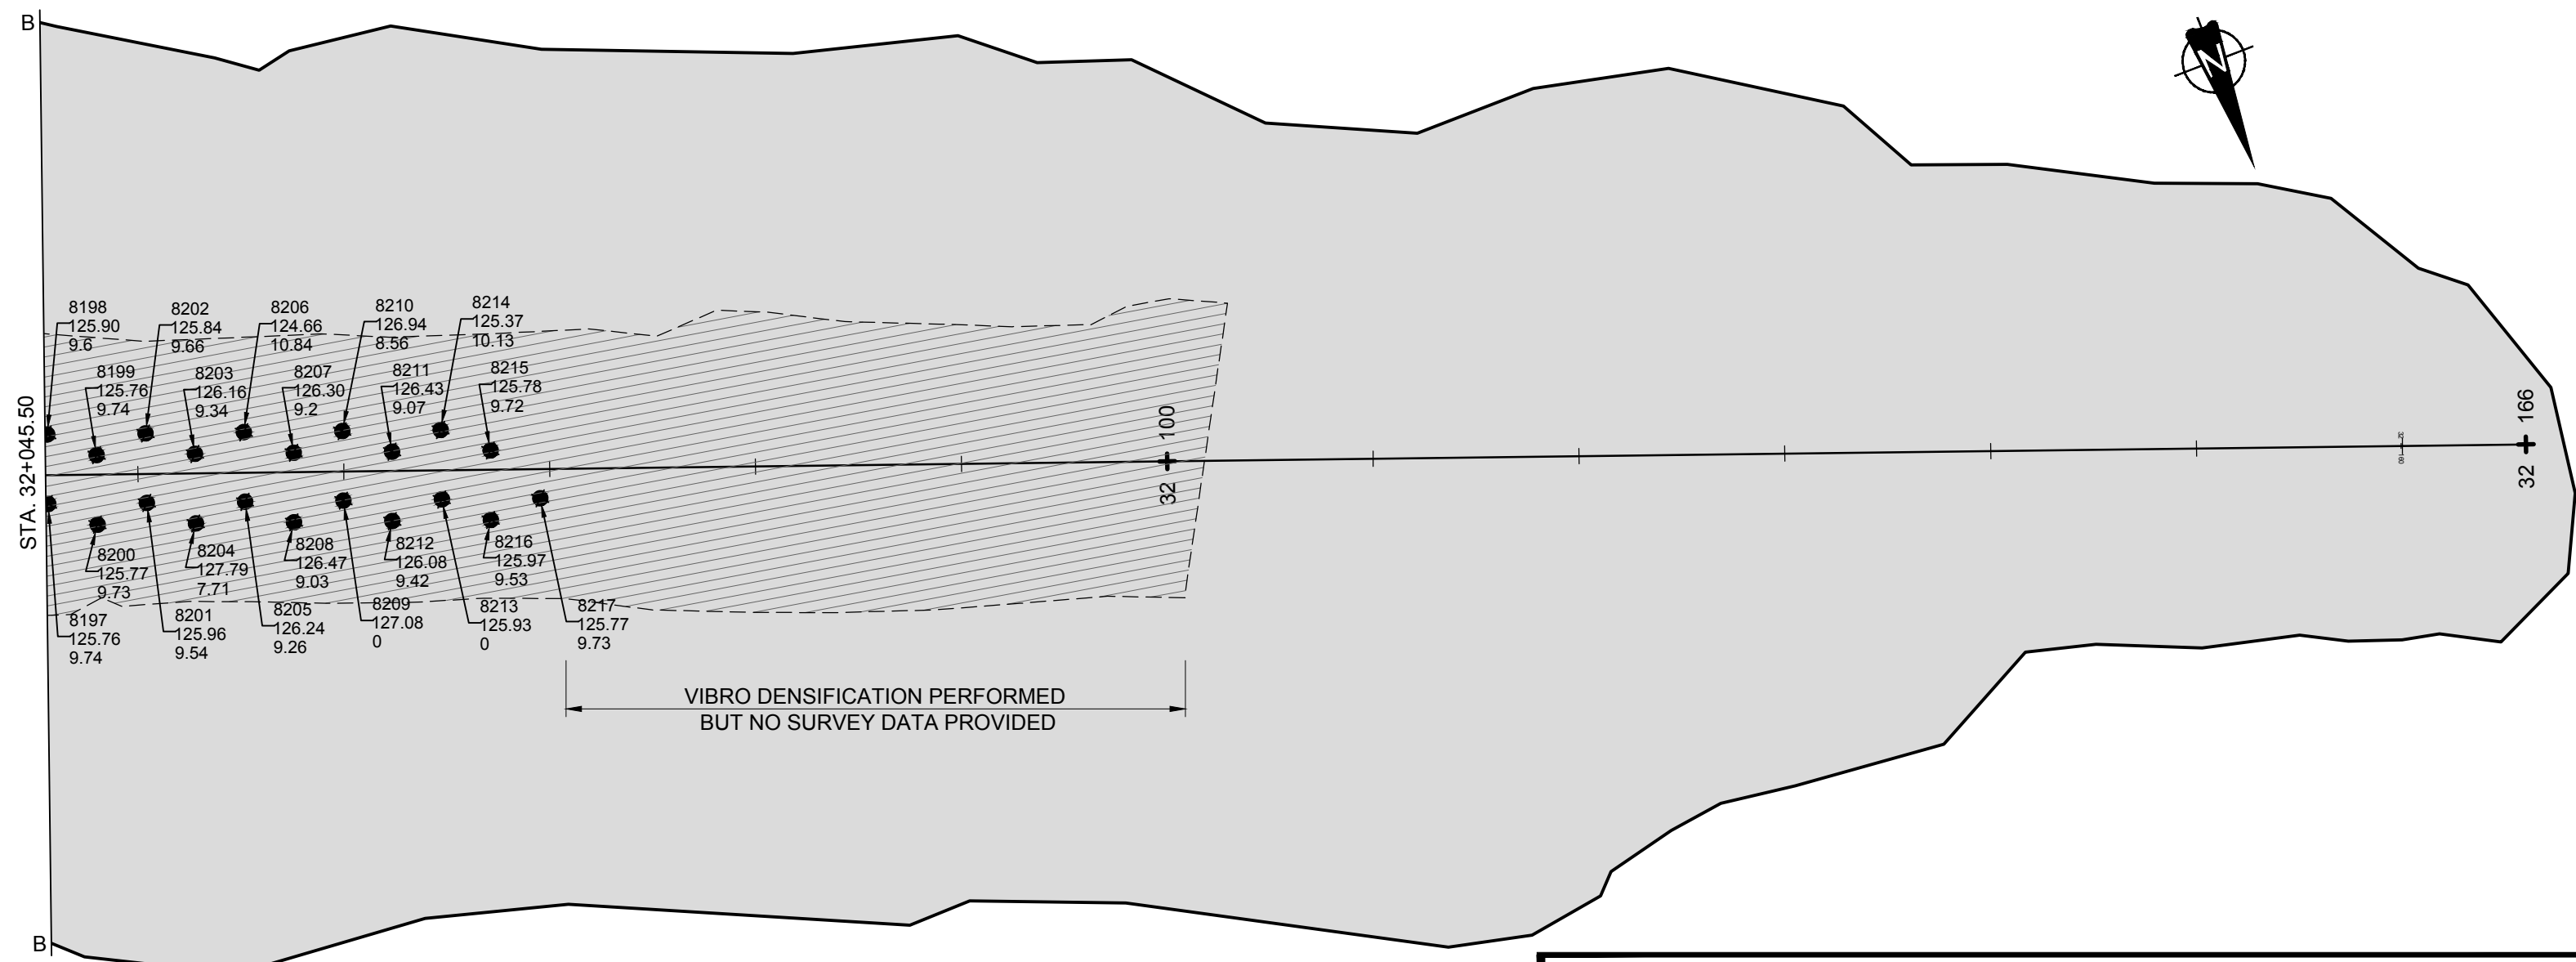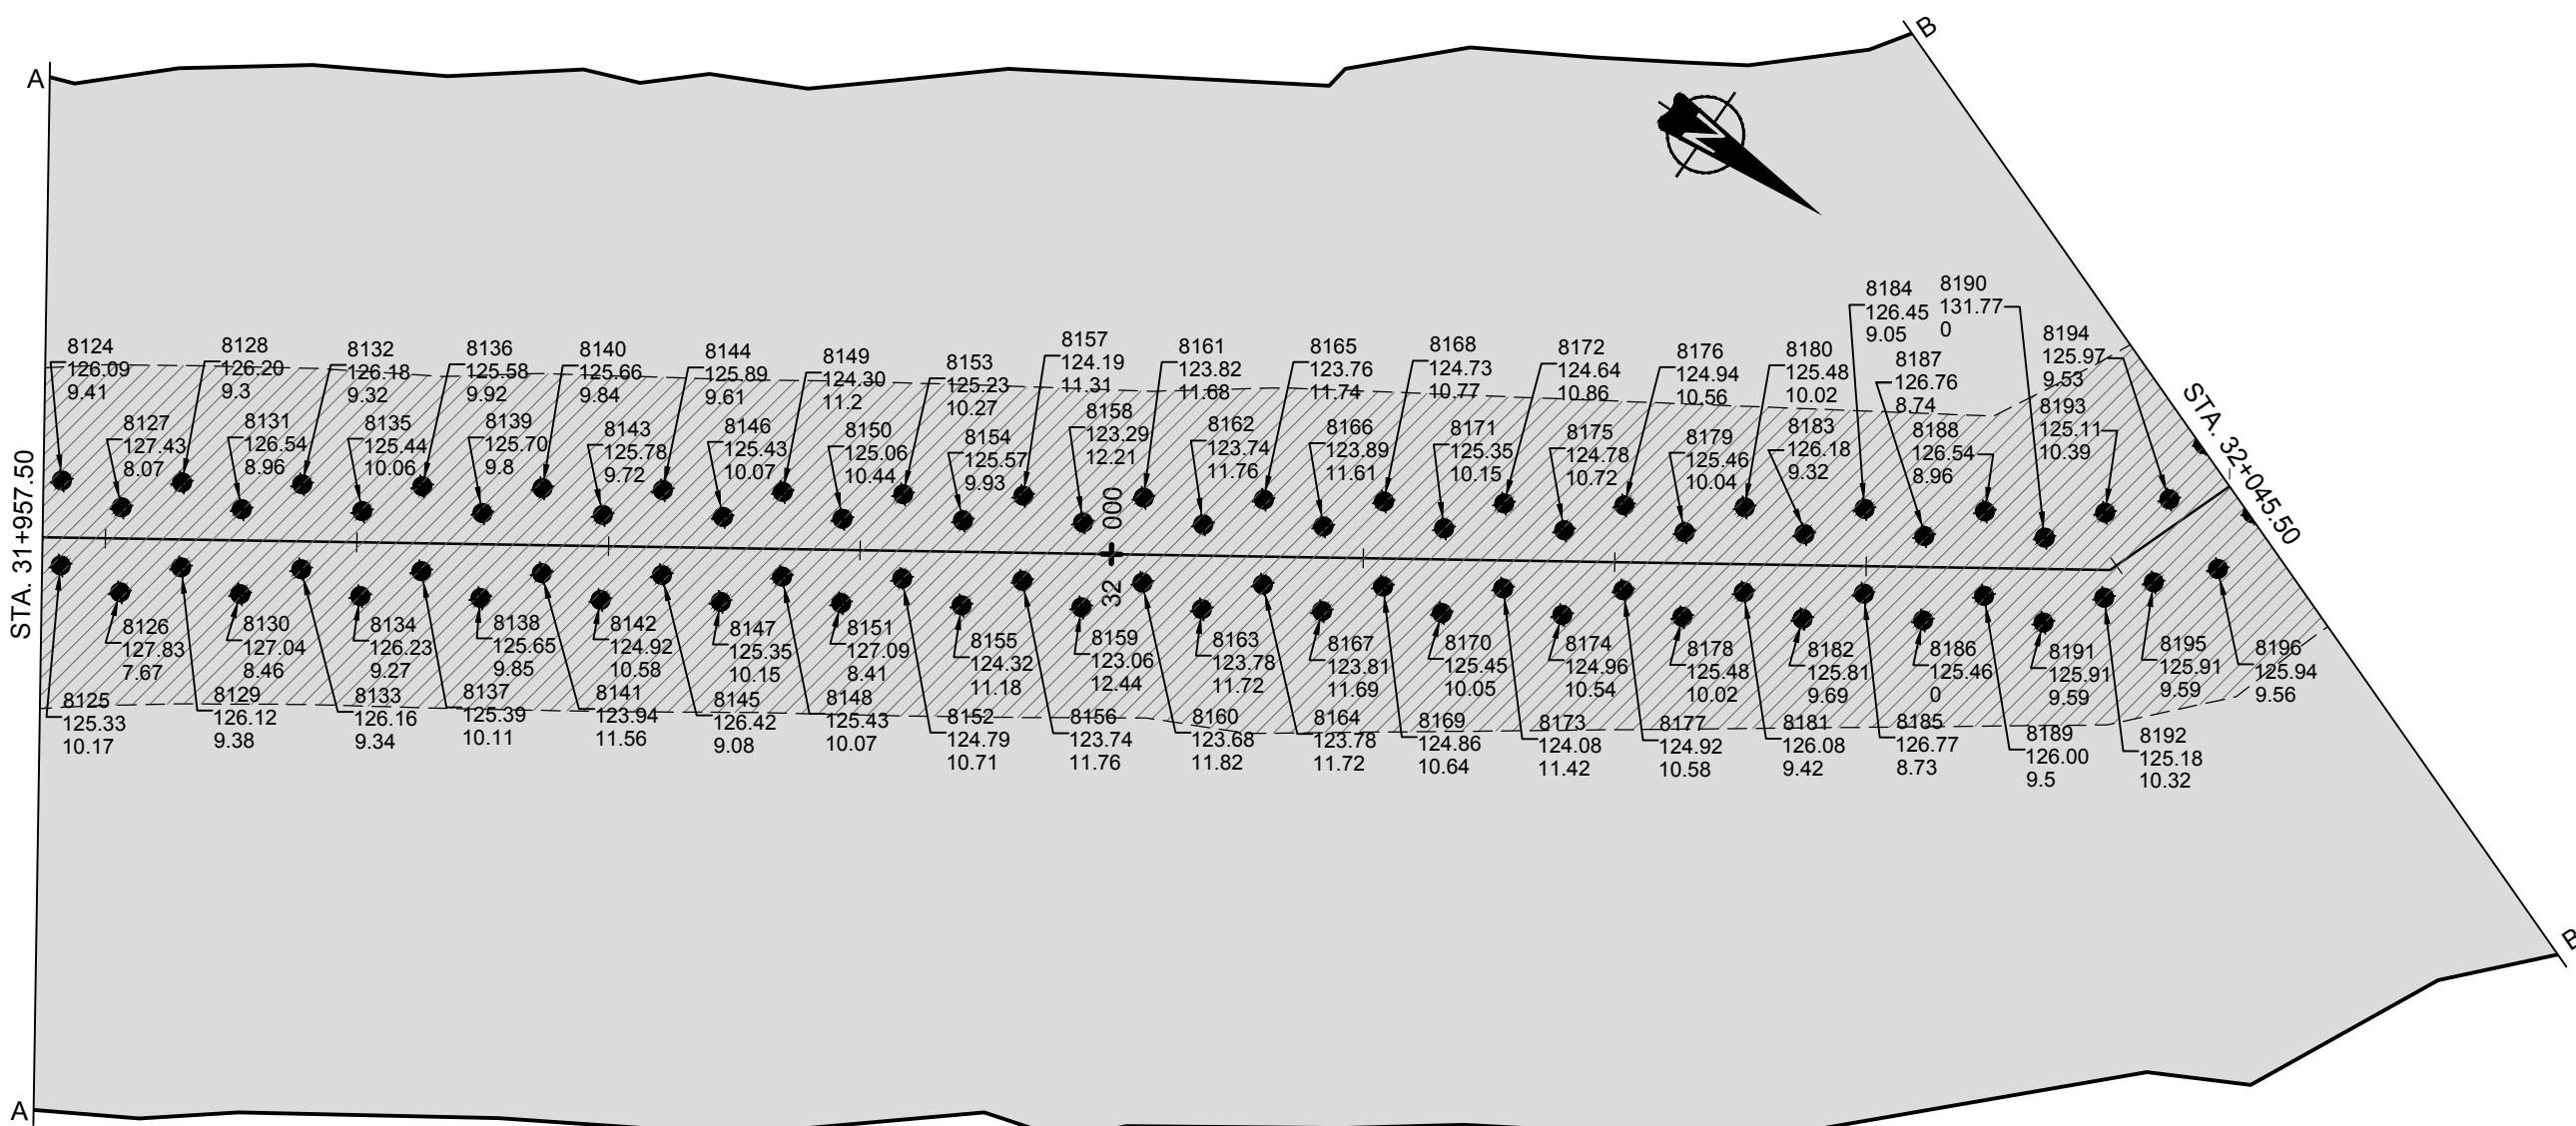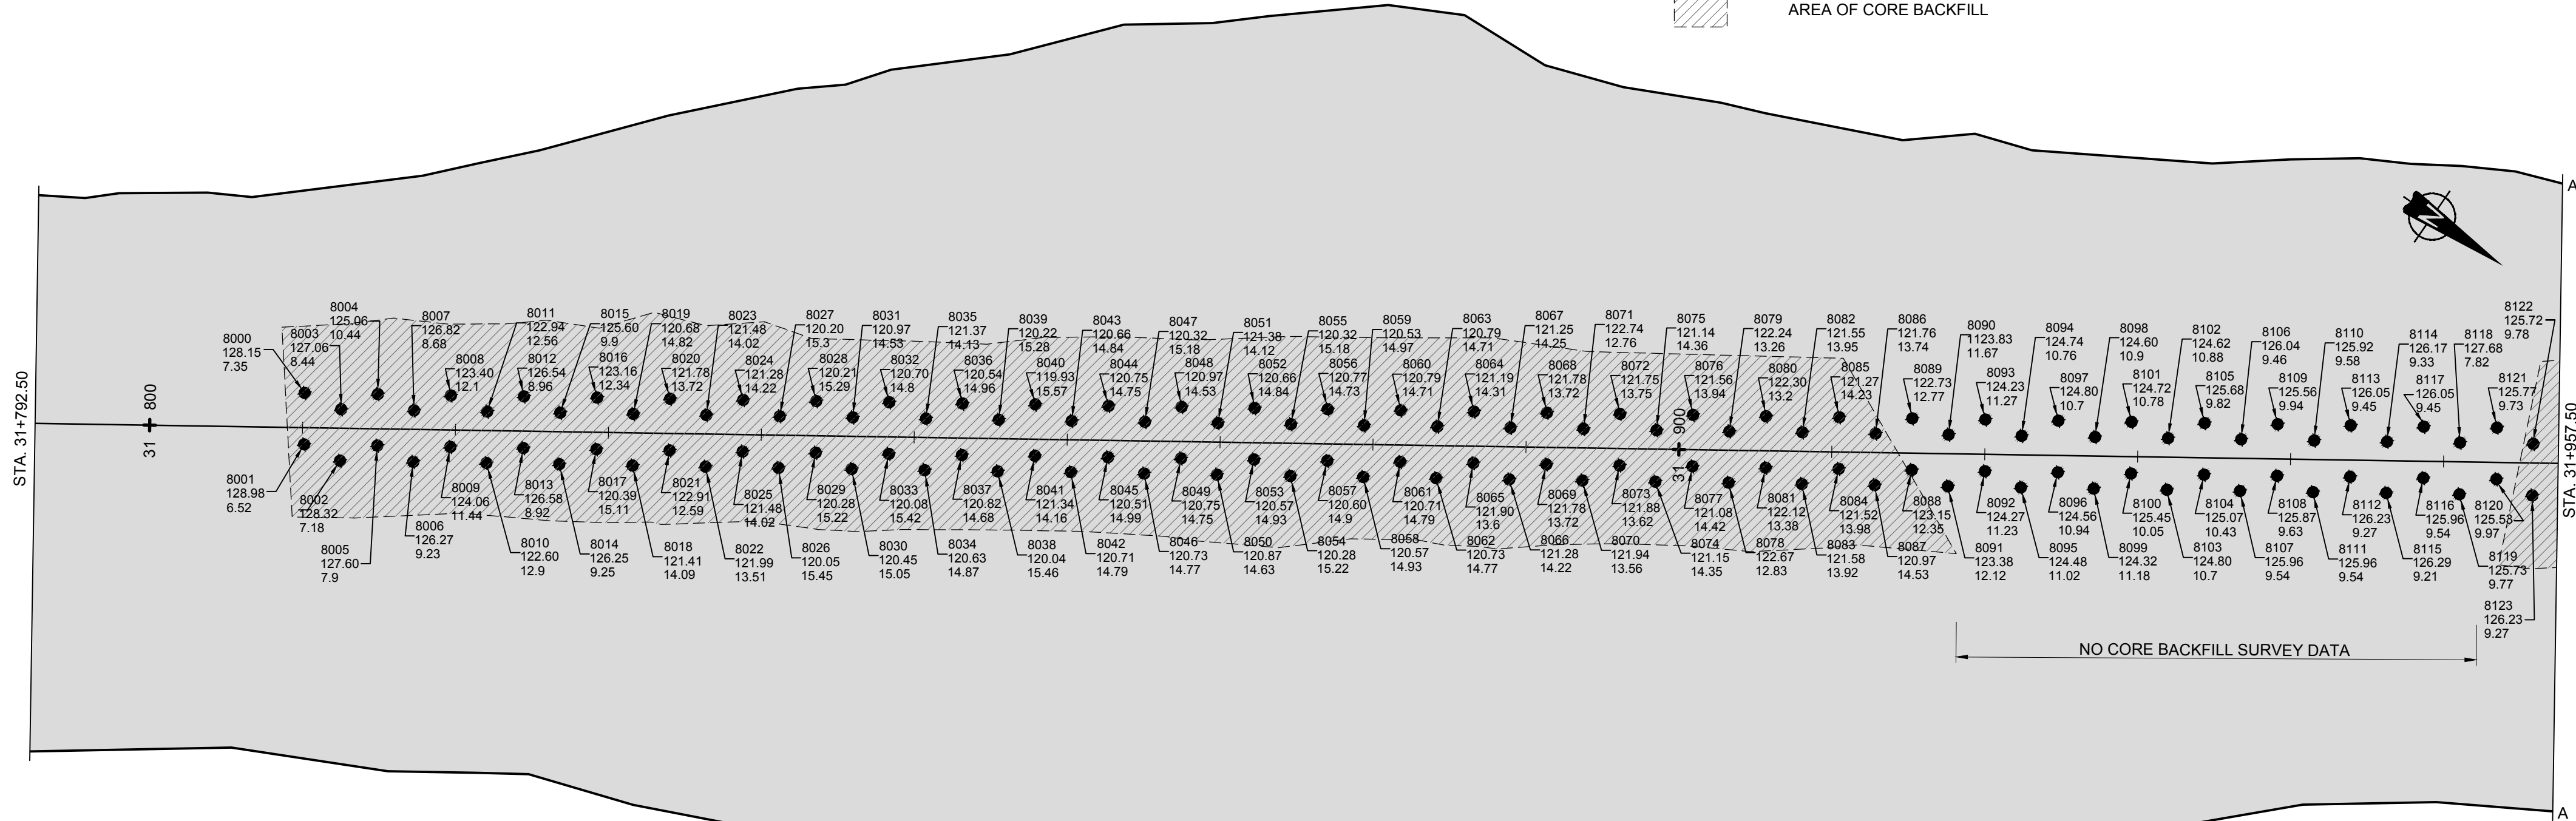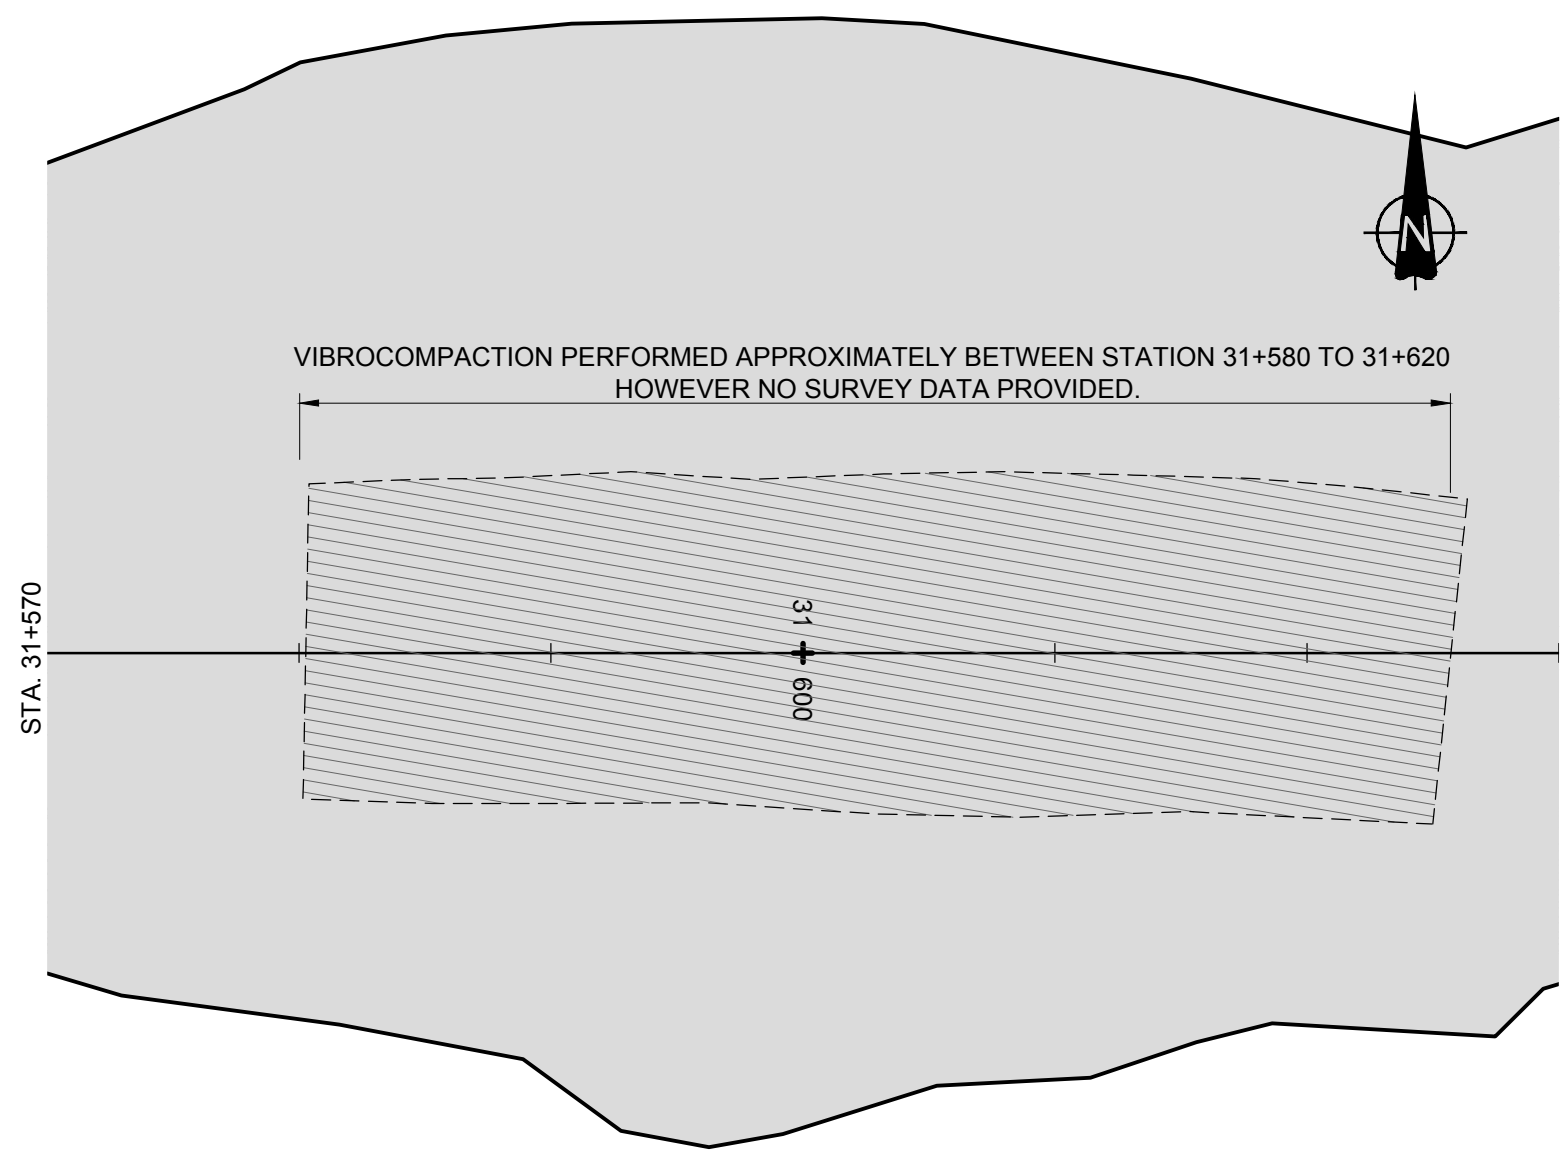

LEGEND

- 8000 COLUM ID
- 128.95 MAX ELEVATION OF COMPACTION
- 7.35 TOTAL LENGTH COMPACTION
- COLUMN
- TRENCH BACKFILL LIMIT
- AREA OF CORE BACKFILL

- NOTES**
- VIBRO-COMPACTION SURVEY PROVIDED BY GEOPAC TECH INC.
 - VIBRO-DENSIFICATION (COMPACTION) PERFORMED FROM INITIAL DIKE CREST ELEVATION 134.6.
 - CORE BACKFILL ZONE INCREASED FOR VIBRO-DENSIFICATION.
 - ALL DIMENSIONS ARE IN METRES UNLESS OTHERWISE NOTED.

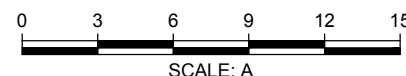

PROJECT	AEM	AGNICO-EAGLE MINES LIMITED MEADOWBANK GOLD PROJECT NUNAVUT			
		BAY-GOOSE DIKE SOUTH PORTION VIBRO COMPACTION PLAN			
TITLE	PROJECT No.		09-1428-5007		FILE No.
	DESIGN		JU		02MAY10
	CADD		EA		10MAY10
	CHECK		GRB		15DEC12
STAMP	REVIEW		FE		15DEC12
	AS-BUILT		JD		GRB
	REVISION DESCRIPTION		CADD		CHK
			RVW		



PROJECT No.	09-1428-5007	FILE No.	4300_0_54
DESIGN	JU	SCALE	AS SHOWN
CADD	EA	REV.	0
CHECK	GRB		
REVIEW	FE		

4300-54