




KEY PLAN

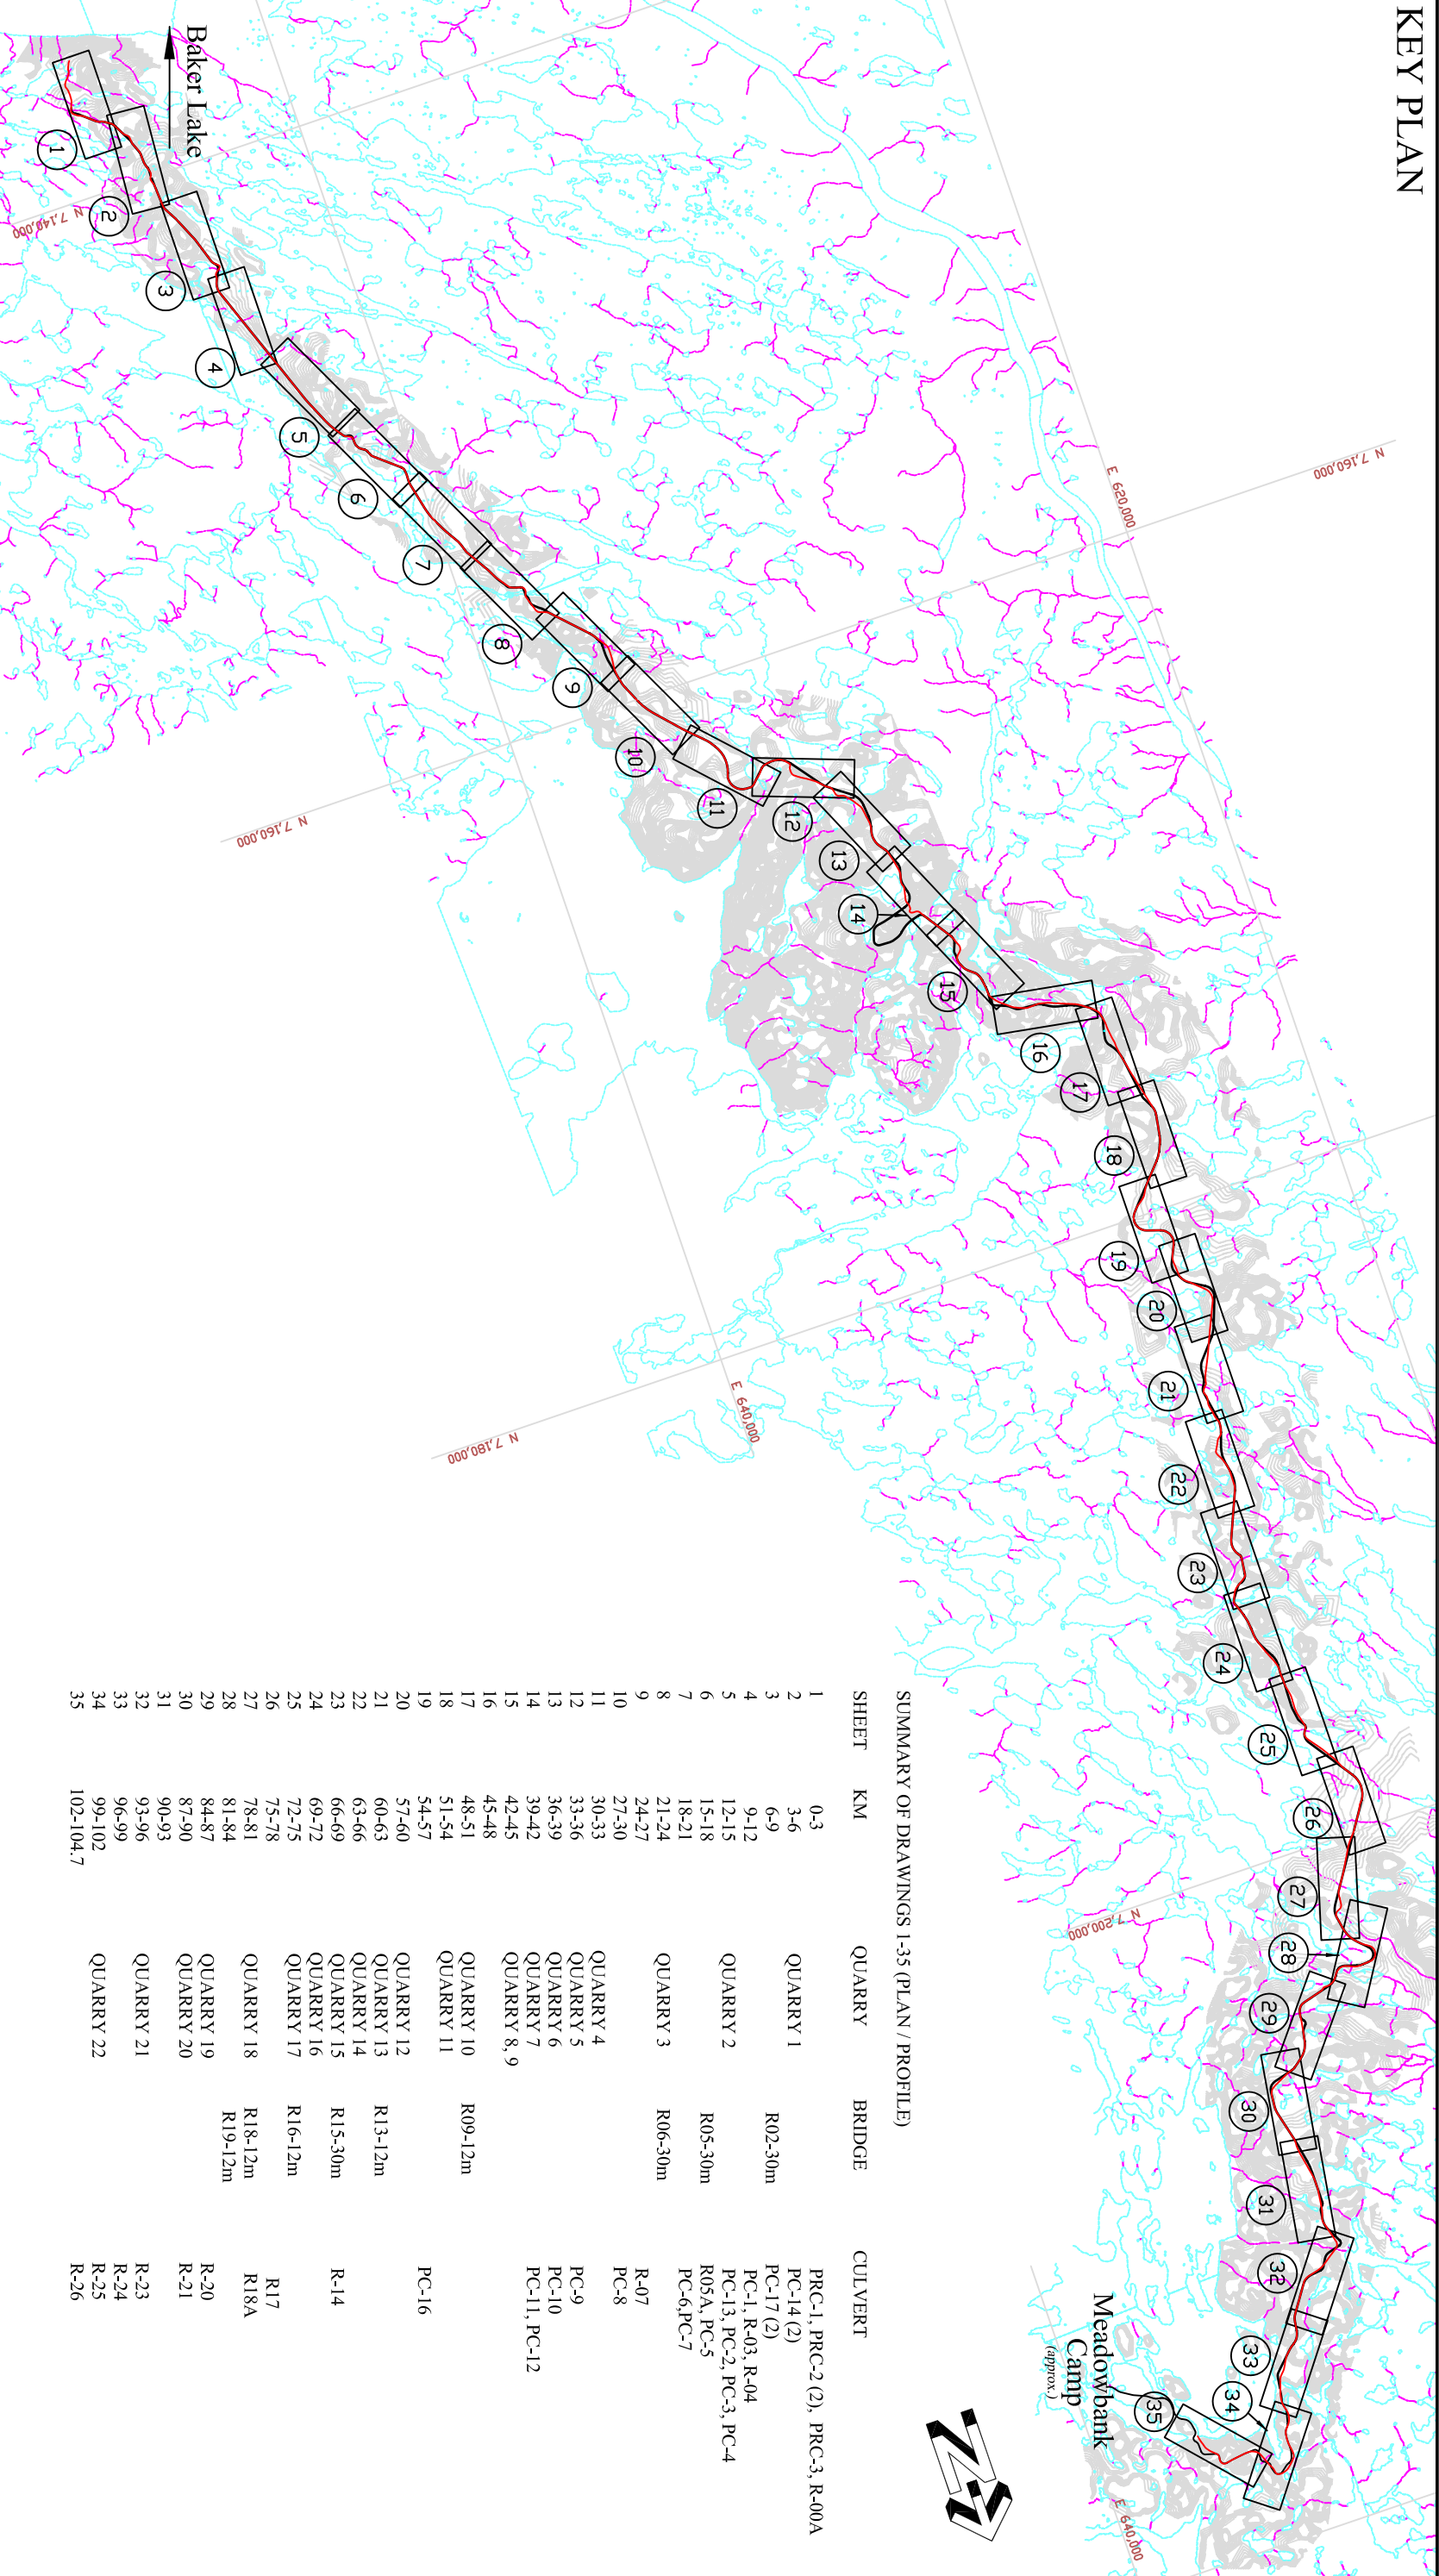

SUMMARY OF DRAWINGS 1-35 (PLAN / PROFILE)

SHEET	KM	QUARRY	BRIDGE	CULVERT
1	0-3			PRC-1, PRC-2 (2), PRC-3, R-00A
2	3-6	QUARRY 1		PC-14 (2)
3	6-9		R02-30m	PC-17 (2)
4	9-12			PC-1, R-03, R-04
5	12-15	QUARRY 2		PC-13, PC-2, PC-3, PC-4
6	15-18		R05-30m	R05A, PC-5
7	18-21			PC-6, PC-7
8	21-24	QUARRY 3	R06-30m	R-07
9	24-27			PC-8
10	27-30			PC-9
11	30-33	QUARRY 4		PC-10
12	33-36	QUARRY 5		PC-11, PC-12
13	36-39	QUARRY 6		
14	39-42	QUARRY 7		
15	42-45	QUARRY 8, 9		
16	45-48			
17	48-51	QUARRY 10	R09-12m	
18	51-54	QUARRY 11		
19	54-57			PC-16
20	57-60	QUARRY 12		
21	60-63	QUARRY 13	R13-12m	
22	63-66	QUARRY 14		
23	66-69	QUARRY 15	R15-30m	R-14
24	69-72	QUARRY 16		
25	72-75	QUARRY 17	R16-12m	
26	75-78			R17
27	78-81	QUARRY 18	R18-12m	R18A
28	81-84		R19-12m	
29	84-87	QUARRY 19		R-20
30	87-90	QUARRY 20		R-21
31	90-93			
32	93-96	QUARRY 21		R-23
33	96-99			R-24
34	99-102			R-25
35	102-104.7	QUARRY 22		R-26

KEY PLAN LEGEND

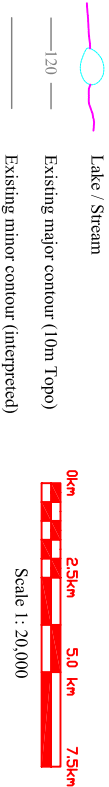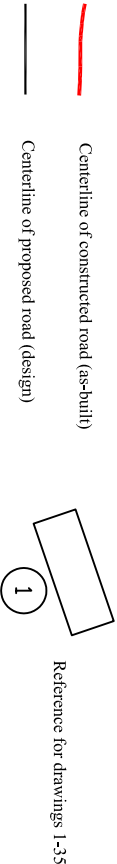

NOTES

1. Coordinate system NAD 83 UTM Zone 14N Geoid HTV2.
2. Golder data supplied by Cumberland/Agnico.
3. For quarry data, please refer to table 1 & Figures 1-6
4. For culvert data, please refer to table 2.
5. For bridge data, please refer to table 3.
6. For typical cross section, please refer to figures 7 & 7A.
7. Station 0+000 N:7135821.224 E:646026.187 refer to table 4.

OWNER

Agnico-Eagle Mines Ltd.

Numavut

PROJECT

Meadowbank Gold Project
Tehék Access Road Construction

TITLE

As constructed drawings - Plan and Profile

M & T SERVICES LTD.

Stationing

0+000 to 104+719

CAD

gc

Sheet

Key Plan

Check

cg/lhb

Date

May 5, 2008