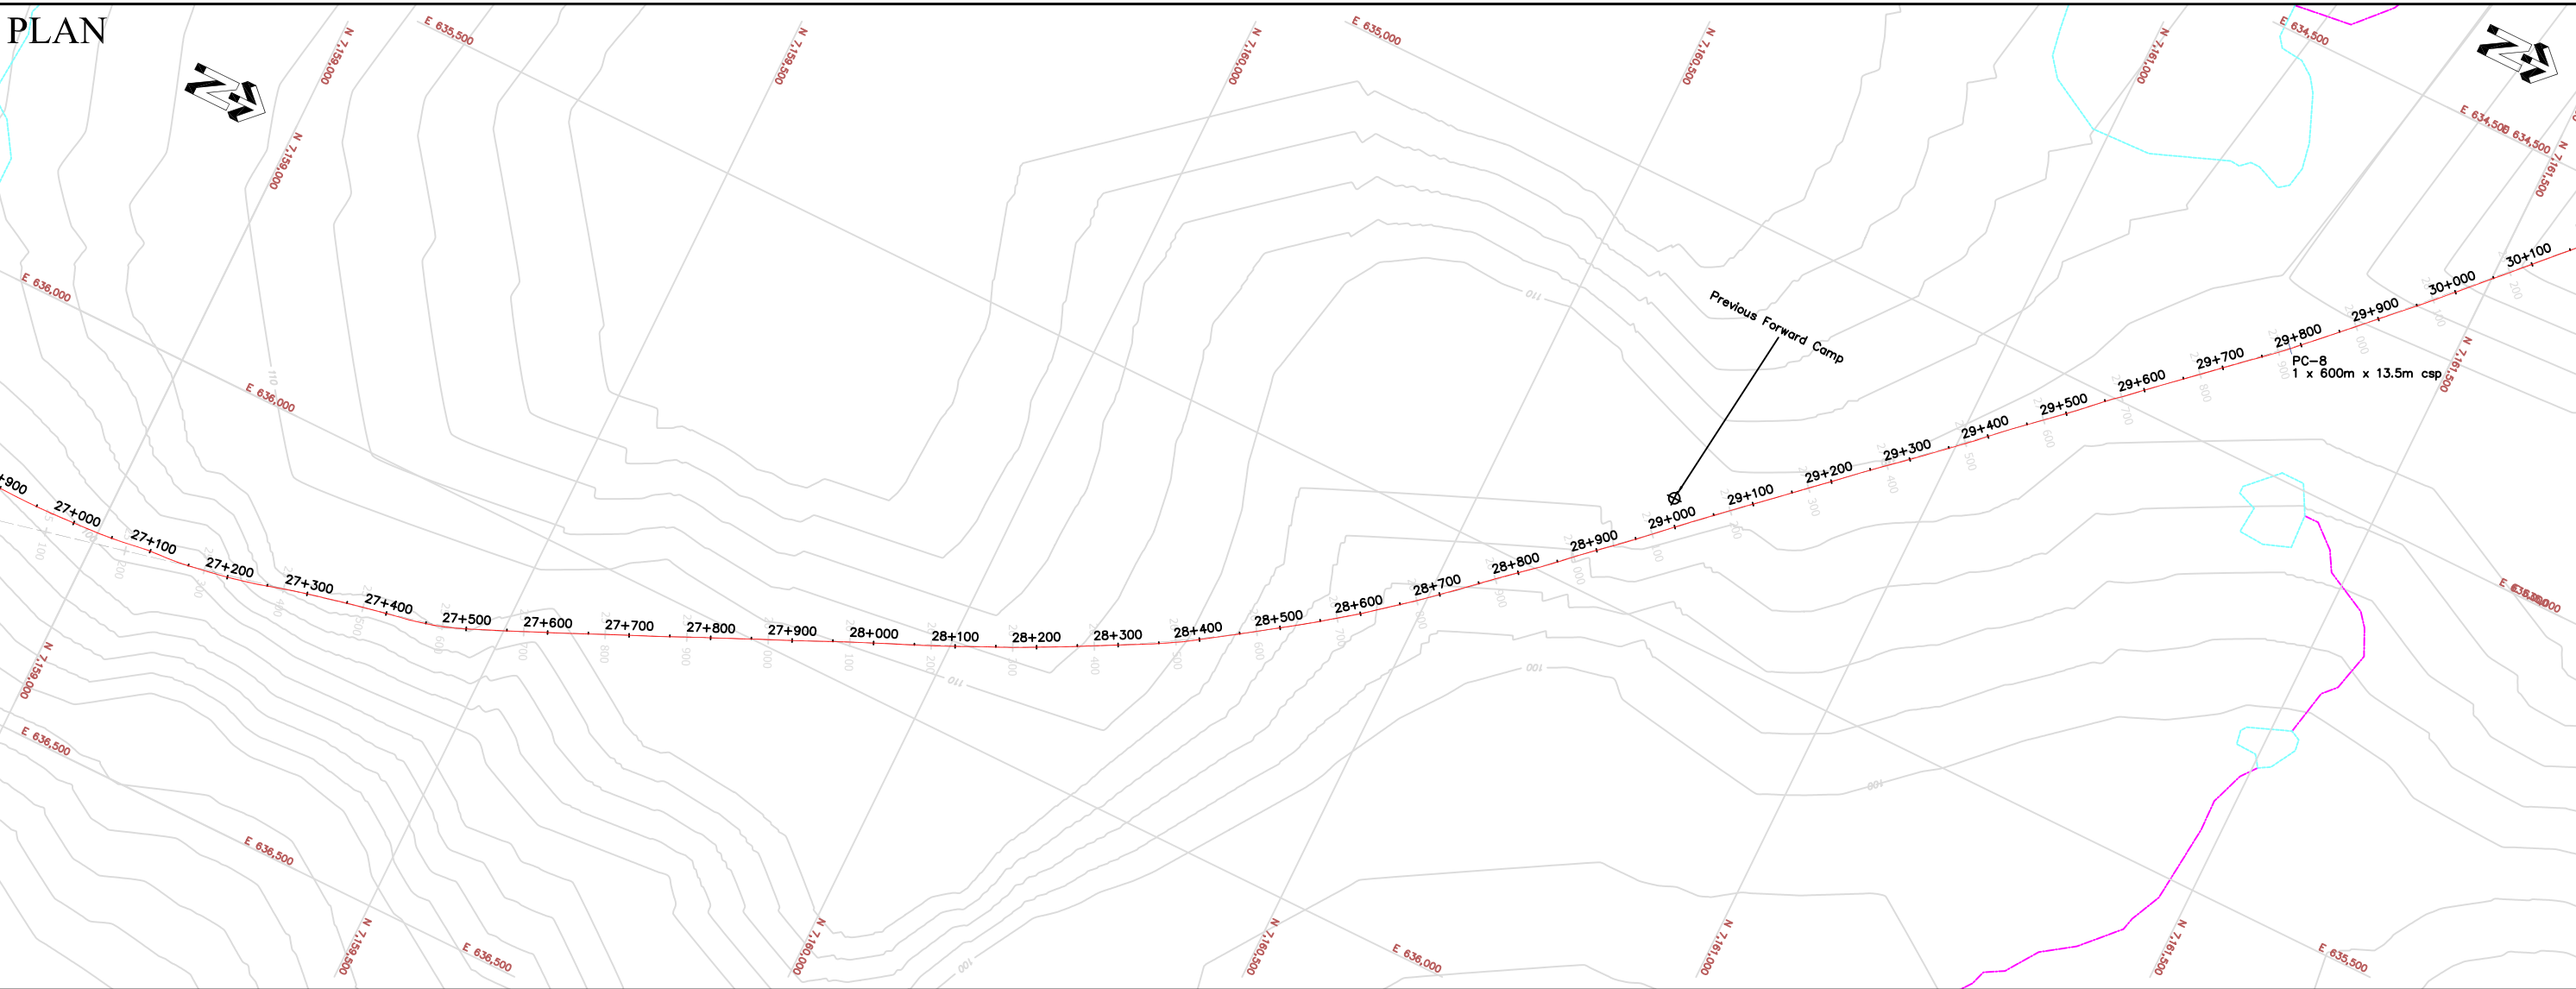


GOLDER DATA			AS CONSTRUCTED DATA			NOTES			OWNER Agnico-Eagle Mines Ltd. Nunavut		
LfLa-3 Existing archeological site			R02 River crossing (crossing structure and dimension)			0+100 Centerline of road with 100m stations			- Coordinate system NAD 83 UTM Zone 14N Geoid HTv2. - Golder data supplied by Cumberland/Agnico. - For quarry data, please refer to table 1. - For culvert data, please refer to table 2. - For bridge data, please refer to table 3.		
Pit-13 Proposed quarry site			120 Existing major contour (10m Topo)			R20 River crossing - culvert 600mm/1200mm dia					
Existing lake/stream			Existing minor contour (interpreted)			R02 River crossing - bridge 12m / 30m length					
Proposed $\frac{1}{2}$ of road alignment			Toe boundary of quarry excavation at bench grade			0m 100m 200m 300m Scale 1: 8000			TITLE As constructed drawings - Plan and Profile		
SUSCEPTIBILITY											
High			Medium-High						Stationing 27+000 to 30+000		
Medium			Low-Medium						Sheet 10 of 35		
Low			Unclassified						Date March 31, 2008		
									CAD gc		
									Check cg/hb		