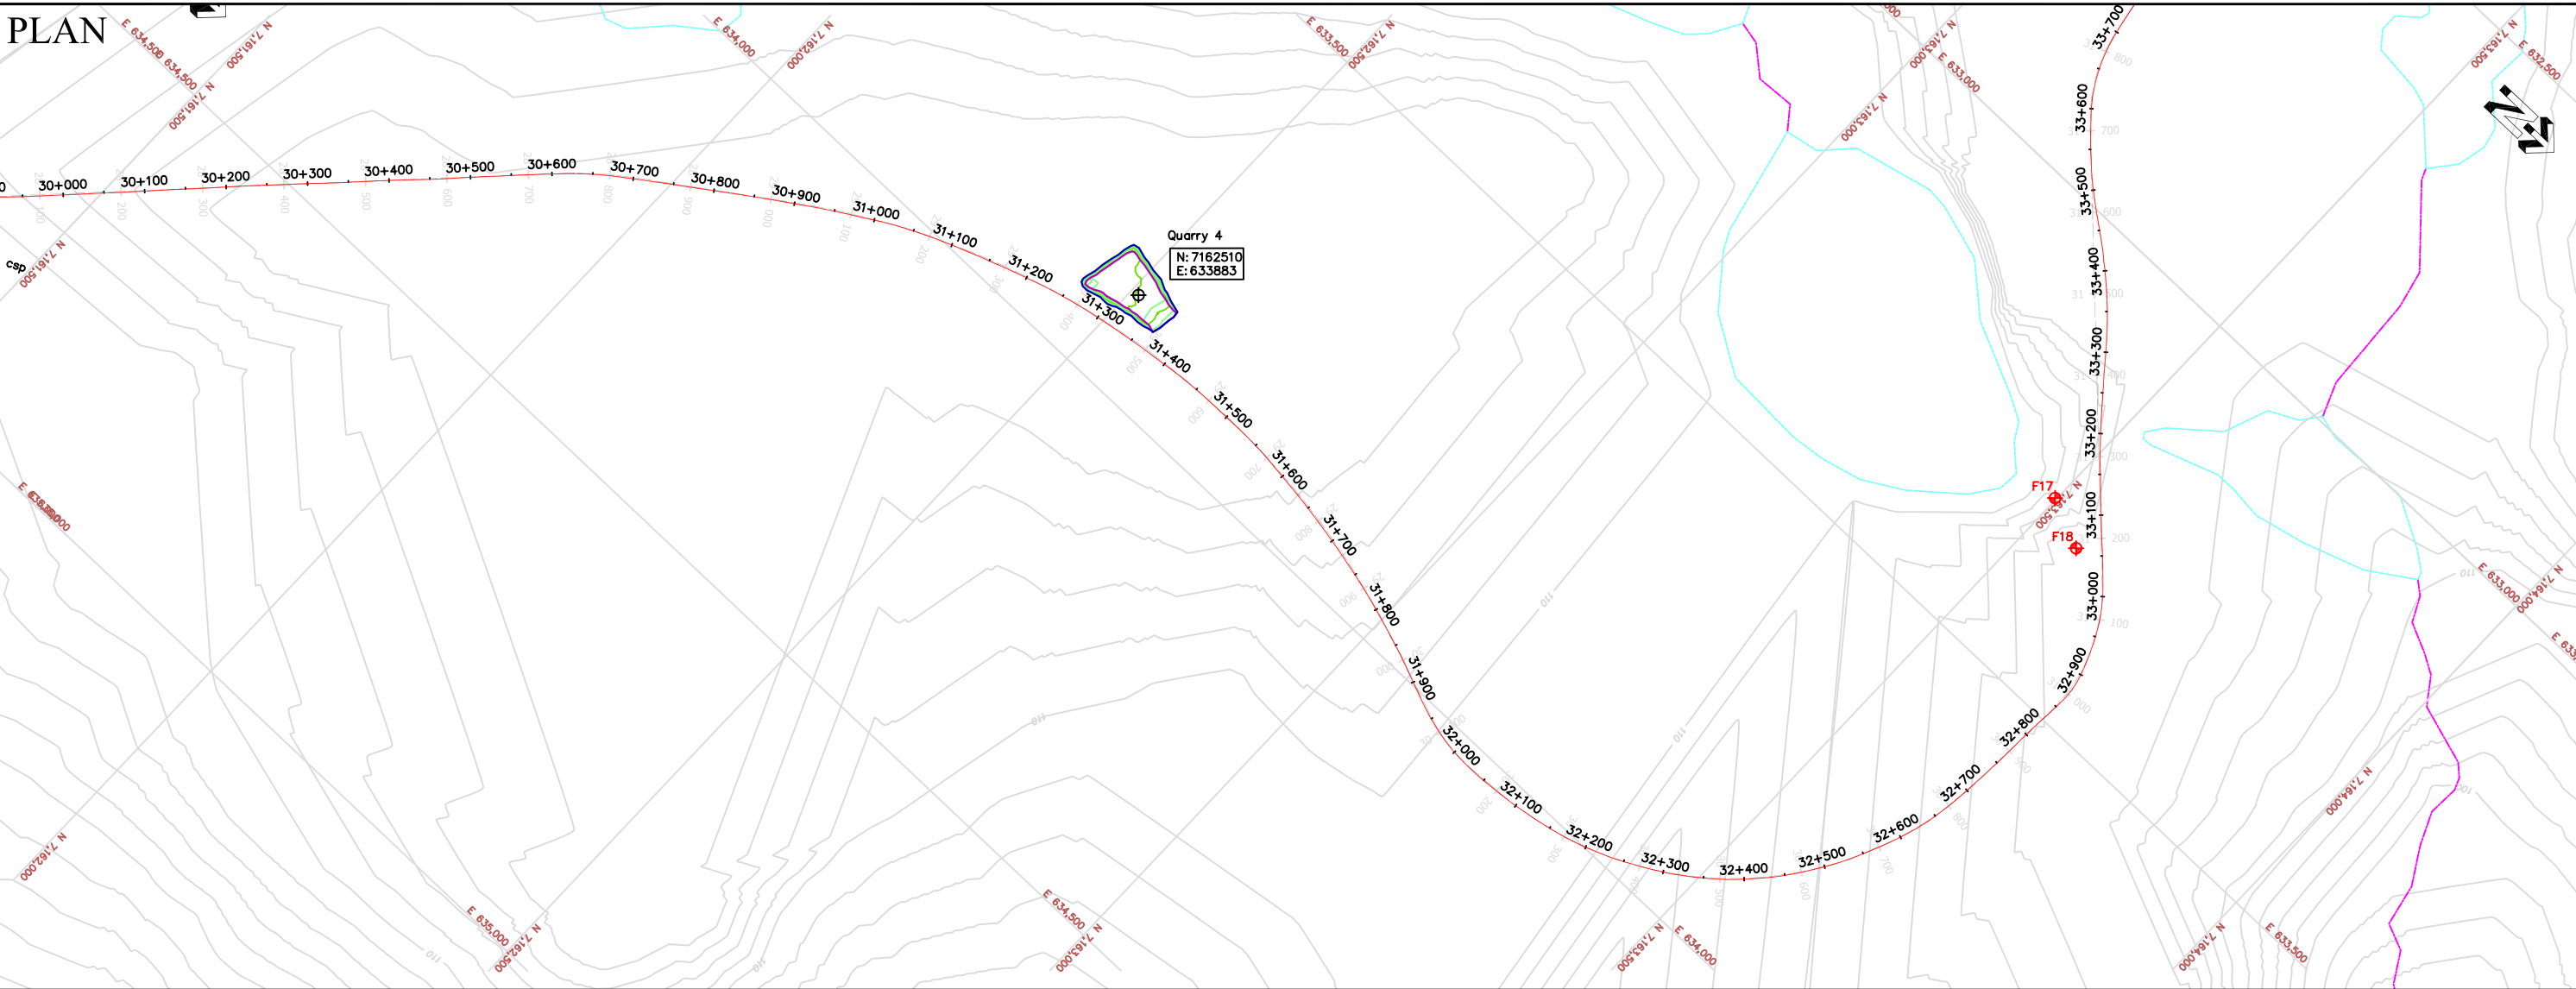


GOLDER DATA					AS CONSTRUCTED DATA					NOTES					OWNER				
LfLa-3 Existing archeological site					R02 River crossing (crossing structure and dimension)					0+100 Centerline of road with 100m stations					1. Coordinate system NAD 83 UTM Zone 14N Geoid HTv2.				
Pit-13 Proposed quarry site					120 Existing major contour (10m Topo)					R20 River crossing - culvert 600mm/1200mm dia					2. Golder data supplied by Cumberland/Agnico.				
Existing lake/stream					Existing minor contour (interpreted)					R02 River crossing - bridge 12m / 30m length					3. For quarry data, please refer to table 1.				
Proposed centerline of road alignment					Toe boundary of quarry excavation at bench grade					0m 100m 200m 300m Scale 1: 8000					4. For culvert data, please refer to table 2.				
SUSCEPTIBILITY															5. For bridge data, please refer to table 3.				
High					Medium-High										NUNA				
Medium					Low-Medium										Stationing				
Low					Unclassified										30+000 to 33+000				
															Sheet				
															11 of 35				
															Date				
															March 31, 2008				
															M & T SERVICES LTD.				