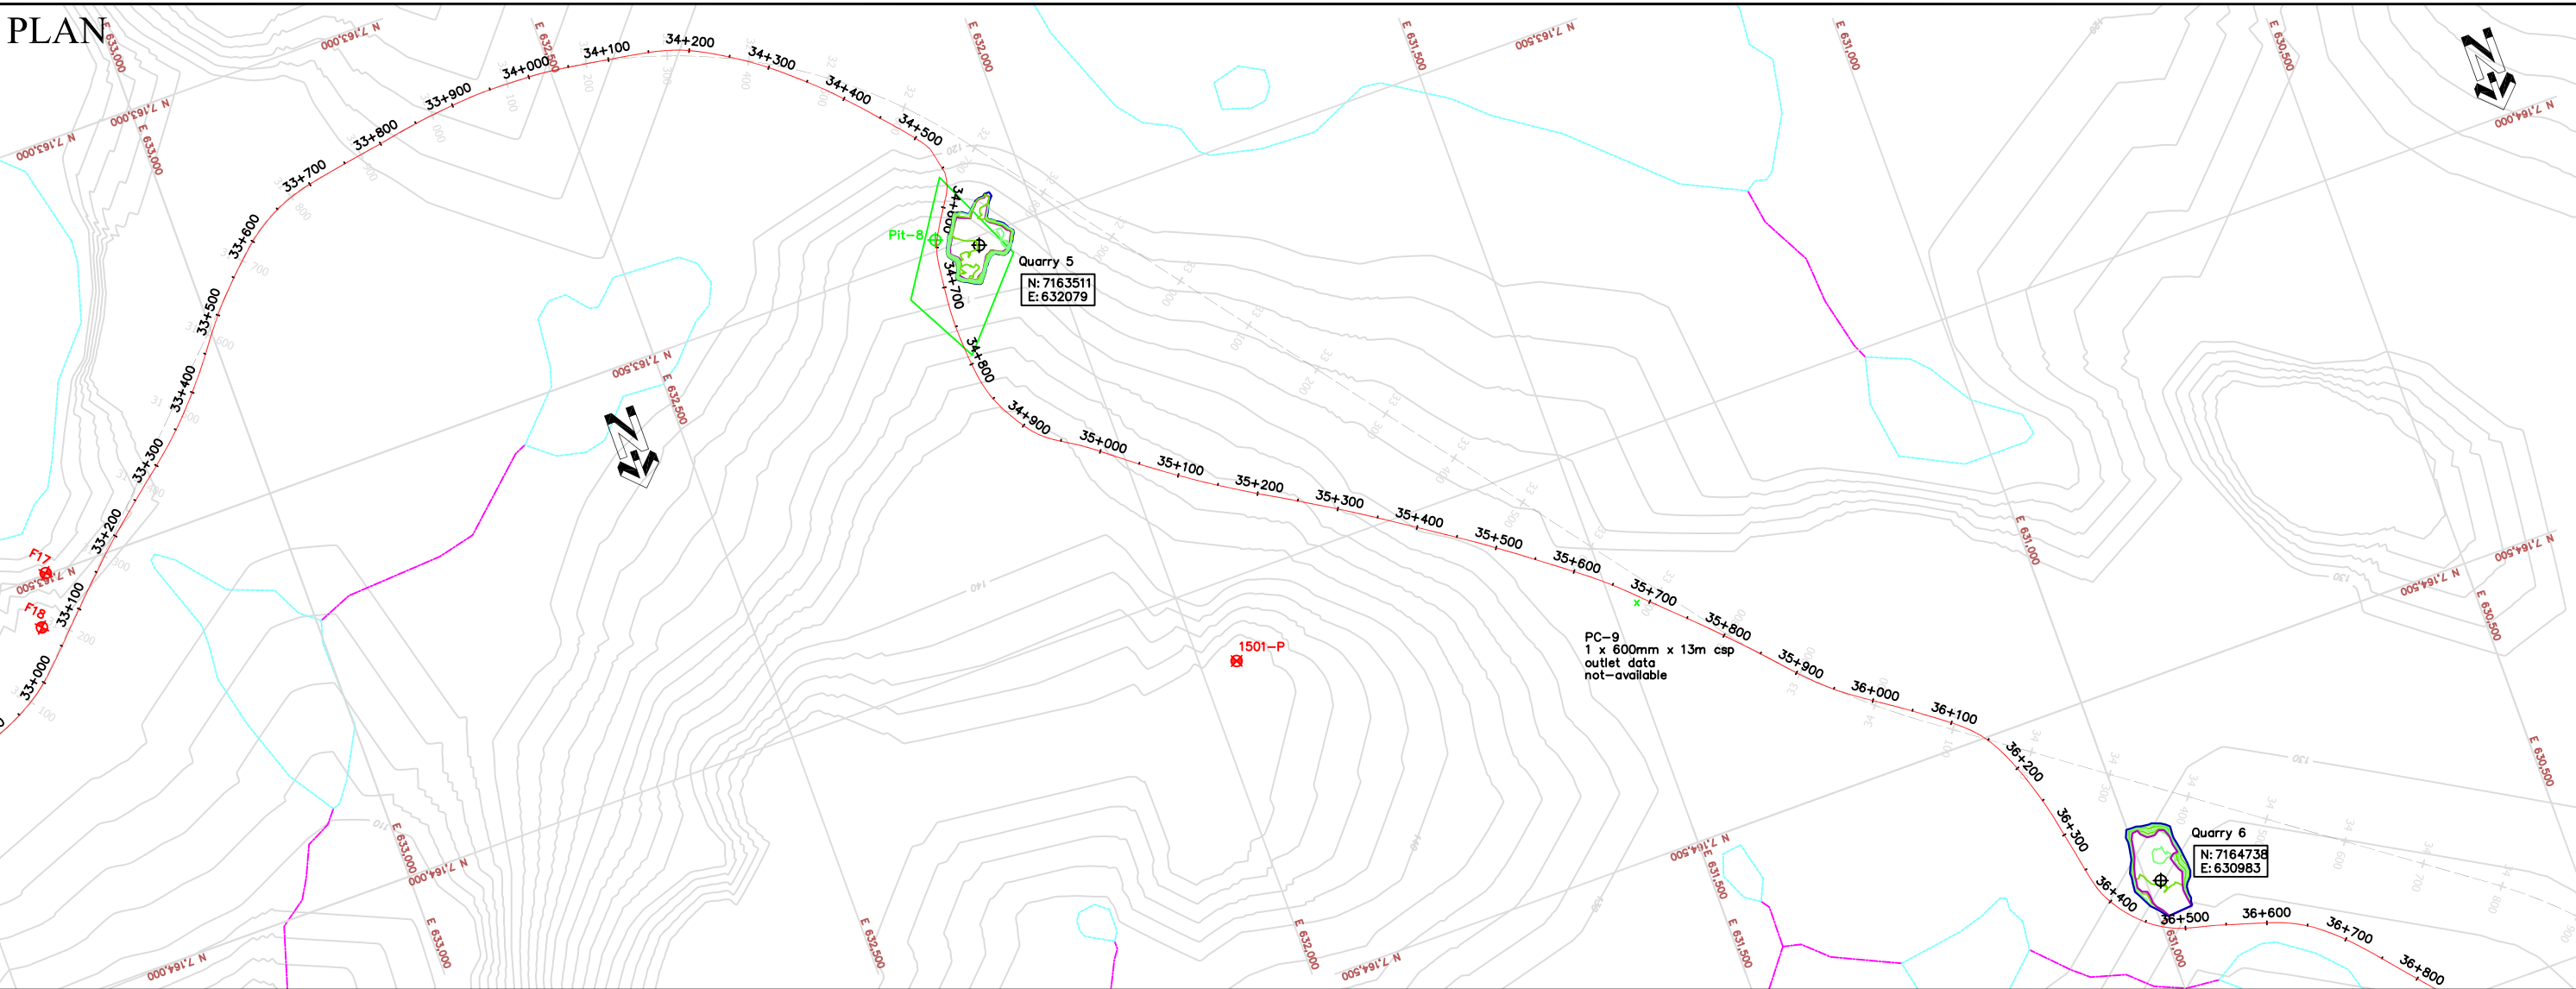


GOLDER DATA					AS CONSTRUCTED DATA					NOTES					OWNER				
Lfla-3 Existing archeological site					R02 River crossing (crossing structure and dimension)					0+100 Centerline of road with 100m stations					1. Coordinate system NAD 83 UTM Zone 14N Geoid HTv2. 2. Golder data supplied by Cumberland/Agnico. 3. For quarry data, please refer to table 1. 4. For culvert data, please refer to table 2. 5. For bridge data, please refer to table 3.				
Pit-13 Proposed quarry site					120 Existing major contour (10m Topo)					R20 River crossing - culvert 600mm/1200mm dia									
Existing lake/stream					Existing minor contour (interpreted)					PC-1 River crossing - bridge 12m / 30m length									
Proposed centerline of road alignment					Crest boundary of quarry limit at original ground					R02 River crossing - bridge 12m / 30m length									
Toe boundary of quarry excavation at bench grade					0m 100m 200m 300m Scale 1: 8000														
SUSCEPTIBILITY																			
High					Medium-High					Medium					Low-Medium				
Low					Unclassified														