



PLAN

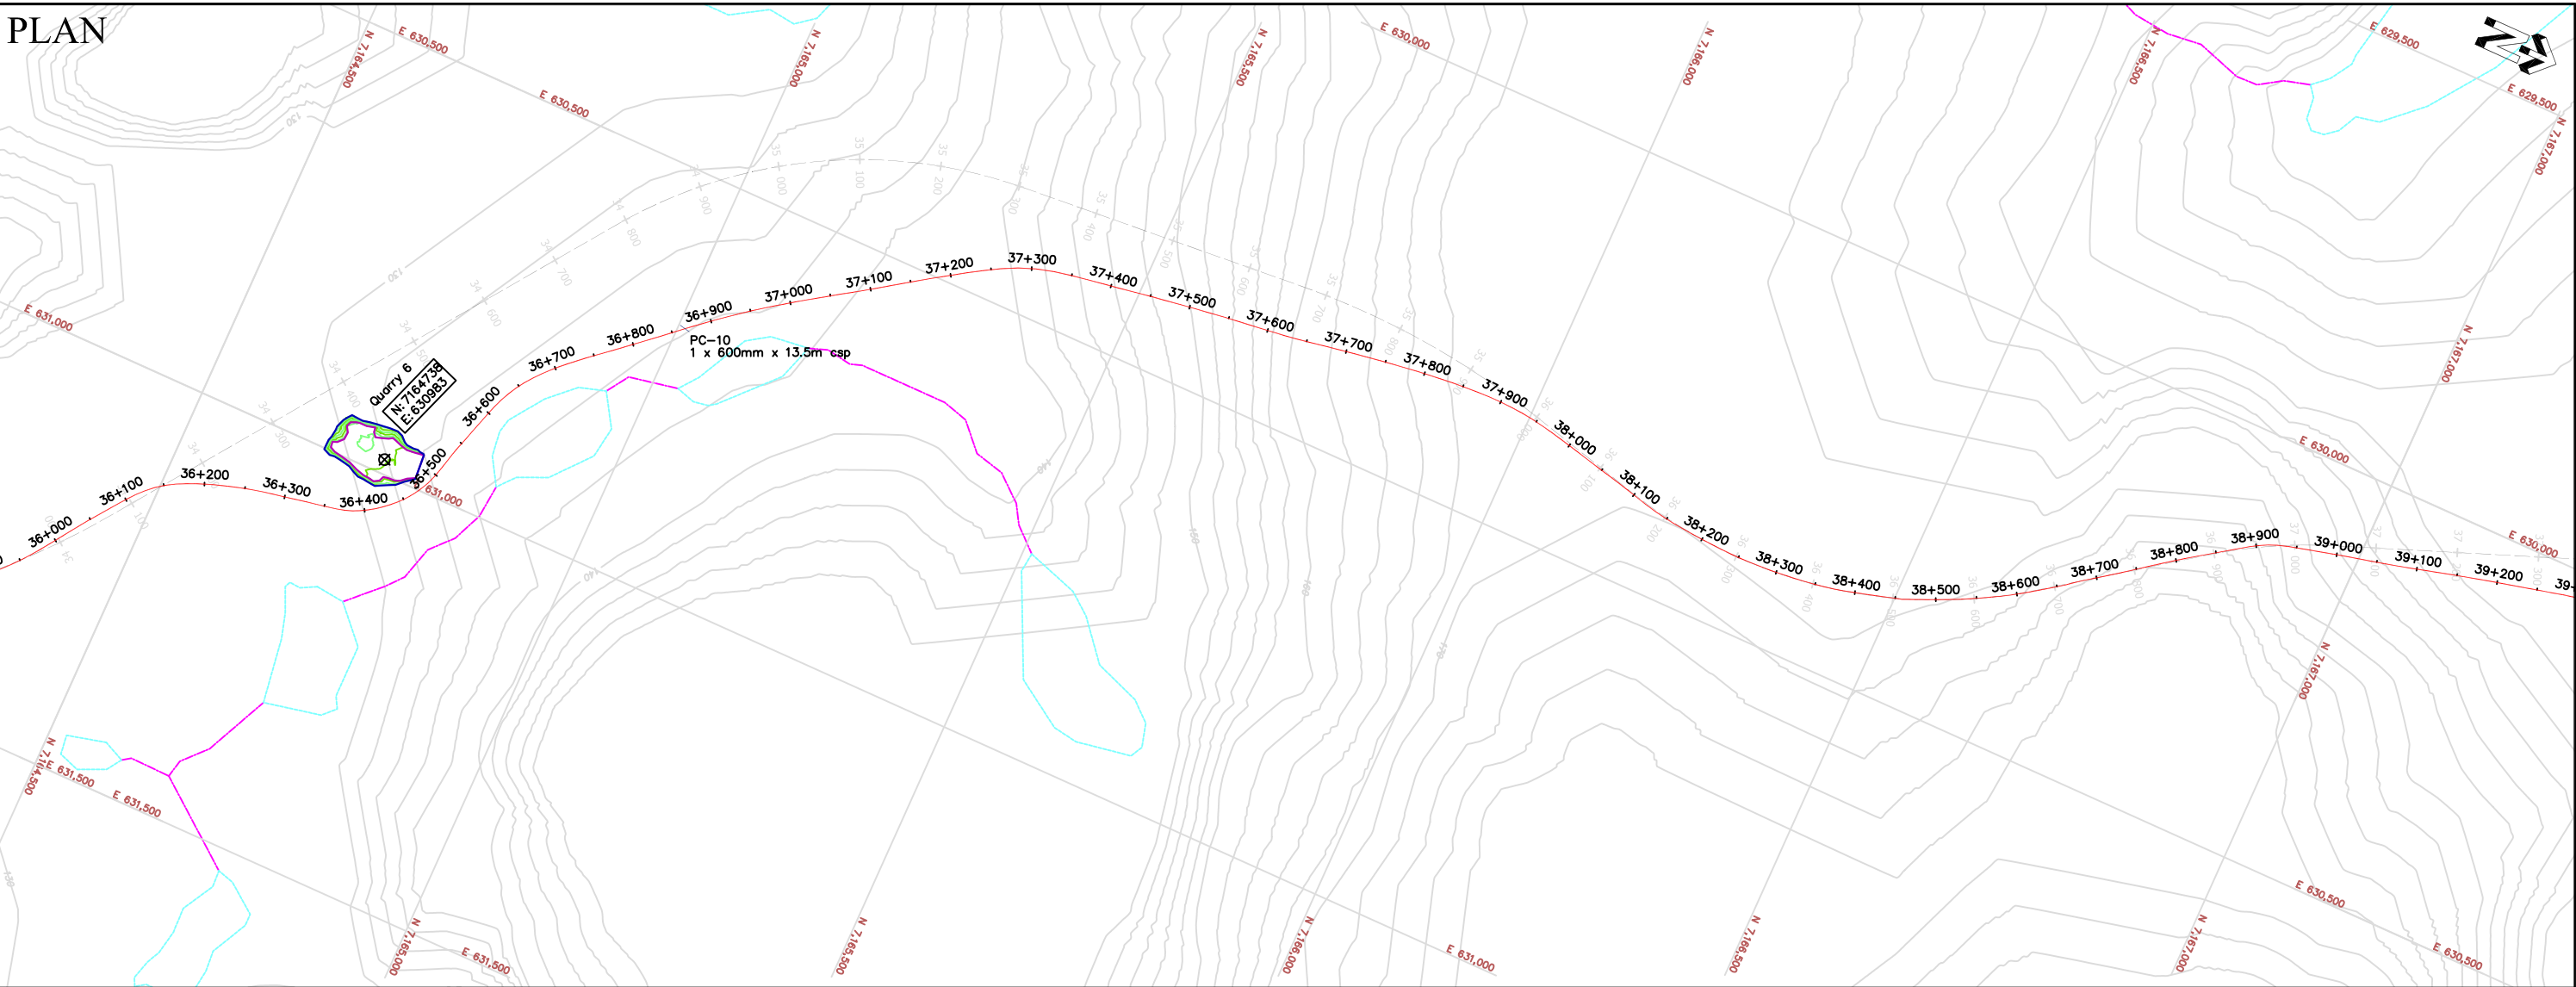

PROFILE

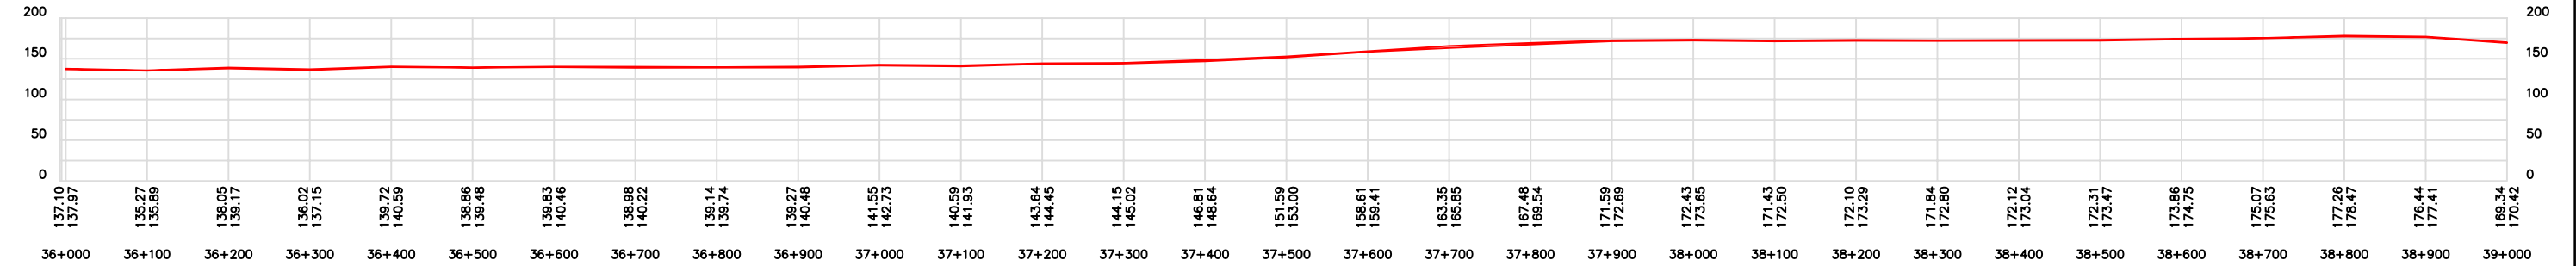

horizontal scale = vertical scale = 1:1

GOLDER DATA

Lfla-3

Existing archeological site

Pit-13

Proposed quarry site

Existing lake/stream

R02

River crossing (crossing structure and dimension)

Existing major contour (10m Topo)

Existing minor contour (interpreted)

Proposed centerline of road alignment

High

Medium-High

Medium

Low-Medium

Low

Unclassified

AS CONSTRUCTED DATA

172

Quarry as-built 2m major contour

Quarry as-built 1m minor contour

Crest boundary of quarry limit at original ground

Toe boundary of quarry excavation at bench grade

0+100

Centerline of road with 100m stations

R20 PC-1

River crossing - culvert 600mm/1200mm dia

River crossing - bridge 12m / 30m length

0m 100m 200m 300m

Scale 1: 8000

NOTES

1. Coordinate system NAD 83 UTM Zone 14N Geoid HTv2.

2. Golder data supplied by Cumberland/Agnico.

3. For quarry data, please refer to table 1.

4. For culvert data, please refer to table 2.

5. For bridge data, please refer to table 3.

OWNER	Agnico-Eagle Mines Ltd. Nunavut		
PROJECT	Meadowbank Gold Project Tehek Access Road Construction		
TITLE	As constructed drawings - Plan and Profile		
	Stationing	Sheet	
	36+000 to 39+000	13 of 35	
CAD	Check	Date	
gc	cg/hb	March 31, 2008	