



PLAN

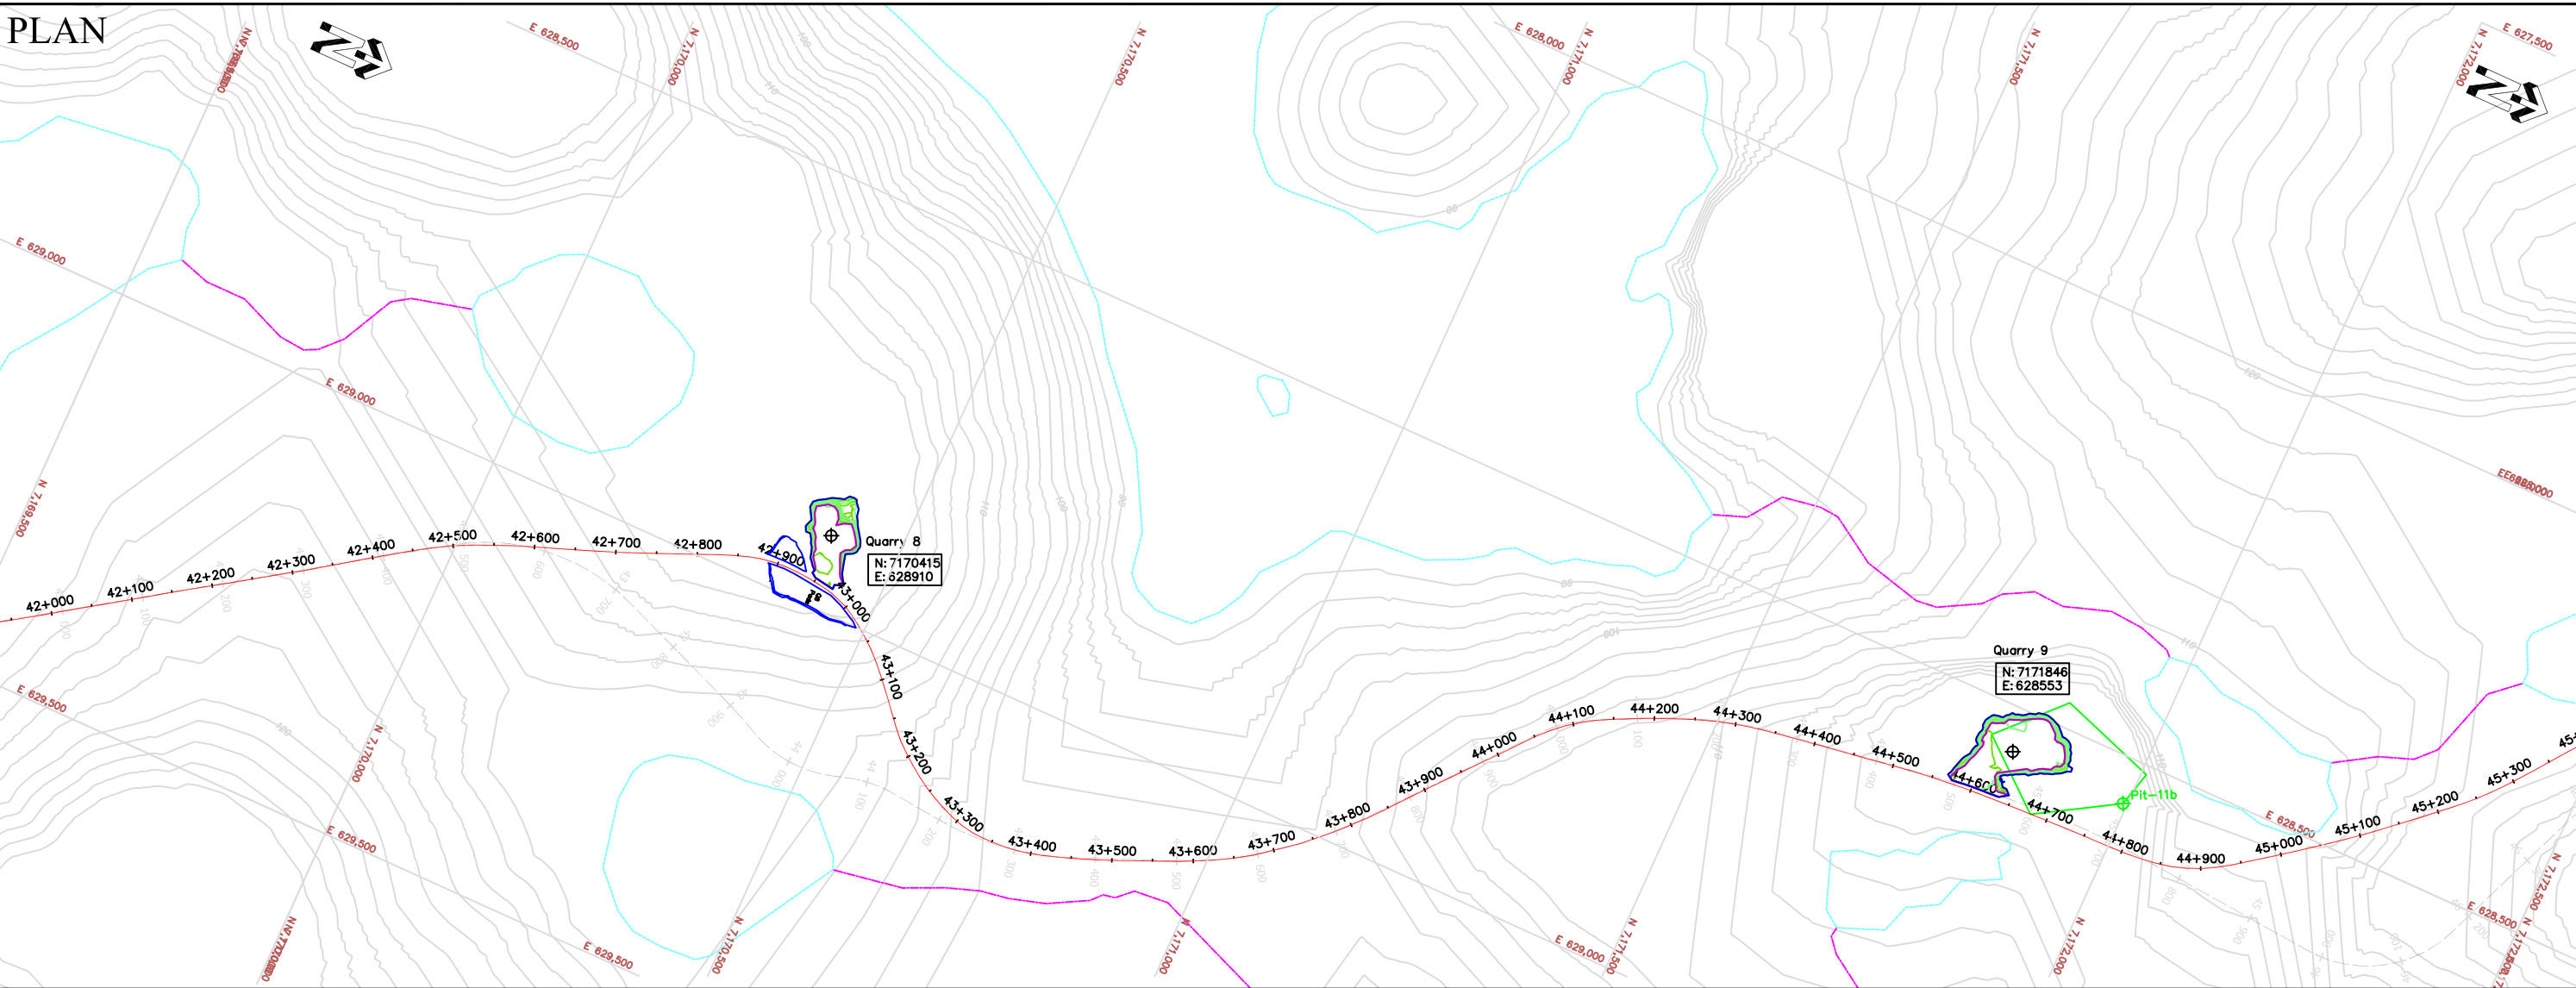

PROFILE

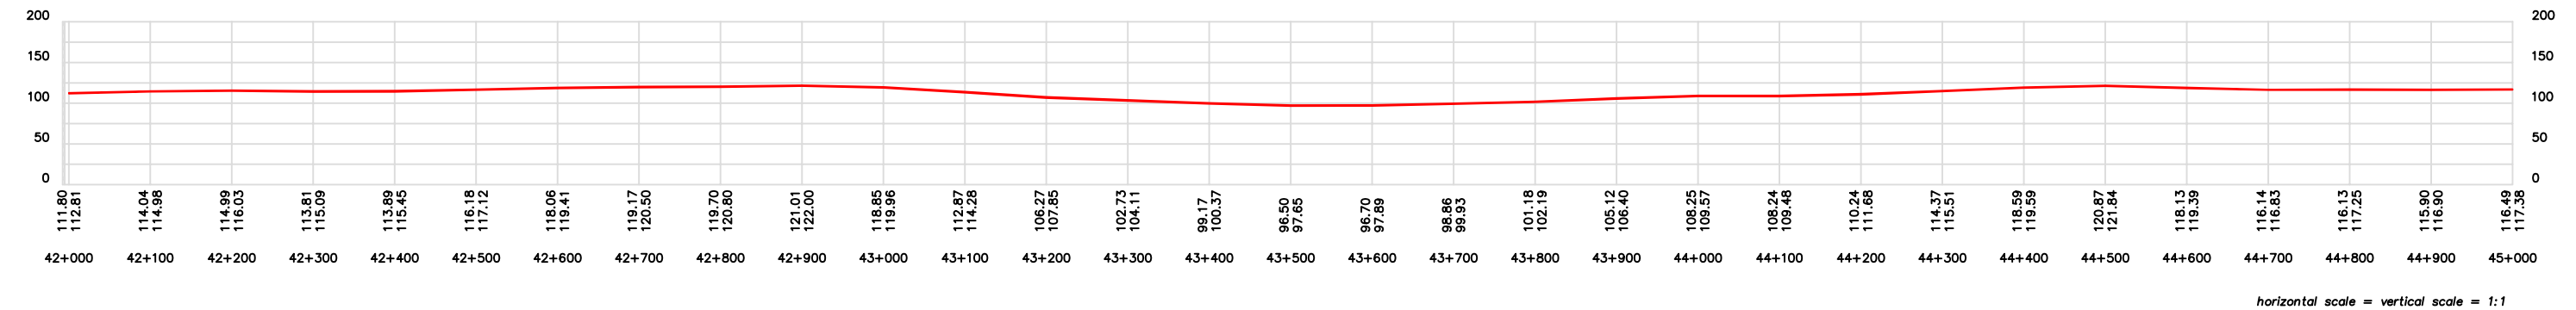

GOLDER DATA

Lfla-3 Existing archeological site

Pit-13 Proposed quarry site

Existing lake/stream

R02 River crossing (crossing structure and dimension)

120 Existing major contour (10m Topo)

Existing minor contour (interpreted)

Proposed $\frac{1}{2}$ of road alignment

High

Medium-High

Medium

Low-Medium

Low

Unclassified

AS CONSTRUCTED DATA

172 Quarry as-built 2m major contour

Quarry as-built 1m minor contour

Crest boundary of quarry limit at original ground

Toe boundary of quarry excavation at bench grade

0+100 Centerline of road with 100m stations

R20 PC-1 River crossing - culvert 600mm/1200mm dia

R02 River crossing - bridge 12m / 30m length

Scale 1: 8000

NOTES

- Coordinate system NAD 83 UTM Zone 14N Geoid HTv2.
- Golder data supplied by Cumberland/Agnico.
- For quarry data, please refer to table 1.
- For culvert data, please refer to table 2.
- For bridge data, please refer to table 3.

OWNER

Agnico-Eagle Mines Ltd. Nunavut

PROJECT

Meadowbank Gold Project
Tehek Access Road Construction

TITLE

As constructed drawings - Plan and Profile

NUNA
M & T SERVICES LTD.

Stationing

42+000 to 45+000

Sheet

15 of 35

CAD

gc

Check

cg/hb

Date

March 31, 2008