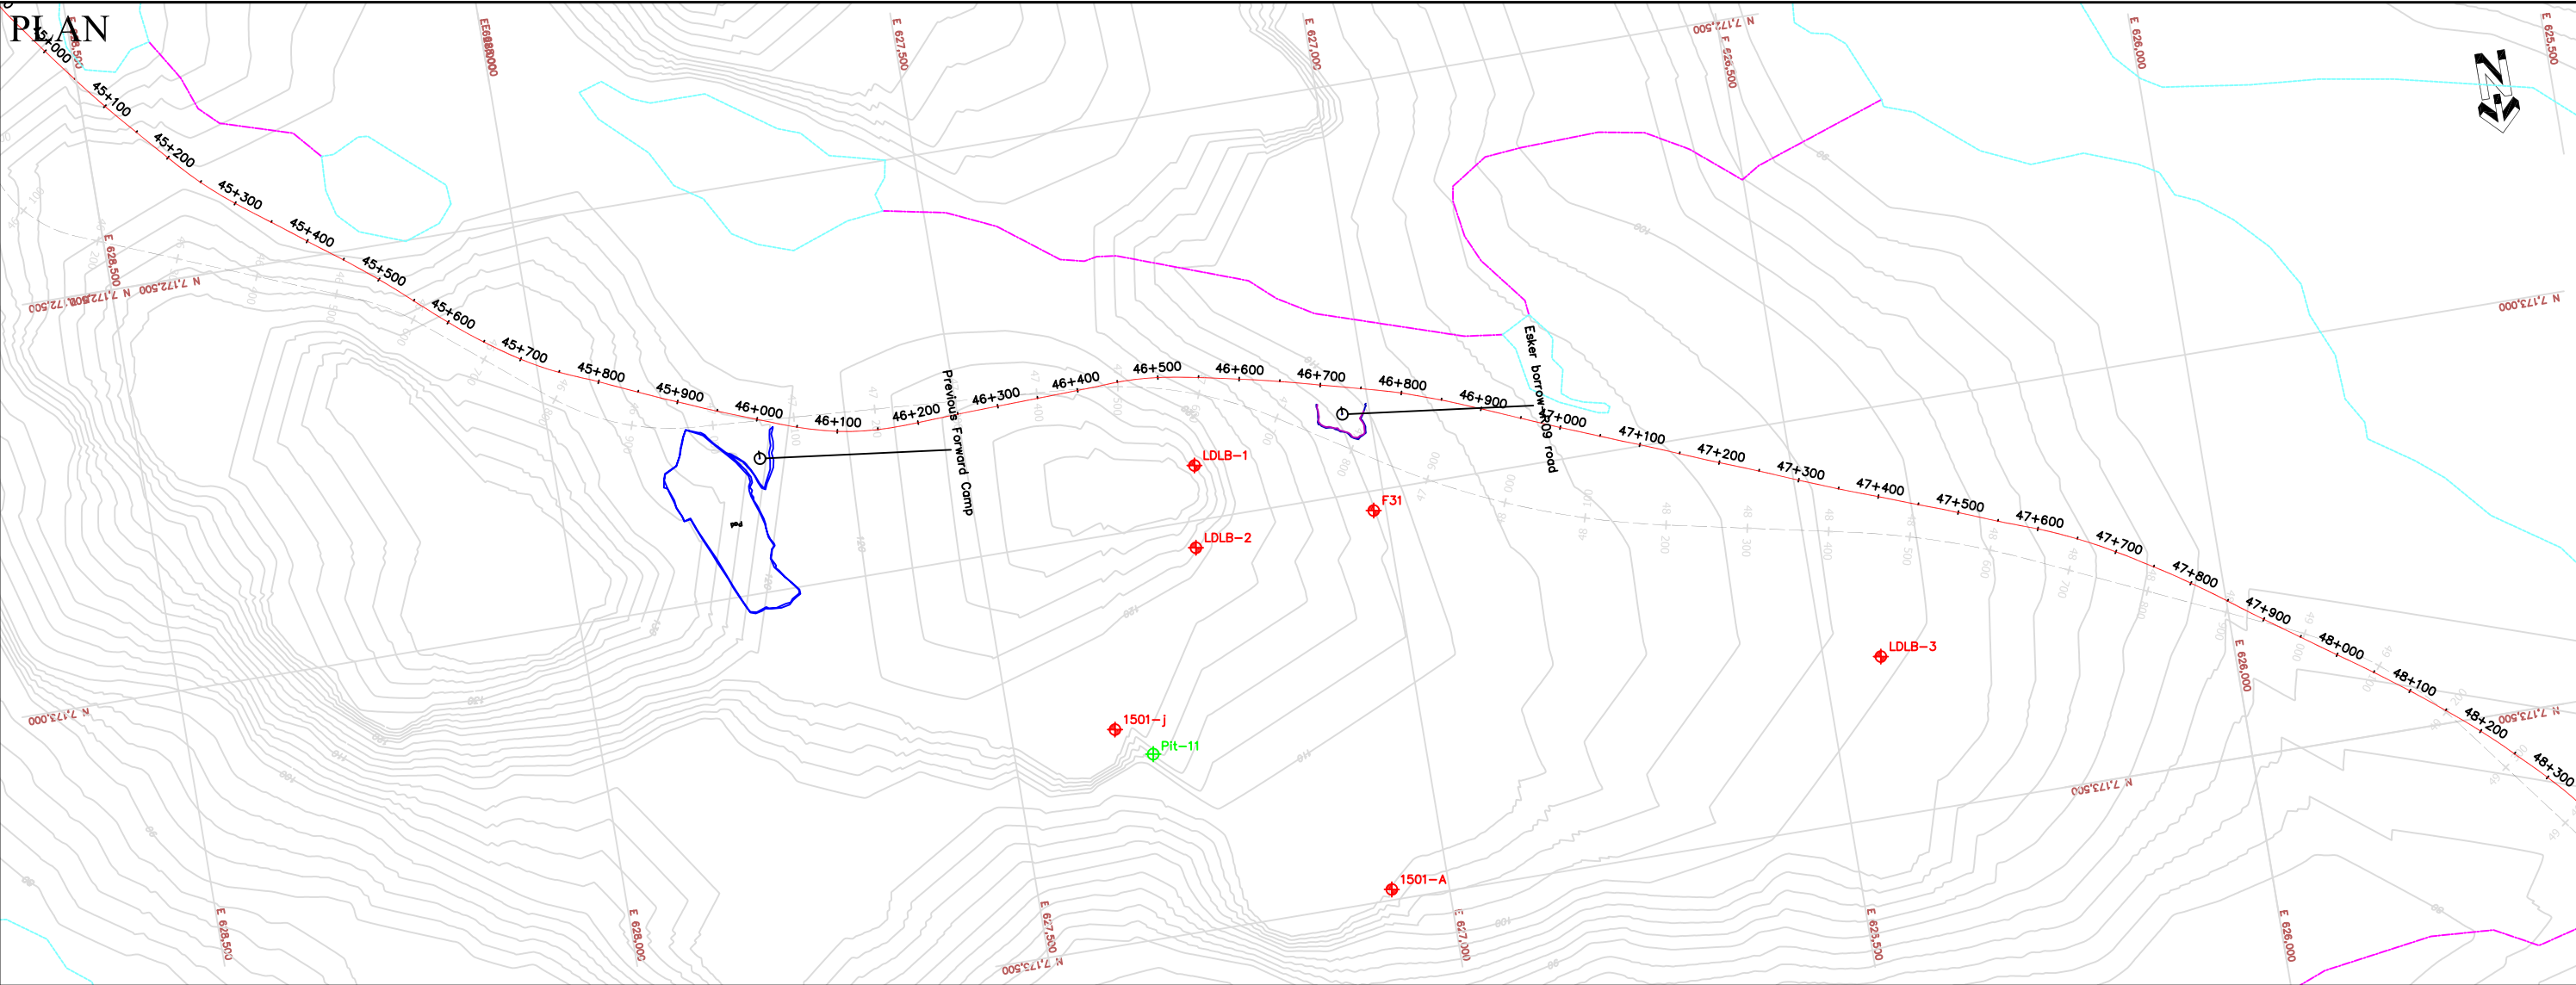


GOLDER DATA					AS CONSTRUCTED DATA					NOTES					OWNER Agnico-Eagle Mines Ltd. Nunavut																			
Lfla-3 Existing archeological site					R02 River crossing (crossing structure and dimension)					172 Quarry as-built 2m major contour					0+100 Centerline of road with 100m stations					1. Coordinate system NAD 83 UTM Zone 14N Geoid HTv2. 2. Golder data supplied by Cumberland/Agnico. 3. For quarry data, please refer to table 1. 4. For culvert data, please refer to table 2. 5. For bridge data, please refer to table 3.														
Pit-13 Proposed quarry site					120 Existing major contour (10m Topo)					R20 Quarry as-built 1m minor contour					R20 PC-1 River crossing - culvert 600mm/1200mm dia																			
Existing lake/stream					Existing minor contour (interpreted)					Crest boundary of quarry limit at original ground					R02 River crossing - bridge 12m / 30m length																			
Proposed ϵ of road alignment										Toe boundary of quarry excavation at bench grade					0m 100m 200m 300m Scale 1: 8000																			
SUSCEPTIBILITY																																		
High					Medium-High					Medium					Low-Medium					Low					Unclassified									
																				 M & T SERVICES LTD.														
																				Stationing 45+000 to 48+000					Sheet 16 of 35									
																				CAD gc					Check cg/hb					Date March 31, 2008				