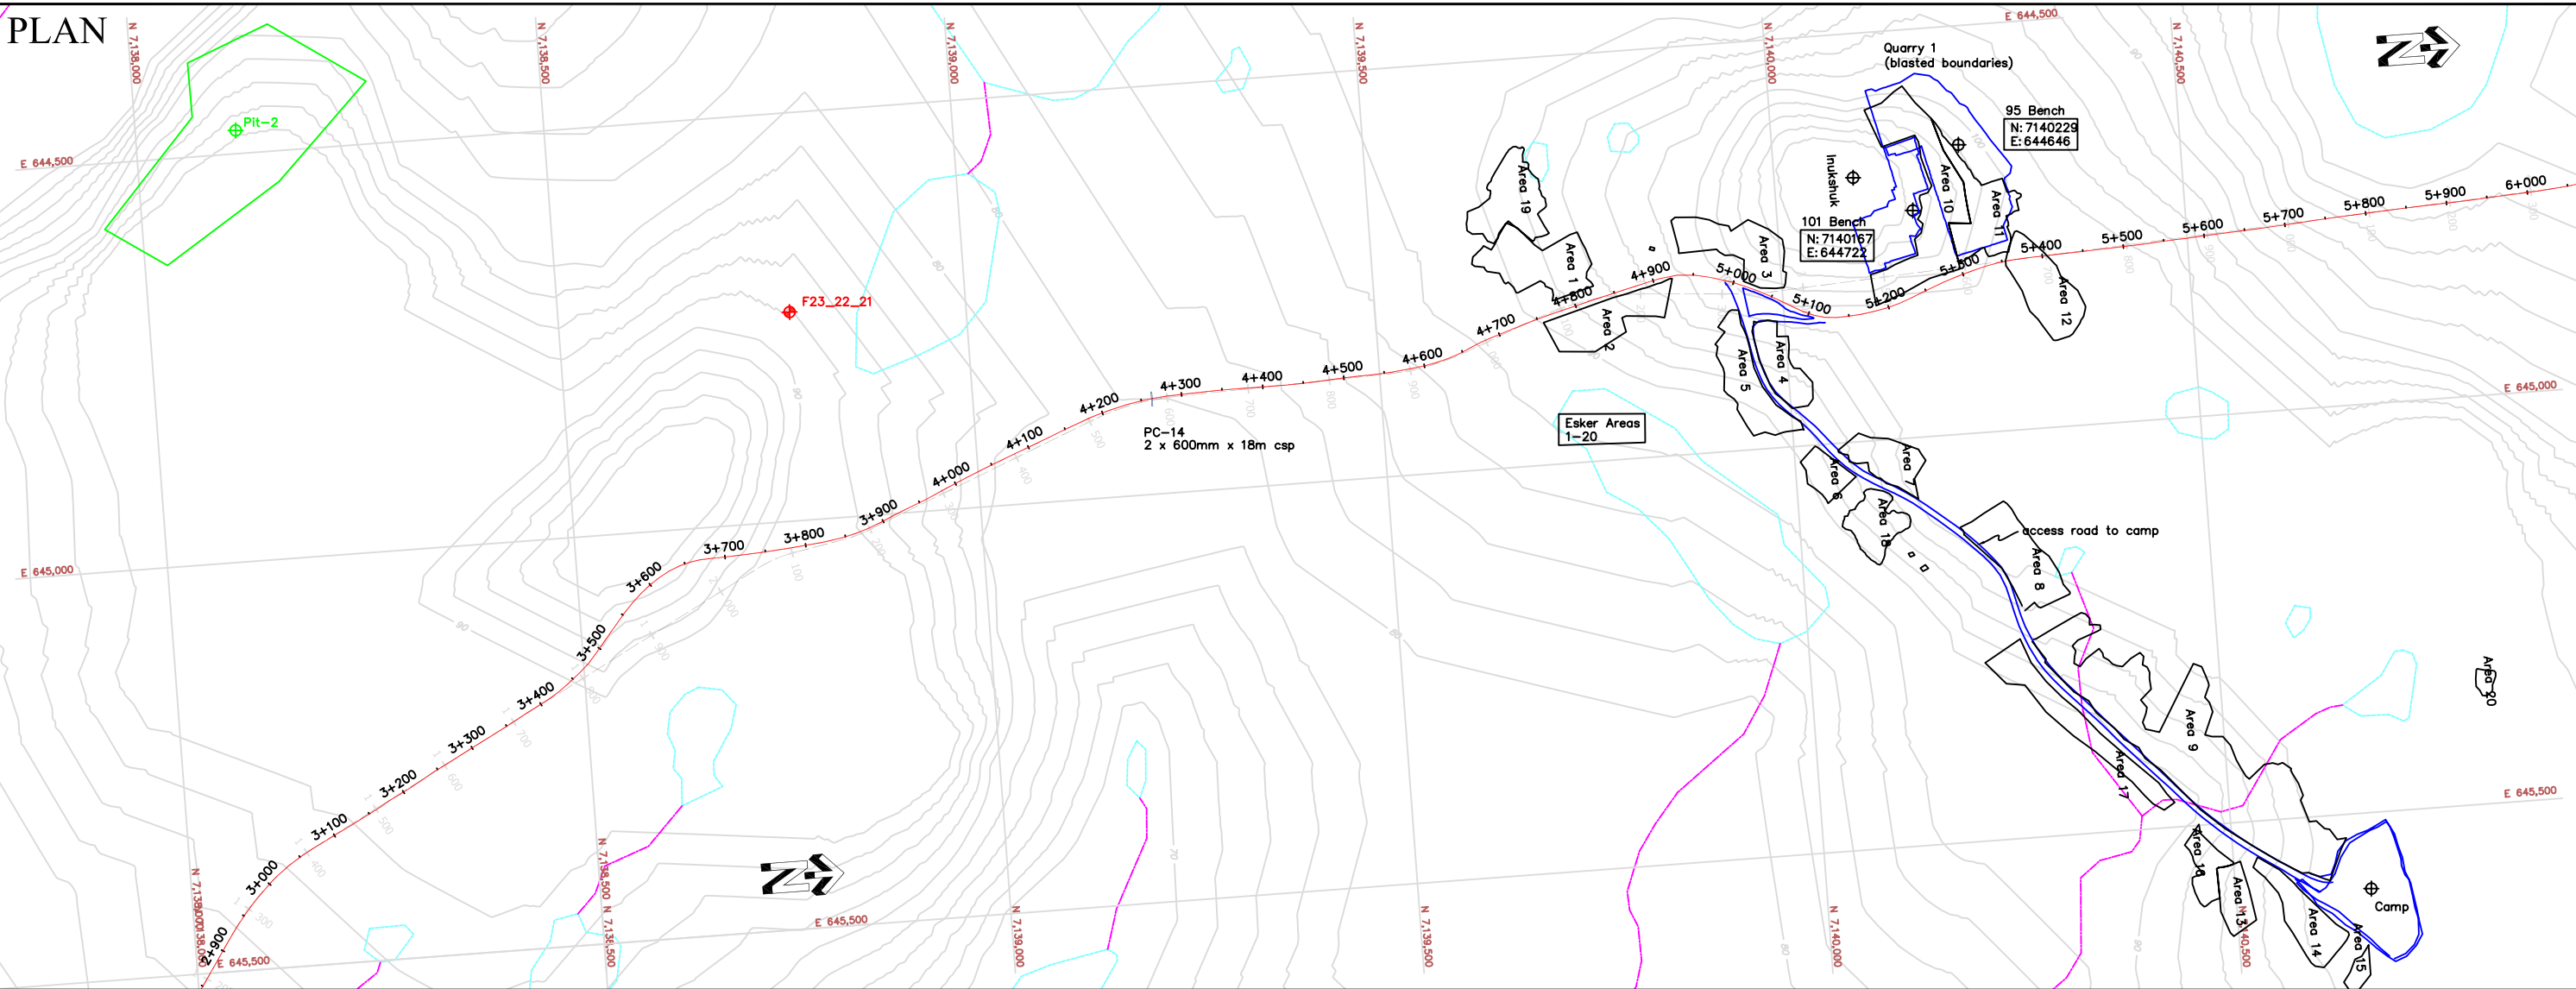


GOLDER DATA				AS CONSTRUCTED DATA				NOTES		OWNER Agnico-Eagle Mines Ltd. Nunavut		
Lfla-3 Existing archeological site				R02 River crossing (crossing structure and dimension)				0+100 Centerline of road with 100m stations		1. Coordinate system NAD 83 UTM Zone 14N Geoid HTv2. 2. Golder data supplied by Cumberland/Agnico. 3. For quarry data, please refer to table 1. 4. For culvert data, please refer to table 2. 5. For bridge data, please refer to table 3.		
Pit-13 Proposed quarry site				172 Quarry as-built 2m major contour				R20 River crossing - culvert 600mm/1200mm dia				
Existing lake/stream				120 Existing major contour (10m Topo)				PC-1 River crossing - bridge 12m / 30m length				
Existing minor contour (interpreted)				Crest boundary of quarry limit at original ground				R02 River crossing - bridge 12m / 30m length				
Proposed ½ of road alignment				Toe boundary of quarry excavation at bench grade				0m 100m 200m 300m Scale 1: 8000		Stationing 3+000 to 6+000 Sheet 2 of 35 NUNA M & T SERVICES LTD. CAD gc Check cg/hb Date March 31, 2008		
SUSCEPTIBILITY High Medium-High Medium Low-Medium Low Unclassified												