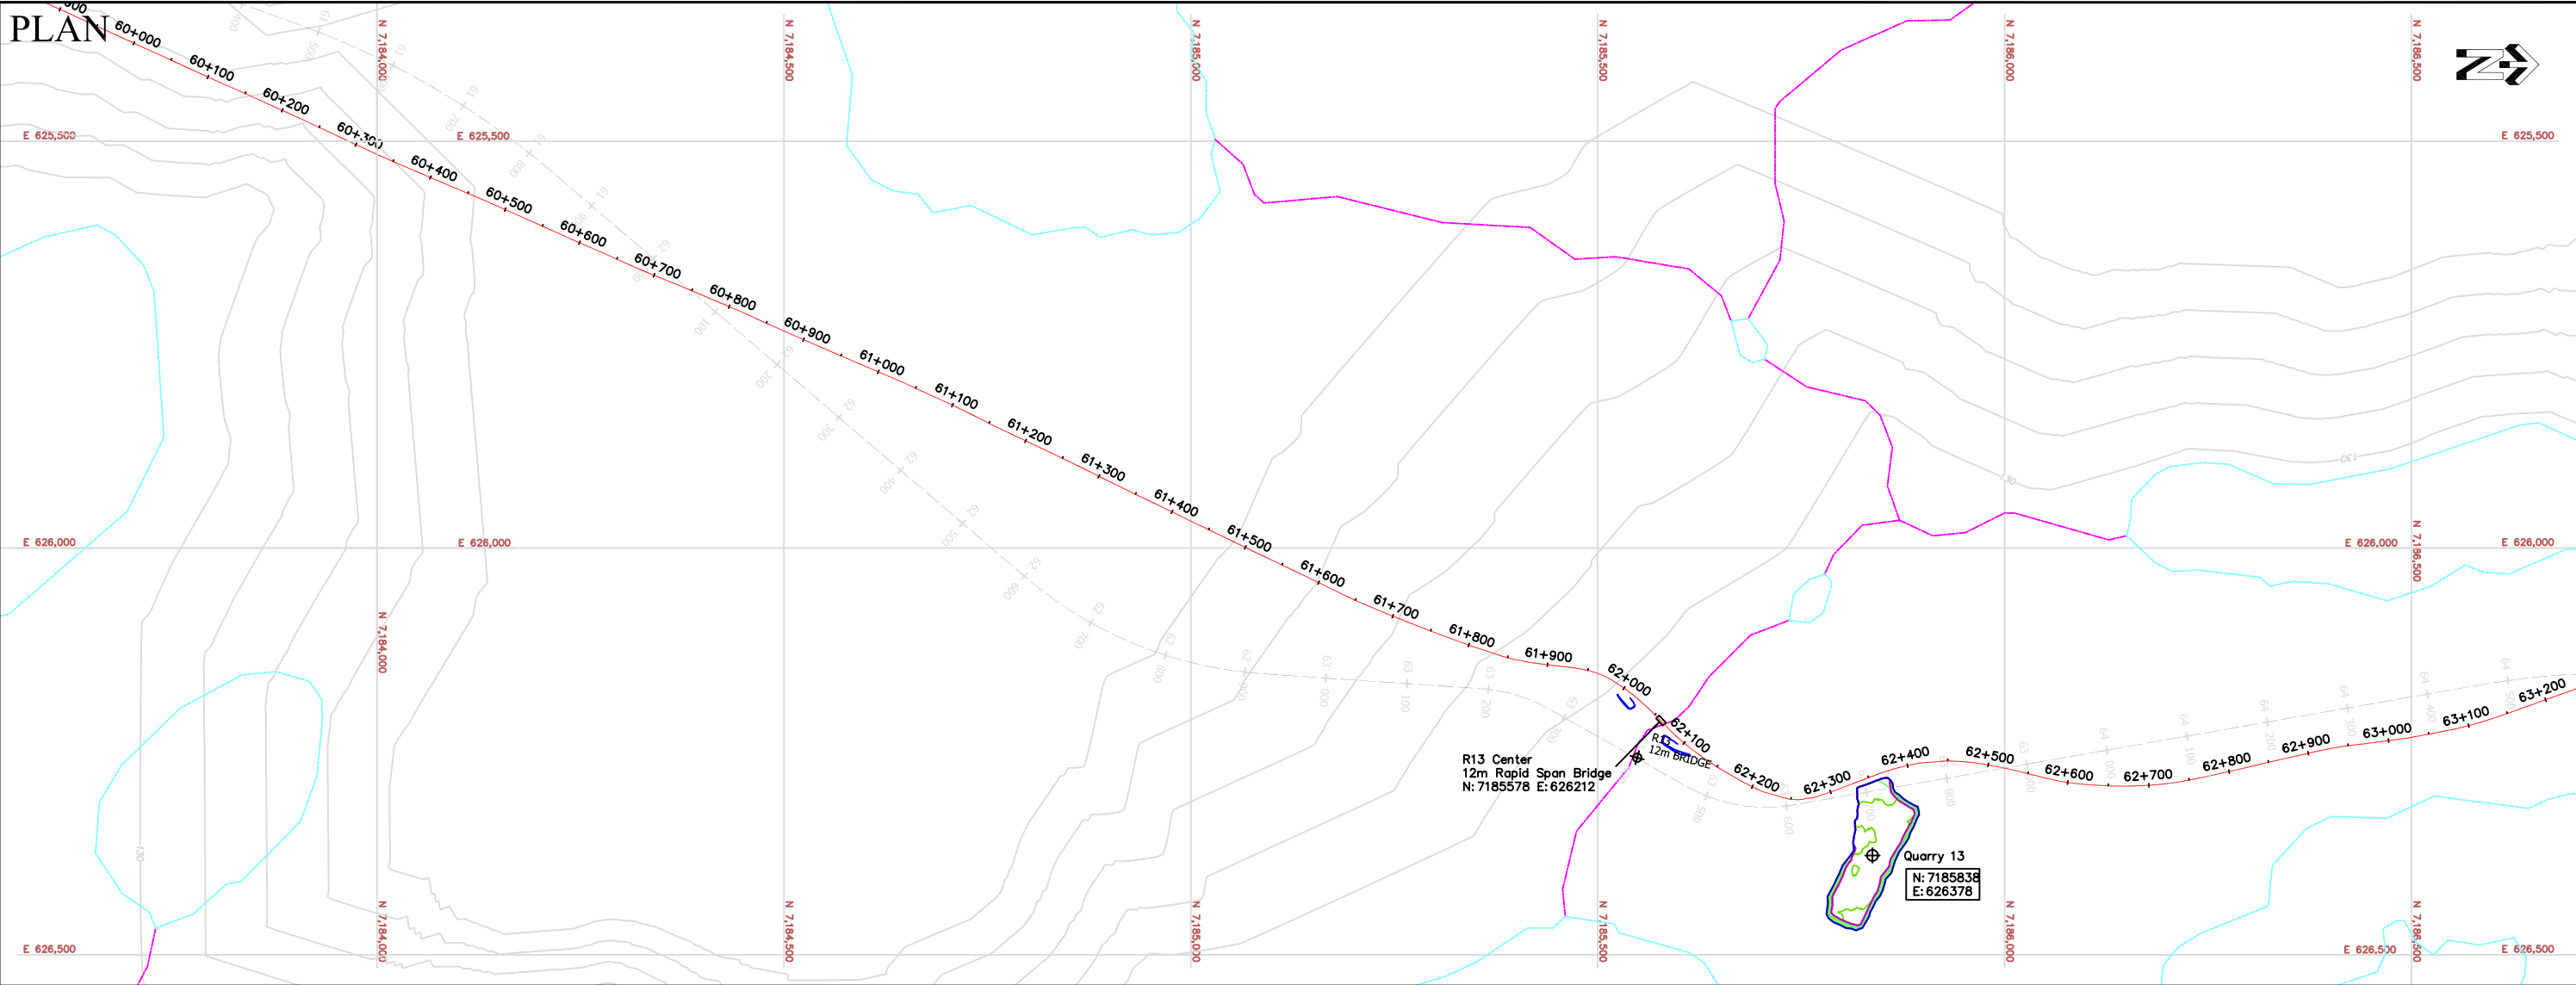
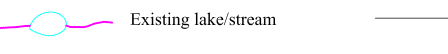


GOLDER DATA				AS CONSTRUCTED DATA				NOTES 1. Coordinate system NAD 83 UTM Zone 14N Geoid HTv2. 2. Golder data supplied by Cumberland/Agnico. 3. For quarry data, please refer to table 1. 4. For culvert data, please refer to table 2. 5. For bridge data, please refer to table 3.	OWNER Agnico-Eagle Mines Ltd. Nunavut		
	Lfla-3	Existing archeological site		R02	River crossing (crossing structure and dimension)		Quarry as-built 2m major contour			Centerline of road with 100m stations	
	Pit-13	Proposed quarry site		120	Existing major contour (10m Topo)		Quarry as-built 1m minor contour			River crossing - culvert 600mm/1200mm dia	
		Existing lake/stream			Existing minor contour (interpreted)		Crest boundary of quarry limit at original ground			River crossing - bridge 12m / 30m length	
		Proposed $\frac{1}{2}$ of road alignment			Proposed $\frac{1}{2}$ of road alignment		Toe boundary of quarry excavation at bench grade			Scale 1: 8000	
SUSCEPTIBILITY  High  Medium-High  Medium  Low-Medium  Low  Unclassified											
		Stationing 60+000 to 63+000		Sheet 21 of 35		CAD gc		Check cg/hb		Date March 31, 2008	