

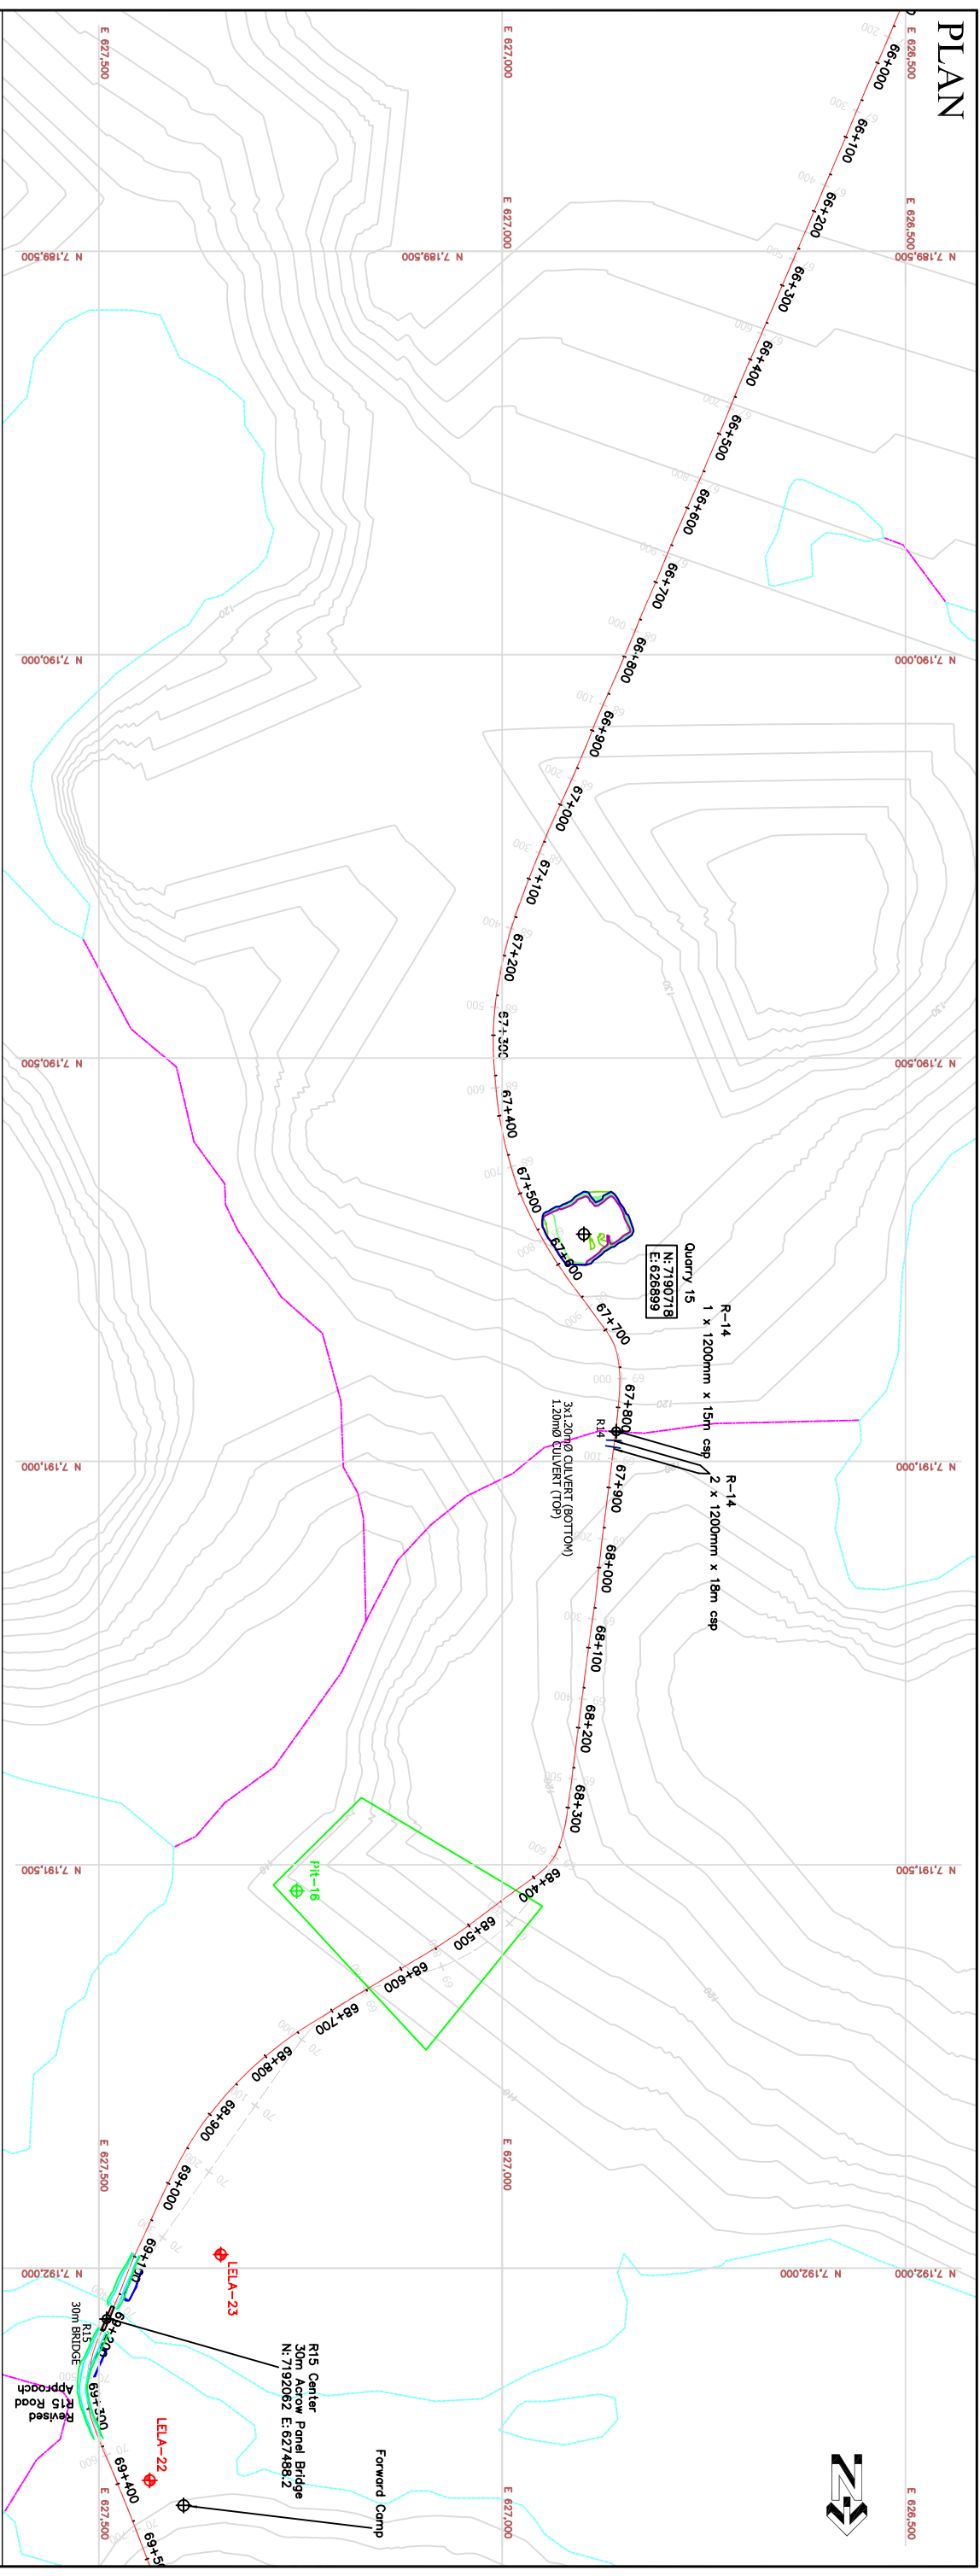


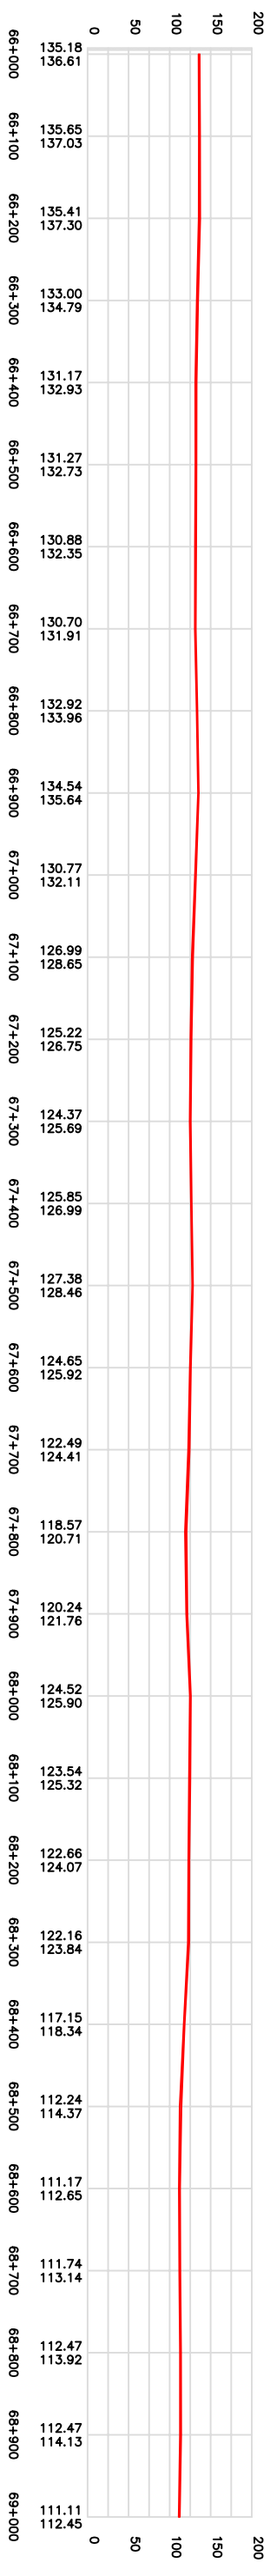

PROFILE

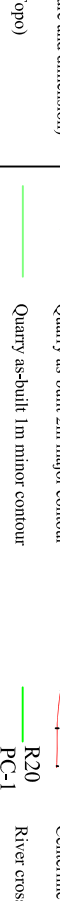

GOLDER DATA		AS CONSTRUCTED DATA		NOTES					
 L1-a-3	Existing archeological site	 R02	River crossing (crossing structure and dimension)	 Centerline of road with 100m stations River crossing - culvert 600mm/1200mm dia Quarry as-built 1m minor contour Crest boundary of quarry limit at original ground River crossing - bridge 12m / 30m length Toe boundary of quarry excavation at bench grade Scale 1: 8000	1. Coordinate system NAD 83 UTM Zone 14N Geoid HTv2. 2. Golder data supplied by Cumberland/Agnico. 3. For quarry data, please refer to table 1. 4. For culvert data, please refer to table 2. 5. For bridge data, please refer to table 3.				
 P1-i-13	Proposed quarry site	— 20 —	Existing major contour (10m Topo)						
	Existing lake/stream	—	Existing minor contour (interpreted)						
	Existing lake/stream	— — — — —	Proposed ϵ of road alignment						
	Existing lake/stream	— — — — —	Proposed ϵ of road alignment						
SUSCEPTIBILITY		 High	 Medium-High	 Medium	 Low-Medium	 Low	 Unclassified		
				OWNER		Agnico-Eagle Mines Ltd.		Nunavut	
				PROJECT		Meadowbank Gold Project Tehuk Access Road Construction			
				TITLE		As constructed drawings - Plan and Profile			
		Stationing		Sheet					
		CAD (66+000 to 69+000)		23 of 35					
		Check (eg/hb)		Date					
				May 5, 2008					