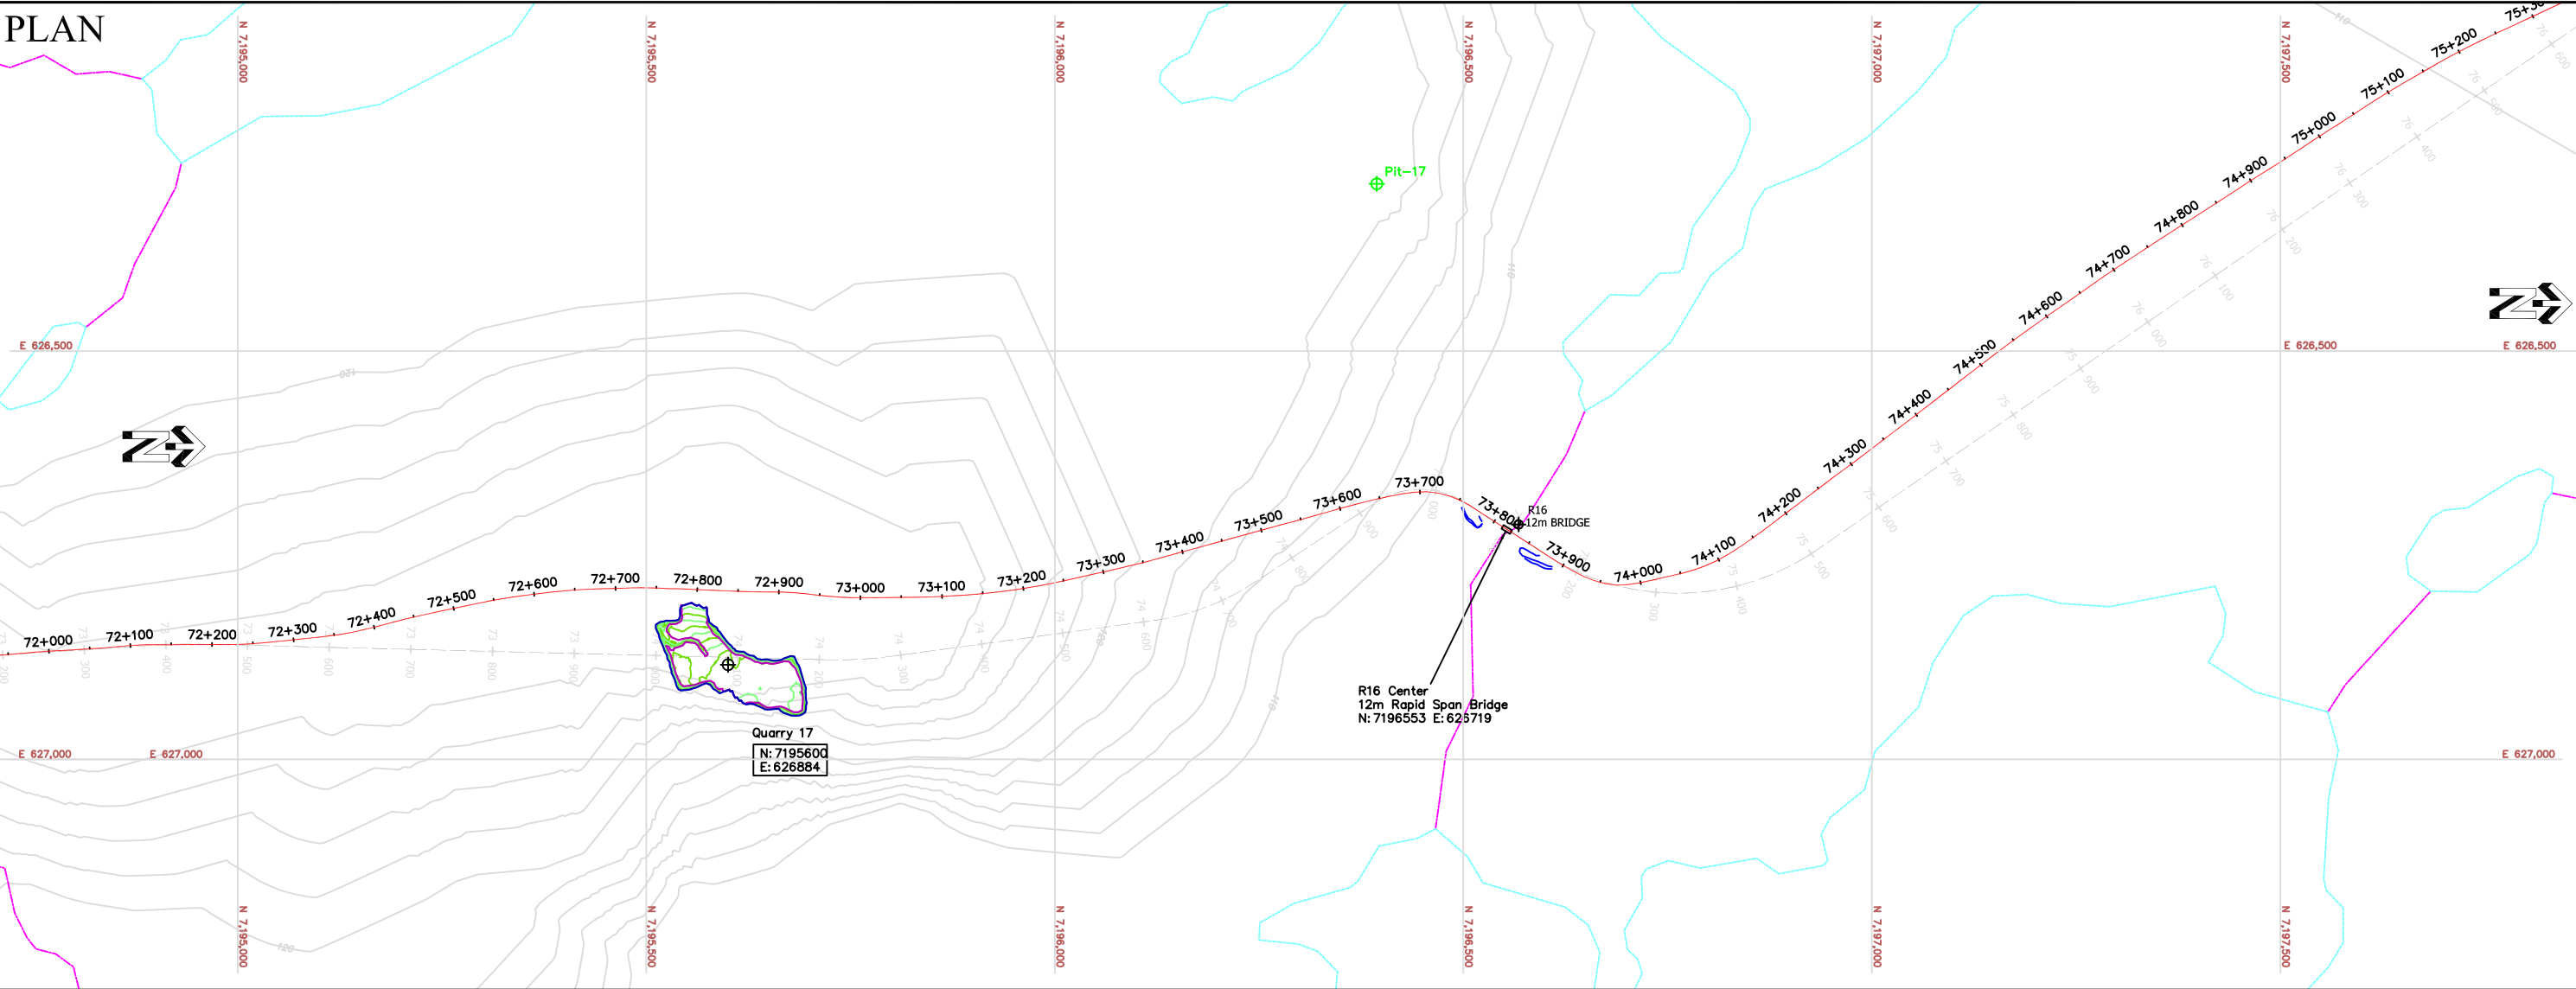


GOLDER DATA				AS CONSTRUCTED DATA				NOTES				OWNER Agnico-Eagle Mines Ltd. Nunavut															
LfLa-3 Existing archeological site Pit-13 Proposed quarry site Existing lake/stream				R02 River crossing (crossing structure and dimension) 120 Existing major contour (10m Topo) Existing minor contour (interpreted) Proposed ϵ of road alignment				172 Quarry as-built 2m major contour Quarry as-built 1m minor contour Crest boundary of quarry limit at original ground Toe boundary of quarry excavation at bench grade				0+100 Centerline of road with 100m stations R20 River crossing - culvert 600mm/1200mm dia PC-1 River crossing - bridge 12m / 30m length R02				0m 100m 200m 300m Scale 1: 8000				1. Coordinate system NAD 83 UTM Zone 14N Geoid HTv2. 2. Golder data supplied by Cumberland/Agnico. 3. For quarry data, please refer to table 1. 4. For culvert data, please refer to table 2. 5. For bridge data, please refer to table 3.				TITLE As constructed drawings - Plan and Profile NUNA M & T SERVICES LTD. Stationing 72+000 to 75+000 CAD gc Check cg/hb Sheet 25 of 35 Date March 31, 2008			