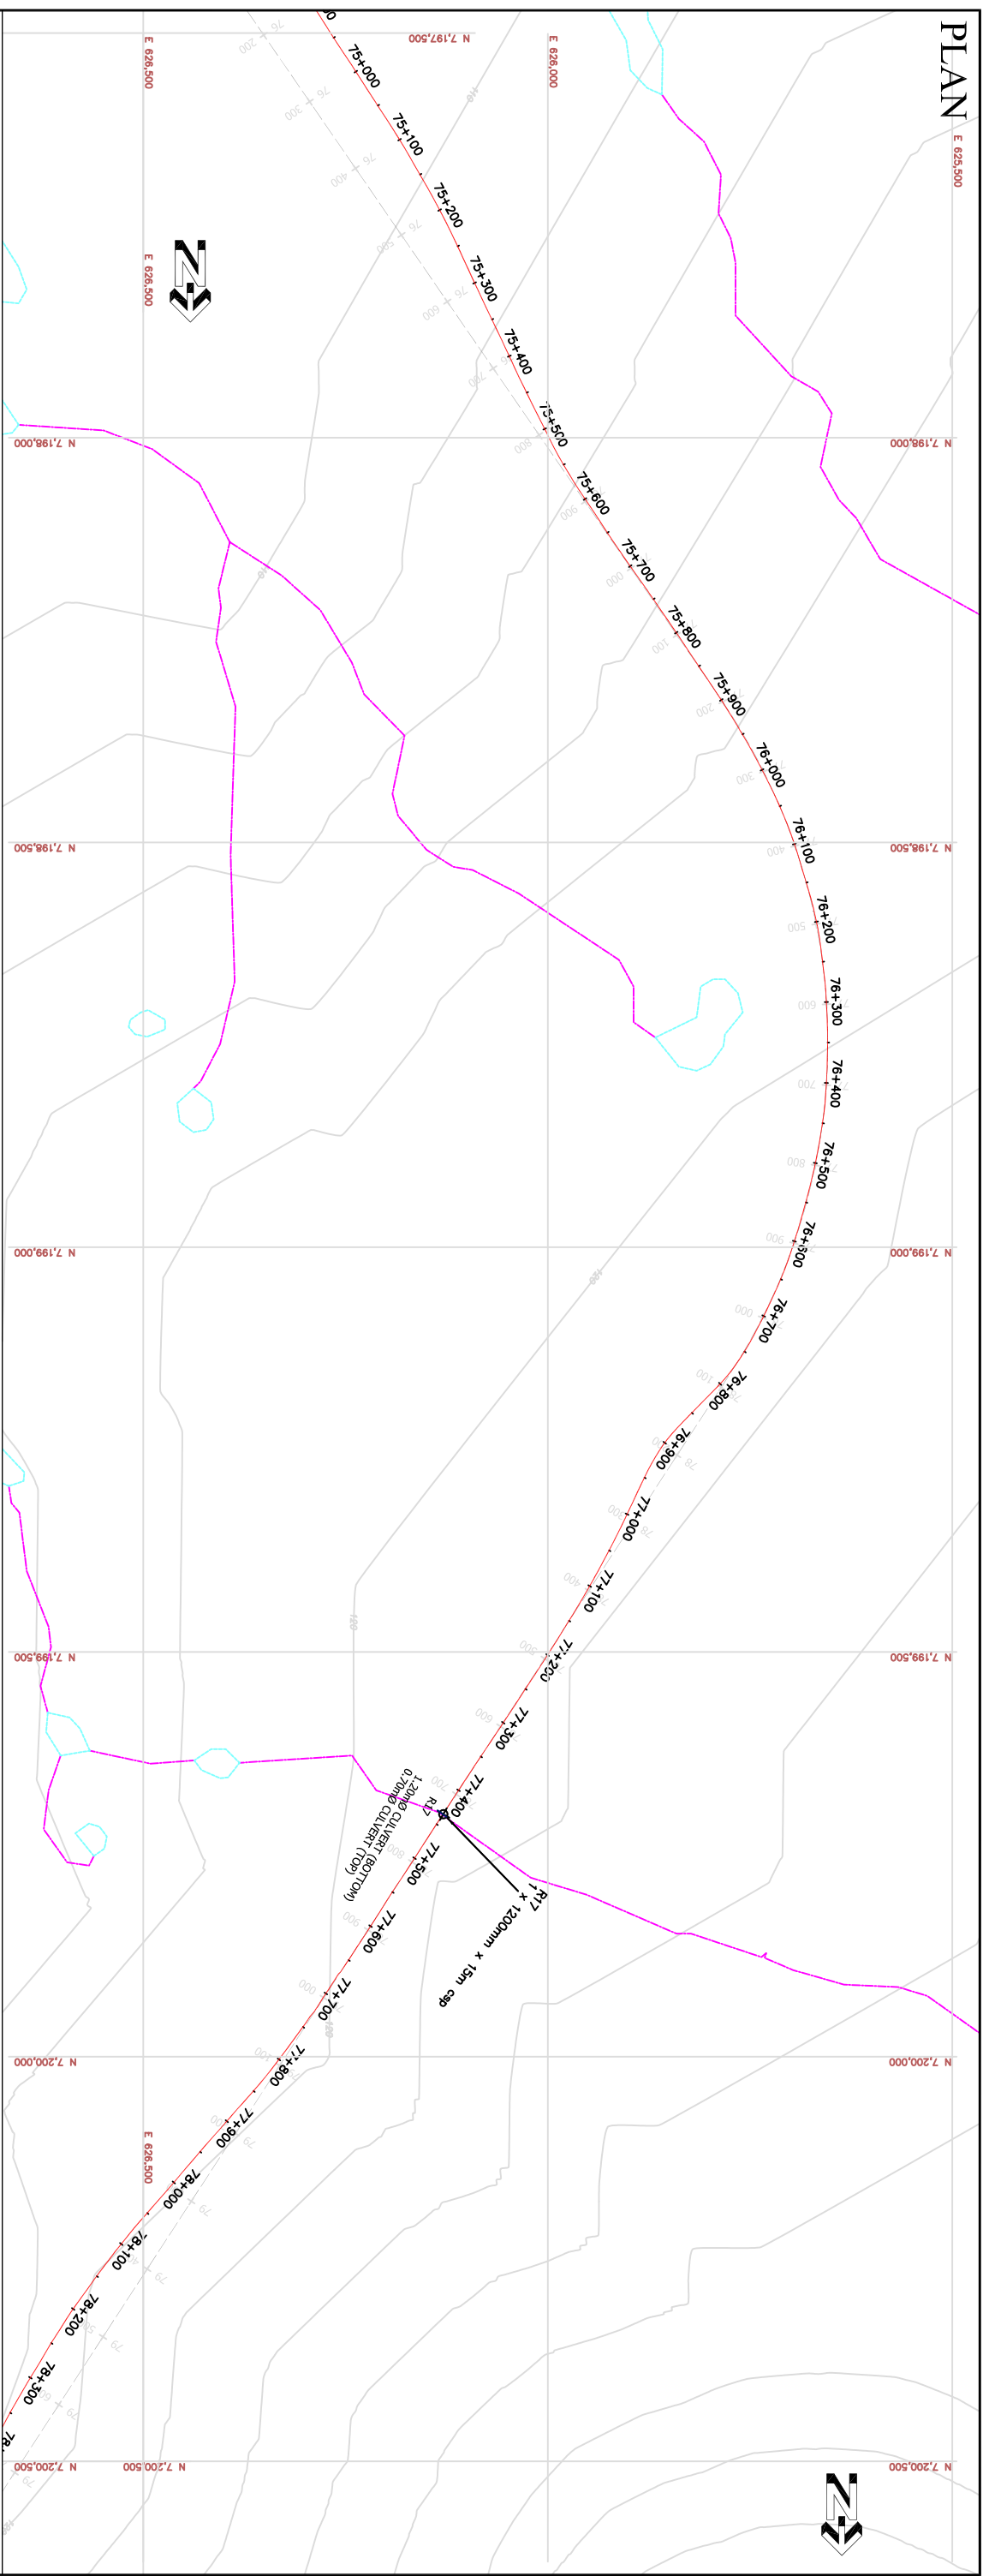


GOLDER DATA					
	LtA-3	Existing archaeological site	R02	River crossing (crossing structure and dimension)	
	Pit-13	Proposed quarry site	— 20 —	Existing major contour (10m Topo)	
		Existing lake/stream	—	Existing minor contour (uninterpreted)	
SUSCEPTIBILITY	High Medium-High Medium Low-Medium Low Unclassified				
AS CONSTRUCTED DATA					
		Quarry as-built 2m major contour	— 72 —		
		Quarry as-built 1m minor contour			
		Crest boundary of quarry limit at original ground			
		Toe boundary of quarry excavation at bench grade			
			 R20 PC-1	Centerline of road with 100m stations	
			 R02	River crossing - culvert 600mm/1200mm dia	
			 0m 100m 200m 300m	River crossing - bridge 12m / 30m length	
			Scale 1 : 8000		
NOTES					
1. Coordinate system NAD 83 UTM Zone 14N Geoid HTv2. 2. Golder data supplied by Cumberland/Agnico. 3. For quarry data, please refer to table 1. 4. For culvert data, please refer to table 2. 5. For bridge data, please refer to table 3.					
OWNER		Agnico-Eagle Mines Ltd.		Nimnawih	
PROJECT		Meadowbank Gold Project Tehuk Access Road Construction			
TITLE					
As constructed drawings - Plan and Profile					
		Stationing		Sheet	
		7+5+000 to 78+000		26 of 35	
		CAD	Check	Date	
		gcb	egmh	May 4, 2008	