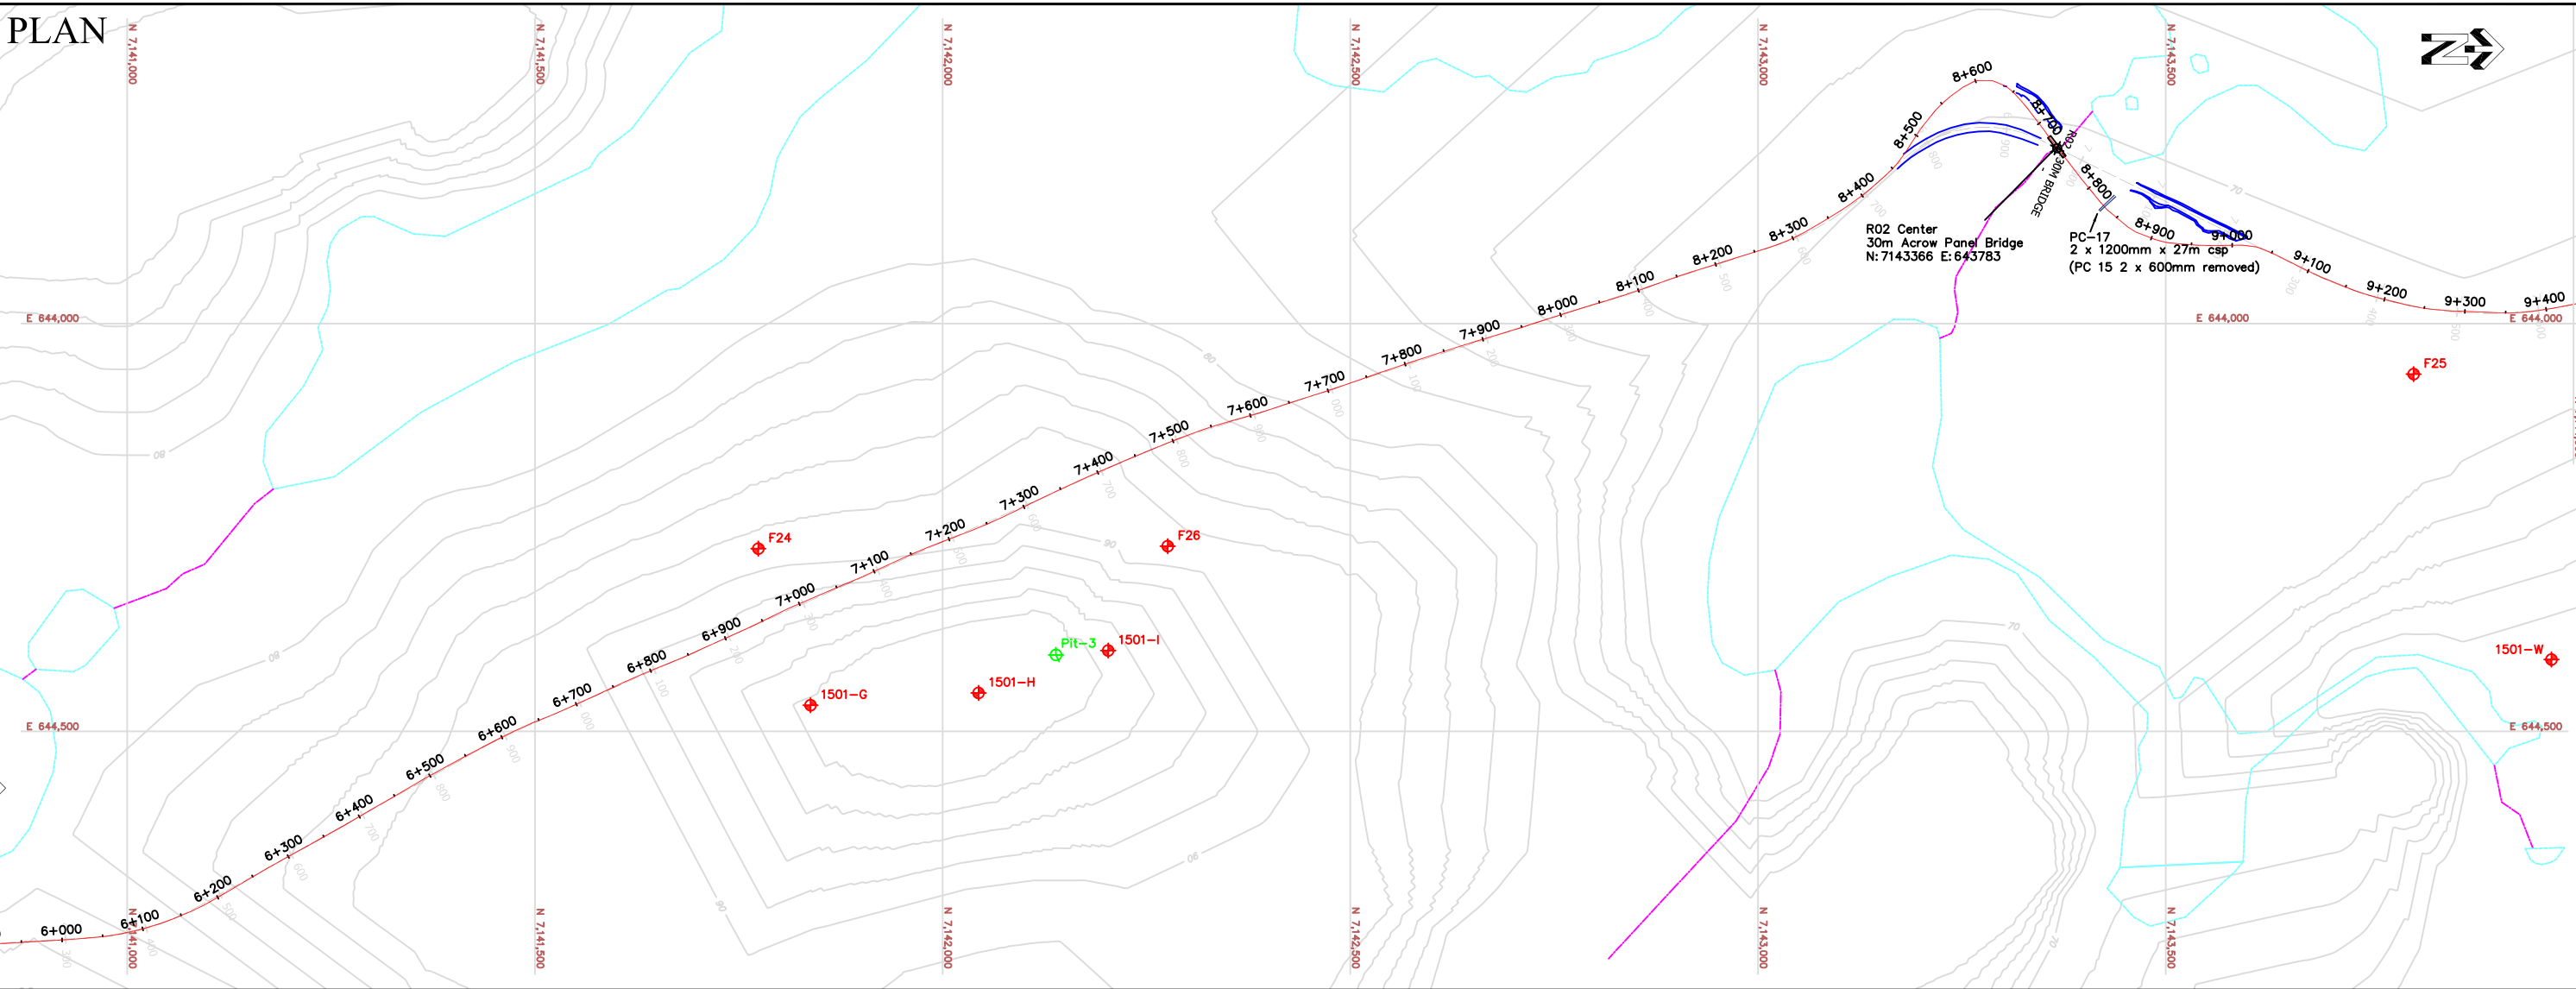


GOLDER DATA				AS CONSTRUCTED DATA				NOTES				OWNER Agnico-Eagle Mines Ltd. Nunavut											
LflA-3 Existing archeological site				R02 River crossing (crossing structure and dimension)				0+100 Centerline of road with 100m stations				1. Coordinate system NAD 83 UTM Zone 14N Geoid HTv2. 2. Golder data supplied by Cumberland/Agnico. 3. For quarry data, please refer to table 1. 4. For culvert data, please refer to table 2. 5. For bridge data, please refer to table 3.											
Pit-13 Proposed quarry site				172 Quarry as-built 2m major contour				R20 River crossing - culvert 600mm/1200mm dia															
Existing lake/stream				120 Existing major contour (10m Topo)				PC-1 Quarry as-built 1m minor contour															
Existing minor contour (interpreted)				R02 Crest boundary of quarry limit at original ground				R02 River crossing - bridge 12m / 30m length															
Proposed $\frac{1}{2}$ of road alignment				Toe boundary of quarry excavation at bench grade				0m 100m 200m 300m Scale 1: 8000				 M & T SERVICES LTD.											
SUSCEPTIBILITY High Medium-High Medium Low-Medium Low Unclassified								Stationing 6+000 to 9+000								Sheet 3 of 35							
												CAD gc				Check cg/hb				Date March 31, 2008			