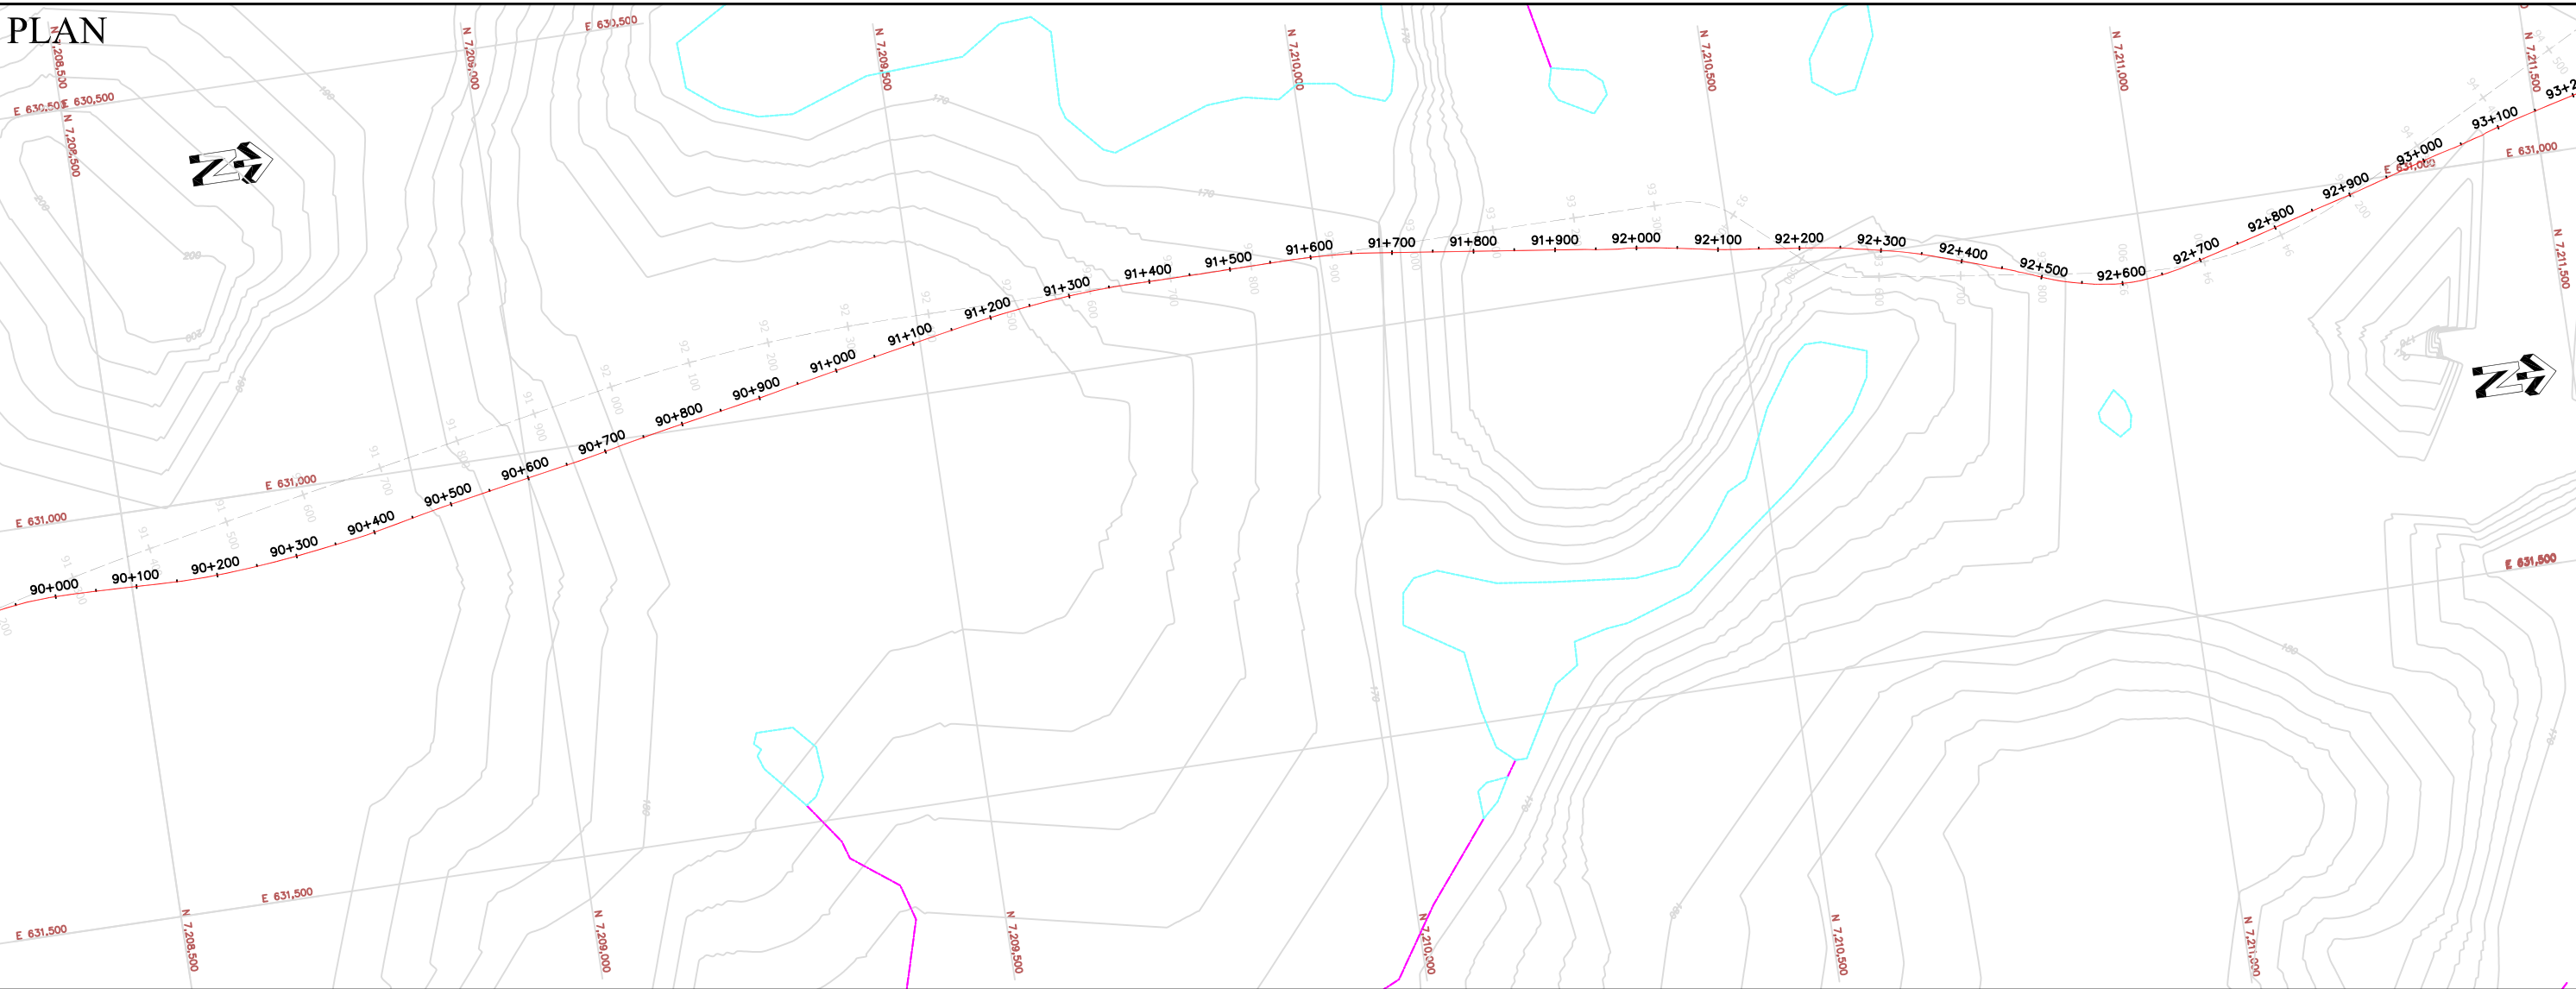


GOLDER DATA				AS CONSTRUCTED DATA				NOTES				OWNER Agnico-Eagle Mines Ltd. Nunavut			
 LfLa-3 Existing archeological site  Pit-13 Proposed quarry site  Existing lake/stream  R02 River crossing (crossing structure and dimension)  120 Existing major contour (10m Topo)  Existing minor contour (interpreted)  Proposed ϵ of road alignment SUSCEPTIBILITY  High  Medium-High  Medium  Low-Medium  Low  Unclassified				 172 Quarry as-built 2m major contour  Quarry as-built 1m minor contour  Crest boundary of quarry limit at original ground  Toe boundary of quarry excavation at bench grade  0+100 Centerline of road with 100m stations  R20  PC-1 River crossing - culvert 600mm/1200mm dia  R02 River crossing - bridge 12m / 30m length  0m 100m 200m 300m Scale 1: 8000				1. Coordinate system NAD 83 UTM Zone 14N Geoid HTv2. 2. Golder data supplied by Cumberland/Agnico. 3. For quarry data, please refer to table 1. 4. For culvert data, please refer to table 2. 5. For bridge data, please refer to table 3.				PROJECT Meadowbank Gold Project Tehek Access Road Construction TITLE As constructed drawings - Plan and Profile NUNA M & T SERVICES LTD. Stationing 90+000 to 93+000 CAD gc Sheet 31 of 35 Check cg/hb Date March 31, 2008			