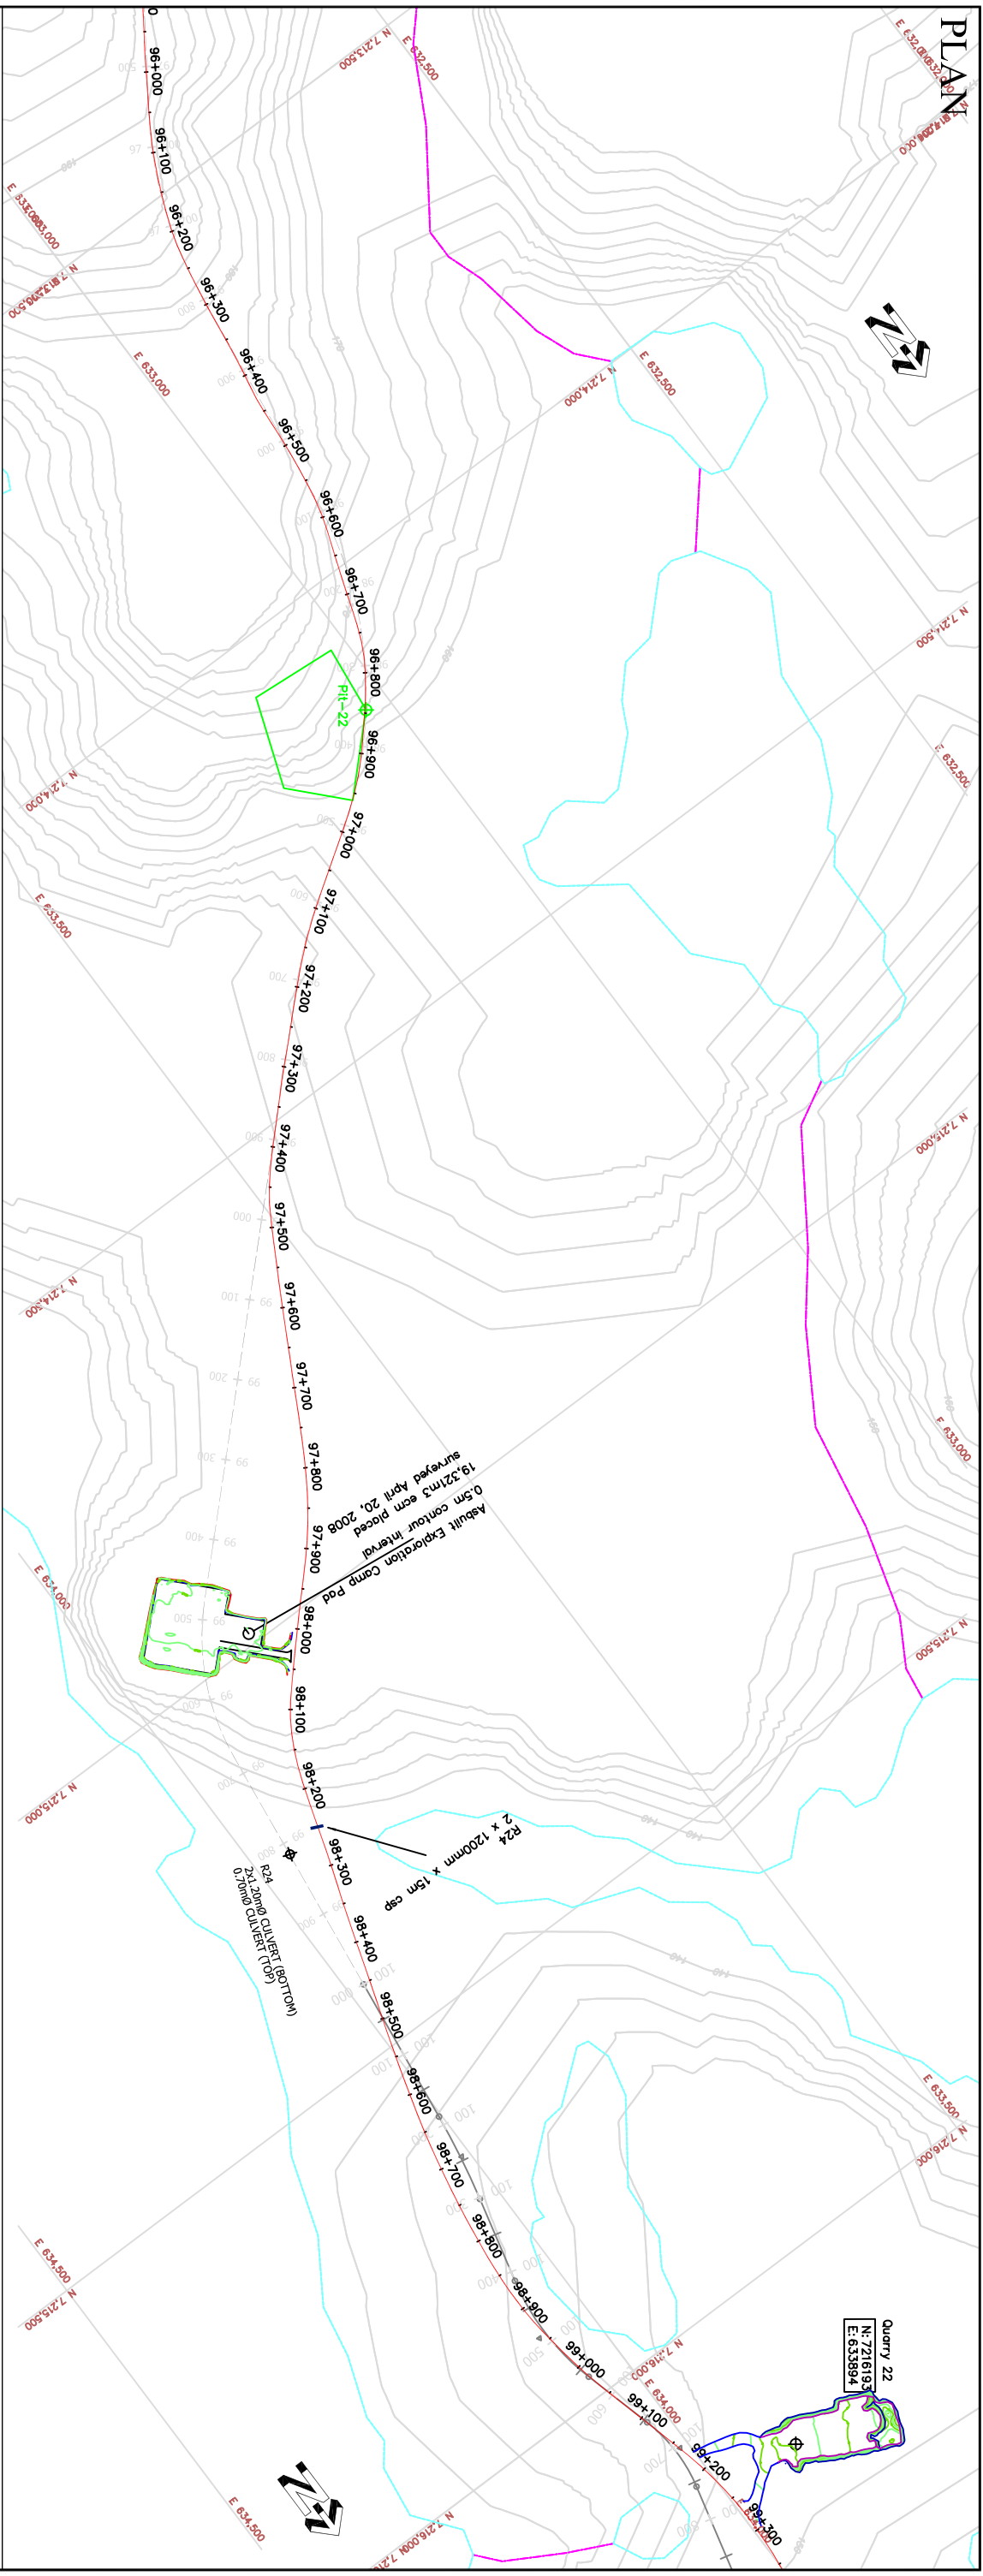


GOLDER DATA		AS CONSTRUCTED DATA		NOTES
 LN-a-3	Existing archeological site	 R02	River crossing (crossing structure and dimension)	1. Coordinate system NAD 83 UTM Zone 14N Geoid HTV2. 2. Golder data supplied by Cumberland/Agnico. 3. For quarry data, please refer to table 1. 4. For culvert data, please refer to table 2. 5. For bridge data, please refer to table 3.
 Pt-13	Proposed quarry site	— 120 —	Existing major contour (10m Topo)	
	Existing lake/stream	—	Existing minor contour (interpreted)	
		— — — — —	Proposed ϵ of road alignment	
SUSCEPTIBILITY	 High  Medium-High  Medium  Low-Medium  Low  Unclassified			
		 172  0+100  R20  PC-1  R02 	Centreline of road with 100m stations Quarry as-built 2m major contour Quarry as-built 1m minor contour River crossing - culvert 600mm/1200mm dia River crossing - bridge 12m / 30m length Toe boundary of quarry excavation at bench grade	
		 Scale 1: 8000		
 NUNA		Stationing 96+000 to 99+000 CAD Check eg/hb May 4, 2008		Sheet 33 of 35 Date
 M & T SERVICES LTD.				
OWNER		Agnico-Eagle Mines Ltd.		Nunavut
PROJECT		Meadowbank Gold Project Tehk Access Road Construction		
TITLE		As constructed drawings - Plan and Profile		