



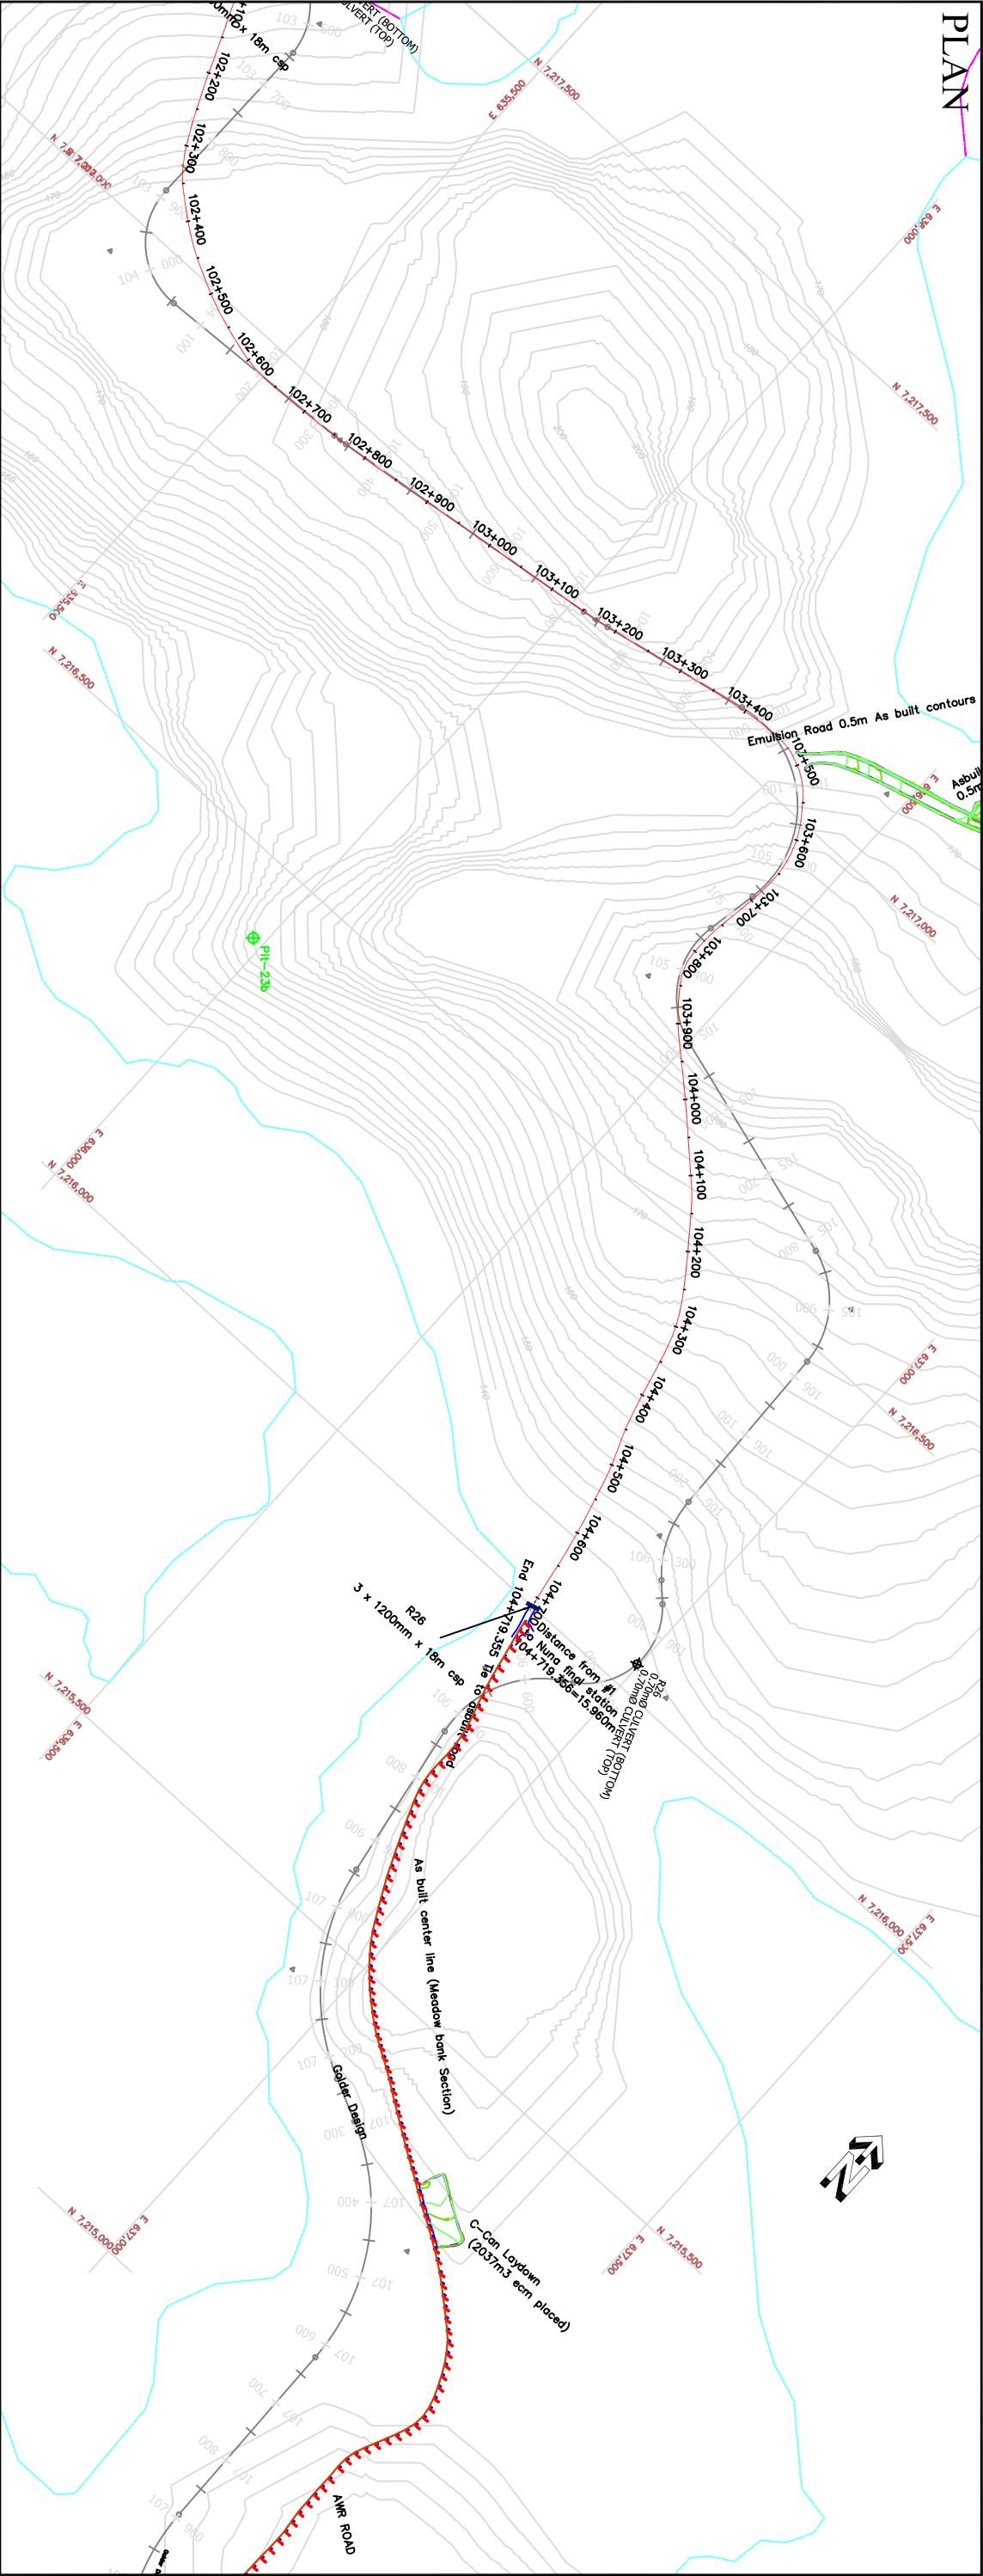

PROFILE

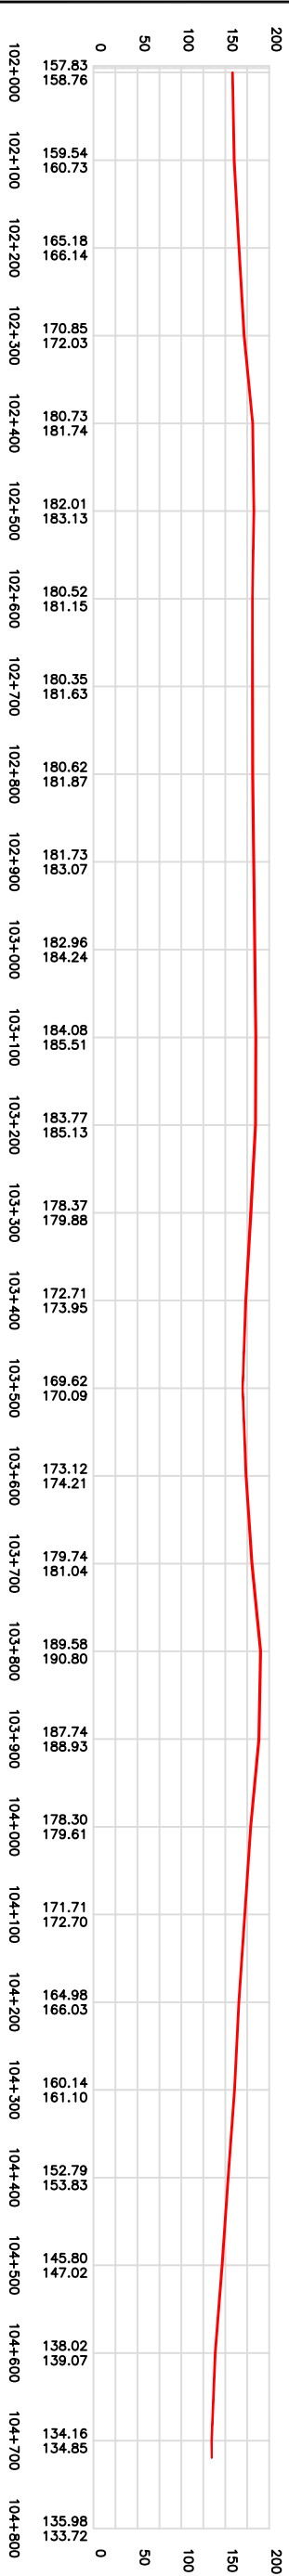

horizontal scale = vertical scale = 1:1

GOLDER DATA				AS CONSTRUCTED DATA				NOTES	
	LFI-3	Existing archeological site		R02	River crossing (crossing structure and dimension)		L72	Quarry as-built 2m major contour	0+100 0m 100m 200m 300m Scale 1: 8000
	Pit-13	Proposed quarry site		120	Existing major contour (10m Topo)		R20	Quarry as-built 1m minor contour	
		Existing lake/stream			Existing minor contour (interpreted)		PC-1	Crest boundary of quarry limit at original ground	
		Proposed £ of road alignment		R02			R02	Crest boundary of quarry excavation at bench grade	
	SUSCEPTIBILITY	 High	 Medium-High	 Medium	 Low-Medium	 Low	 Unclassified		
								1. Coordinate system NAD 83 UTM Zone 14N Geoid HTV2.	
								2. Golder data supplied by Cumberland/Agnico.	
								3. For quarry data, please refer to table 1.	
								4. For culvert data, please refer to table 2.	
								5. For bridge data, please refer to table 3.	
								OWNER	
								PROJECT	
								TITLE	
								As constructed drawings - Plan and Profile	
								Stationing	
								CAD	
								Check	
								cg/hb	
								Date	
								May 4, 2008	
								M & T SERVICES LTD.	