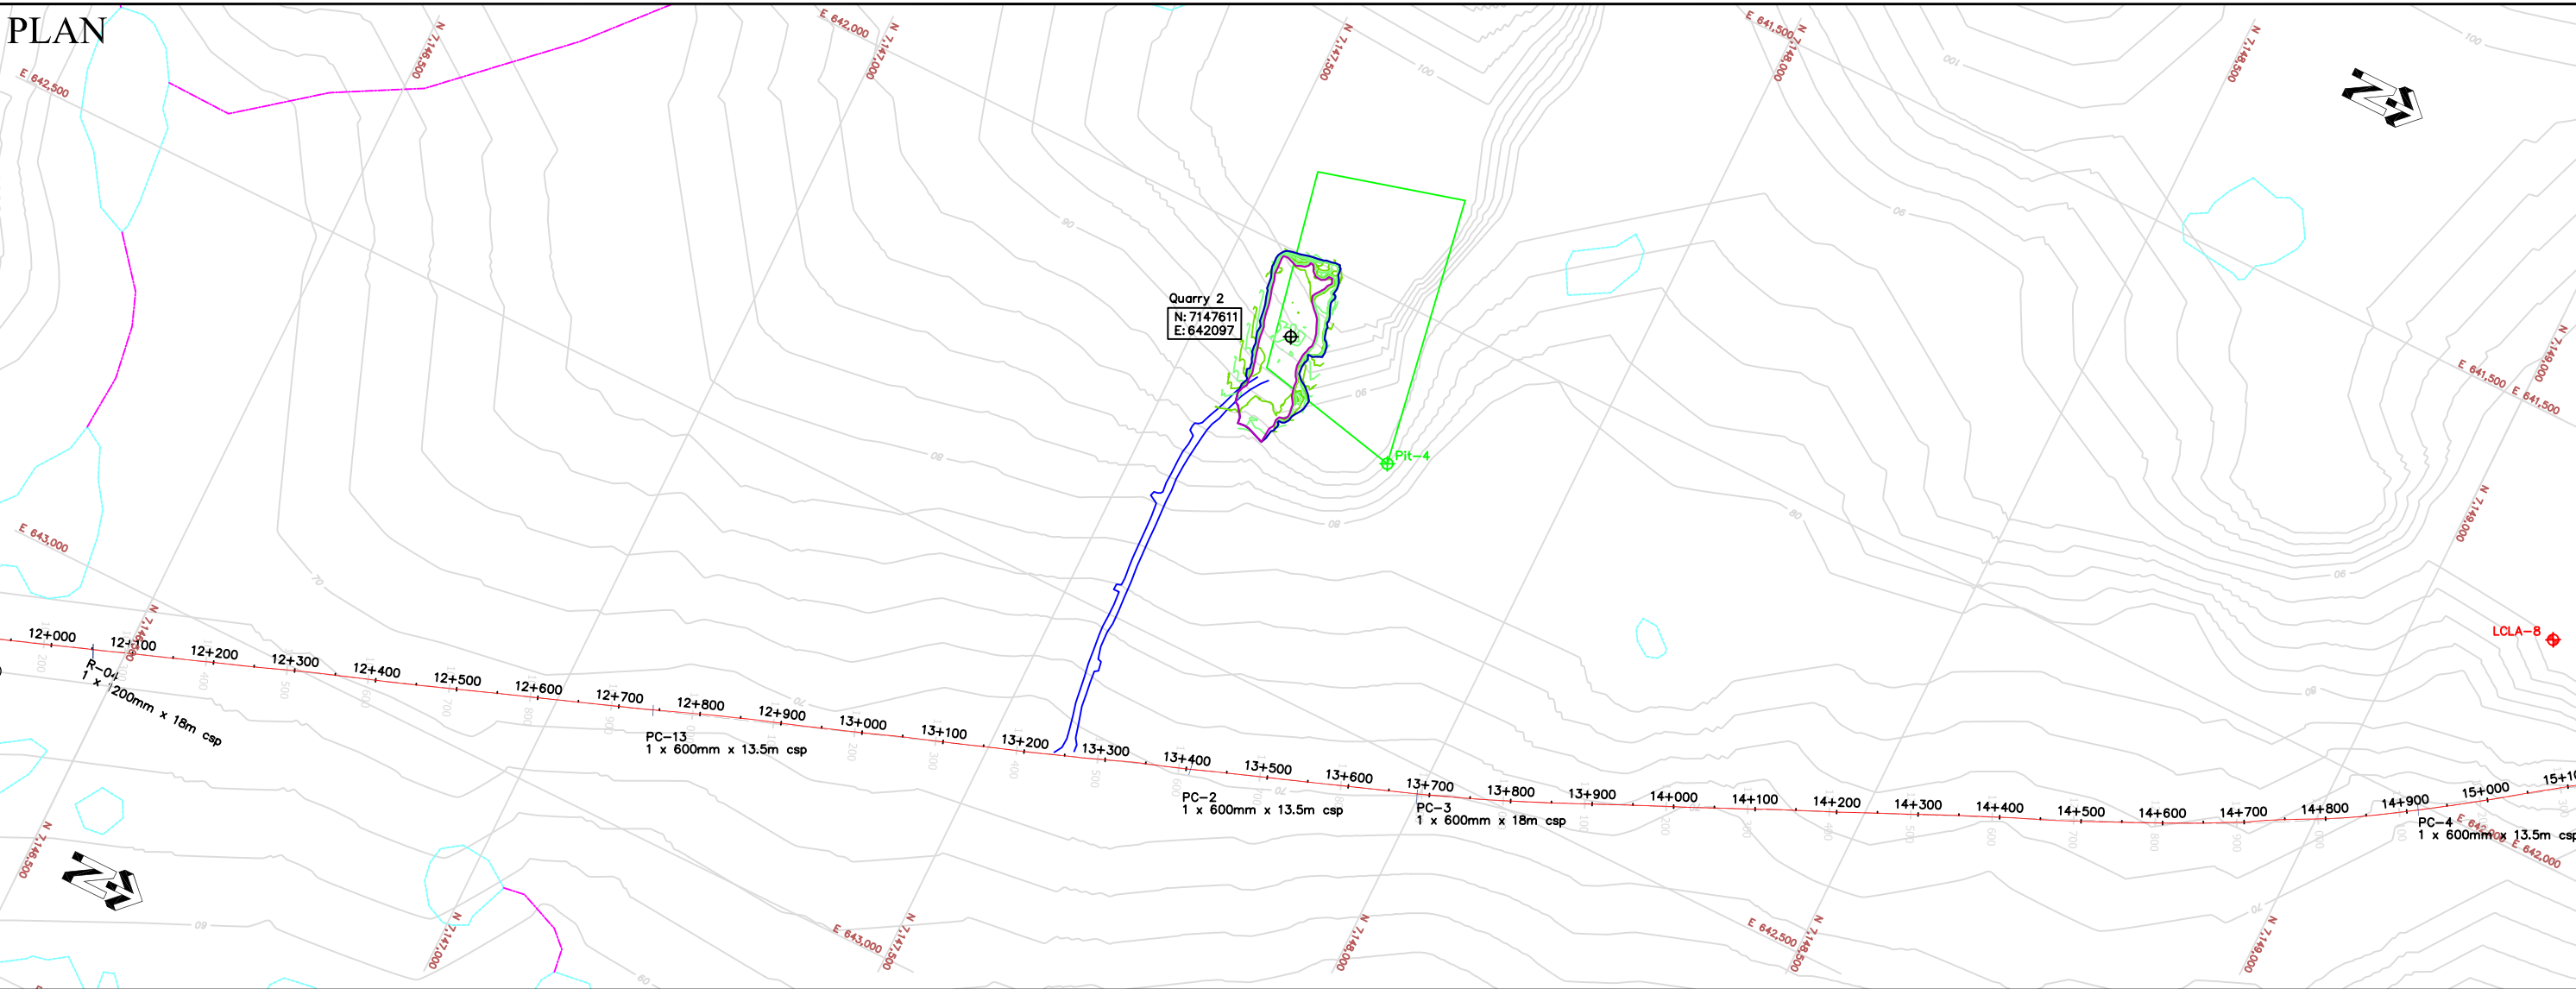


GOLDER DATA				AS CONSTRUCTED DATA				NOTES				OWNER Agnico-Eagle Mines Ltd. Nunavut			
LfLa-3 Existing archeological site				R02 River crossing (crossing structure and dimension)				0+100 Centerline of road with 100m stations				1. Coordinate system NAD 83 UTM Zone 14N Geoid HTv2. 2. Golder data supplied by Cumberland/Agnico. 3. For quarry data, please refer to table 1. 4. For culvert data, please refer to table 2. 5. For bridge data, please refer to table 3.			
Pit-13 Proposed quarry site				120 Existing major contour (10m Topo)				R20 PC-1 River crossing - culvert 600mm/1200mm dia							
Existing lake/stream				Existing minor contour (interpreted)				R02 River crossing - bridge 12m / 30m length							
Proposed centerline of road alignment				Crest boundary of quarry limit at original ground				0m 100m 200m 300m Scale 1: 8000							
Toe boundary of quarry excavation at bench grade															
SUSCEPTIBILITY															
High				Medium-High				Medium				Low-Medium			
Low				Unclassified											