



PLAN

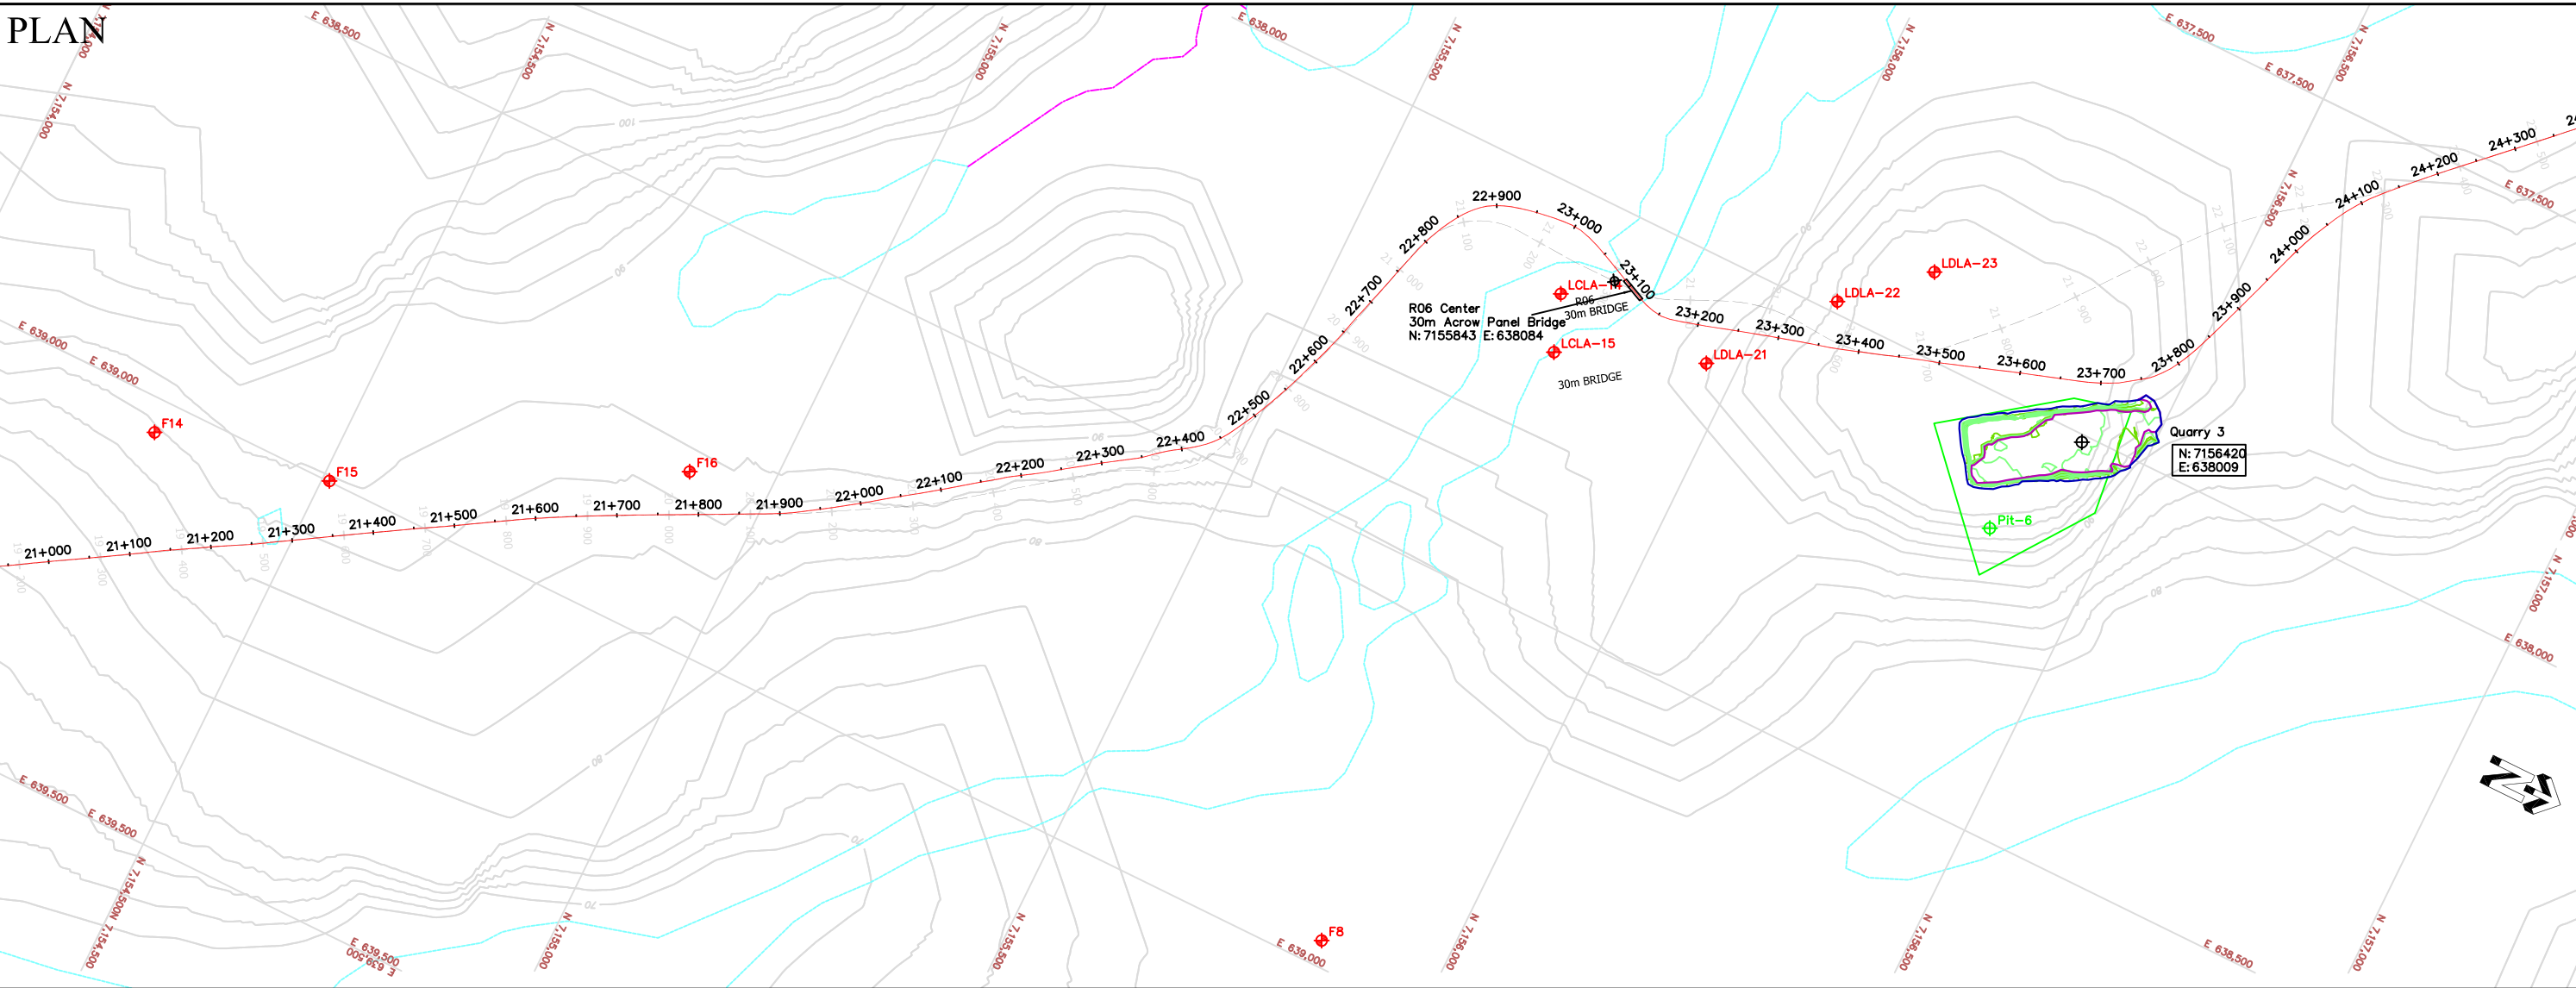

PROFILE

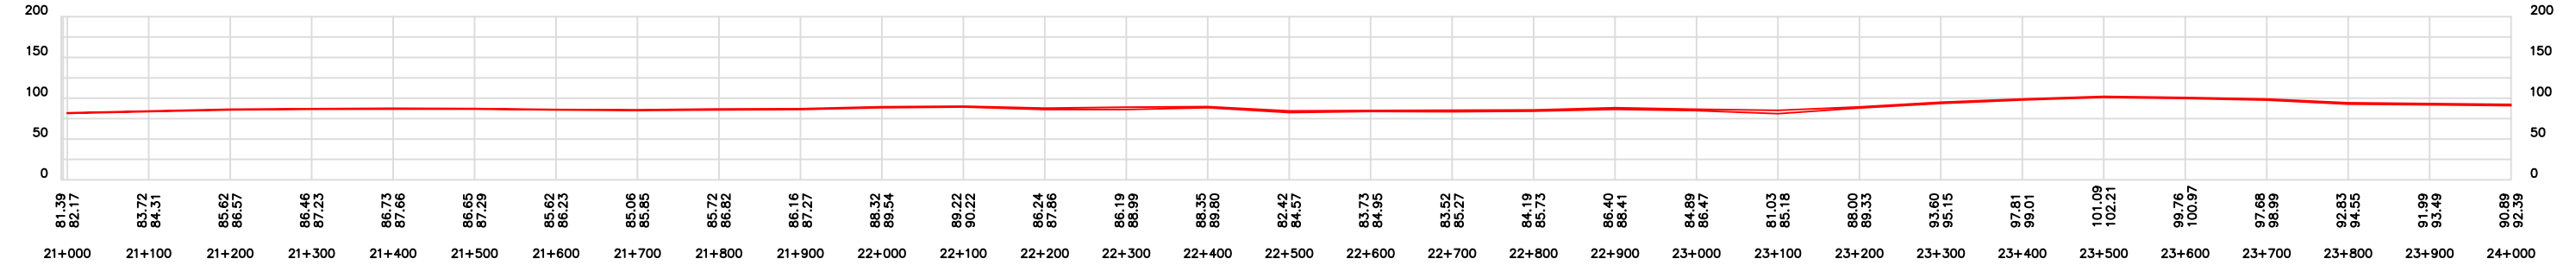

GOLDER DATA			AS CONSTRUCTED DATA			NOTES			OWNER		
LfLa-3 Existing archeological site			R02 River crossing (crossing structure and dimension)			0+100 Centerline of road with 100m stations			Agnico-Eagle Mines Ltd. Nunavut		
Pit-13 Proposed quarry site			120 Existing major contour (10m Topo)			R20 River crossing - culvert 600mm/1200mm dia			PROJECT Meadowbank Gold Project		
Existing lake/stream			Existing minor contour (interpreted)			R02 River crossing - bridge 12m / 30m length			TITLE As constructed drawings - Plan and Profile		
Proposed $\frac{1}{2}$ of road alignment			Toe boundary of quarry excavation at bench grade			Scale 1: 8000			M & T SERVICES LTD.		
SUSCEPTIBILITY									Stationing 21+000 to 24+000 Sheet 8 of 35		
High Medium-High Medium Low-Medium Low Unclassified									CAD gc Check cg/hb Date March 31, 2008		