



PLAN

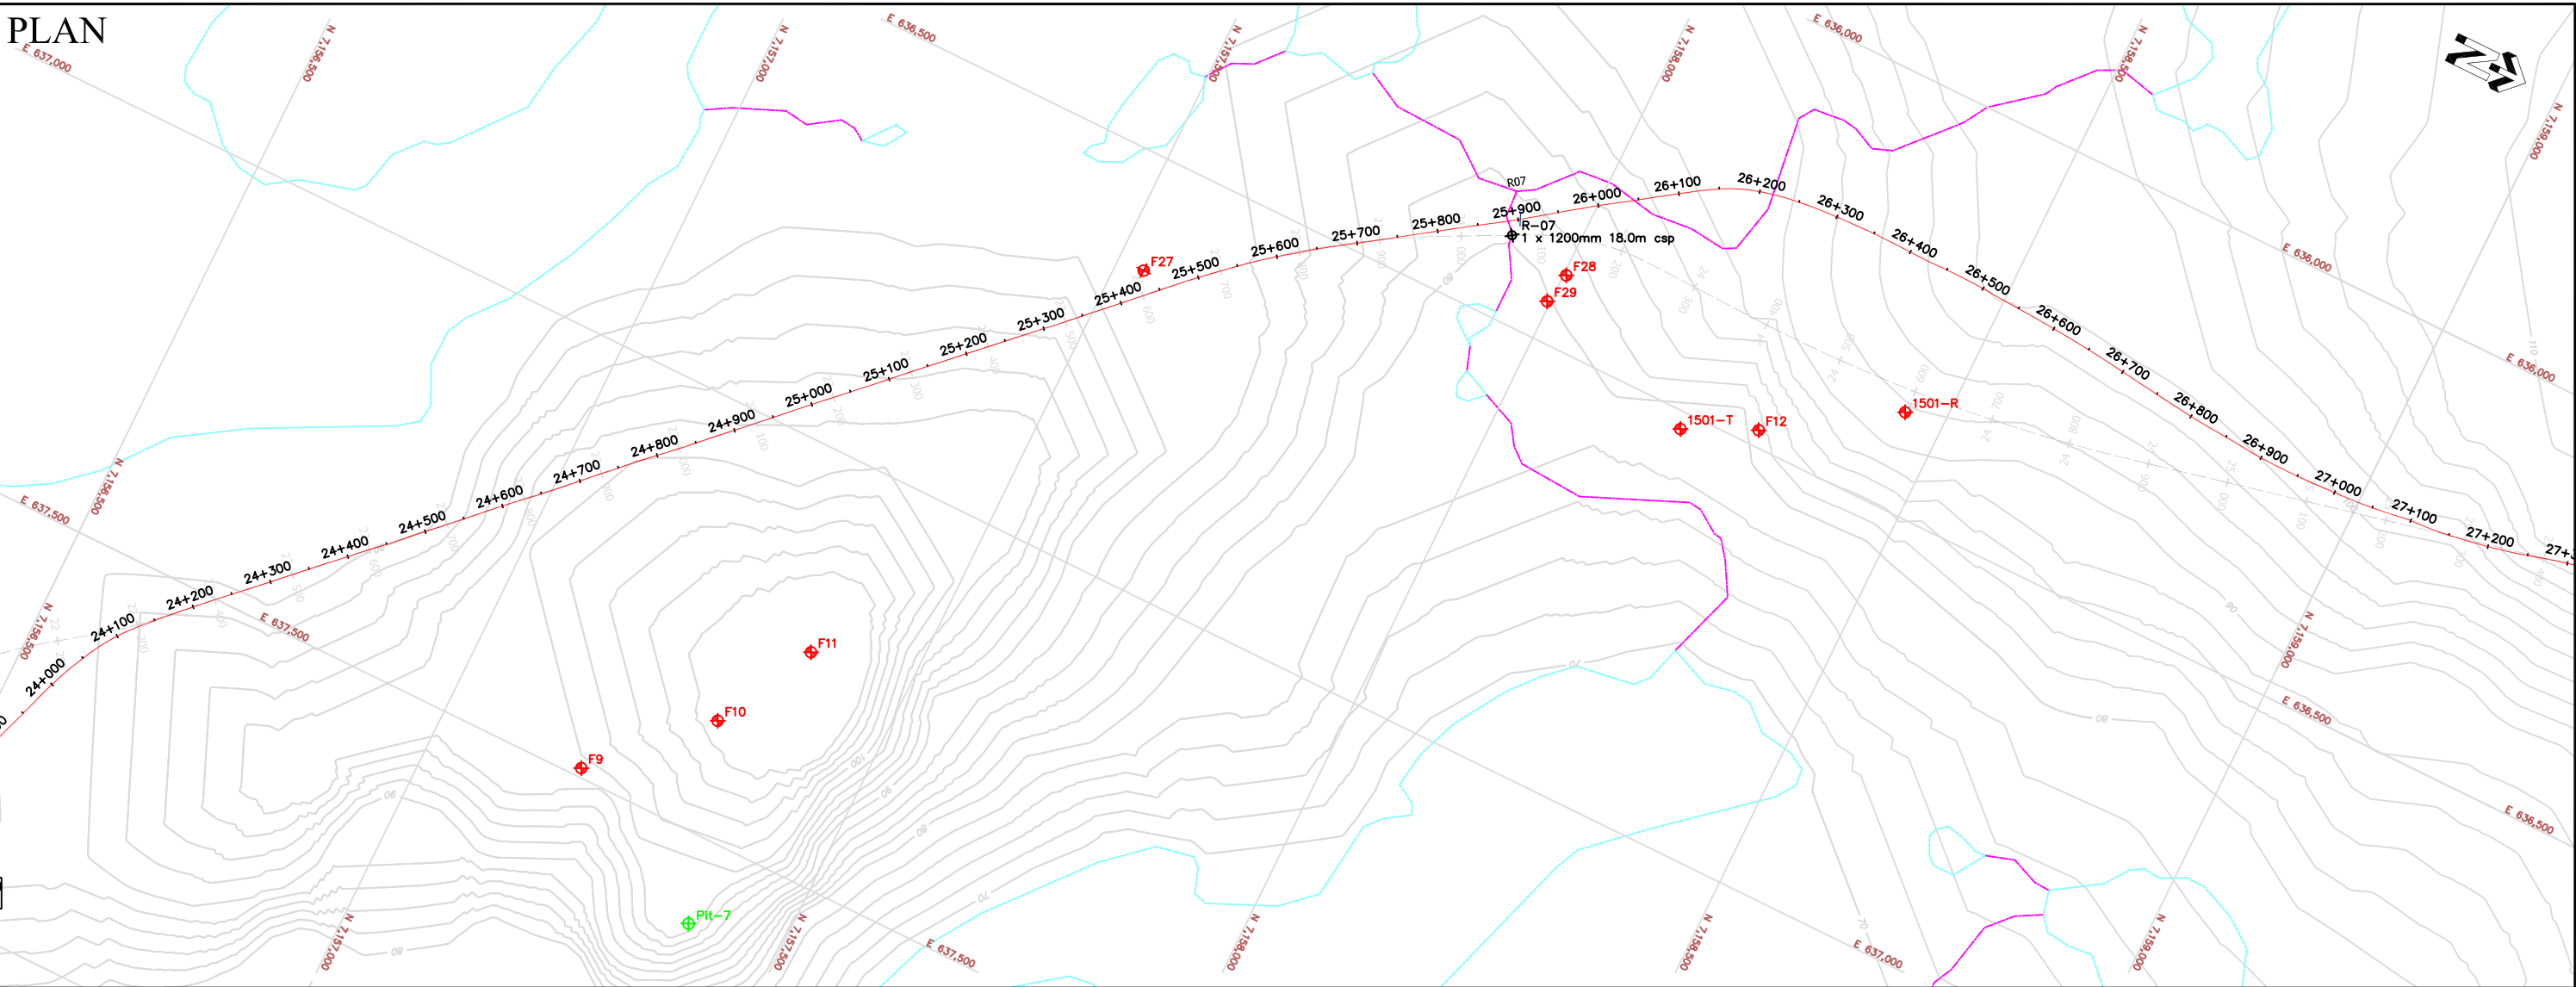

PROFILE

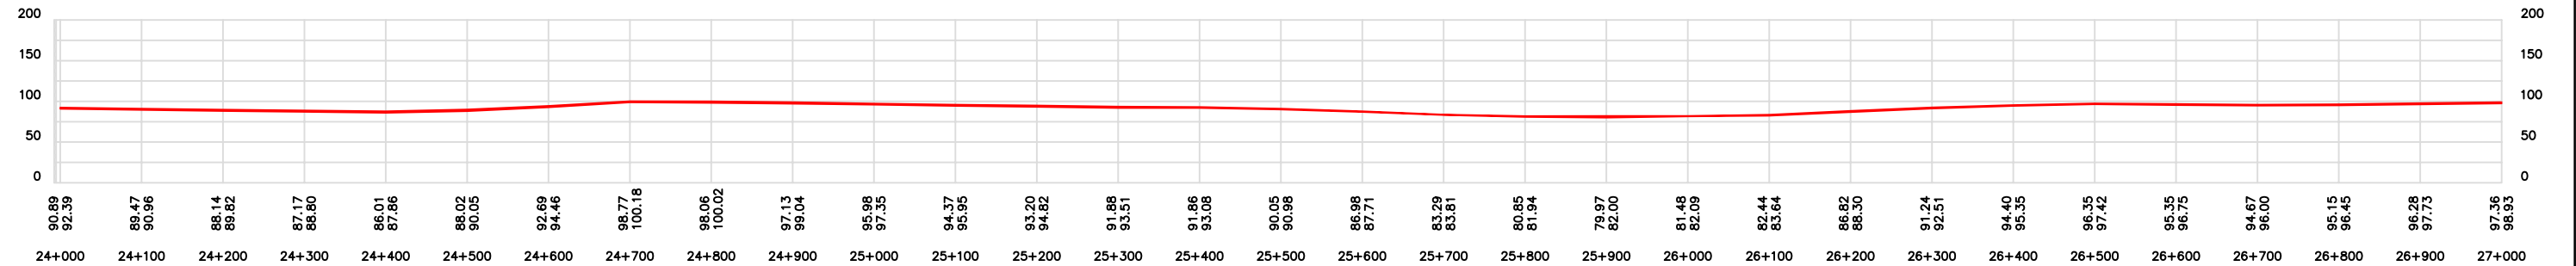

GOLDER DATA				AS CONSTRUCTED DATA				NOTES		OWNER Agnico-Eagle Mines Ltd. Nunavut	
LfLa-3 Existing archeological site				R02 River crossing (crossing structure and dimension)				0+100 Centerline of road with 100m stations		1. Coordinate system NAD 83 UTM Zone 14N Geoid HTv2.	
Pit-13 Proposed quarry site				120 Existing major contour (10m Topo)				R20 River crossing - culvert 600mm/1200mm dia		2. Golder data supplied by Cumberland/Agnico.	
Existing lake/stream				Existing minor contour (interpreted)				R02 River crossing - bridge 12m / 30m length		3. For quarry data, please refer to table 1.	
				Proposed centerline of road alignment				0m 100m 200m 300m Scale 1: 8000		4. For culvert data, please refer to table 2.	
SUSCEPTIBILITY High Medium-High Medium Low-Medium Low Unclassified				Toe boundary of quarry excavation at bench grade						5. For bridge data, please refer to table 3.	
										NUNA M & T SERVICES LTD.	
										Stationing 24+000 to 27+000	
										Sheet 9 of 35	
										CAD gc	
										Check cg/hb	
										Date March 31, 2008	