


Quantity construction chart*
Temporary Diffuser Access Road and Pad
*Theoretical measure in place quantities

	Thickness (mm)	Required (m³)
50mm MINUS	300	587
Run of Mine or Borrow Pit Material (CL. A)	±450	3011
Total	-	3598

TEL QUE CONSTRUIT
AS BUILT
AGNICO EAGLE
DATE : 2018-09-14

TETRA TECH
**FINAL ISSUE
AFTER CONSTRUCTION**
SOME ANNOTATIONS HAVE BEEN
ADDED TO THE DRAWING ISSUED
FOR CONSTRUCTION IN ORDER TO
INCORPORATE THE INFORMATIONS
RECEIVED. IN THIS PROJECT, TETRA TECH
HADN'T DONE ANY FIELD SUPERVISION
AT THE CONSTRUCTION SITE.

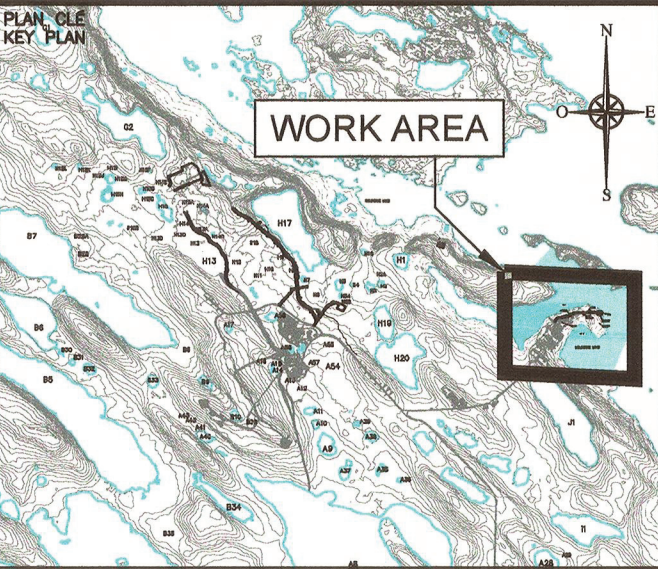

NOTES GÉNÉRALES / GENERAL NOTES

- GENERAL NOTE:
1. EXISTING GROUND DTM PROVIDED BY AEM.
 2. ALL UNITS ARE IN METERS.
 3. ELEVATIONS IN DRAWING PROVIDE FINISHED GRADE ELEVATIONS AT THE TOP OF THE SURFACE GRAVEL LAYER.
 4. THE CONTRACTOR SHALL BE RESPONSIBLE FOR THE SAFETY, SECURITY AND SLOPES OF ALL EXCAVATIONS/ BACKFILL AND SHALL ABIDE BY ALL RELEVANT STANDARDS AND REGULATIONS. THE STABILITY, DEWATERING AND MAINTENANCE OF ALL EXCAVATIONS SHALL BE THE CONTRACTOR'S RESPONSIBILITY.
 5. GRANULAR MATERIAL SHALL BE PLACED IN LIFTS NOT EXCEEDING 300mm AND COMPACTED TO A MINIMUM OF 95% OF MAXIMUM DRY DENSITY. BORROW PIT OR RUN OF MINE MATERIAL 600mm MINUS SHALL BE PLACED IN LIFTS NOT EXCEEDING 600mm AND COMPACTED TO A MINIMUM OF 90% OF MAXIMUM DRY DENSITY. MOISTURE CONDITIONING MAY BE REQUIRED PRIOR TO COMPACTION.

L'INFORMATION D'ENQUÊTE EST LA PROPRIÉTÉ DE AGNICO EAGLE LTD ET DOIT ÊTRE RETENUE PAR AGNICO EAGLE. TOUTE REPRODUCTION OU COPIE À TITRE D'ILLUSTRATION N'EST PAS PERMISE. © AGNICO EAGLE LTD.
ALL INFORMATION HEREIN IS THE PROPERTY OF AGNICO EAGLE LTD. AND MUST BE RETAINED BY AGNICO EAGLE. ANY REPRODUCTION OR COPIE FOR ILLUSTRATION PURPOSES IS NOT PERMITTED. © AGNICO EAGLE LTD.

DESSINS EN RÉFÉRENCE / REFERENCE DRAWINGS

TITRE / TITLE	# DWG
RELEVÉ TQC 2016	65-000-210-200



PERMIT TO PRACTICE REVISIONS
TETRA TECH INDUSTRIES, INC.
O/A TETRA TECH
Signature: *[Signature]*
Date: 2018-09-18
PERMIT NUMBER: P 1029
NTNL Association of Professional Engineers and Geoscientists

TITRE / TITLE
AGNICO EAGLE - MELIADINE DIVISION
417 - ROADS, YARDS, FENCES, AND OTHER
230 - GENERAL EARTH WORKS
MELIADINE LAKE DIFFUSER TEMPORARY SERVICE ROAD
PLAN AND PROFILE VIEW

DESSINÉ PAR DRAWN BY	CHRISTOPHER MORIN	DATE 2017-04-26
VÉRIFIÉ PAR CHECKED BY	SOLÈNE MOREAU	2017-04-26
APPROUVÉ PAR APPROVED BY	JOSÉE ALARIE	2017-04-26

ÉCHELLE
SCALE AS SHOWN 2016-04-26

NO. DESSIN
DRAWING NO. 65-417-230-223

NO. PROJET PROJECT NO.	REVISION	FEUILLE / SHEET
6515/28920	1	1 / 1