


Appendix B-3

As-built drawing of mitigation work

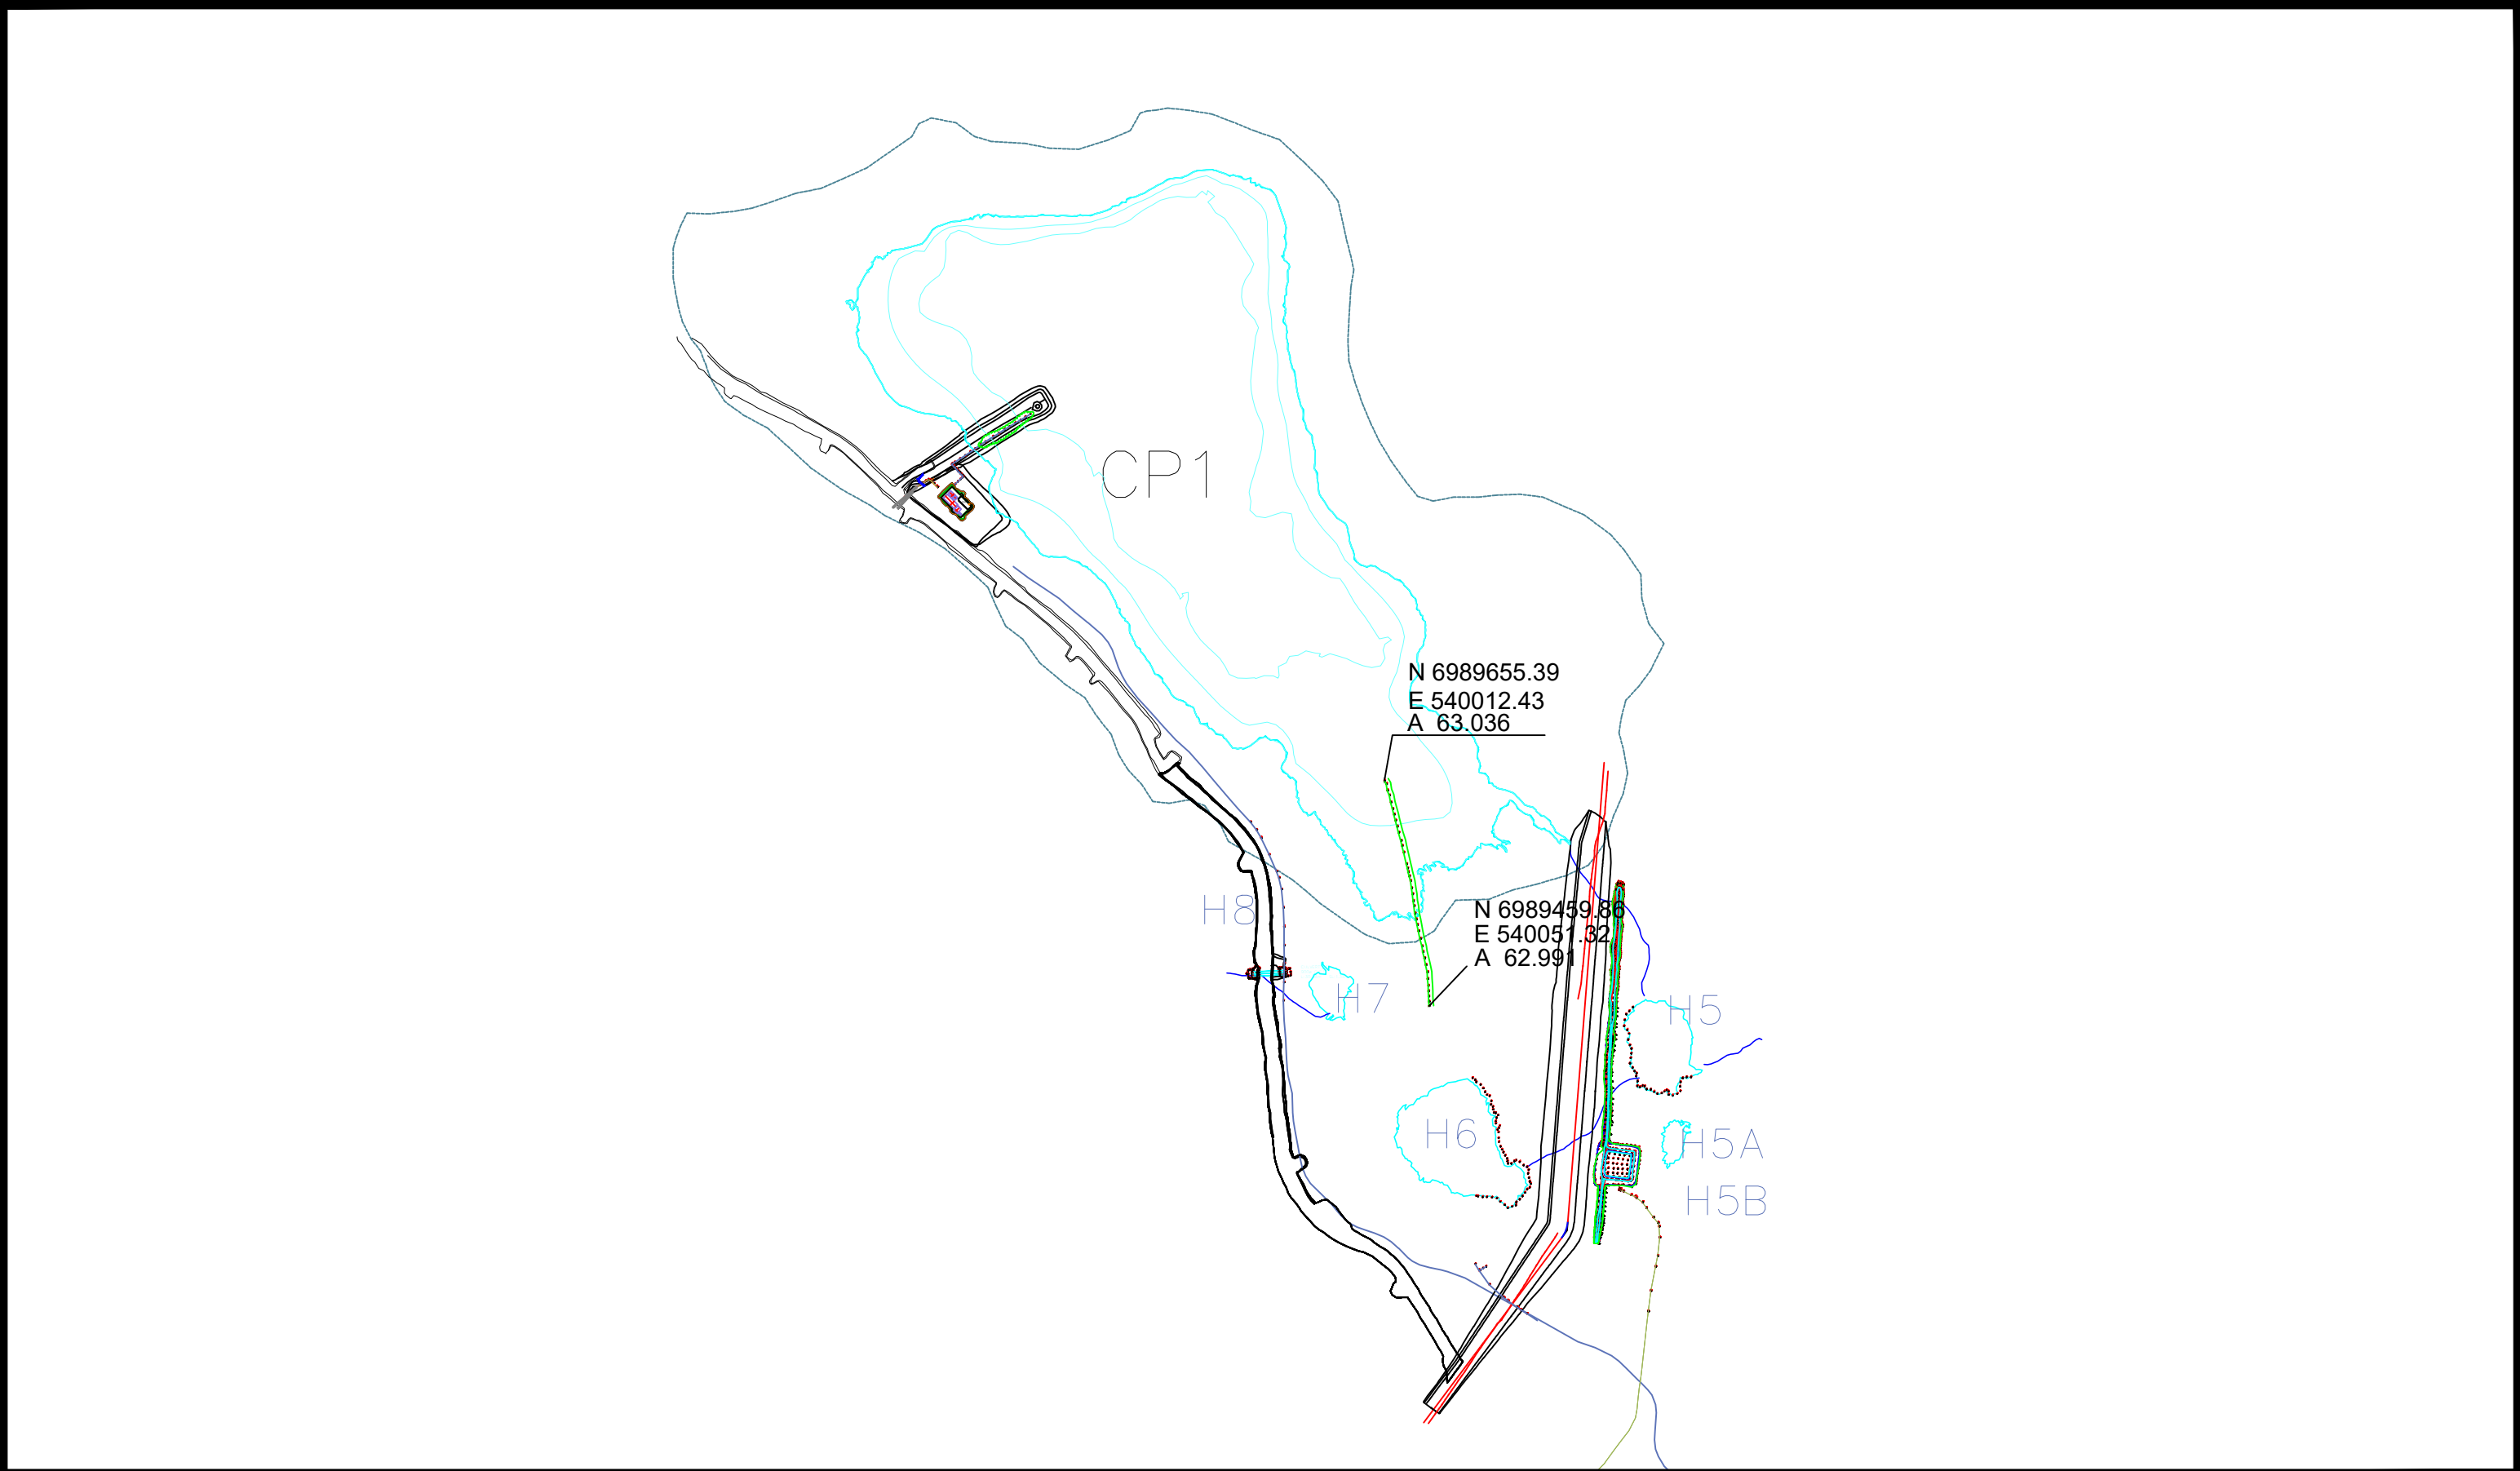

Système de Coord.:
UTM15 NAD83

Echelle:
NA

No plan:

65-695-CP1 TRENCH

ALIGNMENT CP1 TRENCH

AGNICO

Date des travaux :

2018-09

Date d'envoi :

2018-10-24

Dessiné par:

Y. Hamel

Approuvé par:

HAMEL ARP