




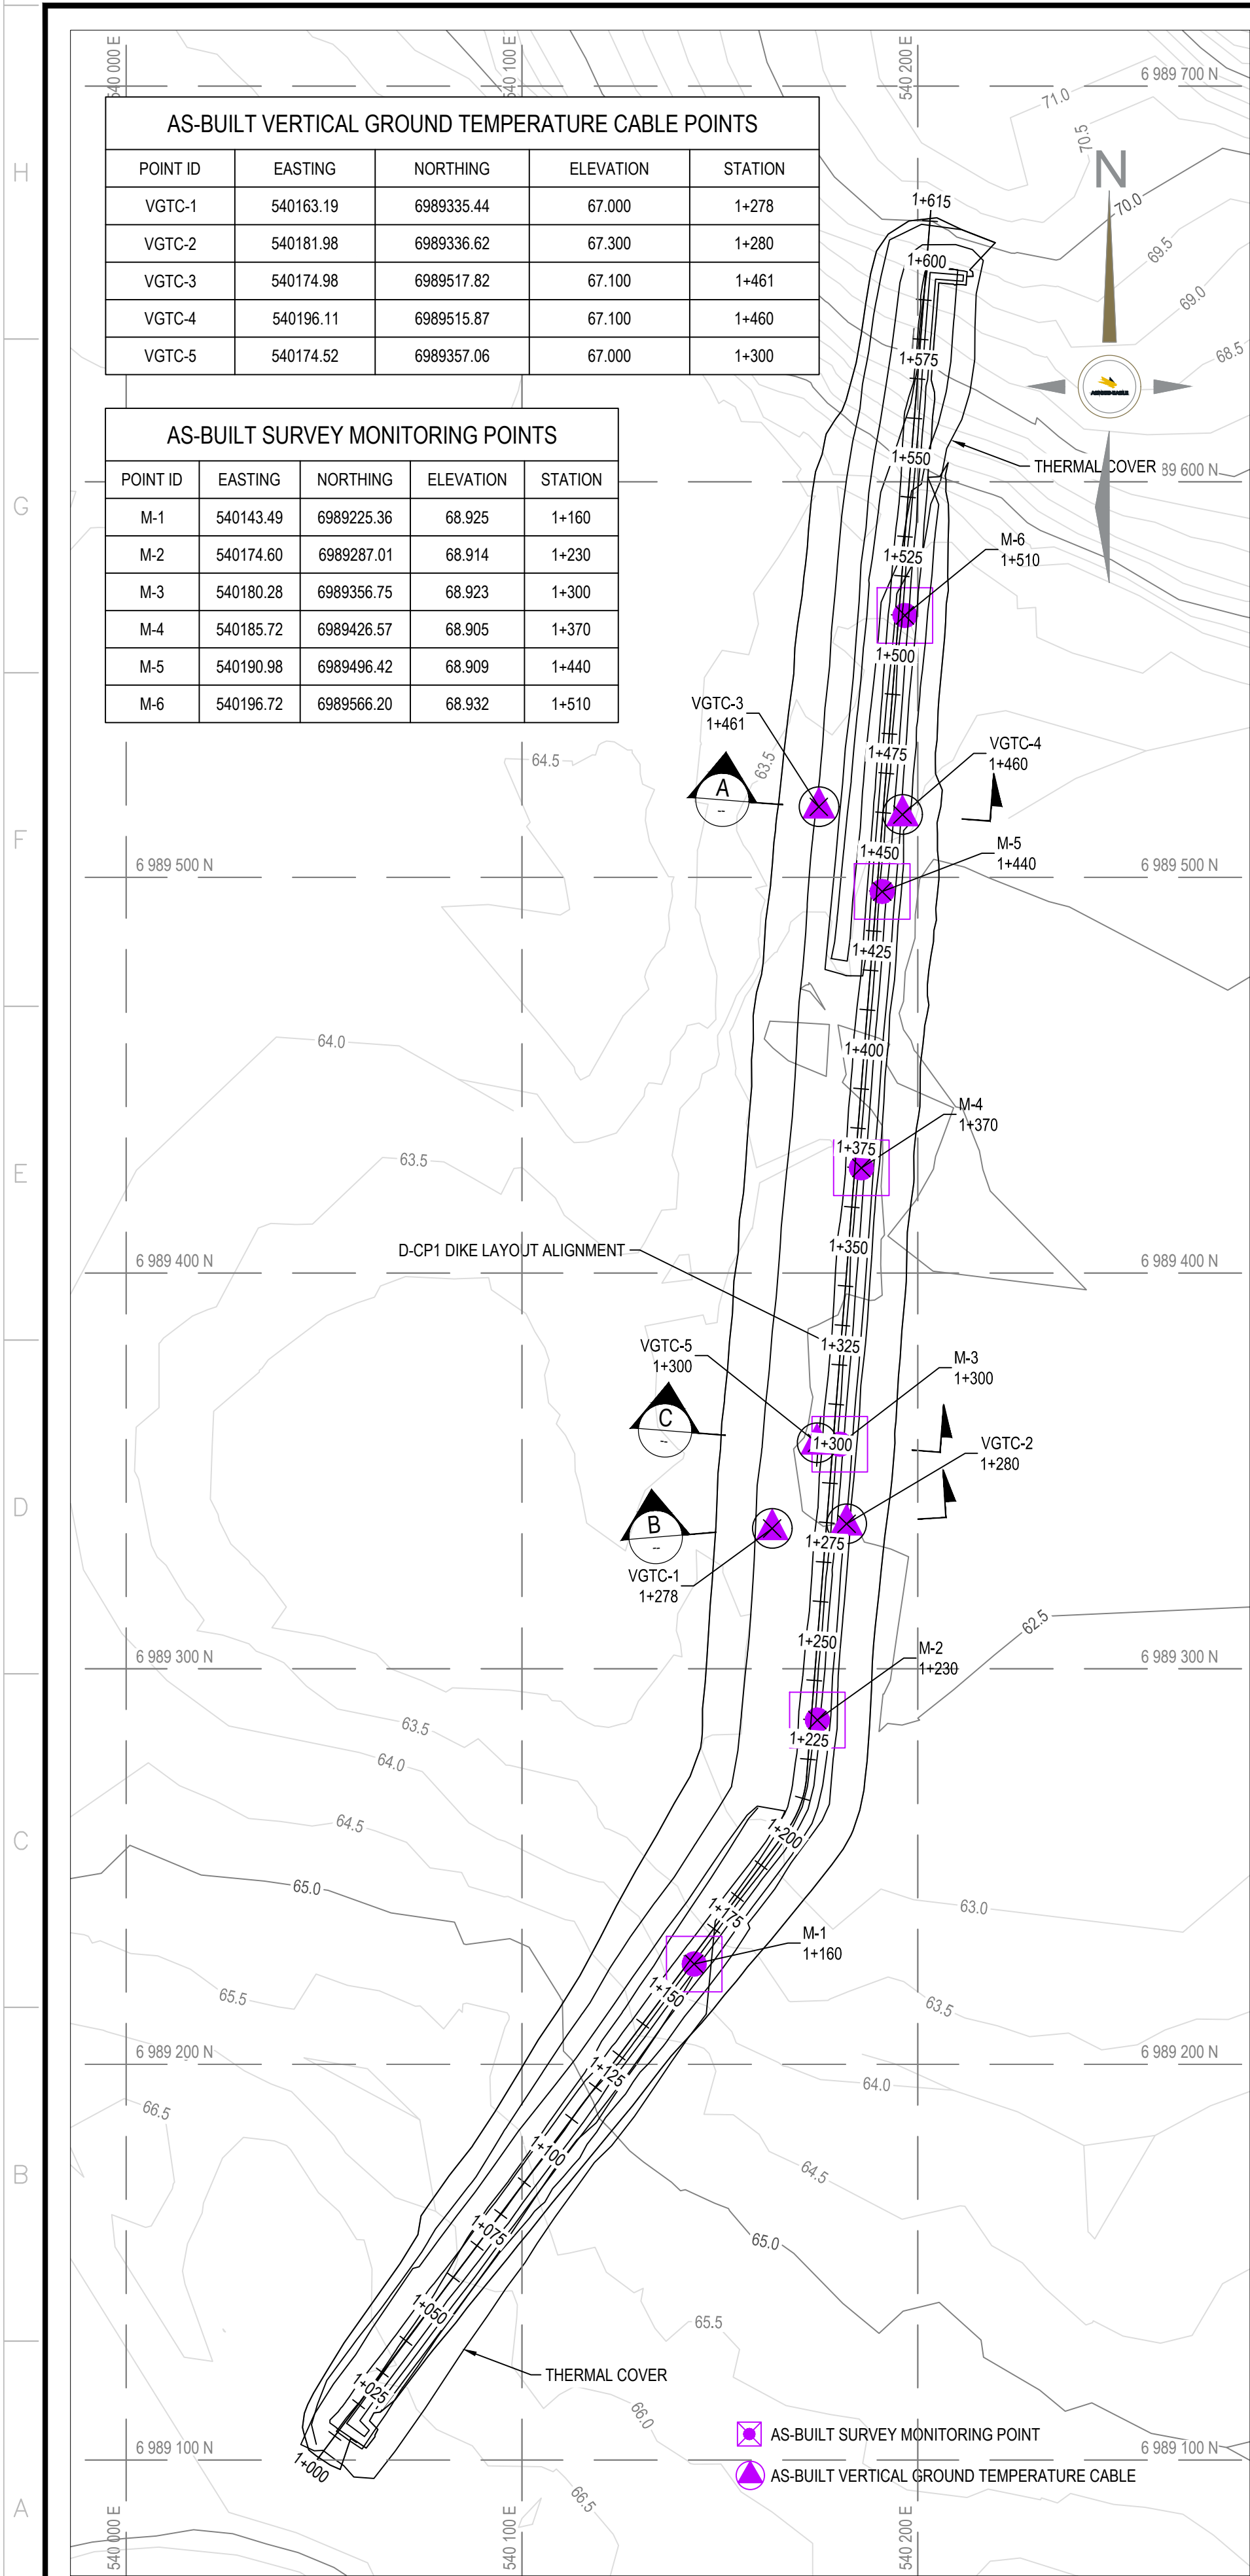


D-CP1 AS-BUILT SURVEY MONUMENT AND VERTICAL GROUND TEMPERATURE CABLE LAYOUT
SCALE: 1:1250

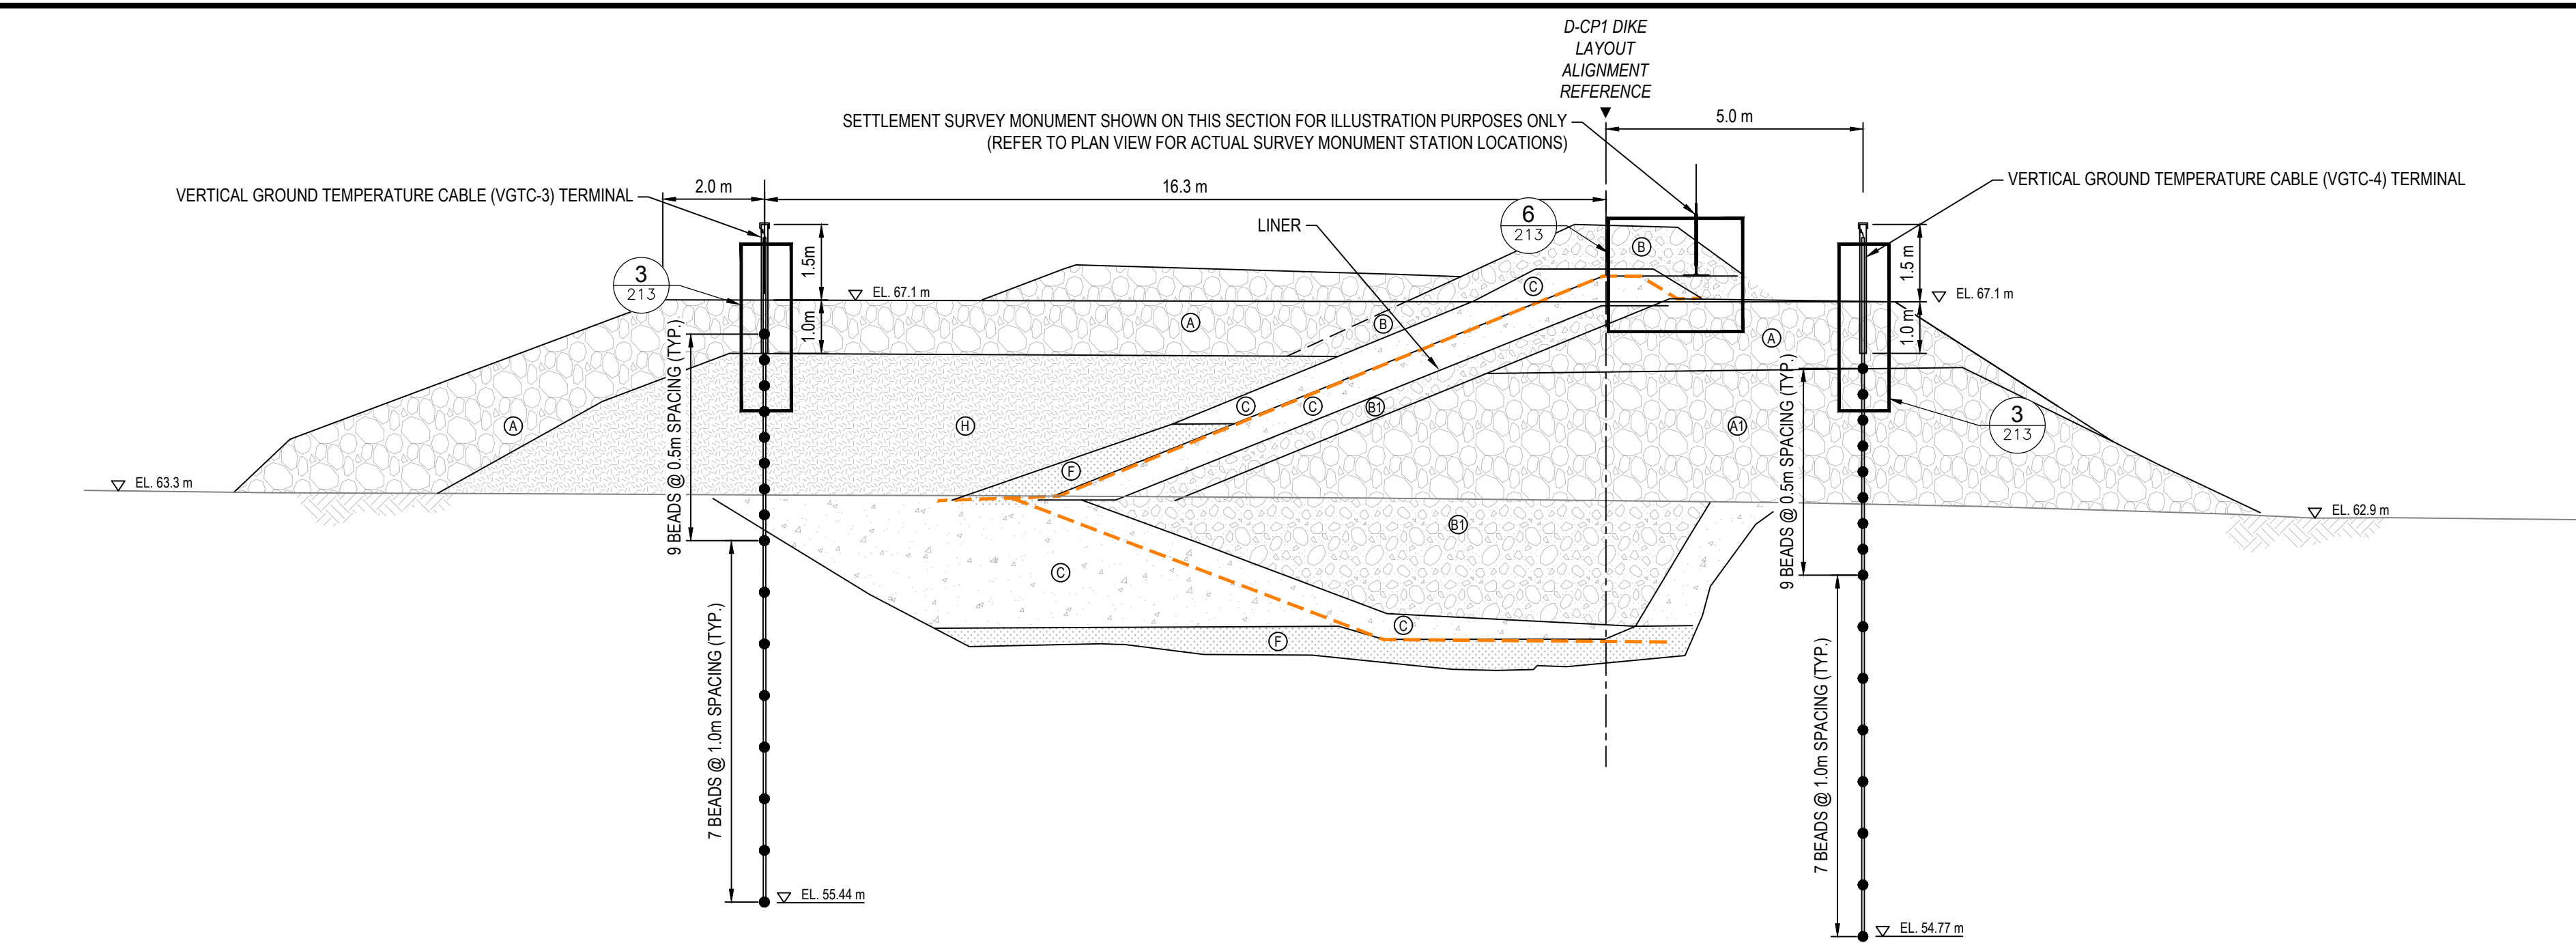


D-CP1 AS-BUILT - SECTION A - VERTICAL GROUND TEMPERATURE CABLE - STATION 1+460
SCALE: 1:100

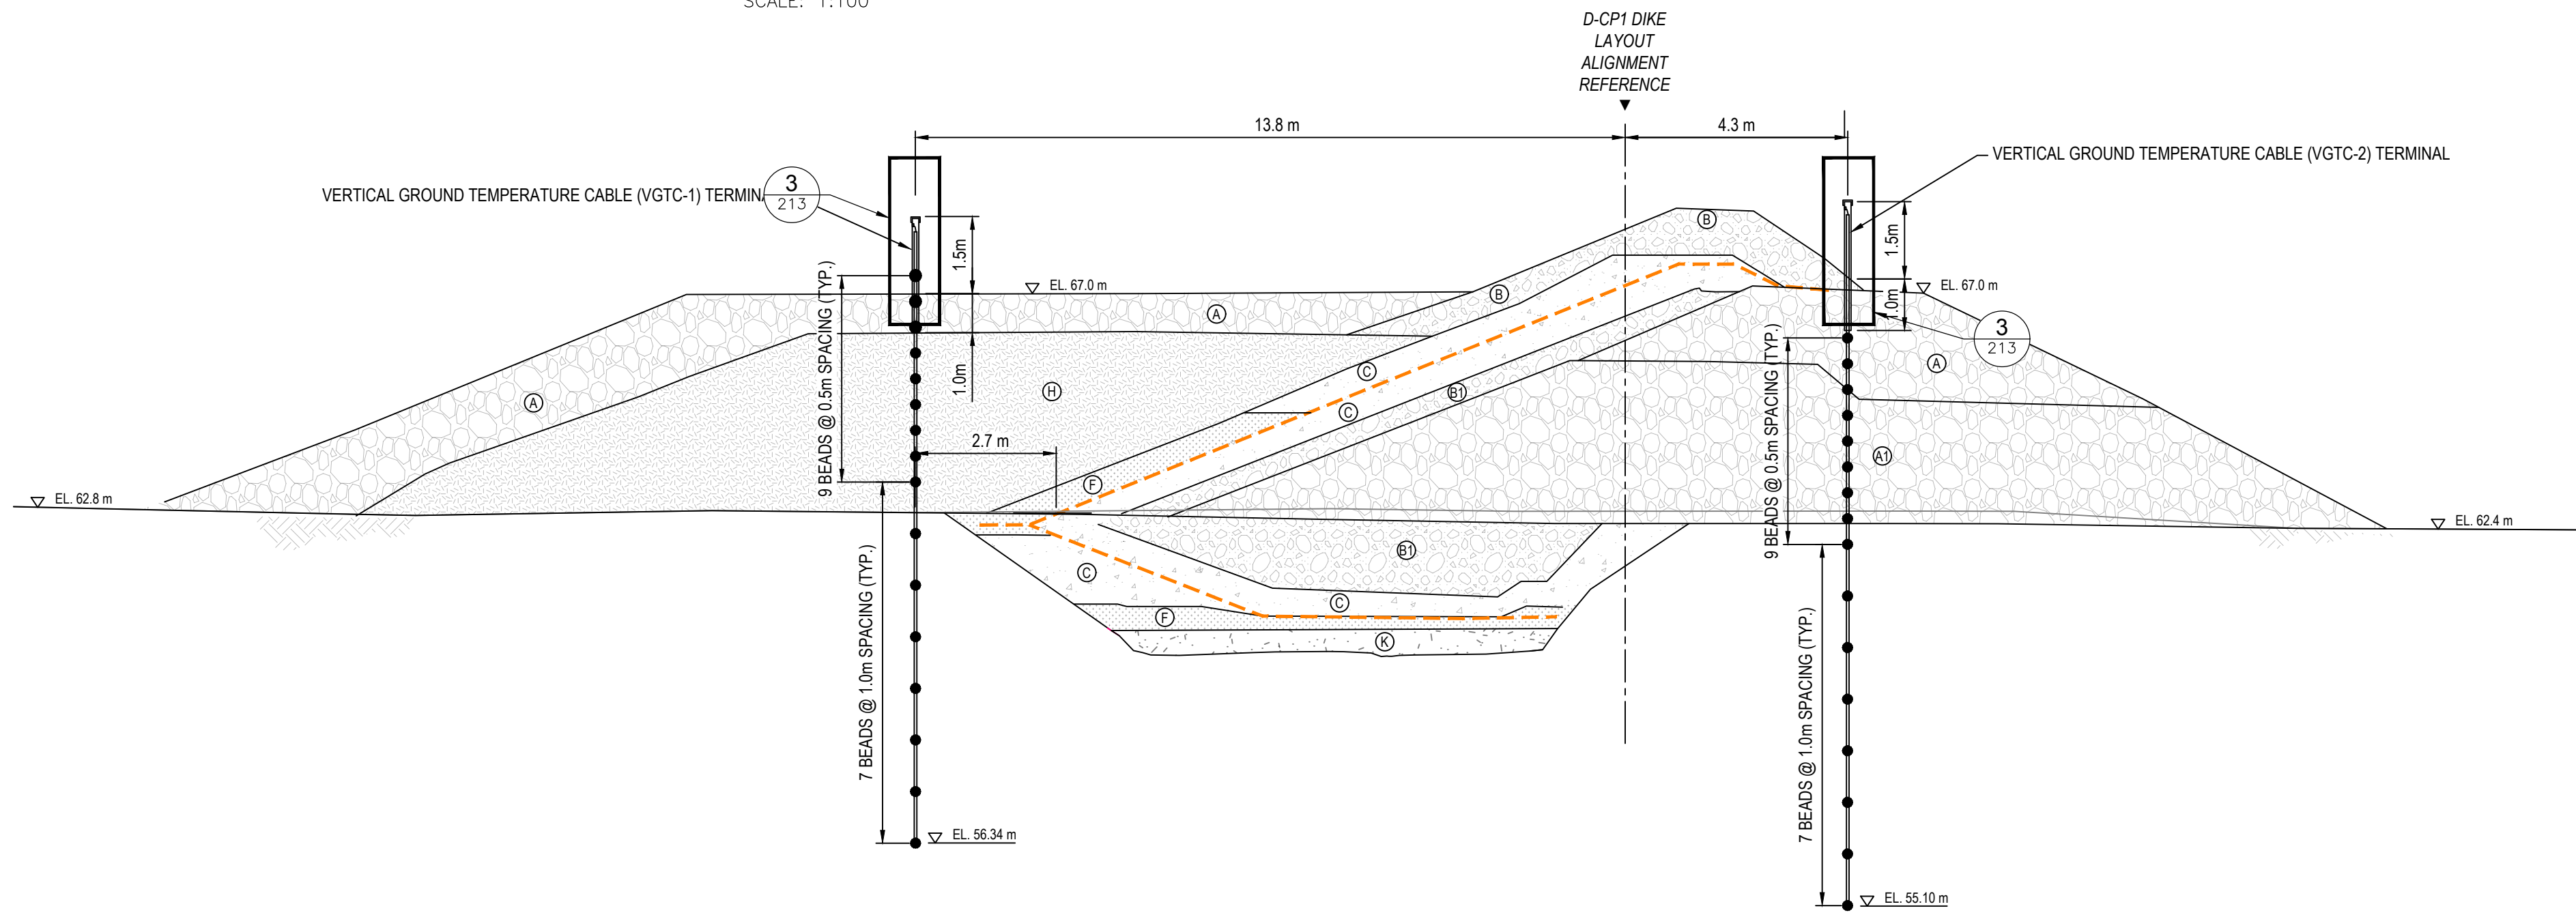

D-CP1 AS-BUILT - SECTION B - VERTICAL GROUND TEMPERATURE CABLE - STATION 1+279
SCALE: 1:100

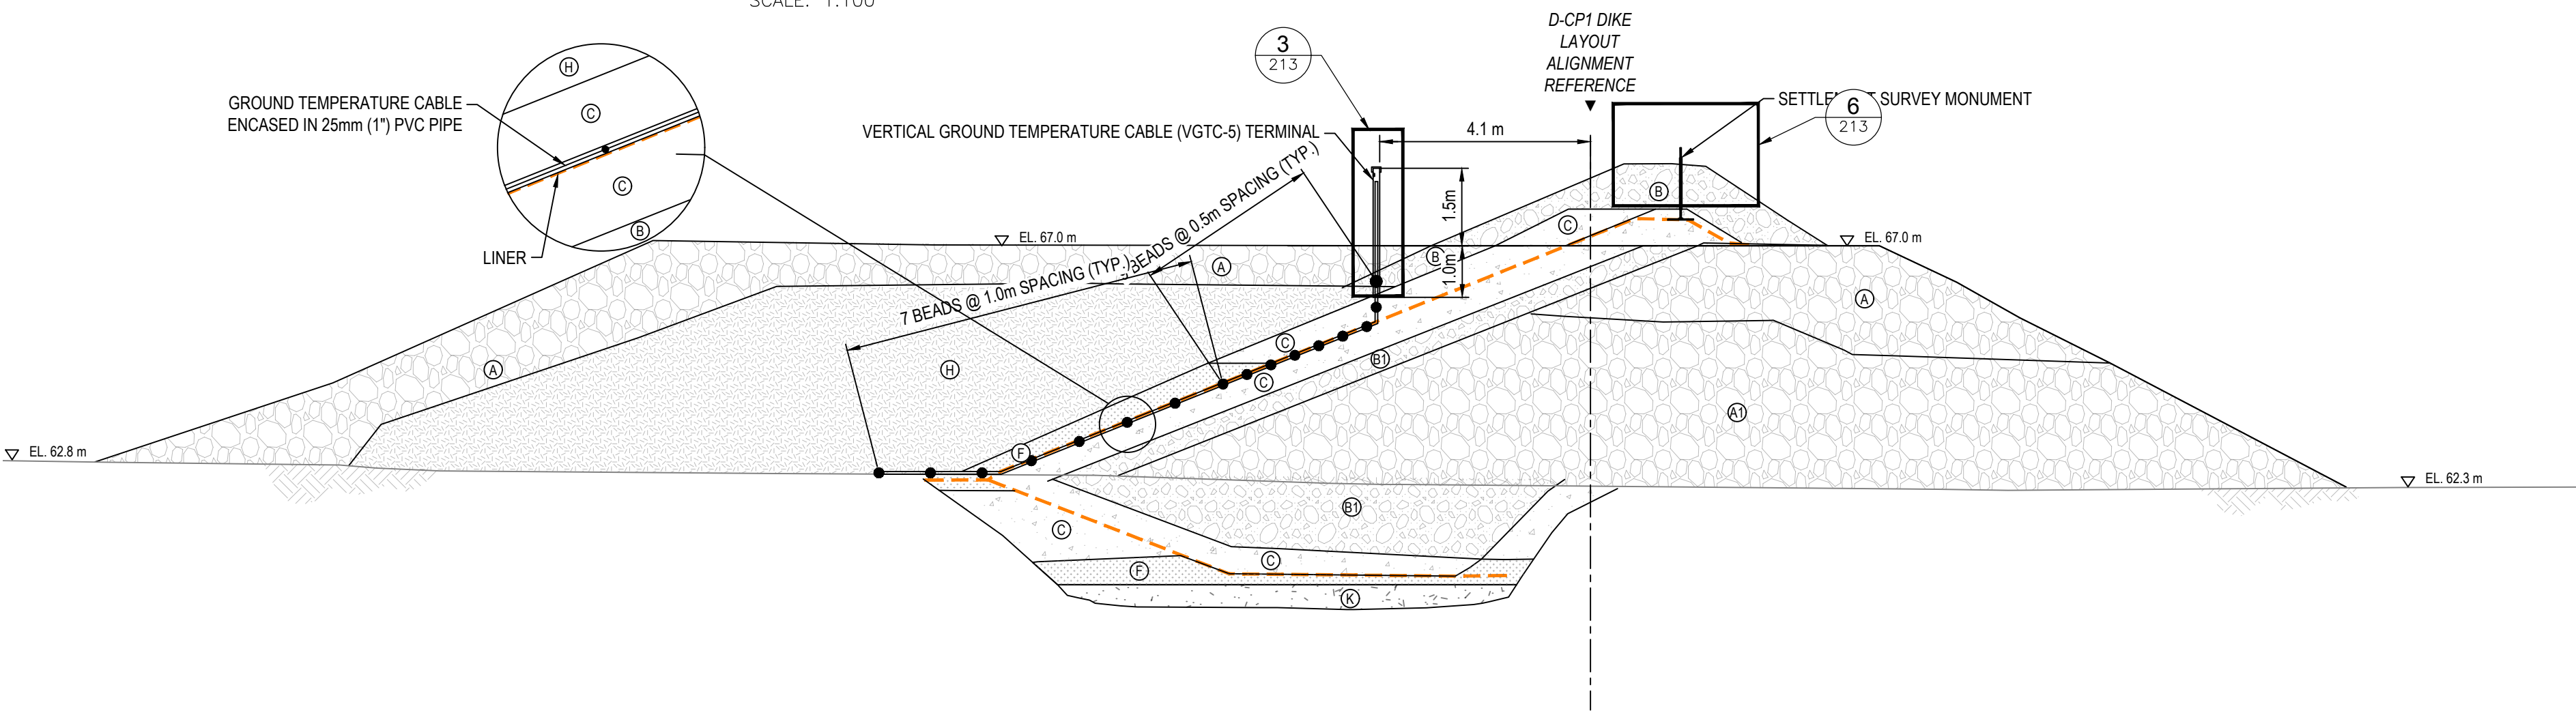

D-CP1 AS-BUILT - SECTION C - VERTICAL GROUND TEMPERATURE CABLE - STATION 1+300
SCALE: 1:100

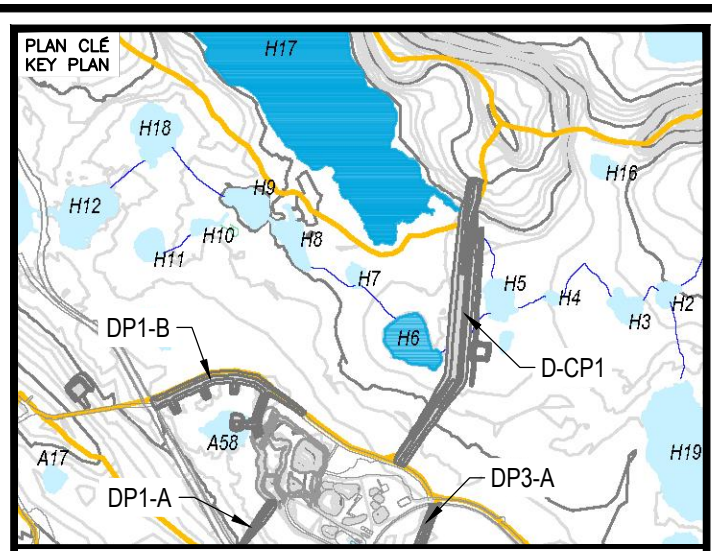

NOTES GÉNÉRALES / GENERAL NOTES

LEGEND

- (A) RUN-OF-MINE ROCKFILL (600 mm MINUS) IN DIKE UPSTREAM AND FOR THERMAL COVER
- (A1) RUN-OF-MINE ROCKFILL (600 mm MINUS) IN DIKE DOWNSTREAM
- (B) TRANSITION ROCKFILL (150 mm MINUS)
- (B1) TRANSITION ROCKFILL (150 mm MINUS)
- (C) GRANULAR FILL OR ESKER SAND (20 mm MINUS)
- (F) BENTONITE-AUGMENTED MATERIAL (MIXTURE OF BENTONITE AND TYPE C MATERIAL)
- (H) ESKER SAND AND GRAVEL (75 mm MINUS)
- (K) NEARLY-SATURATED BACKFILL (20 mm MINUS)

PERMIT TO PRACTICE
TETRA TECH CANADA INC.
Signature: [Signature]
Date: 07/11/2017
PERMIT NUMBER: P 018
NT/NU Association of Professional Engineers and Geoscientists

TEL QUE CONSTRUIT
AS BUILT
AGNICO EAGLE
DATE : 2017-10-19

L'INFORMATION D-CONSTRUIT EST LA PROPRIÉTÉ DE L'AGNICO EAGLE LTD. ET DOIT ÊTRE RETENUE SANS AUTANTION D'OPRE. NOUS AVONS ÉTÉ INFORMÉS DE L'ÉMISSION DE L'AGNICO EAGLE LTD. ET DOIT ÊTRE RETENUE SANS AUTANTION D'OPRE. NOUS AVONS ÉTÉ INFORMÉS DE L'ÉMISSION DE L'AGNICO EAGLE LTD. ET DOIT ÊTRE RETENUE SANS AUTANTION D'OPRE. NOUS AVONS ÉTÉ INFORMÉS DE L'ÉMISSION DE L'AGNICO EAGLE LTD. ET DOIT ÊTRE RETENUE SANS AUTANTION D'OPRE.

DESSINS EN RÉFÉRENCE / REFERENCE DRAWINGS

TITRE / TITLE	# DWG
---	---
---	---
REV.	DATE	DESCRIPTION	PAR/ET	APP.	CLIENT
2	2017-10-19	ISSUED FOR RECORD	WTH	NG	
1	2016-08-24	ISSUED FOR CONSTRUCTION	GZ	KJ	
0	2016-08-15	ISSUED FOR CONSTRUCTION	GZ	KJ	
B	2016-08-11	ISSUED FOR REVIEW	GZ	KJ	
A	2016-08-05	ISSUED FOR REVIEW	GZ	KJ	

REVISIONS



TITRE / TITLE
AGNICO EAGLE MELIADINE GOLD PROJECT

D-CP1 AS-BUILT INSTRUMENTATION PLAN AND
DETAILS FOR GROUND TEMPERATURE CABLES
AND SETTLEMENT SURVEY MONUMENT POINTS

DESSINÉ PAR DRAWN BY	DRG	DATE 2017-10-06
VÉRIFIÉ PAR CHECKED BY	GZ	2017-10-06
APPROUVÉ PAR APPROVED BY	GZ	2017-10-06
ÉCHELLE SCALE	AS SHOWN	DATE 2017-10-06

NO. DESIGN
DRAWING NO. 65-685-230-212

NO. PROJET PROJECT NO.	REVISION	FEUILLE / SHEET
6515	2	11 / 12

H

G

F


E

D


C

B


A

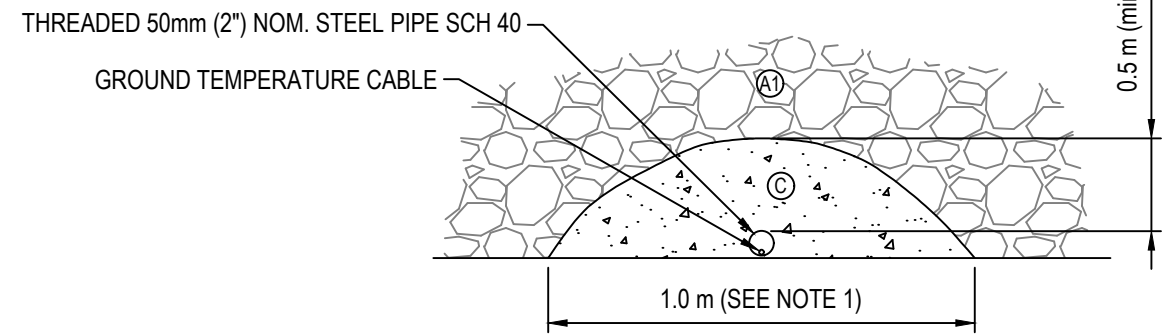


TEMPERATURE CABLE - PROTECTIVE COVER SECTION 1
SCALE: NTS

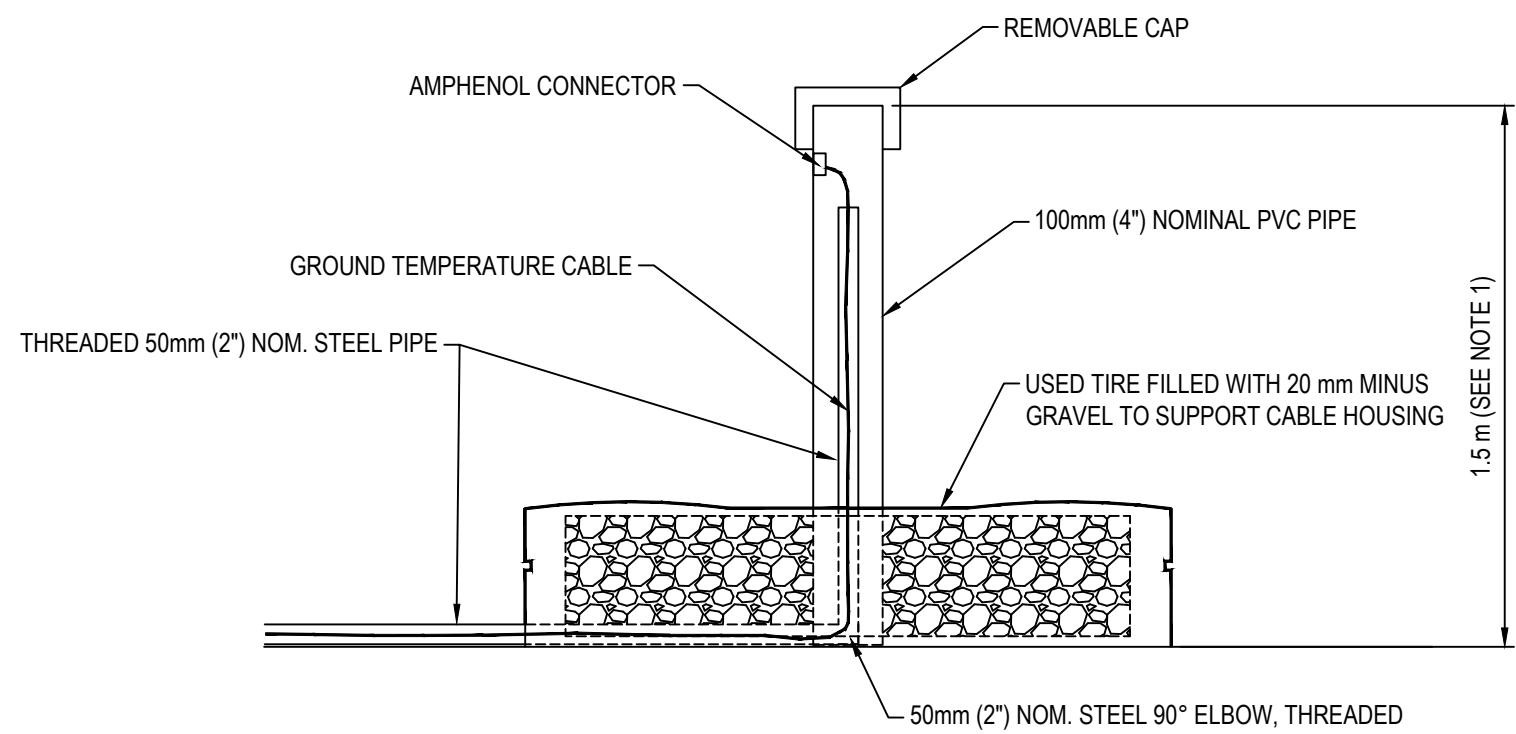

TEMPERATURE CABLE - TERMINAL SUPPORT DETAIL 2
SCALE: NTS

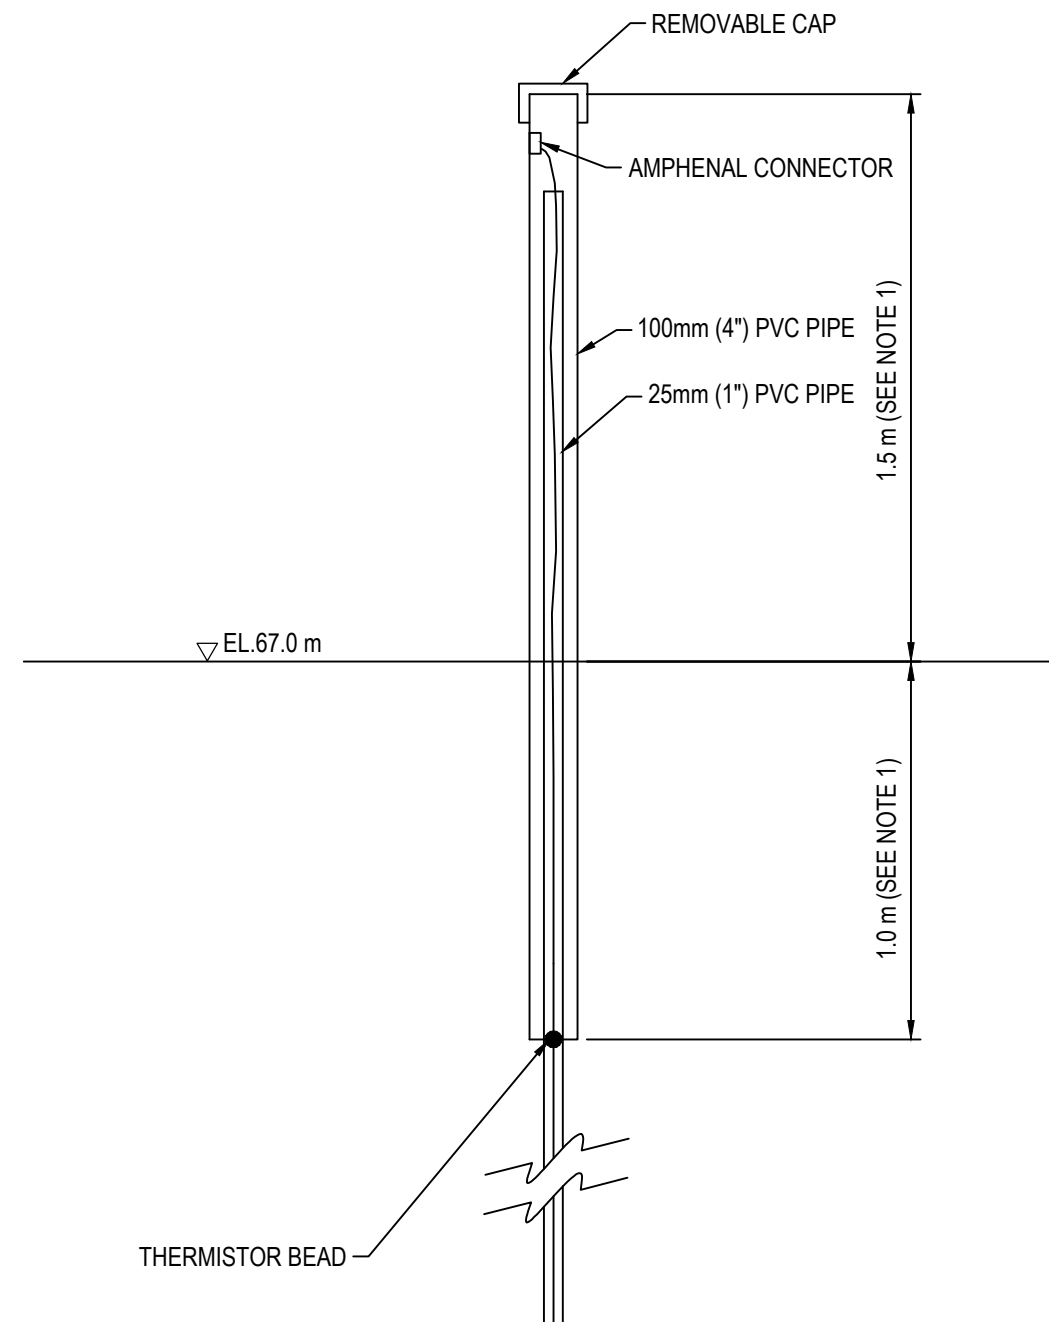


D-CP1 TYPICAL VERTICAL GROUND TEMPERATURE CABLE TERMINAL DETAIL 3
SCALE: 1:20

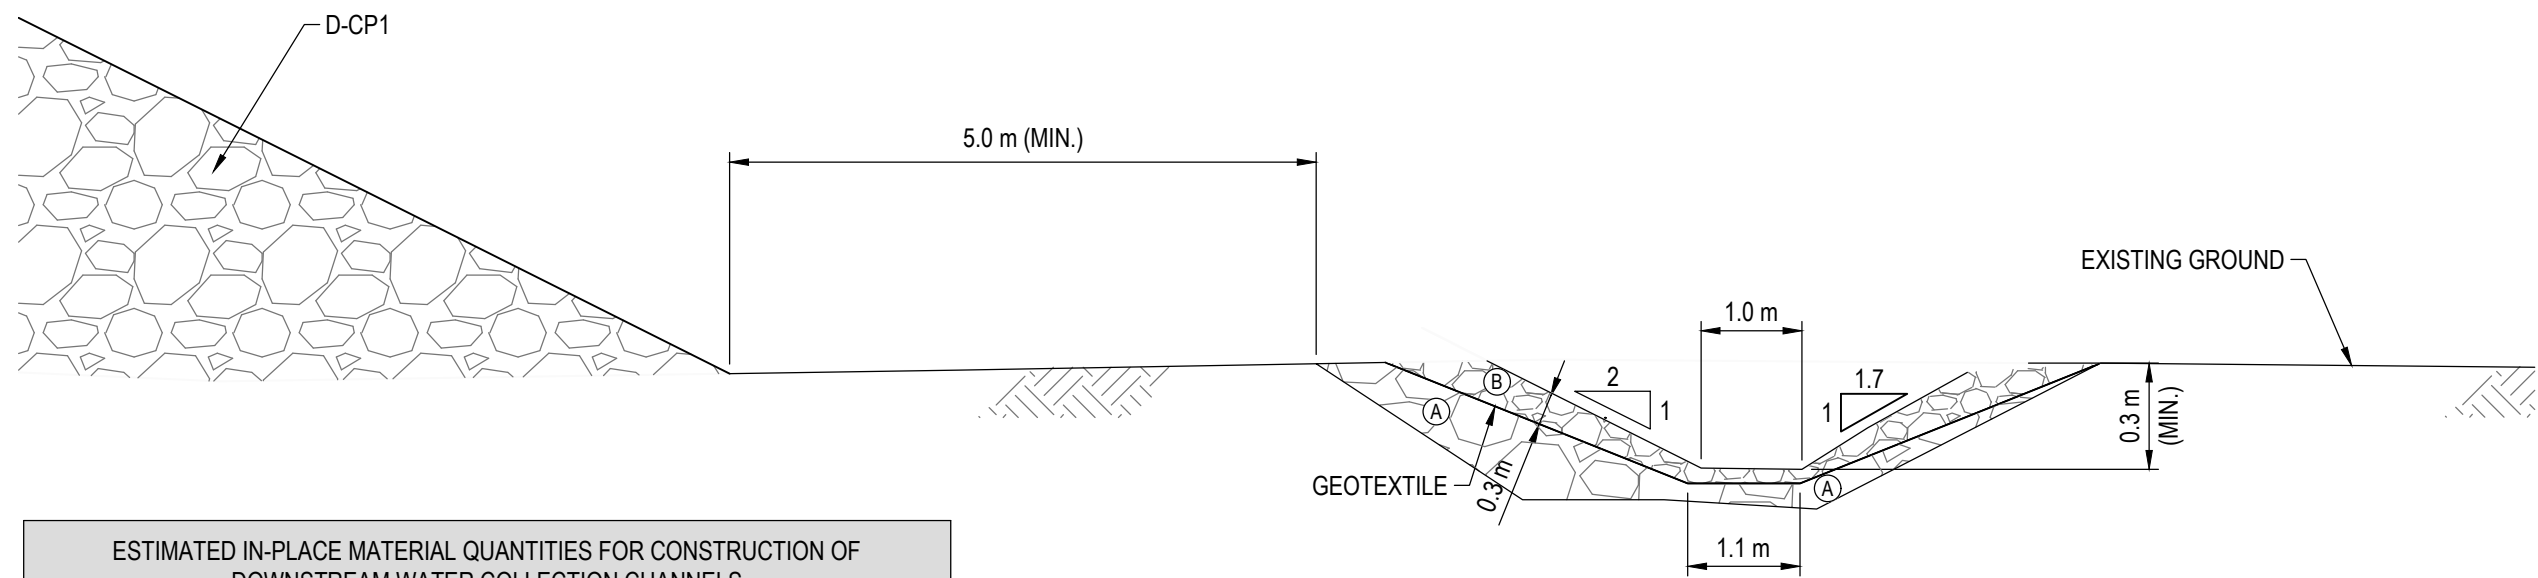


D-CP1 AS-BUILT WATER COLLECTION CHANNEL DETAIL 4
NOT TO SCALE

ESTIMATED IN-PLACE MATERIAL QUANTITIES FOR CONSTRUCTION OF DOWNSTREAM WATER COLLECTION CHANNELS		
ITEM	UNIT	ESTIMATED IN-PLACE QUANTITY AFTER COMPACTION AND INSTALLATION
CHANNEL EXCAVATION	m ³	1,598
CHANNEL MATERIAL B TRANSITION ROCKFILL (150 mm MINUS)	m ³	930
CHANNEL MATERIAL A RUN OF MINE ROCKFILL (600 mm MINUS)	m ³	520
CHANNEL GEOTEXTILE LINER	m ²	1,542

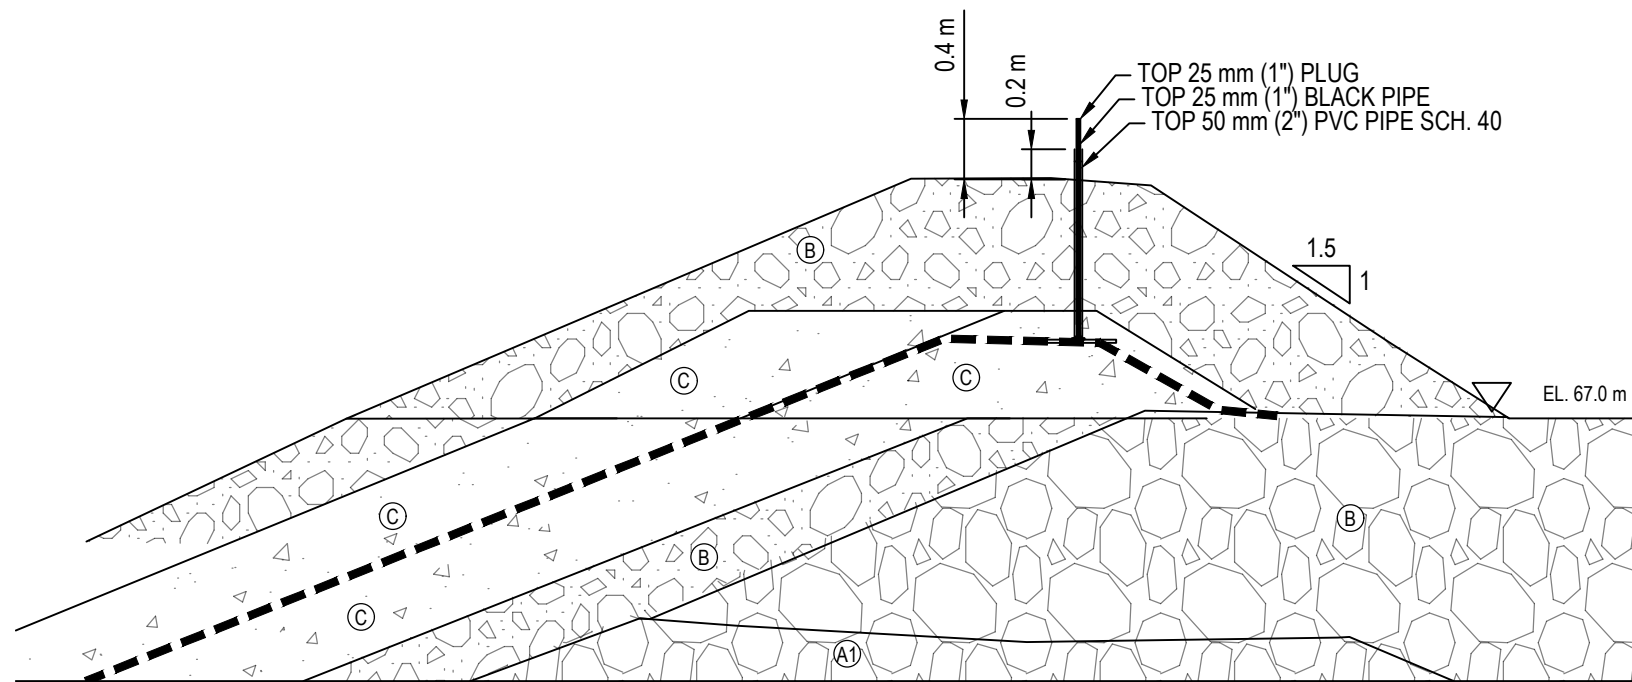


D-CP1 AS-BUILT SETTLEMENT SURVEY MONUMENT DETAIL 6
SCALE: 1:50

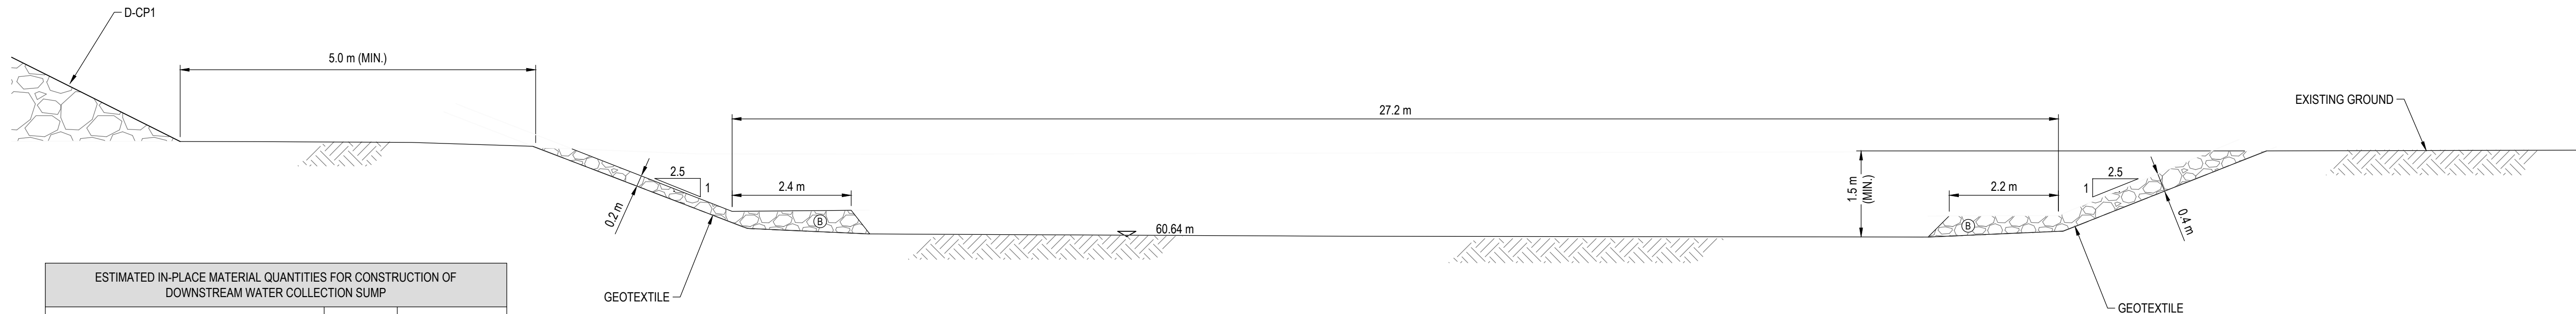

D-CP1 AS-BUILT WATER COLLECTION SUMP DETAIL 5
NOT TO SCALE

ESTIMATED IN-PLACE MATERIAL QUANTITIES FOR CONSTRUCTION OF DOWNSTREAM WATER COLLECTION SUMP		
ITEM	UNIT	ESTIMATED IN-PLACE QUANTITY AFTER COMPACTION AND INSTALLATION
SUMP EXCAVATION	m ³	1,575
SUMP MATERIAL B TRANSITION ROCKFILL (150 mm MINUS)	m ³	280
SUMP GEOTEXTILE LINER	m ²	895

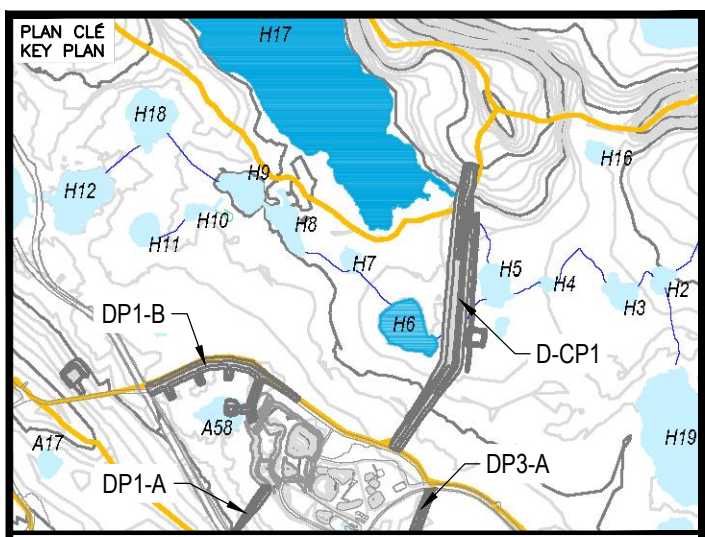

NOTES GÉNÉRALES / GENERAL NOTES

LEGEND

- (A) RUN-OF-MINE ROCKFILL (600 mm MINUS) IN DIKE DOWNSTREAM
- (B) TRANSITION ROCKFILL (150 mm MINUS)
- (C) GRANULAR FILL OR ESKER SAND (20 mm MINUS)
- (F) BENTONITE-AUGMENTED MATERIAL (MIXTURE OF BENTONITE AND TYPE C MATERIAL)
- (H) ESKER SAND AND GRAVEL (75 mm MINUS)

NOTE 1: NO SURVEY DATA AVAILABLE. BASED ON DESIGN AND FIELD OBSERVATIONS



L'INFORMATION D-CONSTRUIT EST LA PROPRIÉTÉ DE L'AGNICO EAGLE LTD. ET DOIT ÊTRE RETENUE SOUS RÉSERVE. L'AGNICO EAGLE LTD. NE GARANTIT PAS L'EXACTITUDE DE L'INFORMATION D-CONSTRUIT. L'AGNICO EAGLE LTD. NE GARANTIT PAS L'EXACTITUDE DE L'INFORMATION D-CONSTRUIT. L'AGNICO EAGLE LTD. NE GARANTIT PAS L'EXACTITUDE DE L'INFORMATION D-CONSTRUIT.


DESSINS EN RÉFÉRENCE / REFERENCE DRAWINGS

TITRE / TITLE	# DWG
---	---
---	---
REV.	DATE	DESCRIPTION	PAR/EN	APP.	CLIENT
2	2017-10-19	ISSUED FOR RECORD	WTH	KJ	
1	2016-09-24	ISSUED FOR CONSTRUCTION	GZ	KJ	
0	2016-08-15	ISSUED FOR CONSTRUCTION	GZ	KJ	
B	2016-08-11	ISSUED FOR REVIEW	GZ	KJ	
A	2016-08-05	ISSUED FOR REVIEW	GZ	KJ	

REVISIONS

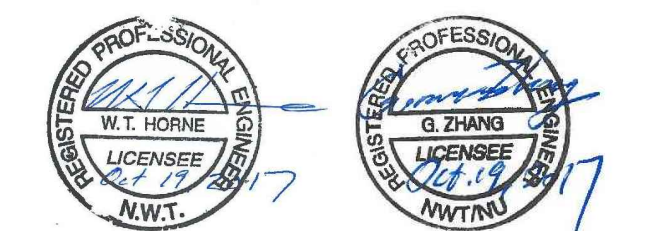

TITRE / TITLE
AGNICO EAGLE MELIADINE GOLD PROJECT
D-CP1 AS-BUILT DOWNSTREAM WATER COLLECTION CHANNEL AND SUMP PROFILES AND INSTRUMENTATION DETAILS

DESSINÉ PAR DRAWN BY	EL	DATE 2017-10-06
VÉRIFIÉ PAR CHECKED BY	GZ	2017-10-06
APPROUVÉ PAR APPROVED BY	GZ	2017-10-06
ÉCHELLE SCALE	N.T.S.	DATE 2017-10-06

NO. DESSIN DRAWING NO.	65-685-230-213		
NO. PROJET PROJECT NO.	6515	REVISION 2	FEUILLE / SHEET 12 / 12

