


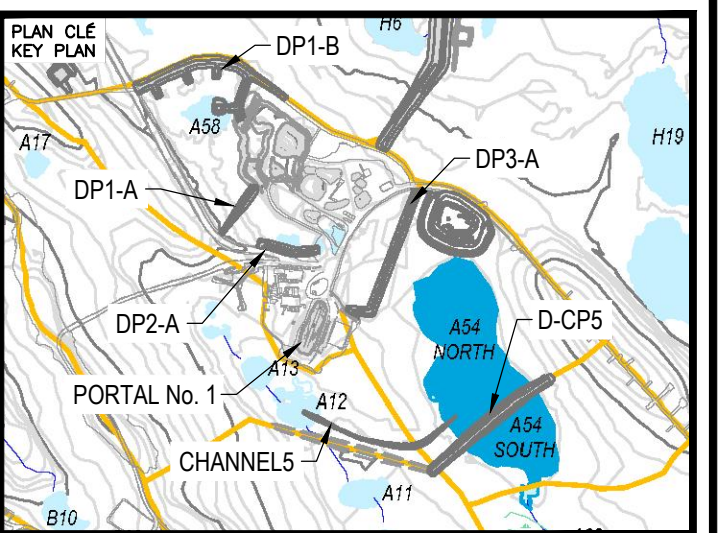

NOTES GÉNÉRALES / GENERAL NOTES

PERMIT TO PRACTICE
TETRA TECH CANADA INC.

Signature [Signature]

Date Oct 19, 2017

PERMIT NUMBER: P 018
NT/NU Association of Professional
Engineers and Geoscientists

TEL QUE CONSTRUIT
AS BUILT

 DATE : 2017-10-19

THE INFORMATION HERE ON IS THE PROPERTY OF ADVCO EAGLE LTD. AND MUST BE RETURNED UPON REQUEST. WITHOUT WRITTEN PERMISSION, ANY COPYING, TRANSMITTAL TO OTHERS AND ANY USE EXCEPT THAT FOR WHICH IT IS LOANED ARE PROHIBITED.
© ADVCO EAGLE LTD.

DESSINS EN RÉFÉRENCE / REFERENCE DRAWINGS

[illegible]

AGNICO EAGLE

1	2017-10-19	ISSUED FOR RECORD	WITH	NG	
0	2016-08-15	ISSUED FOR CONSTRUCTION	GZ	KJ	
A	2016-08-10	ISSUED FOR REVIEW	GZ	KJ	
REV.	DATE	DESCRIPTION	PAR/BY	APP.	CLIENT

REVISIONS




TITRE / TITLE	AGNICO EAGLE MELIADINE GOLD PROJECT
---------------	-------------------------------------

D-CP5 AS-BUILT
PROFILES

DESSINÉ PAR DRAWN BY	EL	DATE	2016-08-15
VÉRIFIÉ PAR CHECKED BY	GZ		2016-08-15
APPROUVÉ PAR APPROVED BY	GZ		2016-08-15
ÉCHELLE SCALE	1:500	DATE	2016-08-15


NO. DESSIN
DRAWING NO. 65-685-230-216

NO. PROJET PROJECT NO. 6515	REVISION	FEUILLE / SHT
	1	3 / 9

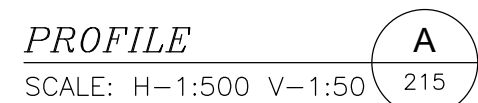



D-CP5 THERMAL COVER LAYOUT POINTS

STATION	EASTING	NORTHING	ELEVATION
• 2+230	540317.70	6988597.83	67.75
• 2+240	540325.86	6988603.61	67.95
• 2+250	540334.20	6988609.14	68.25
• 2+260	540342.58	6988614.59	68.59
• 2+270	540350.91	6988620.11	68.80
• 2+280	540359.23	6988625.66	69.09
• 2+290	540367.59	6988631.15	69.62
• 2+300	540375.94	6988636.65	69.90
• 2+309.57	540383.79	6988642.13	69.86

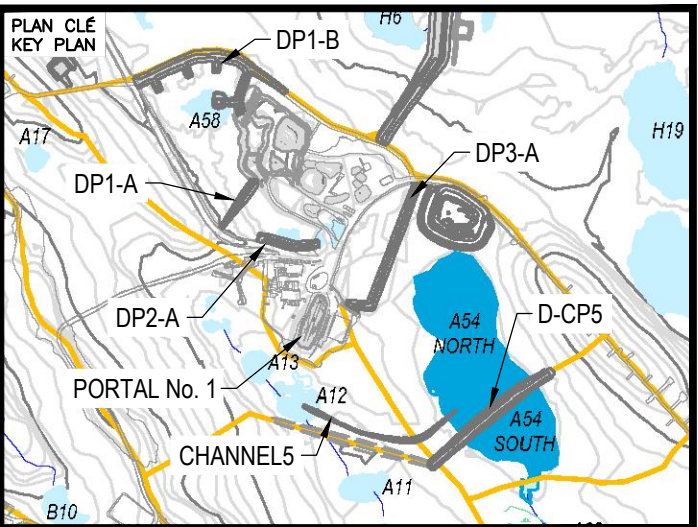

NOTES GÉNÉRALES / GENERAL NOTES

LEGEND

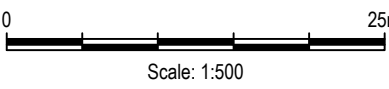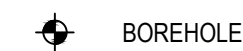

PERMIT TO PRACTICE
TETRA TECH CANADA INC.

Signature *[Signature]*

PERMIT NUMBER: P 018

PERMIT NUMBER: P 018
NT/NU Association of Professional
Engineers and Geoscientists

TEL QUE CONSTRUIT
AS BUILT

AGNICO EAGLE

DATE : 2017-10-19

100

L'INFORMATION CI-DESSOUS EST LA PROPRIÉTÉ DE AONCO EAGLE LTD. ET DOIT ÊTRE RETOURNÉE SUR DEMANDE, SANS AUTORISATION ÉCRITE.
 REPRODUCTION, COPIAGE, TRANSMISSION DE COPIES À AUTRUI ET TOUTE UTILISATION AUTRE QUE CELLE POUR LAQUELLE L'INFORMATION EST PRÉSENTÉE
 SONT INTERDITES. © AONCO EAGLE LTD.

THE INFORMATION HERE ON IS THE PROPERTY OF AONCO EAGLE LTD. AND MUST BE RETURNED UPON REQUEST, WITHOUT WRITTEN PERMISSION.
 ANY COPYING, TRANSMITTAL TO OTHERS AND ANY USE EXCEPT THAT FOR WHICH IT IS LOANED ARE PROHIBITED.
 © AONCO EAGLE LTD.

DESSINS EN RÉFÉRENCE / REFERENCE DRAWINGS

TITRE / TITLE	# DWG
	--
-	--
-	--
-	--
-	--



AGNICO EAGLE

1	2017-10-19	ISSUED FOR RECORD	WITH	NG			
0	2016-08-15	ISSUED FOR CONSTRUCTION	GZ	KJ			
A	2016-08-10	ISSUED FOR REVIEW	GZ	KJ			
REV.	DATE	DESCRIPTION	PAR/BY	APP.	CUSTOMER		
REVISIONS							

REVISIONS



NTRE / TITLE



D-CP5 AS-BUILT THERMAL COVER
LAYOUT PLAN AND PROFILES

ESSINÉ PAR DRAWN BY	EL	DATE 2016-08-1
VÉRIFIÉ PAR CHECKED BY	GZ	2016-08-1
APPROUVÉ PAR APPROVED BY	GZ	2016-08-1

CHELLE CALE	1:500	DATE	2016-08-15
----------------	-------	------	------------

65-685-230-217

NO. PROJ. PROJECT NO.	REVISION	FEUILLE / SHEET
6515	1	4 / 9

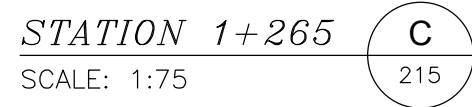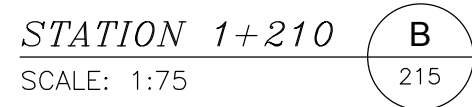

⁽³⁾ MATERIAL QUANTITIES WERE BASED ON SURVEY DATA PROVIDED BY AGNICO EAGLE ON AUGUST 2017

NOTE



NOTES GÉNÉRALES / GENERAL NOTES

PERMIT TO PRACTICE
TETRA TECH CANADA INC.

Signature [Signature]

Date Oct 19, 2017

PERMIT NUMBER: P 018
NT/NU Association of Professional
Engineers and Geoscientists

TEL QUE CONSTRUIT
AS BUILT

 DATE : 2017-10-19

THE INFORMATION ON THIS CONTAINER IS THE PROPERTY OF AGNICO EAGLE LTD. AND MUST BE RETURNED UPON REQUEST. WITHOUT WRITTEN PERMISSION, ANY COPYING, TRANSMITTAL TO OTHERS AND ANY USE EXCEPT THAT FOR WHICH IT IS LOANED ARE PROHIBITED.
© AGNICO EAGLE LTD.

DESSINS EN RÉFÉRENCE / REFERENCE DRAWINGS

[illegible]

1	2017-10-19	ISSUED FOR RECORD	WTH	NG	
0	2016-08-15	ISSUED FOR CONSTRUCTION	GZ	KJ	
A	2016-08-10	ISSUED FOR REVIEW	GZ	KJ	
REV.	DATE	DESCRIPTION	PAR/BY	APP.	CLIENT

REVISIONS



TITRE / TITLE
AGNICO EAGLE MELIADINE GOLD PROJECT

D-CP5 AS-BUILT
TYPICAL SECTIONS AND QUANTITIES

DESSINÉ PAR	DATE
DRAWN BY	2016 08 1


VERIFIÉ PAR CHECKED BY	GZ	2016-08-1
---------------------------	----	-----------

APPROUVE PAR APPROVED BY	GZ	2016-08-1
-----------------------------	----	-----------


ECHELLE SCALE	1:75	DATE	2016-08-15
------------------	------	------	------------

DRAWING NO. 65-685-230-218


NO. PROJET PROJECT NO. 6515	REVISION	FEUILLE / SHEET
	1	5 / 9

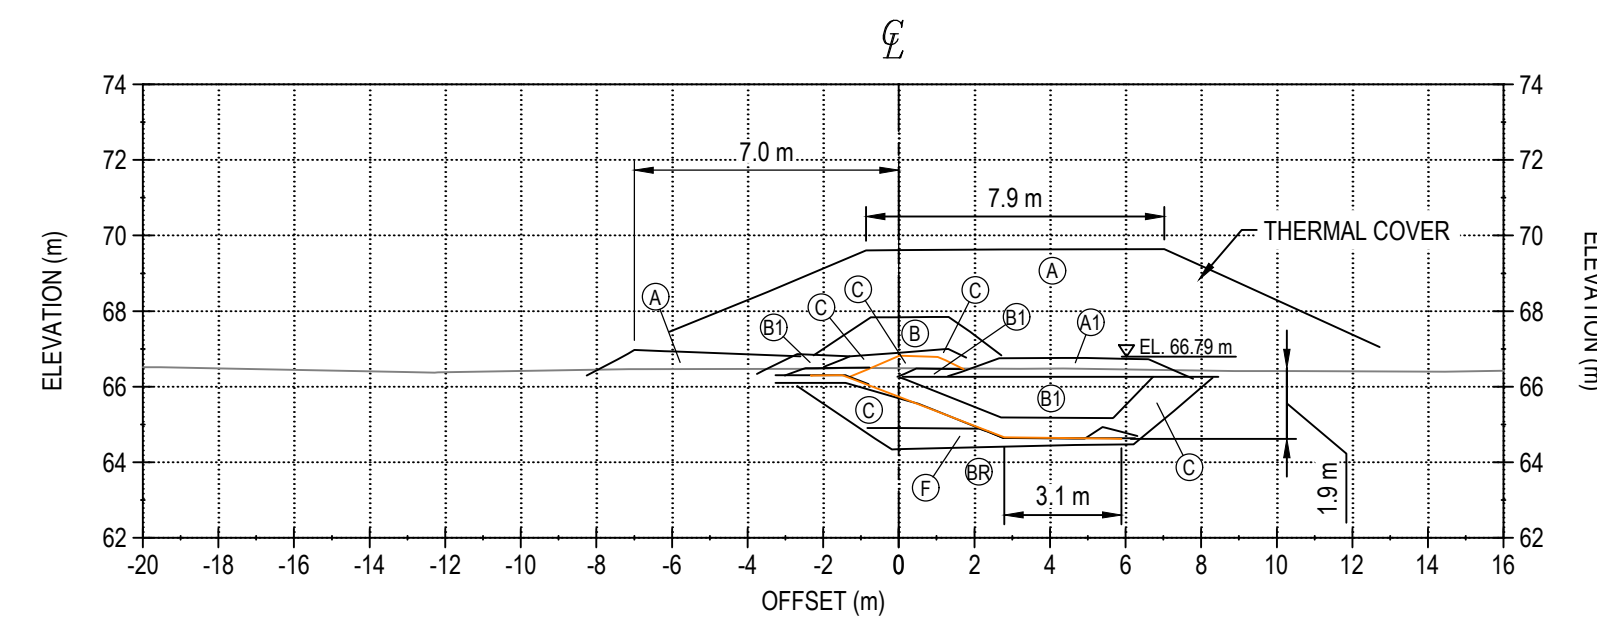


STATION 1+050

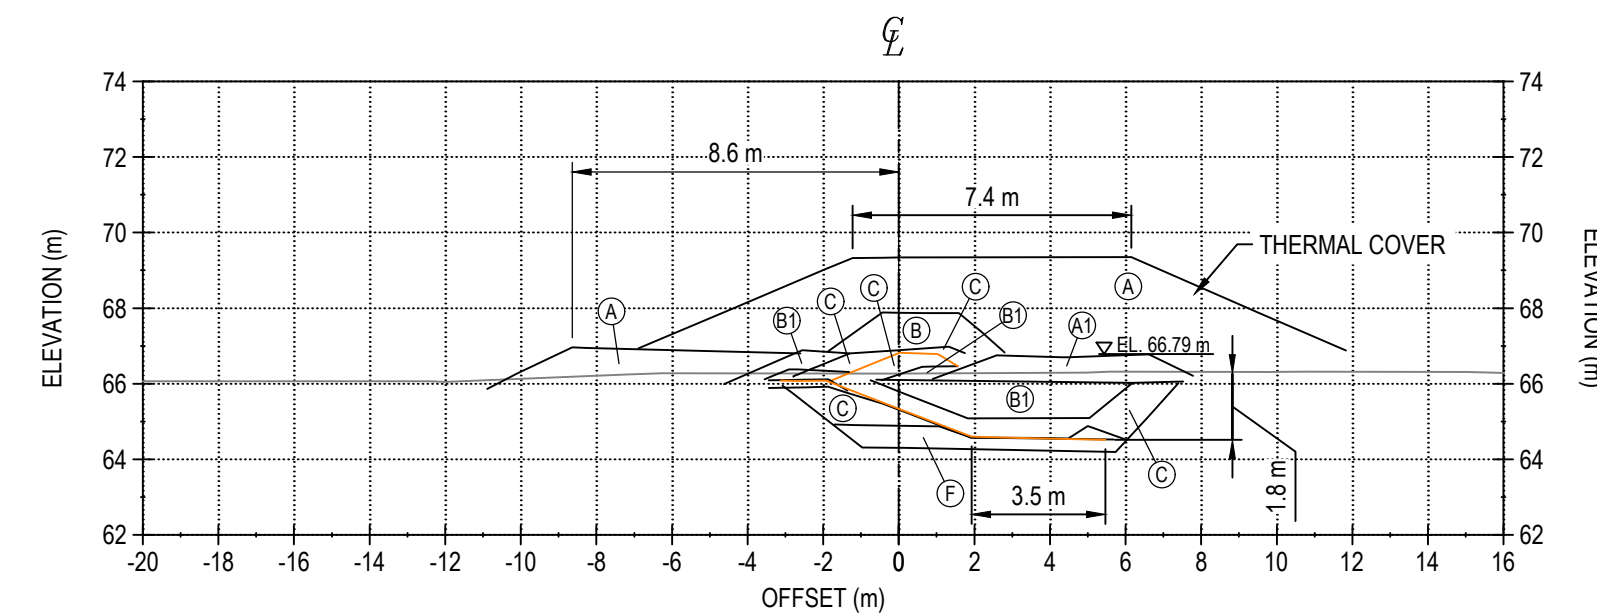


STATION 1+080

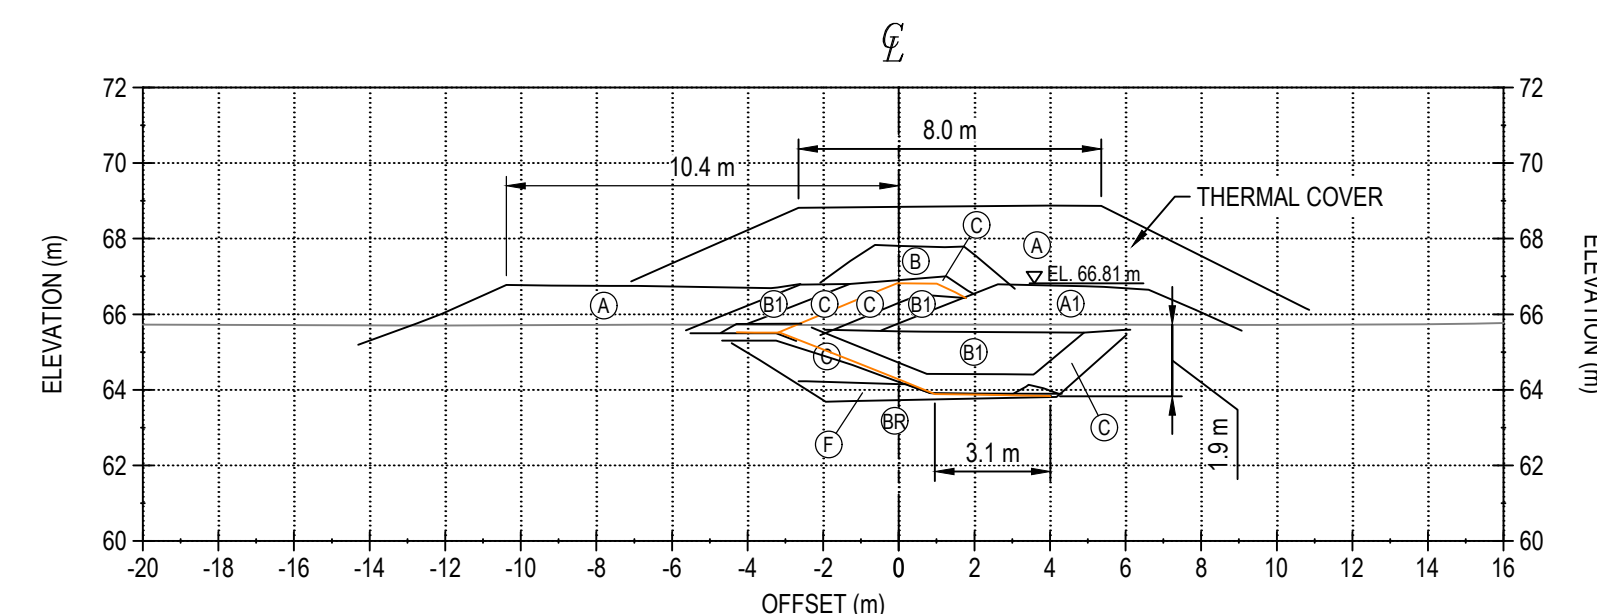

STATION 1+110

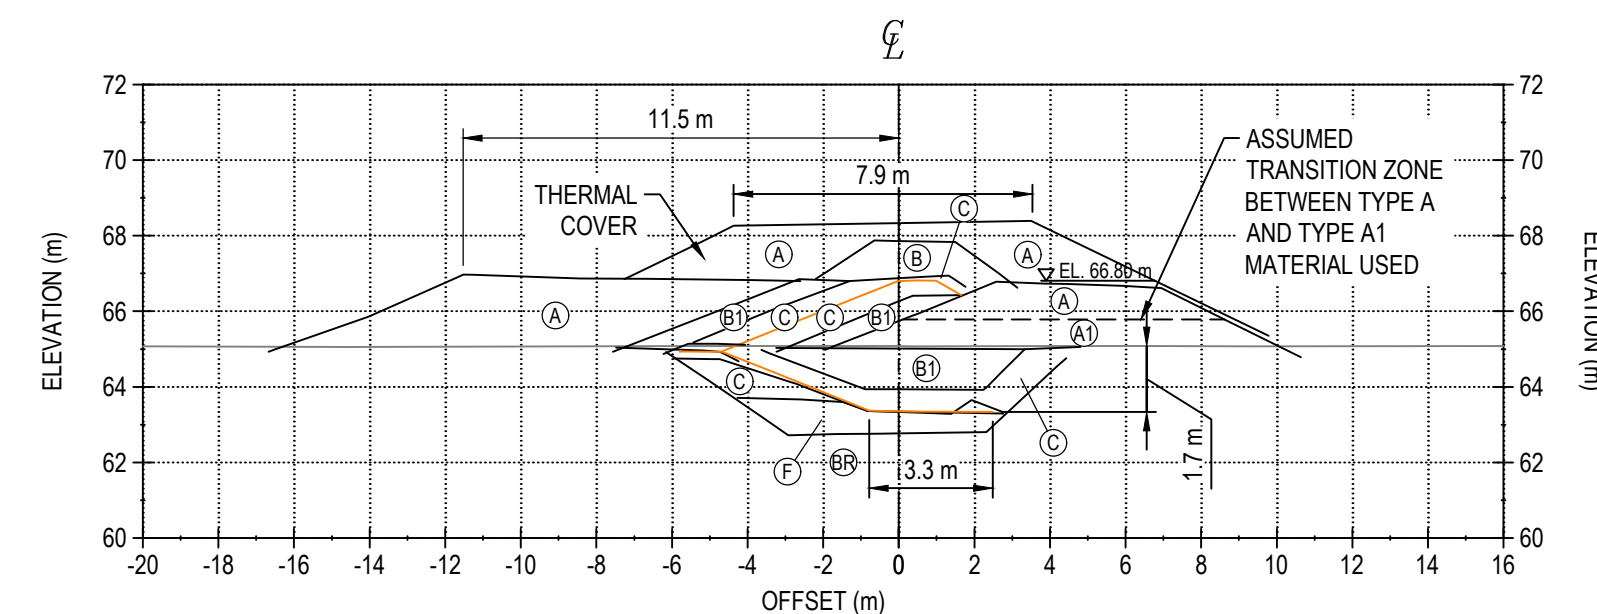

STATION 1+140

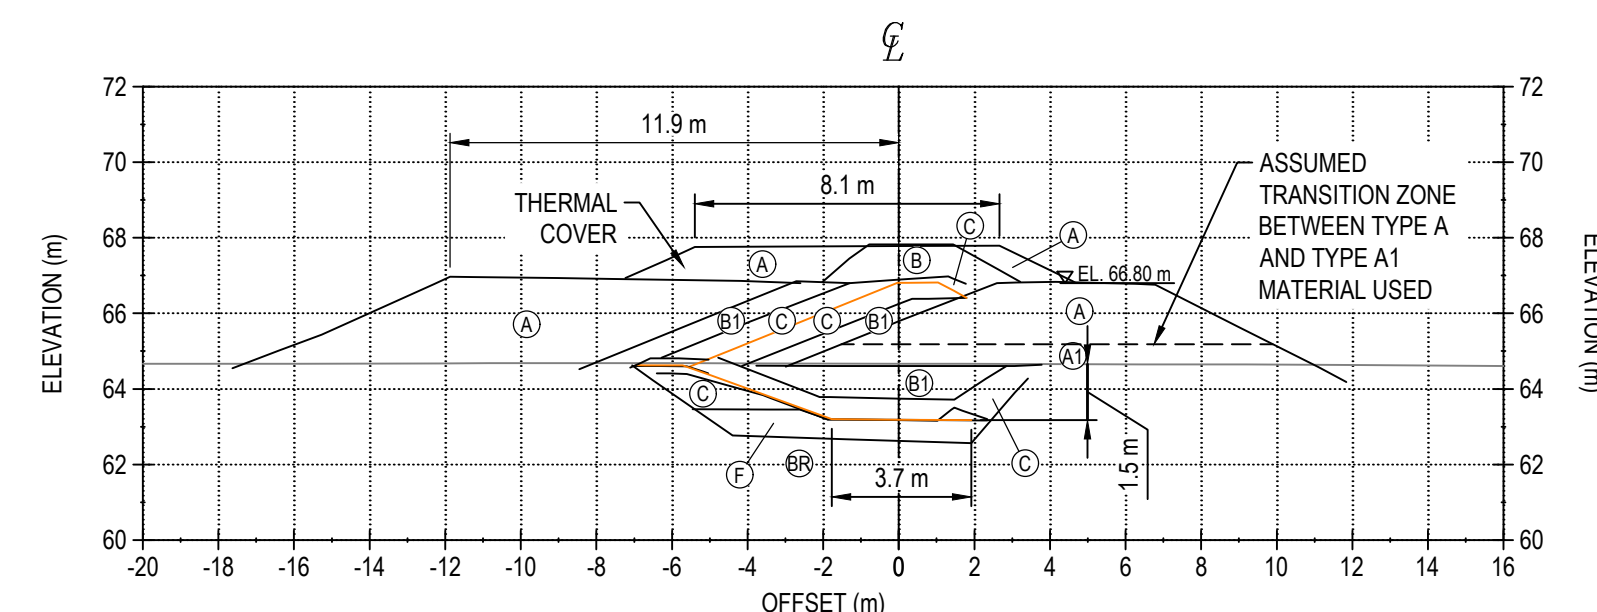

STATION 1+170



LEGEND

- PERMIT TO PRACTICE**
TETRA TECH CANADA INC.
- Signature: [Signature]
- Date: Oct 19, 2017
- PERMIT NUMBER: P 018**
NT/NU Association of Professional
Engineers and Geoscientists

THE INFORMATION HERE ON IS THE PROPERTY OF ADOCO EAGLE LTD. AND MUST BE RETURNED UPON REQUEST. WITHOUT WRITTEN PERMISSION, ANY COPYING, TRANSMISSION TO OTHERS AND ANY USE EXCEPT THAT FOR WHICH IT IS LOANED ARE PROHIBITED.
© ADOCO EAGLE LTD.

[illegible]


0	2017-10-19	ISSUED FOR RECORD	WITH	NG			
1	2016-08-15	ISSUED FOR CONSTRUCTION	GZ	KJ			
A	2016-08-10	ISSUED FOR REVIEW	GZ	KJ			
REV.	DATE	DESCRIPTION	PAR/BY	APP.	CLIENT		

D-CP5 AS-BUILT SECTIONS
STATION 1+030 TO 1+170


DESSINÉ PAR DRAWN BY	EL	DATE 2016-08-15
VÉRIFIÉ PAR CHECKED BY	GZ	2016-08-15
APPROUVÉ PAR APPROVED BY	GZ	2016-08-15
SÉRIELLE		DATE

NO. DESSIN
DRAWING NO.
65-685-230-219-001


NO. PROJ. PROJECT NO.	REVISION	FEUILLE / SHT
6515	1	6 / 9

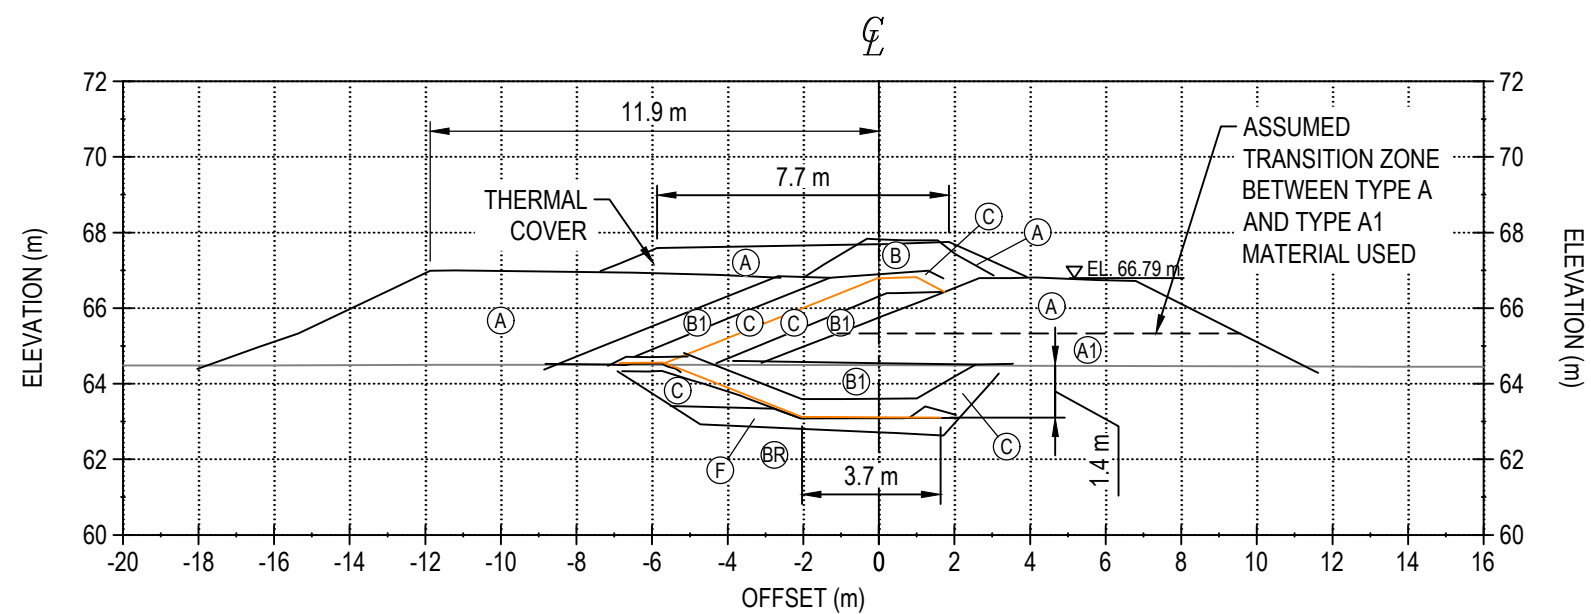


STATION 1+180

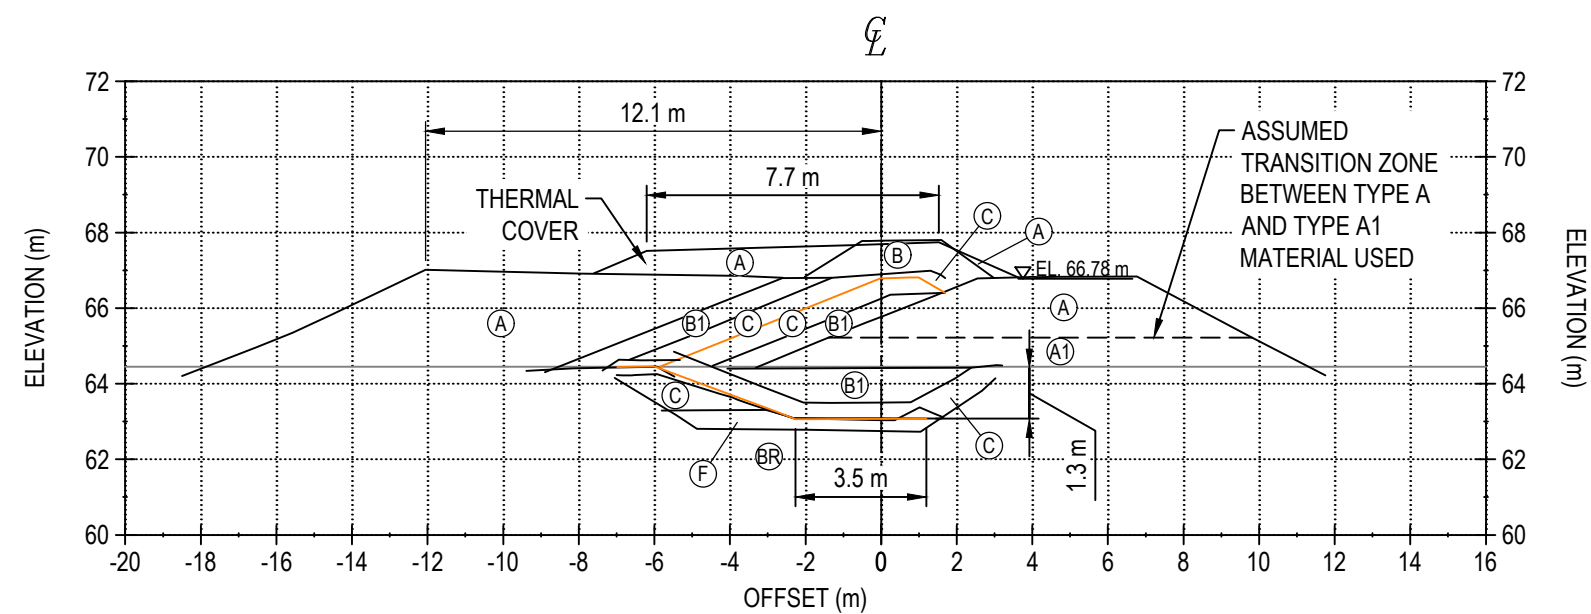


STATION 1+190

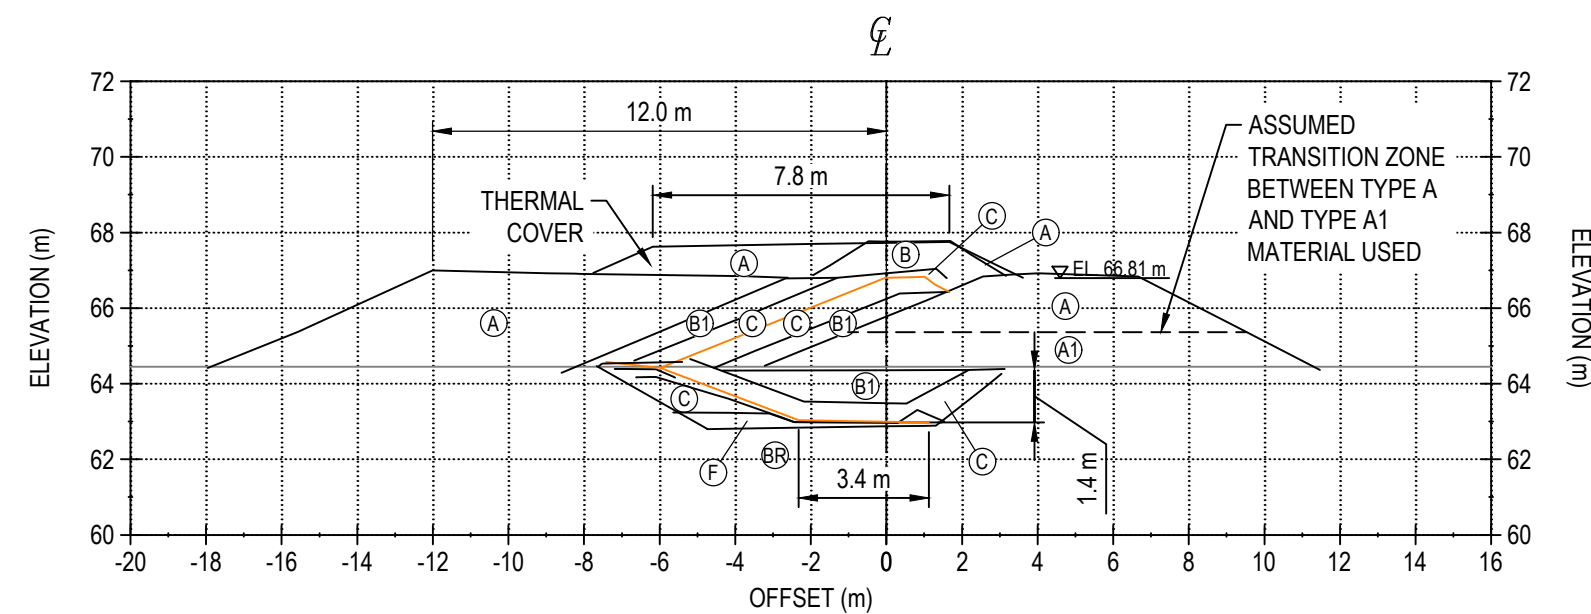


STATION 1+200

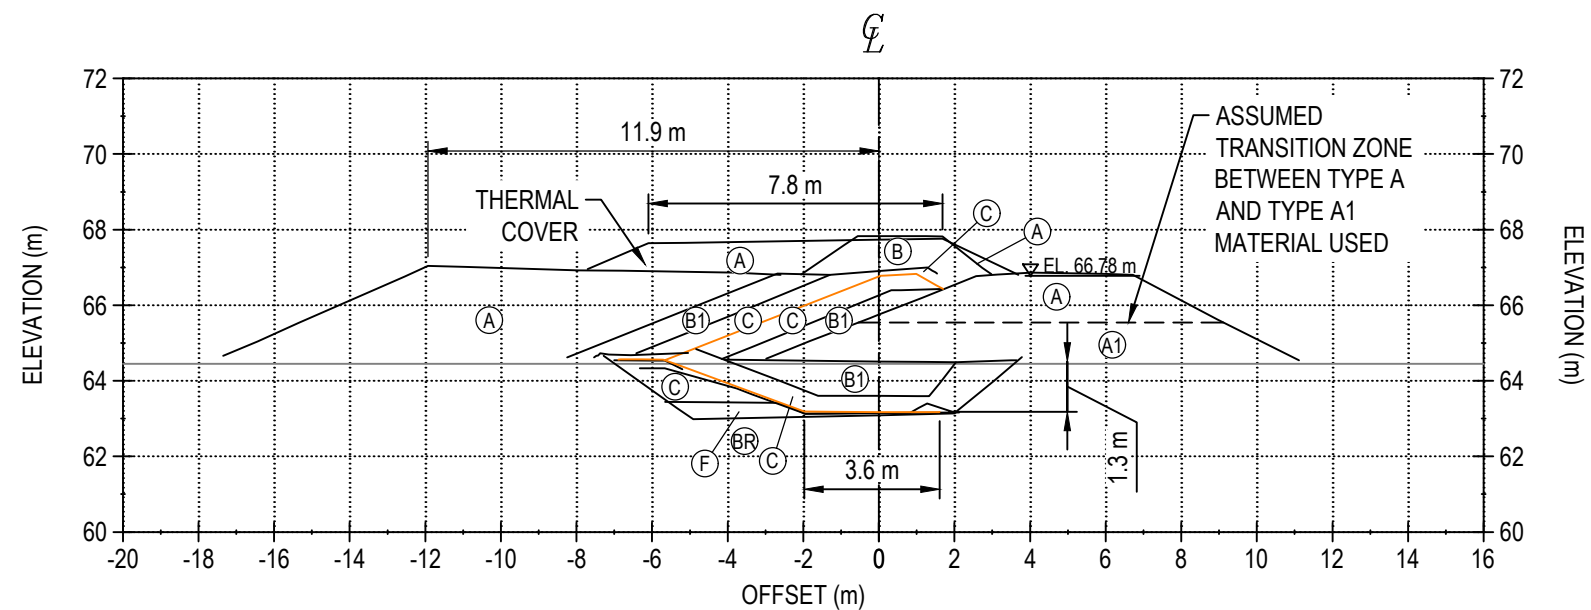


STATION 1+210

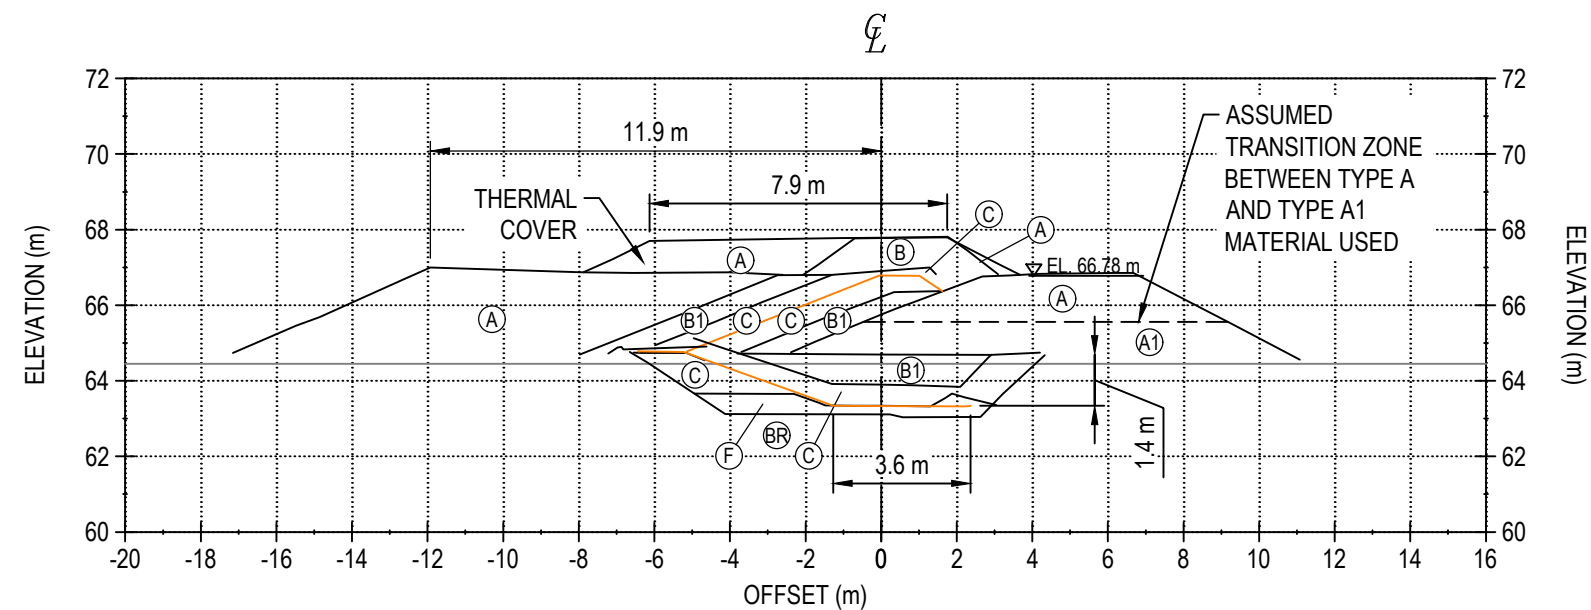


STATION 1+220

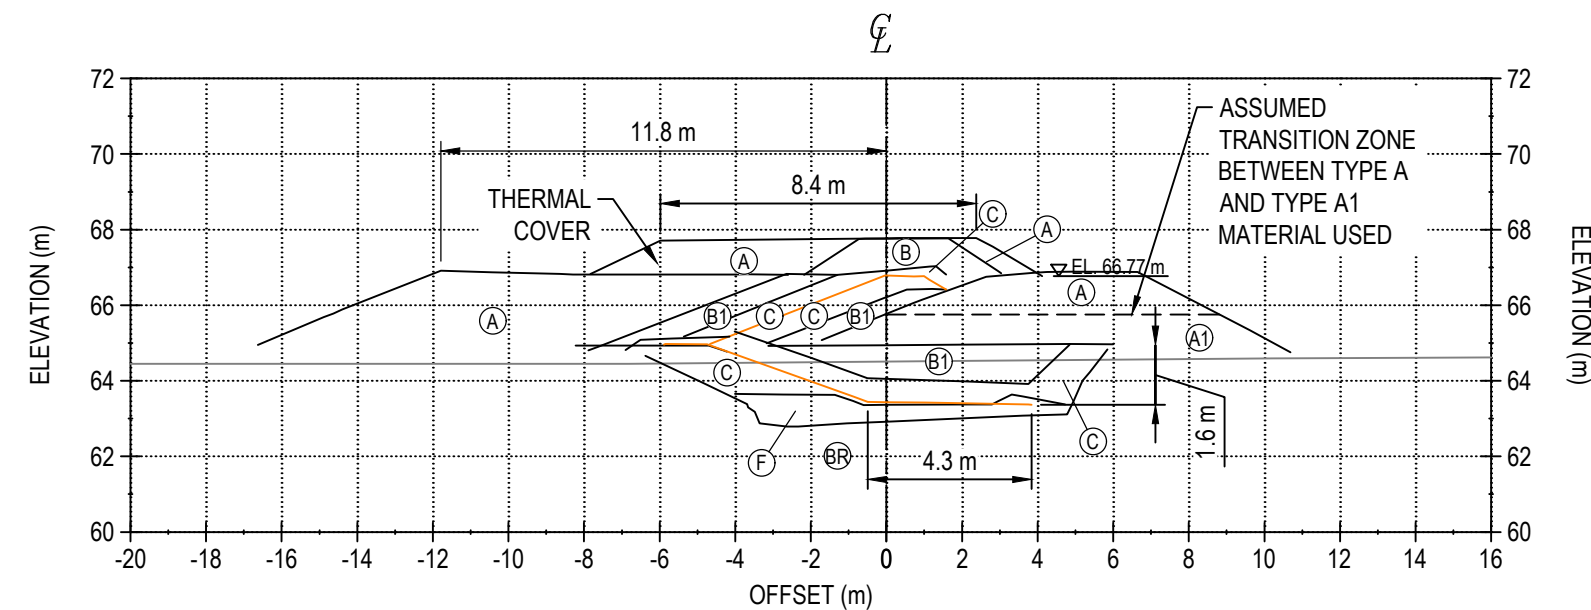


STATION 1+230

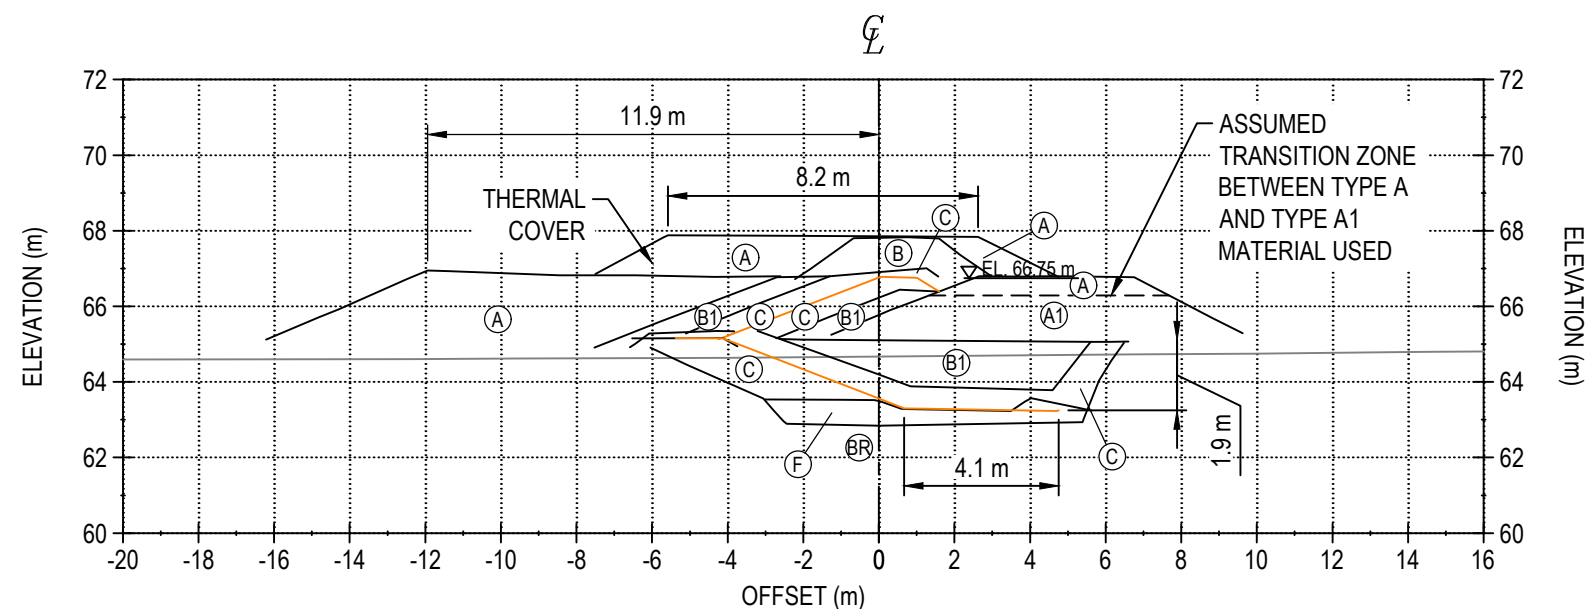


STATION 1+240

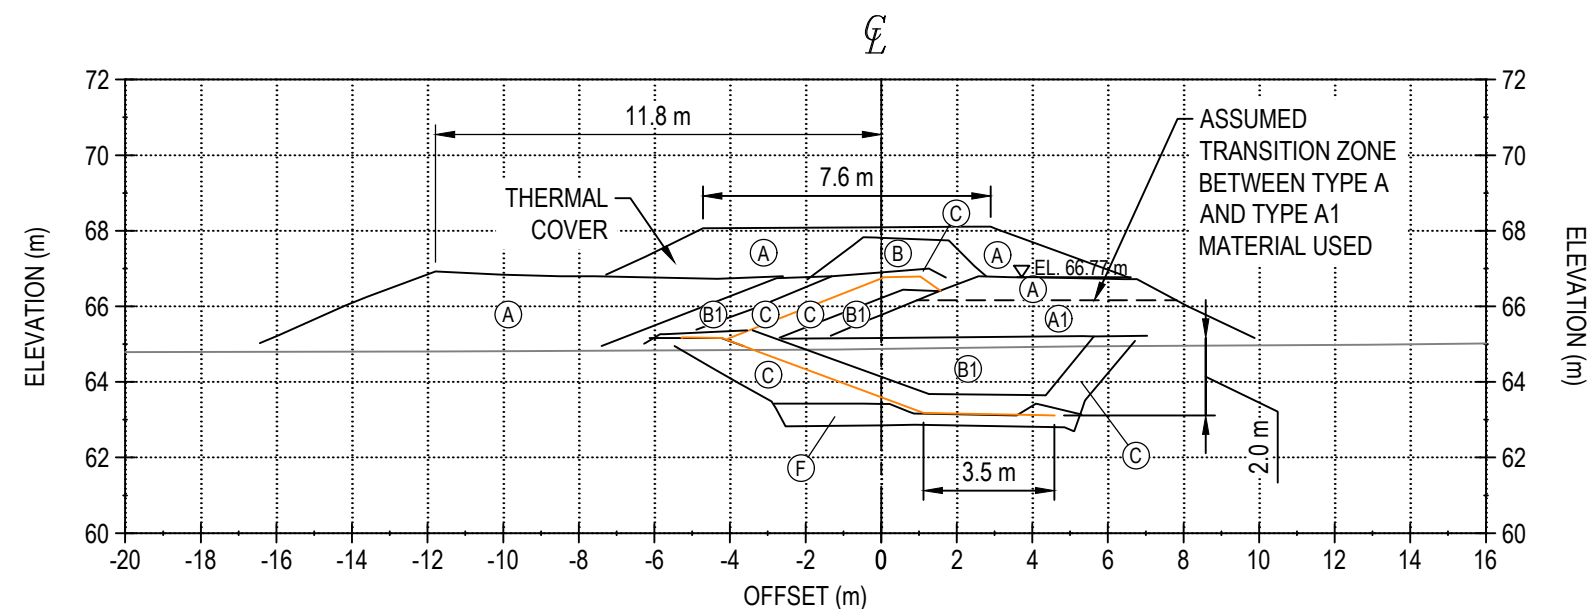


STATION 1+250

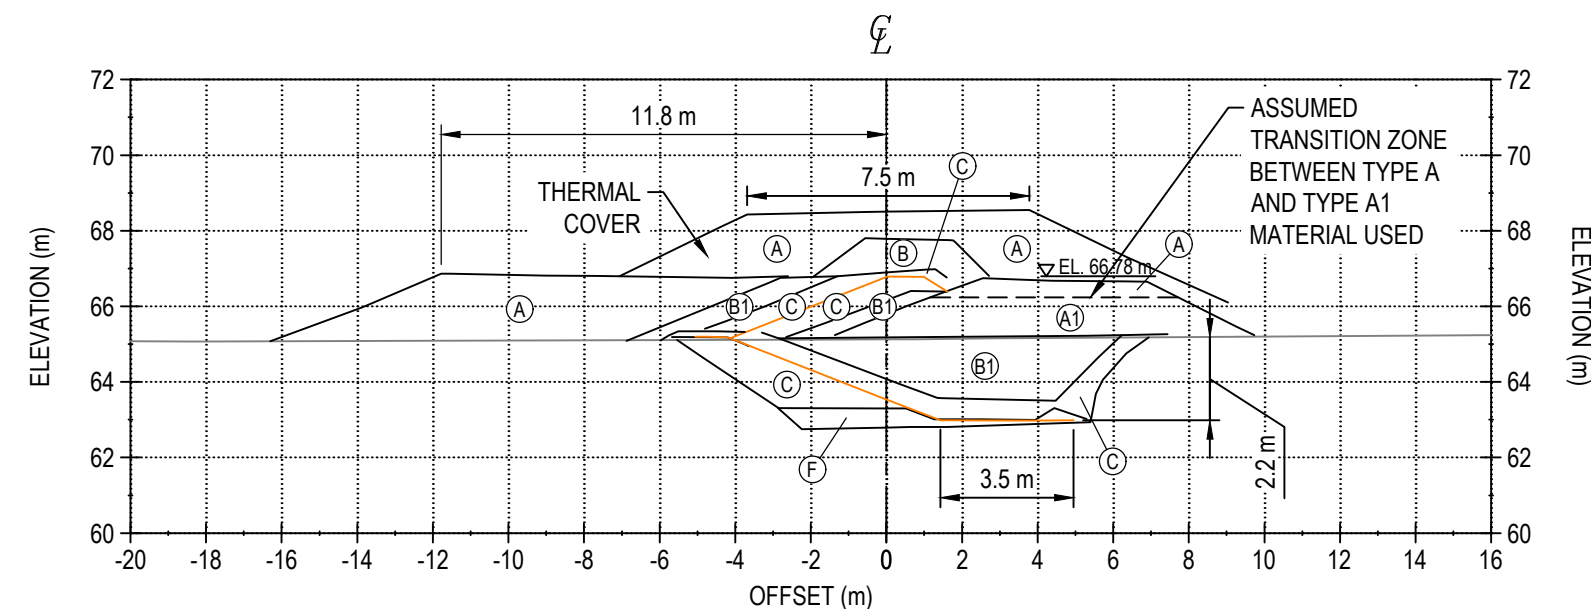


STATION 1+260

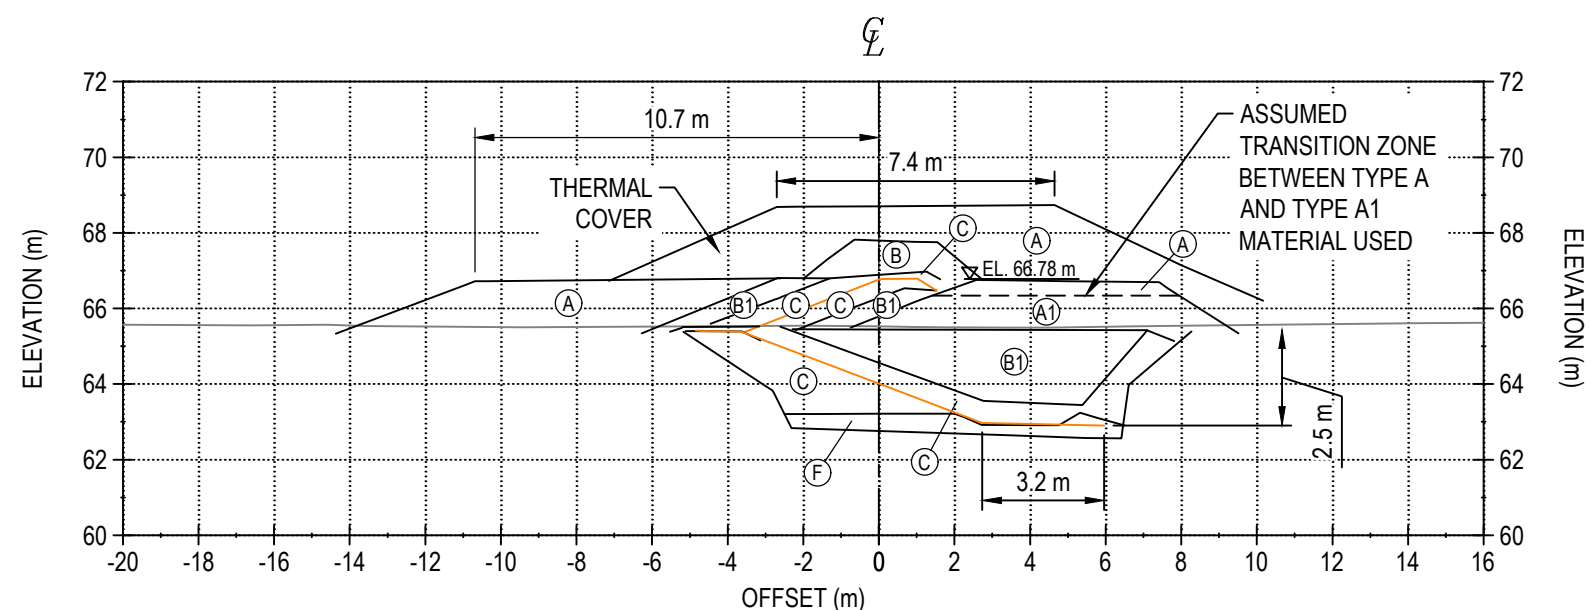


STATION 1+270

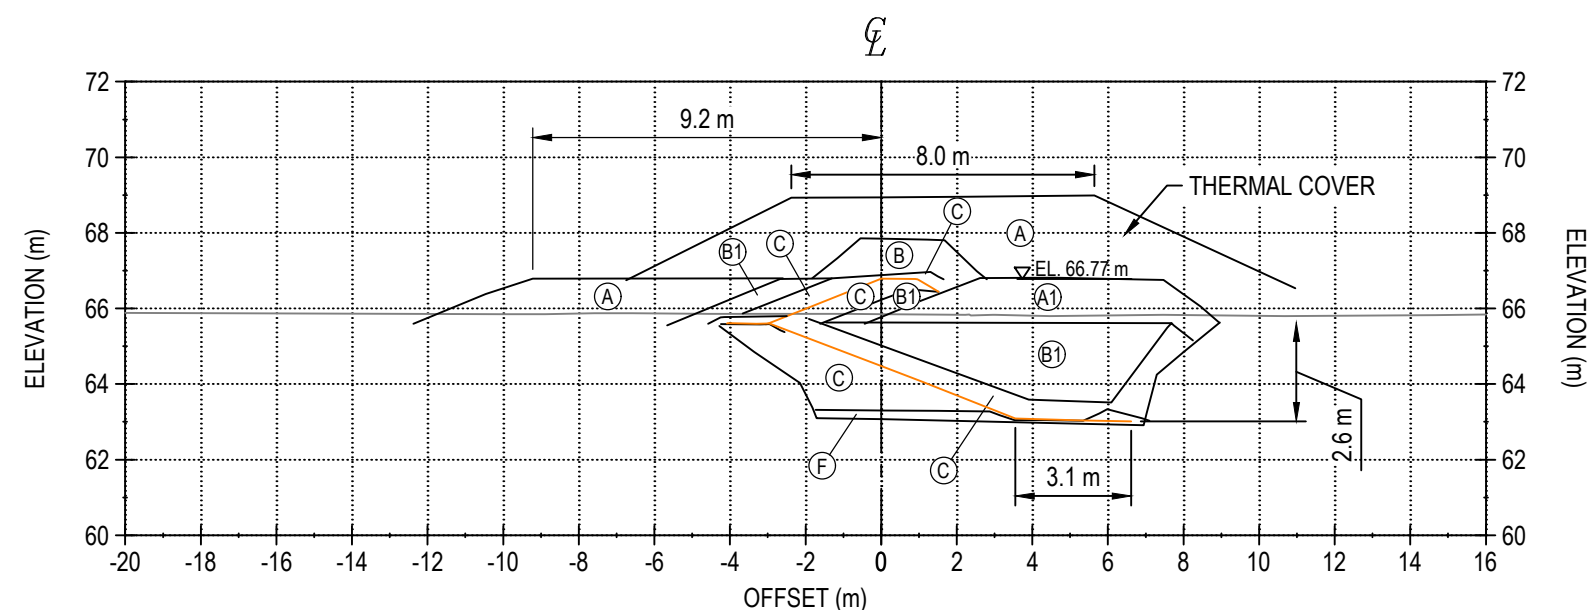


STATION 1+280

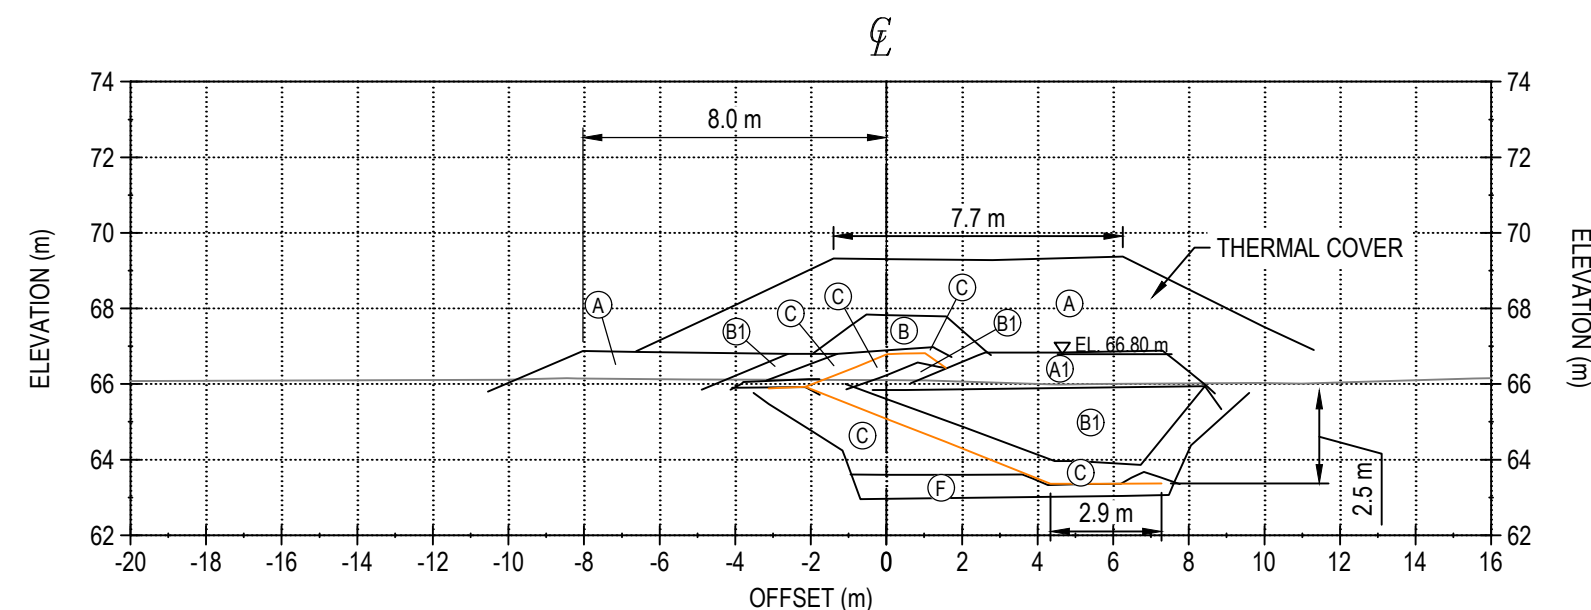


STATION 1+290

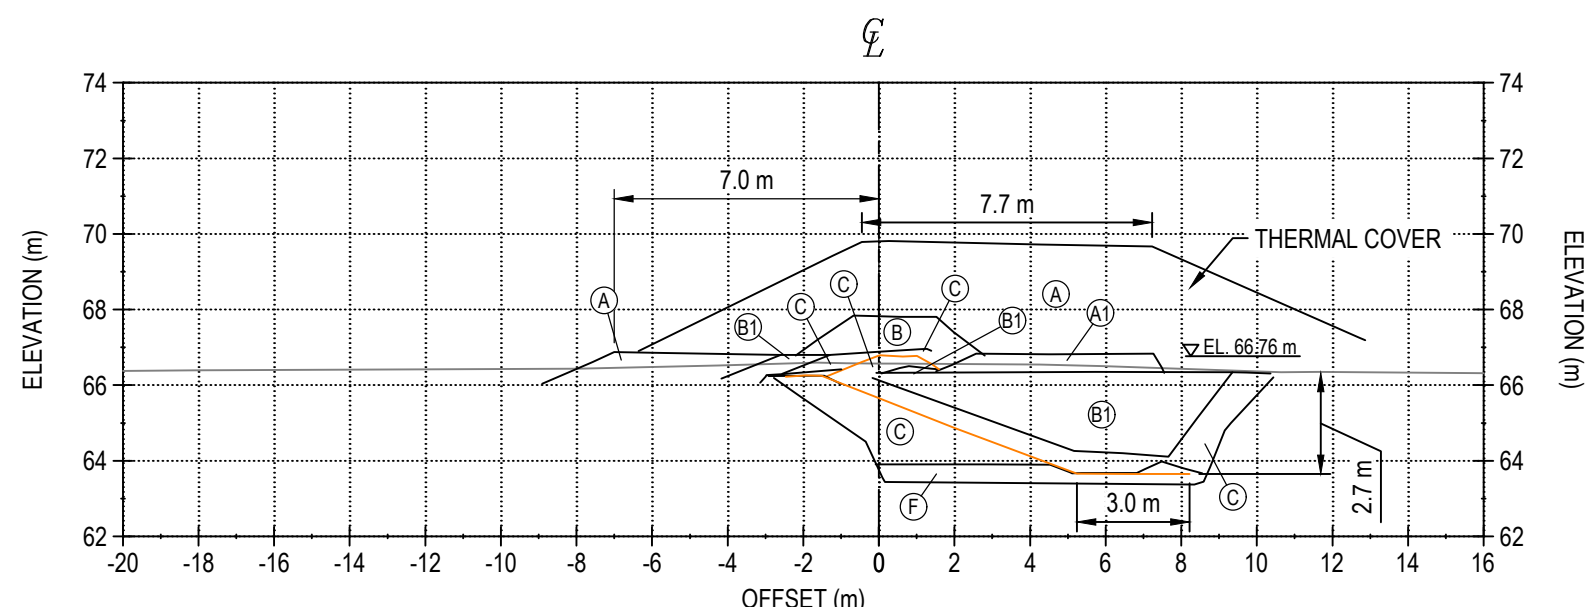

STATION 1+300

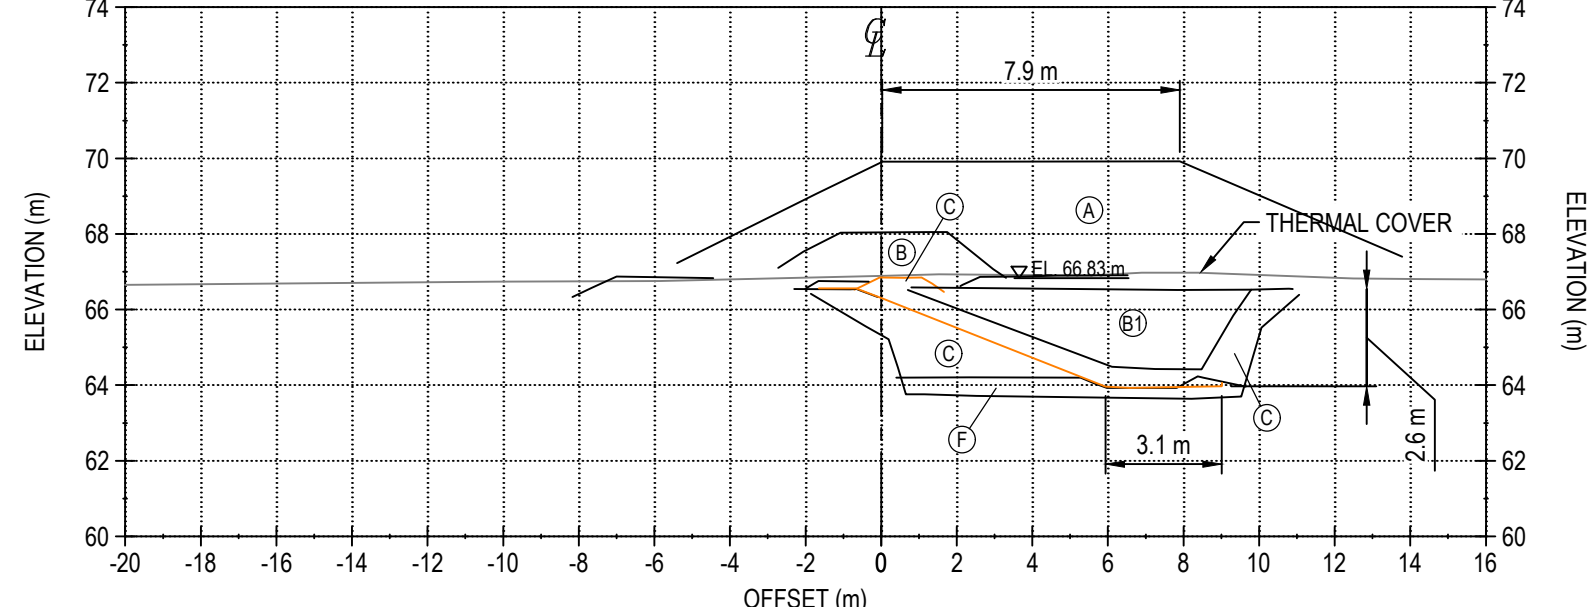


STATION 1+310

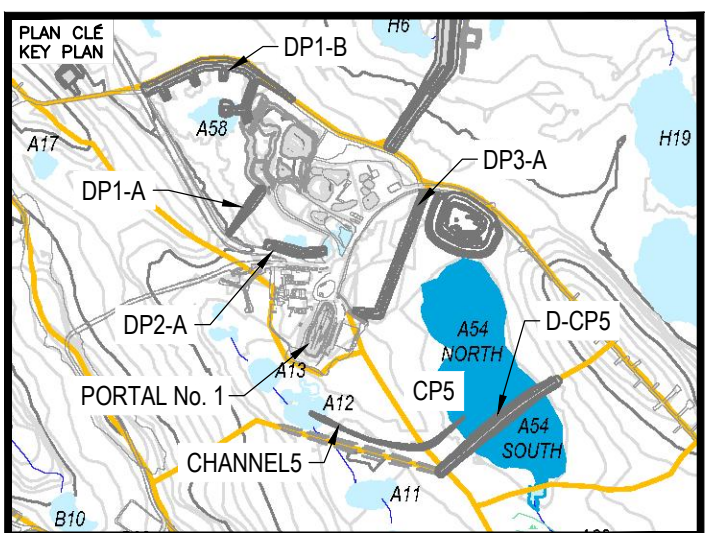

NOTES GÉNÉRALES / GENERAL NOTES

LEGEND

- (A) RUN-OF-MINE ROCKFILL (600 mm MINUS) IN DIKE UPSTREAM AND FOR THERMAL COVER
- (A1) RUN-OF-MINE ROCKFILL (600 mm MINUS) IN DIKE DOWNSTREAM
- (B) TRANSITION ROCKFILL (150 mm MINUS)
- (B1) TRANSITION ROCKFILL (150 mm MINUS)
- (C) GRANULAR FILL OR ESHER SAND (20 mm MINUS)
- (F) BENTONITE-AUGMENTED MATERIAL (MIXTURE OF BENTONITE AND TYPE C MATERIAL)
- DASHED LINES REFER TO NO AS-BUILT DATA BUT ESTIMATED BASED ON FIELD VISUAL OBSERVATION
- (BB) BEDROCK

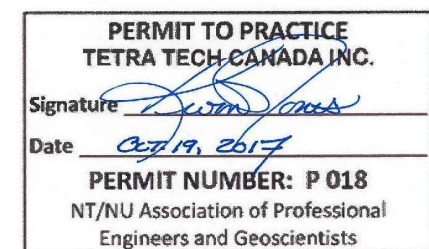


INFORMATION CONTENUE EST LA PROPRIÉTÉ DE AGNICO EAGLE LTD. ET NE DOIT ÊTRE RÉPÉTÉE SUR AUCUN AUTRE PROJET. SANS AUTORISATION ÉCRITE, AGNICO EAGLE LTD. NE PEUT ÊTRE REPRODUITE NI UTILISÉE POUR AUCUN AUTRE PROJET. SANS AUTORISATION ÉCRITE, AGNICO EAGLE LTD. NE PEUT ÊTRE REPRODUITE NI UTILISÉE POUR AUCUN AUTRE PROJET. SANS AUTORISATION ÉCRITE, AGNICO EAGLE LTD. NE PEUT ÊTRE REPRODUITE NI UTILISÉE POUR AUCUN AUTRE PROJET.

THE INFORMATION HEREIN IS THE PROPERTY OF AGNICO EAGLE LTD. AND MUST BE RETURNED UPON REQUEST WITHOUT WRITTEN PERMISSION. NO COPYING, REPRODUCTION, OR DISSEMINATION OF ANY KIND IS PERMITTED WITHOUT WRITTEN PERMISSION.

DESSINS EN RÉFÉRENCE / REFERENCE DRAWINGS	
TITRE / TITLE	# DWG
---	---
---	---
REV.	DATE	DESCRIPTION	PHS/ENR	APP.	CLIENT
1	2017-10-19	ISSUED FOR RECORD	WTH	NG	
2	2016-08-15	ISSUED FOR CONSTRUCTION	GZ	KJ	
3	2016-08-15	ISSUED FOR REVIEW	GZ	KJ	

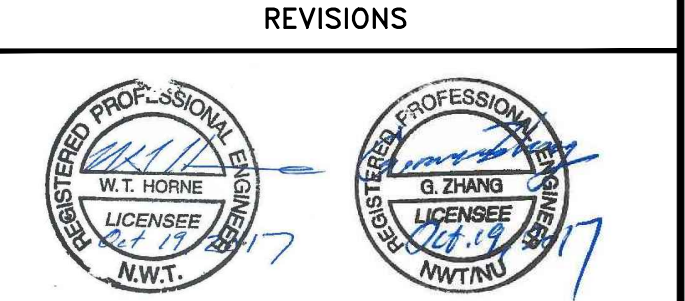

TITRE / TITLE
AGNICO EAGLE MELIADINE GOLD PROJECT


D-CPS AS-BUILT SECTIONS
STATION 1+180 TO 1+310

DESSINÉ PAR DRAWN BY	EL	DATE 2016-08-15
VÉRIFIÉ PAR CHECKED BY	GZ	2016-08-15
APPROUVÉ PAR APPROVED BY	GZ	2016-08-15


ÉCHELLE
SCALE 1:200

NO. DESSIN
DRAWING NO. 65-685-230-219-002


NO. PROJET PROJECT NO.	REVISION	FEUILLE / SHEET
6515	1	7 / 9

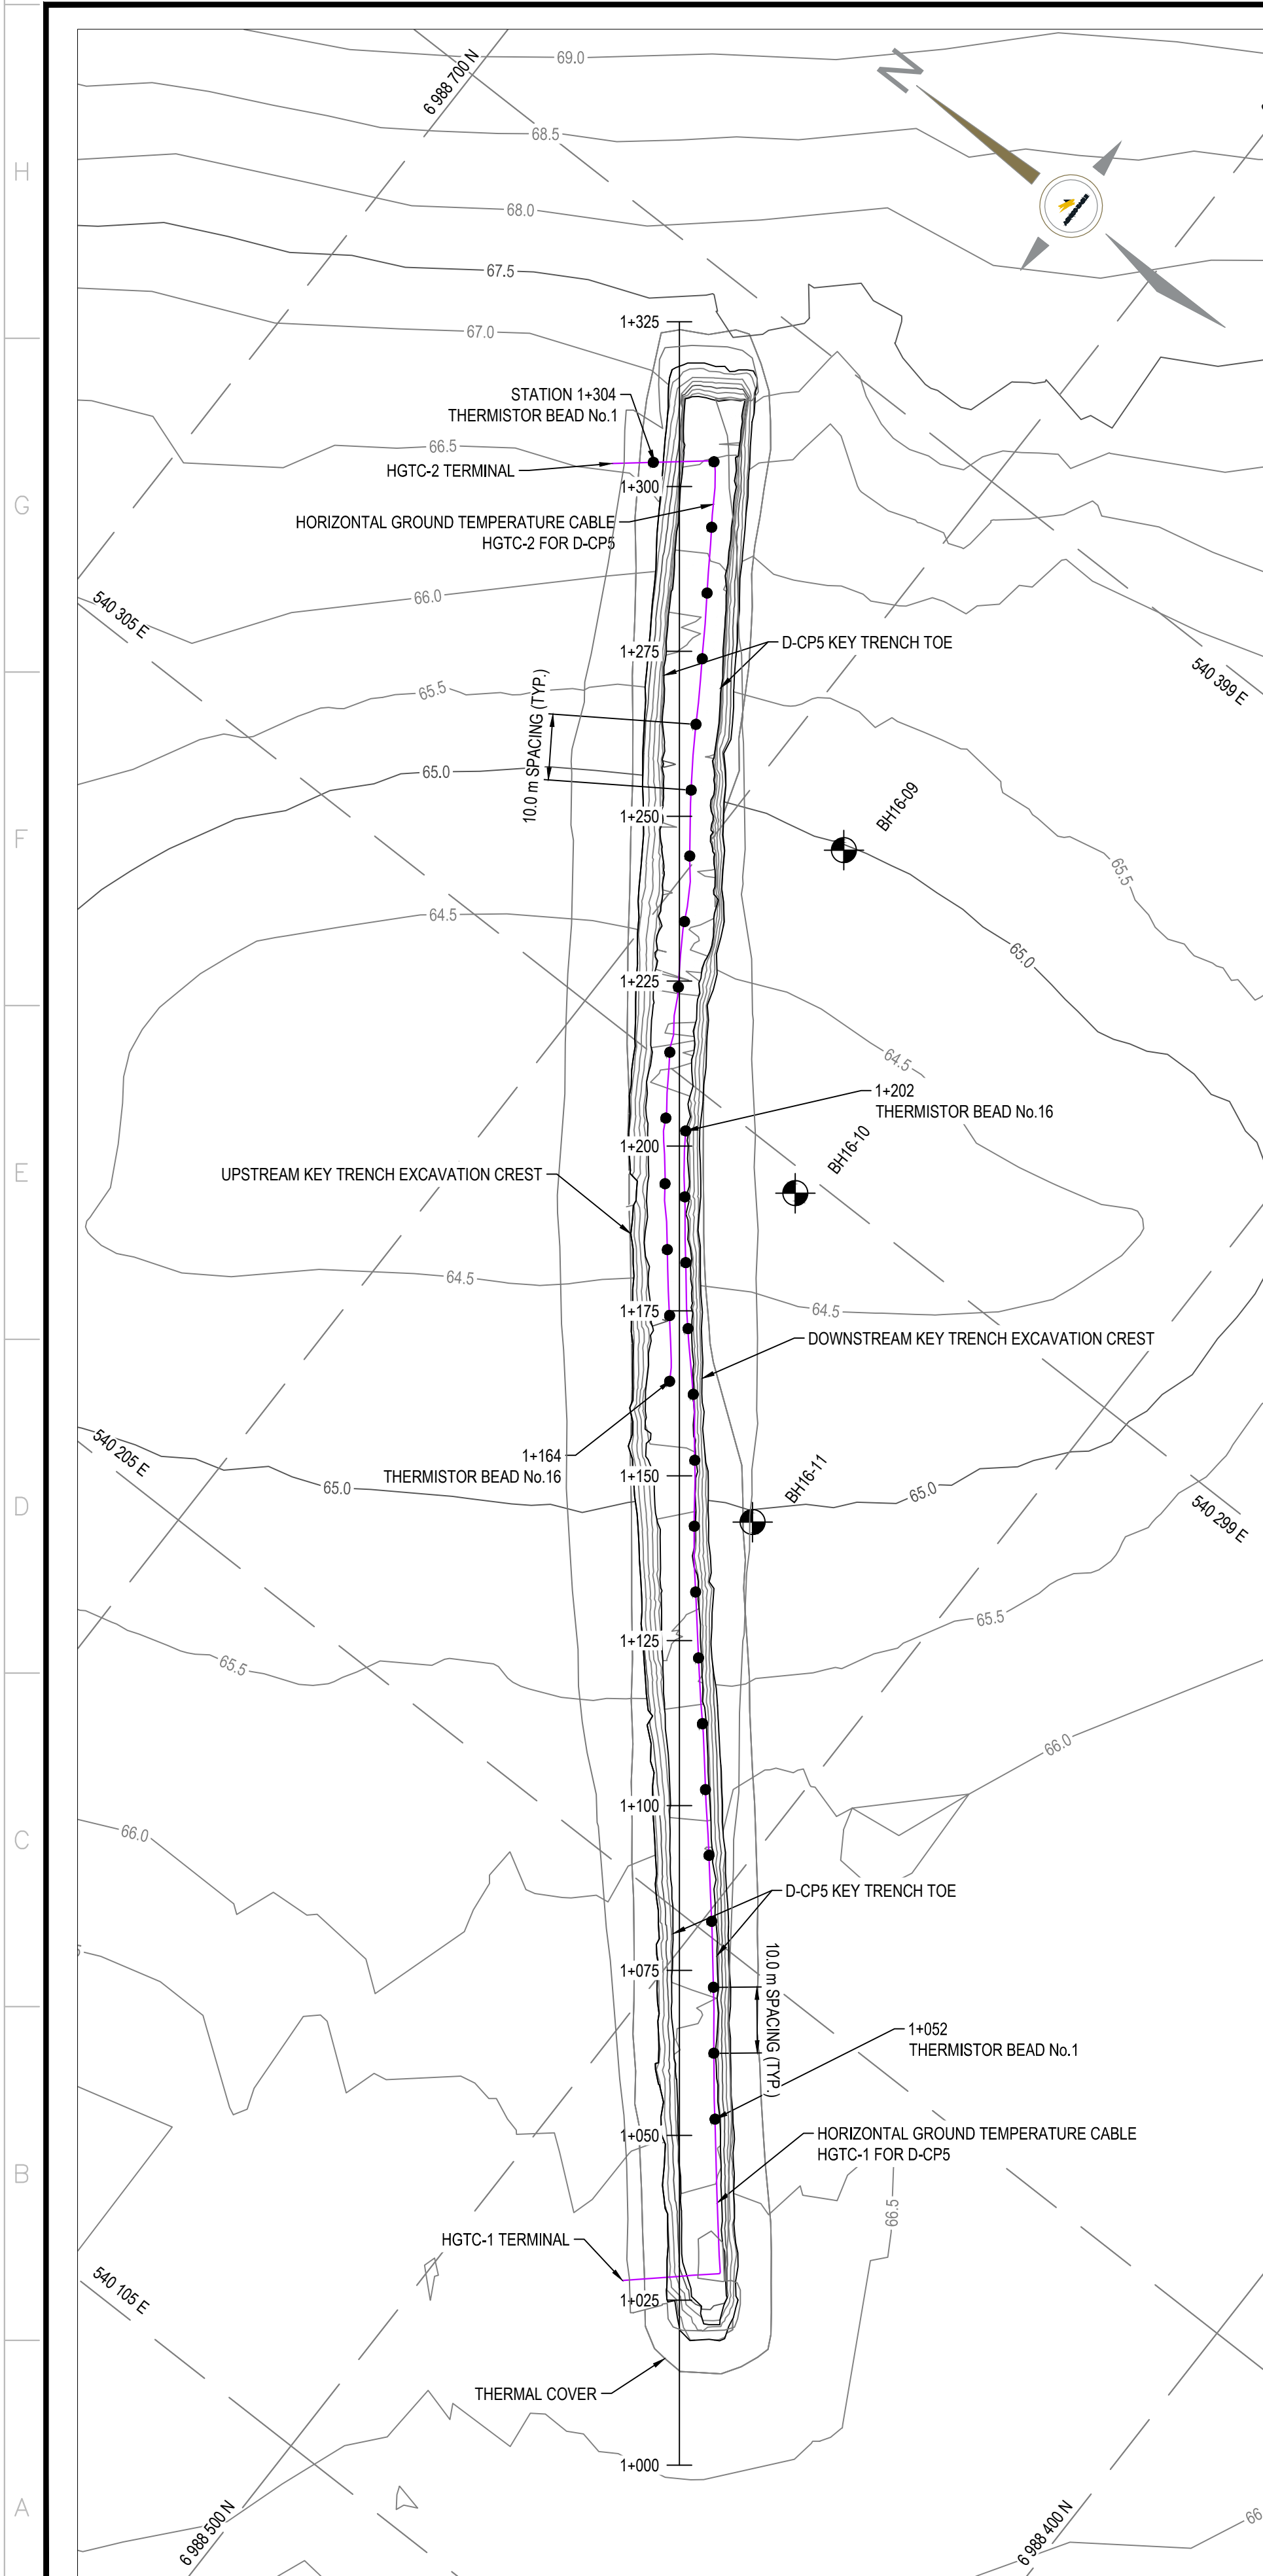

D-CP5 AS-BUILT HORIZONTAL GROUND TEMPERATURE CABLE LAYOUT
SCALE: 1:750

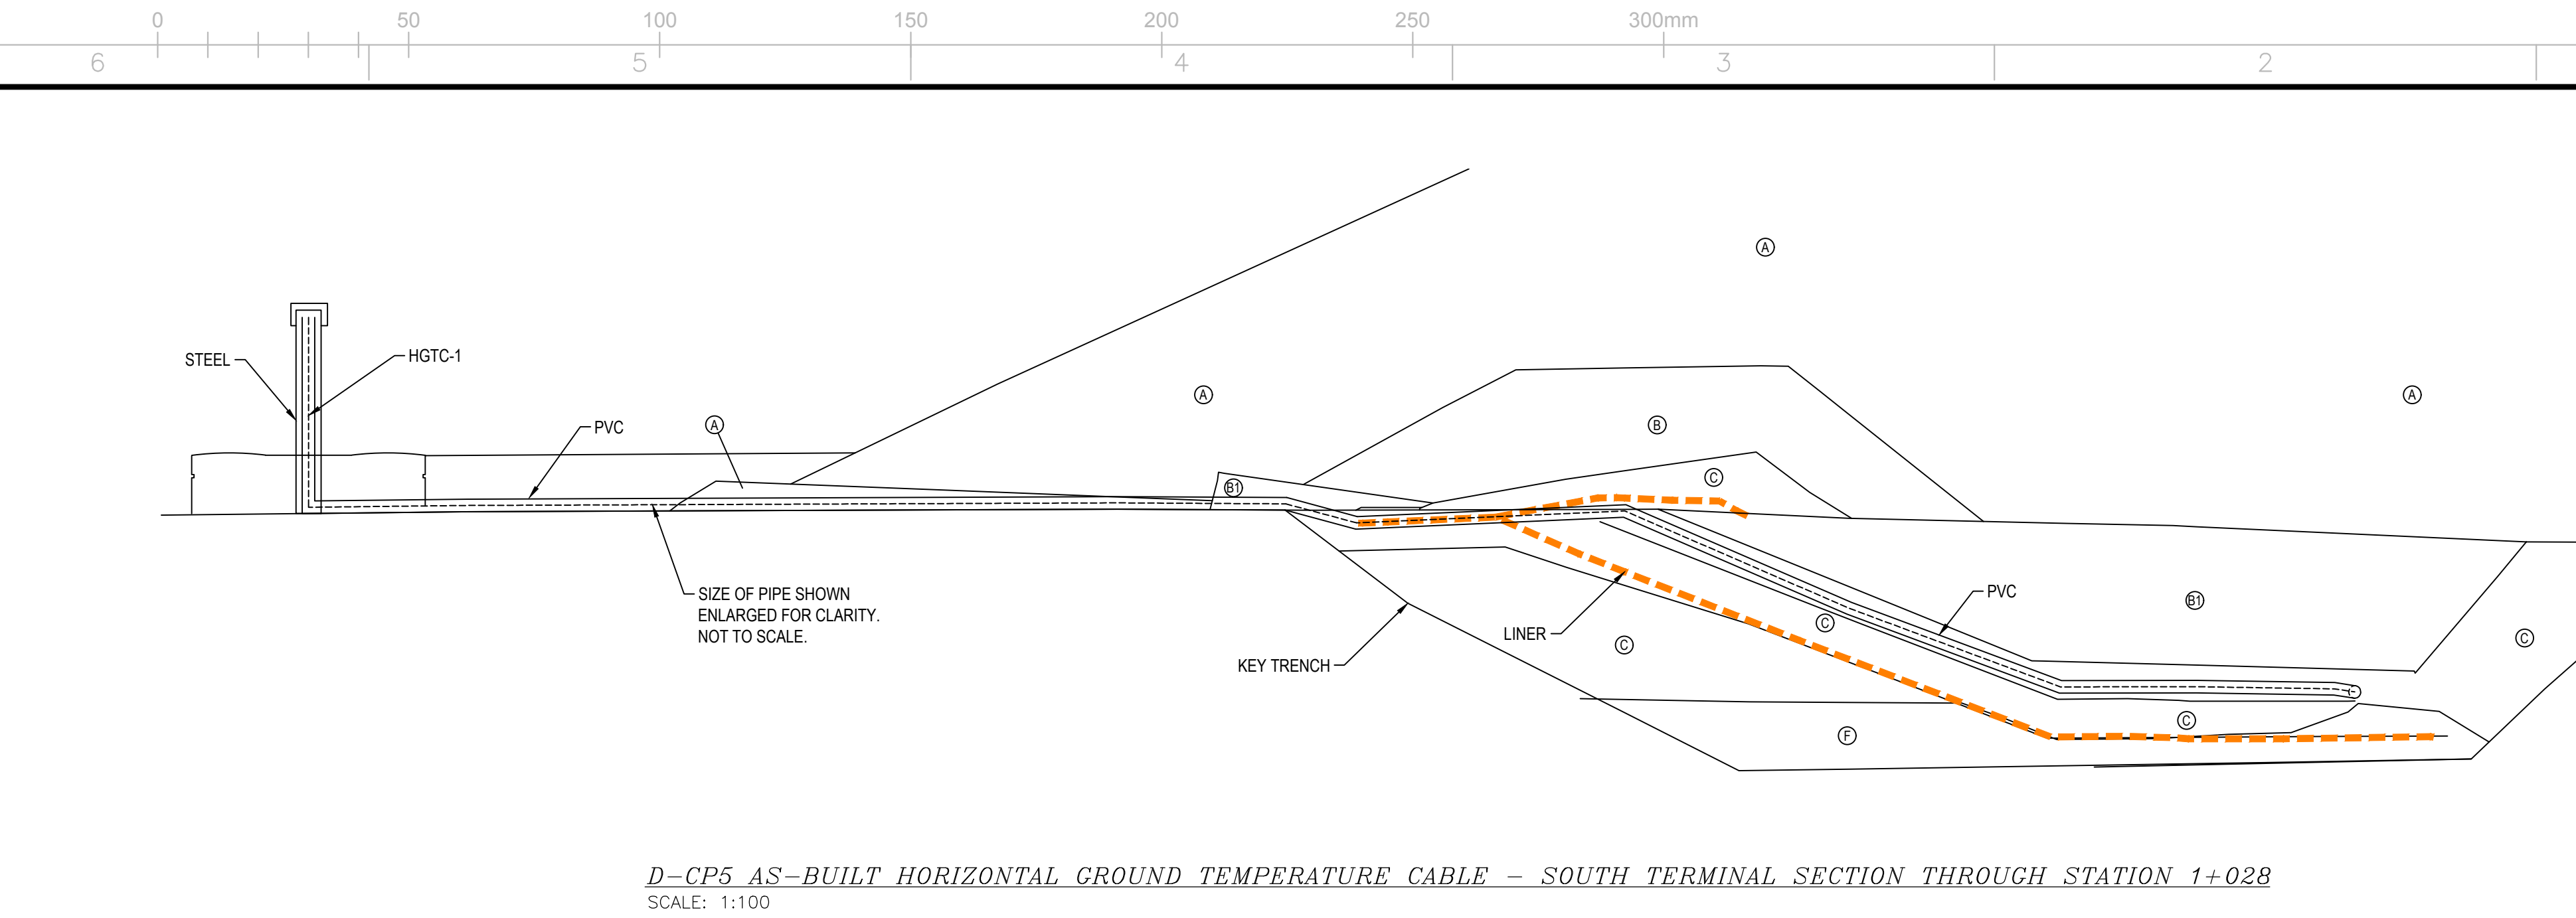

D-CP5 AS-BUILT HORIZONTAL GROUND TEMPERATURE CABLE - SOUTH TERMINAL SECTION THROUGH STATION 1+028
SCALE: 1:100

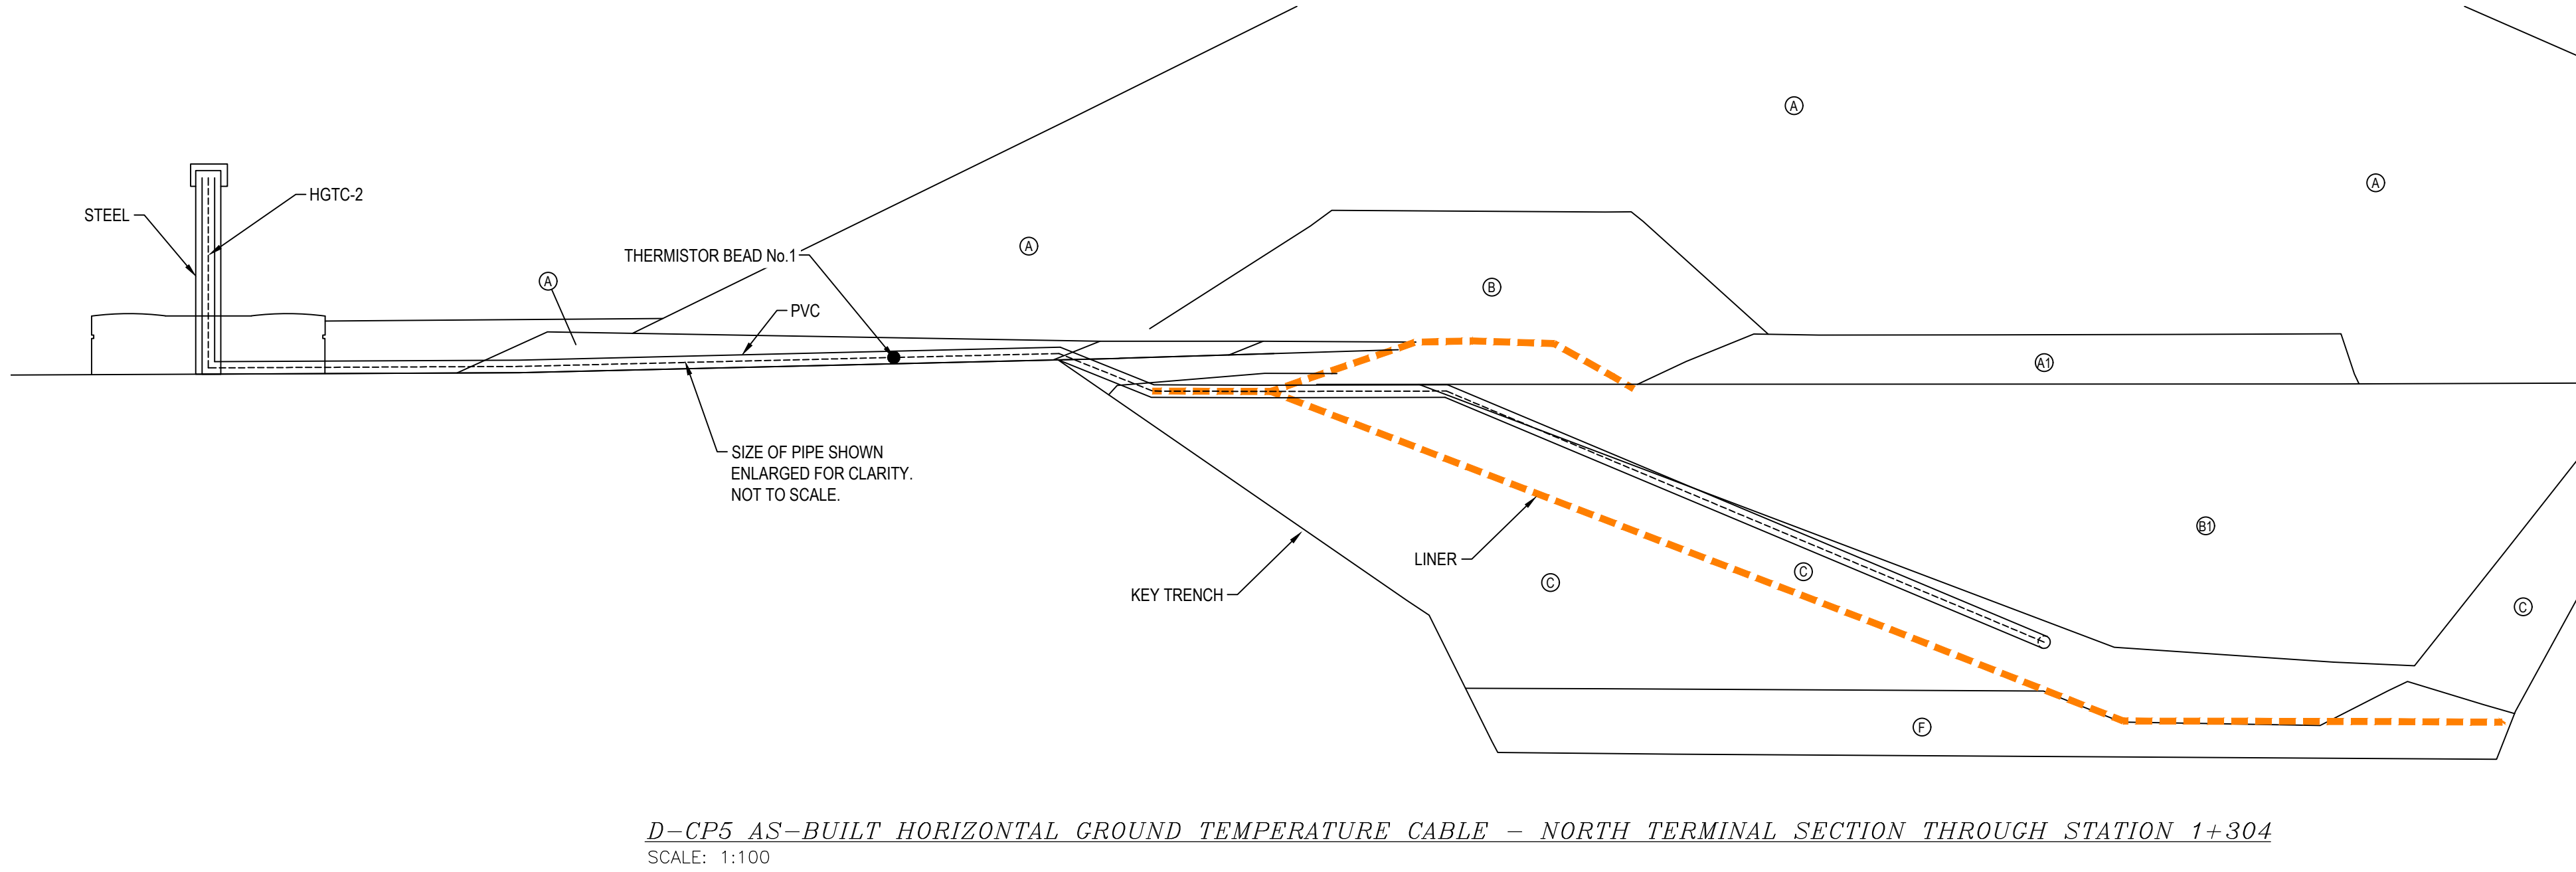



NOTES GÉNÉRALES / GENERAL NOTES

TEL QUE CONSTRUIT
AS BUILT

 AIRMOV EAGLE


DATE : 2017-10-19

THE INFORMATION IS CONTAINED HEREIN IS THE PROPERTY OF AIGVCO EAGLE LTD. AND MUST BE RETURNED UPON REQUEST, WITHOUT WRITTEN PERMISSION. ANY COPYING TRANSMITTAL TO OTHERS AND ANY USE EXCEPT THAT FOR WHICH IT IS LOANED ARE PROHIBITED.



AGNICO EAGLE

REVISIONS

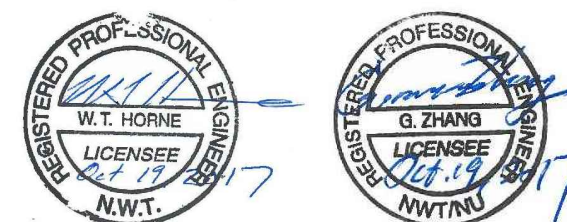

TITRE / TITLE	AGNICO EAGLE MELIADINE GOLD PROJECT
---------------	-------------------------------------

D-CP5 AS-BUILT - INSTRUMENTATION PLAN AND
DETAILS FOR GROUND TEMPERATURE CABLES
AND SETTLEMENT SURVEY MONUMENT POINTS

NO. DESSIN DRAWING NO.	65-685-230-221
---------------------------	----------------

NO. PROJET PROJECT NO.	REVISION	FEUILLE / SHEET
6515	1	9 / 9