



July 6th, 2017

Karen Kharatyan
Manager of Licensing
Nunavut Water Board
P.O. Box 119
Gjoa Haven, NU
X0B 1J0

Re: Water License 2AM-MEL1631 Part D, Item 3 / NIRB Project Certificate 11MN034
Condition 18 - Submission of Construction Summary Report for the Freshwater
Treatment Plant

Mr. Kharatyan,

Agnico Eagle Mines Limited is developing the Meliadine Project, a gold mine located approximately 25 km north from Rankin Inlet, and 80 km southwest from Chesterfield Inlet in the Kivalliq Region of Nunavut. Situated on the western shore of Hudson Bay, the Project site is located on a peninsula between the east, south, and west basins of Meliadine Lake (63°1'23.8" N, 92°13'6.42"W) on Inuit Owned Land.

Facilities that are planned to be constructed for the operation of the future Meliadine Mine include a mill, power plant, maintenance facilities, tank farm for fuel storage, freshwater treatment plant, sewage treatment plant, and accommodation and kitchen facilities for 520 people.

Commissioning of the Freshwater Treatment Plant was completed April 7, 2017. In accordance with Water License 2AM-MEL1631, Part D, Item 3 and Schedule D, and Project Certificate 11MN034 Condition 18, please find enclosed with this letter, a copy of the Construction Summary Report for the Freshwater Treatment Plant.

Should you have any questions regarding this submission, please contact me.

Regards,

Agnico Eagle Mines Limited – Meliadine Division

A handwritten signature in blue ink, appearing to read "Manon Turmel".

Manon Turmel
manon.turmel@agnicoeagle.com
819-759-3555 x8136
Environmental Compliance Counselor



Meliadine Fresh Water Treatment Plant

Construction Summary Report (AS-Built report)

In Accordance with Water License 2AM-MEL1631 (Part D, item 3)

Prepared by:

Agnico Eagle Mines Limited – Meliadine Division

July 2017

TABLE OF CONTENTS

1	INTRODUCTION	4
2	SUMMARY OF THE CONSTRUCTION	4
2.2	SITE LOCATION AND ACCESS	4
2.3	SCHEDULE	5
2.4	TREATMENT PLANT CHARACTERISTICS	5
2.4.1	Cartridge filters treatment	5
2.4.2	Ultraviolet treatment	5
2.4.3	Chemical treatment	6
3	DOCUMENTATION ON FIELD DECISIONS THAT DEVIATE FROM THE ORIGINAL PLAN	6
4	SUMMARY OF ANALYSIS RESULTS OF WATER QUALITY TESTS	6
5	DRAWINGS AND PHOTOGRAPHS	7

LIST OF FIGURE AND TABLE IN TEXT

Figure 1. Plan of the site and location of the FWTP	4
Table 1. List of drawing contained in Appendix D.....	7

APPENDICES

Appendix A: Construction Monitoring Summary

Appendix B: Process Flow Schematics

Appendix C: Summary of analysis result of water quality test

Appendix D: Freshwater Treatment Plant As-Built Drawings

Appendix E: Freshwater Treatment Plant Photographs

1 INTRODUCTION

As required by Water License A No. 2AM-MEL1631 – Agnico Eagle Mines Limited for the Meliadine Gold Project (Part D, Item 3), this report summarizes the construction work of the Freshwater Treatment Plant. Included in this report:

- Summary of the construction;
- Summary of field decisions and mitigation measures implemented during construction;
- As-built drawings;
- Photographs of the infrastructure.

2 SUMMARY OF THE CONSTRUCTION

2.2 SITE LOCATION AND ACCESS

Agnico Eagle Mines Limited (Agnico Eagle) is developing the Meliadine Project (the Project), a gold mine located approximately 25 km north from Rankin Inlet, and 80 km southwest from Chesterfield Inlet in the Kivalliq Region of Nunavut. Situated on the western shore of Hudson Bay, the Project site is located on a peninsula between the east, south, and west basins of Meliadine Lake (63°1'23.8" N, 92°13'6.42"W) on Inuit Owned Land.

The figure below presents a site location plan (Figure 1).

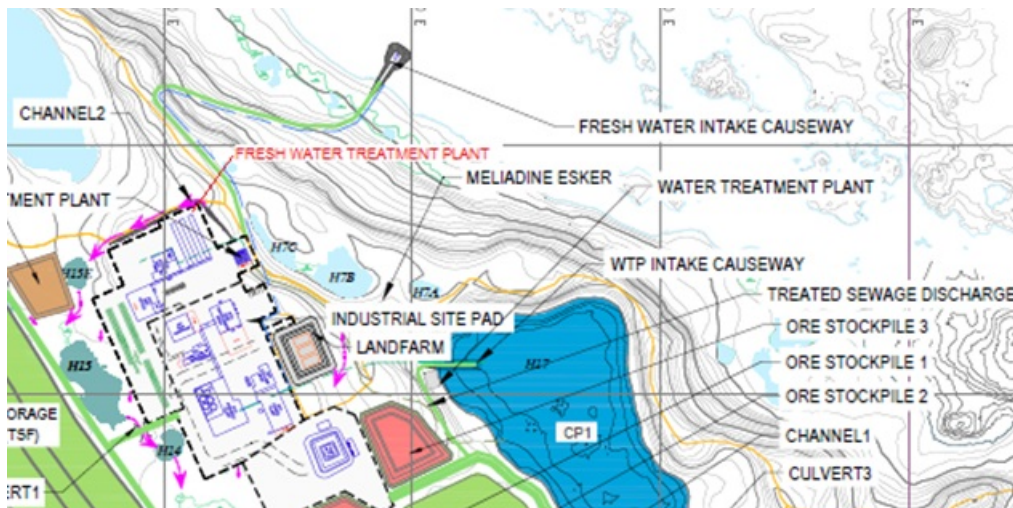


Figure 1. Plan of the site and location of the FWTP

2.3 SCHEDULE

The overall schedules for the Freshwater Treatment Plant are as follows:

- Period of construction and commissioning: From March 3rd, to April 6th, 2017.
- Date of operation start-up: April 7th, 2017.
- The construction monitoring was managed by the supplier (H2O innovation).

The construction monitoring summary is presented in Appendix A.

2.4 TREATMENT PLANT CHARACTERISTICS

The camp and accommodations are equipped with a Freshwater Treatment Plant (FWTP) for potable (domestic) water. The design flow rate for the FWTP is 216 m3 per day. In the FWTP, the freshwater first goes through cartridge filters and then is pumped through ultraviolet units, and finally is treated with sodium hypochlorite (chlorine). The treated water is stored within a potable water tank. Potable water is monitored according to the Nunavut health regulations for total and residual chlorine and microbiological parameters. Treated potable water is piped to the camp as well as to areas in the process plant, service complex, and other facilities requiring potable water. The following sections describe in more detail each step of the treatment. The flow diagram is available in Appendix B.

2.4.1 Cartridge filters treatment

Physical treatments are accomplished by withdrawing the suspended particles in raw Freshwater. This is achieved with cartridge filters which contain 4 pleated element cartridges that are able to trap debris, oils and other particles as water flows through it. The first cartridge filter will reaches 5 microns filtration and the second achieves 1 micron filtration.

2.4.2 Ultraviolet treatment

The water is then disinfected by two ultraviolet reactors installed in parallel. This treatment serves as sterilization which deactivates organic contaminants, such as pathogens, bacteria, parasites or viruses.

2.4.3 Chemical treatment

Chemical treatments are accomplished by the injection of sodium hypochlorite (NaClO), which is often used for water purification. Hypochlorite can be used to prevent algae growth and is effective against bacteria and viruses.

3 DOCUMENTATION ON FIELD DECISIONS THAT DEVIATE FROM THE ORIGINAL PLAN

The construction of the Fresh Water treatment plant followed the design drawing.

During the commissioning, the following issues occurred and were solved:

- Baseboard heater was heating wall instead of floor. To remediate to this, the heater temperature was adjusted to 5C to minimize wall heating.
- The Container#1 and Container#2 baseboard heaters were tripping. To remediate to this the electronic system was bypassed and an external thermostat control was installed.
- One the UV Passing chamber (UV-91000B) was leaking from a weld. To remediate to this, the chamber was replaced.

4 SUMMARY OF ANALYSIS RESULTS OF WATER QUALITY TESTS

To ensure good functioning of the system, water quality tests were undertaken on the drinking water outtake at the camp's kitchen. The parameters tested were coliforms, Escherichia coli (E.coli) and atypical bacteria. The results are presented in Appendix C and show that no bacteria were detected in the drinking water.

5 DRAWINGS AND PHOTOGRAPHS

As-built drawings are presented in Appendix D. Table 1 present the different drawing included in Appendix D.

Table 1. List of drawing contained in Appendix D

Drawing Number	Drawing Name
P65873-C01-0001_R04	Process and Instrumentation Diagrams Legend
P65873-C01-0100_R04	Raw Water Feed System
P65873-C01-0400_R04	Cartridge Filters
P65873-C01-0800_R04	Dosing Skids-Duplex Solenoid
P65873-C01-0910_R04	UV Treatment Units
P65873-C01-0990_R04	Treated Water Distribution System

Appendix E contains photographs taken after the completion of the construction of the FWTP.

Appendix A: Construction Monitoring Summary

Day	Time (from-to)		Work description	Comments/Delays
3/3/2017	13:30pm to 17:30pm		Arrival on site	WTP raw water tank feed to fire suppression system have to be insulated prior to fill raw water tank.
		STP/WTP	Material expedited from H2OI verification/gathering	
		WTP	Give the material to the plumber and give instruction to fix the 1 1/4" PVC piping broken line	
		STP/WTP	STP/WTP interconnections verification	
		STP	Prepare material and give instruction to plumber in prevision of EQ sump and effluent sump inversion for the day after	
		STP	Smoke detector batteries replacement	
		WTP	Installing 5 microns and 10 microns Filters	
3/4/2017	6:00am to 17:30pm		2nd day on site	WTP raw water tank feed to fire suppression system have been insulated by plumber. EQ sump and effluent sump inversion could not be completed due to exteme weather condition
		WTP	I/O test	
		WTP	Start-up UV units, Test	
		WTP	pH/Cl probe wiring connection	
		WTP	Give instruction to the plumber to fix the 2" broken PVC flange	
		WTP	Smoke detector batteries replacement	
3/5/2017	6:00am to 17:30pm		3td day on site	
		STP	EQ sump and effluent sump inversion completed by plumbers	
		STP	EQ pumps electrical connection completed by electriciens	
		WTP	Test the control between raw water lift station and WTP	
		WTP	Fix LT-10060 raw water level transmitter issue.	
3/6/2017	6:00am to 17:30pm		4th day on site	H2OI might have to start commissioning on STP, depending on how long it takes to solve the issues on the WTP raw water lift station.
		WTP	Raw water lift pumps start-up. No water came in the WTP.	
		STP	Troubleshooting remote emergency stop button electrical interconnection	
			Pick up Alexis M. at his arrival at 13:30	
		STP/WTP	Discuss about the next incoming days planning since raw water feed is not available on WTP.	
	1 hour		Camp orientation	

Day	Time (from-to)		Work description	Comments/Delays
3/7/2017	6:00am to 17:30pm		5th day on site	Some progress have been achieve on STP commissioning since WTP commissioning is delayed due to raw water lift pumps issue
		STP/WTP	7:30am meeting with agnico eagle. It have been determine that agnico eagle will witness some pre operational tests before starting up the systems.	
		STP	Replace 2 faulty pressure gages.	
		STP	Connect the 3 pH probes and the O2 sensor the transmitter.	
		STP/WTP	Verify VFD motor parameters	
		STP	Verify system parameters	
		STP	O/I test	
3/8/2017	no site		6th day on site	Blizzard red code all day
		STP/WTP	Double checking documentation in order to validate system determined set-point/adjustment	
3/9/2017			7th day on site	
		STP/WTP	Double checking the STP/WTP documentation in order to validate system determined set-point/adjustment.	Blizzard red code all day
3/10/2017	10:00am to 17:30		8th day on site	Blizzard red code, access to site at 10:00am
	1 heure	STP/WTP	Put together the OIT list for STP/WTP	
	2 heures	STP	H2S/CH2 gas detector installation	
3/11/2017	6:00 to 17:30		9th day on site	
	5 hours	STP	H2S/CH2 gas detector installation	
	1 hour	STP/WTP	13:30pm meeting with Agnico-Eagle	
	1 heure	STP/WTP	Solving Wi-Fi connection with the laptop supplied with the system (Programming laptop)	
3/12/2017	6:00 to 17:30		10th day on site	
	5 hours	STP	H2S/CH2 gas detector installation	
	1 hour	STP/WTP	14:00 meeting with Agnico-Eagle	
3/13/2017	6:00am to 17:30pm		11th day on site	
	30 minutes	STP/WTP	13:00 weekly conference call with Agnico-Eagle	
	3 heures	WTP	Solving UV intensity signal issue	
3/14/2017	6:00am to 17:30pm		12th day on site	
	2 heures	STP	Gas detector programming integration and test	
	2 heures	STP/WTP	Install 3 air dampers. WTP container#1 air damper not accessible with a ladder.	

Day	Time (from-to)		Work description	Comments/Delays
3/15/2017	6:00am to 17:30pm		13th day on site	Raw water lift station is operational and provide water to WTP from 10:00am. Non-potable water is ready to supply camp network, and STP Equalisation reservoir T-19000A by the end of the day
	5 heures	WTP	WTP start-up	
	2 hours 30 minutes	STP	Meeting with Agnico to coordinate STP commissioning	
3/16/2017	6:00am to 17:30pm		14th day on site	
	1 hour	STP	Meeting with Agnico to coordinate STP commissioning	
	2 heures	STP	Put on paper the coordination details discussed during previous meetings. Sent to H2OI engineering for approval.	
	1 heure	WTP	Put together an WTP operational testing check sheet under Agnico Eagle request	
	1 heure	WTP	Dosing pump clear water test/drawndown	
	30 minutes	WTP	pH and turbidity probe calibration	
3/17/2017	10:30am to 17:30		15th day on site	
	30 minutes	WTP	Agnico-Eagle operator training	
		WTP	Monitoring WTP distribution pump fixed speed operation to allow low pressure and smooth distribution network filling/venting	
		WTP	Verification while distribution network is pressurized	
3/18/2017	6:00am to 17:30pm		16th day on site	Camp sewage lift station not available to fill STP reservoir
	1 heure	WTP	Distribution pump automatic operation fine tuning	
3/19/2017	6:00am to 17:30pm		17th day on site	Start filling up STP equalisation reservoir T_19000B when bottom tie in for auxiliary water warm up system is ready at 9:00am
		STP	Outdoor reservoir T-19000A/B, T-72000 level sensor insolation	
		STP	Trottlng T-19000A top blower valve to equilibrate the air supply to both equalization tank	
3/20/2017	6:00am to 17:30pm		18th day on site	Blizzard red code, Billy T. move into new camp in construction to keep working during blizzard
		STP	Filling up Aerobic tank T-72000	
		STP	Testing EQ pumps, screen filter, sump pumps automation while filling up Aerobic tank	

Day	Time (from-to)		Work description	Comments/Delays
3/21/2017	6:00am to 17:30pm		19th day on site	Realise there is metal chips on the sump tank. Raise the flag that the Aerobic tank to membrane tank 6" pipe should have been cleaned from contruction debris. No progress can be done during the cleaning because this pipe was needed to progress on the operation testing. WTP raw water pump quit working during the day, and cause WTP shut down.
	5h	STP	Working with plumber to clean the 6 inch pipe from metal chips	
	2h	STP	Working with plumber to fix the 2 inch valve FV-74050-2 leak	Loosened during transportation. Have to drain a part of Aeration tank to fix the leak.
		STP	Filling Membrane tanks	
		STP	Test recirculation	
3/22/2017	6:00am to 17:30pm		20th day on site	Plumber installed 3X arctic vent
		STP	Clear water operational test membrane train 1 and 2. (permeation cycle)	
3/23/2017	6:00am to 17:30pm		21th day on site	
		STP	Clear water operational test membrane train 1 and 2. (CEB cycle, sludge wasting cycle)	
3/24/2017	6:00am to 17:30pm		22th day on site	Emptied Equalisation tank B by 12:00pm. EQ tankA filling valve frozen so no sewage was introduce, and no water was drained from Aerobic tank.
		STP	Finalize clear water test	

Appendix B: Process Flow Schematics

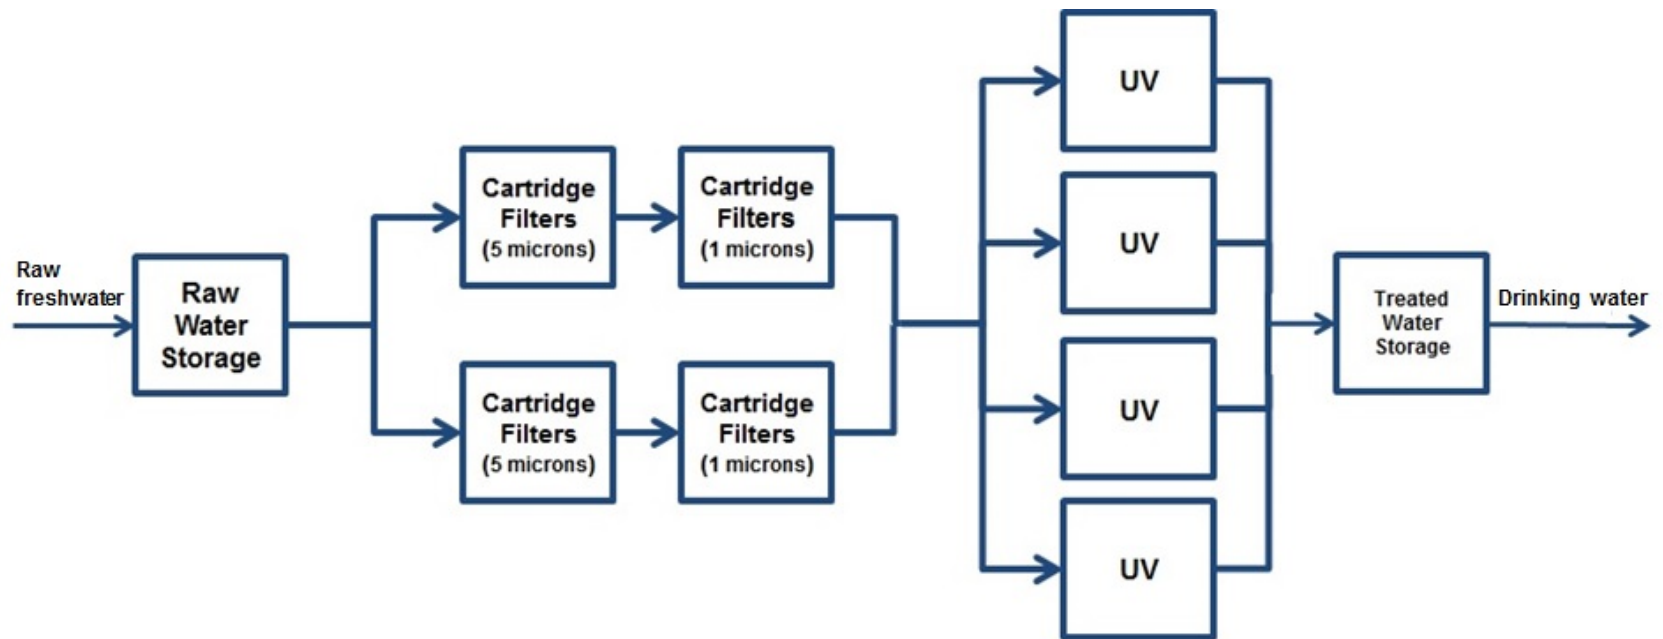


Figure 2: Process Flow Schematics

Appendix C: Summary of analysis result of water quality test



Certificate # : RNM100431

Client #: 1311

Client Reference : N/A

CERTIFICATE OF ANALYSIS

Agnico Eagle Meliadine
Meliadine
Rankin Inlet
Nunavut X0C 0A0
N° téléphone : (867) 645-2990

Sample # : RNM200453
Matrix : Drinking Water
Received on : 2017-04-04
Sampled on : 2017-04-03 5:47
Sample's conditions at reception : Conforme (10.0°C)
Sampling site : DW-Kitchen
Sampler : JM/CP

Parameter (method)	Result	Unit	Norm/ Recommendation	Date of analysis
B.H.A.A. (M-BHAA-1,0) a 1	0	UFC/mL		2017-04-05
Total coliforms (M-COLI-4.0) a 1	0	UFC/100 mL	≤ 10 (N)	2017-04-05
Atypical colonies (M-COLI-4.0) a 1	0	UFC/100 mL	≤ 200 (N)	2017-04-05
Escherichia coli (M-COLI-4.0) a 1	0	UFC/100 mL	0 (N)	2017-04-05

Legend :

a : Paramètre(s) accrédité(s) (N) : Norme (R) : Recommandation UFC : Unités formatrices des colonies 1 : analyse effectuée au laboratoire H2Lab à Rouyn-Noranda

Reference :

(N): c.Q-2, r-40, annexe 1 (RQEP)

(R): Recommandations pour la qualité de l'eau potable au Canada, Santé Canada

The sample's appreciation and conformity towards established norms, if applicable, is based and limited to analyzed parameters. This report can't be reproduced, unless in whole, without prior written authorization from the laboratory. The results are related only to samples submitted for testing.

Certificate emission date: 2017-04-07

Page 1 of 1



Certificate # : RNM100432

Client #: 1311

Client Reference : N/A

CERTIFICATE OF ANALYSIS

Agnico Eagle Meliadine
Meliadine
Rankin Inlet
Nunavut X0C 0A0
N° téléphone : (867) 645-2990

Sample # : RNM200454
Matrix : Drinking Water
Received on : 2017-04-04
Sampled on : 2017-04-03
Sample's conditions at reception : Conforme (9.5°C)
Sampling site : DW-Wing 3
Sampler : JM/CP

Parameter (method)	Result	Unit	Norm/ Recommendation	Date of analysis
B.H.A.A. (M-BHAA-1,0) a 1	0	UFC/mL		2017-04-05
Total coliforms (M-COLI-4.0) a 1	0	UFC/100 mL	≤ 10 (N)	2017-04-05
Atypical colonies (M-COLI-4.0) a 1	0	UFC/100 mL	≤ 200 (N)	2017-04-05
Escherichia coli (M-COLI-4.0) a 1	0	UFC/100 mL	0 (N)	2017-04-05

Legend :

a : Paramètre(s) accrédité(s) (N) : Norme (R) : Recommandation UFC : Unités formatrices des colonies 1 : analyse effectuée au laboratoire H2Lab à Rouyn-Noranda

Reference :

(N): c.Q-2, r-40, annexe 1 (RQEP)

(R): Recommandations pour la qualité de l'eau potable au Canada, Santé Canada

The sample's appreciation and conformity towards established norms, if applicable, is based and limited to analyzed parameters. This report can't be reproduced, unless in whole, without prior written authorization from the laboratory. The results are related only to samples submitted for testing.

Certificate emission date: 2017-04-07

Page 1 of 1



Certificate # : RNM100433

Client #: 1311

Client Reference : N/A

CERTIFICATE OF ANALYSIS

Agnico Eagle Meliadine
Meliadine
Rankin Inlet
Nunavut X0C 0A0
N° téléphone : (867) 645-2990

Sample # : RNM200455
Matrix : Drinking Water
Received on : 2017-04-04
Sampled on : 2017-04-03 6:0
Sample's conditions at reception : Conforme (11.0°C)
Sampling site : DW-Kitchen 2
Sampler : JM/CP

Parameter (method)	Result	Unit	Norm/ Recommendation	Date of analysis
B.H.A.A. (M-BHAA-1,0) a 1	0	UFC/mL		2017-04-05
Total coliforms (M-COLI-4.0) a 1	0	UFC/100 mL	≤ 10 (N)	2017-04-05
Atypical colonies (M-COLI-4.0) a 1	0	UFC/100 mL	≤ 200 (N)	2017-04-05
Escherichia coli (M-COLI-4.0) a 1	0	UFC/100 mL	0 (N)	2017-04-05

Legend :

a : Paramètre(s) accrédité(s) (N) : Norme (R) : Recommandation UFC : Unités formatrices des colonies 1 : analyse effectuée au laboratoire H2Lab à Rouyn-Noranda

Reference :

(N): c.Q-2, r-40, annexe 1 (RQEP)

(R): Recommandations pour la qualité de l'eau potable au Canada, Santé Canada

The sample's appreciation and conformity towards established norms, if applicable, is based and limited to analyzed parameters. This report can't be reproduced, unless in whole, without prior written authorization from the laboratory. The results are related only to samples submitted for testing.

Certificate emission date: 2017-04-07

Page 1 of 1



Certificate # : RNM100434

Client #: 1311

Client Reference : N/A

CERTIFICATE OF ANALYSIS

Agnico Eagle Meliadine
Meliadine
Rankin Inlet
Nunavut X0C 0A0
N° téléphone : (867) 645-2990

Sample # : RNM200456
Matrix : Drinking Water
Received on : 2017-04-04
Sampled on : 2017-04-03 6:5
Sample's conditions at reception : Conforme
Sampling site : DW-H2O WTP
Sampler : JM/CP

Parameter (method)	Result	Unit	Norm/ Recommendation	Date of analysis
B.H.A.A. (M-BHAA-1,0) a 1	0	UFC/mL		2017-04-05
Total coliforms (M-COLI-4.0) a 1	0	UFC/100 mL	≤ 10 (N)	2017-04-05
Atypical colonies (M-COLI-4.0) a 1	0	UFC/100 mL	≤ 200 (N)	2017-04-05
Escherichia coli (M-COLI-4.0) a 1	0	UFC/100 mL	0 (N)	2017-04-05

Legend :

a : Paramètre(s) accrédité(s) (N) : Norme (R) : Recommandation UFC : Unités formatrices des colonies 1 : analyse effectuée au laboratoire H2Lab à Rouyn-Noranda

Reference :

(N): c.Q-2, r-40, annexe 1 (RQEP)


(R): Recommandations pour la qualité de l'eau potable au Canada, Santé Canada


The sample's appreciation and conformity towards established norms, if applicable, is based and limited to analyzed parameters. This report can't be reproduced, unless in whole, without prior written authorization from the laboratory. The results are related only to samples submitted for testing.


Certificate emission date: 2017-04-07

Page 1 of 1

Appendix D: Freshwater Treatment Plant as-Built Drawing

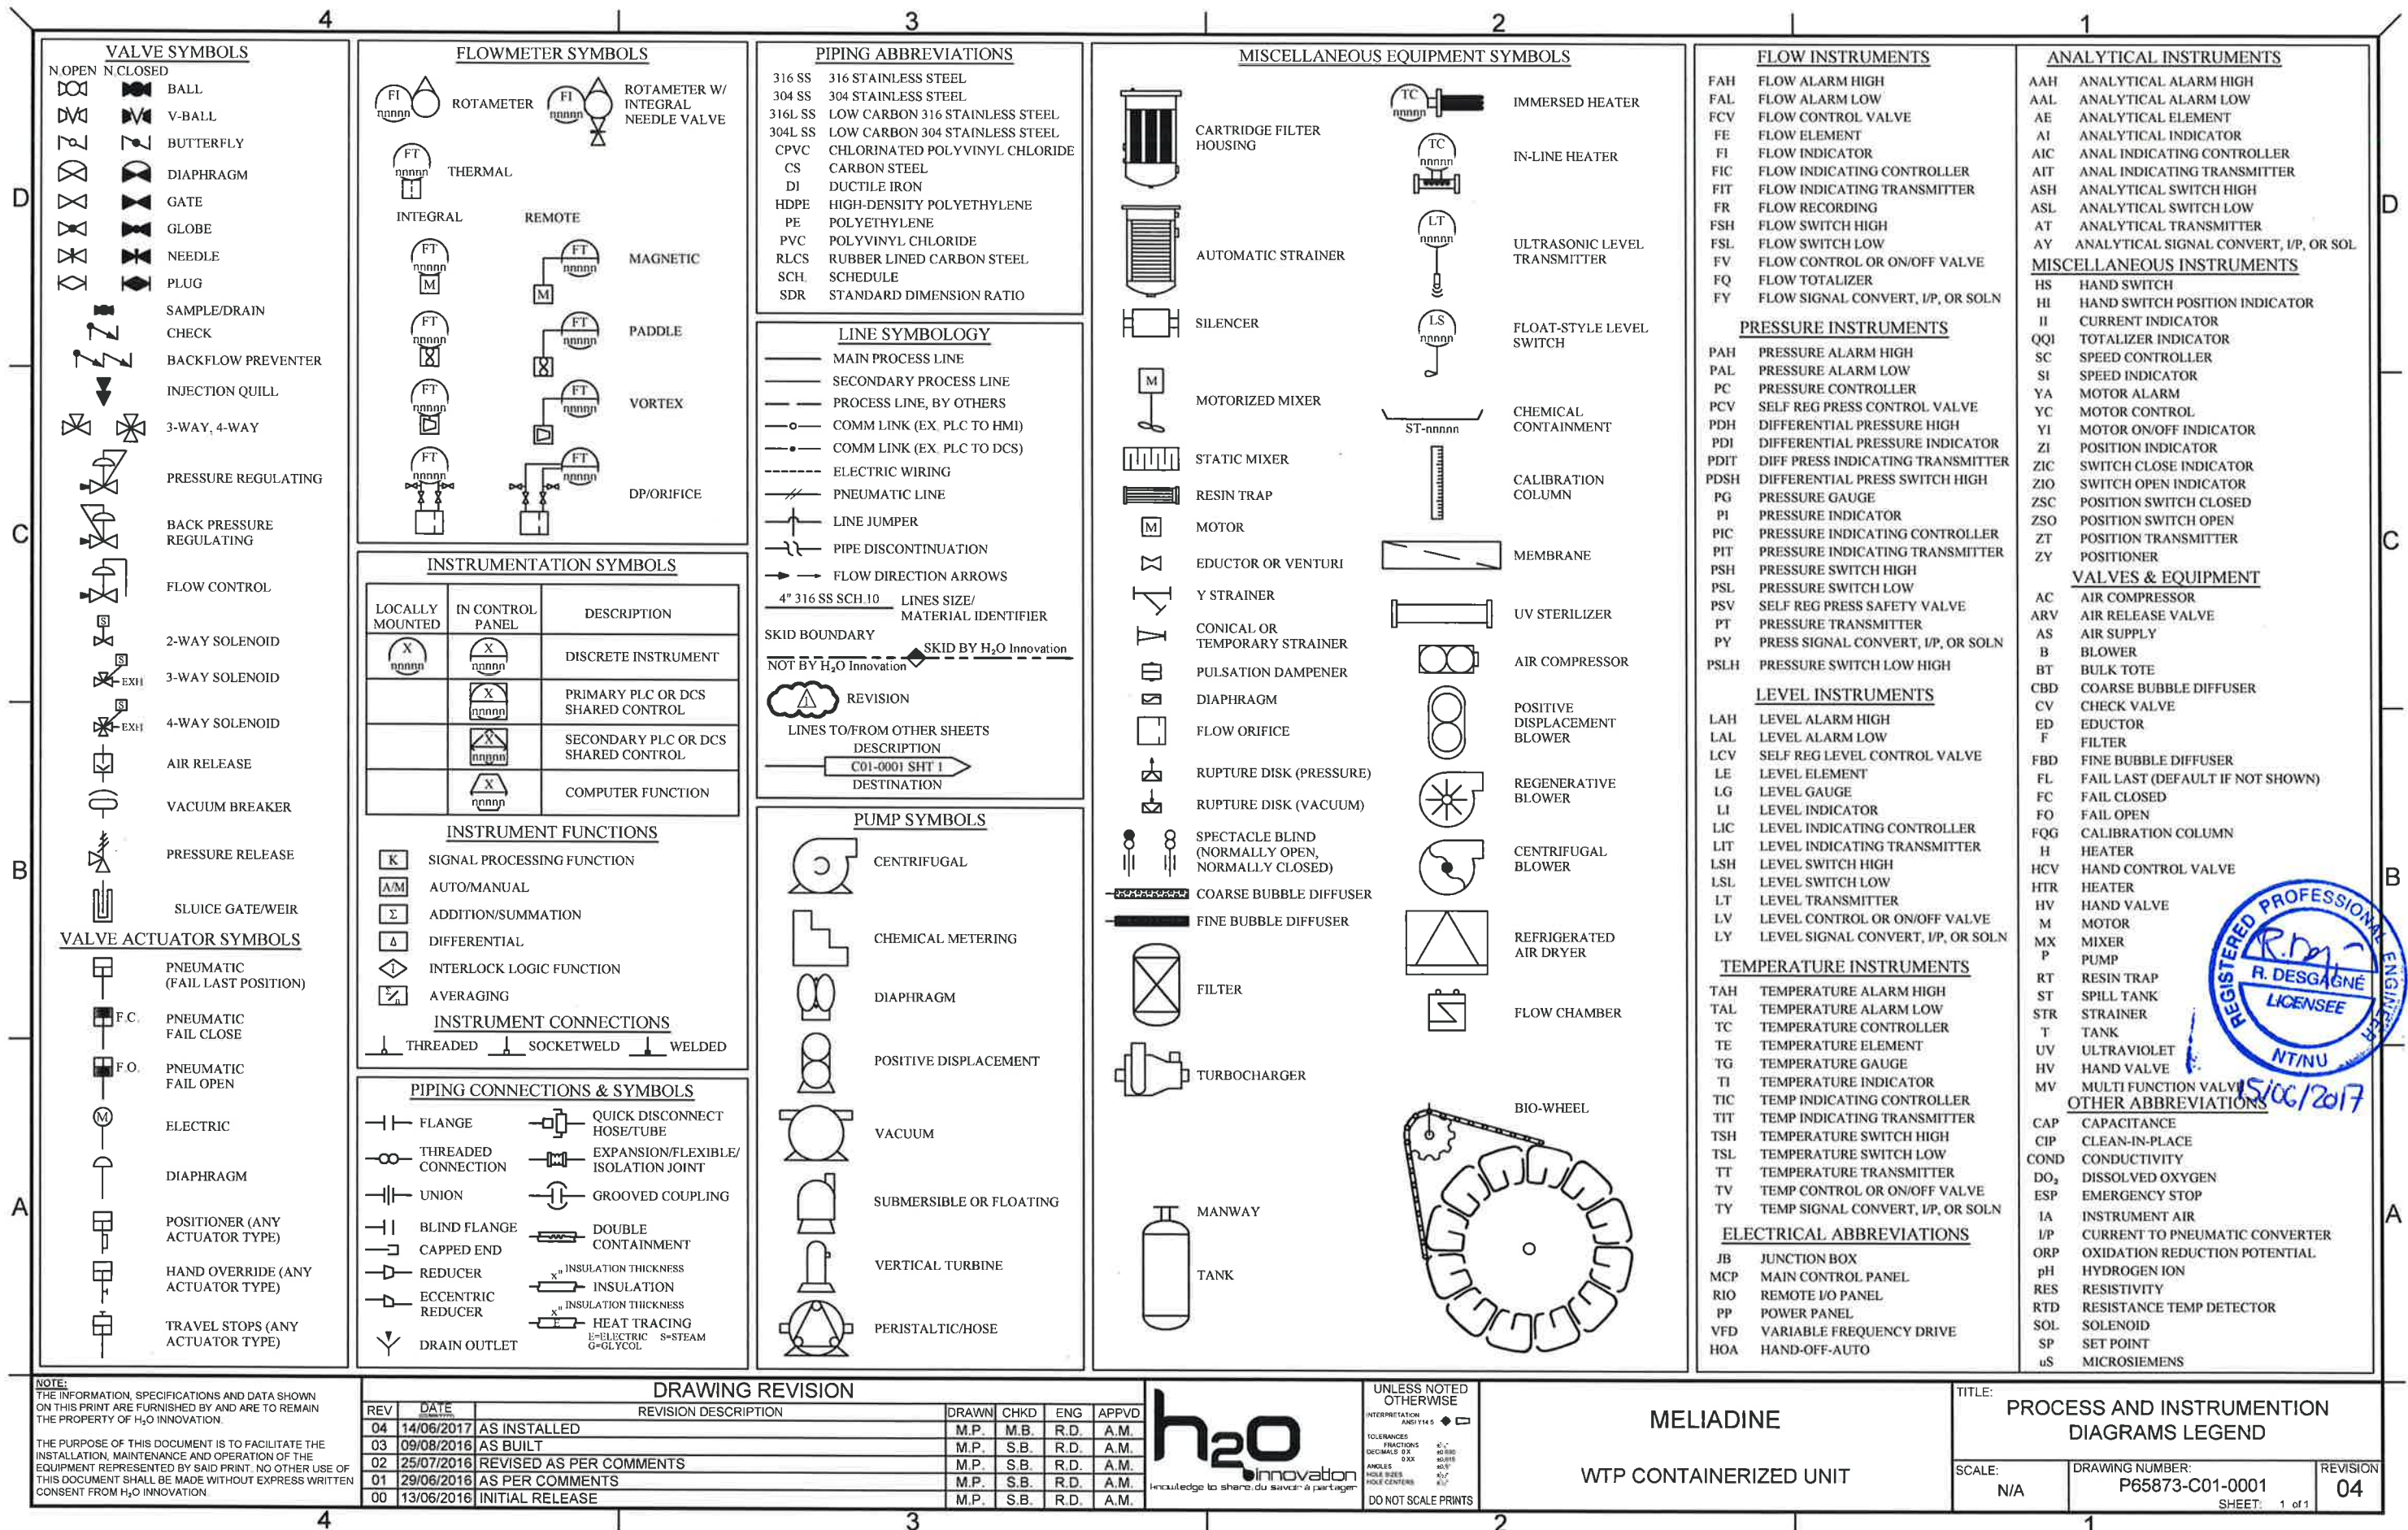

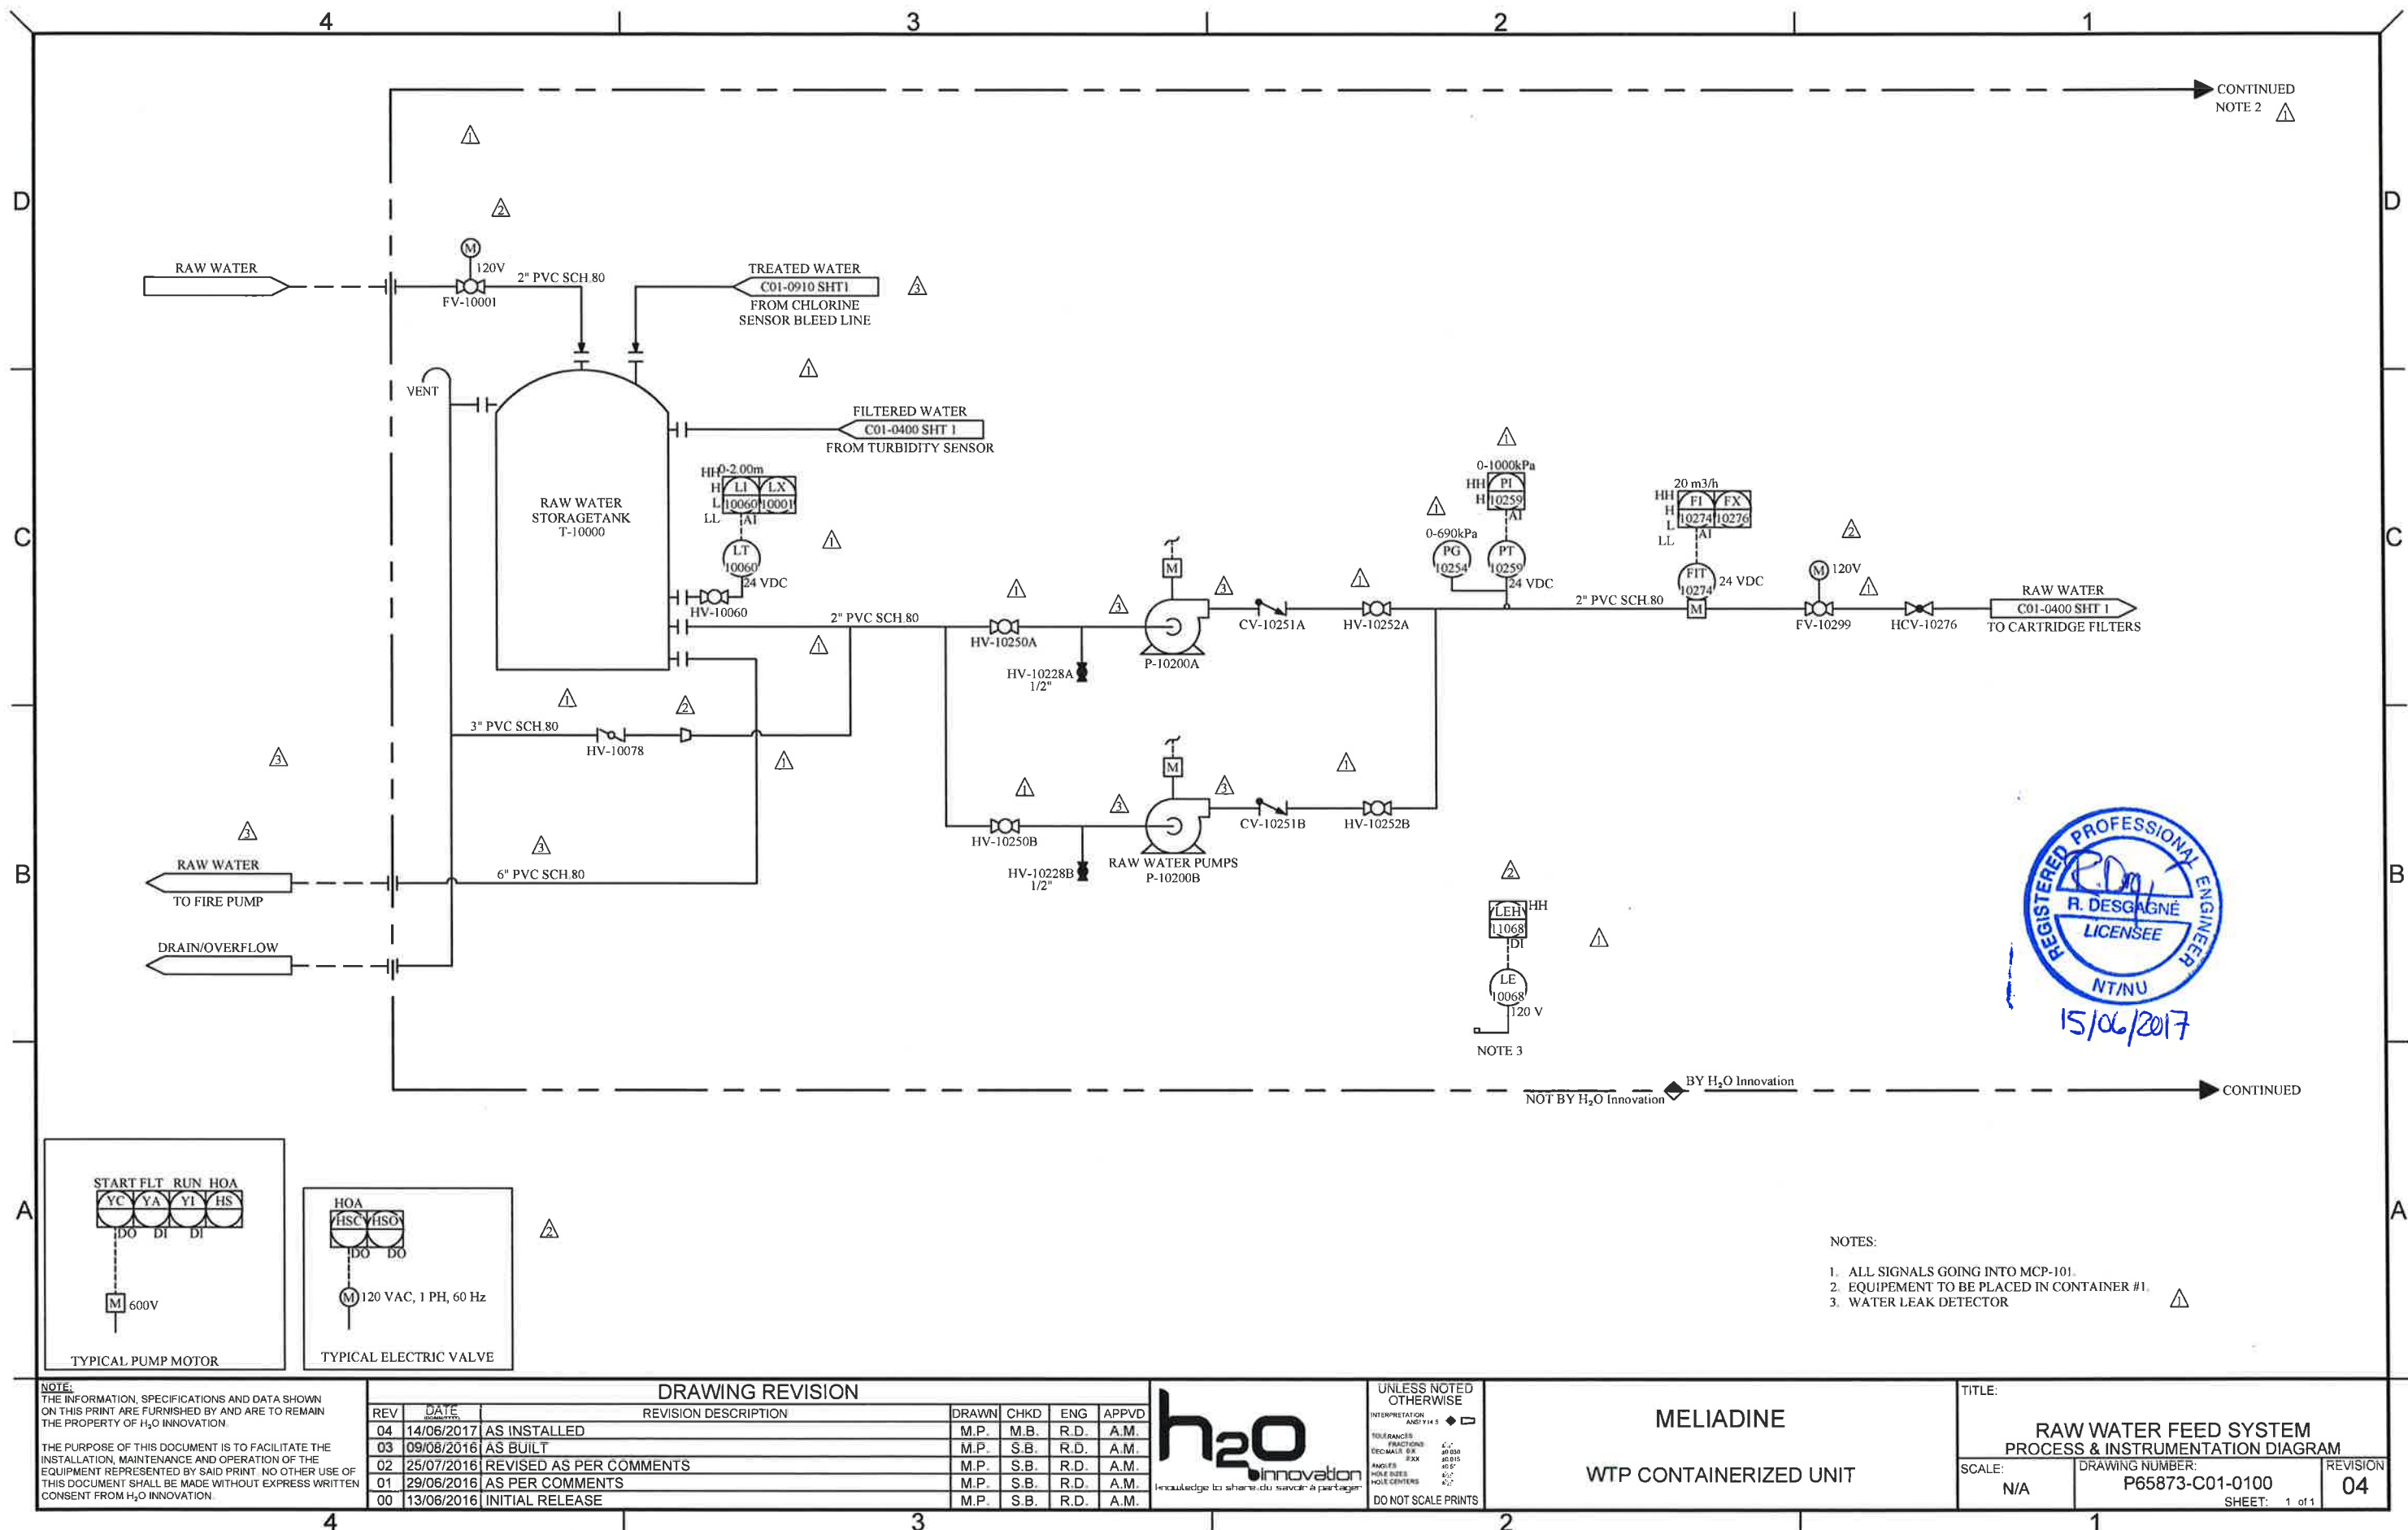

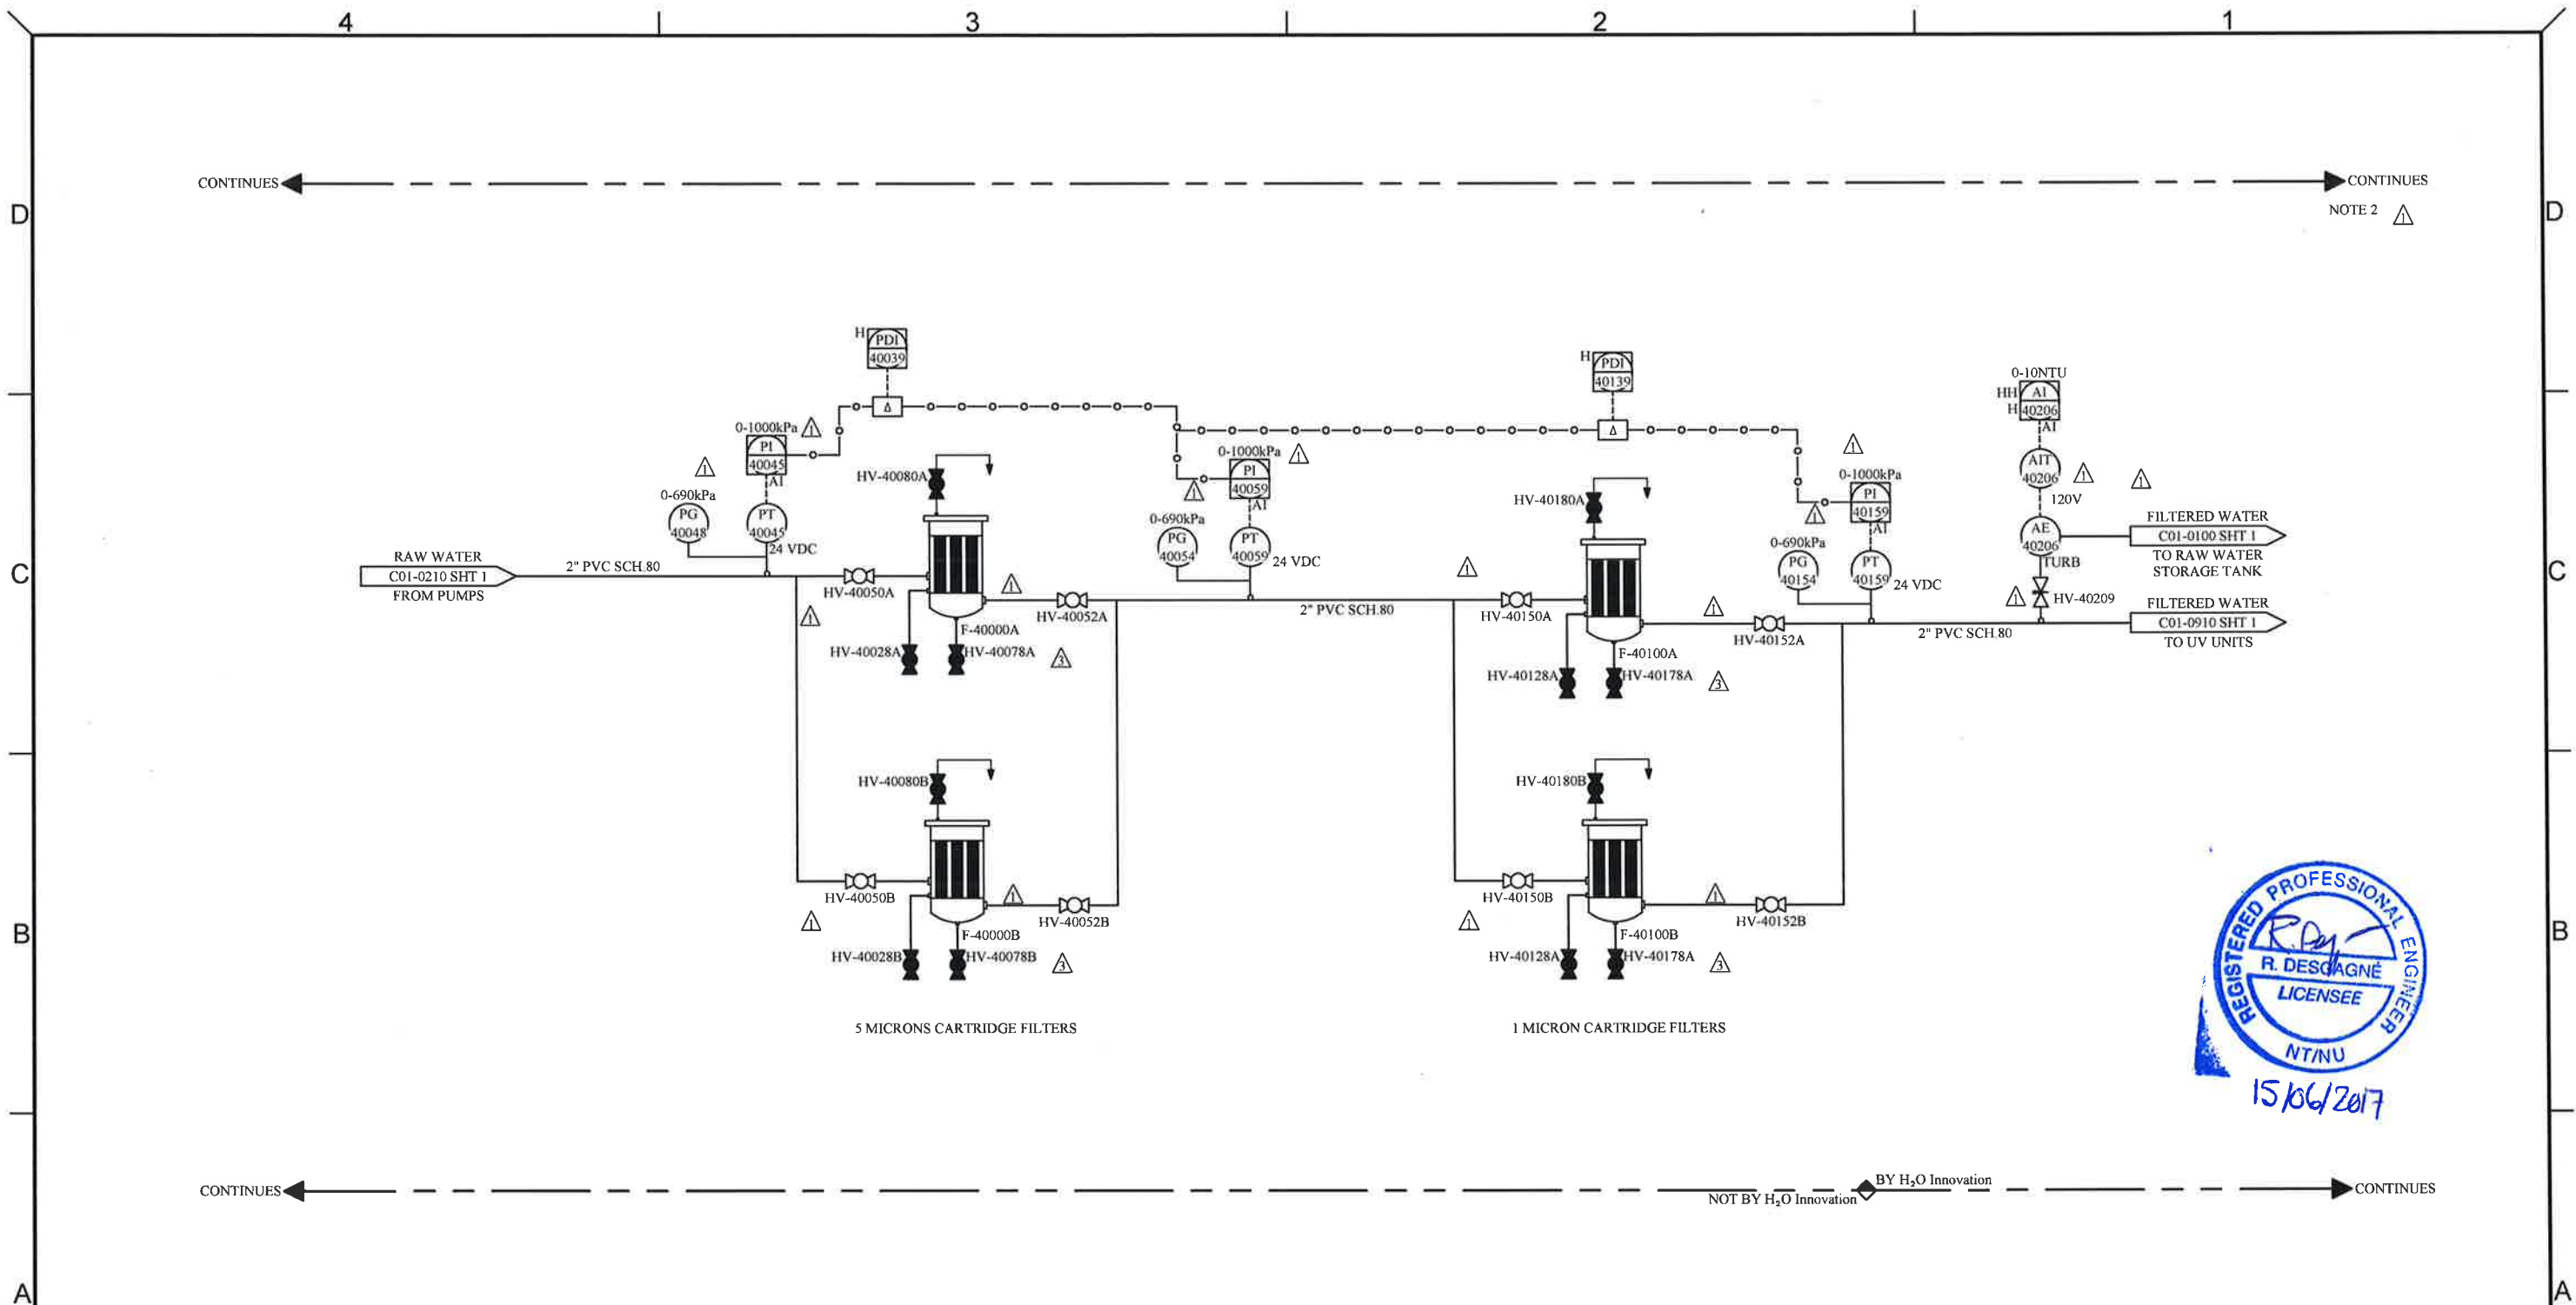

NOTES:

1. ALL SIGNALS GOING INTO MCP-101.
2. EQUIPEMENT TO BE PLACED IN CONTAINER #1.

NOTE:
THE INFORMATION, SPECIFICATIONS AND DATA SHOWN ON THIS PRINT ARE FURNISHED BY AND ARE TO REMAIN THE PROPERTY OF H₂O INNOVATION.

THE PURPOSE OF THIS DOCUMENT IS TO FACILITATE THE INSTALLATION, MAINTENANCE AND OPERATION OF THE EQUIPMENT REPRESENTED BY SAID PRINT. NO OTHER USE OF THIS DOCUMENT SHALL BE MADE WITHOUT EXPRESS WRITTEN CONSENT FROM H₂O INNOVATION.

DRAWING REVISION				DRAWN	CHKD	ENG	APPVD
REV	DATE	REVISION DESCRIPTION					
04	14/06/2017	AS INSTALLED		M.P.	M.B.	R.D.	A.M.
03	09/08/2016	AS BUILT		M.P.	S.B.	R.D.	A.M.
02	25/07/2016	REVISED AS PER COMMENTS		M.P.	S.B.	R.D.	A.M.
01	29/06/2016	AS PER COMMENTS		M.P.	S.B.	R.D.	A.M.
00	13/06/2016	INITIAL RELEASE		M.P.	S.B.	R.D.	A.M.





UNLESS NOTED OTHERWISE
INTERPRETATION
AND Y14 S

TOLERANCES
FRACTIONS
DECIMALS
ANGLES
HOLE SIZES
HOLE CENTERS

DO NOT SCALE PRINTS

MELIADINE
WTP CONTAINERIZED UNIT

TITLE:		
CARTRIDGE FILTERS PROCESS & INSTRUMENTATION DIAGRAM		
SCALE: N/A	DRAWING NUMBER: P65873-C01-0400	REVISION 04
SHEET: 1 of 1		

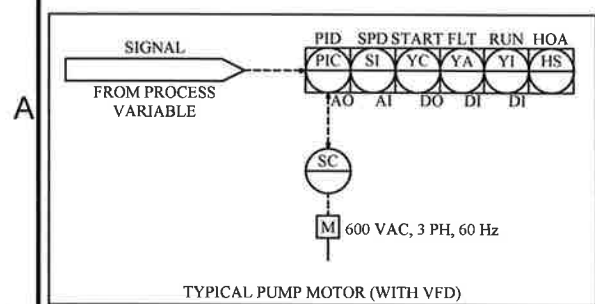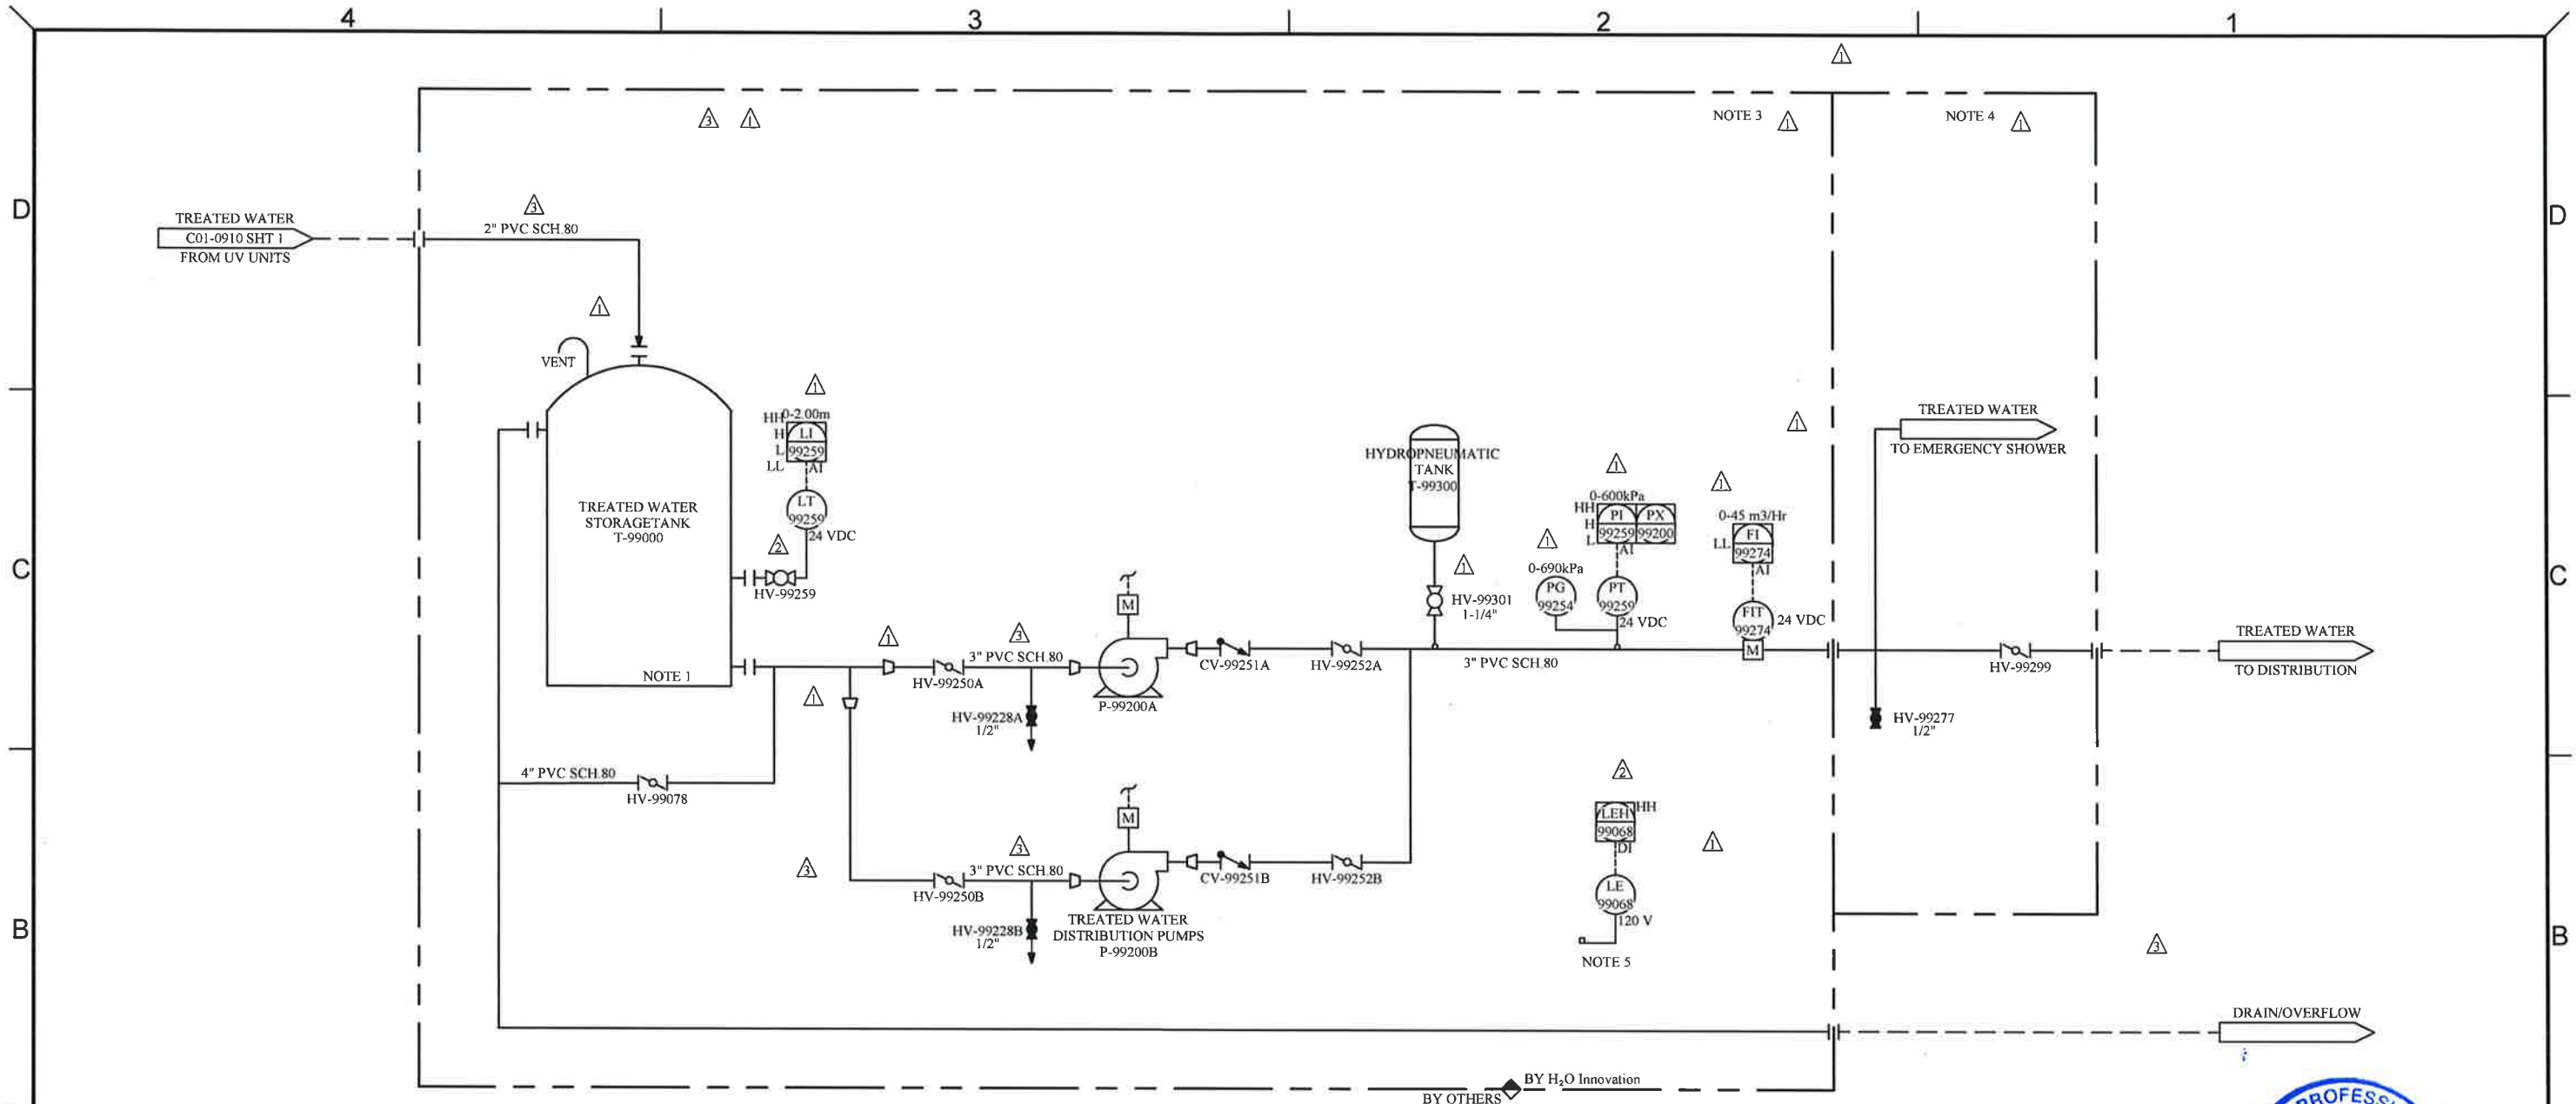

- NOTES:
- 5 TANKS IN SERIES LINKED TOGETHER
 - ALL SIGNALS GOING INTO MCP-101.
 - EQUIPMENT TO BE PLACED IN CONTAINER #2.
 - EQUIPMENT TO BE PLACED IN CONTAINER #1.
 - WATER LEAK DETECTOR



NOTE:
THE INFORMATION, SPECIFICATIONS AND DATA SHOWN ON THIS PRINT ARE FURNISHED BY AND ARE TO REMAIN THE PROPERTY OF H₂O INNOVATION.

THE PURPOSE OF THIS DOCUMENT IS TO FACILITATE THE INSTALLATION, MAINTENANCE AND OPERATION OF THE EQUIPMENT REPRESENTED BY SAID PRINT. NO OTHER USE OF THIS DOCUMENT SHALL BE MADE WITHOUT EXPRESS WRITTEN CONSENT FROM H₂O INNOVATION.

REV	DATE	REVISION DESCRIPTION	DRAWN	CHKD	ENG	APPVD
04	14/06/2017	AS INSTALLED	M.P.	M.B.	R.D.	A.M.
03	09/08/2016	AS BUILT	M.P.	S.B.	R.D.	A.M.
02	25/07/2016	REVISED AS PER COMMENTS	M.P.	S.B.	R.D.	A.M.
01	29/06/2016	AS PER COMMENTS	M.P.	S.B.	R.D.	A.M.
00	13/06/2016	INITIAL RELEASE	M.P.	S.B.	R.D.	A.M.



UNLESS NOTED OTHERWISE
INTERPRETATION
ANSI Y14.5

TOLERANCES
FRACTIONS
DECIMALS
ANGLES
HOLE SIZES
HOLE CENTERS

DO NOT SCALE PRINTS

MELIADINE
WTP CONTAINERIZED UNIT

TITLE: TREATED WATER DISTRIBUTION SYSTEM PROCESS & INSTRUMENTATION DIAGRAM		
SCALE: N/A	DRAWING NUMBER: P65873-C01-0990	REVISION 04
SHEET: 1 of 1		

Appendix E: Freshwater Treatment Plant Photographs




Photos of the outside view of the Freshwater Treatment Plant



Photos of the Fresh water treatment system (Cartridge filters treatment and Chemical Treatment)



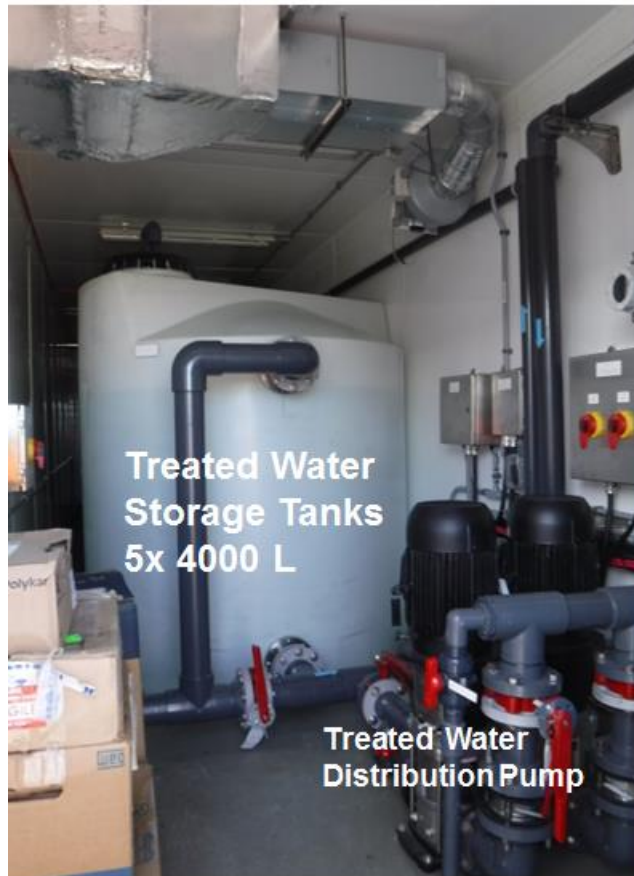

Photos of the Treated Water Storage and distribution Pump