

INTERIM REPORT

# CONSTRUCTION SUMMARY (AS-BUILT) REPORT FOR RANKIN INLET ITIVIA SITE FUEL STORAGE AND CONTAINMENT FACILITIES – COMMISSIONING AND OPERATION OF TANK #2 MELIADINE PROJECT, NUNAVUT



PRESENTED TO  
**Agnico Eagle Mines Ltd.**

MARCH 2018  
ISSUED FOR USE\_R1  
MELIADINE PROJECT, NU | TETRA TECH PROJECT NUMBER: 28920  
AGNICO EAGLE DOCUMENT NUMBER: 6515-E-132-005-132-REP-015

## EXECUTIVE SUMMARY

Tetra Tech was retained by Agnico Eagle Mines Limited (Agnico Eagle) to prepare a construction summary (as-built) report for the Rankin Inlet Itivia Site Fuel Storage and Containment Facilities at the Meliadine Gold Project, Nunavut. Tetra Tech and WSP Canada Inc. previously prepared the construction drawings and specifications as well as the design report for the Fuel Storage and Containment Facilities for the Project (AEM No 6515-E-132-004-132-REP-003). The facilities includes two (2) main fuel storage tanks located at Rankin Inlet Itivia site and four (4) fuel storage tanks located at the Meliadine site.

This interim as-built report summarizes the work executed at Rankin Inlet Itivia Site Fuel Storage and Containment Facilities where the field erected fuel storage Tank #2 (13.5 ML) was completed and commissioned and Tank #1 (20 ML) was started. Completion and commissioning will be done in 2018 as initially planned in the design report.

Tetra Tech was not involved in the construction of the Fuel Farm Facilities. The information presented in this report was provided by Agnico Eagle.

The construction monitoring and quality assurance was managed by Agnico Eagle.

<b>1.0</b>	<b>INTRODUCTION .....</b>	<b>1</b>
<b>2.0</b>	<b>SUMMARY OF THE CONSTRUCTION .....</b>	<b>2</b>
2.1	Site Location Plan .....	2
2.2	Construction Schedule.....	3
2.3	As-built Drawings and Photographs .....	4
<b>3.0</b>	<b>CODES AND STANDARDS .....</b>	<b>5</b>
3.1	Compliance for Field Erected Fuel Tanks .....	5
3.2	Compliance for Secondary Containment.....	5
<b>4.0</b>	<b>FIELD DECISIONS FOR THE FIELD ERECTED FUEL TANK #2 AND SURROUNDING FACILITIES (STRUCTURAL, MECHANICAL, AND ELECTRICAL).....</b>	<b>6</b>
4.1	Documentation on Field Decisions that Deviate from Original Plans .....	6
4.1.1	Structural.....	7
4.1.2	Mechanical.....	7
4.1.3	Electrical .....	7
4.2	Maintenance, Inspection, Construction Monitoring, and Inspection Reports .....	8
<b>5.0</b>	<b>FIELD DECISIONS FOR THE SECONDARY CONTAINMENT FACILITY .....</b>	<b>10</b>
5.1	Documentation on Field Decisions that Deviate from Original Plans .....	10
5.1.1	Tank Foundation As-built.....	10
5.1.2	Dike and Secondary Containment.....	10
5.1.3	Distance Restrictions As-built.....	12
5.2	Commissioning, Inspection, Construction Monitoring, and Inspection Reports .....	12
<b>6.0</b>	<b>FIELD DECISIONS FOR THE RANKIN INLET ITIVIA CULVERT .....</b>	<b>13</b>
6.1	Documentation on Field Decisions that Deviate from Original Plans .....	13
<b>7.0</b>	<b>EARTH WORKS .....</b>	<b>13</b>
<b>8.0</b>	<b>LIMITATIONS OF REPORT.....</b>	<b>15</b>
<b>9.0</b>	<b>CLOSURE .....</b>	<b>15</b>

## APPENDICES

Appendix A	As-built Drawings of Rankin Inlet Itivia Site Fuel Storage and Containment Facilities
Appendix B	Survey Drawing of Rankin Inlet Itivia Site Fuel Storage and Containment Facilities
Appendix C	Survey Drawing of Rankin Inlet Itivia Culvert
Appendix D	Photographs of Rankin Inlet Itivia Site Fuel Storage and Containment Facilities
Appendix E	Photographs of Rankin Inlet Itivia Culvert
Appendix F	Construction Summary of Rankin Fuel Tank Farm and Laydown Area Structural
Appendix G	Construction Summary of Rankin Inlet Itivia Site Mechanical and Electrical Equipment
Appendix H	Inspection Report – Inspection Test Plan
Appendix I	Inspection Report – Handover Package for Tank #2
Appendix J	Inspection Report – Rankin Inlet Offsite and Onsite Fabrication
Appendix K	Inspection Report – Rankin Inlet Fuel Modules
Appendix L	Inspection Report – Non-Compliance Reports
Appendix M	Construction Summary of Rankin Inlet Itivia Site Fuel Storage and Containment Facilities
Appendix N	Particle Size Summary – 30 mm minus
Appendix O	Inspection Reports – Tank Farm Area Final Wall
Appendix P	Inspection Report – Blasting Operation
Appendix Q	Inspection Report – Quality Control Final Report for Geomembrane Installation
Appendix R	Particle Size Summary – 20 mm minus
Appendix S	Construction Summary of Rankin Inlet Itivia Laydown Area Culvert



## 1.0 INTRODUCTION

Agnico Eagle Mines Ltd. (Agnico Eagle) retained the services of Tetra Tech and WSP Canada Inc. to carry out the planning and design works associated with the surface infrastructures for the project, which includes the fuel storage and containment facilities at the Rankin Inlet Itivia site and Meliadine site. These components are part of the Meliadine Project, a gold mine located approximately 25 km north from Rankin Inlet, and 80 km southwest from Chesterfield Inlet in the Kivalliq Region of Nunavut.

Tetra Tech and WSP Canada Inc. previously prepared the design report and drawings for construction related to the Fuel Storage and Containment Facilities for the Project.

Tetra Tech was retained by Agnico Eagle to prepare a construction summary (as-built) report for the Rankin Inlet Itivia Site Fuel Storage and Containment Facilities as well as the Rankin Itivia Culvert.

The Rankin Inlet Itivia site is located in Rankin Inlet, on the shore of Melvin Bay (part of Hudson Bay), and around a UTM (NAD83, Zone 15) coordinate of 546,070E and 6,963,760N.

As required by the Water Licence A (No. 2AM-MEL1631), this report summarizes the construction work of the Rankin Inlet Itivia Site Fuel Storage and Containment Facilities. However, this is an interim report that summarizes the construction work of the secondary containment for the fuel farm, pumping station and ancillaries, and field erection and commissioning of Tank #2 at the Rankin Inlet Itivia site. The completion of the field erection work and commissioning for Tank #1 will be finalized in 2018. Included in this report is:


- A summary of the characteristics of the Rankin Inlet Itivia Site Fuel Storage and Containment Facilities;
- Documentation on field decisions that deviate from original plans and non-conformance / corrective action reports;
- As-built drawings;
- Survey drawings conducted during and after the construction of the Rankin Inlet Itivia Site Fuel Storage and Containment Facilities and Rankin Inlet Itivia Culvert;
- Photographs of the Rankin Inlet Itivia Site Fuel Storage and Containment Facilities and Rankin Itivia Culvert;
- Inspection Reports for the Inspection Test Plan (ITP), and Handover Package of Tank #2;
- Inspection Reports and Quality Control Documents for the Offsite and Onsite Fabrication and the Fuel Modules;
- Inspection Reports for the Tank Farm Area Final Wall, Blasting Operations, Quality Control for Geomembrane Installation;
- Particle Size Summary of 30 mm minus and 20 mm minus material;

## 2.0 SUMMARY OF THE CONSTRUCTION

### 2.1 Site Location Plan

The figure below presents the site location plan for the Rankin Inlet Itivia Site Fuel Storage and Containment Facilities, pumping station, and Rankin Inlet Itivia Culvert. Tank #2 (13.5 ML) was erected, commissioned, and is now operating while Tank #1 (20 ML) will be completed in 2018. The Rankin Itivia Culvert was installed at the southwestern portion of the laydown area where the laydown connects with the existing road.

Figure 2.1: Rankin Inlet Itivia Site Location Plan

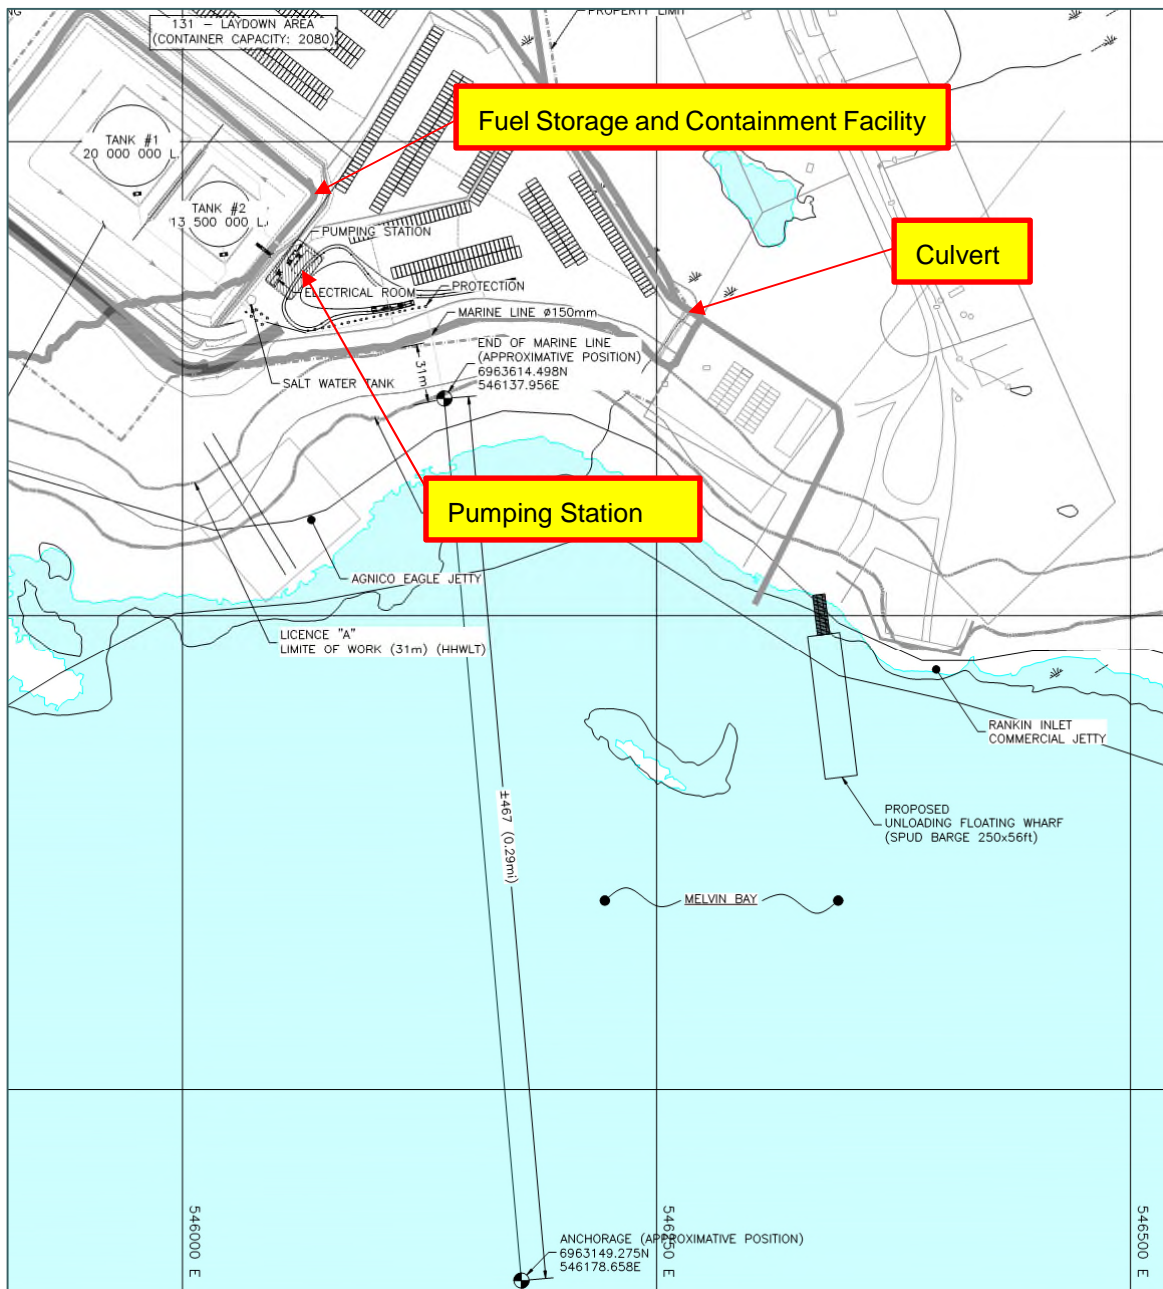

## 2.2 Construction Schedule

Construction activities at the Rankin Inlet Itivia Site Fuel Storage and Containment Facilities were conducted between March and October 2017. As shown in Picture 1 (below) taken during the construction period, both tanks were being erected but only Tank #2 was completed for service as planned. Picture 2 (below) shows the containers for the pumping and electrical stations. Construction was completed according to the milestone dates shown in Table 2.1.

**Picture 1: Construction of Rankin Inlet Itivia Site Fuel Storage and Containment Facilities**  
(Tank #1 is in the foreground and Tank #2 is in the background)



**Picture 2: Pumping and Electrical Station Containers**



**Table 2.1: Rankin Inlet Itivia Site Construction Milestone Dates**

Item	Date
Site Preparation	April 25 <sup>th</sup> to May 2 <sup>nd</sup>
Drill/Blast	April 27 <sup>th</sup> to June 6 <sup>th</sup>
Excavation	May 1 <sup>st</sup> to June 25 <sup>th</sup>
Rock Face Scaling	June 19 <sup>th</sup> to 22 <sup>nd</sup>
Overburden Pushback and Protection Berm	July 15 <sup>th</sup> to August 1 <sup>st</sup>
Under Liner Material Placement	June 10 <sup>th</sup> to September 26 <sup>th</sup>
Containment Berm	June 24 <sup>th</sup> to September 26 <sup>th</sup>
Liner System Installation	July 14 <sup>th</sup> to October 6 <sup>th</sup>
Tank Erection	July 29 <sup>th</sup> to September 8 <sup>th</sup>
Overliner Material Placement	July 16 <sup>th</sup> to October 9 <sup>th</sup>
Marine Pipeline Installation	August 17 <sup>th</sup> to October 14 <sup>th</sup>
Miscellaneous Steel Elements to Pumping Station	September 2 <sup>nd</sup> to October 14 <sup>th</sup>
Rankin Inlet Facility Testing	September 2 <sup>nd</sup> to October 14 <sup>th</sup>
Commissioning of Tank #2	October 17 <sup>th</sup>
Piping Interrelated to Pumping Station	September 16 <sup>th</sup> to October 21 <sup>st</sup>
Electrical Construction	September 16 <sup>th</sup> to October 21 <sup>st</sup>
System Operational for Tank #2	October 21 <sup>st</sup>

## 2.3 As-built Drawings and Photographs

As-built drawings are presented in Appendix A.

Survey drawings conducted during and after the construction of the Rankin Inlet Itivia Site Fuel Storage and Containment Facilities and Rankin Itivia Culvert can be found in Appendixes B and C, respectively.

Photographs of the Rankin Inlet Itivia Site Fuel Storage and Containment Facilities and Rankin Inlet Itivia Culvert during construction are shown in Appendixes D and E, respectively.

## 3.0 CODES AND STANDARDS

### 3.1 Compliance for Field Erected Fuel Tanks

The system for Tank #2 complies with codes and standards related to the project (Federal, Territorial, Municipal, NBCC, NFCC, CEC, CSA, NFPA, and API) as well as the directives of the authorities having jurisdiction over the project, including specific codes such as R-125-95 NWT, Mine Health and Safety Act, and RRMWT 1990, C F-12 Fire Prevention Regulations. See Table 3.1 below.

**Table 3.1: Rankin Inlet Itivia Site Field Erected Fuel Tanks As-built**

Fuel Farm Description	Rankin Inlet Itivia Site Field Erected Fuel Tanks	
	Tank #1	Tank #2
Comply with CCME	-	Yes
Equipped with Overfill Protection	-	Yes
Underground Piping Double Wall	-	No*
Underground Piping Installed to Collect Leak into an Accessible Sump	-	Yes
Connections for Filling/Emptying Storage Tanks Kept Close	-	Yes
Material	G40.21M-260WT	G40.21M-260WT
Product	Diesel	Diesel
Volume	20 ML	13.5 ML
Diameter	43.00 m	35.10 m
Height	14 m	14 m

\* A portion of the marine pipeline (single wall) intended to be aboveground was temporarily buried and the covering material had frozen. An appropriate remedial measure will be taken to remove the covering material as soon as the material is thawed in spring 2018 and there will be no risk to damage the pipe while excavating.

### 3.2 Compliance for Secondary Containment

The secondary containment for aboveground storage tanks complies to NFCC standards. The base and walls of the containment basin were constructed to withstand a full hydrostatic head and has a permeability of  $1 \times 10^{-13}$  cm/s while the required permeability is  $1 \times 10^{-6}$  cm/s. The tanks are located entirely within the diked area, with an impermeable membrane covered with a non-combustible material.



**Table 3.2: Rankin Inlet Itivia Site Secondary Containment As-built**

Parameters	Description		Compliance
Enclosed Tanks	Tank #1	Tank #2	-
Volume	20 ML	13.5 ML	-
Containment Requirement (for Tank #2 only)	14.850 ML		Yes
Containment Requirement (for both tanks)	22.000 ML		No*
Actual Containment Capacity	21.868 ML		-
Base and Wall Membrane to Withstand Hydrostatic Head	HDPE		Yes
Permeability ( $1\text{E}^{-6}$ cm/s min.)	$1\text{E}^{-13}$ cm/s		Yes
Tanks Located Entirely Within the Diked Area	-		Yes

\* See explanation in the paragraph below

As shown in Table 3.2 (above), the current total capacity of the Rankin Inlet Itivia Site Fuel Farm containment is 21 868 m<sup>3</sup> which is sufficient to operate Tank #2 (a minimum containment capacity of 14 850 m<sup>3</sup> is required for Tank #2). However, the dike containment volume required for both tanks to be in service (Tank #1 and Tank #2) is 22 000 m<sup>3</sup> which indicates that an additional 132 m<sup>3</sup> is required to meet the minimum capacity requirements. The changes in the geometry (as shown in section 5.1) compounded into a current volume capacity of 21 868 m<sup>3</sup> calculated from the floor base to the crests of perimeter dike, which is 1 821 m<sup>3</sup> lower than the designed capacity of 23 700 m<sup>3</sup>. A remodeling of the fill over the liner on the fuel farm floor to reach the volumetric capacity of 22 000 m<sup>3</sup> is required prior to the completion and commissioning of Tank #1, planned mid-year 2018.

## 4.0 FIELD DECISIONS FOR THE FIELD ERECTED FUEL TANK #2 AND SURROUNDING FACILITIES (STRUCTURAL, MECHANICAL, AND ELECTRICAL)

### 4.1 Documentation on Field Decisions that Deviate from Original Plans

This section documents variations from original design which were approved by the designer and/or the field engineer on site for the field erected fuel tank and piping systems. The designed intent of the structure was not compromised with the changes to the original design.

A construction summary was prepared for the structural, and the mechanical and electrical systems see Appendix F and G, respectively.



The construction work led to slight variations from the original design in the structural, mechanical, and electrical aspects of Tank #2 of the Rankin Fuel Farm.

#### **4.1.1 Structural**

- The handrails were changed to steel angle of 55 mm x 55 mm x 6 mm instead of a pipe handrail, approved by the designer.
- As per the designer, all manholes will be painted with Thermarust paint to prevent rust damage. Painting for both tanks will be done in summer 2018.

#### **4.1.2 Mechanical**

- The inspection test for leaks in Tank #2 changed to a liquid penetrating test, as approved by the designer. Additional equipment including a 12" pressure vacuum, shell brackets, and vents were installed.
- Vent valves were installed at the top of the dike section in the pipeline for Tank #2.
- The outer housing material was substituted for NEMA 4x Aluminum or Stainless Steel rather than the specified 3R to prevent any rust damage. This change was approved by the designer.
- An OPW loading arm replaced the Emco loading arm and was approved by the designer due to the time constraints of the delivery.
- Two odor control scrubbers with a vent were installed, approved by the designer.
- Tripods were replaced by cement blocks underneath the pump and electrical stations, approved by the designer.
- Structural framing was added to the pumping station to reinforce the structure beneath the motor and pump. This addition was approved by the designer.
- The diesel marine line double walled section does not conform as per Federal regulations. Monitoring gauge and ball valves must be accessible and the double wall pipe section must be visible on both ends. All corrective actions will be done in summer 2018.
- The flexible connection scrubber ducting does not respect the piping and instrumentation diagram. At the entrance of the scrubber, only one (1) flexible ducting should be installed while at the ground level of the drop tank point, flexible ducting is missing. All corrective action will be corrected in summer 2018.

#### **4.1.3 Electrical**

- The installation of Rankin Inlet's main electrical entry and the buried cable and electrical pole were added and approved by the designer.
- Cabletray and its supports were required to be installed on instrumentation and lighting cables, approved by the engineer.
- One switch per VSD was installed per pump. The 600 V power junction boxes were removed, approved by the designer and control cables were installed between cabinets and the VSD.

- Four (4) additional unit heaters were added and four (4)  $\frac{3}{4}$  hp engines to the filter containers. A 45 kVA transformer and a 120/208 V panel with 42 circuits replaced the 30 kVA transformer and the 120/208 V panel with 30 circuits, approved by the designer.
- Additional exterior lighting and fixtures were installed upon approval by the field engineer. One emergency lighting fixture and one 120 V receptacle in each operator room.
- A 4-20 mA was added to the PLC Motorized valves instead of an RTD card, approved by the designer.
- A temperature sensor was installed on Tank #2, approved by the designer.
- Grounding and bonding connections were added to the buried grid for all metallic equipment, as approved by the designer.

## 4.2 Maintenance, Inspection, Construction Monitoring, and Inspection Reports

The construction monitoring was managed by Agnico Eagle. Several activities were conducted during construction to ensure the quality of the work. Here is a description of the reports prepared to summarize the quality control, monitoring, and/or inspections performed during the construction of key activities.

- Inspection Test Plan dated October 29<sup>th</sup>, 2017 prepared by MTKSL, see Appendix H.
- Handover Package of Tank #2 dated October 30<sup>th</sup>, 2017 prepared by Inukshuk Construction Limited, see Appendix I. Testing was done throughout the erection of Tank #2 and the installation of the mechanical and electrical systems. See Table 4.1 for a summary of the inspections.
- Rankin Inlet Offsite and Onsite Fabrication Quality Control Documents dated June 6<sup>th</sup>, 2017 prepared by Nuqsana Promec Mining, see Appendix J. Quality control was done throughout the construction and fabrication the project, including but not limited to, the catwalk, piping, and mechanical fixtures.
- Fuel Module Quality Control Documents dated November 27<sup>th</sup>, 2017 prepared by Nuqsana Promec Mining, see Appendix K. Documentation for inspection and test plan for mechanical, piping, and also red line are included in this document.

During the first filling process of Tank #2, two (2) minor fuel leaks were observed. The first leak occurred on October 17<sup>th</sup>, fuel seeped out from the pressure test port on the fueling nozzle neck reinforcement plate. The second leak occurred on October 18<sup>th</sup>, with minor weeping between the manhole welding joint and the tank reinforcement plate. Both of these leaks were promptly reported to the installation contractor who repaired the leaks with temporary welding from the tank exterior. Regular visual inspections were made thereafter to ensure no further leaks occurred.

Two (2) Non-Compliance Reports were then completed to cover these defects, see Appendix L. At the time of writing this interim report the permanent corrective measures had not yet been finalized by the contractor. The permanent repairs will take place in the Spring of 2018 at which time Tank #2 will have to be emptied such that permanent repairs can take place from within the interior of the tank.

**Table 4.1: Tank #2 As-built Inspections**

Description	Test Method	Result
Floor Welding	Visual	Acceptable
Floor Welding	Vacuum Box	Acceptable
Shell to Floor Welding	Visual	Acceptable
Shell to Bottom Welding	Visual	Acceptable
Tank #2 Roundness	Visual	Acceptable
1 <sup>st</sup> Horizontal Banding	Measure	Acceptable
2 <sup>nd</sup> Horizontal Banding	Measure	Acceptable
3 <sup>rd</sup> Horizontal Banding	Measure	Acceptable
4 <sup>th</sup> Horizontal Banding	Measure	Acceptable
SR1 Vertical	Measure	Acceptable
SR2 Vertical	Measure	Acceptable
SR3 Vertical	Measure	Acceptable
SR4 Vertical	Measure	Acceptable
SR5 Vertical	Measure	Acceptable
Tank Shell Plumbness	Measure	Acceptable
1 <sup>st</sup> Horizontal and Vertical Leaks	Visual	Acceptable
2 <sup>nd</sup> Horizontal and Vertical Leaks	Visual	Acceptable
3 <sup>rd</sup> Horizontal and Vertical Leaks	Visual	Acceptable
4 <sup>th</sup> Horizontal and 4 <sup>th</sup> and 5 <sup>th</sup> Vertical Leaks	Visual	Acceptable
Compression Ring Welding	Visual	Acceptable
Tank #2 Roof Welding	Visual	Acceptable
Roof Columns Plumbness	Measure	Acceptable
Roof Structure Welding and Bolting	Visual	Acceptable
Tank Shell Plumbness	Measure	Acceptable
Shell Nozzle Welding	Visual	Acceptable
Nozzle Repad Leaks	Air Test	Acceptable
Shell Manway Welding	Visual	Acceptable
Tank #2 Shell Plumbness	Measure	Acceptable
Manway Leaks	Visual	Acceptable
Internal Column Repads and Pipe Support Welding	Visual	Acceptable
External Brackets and Cable Tray Welding	Visual	Acceptable
Roof Painter Post Welding	Visual	Acceptable
Staircase Support Bracket and Repad Welding	Visual	Acceptable
Stairs and Platforms Welding	Visual	Acceptable

## 5.0 FIELD DECISIONS FOR THE SECONDARY CONTAINMENT FACILITY

### 5.1 Documentation on Field Decisions that Deviate from Original Plans

This section documents variations from original design which were approved by the designer and/or the field engineer on site for the field erected fuel tank and piping systems. The designed intent of the structure was not compromised with the changes to the original design.

A construction summary was prepared for the Rankin Inlet Itivia Site Fuel Storage and Containment Facilities see Appendix M.

The construction work led to slight variations from the original design in the geometry of the Rankin Fuel Farm. The Rankin Inlet Itivia Site Fuel Storage Containment Facilities and Rankin Inlet Itivia Culvert geometry and characteristics were adjusted to site conditions. Table 5.1 presents the changes between the proposed and final works.

- The rock slope excavation is 1V:0.1H instead of the original 1V:0.75H. It was approved by the geotechnical engineer.

#### 5.1.1 Tank Foundation As-built

- A slope of 1V:120H was required under the tanks, sloping from the center of the tank to the edge of the tank foundation pad.
- The average side slope of dike and pad foundation slope remained the same at 1V:2H.
- The dimensions of the Tank #1 and Tank #2 pad foundations remained the same at 45.4 m x 45.4 m and 37.5 m x 37.5 m, respectively.

#### 5.1.2 Dike and Secondary Containment

- Within the northeast corner and extending along the east wall the bedrock elevation was found to be below 9.45 m or non-existent at the designed floor elevation. The blast was drilled to bedrock or the designed floor in this area, 4 m back from the designed highwall to allow additional berm structure to be constructed.
- The dimensions of the dike CL to CL are greater by 1.6 m length and 2.6 m width.
- The average top width of the dike crest is 1.4 m which is an increase of 0.4 m from the original 1 m design.
- The containment height was reduced by 0.08 m to a height of 1.57 m.
- The depth of fill placed over the liner was increased by 0.08 m to a depth of 0.38 m.
- The average height of the dike crest remained at 1.8 m.
- A detail for the sump area was provided by the designer.
- The rip-rap was removed from the ditch, approved by the designer. The geometry of the ditch was changed due to constructability issues and approved by the field engineer. The overall water management of the containment facility was unaffected, sloping toward the sump area where the clean water will be pumped out of the fuel farm.

Several particle size analyses were conducted for the 30 mm minus material to be used for the tank foundation and liner system. It was approved by the field engineer and the results and summary can be found in Appendix N.

**Table 5.1: Rankin Inlet Itivia Site Fuel Storage and Containment Facilities Geometry and Characteristics**

Item	Proposed		Actual		Difference
	Tank #1	Tank #2	Tank #1	Tank #2	
Secondary Containment Permeability (max.)	1E <sup>-6</sup> cm/s		1E <sup>-13</sup> cm/s		- 10E <sup>-7</sup> cm/s
Dike: length, width (CL to CL) (avg.)	154 m x 104.3 m		155.6 m x 106.9 m		+ 1.6 m / + 2.6 m
Dike Height (avg.)	1.8 m		1.8 m		-
Containment Height (avg.)	1.65 m		1.57 m		- 0.08 m
Dike Flat Top Width (avg.)	1.0 m		1.4 m		+ 0.4 m
Dike Embankment Slope (avg.)	1V:2H		1V:2H		-
Impervious Area	16 050 m <sup>2</sup>		17 051 m <sup>2</sup>		+ 1 001 m <sup>2</sup>
Tank Foundation Pad (avg.)	45.4 m x 45.4 m	37.5 m x 37.5 m	45.4 m x 45.4 m	37.5 m x 37.5 m	-
Tank Foundation Thickness (min.)	900 mm	900 mm	950 mm	1.02 m	+ 50 mm / + 102 mm
Tank Foundation Shoulder (min.)	1.2 m	1.2 m	1.2 m	1.2 m	-
Tank Foundation Pad Embankment Slope (avg.)	1V:2H	1V:2H	1V:2H	1V:2H	-
Tank Foundation Pad Slope (avg.)	1V:120H	1V:120H	1V:120H	1V:120H	-
Tank Foundation Pad Thickness, Above Surrounding Ground (m)	0.4	0.4	0.4	0.4	-
Depth of Liner Under Fill (avg.)	0.3 m		0.38 m		+ 0.08 m
Containment Capacity (for Tank #2 only)	14 850 m <sup>3</sup>		21 686 m <sup>3</sup>		+ 6 836 m <sup>3</sup>
Containment Capacity (both tanks)	22 000 m <sup>3</sup>		21 868 m <sup>3</sup>		- 132 m <sup>3</sup>

### 5.1.3 Distance Restrictions As-built

The minimum clearances that were required or recommended were met and are listed on Table 5.2 below:

**Table 5.2: Distances Restrictions**

Item	Minimum Required	Tank #1	Tank #2
Distance Between Tanks	$\frac{1}{4} (D1 + D2) = 19.5 \text{ m}$ D1=43 m, D2=35.1 m	19.56 m	
Distance Between Tank and Toe of the Dike	1.50 m	15.42 m	12.43 m
Distance Between Tank and CL of the Dike	$\frac{1}{2} (\text{Height of Tank}) = 7.0 \text{ m}$ Height = 14 m	27.91 m	19.33 m
Distance Between Property Limit (that can be built upon) and Tank	Tanks with 3 000 001 gallons or more: 175 ft. = 53.34 m	54.20 m	64.26 m
Distance Between Property Limit and Exterior Toe of the Dike	3.0 m	4.27 m	
Distance Between Tank and Public Roads	60 ft. = 18.3 m	115 m	166.30 m
Distance Between Fuel Farm and High Water Line of Melvin Bay	31.0 m	37.76 m	

## 5.2 Commissioning, Inspection, Construction Monitoring, and Inspection Reports

The construction monitoring was managed by Agnico Eagle. Several activities were conducted during construction to ensure the quality of the work. Here is a description of the reports prepared to summarize the quality control, monitoring, and/or inspections performed during the construction of key activities.

- Visit Reports for Final Wall Inspection dated June 21<sup>st</sup> and 29<sup>th</sup>, 2017 prepared by Vanessa Smith, see Appendix O. A visual inspection was conducted and a fault was discovered in the rock which may reduce the long term stability of the wall, but overall the condition of the rock was good.
- Blasting Operation, Survey and Monitoring dated October 6<sup>th</sup>, 2017 prepared by Explotech Engineering Ltd, see Appendix P. A pre-blast and post-blast inspection were done including vibration monitoring during blasting. No notable changes were observed related to the blasting or construction operations in the surrounding buildings and facilities.
- Quality Control Final Report prepared by Texel Geosol for Nuna Kivalliq Earthworks Inc, see Appendix Q. Testing, both non-destructive and destructive, was performed to ensure the quality of the installation of the geosynthetic materials, including welding. Texel Geosol certified that all materials were installed according to the project plans and specifications.
- Inspection Test Plan dated October 29<sup>th</sup>, 2017 prepared by MTKSL, see Appendix H.



## 6.0 FIELD DECISIONS FOR THE RANKIN INLET ITIVIA CULVERT

### 6.1 Documentation on Field Decisions that Deviate from Original Plans

Particle size analyses were conducted for the 20 mm minus material to be used for the culvert bedding. It was approved by the field engineer and the results and summary can be found in Appendix R.

- The culvert dimensions were maintained at a diameter of 900 mm and length of 30 m.
- The culvert slope was decreased on site to a slope of 1.33% to follow the natural ground slope, and is still adequate to carry the water flow.
- The rip-rap around the Rankin Itivia Culvert will be installed at a later date.

**Table 6.1: Rankin Itivia Culvert Geometry and Characteristics**

Culvert Description	Proposed	Actual	Difference
Length	30 m	30 m	-
Diameter	900 mm	900 mm	-
Slope	3.61%	1.33%	- 2.28%
Number of pipes	2	2	-

Temporary culverts were replaced by final culverts in November 2017 as indicated in the Construction Summary of Rankin Itivia Culvert, see Appendix S.

## 7.0 EARTH WORKS

A shortage of granular material led to slight changes in the materials:

- The original material specified for the Rankin Inlet Itivia Site Fuel Storage Containment Facility was 200 mm minus granular material and was replaced with Class A Borrow Pit or 600 mm minus granular fill graded to a particle size of  $\leq 200$  mm.
- The fill thickness of the 30 mm minus granular fill over and under the liner system was changed to 300 mm and 200 mm respectively, approved by the designer. This change was to allow the heavy equipment required for construction to access the site. This change did not affect the total material quantities.
- A 100 mm layer of sand between the geotextile and geomembrane replaced the 30 mm minus in the Tank #1 containment area, minus the tank pedestal. This was due to construction constraints and to avoid potentially damaging the liner system during tank erection. The substitution was approved by the designer.

The as-built material quantities for the Rankin Inlet Fuel Storage Containment Facilities and the Rankin Inlet Itivia Culvert are presented in Table 7.1 below.

**Table 7.1: As-built Material Quantities**

Item	Proposed	Actual	Difference
Sand	180	1 744 m <sup>3</sup>	+ 1 564 m <sup>3</sup>
30 mm minus	10 590 m <sup>3</sup>	7 073 m <sup>3</sup>	- 3 517 m <sup>3</sup>
50 mm minus	5 900 m <sup>3</sup>	3 425 m <sup>3</sup>	- 2 475 m <sup>3</sup>
Borrow Pit CL-A or Granular Fill (Graded to < 200 mm)	7 670 m <sup>3</sup>	4 510 m <sup>3</sup>	- 3 160 m <sup>3</sup>
Borrow Pit CL-A or Granular Fill (600 mm minus)	7 160 m <sup>3</sup>	12 440 m <sup>3</sup>	+ 5 280 m <sup>3</sup>
Rip-rap (50 mm to 300 mm)	30 m <sup>3</sup>	-	- 30 m <sup>3</sup>
<b>Total of fill</b>	<b>25 630 m<sup>3</sup></b>	<b>25 767 m<sup>3</sup></b>	<b>+ 137 m<sup>3</sup></b>
540 g/m <sup>2</sup> Non-woven geotextile	33 600 m <sup>2</sup>	34 102 m <sup>2</sup>	+ 502 m <sup>2</sup>
HDPE Geomembrane	16 800 m <sup>2</sup>	17 051 m <sup>2</sup>	+ 251 m <sup>2</sup>
Length Culvert, 2 CSP Ø 900 mm, 2.0 mm thick	30 m	30 m	-
Excavation of Overburden	18 480 m <sup>3</sup>	43 445 m <sup>3</sup>	+ 24 965 m <sup>3</sup>
Drill and Blast Excavation of Bedrock	68 400 m <sup>3</sup>	78 500 m <sup>3</sup>	+ 10 100 m <sup>3</sup>


## 8.0 LIMITATIONS OF REPORT

This report and its contents are intended for the sole use of Agnico Eagle Mines Ltd. and their agents. Tetra Tech does not accept any responsibility for the accuracy of any of the data, the analysis, or the recommendations contained or referenced in the report when the report is used or relied upon by any Party other than Agnico Eagle Mines Ltd., or for any Project other than the proposed development at the subject site. Any such unauthorized use of this report is at the sole risk of the user. Use of this report is subject to the terms and conditions stated in Tetra Tech's Services Agreement.

## 9.0 CLOSURE

We trust this report meets your present requirements. If you have any questions or comments, please contact the undersigned.

Respectfully submitted,  
Tetra Tech

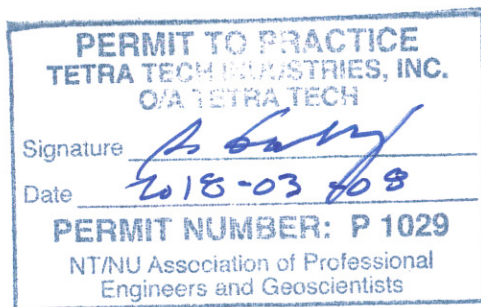

Prepared by: *[Signature]* - 2018-3-0  
Christopher Morin, Jr. Eng.  
Direct Line: 514.257.2427 x3240  
Christopher.Morin@tetrattech.com


Reviewed by:  
Josée Alarie, P.Eng. *[Signature]*  
Direct Line: 514.257.2427 x3323 2018-03-08  
Josée.Alarie@tetrattech.com



## **APPENDIX A**

### **As-built Drawings of Rankin Inlet Itivia Site Fuel Storage and Containment Facilities**




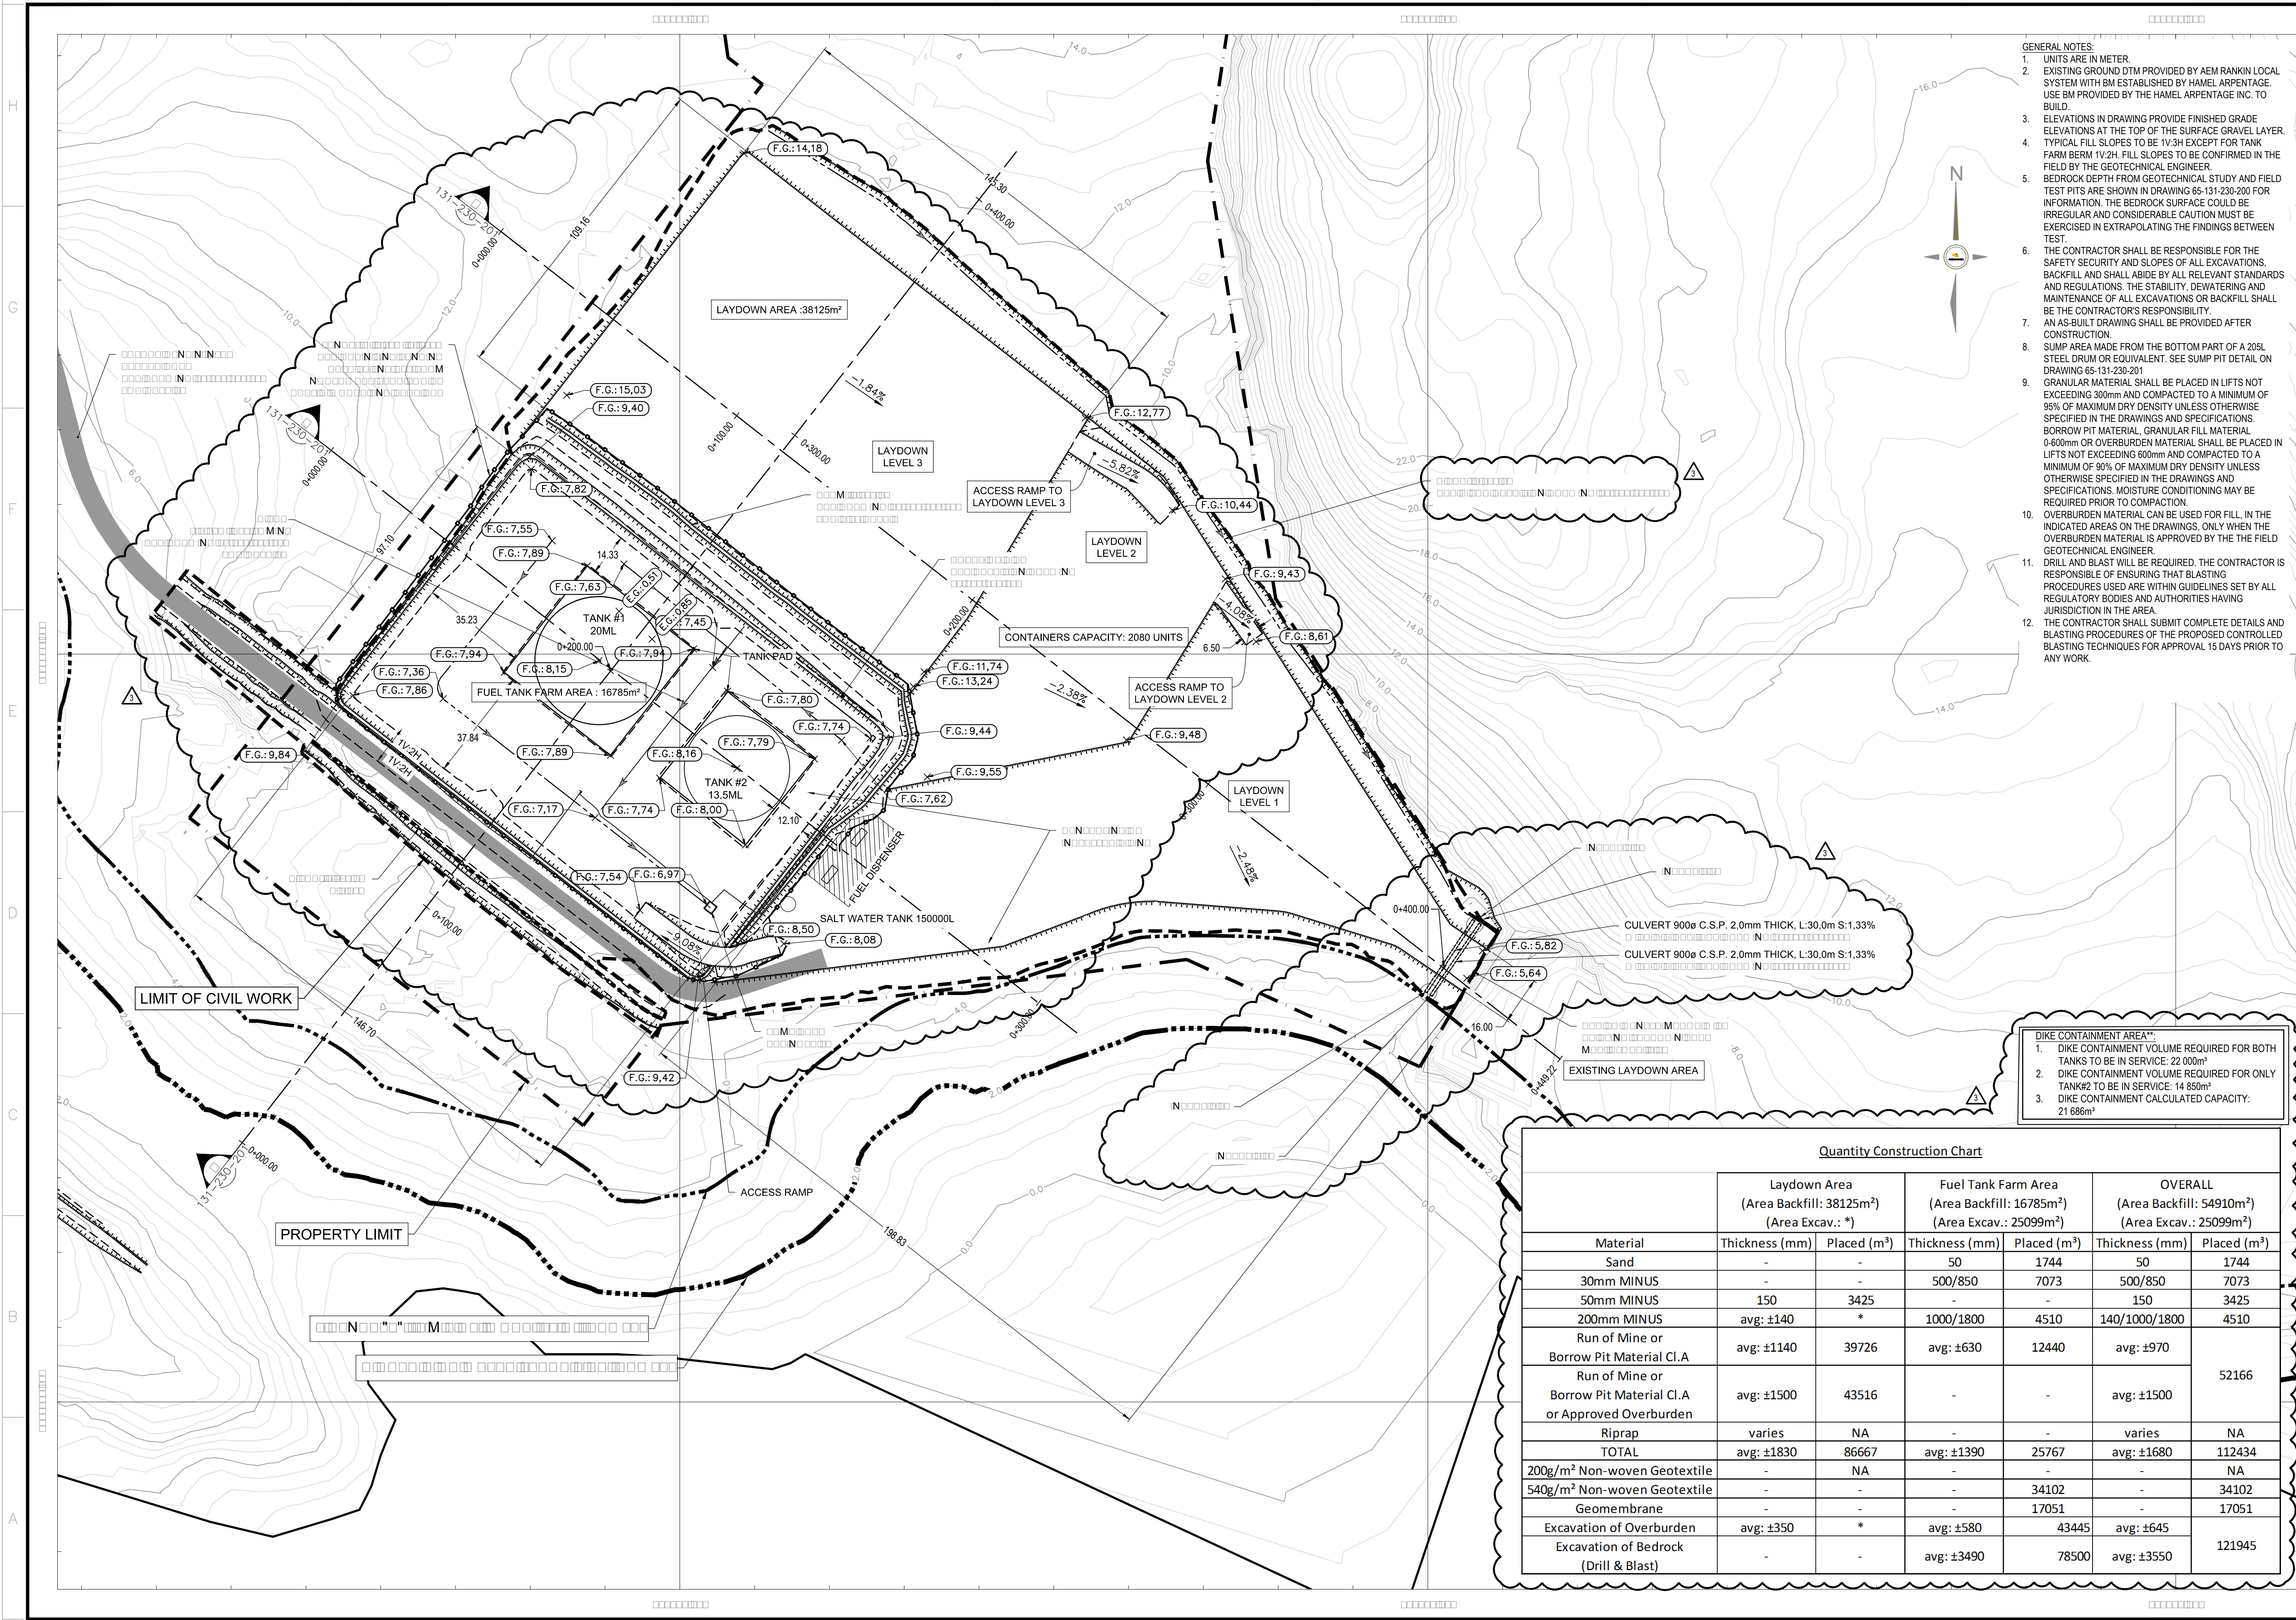

- GENERAL NOTES:
1. UNITS ARE IN METER.
  2. EXISTING GROUND DTM PROVIDED BY AEM RANKIN LOCAL SYSTEM WITH BN ESTABLISHED BY HAMEL ARPENTAGE. USE BN PROVIDED BY THE HAMEL ARPENTAGE INC. TO BUILD.
  3. ELEVATIONS IN DRAWING PROVIDE FINISHED GRADE ELEVATIONS AT THE TOP OF THE SURFACE GRAVEL LAYER.
  4. TYPICAL FILL SLOPES TO BE 1V:3H EXCEPT FOR TANK FARM BERM 1V:4H. FILL SLOPES TO BE CONFIRMED IN THE FIELD BY THE GEOTECHNICAL ENGINEER.
  5. BEDROCK DEPTH FROM GEOTECHNICAL STUDY AND FIELD TEST PITS ARE SHOWN IN DRAWING 65-131-230-200 FOR INFORMATION. THE BEDROCK SURFACE COULD BE IRREGULAR AND CONSIDERABLE CAUTION MUST BE EXERCISED IN EXTRAPOLATING THE FINDINGS BETWEEN TEST.
  6. THE CONTRACTOR SHALL BE RESPONSIBLE FOR THE SAFETY SECURITY AND SLOPES OF ALL EXCAVATIONS, BACKFILL AND SHALL ABIDE BY ALL RELEVANT STANDARDS AND REGULATIONS. THE STABILITY, DEWATERING AND MAINTENANCE OF ALL EXCAVATIONS OR BACKFILL SHALL BE THE CONTRACTOR'S RESPONSIBILITY.
  7. AN AS-BUILT DRAWING SHALL BE PROVIDED AFTER CONSTRUCTION.
  8. SUMP AREA MADE FROM THE BOTTOM PART OF A 205L STEEL DRUM OR EQUIVALENT. SEE SUMP PIT DETAIL ON DRAWING 65-131-230-201.
  9. GRANULAR MATERIAL SHALL BE PLACED IN LIFTS NOT EXCEEDING 300mm AND COMPACTED TO A MINIMUM OF 95% OF MAXIMUM DRY DENSITY UNLESS OTHERWISE SPECIFIED IN THE DRAWINGS AND SPECIFICATIONS. BORROW PIT MATERIAL, GRANULAR FILL MATERIAL 0-600mm OR OVERBURDEN MATERIAL SHALL BE PLACED IN LIFTS NOT EXCEEDING 600mm AND COMPACTED TO A MINIMUM OF 90% OF MAXIMUM DRY DENSITY UNLESS OTHERWISE SPECIFIED IN THE DRAWINGS AND SPECIFICATIONS. MOISTURE CONDITIONING MAY BE REQUIRED PRIOR TO COMPACTION.
  10. OVERBURDEN MATERIAL CAN BE USED FOR FILL, IN THE INDICATED AREAS ON THE DRAWINGS. ONLY WHEN THE OVERBURDEN MATERIAL IS APPROVED BY THE THE FIELD GEOTECHNICAL ENGINEER.
  11. DRILL AND BLAST WILL BE REQUIRED. THE CONTRACTOR IS RESPONSIBLE OF ENSURING THAT BLASTING PROCEDURES USED ARE WITHIN GUIDELINES SET BY ALL REGULATORY BODIES AND AUTHORITIES HAVING JURISDICTION IN THE AREA.
  12. THE CONTRACTOR SHALL SUBMIT COMPLETE DETAILS AND BLASTING PROCEDURES OF THE PROPOSED CONTROLLED BLASTING TECHNIQUES FOR APPROVAL 15 DAYS PRIOR TO ANY WORK.


- DIKE CONTAINMENT AREA\*\*:
1. DIKE CONTAINMENT VOLUME REQUIRED FOR BOTH TANKS TO BE IN SERVICE: 22 000m³
  2. DIKE CONTAINMENT VOLUME REQUIRED FOR ONLY TANK#2 TO BE IN SERVICE: 14 850m³
  3. DIKE CONTAINMENT CALCULATED CAPACITY: 21 686m³

Quantity Construction Chart						
Material	Laydown Area (Area Backfill: 38125m²) (Area Excav.: *)		Fuel Tank Farm Area (Area Backfill: 16785m²) (Area Excav.: 25099m²)		OVERALL (Area Backfill: 54910m²) (Area Excav.: 25099m²)	
	Thickness (mm)	Placed (m³)	Thickness (mm)	Placed (m³)	Thickness (mm)	Placed (m³)
Sand	-	-	50	1744	50	1744
30mm MINUS	-	-	500/850	7073	500/850	7073
50mm MINUS	150	3425	-	-	150	3425
200mm MINUS	avg: ±140	*	1000/1800	4510	140/1000/1800	4510
Run of Mine or Borrow Pit Material Cl.A	avg: ±1140	39726	avg: ±630	12440	avg: ±970	52166
Run of Mine or Borrow Pit Material Cl.A or Approved Overburden	avg: ±1500	43516	-	-	avg: ±1500	
Riprap	varies	NA	-	-	varies	NA
TOTAL	avg: ±1830	86667	avg: ±1390	25767	avg: ±1680	112434
200g/m² Non-woven Geotextile	-	NA	-	-	-	NA
540g/m² Non-woven Geotextile	-	-	-	34102	-	34102
Geomembrane	-	-	-	17051	-	17051
Excavation of Overburden	avg: ±350	*	avg: ±580	43445	avg: ±645	121945
Excavation of Bedrock (Drill & Blast)	-	-	avg: ±3490	78500	avg: ±3550	

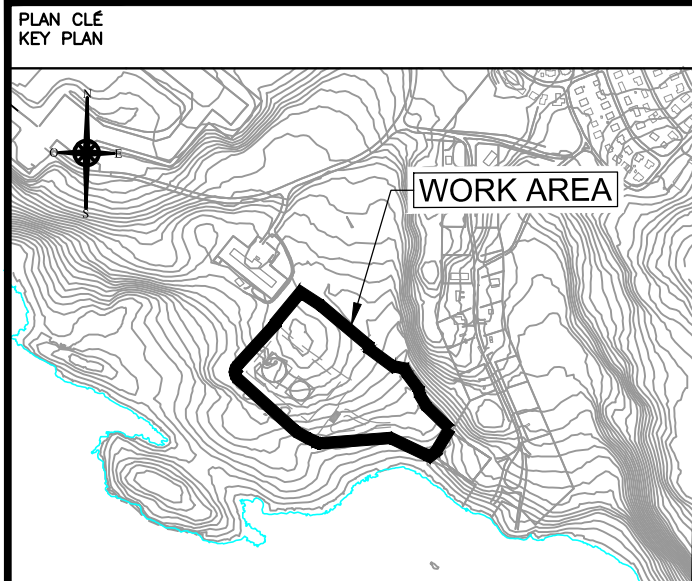

NOTES GÉNÉRALES / GENERAL NOTES

- \* THE FENCE, DITCH, AND THEIR RESPECTIVE MATERIAL QUANTITIES WILL BE INSTALLED AFTER THE AS-BUILT DRAWINGS ARE ISSUED.
- \*\* AS OF THE ISSUANCE OF THE AS-BUILT DRAWING ONLY TANK #2 WILL BE IN SERVICE IN 2017 AND UNTIL THE REQUIRED CAPACITY IS MET FOR BOTH TANKS.

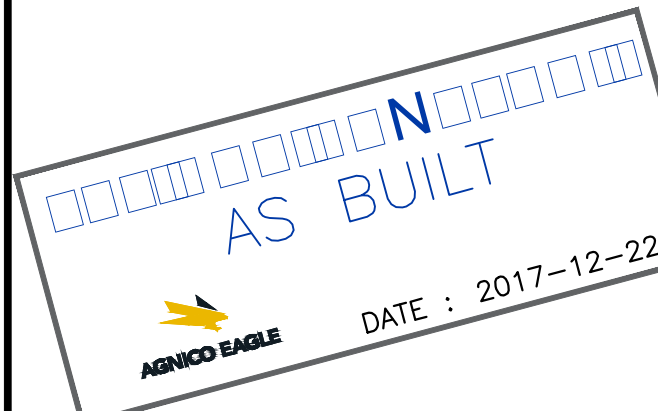

INFORMATION CONTAINED ON THIS DRAWING IS THE PROPERTY OF AGNICO-EAGLE LTD. AND MUST BE RETURNED UPON REQUEST. WITHOUT WRITTEN PERMISSION, NO COPYING, REPRODUCTION, OR DISSEMINATION IS PERMITTED. THIS DRAWING IS NOT TO BE USED FOR ANY OTHER PROJECT OR PURPOSE.

DESSINS EN RÉFÉRENCE / REFERENCE DRAWINGS			
TITRE / TITLE	#	DWG	
-	-	-	-
-	-	-	-
-	-	-	-
-	-	-	-



REV	DATE	DESCRIPTION	PAR/REV	APP.	CLIENT
3	2017-12-22	ISSUED AS-BUILT	C.M.	J.A.	
2	2017-10-13	ISSUED AS-BUILT	C.M.	J.A.	
1	2017-04-12	ISSUED FOR CONSTRUCTION	P.H.	J.A.	
0	2017-03-28	ISSUED FOR CONSTRUCTION	P.H.	J.A.	

REVISIONS

TITRE / TITLE  
AGNICO-EAGLE - MELIADINE DIVISION  
000-SITE PREP  
230-GENERAL EARTH WORKS  
RANKIN FUEL TANK FARM AND LAYDOWN AREA  
FINISHED GRADE ELEVATION

DESSINÉ PAR  
DRAWN BY PATRICK HAMEL

DATE  
2017-03-03

VÉRIFIÉ PAR  
CHECKED BY MÉLANIE YIP WOON SUN

DATE  
2017-03-03

APPROUVÉ PAR  
APPROVED BY JOSÉE ALARIE

DATE  
2017-03-03

ÉCHELLE  
SCALE 1:1000

DATE  
2015-07-16


NO. DESSIN  
DRAWING NO. 65-131-230-200

NO. PROJET  
PROJECT NO. 6515/28920

REVISION  
3

FEUILLE / SHEET  
1 / 1



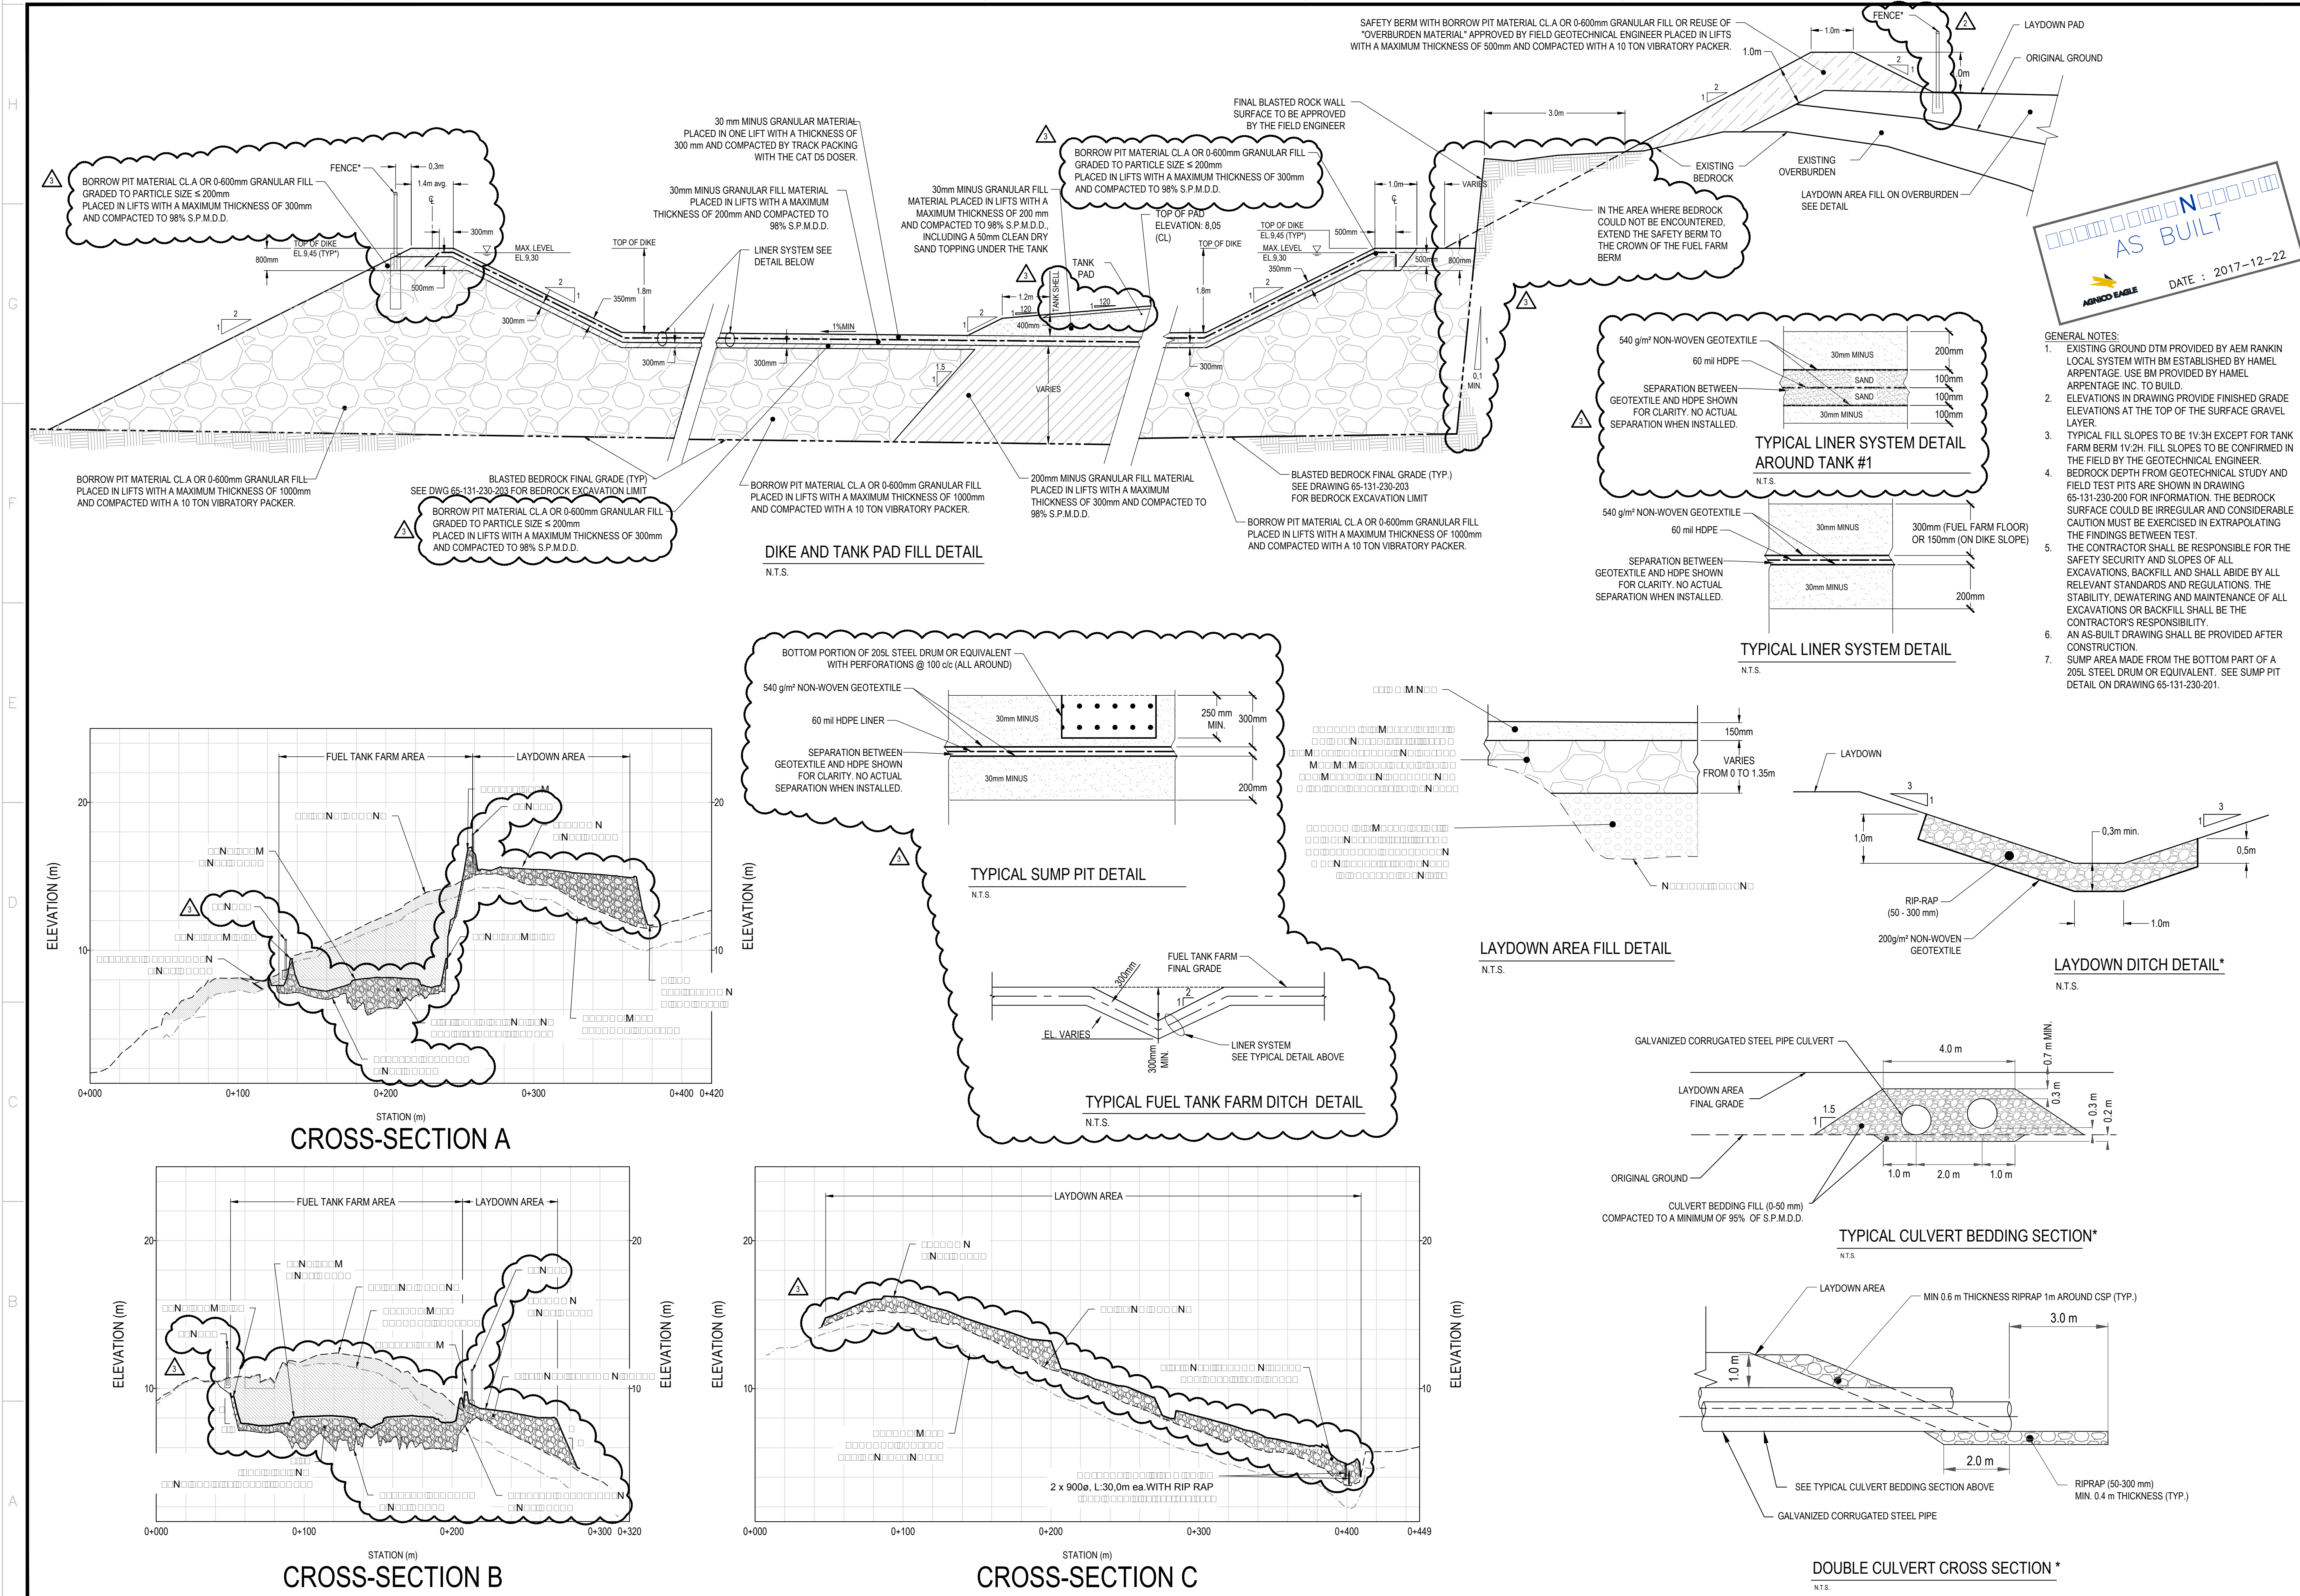

**PLAN CLE KEY PLAN**

**WORK AREA**

**AS BUILT**  
DATE : 2017-12-22

**TETRA TECH**

**NOTES GÉNÉRALES / GENERAL NOTES**

- EXISTING GROUND DTM PROVIDED BY AEM RANKIN LOCAL SYSTEM WITH BM ESTABLISHED BY HAMEL ARPEPAGE INC. TO BUILD.
- ELEVATIONS IN DRAWING PROVIDE FINISHED GRADE ELEVATIONS AT THE TOP OF THE SURFACE GRAVEL LAYER.
- TYPICAL FILL SLOPES TO BE 1V:3H EXCEPT FOR TANK FARM BERM 1V:2H. FILL SLOPES TO BE CONFIRMED IN THE FIELD BY THE GEOTECHNICAL ENGINEER.
- BEDROCK DEPTH FROM GEOTECHNICAL STUDY AND FIELD TEST PITS ARE SHOWN IN DRAWING 65-131-230-200 FOR INFORMATION. THE BEDROCK SURFACE COULD BE IRREGULAR AND CONSIDERABLE CAUTION MUST BE EXERCISED IN EXTRAPOLATING THE FINDINGS BETWEEN TEST.
- THE CONTRACTOR SHALL BE RESPONSIBLE FOR THE SAFETY SECURITY AND SLOPES OF ALL EXCAVATIONS, BACKFILL AND SHALL ABIDE BY ALL RELEVANT STANDARDS AND REGULATIONS. THE STABILITY, DEWATERING AND MAINTENANCE OF ALL EXCAVATIONS OR BACKFILL SHALL BE THE CONTRACTOR'S RESPONSIBILITY.
- AN AS-BUILT DRAWING SHALL BE PROVIDED AFTER CONSTRUCTION.
- SUMP AREA MADE FROM THE BOTTOM PART OF A 20SL STEEL DRUM OR EQUIVALENT. SEE SUMP PIT DETAIL ON DRAWING 65-131-230-201.
- GRANULAR MATERIAL SHALL BE PLACED IN LIFTS NOT EXCEEDING 300mm AND COMPACTED TO A MINIMUM OF 95% OF MAXIMUM DRY DENSITY (STANDARD PROCTOR) UNLESS OTHERWISE SPECIFIED IN THE DRAWINGS AND SPECIFICATIONS. BORROW PIT MATERIAL, GRANULAR FILL MATERIAL 0-600mm OR OVERBURDEN MATERIAL SHALL BE PLACED IN LIFTS NOT EXCEEDING 600mm AND COMPACTED TO A MINIMUM OF 90% OF MAXIMUM DRY DENSITY (STANDARD PROCTOR) UNLESS OTHERWISE SPECIFIED IN THE DRAWINGS AND SPECIFICATIONS. MOISTURE CONDITIONING MAY BE REQUIRED PRIOR TO COMPACTION.
- OVERBURDEN MATERIAL CAN BE USED FOR FILL, IN THE INDICATED AREAS ON THE DRAWINGS, ONLY WHEN THE OVERBURDEN MATERIAL IS APPROVED BY THE THE FIELD GEOTECHNICAL ENGINEER.
- DRILL AND BLAST WILL BE REQUIRED. THE CONTRACTOR IS RESPONSIBLE OF ENSURING THAT BLASTING PROCEDURES USED ARE WITHIN GUIDELINES SET BY ALL REGULATORY BODIES AND AUTHORITIES HAVING JURISDICTION IN THE AREA.
- THE CONTRACTOR SHALL SUBMIT COMPLETE DETAILS AND BLASTING PROCEDURES OF THE PROPOSED CONTROLLED BLASTING TECHNIQUES FOR APPROVAL 15 DAYS PRIOR TO ANY WORK.

THE FENCE, DITCH, AND THEIR RESPECTIVE MATERIAL QUANTITIES WILL BE INSTALLED AFTER THE AS-BUILT DRAWINGS ARE ISSUED.

**DESSINS EN RÉFÉRENCE / REFERENCE DRAWINGS**

TITRE / TITLE	# DWG
---	---
---	---
**AGNICO EAGLE**

REV	DATE	DESCRIPTION	PAR/REV	APP.	CLIENT
3	2017-12-22	ISSUED AS-BUILT	C.M.	J.A.	
2	2017-10-13	ISSUED AS-BUILT	C.M.	J.A.	
1	2017-04-12	ISSUED FOR CONSTRUCTION	P.H.	J.A.	
0	2017-03-28	ISSUED FOR CONSTRUCTION	P.H.	J.A.	
H	2017-02-24	ISSUED FOR TENDER	J.G.M.	J.A.	
G	2017-02-20	ISSUED FOR COMMENTS	P.H.	J.A.	

**REVISIONS**



DESSINÉ PAR DRAWN BY	DATE 2017-03-28
PATRICK HAMEL	
VÉRIFIÉ PAR CHECKED BY	2017-03-28
MÉLANIE YIP WOON SUN	
APPROUVÉ PAR APPROVED BY	2017-03-28
JOSÉE ALARIE	

**ÉCHELLE  
SCALE** H 1:2000, V 1:200 DATE 2015-07-16

**NO. DESSIN  
DRAWING NO.** 65-131-230-201

NO. PROJET PROJECT NO.	REVISION	FEUILLE / SHEET
6515/28920	3	1 / 1



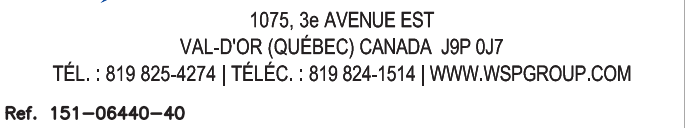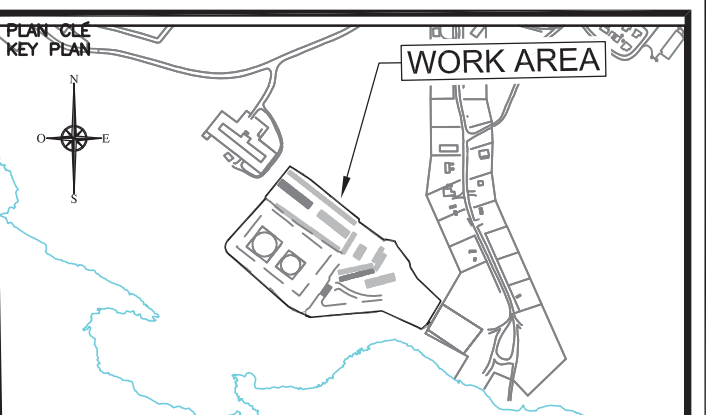

1. TANK DIMENSIONS ADJUSTED ACCORDING TO INFORMATION PROVIDED BY CONTRACTOR
2. REPLACE DRAWING : 65-103-210-200

THE INFORMATION ON CONTAINER IS THE PROPERTY OF AGNICO EAGLE LTD. AND MUST BE RETURNED UPON REQUEST, WITHOUT WRITTEN PERMISSION, ANY COPYING, TRANSMITTAL, TO OTHERS AND ANY USE EXCEPT THAT FOR WHICH IT IS LOANED ARE PROHIBITED.

TITRE / TITLE	# DWG



0	2017-05-31	ISSUED FOR CONSTRUCTION	J.M.	D.T.		
REV.	DATE	DESCRIPTION	PAR/BY	APP.	CUSTOMER	


TITRE / TITLE  
AGNICO EAGLE - MELIADINE DIVISION  
116 - FUEL TANK FARM  
210 - GENERAL ARRANGEMENT  
FUEL DISTRIBUTION  
PLAN VIEWS

DESSINÉ PAR DRAWN BY	G. CORNUT	DATE 2017-05-29
VÉRIFIÉ PAR CHECKED BY	J. MORLIÈRE, tech.	2017-05-29
APPROUVÉ PAR APPROVED BY	D. THIBODEAU, P. Eng.	2017-05-29

ÉCHELLE SCALE	INDICATED	DATE	2017-05-29
NO. DESSIN DRAWING NO.		65-116-210-200	

NO. PROJ PROJECT NO.	REVISION	FEUILLE / SHT
6515	0	1 / 1



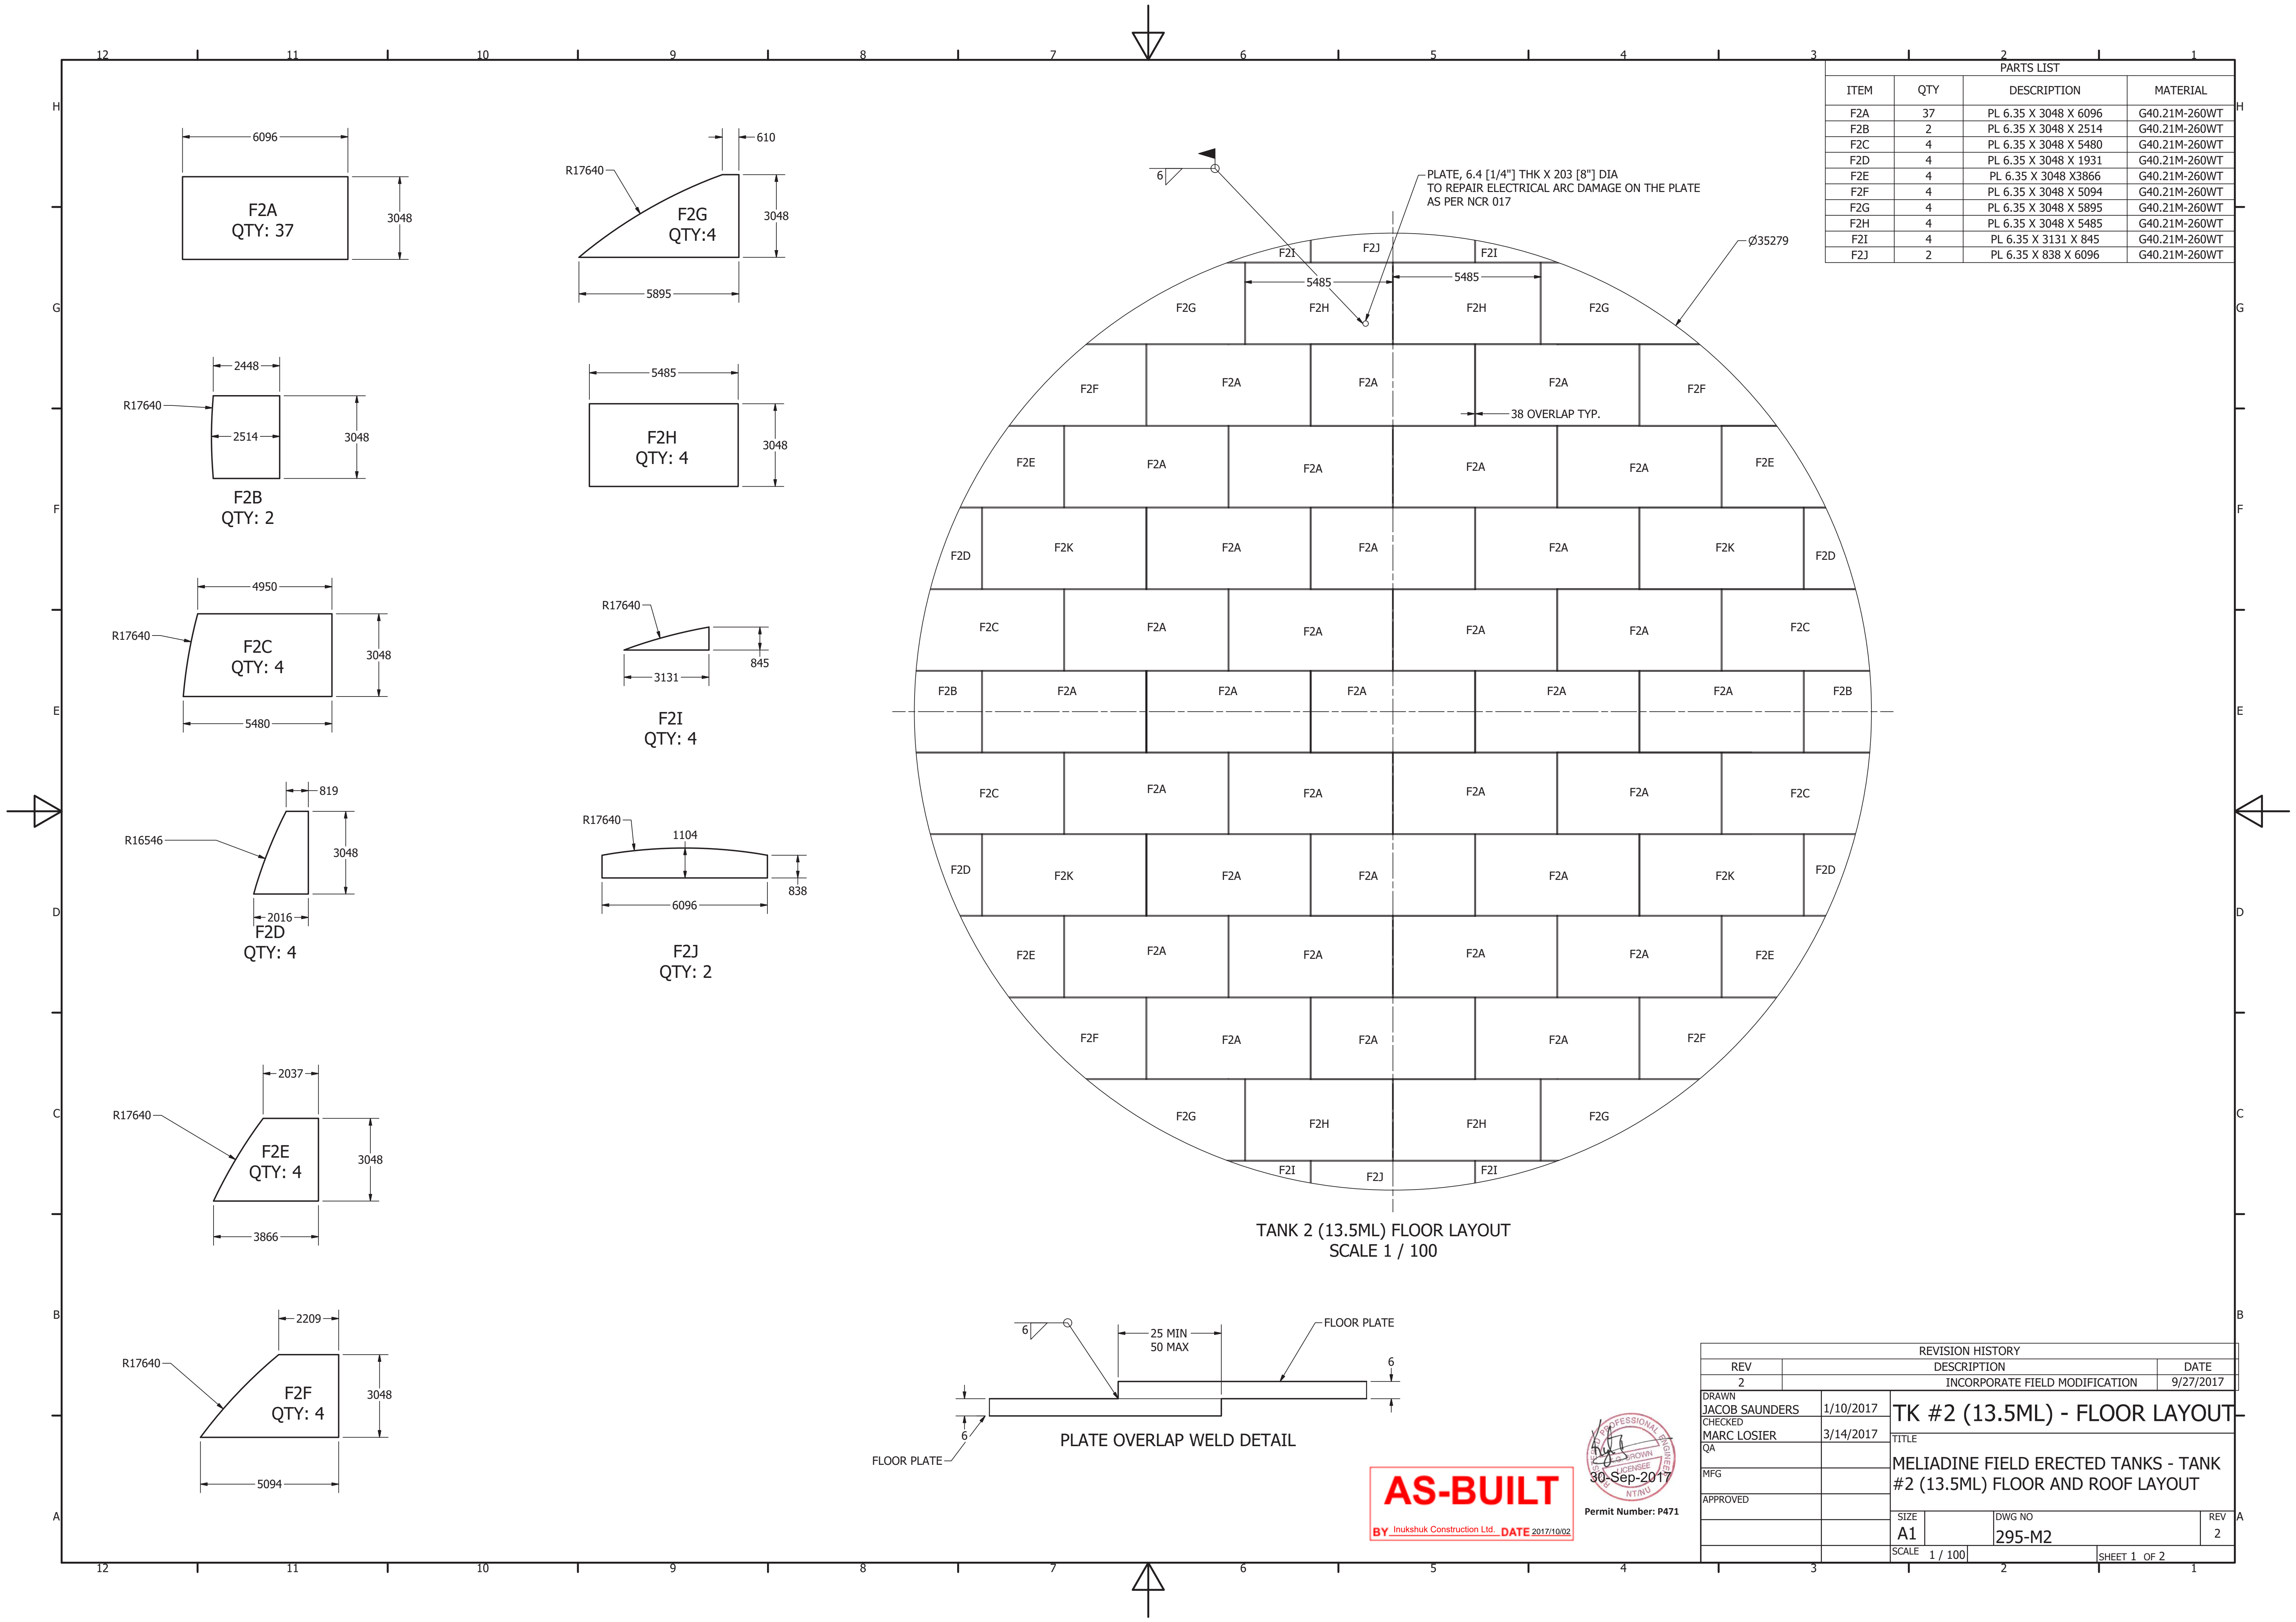

PARTS LIST			
ITEM	QTY	DESCRIPTION	MATERIAL
F2A	37	PL 6.35 X 3048 X 6096	G40.21M-260WT
F2B	2	PL 6.35 X 3048 X 2514	G40.21M-260WT
F2C	4	PL 6.35 X 3048 X 5480	G40.21M-260WT
F2D	4	PL 6.35 X 3048 X 1931	G40.21M-260WT
F2E	4	PL 6.35 X 3048 X3866	G40.21M-260WT
F2F	4	PL 6.35 X 3048 X 5094	G40.21M-260WT
F2G	4	PL 6.35 X 3048 X 5895	G40.21M-260WT
F2H	4	PL 6.35 X 3048 X 5485	G40.21M-260WT
F2I	4	PL 6.35 X 3131 X 845	G40.21M-260WT
F2J	2	PL 6.35 X 838 X 6096	G40.21M-260WT

Ø35279

PLATE, 6.4 [1/4"] THK X 203 [8"] DIA  
TO REPAIR ELECTRICAL ARC DAMAGE ON THE PLATE  
AS PER NCR 017

38 OVERLAP TYP.

TANK 2 (13.5ML) FLOOR LAYOUT  
SCALE 1 / 100


PLATE OVERLAP WELD DETAIL

**AS-BUILT**  
BY Inukshuk Construction Ltd. DATE 2017/10/02



Permit Number: P471

REVISION HISTORY			
REV	DESCRIPTION	DATE	
2	INCORPORATE FIELD MODIFICATION	9/27/2017	
DRAWN JACOB SAUNDERS		1/10/2017	TK #2 (13.5ML) - FLOOR LAYOUT
CHECKED MARC LOSIER		3/14/2017	
QA			
MFG			
APPROVED			MELIADINE FIELD ERECTED TANKS - TANK #2 (13.5ML) FLOOR AND ROOF LAYOUT
		SIZE A1	DWG NO 295-M2
		SCALE 1 / 100	REV 2
		SHEET 1 OF 2	

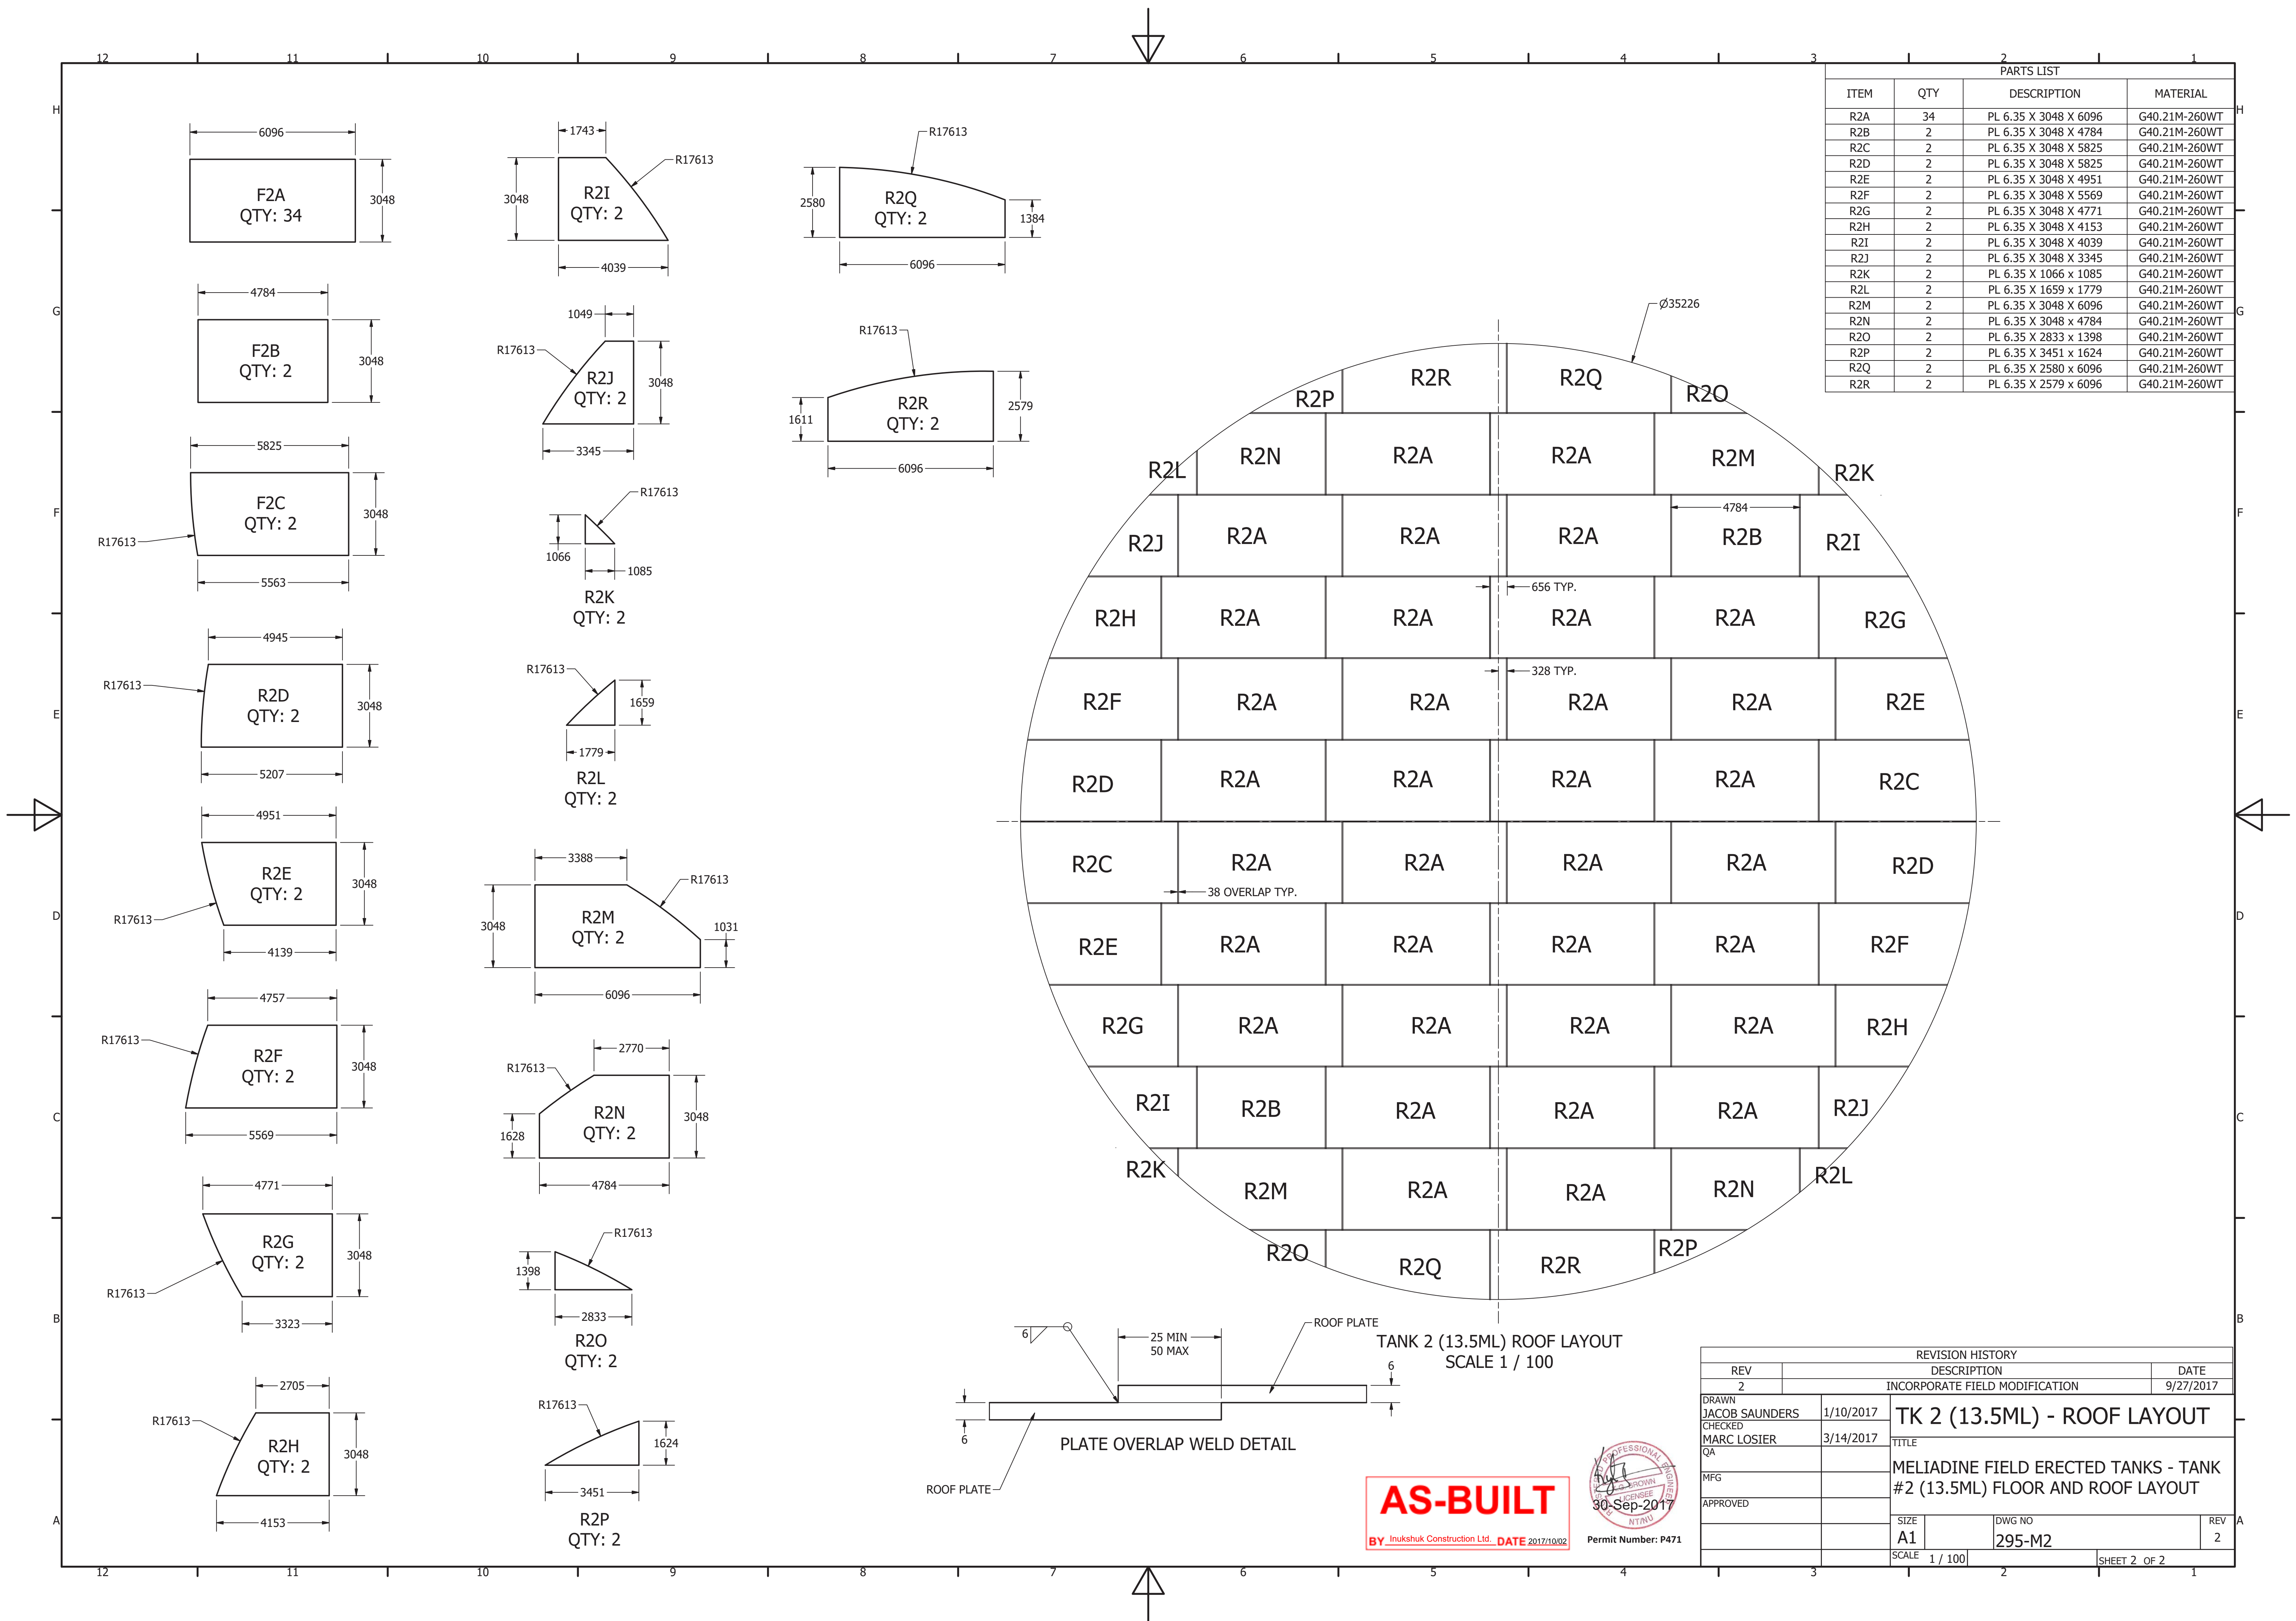


PARTS LIST			
ITEM	QTY	DESCRIPTION	MATERIAL
R2A	34	PL 6.35 X 3048 X 6096	G40.21M-260WT
R2B	2	PL 6.35 X 3048 X 4784	G40.21M-260WT
R2C	2	PL 6.35 X 3048 X 5825	G40.21M-260WT
R2D	2	PL 6.35 X 3048 X 5825	G40.21M-260WT
R2E	2	PL 6.35 X 3048 X 4951	G40.21M-260WT
R2F	2	PL 6.35 X 3048 X 5569	G40.21M-260WT
R2G	2	PL 6.35 X 3048 X 4771	G40.21M-260WT
R2H	2	PL 6.35 X 3048 X 4153	G40.21M-260WT
R2I	2	PL 6.35 X 3048 X 4039	G40.21M-260WT
R2J	2	PL 6.35 X 3048 X 3345	G40.21M-260WT
R2K	2	PL 6.35 X 1066 x 1085	G40.21M-260WT
R2L	2	PL 6.35 X 1659 x 1779	G40.21M-260WT
R2M	2	PL 6.35 X 3048 X 6096	G40.21M-260WT
R2N	2	PL 6.35 X 3048 x 4784	G40.21M-260WT
R2O	2	PL 6.35 X 2833 x 1398	G40.21M-260WT
R2P	2	PL 6.35 X 3451 x 1624	G40.21M-260WT
R2Q	2	PL 6.35 X 2580 x 6096	G40.21M-260WT
R2R	2	PL 6.35 X 2579 x 6096	G40.21M-260WT

REVISION HISTORY		
REV	DESCRIPTION	DATE
2	INCORPORATE FIELD MODIFICATION	9/27/2017
TK 2 (13.5ML) - ROOF LAYOUT		
MELIADINE FIELD ERECTED TANKS - TANK #2 (13.5ML) FLOOR AND ROOF LAYOUT		
TITLE		
MFG		
APPROVED		
SIZE		
DWG NO		
REV		
SCALE		
SHEET 2 OF 2		


**AS-BUILT**  
BY Inukshuk Construction Ltd. DATE 2017/10/02

Permit Number: P471




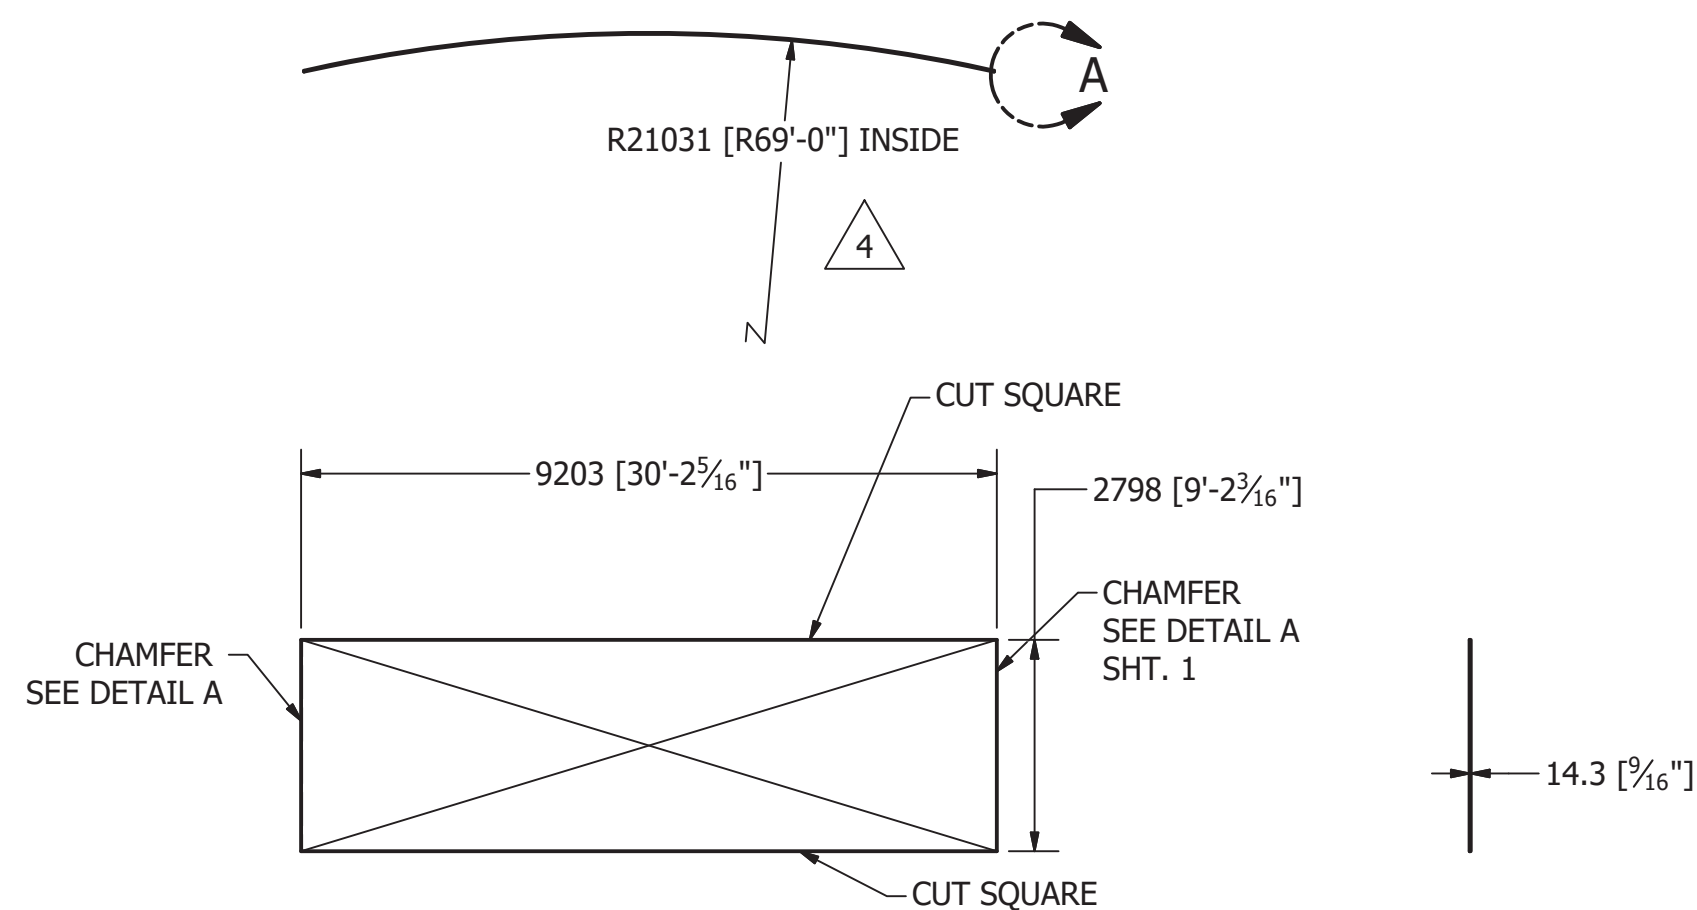



DEVELOP VIEW  
COURSE NO. 1 (BOTTOM) 14.3mm THK (9/16")  
CUT FROM PLATE 2874mm x 9269mm  
QTY: 12  
MARK 7201

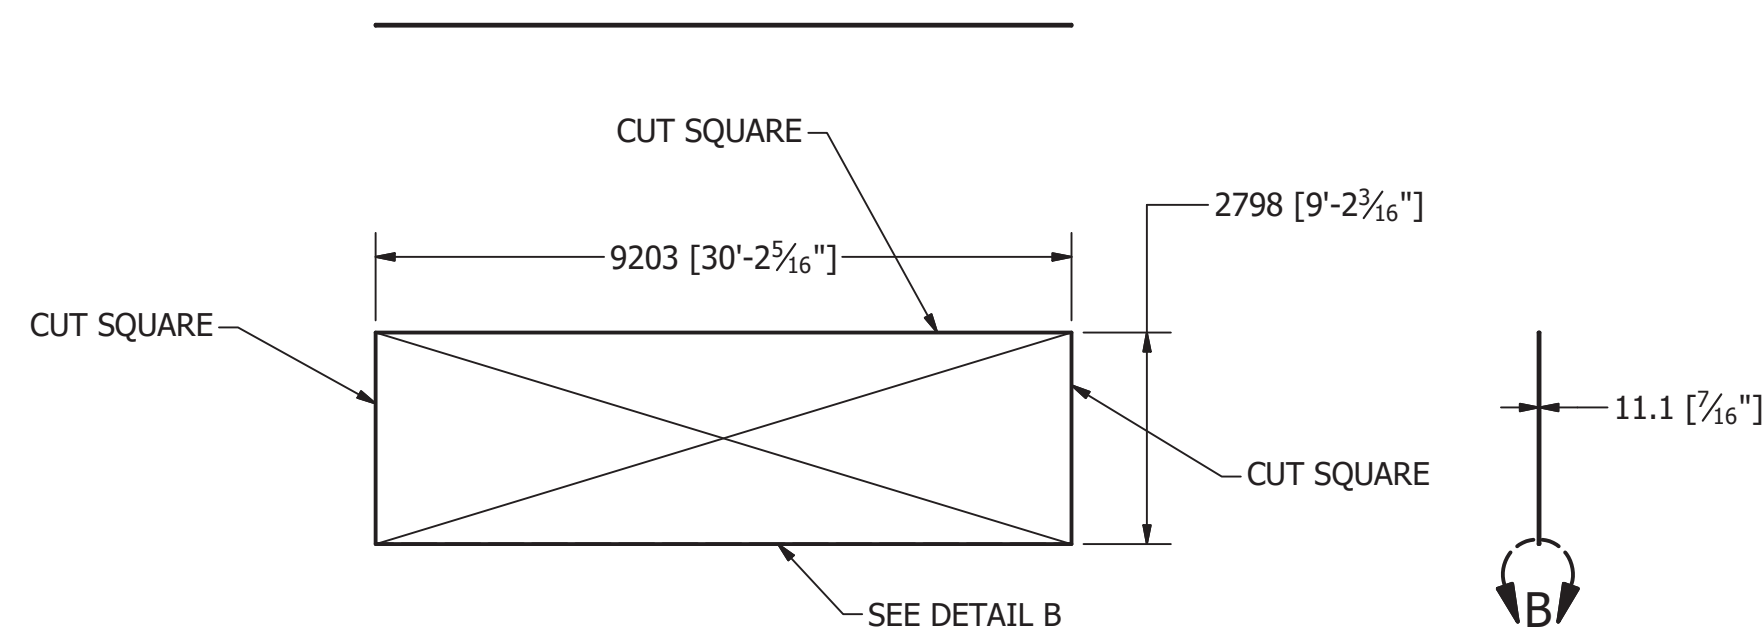


DEVELOP VIEW  
COURSE NO. 2 - 11.1mm THK (7/16")  
CUT FROM PLATE 2874mm x 9269mm  
QTY: 12  
MARK 7202

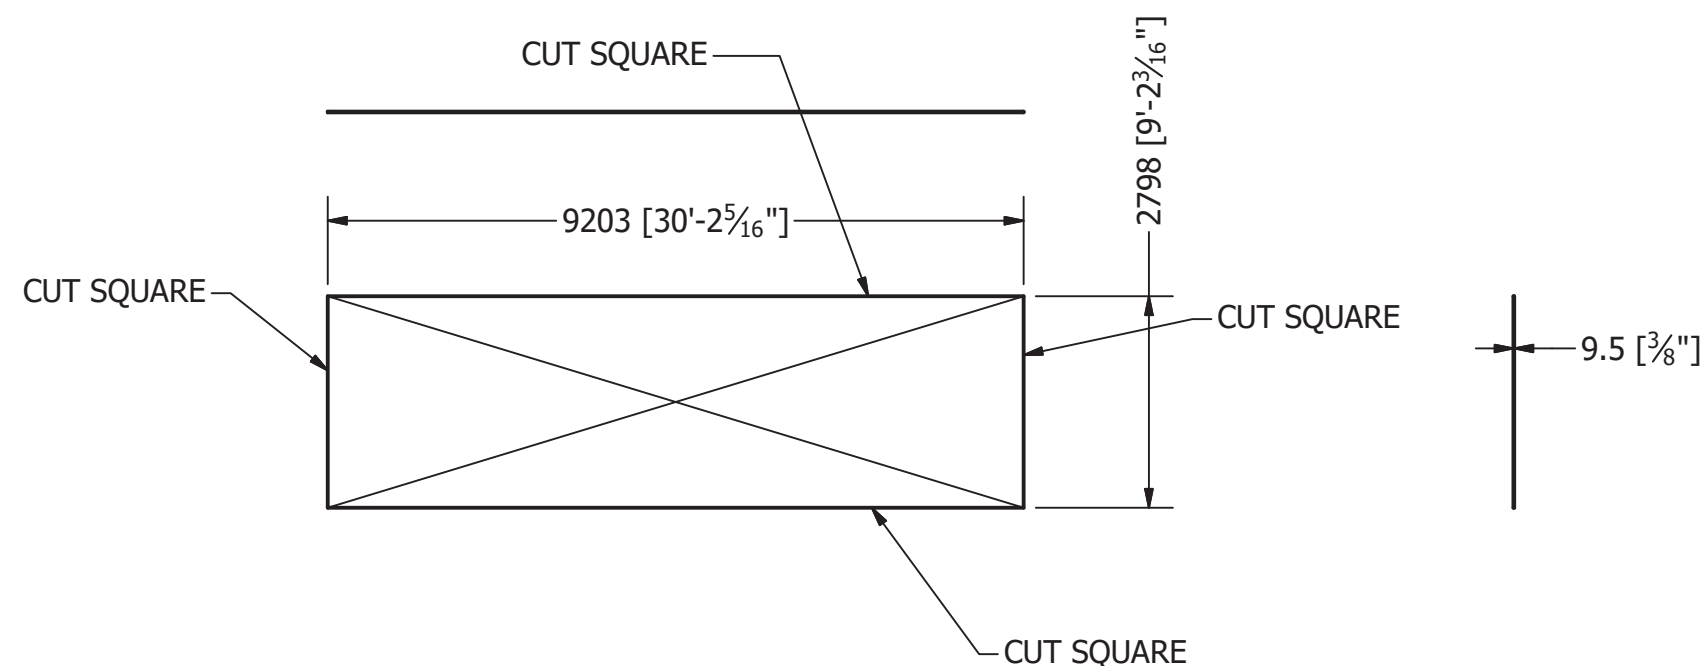

DEVELOP VIEW  
COURSE NO. 3, 4, & 5 - 9.5mm THK (3/8")  
CUT FROM PLATE 2874mm x 9269mm  
QTY: 36  
MARK 7203

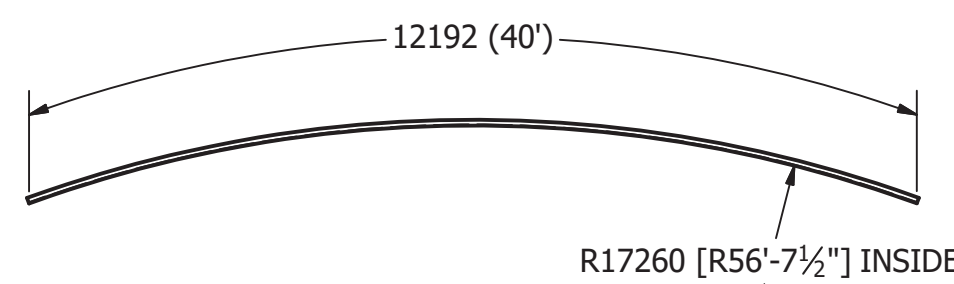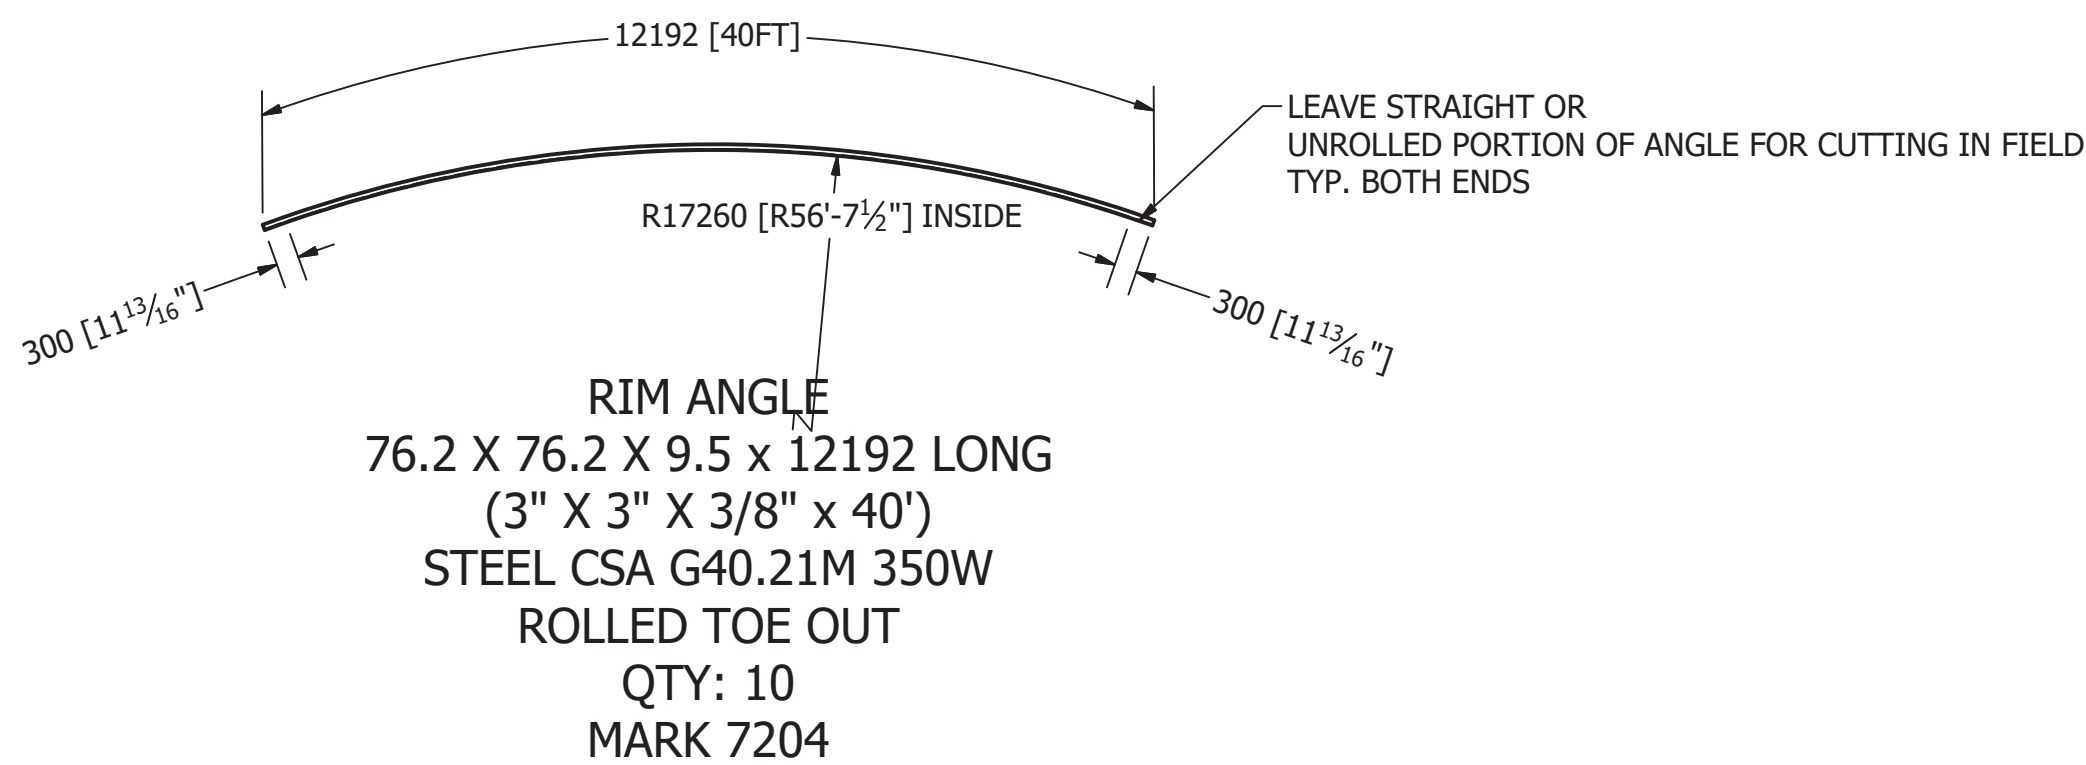

ROOF TOP HANDRAIL ANGLE  
50.8 X 50.8 X 6.4 (2" X 2" X 1/4")  
STEEL CSA G40.21M 350W  
ROLLED TOE OUT  
QTY: 10  
MARK 7205

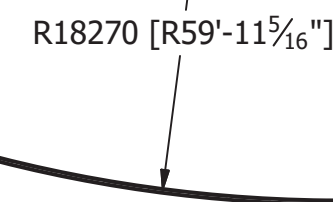


STAIRWAY HANDRAIL ANGLE  
50.8 X 50.8 X 6.4 X 6096MM  
(2" X 2" X 1/4" X 20' LONG)  
STEEL CSA G40.21M 350W  
QTY: 5  
MARK 7206

NOTES:


ONLY COURSE NO. 1 SHELL PLATES REQUIRE SHOP ROLLING FOR TANK NO.2

SHELL PLATES TO BE CHECKED CORNER TO CORNER FOR SQUARENESS

STEEL PLATES: 38WT SUPPLIED BY MEL  
STEEL SHAPES: 350W SUPPLIED BY FORMATECH

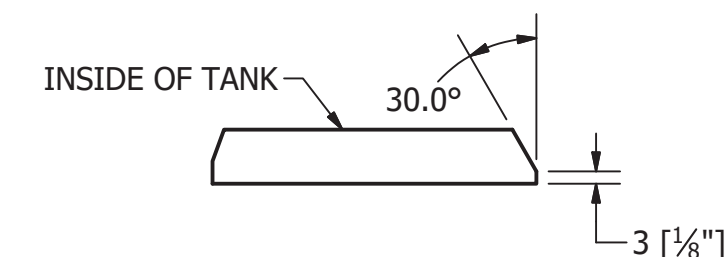

DETAIL A  
COURSE NO. 1 VERT. PREP.  
TYP. BOTH ENDS  
SCALE 1 / 2

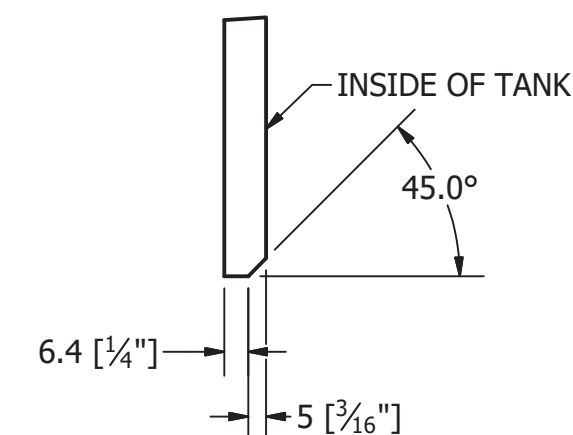



DETAIL B  
COURSE NO. 2  
BOTTOM EDGE PREP.  
SCALE 1 / 2

**AS-BUILT**  
BY Inukshuk Construction Ltd. DATE 2017/10/02

PROFESSIONAL  
ENGINEER  
30-Sep-2017  
Permit Number: P471

REVISION HISTORY			
ZONE	REV	DESCRIPTION	DATE
2D, 2F, 10B, 10D, 10G	3	DETAIL A & B MODIFIED, COURSE NO. 2 VERT EDGE PREP. REM., COURSE NO. 3, 4, 5 HOR. EDGE PREP. REM.	2/14/2017
10H	4	COURSE NO. 1 RAD. CHANGED	2/14/2017
DRAWN Marc Losier		2/2/2017	TANK NO. 2 - 13,500 CUM
CHECKED Jacob Saunders		2/2/2017	
QA			MELIADINE FIELD ERECTED TANKS - SHELL PLATES AND ANGLES ROLLING DETAILS
MFG			
APPROVED			SIZE A1
		DWG NO 295-M7	REV 4
		SCALE	SHEET 2 OF 6

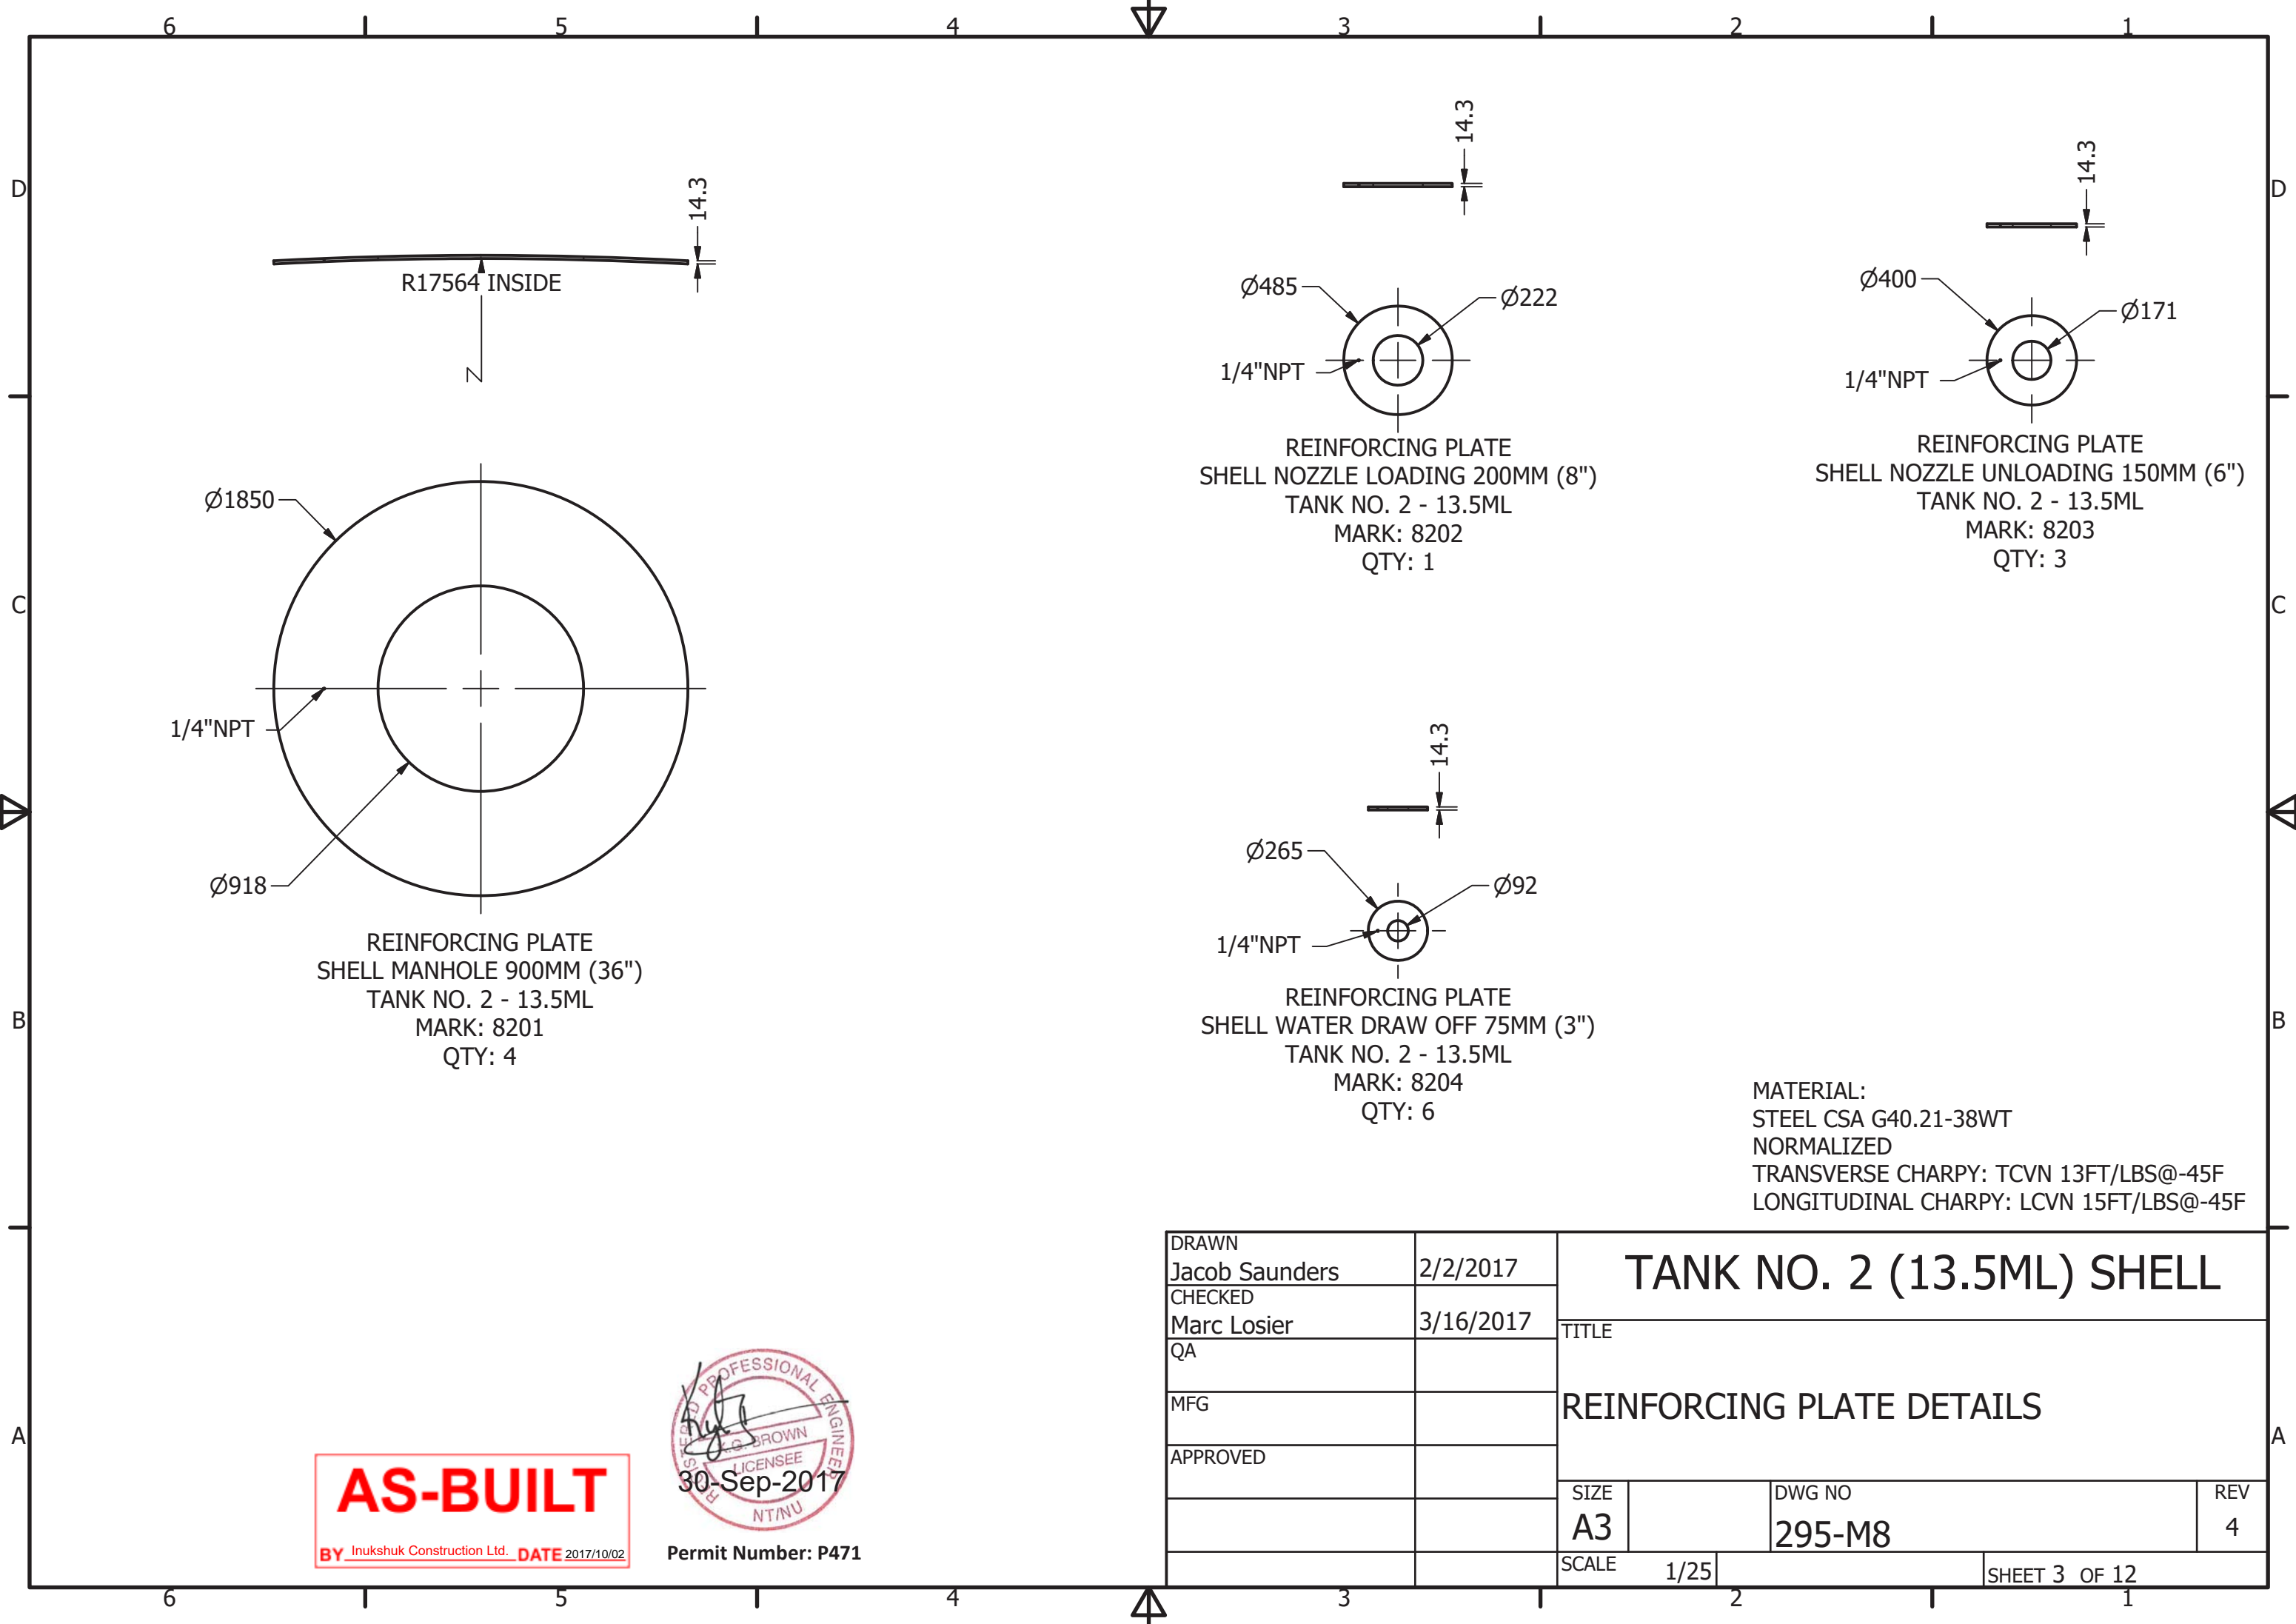

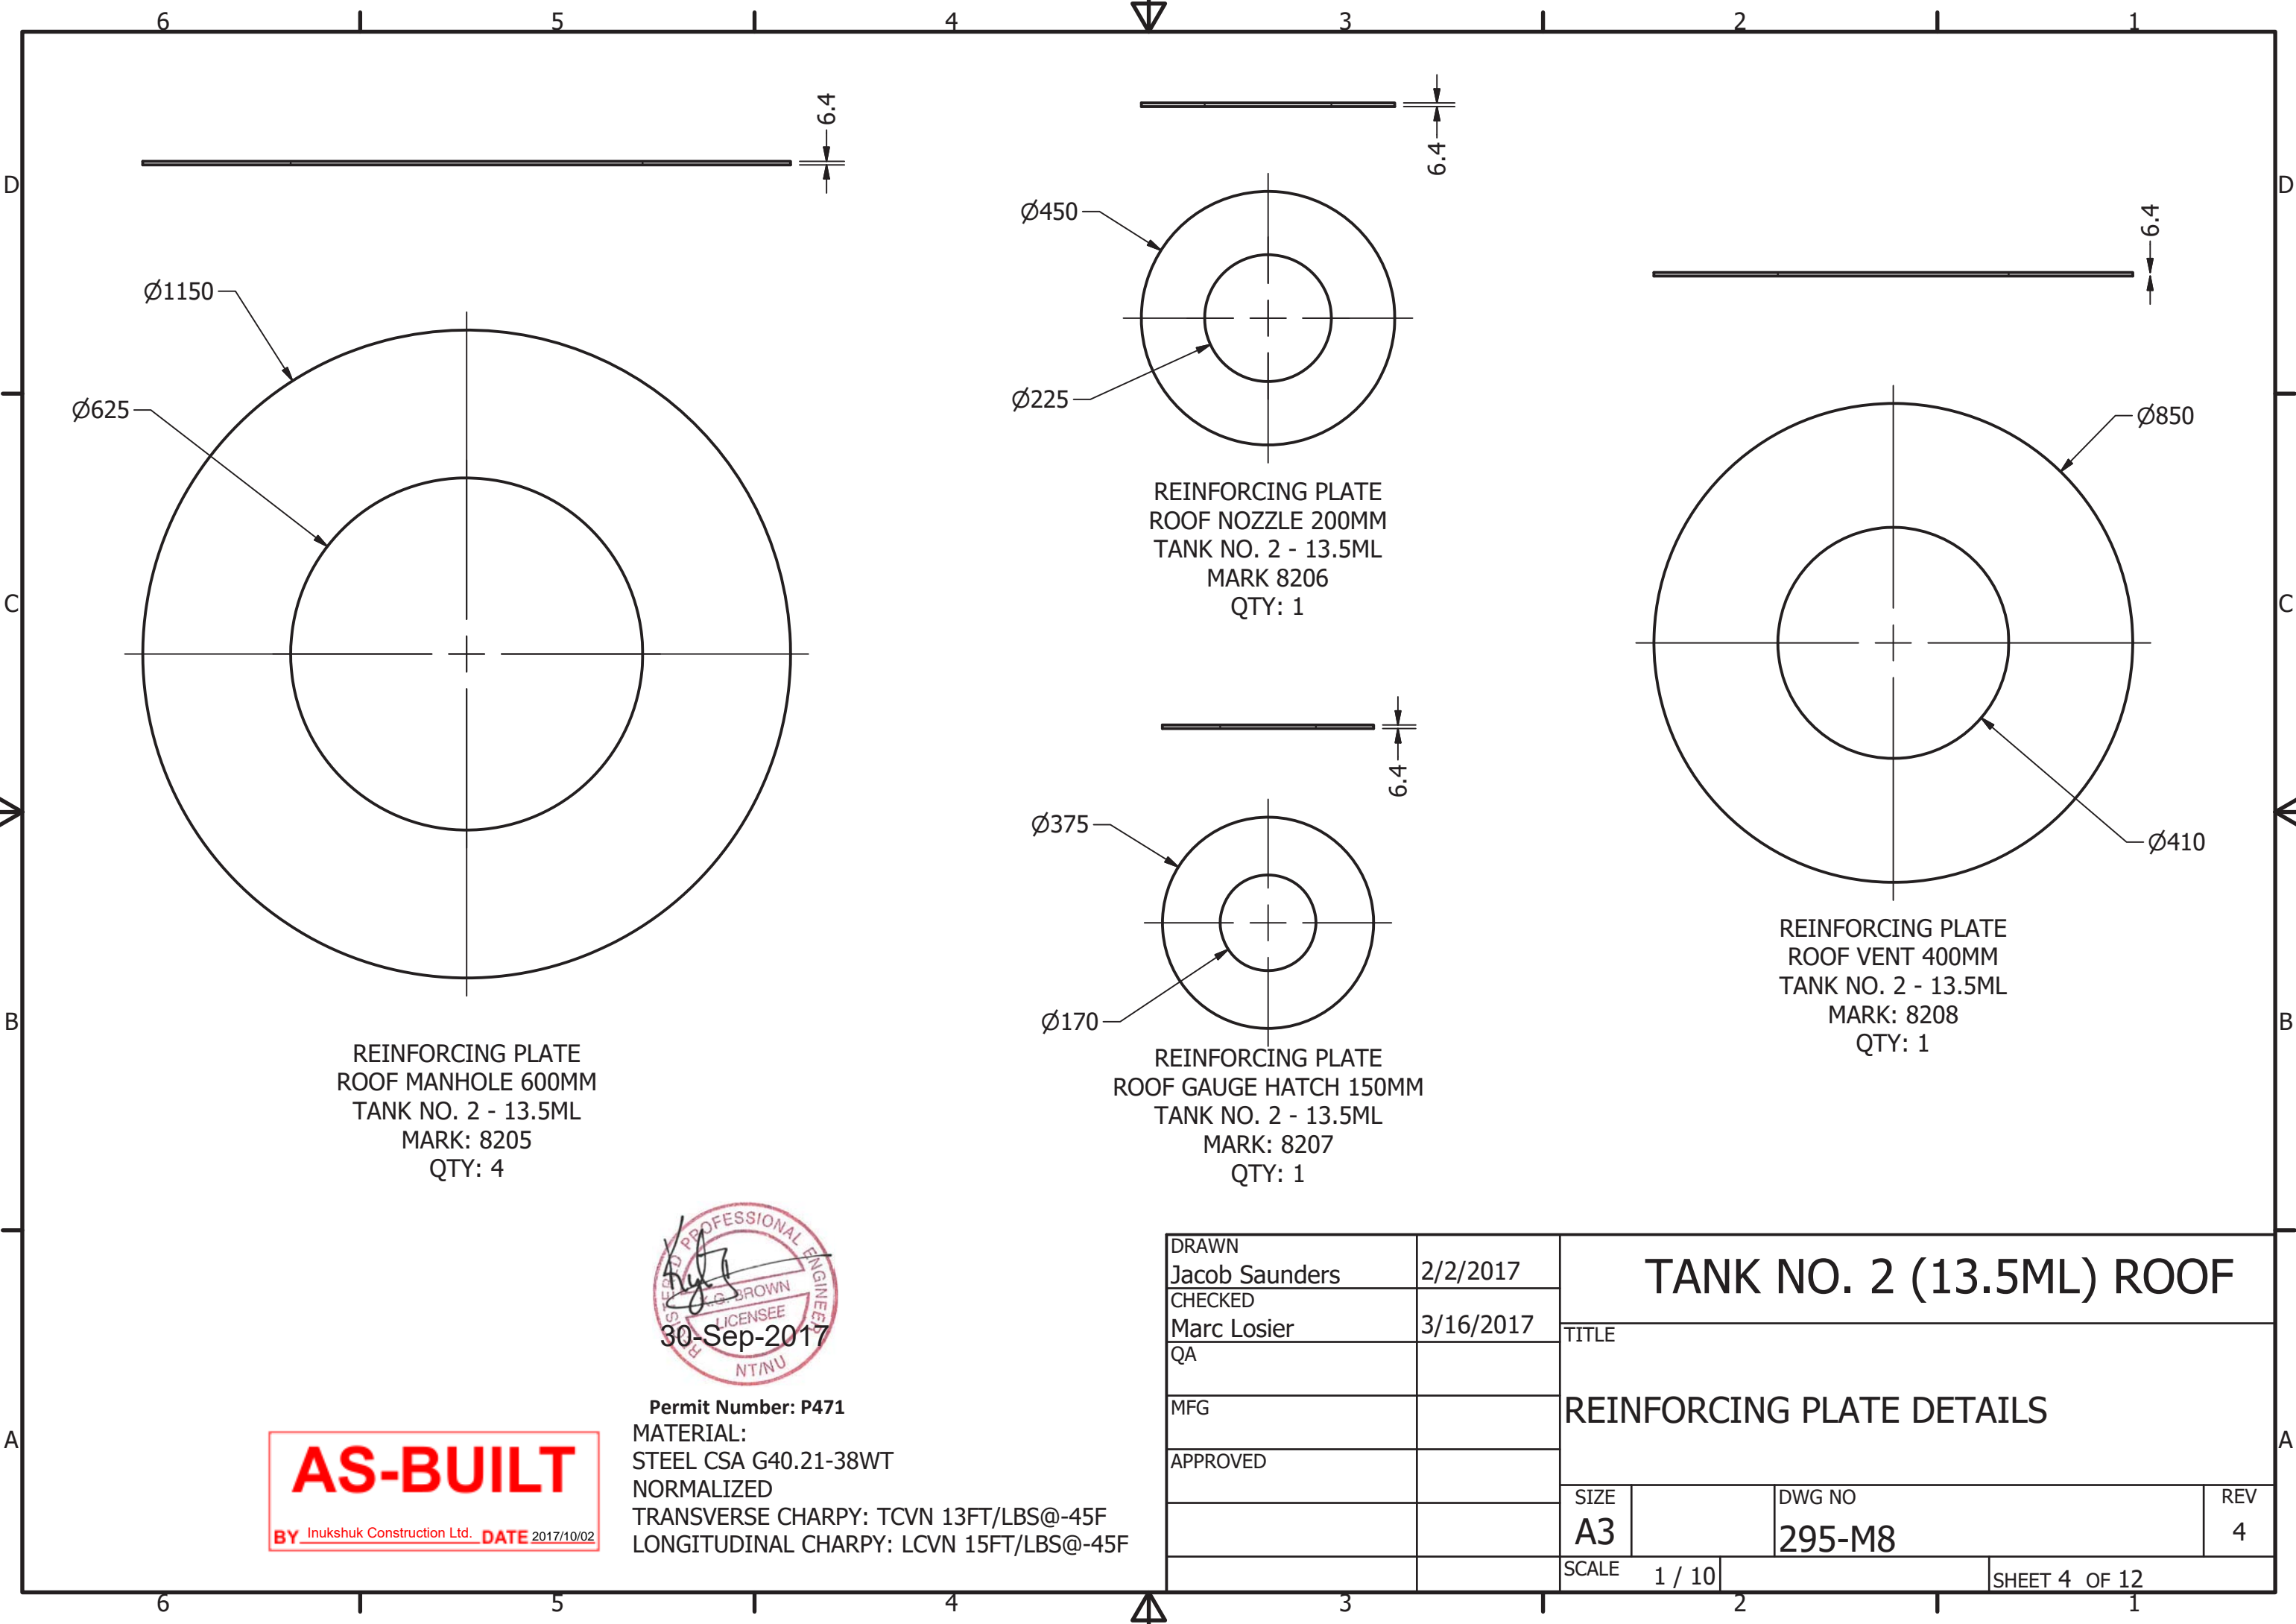


**AS-BUILT**  
BY Inukshuk Construction Ltd. DATE 2017/10/02



Permit Number: P471  
MATERIAL:  
STEEL CSA G40.21-38WT  
NORMALIZED  
TRANSVERSE CHARPY: TCVN 13FT/LBS@-45F  
LONGITUDINAL CHARPY: LCVN 15FT/LBS@-45F



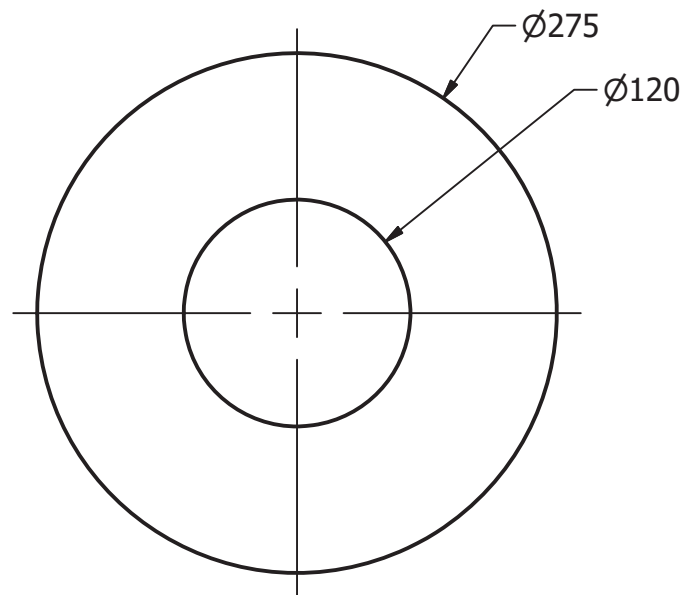


M81201 QTY	
Tank No.	QTY
1	1
2	1
3	1
4	1
5	1
6	1
TOTAL	6



REINFORCING PLATE  
100NS ROOF NOZZLE  
QTY: 6  
1 PER TANK  
MARK 81201  
SCALE 1/4

MATERIAL:  
STEEL CSA G40.21-300W

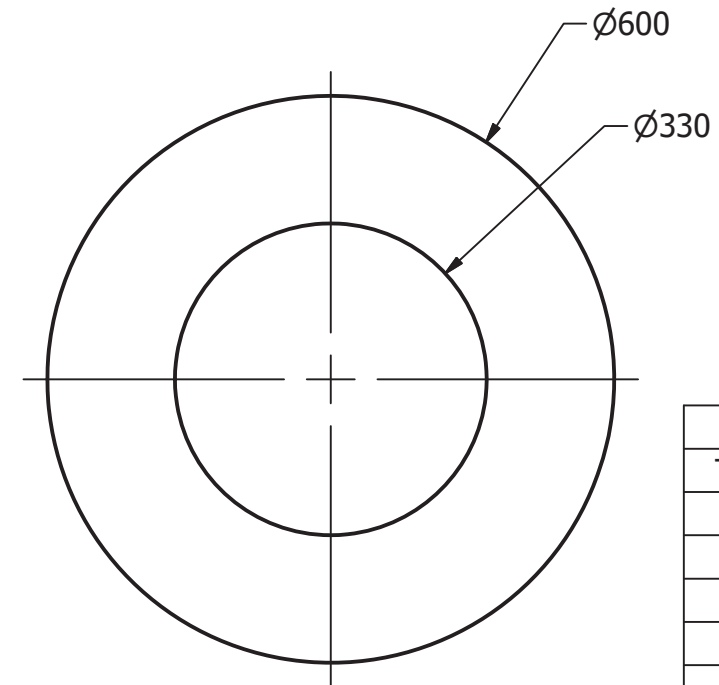

M81202 QTY	
Tank No.	QTY
1	2
2	1
3	0
4	0
5	0
6	0
TOTAL	10


REINFORCING PLATE  
300NS ROOF NOZZLE FOR PV VENT  
QTY: 10  
MARK 81202  
SCALE 1/8

**AS-BUILT**  
BY Inukshuk Construction Ltd. DATE 2017/10/02







Permit Number: P471

REVISION HISTORY				
REV	DESCRIPTION			DATE
4	THIS SHEET ADDED			7/7/2017
DRAWN Jacob Saunders		2/2/2017	REINFORCING PAD FOR ECN-001	
CHECKED Marc Losier		3/16/2017		
QA				
MFG				
APPROVED			REINFORCING PLATE DETAILS	
			SIZE A3	DWG NO 295-M8
			SCALE 1/4	REV 4
SHEET 13 OF 13				

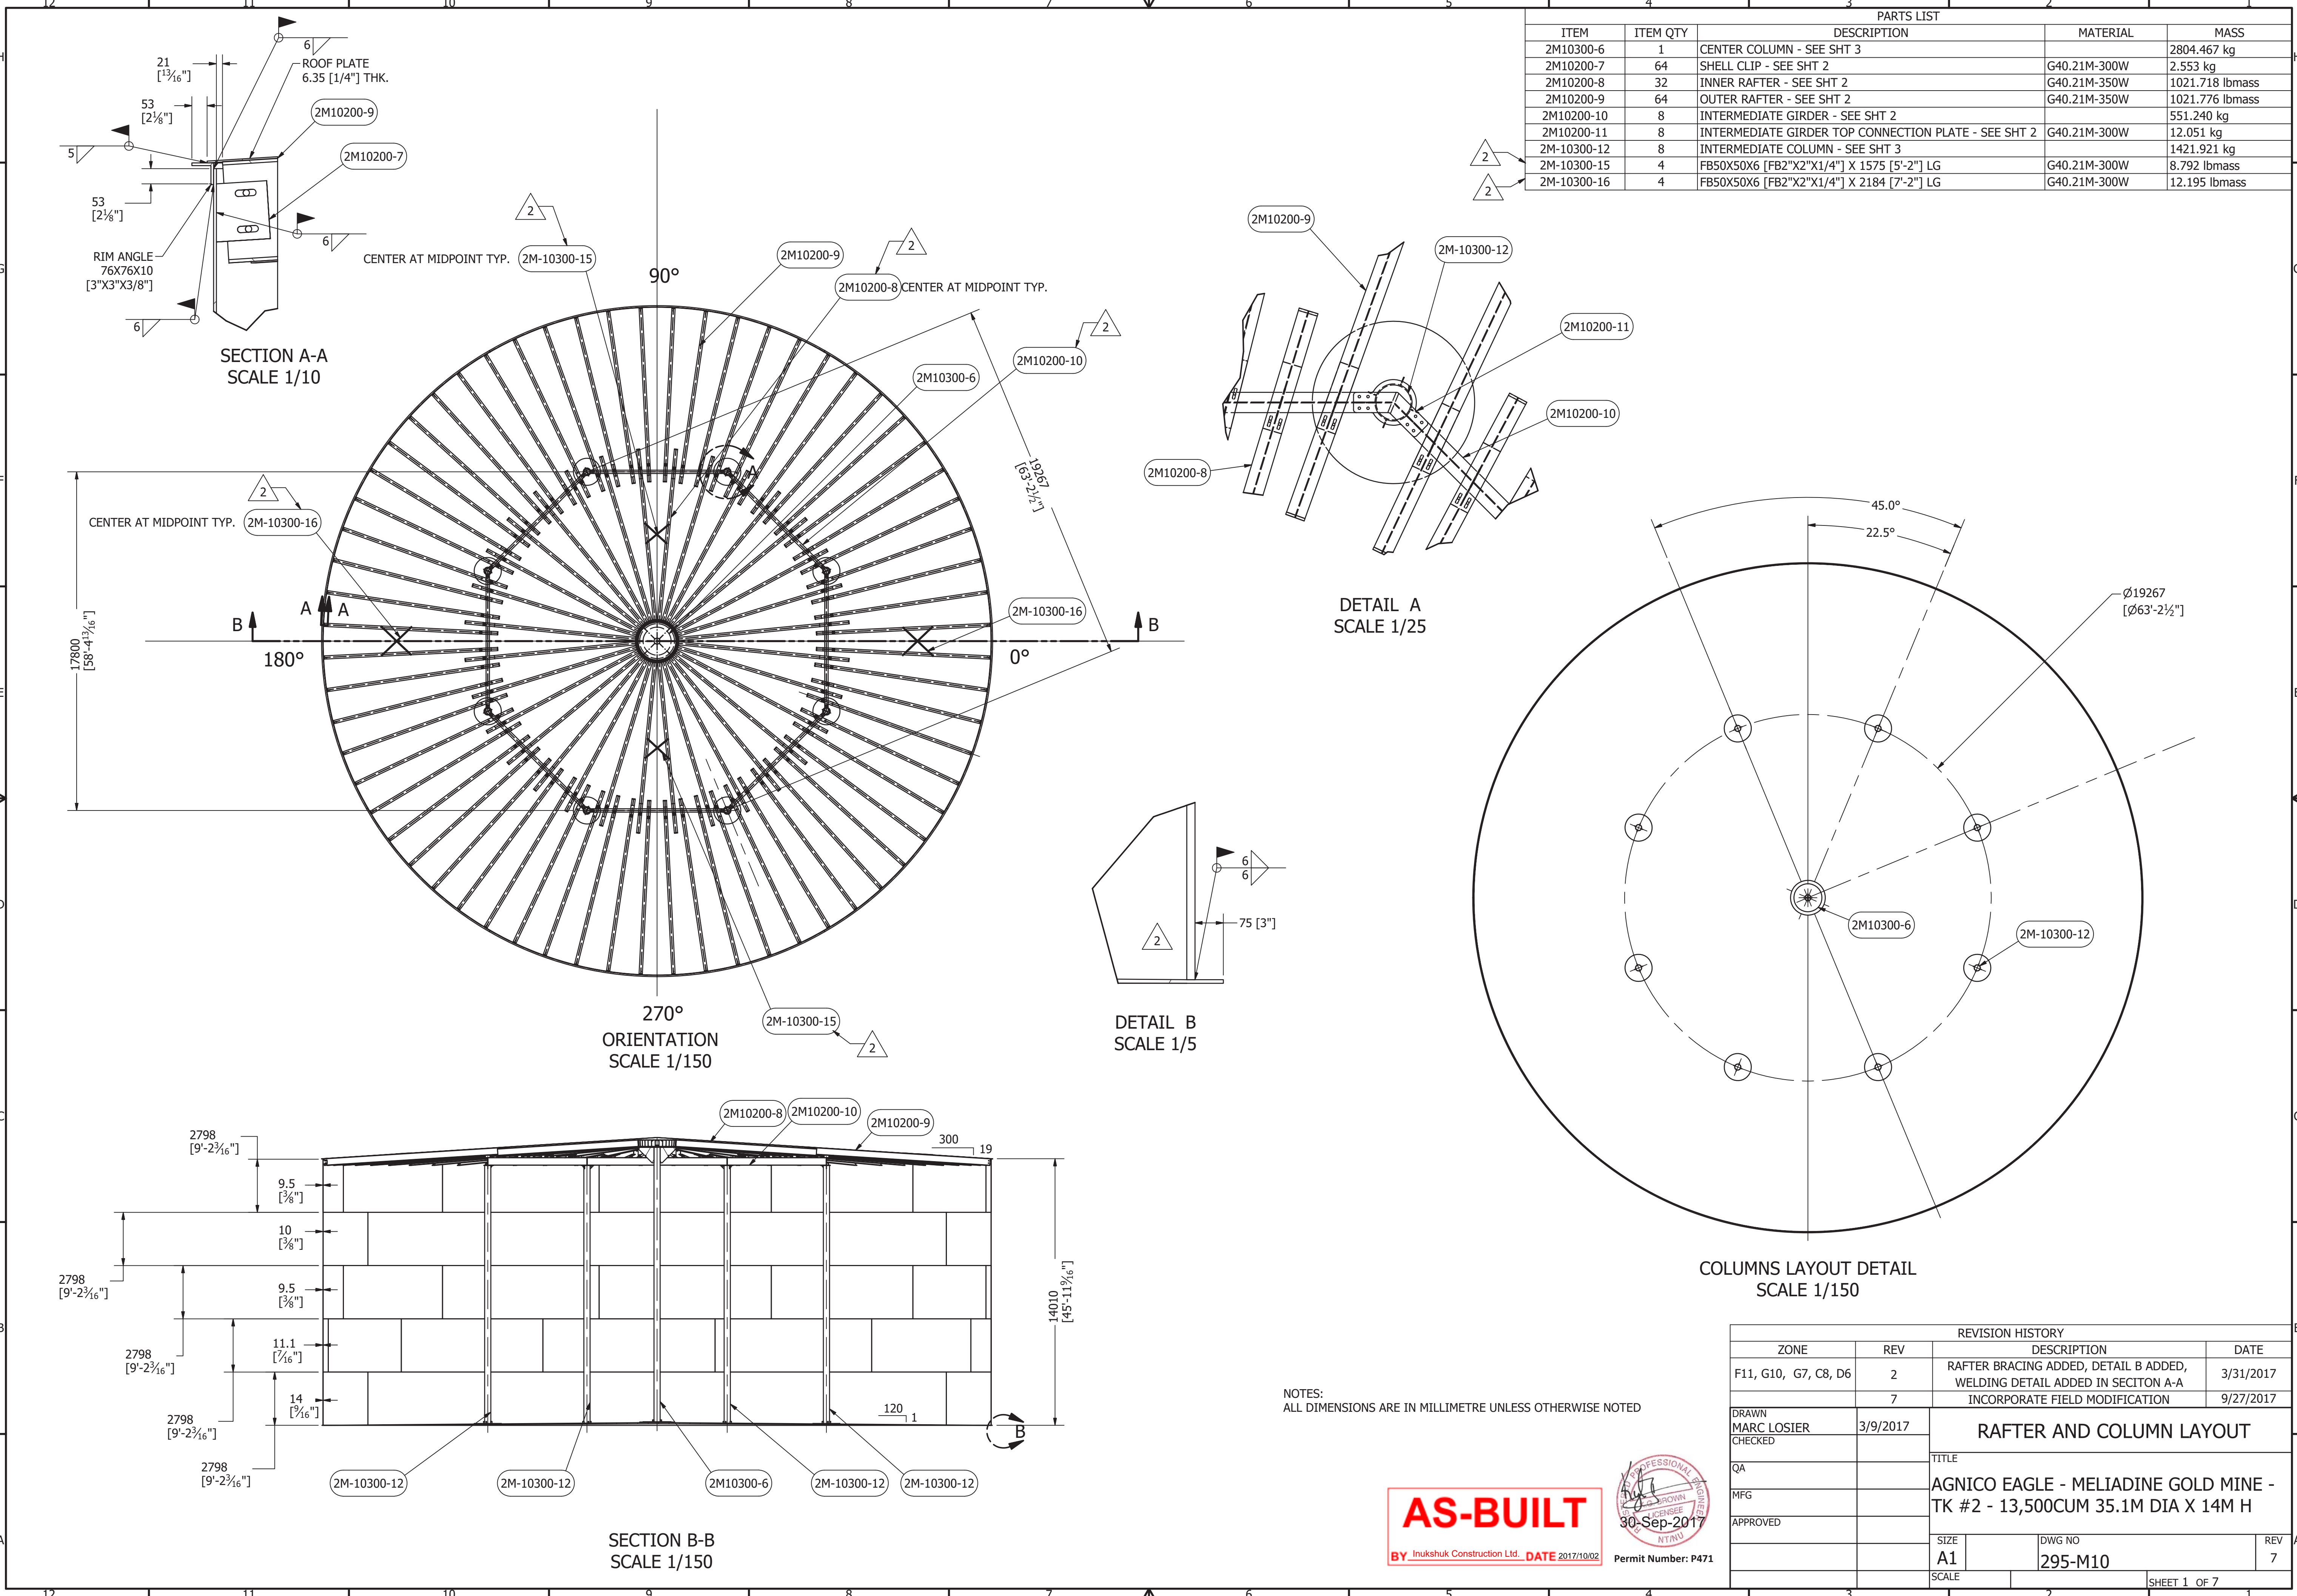






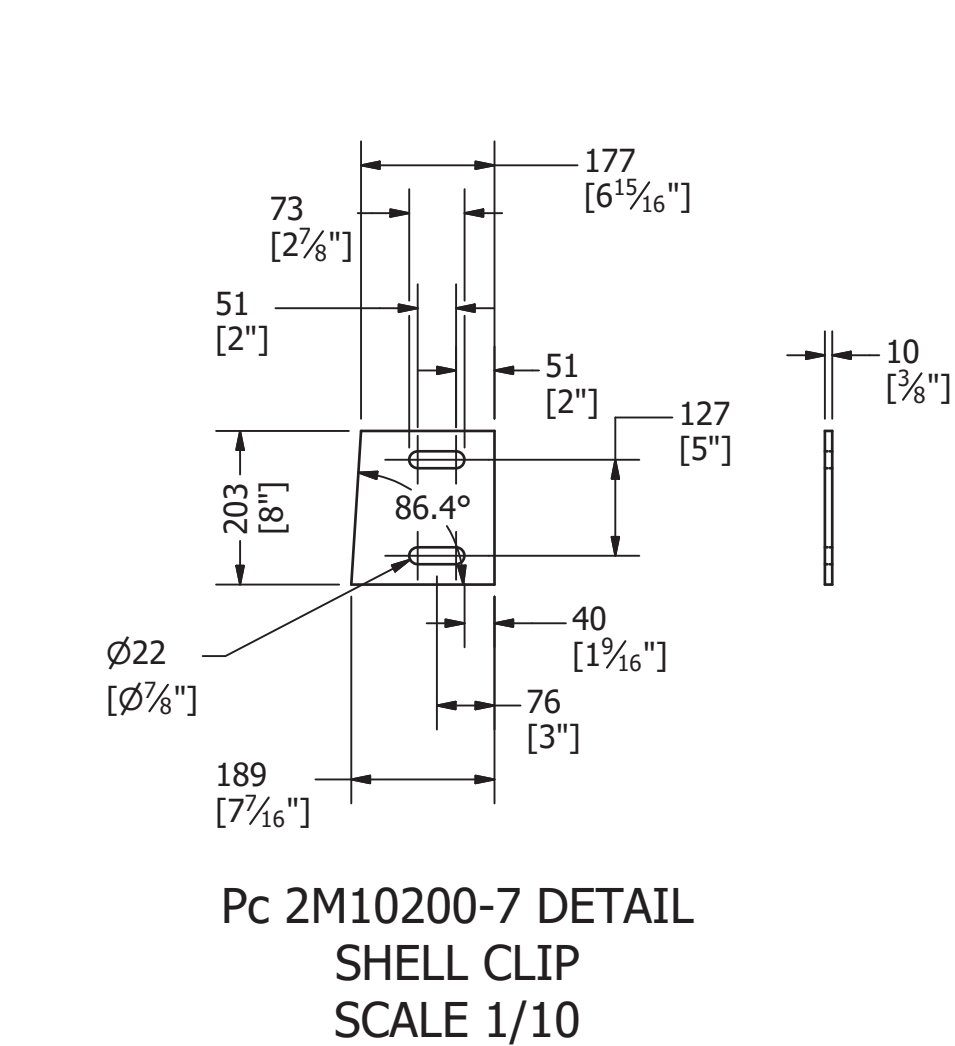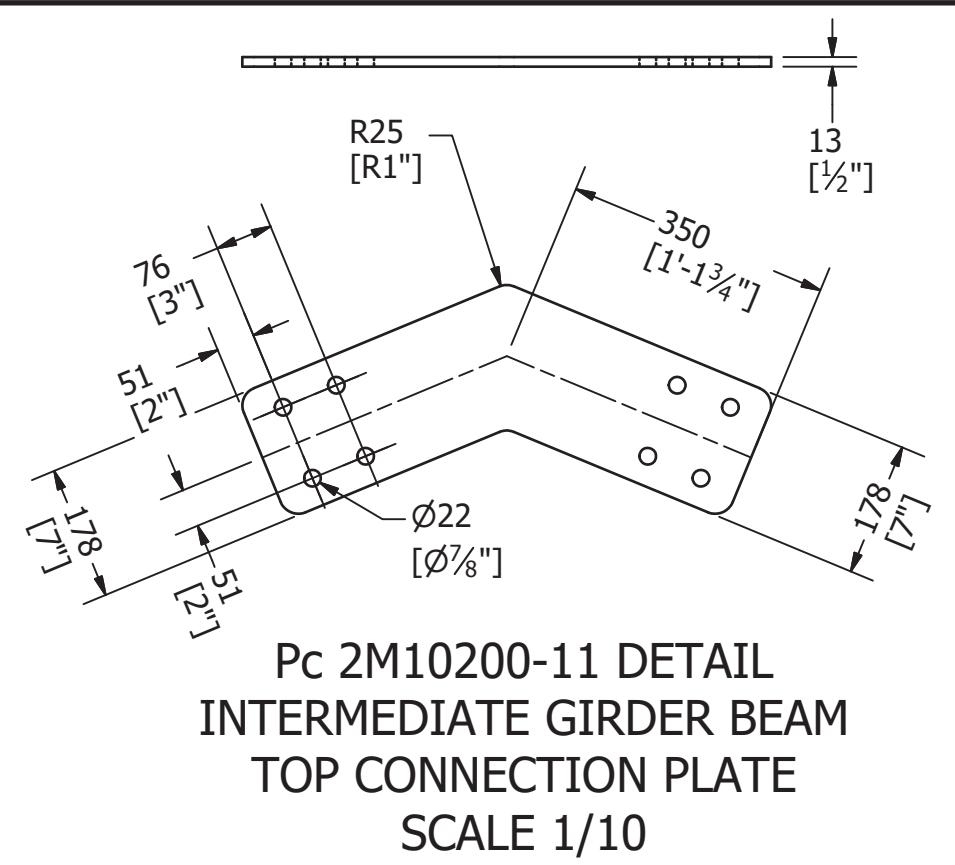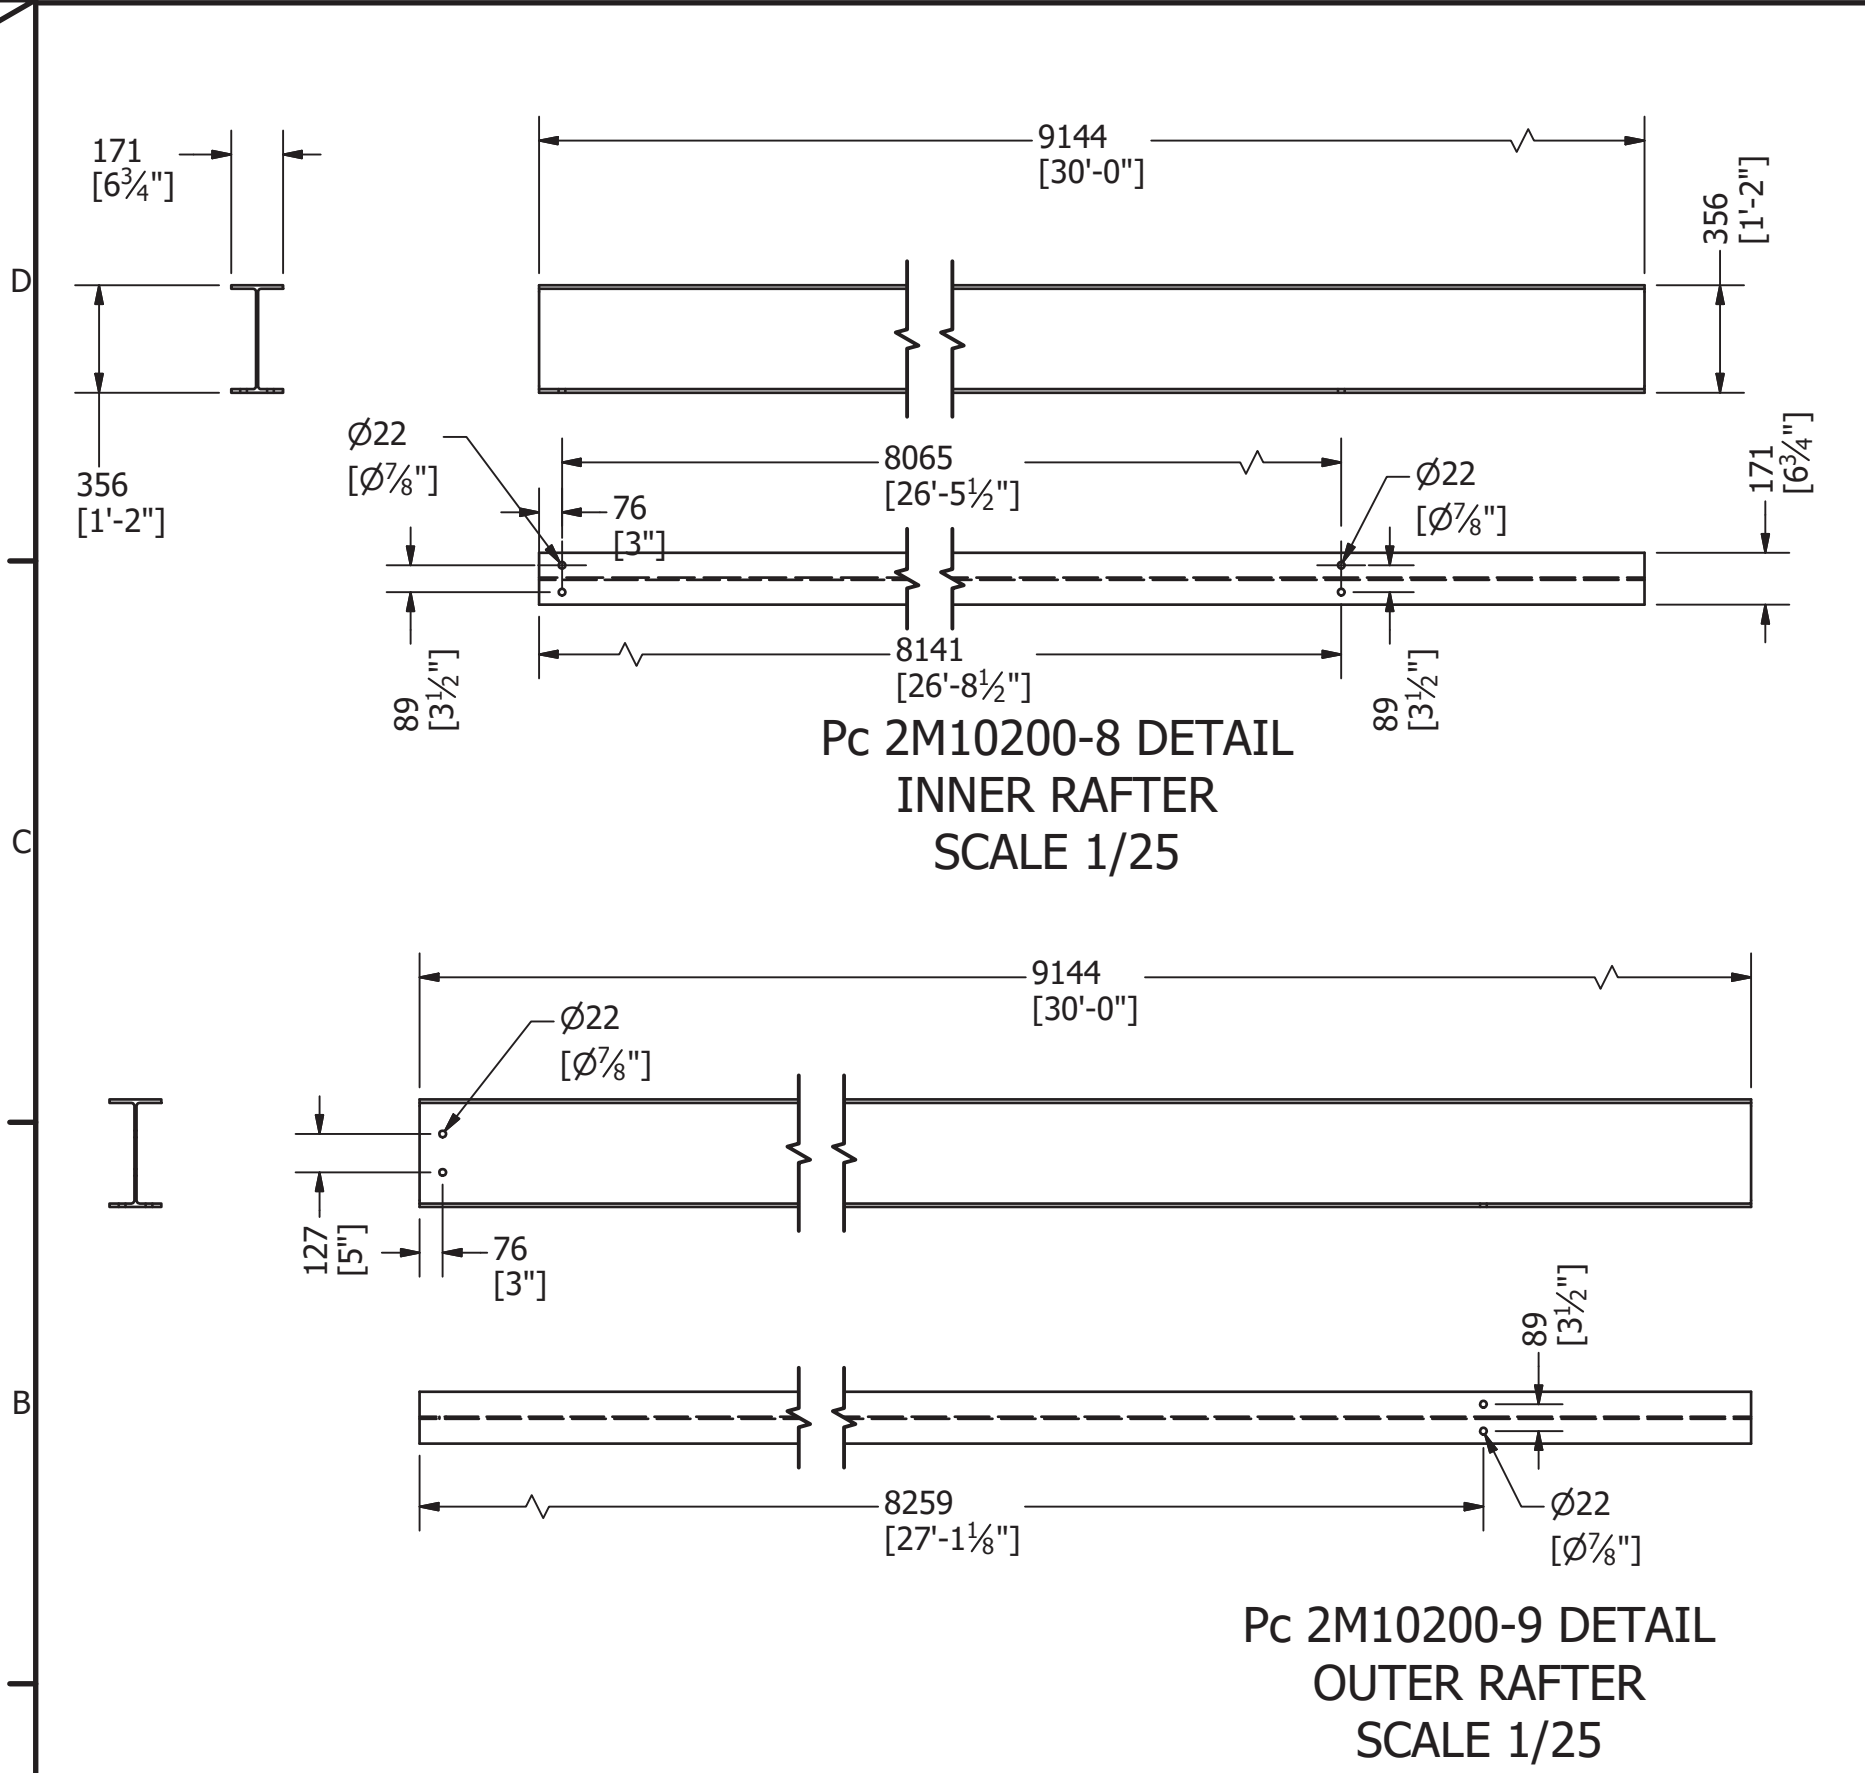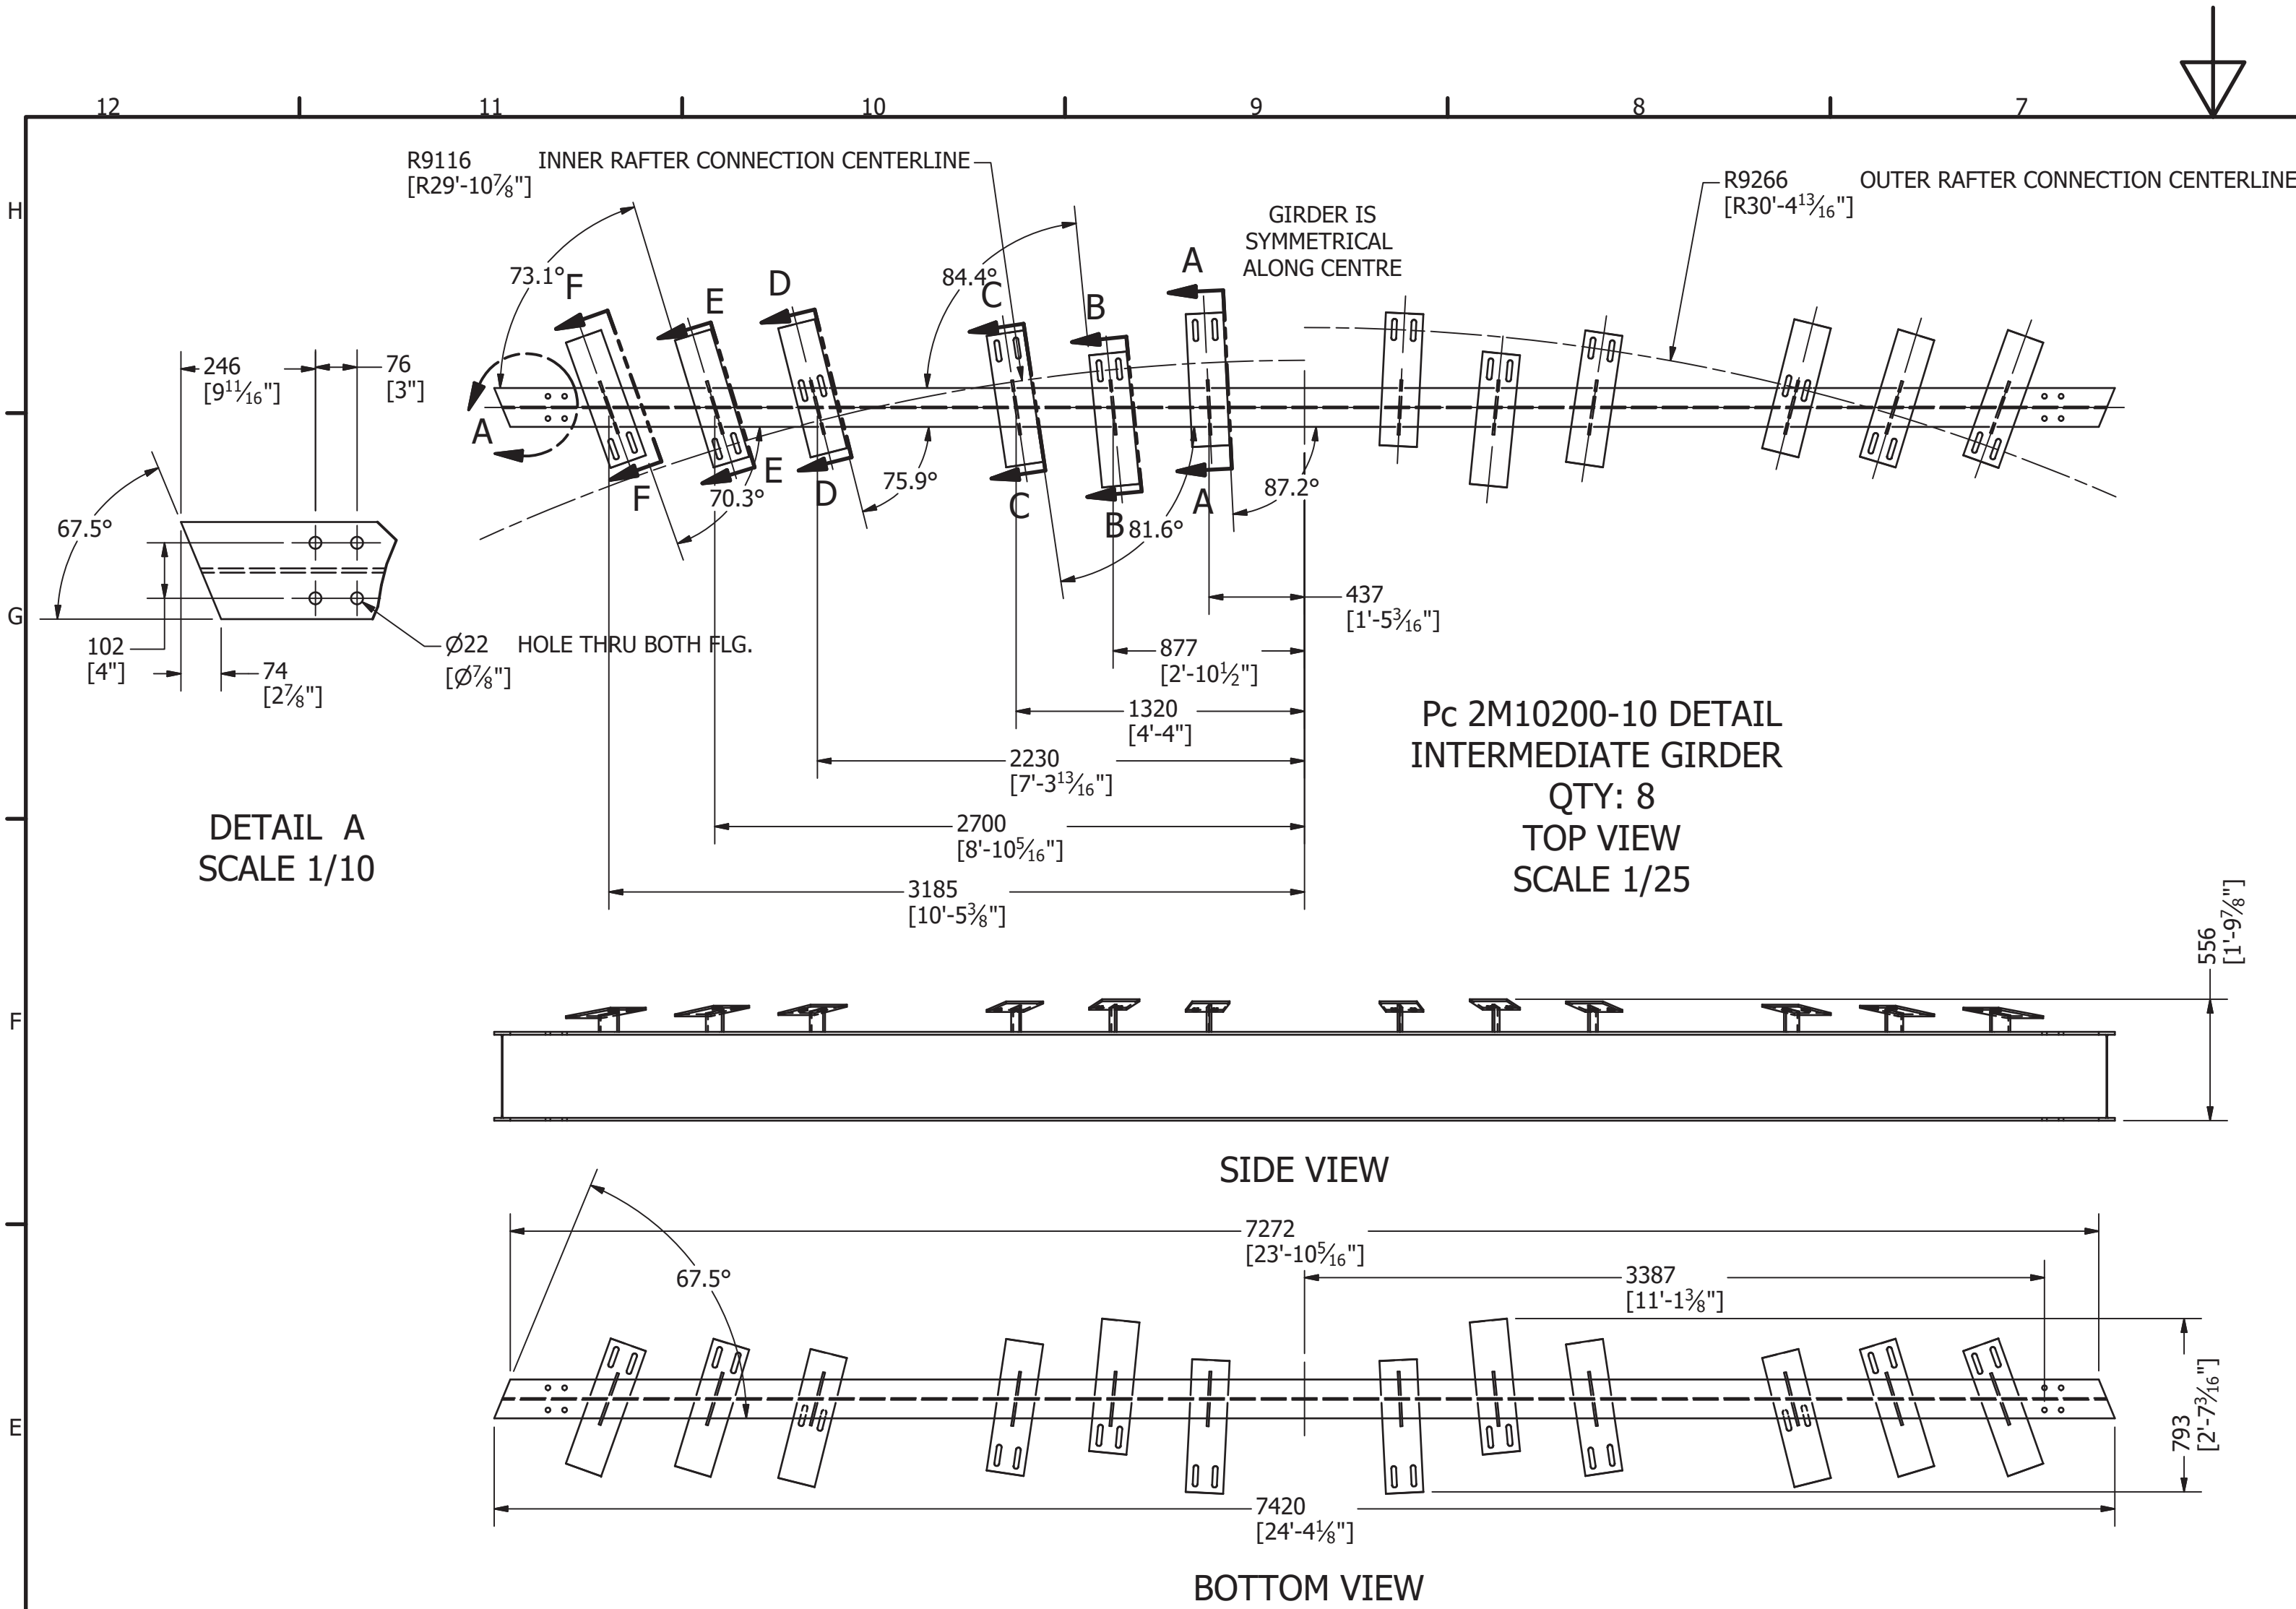

BILL OF MATERIAL				
ITEM	ITEM QTY	DESCRIPTION	MATERIAL	MASS
2M10200-7	64	10 [3/8"] THK X 189 [7 1/2"] WD X 203 [8"] LG	G40.21M-300W	2.553 kg
2M10200-8	32	W360X51 [W14"x34#] 9144 [30'-0"]	G40.21M-350W	1021.718 lbmass
2M10200-9	64	W360X51 [W14"x34#] 9144 [30'-0"]	G40.21M-350W	1021.776 lbmass
2M10200-11	8	13 [1/2"] THK X 357 [1'-2"] WD X 573 [1'-10 1/2"] LG	G40.21M-300W	12.051 kg

BILL OF MATERIAL - INTERMEDIATE GIRDER ASSEMBLY				
MARK	ITEM QTY	DESCRIPTION	MATERIAL	MASS
2M10201	1	W410X60 [W16"x40#] X 7420 [24'- 4 1/8"]	G40.21M-350W	437.619 kg
2M10202	2	10 [3/8"] THK X 127 [5"] WD X 250 [9 7/8"]	G40.21M-300W	2.230 kg
2M10203	2	10 [3/8"] THK X 125 [4 7/8"] WD X 250 [9 7/8"]	G40.21M-300W	2.192 kg
2M10204	2	10 [3/8"] THK X 121 [4 3/4"] WD X 250 [9 7/8"]	G40.21M-300W	2.113 kg
2M10205	2	10 [3/8"] THK X 110 [4 3/8"] WD X 250 [9 7/8"]	G40.21M-300W	1.904 kg
2M10206	2	10 [3/8"] THK X 101 [4"] WD X 250 [9 7/8"]	G40.21M-300W	1.748 kg
2M10207	2	10 [3/8"] THK X 92 [3 5/8"] WD X 250 [9 7/8"]	G40.21M-300W	1.576 kg
2M10208	10	10 [3/8"] THK X 171 [6 3/4"] WD X 610 [2'-0"]	G40.21M-300W	7.508 kg
2M10209	2	10 [3/8"] THK X 171 [6 3/4"] WD X 610 [2'-0"]	G40.21M-300W	7.508 kg

BILLING FOR ONE GIRDER ASSEMBLY SHOWN  
TOTAL EIGHT GIRDER ASSEMBLIES REQUIRED

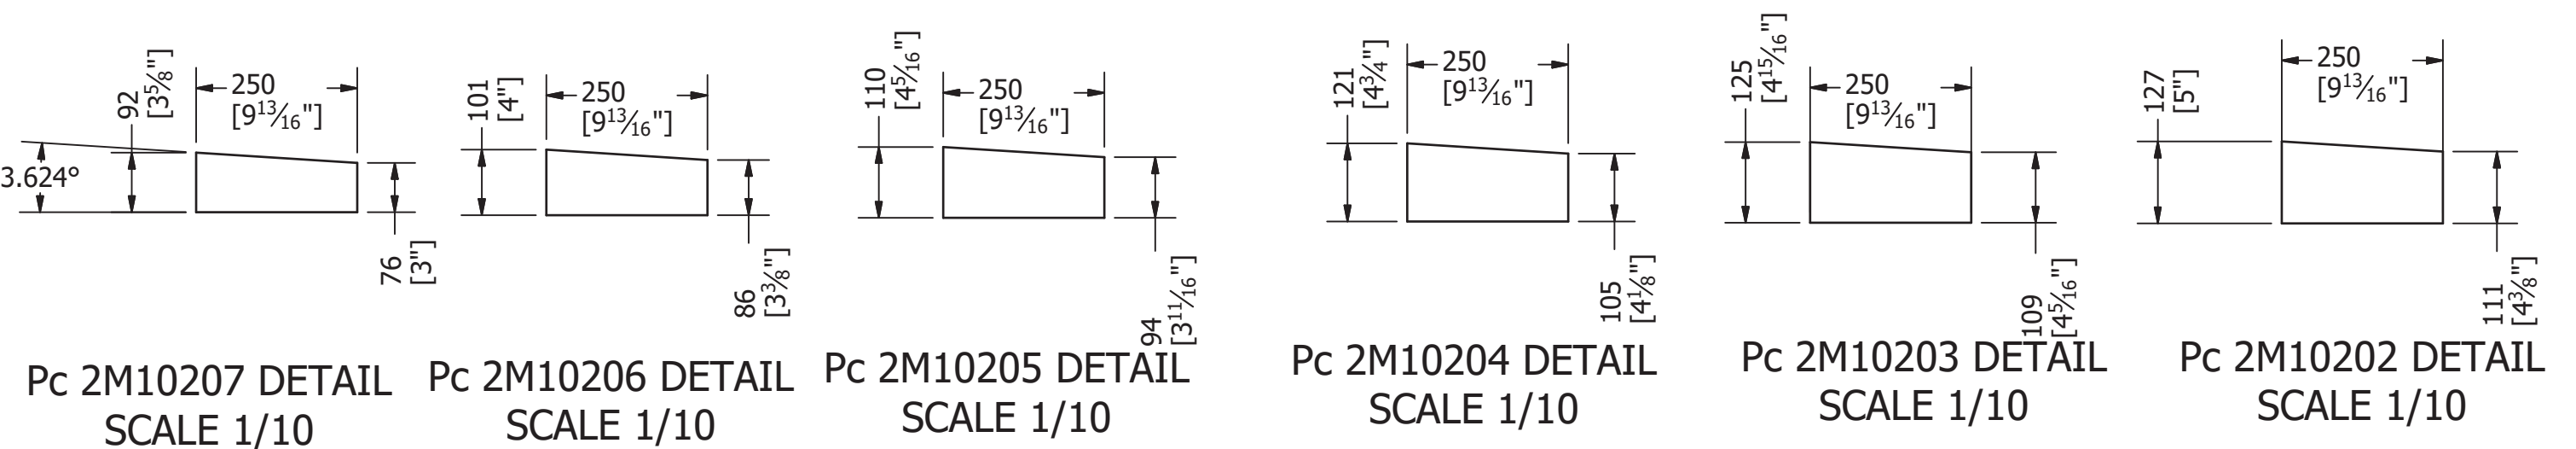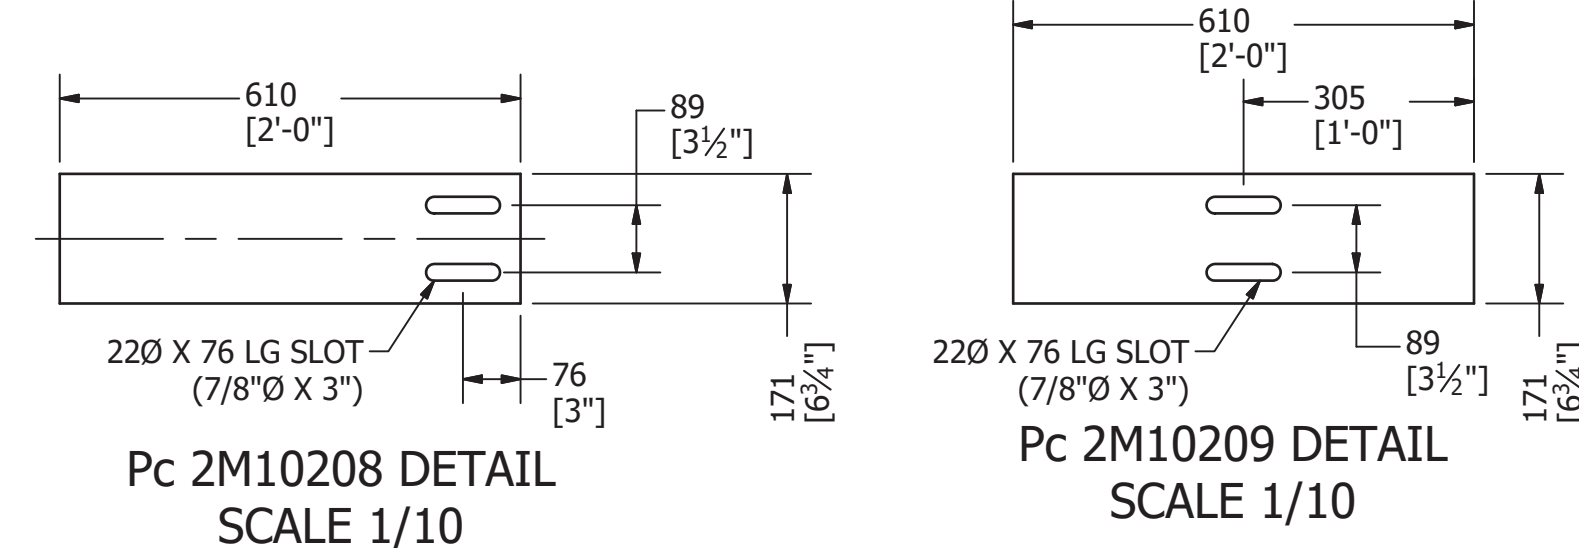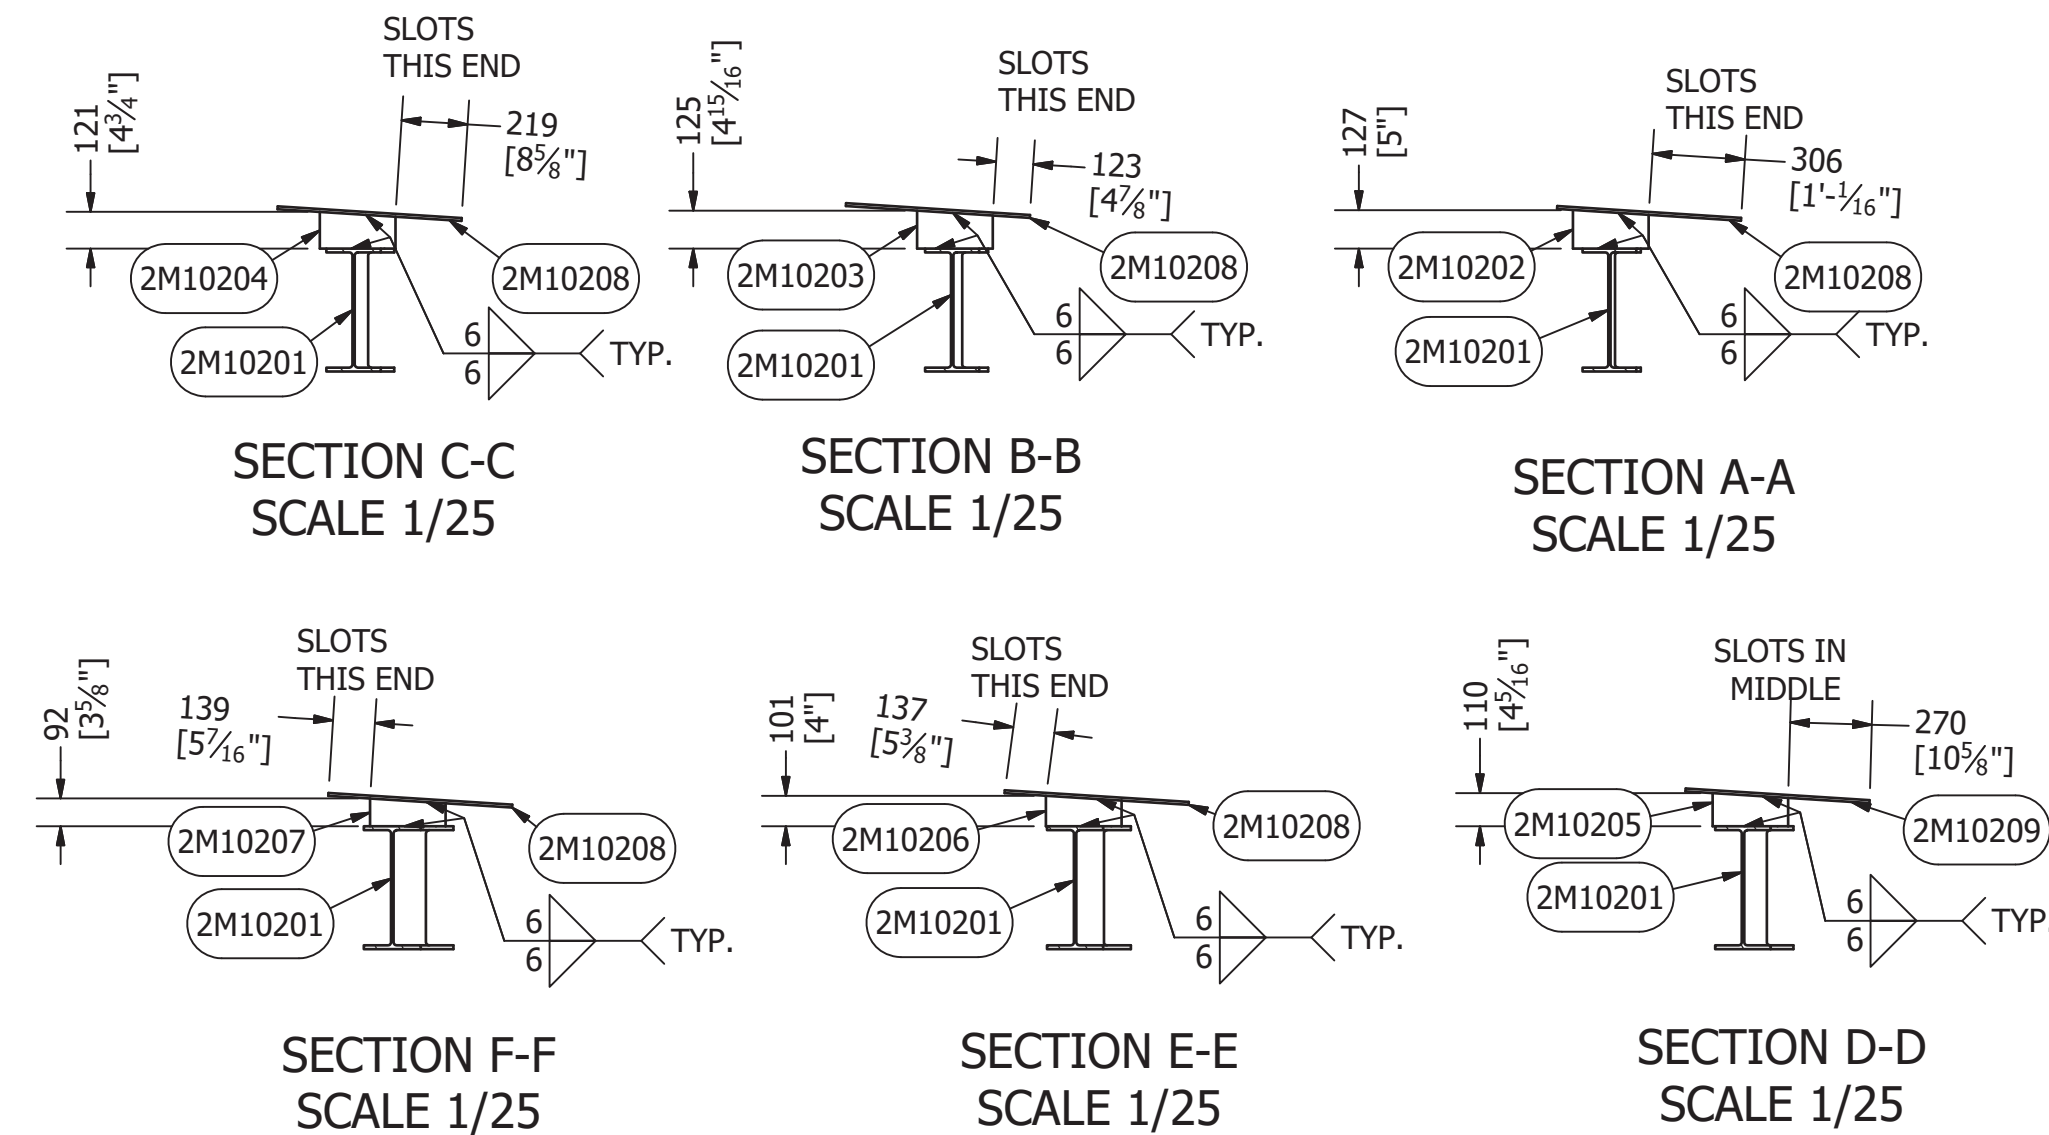

**AS-BUILT**  
BY Inukshuk Construction Ltd. DATE 2017/10/02

PROFESSIONAL ENGINEER  
DRAWN  
CHECKED  
LICENSEE  
30-Sep-2017  
NTNU


NOTE:  
ALL DIMENSIONS ARE IN MM UNLESS OTHERWISE NOTED

Permit Number: P471



DRAWN MARC LOSIER	3/9/2017	INTERMEDIATE GIRDER AND RAFTER DETAIL		
CHECKED		TITLE		
QA		AGNICO EAGLE - MELIADINE GOLD MINE -		
MFG		TK #2 - 13,500CUM 35.1M DIA X 14M H		
APPROVED		SIZE		
		A1		
		DWG NO		
		295-M10		
		REV		
		7		
		SCALE		
		SHEET 2 OF 7		




BILL OF MATERIAL - CENTER COLUMN				
MARK	ITEM QTY	DESCRIPTION	MATERIAL	MASS
2M10301	1	25 [1"] THK X 2286 [7'-6"] DIA	G40.21M-300W	798.104 kg
2M10302	1	13 [1/2"] THK X 1473 [4'-10"] DIA.	G40.21M-300W	169.937 kg
2M10303	8	10 [3/8"] x 750 [2'-5 1/2"] WD x 750 [2'-5 1/2"] LG	G40.21M-300W	30.566 kg
2M10304	4	6 [1/4"] THK X 76 [3"] X 102 [4"]	G40.21M-300W	0.851 lbmass
2M10305	1	25 [1"] THK X 1828 [6'-0"] DIA.	G40.21M-300W	523.752 kg
2M10306	1	HSS 324 [12 3/4"] O.D. X 9.5 [3/8"] WALL x 14426 [47'-3 15/16"] LG	G40.21M-350W CLASS H	2348.230 lbmass
2M10307	1	19 [3/4"] THK X 89 [3 1/2"] WD X 203 [8"] LG	G40.21M-300W	1.461 kg

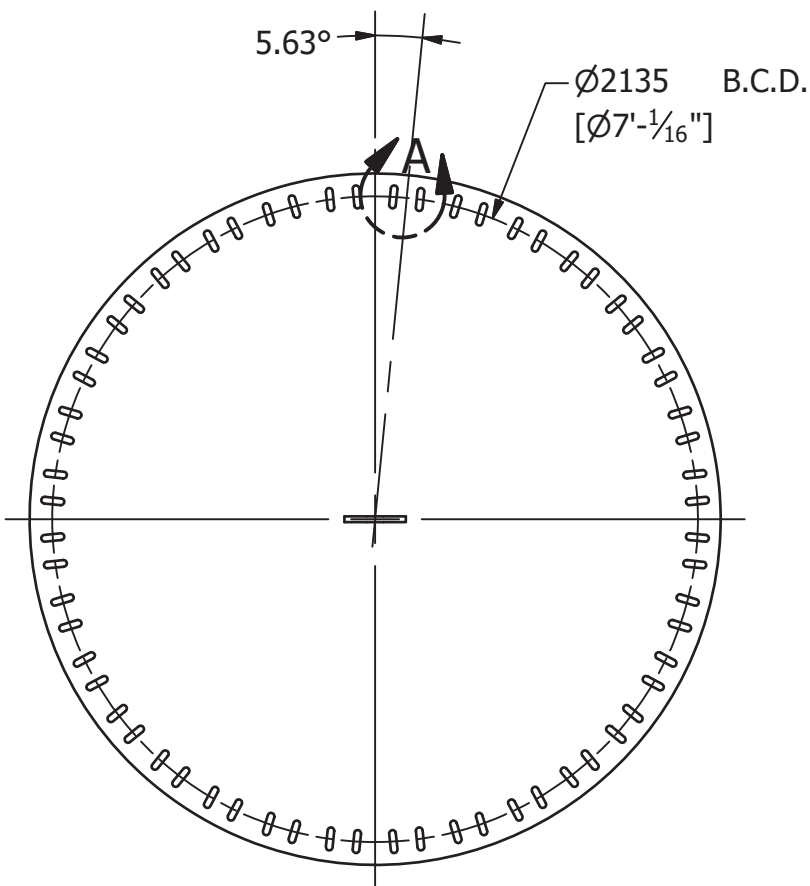


DETAIL A  
TYPICAL (32) LOCATIONS EQ. SPACED  
SCALE 1/10

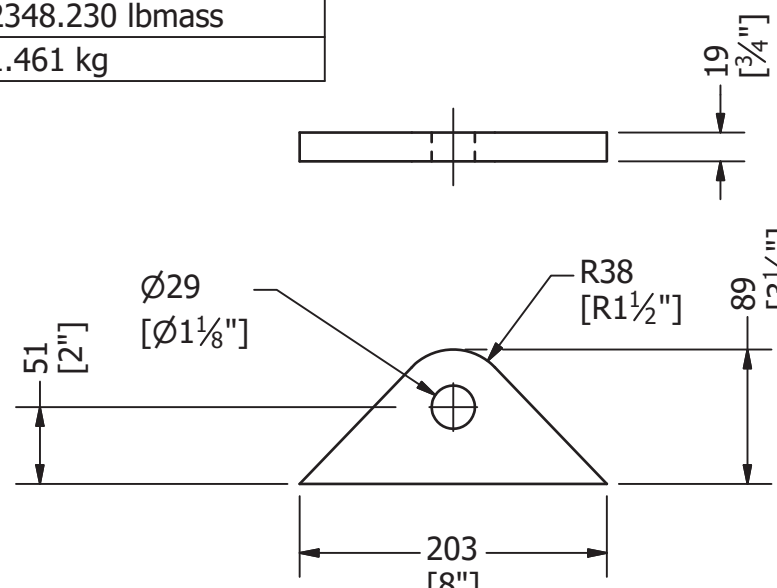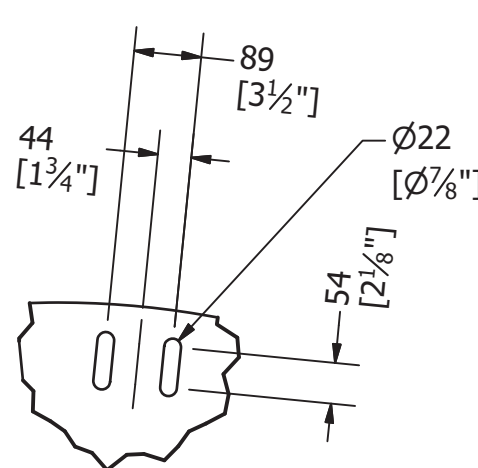


2M10307  
SCALE 1/5

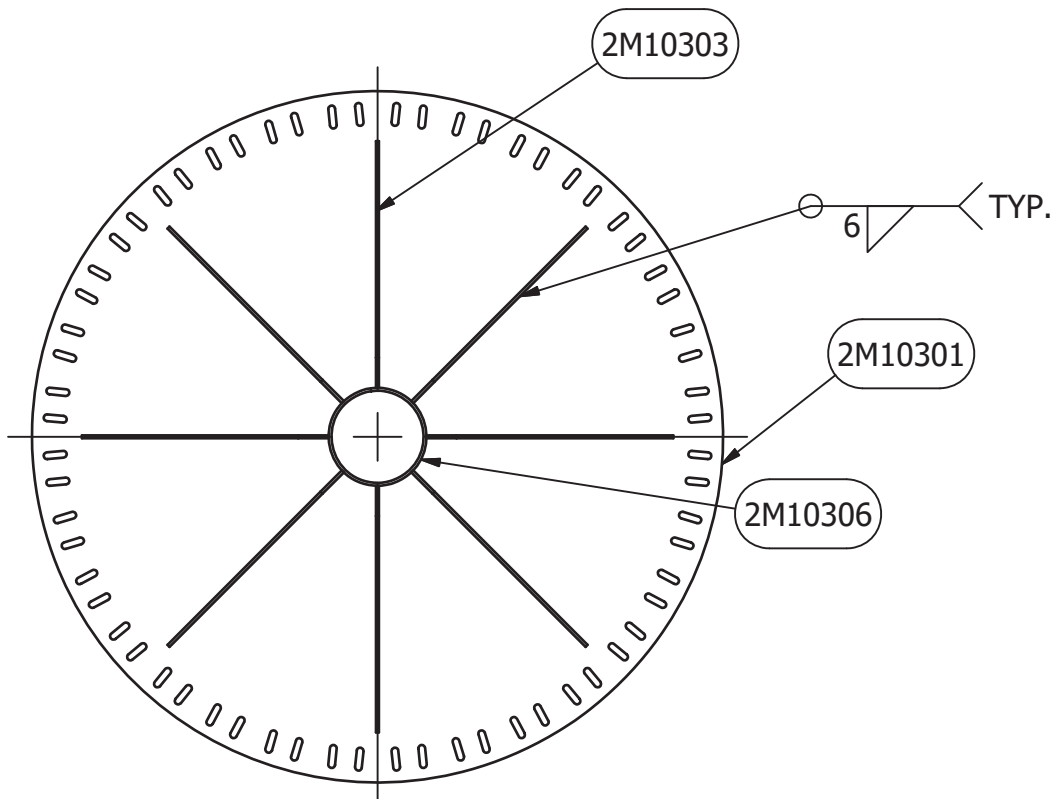


SECTION A-A  
SCALE 1/25

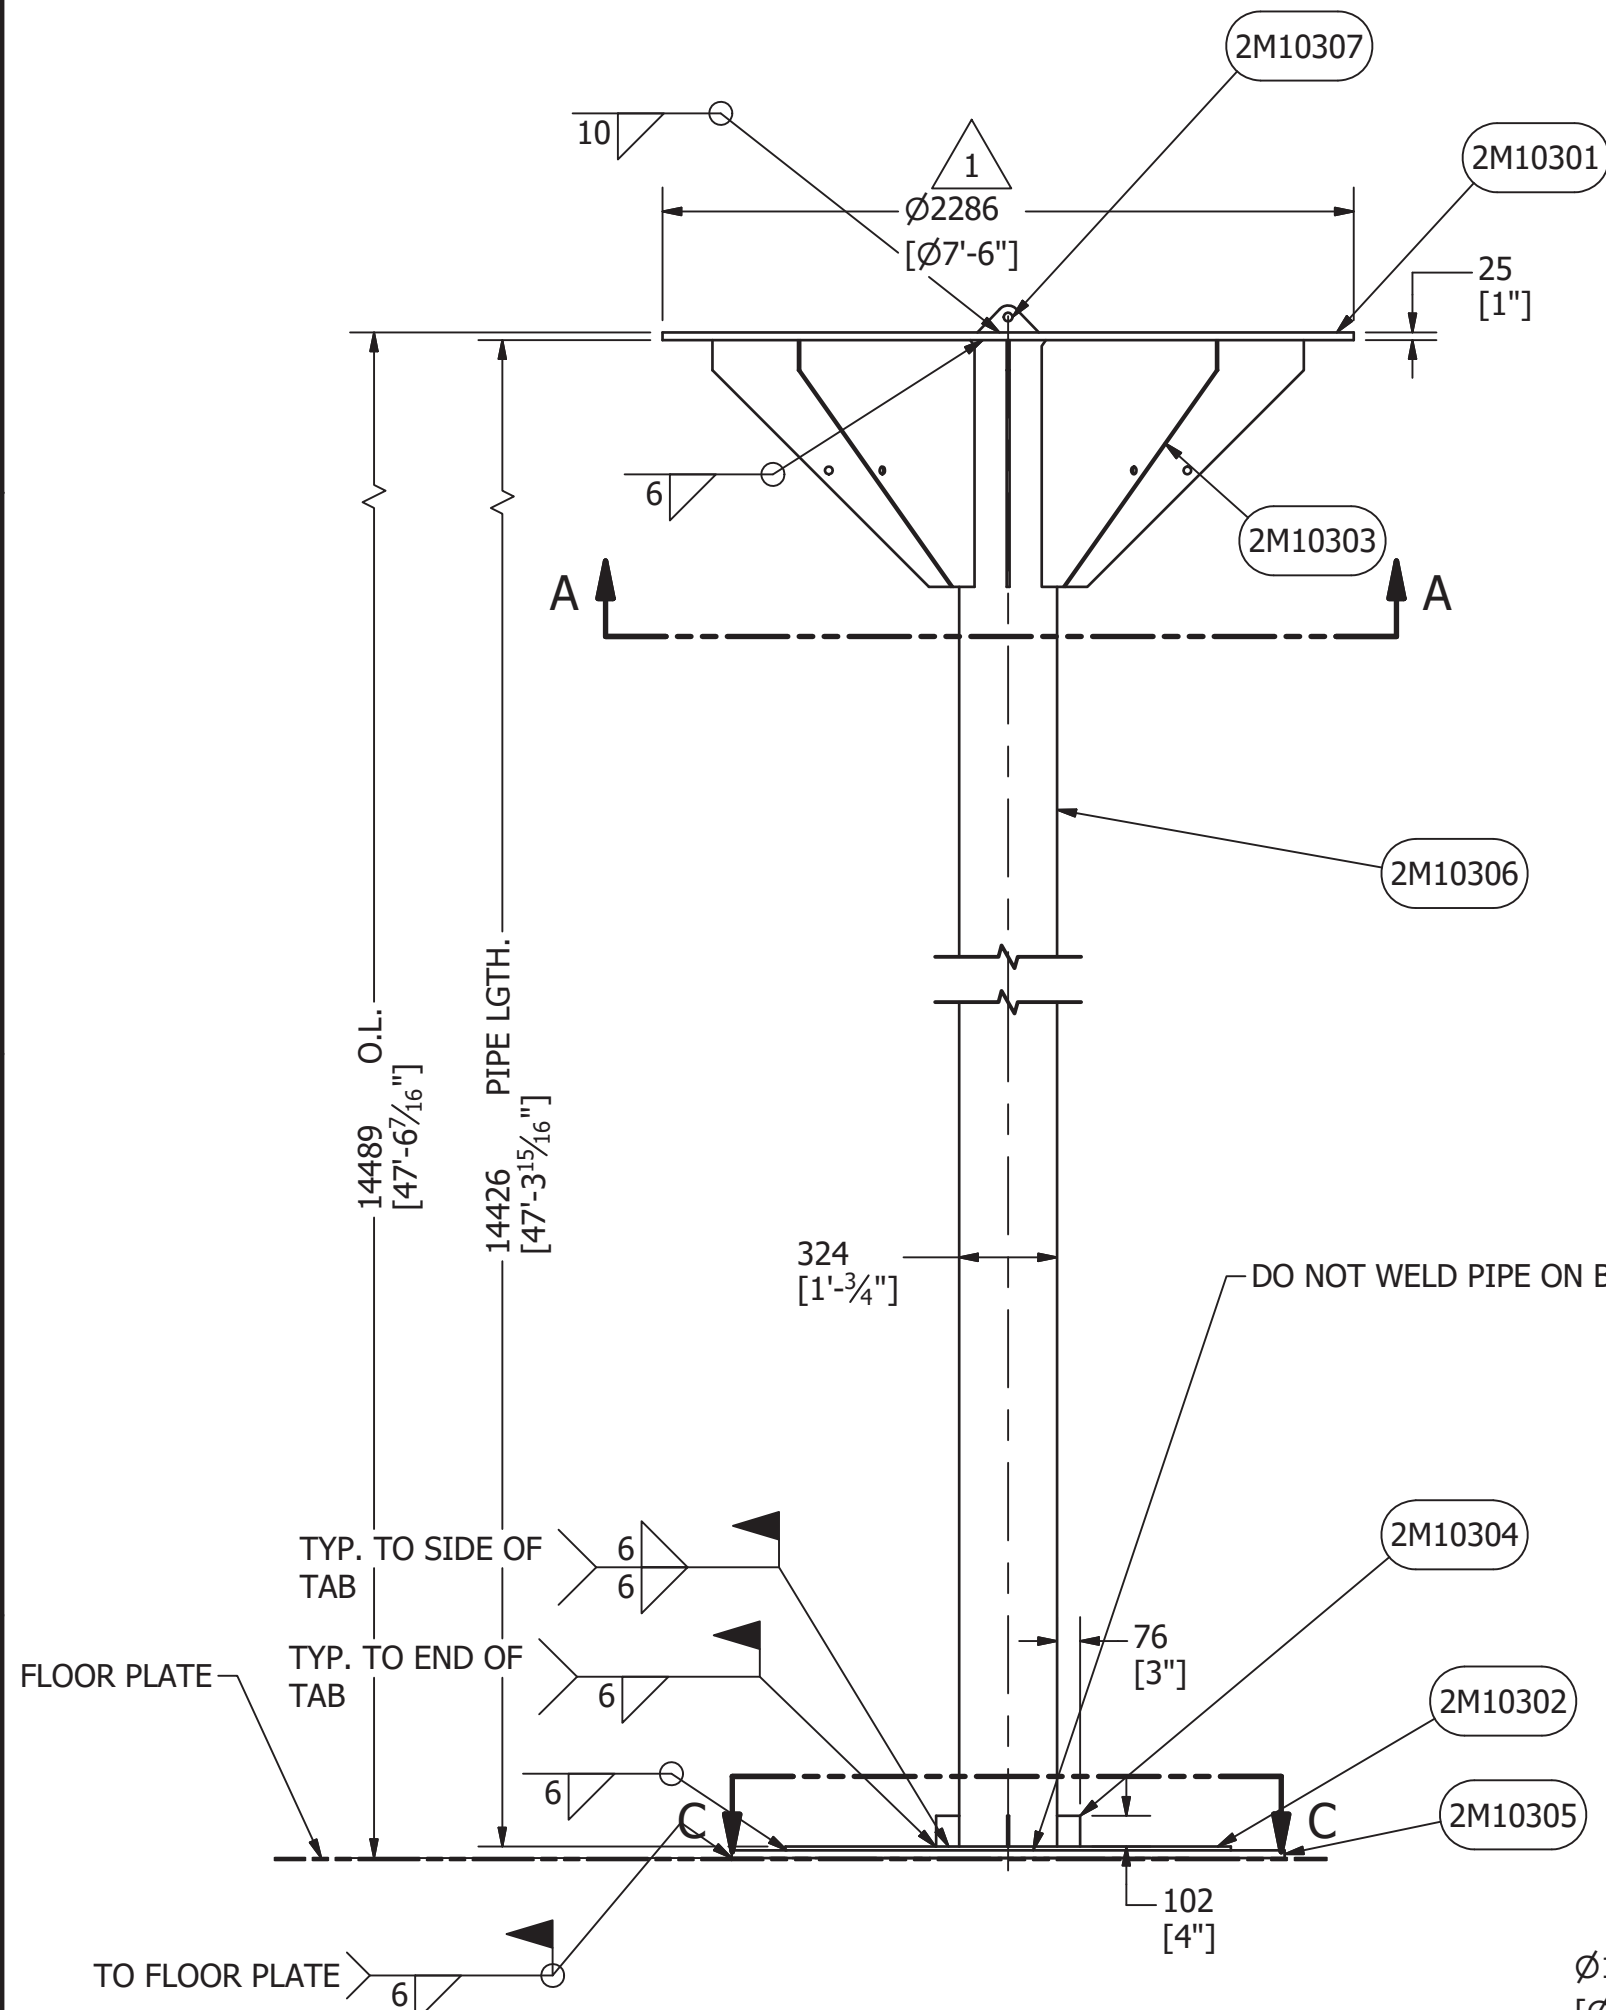

Pc 2M10300-6 DETAIL  
CENTER COLUMN  
SCALE 1/25

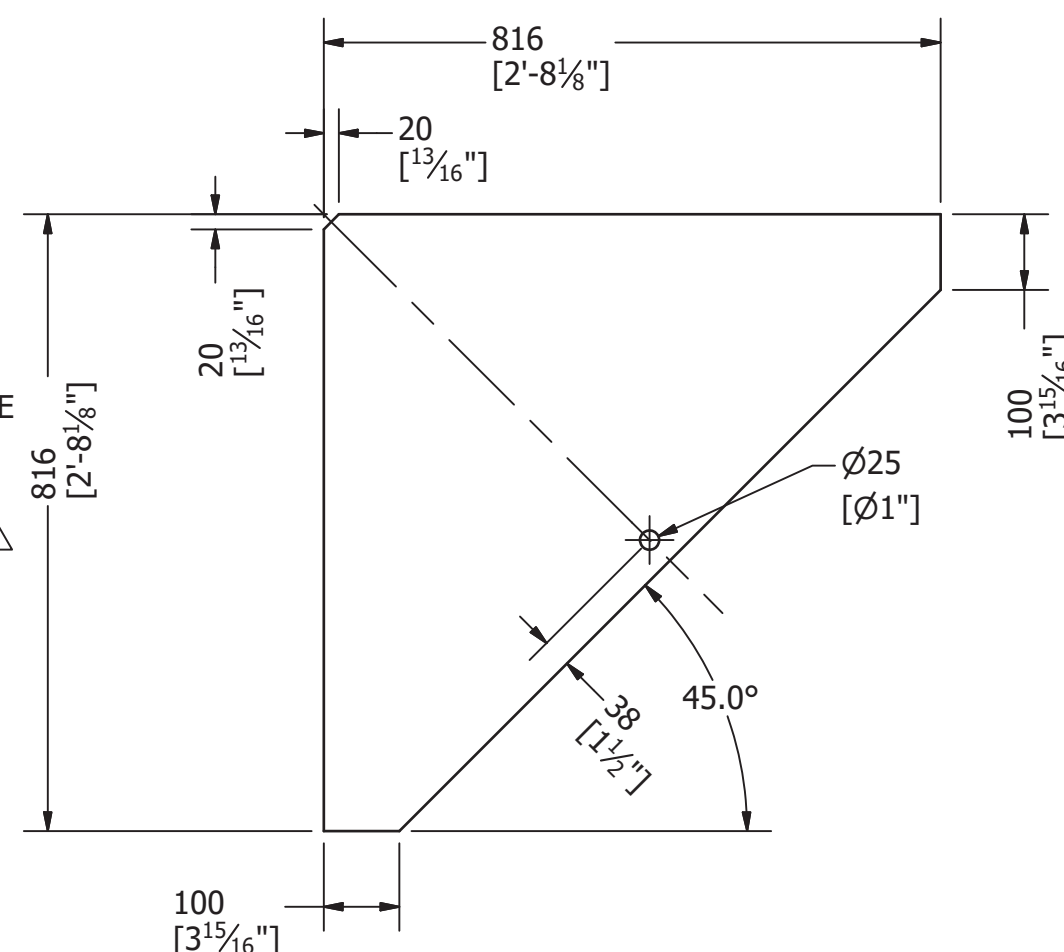


Pc 2M10303 DETAIL  
SCALE 1/10

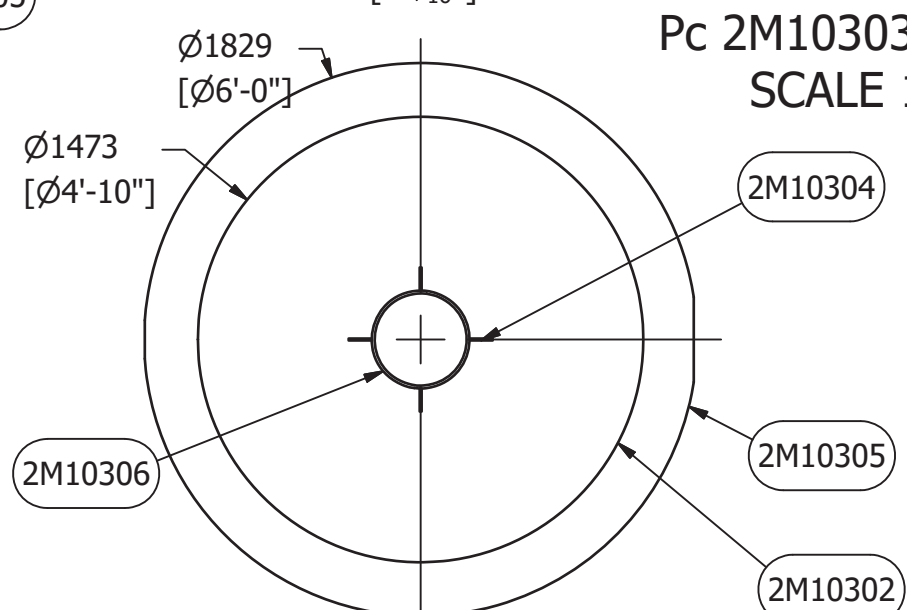


SECTION C-C  
SCALE 1/25

PARTS LIST				
ITEM	ITEM QTY	DESCRIPTION	MATERIAL	MASS
2M10321	1	13 [1/2"] THK x 407 [1'-4"] WD x 696 [2'-3 3/8"] LG	G40.21M-300W	17.744 kg
2M10322	1	HSS324 [12 3/4"] O.D. X 10 [3/8"] WALL x 13557 [44'-5 3/4"] LG	G40.21M-350W CLASS H	2215.665 lbmass
2M10323	1	32 [1 1/4"] THK X 1422 [4'-8"] DIA.	G40.21M-300W	396.047 kg
2M10324	4	6 [1/4"] THK X 76 [3"] WD X 102 [4"] LG	G40.21M-300W	0.851 lbmass
2M10325	2	6 [1/4"] THK X 164 [6 1/2"] WD X 164 [6 1/2"] LG	G40.21M-300W	0.789 kg


BILLING FOR ONE INTERMEDIATE COLUMN ASSEMBLY SHOWN  
TOTAL EIGHT INTERMEDIATE COLUMN ASSEMBLIES REQUIRED

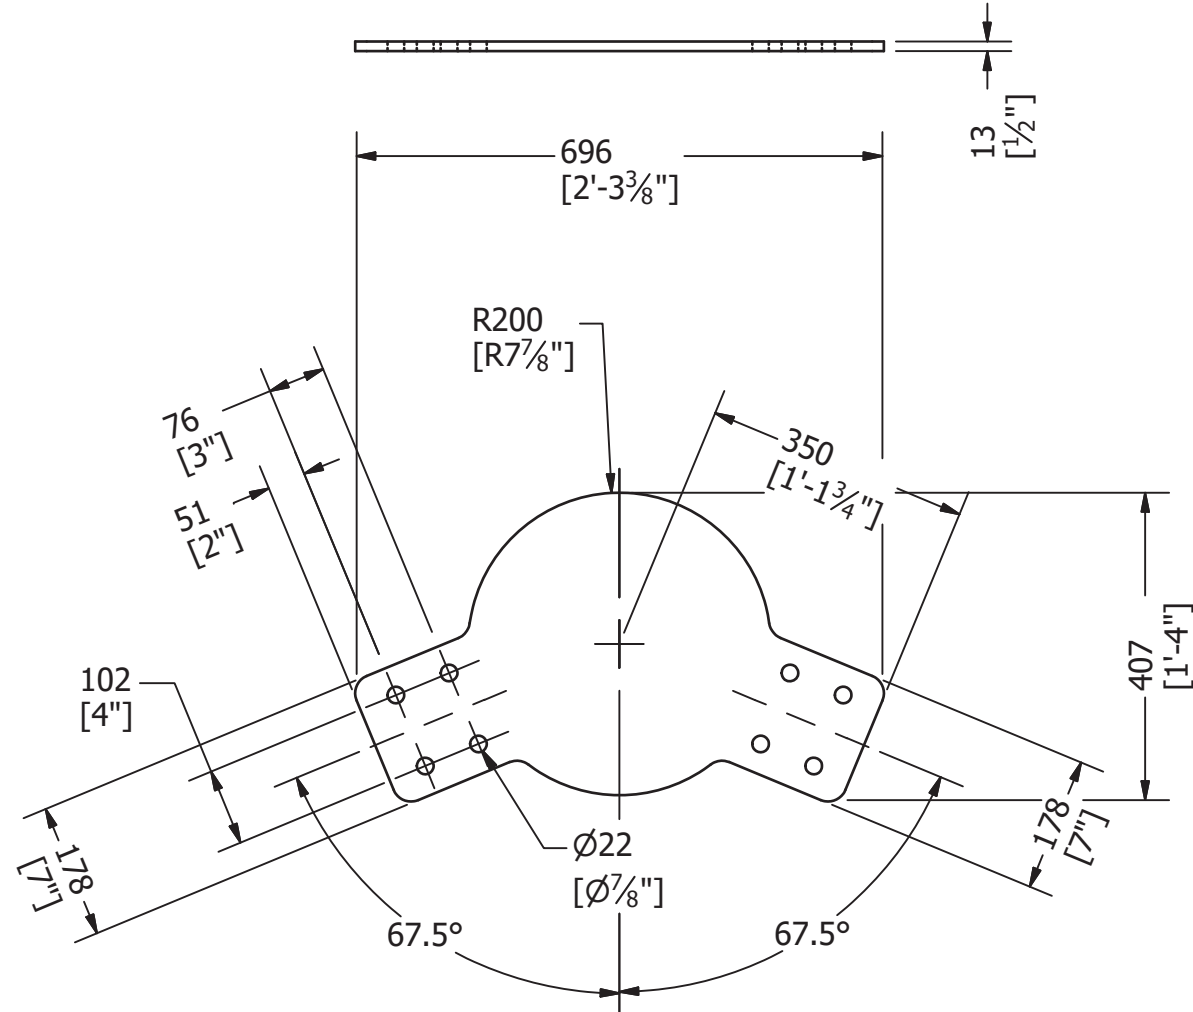



Pc 2M10321 DETAIL  
INTERMEDIATE COLUMN CAP PLATE  
SCALE 1/10

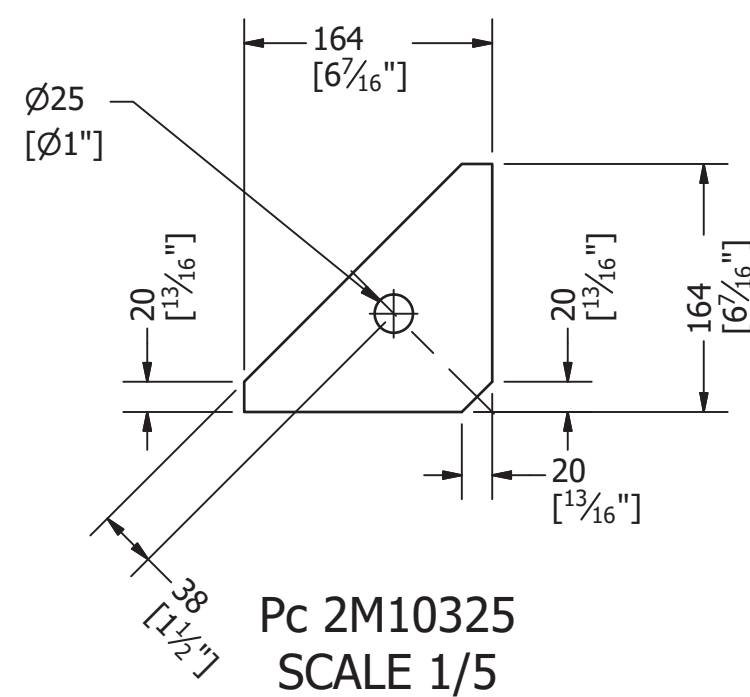

Pc 2M10325  
SCALE 1/5

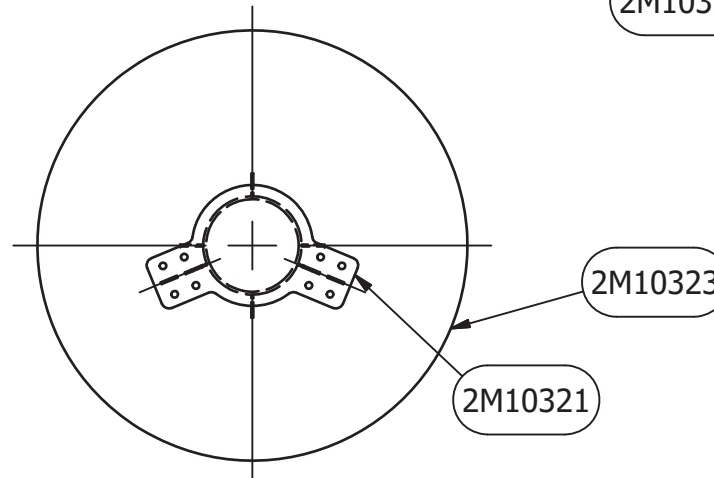


SECTION B-B  
SCALE 1/10

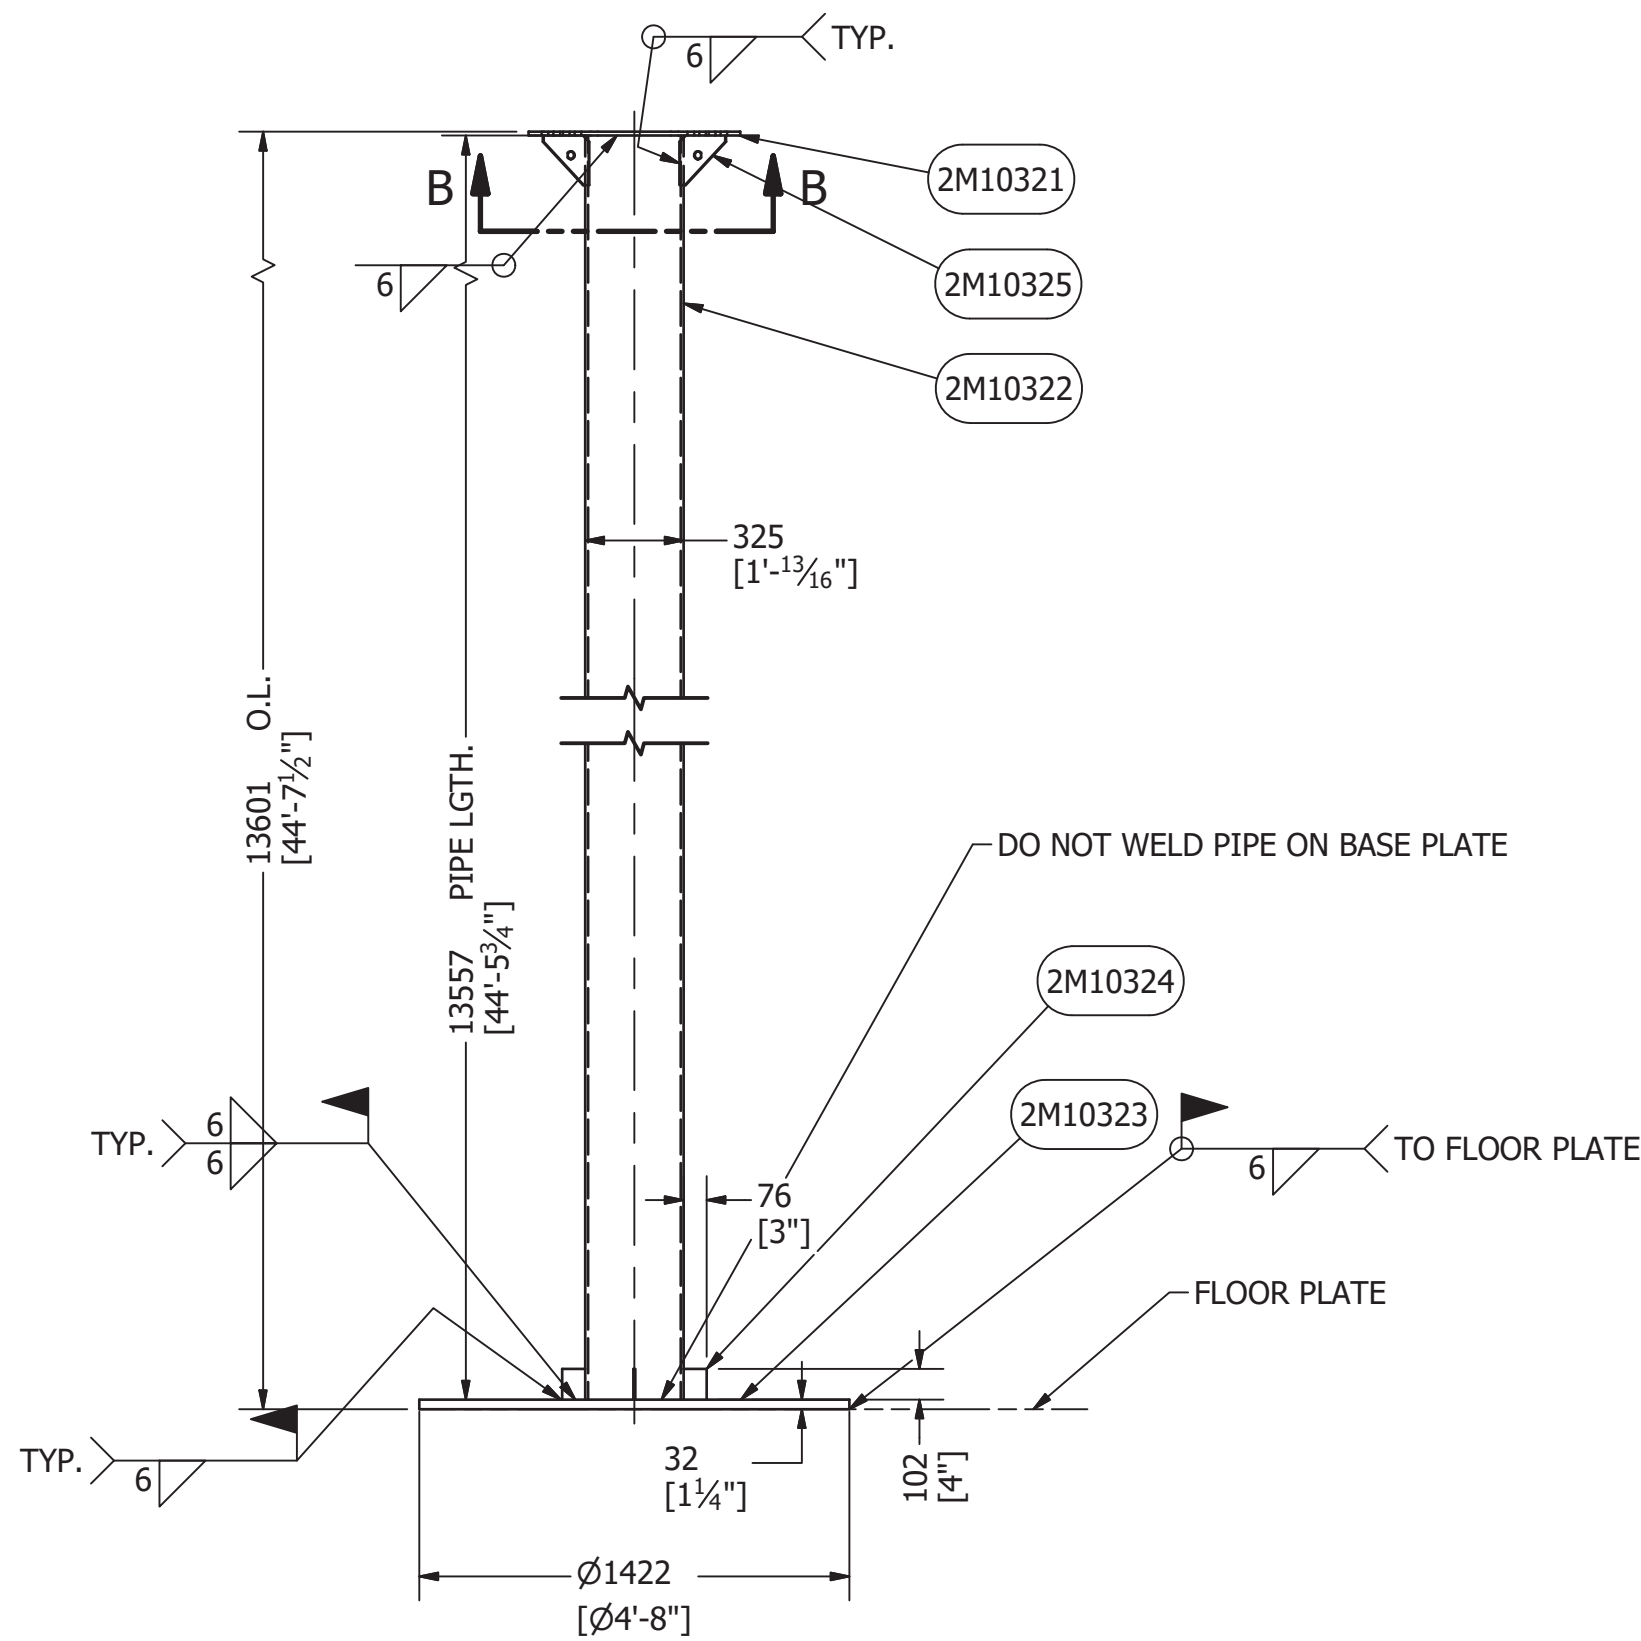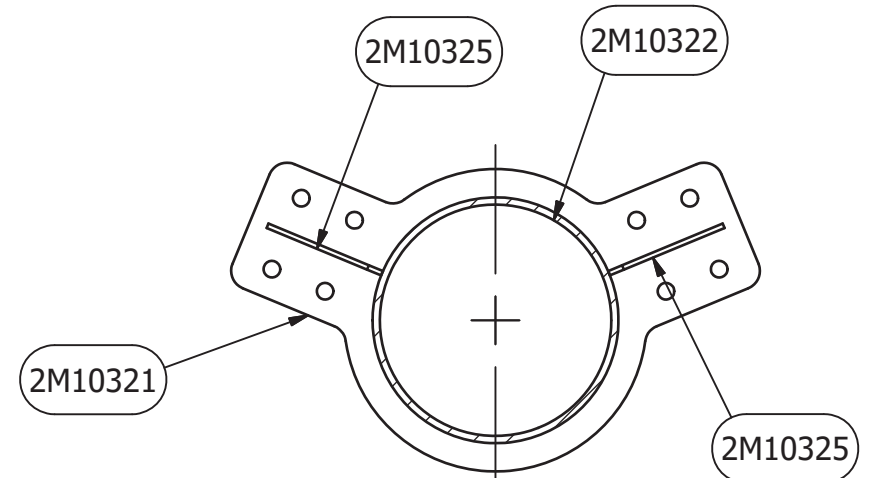

Pc 2M10300-12  
INTERMEDIATE COLUMN  
QTY: 8  
SCALE 1/25


**AS-BUILT**  
BY Inukshuk Construction Ltd. DATE 2017/10/02

NOTE:  
ALL DIMENSIONS ARE IN MM UNLESS OTHERWISE NOTED

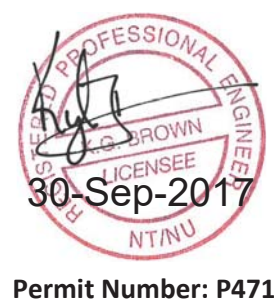

REVISION HISTORY			
ZONE	REV	DESCRIPTION	DATE
3H, 10H	1	CENTER COLUMN PIPE AND INTERMEDIATE COLUMN PIPE LGTH. CHG. TO SUITE SLOPE 1/120, INTERMEDIATE COLUMN PIPE CHG. FROM 10.75"X1/2"WALL TO 12.75"X 3/8"	3/13/2017
DRAWN MARC LOSIER		3/9/2017	CENTER AND INTERMEDIATE COLUMN DETAILS
CHECKED			
QA			
MFG			
APPROVED			AGNICO EAGLE - MELIADINE GOLD MINE - TK #2 - 13,500CUM 35.1M DIA X 14M H
		SIZE A1	DWG NO 295-M10
		SCALE	REV 7
SHEET 3 OF 7			



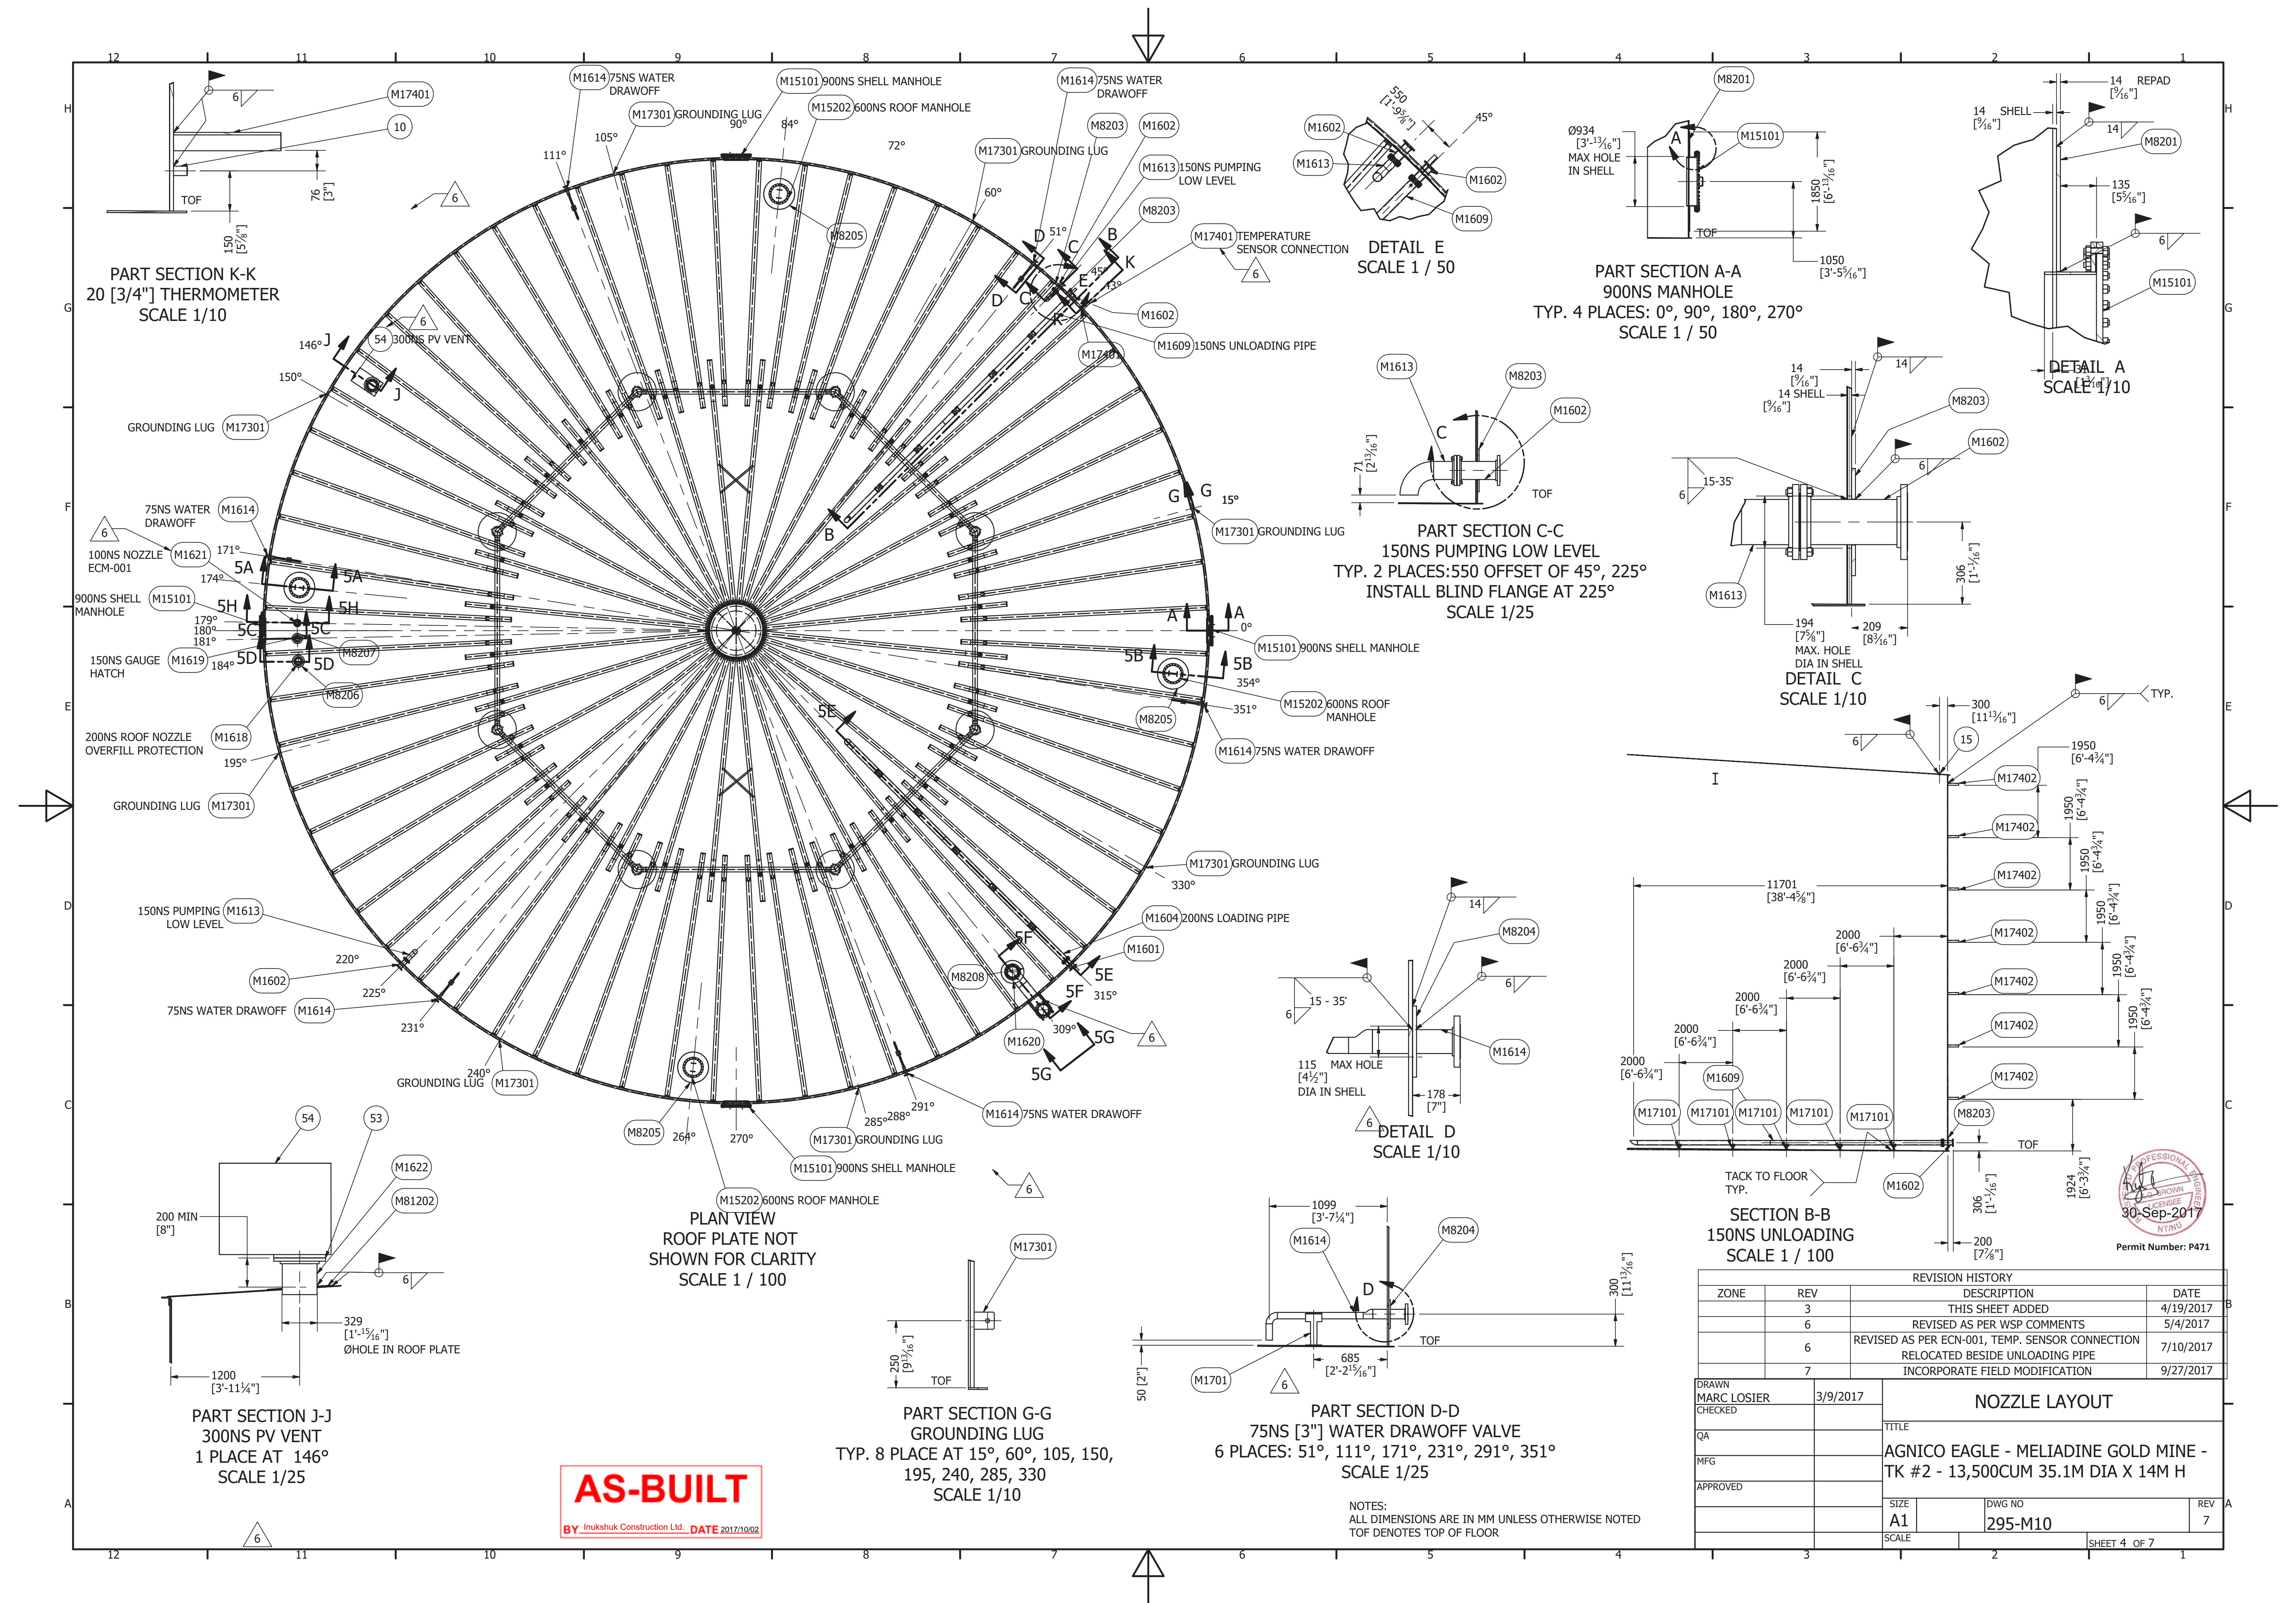

PART SECTION K-K  
20 [3/4"] THERMOMETER  
SCALE 1/10

PART SECTION A-A  
900NS MANHOLE  
TYP. 4 PLACES: 0°, 90°, 180°, 270°  
SCALE 1 / 50

PART SECTION C-C  
150NS PUMPING LOW LEVEL  
TYP. 2 PLACES: 550 OFFSET OF 45°, 225°  
INSTALL BLIND FLANGE AT 225°  
SCALE 1/25

DETAIL C  
SCALE 1/10

DETAIL D  
SCALE 1/10

SECTION B-B  
150NS UNLOADING  
SCALE 1 / 100

PART SECTION D-D  
75NS [3"] WATER DRAWOFF VALVE  
6 PLACES: 51°, 111°, 171°, 231°, 291°, 351°  
SCALE 1/25

PART SECTION G-G  
GROUNDING LUG  
TYP. 8 PLACE AT 15°, 60°, 105, 150, 195, 240, 285, 330  
SCALE 1/10

PART SECTION J-J  
300NS PV VENT  
1 PLACE AT 146°  
SCALE 1/25

PLAN VIEW  
ROOF PLATE NOT  
SHOWN FOR CLARITY  
SCALE 1 / 100

**AS-BUILT**  
BY Inukshuk Construction Ltd. DATE 2017/10/02

REVISION HISTORY			
ZONE	REV	DESCRIPTION	DATE
	3	THIS SHEET ADDED	4/19/2017
	6	REVISED AS PER WSP COMMENTS	5/4/2017
	6	REVISED AS PER ECN-001, TEMP. SENSOR CONNECTION RELOCATED BESIDE UNLOADING PIPE	7/10/2017
	7	INCORPORATE FIELD MODIFICATION	9/27/2017
DRAWN MARC LOSIER CHECKED		NOZZLE LAYOUT	
3/9/2017			
QA			
MFG			
APPROVED		TITLE AGNICO EAGLE - MELIADINE GOLD MINE - TK #2 - 13,500CUM 35.1M DIA X 14M H	
		SIZE A1	DWG NO 295-M10
		SCALE	REV 7
		SHEET 4 OF 7	

NOTES:  
ALL DIMENSIONS ARE IN MM UNLESS OTHERWISE NOTED  
TOF DENOTES TOP OF FLOOR









ITEM		PARTS LIST	
ITEM	ITEM QTY	PART NUMBER	DESCRIPTION
2M10601	18	T2 Roof Top Handrail Section	PREFABRICATED ROOF TOP HANDRAIL SECITON SEE DETAIL
2M10602	1	T2 Roof Top Handrail Section (3)	PREFABRICATED ROOF TOP HANDRAIL SECITON SEE DETAIL Pc 1M10601 TRIM AT SITE
M17201	1	AISC - L 3 x 3 x 1/4 - 58.228346	Angle Steel
5	1	AISC - L 2 x 2 x 1/4 - 1.5	Angle Steel
6	1	TK 2 Platforms and Stairways	

PARTS LIST						
ITEM	ITEM QTY	CUT (MM)	DESCRIPTION	PRE-FAB DRG #	MATERIAL	MASS
M17201	4	1479	L76X76X6 [3"X3"X1/4"] X 1474 [58 1/4"]	M17	G40X21M 350W	23.905 lbmass
M7205	1	5791	L50X50X6[L2"X2"X6] ROOF HANDRAIL ROLLED ANGLE	M7	G40.21M 300W	27.480 kg
3	2	5791	FB50X6 [ FB2"X1/4"] X 5791[19"] LG		G40.21M 300W	14.646 kg
4	1	5791	FB100X5 [4"X3/16"] x 5791 [19"] LG		G40.21M 300W	22.029 kg

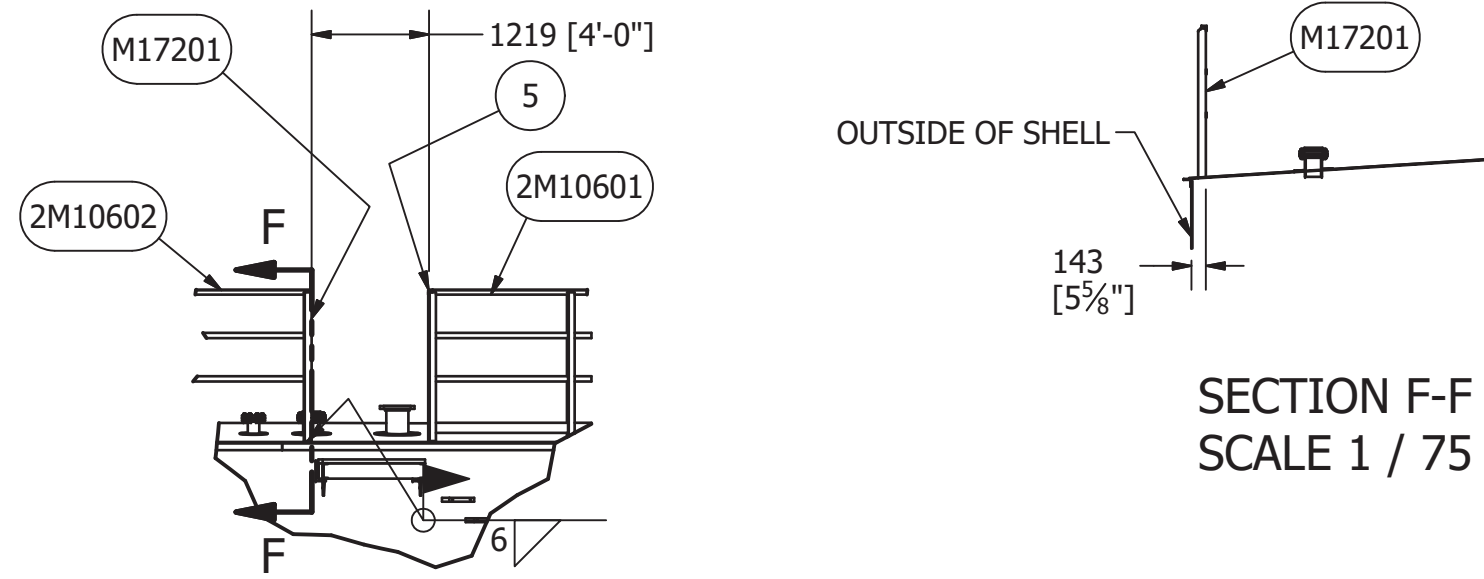


PART SECTION E-E  
SCALE 1 / 75


SECTION F-F  
SCALE 1 / 75

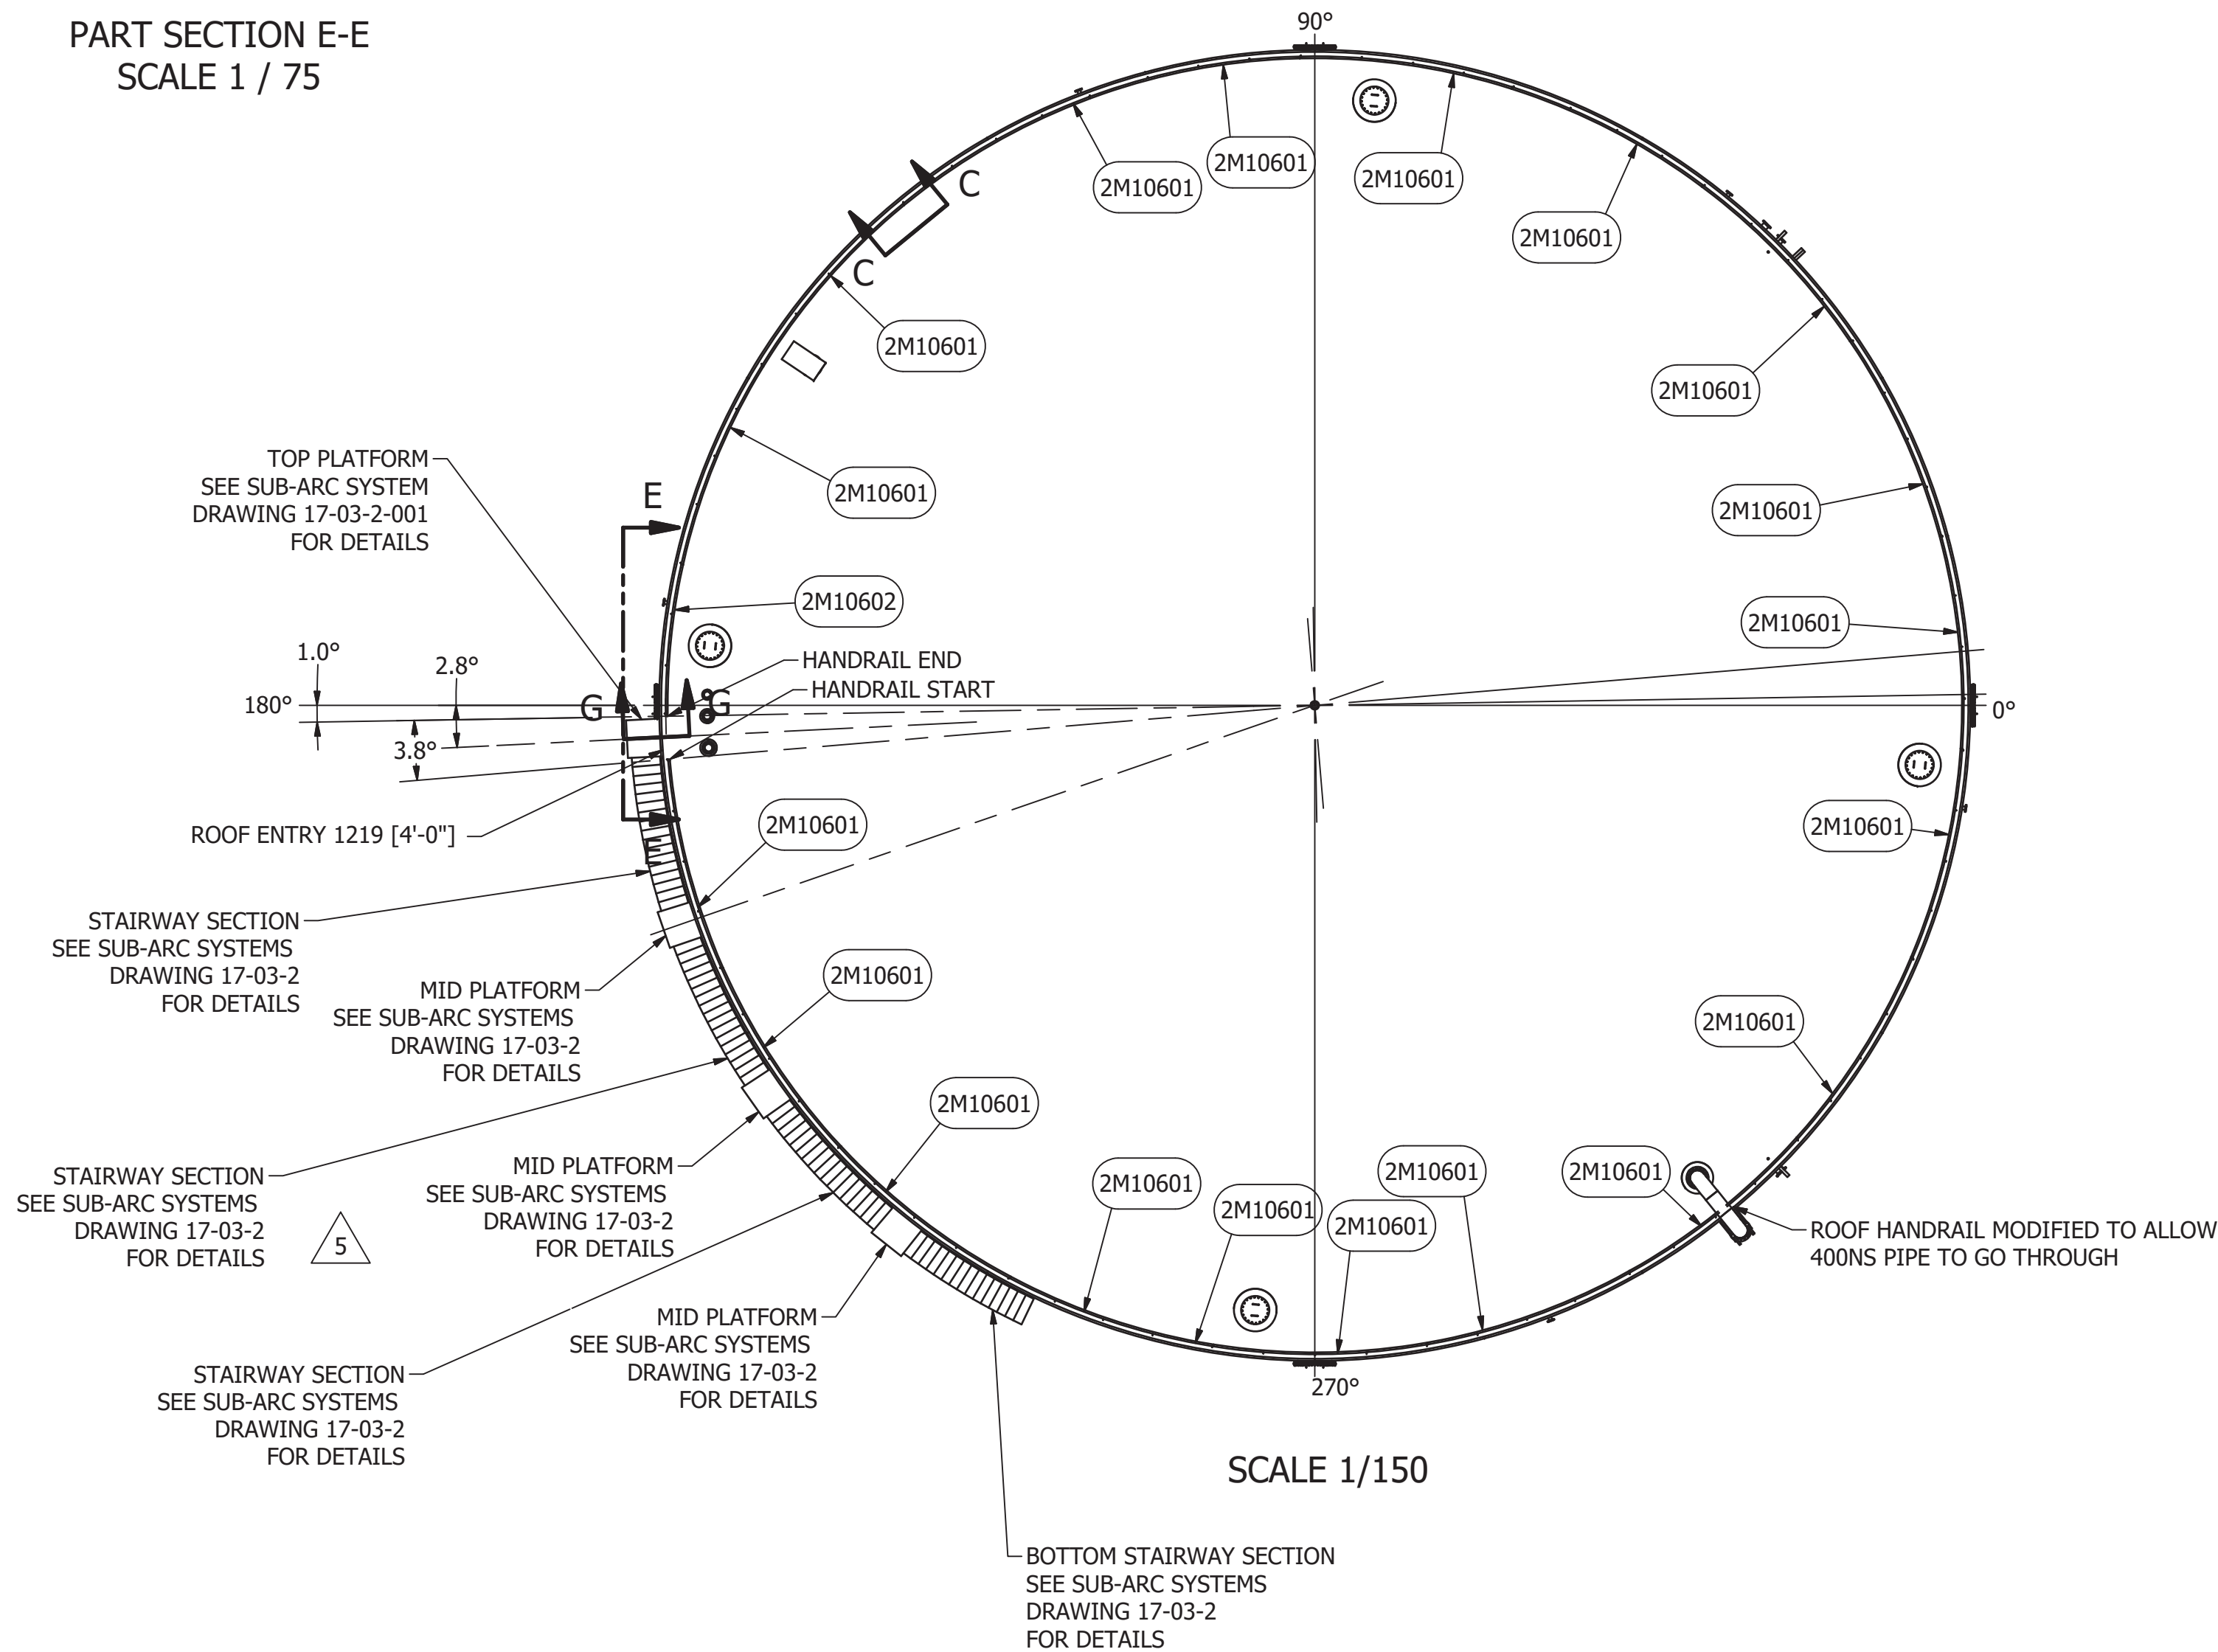


SCALE 1/150

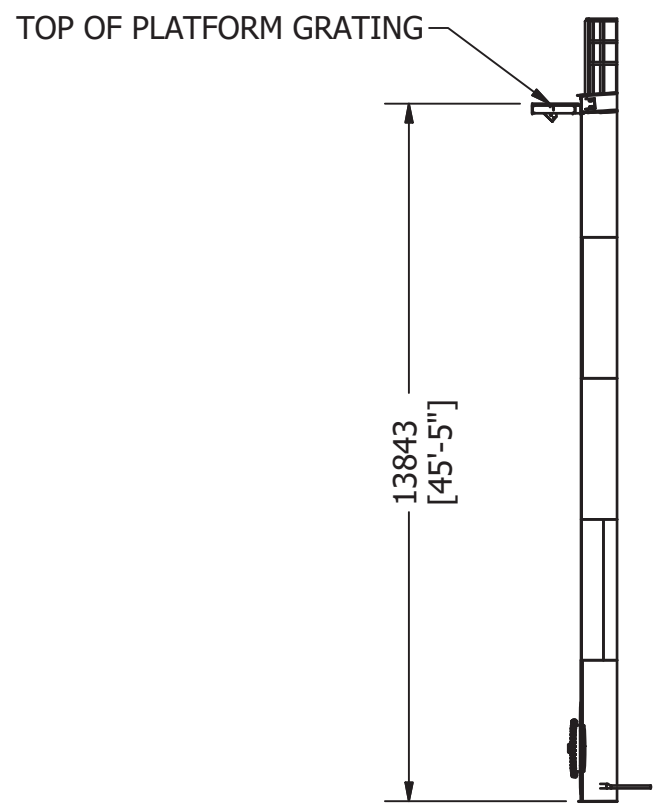


SECTION G-G  
SCALE 1/150

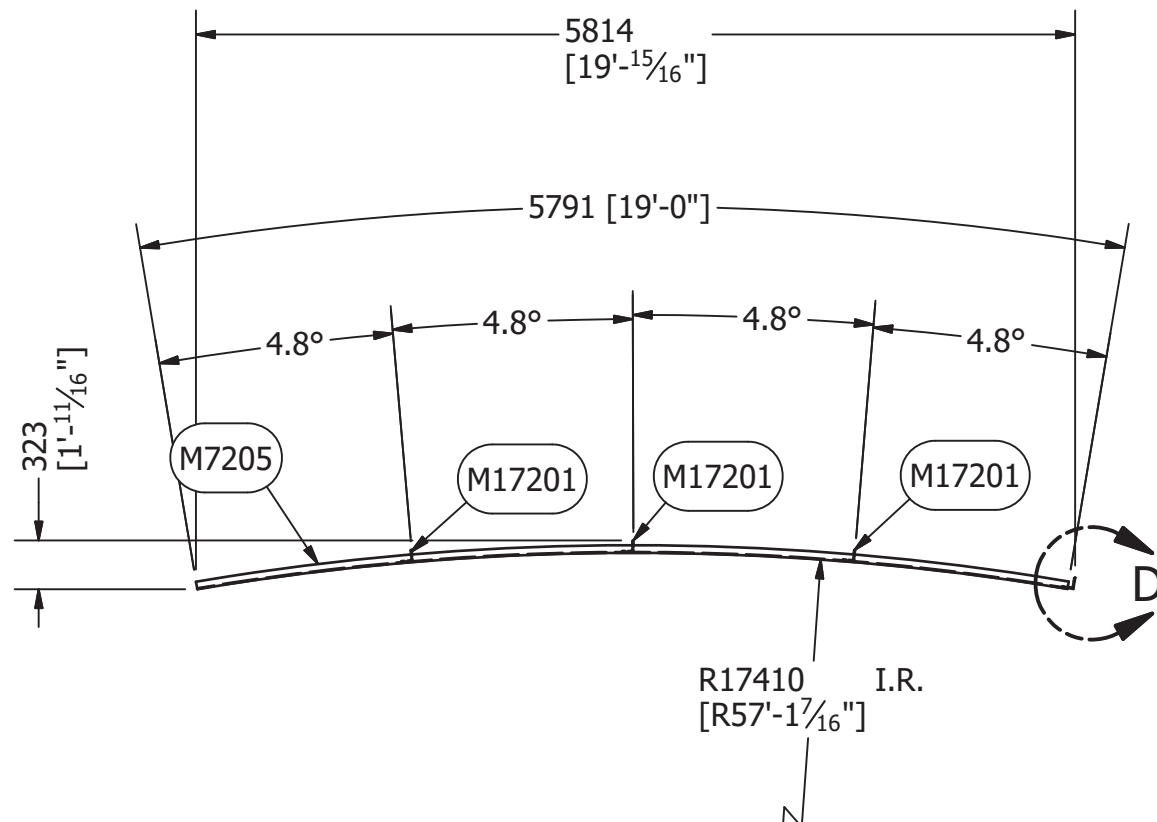


DETAIL D  
SCALE 1/10

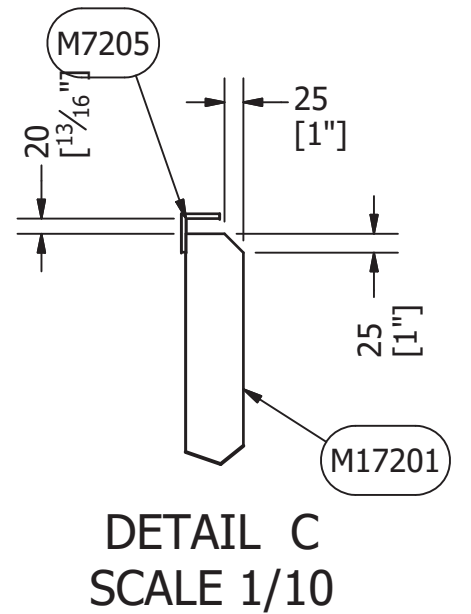

DETAIL C  
SCALE 1/10

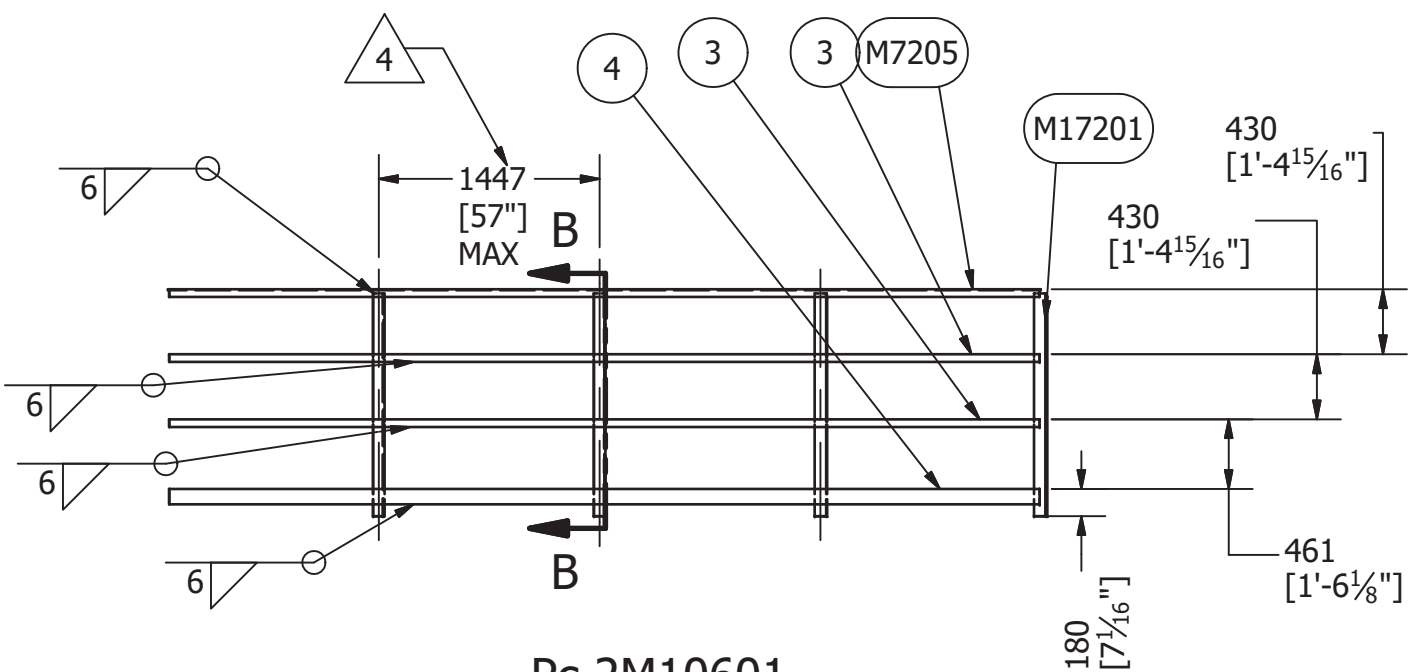

Pc 2M10601  
PREFABRICATED ROOF TOP HANDRAIL SECTION  
QTY: 19  
SCALE 1/50

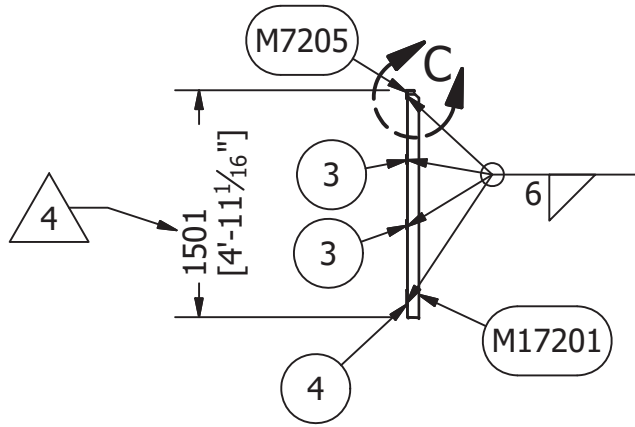

SECTION B-B  
SCALE 1/50

FINISH:  
SSPC SURFACE PREPERATION FOR PAINTING: SP6 COMMERCIAL SANDBLASTING  
ONE COAT OF POLYVAL 390


NOTE:  
ALL DIMENSIONS ARE IN MM UNLESS OTHERWISE NOTED

**AS-BUILT**  
BY Inukshuk Construction Ltd. DATE 2017/10/02

PROFESSIONAL ENGINEER  
30-Sep-2017  
Permit Number: P471

REVISION HISTORY			
ZONE	REV	DESCRIPTION	DATE
4D, 2D	3	THIS SHEET ADDED	4/20/2017
11F, 10A	4	MAX. DIST. BTW POST ADDED, HEIGHT SECTION B-B CHG TO 1501	5/2/2017
	5	PLATFORMS AND STAIRWAY ADDED	6/28/2017
DRAWN MARC LOSIER CHECKED		3/9/2017	
QA		TITLE	
MFG		AGNICO EAGLE - MELIADINE GOLD MINE - TK #2 - 13,500CUM 35.1M DIA X 14M H	
APPROVED		SIZE	
		A1	
		DWG NO	
		295-M10	
		REV	
		7	
		SHEET 6 OF 7	

PARTS LIST		
ITEM	ITEM QTY	PART NUMBER
1	55	SHELL PLATE 2798 X 9203 THICKNESS
2	5	SHELL PLATE LAST ON COURSE 2798 X 9127 (TRIM AT SITE)
3	4	900ns SHELL MANHOLE
5	8	Grounding Lug
6	3	150NS SHELL NOZZLE
8	6	75NS WATER DRAWOFF
10	1	20NS THERMOMETER CONNECTION
11	1	AISC - L 4 x 4 x 1/4 - 15.748031 TEMPERATURE CONNECTION PROTECTION
12	1	400NS VENT
13	4	PLATFORM
14	115	STEPS
18	14	AISC - L 3 x 3 x 1/4 - 15.748031 PRV PIPE SUPPORT
19	1	200NS SHELL NOZZLE - FIX LOADING PIPE

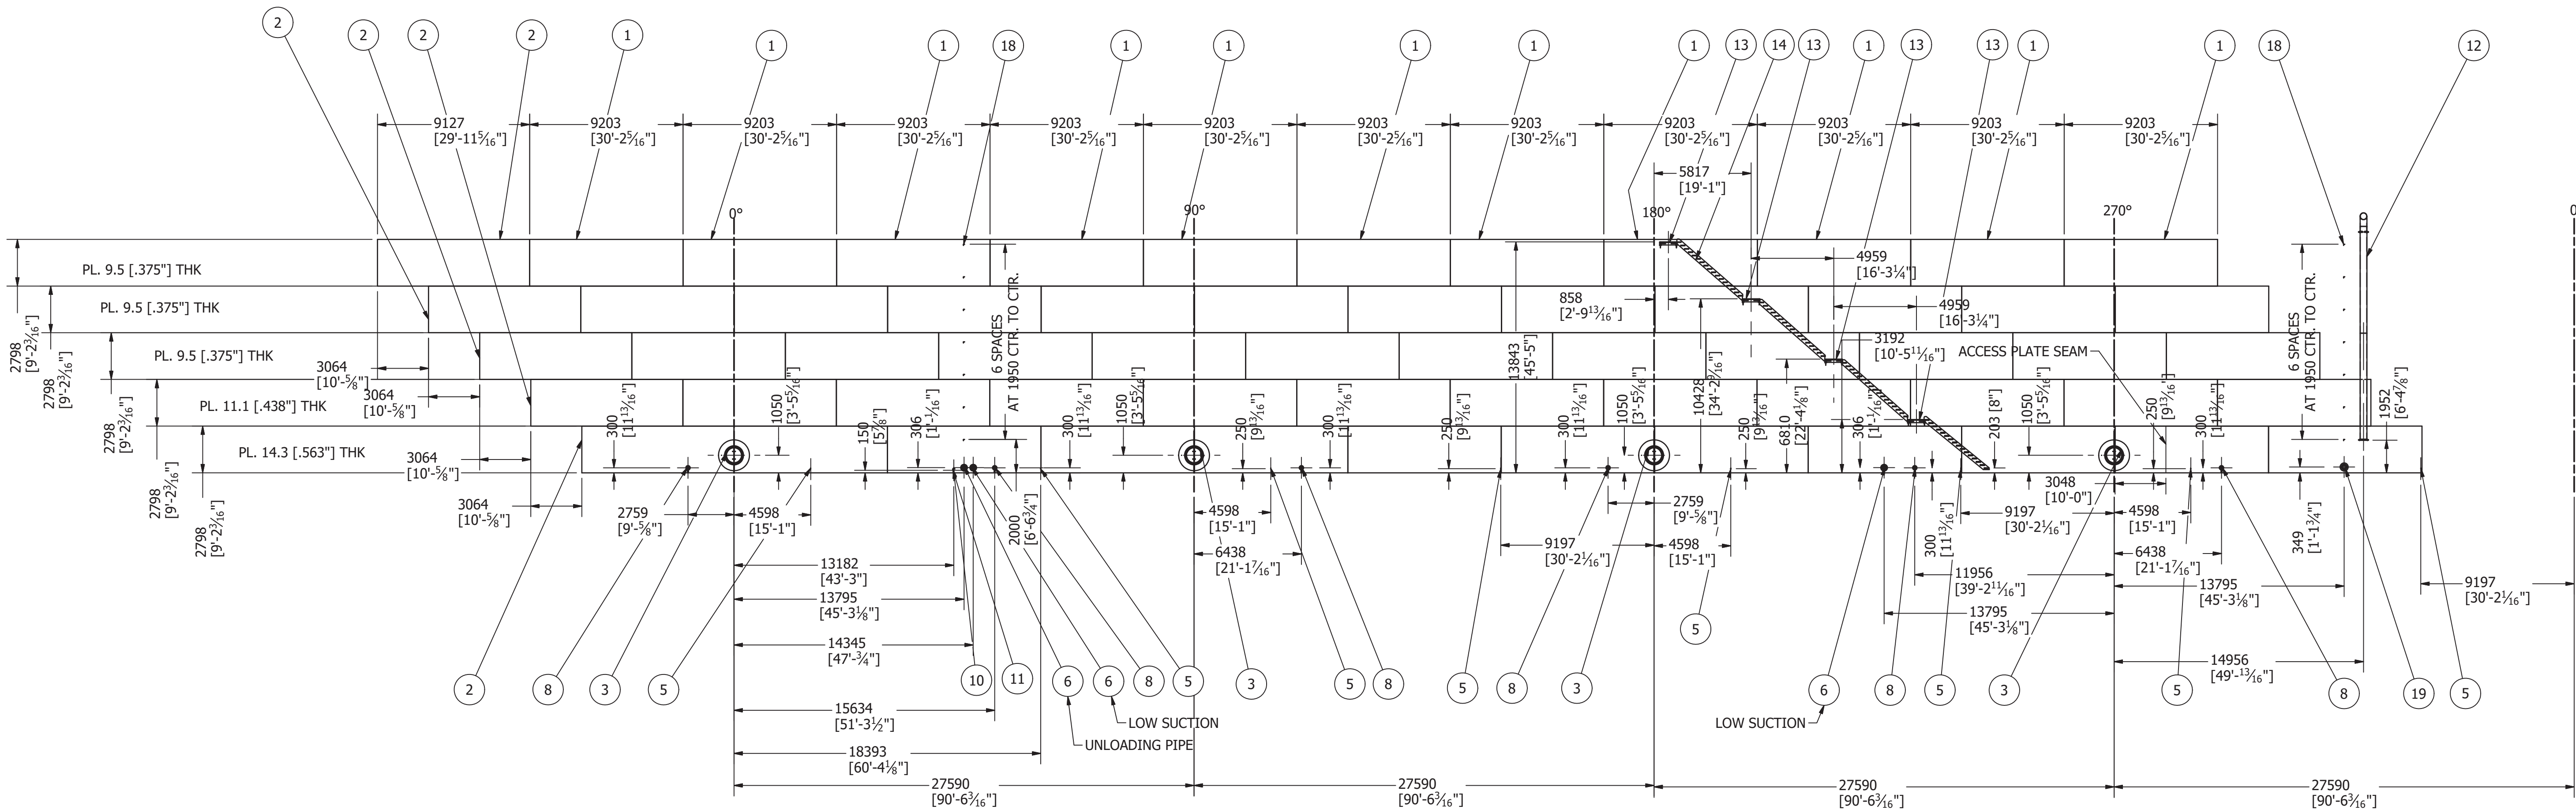


SHELL DEVELOPED VIEW  
SCALE 1/200

**AS-BUILT**  
BY Inukshuk Construction Ltd. DATE 2017/10/02




PROFESSIONAL ENGINEER  
30-Sep-2017  
Permit Number: P471

REVISION HISTORY		
REV	DESCRIPTION	DATE
6	THIS SHEET ADDED	7/12/2017
7	INCORPORATE FIELD MODIFICATION	9/27/2017
DEVELOP VIEW		
TITLE		
AGNICO EAGLE - MELIADINE GOLD MINE - TK #2 - 13,500CUM 35.1M DIA X 14M H		
SIZE		
A1	DWG NO 295-M10	REV 7
SCALE		
SHEET 7 OF 7		



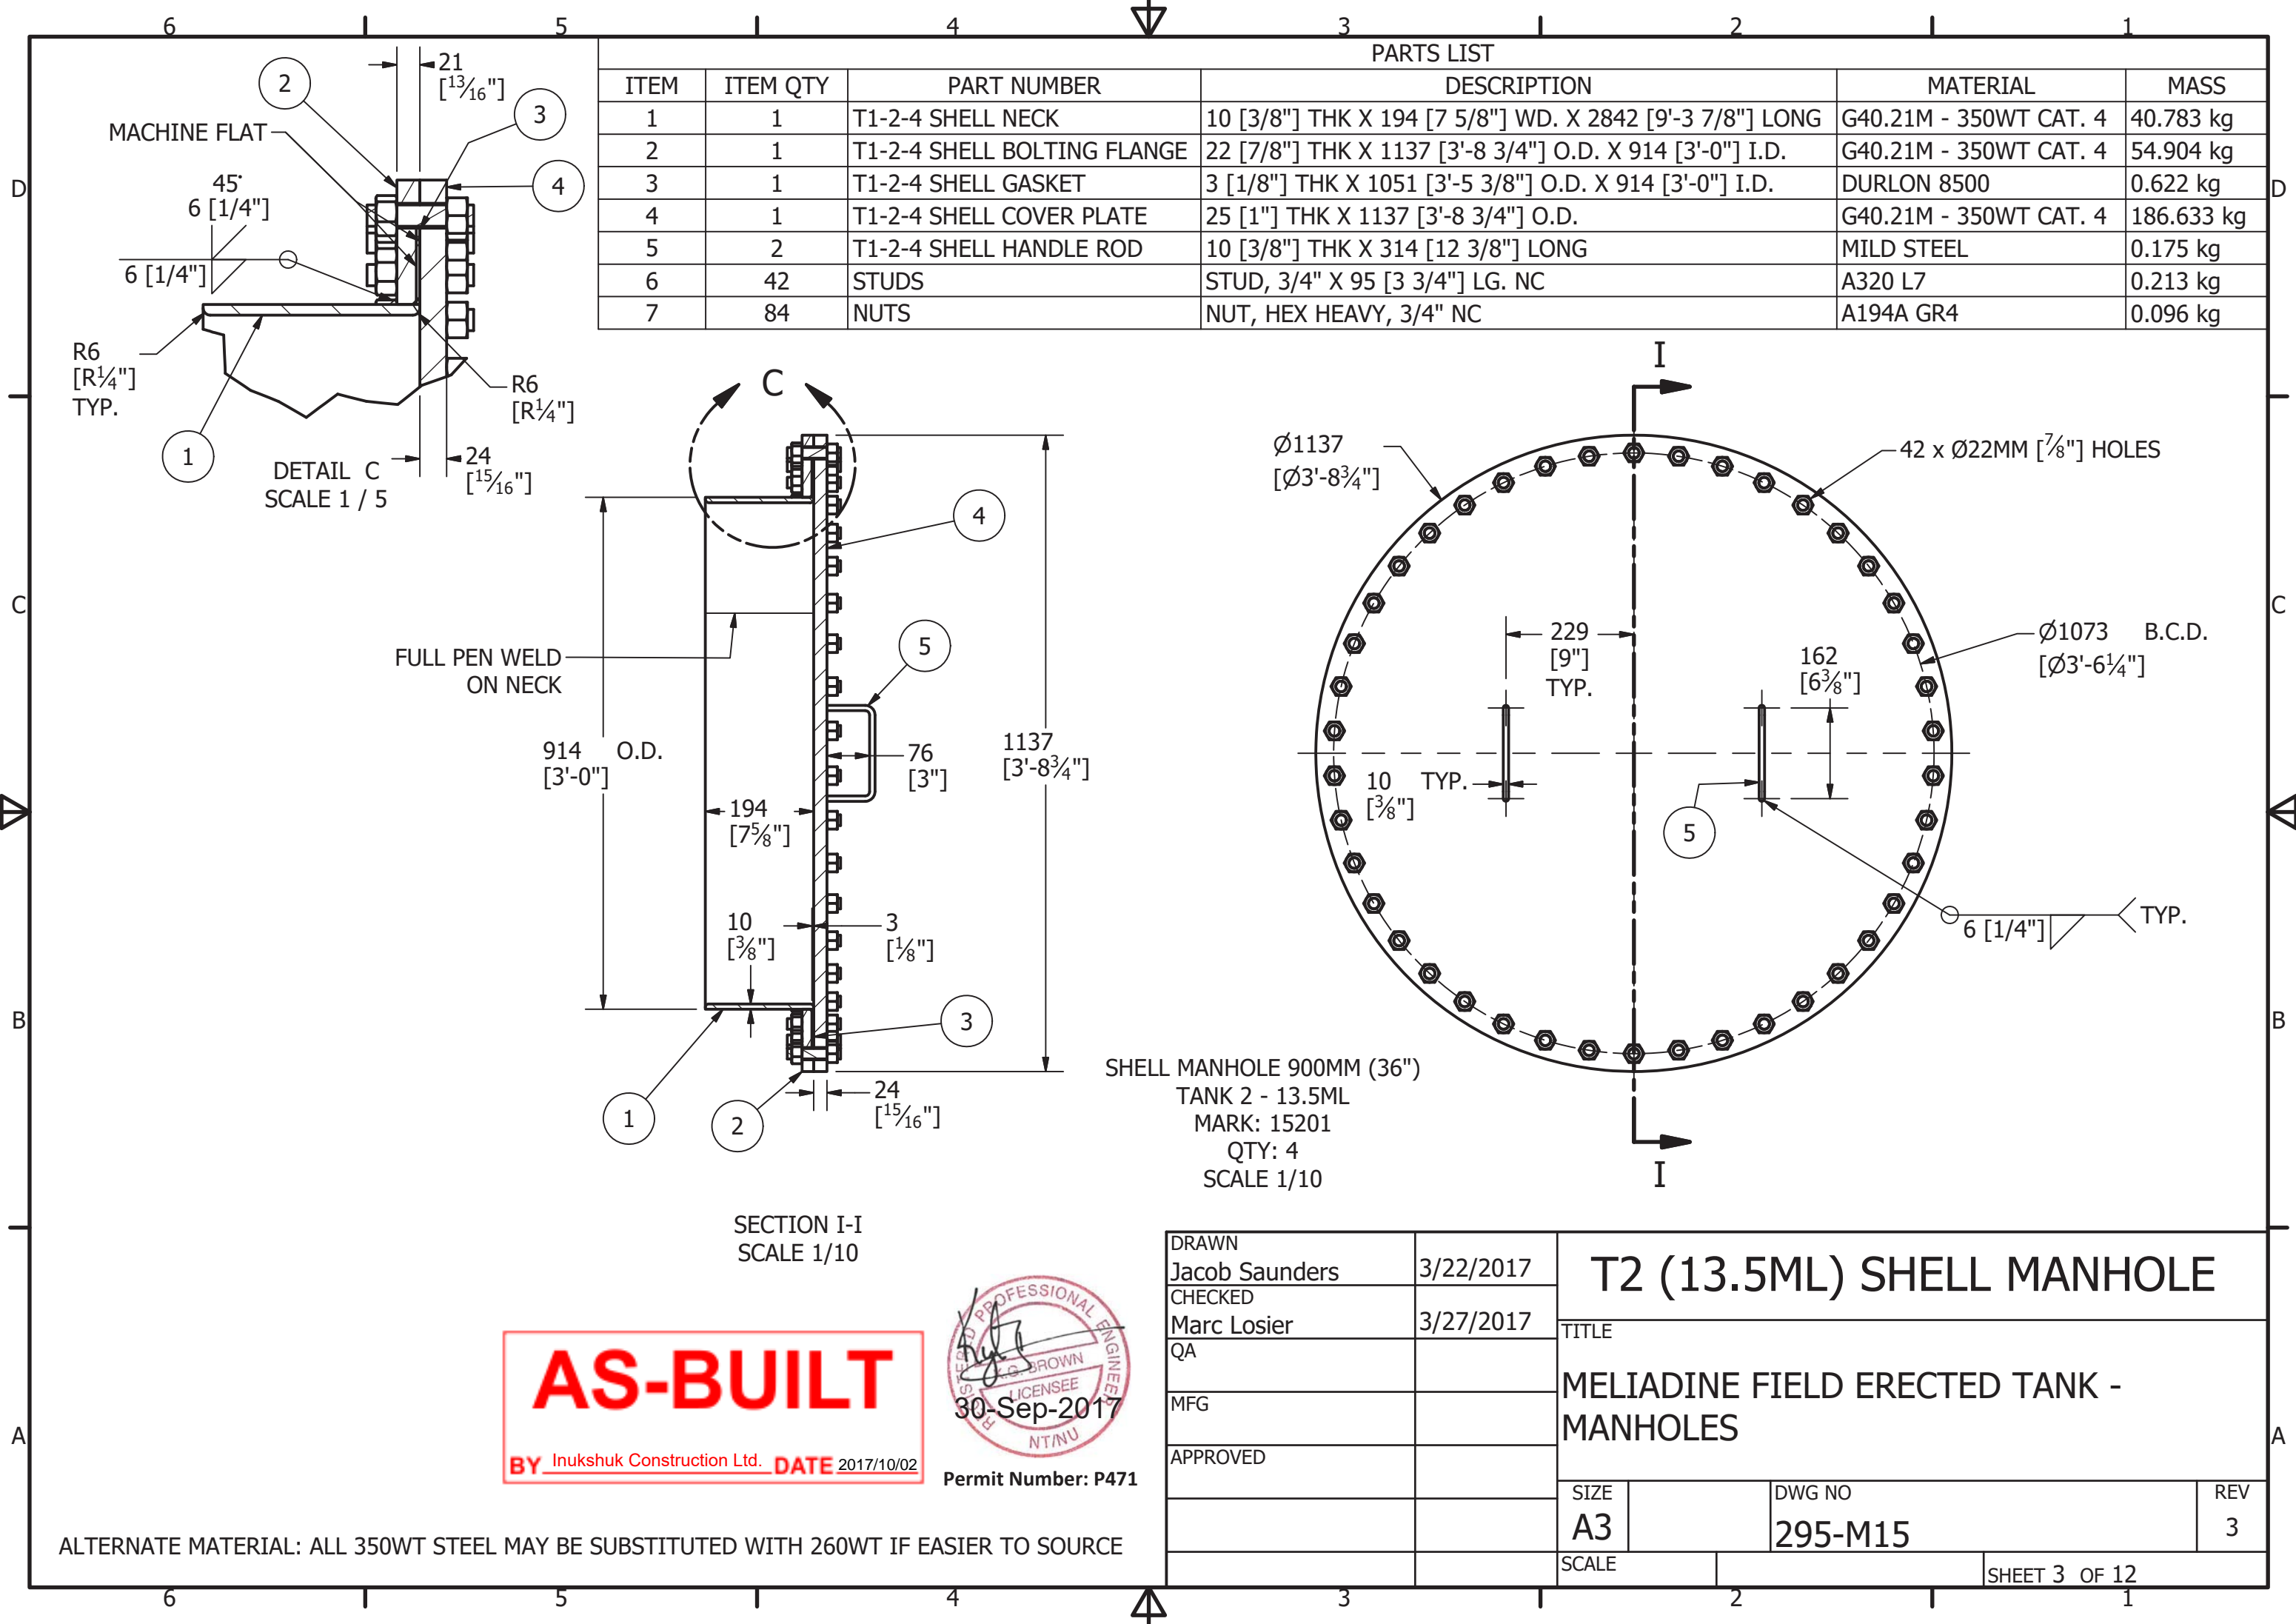

PARTS LIST					
ITEM	ITEM QTY	PART NUMBER	DESCRIPTION	MATERIAL	MASS
1	1	T1-2-4 SHELL NECK	10 [3/8"] THK X 194 [7 5/8"] WD. X 2842 [9'-3 7/8"] LONG	G40.21M - 350WT CAT. 4	40.783 kg
2	1	T1-2-4 SHELL BOLTING FLANGE	22 [7/8"] THK X 1137 [3'-8 3/4"] O.D. X 914 [3'-0"] I.D.	G40.21M - 350WT CAT. 4	54.904 kg
3	1	T1-2-4 SHELL GASKET	3 [1/8"] THK X 1051 [3'-5 3/8"] O.D. X 914 [3'-0"] I.D.	DURLON 8500	0.622 kg
4	1	T1-2-4 SHELL COVER PLATE	25 [1"] THK X 1137 [3'-8 3/4"] O.D.	G40.21M - 350WT CAT. 4	186.633 kg
5	2	T1-2-4 SHELL HANDLE ROD	10 [3/8"] THK X 314 [12 3/8"] LONG	MILD STEEL	0.175 kg
6	42	STUDS	STUD, 3/4" X 95 [3 3/4"] LG. NC	A320 L7	0.213 kg
7	84	NUTS	NUT, HEX HEAVY, 3/4" NC	A194A GR4	0.096 kg

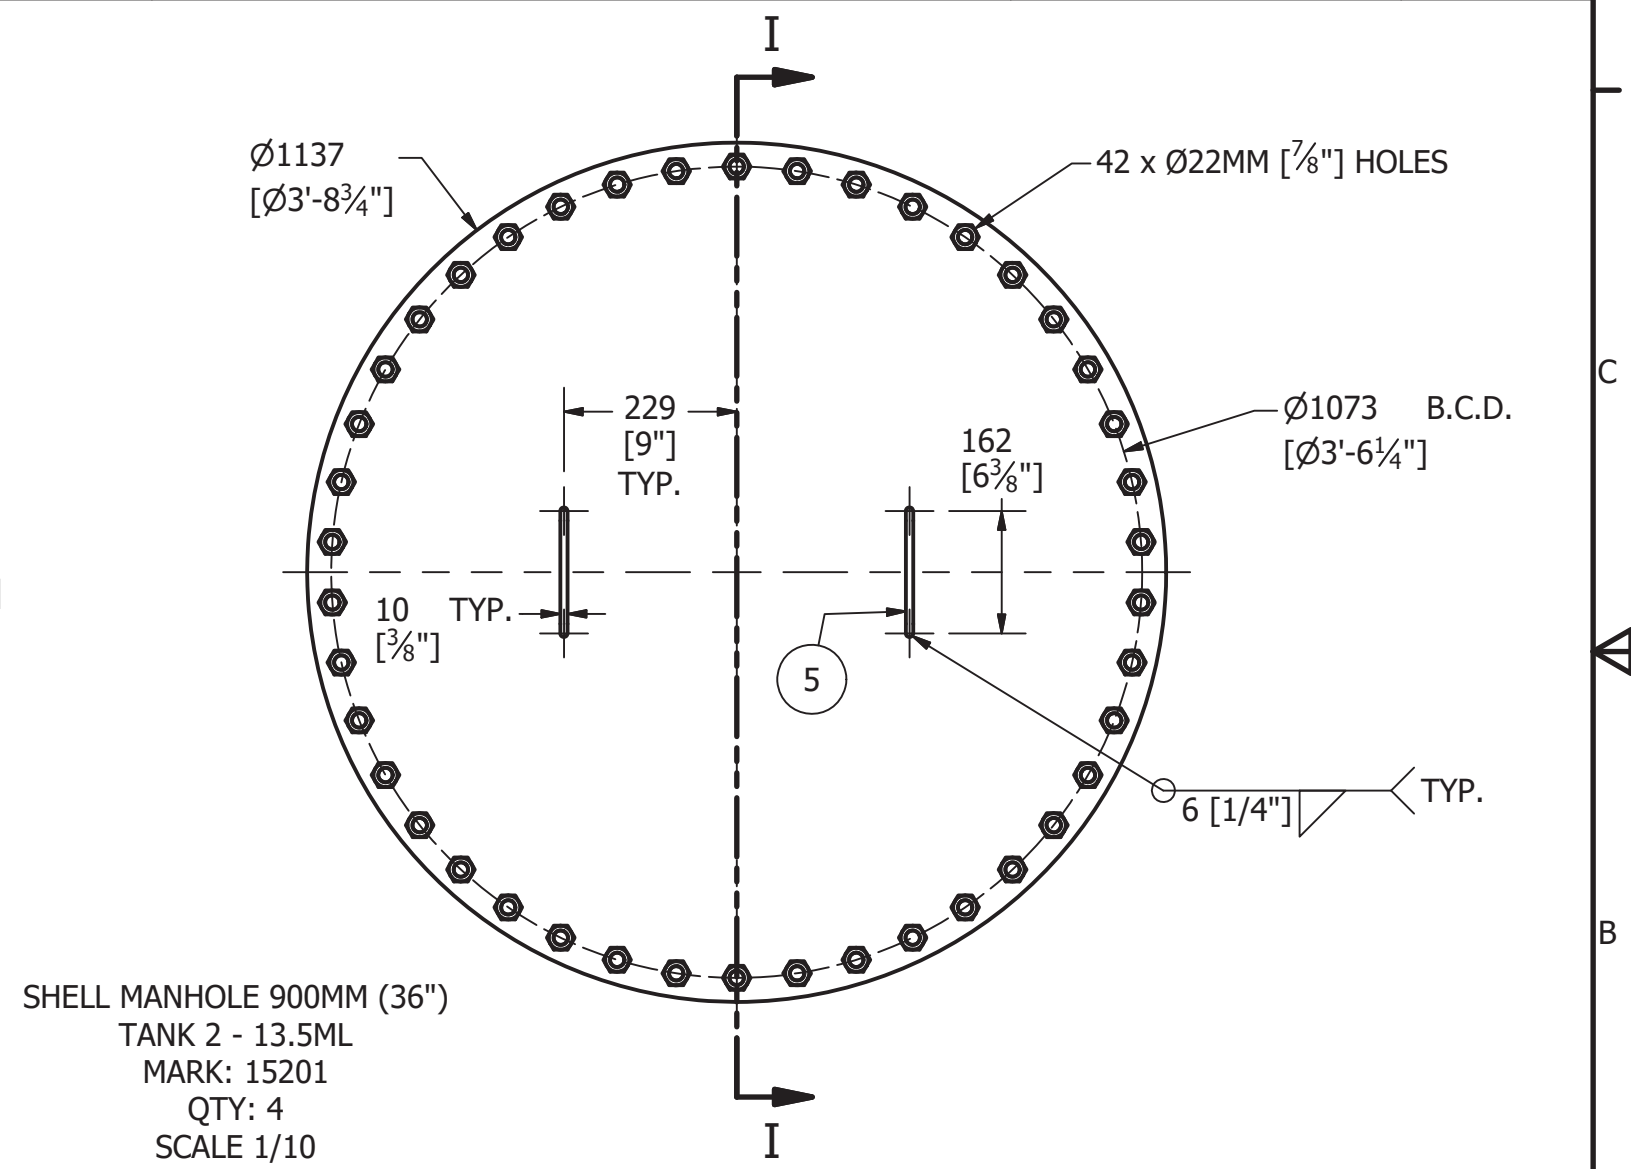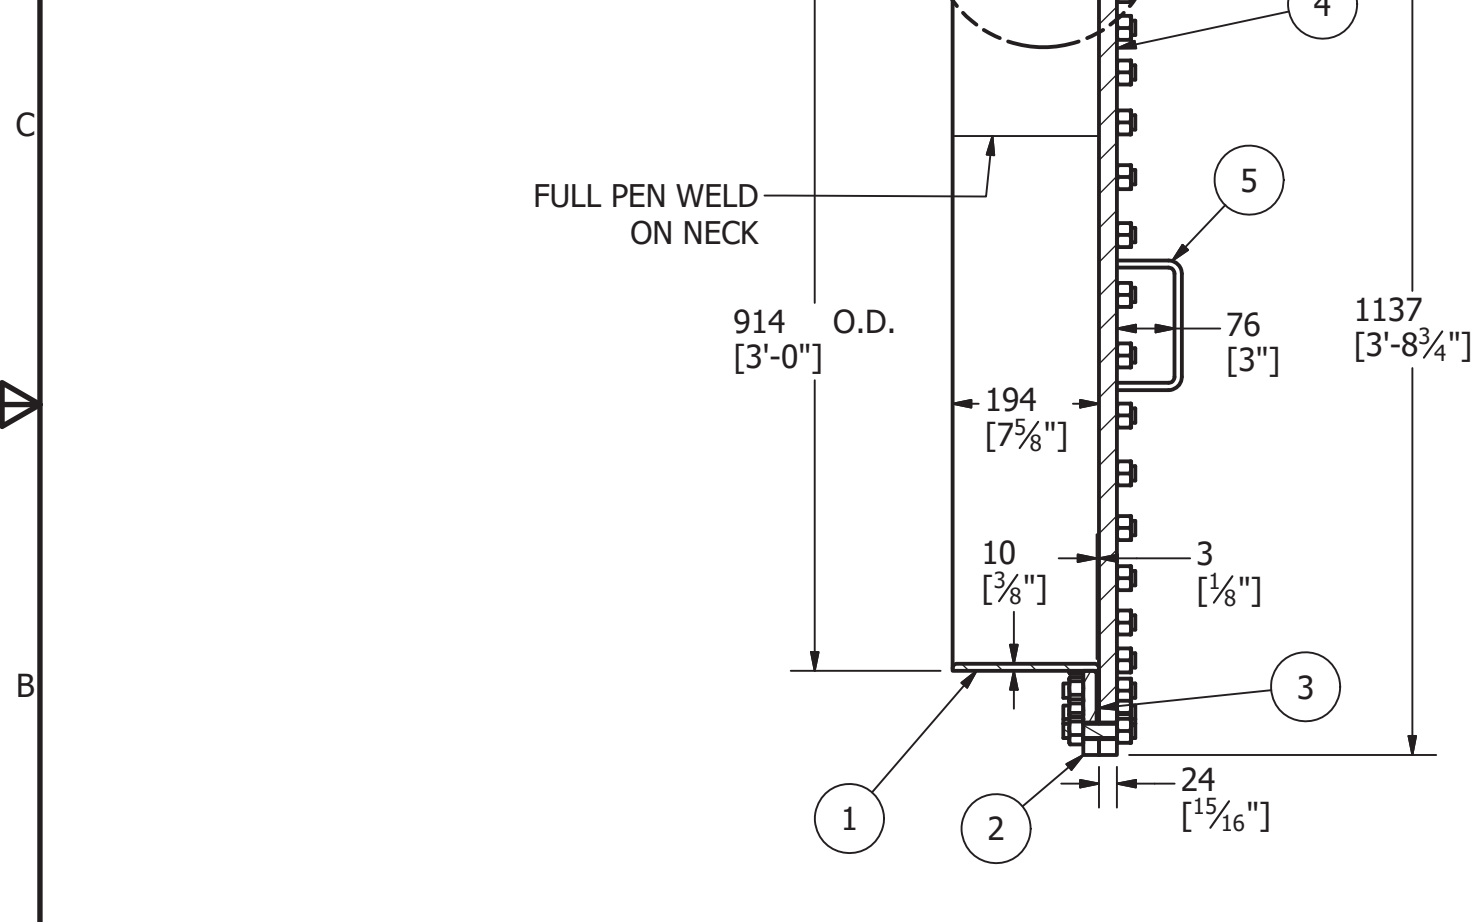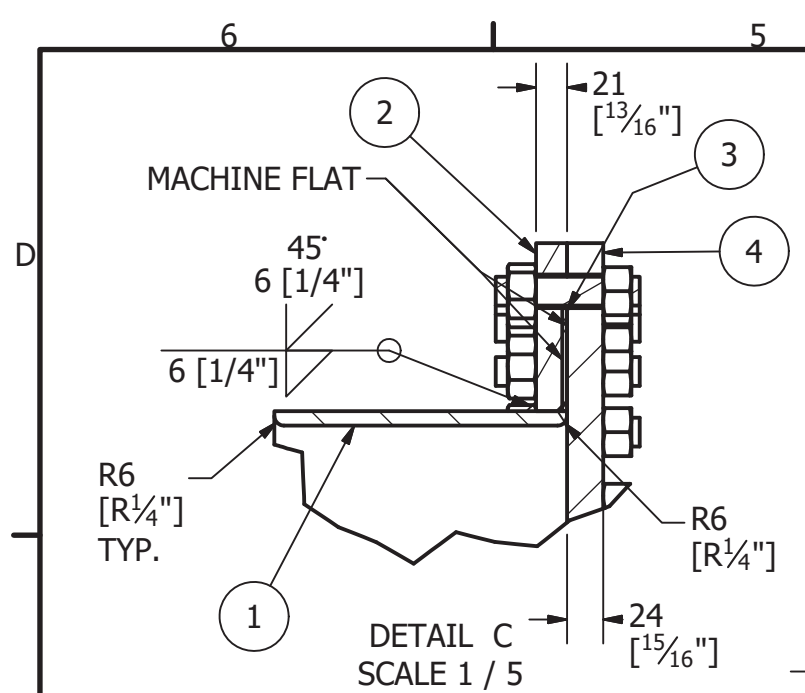

**AS-BUILT**

BY Inukshuk Construction Ltd. DATE 2017/10/02






Permit Number: P471

DRAWN Jacob Saunders	3/22/2017	T2 (13.5ML) SHELL MANHOLE		
CHECKED Marc Losier	3/27/2017			
QA		MELIADINE FIELD ERECTED TANK - MANHOLES		
MFG				
APPROVED		SIZE A3		
		SCALE	DWG NO 295-M15	REV 3
		SHEET 3 OF 12		

ALTERNATE MATERIAL: ALL 350WT STEEL MAY BE SUBSTITUTED WITH 260WT IF EASIER TO SOURCE

PARTS LIST					
ITEM	ITEM QTY	PART NUMBER	DESCRIPTION	MATERIAL	MASS
1	1	ROOF NECK	6 [1/4"] THK X 216 [8 1/2"] WD X 1935 [6' - 4 3/16"] LG	G40.21M 300W	20.825 kg
2	1	ROOF BOLTING FLANGE	6 [1/4"] THK X 762 [2'-6"] O.D. X 622 [2'-1/2"] I.D.	G40.21M 300W	7.287 kg
4	1	ROOF COVER PLATE	6 [1/4"] THK X 762 [2'-6"] DIA	G40.21M 300W	22.448 kg
5	2	ROOF HANDLE ROD	16 [5/8"] DIA X 314 [12 3/8"] LG.	Steel, MILD	0.506 kg
6	20	STUDS	STUD, 5/8" X 57 [2 1/4"] LG. NC	A320 L7	0.089 kg
7	40	NUTS	NUT, HEX HEAVY, 5/8"	A194A GR4	0.059 kg
8	1	295-P1 Gasket 24in (600mm)		Rubber	0.216 kg

SECTION J-J  
SCALE 1/10

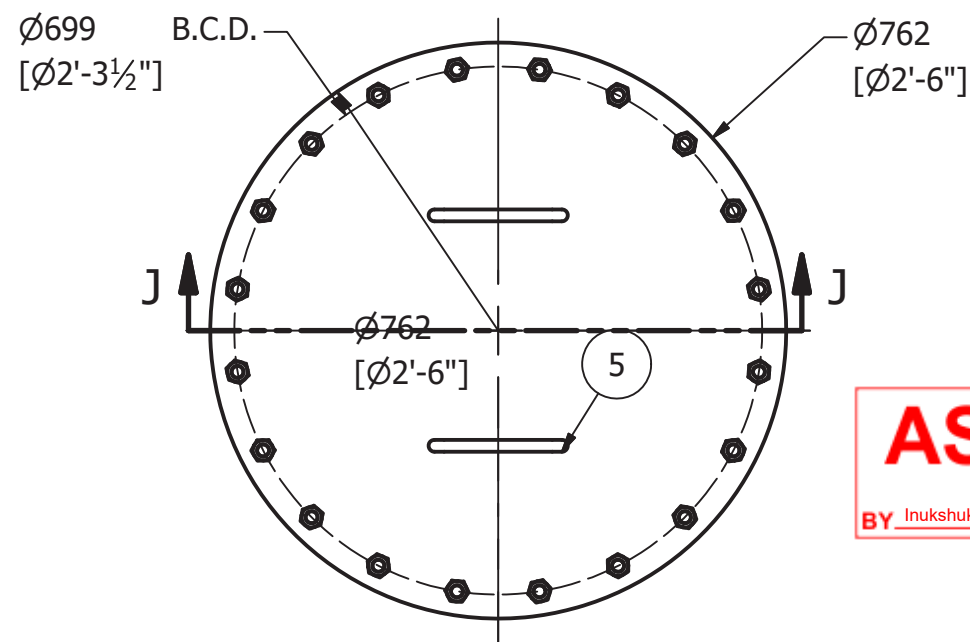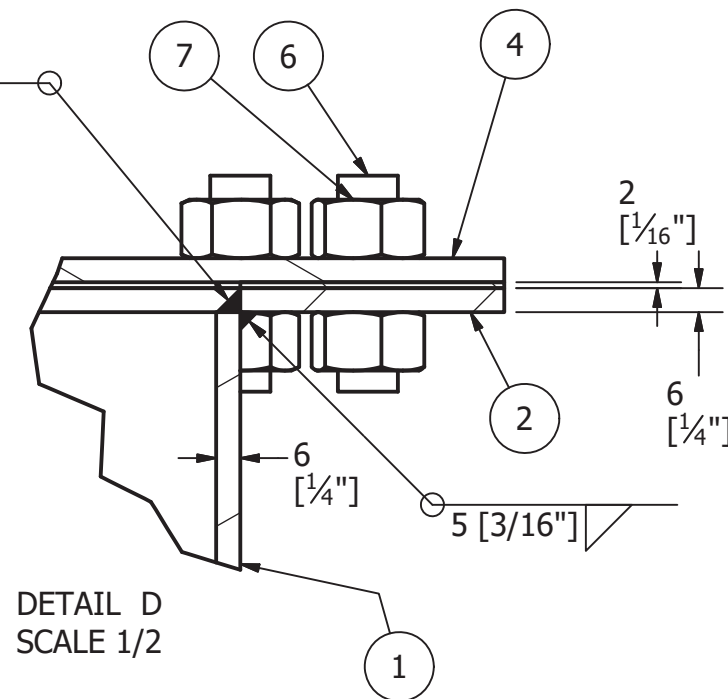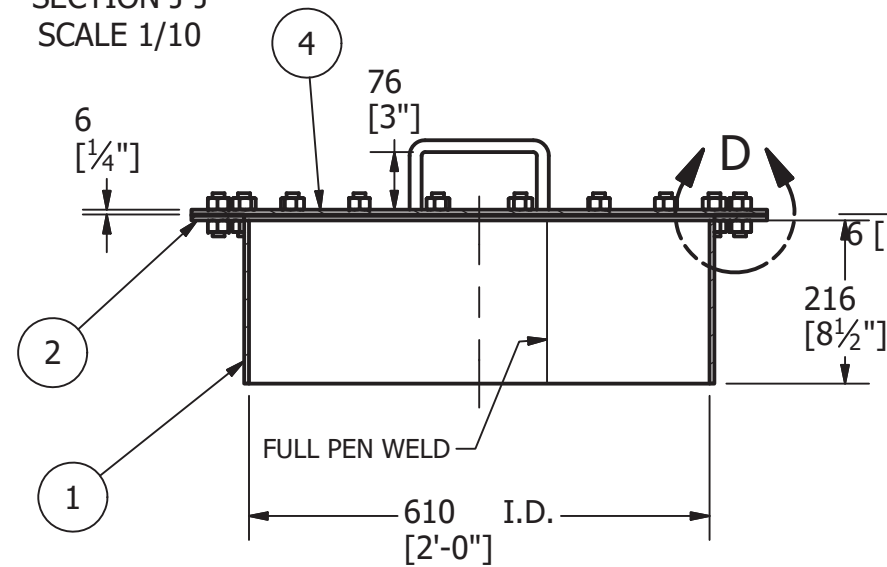

ROOF MANHOLE 600MM (24")  
TANK 2 - 13.5ML  
MARK: 15202  
QTY: 4  
SCALE 1/10

**AS-BUILT**  
BY Inukshuk Construction Ltd. DATE 2017/10/02



Permit Number: P471

ALTERNATE MATERIAL: ALL 350WT STEEL MAY BE SUBSTITUTED WITH 260WT IF EASIER TO SOURCE

REVISION HISTORY					
ZONE	REV	DESCRIPTION			DATE
	2	EMERGENCY VENT/MANHOLE DETAIL ADDED			4/13/2017
	3	EMERGENCY VENT/MANHOLE DETAIL REMOVED			7/9/2017
DRAWN Jacob Saunders		3/22/2017	T2 (13.5ML) ROOF MANHOLE		
CHECKED Marc Losier		3/27/2017			
QA					
MFG					
APPROVED					
			TITLE  MELIADINE FIELD ERECTED TANK - MANHOLES		
		SIZE A3	DWG NO 295-M15		REV 3
		SCALE			SHEET 4 OF 12



SHOP DRAWING  
DATA SHEET

*Affixing this stamp confirms that an administrative approval and/or a verification of compliance with shop drawings or specifications was made, but does not entail the liability of the author of the work or its owner with regards to this shop drawing or data sheet, for which the contractor is the sole responsible.*

☒ Reviewed

☐ Reviewed as noted

☐ Rejected

☐ Filed for records

*The contractor, supplier and/or sub-contractor is responsible for: confirming and coordinating all quantities and dimensions; selecting fabrication processes and techniques of construction; coordinating his or her work with that of all other trades and performing all work in a safe and satisfactory manner.*

By: J. morliere

Date: 2017/07/14

Project #: 151-06440-40



Parts List				
ITEM	ITEM QTY	CUT (MM)	PART NUMBER	MATERIAL
1	2		ASME B16.5 Flange Slip-On Welding - Class 150 8	A350 LF2
2	1	375	Pipe 8 - Schedule 80 - 14.76378	A333 GR. 6

Ø200 NS DOUBLE FLANGE  
SHELL LOADING  
MARK: M1601  
QTY: 2

WEIGHT/SPOOL: 48.2KG

M1601 QTY	
Tank No.	QTY
1	1
2	1
3	0
4	0
5	0
6	0
TOTAL	2

- NOTES:
- ALL DIMENSIONS ARE IN MM UNLESS OTHERWISE NOTED
  - FINISH: SANDBLAST TO SSP-6

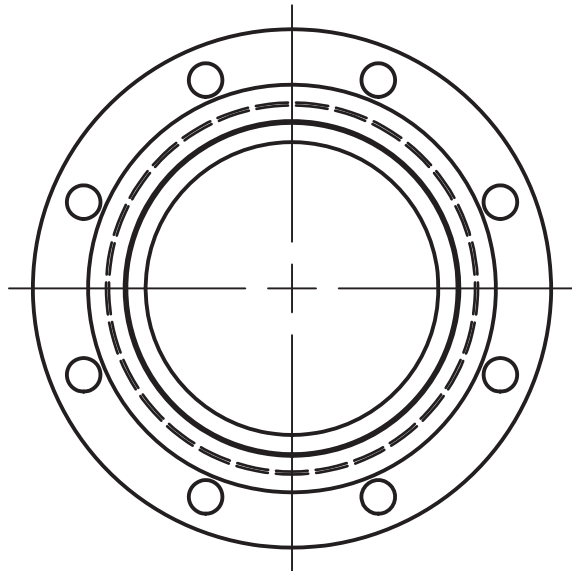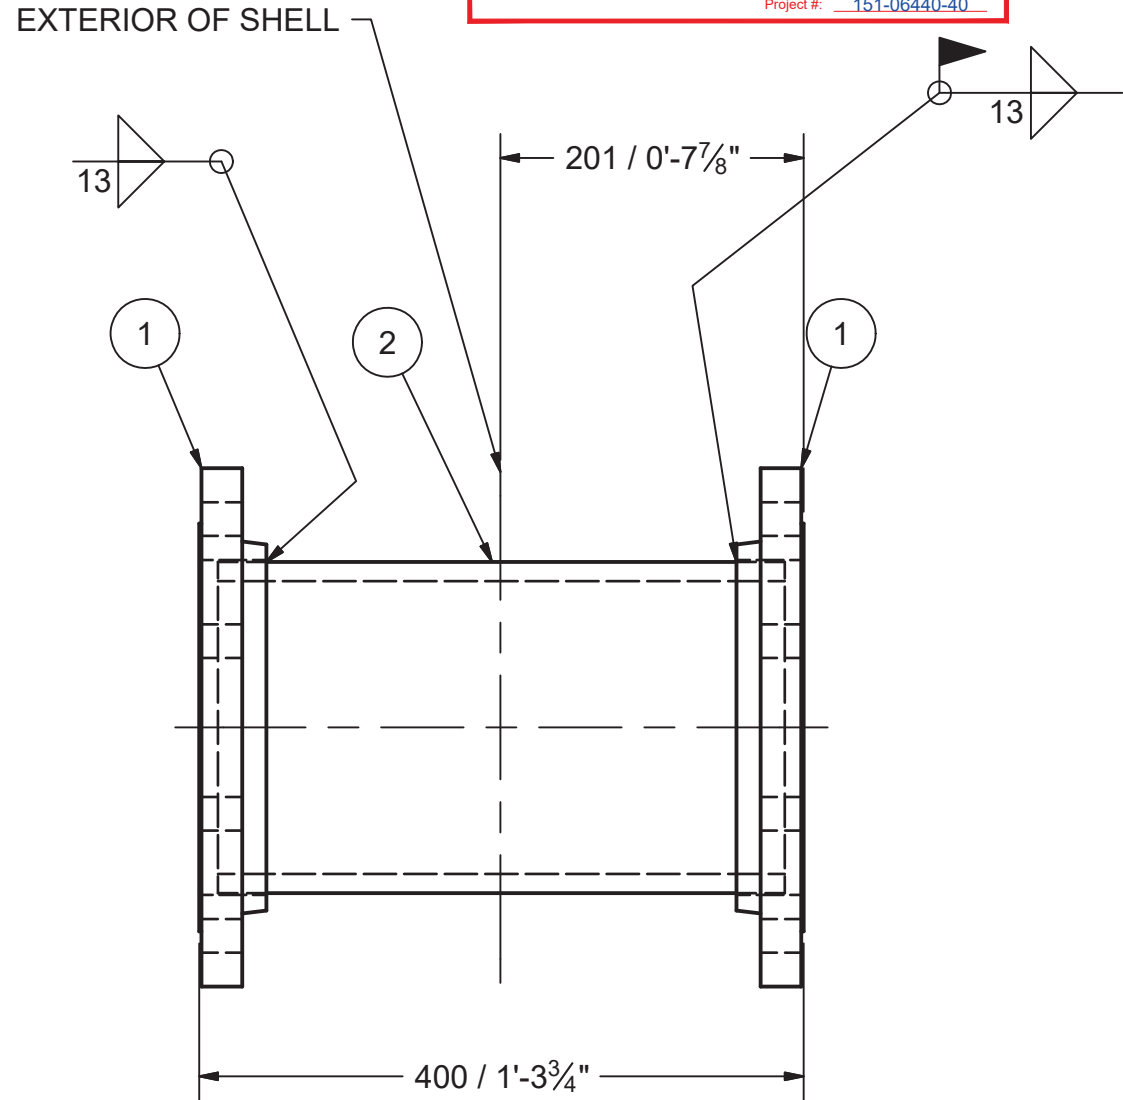


AS-BUILT

BY Inukshuk Construction Ltd. DATE 2017/10/02



16-Jul-2017  
Permit Number: P471

REVISION HISTORY				
REV	DESCRIPTION			DATE
3	ALL SHEETS REVISED AS PER ENGINEER COMMENTS			5/1/2017
DRAWN Jacob Saunders	4/13/2017	AEM Meliadine Fuel Storage Tanks		
CHECKED				
QA				
MFG				
APPROVED				
		M1601 - 200NS DOUBLE FLG. SHELL		
		SIZE A3	DWG NO 295-M16	REV 3
		SCALE	SHEET 1 OF 22	

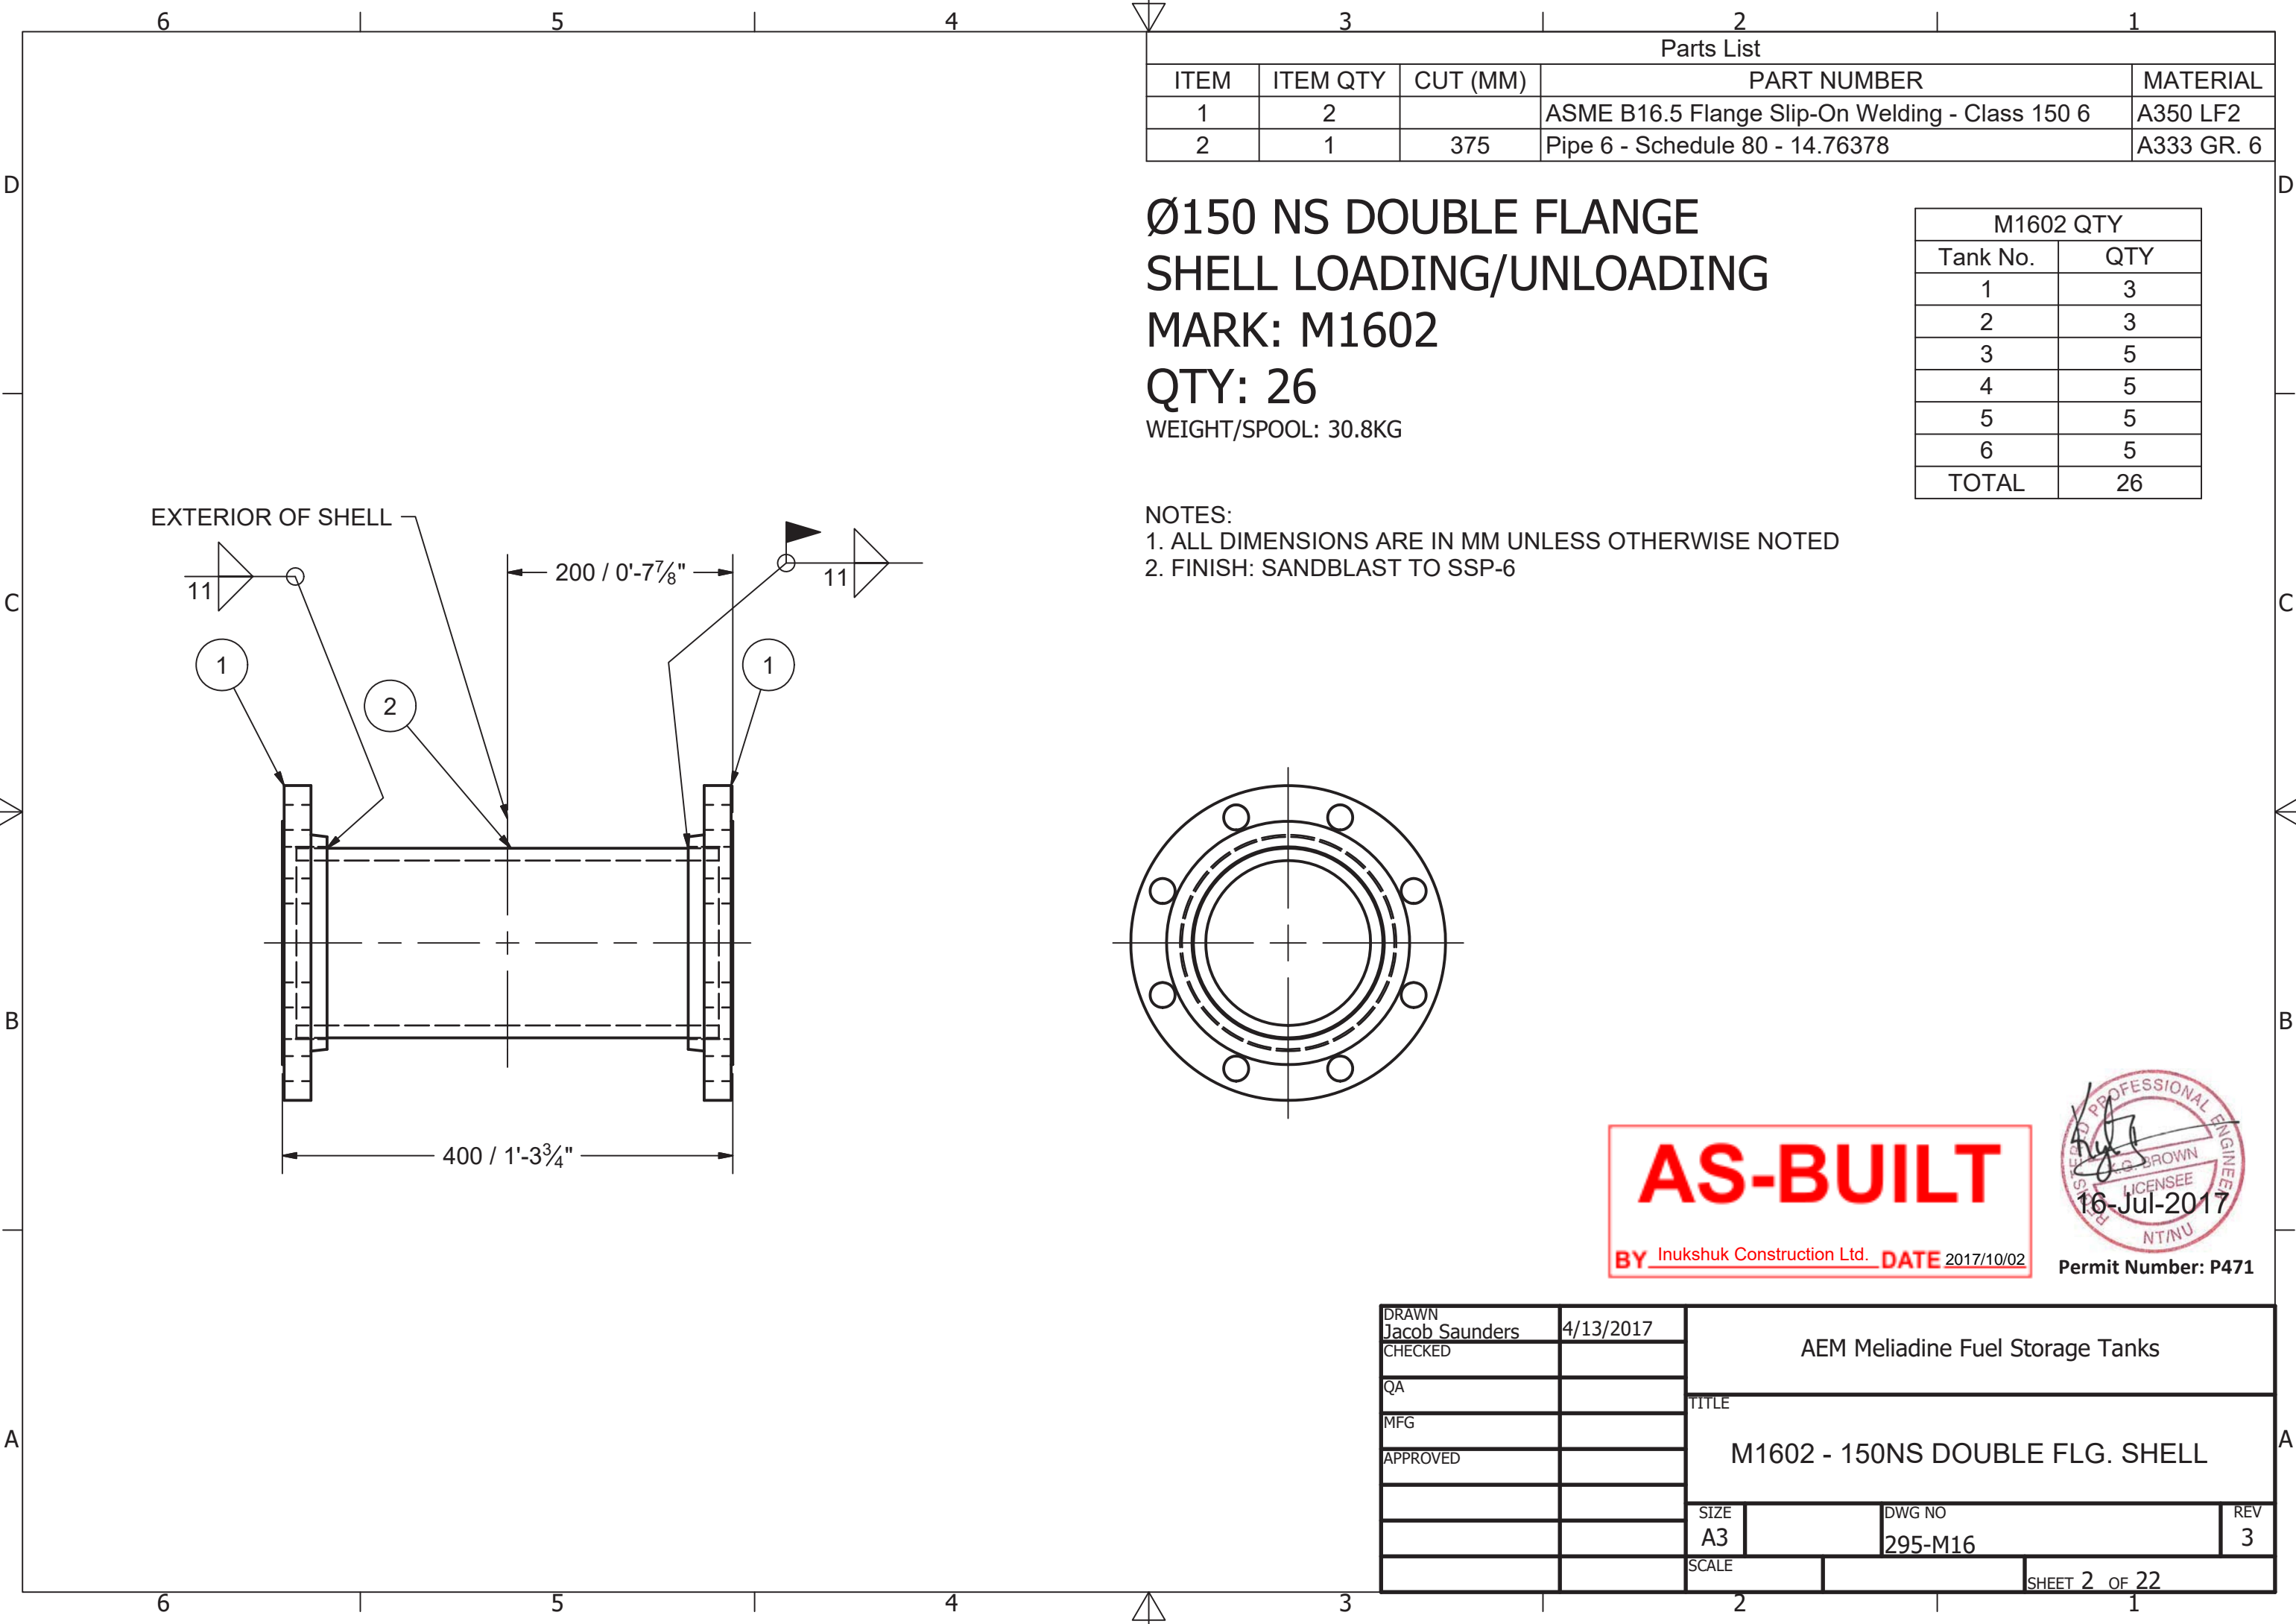

Parts List				
ITEM	ITEM QTY	CUT (MM)	PART NUMBER	MATERIAL
1	2		ASME B16.5 Flange Slip-On Welding - Class 150 6	A350 LF2
2	1	375	Pipe 6 - Schedule 80 - 14.76378	A333 GR. 6

Ø150 NS DOUBLE FLANGE  
SHELL LOADING/UNLOADING  
MARK: M1602  
QTY: 26  
WEIGHT/SPOOL: 30.8KG

M1602 QTY	
Tank No.	QTY
1	3
2	3
3	5
4	5
5	5
6	5
TOTAL	26

NOTES:  
1. ALL DIMENSIONS ARE IN MM UNLESS OTHERWISE NOTED  
2. FINISH: SANDBLAST TO SSP-6

AS-BUILT

BY Inukshuk Construction Ltd. DATE 2017/10/02

Permit Number: P471

DRAWN Jacob Saunders	4/13/2017	AEM Meliadine Fuel Storage Tanks		
CHECKED				
QA		M1602 - 150NS DOUBLE FLG. SHELL		
MFG				
APPROVED				
		SIZE A3	DWG NO 295-M16	REV 3
		SCALE	SHEET 2 OF 22	






Ø200 NS FIXED PIPE LOADING  
TANK 2 (13.5ML)  
MARK: M1604  
QTY: 1

WEIGHT/SPOOL: 508.5KG

Parts List				
ITEM	ITEM QTY	CUT (MM)	PART NUMBER	MATERIAL
1	1		ASME B16.9 Long Radius 90 Deg Elbow (Inch) 8 x 0.322 SCH40	A420 WPL6
2	1		ASME B16.5 Flange Slip-On Welding - Class 150 8	A350 LF2
3	1	6401	Pipe 8 - Schedule 40 - 440.28	A333 GR. 6
4	1	4782	ASTM A 53/A 53M Pipe 8 - Schedule 40 - 188.27764	Steel

M1604 QTY	
Tank No.	QTY
1	0
2	1
3	0
4	0
5	0
6	0
TOTAL	1

NOTES:  
1. ALL DIMENSIONS ARE IN MM UNLESS OTHERWISE NOTED  
2. FINISH: BARE

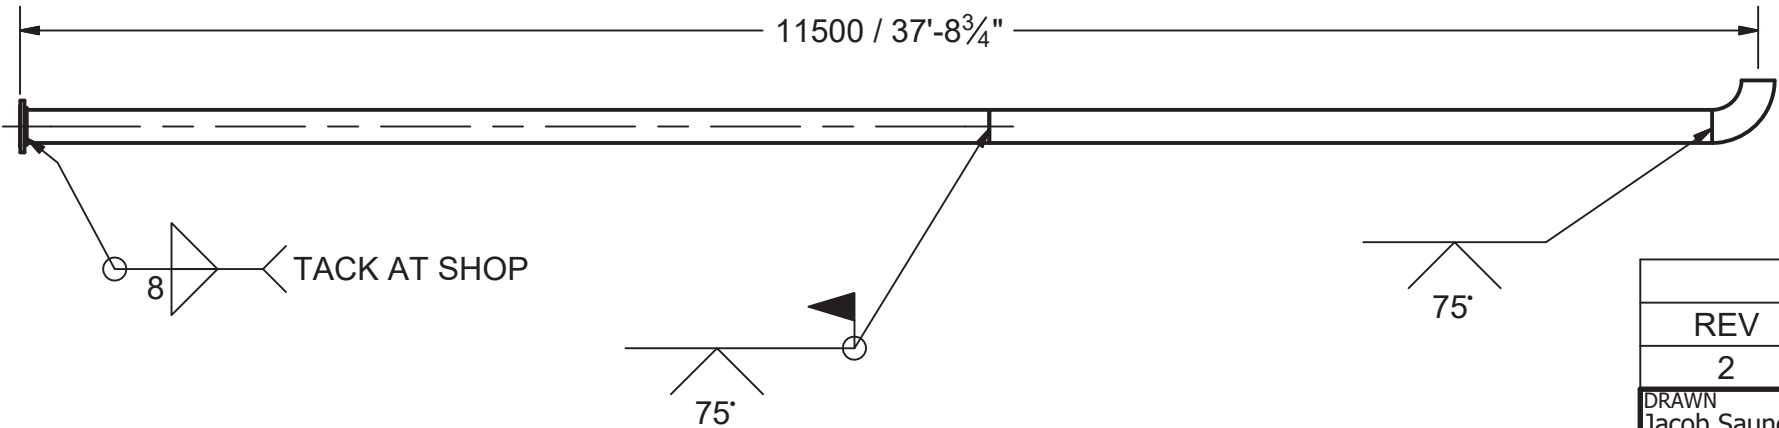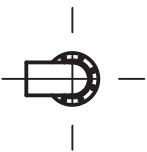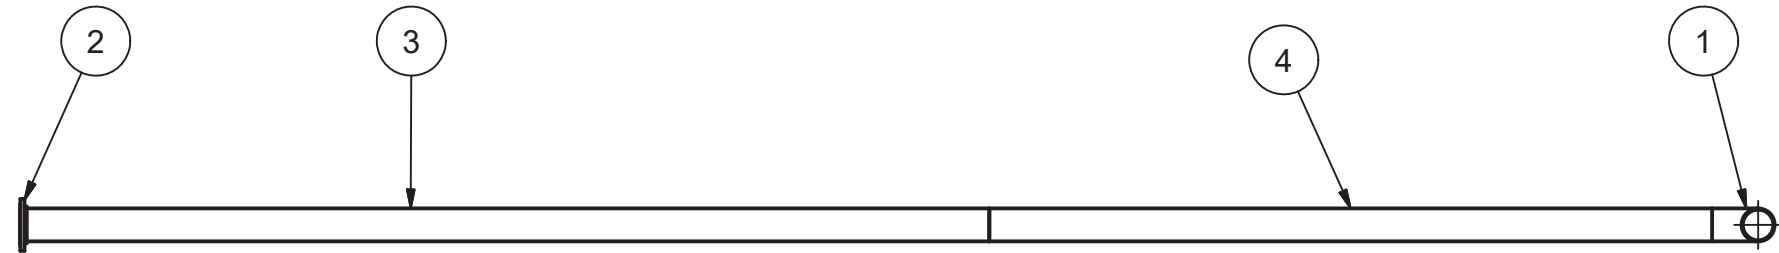

**AS-BUILT**  
BY Inukshuk Construction Ltd. DATE 2017/10/02



Permit Number: P471

REVISION HISTORY				
REV	DESCRIPTION			DATE
2	NOTE 2 CHANGED, PIPE BROKEN IN SECTIONS			5/11/2017
DRAWN Jacob Saunders		4/13/2017	AEM Meliadine Fuel Storage Tanks	
CHECKED				
QA				
MFG				
APPROVED			M1604 - 200NS FIXED PIPE LOADING	
			SIZE A3	DWG NO 295-M16
			SCALE	REV 3
SHEET 4 OF 22				


Parts List				
ITEM	ITEM QTY	CUT (MM)	PART NUMBER	MATERIAL
1	1		ASME B16.5 Flange Slip-On Welding - Class 150 6	A350 LF2
2	1		ASME B16.9 Long Radius 90 Deg Elbow (Inch) 6 x 0.28 SCH40	A420 WPL6
3	1	6401	Pipe 6 - Schedule 40 - 446.88977	A333 GR. 6
4	1	4950	Pipe 6 - Schedule 40 - 194.88976	A333 GR. 6

Ø150 NS FIXED PIPE UNLOADING  
TANK 2 (13.5ML)  
MARK: M1609

QTY: 1  
WEIGHT/SPOOL: 326.1KG

M1609 QTY	
Tank No.	QTY
1	0
2	1
3	0
4	0
5	0
6	0
TOTAL	1

NOTES:  
1. ALL DIMENSIONS ARE IN MM UNLESS OTHERWISE NOTED  
2. FINISH: BARE

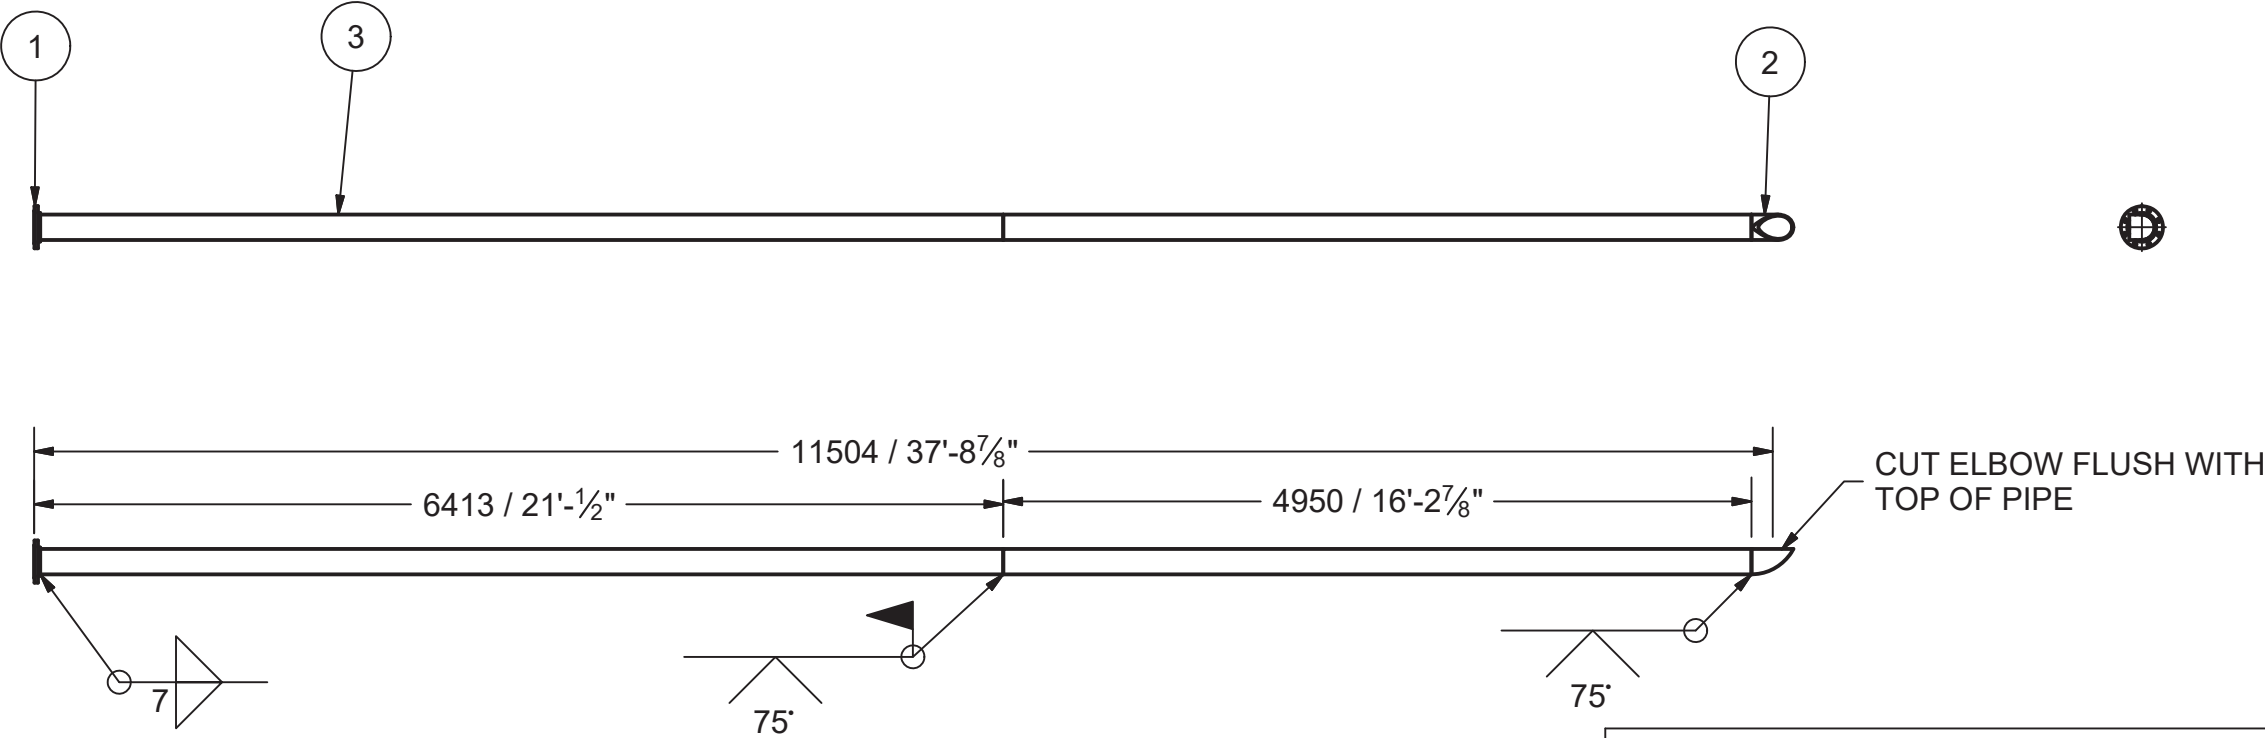

**AS-BUILT**  
BY Inukshuk Construction Ltd. DATE 2017/10/02



Permit Number: P471



REVISION HISTORY			
REV	DESCRIPTION		DATE
2	NOTE 2 CHANGED, PIPE BROKEN IN SECTIONS		5/11/2017
DRAWN Jacob Saunders		4/13/2017	AEM Meliadine Fuel Storage Tanks
CHECKED			
QA			
MFG			
APPROVED			M1609 - 150NS FIXED PIPE UNLOADING
		SIZE A3	DWG NO 295-M16
		SCALE	REV 3
SHEET 9 OF 22			

Parts List				
ITEM	ITEM QTY	CUT (MM)	PART NUMBER	MATERIAL
1	1		ASME B16.5 Flange Slip-On Welding - Class 150 6	A350 LF2
2	1	203	Pipe 6 - Schedule 40 - 8	A333 GR. 6
3	1		ASME B16.9 Long Radius 90 Deg Elbow - 6 SCH40	A420 WPL6

Ø150 NS PIPING LOW LEVEL  
MARK: M1613  
QTY: 16  
WEIGHT/SPOOL: 23.3KG

M1613 QTY	
Tank No.	QTY
1	2
2	2
3	3
4	3
5	3
6	3
TOTAL	16

NOTES:  
1. ALL DIMENSIONS ARE IN MM UNLESS OTHERWISE NOTED  
2. FINISH: BARE

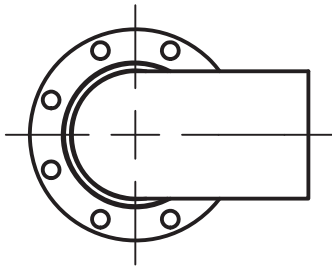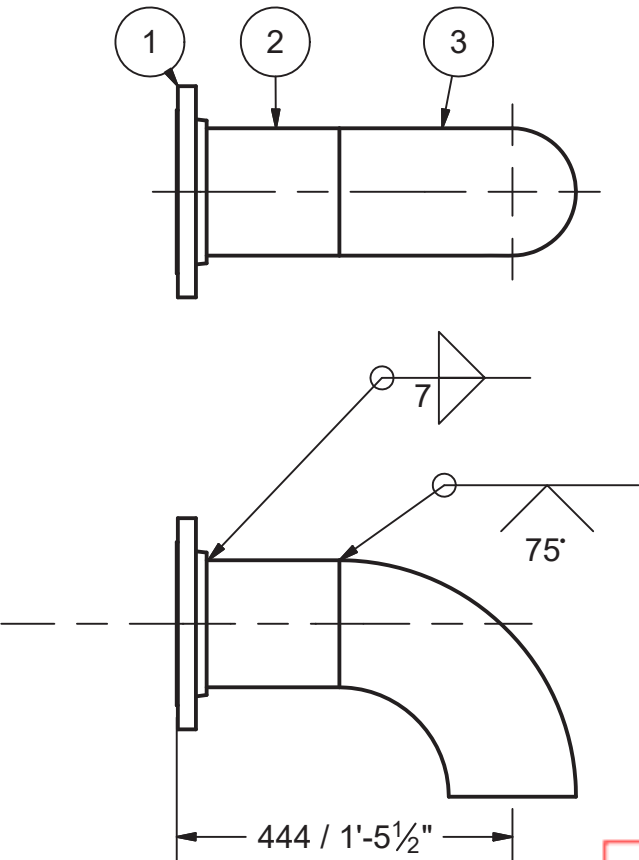

**AS-BUILT**  
BY Inukshuk Construction Ltd. DATE 2017/10/02



Permit Number: P471


REVISION HISTORY				
REV	DESCRIPTION			DATE
2	NOTE 2 CHANGED			5/11/2017
DRAWN Jacob Saunders	4/13/2017	AEM Meliadine Fuel Storage Tanks		
CHECKED				
QA				
MFG				
APPROVED		TITLE  M1613 - 150NS PIPING LOW LEVEL		
		SIZE A3	DWG NO 295-M16	REV 3
		SCALE		SHEET 13 OF 22



Ø75 NS WATER DRAW OFF  
MARK: M1614  
QTY: 32

WEIGHT/SPOOL: 16.6KG

Parts List				
ITEM	ITEM QTY	CUT (MM)	PART NUMBER	MATERIAL
1	1		ASME B16.5 Flange Slip-On Welding - Class 150 3	A350 LF2
2	1	316	Pipe 3 - Schedule 80 - 12.440945	A333 GR. 6
3	1		ASME B16.9 Long Radius 90 Deg Elbow (Inch) 2 x 0.218 SCH80	A420
4	1		ASME B16.9 Eccentric Reducer 3 x 2 - Schedule 80	A420
5	1	799	Pipe 2 - Schedule 80 - 31.456693	A333 GR. 6
6	1	152	ASTM A 53/A 53M Pipe 2 - Schedule 40 - 6	Steel

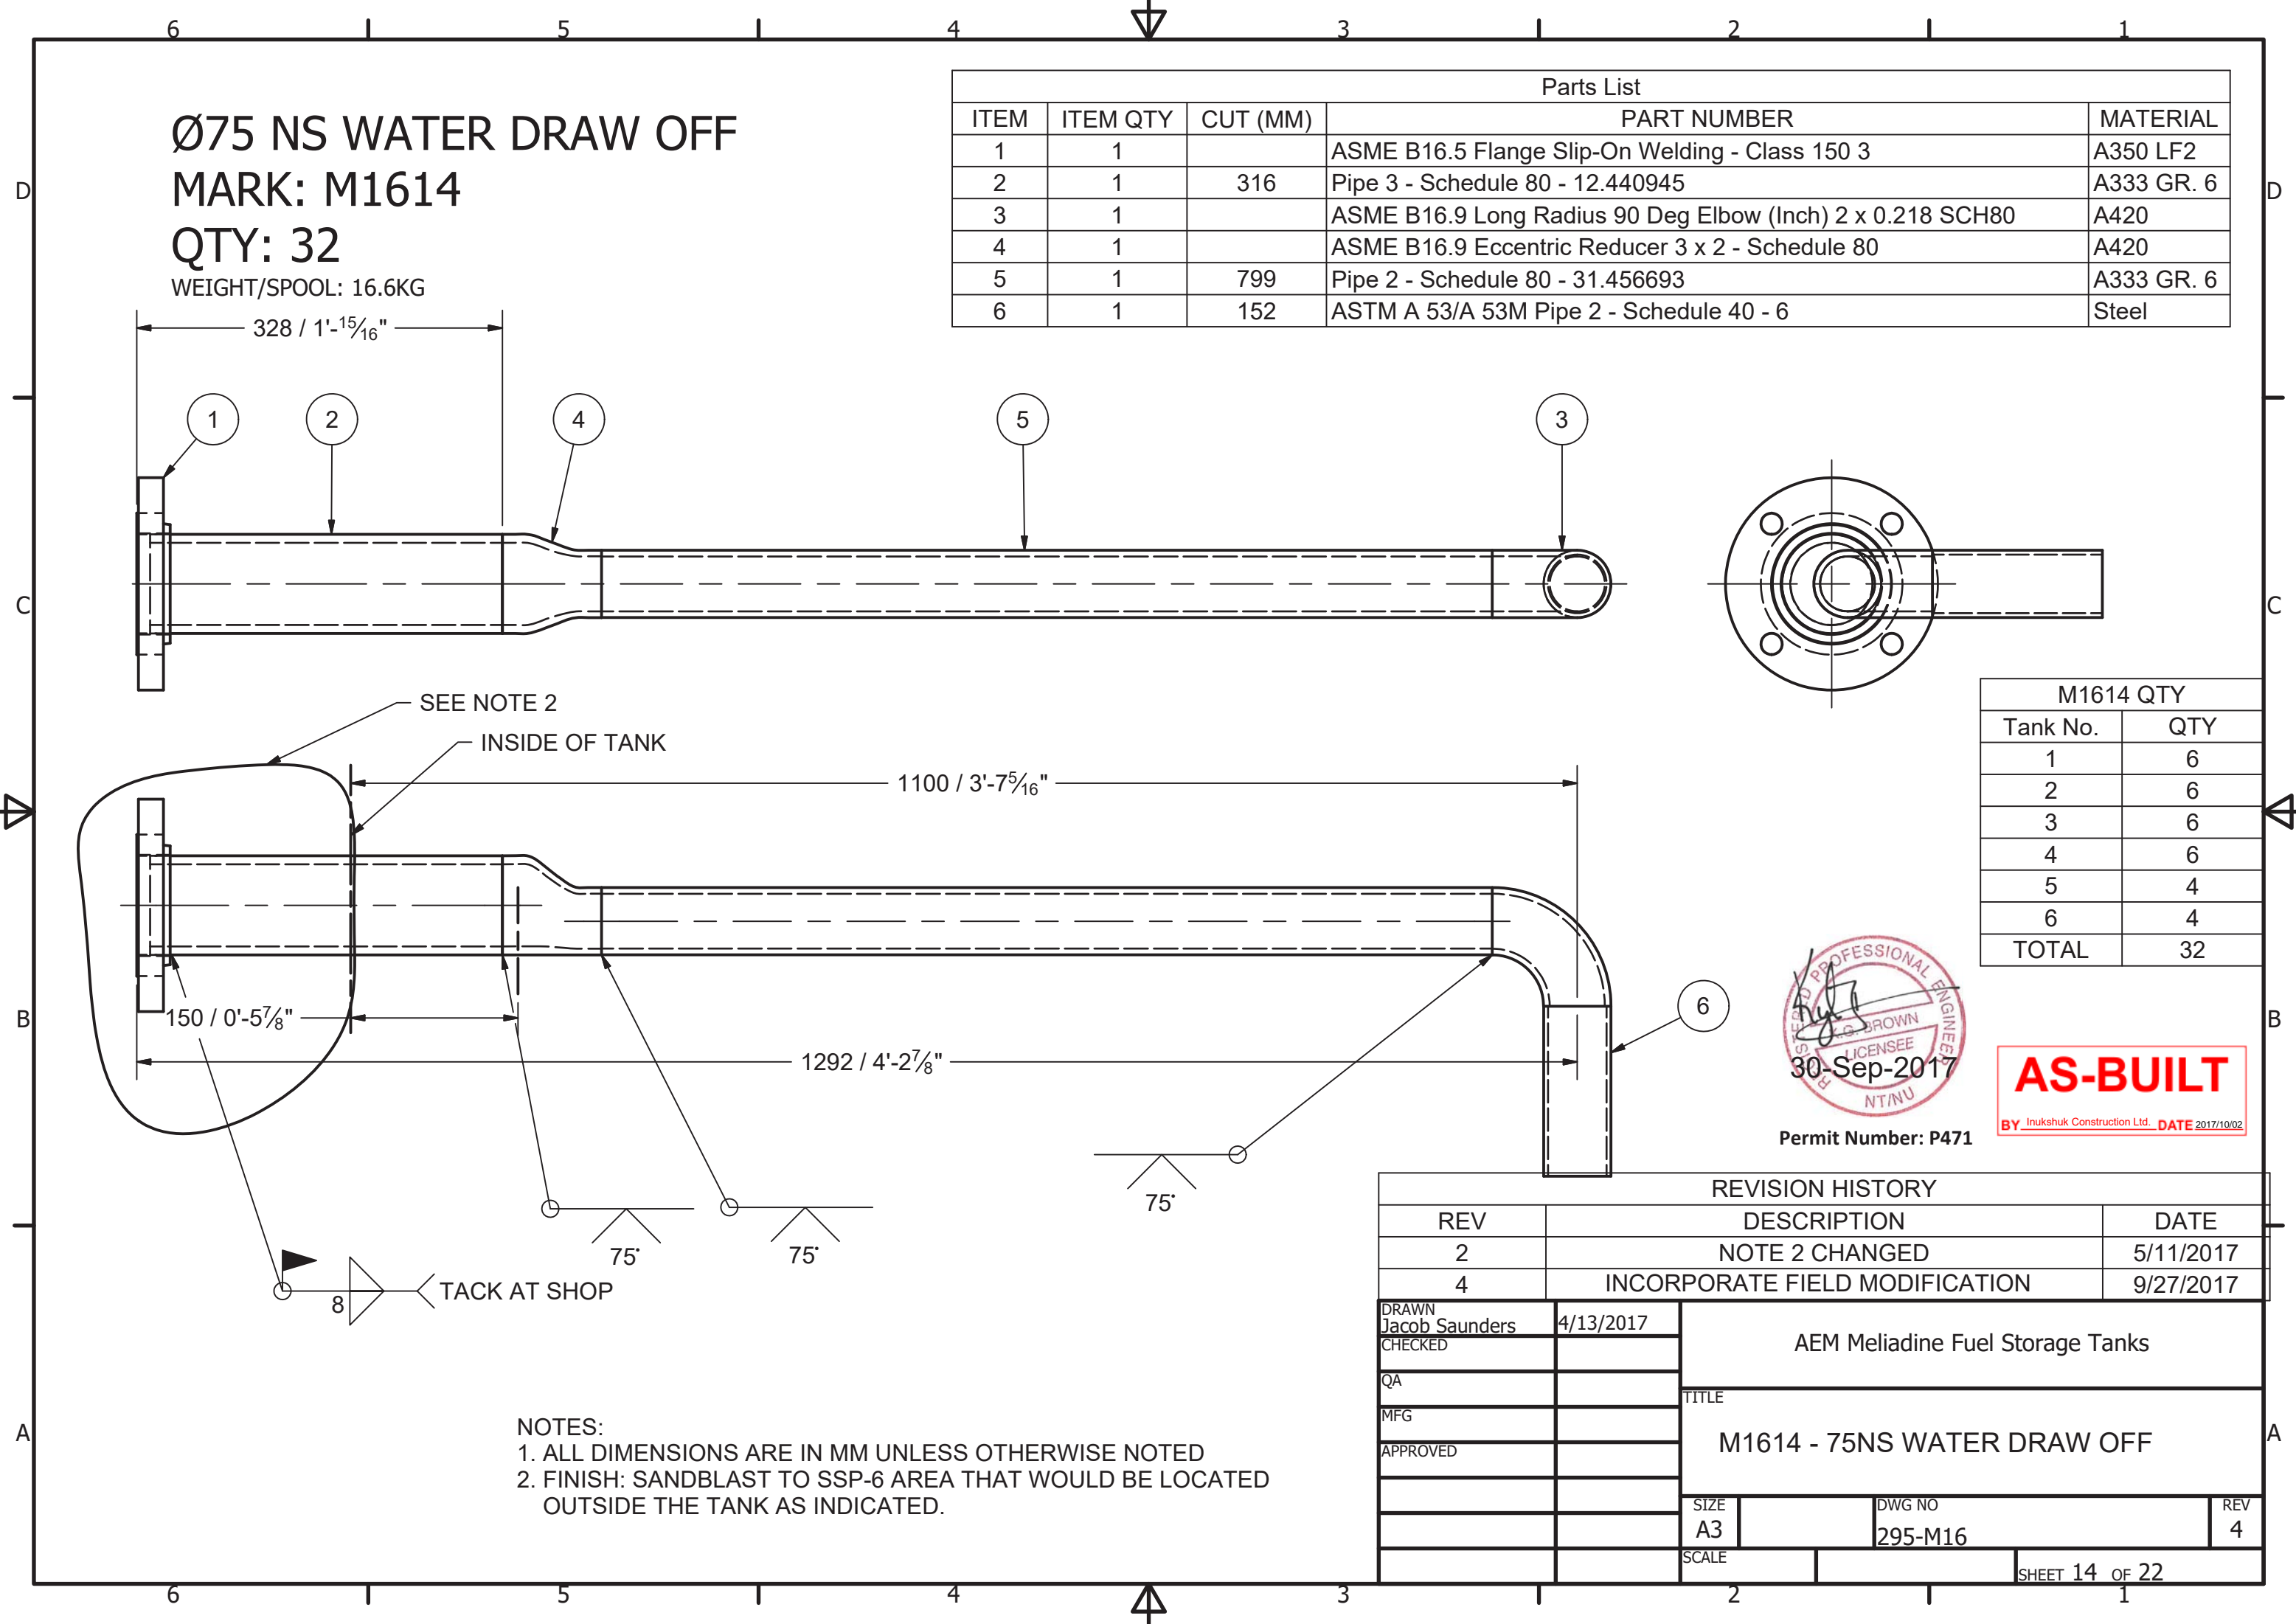

NOTES:  
1. ALL DIMENSIONS ARE IN MM UNLESS OTHERWISE NOTED  
2. FINISH: SANDBLAST TO SSP-6 AREA THAT WOULD BE LOCATED OUTSIDE THE TANK AS INDICATED.

M1614 QTY	
Tank No.	QTY
1	6
2	6
3	6
4	6
5	4
6	4
TOTAL	32




**AS-BUILT**  
BY Inukshuk Construction Ltd. DATE 2017/10/02

Parts List					
ITEM	ITEM QTY	CUT (MM)	PART NUMBER	DESCRIPTION	MATERIAL
1	1		Plate, 1/4" Thick x 152 Dia	Steel, Mild	G40.21M 300W
2	1	152	PIPE SCH40 ANSI - 4 x .237 - 6	Pipe	A53
3	1		Painters Post Reinforcing Plate	Plate, Mild Steel, 3/8" thk x 133 I.D. x 229 O.D.	G40.21M 300W

Ø100 NS PAINTERS SCAFFOLD CABLE SUPPORT  
MARK: M1615  
QTY: 6  
WEIGHT/SPOOL: 3.4KG

M1615 QTY	
Tank No.	QTY
1	1
2	1
3	1
4	1
5	1
6	1
TOTAL	6

NOTES:  
1. ALL DIMENSIONS ARE IN MM UNLESS OTHERWISE NOTED  
2. FINISH: SANDBLAST TO SSP-6

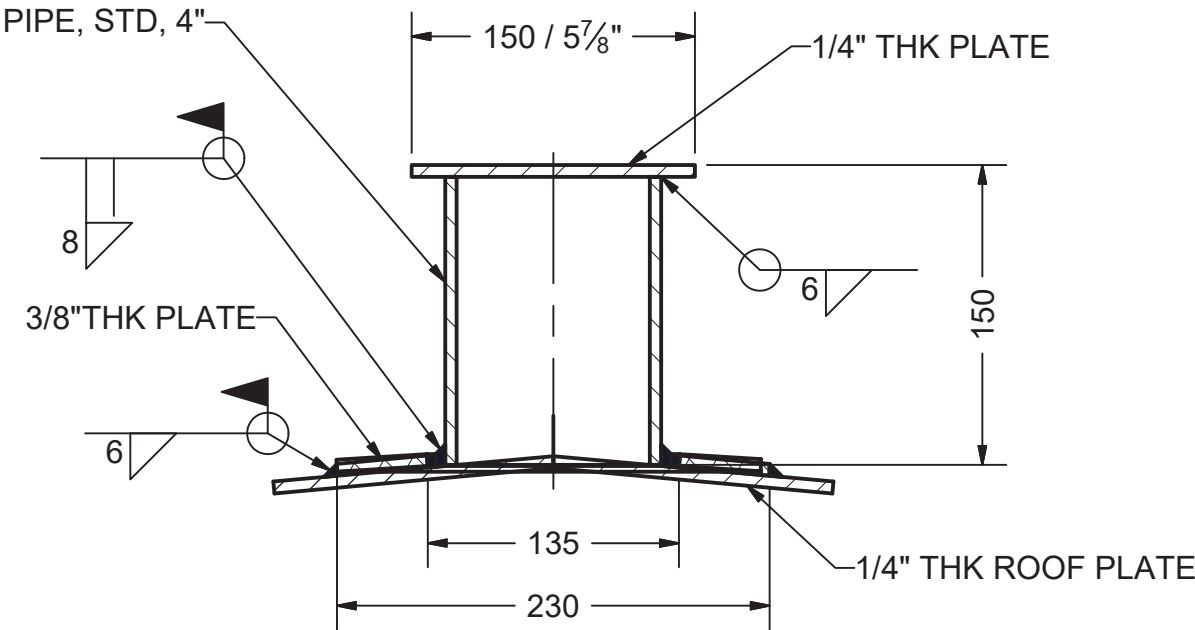

MOSHER ENGINEERING LIMITED

-GRAVEL CRUSHING  
-EARTHWORK  
-PROCESS PIPE WELDING  
-INDUSTRIAL CONTRACTING

1358 QUEEN ST  
HALIFAX, NS  
B3J 2H5  
PH: (902) 429-0272  
FAX: (902) 429-7762

DRAWN	Jacob Saunders	4/13/2017	AEM Meliadine Fuel Storage Tanks		
CHECKED					
QA			M1615 - PAINTERS SCAFFOLD CABLE SUPPORT		
MFG					
APPROVED					
			SIZE	DWG NO	REV
			A3	295-M16	3
			SCALE		

SHEET 15

OF 22

AS-BUILT

BY Inukshuk Construction Ltd. DATE 2017/10/02

PROFESSIONAL ENGINEER

16-Jul-2017


PERMIT NUMBER: P471

Parts List				
ITEM	ITEM QTY	CUT (MM)	PART NUMBER	MATERIAL
1	1		ASME B16.5 Flange Slip-On Welding - Class 150 16	A350 LF2
2	1	330	Pipe 16 - Schedule 30, 3/8" wall - 13"LG	A106

Ø400 NS ROOF NOZZLE  
MARK: M1616  
QTY: 6  
WEIGHT/SPOOL: 83.5KG

M1616 QTY	
Tank No.	QTY
1	1
2	1
3	1
4	1
5	1
6	1
TOTAL	6

NOTES:  
1. ALL DIMENSIONS ARE IN MM UNLESS OTHERWISE NOTED  
2. FINISH: SANDBLAST TO SSP-6

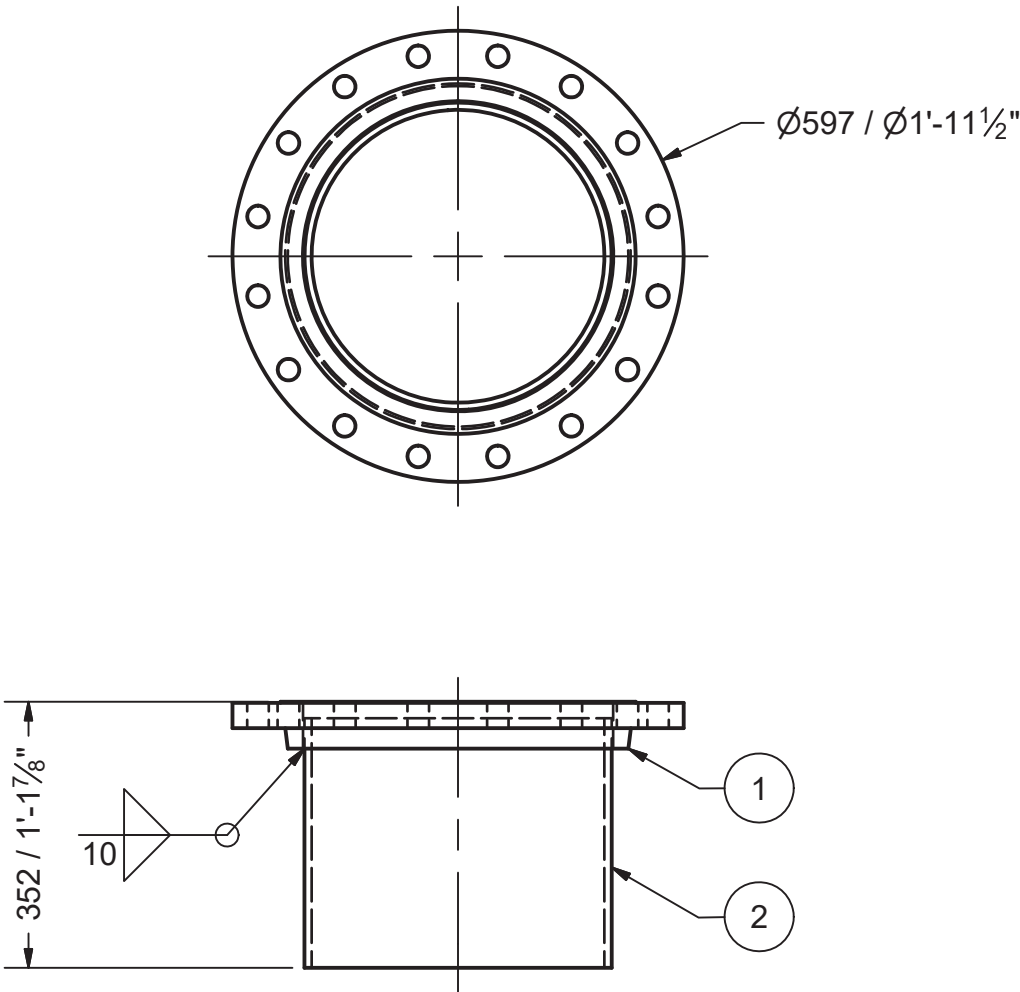

**AS-BUILT**  
BY Inukshuk Construction Ltd. DATE 2017/10/02



Permit Number: P471

DRAWN Jacob Saunders	4/13/2017	AEM Meliadine Fuel Storage Tanks		
CHECKED		TITLE M1616 - Ø400 NS ROOF NOZZLE		
QA				
MFG				
APPROVED				
		SIZE A3	DWG NO 295-M16	REV 3
		SCALE	SHEET 16 OF 22	



Parts List				
ITEM	ITEM QTY	CUT (MM)	PART NUMBER	MATERIAL
1	1		ASME B16.5 Flange Slip-On Welding - Class 150 8	A350 LF2
2	1	325	Pipe 8 - Schedule 40 - 12.795276	A333 GR. 6


Ø200 NS ROOF NOZZLE FOR OVERFILL PROT.

MARK: M1618


QTY: 6

WEIGHT/SPOOL: 25.8KG

- NOTES:
- 1. ALL DIMENSIONS ARE IN MM UNLESS OTHERWISE NOTED
  - 2. FINISH: SANDBLAST TO SSP-6

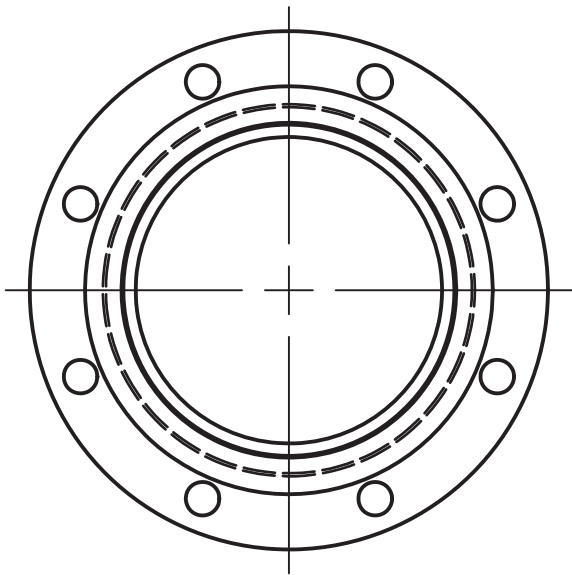

M1618 QTY	
Tank No.	QTY
1	1
2	1
3	1
4	1
5	1
6	1
TOTAL	6

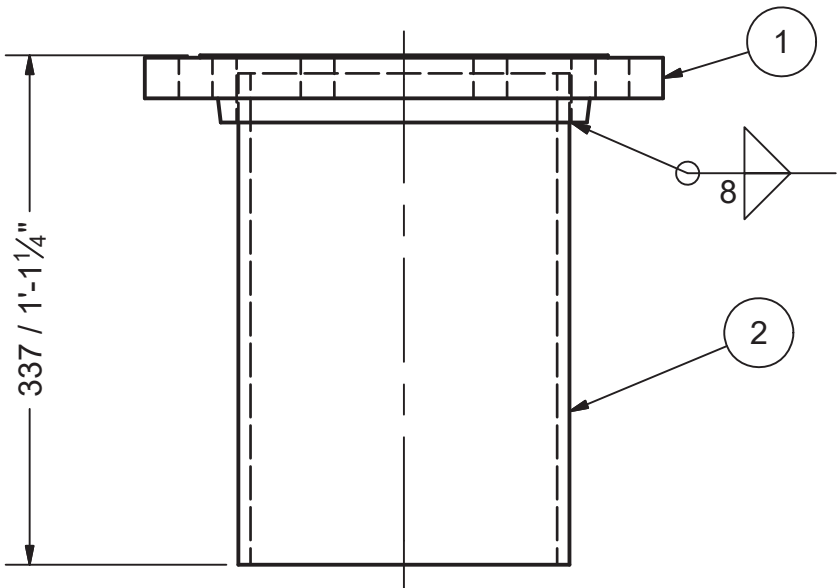


**AS-BUILT**  
BY Inukshuk Construction Ltd. DATE 2017/10/02



Permit Number: P471

DRAWN Jacob Saunders	4/13/2017	AEM Meliadine Fuel Storage Tanks		
CHECKED		TITLE M1618 - 200NS ROOF NOZZLE FOR OVERFILL PROT.		
QA				
MFG				
APPROVED				
		SIZE A3	DWG NO 295-M16	REV 3
		SCALE	SHEET 18 OF 22	

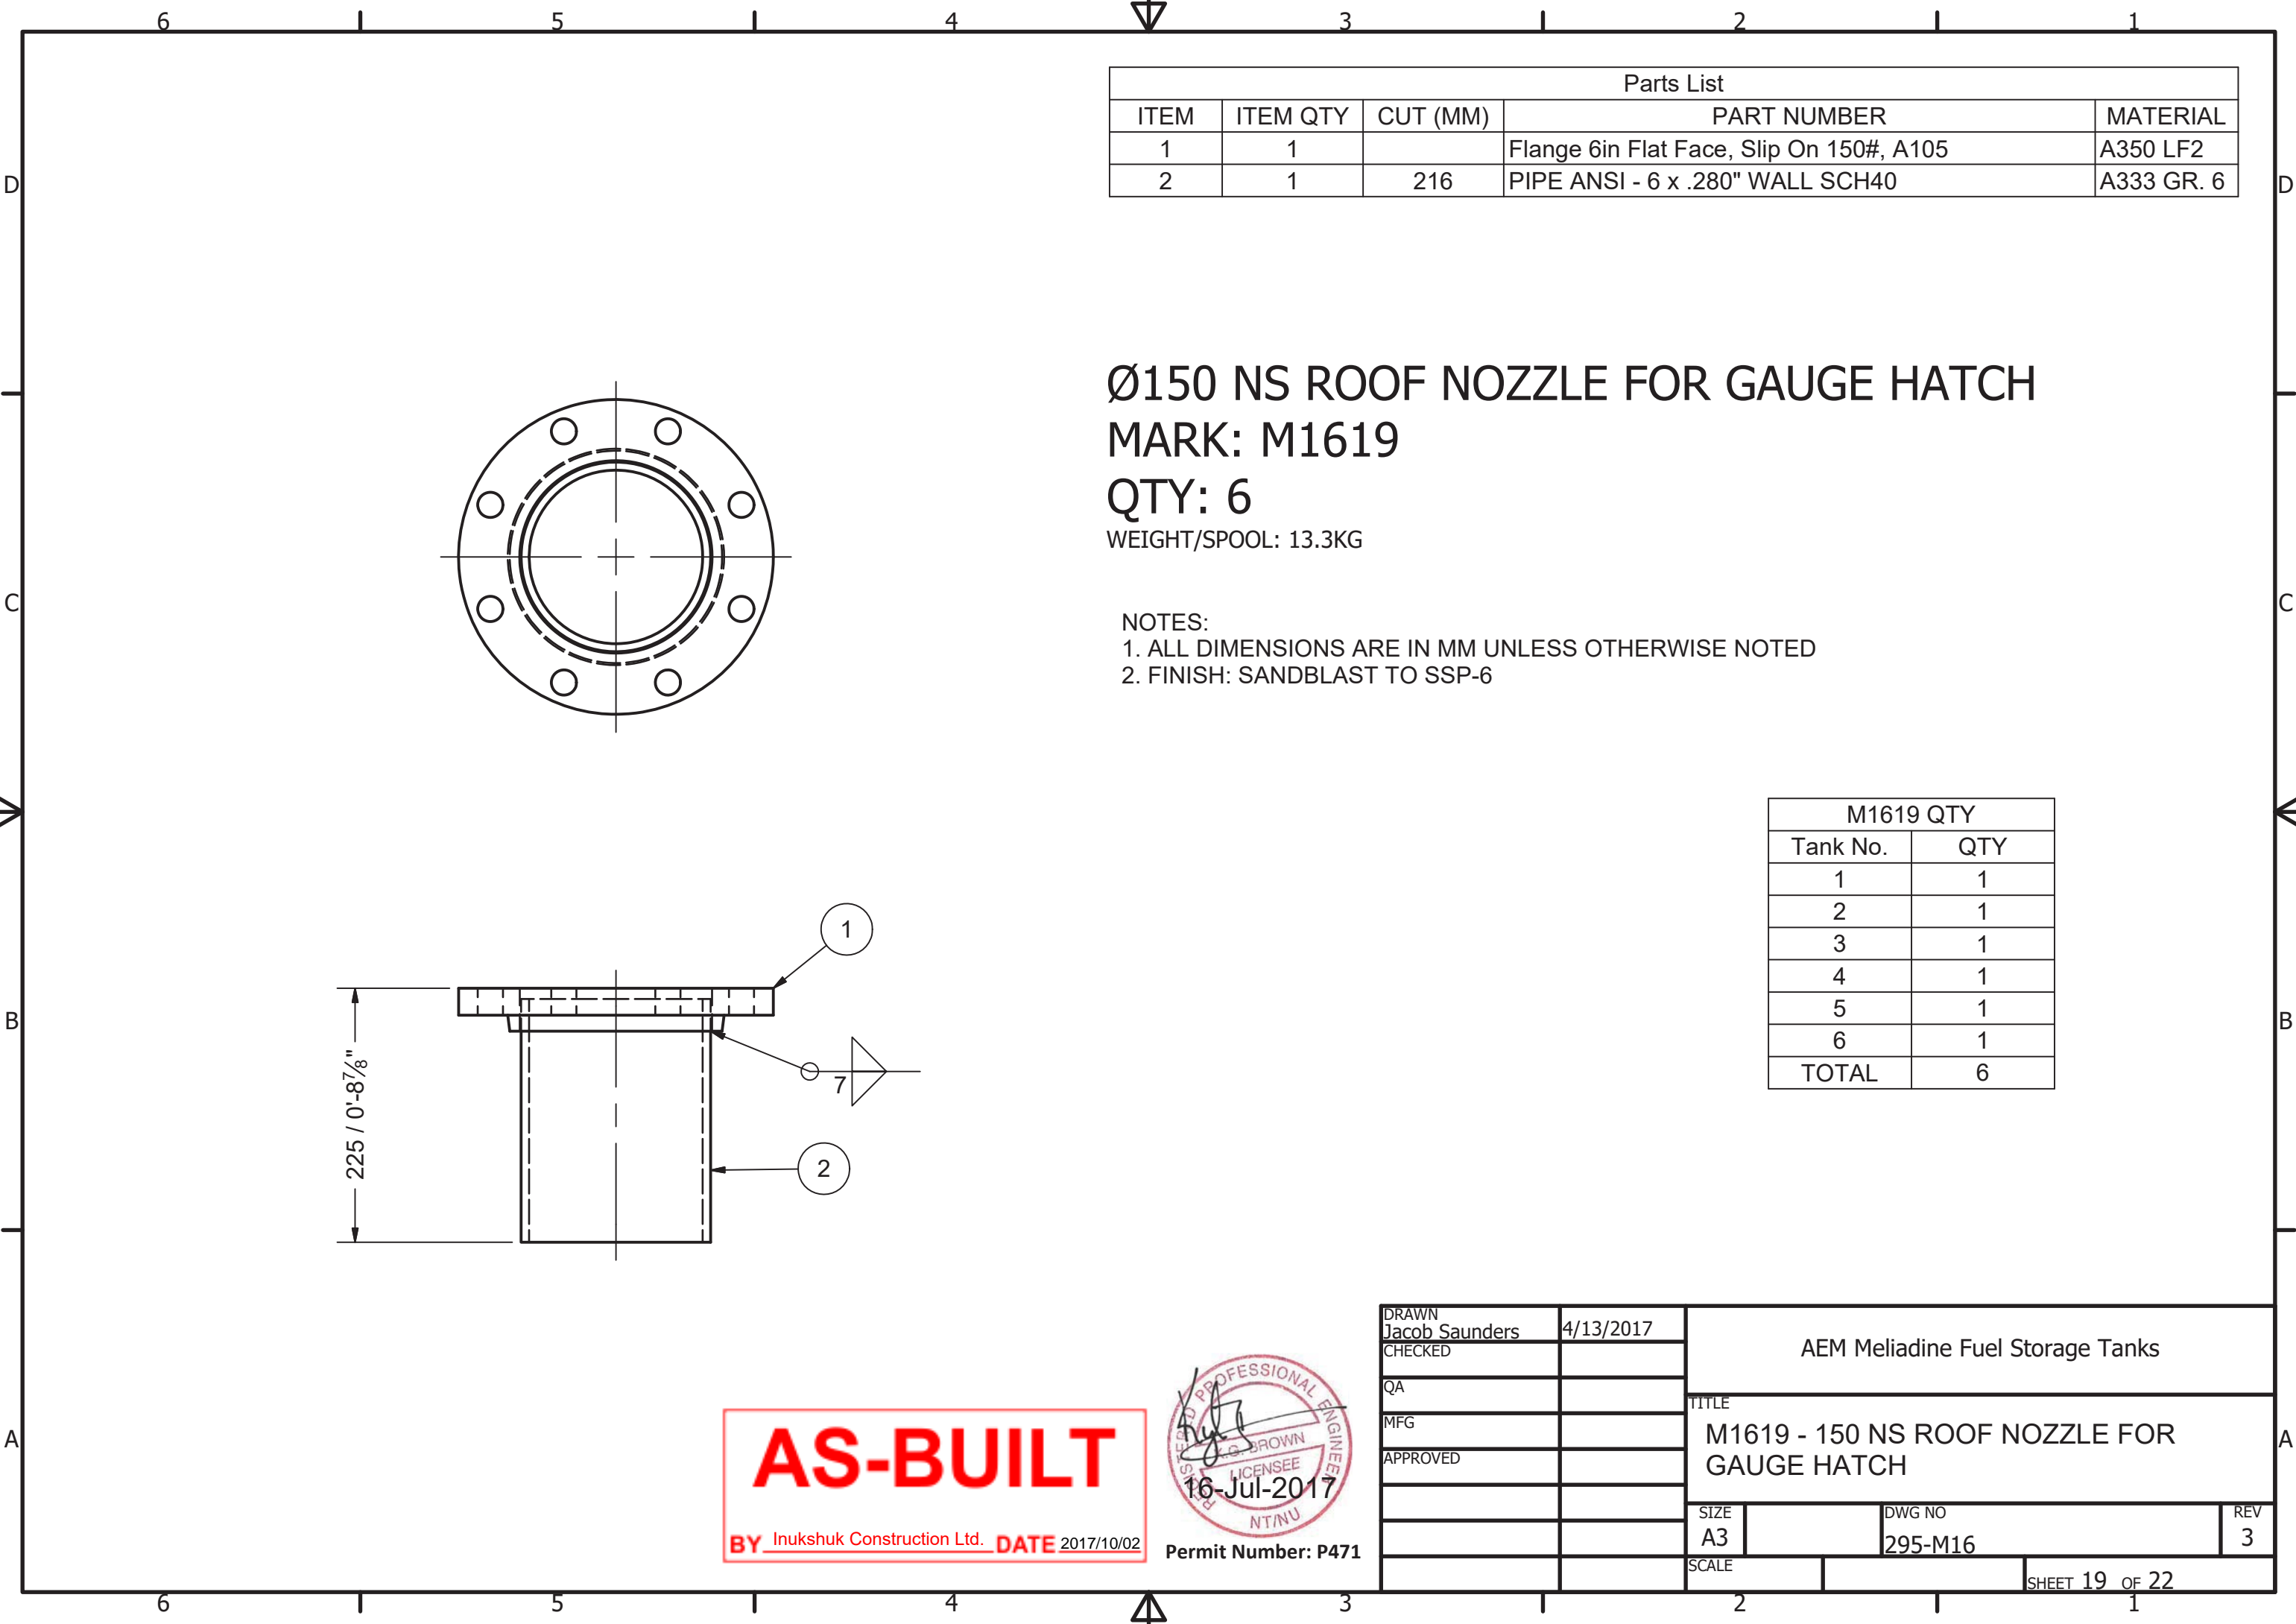

Parts List				
ITEM	ITEM QTY	CUT (MM)	PART NUMBER	MATERIAL
1	1		Flange 6in Flat Face, Slip On 150#, A105	A350 LF2
2	1	216	PIPE ANSI - 6 x .280" WALL SCH40	A333 GR. 6

Ø150 NS ROOF NOZZLE FOR GAUGE HATCH  
MARK: M1619  
QTY: 6  
WEIGHT/SPOOL: 13.3KG

- NOTES:  
1. ALL DIMENSIONS ARE IN MM UNLESS OTHERWISE NOTED  
2. FINISH: SANDBLAST TO SSP-6

M1619 QTY	
Tank No.	QTY
1	1
2	1
3	1
4	1
5	1
6	1
TOTAL	6

**AS-BUILT**  
BY Inukshuk Construction Ltd. DATE 2017/10/02




Permit Number: P471

DRAWN Jacob Saunders	4/13/2017	AEM Meliadine Fuel Storage Tanks		
CHECKED		TITLE M1619 - 150 NS ROOF NOZZLE FOR GAUGE HATCH		
QA				
MFG				
APPROVED				
		SIZE A3	DWG NO 295-M16	REV 3
		SCALE	SHEET 19 OF 22	

Parts List				
ITEM	ITEM QTY	CUT (MM)	PART NUMBER	MATERIAL
1	2		ASME B16.5 Flange Slip-On Welding - Class 150 16	A350 LF2
2	1	330	Pipe 16 - Schedule 10 - 13	A106
6	2		ASME B16.9 Long Radius 90 Deg Elbow (Metric) 16 x 9.5	A234
7	1	600	Pipe 16 - Schedule 10 - 23.622047	A106
8	2	6401	Pipe 16 - Schedule 10 - 252	A106

M1620 QTY	
Tank No.	QTY
1	1
2	1
3	0
4	0
5	0
6	0
TOTAL	2

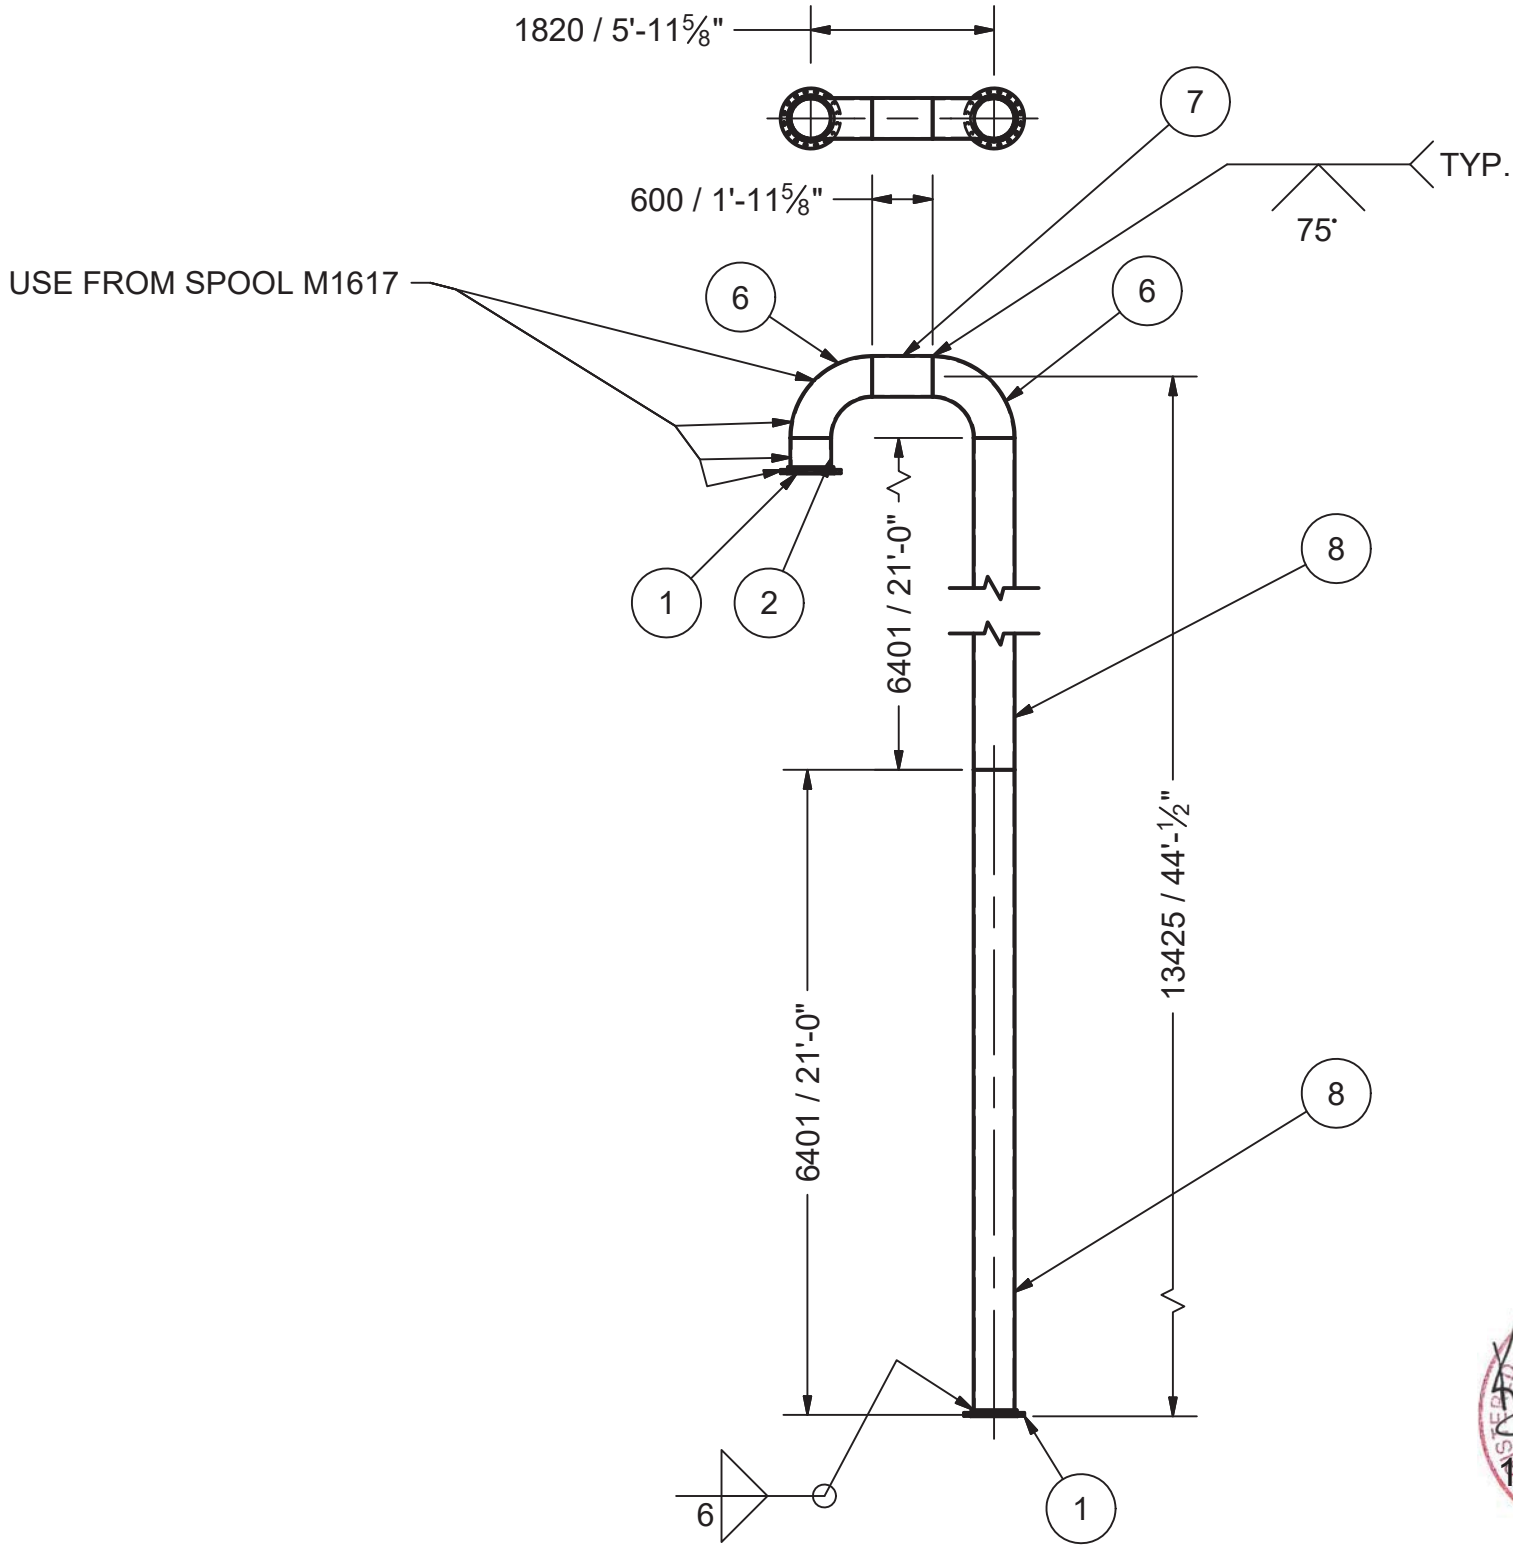

Ø400 NS VENT (RETURN BEND) FOR TANK NO.  
1 & 2 AS PER ECN NO. 1  
MARK: M1620

QTY: 2  
WEIGHT/SPOOL: 1134KG

**AS-BUILT**  
BY Inukshuk Construction Ltd. DATE 2017/10/02

REVISION HISTORY			
REV	DESCRIPTION		DATE
3	THIS SHEET ADDED		7/7/2017
DRAWN	Jacob Saunders	4/13/2017	AEM Meliadine Fuel Storage Tanks
CHECKED			
QA			
MFG			
APPROVED			M1620 - 400 NS VENT TANK NO. 1 & 2
SIZE	A3	DWG NO	295-M16
SCALE			
SHEET 20 OF 22			




Permit Number: P471

Parts List						
ITEM	ITEM QTY	CUT (MM)	PART NUMBER	DESCRIPTION	STOCK NUMBER	MATERIAL
1	1		ASME B16.5 Flange Slip-On Welding - Class 150 4	FLANGE, R.F., SLIP ON, 150#, 100NS [4"]		A350 LF2
2	1	184	ASTM A 53/A 53M Pipe 4 - Schedule 40 - 7.2440945	PIPE, STD, 100NS [4"]	ASTM A 53/A 53M Pipe 4 - Schedule 40	A53

Ø100 NS ROOF NOZZLE  
AS PER ECN NO. 1

MARK: M1621  
QTY: 6  
WEIGHT/SPOOL: 9 KG

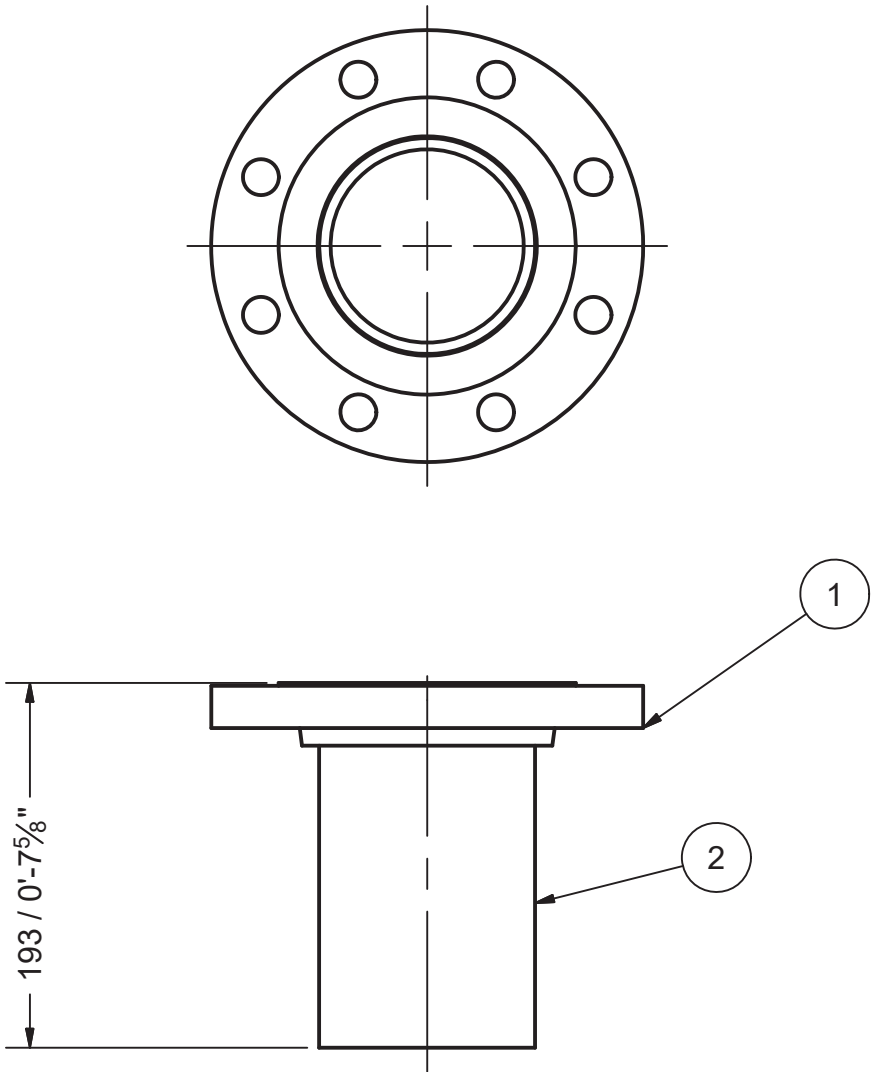

M1621 QTY	
Tank No.	QTY
1	1
2	1
3	1
4	1
5	1
6	1
TOTAL	6

REVISION HISTORY			
REV	DESCRIPTION		DATE
3	THIS SHEET ADDED AS PER ECN-001		7/7/2017
DRAWN Jacob Saunders	4/13/2017	AEM Meliadine Fuel Storage Tanks	
CHECKED			
QA			
MFG			
APPROVED		M1621 - 100NS ROOF NOZZLE	
		SIZE A3	DWG NO 295-M16
		SCALE	REV 3
SHEET 21 OF 22			

**AS-BUILT**  
BY Inukshuk Construction Ltd. DATE 2017/10/02





Permit Number: P471



Parts List				
ITEM	ITEM QTY	CUT (MM)	PART NUMBER	MATERIAL
2	1	330	ASTM A 53/A 53M Pipe 12 - Schedule 40 - 12.992126	A53
3	1		ASME B16.5 Flange Slip-On Welding - Class 150 12 Flate Face	A106

Ø300 NS ROOF NOZZLE  
FOR PRESSURE VACUUM VENT  
AS PER ECN NO. 1

MARK: M1622  
QTY: 3  
WEIGHT/SPOOL: 51 KG

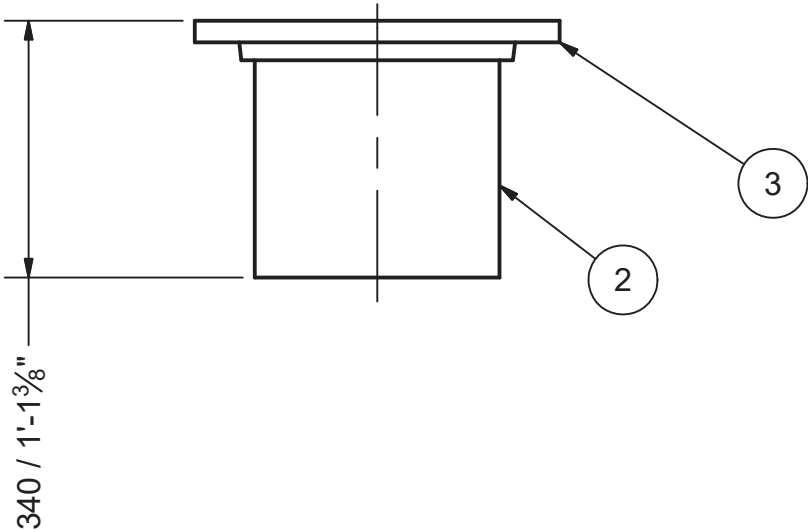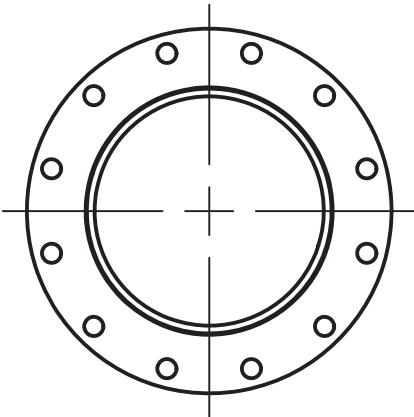


M1622 QTY	
Tank No.	QTY
1	2
2	1
3	0
4	0
5	0
6	0
TOTAL	3

REVISION HISTORY				
REV	DESCRIPTION			DATE
3	THIS SHEET ADDED AS PER ECN-001			7/7/2017
DRAWN Jacob Saunders	4/13/2017	AEM Meliadine Fuel Storage Tanks		
CHECKED				
QA				
MFG				
APPROVED		M1622 - 300NS ROOF NOZZLE		
		SIZE A3	DWG NO 295-M16	REV 3
		SCALE		SHEET 22 OF 22

**AS-BUILT**  
BY Inukshuk Construction Ltd. DATE 2017/10/02



Permit Number: P471

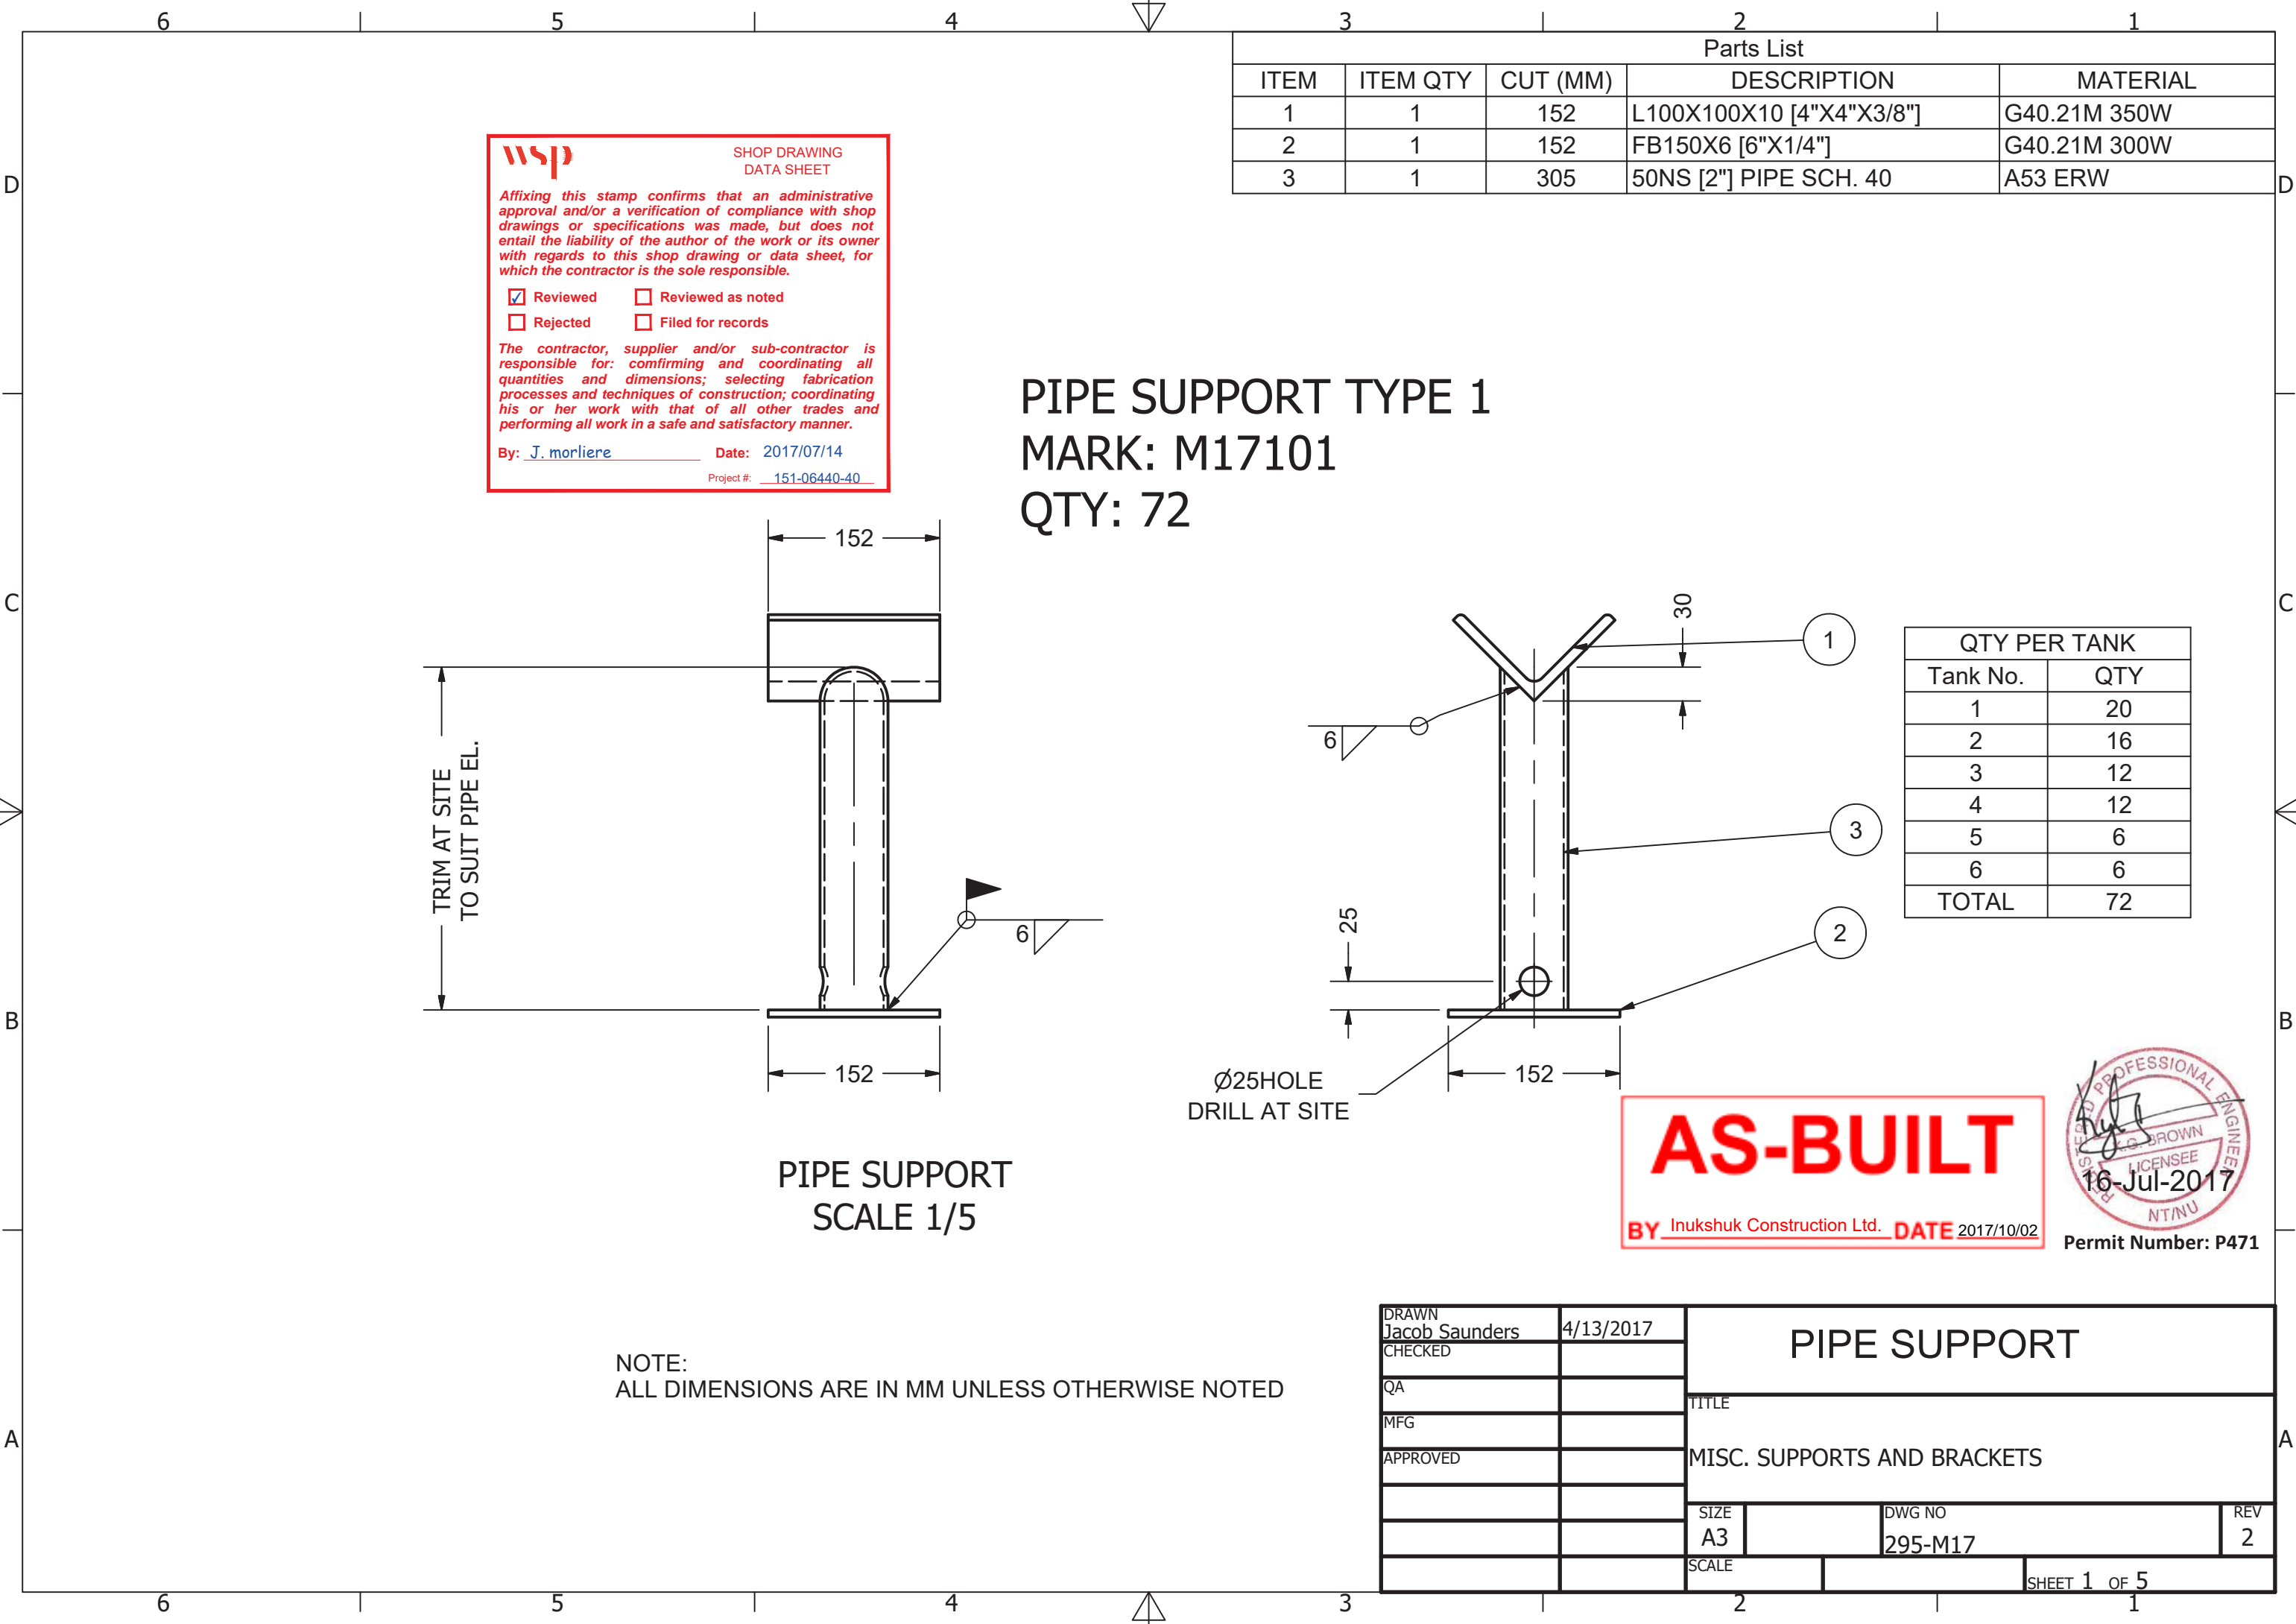

**wsp**

SHOP DRAWING  
DATA SHEET

Affixing this stamp confirms that an administrative approval and/or a verification of compliance with shop drawings or specifications was made, but does not entail the liability of the author of the work or its owner with regards to this shop drawing or data sheet, for which the contractor is the sole responsible.

☒ Reviewed☐ Reviewed as noted

☐ Rejected☐ Filed for records

The contractor, supplier and/or sub-contractor is responsible for: confirming and coordinating all quantities and dimensions; selecting fabrication processes and techniques of construction; coordinating his or her work with that of all other trades and performing all work in a safe and satisfactory manner.

By: J. morliere      Date: 2017/07/14

Project #: 151-06440-40

Parts List				
ITEM	ITEM QTY	CUT (MM)	DESCRIPTION	MATERIAL
1	1	152	L100X100X10 [4"X4"X3/8"]	G40.21M 350W
2	1	152	FB150X6 [6"X1/4"]	G40.21M 300W
3	1	305	50NS [2"] PIPE SCH. 40	A53 ERW

PIPE SUPPORT TYPE 1  
MARK: M17101  
QTY: 72

PIPE SUPPORT  
SCALE 1/5

NOTE:  
ALL DIMENSIONS ARE IN MM UNLESS OTHERWISE NOTED

QTY PER TANK	
Tank No.	QTY
1	20
2	16
3	12
4	12
5	6
6	6
TOTAL	72


**AS-BUILT**

BY Inukshuk Construction Ltd. DATE 2017/10/02



Permit Number: P471

DRAWN Jacob Saunders	4/13/2017	PIPE SUPPORT		
CHECKED				
QA		MISC. SUPPORTS AND BRACKETS		
MFG				
APPROVED		SIZE A3	DWG NO 295-M17	REV 2
		SCALE	SHEET 1 OF 5	

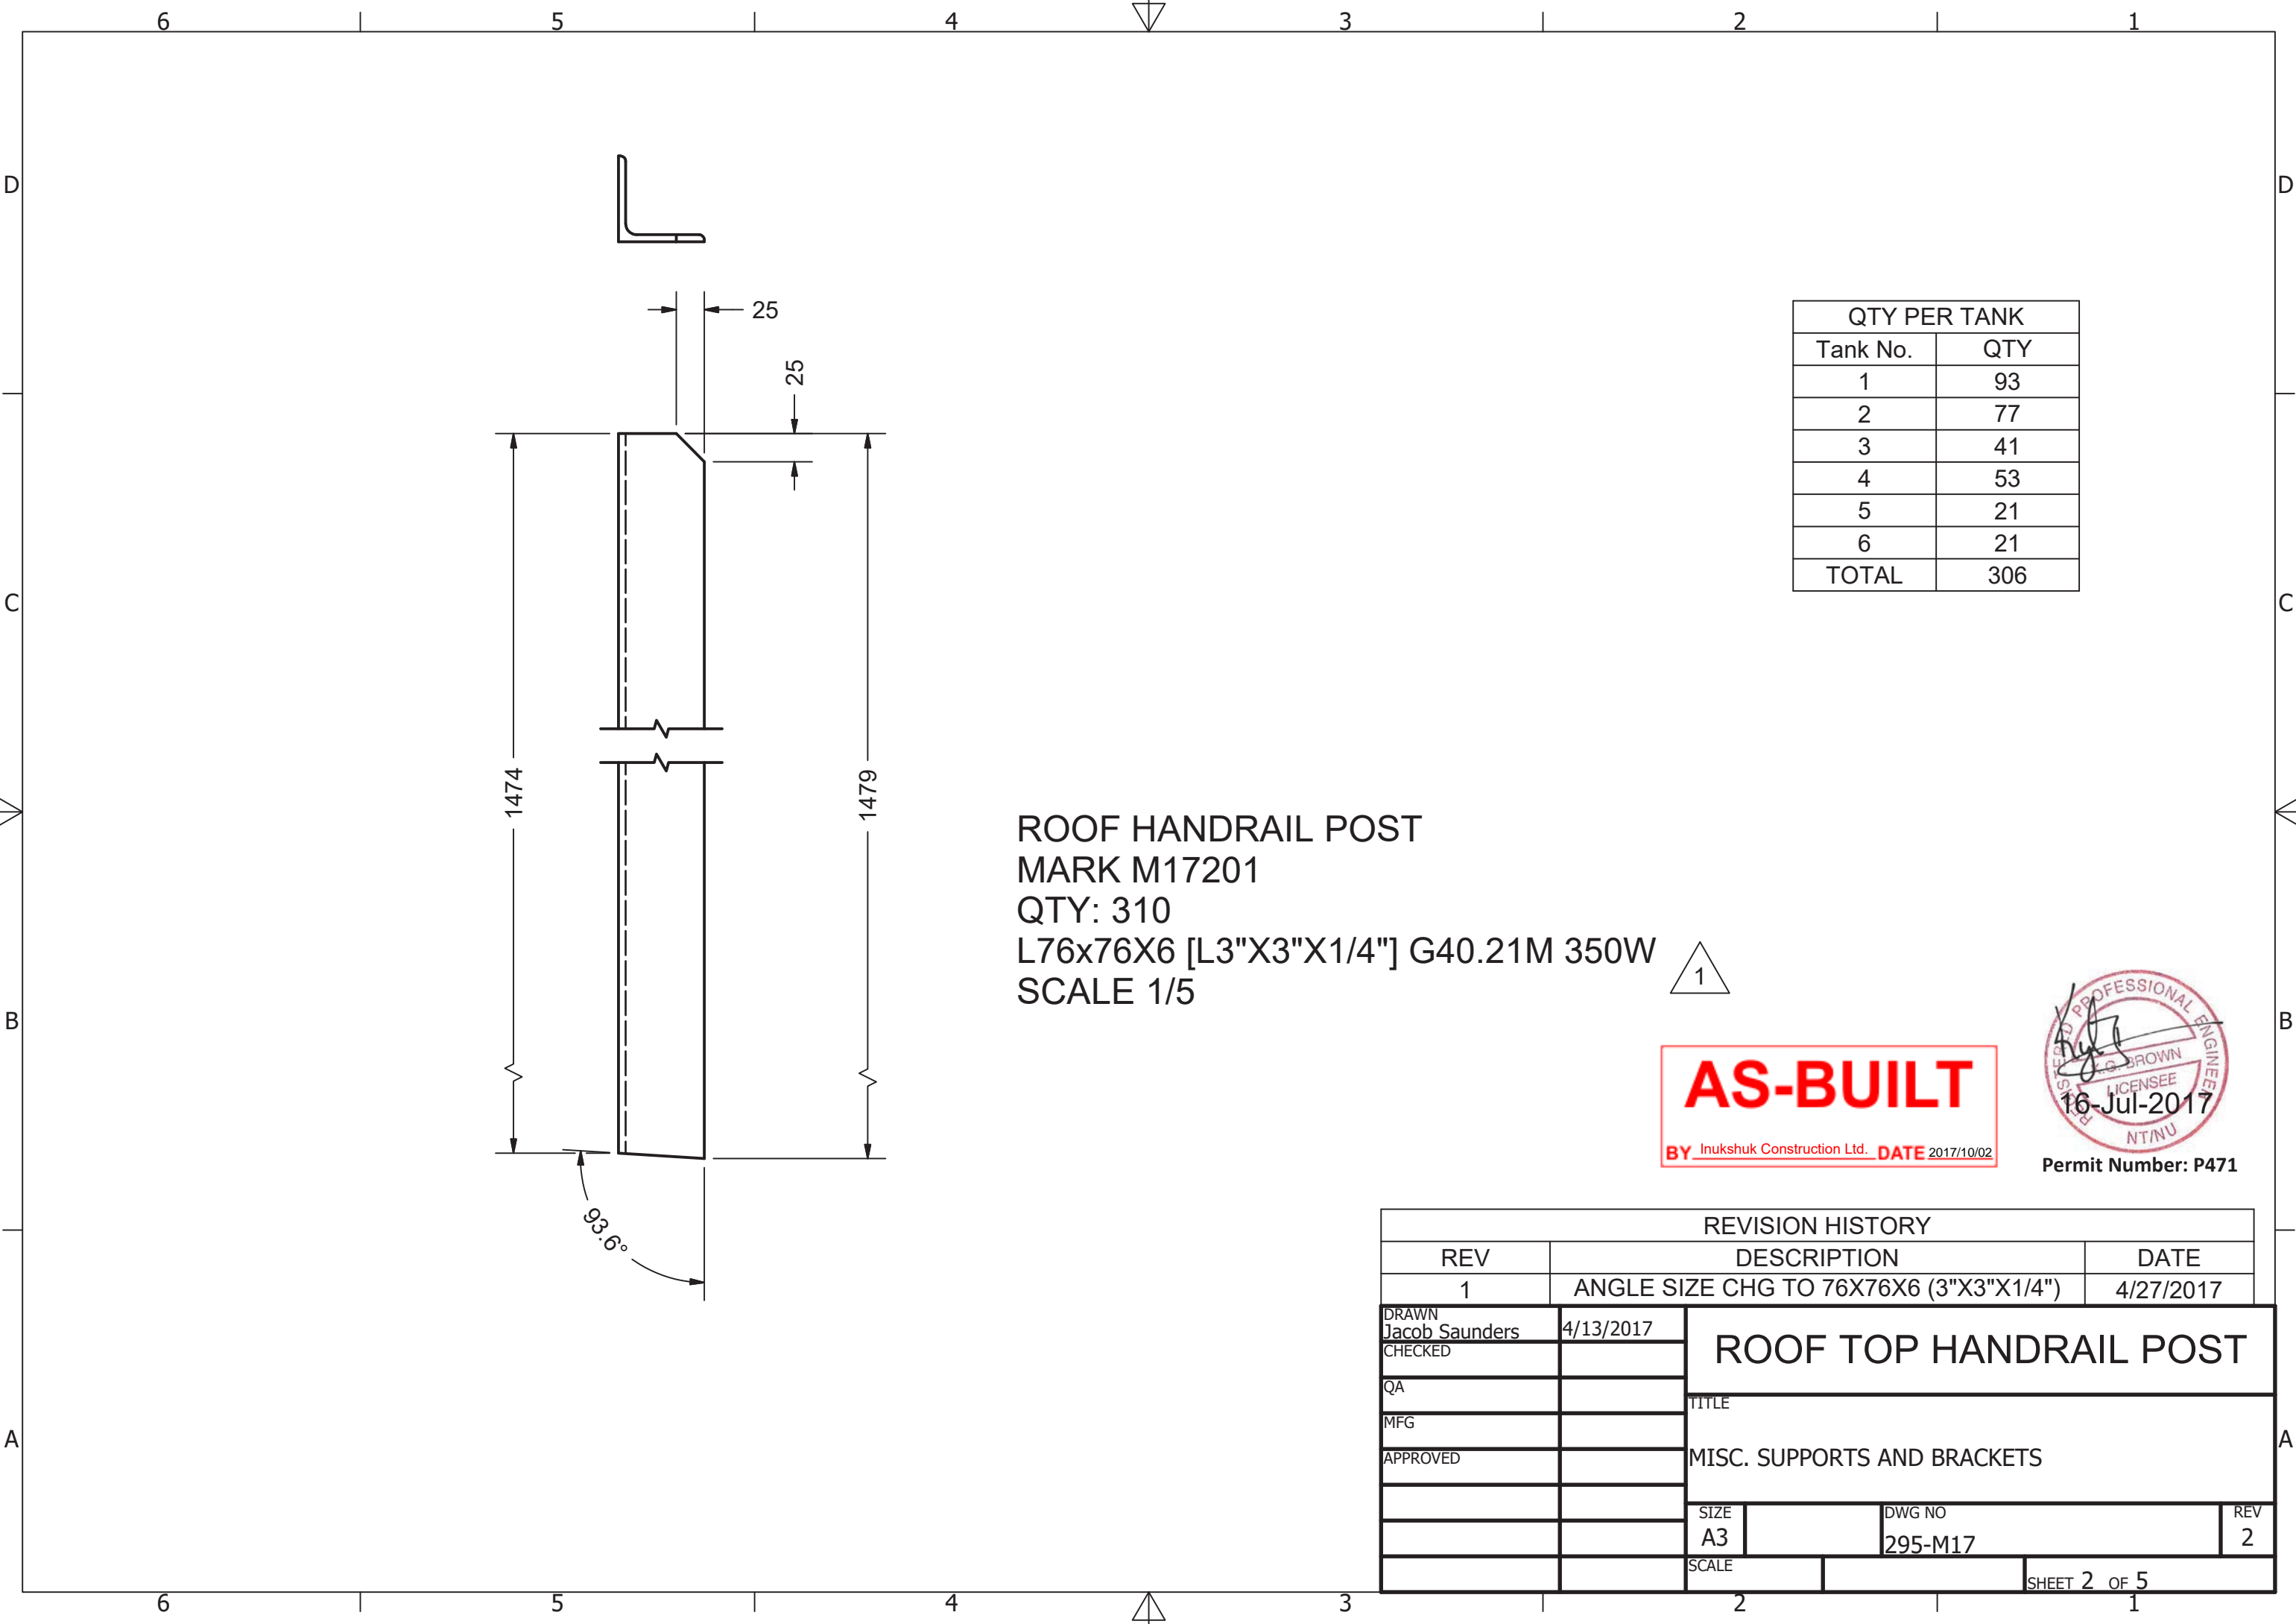

ROOF HANDRAIL POST  
MARK M17201  
QTY: 310  
L76x76X6 [L3"X3"X1/4"] G40.21M 350W  
SCALE 1/5

QTY PER TANK	
Tank No.	QTY
1	93
2	77
3	41
4	53
5	21
6	21
TOTAL	306




AS-BUILT

BY Inukshuk Construction Ltd. DATE 2017/10/02



Permit Number: P471

REVISION HISTORY				
REV	DESCRIPTION			DATE
1	ANGLE SIZE CHG TO 76X76X6 (3"X3"X1/4")			4/27/2017
DRAWN Jacob Saunders	4/13/2017	ROOF TOP HANDRAIL POST		
CHECKED				
QA				
MFG				
APPROVED		MISC. SUPPORTS AND BRACKETS		
		SIZE A3	DWG NO 295-M17	REV 2
		SCALE	SHEET 2 OF 5	

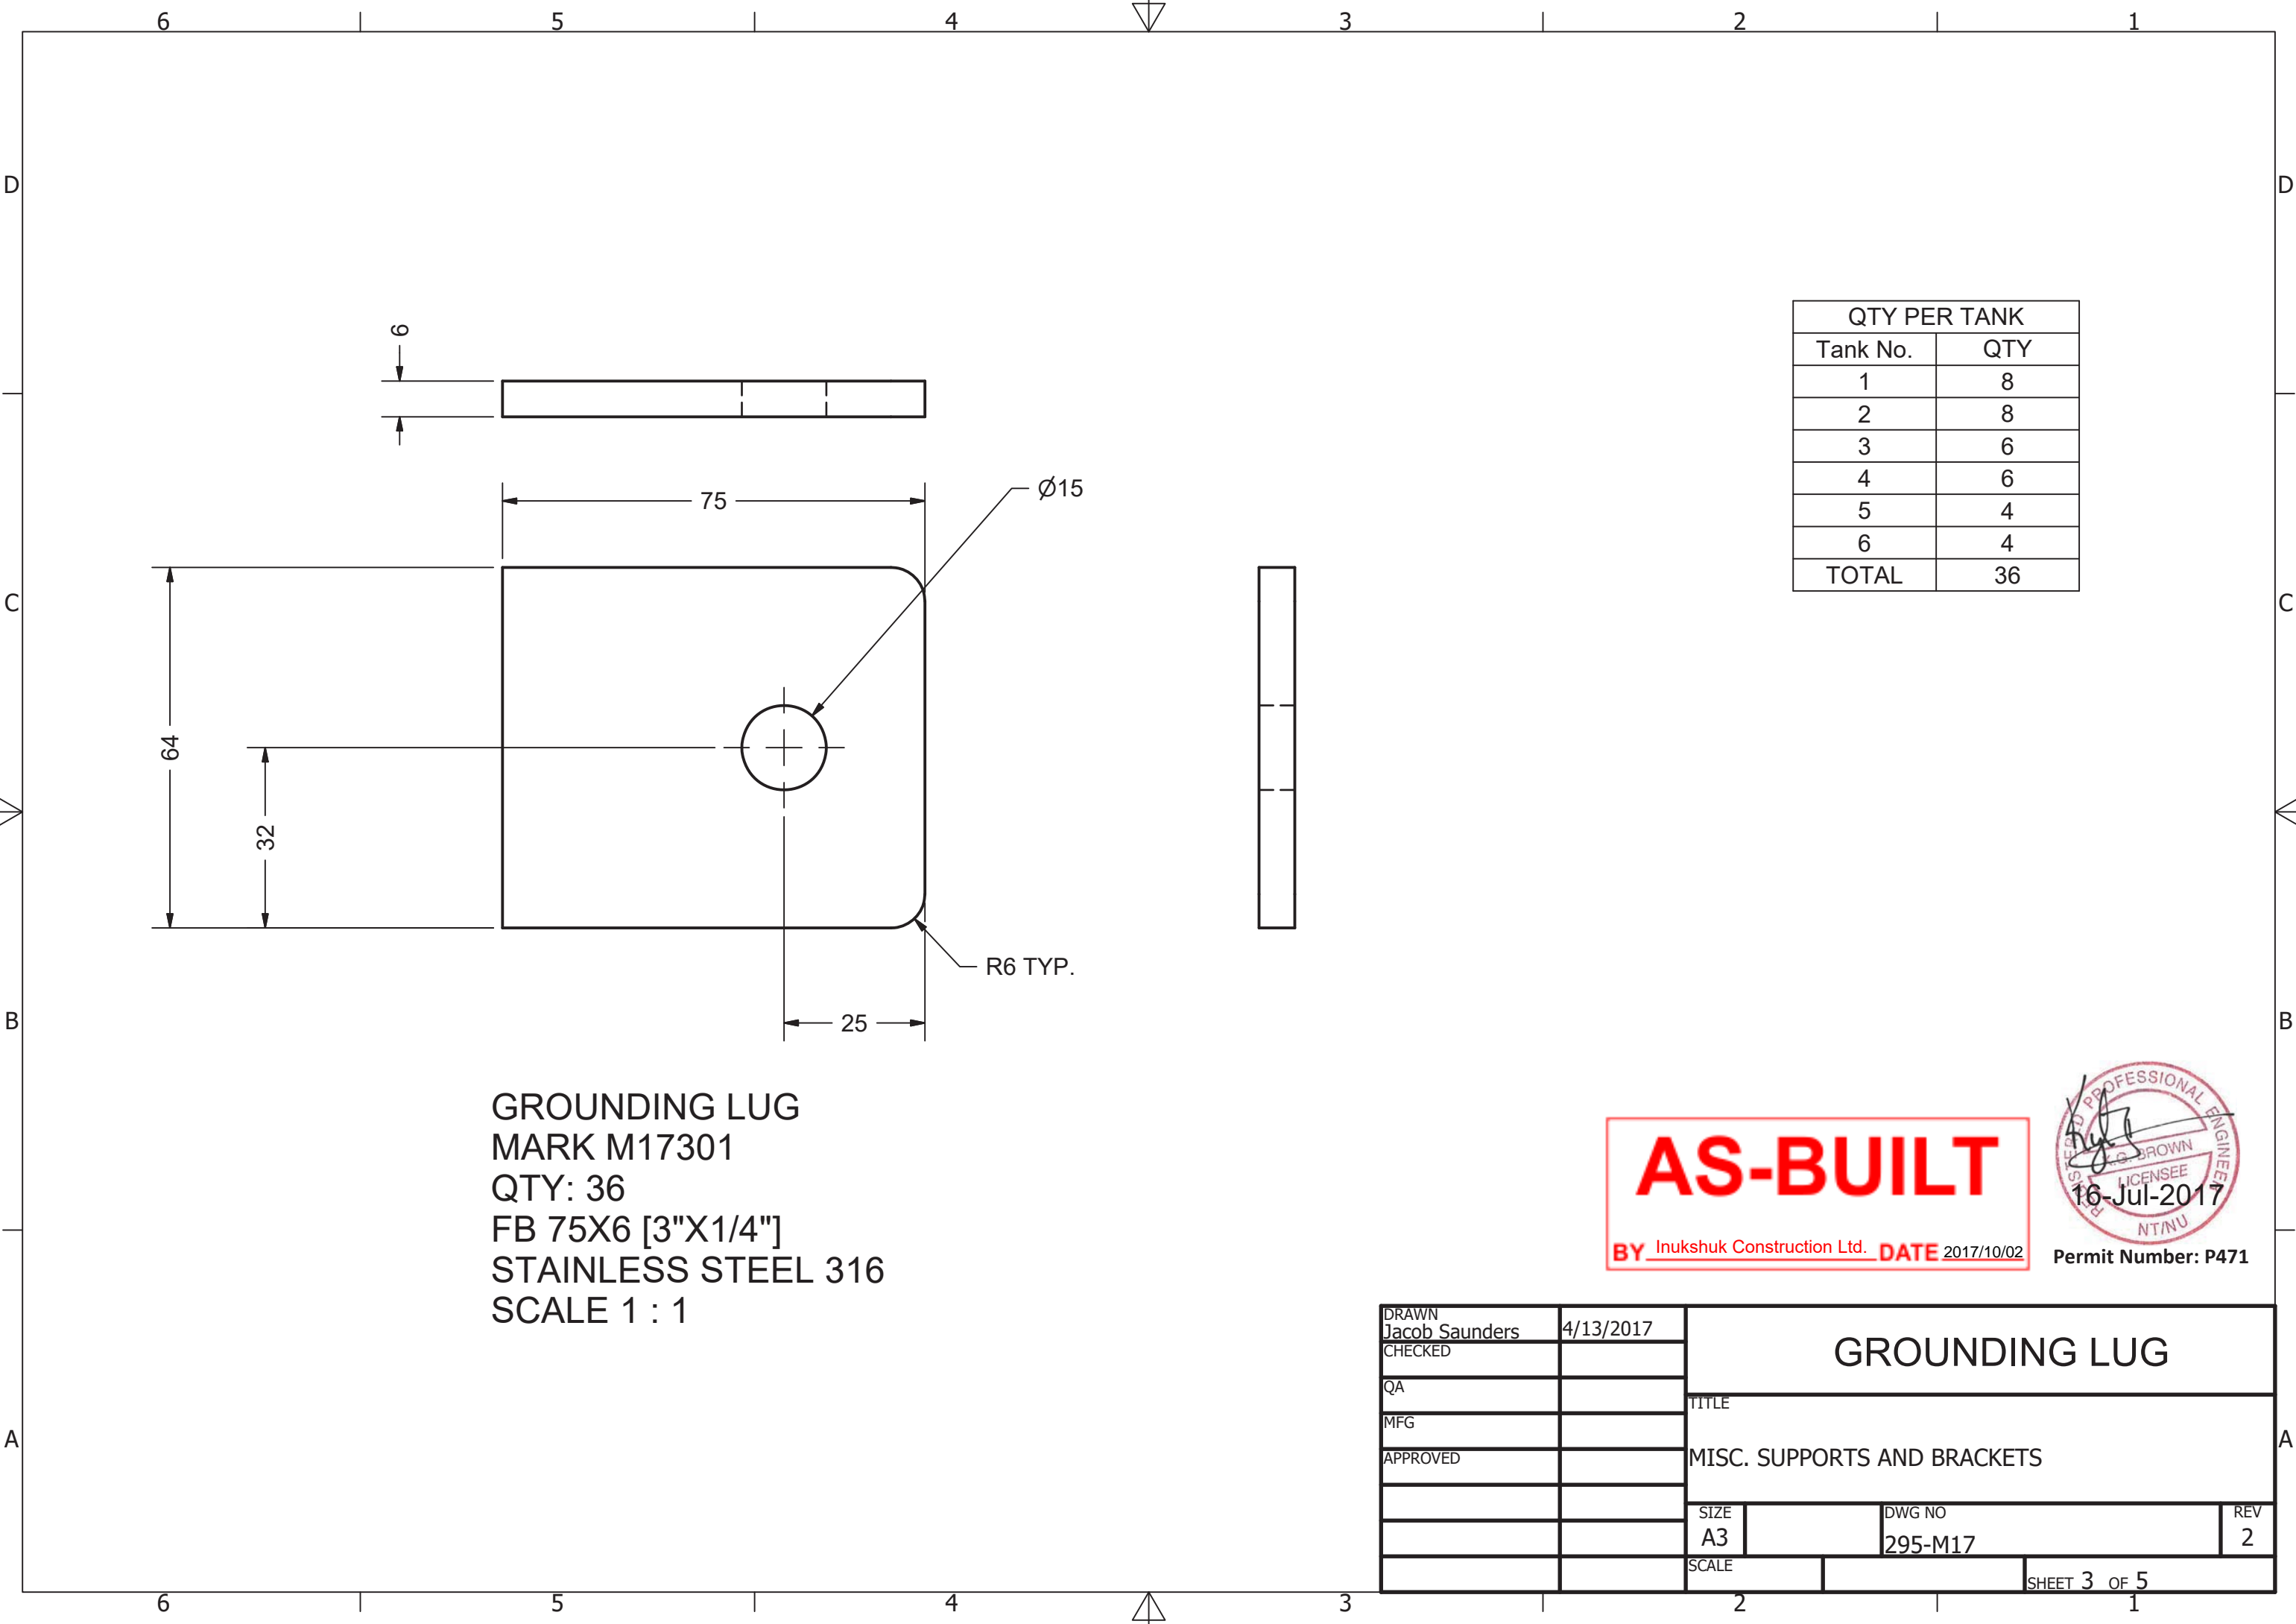

QTY PER TANK	
Tank No.	QTY
1	8
2	8
3	6
4	6
5	4
6	4
TOTAL	36

GROUNDING LUG  
MARK M17301  
QTY: 36  
FB 75X6 [3"X1/4"]  
STAINLESS STEEL 316  
SCALE 1 : 1

**AS-BUILT**  
BY Inukshuk Construction Ltd. DATE 2017/10/02



Permit Number: P471

DRAWN Jacob Saunders	4/13/2017	GROUNDING LUG		
CHECKED				
QA		MISC. SUPPORTS AND BRACKETS		
MFG				
APPROVED				
		SIZE A3	DWG NO 295-M17	REV 2
		SCALE	SHEET 3 OF 5	



CUT LIST					UNIT QTY PER TANK					
MARK	QTY	CUT MM	DESCRIPTION	MATERIAL	TK #1	TK #2	TK #3	TK #4	TK #5	TK #6
M17401	6	400	L100X100X6 [L4"X4"X1/4"] TEMPERATOR SENSOR	G40.21M 350W	1	1	1	1	1	1
M17402	45	400	L75X75X6 [L3"X3"X1/4"] PIPING & ELECTRICAL BRACKET	G40.21M 350W	14	14	6	7	2	2

**AS-BUILT**  
BY Inukshuk Construction Ltd. DATE 2017/10/02



Permit Number: P471

DRAWN Jacob Saunders	4/13/2017	MISC BRACKETS			
CHECKED					
QA					
MFG					
APPROVED		MISC. SUPPORTS AND BRACKETS			
		SIZE A3	DWG NO 295-M17	REV 2	
		SCALE	SHEET 4 OF 5		

Parts List						
ITEM	ITEM QTY	CUT (MM)	PART NUMBER	DESCRIPTION	STOCK NUMBER	MATERIAL
2	1	1230	AISC - L 3 x 3 x 3/8 - 48.426	Angle Steel	L 3 x 3 x 3/8	G40.21 350w
3	1	914	AISC - C 6 x 8.2 - 36	U-Shape	C 6 x 8.2	G40.21 350w
4	1	203	AISC - 6x1/4 - 8	Flat Bar Steel	6x1/4	G40.21 350w
5	1	229	AISC - 6x1/4 - 9	Flat Bar Steel	6x1/4	G40.21 350w

D

D

C

C

B


B

A


A



TOP VIEW  
SCALE 1/10

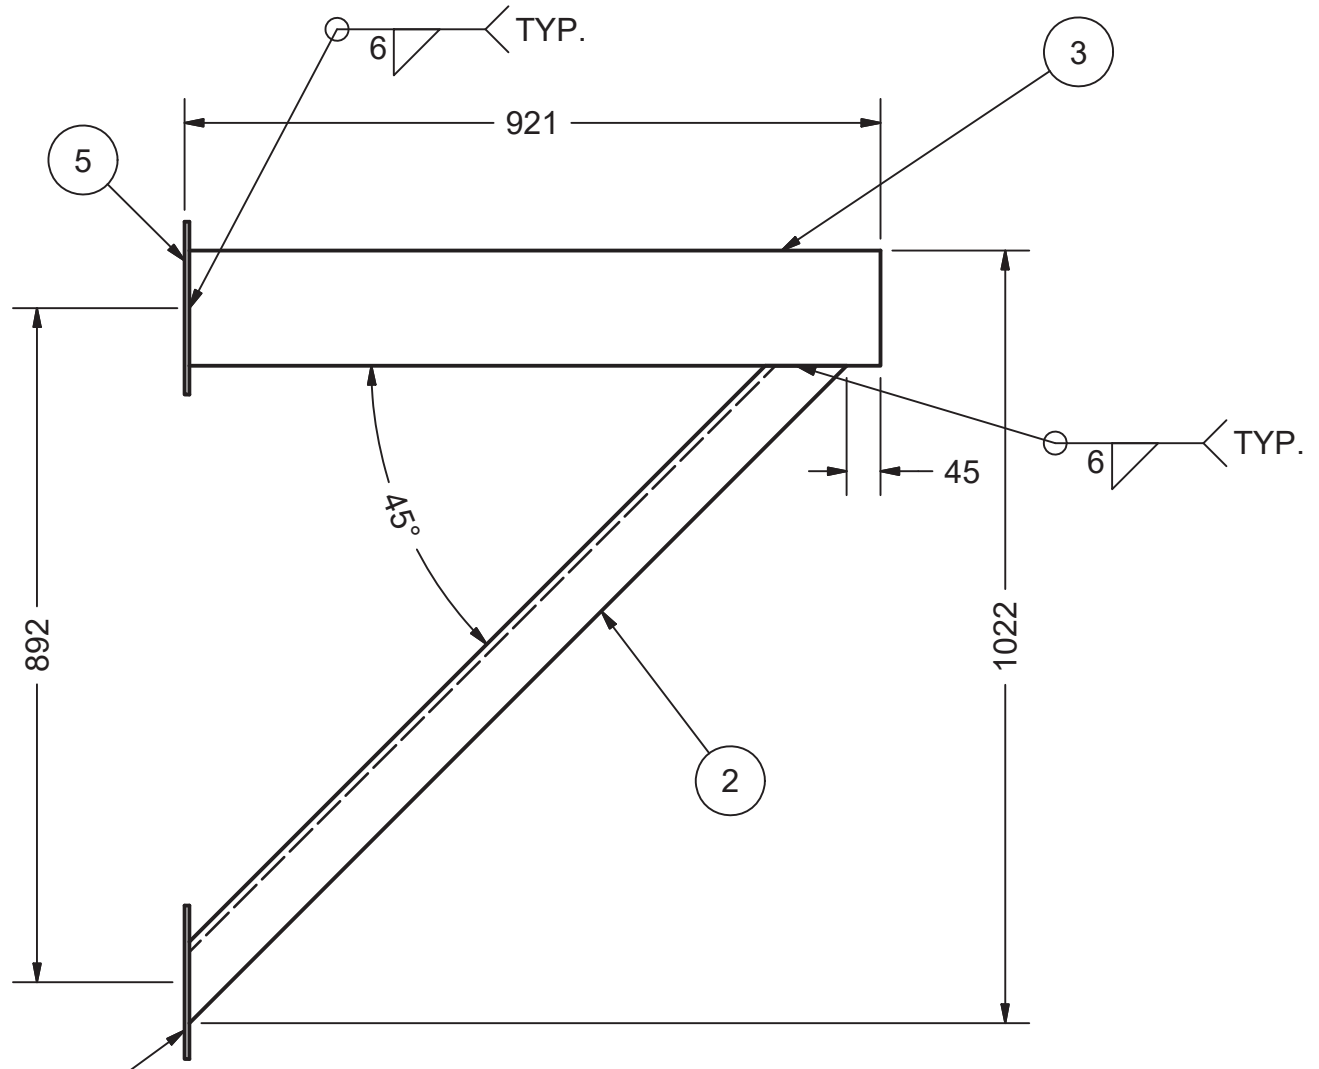

SIDE VIEW  
SCALE 1/10

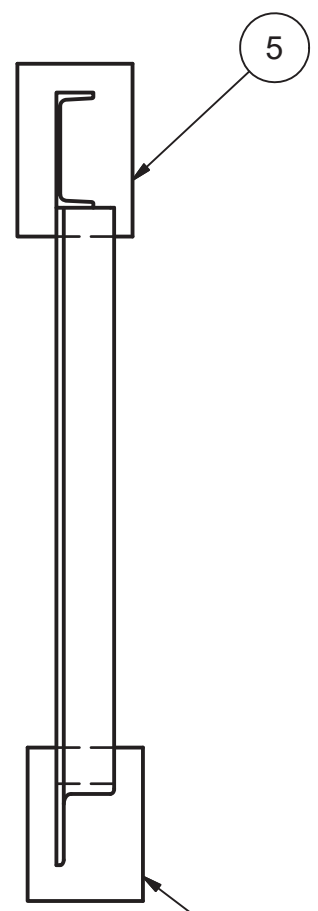

END VIEW  
SCALE 1/10

PIPE SUPPORT FOR 400NS  
VENT SUPPORT FOR TANK NO. 1 & 2  
MARK: M17501  
QTY: 4  
2 AS SHOWN  
2 MIRROR

FINISH: SHOP SANDBLAST


**AS-BUILT**  
BY Inukshuk Construction Ltd. DATE 2017/10/02



Permit Number: P471

REVISION HISTORY				
REV	DESCRIPTION		DATE	
2	THIS SHEET ADDED		7/7/2017	
DRAWN	Jacob Saunders	4/13/2017	TITLE MISC. SUPPORTS AND BRACKETS	
CHECKED				
QA				
MFG				
APPROVED			SIZE A3	
			SCALE	
			DWG NO 295-M17	REV 2
			SHEET 5 OF 5	


ITEM	ITEM QTY	CUT (MM)	DESCRIPTION	MATERIAL
M18101	1	341	5/8"THK X 66 WIDE PLATE, SEE DETAIL	G40.21M 300W
M18102	1	373	2 1/2" STD PIPE	A53
M18103	1		DAVIT ARM, SEE DETAIL	
M18104	1	198	16 [5/8"] DIA LG SEE DETAIL	Steel
M18105	1		EYE-BOLT 5/8"DIA X 12" LG CROSBY G291	FORGED STEEL
M18106	2		5/8"-11UNC Hex Nuts (Inch Series) Heavy Hex Nut	A194 GR4

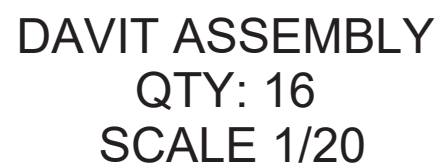

**AS-BUILT**  
BY Inukshuk Construction Ltd. DATE 2017/10/

04-May-2017

Permit Number: P471

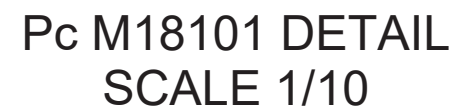

ITEM	ITEM QTY	CUT (MM)	DESCRIPTION	MATERIAL
M18108	1	645	2"NS XXH PIPE	A53
M18109	1	25	2 1/2"NS STD PIPE	A53
M18110	1		2"NS XXH ELBOW BW 90DEG L.R.	A234
M18111	1	890	2"NS XXH PIPE	A53
M18112	1	520	FB10X50 [3/8"X2"]	G40.21M 300W




DRAWN MARC LOSIER	4/13/2017	900MM [36"] NS FOR TK1, 2, 3, 4		
CHECKED				
QA				
MFG		TITLE		
APPROVED		MANHOLE COVER DAVIT		
		SIZE	DWG NO	REV
		A3	295-M18	
		SCALE	SHEET 1 OF 1	




BILL OF MATERIALS					
MARK	QTY.	DESCRIPTION	MATERIAL	MTR	WT # <sup>a</sup>
1	1	C6@10.5# x 3'-4" LG (CBE)	G40.21-300W	C	-
2	2	C6@10.5# x 3'-1 15/16" LG (COE/POE)	G40.21-300W	C	-
3	1	C6@10.5# x 3'-1 27/32" LG (CBE)	G40.21-300W	C	-
4	1	3/8" x 3" x 3" ANGLE x 3'-2 17/32" LG (CBE)	G40.21-300W	C	-
5	2	3/8" THK x 3" x 5"	G40.21-260W	C	-
6	4	1/4" THK x 6" x 10" c/w 2" RADIUS CORNERS	G40.21-260W	C	-
7	16	5/8"Ø x 1 3/4" LG HEX HD BOLT c/w (1) NUT & LOCK WASHER AND (2) FLAT WASHERS	A325 GALV	C	-
8	2	3/8" x 3" x 3" ANGLE x 3'-9 1/8" LG (CBE)	G40.21-300W	C	-
9	2	1/4" THK x 5" x 5 3/4" SEE DETAIL	G40.21-260W	C	-
10	4	1/4" THK x 6" x 6"	G40.21-260W	C	-


BILLING FOR ONE TANK SHOWN, THREE (3) REQUIRED

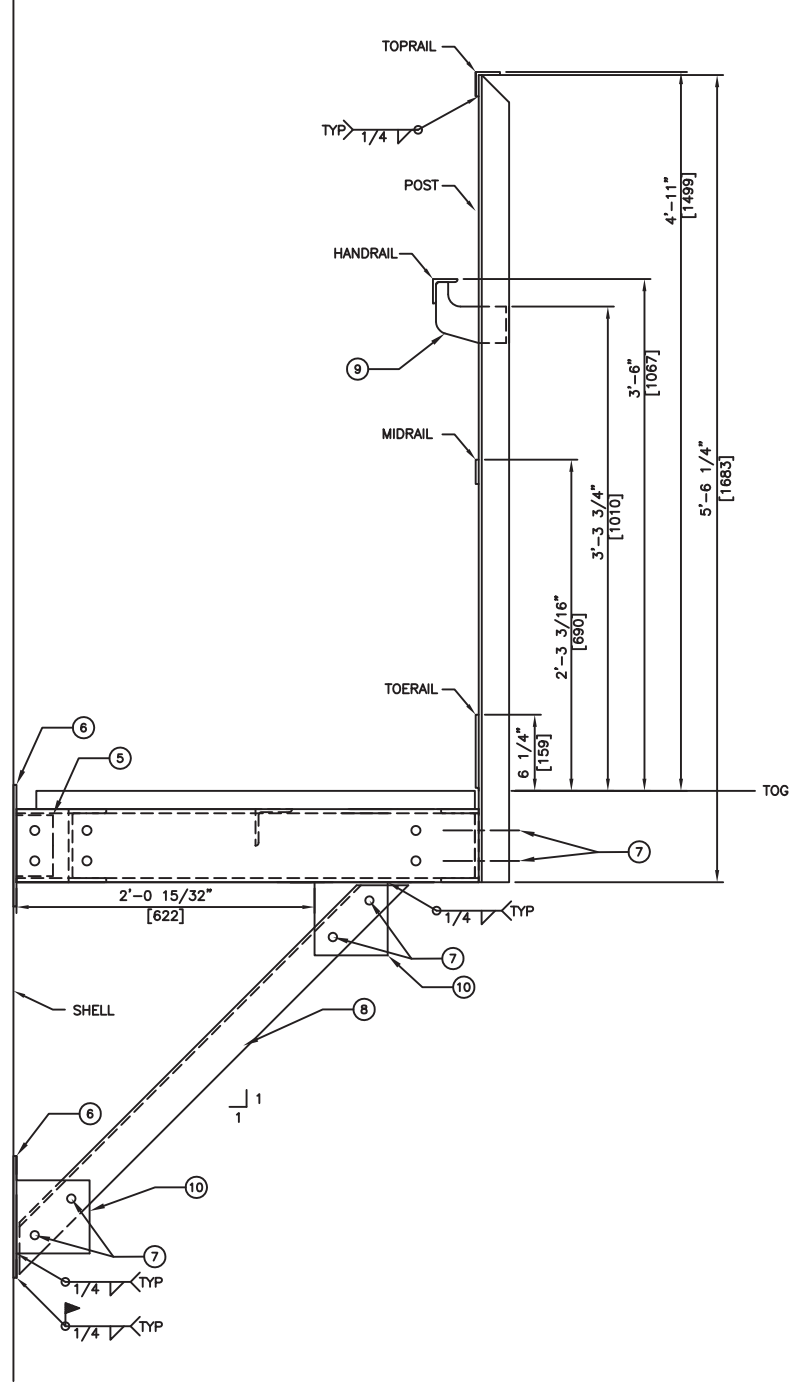



PLATFORM ELEVATION DETAIL

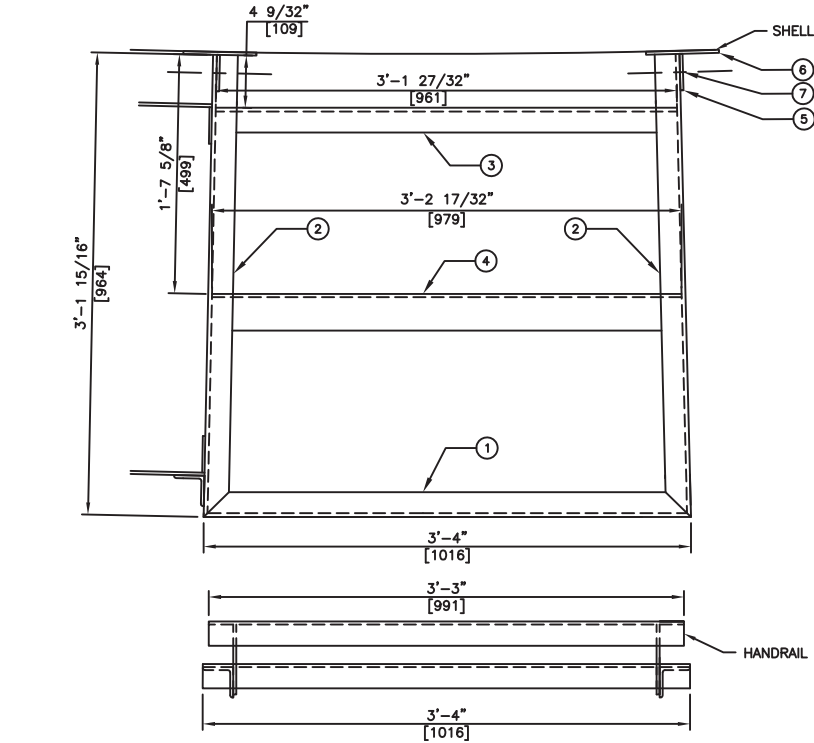


GRATING DETAIL

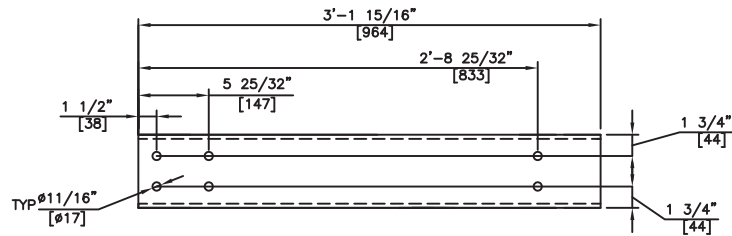

MARK 2 - RIGHT HAND SHOWN  
LEFT HAND OPPOSITE

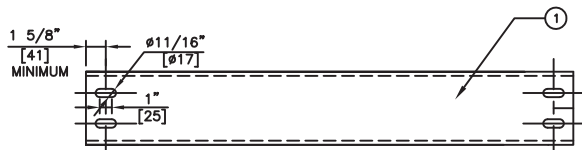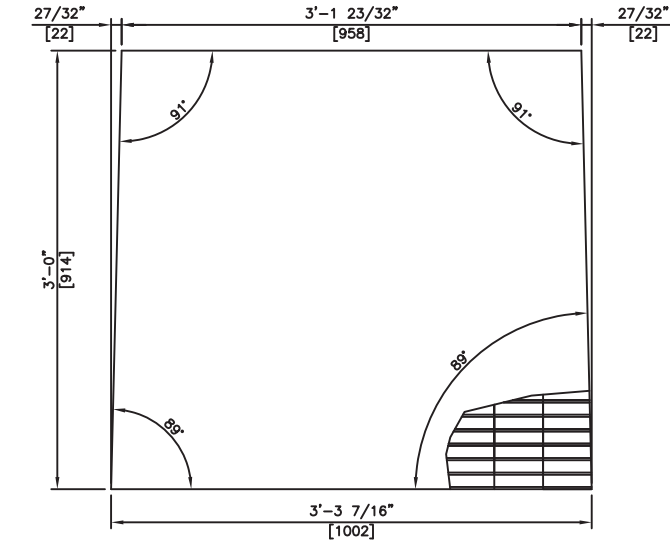

SLOTS MAY BE SHOP LOCATED TO MATCH HANDRAIL POST

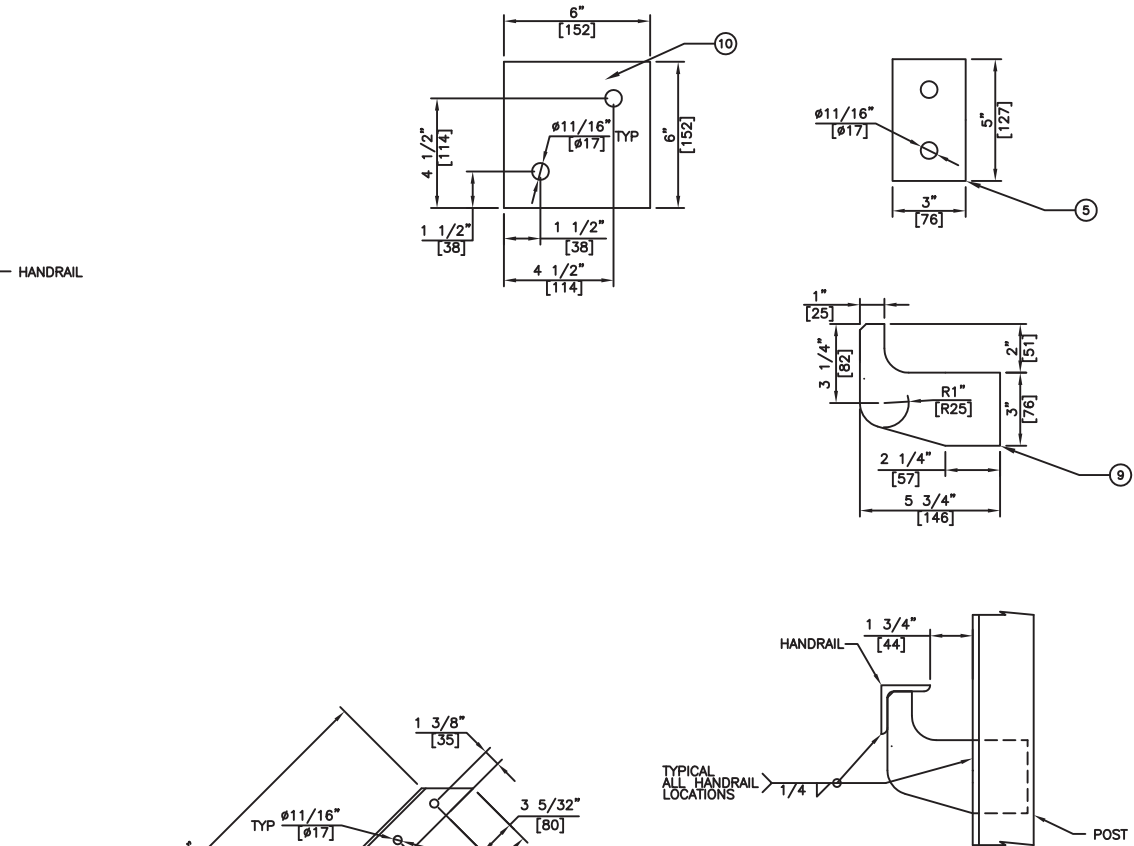

TYPICAL HANDRAIL/POST DETAIL

TYPICAL HANDRAIL DETAIL

TOPRAIL - 1/4" x 2" x 2" ANGLE  
HANDRAIL - 1/4" x 2" x 2" ANGLE  
MIDRAIL - 1/4" x 2" FLATBAR  
TOERAIL - 1/4" x 6" FLATBAR  
POST - 1/4" x 2 1/2" x 2 1/2" ANGLE  
GRATING - 19-W-4 1 1/2" DEEP x 3/16" GALVANIZED SERRATED BAR GRATING

\*\*HANDRAIL LOCATED ON OUTSIDE ONLY - BOLTED TO PLATFORM


\*\*ALL GRATING TO BE SECURED TO PLATFORM FRAME USING SADDLE CLIPS (BOLTED).

PLATFORM IS CAPABLE OF SUPPORTING A MOVING CONCENTRATED LOAD OF 1000LBS, AND HANDRAIL LOAD OF 200LBS IN ANY DIRECTION.


**AS-BUILT**  
BY Inukshuk Construction Ltd. DATE 2017/10/02




						SUB-ARC SYSTEMS INC.					
						CUSTOMER AGNICO EAGLE MINES LIMITED - MELIADINE PROJECT					
						TITLE MID PLATFORM DETAIL			PROJECT NO. 6515		
						LOCATION RANKIN INLET, NUNAVUT			TANK TAG: TK #2		
0	5-MAY-17	ME	KB	ISSUED FOR CONSTRUCTION							
A	17-APR-17	ME	KB	ISSUED FOR APPROVAL							
REV.	DATE	ORIG.	APPL.	DESCRIPTION			SCALE: 3/4" = 1'-0"	E.G. 17-03		DRWG. No. 17-03-2-001	Rev. 0
REVISIONS											

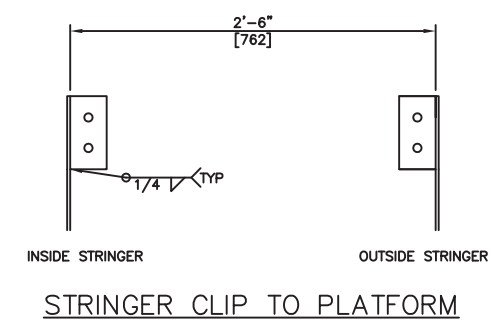[illegible]


BILLING FOR ONE TANK SHOWN, ONE REQUIRED

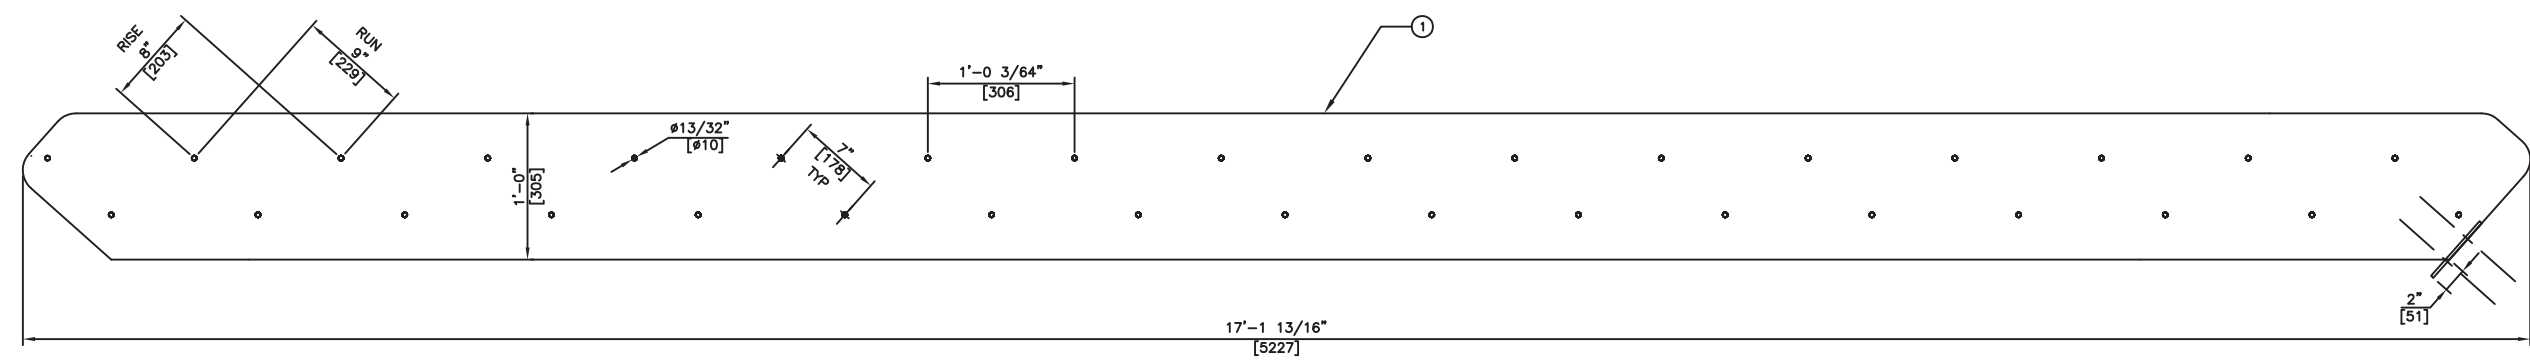


INSIDE BOTTOM STRINGER

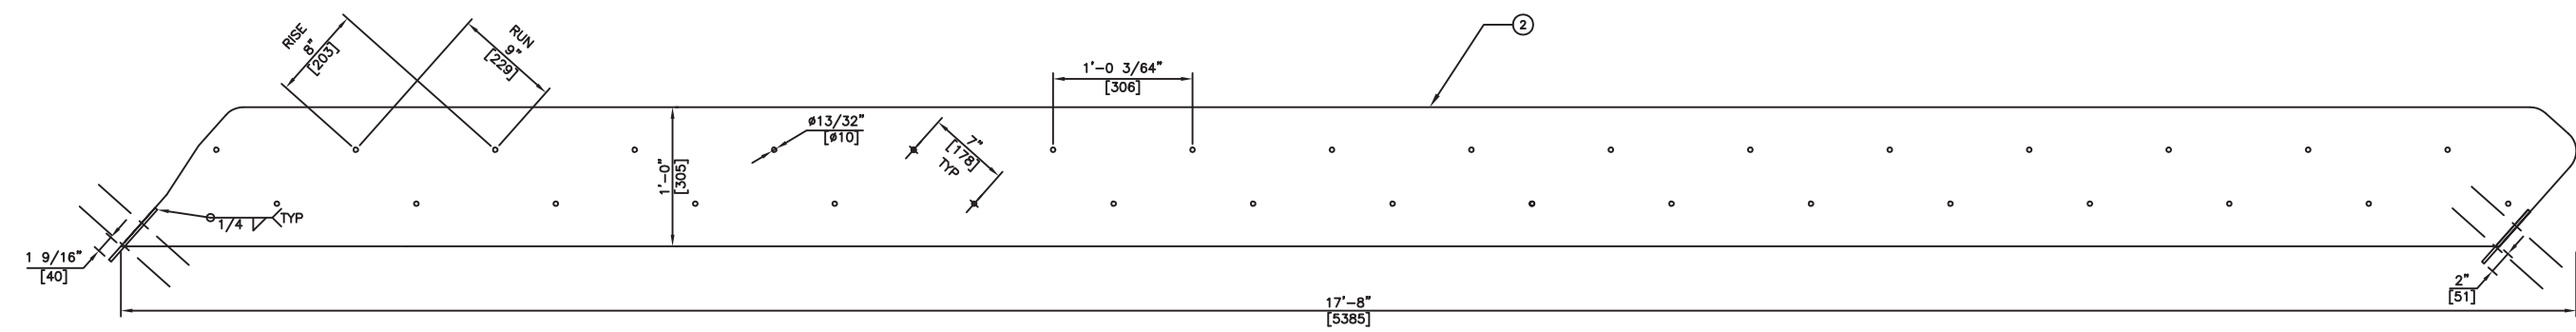


INSIDE STRINGER – THREE SECTIONS REQUIRED

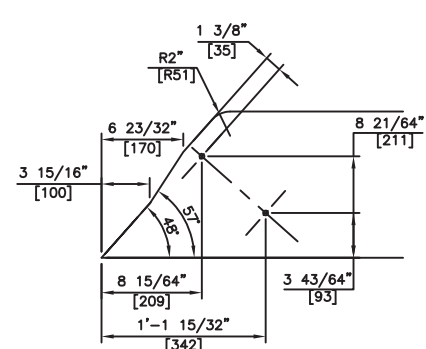

BOTTOM @ PLATFORM

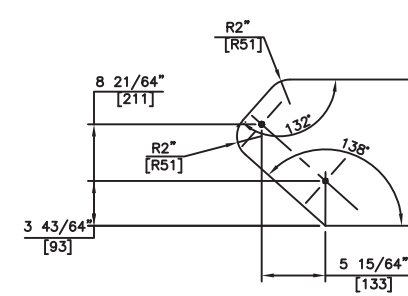

BOTTOM

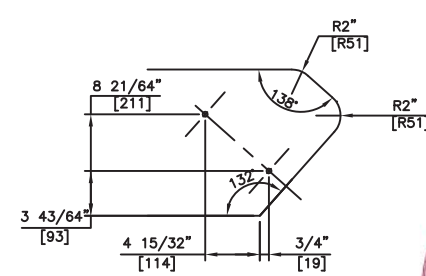


TOP

**AS-BUILT**

BY Inukshuk Construction Ltd. DATE 2017/10/02

NOTE: MARK 3 IS PLACED SAME SIDE AS STAIR.


						<div>SUB-ARC SYSTEMS INC.</div>											
						CUSTOMERAGNICO EAGLE MINES LIMITED – MELIADINE PROJECT											
						TITLEINSIDE STRINGER DETAIL				PROJECT NO.6515							
						LOCATIONRANKIN INLET, NUNAVUT				TANK NO.TANK TAG: TK #2							
0	5-MAY-17	ME	KB	ISSUED FOR CONSTRUCTION													
A	17-APR-17	ME	KB	ISSUED FOR APPROVAL													
REV.	DATE	DRWN.	APP'D.	DESCRIPTION													
REVISIONS																	
						SCALE:3/4" = 1'-0"				S.D.		17-03		DRWG. No.17-03-2-002		Rev.0	
						DATE:17-APR-17											

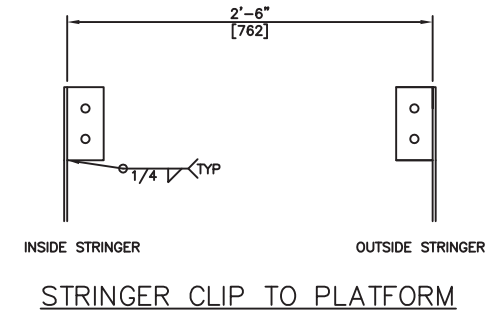[illegible]


Technical drawing of a rectangular plate with the following specifications:

- Overall Dimensions:**
  - Length:  $17'-6 \frac{1}{8}"$  [5338]
  - Width:  $1'-0"$  [305]
- Top Edge Details:**
  - Left corner chamfer:  $R15"$  [203]
  - Top edge slope:  $9 \times 1/32"$  [237]
- Hole Specifications:**
  - Top edge hole:  $\phi 13/32"$  [ $\phi 10$ ]
  - Bottom edge hole:  $\phi 13/32"$  [ $\phi 10$ ]
  - Internal hole:  $\phi 13/32"$  [ $\phi 10$ ]
- Other Features:**
  - Right corner chamfer:  $R15"$  [203]
  - Bottom edge chamfer:  $R15"$  [203]
  - Bottom edge slope:  $9 \times 1/32"$  [237]


OUTSIDE BOTTOM STRINGER

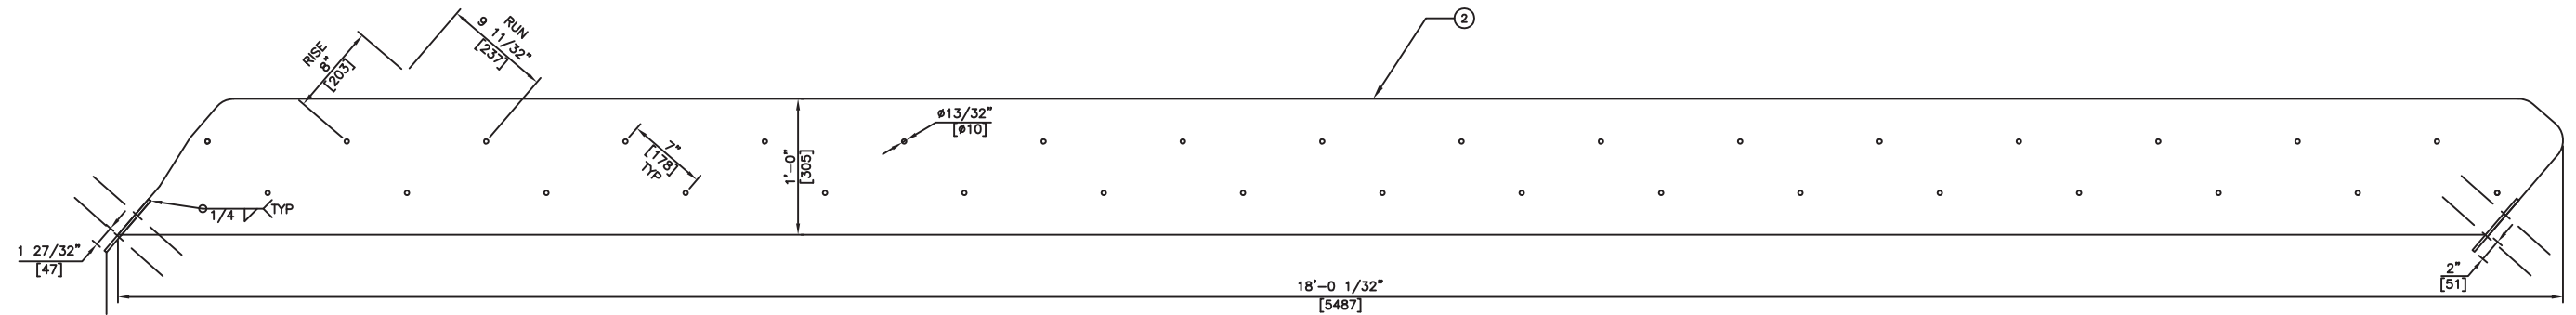

### OUTSIDE STRINGER – THREE SECTIONS REQUIRED

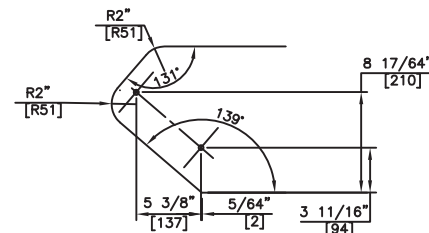

BOTTOM @ PLATFORM

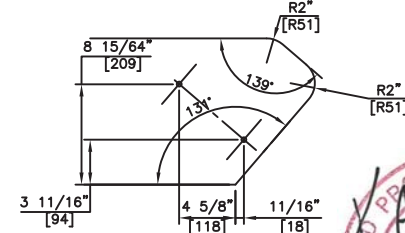

TOP

## AS-BUILT

**BY** Inukshuk Construction Ltd. **DATE** 2017/10/02


NOTE: MARK 3 IS PLACED SAME SIDE AS STAIR.

*SUB-ARC SYSTEMS INC.*


						<i>SUB-ARC SYSTEMS INC.</i>									
						CUSTOMER AGNICO EAGLE MINES LIMITED – MELIADINE PROJECT									
						TITLE OUTSIDE STRINGER DETAIL							PROJECT NO. 6515		
						LOCATION RANKIN INLET, NUUNAVUT							TANK NO. TANK TAG: TK #2		
0	5-MAY-17	ME	KB	ISSUED FOR CONSTRUCTION					SCALE: 3/4" = 1'-0"		N.O.		DWG. No.		Rev.
A	17-APR-17	ME	KB	ISSUED FOR APPROVAL					DATE: 17-APR-17		17-03		17-03-2-003		0
REV.	DATE	DRAWN	APP'D	DESCRIPTION					SCALE:		N.O.		DWG. No.		Rev.
REVISIONS															






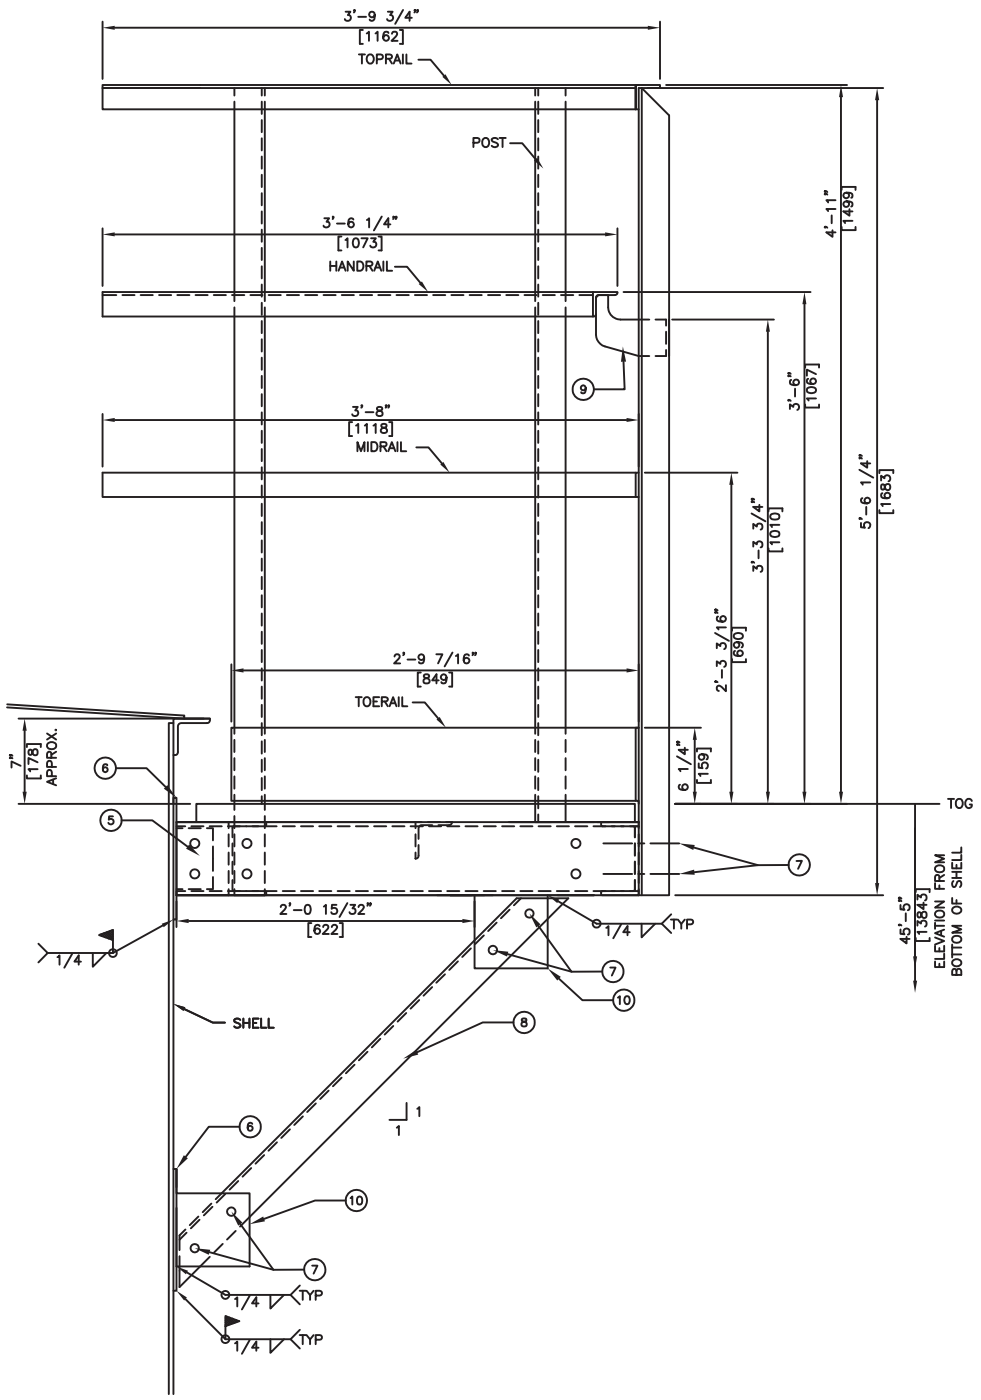


PLATFORM ELEVATION DETAIL

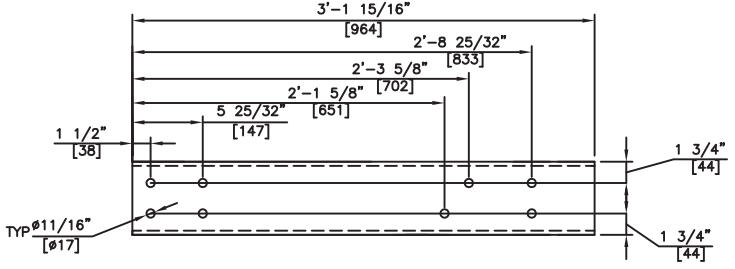



MARK 2 - RIGHT HAND SHOWN  
LEFT HAND OPPOSITE

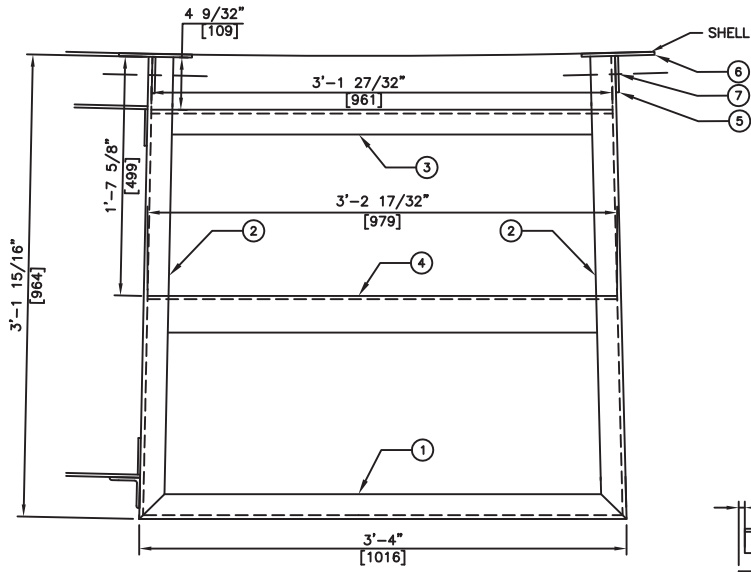

GRATING DETAIL

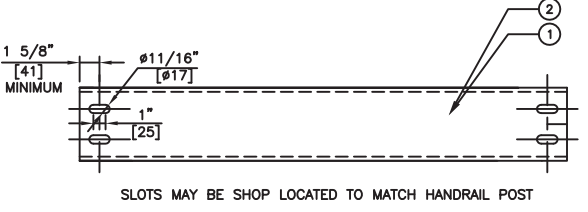

SLOTS MAY BE SHOP LOCATED TO MATCH HANDRAIL POST

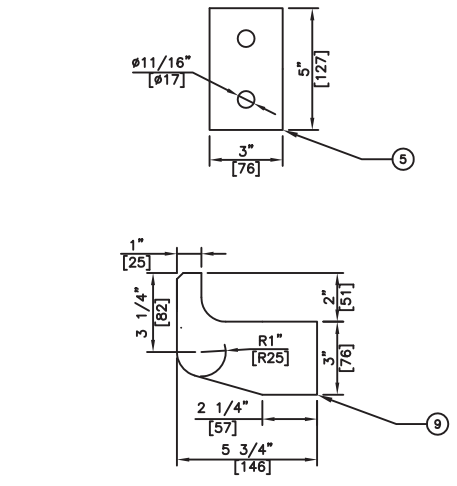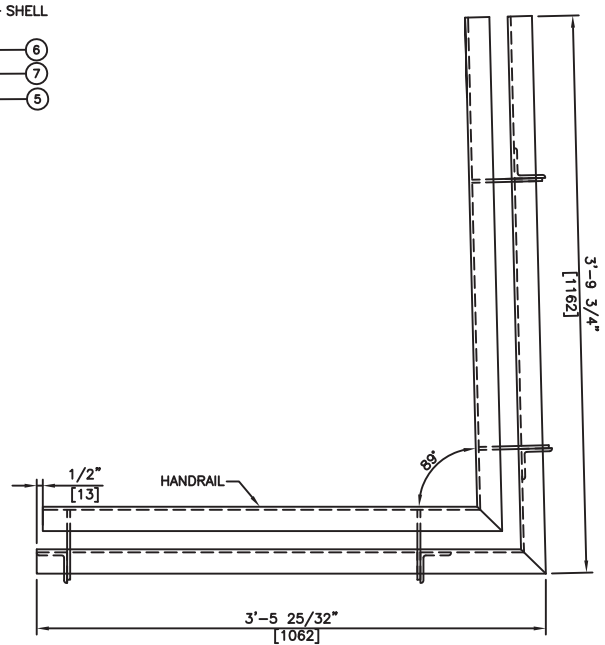

TYPICAL HANDRAIL/POST DETAIL

TYPICAL HANDRAIL DETAIL

TOPRAIL - 1/4" x 2" x 2" ANGLE  
HANDRAIL - 1/4" x 2" x 2" ANGLE  
MIDRAIL - 1/4" x 2" FLATBAR  
TOERAIL - 1/4" x 6" FLATBAR  
POST - 1/4" x 2 1/2" x 2 1/2" ANGLE  
GRATING - 19-W-4 1 1/2" DEEP x 3/16" GALVANIZED SERRATED BAR GRATING

\*\*HANDRAIL LOCATED ON OUTSIDE ONLY - BOLTED TO PLATFORM  
\*\*ALL GRATING TO BE SECURED TO PLATFORM FRAME USING SADDLE CLIPS (BOLTED).  
FIELD TO TRIM HANDRAIL OVER TANK ROOF TO MATE WITH PERIMETER HANDRAIL  
PLATFORM IS CAPABLE OF SUPPORTING A MOVING CONCENTRATED LOAD OF 1000LBS, AND HANDRAIL LOAD OF 200LBS IN ANY DIRECTION.

BILL OF MATERIALS


MARK	QTY.	DESCRIPTION	MATERIAL	MTR	WT #s
1	1	C6@10.5# x 3'-4" LG (CBE)	G40.21-300W	C	-
2	2	C6@10.5# x 3'-1 15/16" LG (COE/POE)	G40.21-300W	C	-
3	1	C6@10.5# x 3'-1 27/32" LG (CBE)	G40.21-300W	C	-
4	1	3/8" x 3" x 3" ANGLE x 3'-2 17/32" LG (CBE)	G40.21-300W	C	-
5	2	3/8" THK x 3" x 5"	G40.21-260W	C	-
6	4	1/4" THK x 6" x 10" c/w 2" RADIUS CORNERS	G40.21-260W	C	-
7	20	5/8" x 1 3/4" LG HEX HD BOLT c/w (1) NUT & LOCK WASHER AND (2) FLAT WASHERS	A325 GALV	C	-
8	2	3/8" x 3" x 3" ANGLE x 3' - 9 1/8" LG (CBE)	G40.21-300W	C	-
9	4	1/4" THK x 5" x 5 3/4" SEE DETAIL	G40.21-260W	C	-

BILLING FOR ONE TANK SHOWN, ONE (1) REQUIRED

**AS-BUILT**  
BY Inukshuk Construction Ltd. DATE 2017/10/02



REVISIONS						SUB-ARC SYSTEMS INC.			
REV.	DATE	DRWN.	APP'D.	DESCRIPTION		CUSTOMER AGNICO EAGLE MINES LIMITED - MELIADINE PROJECT			
0	5-MAY-17	ME	KB	ISSUED FOR CONSTRUCTION		TITLE TOP PLATFORM DETAIL			
A	17-APR-17	ME	KB	ISSUED FOR APPROVAL		PROJECT NO. 6515			
						LOCATION RANKIN INLET, NUNAVUT			
						TANK TAG: TK #2			
						SCALE: 3/4" = 1'-0"			
						DATE: 17-APR-17			
						17-03			
						17-03-2-005			
						0			

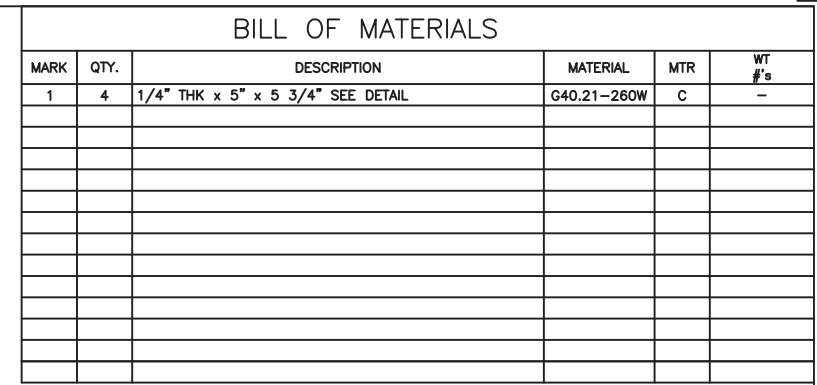

1 1/4" [25]

3 1/4" [82]

2" [51]

R1" [R25]

2 1/4" [57]

5 3/4" [146]

3" [76]

1

HANDRAIL

1 3/4" [44]

1 1/4"

TYPICAL ALL HANDRAIL LOCATIONS

POST

TYPICAL HANDRAIL DETAIL

\*\*HANDRAIL LOCATED ON OUTSIDE ONLY

# AS-BUILT

BY Inukshuk Construction Ltd. DATE 2017/10/02

						<div style="text-align: center; font-size: 1.2em; font-weight: bold;">SUB-ARC SYSTEMS INC.</div>			
						<div style="display: flex; justify-content: space-between;"> <div>CUSTOMER</div> <div>AGNICO EAGLE MINES LIMITED – MELIADINE PROJECT</div> </div>			
						<div style="display: flex; justify-content: space-between;"> <div>TITLE</div> <div>STAIR HANDRAIL DETAIL</div> </div>		<div style="display: flex; justify-content: space-between;"> <div>PROJECT NO.</div> <div>6515</div> </div>	
						<div style="display: flex; justify-content: space-between;"> <div>LOCATION</div> <div>RANKIN INLET, NUNAVUT</div> </div>		<div style="display: flex; justify-content: space-between;"> <div>TANK NO.</div> <div>TANK TAG: TK #2</div> </div>	
						<div style="display: flex; justify-content: space-between;"> <div>SCALE: 3/4" = 1'-0"</div> <div>S.D.</div> </div>			
						<div style="display: flex; justify-content: space-between;"> <div>DATE: 17-APR-17</div> <div>17-03</div> </div>		<div style="display: flex; justify-content: space-between;"> <div>DRWG. NO.</div> <div>17-03-2-006</div> </div>	
						<div style="display: flex; justify-content: space-between;"> <div>REV.</div> <div>DATE</div> <div>DRWN.</div> <div>APP'D.</div> <div>DESCRIPTION</div> </div>			
						<div>REVISIONS</div>			
0	5-MAY-17	ME	KB	ISSUED FOR CONSTRUCTION					
A	17-APR-17	ME	KB	ISSUED FOR APPROVAL					



## **APPENDIX B**

# **Survey Drawings of Rankin Inlet Fuel Storage and Containment Facilities**



AGNICO EAGLE

COORD. SYSTEME:  
UTM15 NAD83

SCALE:  
1:2000

WORK EXECUTION DATE : 2017-10-13

AS BUILT  
RANKIN FUEL FARM

PLAN NO.:  
131-RANKIN-FUEL-FARM-QT-171025-01


EMISSION DATE : 2017-10-25

DRAWN BY:  
R.CLOUATRE

APPROVED BY:  
Hamel arpentage



*EXCAVATION*  
*78 500 M<sup>3</sup>*

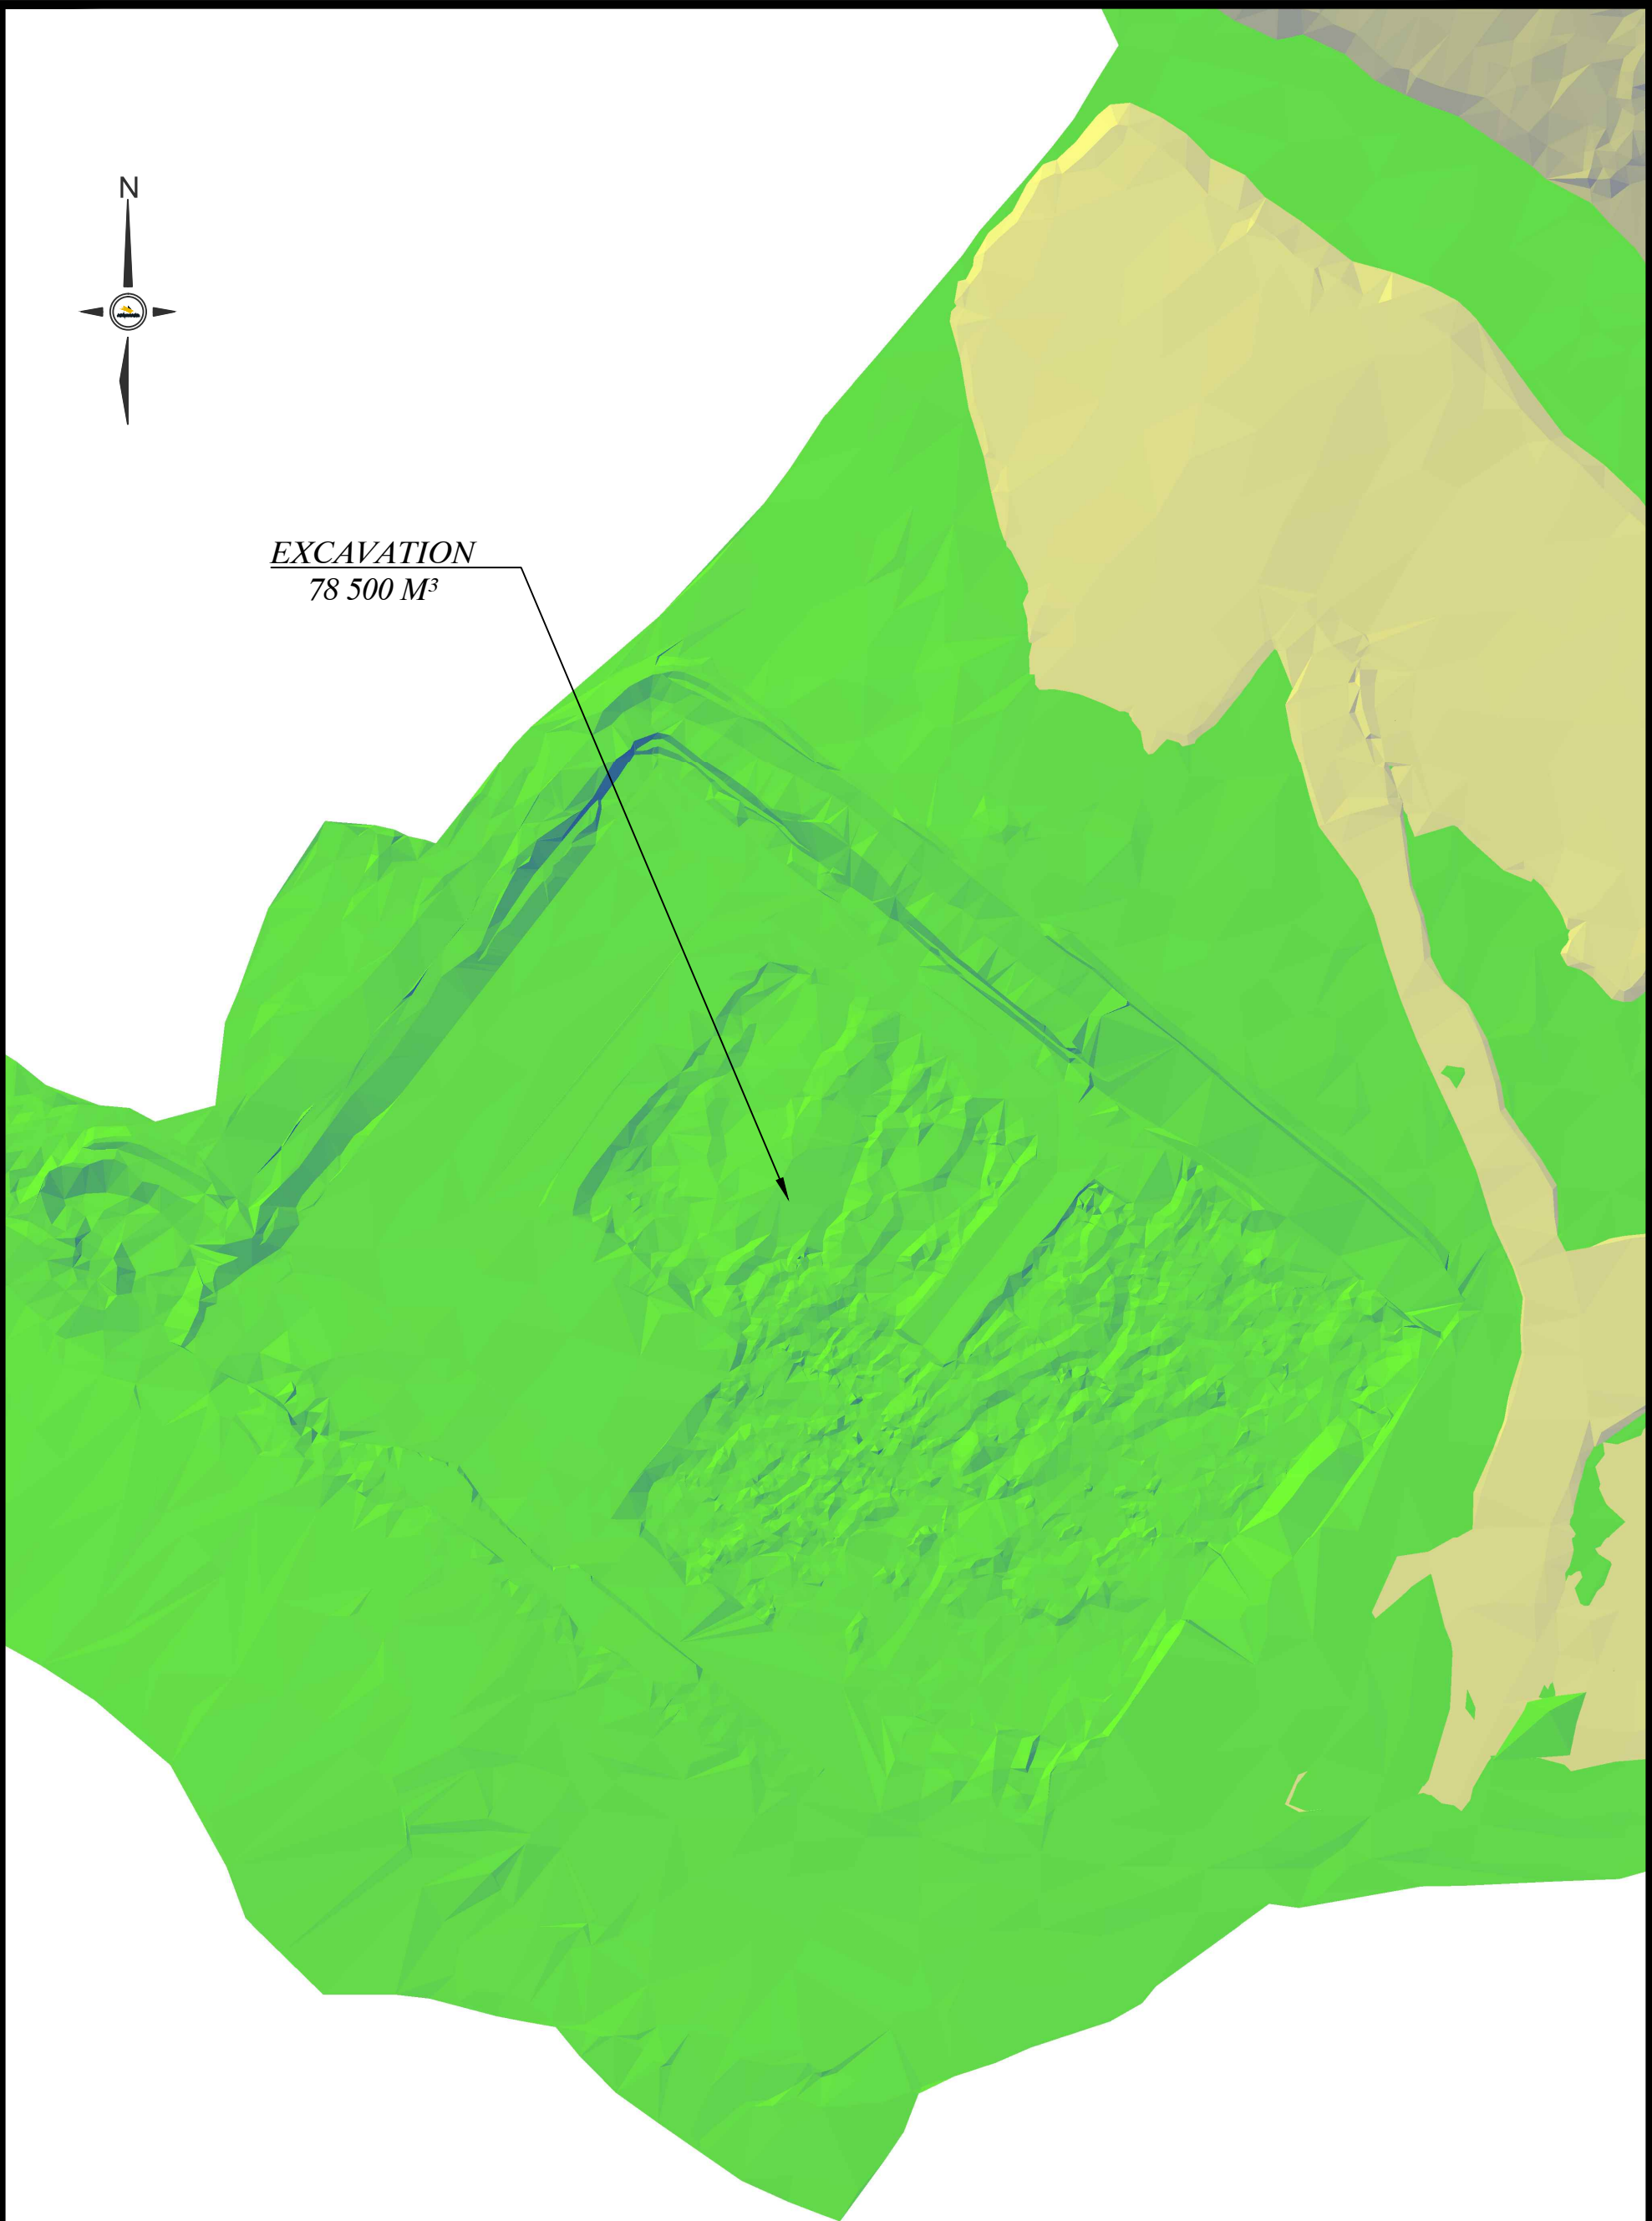

*AGNICO EAGLE*

COORD. SYSTEME:  
*UTM15 NAD83*

SCALE:  
*1:1000*

WORK EXECUTION DATE : *2017-10-13*

*AS BUILT EXCAVATION*  
*RANKIN FUEL FARM*

PLAN NO.:  
*131-RANKIN-FUEL-FARM-QT-171025-02*

EMISSION DATE : *2017-10-25*

DRAWN BY:  
*R.CLOUATRE*


APPROVED BY:  
*Hamel arpentage*





*WASTE DUMP*  
*29 820 M<sup>3</sup>*

*OVERBURDEN*  
*13 696 M<sup>3</sup>*

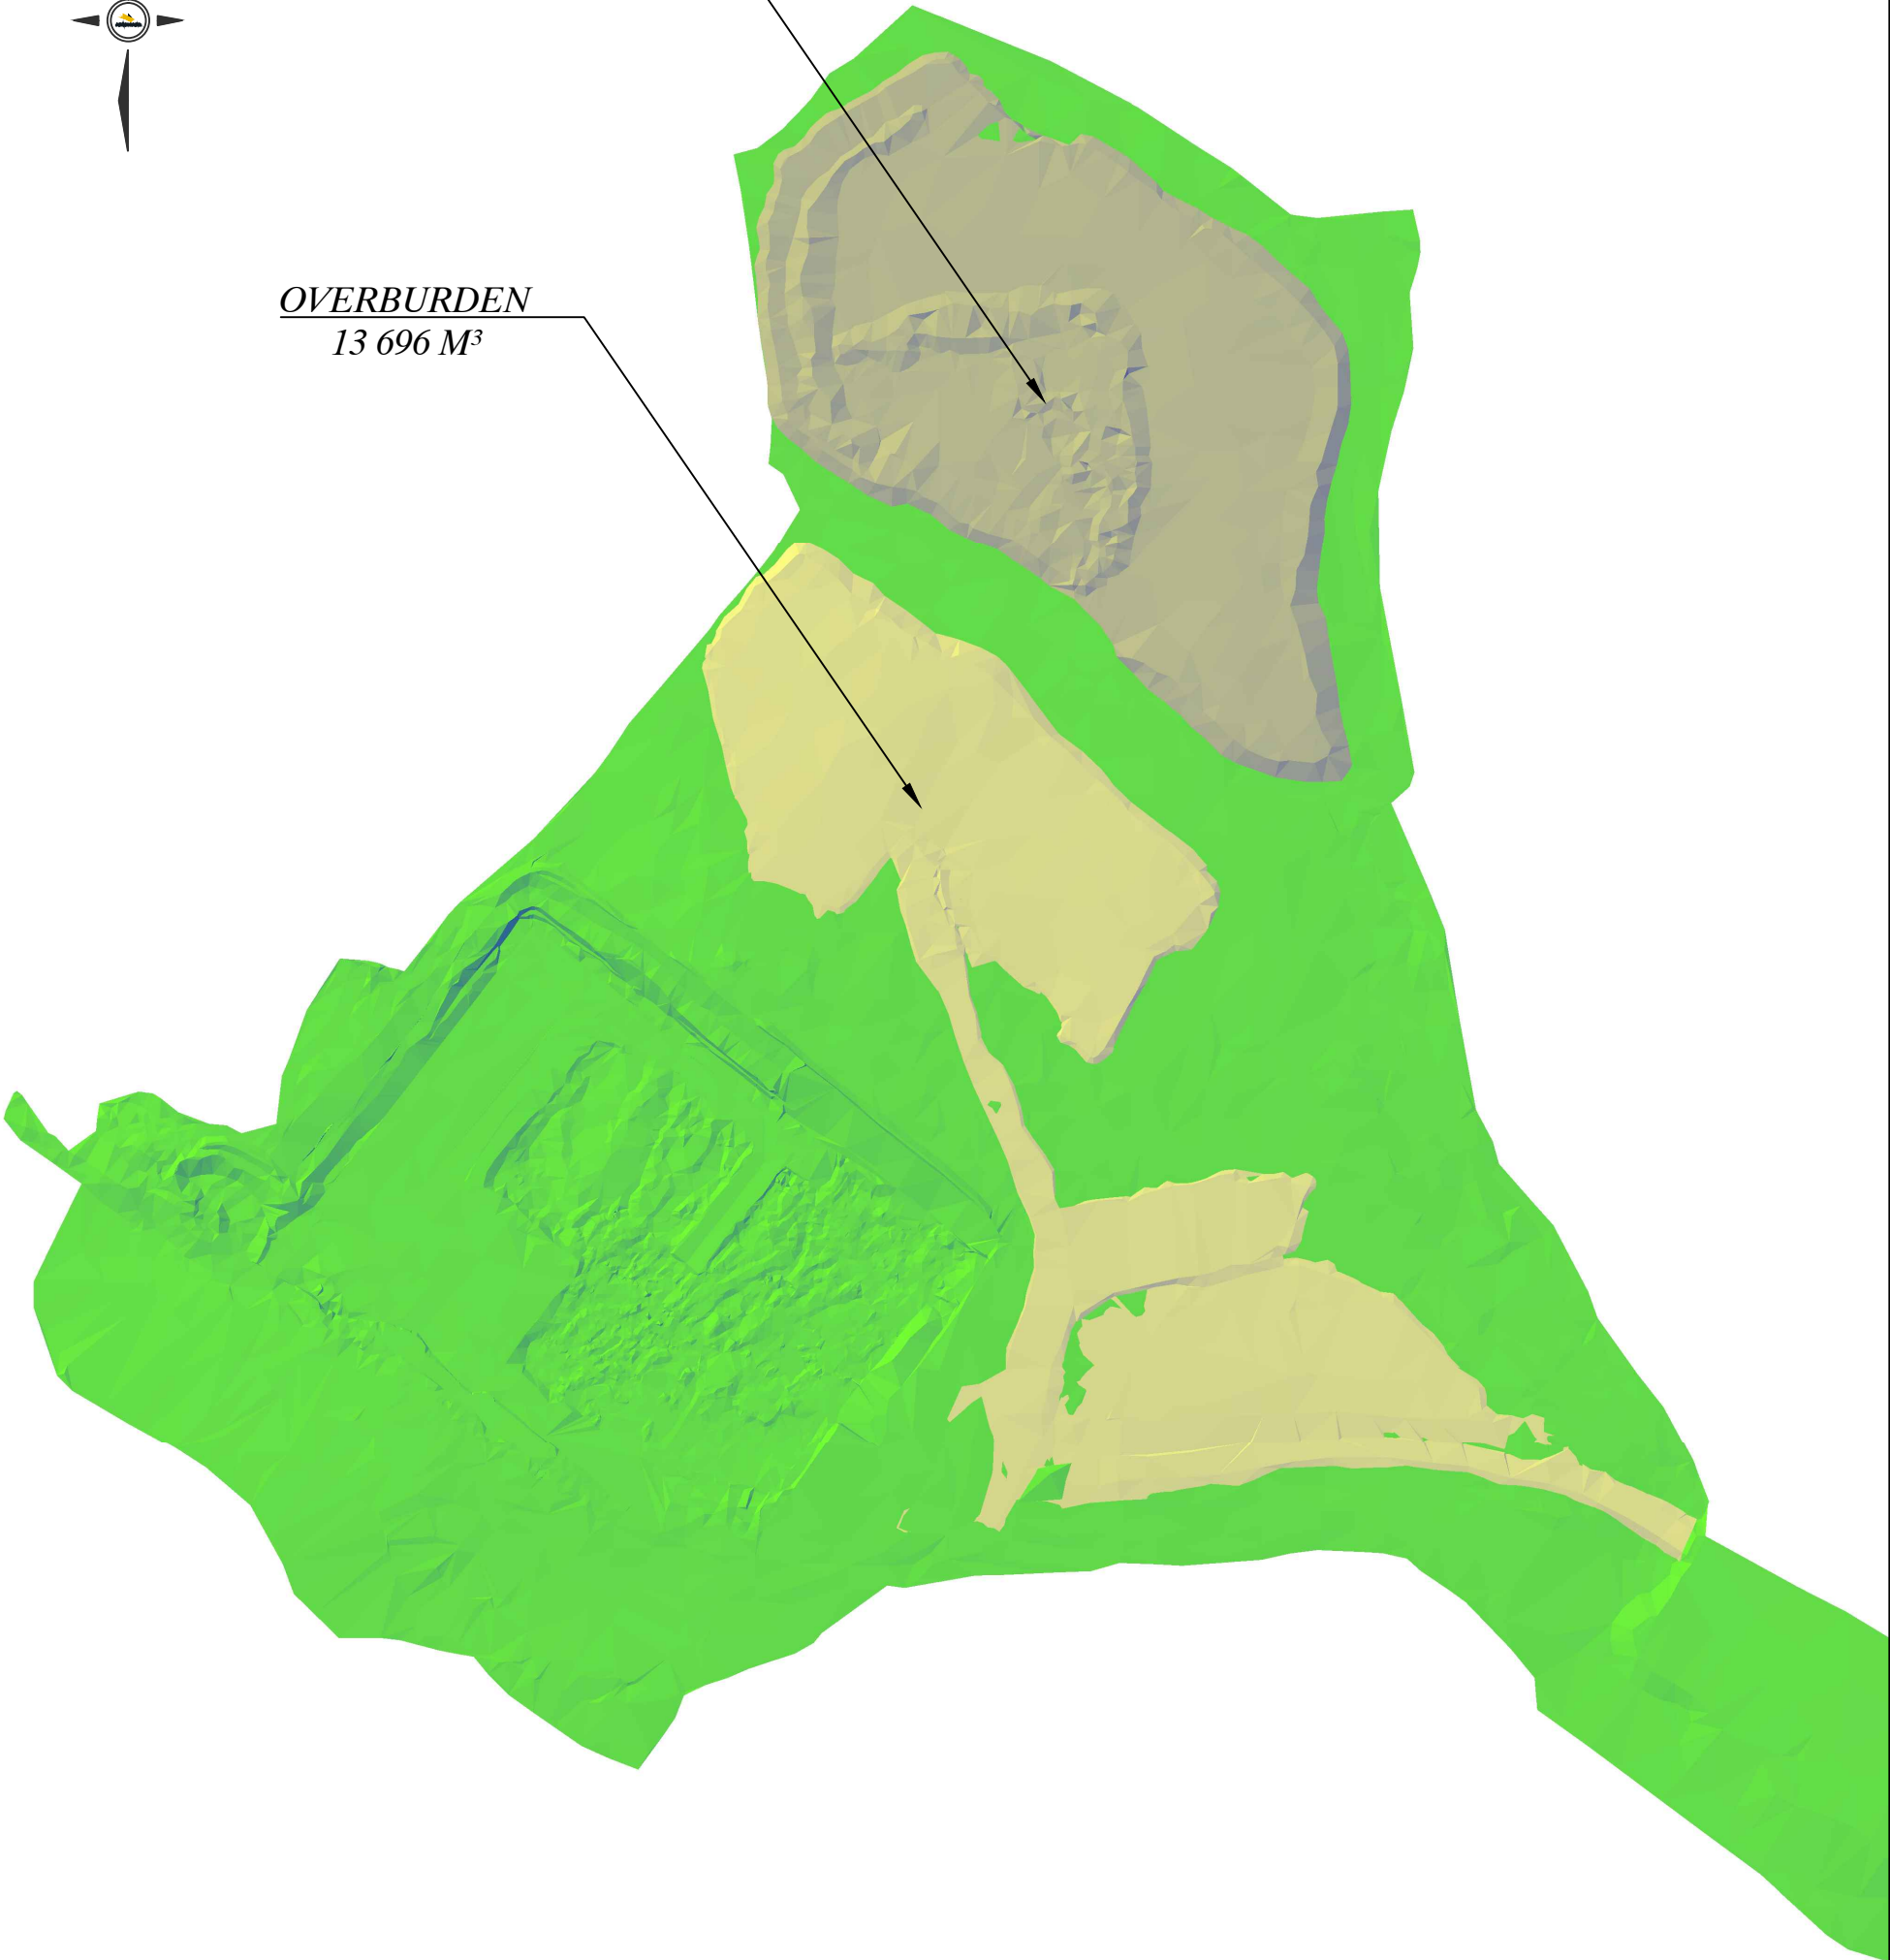

*AGNICO EAGLE*

COORD. SYSTEME:  
*UTM15 NAD83*

SCALE:  
*1:2000*

WORK EXECUTION DATE : *2017-10-13*

*AS BUILT OVERBURDEN*  
*RANKIN FUEL FARM*

PLAN NO.:  
*131-RANKIN-FUEL-FARM-QT-171025-03*

EMISSION DATE : *2017-10-25*

DRAWN BY:  
*R.CLOUATRE*

APPROVED BY:  
*Hamel arpentage*



40 % OVERBURDEN  
AND 60% ROM  
9 343 M<sup>3</sup>



AGNICO EAGLE

COORD. SYSTEME:  
UTM15 NAD83

SCALE:  
1:2000

WORK EXECUTION DATE :2017-10-13

AS BUILT OB-ROM-MIX  
RANKIN FUEL FARM

PLAN NO.:  
131-RANKIN-FUEL-FARM-QT-171025-04

EMISSION DATE : 2017-10-25

DRAWN BY:  
R.CLOUATRE

APPROVED BY:  
Hamel arpentage



AGNICO EAGLE

WORK EXECUTION DATE : 2017-10-13

EMISSION DATE : 2017-10-25

COORD. SYSTEME:  
UTM15 NAD83

AS BUILT 0-600 MM  
RANKIN FUEL FARM

DRAWN BY:  
R.CLOUATRE

SCALE:  
1:2000

PLAN NO.:  
131-RANKIN-FUEL-FARM-QT-171025-05

APPROVED BY:  
Hamel arpentage







C:\Users\Utilisateur\Desktop\RANKIN\_INLET\SURVEY\DWG\FINAL-AS-BUILT\AS-BUILT\_FUEL\_FARM-171025-06-RANKIN-surfaces.dwg



AGNICO EAGLE	WORK EXECUTION DATE : 2017-10-13	EMISSION DATE : 2017-10-25
COORD. SYSTEME: UTM15 NAD83	AS BUILT 0-200 MM RANKIN FUEL FARM	DRAWN BY: R.CLOUATRE
SCALE: 1:1000	PLAN NO.: 131-RANKIN-FUEL-FARM-QT-171025-06	APPROVED BY: Hamel arpentage



0-30 MM UNDER LINER  
3 745 M<sup>3</sup>

SUMP



AGNICO EAGLE

COORD. SYSTEME:  
UTM15 NAD83

SCALE:  
1:1000

WORK EXECUTION DATE : 2017-10-13

AS BUILT  
RANKIN FUEL FARM

PLAN NO.:  
131-RANKIN-FUEL-FARM-QT-171025-07

EMISSION DATE : 2017-10-25

DRAWN BY:  
R.CLOUATRE

APPROVED BY:  
Hamel arpentage





*SAND UNDER LINER*  
*684 M<sup>3</sup>*

*SUMP*



*AGNICO EAGLE*

COORD. SYSTEME:  
*UTM15 NAD83*

SCALE:  
*1:1000*

WORK EXECUTION DATE : *2017-10-13*

*A-B SAND UNDER LINER*  
*RANKIN FUEL FARM*

PLAN NO.:  
*131-RANKIN-FUEL-FARM-QT-171025-08*

EMISSION DATE : *2017-10-25*

DRAWN BY:  
*R.CLOUATRE*

APPROVED BY:  
*Hamel arpentage*






C:\Users\Utilisateur\Desktop\RANKIN\_INLET\SURVEY\DWG\FINAL-AS-BUILT\FU2017F4004-RANKIN-surfaces.dwg



AGNICO EAGLE	WORK EXECUTION DATE : 2017-10-13	EMISSION DATE : 2017-10-25
COORD. SYSTEME: UTM15 NAD83	AS BUILT LINER RANKIN FUEL FARM	DRAWN BY: R.CLOUATRE
SCALE: 1:1000	PLAN NO.: 131-RANKIN-FUEL-FARM-QT-171025-09	APPROVED BY: Hamel arpentage

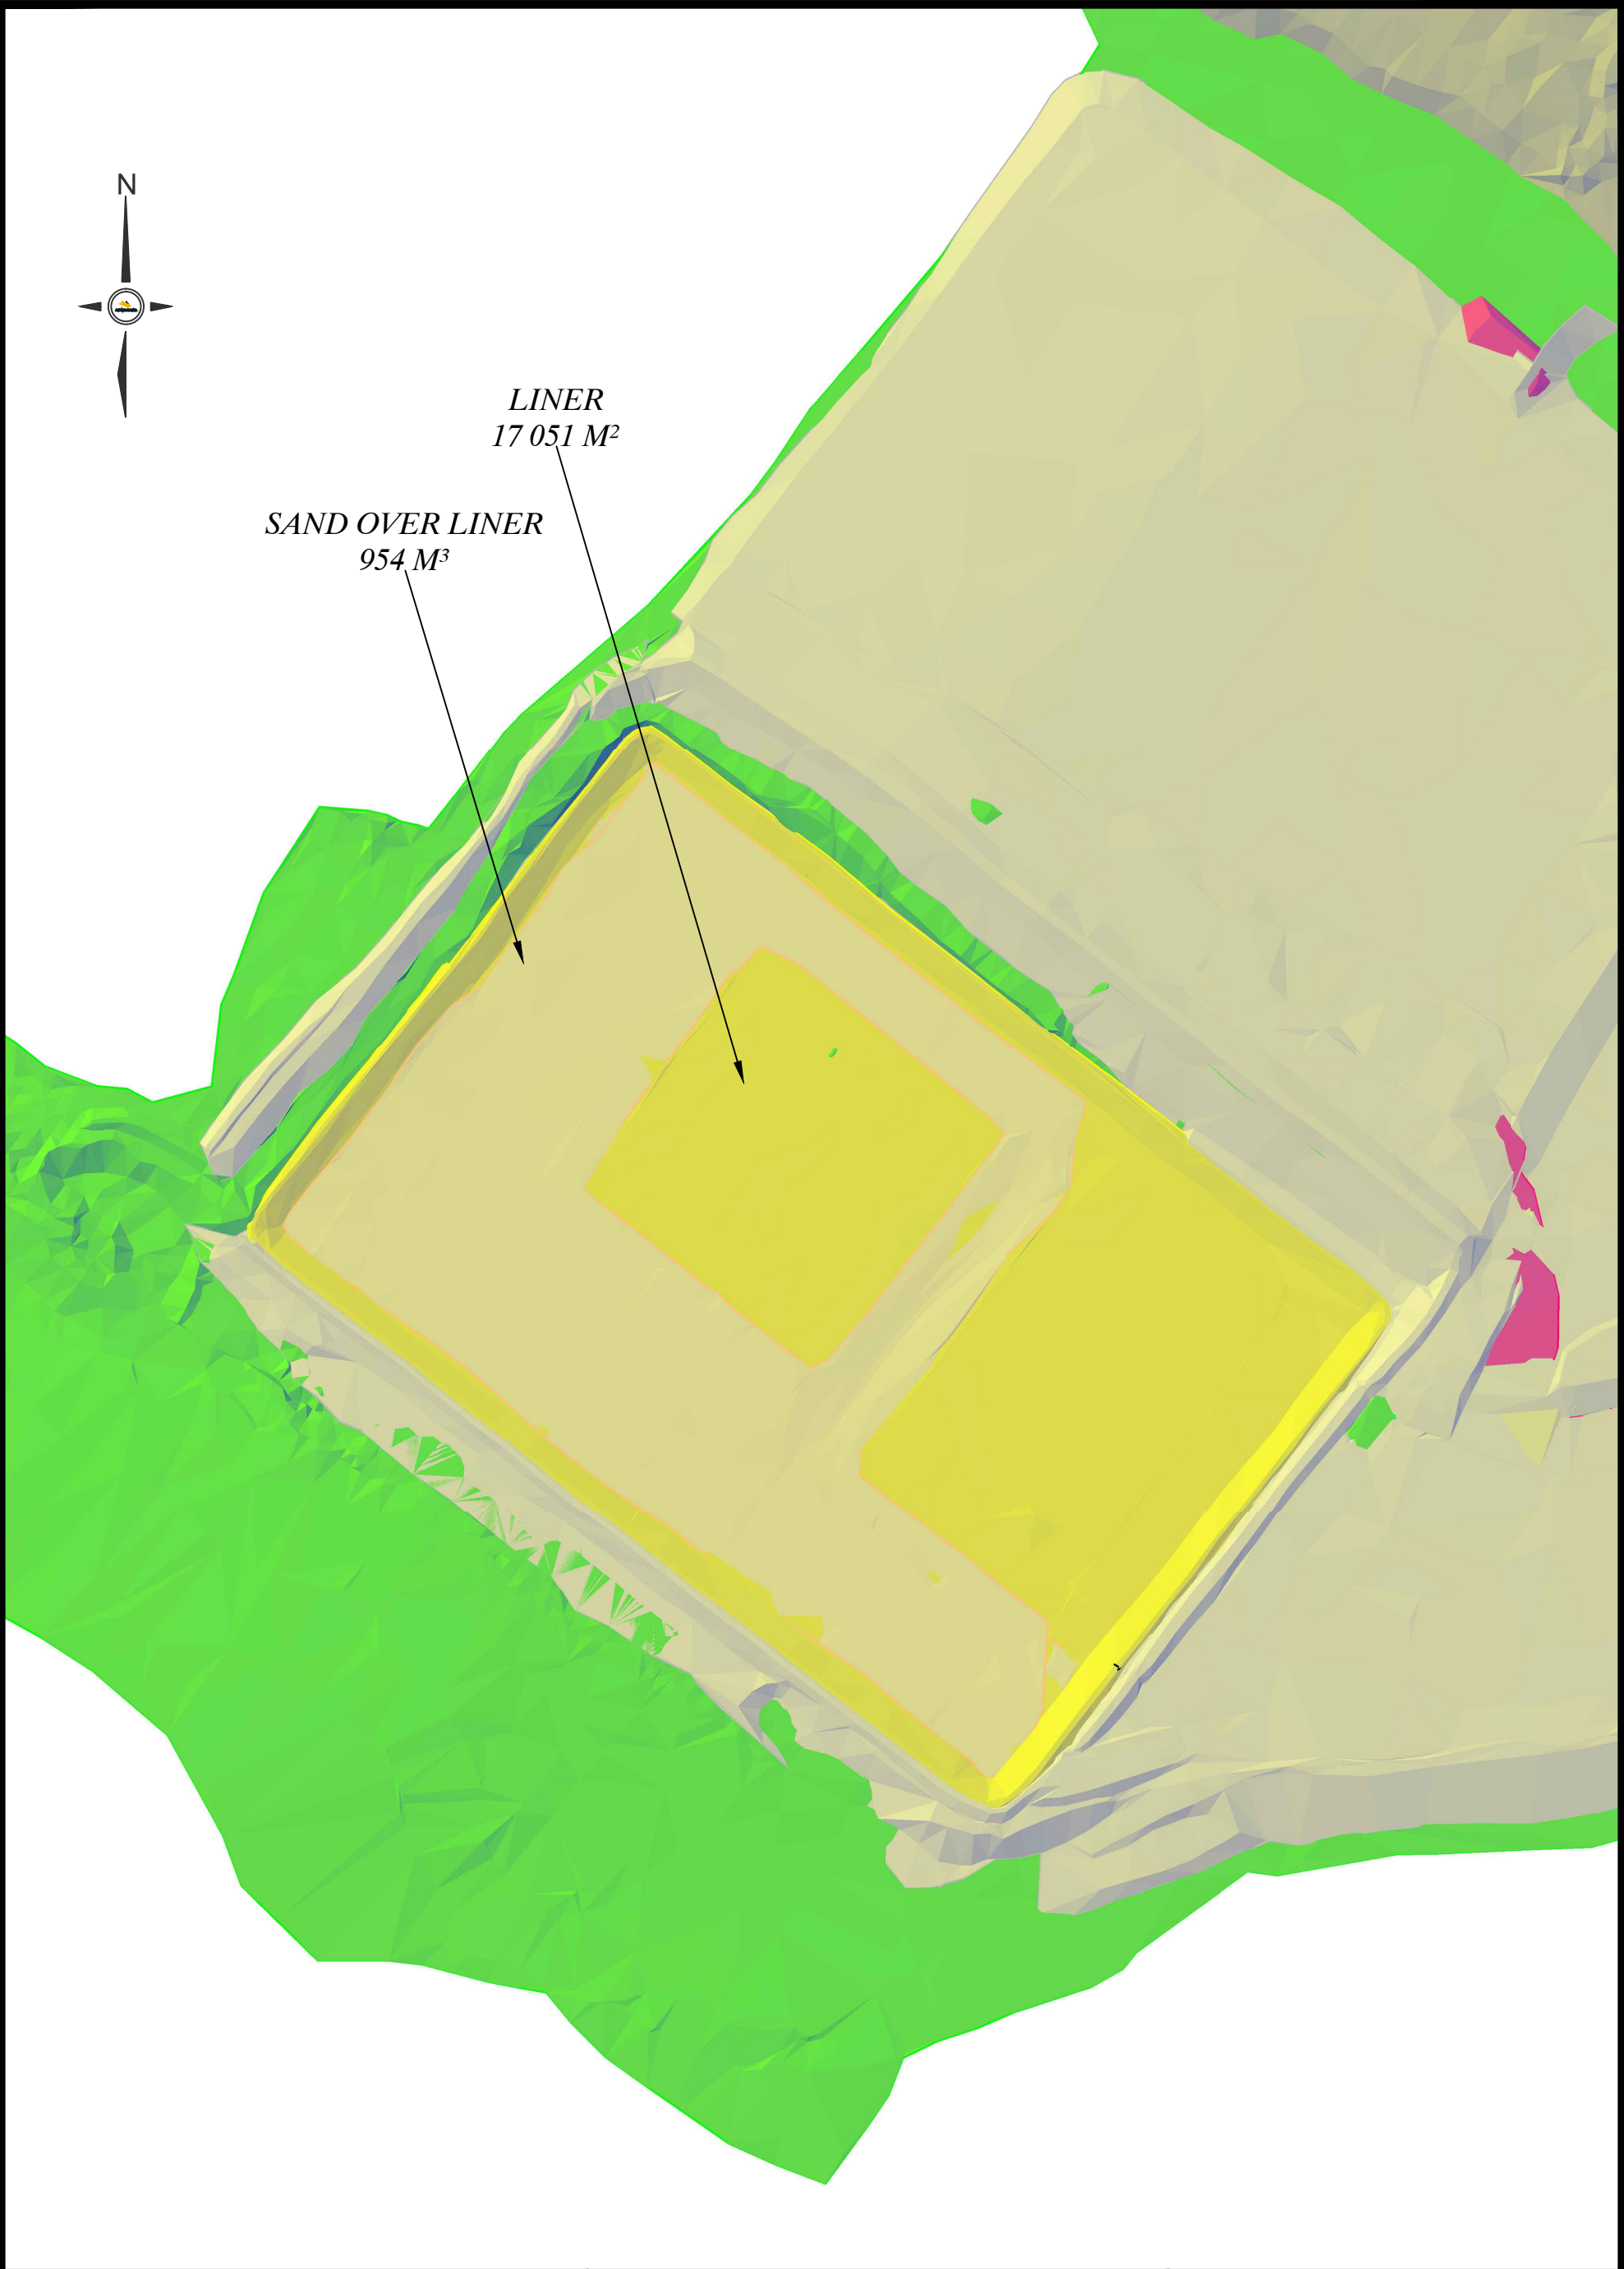

AGNICO EAGLE

COORD. SYSTEME:  
UTM15 NAD83

SCALE:  
1:1000

WORK EXECUTION DATE : 2017-10-13

A-B SAND OVER LINER  
RANKIN FUEL FARM


PLAN NO.:  
131-RANKIN-FUEL-FARM-QT-171025-10

EMISSION DATE : 2017-10-25

DRAWN BY:  
R.CLOUATRE

APPROVED BY:  
Hamel arpentage



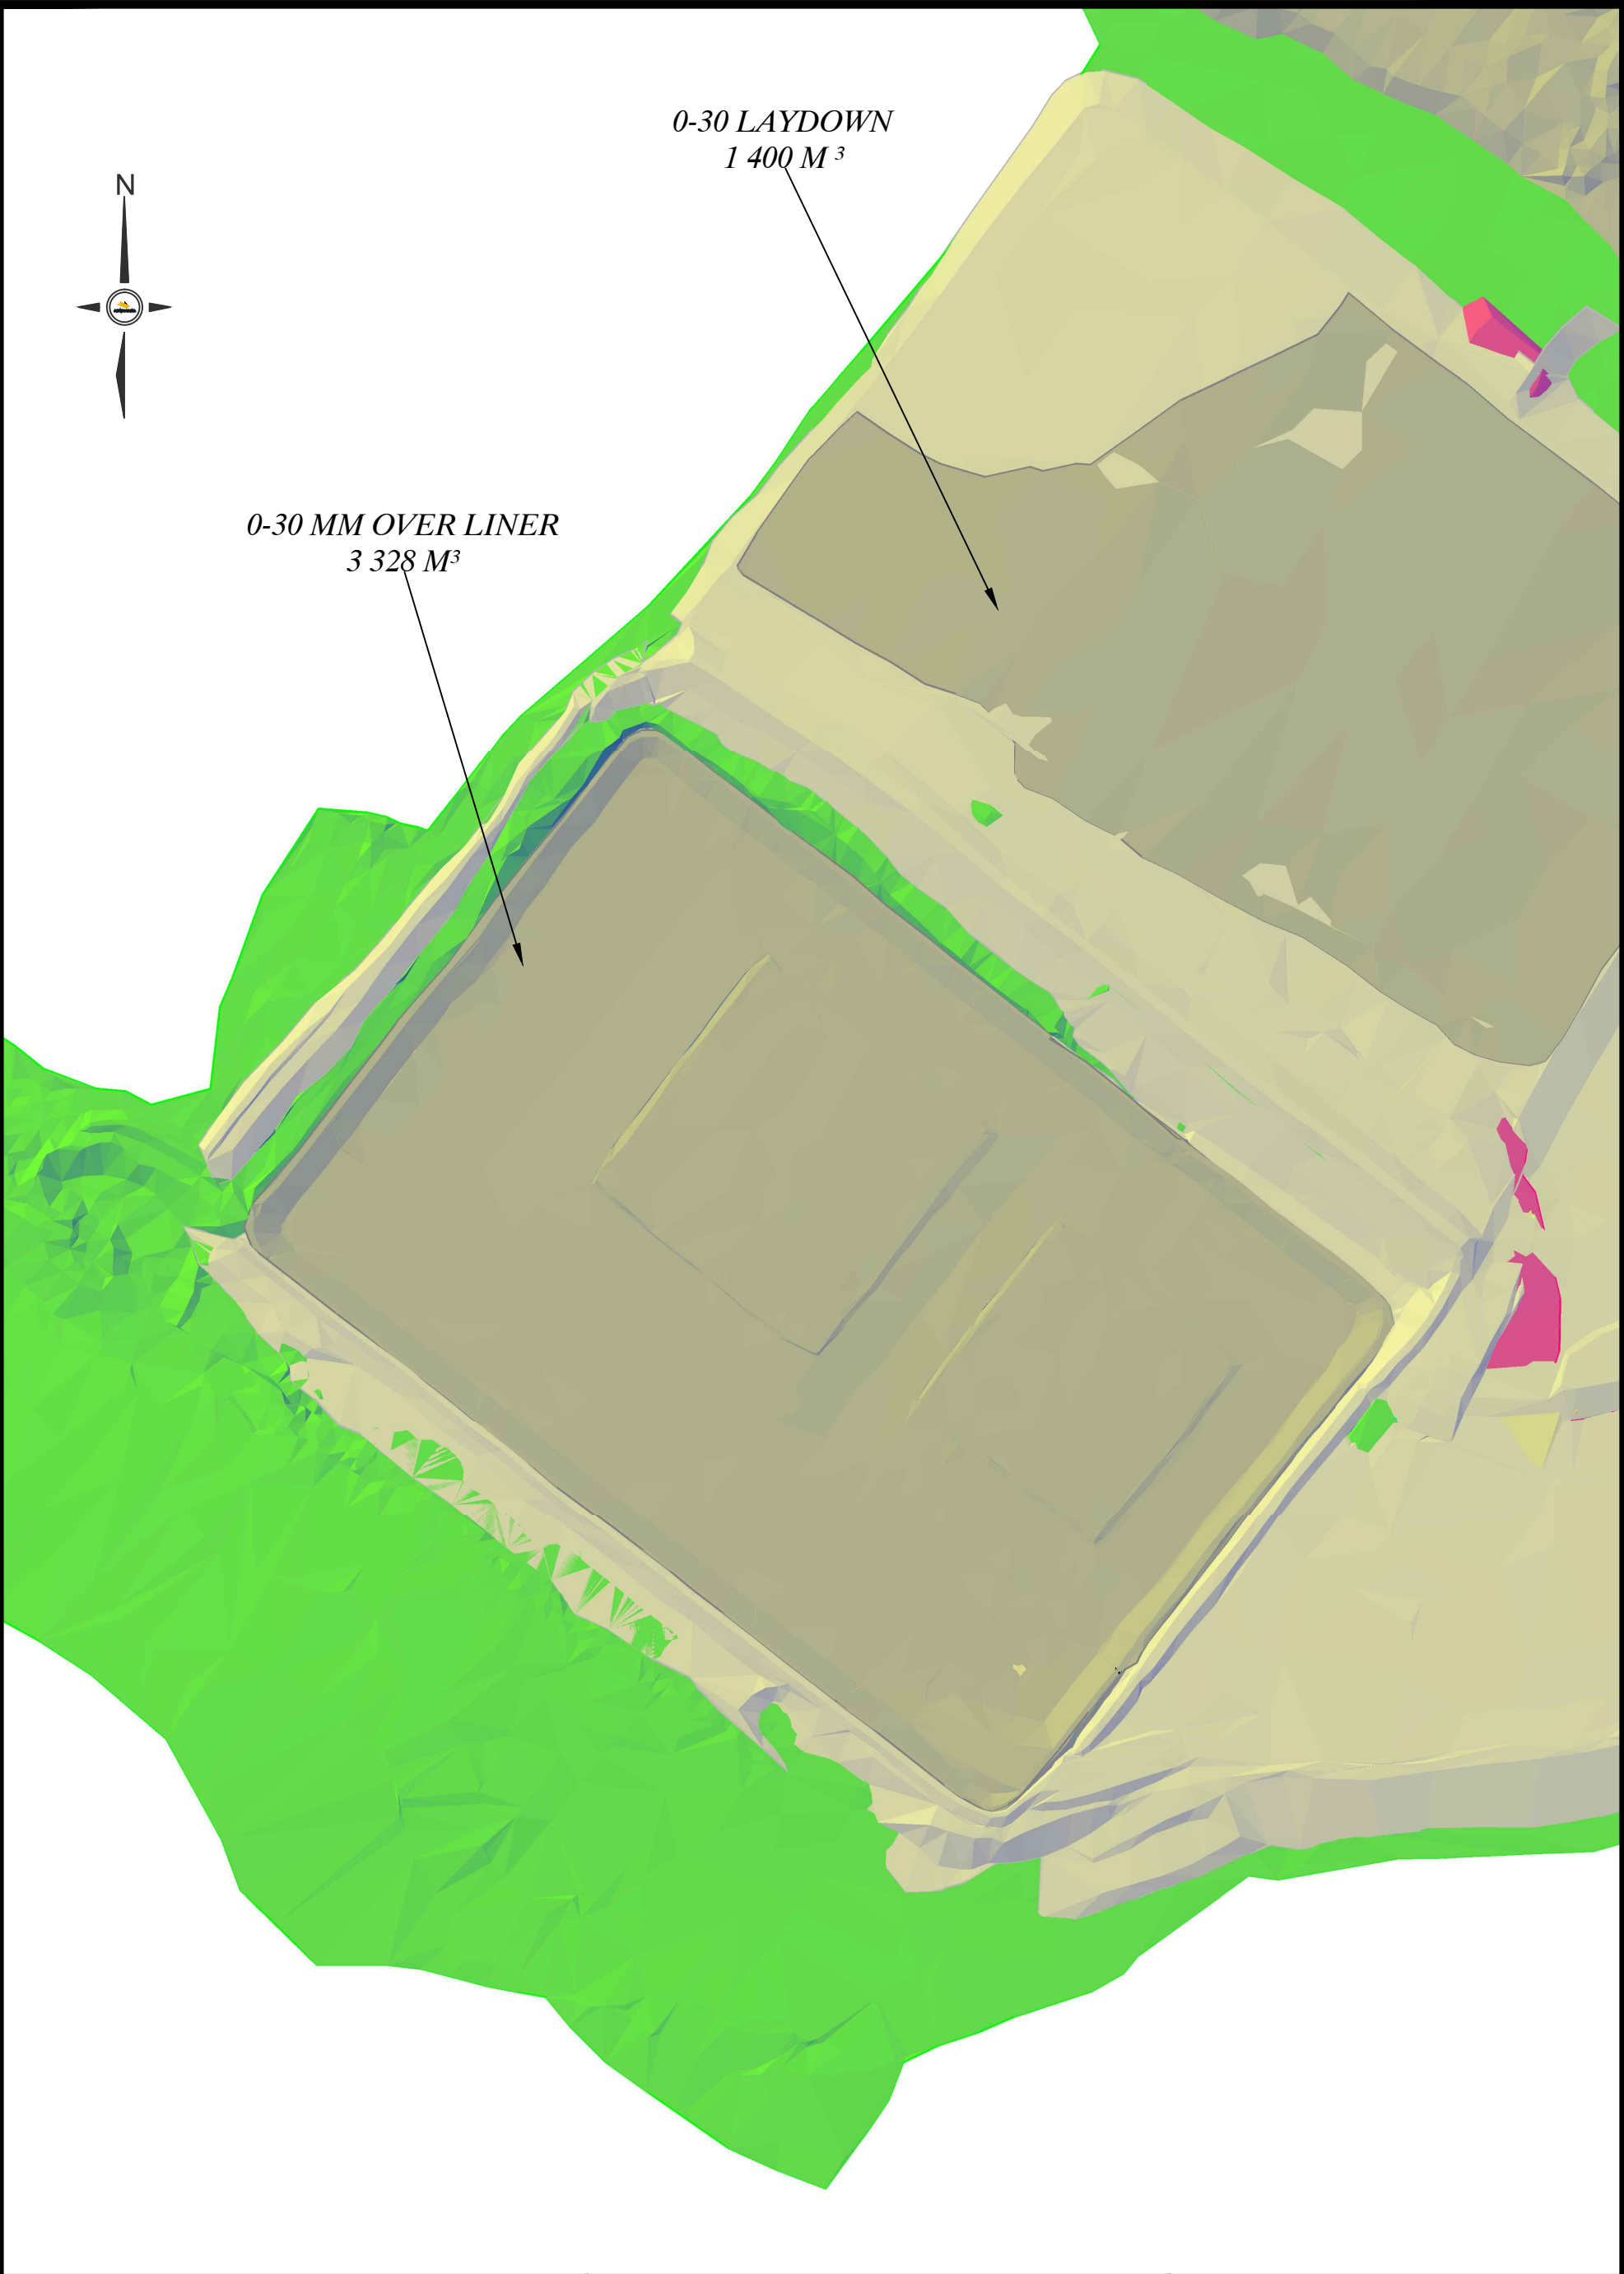

AGNICO EAGLE

COORD. SYSTEME:  
UTM15 NAD83

SCALE:  
1:1000

WORK EXECUTION DATE : 2017-10-13

A-B 0-30 MM OVER LINER  
RANKIN FUEL FARM

PLAN NO.:  
131-RANKIN-FUEL-FARM-QT-171025-11

EMISSION DATE : 2017-10-25

DRAWN BY:  
R.CLOUATRE

APPROVED BY:  
Hamel arpentage





AGNICO EAGLE

COORD. SYSTEME:  
UTM15 NAD83

SCALE:  
1:2000

WORK EXECUTION DATE : 2017-10-13

AS BUILT 0-75 MM  
RANKIN FUEL FARM

PLAN NO.:  
131-RANKIN-FUEL-FARM-QT-171025-12


EMISSION DATE : 2017-10-25

DRAWN BY:  
R.CLOUATRE

APPROVED BY:  
Hamel arpentage

## **APPENDIX C**

### Survey Drawings of Rankin Itivia Culvert

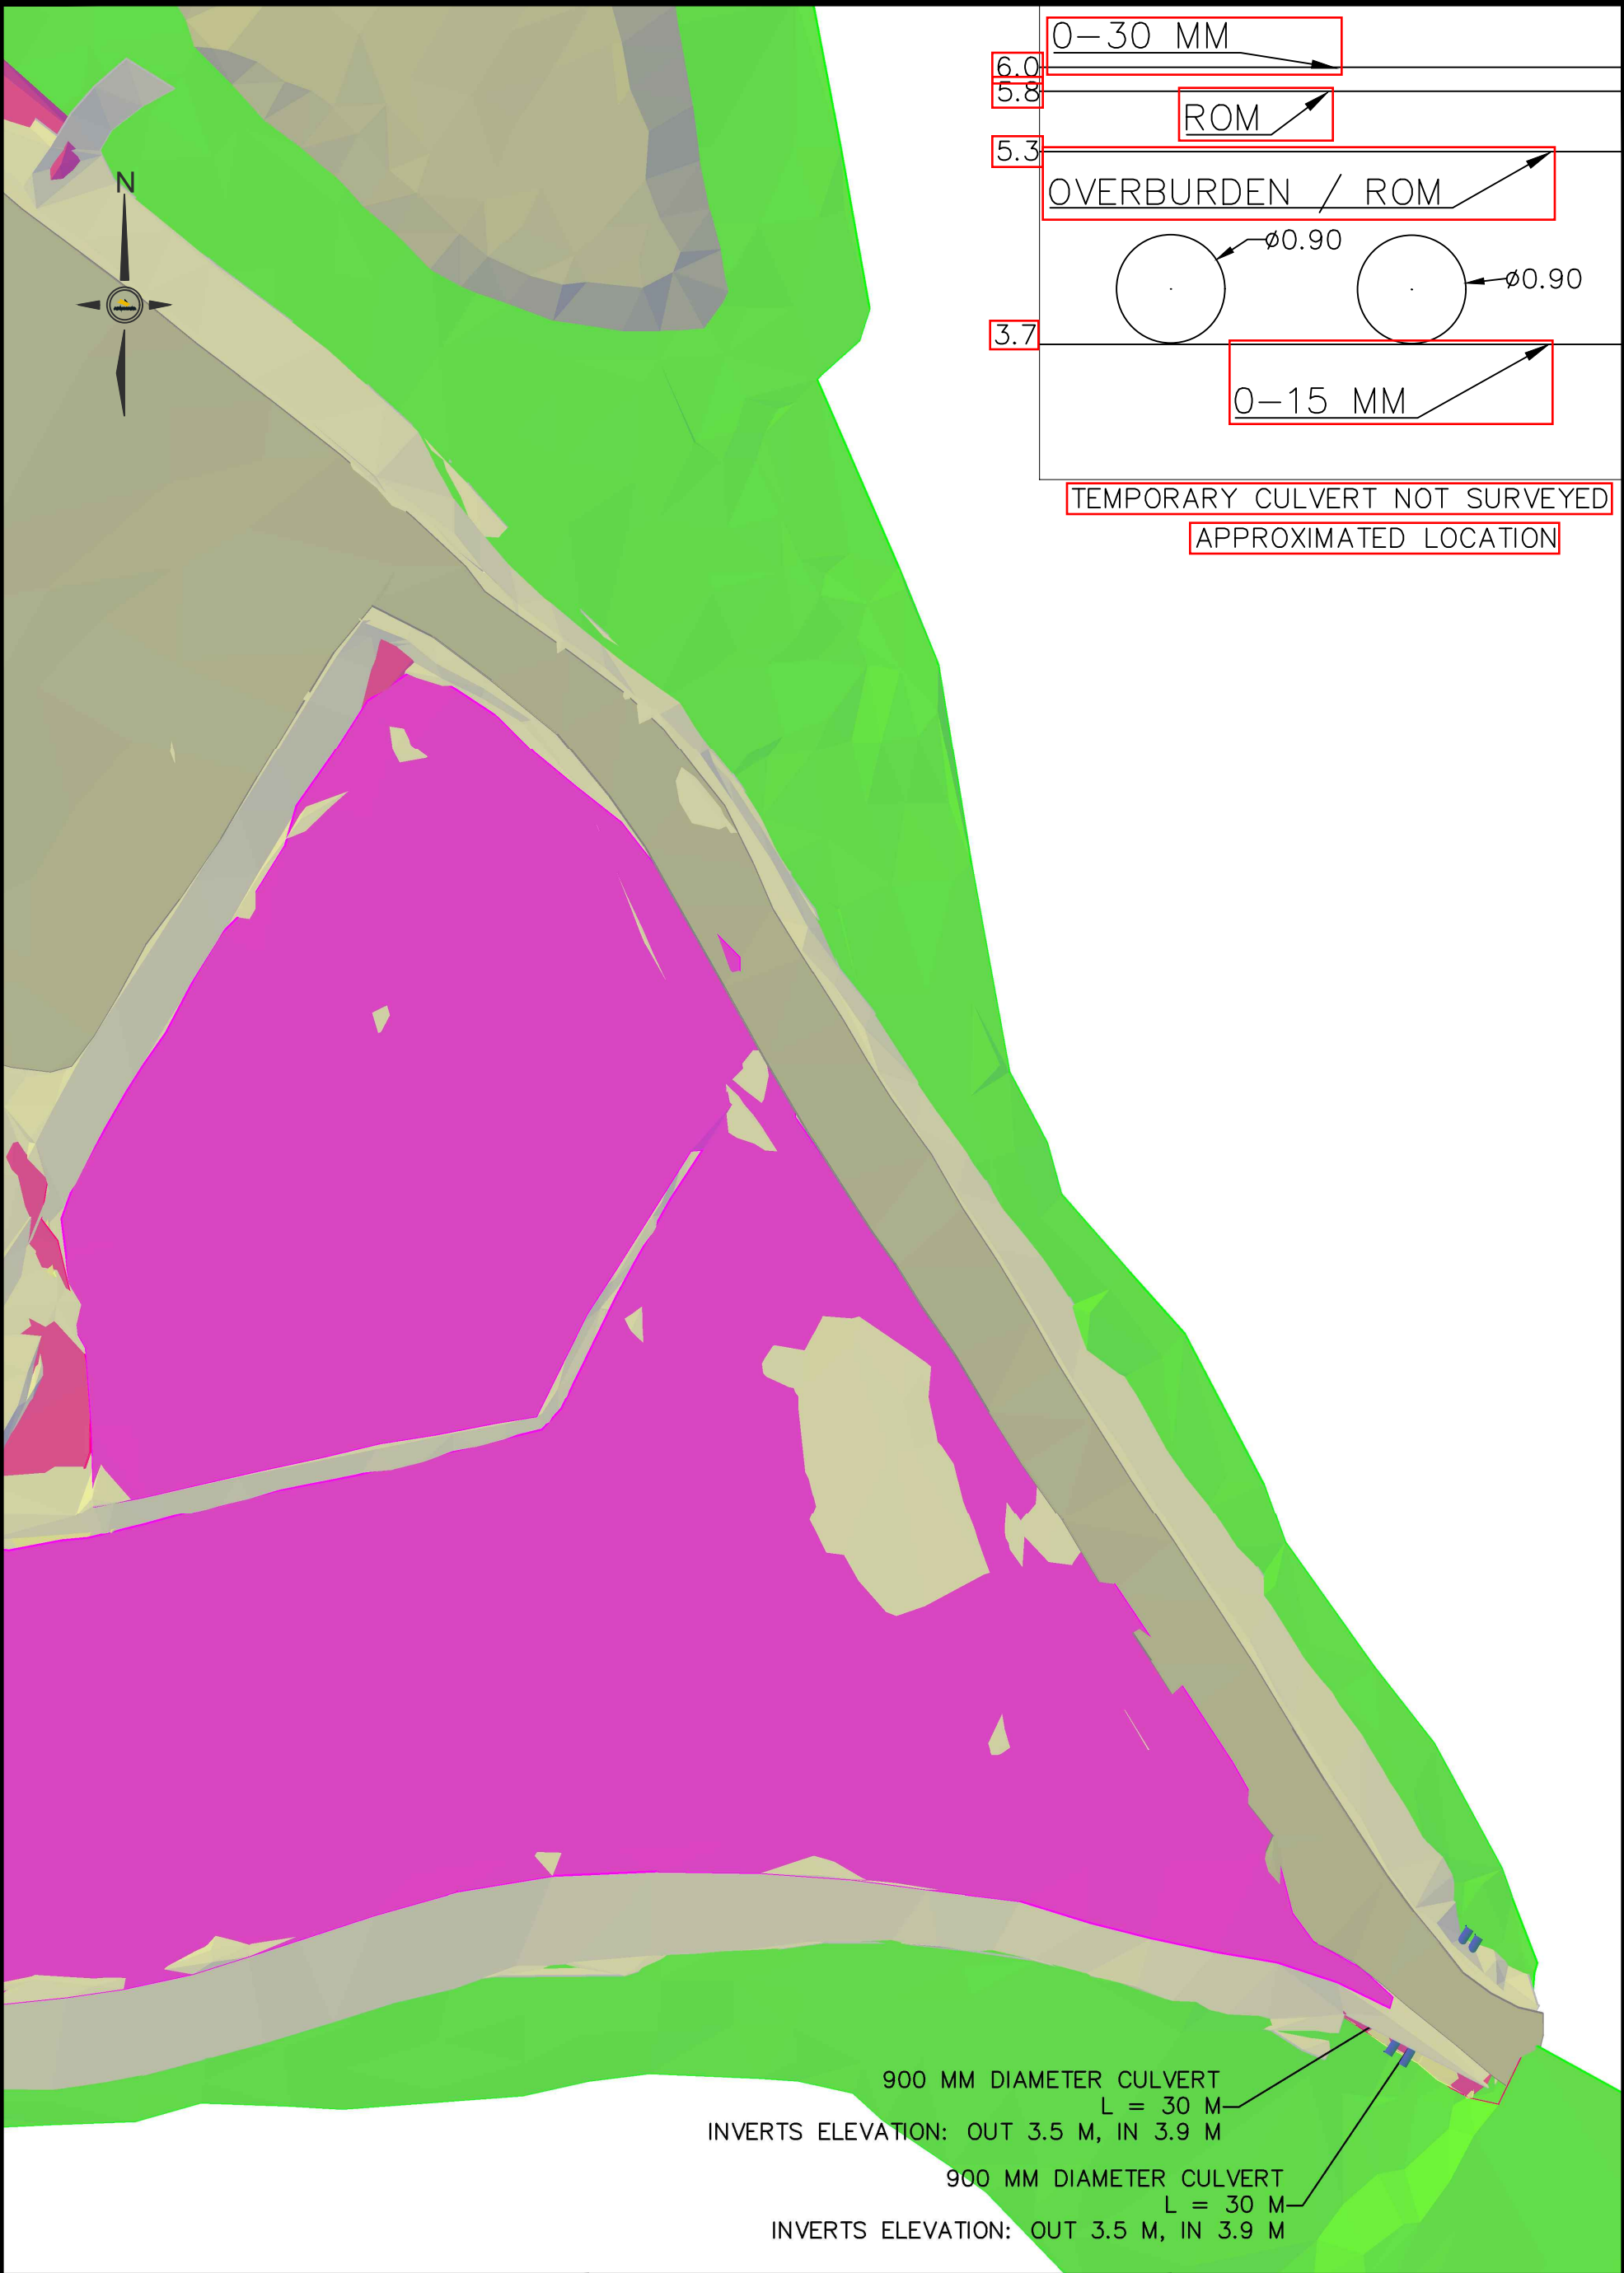

AGNICO EAGLE

WORK EXECUTION DATE 2017-10-13

EMISSION DATE : 2017-12-03

COORD. SYSTEME:

UTM15 NAD83

AS BUILT  
900 MM CULVERTS

DRAWN BY:

R.CLOUATRE

SCALE:

1:750

PLAN NO.:

131-RANKIN-FUEL-FARM-QT-171203-01

APPROVED BY:

Hamel arpentage



## **APPENDIX D**

# Photographs of Rankin Inlet Fuel Storage and Containment Facilities



2017-06-20

Compaction of 200mm MINUS under Tank #2



2017-07-18  
Excavation to rock under Tank #2





2017-07-19  
Tank #2 foundation





2017-08-06  
Tank #2 erection





2017-09-02  
Installation of underground double walled pipe





2017-09-10  
Sand under liner placement





2017-09-12  
Start of liner installation





2017-10-04  
Over liner placement





2017-10-29  
16" vacuum pipe to Tank #2





2017-10-29  
Electrical and pump station containers

## **APPENDIX E**

### Photographs of Rankin Inlet Itivia Culvert





2017-11-18  
Road excavation





2017-11-19  
Culvert Placement





2017-11-19  
Placement of bedding





2017-11-20  
Completed installation

## **APPENDIX F**

### **Construction Summary of Rankin Fuel Tank Farm and Laydown Area Structural**

## **Construction Summary- Rankin Fuel Tank Farm and Laydown Area**

Construction and quality assurance performed by Agnico Eagle Construction

Contractor: Inukshuk Contracting Ltd (ICL)

All survey conducted by ICL

### **Design Variations**

The tank 2 was built as per original design alignment (65-116-260-200-R0, 65-116-260-201-R0, 65-116-260-202-R0)

Tank #1 work was started and stop for the winter period. The work will resume in spring 2018

### **Field modification**

No field modification was done during the construction of tank #2 and no change has been required on tank #1 at this point

### **Site preparations**

Contractor mobilized on site and unloaded plates ready to install outside the tank perimeter and located the tank on the footprint.

### **Tank #1 and #2 erection**

First phase of the construction started with the installation of floor plates and welding. Then proceeded with the second phase, installation of the tank rings and welding until design height obtained. Third phase of the construction consisted of erecting the interior structure columns and installation of all the openings at the base of the tank. The fourth and final phase consisted of placing, all the roof plates, assembling the permanent stairs and closing the opening located at south end of the tank for construction access. The construction of the tank #1 started in conjunction with tank #2 with the same process but was temporary discontinued after the 3<sup>rd</sup> ring

### **Equipment use**

765-E Grove all terrain crane

Welding machine

65 ft JLG

267B skidd steer

45 ft JLG

Automatic welder

### **Remaining work**

The tank #1 is presently completed at 60%. The work stopped mid September 2017 for the winter and will resume spring 2018. Completion of the tank #1 will occur prior to sea lift season.

### **Non-Conformances**

During first fill of Tank No 2, two (2) minor fuel leaks were observed. The first leak occurred on October 17<sup>th</sup> with fuel seeping out from the pressure test port on the fueling nozzle neck reinforcement plate. The second leak was observed on October 18<sup>th</sup> as minor weeping between the manhole welding joint



and the tank reinforcement plate. Both leaks were promptly reported to the installation contractor who arrested the leakage with temporary welding repairs from the exterior of the tank.

Regular visual inspections were made thereafter to ensure no further leakage occurred.

Two (2) NCR's were then raised to cover these defects. The NCR's are presented in Appendix L of this report. At the time of writing this interim report the permanent corrective measures had not yet been finalized by the contractor. The permanent repairs will however take place in the Spring of 2018 at which time Tank No 2 will have to be emptied such that repairs can take place from within the interior of the tank.

## **APPENDIX G**

# Construction Summary of Rankin Inlet Itivia Site Mechanical and Electrical Equipment