

CHARPY V-NOTCH IMPACT TEST RESULTS

For Procedure Qualification Report # SAS-1



Client:	Sub Arc Systems	Job Number:	636-01001
Address:	4605-47 Steet Vermillion, AB	Date:	January 4, 2002
Materials:	SA-516 Grade 60 to 70		
Size:	1.750" wt plate	Condition:	As Welded
Specimen Type:	10.0 mm Charpy V Notch impact specimens		
Specification:	ASTM A-370, ASME Section VIII UG-84		
Qualification Temp.:	-46°C (-50°F)		

Sample Set	Sample Number	Impact Ft-lb	Energy (Joule)	Converted Full Size Impact Energy (J)	% Shear
Weld Zone – Root	1	14	19	24	20
Includes Both	2	48	65	81	20
SMAW Processes	3	38	51	64	20
	Average:	33	45	57	20
Weld Zone – Fill	1	58	79	79	10
	2	45	61	61	20
	3	88	119	119	40
	Average:	64	86	86	23
Heat Affected Zone	1	18	24	24	20
SA-516 Gr. 70	2	122	165	165	60
	3	101	137	137	70
	Average:	80	109	109	50
Heat Affected Zone	1	98	133	133	40
SA-516 Gr. 70	2	132	179	179	100
	3	86	117	117	40
	Average:	105	143	143	60

Remarks: These Charpy v-notch impact test results exceed the minimum requirements of ASME Section VIII and B31.3 Codes for -46°C; or CSA Z662-99 Codes for -46°C.

We certify that the statements in this record are acceptable, in accordance with the requirements of ASME Section IX.



Test Results Certified By:

QUALIMET INC.

PROCEDURE QUALIFICATION RECORD (PQR) QW-483
(Section IX, ASME Boiler and Pressure Vessel Code)

Company Name:	Sub Arc Systems	
PQR No:	SAS-1-2	Date: January 4, 2002
Revision No.:	-----	Revision Date: -----
WPS No:	SAS-1	
Welding Process(es):	SMAW/ SMAW/ SAW	
Types:	Manual/ Manual/ Machine	

JOINTS QW-402

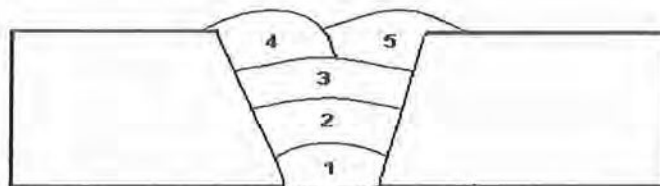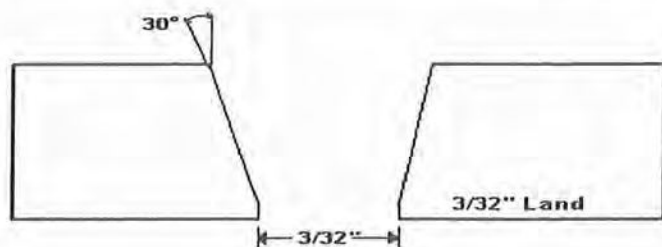

BASE METALS QW-403		POSTWELD HEAT TREATMENT QW-407	
Material Spec.:	SA-516	Temperature:	
Type or Grade:	Grade 60	Time:	
P-No.:	P-1 Group 1	Other:	Not Applicable
Thickness of Test Coupon:	0.375" wt.		
Diameter of Test Coupon:	Plate		
Other:	Carbon Equivalent (C.E) : 0.38		
PREHEAT QW-406		SHIELDING GAS QW-408	
Preheat & Interpass Min.:	50 °F	Shielding Gas:	N/A
Interpass Max.:	600°F	Composition:	N/A
	Temperature monitored using Tempilstick	Flow Rate:	N/A
FILLER METALS QW-404			
Process	SMAW	SMAW	SAW
SFA Spec No:	5.1	5.1	5.17
AWS Class. No:	E6010	E7018-1	EM12K
F-No:	F-3	F-4	F-6
A-No:	A-1	A-1	A-1
Size of Filler Metal:	1/8"	3/32"	3/32"
Deposited Metal:	0.100"	0.125"	0.150"
Flux Class:	N/A	N/A	F7A6 (Neutral)
Other:	Covered Electrode	Covered Electrode	Coiled Solid Wire (Lincoln L61/882)
ELECTRICAL CHARACTERISTICS QW-409			
Process:	SMAW	SMAW	SAW
Current:	Direct (DC)	Direct (DC)	Direct (DC)
Polarity:	Reverse (EP)	Reverse (EP)	Reverse (EP)
Volts:	21	21	30
Amps:	110	110	425
Heat Input (J/in):	39 610	55 428	36 428
TECHNIQUE QW-410			
Process:	SMAW	SMAW	SAW
Position:	3G	3G	2G
Progression:	Vertical Up	Vertical Up	Horizontal
Travel Speed (ipm):	3.5	2.5	21
String or Weave:	String	String and Weave	String
Oscillation:	N/A	N/A	N/A
Single / Multi Pass:	Multiple	Multiple	Multiple
Single / Multi Electrodes:	Single	Single	Single
Wire Feed Rate:	N/A	N/A	83 ipm

PROCEDURE QUALIFICATION RECORD (PQR) QW-483
(Section IX, ASME Boiler and Pressure Vessel Code)

PQR # _____ SAS-1-2

Tensile Test
QW-462

Specimen No.	Width In	Thickness In	Area In ²	Ultimate Total Load Lb	Ultimate Unit Stress psi	Type of Failure & Location
		See Attached Report				

Guided Bend Tests
QW-462

Type and Figure No.	Result
See Attached Report	

Toughness Tests
QW-170

Specimen No.	Notch Location	Notch Type	Test Temp	Impact Values	Lateral Exp % Shear	Mils	Drop Weight Break	No Brk
		See Attached Report						

Fillet-Weld Tests
Not Applicable

Result-Satisfactory:	Yes	_____	No	_____	Pen. Into Parent Material:	Yes	_____	No	_____
Macro-Results:									


Other Tests

Type of Test:	Vickers Hardness Test to NACE MR01
Deposit Analysis:	N/A

Welder's Name: Gary Kolman Clock No.: W-2368 Stamp ID: CD
Tests Conducted By: Qualimet Inc. Lab. Test No.: 636 - 01001

We certify that the statements in this record are correct and that the test welds were prepared, welded, and tested in accordance with the requirements of Section IX of the ASME Code.

Manufacturer: Sub Arc Systems

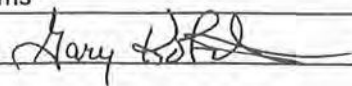Date: January 4, 2002 By: Gary Kolman 

MECHANICAL TEST REPORT for Procedure Qualification Record # SAS-1-2



Client:	Sub Arc Systems	Job Number:	636-01001
Address:	4605-47 Steet Vermillion, AB	Date:	January 4, 2002
Materials:	SA-516 Grade 60 to 70		
Size:	0.375" wt plate	Condition:	As Welded
Test Specification:	ASME Section IX		

Tensile Tests QW - 462.1(a)

Sample Identification:	CDT1	CDT2
Sample Size - inch:(W x T)	0.7300 x 0.3600	0.7200 x 0.380
Least X-Sect. Area - in ² :	0.263	0.360
Ultimate Load - lbs:	22 340	22 408
Ult. Ten. Strength - ksi:	85.0	86.4
Character of Failure:	Ductile	Ductile
Location of Failure:	Base Metal SA-516 Gr.60 Side	Base Metal SA-516 Gr.60 Side
Req'd Tensile Strength - ksi:	60.0	60.0
Pass or Fail:	Passed	Passed
Remarks:		

* Bend Test QW - 462.2

Sample Identification:	CDB1	CDB2	CDB3	CDB4
Type of Bend Test:	TSB	TSB	TSB	TSB
Pass or Fail:	Pass	Pass	Pass	Pass
Remarks:				

* Types of Bend Tests

TSB, TFB, TRB = transverse side, face or root bend

LSB, LFB, LRB = longitudinal side, face or root bend

We certify that the statements in this record are acceptable, in accordance with the requirements of ASME Section IX.


TEST RESULTS CERTIFIED BY:

QUALIMET INC.

HARDNESS TEST REPORT

for Procedure Qualification Record # SAS-1-2

Client:	Sub Arc Systems	Job Number:	636-01001
Address:	4605-47 Steel Vermillion, AB	Date:	January 4, 2002
Materials:	SA-516 Grade 60 to 70		
Size:	0.375" wt plate	Condition:	As Welded
Test Method:	Hardness testing performed in accordance with ASTM E-92 using a Vickers Hardness Tester with a 10 kg load. (HV10)		
Equipment:	Matsuzawa Seiki Co. Ltd. Vickers Hardness Tester S/N: 7193M		
Calibration:	Test Block : 197 ± 6 DPH	Act. Reading:	197 DPH

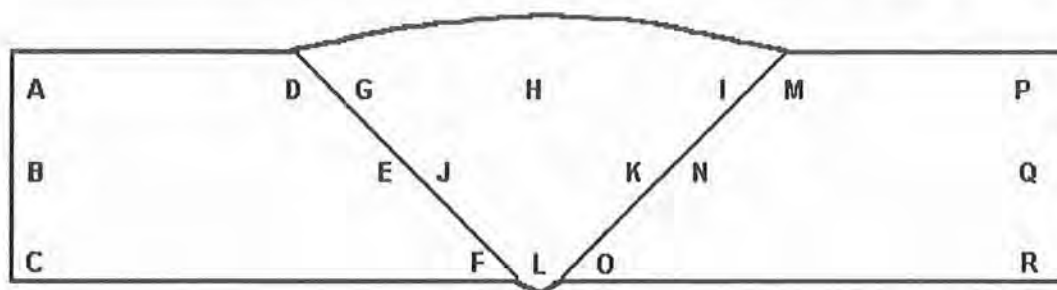

Hardness Values

A	198	D	208	G	215	J	212	M	204	P	193
B	195	E	203	H	211	K	215	N	202	Q	189
C	196	F	206	I	210	L	209	O	207	R	195

These hardness values do not exceed 248 HV10 (22 HRC).

We certify that the statements in this record are acceptable, in accordance with the requirements of ASME Section IX and NACE MR01

Test Results Certified by:

QUALIMET INC.

CHARPY V-NOTCH IMPACT TEST RESULTS

For Procedure Qualification Report # SAS-1-2



Client:	Sub Arc Systems	Job Number:	636-01001
Address:	4605-47 Steel Vermillion, AB	Date:	January 4, 2002
Materials:	SA-516 Grade 60 to 70		
Size:	0.375" wt plate	Condition:	As Welded
Specimen Type:	8.5 mm Charpy V Notch impact specimens		
Specification:	ASTM A-370, ASME Section VIII UG-84		
Qualification Temp.:	-46°C (-50°F)		

Sample Set	Sample Number	Impact Ft-lb	Energy (Joule)	Converted Full Size Impact Energy (J)	% Shear
Weld	1	10	14	16	20
	2	12	16	19	20
	3	24	33	38	20
	Average:	15	21	24	20
Heat Affected Zone SA516 Gr. 60	1	82	111	131	70
	2	106	144	169	80
	3	146	198	233	100
	Average:	111	151	178	83
Heat Affected Zone SA516 Gr. 70	1	98	133	166	40
	2	132	179	224	100
	3	86	117	146	40
	Average:	105	143	179	60

Remarks: These Charpy v-notch impact test results exceed the minimum requirements of ASME Section VIII and B31.3 Codes for -46°C; or CSA Z662-99 Codes for -46°C.

We certify that the statements in this record are acceptable, in accordance with the requirements of ASME Section IX.


Test Results Certified By:

QUALIMET INC.

PROCEDURE QUALIFICATION RECORD (PQR) QW-483
(Section IX, ASME Boiler and Pressure Vessel Code)

Company Name:	Sub Arc Systems	By:	Gary Kohlman
PQR No.:	SAS-1-3	Date:	January 4, 2002
Revision No.:	1 ¹	Revision Date:	July 15, 2014
Welding Process(es):	SMAW / SMAW / SAW	Types:	Manual / Manual / Machine

JOINTS QW-402

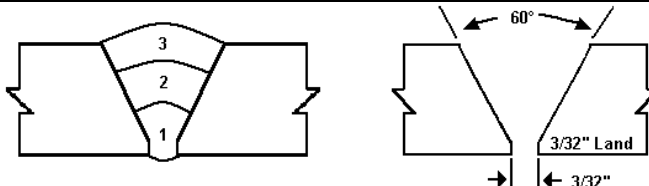

BASE METALS QW-403		POSTWELD HEAT TREATMENT QW-407		
Material Spec.:	SA-516	SA-516	Temperature:	
Grade/Type/Class:	Gr. 60	Gr. 70	Time:	
P-No. Group No.:	P-1 Group 1	to P-1 Group 2	Heating:	
Heat No.:	Not Recorded	Not Recorded	Cooling:	(Not Applicable)
ASME C.E.:	Not Recorded	Not Recorded	Other:	
CSA C.E.:	Not Recorded	Not Recorded		
Thickness & Diameter:	0.249" thick plate (machined)			
Max Weld Deposit:	<0.500" per pass			
PREHEAT QW-406		POSITIONS QW-405		
Preheat Temp. Min.:	50°F	Process:	F-3 SMAW	F-4 SMAW
Interpass Temp. Max.:	600°F	Position:	3-G	3-G
Interpass Temp. Min.:	50°F	Progression:	Vertical Up	Vertical Up
Other:	Temperature monitored by tempilstiks	Other:	Not Applicable	Not Applicable
			Not Applicable	Not Applicable
FILLER METALS QW-404				
Process:	SMAW	SMAW	SAW	
SFA Specification No.:	5.1	5.1	5.17	
AWS Classification No.:	E6010	E7018-1	EM12K	
F-No.:	F-3	F-4	F-6	
A-No.:	A-1	A-1	A-1	
Size of Filler Metal:	1/8"	3/32"	3/32"	
Deposited Weld Metal:	0.050"	0.075"	0.125"	
Electrode-Flux (Class):	Not Applicable	Not Applicable	F7A6	
Flux Trade Name:	Not Applicable	Not Applicable	Lincolnweld 882	
Alloy Element/Flux:	Not Applicable	Not Applicable	None	
Manufacturer:	Not Recorded	Not Recorded	Lincoln Electric	
Trade Name:	Not Recorded	Not Recorded	L-61	
Heat Number:	Not Recorded	Not Recorded	Not Recorded	
Product Form:	Covered Electrode	Covered Electrode	Coiled Metal Cored Wire	
SHIELDING GAS QW-408				
Shielding Gas:				
Composition:				
Flow Rate:	(Not Applicable)	(Not Applicable)	(Not Applicable)	
Trailing / Backing Gas:				
Flow Rate:				
ELECTRICAL CHARACTERISTICS QW-409				
Current:	Direct (DC)	Direct (DC)	Direct (DC)	
Polarity:	Reverse (EP)	Reverse (EP)	Reverse (EP)	
Volts:	21	20	30	
Amps:	110	105	425	
Travel Speed (ipm):	5.5	4.3	24	
Maximum Heat Input (J/in):	25 200	29 640	36 428	
Wire Feed Speed (ipm):	Not Applicable	Not Applicable	82	
Mode of Metal Transfer:	Not Applicable	Not Applicable	Not Applicable	
TECHNIQUE QW-410				
String or Weave:	String	String & Weave	String	
Oscillation:	Not Applicable	Not Applicable	Not Applicable	
Single / Multi Pass:	Single Pass from one side	Single Pass from one side	Single Pass from one side	
Single / Multi Electrodes:	Single	Single	Single	
Thermal Processes	Not Applicable	Not Applicable	Not Applicable	
Wire Stick Out:	Not Applicable	Not Applicable	Not Recorded	
Nozzle / Cup Size:	Not Applicable	Not Applicable	Not Applicable	

¹ Revision 1: Revision to correct editorial error.

PROCEDURE QUALIFICATION RECORD (PQR) QW-483
(Section IX, ASME Boiler and Pressure Vessel Code)

PQR # SAS-1-3 Revision 1

Tensile Test
QW-462

Specimen No.	Width in	Thickness in	Area in ²	Ultimate Total Load Lb	Ultimate Unit Stress ksi	Type of Failure & Location
		(Not Applicable)				

Guided Bend Tests
QW-462

Specimen No.	Type	Figure	Result
	(Not Applicable)		

Toughness Tests
QW-170

Specimen No.	Notch Location	Notch Type	Test Temp	Full Size Values (ft-lbs)	% Shear	Lateral Exp Inches	Drop Weight Break	No Brk
CE-1	Weld	V-Notch	-50°F	76	80	Not Recorded	N/A	N/A
CE-2	Weld	V-Notch	-50°F	92	80	Not Recorded	N/A	N/A
CE-3	Weld	V-Notch	-50°F	100	100	Not Recorded	N/A	N/A
CE-4	HAZ (Grade 60)	V-Notch	-50°F	56	40	Not Recorded	N/A	N/A
CE-5	HAZ (Grade 60)	V-Notch	-50°F	72	40	Not Recorded	N/A	N/A
CE-6	HAZ (Grade 60)	V-Notch	-50°F	52	30	Not Recorded	N/A	N/A
CE-7	HAZ (Grade 70)	V-Notch	-50°F	82	40	Not Recorded	N/A	N/A
CE-8	HAZ (Grade 70)	V-Notch	-50°F	74	40	Not Recorded	N/A	N/A
CE-9	HAZ (Grade 70)	V-Notch	-50°F	72	40	Not Recorded	N/A	N/A

Fillet-Weld Tests
Not Applicable

Result-Satisfactory: <u>Yes</u> <u>No</u>	Pen. into Parent Material: <u>Yes</u> <u>No</u>
Macro-Results:	

Other Tests
Not Applicable

Type of Test: _____
Other: _____

Welder's Name: Gary Kohlman Reg. No.: W-2368 Stamp ID: CE
 Tests Conducted By: Qualimet Lab. Test No.: 100-14010
 Revisions By: Qualimet

We hereby recertify that the statements in this record have been revised in accordance with paragraph QW-200.2 are correct and that the test welds were prepared, welded, and tested in accordance with the requirements of Section IX of the ASME Code.

Manufacturer: Sub Arc Systems
 Original Cert. Date: January 4, 2002 Certified By: Gary Kohlman

Recertification Date: July 16, 14 Certified By: 

**REVISED CHARPY IMPACT TEST REPORT****

for Procedure Qualification Record # SAS-1-3

Client:	Sub-Arc Systems Inc.	Job Number:	636-01001
Address:	4605-47 Street, Vermillion AB, T9X 1L6	Date:	January 4, 2002
Materials:	SA-516 Grade 60/70 to SA-516 Grade 60/70	Revision Date:	July 15, 2014
Size:	0.249" w.t. Plate (machined)	Condition:	As Welded
Test Specification:	ASME Section VIII UG-84, ASTM A-370		
Test Equipment:	Satec Model S1-10, S/N: 1164		

Specimen Type:	Charpy V-Notch		
Qualification Temperature:	-50.0°F	Test Temperature:	-50.0°F

Specimen Size (mm): 5

Sample Set	Sample Number	Actual Impact Energy (ft-lb)	Full Size (ft-lb)	Shear (%)	Lat. Exp. (in.)
Weld (Includes all processes)	1	38	76	80	Not Recorded
	2	46	92	80	Not Recorded
	3	50	100	100	Not Recorded
	Average:	45	89	87	Not Recorded

We certify that the statements in this record are acceptable and that the specimen(s) were prepared and tested in accordance with the requirements of the current edition of ASTM A370, ASTM E23 and their latest editions.

**Revision of test report to correct editorial error.

TEST RESULTS CERTIFIED BY:

Qualimet

Hanibal Ghile, E.I.T.



REVISED CHARPY IMPACT TEST REPORT**

for Procedure Qualification Record # SAS-1-3

Client:	Sub-Arc Systems Inc.	Job Number:	636-01001
Address:	4605-47 Street, Vermillion AB, T9X 1L6	Date:	January 4, 2002
Materials:	SA-516 Grade 60/70 to SA-516 Grade 60/70	Revision Date:	July 15, 2014
Size:	0.249" w.t. Plate (machined)	Condition:	As Welded
Test Specification:	ASME Section VIII UG-84, ASTM A-370		
Test Equipment:	Satec Model S1-10, S/N: 1164		

Specimen Type:	Charpy V-Notch		
Qualification Temperature:	-50.0°F	Test Temperature:	-50.0°F

Sample Set	Sample Number	Actual Impact Energy (ft-lb)	Full Size (ft-lb)	Shear (%)	Lat. Exp. (in.)
HAZ (Grade 60)	1	28	56	40	Not Recorded
	2	36	72	40	Not Recorded
	3	26	52	30	Not Recorded
	Average:	30	60	37	Not Recorded

We certify that the statements in this record are acceptable and that the specimen(s) were prepared and tested in accordance with the requirements of the current edition of ASTM A370, ASTM E23 and their latest editions.

**Revision of test report to correct editorial error.

TEST RESULTS CERTIFIED BY:

Qualimet

Hanibal Ghile, E.I.T.



REVISED CHARPY IMPACT TEST REPORT**

for Procedure Qualification Record # SAS-1-3

Client:	Sub-Arc Systems Inc.	Job Number:	636-01001
Address:	4605-47 Street, Vermillion AB, T9X 1L6	Date:	January 4, 2002
Materials:	SA-516 Grade 60/70 to SA-516 Grade 60/70	Revision Date:	July 15, 2014
Size:	0.249" w.t. Plate (machined)	Condition:	As Welded
Test Specification:	ASME Section VIII UG-84, ASTM A-370		
Test Equipment:	Satec Model S1-10, S/N: 1164		

Specimen Type:	Charpy V-Notch		
Qualification Temperature:	-50.0°F	Test Temperature:	-50.0°F

Specimen Size (mm): 5

Sample Set	Sample Number	Actual Impact Energy (ft-lb)	Full Size (ft-lb)	Shear (%)	Lat. Exp. (in.)
HAZ (Grade 70)	1	41	82	40	Not Recorded
	2	37	74	40	Not Recorded
	3	36	72	40	Not Recorded
	Average:	38	76	40	Not Recorded

We certify that the statements in this record are acceptable and that the specimen(s) were prepared and tested in accordance with the requirements of the current edition of ASTM A370, ASTM E23 and their latest editions.

**Revision of test report to correct editorial error.

TEST RESULTS CERTIFIED BY:

Qualimet


Hanibal Ghile, E.I.T.

PROCEDURE QUALIFICATION RECORD (PQR) QW-483
(Section IX, ASME Boiler and Pressure Vessel Code)

Company Name: Sub-Arc Systems Inc.
PQR No.: SAS-1-4
Revision No.: 0
Welding Process(es): SMAW / SMAW / SAW

By: Gary Kohlman
Date: July 15, 2014
Revision Date: -----
Type(s): Manual / Manual / Machine

JOINTS QW-402

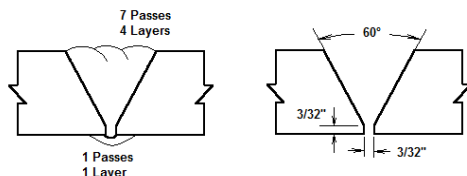

BASE METALS QW-403		POSTWELD HEAT TREATMENT QW-407	
Material Spec.:	SA-516	SA-516	Temperature:
Grade/Type/Class:	Grade 60/70	Grade 60/70	Time:
P-No. Group No.:	P-1 Group 1/2	P-1 Group 1/2	Heating: (None - As Welded)
Heat No.:	E3D260	E3D260	Cooling:
Carbon Equivalent (ASME):	0.42	0.42	Other:
Carbon Equivalent (CSA):	0.42	0.42	
Thickness & Diameter:	0.500" w.t. Plate		
Max Weld Deposit:	<0.500" per pass		
PREHEAT QW-406		POSITIONS QW-405	
Preheat Temp. Min.:	50°F	Process:	F-3 SMAW F-4 SMAW SAW
Interpass Temp. Max.:	600°F	Position:	3-G 3-G 2-G
Interpass Temp. Min.:	50°F	Progression:	Vertical Up Vertical Up Horizontal
Other:	Temperature monitored using tempilstiks	Other:	N/A N/A N/A
FILLER METALS QW-404			
Process:	SMAW	SMAW	SAW
SFA Specification No.:	5.1	5.1	5.17
AWS Classification No.:	E6010	E7018-1	EM12K-H8
F-No.:	F-3	F-4	F-6
A-No.:	A-1	A-1	A-1
Size of Filler Metal:	1/8"	3/32"	3/32"
Deposited Weld Metal:	0.125"	0.125"	0.250"
Manufacturer:	Lincoln Electric	ESAB	Lincoln Electric
Trade Name:	Fleetweld 5P+	OK55	LA-61
Heat / Lot Number:	ED511111	SB248224	500344
Electrode-Flux (Class):	Not Applicable	Not Applicable	F7A6-EM12K-H8
Flux Tradename:	Not Applicable	Not Applicable	Lincolnweld 882 Flux
Flux Heat / Lot Number.:	Not Applicable	Not Applicable	12R13
Product Form:	Covered Electrode	Covered Electrode	Coiled Solid Wire
SHIELDING GAS QW-408			
Shielding Gas:			
Composition:	(Not Applicable)	(Not Applicable)	(Not Applicable)
Flow Rate:			
Backing Gas:			
ELECTRICAL CHARACTERISTICS QW-409			
Current:	Direct (DC)	Direct (DC)	Direct (DC)
Polarity:	Reverse (EP)	Reverse (EP)	Reverse (EP)
Volts:	22	22	30
Amps:	80	80 - 90	420
Travel Speed (ipm):	5.9	4.9 - 5.7	21.8
Maximum Heat Input (J/in):	18 040	23 704	34 650
Tungsten Electrode:	Not Applicable	Not Applicable	Not Applicable
STT Program Settings:	Not Applicable	Not Applicable	Not Applicable
TECHNIQUE QW-410			
String or Weave:	String	String	String
Oscillation:	Not Applicable	Not Applicable	Not Applicable
Single / Multi Pass:	Single Pass from one side	Multiple Passes from one side	Multiple Passes from one side
Single / Multi Electrodes:	Single	Single	Single
Wire Stick Out:	Not Applicable	Not Applicable	1/4" to 1 1/4"
Nozzle / Cup Size:	Not Applicable	Not Applicable	Not Applicable

PROCEDURE QUALIFICATION RECORD (PQR) QW-483
(Section IX, ASME Boiler and Pressure Vessel Code)

PQR # SAS-1-4 Rev.0

Tensile Test
QW-462

Specimen No.	Width (in)	Thickness (in)	Area (in ²)	Ultimate Total Load (lbs)	Ultimate Unit Stress (ksi)	Type of Failure & Location
			(Not Applicable)			

Guided Bend Tests
QW-462

Specimen No.	Type	Figure	Result
		(Not Applicable)	

Toughness Tests
QW-170

Specimen No.	Notch Location	Notch Type	Qual. Temp	Full Size Values (ft-lbs)	% Shear	Lateral Exp Inches	Drop Weight Break	No Brk
DG-1	Weld	V-Notch	-50°F	56	30	0.040	----	----
DG-2	Weld	V-Notch	-50°F	58	40	0.041	----	----
DG-3	Weld	V-Notch	-50°F	66	40	0.044	----	----
DG-4	HAZ	V-Notch	-50°F	56	----	----	----	----
DG-5	HAZ	V-Notch	-50°F	28	30	0.019	----	----
DG-6	HAZ	V-Notch	-50°F	89	----	----	----	----

**Shear and Lateral Expansion not recorded – specimen did not break

Fillet-Weld Tests
Not Applicable

Result-Satisfactory: <u>Yes</u> <u>No</u>	Pen. into Parent Material: <u>Yes</u> <u>No</u>
Macro-Results:	

Other Tests

Type of Test: <u>Not Applicable</u>
Other: <u>Not Applicable</u>

Welder's Name: Keith Breedon Reg. No.: W-11618 Stamp ID: DG
Tests Conducted By: Qualimet Lab. Test No.: 100-14010

We certify that the statements in this record are correct and that the test welds were prepared, welded, and tested in accordance with the requirements of Section IX of the ASME code.

Manufacturer: Sub-Arc Systems Inc.
Date: July 15, 2014 Certified By: Gary Kohlman 

**CHARPY IMPACT TEST REPORT**

for Procedure Qualification Record # SAS-1-4

Client:	Sub-Arc Systems Inc.	Job Number:	100-14010
Address:	4605-47 Street, Vermillion AB, T9X 1L6	Date:	July 15, 2014
Materials:	SA-516 Grade 60/70 to SA-516 Grade 60/70		
Size:	0.500" w.t. Plate	Condition:	As Welded
Test Specification:	ASME Section VIII UG-84, ASTM A-370		
Test Equipment:	Satec Model S1-10, S/N: 1164		

Specimen Type:	Charpy V-Notch		
Qualification Temperature:	-50.0°F	Test Temperature:	-50.0°F

Specimen Size (mm): 10

Sample Set	Sample Number	Actual Impact Energy (ft-lb)	Full Size (ft-lb)	Shear (%)	Lateral Expansion Inches
Weld (includes all processes)	DG-1	56	56	30	0.040
	DG-2	58	58	40	0.041
	DG-3	66	66	40	0.044
	Average:	60	60	37	0.042

We certify that the statements in this record are acceptable and that the specimen(s) were prepared and tested in accordance with the requirements of the current edition of ASTM A370, ASTM E23 and their latest editions.

TEST RESULTS CERTIFIED BY:

Qualimet

Hanibal Ghile, E.I.T.



CHARPY IMPACT TEST REPORT

for Procedure Qualification Record # SAS-1-4

Client:	Sub-Arc Systems Inc.	Job Number:	100-14010
Address:	4605-47 Street, Vermillion AB, T9X 1L6	Date:	July 15, 2014
Materials:	SA-516 Grade 60/70 to SA-516 Grade 60/70		
Size:	0.500" w.t. Plate	Condition:	As Welded
Test Specification:	ASME Section VIII UG-84, ASTM A-370		
Test Equipment:	Satec Model S1-10, S/N: 1164		

Specimen Type:	Charpy V-Notch		
Qualification Temperature:	-50.0°F	Test Temperature:	-50.0°F

Specimen Size (mm): 10

Sample Set	Sample Number	Actual Impact Energy (ft-lb)	Full Size (ft-lb)	Shear (%)	Lateral Expansion Inches
HAZ	DG-4	56	56	-----**	-----**
	DG-5	28	28	30	0.019
	DG-6	89	89	-----**	-----**
	Average:	58	58	-----**	-----**

**Shear and Lateral Expansion not recorded – specimen did not break

We certify that the statements in this record are acceptable and that the specimen(s) were prepared and tested in accordance with the requirements of the current edition of ASTM A370, ASTM E23 and their latest editions.

TEST RESULTS CERTIFIED BY:

Qualimet

Hanibal Ghile, E.I.T.

SUB-ARC SYSTEMS INC.

Welding Procedure Specification

in accordance with

ASME Section IX

Welding Procedure Specification No.: SAS-2 Revision 2¹

Supporting PQR No. (s): SAS-2-1 Revision 1, SAS-2-2 Revision 1,
SAS-2-3 Revision 1, SAS-2-4 Revision 1

Qualified for

Process(es):	SAW (Leading) / SAW (Trailing)	Position(s):	Flat, Horizontal
Filler Metal F-No.:	F7A6-EM12K -H8 / F7A6-EM12K-H8	A-No.:	A-1 / A-1
AWS Classification:	F-6 / F-6	Weld Type(s):	Groove, Fillet, Weld buildup
Base Metal:	P-1 Group 1 or 2	To:	P-1 Group 1 or 2
Typical Materials:	This procedure is qualified for all P-1 materials as specified in Table QW-422 of ASME Section IX for applications where proven notch toughness properties are not required, and P-1 Group 1 or 2 materials only for applications where proven notch toughness properties are required.		
Diameter Range:	All diameters	Condition(s):	As Welded
Thickness Range:	ASME Section IX	Normal Service	Impact Tested to -50°F
	ASME Section VIII	0.062" to 1.500"	0.125" to 1.500"
	ASME B31.1	0.062" to 0.750"	0.125" to 0.750"
	ASME B31.3	0.062" to 0.750"	0.125" to 0.750"

¹Revision 2: Review and update to the current edition of the ASME code.

Provincial Registration

ABSA

SAFETY CODES ACT - PROVINCE OF ALBERTA
WELDING PROCEDURE

Reg. No. WP 2389.2
Spec No. SAS-2 (Rev 2)
Weld Process SAW
Matl. Gr. P No. 16r.1.2 to P No. 16r.1.2
Elect Gr. F No. 6 A No. 1
Th. Qual For 38.1mm P.W.H.T. NO
MIN TH QUAL 3.2mm CVN -46°C
Yr. 14 Mo. 11 Day 5 Signed [Signature]
JASON REINHART, PENG.
WELDING SPECIALIST

Provincial Registration

WELDING PROCEDURE SPECIFICATION (WPS) QW-482
(Section IX, ASME Boiler and Pressure Vessel Code)

Company Name: Sub-Arc Systems Inc.	By: Gary Kohlman
WPS No.: SAS-2	Date: June 4, 2010
Revision No.: 2 ¹	Revision Date: October 3, 2014
Supporting PQR's: SAS-2-1 Revision 1, SAS-2-2 Revision 1, SAS-2-3 Revision 1, SAS-2-4 Revision 1	
Welding Process(es): SAW / SAW	Type(s): Machine / Machine

JOINTS QW-402		Joint Details	
Joint Design:	Butt, Tee, Lap, Corner, etc.	All ASME joint designs. Reference construction	
Backing:	F-6 SAW (Leading) with or without backing	drawings for joint details. Where joint details are not	
	F-6 SAW (Trailing) with backing only	specified, refer to typical joint detail sheet provided.	
Backing Material (Type): Similar base or weld metal or backwelding as required. No Retainers.			
BASE METALS QW-403			
P-No.: P-1	Group No.: *1 or 2	to P-No.: P-1	Group No.: *1 or 2
OR			
Spec. type & grade:	Not Applicable	to Spec. type & grade:	Not Applicable
OR			
Chem. Analysis & Mech. Prop.:	Not Applicable	to Chem. Analysis & Mech. Prop.:	Not Applicable
Thickness Range			
	Normal Service	Impact Tested to -50°F	
Base Metal: Groove:	Section IX 0.062" to 1.500"	0.125" to 1.500"	Fillet: All
	Section VIII 0.062" to 1.500"	0.125" to 1.500"	Fillet: All
	B31.1 0.062" to 0.750"	0.125" to 0.750"	Fillet: All
	B31.3 0.062" to 0.750"	0.125" to 0.750"	Fillet: All
Pipe Dia Range: Groove:	All diameters		Fillet: All
Other:	*Limited to P-1 Group 1 or 2 only when proven notch toughness properties are required.		
	Maximum thickness of any weld layer shall not exceed .500"		
FILLER METALS QW-404			
Process:	SAW (Leading)	SAW (Trailing)	
Specification No. (SFA):	5.17	5.17	
AWS Classification No.:	F7A6-EM12K	F7A6-EM12K	
F-No.:	F-6	F-6	
A-No.:	A-1	A-1	
Size of Filler Metals:	3/32", 1/8", 5/32", 3/16"	3/32", 1/8", 5/32", 3/16"	
Weld Metal Thickness - Groove:	1.000"	1.000"	
- Fillet:	Unlimited	Unlimited	
Electrode-Flux (Class):	F7A6-EM12K-H8	F7A6-EM12K-H8	
Manufacturer:	Lincoln Electric	Lincoln Electric	
Tradename:	LA-61	LA-61	
Flux Trade Name:	Lincoln 882 Flux	Lincoln 882 Flux	
Alloy Flux:	Neutral	Neutral	
Consumable Insert:	Not Applicable	Not Applicable	
Supplemental Filler Metals:	Not Applicable	Not Applicable	
Product Form:	Coiled Solid Wire	Coiled Solid Wire	

¹Revision 2: Review and update to the current edition of the ASME code.

WELDING PROCEDURE SPECIFICATION (WPS) QW-482
(Section IX, ASME Boiler and Pressure Vessel Code)

WPS # SAS-2 Rev.2

POSITIONS QW-405			POSTWELD HEAT TREATMENT QW-407			
Position(s) of Groove: All			Temp. Range: _____			
Welding Progression: F-6 SAW (Leading) Flat or Horizontal only.			Time Range: <u>(None - As Welded)</u>			
F-6 SAW (Trailing) Flat or Horizontal only.			Heating: _____			
Position(s) of Fillet: All			Cooling: _____			
PREHEAT QW-406			GAS QW-408			
Temperature Min.: _____			Shielding Gas(es): _____			
Interpass Temp. Max.: <u>(See Next Page)</u>			Composition: _____			
Interpass Min.: _____			Flow Rate: <u>(Not Applicable)</u>			
Preheat Maintenance: Monitor using tempilstiks, pyrometer or other suitable methods.			Gas Backing: _____			
			Other: _____			
ELECTRICAL CHARACTERISTICS QW-409						
Current:	F-6 SAW (Leading):	Direct - DC	F-6 SAW (Trailing):	Direct - DC		
Polarity:	F-6 SAW (Leading):	Reverse - EP	F-6 SAW (Trailing):	Reverse - EP		
Amps (Range):	F-6 SAW (Leading):	250 - 750	F-6 SAW (Trailing):	250 - 750		
Volts (Range):	F-6 SAW (Leading):	22 - 38	F-6 SAW (Trailing):	22 - 38		
Travel Speed (Range):	F-6 SAW (Leading):	4 - 35	F-6 SAW (Trailing):	4 - 35		
Maximum Heat Input: 0.125" to 0.625":	F-6 SAW (Leading):	30 240 J/in	F-6 SAW (Trailing):	30 240 J/in		
0.625" to 1.500":	F-6 SAW (Leading):	30 240 J/in	F-6 SAW (Trailing):	30 240 J/in		
Electrode Wire feed speed range:	50 - 550 ipm					
Tungsten Electrode Size & Type:	Not Applicable					
Mode of Metal Transfer for GMAW:	Not Applicable					
Other:	Maximum heat input mandatory only when proven notch toughness is required					
TECHNIQUE QW-410						
String or Weave Bead:	String and weave. Weave size shall be controlled to prevent exceeding maximum heat inputs.					
Orifice or Gas Cup Size:	1/4" to 1"					
Initial Cleaning:	Base material must be thoroughly cleaned of all foreign material (scale, rust, oil, grease, paint, tar, etc.) at least 1" back on each side of the joint prior to welding. All surfaces to be welded shall be smooth, uniform and free from notches, slag, fins and burrs.					
Interpass Cleaning:	Perform by wire brush, chipping hammer, power brushing, grinding, etc. after each weld layer.					
Method of Back Gouging:	Arc air, gouge, grind, etc., grind to clean metal where thermal processes are used if required.					
Oscillation:	Not Applicable					
Contact Tube to Work Distance:	1/4" to 1 1/4"					
Electrode Spacing:	1" to 6"					
Multiple or Single Pass (per side):	Single or multiple passes per side, multiple only when proven notch toughness properties are required.					
Multiple or Single Electrodes & Spacing:	Single or Multiple, multiple only when proven notch toughness properties are required.					
Peening:	Peening is not allowed					
TYPICAL WELDING PARAMETERS						
Process	Filler Metal		Type & Polarity	Current		Travel Speed (IPM)
	AWS Classification	Diameter (in)		Amp. Range	Volt Range	
SAW	F7A6-EM12K	3/32	DC EP	250 - 750	22 - 38	4 - 35
SAW	F7A6-EM12K	1/8				
SAW	F7A6-EM12K	5/32				
SAW	F7A6-EM12K	3/16				
Notes: Number of weld layers and size of filler metal may vary with thickness of base material and position of weld.						

WELDING PROCEDURE SPECIFICATION (WPS) QW-482
(Section IX, ASME Boiler and Pressure Vessel Code)


WPS # SAS-2 Rev.2

PREHEAT & INTERPASS TEMPERATURE MINIMUM AND MAXIMUM	
Section VIII :	50°F minimum for all P-1 materials except as listed below :
	175°F if the joint thickness exceeds 1.000" and the specified carbon content exceeds 0.30%
	200°F if the joint thickness is 1.250" to 1.500"
B31.1 :	50°F minimum for all P-1 materials except as listed below :
	175°F if the joint thickness exceeds 1.00" and the specified carbon content exceeds 0.30%
B31.3 :	50°F for all P-1 materials except as listed below:
	175°F if the specified minimum tensile strength of the base material exceeds 71 ksi
	175°F if the nominal wall thickness exceeds 1"
Max. Interpass Temp.:	650°F for normal service, 550°F for applications where proven notch toughness is required


Reference to relevant construction codes is mandatory prior to production welding to determine any supplementary restrictions.

Typical Joint Details QW-482


Prepared by: **Qualimet**

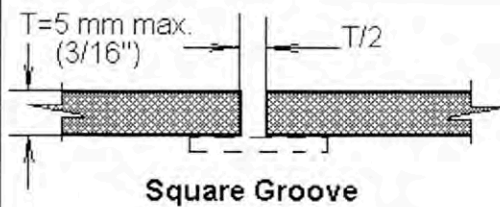


Square Groove

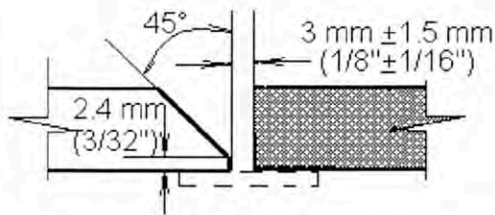


Single Bevel Groove

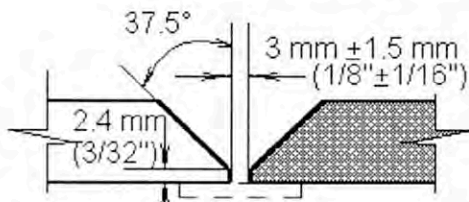


Single Vee Groove

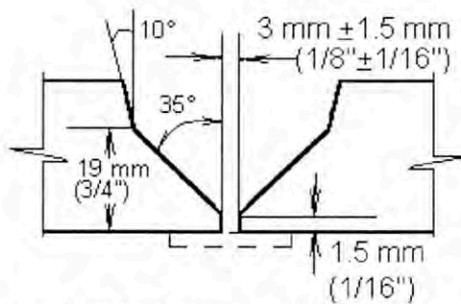


Modified Single Vee Groove

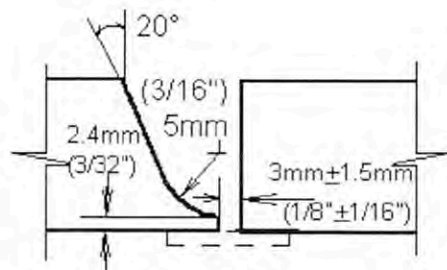


Single J Groove

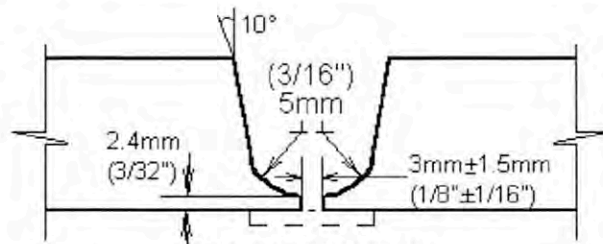


Single U Groove

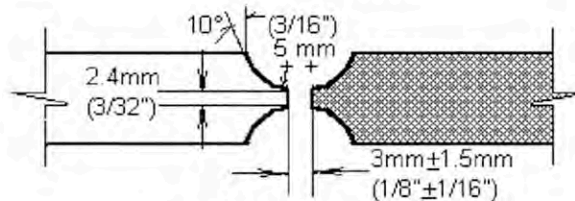


Double U Groove

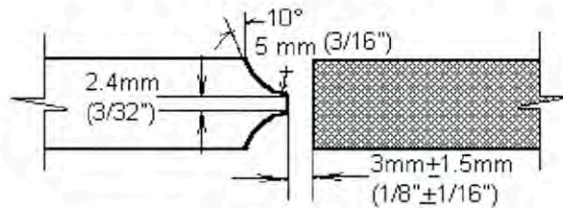

Double J Groove

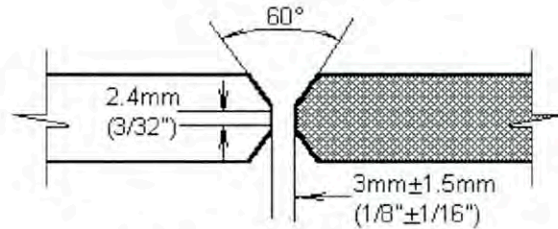

Double Vee Groove

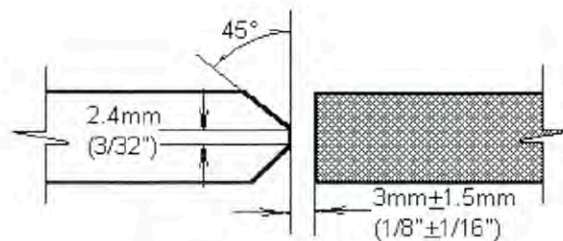


Double Bevel Groove

PROCEDURE QUALIFICATION RECORD (PQR) QW-483
(Section IX, ASME Boiler and Pressure Vessel Code)

Company Name: Sub-Arc Systems Inc.
PQR No.: SAS-2-1
Revision No.: 1¹
Welding Process(es): SAW / SAW

By: Gary Kohlman
Date: June 4, 2010
Revision Date: October 3, 2014
Types: Machine / Machine

JOINTS QW-402

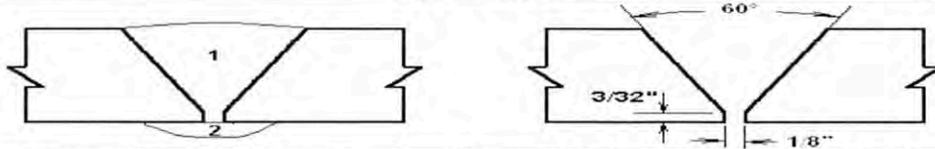

BASE METALS QW-403		POSTWELD HEAT TREATMENT QW-407	
Material Spec.:	SA-516	SA-516	Temperature:
Grade/Type/Class:	Grade 70	Grade 70	Time:
P-No. Group No.:	P-1 Group 2	to P-1 Group 2	Heating:
Heat No.:	0934K-54	0934K-54	Cooling:
Carbon Equivalent (CE):	0.39	0.39	Other:
Thickness & Diameter:	0.249" Plate (machined)		
Max Weld Deposit:	<0.500" per pass		
PREHEAT QW-406		POSITIONS QW-405	
Preheat Temp. Min.:	50°F	Process:	SAW (Leading) SAW (Trailing)
Interpass Temp. Max.:	550°F	Position:	2-G 2-G
Interpass Temp. Min.:	50°F	Progression:	Horizontal Horizontal
Other:	Temperature monitored by tempilsticks		
FILLER METALS QW-404			
Process:	SAW (Leading)	SAW (Trailing)	
SFA Specification No.:	5.17	5.17	
AWS Classification No.:	EM12K-H8	EM12K-H8	
F-No.:	F-6	F-6	
A-No.:	A-1	A-1	
Size of Filler Metal:	3/32"	3/32"	
Deposited Weld Metal:	0.125"	0.125"	
Manufacturer:	Lincoln Electric Co.	Lincoln Electric Co.	
Trade Name:	LA-61	LA-61	
Heat / Lot Number:	Not Recorded	Not Recorded	
Electrode-Flux (Class):	F7A6-EM12K-H8	F7A6-EM12K-H8	
Flux Tradename:	Lincolnweld 882 Flux	Lincolnweld 882 Flux	
Flux Heat / Lot Number.:	Not Recorded	Not Recorded	
Product Form:	Coiled Solid Wire	Coiled Solid Wire	
Other:	Recrushed Slag Not Permitted	Recrushed Slag Not Permitted	
ELECTRICAL CHARACTERISTICS QW-409			
Process:	SAW (Leading)	SAW (Trailing)	
Current:	Direct - DC	Direct - DC	
Polarity:	Reverse - EP	Reverse - EP	
Volts:	27	27	
Amps:	400	300	
Travel Speed (ipm):	20.0 - 26.0	20.0 - 24.0	
Maximum Heat Input (J/in):	32 400	24 300	
Tungsten Electrode:	Not Applicable	Not Applicable	
STT Program Settings:	Not Applicable	Not Applicable	
Other:	Not Applicable	Not Applicable	
TECHNIQUE QW-410			
String or Weave:	String	String	
Oscillation:	Not Applicable	Not Applicable	
Single / Multi Pass:	Single Pass Per Side		
Single / Multi Electrodes:	Multiple Electrodes		
Wire Stick Out:	1/4" to 1 1/4"	1/4" to 1 1/4"	
Electrode Spacing:	Not Recorded	Not Recorded	
Nozzle / Cup Size:	Not Recorded	Not Recorded	

¹Revision 1: Review and update to the current edition of the ASME code.

PROCEDURE QUALIFICATION RECORD (PQR) QW-483
(Section IX, ASME Boiler and Pressure Vessel Code)

PQR # SAS-2-1 Revision 1

Tensile Test
QW-462

Specimen No.	Width in	Thickness in	Area in ²	Ultimate Total Load Lb	Ultimate Unit Stress ksi	Type of Failure & Location
ZB-T1	0.742	0.244	0.181	15 054	83.0	Ductile - Base
ZB-T2	0.746	0.241	0.180	14 656	81.5	Ductile - Base

Guided Bend Tests
QW-462

Specimen No.	Type	Figure	Result
ZB-B1	TFB	QW-462.3(a)	Pass
ZB-B2	TFB	QW-462.3(a)	Pass
ZB-B3	TRB	QW-462.3(a)	Pass
ZB-B4	TRB	QW-462.3(a)	Pass

Toughness Tests
QW-170

Specimen No.	Notch Location	Notch Type	Test Temp	Impact Values (ft-lbs)	% Shear	Lateral Exp Inches	Drop Weight Break	No Brk
ZB-1	Weld	V-Notch	-50°F	49	50	0.040	N/A	N/A
ZB-2	Weld	V-Notch	-50°F	30	40	0.026	N/A	N/A
ZB-3	Weld	V-Notch	-50°F	67	60	0.053	N/A	N/A
ZB-4	HAZ	V-Notch	-50°F	67	60	0.054	N/A	N/A
ZB-5	HAZ	V-Notch	-50°F	75	70	0.056	N/A	N/A
ZB-6	HAZ	V-Notch	-50°F	123	100	0.065	N/A	N/A

Fillet-Weld Tests

Not Applicable

Result-Satisfactory:	Yes	No	Pen. into Parent Material:	Yes	No
Macro-Results:					

Other Tests

Type of Test:	Hardness Testing - See Attached Report
Other:	

Welder's Name:	<u>Matt MacKenzie</u>	Reg. No.:	<u>Not Applicable</u>	Stamp ID: <u>ZB</u>
Welder's Name:	<u>Joel Overguard</u>	Reg. No.:	<u>Not Applicable</u>	
Tests Conducted By:	<u>Qualimet</u>	Lab. Test No.:	<u>636-10004</u>	
Revised By:	<u>Qualimet</u>			

We hereby recertify that the statements in this record have been revised in accordance with paragraph QW-200.2 are correct and that the test welds were prepared, welded, and tested in accordance with the requirements of Section IX of the ASME Code.

Manufacturer:	<u>Sub-Arc Systems Inc.</u>	By:	<u>Gary Kohlman</u>
Original Cert. Date:	<u>June 4, 2010</u>	By:	<u>Gary Kohlman</u>
Recertification Date:	<u>October 3, 2014</u>	By:	<u>Gary Kohlman</u>

MECHANICAL TEST REPORT

for Procedure Qualification Record # SAS-2-1

Client: Sub-Arc Systems Inc.	Job Number: 636-10004
Address: 4605-47 Street Vermillion AB T9X 1L6	Date: June 4, 2010
Materials: SA-516 Grade 70	
Size: 0.249" Plate (machined)	Condition: As Welded
Test Specification:	ASME Section IX

Tensile Tests

QW-462.1(a)

Sample Identification:	ZB-T1	ZB-T2
Sample Size - inch:(W x T)	0.742 x 0.244	0.746 x 0.241
Least X-Sect. Area - in²:	0.181	0.180
Ultimate Load - lbs:	15 054	14 656
Ult. Ten. Strength - ksi:	83.0	81.5
Character of Failure:	Ductile	Ductile
Location of Failure:	Base Metal	Base Metal
Req'd Tensile Strength - ksi:	70.0	70.0
Pass or Fail:	Pass	Pass
Remarks:	-----	-----

Bend Tests

QW-462.3 (a)

Sample Identification:	ZB-B1	ZB-B2	ZB-B3	ZB-B4
*Type of Bend Test:	TFB	TFB	TRB	TRB
Pass or Fail:	Pass	Pass	Pass	Pass
Remarks:	-----	-----	-----	-----

*Types of Bend Tests TSB, TFB, TRB = transverse side, face or root bend LSB, LFB, LRB = longitudinal side, face or root bend

We certify that the statements in this record are acceptable, in accordance with the requirements of ASME Section IX.

TEST RESULTS CERTIFIED BY:



Sean Lepine, E.I.T.

Qualimet

CHARPY IMPACT TEST REPORT

for Procedure Qualification Record # SAS-2-1

Client: Sub-Arc Systems Inc.	Job Number: 636-10004
Address: 4605-47 Street Vermillion AB T9X 1L6	Date: June 4, 2010
Materials: SA-516 Grade 70	
Size: 0.249" Plate (machined)	Condition: As Welded
Test Specification: ASME Section IX, ASME Section VIII UG-84, ASTM A-370	


Specimen Type: Charpy V-Notch
Qualification Temperature: -50°F
Test Temperature: -50°F

Specimen Size (mm): 5.35

Sample Set	Sample Number	Actual Impact Energy (ft-lb)	Full Size (ft-lb)	Shear (%)	Lateral Expansion Inches
Weld Zone	ZB-1	26	49	50	0.040
	ZB-2	16	30	40	0.026
	ZB-3	36	67	60	0.053
	Average:	26	49	50	0.040

We certify that the statements in this record are acceptable and that the specimen(s) were prepared and tested in accordance with the requirements of the current edition of ASME Section IX and the latest addenda.

TEST RESULTS CERTIFIED BY:

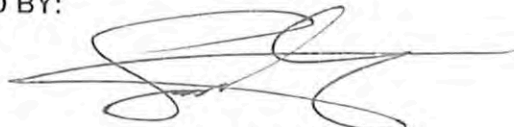


Sean Lepine, E.I.T.

Qualimet



CHARPY IMPACT TEST REPORT

for Procedure Qualification Record # SAS-2-1

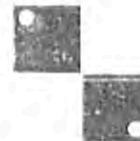

Client: Sub-Arc Systems Inc.	Job Number: 636-10004
Address: 4605-47 Street Vermillion AB T9X 1L6	Date: June 4, 2010
Materials: SA-516 Grade 70	
Size: 0.249" Plate (machined)	Condition: As Welded
Test Specification: ASME Section IX, ASME Section VIII UG-84, ASTM A-370	

Specimen Type: Charpy V-Notch
Qualification Temperature: -50°F
Test Temperature: -50°F

Specimen Size (mm): 5.35

Sample Set	Sample Number	Actual Impact Energy (ft-lb)	Full Size (ft-lb)	Shear (%)	Lateral Expansion Inches
HAZ	ZB-4	36	67	60	0.054
	ZB-5	40	75	70	0.056
	ZB-6	66	123	100	0.065
	Average:	47	88	77	0.058

We certify that the statements in this record are acceptable and that the specimen(s) were prepared and tested in accordance with the requirements of the current edition of ASME Section IX and the latest addenda.

TEST RESULTS CERTIFIED BY:

Sean Lepine, E.I.T.

Qualimet


HARDNESS TEST REPORT

for Procedure Qualification Record # SAS-2-1



Client:	Sub-Arc Systems Inc.	Job Number:	636-10004
Address:	4605-47 Street Vermillion AB T9X 1L6	Date:	June 4, 2010
Materials:	SA-516 Grade 70		
Size:	0.249" Plate (machined)	Condition:	As Welded
Test Specification:	NACE RP0472		

Test Method:	Hardness testing performed in accordance with ASTM E-92 (Vickers Hardness of Metallic Materials) using a Vickers tester with a 1kg load.
---------------------	--

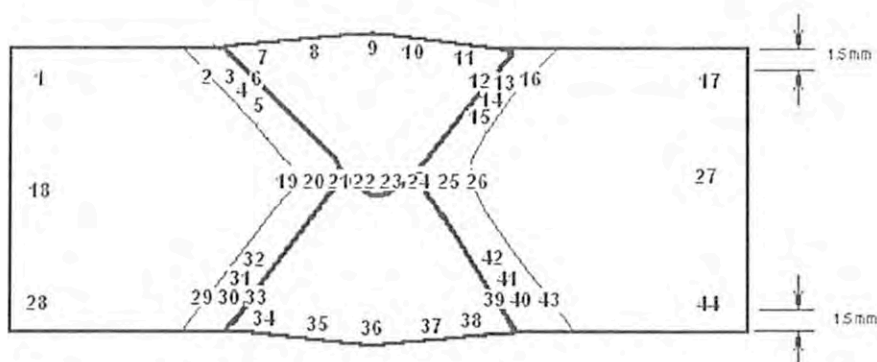

Vickers Hardness Values

1	153	10	190	19	165	28	172	37	193
2	156	11	192	20	171	29	158	38	192
3	169	12	183	21	191	30	189	39	195
4	167	13	183	22	186	31	182	40	176
5	169	14	179	23	204	32	181	41	175
6	182	15	185	24	195	33	206	42	178
7	182	16	163	25	180	34	189	43	172
8	198	17	159	26	169	35	203	44	167
9	179	18	160	27	165	36	203		

We certify that the statements in this record are acceptable, in accordance with the requirements of NACE RP 0472. RP 0472-2005 paragraph 5.3 states "The maximum allowable HAZ hardness shall be 248 HV the maximum weld deposit hardness should be 248 HV and the average weld deposit hardness should not exceed 210 HV"

TEST RESULTS CERTIFIED BY:

Qualimet


Sean Lepine, E.I.T.

PROCEDURE QUALIFICATION RECORD (PQR) QW-483
(Section IX, ASME Boiler and Pressure Vessel Code)

Company Name: Sub-Arc Systems Inc.
PQR No.: SAS-2-2
Revision No.: 1¹
Welding Process(es): SAW / SAW

By: Gary Kohlman
Date: June 4, 2010
Revision Date: October 3, 2014
Types: Machine / Machine

JOINTS QW-402

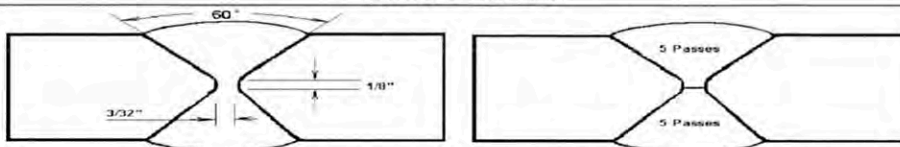

BASE METALS QW-403		POSTWELD HEAT TREATMENT QW-407	
Material Spec.:	SA-516	SA-516	Temperature:
Grade/Type/Class:	Grade 70	Grade 70	Time:
P-No. Group No.:	P-1 Group 2	to P-1 Group 2	Heating:
Heat No.:	8277J	8277J	(Not Applicable)
Carbon Equivalent (CE):	0.40	0.40	Cooling:
Thickness & Diameter:	1.000" Plate		Other:
Max Weld Deposit:	<0.500" per pass		
PREHEAT QW-406		POSITIONS QW-405	
Preheat Temp. Min.:	50°F	Process:	SAW (Leading) SAW (Trailing)
Interpass Temp. Max.:	550°F	Position:	2-G 2-G
Interpass Temp. Min.:	50°F	Progression:	Horizontal Horizontal
Other:	Temperature monitored by tempilsticks	Other:	Not Applicable Not Applicable
FILLER METALS QW-404			
Process:	SAW (Leading)	SAW (Trailing)	
SFA Specification No.:	5.17	5.17	
AWS Classification No.:	EM12K-H8	EM12K-H8	
F-No.:	F-6	F-6	
A-No.:	A-1	A-1	
Size of Filler Metal:	3/32"	3/32"	
Deposited Weld Metal:	0.500"	0.500"	
Manufacturer:	Lincoln Electric Co.	Lincoln Electric Co.	
Trade Name:	LA-61	LA-61	
Heat / Lot Number:	Not Recorded	Not Recorded	
Electrode-Flux (Class):	F7A6-EM12K-H8	F7A6-EM12K-H8	
Flux Tradename:	Lincolnweld 882 Flux	Lincolnweld 882 Flux	
Flux Heat / Lot Number.:	Not Recorded	Not Recorded	
Product Form:	Coiled Solid Wire	Coiled Solid Wire	
Other:	Recrushed Slag Not Permitted	Recrushed Slag Not Permitted	
ELECTRICAL CHARACTERISTICS QW-409			
Process:	SAW (Leading)	SAW (Trailing)	
Current:	Direct - DC	Direct - DC	
Polarity:	Reverse - EP	Reverse - EP	
Volts:	27	27 - 29	
Amps:	400 - 420	320 - 415	
Travel Speed (ipm):	18.0 - 25.0	18.0 - 25.0	
Maximum Heat Input (J/in):	35 998	33 615	
Wirefeed Speed (ipm):	410	400	
STT Program Settings:	Not Applicable	Not Applicable	
Other:	Not Applicable	Not Applicable	
TECHNIQUE QW-410			
String or Weave:	String	String	
Oscillation:	Not Applicable	Not Applicable	
Single / Multi Pass:	Multiple Passes Per Side		
Single / Multi Electrodes:	Multiple Electrodes		
Wire Stick Out:	1/4" to 1 1/4"	1/4" to 1 1/4"	
Electrode Spacing:	Not Recorded	Not Recorded	
Nozzle / Cup Size:	Not Recorded	Not Recorded	

¹Revision 1: Review and update to the current edition of the ASME code.

PROCEDURE QUALIFICATION RECORD (PQR) QW-483
(Section IX, ASME Boiler and Pressure Vessel Code)

PQR # SAS-2-2 Revision 1

Tensile Test
QW-462

Specimen No.	Width in	Thickness in	Area in ²	Ultimate Total Load Lb	Ultimate Unit Stress ksi	Type of Failure & Location
YE-T1	0.741	0.983	0.728	58 240	80.0	Ductile - Base
YE-T2	0.735	0.994	0.731	57 482	79.0	Ductile - Base

Guided Bend Tests
QW-462

Specimen No.	Type	Figure	Result
YE-B1	TSB	QW-462.2	Pass
YE-B2	TSB	QW-462.2	Pass
YE-B3	TSB	QW-462.2	Pass
YE-B4	TSB	QW-462.2	Pass

Toughness Tests
QW-170

Specimen No.	Notch Location	Notch Type	Test Temp	Impact Values (ft-lbs)	% Shear	Lateral Exp Inches	Drop Weight Break	No Brk
YE-1	Weld	V-Notch	-50°F	24	40	0.038	N/A	N/A
YE-2	Weld	V-Notch	-50°F	16	30	0.019	N/A	N/A
YE-3	Weld	V-Notch	-50°F	50	50	0.015	N/A	N/A
YE-4	HAZ	V-Notch	-50°F	58	60	0.044	N/A	N/A
YE-5	HAZ	V-Notch	-50°F	16	30	0.013	N/A	N/A
YE-6	HAZ	V-Notch	-50°F	53	60	0.078	N/A	N/A

Fillet-Weld Tests

Not Applicable

Result-Satisfactory: <u>Yes</u> <u>No</u>	Pen. into Parent Material: <u>Yes</u> <u>No</u>
Macro-Results:	

Other Tests

Type of Test: <u>Hardness Testing - See Attached Report</u>
Other:

Welder's Name: Matt MacKenzie

Reg. No.: Not Applicable

Welder's Name: Joel Overguard

Reg. No.: Not Applicable

Stamp ID: YE

Tests Conducted By: Qualimet

Lab. Test No.: 636-10004

Revised By: Qualimet

We hereby recertify that the statements in this record have been revised in accordance with paragraph QW-200.2 are correct and that the test welds were prepared, welded, and tested in accordance with the requirements of Section IX of the ASME Code.

Manufacturer: Sub-Arc Systems Inc.

Original Cert. Date: June 4, 2010

By: Gary Kohlman

Recertification Date: October 3, 2014

By: Gary Kohlman

MECHANICAL TEST REPORT

for Procedure Qualification Record # SAS-2-2

Client: Sub-Arc Systems Inc.	Job Number: 636-10004
Address: 4605-47 Street Vermillion AB T9X 1L6	Date: June 4, 2010
Materials: SA-516 Grade 70	
Size: 1.000" Plate	Condition: As Welded
Test Specification:	ASME Section IX

Tensile Tests

QW-462.1(a)

Sample Identification:	YE-T1	YE-T2
Sample Size - inch:(W x T)	0.741 x 0.983	0.735 x 0.994
Least X-Sect. Area - in²:	0.728	0.731
Ultimate Load - lbs:	58 240	57 482
Ult. Ten. Strength - ksi:	80.0	79.0
Character of Failure:	Ductile	Ductile
Location of Failure:	Base Metal	Base Metal
Req'd Tensile Strength - ksi:	70.0	70.0
Pass or Fail:	Pass	Pass
Remarks:	----	----

Bend Tests

QW-462.2

Sample Identification:	YE-B1	YE-B2	YE-B3	YE-B4
*Type of Bend Test:	TSB	TSB	TSB	TSB
Pass or Fail:	Pass	Pass	Pass	Pass
Remarks:	----	----	----	----

*Types of Bend Tests TSB, TFB, TRB = transverse side, face or root bend LSB, LFB, LRB = longitudinal side, face or root bend

We certify that the statements in this record are acceptable, in accordance with the requirements of ASME Section IX.

TEST RESULTS CERTIFIED BY:



Sean Lepine, E.I.T.

Qualimet



CHARPY IMPACT TEST REPORT

for Procedure Qualification Record # SAS-2-2



Client:	Sub-Arc Systems Inc.	Job Number:	636-10004
Address:	4605-47 Street Vermillion AB T9X 1L6	Date:	June 4, 2010
Materials:	SA-516 Grade 70		
Size:	1.000" Plate	Condition:	As Welded
Test Specification:	ASME Section IX, ASME Section VIII UG-84, ASTM A-370		

Specimen Type:	Charpy V-Notch
Qualification Temperature:	-50°F
Test Temperature:	-50°F

Specimen Size (mm): 10

Sample Set	Sample Number	Actual Impact Energy (ft-lb)	Full Size (ft-lb)	Shear (%)	Lateral Expansion Inches
Weld	YE-1	24	24	40	0.038
	YE-2	16	16	30	0.019
	YE-3	50	50	50	0.015
	Average:	30	30	40	0.024

We certify that the statements in this record are acceptable and that the specimen(s) were prepared and tested in accordance with the requirements of the current edition of ASME Section IX and the latest addenda.

TEST RESULTS CERTIFIED BY:

Sean Lepine, E.I.T.

Qualimet



CHARPY IMPACT TEST REPORT

for Procedure Qualification Record # SAS-2-2

Client: Sub-Arc Systems Inc.	Job Number: 636-10004
Address: 4605-47 Street Vermillion AB T9X 1L6	Date: June 4, 2010
Materials: SA-516 Grade 70	
Size: 1.000" Plate	Condition: As Welded
Test Specification: ASME Section IX, ASME Section VIII UG-84, ASTM A-370	

Specimen Type: Charpy V-Notch
Qualification Temperature: -50°F
Test Temperature: -50°F

Specimen Size (mm): 10

Sample Set	Sample Number	Actual Impact Energy (ft-lb)	Full Size (ft-lb)	Shear (%)	Lateral Expansion Inches
HAZ	YE-4	58	58	60	0.044
	YE-5	16	16	30	0.013
	YE-6	53	53	60	0.078
	Average:	42	42	50	0.045

We certify that the statements in this record are acceptable and that the specimen(s) were prepared and tested in accordance with the requirements of the current edition of ASME Section IX and the latest addenda.

TEST RESULTS CERTIFIED BY:



Sean Lepine, E.I.T.

Qualimet




HARDNESS TEST REPORT

for Procedure Qualification Record # SAS-2-2



Client:	Sub-Arc Systems Inc.	Job Number:	636-10004
Address:	4605-47 Street Vermillion AB T9X 1L6	Date:	June 4, 2010
Materials:	SA-516 Grade 70		
Size:	1.000" Plate	Condition:	As Welded
Test Specification:	NACE RP0472		

Test Method: Hardness testing performed in accordance with ASTM E-92 (Vickers Hardness of Metallic Materials) using a Vickers tester with a 1kg load.

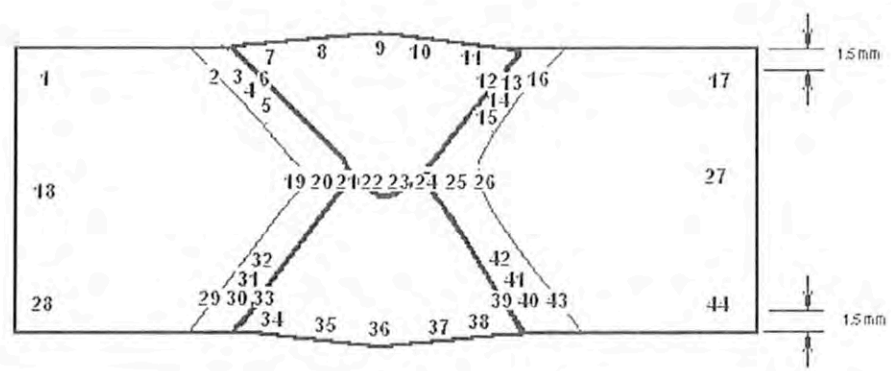

Vickers Hardness Values

1	165	10	231	19	195	28	173	37	212
2	191	11	212	20	183	29	191	38	224
3	234	12	220	21	180	30	206	39	214
4	216	13	245	22	179	31	193	40	206
5	219	14	246	23	184	32	187	41	197
6	235	15	232	24	184	33	199	42	207
7	208	16	187	25	173	34	209	43	174
8	194	17	164	26	170	35	208	44	161
9	181	18	158	27	152	36	202		

We certify that the statements in this record are acceptable, in accordance with the requirements of NACE RP 0472. RP 0472-2005 paragraph 5.3 states "The maximum allowable HAZ hardness shall be 248 HV the maximum weld deposit hardness should be 248 HV and the average weld deposit hardness should not exceed 210 HV"

TEST RESULTS CERTIFIED BY:

Sean Lepine, E.I.T.


Qualimet

PROCEDURE QUALIFICATION RECORD (PQR) QW-483
(Section IX, ASME Boiler and Pressure Vessel Code)

Company Name: Sub-Arc Systems Inc.
PQR No.: SAS-2-3
Revision No.: 1¹
Welding Process(es): SAW / SAW

By: Gary Kohlman
Date: January 20, 2014
Revision Date: October 3, 2014
Type(s): Machine / Machine

JOINTS QW-402

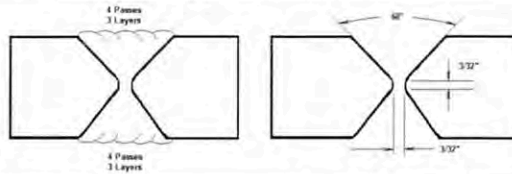

BASE METALS QW-403		POSTWELD HEAT TREATMENT QW-407	
Material Spec.:	SA-516	SA-516	Temperature:
Grade/Type/Class:	Grade 60/70	Grade 60/70	Time:
P-No. Group No.:	P-1 Group 1/2	P-1 Group 1/2	Heating:
Heat No.:	H6/5888	H6/5888	Cooling:
Carbon Equivalent (ASME):	0.41	0.41	Other:
Carbon Equivalent (CSA):	0.41	0.41	
Thickness & Diameter:	1.000" w.t. Plate		
Max Weld Deposit:	<0.500" per pass		
PREHEAT QW-406		POSITIONS QW-405	
Preheat Temp. Min.:	50°F	Process:	SAW (Leading) SAW (Trailing)
Interpass Temp. Max.:	550°F	Position:	2-G 2-G
Interpass Temp. Min.:	50°F	Progression:	Horizontal Horizontal
Other:	Temperature monitored using tempilstiks	Other:	Not Applicable Not Applicable
FILLER METALS QW-404			
Process:	SAW (Leading)	SAW (Trailing)	
SFA Specification No.:	5.17	5.17	
AWS Classification No.:	EM12K-H8	EM12K-H8	
F-No.:	F-6	F-6	
A-No.:	A-1	A-1	
Size of Filler Metal:	3/32"	3/32"	
Deposited Weld Metal:	0.500"	0.500"	
Manufacturer:	Lincoln Electric	Lincoln Electric	
Trade Name:	LA-61	LA-61	
Heat / Lot Number:	Not Recorded	Not Recorded	
Electrode-Flux (Class):	F7A6-EM12K-H8	F7A6-EM12K-H8	
Flux Tradename:	Lincolnweld 882 Flux	Lincolnweld 882 Flux	
Flux Heat / Lot Number.:	Not Recorded	Not Recorded	
Product Form:	Coiled Solid Wire	Coiled Solid Wire	
SHIELDING GAS QW-408			
Shielding Gas:			
Composition:	(Not Applicable)	(Not Applicable)	
Flow Rate:			
Backing Gas:			
ELECTRICAL CHARACTERISTICS QW-409			
Current:	Direct (DC)	Direct (DC)	
Polarity:	Reverse (EP)	Reverse (EP)	
Volts:	28 - 30	28 - 30	
Amps:	380 - 420	380 - 420	
Travel Speed (ipm):	25.0	25.0	
Maximum Heat Input (J/in):	30 240	30 240	
TECHNIQUE QW-410			
String or Weave:	String	String	
Oscillation:	Not Applicable	Not Applicable	
Single / Multi Pass:	Multiple Passes from both sides		
Single / Multi Electrodes:	Multi	Multi	
Wire Stick Out:	1/4" to 1 1/4"	1/4" to 1 1/4"	
Electrode Spacing:	Not Recorded	Not Recorded	
Nozzle / Cup Size:	Not Recorded	Not Recorded	

¹Revision 1: Review and update to the current edition of the ASME code.

PROCEDURE QUALIFICATION RECORD (PQR) QW-483
(Section IX, ASME Boiler and Pressure Vessel Code)

PQR # SAS-2-3 Revision 1

Tensile Test

QW-462

Specimen No.	Width (in)	Thickness (in)	Area (in ²)	Ultimate Total Load (lbs)	Ultimate Unit Stress (ksi)	Type of Failure & Location
			(Not Applicable)			

Guided Bend Tests

QW-462

Specimen No.	Type	Figure	Result
		(Not Applicable)	

Toughness Tests

QW-170

Specimen No.	Notch Location	Notch Type	Qual. Temp	Full Size Values (ft-lbs)	% Shear	Lateral Exp Inches	Drop Weight Break	No Brk
BH-1	Weld	V-Notch	-50°F	94	60	0.064	----	----
BH-2	Weld	V-Notch	-50°F	105	70	0.063	----	----
BH-3	Weld	V-Notch	-50°F	115	80	0.072	----	----
BH-4	HAZ	V-Notch	-50°F	74	40	0.046	----	----
BH-5	HAZ	V-Notch	-50°F	68	30	0.044	----	----
BH-6	HAZ	V-Notch	-50°F	83	----	----	----	----

**Shear and Lateral Expansion not recorded – specimen did not break

Fillet-Weld Tests

Not Applicable



Result-Satisfactory: Yes _____ No _____	Pen. into Parent Material: Yes _____ No _____
Macro-Results:	

Other Tests

Type of Test: Not Applicable
Other: Not Applicable

Welder's Name: Keith Breedon **Reg. No.:** W-11618 **Stamp ID:** BH
Tests Conducted By: Qualimet **Lab. Test No.:** 636-13001
Revised By: Qualimet

We hereby recertify that the statements in this record have been revised in accordance with paragraph QW-200.2 are correct and that the test welds were prepared, welded, and tested in accordance with the requirements of Section IX of the ASME Code.

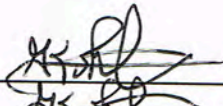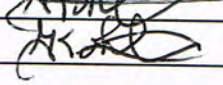Manufacturer: Sub-Arc Systems Inc.
Original Cert. Date: January 20, 2014 **By:** Gary Kohlman 
Recertification Date: October 3, 2014 **By:** Gary Kohlman 



CHARPY IMPACT TEST REPORT

for Procedure Qualification Record # SAS-2-3

Client:	Sub-Arc Systems Inc.	Job Number:	636-13001
Address:	4605-47 Street Vermillion AB T9X 1L6	Date:	January 20, 2014
Materials:	SA-516 Grade 60/70 to SA-516 Grade 60/70		
Size:	1.000" w.t. Plate	Condition:	As Welded
Test Specification:	ASME Section IX, ASME Section VIII UG-84, ASTM A-370		
Test Equipment:	Satec Model S1-10, S/N: 1164		

Specimen Type:	Charpy V-Notch
Qualification Temperature:	-50.0°F
Test Temperature:	-50.0°F

Specimen Size (mm): 10

Sample Set	Sample Number	Actual Impact Energy (ft-lb)	Full Size (ft-lb)	Shear (%)	Lateral Expansion Inches
Weld (includes all processes)	BH-1	94	94	60	0.064
	BH-2	105	105	70	0.063
	BH-3	115	115	80	0.072
	Average:	105	105	70	0.066

We certify that the statements in this record are acceptable and that the specimen(s) were prepared and tested in accordance with the requirements of the current edition of ASTM A370, ASTM E23 and their latest editions.

TEST RESULTS CERTIFIED BY:

Qualimet

Hanibal Ghile, E.I.T.



CHARPY IMPACT TEST REPORT

for Procedure Qualification Record # SAS-2-3

Client:	Sub-Arc Systems Inc.	Job Number:	636-13001
Address:	4605-47 Street Vermillion AB T9X 1L6	Date:	January 20, 2014
Materials:	SA-516 Grade 60/70 to SA-516 Grade 60/70		
Size:	1.000" w.t. Plate	Condition:	As Welded
Test Specification:	ASME Section IX, ASME Section VIII UG-84, ASTM A-370		
Test Equipment:	Satec Model S1-10, S/N: 1164		

Specimen Type:	Charpy V-Notch
Qualification Temperature:	-50.0°F
Test Temperature:	-50.0°F

Specimen Size (mm): 10

Sample Set	Sample Number	Actual Impact Energy (ft-lb)	Full Size (ft-lb)	Shear (%)	Lateral Expansion Inches
HAZ	BH-4	74	74	40	0.046
	BH-5	68	68	30	0.044
	BH-6	83	83	-----**	-----**
	Average:	75	75	-----**	-----**

**Shear and Lateral Expansion not recorded – specimen did not break

We certify that the statements in this record are acceptable and that the specimen(s) were prepared and tested in accordance with the requirements of the current edition of ASTM A370, ASTM E23 and their latest editions.

TEST RESULTS CERTIFIED BY:

Qualimet


Hanibal Ghile, E.I.T.

PROCEDURE QUALIFICATION RECORD (PQR) QW-483
(Section IX, ASME Boiler and Pressure Vessel Code)

Company Name: Sub-Arc Systems Inc.
PQR No.: SAS-2-4
Revision No.: 1¹
Welding Process(es): SAW / SAW

By: Gary Kohlman
Date: January 20, 2014
Revision Date: October 3, 2014
Type(s): Machine / Machine

JOINTS QW-402

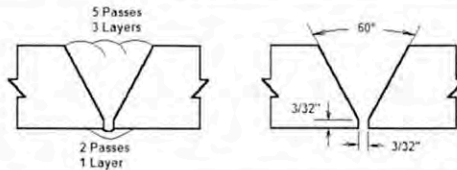

BASE METALS QW-403		POSTWELD HEAT TREATMENT QW-407	
Material Spec.:	SA-516	SA-516	Temperature:
Grade/Type/Class:	Grade 60/70	Grade 60/70	Time:
P-No. Group No.:	P-1 Group 1/2	P-1 Group 1/2	Heating:
Heat No.:	53293	53293	Cooling:
Carbon Equivalent (ASME):	0.39	0.39	Other:
Carbon Equivalent (CSA):	0.39	0.39	
Thickness & Diameter:	0.249" w.t. Plate (machined)		
Max Weld Deposit:	<0.500" per pass		
PREHEAT QW-406		POSITIONS QW-405	
Preheat Temp. Min.:	50°F	Process:	SAW (Leading) SAW (Trailing)
Interpass Temp. Max.:	550°F	Position:	2-G 2-G
Interpass Temp. Min.:	50°F	Progression:	Horizontal Horizontal
Other:	Temperature monitored using tempilstiks		
FILLER METALS QW-404			
Process:	SAW (Leading)	SAW (Trailing)	
SFA Specification No.:	5.17	5.17	
AWS Classification No.:	EM12K-H8	EM12K-H8	
F-No.:	F-6	F-6	
A-No.:	A-1	A-1	
Size of Filler Metal:	3/32"	3/32"	
Deposited Weld Metal:	0.125"	0.125"	
Manufacturer:	Lincoln Electric	Lincoln Electric	
Trade Name:	LA-61	LA-61	
Heat / Lot Number:	Not Recorded	Not Recorded	
Electrode-Flux (Class):	F7A6-EM12K-H8	F7A6-EM12K-H8	
Flux Tradename:	Lincolnweld 882 Flux	Lincolnweld 882 Flux	
Flux Heat / Lot Number.:	Not Recorded	Not Recorded	
Product Form:	Coiled Solid Wire	Coiled Solid Wire	
SHIELDING GAS QW-408			
Shielding Gas:			
Composition:	(Not Applicable)	(Not Applicable)	
Flow Rate:			
Backing Gas:			
ELECTRICAL CHARACTERISTICS QW-409			
Current:	Direct (DC)	Direct (DC)	
Polarity:	Reverse (EP)	Reverse (EP)	
Volts:	30	30	
Amps:	420	420	
Travel Speed (ipm):	25.0	25.0	
Maximum Heat Input (J/in):	30 240	30 240	
TECHNIQUE QW-410			
String or Weave:	String	String	
Oscillation:	Not Applicable	Not Applicable	
Single / Multi Pass:	Multiple Passes from both sides		
Single / Multi Electrodes:	Multi	Multi	
Wire Stick Out:	1/4" to 1 1/4"	1/4" to 1 1/4"	
Electrode Spacing:	Not Recorded	Not Recorded	
Nozzle / Cup Size:	Not Recorded	Not Recorded	

¹Revision 1: Review and update to the current edition of the ASME code.

PROCEDURE QUALIFICATION RECORD (PQR) QW-483
(Section IX, ASME Boiler and Pressure Vessel Code)

PQR # SAS-2-4 Revision 1

Tensile Test

QW-462

Specimen No.	Width (in)	Thickness (in)	Area (in ²)	Ultimate Total Load (lbs)	Ultimate Unit Stress (ksi)	Type of Failure & Location
			(Not Applicable)			

Guided Bend Tests

QW-462

Specimen No.	Type	Figure	Result
		(Not Applicable)	

Toughness Tests

QW-170

Specimen No.	Notch Location	Notch Type	Qual. Temp	Full Size Values (ft-lbs)	% Shear	Lateral Exp Inches	Drop Weight Break	No Brk
BG-1	Weld	V-Notch	-50°F	104	80	0.078	----	----
BG-2	Weld	V-Notch	-50°F	81	70	0.060	----	----
BG-3	Weld	V-Notch	-50°F	77	70	0.058	----	----
BG-4	HAZ	V-Notch	-50°F	40	30	0.027	----	----
BG-5	HAZ	V-Notch	-50°F	35	30	0.024	----	----
BG-6	HAZ	V-Notch	-50°F	46	40	0.033	----	----

Fillet-Weld Tests

Not Applicable


Result-Satisfactory:	Yes	____	No	____	Pen. into Parent Material:	Yes	____	No	____
Macro-Results:									

Other Tests

Type of Test:	Not Applicable
Other:	Not Applicable

Welder's Name: Keith Breedon **Reg. No.:** W-11618 **Stamp ID:** BG
Tests Conducted By: Qualimet **Lab. Test No.:** 636-13001
Revised By: Qualimet

We hereby recertify that the statements in this record have been revised in accordance with paragraph QW-200.2 are correct and that the test welds were prepared, welded, and tested in accordance with the requirements of Section IX of the ASME Code.

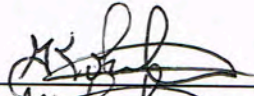Manufacturer: Sub-Arc Systems Inc.
Original Cert. Date: January 20, 2014 **By:** Gary Kohlman 
Recertification Date: October 3, 2014 **By:** Gary Kohlman 



CHARPY IMPACT TEST REPORT

for Procedure Qualification Record # SAS-2-4

Client: Sub-Arc Systems Inc.	Job Number: 636-13001
Address: 4605-47 Street Vermillion AB T9X 1L6	Date: January 20, 2014
Materials: SA-516 Grade 60/70 to SA-516 Grade 60/70	
Size: 0.249" w.t. Plate (machined)	Condition: As Welded
Test Specification: ASME Section IX, ASME Section VIII UG-84, ASTM A-370	
Test Equipment: Satec Model S1-10, S/N: 1164	

Specimen Type: Charpy V-Notch
Qualification Temperature: -50.0°F
Test Temperature: -50.0°F

Specimen Size (mm): 5.2

Sample Set	Sample Number	Actual Impact Energy (ft-lb)	Full Size (ft-lb)	Shear (%)	Lateral Expansion Inches
Weld (includes all processes)	BG-1	54	104	80	0.078
	BG-2	42	81	70	0.060
	BG-3	40	77	70	0.058
	Average:	45	87	73	0.065

We certify that the statements in this record are acceptable and that the specimen(s) were prepared and tested in accordance with the requirements of the current edition of ASTM A370, ASTM E23 and their latest editions.

TEST RESULTS CERTIFIED BY:

Qualimet

Hanibal Ghile, E.I.T.



CHARPY IMPACT TEST REPORT

for Procedure Qualification Record # SAS-2-4

Client: Sub-Arc Systems Inc.	Job Number: 636-13001
Address: 4605-47 Street Vermillion AB T9X 1L6	Date: January 20, 2014
Materials: SA-516 Grade 60/70 to SA-516 Grade 60/70	
Size: 0.249" w.t. Plate (machined)	Condition: As Welded
Test Specification: ASME Section IX, ASME Section VIII UG-84, ASTM A-370	
Test Equipment: Satec Model S1-10, S/N: 1164	

Specimen Type: Charpy V-Notch
Qualification Temperature: -50.0°F
Test Temperature: -50.0°F

Specimen Size (mm): 5.2

Sample Set	Sample Number	Actual Impact Energy (ft-lb)	Full Size (ft-lb)	Shear (%)	Lateral Expansion Inches
HAZ	BG-4	21	40	30	0.027
	BG-5	18	35	30	0.024
	BG-6	24	46	40	0.033
	Average:	21	40	33	0.028

We certify that the statements in this record are acceptable and that the specimen(s) were prepared and tested in accordance with the requirements of the current edition of ASTM A370, ASTM E23 and their latest editions.

TEST RESULTS CERTIFIED BY:

Qualimet

Hanibal Ghile, E.I.T.

Item 6 – Welding Consumable

Contents

1. N/A

Item 7 – Foundation

Contents

1. Foundation Acceptance Report

Item 7 - Foundation Acceptance Report

PROJECT #:	AEM Tank #2 Pad Sand Grade
PROJECT TITLE:	AEM Tank Farm
SITE:	Rankin Inlet , NU
Date:	July 28, 2017

No.	Northing	Easting	Elevation	Description
1	6963697.448	546007.935	0.000	270
3	6963726.036	546030.269	0.000	90
4	6963722.909	546004.808	0.000	180
2	6963700.575	546033.396	0.000	0
5	6963711.742	546019.102	0.000	center
11	6963648.504	546002.922	7.816	BM1
12	6963667.273	546022.542	7.956	BM2
20	6963662.458	546016.328	6.718	nail
100	6963711.698	546019.037	8.233	PAD
101	6963715.178	546021.045	8.198	PAD
102	6963713.312	546022.745	8.196	PAD
103	6963711.476	546023.032	8.194	PAD
104	6963709.701	546022.557	8.188	PAD
105	6963708.140	546020.837	8.186	PAD
106	6963707.859	546017.903	8.193	PAD
107	6963709.297	546015.856	8.194	PAD
108	6963711.861	546015.038	8.188	PAD
109	6963714.849	546016.565	8.188	PAD
110	6963718.123	546014.307	8.164	PAD
111	6963719.743	546019.425	8.167	PAD
112	6963717.700	546024.421	8.164	PAD
113	6963714.725	546026.494	8.158	PAD
114	6963709.295	546026.704	8.164	PAD

Inukshuk Construction Limited

Industrial Contracting



Project Management

PO Box 654
Rankin Inlet, NU X0C 0G0
T 867.645.4030 F 867.645.4064


Item 7 - Foundation Acceptance Report

115	6963705.182	546023.754	8.164	PAD	
116	6963703.695	546019.525	8.166	PAD	
117	6963704.779	546015.018	8.170	PAD	
118	6963708.409	546011.772	8.164	PAD	
119	6963706.886	546008.105	8.134	PAD	
120	6963712.083	546007.038	8.128	PAD	
121	6963717.635	546008.628	8.128	PAD	
122	6963721.388	546011.970	8.128	PAD	
123	6963723.540	546017.010	8.133	PAD	
124	6963723.302	546022.515	8.134	PAD	
125	6963720.466	546027.280	8.131	PAD	
126	6963716.145	546030.254	8.124	PAD	
127	6963710.646	546031.041	8.126	PAD	
128	6963705.524	546029.362	8.128	PAD	
129	6963701.923	546026.064	8.134	PAD	
130	6963700.029	546021.916	8.130	PAD	
131	6963699.785	546017.655	8.136	PAD	
132	6963701.338	546013.053	8.131	PAD	
133	6963704.648	546009.354	8.126	PAD	
134	6963701.326	546004.827	8.084	PAD	→ outter
135	6963698.560	546007.256	8.080	PAD	
136	6963696.498	546010.177	8.075	PAD	
137	6963694.887	546013.707	8.082	PAD	
138	6963694.193	546017.025	8.079	PAD	
139	6963694.063	546020.096	8.084	PAD	
140	6963694.529	546023.186	8.087	PAD	
141	6963695.624	546026.381	8.087	PAD	
142	6963697.302	546029.256	8.083	PAD	
143	6963699.509	546031.814	8.086	PAD	

Item 7 - Foundation Acceptance Report

144	6963702.622	546034.180	8.086	PAD
145	6963706.256	546035.852	8.082	PAD
146	6963710.155	546036.642	8.083	PAD
147	6963714.305	546036.546	8.087	PAD
148	6963718.009	546035.606	8.082	PAD
149	6963721.614	546033.677	8.077	PAD
150	6963724.642	546031.096	8.073	PAD
151	6963727.047	546027.824	8.079	PAD
152	6963728.664	546024.091	8.078	PAD
153	6963729.355	546020.065	8.080	PAD
154	6963729.081	546015.944	8.078	PAD
155	6963727.801	546011.792	8.075	PAD
156	6963725.881	546008.572	8.080	PAD
157	6963723.215	546005.675	8.078	PAD
158	6963720.263	546003.644	8.078	PAD
159	6963716.126	546001.962	8.080	PAD
160	6963712.384	546001.478	8.075	PAD
161	6963708.257	546001.727	8.079	PAD
162	6963704.537	546002.941	8.085	PAD
163	6963701.310	546004.821	8.088	PAD

Tank Pad #2 Sand Top Elevations

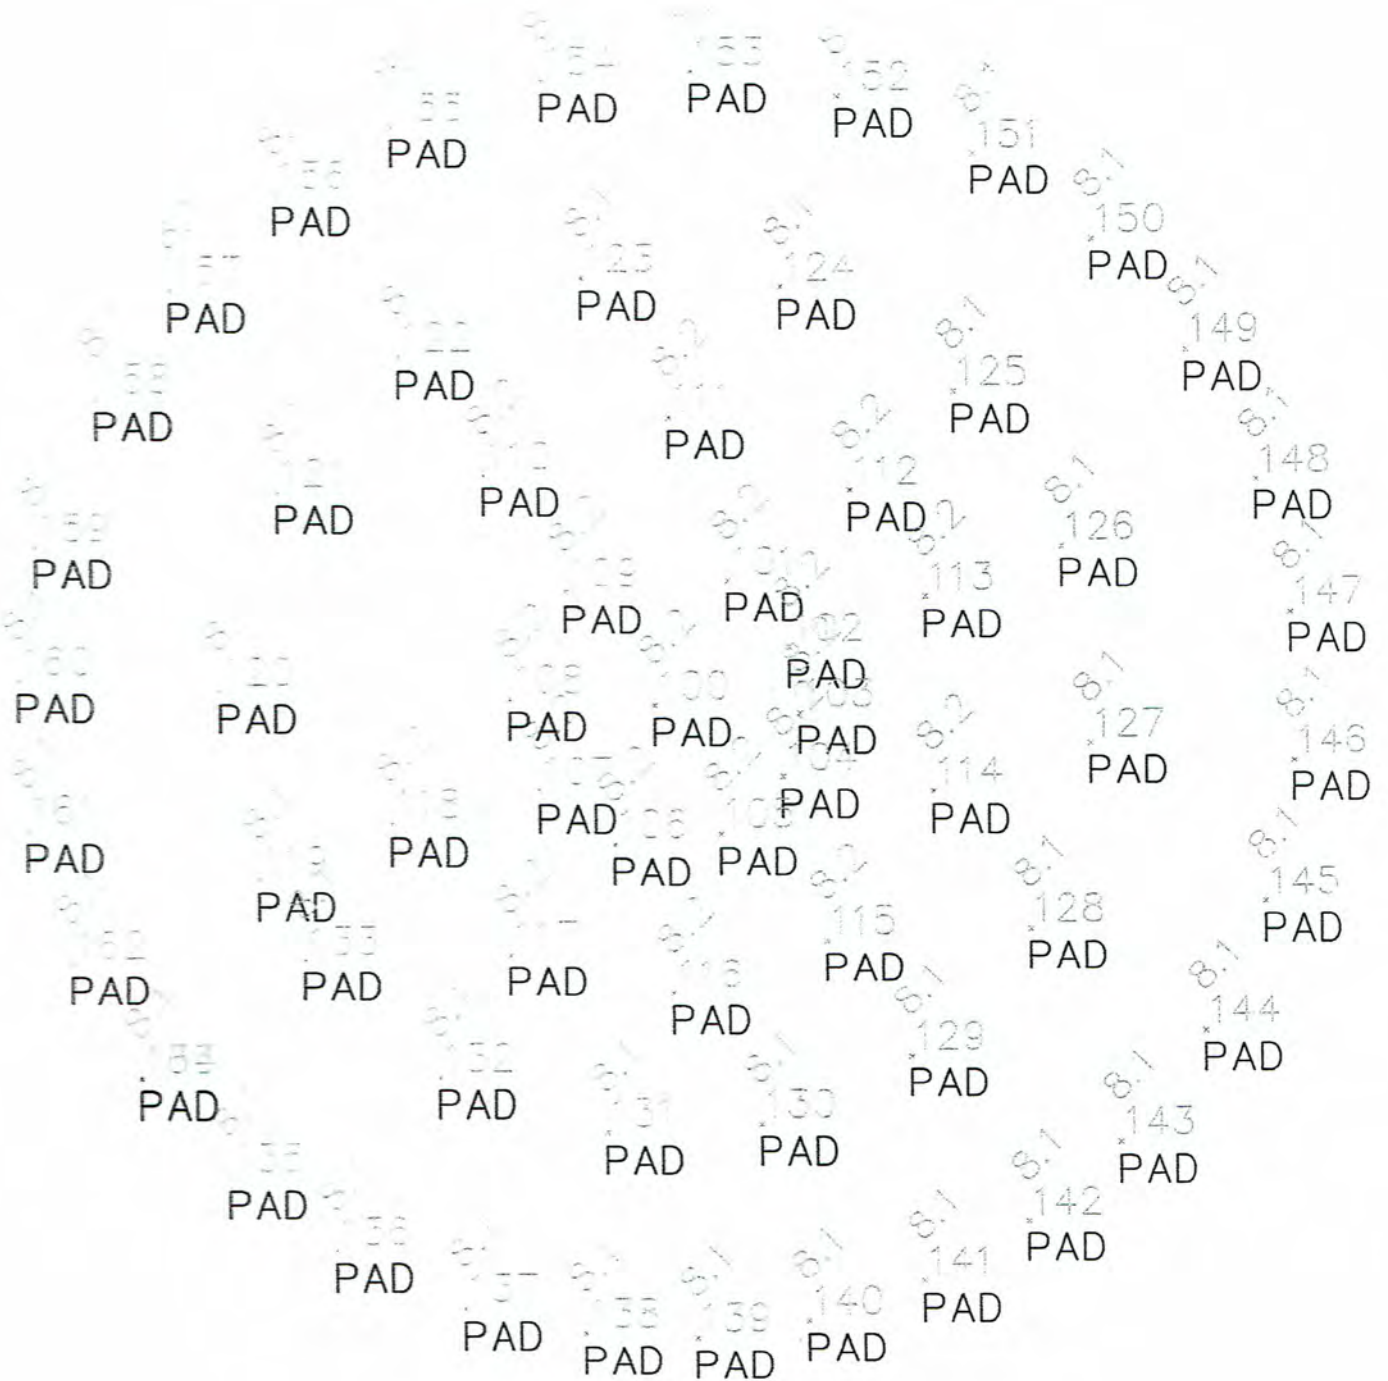

Item 8 – Floor

Contents

1. MTR
2. Weld Map
3. Visual Report
4. Vacuum Box Test Report



Test Certificate

12400 Highway 43 North, Axis, Alabama 36505, US

Item 8 - Floor - MTR

Form TC1: Revision 2: Date 23 Apr 2014

Customer: SAMUEL, SON & CO. LTD 1250 APPLEBY LINE BURLINGTON ON L7L5G6	Customer P.O.No.: C41966 & 41-490196	Mill Order No. 41-491119-13	Shipping Manifest: AR240131
	Product Description: CSA G40.21(2013) 38WT/260WT - CAT 5;LCVN 15FT.LBS,TCVN13FT.LBS@-45F/A673-P ALLOYS API650(12TH ED) TABLE 4-1 GR.IIIA NORMALIZED		Ship Date: 21 Feb 17 Cert Date: 21 Feb 17
	Size: 0.250 X 120.0 X 480.0 (IN)		Cert No: 081597448 (Page 1 of 2)

Tested Pieces:				Tensiles:						Charpy Impact Tests											
Heat Id	Piece Id	Tested Thickness	Tst Loc	YS (KSI)	UTS (KSI)	%RA	Elong % 2in 8in	Tst Dir	Hardness	Abs. Energy(FTLB) 1 2 3 Avg				% Shear 1 2 3 Avg				Tst Tmp	Tst Dir	Tst Siz (mm)	BDWTT Tmp %Shr
E7B102	E11	0.256 (DISCRT)	C							33	44	37	38					-50F	L	5.0	
			C							35	27	34	32					-50F	T	5.0	
E7B102	E12	0.256 (DISCRT)	C							39	40	36	38					-50F	L	5.0	
			C							27	25	22	25					-50F	T	5.0	
E7B102	E13	0.255 (DISCRT)	C	55	76		26	T		35	34	30	33					-50F	L	5.0	
			C							27	44	41	37					-50F	T	5.0	
E7B102	E14	0.256 (DISCRT)	C	55	75		24	T		56	41	58	52					-50F	L	5.0	
			C							27	32	30	30					-50F	T	5.0	
W7B598	E06	0.256 (DISCRT)	C							30	30	30	30					-50F	L	5.0	
			C							37	27	23	29					-50F	T	5.0	
W7B598	E07	0.256 (DISCRT)	C	52	72		25	T													
W7B598	E08	0.256 (DISCRT)	C	51	71		25	T													
W7B598	E10	0.256 (DISCRT)	C							32	40	31	34					-50F	L	5.0	
			C							28	34	28	30					-50F	T	5.0	

Heat Id	Chemical Analysis																ORGN
	C	Mn	P	S	Si	Tot Al	Sol Al	Cu	Ni	Cr	Mo	Cb	V	Ti	B	N	
E7B102	.18	.94	.009	.001	.25	.027	.025	.26	.12	.11	.05	.002	.005	.011	.0002	.0076	USA
W7B598	.18	.92	.009	.001	.24	.028	.022	.26	.13	.08	.05	.001	.004	.011	.0002	.0078	USA

KILLED STEEL

MERCURY IS NOT A METALLURGICAL COMPONENT OF THE STEEL AND NO MERCURY WAS INTENTIONALLY ADDED DURING THE MANUFACTURE OF THIS PRODUCT.

KILLED STEEL, PRODUCED TO A FINE GRAIN PRACTICE

MTR EN 10204:2004 INSPECTION CERTIFICATE 3.1 COMPLIANT

CHARPY FULL SIZE EQUIVALENT = ABSORBED ENERGY AVG X 10 / TEST SIZE IN MM

NORMALIZED PLATES. HEATED AT 1665F FOR 14 MINUTES.

TEST COUPONS TAKEN FROM HEAT TREATED PLATE.

PRODUCTS SHIPPED:

W7B598 E06	6705201	PCES:	1, LBS:	4084	W7B598 E06	6705200	PCES:	1, LBS:	4084
E7B102 E14	6705250	PCES:	1, LBS:	4084	E7B102 E14	6705249	PCES:	1, LBS:	4084
E7B102 E13	6705243	PCES:	1, LBS:	4084	E7B102 E12	6705236	PCES:	1, LBS:	4084
E7B102 E13	6705244	PCES:	1, LBS:	4084	W7B598 E06	6705199	PCES:	1, LBS:	4084
E7B102 E12	6705235	PCES:	1, LBS:	4084	E7B102 E13	6705234	PCES:	1, LBS:	4084
E7B102 E11	6705193	PCES:	1, LBS:	4084	E7B102 E11	6705190	PCES:	1, LBS:	4084

(P)

Cust Part #:

WE HEREBY CERTIFY THAT THIS MATERIAL WAS
TESTED IN ACCORDANCE WITH, AND MEETS THE
REQUIREMENTS OF, THE APPROPRIATE SPECIFICATION

Justin Ward +1 251 662 4400
SENIOR METALLURGIST - PRODUCT



Test Certificate

12400 Highway 43 North, Axis, Alabama 36505, US

Item 8 - Floor - MTR

Form TC1: Revision 2: Date 23 Apr 2014

Customer: SAMUEL, SON & CO. LTD 1250 APPLEBY LINE BURLINGTON ON L7L5G6	Customer P.O.No.: C41966 & 41-490196	Mill Order No. 41-491119-13	Shipping Manifest: AR240131
	Product Description: CSA G40.21(2013) 38WT/260WT - CAT 5;LCVN 15FT.LBS,TCVN13FT.LBS@-45F/A673-P ALLOYS API650(12TH ED) TABLE 4-1 GR.IIIA NORMALIZED		Ship Date: 21 Feb 17 Cert Date: 21 Feb 17
	Size: 0.250 X 120.0 X 480.0 (IN)		Cert No: 081597448 (Page 2 of 2)

Tested Pieces:				Tensiles:						Charpy Impact Tests													
Heat Id	Piece Id	Tested Thickness	Tst Loc	YS (KSI)	UTS (KSI)	%RA	Elong % 2in 8in	Tst Dir	Hardness	Abs. Energy(FTLB) 1 2 3 Avg				% Shear 1 2 3 Avg				Tst Tmp	Tst Dir	Tst Siz (mm)	BDWTT Tmp %Shr		
W7B598 E10	E10	6705178	PCES:	1, LBS:	4084				E7B102 E11	6705183	PCES:	1, LBS:	4084										
W7B598 E10	E10	6705177	PCES:	1, LBS:	4084				W7B598 E10	6705181	PCES:	1, LBS:	4084										
W7B598 E10	E10	6705179	PCES:	1, LBS:	4084				W7B598 E10	6705189	PCES:	1, LBS:	4084										
W7B598 E10	E10	6705186	PCES:	1, LBS:	4084				E7B102 E11	6705172	PCES:	1, LBS:	4084										
E7B102 E11	E11	6705176	PCES:	1, LBS:	4084				W7B598 E10	6705180	PCES:	1, LBS:	4084										
E7B102 E11	E11	6705192	PCES:	1, LBS:	4084				E7B102 E11	6705194	PCES:	1, LBS:	4084										
E7B102 E11	E11	6705184	PCES:	1, LBS:	4084				E7B102 E11	6705185	PCES:	1, LBS:	4084										
W7B598 E06	E06	6705207	PCES:	1, LBS:	4084				W7B598 E06	6705206	PCES:	1, LBS:	4084										
E7B102 E12	E12	6705239	PCES:	1, LBS:	4084				E7B102 E12	6705231	PCES:	1, LBS:	4084										
E7B102 E14	E14	6705247	PCES:	1, LBS:	4084				E7B102 E13	6705242	PCES:	1, LBS:	4084										
E7B102 E14	E14	6705248	PCES:	1, LBS:	4084				E7B102 E12	6705237	PCES:	1, LBS:	4084										
W7B598 E06	E06	6705209	PCES:	1, LBS:	4084				E7B102 E13	6705240	PCES:	1, LBS:	4084										
E7B102 E12	E12	6705238	PCES:	1, LBS:	4084				W7B598 E06	6705198	PCES:	1, LBS:	4084										
E7B102 E14	E14	6705251	PCES:	1, LBS:	4084				W7B598 E06	6705197	PCES:	1, LBS:	4084										
E7B102 E13	E13	6705241	PCES:	1, LBS:	4084				E7B102 E12	6705230	PCES:	1, LBS:	4084										

(P)


Cust Part #:

WE HEREBY CERTIFY THAT THIS MATERIAL WAS
TESTED IN ACCORDANCE WITH, AND MEETS THE
REQUIREMENTS OF, THE APPROPRIATE SPECIFICATION




Justin Ward +1 251 662 4400
SENIOR METALLURGIST - PRODUCT

Item 8 - Floor -Weld Map

PARTS LIST			
ITEM	QTY	DESCRIPTION	MATERIAL
F2A	37	PL 6.35 X 3048 X 6096	G40.21M-260WT
F2B	2	PL 6.35 X 3048 X 2514	G40.21M-260WT
F2C	4	PL 6.35 X 3048 X 5480	G40.21M-260WT
F2D	4	PL 6.35 X 3048 X 1931	G40.21M-260WT
F2E	4	PL 6.35 X 3048 X3866	G40.21M-260WT
F2F	4	PL 6.35 X 3048 X 5094	G40.21M-260WT
F2G	4	PL 6.35 X 3048 X 5895	G40.21M-260WT
F2H	4	PL 6.35 X 3048 X 5485	G40.21M-260WT
F2I	4	PL 6.35 X 3131 X 845	G40.21M-260WT
F2J	2	PL 6.35 X 838 X 6096	G40.21M-260WT

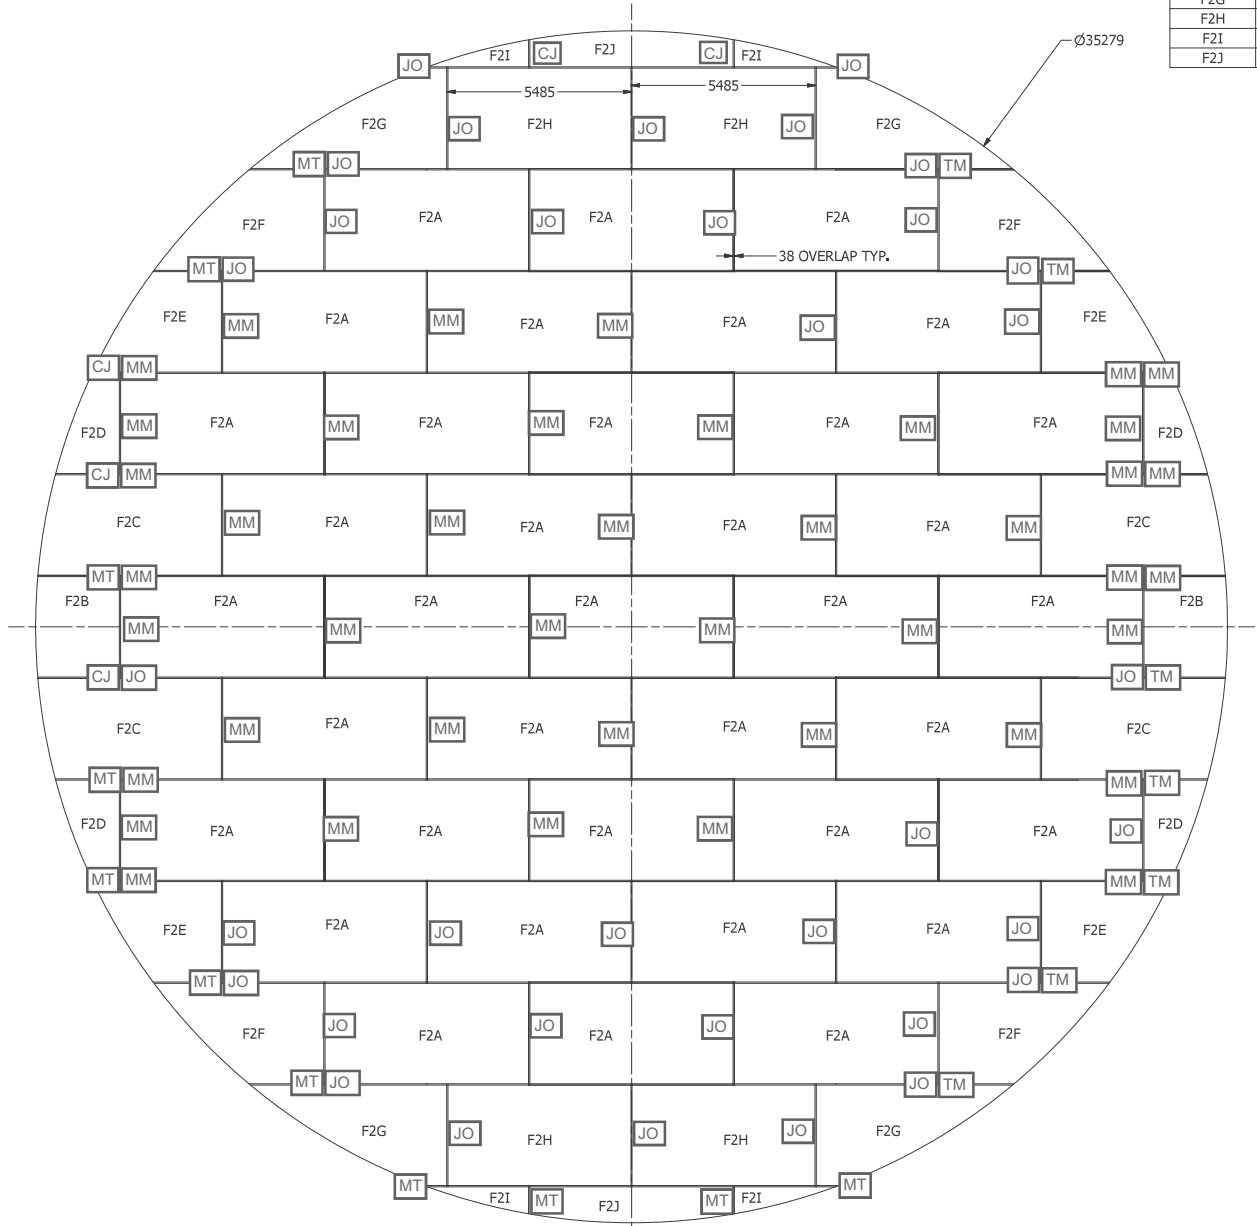

TANK 2 (13.5ML) FLOOR LAYOUT
SCALE 1 / 100

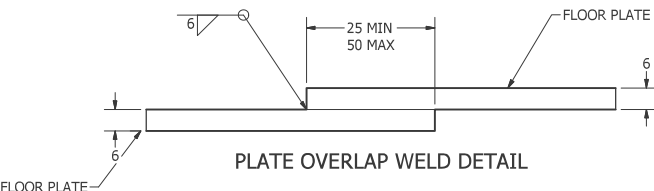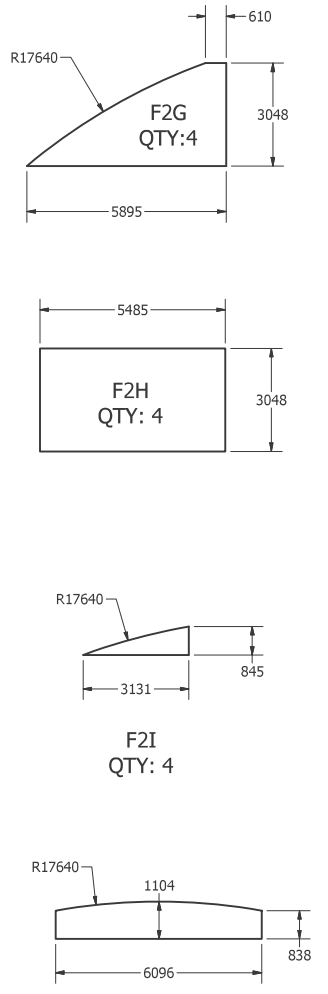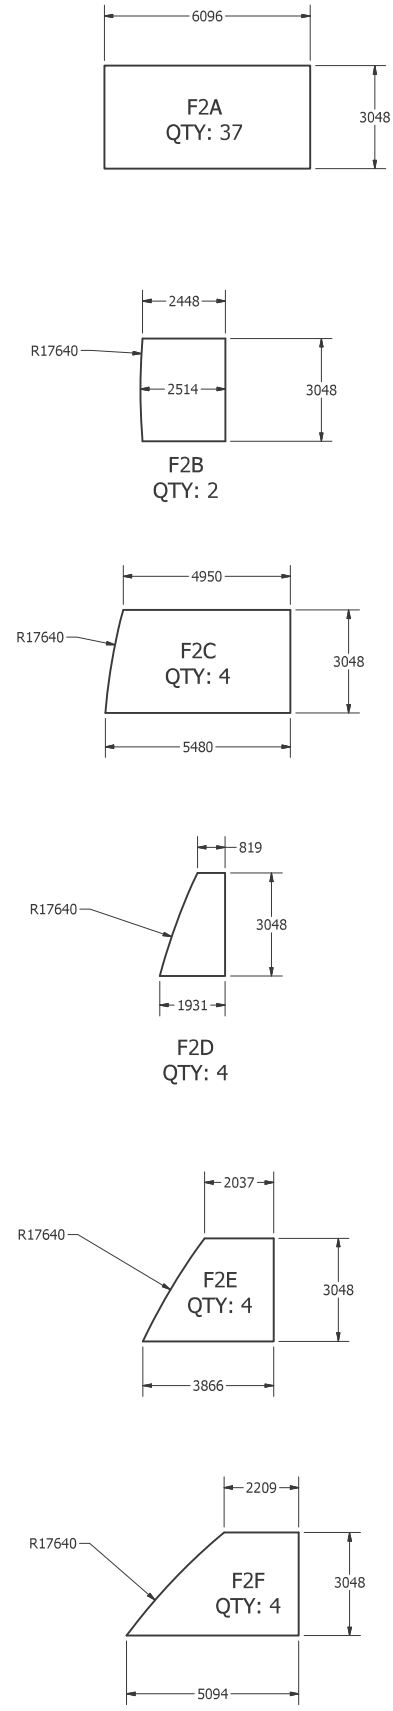

NOTE - PER API-650 5.1.5.4 - BOTTOM PLATES UNDER THE SHELL SHALL HAVE THE OUTER ENDS OF THE JOINTS FITTED AND LAP-WELDED TO FORM A SMOOTH BEARING SURFACE.



Permit Number: P471

DRAWN JACOB SAUNDERS	1/10/2017	TK #2 (13.5ML) - FLOOR LAYOUT	
CHECKED MARC LOSIER	3/14/2017	TITLE	
QA		MELIADINE FIELD ERECTED TANKS - TANK #2 (13.5ML) FLOOR AND ROOF LAYOUT	
MFG			
APPROVED			
		SIZE A1	DWG NO 295-M2
		SCALE 1 / 100	REV 1
		SHEET 1 OF 2	

Exhibit 15c, Rev 1

QUALITY CONTROL MANUAL

VISUAL TEST REPORT

Customer: Agnico Eagle

Location: Rankin Inlet

Code Requiring Test: API 650 (section 8.5.2)

Reason for Test: New Construction

A weld shall be acceptable by visual examination if the inspection shows the following.

- There are no crater cracks, other surface cracks or arc strikes in or adjacent to the welded joints.
- Maximum permissible undercut is 0.4 mm (1/64 in.) in depth for vertical butt joints, vertically oriented permanent attachments, attachment welds for nozzles, manholes, flush-type openings, and the inside shell-to-bottom welds. For horizontal butt joints, horizontally oriented permanent attachments, and annular-ring butt joints, the maximum permissible undercut is 0.8 mm (1/32 in.) in depth.
- The frequency of surface porosity in the weld does not exceed one cluster (one or more pores) in any 100 mm (4 in.) of length, and the diameter of each cluster does not exceed 2.5 mm (3/32 in.).
- The reinforcement of the welds on all thicknesses:

Plate Thickness mm (in.)	Maximum Reinforcement Thickness mm (in.)	
	Vertical Joints	Horizontal Joints
≤ 13 (1/2)	2.5 (3/32)	3 (1/8)
> 13 (1/2) to 25 (1)	3 (1/8)	5 (3/16)
> 25 (1)	5 (3/16)	6 (1/4)

Surface Condition (As Welded)

Test Solution: N/A

Test Date(s):

Tested by:

Ambient Conditions:

Items Tested:

FLOOR WELDS.

Results:

ALL FLOOR WELD VISUALLY TESTED. ALL WELDS
ACCEPTABLE.Sub-Arc Representative Signature: Math MacKerDate: Aug 31/17Client Representative Signature: Olson BonicaDate: Sept 04/17

Client Signature: _____

Date: _____

Sub-Arc Systems Inc.

4605-47 Street
Vermillion, AB, T9X 1L6
780-608-9589

QUALITY CONTROL MANUAL

Exhibit 14, Rev 1

VACUUM BOX TEST REPORT – FLOOR PLATE WELDS

Customer: AGNICO EAGLELocation: RANKIN INLET TANK #2Equipment Tag No.: N/AEquipment Description: N/A

Code Requiring Test: API 650

Reason for Test: New Construction

(A vacuum box/soap solution test for floor plate weld seams is required for new construction or major alterations, no visible leaks should be observed)

Test Solution: Water / Snoop

Ambient Conditions: 10°Test Date(s): AUG 7/17Surface Condition: CLEANTested by: NAT MACKENZIESurface Test Temperature: 10°

Pressure Gauge:

Items Tested:

FLOOR WELDS.

Results:

ALL FLOOR WELDS WERE VACUUM BOX TESTEDONE LEAK WAS DETECTED. AREA WAS FIXED, THEN RE-TESTED.
NO FURTHER LEAKS WERE FOUND.Sub-Arc Representative Signature: [Signature] Date: AUG 7/17

Client Representative Signature: _____ Date: _____

Client Signature: Clem Bonin CLEM BONIN Date: aug 23/17

Item 9 – Shell to Floor Seams

Contents

1. Initial and Final Pass Weld Map
2. Visual Report
3. Diesel Test – Leak Test Report



QUALITY CONTROL MANUAL

Exhibit 15c, Rev 1

VISUAL TEST REPORT

Customer: Agnico Eagle

Location: Rankin Inlet

Code Requiring Test: API 650 (section 8.5.2)

Reason for Test: New Construction

A weld shall be acceptable by visual examination if the inspection shows the following.

- There are no crater cracks, other surface cracks or arc strikes in or adjacent to the welded joints.
- Maximum permissible undercut is 0.4 mm (1/64 in.) in depth for vertical butt joints, vertically oriented permanent attachments, attachment welds for nozzles, manholes, flush-type openings, and the inside shell-to-bottom welds. For horizontal butt joints, horizontally oriented permanent attachments, and annular-ring butt joints, the maximum permissible undercut is 0.8 mm (1/32 in.) in depth.
- The frequency of surface porosity in the weld does not exceed one cluster (one or more pores) in any 100 mm (4 in.) of length, and the diameter of each cluster does not exceed 2.5 mm (3/32 in.).
- The reinforcement of the welds on all thicknesses:

Plate Thickness mm (in.)	Maximum Reinforcement Thickness mm (in.)	
	Vertical Joints	Horizontal Joints
≤ 13 (1/2)	2.5 (3/32)	3 (1/8)
> 13 (1/2) to 25 (1)	3 (1/8)	5 (3/16)
> 25 (1)	≤ 3 (3/16)	6 (3/4)

Surface Condition (As Welded)

Test Solution: N/A

Test Date(s): Aug 18/17

Tested by: MATT MACKENZIE

Ambient Conditions: 9°

Items Tested:

SHELL TO FLOOR WELD.

Results:

SHELL TO FLOOR WELD VISUALLY INSPECTED.NO DEFECTS WERE FOUND ALL WELDS ACCEPTABLE.Sub-Arc Representative Signature: [Signature] Date: Aug 18/17.

Client Representative Signature: _____ Date: _____

Client Signature: Chaim CLEM BONTA Date: Aug 23/17

Sub-Arc Systems Inc.

4605-47 Street
Vermillion, AB, T9X 1L6
780-608-9589

QUALITY CONTROL MANUAL

Exhibit 15a, Rev 1

DIESEL TEST REPORT (SHELL TO BOTTOM WELD)

Customer: Agnico Eagle

Location: Rankin Inlet

Tank #2

Equipment Tag No.: N/A

Equipment Type: N/A

Equipment Description: N/A

Code Requiring Test: API 650 (section 7.2.4)

Reason for Test: New Construction

(The initial weld pass inside the shell shall have all slag and non-metals removed from the surface of the weld and then examined for its entire circumference both visually and applying a high Flash-point penetrating oil such as light diesel to the gap between the shell and the bottom, letting stand for at least four hours, and examining the weld for evidence of wicking.)

Surface Condition (As Welded)

Test Solution: Diesel

Test Date(s):

Aug 4/17

Tested by: Matt MacKerrie

Ambient Conditions:

12°C


Items Tested:

Shell to bottom weld.

Results:

No leaks were found at time of inspection.

Sub-Arc Representative Signature:

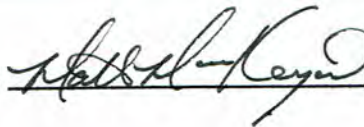

Date:

Aug 4/17

Client Representative Signature:

Date:

Client Signature:

Clem Bonita Bonita

Date:

Aug 23/17

Item 10 - Shell

Contents

1. MTR
2. Roundness Dimension Report (SAS)
3. Roundness Dimension Report (AmSpec)
4. Weld Map and MTR Traceability, Visual Report
5. Dimension Reports – Banding
6. Dimension Reports – Peaking
7. Dimension Reports – Plumbness
8. Diesel Test Reports
9. UT Report (3rd Party)



Item 10 - Shell - MTR

Test Certificate

12400 Highway 43 North, Axis, Alabama 36505, US

Form TC1: Revision 2: Date 23 Apr 2014

Customer: SAMUEL, SON & CO. LTD 1250 APPLEBY LINE BURLINGTON ON L7L5G6				Customer P.O.No.: C41966 & 41-490196				Mill Order No. 41-491119-06				Shipping Manifest: AR239887																													
				Product Description: CSA G40.21(2013) 38WT/260WT - CAT 5;LCVN 15FT.LBS,TCVN13FT.LBS@-45F/A673-P ALLOYS API650(12TH ED) TABLE 4-1 GR.IIIA NORMALIZED								Ship Date: 16 Feb 17 Cert Date: 16 Feb 17				Cert No: 081596751 (Page 1 of 1)																									
				Size: 0.562 X 113.0 X 365.0 (IN)																																					
Tested Pieces:				Tensiles:				Charpy Impact Tests																																	
Heat Id	Piece Id	Tested Thickness	Tst Loc	YS (KSI)	UTS (KSI)	%RA	Elong % 2in 8in	Tst Dir	Hardness	Abs. Energy(FTLB) 1 2 3 Avg				% Shear 1 2 3 Avg				Tst Tmp	Tst Dir	Tst Siz (mm)	BDWTT Tmp %Shr																				
E7B111	B15	0.568 (DISCRT)	C 51 C	72			26	T		114 106 131 117 76 81 74 77									-45F -45F	L T	10. 10.																				
Heat Id				Chemical Analysis																ORGN																					
				C	Mn	P	S	Si	Tot Al	Sol Al	Cu	Ni	Cr	Mo	Cb	V	Ti	B	N																						
E7B111				.18	.92	.010	<.001	.24	.027	.026	.26	.14	.11	.04	.002	.005	.011	.0002	.0074	USA																					
KILLED STEEL MERCURY IS NOT A METALLURGICAL COMPONENT OF THE STEEL AND NO MERCURY WAS INTENTIONALLY ADDED DURING THE MANUFACTURE OF THIS PRODUCT. KILLED STEEL, PRODUCED TO A FINE GRAIN PRACTICE MTR EN 10204:2004 INSPECTION CERTIFICATE 3.1 COMPLIANT NORMALIZED PLATES. HEATED AT 1665F FOR 26 MINUTES. TEST COUPONS TAKEN FROM HEAT TREATED PLATE. PRODUCTS SHIPPED: <table><tr><td>E7B111 B15</td><td>6704705</td><td>PCES:</td><td>1, LBS:</td><td>6574</td><td>E7B111 B15</td><td>6704706</td><td>PCES:</td><td>1, LBS:</td><td>6574</td></tr><tr><td>E7B111 B15</td><td>6704704</td><td>PCES:</td><td>1, LBS:</td><td>6574</td><td>E7B111 B15</td><td>6704707</td><td>PCES:</td><td>1, LBS:</td><td>6574</td></tr></table>																						E7B111 B15	6704705	PCES:	1, LBS:	6574	E7B111 B15	6704706	PCES:	1, LBS:	6574	E7B111 B15	6704704	PCES:	1, LBS:	6574	E7B111 B15	6704707	PCES:	1, LBS:	6574
E7B111 B15	6704705	PCES:	1, LBS:	6574	E7B111 B15	6704706	PCES:	1, LBS:	6574																																
E7B111 B15	6704704	PCES:	1, LBS:	6574	E7B111 B15	6704707	PCES:	1, LBS:	6574																																
(P) Cust Part #:										WE HEREBY CERTIFY THAT THIS MATERIAL WAS TESTED IN ACCORDANCE WITH, AND MEETS THE REQUIREMENTS OF, THE APPROPRIATE SPECIFICATION										Justin Ward +1 251 662 4400 SENIOR METALLURGIST - PRODUCT																					



Item 10 - Shell - MTR

Test Certificate

Form TC1: Revision 2: Date 23 Apr 2014

12400 Highway 43 North, Axis, Alabama 36505, US

Customer: SAMUEL, SON & CO. LTD 1250 APPLEBY LINE BURLINGTON ON L7L5G6				Customer P.O.No.: C41966 & 41-490196				Mill Order No. 41-491119-06				Shipping Manifest: AR239891																																																											
				Product Description: CSA G40.21(2013) 38WT/260WT - CAT 5;LCVN 15FT.LBS,TCVN13FT.LBS@-45F/A673-P ALLOYS API650(12TH ED) TABLE 4-1 GR.IIIA NORMALIZED Size: 0.562 X 113.0 X 365.0 (IN)								Ship Date: 16 Feb 17 Cert Date: 16 Feb 17				Cert No: 081596775 (Page 1 of 1)																																																							
Tested Pieces:				Tensiles:				Charpy Impact Tests																																																															
Heat Id	Piece Id	Tested Thickness	Tst Loc	YS (KSI)	UTS (KSI)	%RA	Elong % 2in 8in	Tst Dir	Hardness	Abs. Energy(FTLB) 1 2 3 Avg				% Shear 1 2 3 Avg				Tst Tmp	Tst Dir	Tst Siz (mm)	BDWTT Tmp %Shr																																																		
E7B111	B15	0.568 (DISCRT)	C	51	72		26	T		114	106	131	117					-45F	L	10.																																																			
			C							76	81	74	77					-45F	T	10.																																																			
E7B111	B16	0.568 (DISCRT)	C	50	72		27	T		135	123	122	127					-45F	L	10.																																																			
			C							112	84	96	97					-45F	T	10.																																																			
Heat Id																					Chemical Analysis										ORGN																																								
																					C	Mn	P	S	Si	Tot Al	Sol Al	Cu	Ni	Cr	Mo	Cb	V	Ti	B	N																																			
E7B111																					.18	.92	.010	<.001	.24	.027	.026	.26	.14	.11	.04	.002	.005	.011	.0002	.0074	USA																																		
KILLED STEEL MERCURY IS NOT A METALLURGICAL COMPONENT OF THE STEEL AND NO MERCURY WAS INTENTIONALLY ADDED DURING THE MANUFACTURE OF THIS PRODUCT. KILLED STEEL, PRODUCED TO A FINE GRAIN PRACTICE MTR EN 10204:2004 INSPECTION CERTIFICATE 3.1 COMPLIANT NORMALIZED PLATES. HEATED AT 1665F FOR 26 MINUTES. TEST COUPONS TAKEN FROM HEAT TREATED PLATE. PRODUCTS SHIPPED: <table><tr><td>E7B111 B16</td><td>6704877</td><td>PCES:</td><td>1, LBS:</td><td>6574</td><td>E7B111 B15</td><td>6704876</td><td>PCES:</td><td>1, LBS:</td><td>6574</td></tr><tr><td>E7B111 B15</td><td>6704866</td><td>PCES:</td><td>1, LBS:</td><td>6574</td><td>E7B111 B15</td><td>6704867</td><td>PCES:</td><td>1, LBS:</td><td>6574</td></tr><tr><td>E7B111 B15</td><td>6704865</td><td>PCES:</td><td>1, LBS:</td><td>6574</td><td>E7B111 B15</td><td>6704864</td><td>PCES:</td><td>1, LBS:</td><td>6574</td></tr><tr><td>E7B111 B15</td><td>6704708</td><td>PCES:</td><td>1, LBS:</td><td>6574</td><td>E7B111 B16</td><td>6704878</td><td>PCES:</td><td>1, LBS:</td><td>6574</td></tr></table>																					E7B111 B16	6704877	PCES:	1, LBS:	6574	E7B111 B15	6704876	PCES:	1, LBS:	6574	E7B111 B15	6704866	PCES:	1, LBS:	6574	E7B111 B15	6704867	PCES:	1, LBS:	6574	E7B111 B15	6704865	PCES:	1, LBS:	6574	E7B111 B15	6704864	PCES:	1, LBS:	6574	E7B111 B15	6704708	PCES:	1, LBS:	6574	E7B111 B16	6704878	PCES:	1, LBS:	6574											
E7B111 B16	6704877	PCES:	1, LBS:	6574	E7B111 B15	6704876	PCES:	1, LBS:	6574																																																														
E7B111 B15	6704866	PCES:	1, LBS:	6574	E7B111 B15	6704867	PCES:	1, LBS:	6574																																																														
E7B111 B15	6704865	PCES:	1, LBS:	6574	E7B111 B15	6704864	PCES:	1, LBS:	6574																																																														
E7B111 B15	6704708	PCES:	1, LBS:	6574	E7B111 B16	6704878	PCES:	1, LBS:	6574																																																														
(P) Cust Part #:										WE HEREBY CERTIFY THAT THIS MATERIAL WAS TESTED IN ACCORDANCE WITH, AND MEETS THE REQUIREMENTS OF, THE APPROPRIATE SPECIFICATION										Justin Ward +1 251 662 4400 SENIOR METALLURGIST - PRODUCT																																																			

SSAB**Test Certificate**

Form TC1: Revision 2: Date 23 Apr 2014

12400 Highway 43 North, Axis, Alabama 36505, US

Customer: SAMUEL, SON & CO. LTD 1250 APPLEBY LINE BURLINGTON ON L7L5G6				Customer P.O.No.: C41966 & 41-490196				Mill Order No. 41-491119-08				Shipping Manifest: AR239887									
				Product Description: CSA G40.21(2013) 38WT/260WT - CAT 5;LCVN 15FT.LBS,TCVN13FT.LBS@-45F/A673-P ALLOYS API650(12TH ED) TABLE 4-1 GR.IIIA NORMALIZED				Ship Date: 16 Feb 17				Cert No: 081596752 (Page 1 of 1)									
				Size: 0.437 X 113.0 X 365.0 (IN)																	
Tested Pieces:				Tensiles:				Charpy Impact Tests													
Heat Id	Piece Id	Tested Thickness	Tst Loc	YS (KSI)	UTS (KSI)	%RA	Elong % 2in 8in	Tst Dir	Hardness	Abs. Energy(FTLB) 1 2 3 Avg				% Shear 1 2 3 Avg				Tst Tmp	Tst Dir	Tst Siz (mm)	BDWTT Tmp %Shr
E7B111	B14	0.443 (DISCRT)	C	53	74		27	T		143	155	114	137			-45F	L	10.			
			C							90	102	80	91			-45F	T	10.			
W7B608	B11	0.442 (DISCRT)	C	53	75		26	T		121	122	118	120			-50F	L	10.			
			C							104	93	51	83			-50F	T	10.			
Chemical Analysis																					
Heat Id	C	Mn	P	S	Si	Tot Al	Sol Al	Cu	Ni	Cr	Mo	Cb	V	Ti	B	N	ORGN				
E7B111	.18	.92	.010	<.001	.24	.027	.026	.26	.14	.11	.04	.002	.005	.011	.0002	.0074	USA				
W7B608	.18	.92	.008	.001	.24	.027	.026	.26	.18	.10	.05	.001	.005	.011	.0002	.0079	USA				
KILLED STEEL MERCURY IS NOT A METALLURGICAL COMPONENT OF THE STEEL AND NO MERCURY WAS INTENTIONALLY ADDED DURING THE MANUFACTURE OF THIS PRODUCT. KILLED STEEL, PRODUCED TO A FINE GRAIN PRACTICE MTR EN 10204:2004 INSPECTION CERTIFICATE 3.1 COMPLIANT NORMALIZED PLATES. HEATED AT 1665F FOR 21 MINUTES. TEST COUPONS TAKEN FROM HEAT TREATED PLATE. PRODUCTS SHIPPED: W7B608 B11 6704648 PCES: 1, LBS: 5112 W7B608 B11 6704649 PCES: 1, LBS: 5112 E7B111 B14 6704652 PCES: 1, LBS: 5112																					
(P) Cust Part #:										WE HEREBY CERTIFY THAT THIS MATERIAL WAS TESTED IN ACCORDANCE WITH, AND MEETS THE REQUIREMENTS OF, THE APPROPRIATE SPECIFICATION											
										<u>Justin Ward +1 251 662 4400</u> SENIOR METALLURGIST - PRODUCT											



Item 10 - Shell - MTR

Test Certificate

Form TC1: Revision 2: Date 23 Apr 2014

12400 Highway 43 North, Axis, Alabama 36505, US

Customer: SAMUEL, SON & CO. LTD 1250 APPLEBY LINE BURLINGTON ON L7L5G6				Customer P.O.No.: C41966 & 41-490196				Mill Order No. 41-491119-08				Shipping Manifest: AR239886																																							
				Product Description: CSA G40.21(2013) 38WT/260WT - CAT 5;LCVN 15FT.LBS,TCVN13FT.LBS@-45F/A673-P ALLOYS API650(12TH ED) TABLE 4-1 GR.IIIA NORMALIZED								Ship Date: 16 Feb 17				Cert No: 081596745 (Page 1 of 1)																																			
												Size: 0.437 X 113.0 X 365.0 (IN)																																							
Tested Pieces:				Tensiles:				Charpy Impact Tests																																											
Heat Id	Piece Id	Tested Thickness	Tst Loc	YS (KSI)	UTS (KSI)	%RA	Elong % 2in 8in	Tst Dir	Hardness	Abs. Energy(FTLB) 1 2 3 Avg				% Shear 1 2 3 Avg				Tst Tmp	Tst Dir	Tst Siz (mm)	BDWTT Tmp %Shr																														
E7B111	B14	0.443 (DISCRT)	C	53	74		27	T		143	155	114	137					-45F	L	10.																															
W7B608	B11	0.442 (DISCRT)	C	53	75		26	T		90	102	80	91					-45F	T	10.																															
			121							122	118	120					-50F	L	10.																																
			104							93	51	83					-50F	T	10.																																
Heat Id				Chemical Analysis														ORGN																																	
				C	Mn	P	S	Si	Tot Al	Sol Al	Cu	Ni	Cr	Mo	Cb	V	Ti	B	N																																
E7B111				.18	.92	.010	<.001	.24	.027	.026	.26	.14	.11	.04	.002	.005	.011	.0002	.0074	USA																															
W7B608				.18	.92	.008	.001	.24	.027	.026	.26	.18	.10	.05	.001	.005	.011	.0002	.0079	USA																															
KILLED STEEL MERCURY IS NOT A METALLURGICAL COMPONENT OF THE STEEL AND NO MERCURY WAS INTENTIONALLY ADDED DURING THE MANUFACTURE OF THIS PRODUCT. KILLED STEEL, PRODUCED TO A FINE GRAIN PRACTICE MTR EN 10204:2004 INSPECTION CERTIFICATE 3.1 COMPLIANT NORMALIZED PLATES. HEATED AT 1665F FOR 21 MINUTES. TEST COUPONS TAKEN FROM HEAT TREATED PLATE. PRODUCTS SHIPPED: <table><tr><td>E7B111 B14</td><td>6704428</td><td>PCES:</td><td>1, LBS:</td><td>5112</td><td>W7B608 B11</td><td>6704660</td><td>PCES:</td><td>1, LBS:</td><td>5112</td></tr><tr><td>W7B608 B11</td><td>6704659</td><td>PCES:</td><td>1, LBS:</td><td>5112</td><td>W7B608 B11</td><td>6704657</td><td>PCES:</td><td>1, LBS:</td><td>5112</td></tr><tr><td>W7B608 B11</td><td>6704658</td><td>PCES:</td><td>1, LBS:</td><td>5112</td><td>W7B608 B11</td><td>6704656</td><td>PCES:</td><td>1, LBS:</td><td>5112</td></tr></table>																						E7B111 B14	6704428	PCES:	1, LBS:	5112	W7B608 B11	6704660	PCES:	1, LBS:	5112	W7B608 B11	6704659	PCES:	1, LBS:	5112	W7B608 B11	6704657	PCES:	1, LBS:	5112	W7B608 B11	6704658	PCES:	1, LBS:	5112	W7B608 B11	6704656	PCES:	1, LBS:	5112
E7B111 B14	6704428	PCES:	1, LBS:	5112	W7B608 B11	6704660	PCES:	1, LBS:	5112																																										
W7B608 B11	6704659	PCES:	1, LBS:	5112	W7B608 B11	6704657	PCES:	1, LBS:	5112																																										
W7B608 B11	6704658	PCES:	1, LBS:	5112	W7B608 B11	6704656	PCES:	1, LBS:	5112																																										
(P) Cust Part #:										WE HEREBY CERTIFY THAT THIS MATERIAL WAS TESTED IN ACCORDANCE WITH, AND MEETS THE REQUIREMENTS OF, THE APPROPRIATE SPECIFICATION												Justin Ward +1 251 662 4400 SENIOR METALLURGIST - PRODUCT																													



Item 10 - Shell - MTR

Test Certificate

Form TC1: Revision 2: Date 23 Apr 2014

12400 Highway 43 North, Axis, Alabama 36505, US

Customer: SAMUEL, SON & CO. LTD 1250 APPLEBY LINE BURLINGTON ON L7L5G6				Customer P.O.No.: C41966 & 41-490196				Mill Order No. 41-491119-08				Shipping Manifest: AR239888			
				Product Description: CSA G40.21(2013) 38WT/260WT - CAT 5;LCVN 15FT.LBS,TCVN13FT.LBS@-45F/A673-P ALLOYS API650(12TH ED) TABLE 4-1 GR.IIIA NORMALIZED								Ship Date: 16 Feb 17 Cert Date: 16 Feb 17		Cert No: 081596755 (Page 1 of 1)	
				Size: 0.437 X 113.0 X 365.0 (IN)											

Tested Pieces:				Tensiles:					Charpy Impact Tests												
Heat Id	Piece Id	Tested Thickness	Tst Loc	YS (KSI)	UTS (KSI)	%RA	Elong % 2in 8in	Tst Dir	Hardness	Abs. Energy(FTLB)				% Shear				Tst Tmp	Tst Dir	Tst Siz (mm)	BDWTT Tmp %Shr
										1	2	3	Avg	1	2	3	Avg				
E7B111	B14	0.443 (DISCRT)	C	53	74		27	T		143	155	114	137					-45F	L	10.	
			C							90	102	80	91					-45F	T	10.	
W7B608	B11	0.442 (DISCRT)	C	53	75		26	T		121	122	118	120					-50F	L	10.	
			C							104	93	51	83					-50F	T	10.	

Heat Id	Chemical Analysis																ORGN
	C	Mn	P	S	Si	Tot Al	Sol Al	Cu	Ni	Cr	Mo	Cb	V	Ti	B	N	
E7B111	.18	.92	.010	<.001	.24	.027	.026	.26	.14	.11	.04	.002	.005	.011	.0002	.0074	USA
W7B608	.18	.92	.008	.001	.24	.027	.026	.26	.18	.10	.05	.001	.005	.011	.0002	.0079	USA

KILLED STEEL
 MERCURY IS NOT A METALLURGICAL COMPONENT OF THE STEEL AND NO MERCURY WAS INTENTIONALLY ADDED DURING THE MANUFACTURE OF THIS PRODUCT.
 KILLED STEEL, PRODUCED TO A FINE GRAIN PRACTICE
 MTR EN 10204:2004 INSPECTION CERTIFICATE 3.1 COMPLIANT
 NORMALIZED PLATES. HEATED AT 1665F FOR 21 MINUTES.
 TEST COUPONS TAKEN FROM HEAT TREATED PLATE.
 PRODUCTS SHIPPED:
 E7B111 B14 6704427 PCES: 1, LBS: 5112 W7B608 B11 6704442 PCES: 1, LBS: 5112

(P)	Cust Part #:	WE HEREBY CERTIFY THAT THIS MATERIAL WAS	<u>Justin Ward +1 251 662 4400</u> SENIOR METALLURGIST - PRODUCT
		TESTED IN ACCORDANCE WITH, AND MEETS THE	
		REQUIREMENTS OF, THE APPROPRIATE SPECIFICATION	



Item 10 - Shell - MTR

Test Certificate

Form TC1: Revision 2: Date 23 Apr 2014

12400 Highway 43 North, Axis, Alabama 36505, US

Customer: SAMUEL, SON & CO. LTD 1250 APPLEBY LINE BURLINGTON ON L7L5G6		Customer P.O.No.: C41966 & 41-490196		Mill Order No. 41-491119-08		Shipping Manifest: AR239887															
		Product Description: CSA G40.21(2013) 38WT/260WT - CAT 5;LCVN 15FT.LBS,TCVN13FT.LBS@-45F/A673-P ALLOYS API650(12TH ED) TABLE 4-1 GR.IIIA NORMALIZED		Ship Date: 16 Feb 17		Cert No: 081596752 (Page 1 of 1)															
		Size: 0.437 X 113.0 X 365.0 (IN)																			
Tested Pieces:				Tensiles:				Charpy Impact Tests													
Heat Id	Piece Id	Tested Thickness	Tst Loc	YS (KSI)	UTS (KSI)	%RA	Elong % 2in 8in	Tst Dir	Hardness	Abs. Energy(FTLB) 1 2 3 Avg				% Shear 1 2 3 Avg				Tst Tmp	Tst Dir	Tst Siz (mm)	BDWTT Tmp %Shr
E7B111	B14	0.443 (DISCRT)	C	53	74		27	T		143	155	114	137				-45F	L	10.		
			C							90	102	80	91				-45F	T	10.		
W7B608	B11	0.442 (DISCRT)	C	53	75		26	T		121	122	118	120				-50F	L	10.		
			C							104	93	51	83				-50F	T	10.		
Chemical Analysis																					
Heat Id	C	Mn	P	S	Si	Tot Al	Sol Al	Cu	Ni	Cr	Mo	Cb	V	Ti	B	N	ORGN				
E7B111	.18	.92	.010	<.001	.24	.027	.026	.26	.14	.11	.04	.002	.005	.011	.0002	.0074	USA				
W7B608	.18	.92	.008	.001	.24	.027	.026	.26	.18	.10	.05	.001	.005	.011	.0002	.0079	USA				
KILLED STEEL MERCURY IS NOT A METALLURGICAL COMPONENT OF THE STEEL AND NO MERCURY WAS INTENTIONALLY ADDED DURING THE MANUFACTURE OF THIS PRODUCT. KILLED STEEL, PRODUCED TO A FINE GRAIN PRACTICE MTR EN 10204:2004 INSPECTION CERTIFICATE 3.1 COMPLIANT NORMALIZED PLATES. HEATED AT 1665F FOR 21 MINUTES. TEST COUPONS TAKEN FROM HEAT TREATED PLATE. PRODUCTS SHIPPED: W7B608 B11 6704648 PCES: 1, LBS: 5112 W7B608 B11 6704649 PCES: 1, LBS: 5112 E7B111 B14 6704652 PCES: 1, LBS: 5112																					
(P) Cust Part #:									WE HEREBY CERTIFY THAT THIS MATERIAL WAS TESTED IN ACCORDANCE WITH, AND MEETS THE REQUIREMENTS OF, THE APPROPRIATE SPECIFICATION											Justin Ward +1 251 662 4400 SENIOR METALLURGIST - PRODUCT	



Item 10 - Shell - MTR

Test Certificate

Form TC1: Revision 2: Date 23 Apr 2014

12400 Highway 43 North, Axis, Alabama 36505, US

Customer: SAMUEL, SON & CO. LTD 1250 APPLEBY LINE BURLINGTON ON L7L5G6		Customer P.O.No.: C41966 & 41-490196		Mill Order No. 41-491119-08		Shipping Manifest: AR239891											
		Product Description: CSA G40.21(2013) 38WT/260WT - CAT 5;LCVN 15FT.LBS,TCVN13FT.LBS@-45F/A673-P ALLOYS API650(12TH ED) TABLE 4-1 GR.IIIA NORMALIZED		Ship Date: 16 Feb 17		Cert No: 081596776 (Page 1 of 1)											
				Cert Date: 16 Feb 17													
		Size: 0.437 X 113.0 X 365.0 (IN)															
Tested Pieces:				Tensiles:				Charpy Impact Tests									
Heat Id	Piece Id	Tested Thickness	Tst Loc	YS (KSI)	UTS (KSI)	%RA	Elong % 2in 8in	Tst Dir	Hardness	Abs. Energy(FTLB) 1 2 3 Avg	% Shear 1 2 3 Avg	Tst Tmp	Tst Dir	Tst Siz (mm)	BDWTT Tmp %Shr		
W7B608	B11	0.442 (DISCRT)	C	53	75		26	T		121 122 118 120 104 93 51 83		-50F -50F	L T	10. 10.			
Chemical Analysis																	
Heat Id	C	Mn	P	S	Si	Tot Al	Sol Al	Cu	Ni	Cr	Mo	Cb	V	Ti	B	N	ORGN
W7B608	.18	.92	.008	.001	.24	.027	.026	.26	.18	.10	.05	.001	.005	.011	.0002	.0079	USA
KILLED STEEL MERCURY IS NOT A METALLURGICAL COMPONENT OF THE STEEL AND NO MERCURY WAS INTENTIONALLY ADDED DURING THE MANUFACTURE OF THIS PRODUCT. KILLED STEEL, PRODUCED TO A FINE GRAIN PRACTICE MTR EN 10204:2004 INSPECTION CERTIFICATE 3.1 COMPLIANT NORMALIZED PLATES. HEATED AT 1665F FOR 21 MINUTES. TEST COUPONS TAKEN FROM HEAT TREATED PLATE. PRODUCTS SHIPPED: W7B608 B11 6704647 PCES: 1, LBS: 5112																	
(P) Cust Part #:									WE HEREBY CERTIFY THAT THIS MATERIAL WAS TESTED IN ACCORDANCE WITH, AND MEETS THE REQUIREMENTS OF, THE APPROPRIATE SPECIFICATION								
									Justin Ward +1 251 662 4400 SENIOR METALLURGIST - PRODUCT								



Item 10 - Shell - MTR

Test Certificate

Form TC1: Revision 2: Date 23 Apr 2014

12400 Highway 43 North, Axis, Alabama 36505, US

Customer: SAMUEL, SON & CO. LTD 1250 APPLEBY LINE BURLINGTON ON L7L5G6				Customer P.O.No.: C41966 & 41-490196				Mill Order No. 41-491119-09				Shipping Manifest: AR239886																																																																																																														
				Product Description: CSA G40.21(2013) 38WT/260WT - CAT 5;LCVN 15FT.LBS,TCVN13FT.LBS@-45F/A673-P ALLOYS API650(12TH ED) TABLE 4-1 GR.IIIA NORMALIZED								Ship Date: 16 Feb 17				Cert No: 081596746 (Page 1 of 1)																																																																																																										
												Cert Date: 16 Feb 17																																																																																																														
				Size: 0.375 X 113.0 X 365.0 (IN)																																																																																																																						
Tested Pieces:				Tensiles:								Charpy Impact Tests																																																																																																														
Heat Id	Piece Id	Tested Thickness	Tst Loc	YS (KSI)	UTS (KSI)	%RA	Elong % 2in 8in	Tst Dir	Hardness	Abs. Energy(FTLB) 1 2 3 Avg				% Shear 1 2 3 Avg				Tst Tmp	Tst Dir	Tst Siz (mm)	BDWTT Tmp %Shr																																																																																																					
W7B608	B06	0.381 (DISCRT)	C	53	75		27	T		77	78	103	86					-50F	L	7.5																																																																																																						
			C							46	31	49	42					-50F	T	7.5																																																																																																						
W7B608	B07	0.380 (DISCRT)	C	52	75		27	T		88	103	87	93					-45F	L	7.5																																																																																																						
			C							54	52	48	51					-45F	T	7.5																																																																																																						
W7B608	B08	0.381 (DISCRT)	C	53	74		26	T		100	122	119	114					-45F	L	7.5																																																																																																						
			C							40	57	79	59					-45F	T	7.5																																																																																																						
Heat Id																					Chemical Analysis										ORGN																																																																																											
																					C	Mn	P	S	Si	Tot Al	Sol Al	Cu	Ni	Cr	Mo	Cb	V	Ti	B	N																																																																																						
W7B608																					.18	.92	.008	.001	.24	.027	.026	.26	.18	.10	.05	.001	.005	.011	.0002	.0079	USA																																																																																					
KILLED STEEL MERCURY IS NOT A METALLURGICAL COMPONENT OF THE STEEL AND NO MERCURY WAS INTENTIONALLY ADDED DURING THE MANUFACTURE OF THIS PRODUCT. KILLED STEEL, PRODUCED TO A FINE GRAIN PRACTICE MTR EN 10204:2004 INSPECTION CERTIFICATE 3.1 COMPLIANT CHARPY FULL SIZE EQUIVALENT = ABSORBED ENERGY AVG X 10 / TEST SIZE IN MM NORMALIZED PLATES. HEATED AT 1665F FOR 19 MINUTES. TEST COUPONS TAKEN FROM HEAT TREATED PLATE. PRODUCTS SHIPPED: <table><tr><td>W7B608 B08</td><td>6704576</td><td>PCES:</td><td>1, LBS:</td><td>4386</td><td>W7B608 B07</td><td>6704580</td><td>PCES:</td><td>1, LBS:</td><td>4386</td></tr><tr><td>W7B608 B07</td><td>6704579</td><td>PCES:</td><td>1, LBS:</td><td>4386</td><td>W7B608 B08</td><td>6704577</td><td>PCES:</td><td>1, LBS:</td><td>4386</td></tr><tr><td>W7B608 B08</td><td>6704583</td><td>PCES:</td><td>1, LBS:</td><td>4386</td><td>W7B608 B07</td><td>6704582</td><td>PCES:</td><td>1, LBS:</td><td>4386</td></tr><tr><td>W7B608 B07</td><td>6704578</td><td>PCES:</td><td>1, LBS:</td><td>4386</td><td>W7B608 B08</td><td>6704589</td><td>PCES:</td><td>1, LBS:</td><td>4386</td></tr><tr><td>W7B608 B08</td><td>6704585</td><td>PCES:</td><td>1, LBS:</td><td>4386</td><td>W7B608 B08</td><td>6704586</td><td>PCES:</td><td>1, LBS:</td><td>4386</td></tr><tr><td>W7B608 W7B608 B07	6704579	PCES:	1, LBS:	4386	W7B608 B08	6704577	PCES:	1, LBS:	4386																																																																																																																	
W7B608 B08	6704583	PCES:	1, LBS:	4386	W7B608 B07	6704582	PCES:	1, LBS:	4386																																																																																																																	
W7B608 B07	6704578	PCES:	1, LBS:	4386	W7B608 B08	6704589	PCES:	1, LBS:	4386																																																																																																																	
W7B608 B08	6704585	PCES:	1, LBS:	4386	W7B608 B08	6704586	PCES:	1, LBS:	4386																																																																																																																	
W7B608 B08	6704588	PCES:	1, LBS:	4386	W7B608 B07	6704581	PCES:	1, LBS:	4386																																																																																																																	
W7B608 B08	6704590	PCES:	1, LBS:	4386	W7B608 B08	6704587	PCES:	1, LBS:	4386																																																																																																																	
W7B608 B06	6704488	PCES:	1, LBS:	4386	W7B608 B07	6704499	PCES:	1, LBS:	4386																																																																																																																	
W7B608 B06	6704485	PCES:	1, LBS:	4386	W7B608 B08	6704574	PCES:	1, LBS:	4386																																																																																																																	
W7B608 B08	6704575	PCES:	1, LBS:	4386	W7B608 B07	6704498	PCES:	1, LBS:	4386																																																																																																																	
(P) Cust Part #:										WE HEREBY CERTIFY THAT THIS MATERIAL WAS TESTED IN ACCORDANCE WITH, AND MEETS THE REQUIREMENTS OF, THE APPROPRIATE SPECIFICATION										Justin Ward +1 251 662 4400 SENIOR METALLURGIST - PRODUCT																																																																																																						



Test Certificate

Form TC1: Revision 2: Date 23 Apr 2014

12400 Highway 43 North, Axis, Alabama 36505, US

Customer: SAMUEL, SON & CO. LTD 1250 APPLEBY LINE BURLINGTON ON L7L5G6				Customer P.O.No.: C41966 & 41-490196				Mill Order No. 41-491119-09				Shipping Manifest: AR239888			
				Product Description: CSA G40.21(2013) 38WT/260WT - CAT 5;LCVN 15FT.LBS,TCVN13FT.LBS@-45F/A673-P ALLOYS API650(12TH ED) TABLE 4-1 GR.IIIA NORMALIZED								Ship Date: 16 Feb 17		Cert No: 081596756 (Page 1 of 1)	
												Size: 0.375 X 113.0 X 365.0 (IN)			

Tested Pieces:				Tensiles:					Charpy Impact Tests										BDWTT Tmp %Shr		
Heat Id	Piece Id	Tested Thickness	Tst Loc	YS (KSI)	UTS (KSI)	%RA	Elong % 2in 8in	Tst Dir	Hardness	Abs. Energy(FTLB) 1 2 3 Avg				% Shear 1 2 3 Avg				Tst Tmp		Tst Dir	Tst Siz (mm)
W7B608	B06	0.381 (DISCRT)	C	53	75		27	T		77	78	103	86					-50F	L	7.5	
			C							46	31	49	42					-50F	T	7.5	
W7B608	B07	0.380 (DISCRT)	C	52	75		27	T		88	103	87	93					-45F	L	7.5	
			C							54	52	48	51					-45F	T	7.5	

Heat Id	Chemical Analysis																ORGN
	C	Mn	P	S	Si	Tot Al	Sol Al	Cu	Ni	Cr	Mo	Cb	V	Ti	B	N	
W7B608	.18	.92	.008	.001	.24	.027	.026	.26	.18	.10	.05	.001	.005	.011	.0002	.0079	USA

KILLED STEEL
 MERCURY IS NOT A METALLURGICAL COMPONENT OF THE STEEL AND NO MERCURY WAS INTENTIONALLY ADDED DURING THE MANUFACTURE OF THIS PRODUCT.
 KILLED STEEL, PRODUCED TO A FINE GRAIN PRACTICE
 MTR EN 10204:2004 INSPECTION CERTIFICATE 3.1 COMPLIANT
 CHARPY FULL SIZE EQUIVALENT = ABSORBED ENERGY AVG X 10 / TEST SIZE IN MM
 NORMALIZED PLATES. HEATED AT 1665F FOR 19 MINUTES.
 TEST COUPONS TAKEN FROM HEAT TREATED PLATE.

PRODUCTS SHIPPED:

W7B608 B06	6704489	PCES:	1, LBS:	4386	W7B608 B07	6704497	PCES:	1, LBS:	4386
W7B608 B07	6704495	PCES:	1, LBS:	4386	W7B608 B06	6704480	PCES:	1, LBS:	4386
W7B608 B06	6704492	PCES:	1, LBS:	4386	W7B608 B06	6704491	PCES:	1, LBS:	4386
W7B608 B06	6704490	PCES:	1, LBS:	4386	W7B608 B07	6704496	PCES:	1, LBS:	4386
W7B608 B06	6704484	PCES:	1, LBS:	4386	W7B608 B06	6704481	PCES:	1, LBS:	4386
W7B608 B06	6704486	PCES:	1, LBS:	4386	W7B608 B06	6704487	PCES:	1, LBS:	4386
W7B608 B07	6704500	PCES:	1, LBS:	4386					

(P) Cust Part #:	WE HEREBY CERTIFY THAT THIS MATERIAL WAS TESTED IN ACCORDANCE WITH, AND MEETS THE REQUIREMENTS OF, THE APPROPRIATE SPECIFICATION
------------------	--

Justin Ward +1 251 662 4400
 SENIOR METALLURGIST - PRODUCT



Item 10 - Shell - MTR

Test Certificate

Form TC1: Revision 2: Date 23 Apr 2014

12400 Highway 43 North, Axis, Alabama 36505, US

Customer: SAMUEL, SON & CO. LTD 1250 APPLEBY LINE BURLINGTON ON L7L5G6		Customer P.O.No.: C41966 & 41-490196		Mill Order No. 41-491119-09		Shipping Manifest: AR239891																																																																																											
		Product Description: CSA G40.21(2013) 38WT/260WT - CAT 5;LCVN 15FT.LBS,TCVN13FT.LBS@-45F/A673-P ALLOYS API650(12TH ED) TABLE 4-1 GR.IIIA NORMALIZED				Ship Date: 16 Feb 17 Cert Date: 16 Feb 17		Cert No: 081596777 (Page 1 of 1)																																																																																									
		Size: 0.375 X 113.0 X 365.0 (IN)																																																																																															
Tested Pieces:				Tensiles:				Charpy Impact Tests																																																																																									
Heat Id	Piece Id	Tested Thickness	Tst Loc	YS (KSI)	UTS (KSI)	%RA	Elong % 2in 8in	Tst Dir	Hardness	Abs. Energy(FTLB) 1 2 3 Avg				% Shear 1 2 3 Avg				Tst Tmp	Tst Dir	Tst Siz (mm)	BDWTT Tmp %Shr																																																																												
W7B608	B09	0.381 (DISCRT)	C	52	73		26	T		97	83	96	92					-45F	L	7.5																																																																													
			C							50	58	48	52					-45F	T	7.5																																																																													
W7B608	B10	0.380 (DISCRT)	C	52	74		23	T		120	92	86	99					-45F	L	7.5																																																																													
			C							53	51	57	54					-45F	T	7.5																																																																													
Heat Id																						Chemical Analysis														ORGN																																																													
																						C	Mn	P	S	Si	Tot Al	Sol Al	Cu	Ni	Cr	Mo	Cb	V	Ti	B	N																																																												
W7B608																						.18	.92	.008	.001	.24	.027	.026	.26	.18	.10	.05	.001	.005	.011	.0002	.0079	USA																																																											
KILLED STEEL MERCURY IS NOT A METALLURGICAL COMPONENT OF THE STEEL AND NO MERCURY WAS INTENTIONALLY ADDED DURING THE MANUFACTURE OF THIS PRODUCT. KILLED STEEL, PRODUCED TO A FINE GRAIN PRACTICE MTR EN 10204:2004 INSPECTION CERTIFICATE 3.1 COMPLIANT CHARPY FULL SIZE EQUIVALENT = ABSORBED ENERGY AVG X 10 / TEST SIZE IN MM NORMALIZED PLATES. HEATED AT 1665F FOR 19 MINUTES. TEST COUPONS TAKEN FROM HEAT TREATED PLATE. PRODUCTS SHIPPED: <table><tr><td>W7B608 B09</td><td>6704857</td><td>PCES:</td><td>1, LBS:</td><td>4386</td><td>W7B608 B09</td><td>6704863</td><td>PCES:</td><td>1, LBS:</td><td>4386</td></tr><tr><td>W7B608 B09</td><td>6704858</td><td>PCES:</td><td>1, LBS:</td><td>4386</td><td>W7B608 B09</td><td>6704856</td><td>PCES:</td><td>1, LBS:</td><td>4386</td></tr><tr><td>W7B608 B09</td><td>6704848</td><td>PCES:</td><td>1, LBS:</td><td>4386</td><td>W7B608 B09</td><td>6704846</td><td>PCES:</td><td>1, LBS:</td><td>4386</td></tr><tr><td>W7B608 B10</td><td>6704849</td><td>PCES:</td><td>1, LBS:</td><td>4386</td><td>W7B608 B09</td><td>6704853</td><td>PCES:</td><td>1, LBS:</td><td>4386</td></tr><tr><td>W7B608 B09</td><td>6704855</td><td>PCES:</td><td>1, LBS:</td><td>4386</td><td>W7B608 B09</td><td>6704854</td><td>PCES:</td><td>1, LBS:</td><td>4386</td></tr><tr><td>W7B608 B10</td><td>6704850</td><td>PCES:</td><td>1, LBS:</td><td>4386</td><td>W7B608 B09</td><td>6704847</td><td>PCES:</td><td>1, LBS:</td><td>4386</td></tr></table>																						W7B608 B09	6704857	PCES:	1, LBS:	4386	W7B608 B09	6704863	PCES:	1, LBS:	4386	W7B608 B09	6704858	PCES:	1, LBS:	4386	W7B608 B09	6704856	PCES:	1, LBS:	4386	W7B608 B09	6704848	PCES:	1, LBS:	4386	W7B608 B09	6704846	PCES:	1, LBS:	4386	W7B608 B10	6704849	PCES:	1, LBS:	4386	W7B608 B09	6704853	PCES:	1, LBS:	4386	W7B608 B09	6704855	PCES:	1, LBS:	4386	W7B608 B09	6704854	PCES:	1, LBS:	4386	W7B608 B10	6704850	PCES:	1, LBS:	4386	W7B608 B09	6704847	PCES:	1, LBS:	4386																
W7B608 B09	6704857	PCES:	1, LBS:	4386	W7B608 B09	6704863	PCES:	1, LBS:	4386																																																																																								
W7B608 B09	6704858	PCES:	1, LBS:	4386	W7B608 B09	6704856	PCES:	1, LBS:	4386																																																																																								
W7B608 B09	6704848	PCES:	1, LBS:	4386	W7B608 B09	6704846	PCES:	1, LBS:	4386																																																																																								
W7B608 B10	6704849	PCES:	1, LBS:	4386	W7B608 B09	6704853	PCES:	1, LBS:	4386																																																																																								
W7B608 B09	6704855	PCES:	1, LBS:	4386	W7B608 B09	6704854	PCES:	1, LBS:	4386																																																																																								
W7B608 B10	6704850	PCES:	1, LBS:	4386	W7B608 B09	6704847	PCES:	1, LBS:	4386																																																																																								
(P) Cust Part #:										WE HEREBY CERTIFY THAT THIS MATERIAL WAS TESTED IN ACCORDANCE WITH, AND MEETS THE REQUIREMENTS OF, THE APPROPRIATE SPECIFICATION										Justin Ward +1 251 662 4400 SENIOR METALLURGIST - PRODUCT																																																																													

Sub-Arc Systems Inc.

4605-47 Street
Vermillion, AB, T9X 1L6
780-608-9589

QUALITY CONTROL MANUAL

Exhibit 18, Rev A

DIMENSIONAL CHECK REPORT - ROUNDNESS

Customer: AGNICO EAGLELocation: RANKIN INLET TANK #2.Equipment Tag No.: N/AEquipment Type: N/AEquipment Description: N/A.

Code Requiring Test: API 650

Reason for Test: New Construction

(The tank shell will be checked for roundness at 12" above the tank floor. Roundness will be checked at 45 degree intervals or less, max. 20' spacing)

Test Date(s): Aug 8/17.

Tested by:

Seam Test Results:

Roundness checks were made every 20'
around the tank. All Areas were found
acceptable.

Sub-Arc Representative Signature: [Signature] Date: Aug 8/17.

Client Representative Signature: _____ Date: _____

Client Signature: Stephane Gionet Date: Aug 21/17

Item 10 - Shell Roundness Dimension Report - AmSpec Data (3rd party)



LASER DIAMETERS



Enter Diameters (or Radii) in decimal Ft.
Ex: 45.90

Diameters		of center beam	
left	Right		
1	114.92	114.81	
2	114.93	115.05	
3	115.15	115.14	
4	115.09	115.13	
5	115.09	115.11	
6	115.11	114.99	
7	115.08	115.07	
8	115.07	115.90	
9	115.05	115.11	
10	115.07	115.07	
11	115.05	115.07	
12	115.12	115.13	
13	115.12	115.15	
14	114.97	115.11	
15	114.94	114.86	
16	115.12	115.13	
17	115.08	115.12	
18	115.04	115.02	
19	115.04	115.06	
20	115.13	115.11	
21	115.08	115.08	
22	115.06	115.01	
23	115.08	115.07	
24	115.12	115.15	
25	115.14	115.18	
26	114.88	114.95	
27			
28			
29			
30			
31			
32			
33			
34			
Average=		115.059	115.099


Dia	Beam	Hyp	
14.000		14.000	0.000

TAKE LASER DIAMETERS ABOUT EVERY 3 to 5 FEET AROUND THE INSIDE PERIMETER OF THE TANK FOR 180 DEGREES (HALF WAY ROUND). TAKING READINGS BOTH (ALTERNATE) SIDES OF THE CENTER POST/COLUMN.

IF DIAMETER DISTANCE IS TOO GREAT FOR LASER, THEN TAKE RADII FROM CENTER PIPE (NOT FROM A COLUMN) ABOUT EVERY 5 FEET AROUND THE INSIDE PERIMETER OF THE TANK FOR 360 DEGREES

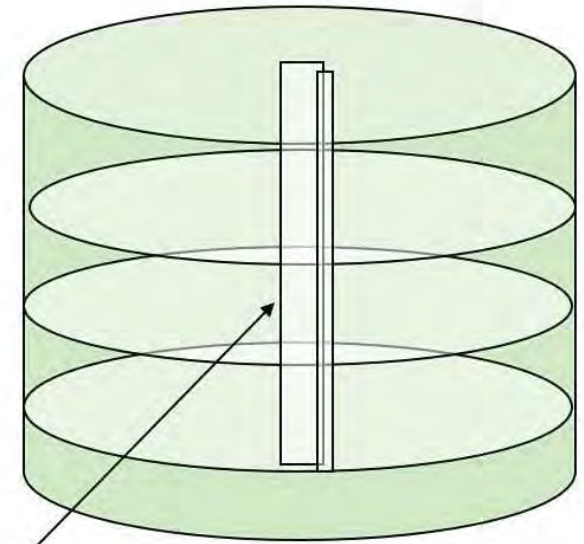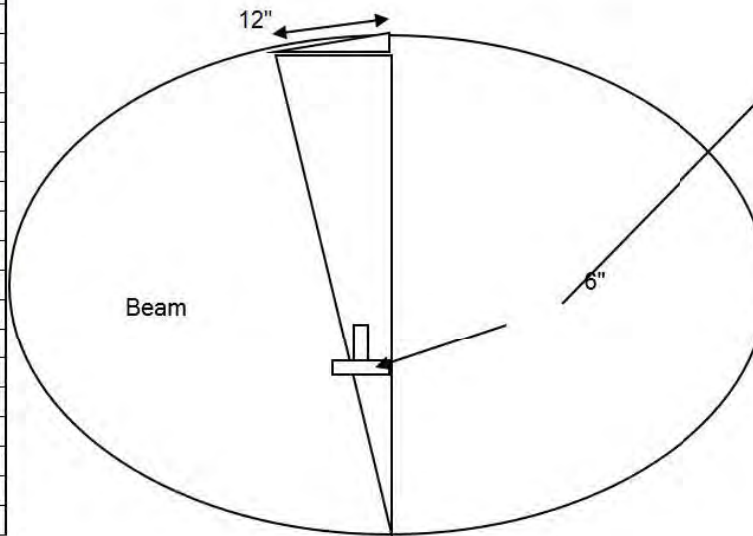

Tank #2 Rankin Inlet (AEM)

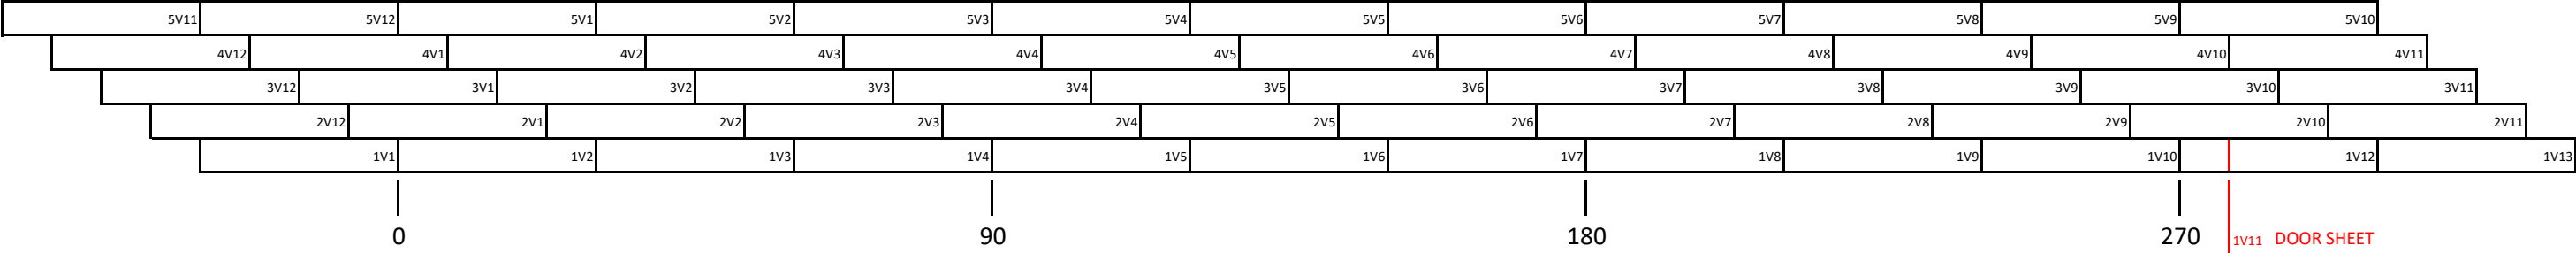

VERTS (Welder ID)

	IN	OUT
1V1	MG	MG
1V2	MG	KW
1V3	KW	KW
1V4	KW	KW
1V5	DZ	DZ
1V6	DZ	DZ
1V7	DZ	MT
1V8	DZ	MT
1V9	DZ	MT
1V10	MT	MT
1V11 (DOOR SHEET)	MM	MM
1V12	KW	MT
1V13	MG	KW

	IN	OUT
2V1	MT	DZ
2V2	MT	DZ
2V3	DZ	DZ
2V4	DZ	MT
2V5	DZ	MT
2V6	MG	MT
2V7	MG	MG
2V8	KW	MG
2V9	KW	MG
2V10	KW	KW
2V11	KW	KW
2V12	KW	MT

	IN	OUT
3V1	JH	JN
3V2	JH	JN
3V3	JH	JH
3V4	JH	JH
3V5	JN	JH
3V6	JN	DZ
3V7	MG	DZ
3V8	DZ	MG
3V9	DZ	MG
3V10	DZ	MG
3V11	MG	DZ
3V12	JN	DZ

	IN	OUT
4V1	MT	MT
4V2	JO	KW
4V3	JO	JO
4V4	JH	JH
4V5	JN	JH
4V6	JH	JH
4V7	JH	JH
4V8	CJ	DZ
4V9	DZ	DZ
4V10	DZ	DZ
4V11	DZ	DZ
4V12	MT	DZ

	IN	OUT
5V1	DZ	MT
5V2	DZ	MT
5V3	KW	JH
5V4	KW	JO
5V5	JO	JO
5V6	JH	JO
5V7	JH	JN
5V8	JN	JN
5V9	JN	JH
5V10	DZ	DZ
5V11	KW	DZ
5V12	MT	DZ

HORIZONTAL (Welder ID)

	IN	OUT
H1	JO	MG
DOOR SHEET	MM/MT	MM/MT

	IN	OUT
H2	JO/MM	MG/KW

	IN	OUT
H3	JO/MM	MG/KW

	IN	OUT
H4	JO/MM	MG/KW

PLATES IDENTIFICATION (heat numbers)

	Heat Number
1V1	E7B111 B15
1V2	E7B111 B15
1V3	E7B111 B16
1V4	E7B111 B15
1V5	E7B111 B15
1V6	E7B111 B15
1V7	E7B111 B16
1V8	E7B111 B15
1V9	E7B111 B15
1V10	E7B111 B15
1V11	E7B111 B15
1V12	E7B111 B15
1V13	E7B111 B15

	Heat Number
2V1	W7B608 B11
2V2	E7B111 B14
2V3	W7B608 B11
2V4	E7B111 B14
2V5	E7B111 B14
2V6	W7B608 B11
2V7	W7B608 B11
2V8	W7B608 B11
2V9	W7B608 B11
2V10	W7B608 B11
2V11	W7B608 B11
2V12	W7B608 B11

	Heat Number
3V1	W7B608 B09
3V2	W7B608 B06
3V3	W7B608 B07
3V4	W7B608 B06
3V5	W7B608 B08
3V6	W7B608 B06
3V7	W7B608 B09
3V8	W7B608 B07
3V9	W7B608 B06
3V10	W7B608 B07
3V11	W7B608 B06
3V12	W7B608 B06

	Heat Number
4V1	W7B608 B07
4V2	W7B608 B08
4V3	W7B608 B07
4V4	W7B608 B07
4V5	W7B608 B09
4V6	W7B608 B06
4V7	W7B608 B08
4V8	W7B608 B09
4V9	W7B608 B07
4V10	W7B608 B08
4V11	W7B608 B09
4V12	W7B608 B08

	Heat Number
5V1	W7B608 B06
5V2	W7B608 B07
5V3	W7B608 B06
5V4	W7B608 B08
5V5	W7B608 B08
5V6	W7B608 B09
5V7	W7B608 B07
5V8	W7B608 B06
5V9	W7B608 B06
5V10	W7B608 B09
5V11	W7B608 B07
5V12	W7B608 B08

Sub-Arc Systems Inc.

4605-47 Street
Vermillion, AB, T9X 1L6
780-608-9589

QUALITY CONTROL MANUAL

Exhibit 17, Rev A

DIMENSIONAL CHECK REPORT - BANDING

Customer: AGNICO EAGLELocation: RANKIN INLET TANK #2Equipment Tag No.: N/AEquipment Type: N/AEquipment Description: N/ACode Requiring Test: API 650Reason for Test: New Construction

(Each circumferential seam will be checked for banding and max. banding dimension recorded for that seam. Circumferential seams will be checked at 45 degree intervals or less, max. 20' spacing)

Test Date(s): AUG 18/17Tested by: MATT TURMEL

Seam Test Results:

1ST HORIZONTAL BANDING CHECKS DONE EVERY 20FTMAX BANDING WAS 1/4" ON A 4FT LEVELALL CHECKS ACCEPTABLESub-Arc Representative Signature: M. Turmel Date: AUG 18/17

Client Representative Signature: _____ Date: _____

Client Signature: Cherise Clem Bonita Date: AUG 23/17

Sub-Arc Systems Inc.

4605-47 Street
Vermillion, AB, T9X 1L6
780-608-9589

QUALITY CONTROL MANUAL

Exhibit 17, Rev A

DIMENSIONAL CHECK REPORT - BANDING

Customer: AGNICO EAGLELocation: RANKIN INLET TANK #2.Equipment Tag No.: N/AEquipment Type: N/AEquipment Description: N/ACode Requiring Test: API 650Reason for Test: New Construction

(Each circumferential seam will be checked for banding and max. banding dimension recorded for that seam. Circumferential seams will be checked at 45 degree intervals or less, max. 20' spacing)

Test Date(s): AUG 19/17Tested by: MATT TURMEL

Seam Test Results:

2ND HORIZONTAL BANDING CHECKS DONE EVERY 20FTMAX BANDING WAS 5/16" ON A 4 FT LEVELALL CHECKS ACCEPTABLESub-Arc Representative Signature: M. TurmelDate: AUG 19/17

Client Representative Signature: _____

Date: _____

Client Signature: C. BoninChen BoninDate: Aug 23/17

Sub-Arc Systems Inc.

4605-47 Street
Vermillion, AB, T9X 1L6
780-608-9589

QUALITY CONTROL MANUAL

Exhibit 17, Rev A

DIMENSIONAL CHECK REPORT - BANDING

Customer: AGNICO EAGLELocation: RANKIN INLET TANK #2.Equipment Tag No.: N/AEquipment Type: N/AEquipment Description: N/ACode Requiring Test: API 650Reason for Test: New Construction

(Each circumferential seam will be checked for banding and max. banding dimension recorded for that seam. Circumferential seams will be checked at 45 degree intervals or less, max. 20' spacing)

Test Date(s): AUG 19/17.Tested by: MATT TURMEL

Seam Test Results:

3RD HORIZONTAL BANDING CHECKS DONE EVERY 20FTMAX BANDING WAS 1/4" ON A HFT LEVELALL CHECKS ACCEPTABLESub-Arc Representative Signature: M. Turmel Date: AUG 19/17

Client Representative Signature: _____ Date: _____

Client Signature: Chonin Chen Borja Date: Aug 23/17

Sub-Arc Systems Inc.

4605-47 Street
Vermillion, AB, T9X 1L6
780-608-9589

QUALITY CONTROL MANUAL

Exhibit 17, Rev A

DIMENSIONAL CHECK REPORT - BANDING

Customer: AGNICO EAGLELocation: RANKIN INLET TANK #2.Equipment Tag No.: N/AEquipment Type: N/AEquipment Description: N/ACode Requiring Test: API 650Reason for Test: New Construction

(Each circumferential seam will be checked for banding and max. banding dimension recorded for that seam. Circumferential seams will be checked at 45 degree intervals or less, max. 20' spacing)

Test Date(s): AUG 19/17.Tested by: MATT TURMEL.

Seam Test Results:

4TH HORIZONTAL BANDING CHECKS DONE EVERY 20FT
MAX BANDING WAS 5/16" ON A 4FT LEVELALL CHECKS ACCEPTABLESub-Arc Representative Signature: M. Turmel Date: AUG 19/17.

Client Representative Signature: _____ Date: _____

Client Signature: Chris CLEA BOYER Date: aug 23/17

Sub-Arc Systems Inc.

4605-47 Street
Vermillion, AB, T9X 1L6
780-608-9589

QUALITY CONTROL MANUAL

Exhibit 16, Rev A

DIMENSIONAL CHECK REPORT - PEAKING

Customer: AGNICO EAGLELocation: RANKIN INLET TANK #2Equipment Tag No.: N/AEquipment Type: N/AEquipment Description: N/ACode Requiring Test: API 650Reason for Test: New Construction

(Each vertical seam will be checked for peaking and max. peak dimension recorded for that seam.)

Test Date(s): AUG 18/17Tested by: MATT TURNER

Seam Test Results:

SRI - 1V1 1/8", 1V2 1/8", 1V3 1/4", 1V4 Ø, 1V5 1/16", 1V6 1/8",1V7 Ø, 1V8 1/16", 1V9 1/16", 1V10 (DOORSHEET), 1V11 (DOORSHEET),1V12 Ø, 1V13 1/8" ↓ 1/8" ↓ 1/4"ALL SRI VERTS ACCEPTABLE (1V10 + 1V11 WILL BE DONE WHEN DOORSHEET COMPLETE)Sub-Arc Representative Signature: M Turner Date: AUG 18/17

Client Representative Signature: _____ Date: _____

Client: Chaim Clem BOYD Date: Aug 23/17

QUALITY CONTROL MANUAL

Exhibit 16, Rev A

DIMENSIONAL CHECK REPORT – PEAKING

Customer: AGNICO EAGLELocation: RANKIN INLET TANK #2.Equipment Tag No.: N/AEquipment Type: N/AEquipment Description: N/ACode Requiring Test: API 650Reason for Test: New Construction

(Each vertical seam will be checked for peaking and max. peak dimension recorded for that seam.)

Test Date(s): AUG 18/17Tested by: MATT TURMEL

Seam Test Results:

SR2 - 2V1 1/16", 2V2 Ø, 2V3 1/16", 2V4 Ø, 2V5 Ø, 2V6 1/8"
2V7 1/8", 2V8 3/16", 2V9 1/16", 2V10 Ø, 2V11 1/8", 2V12 1/16"ALL SR2 VERTS ACCEPTABLESub-Arc Representative Signature: M. Turmel Date: AUG 18/17

Client Representative Signature: _____ Date: _____

Client: Clem Bonia Date: Sept 04/17

Sub-Arc Systems Inc.

4605-47 Street
Vermillion, AB, T9X 1L6
780-608-9589

QUALITY CONTROL MANUAL

Exhibit 16, Rev A

DIMENSIONAL CHECK REPORT - PEAKING

Customer: AGNICO EAGLELocation: RANKIN INLET TANK #2Equipment Tag No.: N/AEquipment Type: N/AEquipment Description: N/ACode Requiring Test: API 650Reason for Test: New Construction

(Each vertical seam will be checked for peaking and max. peak dimension recorded for that seam.)

Test Date(s): AUG 18/17Tested by: MATT TURMEL

Seam Test Results:

SR3 - 3V1 3/16", 3V2 1/8", 3V3 Ø, 3V4 1/8", 3V5 1/16",
3V6 3/16", 3V7 1/8", 3V8 Ø, 3V9 1/16", 3V10 1/4", 3V11 1/8",
3V12 Ø
ALL SR3 VERTS ACCEPTABLE

Sub-Arc Representative Signature: M. Turmel Date: AUG 18/17

Client Representative Signature: _____ Date: _____

Client: CBONIA CHEN BONIA Date: AUG 23/17

QUALITY CONTROL MANUAL

Exhibit 16, Rev A

DIMENSIONAL CHECK REPORT - PEAKING

Customer: AGNICO EAGLE

Location: RANKIN INLET TANK #2

Equipment Tag No.: N/A

Equipment Type: N/A

Equipment Description: N/A

Code Requiring Test: API 650

Reason for Test: New Construction

(Each vertical seam will be checked for peaking and max. peak dimension recorded for that seam.)

Test Date(s): AUG 18/17

Tested by: MATT TURMEL

Seam Test Results:

SR4 - 4V1 Ø, 4V2 1/16", 4V3 1/4", 4V4 3/16", 4V5 1/8",
4V6 1/8, 4V7 Ø, 4V8 3/16", 4V9 1/16", 4V10 Ø, 4V11 1/16",
4V12 Ø
ALL SR4 VERTS ACCEPTABLE

Sub-Arc Representative Signature: M. Turmel Date: AUG 18/17

Client Representative Signature: _____ Date: _____

Client: CLONIA CLONIA BONIA Date: AUG 23/17

QUALITY CONTROL MANUAL

Exhibit 16, Rev A

DIMENSIONAL CHECK REPORT – PEAKING

Customer: AGNICO EAGLELocation: RANKIN INLET TANK #2Equipment Tag No.: N/AEquipment Type: N/AEquipment Description: N/ACode Requiring Test: API 650Reason for Test: New Construction

(Each vertical seam will be checked for peaking and max. peak dimension recorded for that seam.)

Test Date(s): AUG 18/17Tested by: MATT TURNER

Seam Test Results:

SR5 - 5V1 1/16", 5V2 Ø, 5V3 1/16", 5V4 1/8", 5V5 1/8",
5V6 3/16", 5V7 1/8", 5V8 Ø, 5V9 1/16", 5V10 1/8", 5V11 Ø,
5V12 3/16"
ALL SR5 VERTS ACCEPTABLE

Sub-Arc Representative Signature: M. Turner Date: AUG 18/17

Client Representative Signature: _____ Date: _____

Client: Chonin Clean Boy's Date: Aug 23/17

Sub-Arc Systems Inc.

4605-47 Street
Vermillion, AB, T9X 1L6
780-608-9589

QUALITY CONTROL MANUAL

Exhibit 19, Rev A

DIMENSIONAL CHECK REPORT - PLUMBNESS

Customer: AGNICO EAGE

Location: RANKIN INLET TANK #2

Equipment Tag No.: N/A

Equipment Type: N/A

Equipment Description: N/A

Code Requiring Test: API 650

Reason for Test: New Construction

(The tank shell will be checked for plumb at 12" below the tank roof. Plumb measurements will be checked at 45 degree intervals or less, max. 20' spacing)

Test Date(s): AUG 17/17

Tested by: MATT MACKENZIE

Seam Test Results:

Plumbness measurements were taken every
20'. All measurements were acceptable.

Sub-Arc Representative Signature: [Signature] Date: Aug 17/17

Client Representative Signature: _____ Date: _____

Client Signature: Stephane Girard Date: 21/08/17
[Signature]

Sub-Arc Systems Inc.

4605-47 Street
Vermillion, AB, T9X 1L6
780-608-9589

Exhibit 15b, Rev 1

QUALITY CONTROL MANUAL
DIESEL TEST REPORT (SHELL)

Customer: Agnico Eagle

Location: Rankin Inlet *Tank #2*

Equipment Tag No.: N/A

Equipment Type: N/A

Equipment Description: N/A

Code Requiring Test: API 650 (section 7.3.5)

Reason for Test: New Construction

(The shell shall be tested by painting all of the joints on the inside with a highly penetrating oil and carefully examining the outside of the joints for leakage.)

Surface Condition (As Welded)

Test Solution: Diesel

Test Date(s): *Aug 11/17*Tested by: *Chris Jacques.*Ambient Conditions: *9°C*

Items Tested:

2nd horizontal + 2nd Course Verts.

Results:

*No leaks were found at time of inspection.*Sub-Arc Representative Signature: *[Signature]* Date: *Aug 11/17*

Client Representative Signature: _____ Date: _____

Client Signature: *Stephane Giamet* Date: *Aug 11/17*
[Signature]

Exhibit 15b, Rev 1

QUALITY CONTROL MANUAL
DIESEL TEST REPORT (SHELL)

Customer: Agnico Eagle

Location: Rankin Inlet

TANK #2.

Equipment Tag No.: N/A

Equipment Type: N/A

Equipment Description: N/A

Code Requiring Test: API 650 (section 7.3.5)

Reason for Test: New Construction

(The shell shall be tested by painting all of the joints on the inside with a highly penetrating oil and carefully examining the outside of the joints for leakage.)

Surface Condition (As Welded)

Test Solution: Diesel

Test Date(s): Aug 13/17

Tested by: Matt Turner.

Ambient Conditions: 10°C

Items Tested:

3rd Horizontal + 3rd Course Verts.

Results:

No leaks were found at time of inspection.

Sub-Arc Representative Signature:



Date:

Aug. 14/17.

Client Representative Signature:



Date:

August 14/17

Client Signature:

Stephane Gionet

Date:

QUALITY CONTROL MANUAL
DIESEL TEST REPORT (SHELL)

Exhibit 15b, Rev 1

Customer: Agnico Eagle

Location: Rankin Inlet

TANK #2

Equipment Tag No.: N/A

Equipment Type: N/A

Equipment Description: N/A

Code Requiring Test: API 650 (section 7.3.5)

Reason for Test: New Construction

(The shell shall be tested by painting all of the joints on the inside with a highly penetrating oil and carefully examining the outside of the joints for leakage.)

Surface Condition (As Welded)

Test Solution: Diesel

Test Date(s):

Aug 15/17

Tested by: NAT TURNER

Ambient Conditions:

10°C

Items Tested:

4th HORIZONTAL + 4th Course VERTS. + 5th Course VERTS.

Results:

No leaks were found at time of inspection.

Sub-Arc Representative Signature:

[Signature]

Date:

Aug 15/17

Client Representative Signature: _____

Date: _____

Client Signature:

[Signature]

Date:

Aug 15/17

Sub-Arc Systems Inc.

4605-47 Street
Vermillion, AB, T9X 1L6
780-608-9589

Exhibit 15b, Rev 1

QUALITY CONTROL MANUAL
DIESEL TEST REPORT (SHELL)

Customer: Agnico Eagle

Location: Rankin Inlet

Equipment Tag No.: N/A

Equipment Type: N/A

Equipment Description: N/A

Code Requiring Test: API 650 (section 7.3.5)

Reason for Test: New Construction

(The shell shall be tested by painting all of the joints on the inside with a highly penetrating oil and carefully examining the outside of the joints for leakage.)

Surface Condition (As Welded)

Test Solution: Diesel

Test Date(s):

Aug 6/17.

Tested by: Matt Mackenzie

Ambient Conditions: 10°C

Items Tested:

1st horizontal & 1st Course Verts.

Results:

No leaks were found at time of inspection.Sub-Arc Representative Signature: *Mark G.*

Date:

Aug 6/17

Client Representative Signature: _____

Date: _____

Client Signature: *Chaim Clem Borin*

Date:

Aug 23/17



Client :	Inukshuk Construction Ltd,	Date d'intervention : Intervention date :	2017-08-30
Adresse/Address :	PO Box 654 Rankin Inlet, Nunavut X0C 0G0	Date du rapport : Report date :	2017-09-08
Contact :	Marc Losier	N° dossier : File no :	INS-117107-01_R01
Entrepreneur : Contractor :	N/A	Commande : Order :	295-1046
Endroit du travail : Job location :	Rankin Inlet , Nunavut		

Page 1 de/of 3

INSP. VISUELLE VISUAL INSP.	☐	MAGNÉTOSCOPIE MAGNETIC PARTICLES	☒	RESSUAGE LIQUID PENETRANT	☐	ULTRASONS ULTRASONIC	☒
DESCRIPTION :							
<u>Magnetic particles inspection and Ultrasonic inspection on tank 2</u>							
The client is opting to use an ultrasonic testing, instead of radiographic testing							
Remark : Visual testing was performed by client I							
INSP. VISUELLE / VISUAL INSP.		NORME : SPECIFICATION :		N° équip. : Equip. no : N/A			
MAGNÉTOSCOPIE MAGNETIC PARTICLES		NORME : SPECIFICATION : API 650		N° équip. : Equip. no : MP-Q-27			
Ampérage : Amperage :	Culasse/Yoke	Continue Continuous	☒	Résiduelle Residual	☐	Humide Wet	☐
Longitudinale Longitudinal	☐	Circulaire Circular	☐	C.A. A.C.	☒	Sèche Dry	☒
						Démagnétisée Demagnetized	☐
RESSUAGE LIQUID PENETRANT		NORME : SPECIFICATION :		N° équip. : Equip. no :			
Pénétrant/Penetrant :		Émulsifiant/Emulsifier :		Révélateur/Developer :			
Temps/Time :		Temps/Time :		Temps/Time :			
ULTRASONS / ULTRASONIC		NORME : SPECIFICATION : API 650					
ÉTALONNAGE/CALIBRATION :		Trou/Hole : N/A		C.A.D. /D.A.C. : X ☐			
Bloc/Block : IIW Type 2							
APPAREIL/EQUIPMENT :		Couplant : Echogel		Échelle/Sweep length :			
Instrument : USM GO+		Palpeur/Transducer : 0° degré and 70° degré					
N° équip./Equip. no : UT-Q-34							
RÉSULTATS/RESULTS :							
For ultrasonic results: All spots are acceptable. See attached tables for locations.							
Magnetic particles inspection was performed on angle joint between the shell and nozzle, inside and outside the tank:							
-Inside tank, weld between shell/nozzle, with a 100%: magnetic particles inspection, is acceptable -Outside tank, weld between shell/pad & weld between pad/nozzle, with 100% (note 1): magnetic particles inspection, is acceptable.							
Note 1: Fourteen (14) nozzles including four (4) manholes and one nozzle outside, does not have pad . Please refer to drawing 295-M10; part section K-K item #10. This nozzle corresponds to a ¾" coupling for a water temperature gauge in the shell and the client has advised that no repad is needed for this specific coupling.							
Techniciens : Technicians :		Sylvain Germain CSA W178.2 level 2		Assistants:		Approuvé par : Approved by : Pierre Dostie Technical Supervisor CSA W178.2, niveau 3	

Ce rapport ne doit pas être reproduit, sinon en entier, sans l'autorisation écrite de SGS CANADA inc.


Le présent rapport est émis par la Société conformément à ses Conditions Générales de Service accessibles sur <http://www.sgs.ca/fr-FR/Terms-and-Conditions.aspx>

This report is confidential and shall not be reproduced without the written approval of SGS CANADA Inc

This document is issued by the Company under its General Conditions of Service accessible at <http://www.sgs.ca/en/Terms-and-Conditions.aspx>SGS Canada Inc. Services industriels / Industrial Services 1300, boul. du Parc Technologique, Québec, QC G1P 4S3 t (800) 361-1679 f (418) 683-6328 www.sgs.ca

Client :	Inukshuk Construction Ltd,	Date d'intervention :	2017-08-30
Adresse/Address :	PO Box 654 Rankin Inlet, Nunavut X0C 0G0	Intervention date :	
Contact :	Marc Losier	Date du rapport :	2017-09-08
Entrepreneur :	N/A	Report date :	
Contractor :		N° dossier :	INS-117107-01_R01
File no :		Commande :	295-1046
Endroit du travail :	Rankin Inlet , Nunavut	Order :	
Job location :			

Picture : 1

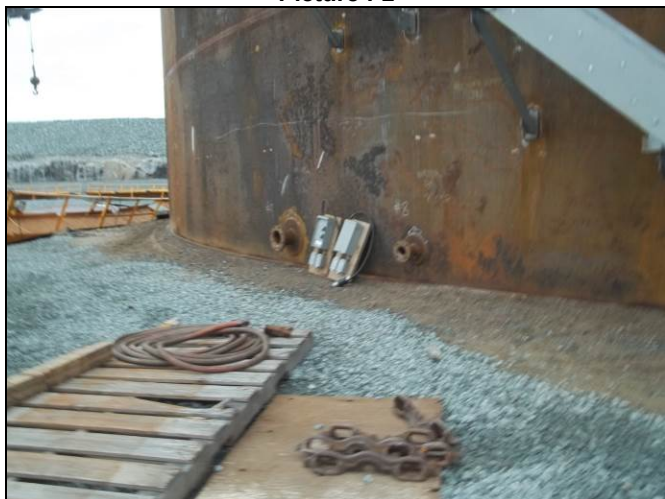

View of some nozzles

Picture : 2




View of tank 2

Techniciens :	Sylvain Germain	Assistants:		Approuvé par :	Pierre Dostie
Technicians :	CSA W178.2 level 2			Approved by :	Technical Supervisor
					CSA W178.2, niveau 3

Ce rapport ne doit pas être reproduit, sinon en entier, sans l'autorisation écrite de SGS CANADA inc.
 Le présent rapport est émis par la Société conformément à ses Conditions Générales de Service accessibles sur <http://www.sgs.ca/fr-FR/Terms-and-Conditions.aspx>
 This report is confidential and shall not be reproduced without the written approval of SGS CANADA Inc
 This document is issued by the Company under its General Conditions of Service accessible at <http://www.sgs.ca/en/Terms-and-Conditions.aspx>

Client :	Inukshuk Construction Ltd,	Date d'intervention :	2017-08-30
Adresse/Address :	PO Box 654 Rankin Inlet, Nunavut X0C 0G0	Intervention date :	
Contact :	Marc Losier	Date du rapport :	2017-09-08
Entrepreneur :	N/A	Report date :	
Contractor :		N° dossier :	INS-117107-01_R01
File no :		Commande :	295-1046
Endroit du travail :	Rankin Inlet , Nunavut	Order :	
Job location :			

Picture :3

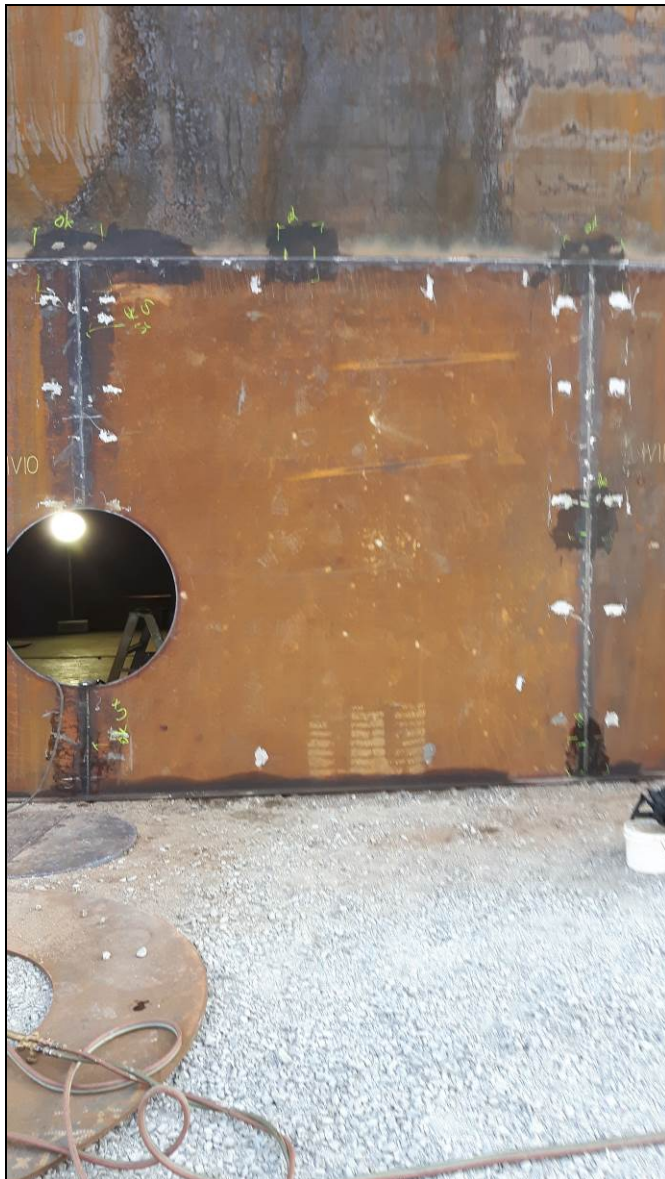

View of manhole before padding

Techniciens :	Sylvain Germain	Assistants:		Approuvé par :	Pierre Dostie
Technicians :	CSA W178.2 level 2			Approved by :	Technical Supervisor
					CSA W178.2, niveau 3


Ce rapport ne doit pas être reproduit, sinon en entier, sans l'autorisation écrite de SGS CANADA inc.

Le présent rapport est émis par la Société conformément à ses Conditions Générales de Service accessibles sur <http://www.sgs.ca/fr-FR/Terms-and-Conditions.aspx>

This report is confidential and shall not be reproduced without the written approval of SGS CANADA Inc

This document is issued by the Company under its General Conditions of Service accessible at <http://www.sgs.ca/en/Terms-and-Conditions.aspx>

Tank #2 Rankin Inlet (AEM)

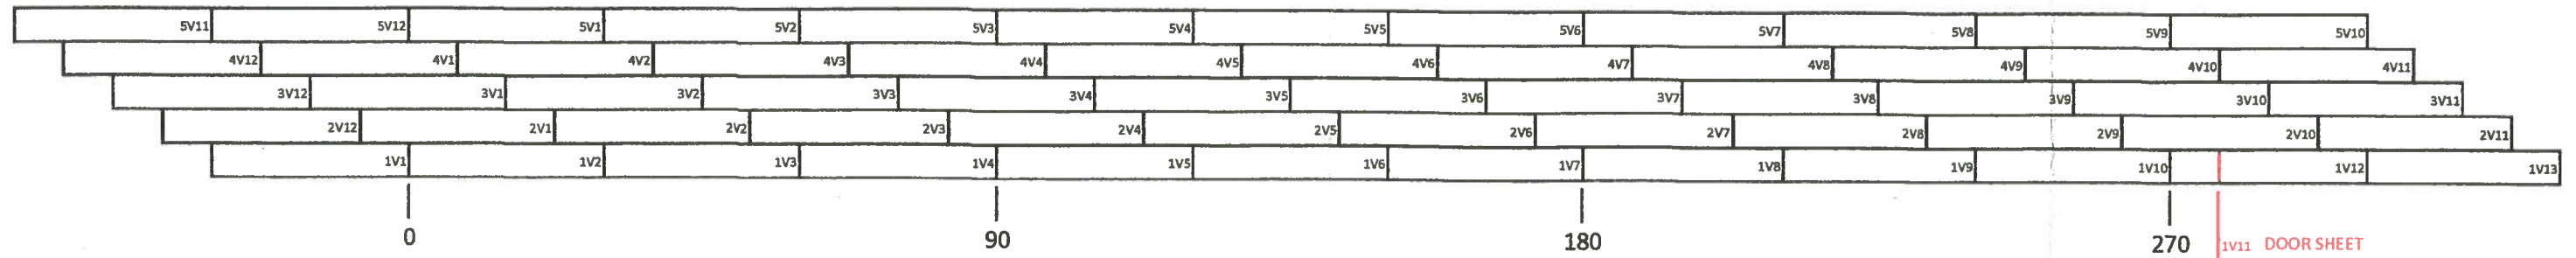

NDT TECHNICIAN WILL INITIAL EACH BOX WHEN WELD IS ACCEPTABLE

B ----> BOTTOM OF THE VERT (0-6")

M ----> MIDDLE OF THE VERT (53"-59")

T ----> TOP OF THE VERT (104 3/16" - 110 3/16")

VERTICAL SEAMS MAPPING UT

	B	M	T	FULL
1V1	UT FULL BECAUSE NOZZLE INTO VERT			SC
1V2	SG	SG	SG	
1V3	SG	SG	SG	
1V4	UT FULL BECAUSE NOZZLE INTO VERT			SC
1V5	SG	SG	SG	
1V6	SG	SG	SG	
1V7	UT FULL BECAUSE NOZZLE INTO VERT			SG
1V8	SG	SG	SG	
1V9	SG	SG	SG	
1V10	UT FULL BECAUSE NOZZLE INTO VERT			SG
1V11 (DOOR SHEET)	SG	SG	SG	
1V12	SG	SG	SG	
1V13	SG	SG	SG	

	B	M	T
2V1	SG	SC	SG
2V2	SG	SG	SG
2V3	SG	SG	SG
2V4	SG	SG	SG
2V5	SC	SG	SC
2V6	SG	SG	SG
2V7	SG	SG	SG
2V8	SG	SG	SG
2V9	SG	SG	SG
2V10	SG	SG	SG
2V11	SG	SG	SG
2V12	SG	SG	SG

	B	T
3V1	SG	SG
3V2	SG	SG
3V3	SG	SG
3V4	SG	SG
3V5	SG	SG
3V6	SG	SG
3V7	SG	SG
3V8	SG	SG
3V9	SG	SG
3V10	SG	SG
3V11	SG	SG
3V12	SG	SG

	B	T
4V1	SG	SG
4V2	SG	SG
4V3	SG	SG
4V4	SG	SG
4V5	SG	SG
4V6	SG	SG
4V7	SG	SG
4V8	SG	SG
4V9	SG	SG
4V10	SG	SG
4V11	SG	SG
4V12	SG	SG

	B	T
5V1	SG	
5V2	SG	
5V3	SG	
5V4	SG	
5V5	SG	
5V6	SG	
5V7	SG	
5V8	SG	
5V9	SG	
5V10	SG	
5V11	SG	
5V12	SG	

HORIZONTAL SEAMS MAPPING UT

H1V2	48"-54"	SG
H1V8	60"-66"	SG
H1V10	42"-48"	SG

H2V3	48"-54"	SG
H2V9	72"-78"	SG

H3V1	60"-66"	SG
H3V7	42"-48"	SG

H4V5	30"-36"	SG
H4V11	72"-78"	SG


Sub-Arc Representative Signature: <i>[Signature]</i>	Date: <i>Aug 26/17</i>
Client Representative Signature: _____	Date: _____
NDT Representative Signature: <i>[Signature]</i>	Date: <i>August 26 2017</i>

Item 11 – Compression Ring

Contents


1. Weld Maps
2. Visual Report

Item 11 - Compression Ring - Rim Angle to Roof Weld Map

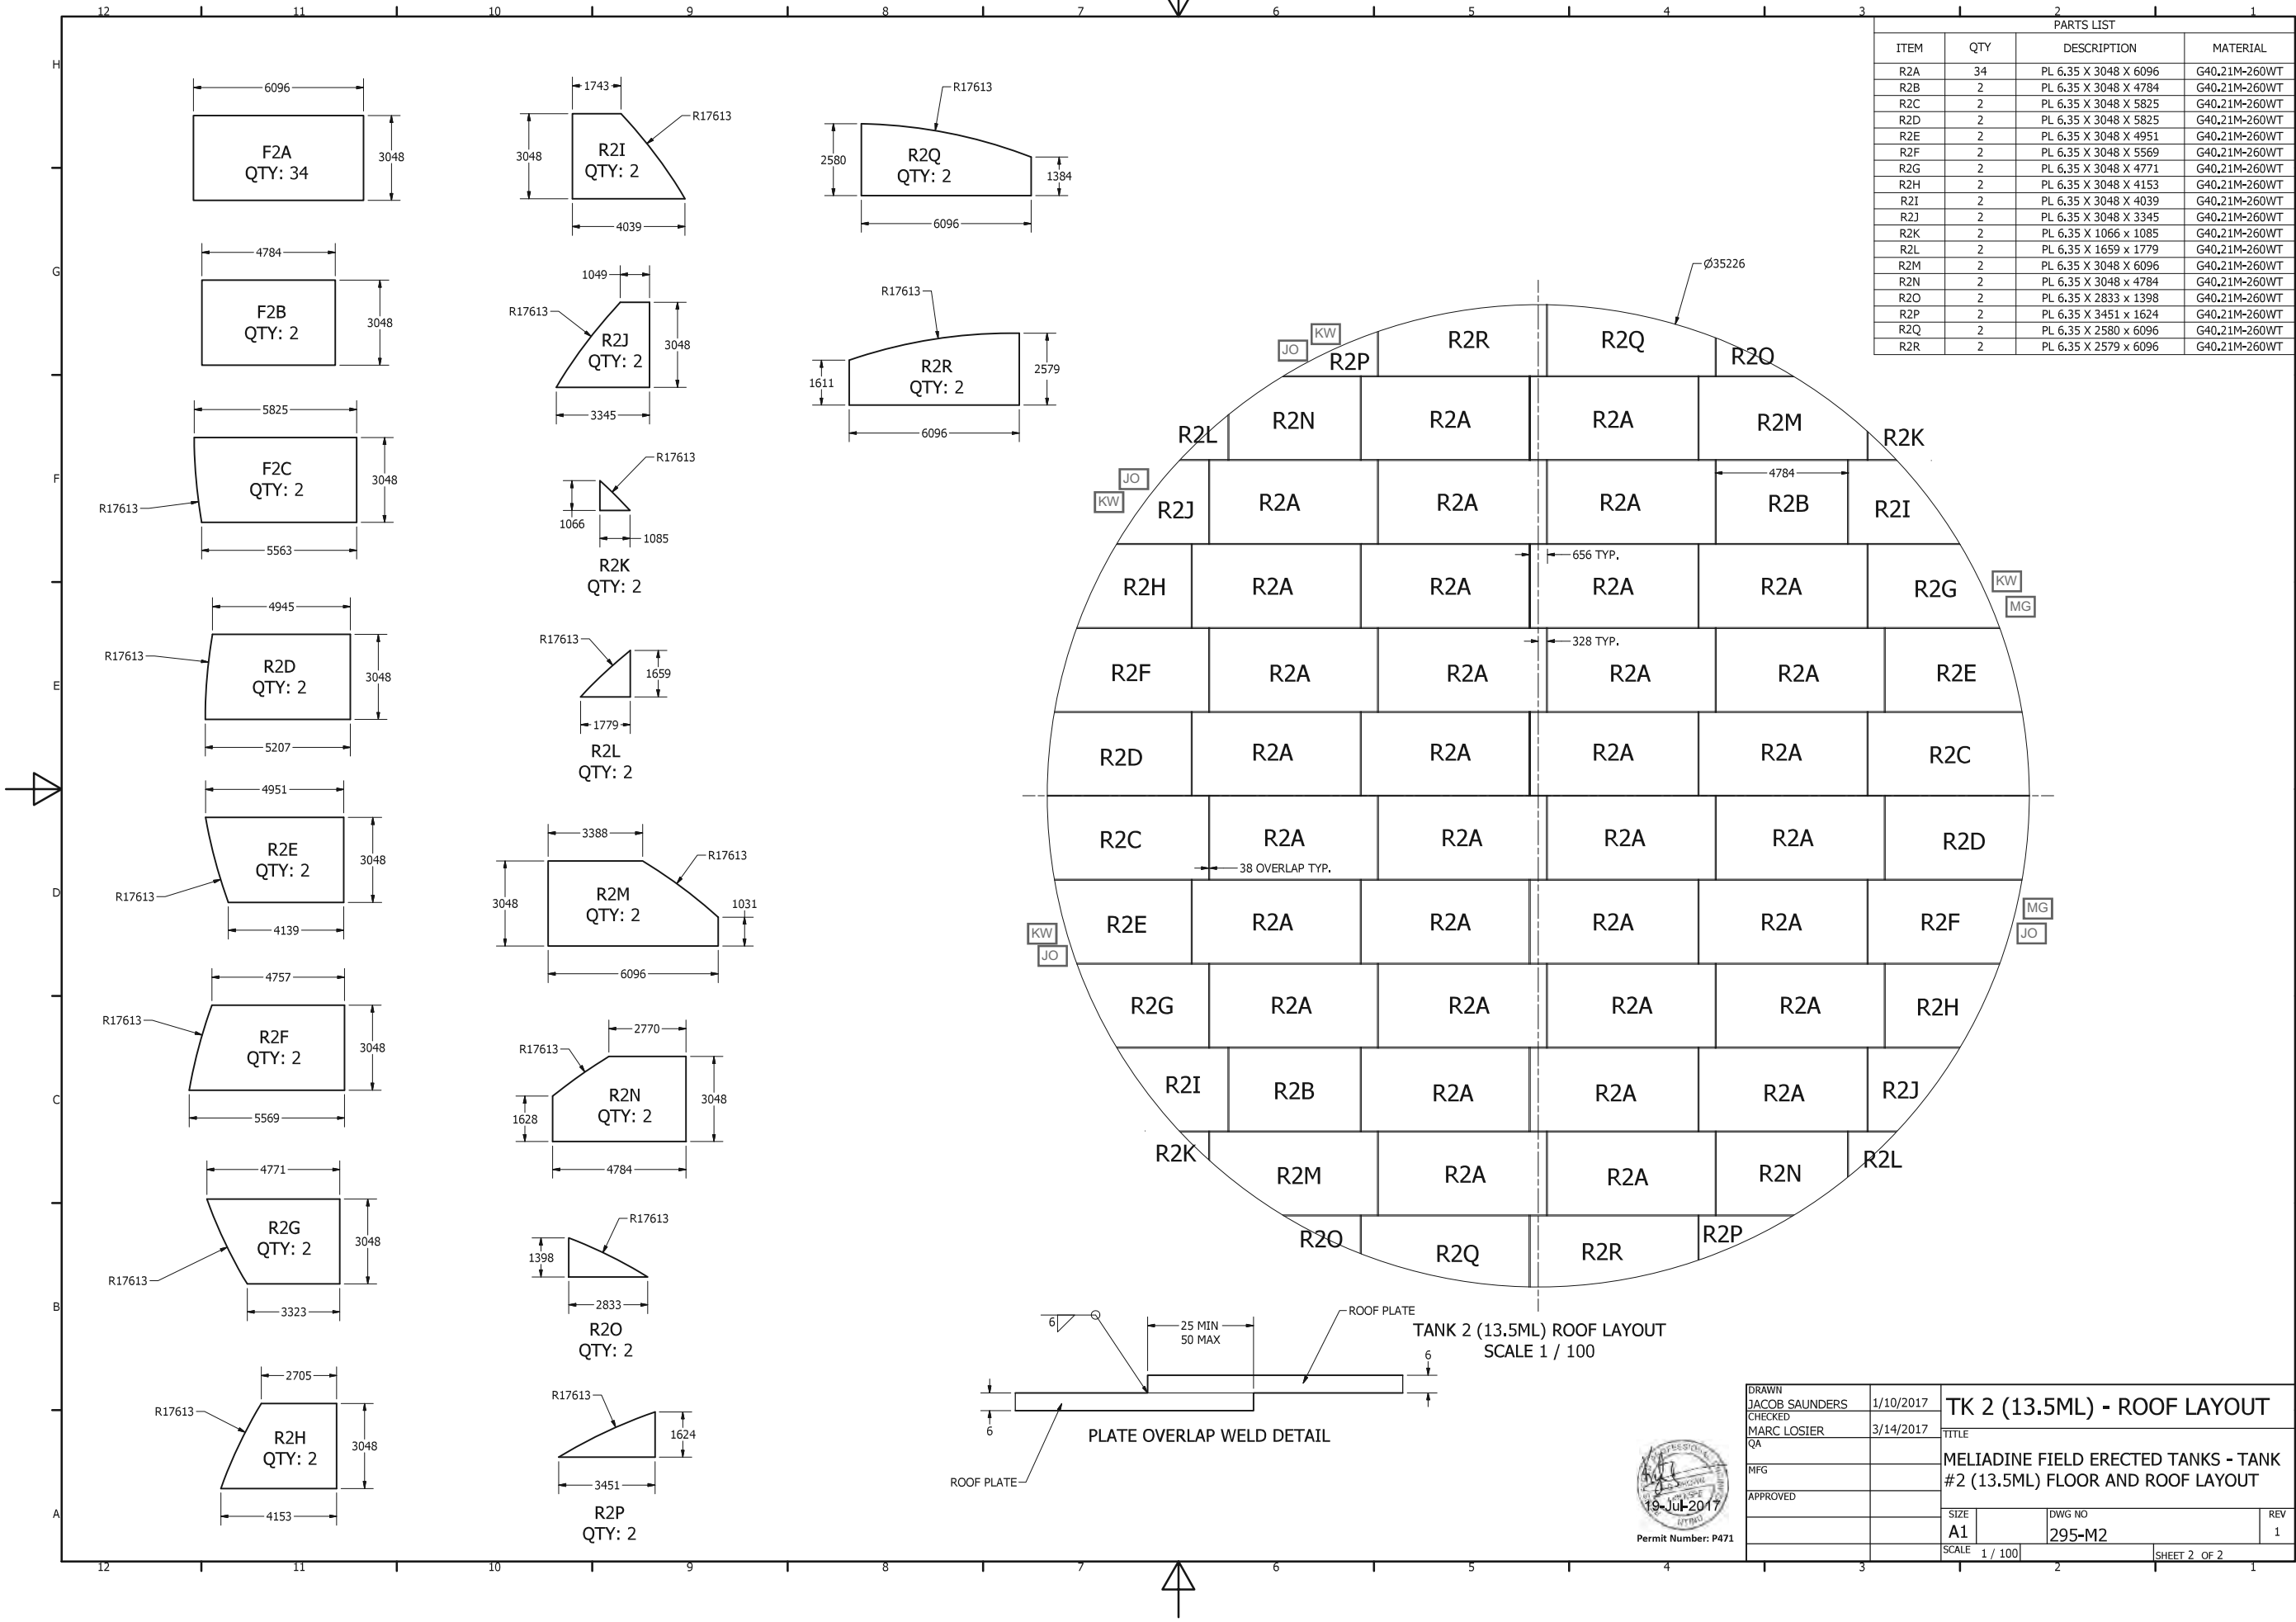

DRAWN JACOB SAUNDERS	1/10/2017	TK 2 (13.5ML) - ROOF LAYOUT	
CHECKED MARC LOSIER	3/14/2017	TITLE	
QA		MELIADINE FIELD ERECTED TANKS - TANK #2 (13.5ML) FLOOR AND ROOF LAYOUT	
MFG			
APPROVED			
		SIZE A1	DWG NO 295-M2
		SCALE 1 / 100	REV 1
		SHEET 2 OF 2	

Item 11 - Compression Ring - Rim Angle to Shell Weld Map

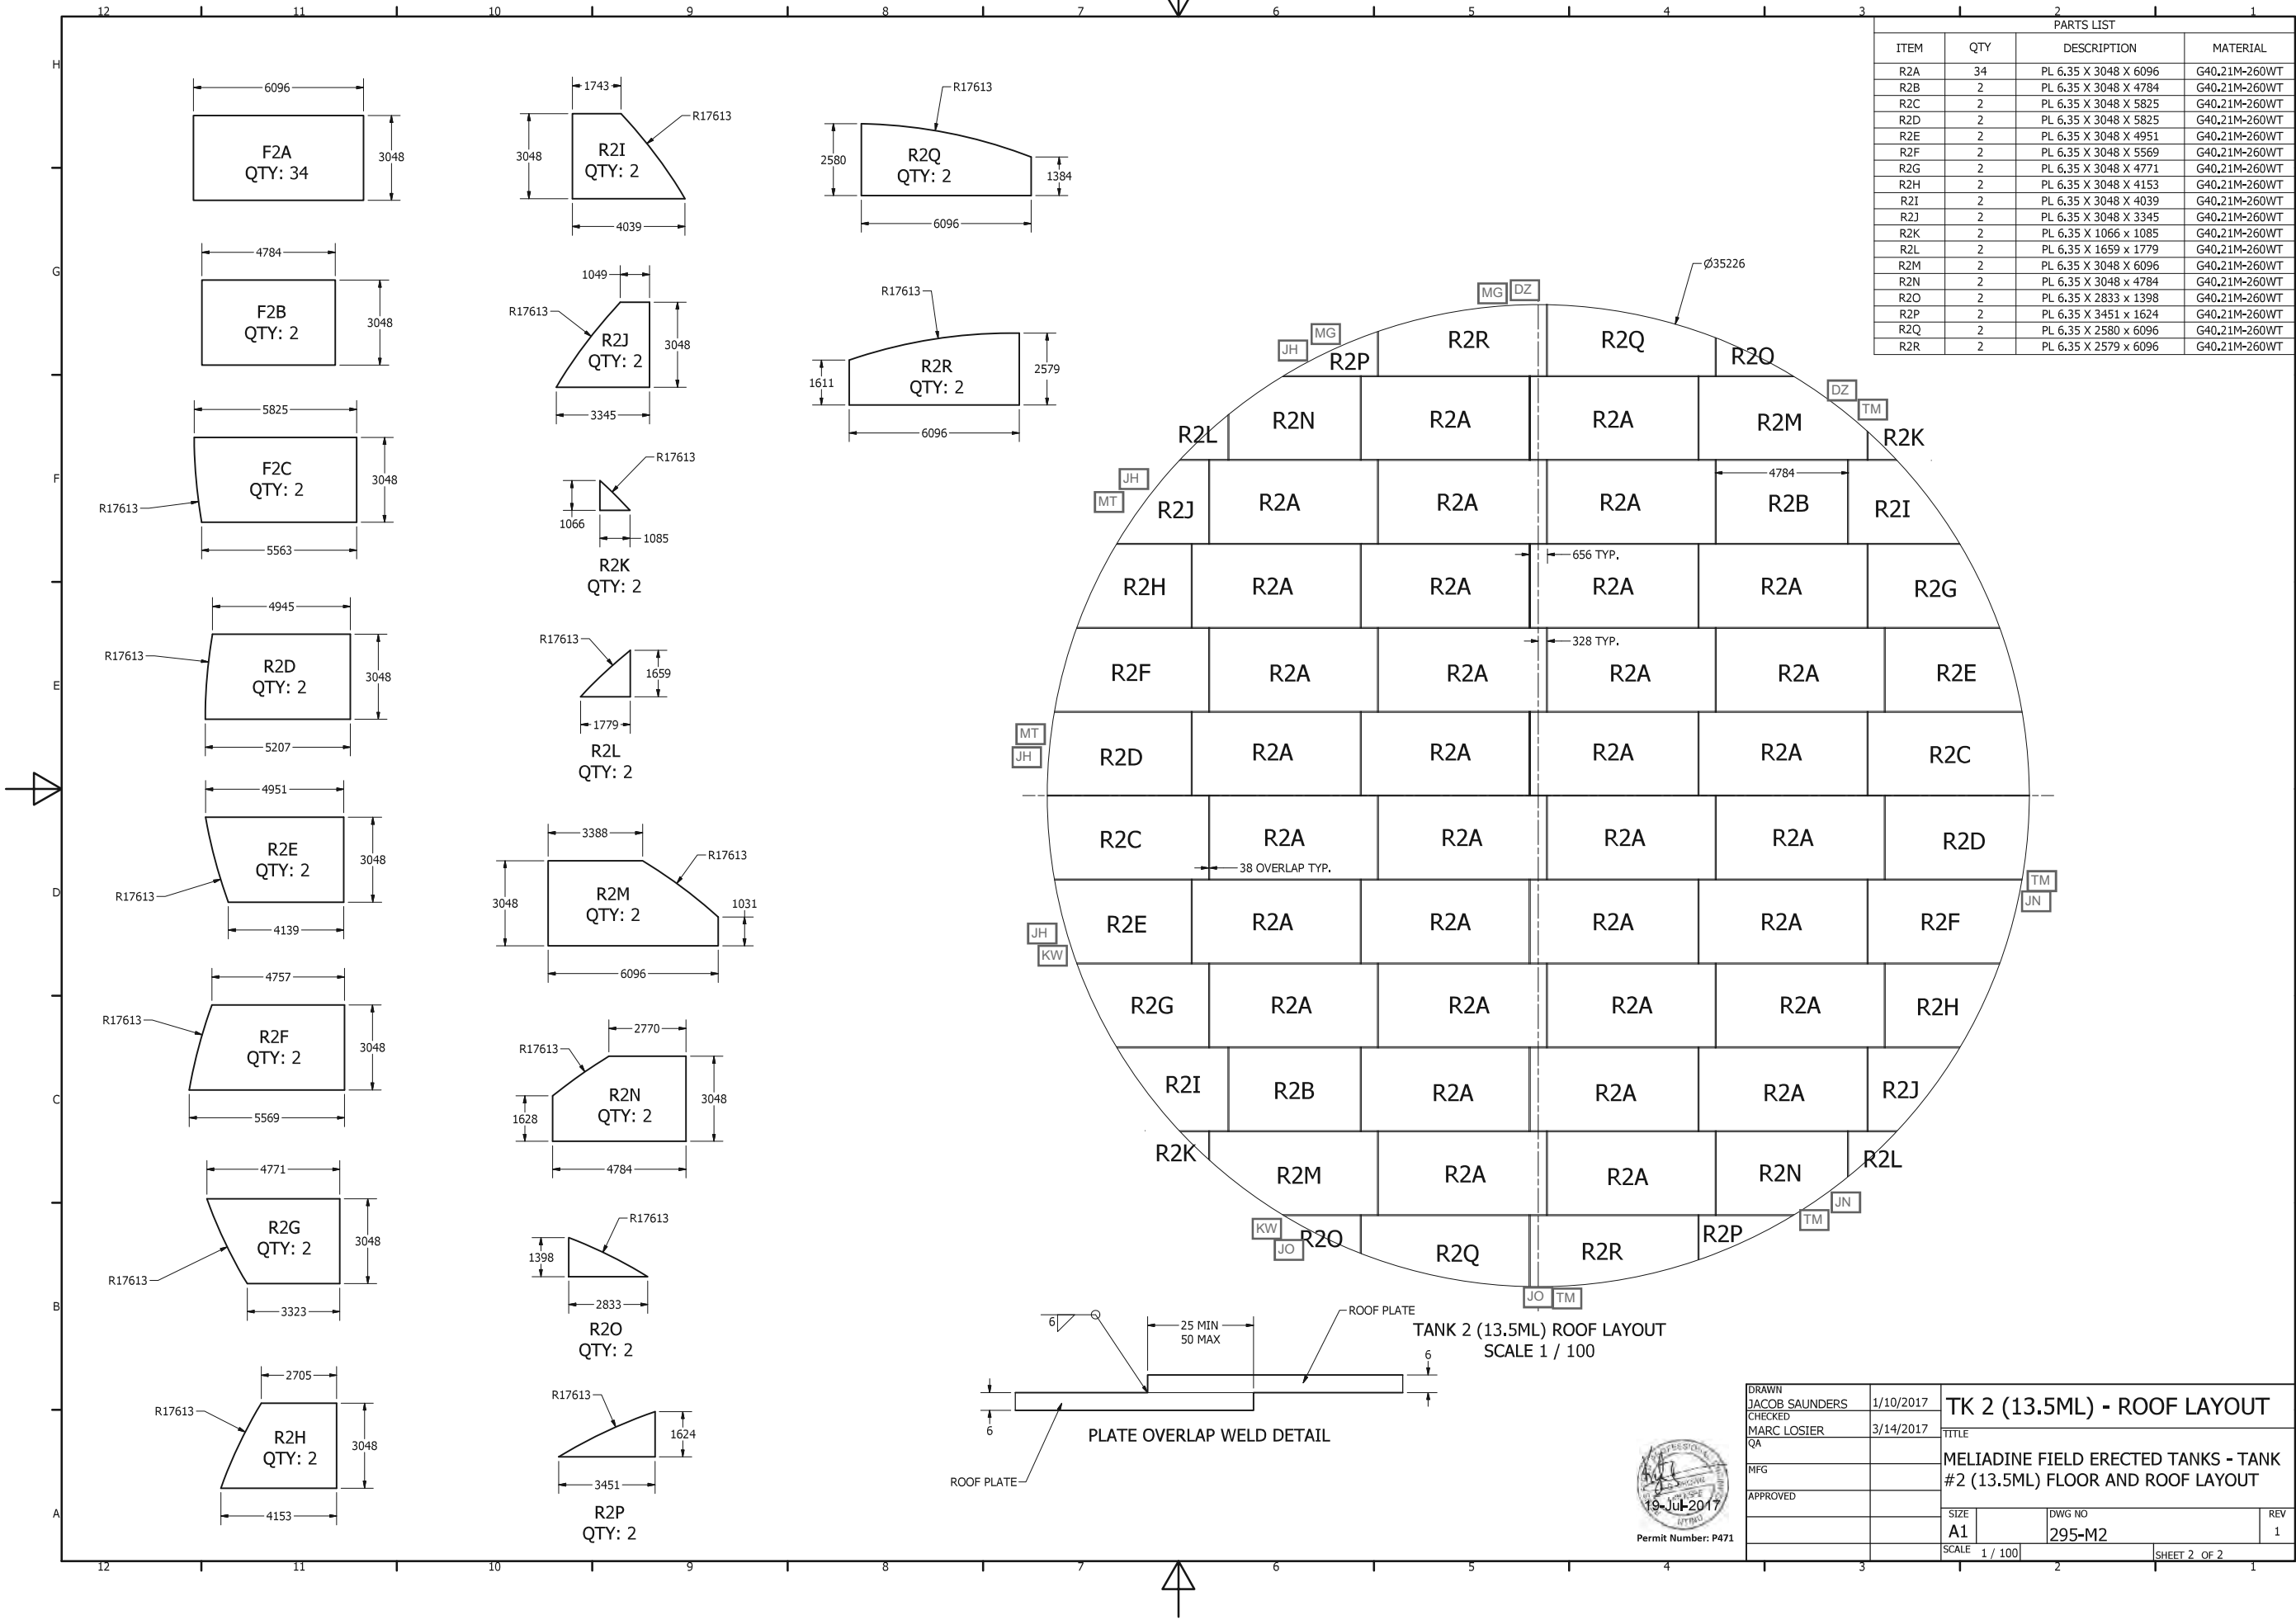

Sub-Arc Systems Inc.

4605-47 Street
Vermillion, AB, T9X 1L6
780-608-9589

QUALITY CONTROL MANUAL

Exhibit 15c, Rev 1

VISUAL TEST REPORT

Customer: Agnico Eagle

Location: Rankin Inlet

Code Requiring Test: API 650 (section 8.5.2)

Reason for Test: New Construction

A weld shall be acceptable by visual examination if the inspection shows the following.

- There are no crater cracks, other surface cracks or arc strikes in or adjacent to the welded joints.
- Maximum permissible undercut is 0.4 mm (1/64 in.) in depth for vertical butt joints, vertically oriented permanent attachments, attachment welds for nozzles, manholes, flush-type openings, and the inside shell-to-bottom welds. For horizontal butt joints, horizontally oriented permanent attachments, and annular-ring butt joints, the maximum permissible undercut is 0.8 mm (1/32 in.) in depth.
- The frequency of surface porosity in the weld does not exceed one cluster (one or more pores) in any 100 mm (4 in.) of length, and the diameter of each cluster does not exceed 2.5 mm (3/32 in.).
- The reinforcement of the welds on all thicknesses:

Plate Thickness mm (in.)	Maximum Reinforcement Thickness mm (in.)	
	Vertical Joints	Horizontal Joints
≤ 13 (1/2)	2.5 (3/32)	3 (1/8)
> 13 (1/2) to 25 (1)	3 (1/8)	5 (3/16)
> 25 (1)	5 (3/16)	6 (1/4)

Surface Condition (As Welded)

Test Solution: N/A

Test Date(s): Aug 20/17Tested by: Mark Mackenzie Ambient Conditions:

Items Tested:

COMPRESSION RING

Results:

NO DEFECTS WERE FOUND. ALL WELDING
ACCEPTABLE.Sub-Arc Representative Signature: [Signature] Date: Aug 20/17

Client Representative Signature: _____ Date: _____

Client Signature: Cherise Clem Bonita Date: Aug 23/17

Item 12 – Roof

Contents

1. Visual Report
2. MTR

Sub-Arc Systems Inc.

4605-47 Street
Vermillion, AB, T9X 1L6
780-608-9589

QUALITY CONTROL MANUAL

Exhibit 15c, Rev 1

VISUAL TEST REPORT

Customer: Agnico Eagle

Location: Rankin Inlet

Code Requiring Test: API 650 (section 8.5.2)

Reason for Test: New Construction

A weld shall be acceptable by visual examination if the inspection shows the following.

- There are no crater cracks, other surface cracks or arc strikes in or adjacent to the welded joints.
- Maximum permissible undercut is 0.4 mm (1/64 in.) in depth for vertical butt joints, vertically oriented permanent attachments, attachment welds for nozzles, manholes, flush-type openings, and the inside shell-to-bottom welds. For horizontal butt joints, horizontally oriented permanent attachments, and annular-ring butt joints, the maximum permissible undercut is 0.8 mm (1/32 in.) in depth.
- The frequency of surface porosity in the weld does not exceed one cluster (one or more pores) in any 100 mm (4 in.) of length, and the diameter of each cluster does not exceed 2.5 mm (3/32 in.).
- The reinforcement of the welds on all thicknesses:

Plate Thickness mm (in.)	Maximum Reinforcement Thickness mm (in.)	
	Vertical Joints	Horizontal Joints
≤ 13 (1/2)	2.5 (3/32)	3 (1/8)
> 13 (1/2) to 25 (1)	3 (1/8)	5 (3/16)
> 25 (1)	5 (3/16)	6 (1/2)

Surface Condition (As Welded)

Test Solution: N/A

Test Date(s): Aug 23/17

Tested by: Matt Mackenzie Ambient Conditions: 17°

Items Tested:

TK-2 ROOF

Results:

VISUAL COMPLETED ON TK-2 ROOF. NO DEFECTS WERE FOUND. ALL WELDING ACCEPTABLE.

Sub-Arc Representative Signature: [Signature] Date: Aug 23/17

Client Representative Signature: _____ Date: _____

Client Signature: Cherise Chern Bonin Date: Aug 23/17



Test Certificate

12400 Highway 43 North, Axis, Alabama 36505, US

Item 12 - Roof - MTR

Form TC1: Revision 2: Date 23 Apr 2014

Customer: SAMUEL, SON & CO. LTD 1250 APPLEBY LINE BURLINGTON ON L7L5G6	Customer P.O.No.: C41966 & 41-490196	Mill Order No. 41-491119-13	Shipping Manifest: AR240131
	Product Description: CSA G40.21(2013) 38WT/260WT - CAT 5;LCVN 15FT.LBS,TCVN13FT.LBS@-45F/A673-P ALLOYS API650(12TH ED) TABLE 4-1 GR.IIIA NORMALIZED		Ship Date: 21 Feb 17 Cert Date: 21 Feb 17
	Size: 0.250 X 120.0 X 480.0 (IN)		Cert No: 081597448 (Page 1 of 2)

Tested Pieces:				Tensiles:						Charpy Impact Tests											
Heat Id	Piece Id	Tested Thickness	Tst Loc	YS (KSI)	UTS (KSI)	%RA	Elong % 2in 8in	Tst Dir	Hardness	Abs. Energy(FTLB) 1 2 3 Avg				% Shear 1 2 3 Avg				Tst Tmp	Tst Dir	Tst Siz (mm)	BDWTT Tmp %Shr
E7B102	E11	0.256 (DISCRT)	C							33	44	37	38					-50F	L	5.0	
			C							35	27	34	32					-50F	T	5.0	
E7B102	E12	0.256 (DISCRT)	C							39	40	36	38					-50F	L	5.0	
			C							27	25	22	25					-50F	T	5.0	
E7B102	E13	0.255 (DISCRT)	C	55	76		26	T		35	34	30	33					-50F	L	5.0	
			C							27	44	41	37					-50F	T	5.0	
E7B102	E14	0.256 (DISCRT)	C	55	75		24	T		56	41	58	52					-50F	L	5.0	
			C							27	32	30	30					-50F	T	5.0	
W7B598	E06	0.256 (DISCRT)	C							30	30	30	30					-50F	L	5.0	
			C							37	27	23	29					-50F	T	5.0	
W7B598	E07	0.256 (DISCRT)	C	52	72		25	T													
W7B598	E08	0.256 (DISCRT)	C	51	71		25	T													
W7B598	E10	0.256 (DISCRT)	C							32	40	31	34					-50F	L	5.0	
			C							28	34	28	30					-50F	T	5.0	

Heat Id		Chemical Analysis																ORGN
		C	Mn	P	S	Si	Tot Al	Sol Al	Cu	Ni	Cr	Mo	Cb	V	Ti	B	N	
E7B102		.18	.94	.009	.001	.25	.027	.025	.26	.12	.11	.05	.002	.005	.011	.0002	.0076	USA
W7B598		.18	.92	.009	.001	.24	.028	.022	.26	.13	.08	.05	.001	.004	.011	.0002	.0078	USA

KILLED STEEL

MERCURY IS NOT A METALLURGICAL COMPONENT OF THE STEEL AND NO MERCURY WAS INTENTIONALLY ADDED DURING THE MANUFACTURE OF THIS PRODUCT.

KILLED STEEL, PRODUCED TO A FINE GRAIN PRACTICE

MTR EN 10204:2004 INSPECTION CERTIFICATE 3.1 COMPLIANT

CHARPY FULL SIZE EQUIVALENT = ABSORBED ENERGY AVG X 10 / TEST SIZE IN MM

NORMALIZED PLATES. HEATED AT 1665F FOR 14 MINUTES.

TEST COUPONS TAKEN FROM HEAT TREATED PLATE.

PRODUCTS SHIPPED:

W7B598 E06	6705201	PCES:	1, LBS:	4084	W7B598 E06	6705200	PCES:	1, LBS:	4084
E7B102 E14	6705250	PCES:	1, LBS:	4084	E7B102 E14	6705249	PCES:	1, LBS:	4084
E7B102 E13	6705243	PCES:	1, LBS:	4084	E7B102 E12	6705236	PCES:	1, LBS:	4084
E7B102 E13	6705244	PCES:	1, LBS:	4084	W7B598 E06	6705199	PCES:	1, LBS:	4084
E7B102 E12	6705235	PCES:	1, LBS:	4084	E7B102 E13	6705234	PCES:	1, LBS:	4084
E7B102 E11	6705193	PCES:	1, LBS:	4084	E7B102 E11	6705190	PCES:	1, LBS:	4084

(P)

Cust Part #:

WE HEREBY CERTIFY THAT THIS MATERIAL WAS
TESTED IN ACCORDANCE WITH, AND MEETS THE
REQUIREMENTS OF, THE APPROPRIATE SPECIFICATION

Justin Ward +1 251 662 4400
SENIOR METALLURGIST - PRODUCT



Test Certificate

12400 Highway 43 North, Axis, Alabama 36505, US

Item 12 - Roof - MTR

Form TC1: Revision 2: Date 23 Apr 2014

Customer: SAMUEL, SON & CO. LTD 1250 APPLEBY LINE BURLINGTON ON L7L5G6	Customer P.O.No.: C41966 & 41-490196		Mill Order No. 41-491119-13	Shipping Manifest: AR240131
	Product Description: CSA G40.21(2013) 38WT/260WT - CAT 5;LCVN 15FT.LBS,TCVN13FT.LBS@-45F/A673-P ALLOYS API650(12TH ED) TABLE 4-1 GR.IIIA NORMALIZED			Ship Date: 21 Feb 17 Cert Date: 21 Feb 17 Cert No: 081597448 (Page 2 of 2)
	Size: 0.250 X 120.0 X 480.0 (IN)			

Tested Pieces:				Tensiles:				Hardness				Charpy Impact Tests								BDWTT	
Heat Id	Piece Id	Tested Thickness	Tst Loc	YS (KSI)	UTS (KSI)	%RA	Elong % 2in 8in	Tst Dir	Hardness	Abs. Energy(FTLB)				% Shear				Tst Tmp	Tst Dir	Tst Siz (mm)	BDWTT Tmp %Shr
W7B598 E10	6705178	PCES:	1, LBS:	4084					E7B102 E11	6705183	PCES:	1, LBS:	4084								
W7B598 E10	6705177	PCES:	1, LBS:	4084					W7B598 E10	6705181	PCES:	1, LBS:	4084								
W7B598 E10	6705179	PCES:	1, LBS:	4084					W7B598 E10	6705189	PCES:	1, LBS:	4084								
W7B598 E10	6705186	PCES:	1, LBS:	4084					E7B102 E11	6705172	PCES:	1, LBS:	4084								
E7B102 E11	6705176	PCES:	1, LBS:	4084					W7B598 E10	6705180	PCES:	1, LBS:	4084								
E7B102 E11	6705192	PCES:	1, LBS:	4084					E7B102 E11	6705194	PCES:	1, LBS:	4084								
E7B102 E11	6705184	PCES:	1, LBS:	4084					E7B102 E11	6705185	PCES:	1, LBS:	4084								
W7B598 E06	6705207	PCES:	1, LBS:	4084					W7B598 E06	6705206	PCES:	1, LBS:	4084								
E7B102 E12	6705239	PCES:	1, LBS:	4084					E7B102 E12	6705231	PCES:	1, LBS:	4084								
E7B102 E14	6705247	PCES:	1, LBS:	4084					E7B102 E13	6705242	PCES:	1, LBS:	4084								
E7B102 E14	6705248	PCES:	1, LBS:	4084					E7B102 E12	6705237	PCES:	1, LBS:	4084								
W7B598 E06	6705209	PCES:	1, LBS:	4084					E7B102 E13	6705240	PCES:	1, LBS:	4084								
E7B102 E12	6705238	PCES:	1, LBS:	4084					W7B598 E06	6705198	PCES:	1, LBS:	4084								
E7B102 E14	6705251	PCES:	1, LBS:	4084					W7B598 E06	6705197	PCES:	1, LBS:	4084								
E7B102 E13	6705241	PCES:	1, LBS:	4084					E7B102 E12	6705230	PCES:	1, LBS:	4084								

(P)

Cust Part #:

WE HEREBY CERTIFY THAT THIS MATERIAL WAS
TESTED IN ACCORDANCE WITH, AND MEETS THE
REQUIREMENTS OF, THE APPROPRIATE SPECIFICATION

Justin Ward +1 251 662 4400
SENIOR METALLURGIST - PRODUCT



Test Certificate

12400 Highway 43 North, Axis, Alabama 36505, US

Item 12 - Roof - MTR

Form TC1: Revision 2: Date 23 Apr 2014

Customer: SAMUEL, SON & CO. LTD 1250 APPLEBY LINE BURLINGTON ON L7L5G6	Customer P.O.No.: C41965 & 41-490195	Mill Order No. 41-491117-01	Shipping Manifest: AR240135
	Product Description: CSA G40.21(2013) 38WT/260WT - CAT 5;LCVN 15FT.LBS,TCVN13FT.LBS@-45F/A673-P ALLOYS API650(12TH ED) TABLE 4-1 GR.IIIA NORMALIZED		Ship Date: 21 Feb 17 Cert Date: 21 Feb 17
	Size: 0.250 X 120.0 X 480.0 (IN)		Cert No: 081597458 (Page 1 of 2)

Tested Pieces:				Tensiles:						Charpy Impact Tests											
Heat Id	Piece Id	Tested Thickness	Tst Loc	YS (KSI)	UTS (KSI)	%RA	Elong % 2in 8in	Tst Dir	Hardness	Abs. Energy(FTLB) 1 2 3 Avg				% Shear 1 2 3 Avg				Tst Tmp	Tst Dir	Tst Siz (mm)	BDWTT Tmp %Shr
E7B101	E01	0.256 (DISCRT)	C	53	75		25	T		37	27	59	41				-50F	L	5.0		
E7B101	E02	0.256 (DISCRT)	C							24	36	28	29				-50F	T	5.0		
E7B101	E03	0.256 (DISCRT)	C	54	75		27	T		51	62	61	58				-50F	L	5.0		
			C							37	30	27	31				-50F	T	5.0		
E7B101	E04	0.256 (DISCRT)	C							22	33	38	31				-50F	L	5.0		
			C							42	37	48	42				-50F	T	5.0		
E7B101	E05	0.256 (DISCRT)	C							61	49	61	57				-50F	L	5.0		
			C							32	41	32	35				-50F	T	5.0		
W7B598	E07	0.256 (DISCRT)	C	52	72		25	T													
W7B598	E08	0.256 (DISCRT)	C	51	71		25	T		33	31	37	34				-45F	L	5.0		
			C							30	28	31	30				-45F	T	5.0		
W7B598	E09	0.256 (DISCRT)	C							43	31	55	43				-50F	L	5.0		
			C							33	30	31	31				-50F	T	5.0		

Heat Id		Chemical Analysis																ORGN
		C	Mn	P	S	Si	Tot Al	Sol Al	Cu	Ni	Cr	Mo	Cb	V	Ti	B	N	
E7B101		.19	.92	.010	<.001	.24	.022	.020	.24	.13	.10	.04	.002	.005	.010	.0002	.0069	USA
W7B598		.18	.92	.009	.001	.24	.028	.022	.26	.13	.08	.05	.001	.004	.011	.0002	.0078	USA

KILLED STEEL

MERCURY IS NOT A METALLURGICAL COMPONENT OF THE STEEL AND NO MERCURY WAS INTENTIONALLY ADDED DURING THE MANUFACTURE OF THIS PRODUCT.

KILLED STEEL, PRODUCED TO A FINE GRAIN PRACTICE

MTR EN 10204:2004 INSPECTION CERTIFICATE 3.1 COMPLIANT

CHARPY FULL SIZE EQUIVALENT = ABSORBED ENERGY AVG X 10 / TEST SIZE IN MM

NORMALIZED PLATES. HEATED AT 1665F FOR 14 MINUTES.

TEST COUPONS TAKEN FROM HEAT TREATED PLATE.

PRODUCTS SHIPPED:

E7B101 E05	6705084	PCES:	1, LBS:	4084	E7B101 E02	6705125	PCES:	1, LBS:	4084
E7B101 E02	6705123	PCES:	1, LBS:	4084	E7B101 E05	6705086	PCES:	1, LBS:	4084
E7B101 E03	6705100	PCES:	1, LBS:	4084	E7B101 E05	6705085	PCES:	1, LBS:	4084
E7B101 E02	6705124	PCES:	1, LBS:	4084	W7B598 E08	6705042	PCES:	1, LBS:	4084
W7B598 E08	6705041	PCES:	1, LBS:	4084	W7B598 E08	6705040	PCES:	1, LBS:	4084
W7B598 E09	6705038	PCES:	1, LBS:	4084	W7B598 E08	6705043	PCES:	1, LBS:	4084

(P)

Cust Part #:

WE HEREBY CERTIFY THAT THIS MATERIAL WAS
TESTED IN ACCORDANCE WITH, AND MEETS THE
REQUIREMENTS OF, THE APPROPRIATE SPECIFICATION

Justin Ward +1 251 662 4400
SENIOR METALLURGIST - PRODUCT



12400 Highway 43 North, Axis, Alabama 36505, US

Test Certificate

Item 12 - Roof - MTR

Form TC1: Revision 2: Date 23 Apr 2014

Customer: SAMUEL, SON & CO. LTD 1250 APPLEBY LINE BURLINGTON ON L7L5G6	Customer P.O.No.: C41965 & 41-490195		Mill Order No. 41-491117-01	Shipping Manifest: AR240135	
	Product Description: CSA G40.21(2013) 38WT/260WT - CAT 5;LCVN 15FT.LBS,TCVN13FT.LBS@-45F/A673-P ALLOYS API650(12TH ED) TABLE 4-1 GR.IIIA NORMALIZED			Ship Date: 21 Feb 17 Cert Date: 21 Feb 17	Cert No: 081597458 (Page 2 of 2)
	Size: 0.250 X 120.0 X 480.0 (IN)				

Tested Pieces:				Tensiles:					Charpy Impact Tests												BDWTT Tst %Shr	
Heat Id	Piece Id	Tested Thickness	Tst Loc	YS (KSI)	UTS (KSI)	%RA	Elong % 2in 8in	Tst Dir	Hardness	Abs. Energy(FTLB)				% Shear				Tst Tst	Dir	Tst Siz (mm)		
										1	2	3	Avg	1	2	3	Avg					
W7B598	E08	6705039	PCES:	1, LBS:	4084				E7B101 E05	6705087	PCES:	1, LBS:	4084					4084				
W7B598	E08	6705052	PCES:	1, LBS:	4084				W7B598 E08	6705050	PCES:	1, LBS:	4084					4084				
W7B598	E08	6705049	PCES:	1, LBS:	4084				W7B598 E08	6705044	PCES:	1, LBS:	4084					4084				
W7B598	E08	6705045	PCES:	1, LBS:	4084				E7B101 E04	6705126	PCES:	1, LBS:	4084					4084				
E7B101	E02	6705151	PCES:	1, LBS:	4084				E7B101 E02	6705152	PCES:	1, LBS:	4084					4084				
E7B101	E02	6705150	PCES:	1, LBS:	4084				E7B101 E05	6705162	PCES:	1, LBS:	4084					4084				
E7B101	E05	6705160	PCES:	1, LBS:	4084				E7B101 E05	6705153	PCES:	1, LBS:	4084					4084				
E7B101	E05	6705161	PCES:	1, LBS:	4084				E7B101 E04	6705129	PCES:	1, LBS:	4084					4084				
E7B101	E04	6705127	PCES:	1, LBS:	4084				E7B101 E04	6705130	PCES:	1, LBS:	4084					4084				
E7B101	E04	6705128	PCES:	1, LBS:	4084				E7B101 E05	6705163	PCES:	1, LBS:	4084					4084				
E7B101	E02	6705149	PCES:	1, LBS:	4084				E7B101 E04	6705102	PCES:	1, LBS:	4084					4084				
W7B598	E08	6705046	PCES:	1, LBS:	4084																	

(P)

Cust Part #:

WE HEREBY CERTIFY THAT THIS MATERIAL WAS
TESTED IN ACCORDANCE WITH, AND MEETS THE
REQUIREMENTS OF, THE APPROPRIATE SPECIFICATION

Justin Ward +1 251 662 4400
SENIOR METALLURGIST - PRODUCT



Test Certificate

12400 Highway 43 North, Axis, Alabama 36505, US

Item 12 - Roof - MTR

Form TC1: Revision 2: Date 23 Apr 2014

Customer: SAMUEL, SON & CO. LTD 1250 APPLEBY LINE BURLINGTON ON L7L5G6	Customer P.O.No.: C41965 & 41-496189	Mill Order No. 41-496191-01	Shipping Manifest: AR240215
	Product Description: CSA G40.21(2013) 38WT/260WT - CAT 5;LCVN 1500 LBS, 2 CVN RPT: 1650 F 45F/A673-P ALLOYS API650(12TH ED) TABLE 4-1 GR.IIIA NORMALIZED		Ship Date: 22 Feb 17 Cert Date: 22 Feb 17
	Size: 0.250 X 120.0 X 480.0 (IN)		Cert No: 081597726 (Page 1 of 2)

Tested Pieces:				Tensiles:						Charpy Impact Tests											
Heat Id	Piece Id	Tested Thickness	Tst Loc	YS (KSI)	UTS (KSI)	%RA	Elong % 2in 8in	Tst Dir	Hardness	Abs. Energy(FTLB) 1 2 3 Avg				% Shear 1 2 3 Avg				Tst Tmp	Tst Dir	Tst Siz (mm)	BDWTT Tmp %Shr
E7B102	E13	0.255 (DISCRT)	C	55	76		26	T		35	34	30	33				-50F	L	5.0		
			C							27	44	41	37				-50F	T	5.0		
W7B598	E07	0.256 (DISCRT)	C	52	72		25	T		36	34	32	34				-45F	L	5.0		
			C							30	29	27	29				-45F	T	5.0		
W7B598	E08	0.256 (DISCRT)	C	51	71		25	T													
W7B598	E09	0.256 (DISCRT)	C							43	31	55	43				-50F	L	5.0		
			C							33	30	31	31				-50F	T	5.0		
W7B598	E10	0.256 (DISCRT)	C							32	40	31	34				-50F	L	5.0		
			C							28	34	28	30				-50F	T	5.0		

Heat		Chemical Analysis																ORGN
Id		C	Mn	P	S	Si	Tot Al	Sol Al	Cu	Ni	Cr	Mo	Cb	V	Ti	B	N	
E7B102		.18	.94	.009	.001	.25	.027	.025	.26	.12	.11	.05	.002	.005	.011	.0002	.0076	USA
W7B598		.18	.92	.009	.001	.24	.028	.022	.26	.13	.08	.05	.001	.004	.011	.0002	.0078	USA

KILLED STEEL

MERCURY IS NOT A METALLURGICAL COMPONENT OF THE STEEL AND NO MERCURY WAS INTENTIONALLY ADDED DURING THE MANUFACTURE OF THIS PRODUCT.

KILLED STEEL, PRODUCED TO A FINE GRAIN PRACTICE

MTR EN 10204:2004 INSPECTION CERTIFICATE 3.1 COMPLIANT

CHARPY FULL SIZE EQUIVALENT = ABSORBED ENERGY AVG X 10 / TEST SIZE IN MM

NORMALIZED PLATES. HEATED AT 1665F FOR 15 MINUTES.

TEST COUPONS TAKEN FROM HEAT TREATED PLATE.

PRODUCTS SHIPPED:

W7B598 E10	6705182	PCES:	1, LBS:	4084	W7B598 E07	6705202	PCES:	1, LBS:	4084
W7B598 E07	6705203	PCES:	1, LBS:	4084	W7B598 E07	6705204	PCES:	1, LBS:	4084
W7B598 E07	6705205	PCES:	1, LBS:	4084	W7B598 E09	6705210	PCES:	1, LBS:	4084
W7B598 E07	6705211	PCES:	1, LBS:	4084	W7B598 E07	6705212	PCES:	1, LBS:	4084
W7B598 E07	6705213	PCES:	1, LBS:	4084	W7B598 E07	6705214	PCES:	1, LBS:	4084
W7B598 E07	6705215	PCES:	1, LBS:	4084	W7B598 E10	6705216	PCES:	1, LBS:	4084
W7B598 E10	6705217	PCES:	1, LBS:	4084	W7B598 E10	6705218	PCES:	1, LBS:	4084
W7B598 E10	6705219	PCES:	1, LBS:	4084	W7B598 E09	6705220	PCES:	1, LBS:	4084
W7B598 E09	6705221	PCES:	1, LBS:	4084	W7B598 E09	6705222	PCES:	1, LBS:	4084
W7B598 E09	6705223	PCES:	1, LBS:	4084	E7B102 E13	6705232	PCES:	1, LBS:	4084
E7B102 E13	6705233	PCES:	1, LBS:	4084	E7B102 E13	6705245	PCES:	1, LBS:	4084

(P)

Cust Part #:

WE HEREBY CERTIFY THAT THIS MATERIAL WAS
TESTED IN ACCORDANCE WITH, AND MEETS THE
REQUIREMENTS OF, THE APPROPRIATE SPECIFICATION

Justin Ward +1 251 662 4400
SENIOR METALLURGIST - PRODUCT

Item 13 – Roof Structure

Contents

1. Column Plumbness Dimension Report
2. Visual Report

Sub-Arc Systems Inc.

4605-47 Street
Vermillion, AB, T9X 1L6
780-608-9589

QUALITY CONTROL MANUAL

Exhibit 19, Rev A

DIMENSIONAL CHECK REPORT - PLUMBNESS

Customer: AGNICO EAGLE

Location: BANKIN INLET. TK.02

Equipment Tag No.:

Equipment Type:

Equipment Description:

Code Requiring Test: API 650

Reason for Test: New Construction

(The tank shell will be checked for plumb at 12" below the tank roof. Plumb measurements will be checked at 45 degree intervals or less, max. 20' spacing)

Test Date(s): AUG 31/17

Tested by: MATT MACKENZIE

Seam Test Results:

ALL ROOF STRUCTURE COLUMNS ARE
PLUMB. + ACCEPTABLE AT TIME OF
INSPECTION.

Sub-Arc Representative Signature: [Signature] Date: AUG 31/17.

Client Representative Signature: _____ Date: _____

Client Signature: [Signature] Date: Sept 04/17

QUALITY CONTROL MANUAL

VISUAL TEST REPORT

Exhibit 15c, Rev 1

Customer: Agnico Eagle

Location: Rankin Inlet

Code Requiring Test: API 650 (section 8.5.2)

Reason for Test: New Construction

A weld shall be acceptable by visual examination if the inspection shows the following.

- There are no crater cracks, other surface cracks or arc strikes in or adjacent to the welded joints.
- Maximum permissible undercut is 0.4 mm (1/64 in.) in depth for vertical butt joints, vertically oriented permanent attachments, attachment welds for nozzles, manholes, flush-type openings, and the inside shell-to-bottom welds. For horizontal butt joints, horizontally oriented permanent attachments, and annular-ring butt joints, the maximum permissible undercut is 0.8 mm (1/32 in.) in depth.
- The frequency of surface porosity in the weld does not exceed one cluster (one or more pores) in any 100 mm (4 in.) of length, and the diameter of each cluster does not exceed 2.5 mm (3/32 in.).
- The reinforcement of the welds on all thicknesses:

Plate Thickness mm (in.)	Maximum Reinforcement thickness mm (in.)	
	Vertical Joints	Horizontal Joints
≤ 13 (1/2)	2.5 (3/32)	3 (1/8)
> 13 (1/2) to 25 (1)	3 (1/8)	5 (3/16)
> 25 (1)	5 (3/16)	6 (1/2)

Surface Condition (As Welded)

Test Solution: N/A

Test Date(s): AUG 23/17Tested by: MATT MACKENZIEAmbient Conditions: 17°

Items Tested:

ROOF STRUCTURE

Results:

ALL ROOF STRUCTURE WELDING + BOLT UP ACCEPTABLE.Sub-Arc Representative Signature: *Matthew Mackenzie* Date: AUG 23/17

Client Representative Signature: _____ Date: _____

Client Signature: *Clem Bonita* Date: AUG 23/17

Item 14 - Nozzles

Contents

1. Weld Map
2. Plumbness Dimension Report
3. Visual Report
4. Air Test – Leak Test Report
5. MPI Report
6. PVRV Test Reports