





Agnico-Eagle Mines Ltd.  
Pressure Test Report

ITR Number : AEM-PI-ITR-001  
Contract no. : C22466T



Design Code	Design Test Pressure	Test Medium	Medium Temp.	Test Duration
	60 PSI	Pneumatic		60 min

P&ID (Highlight Boundaries)	Rev	Line	Drawing/ISO	Rev	Spool
65-116-205-200	2	116-150-PD1-CC10-0001	103-150-PD1-CC10-001	0	Pg 1-9
11	2	116-150-PD1-CC10-002	103-150-PD1-CC10-002	0	Pg 1-3

Pressure Test Specifications

	Contractor	Date (dd-mm-yy)	Client	Date (dd-mm-yy)
Pre-Hydro Inspection				
NDE/PWHT Clearance				
Release for Test				

Test Instruments

	Make/Model	Serial Number	Test Range (psi)	Calibration Date
Upper	Winters PFO Series	617-0675	0-300 PSI	May 15 2017
Lower				

Test Data

	Time	Test Pressure	Ambient Temp. (C)	Pipe Temp. (C)	Comments
Start	4 h 46 PM	60 PSI	-2	-2	
Finish	5 h 46 PM	60 PSI	-2	-2	

Comments/Referenced Documents (e.g. applicable field reports):

PRESSURE TEST COMPLETE

Contractor Representative		Client Representative	
Robert Lemothé		Stephane Gienet	
Name (Print)	Signature	Name (Print)	Signature
	7 Oct 2017		07 Oct, 2017
	Date		Date

LINE RESTORATION COMPLETE

Contractor Representative		Client Representative	
Robert Lemothé		Stephane Gienet	
Name (Print)	Signature	Name (Print)	Signature
	8 Oct 2017		08 Oct, 2017
	Date		Date











## Pigging of Pipe


1 fois le RX 3

1 fois le RX4

6 fois le RX5

2 fois le G1 swabs



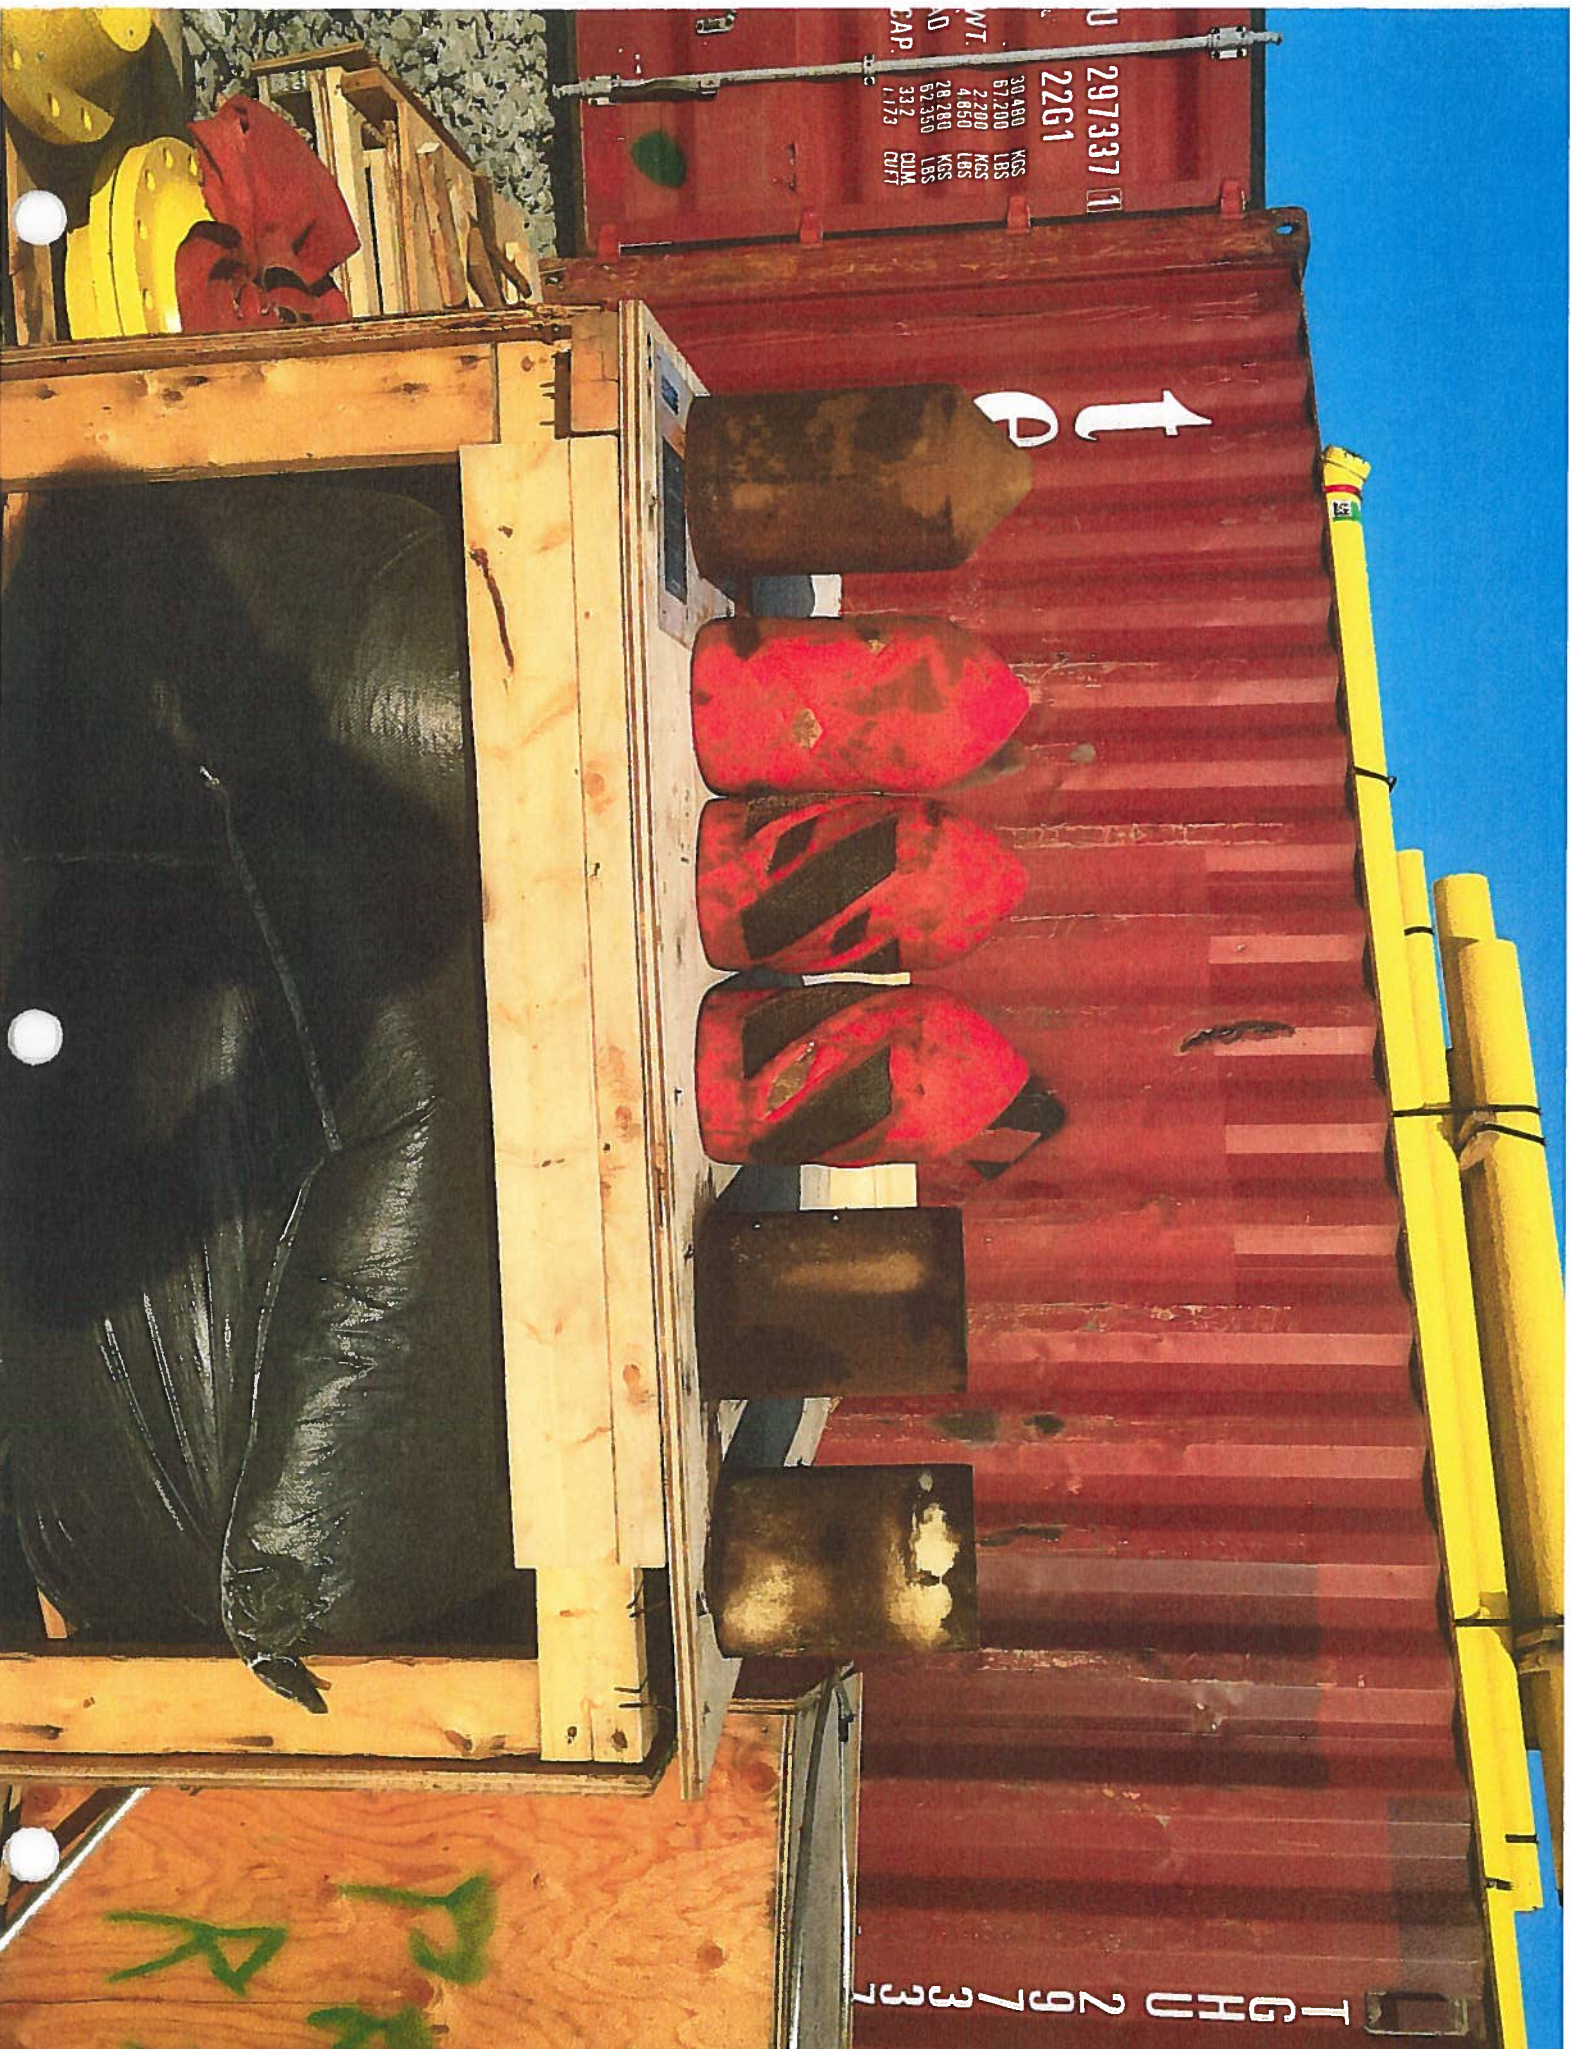


WT. 30,480 KGS  
CAP. 67,200 LBS  
2,200 KGS  
4,850 LBS  
28,280 KGS  
67,350 LBS  
332 DIM  
1,173 CMT

297337 1  
2261


↑

IGHD 2073337




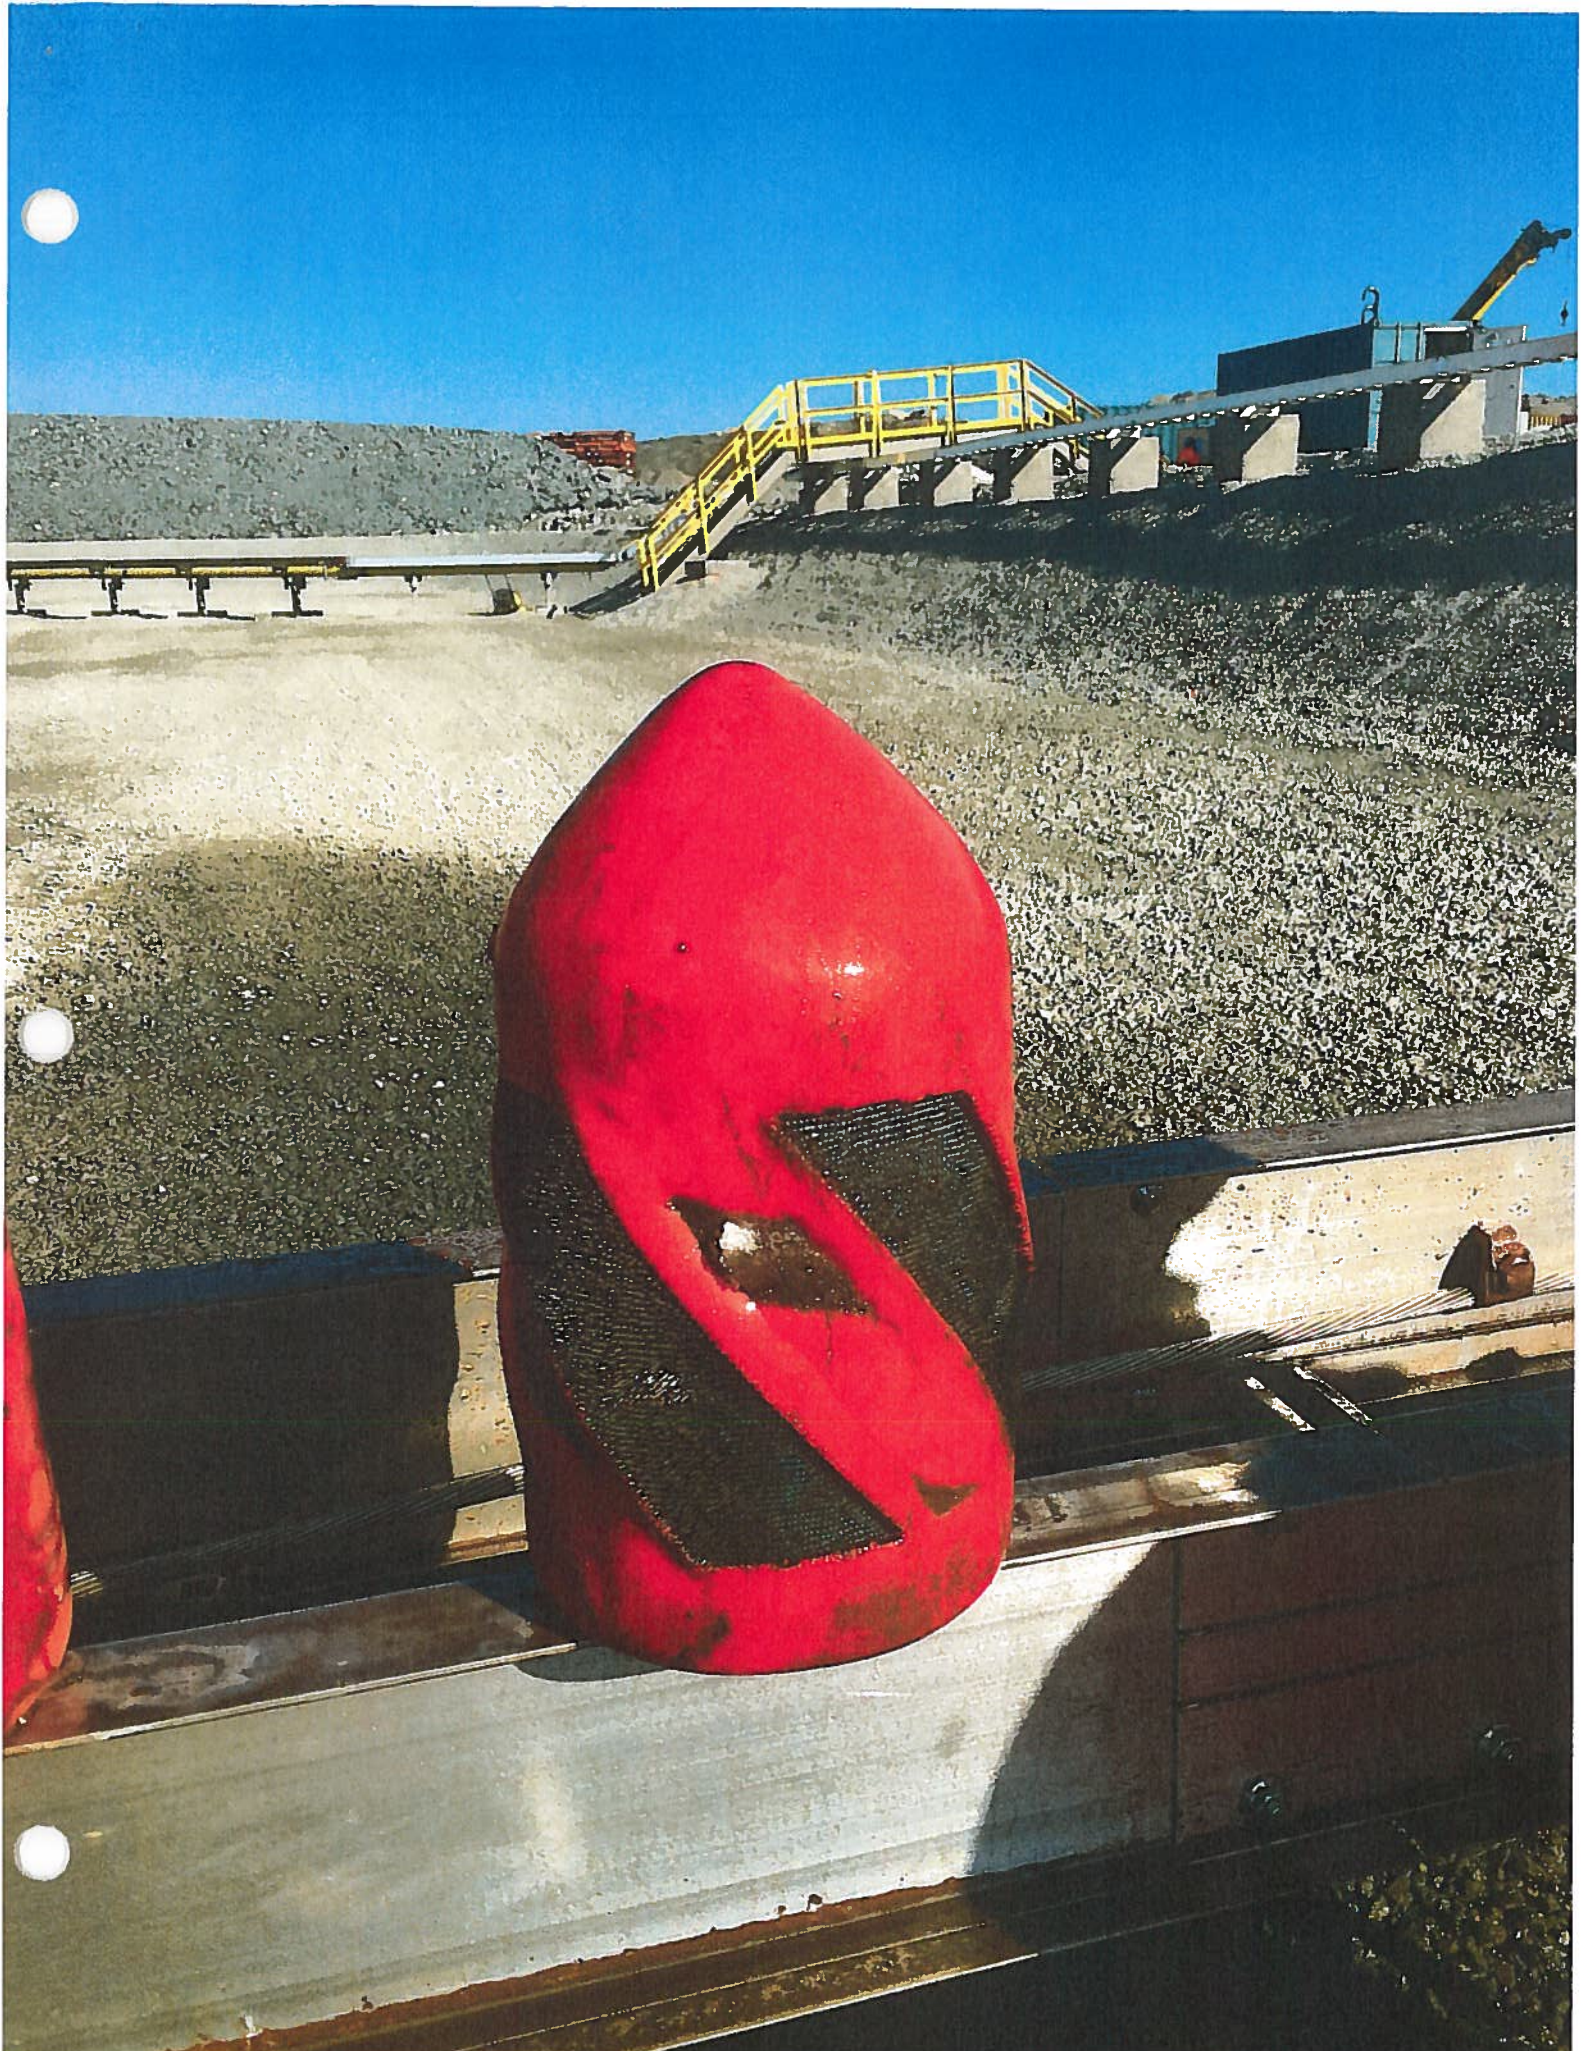



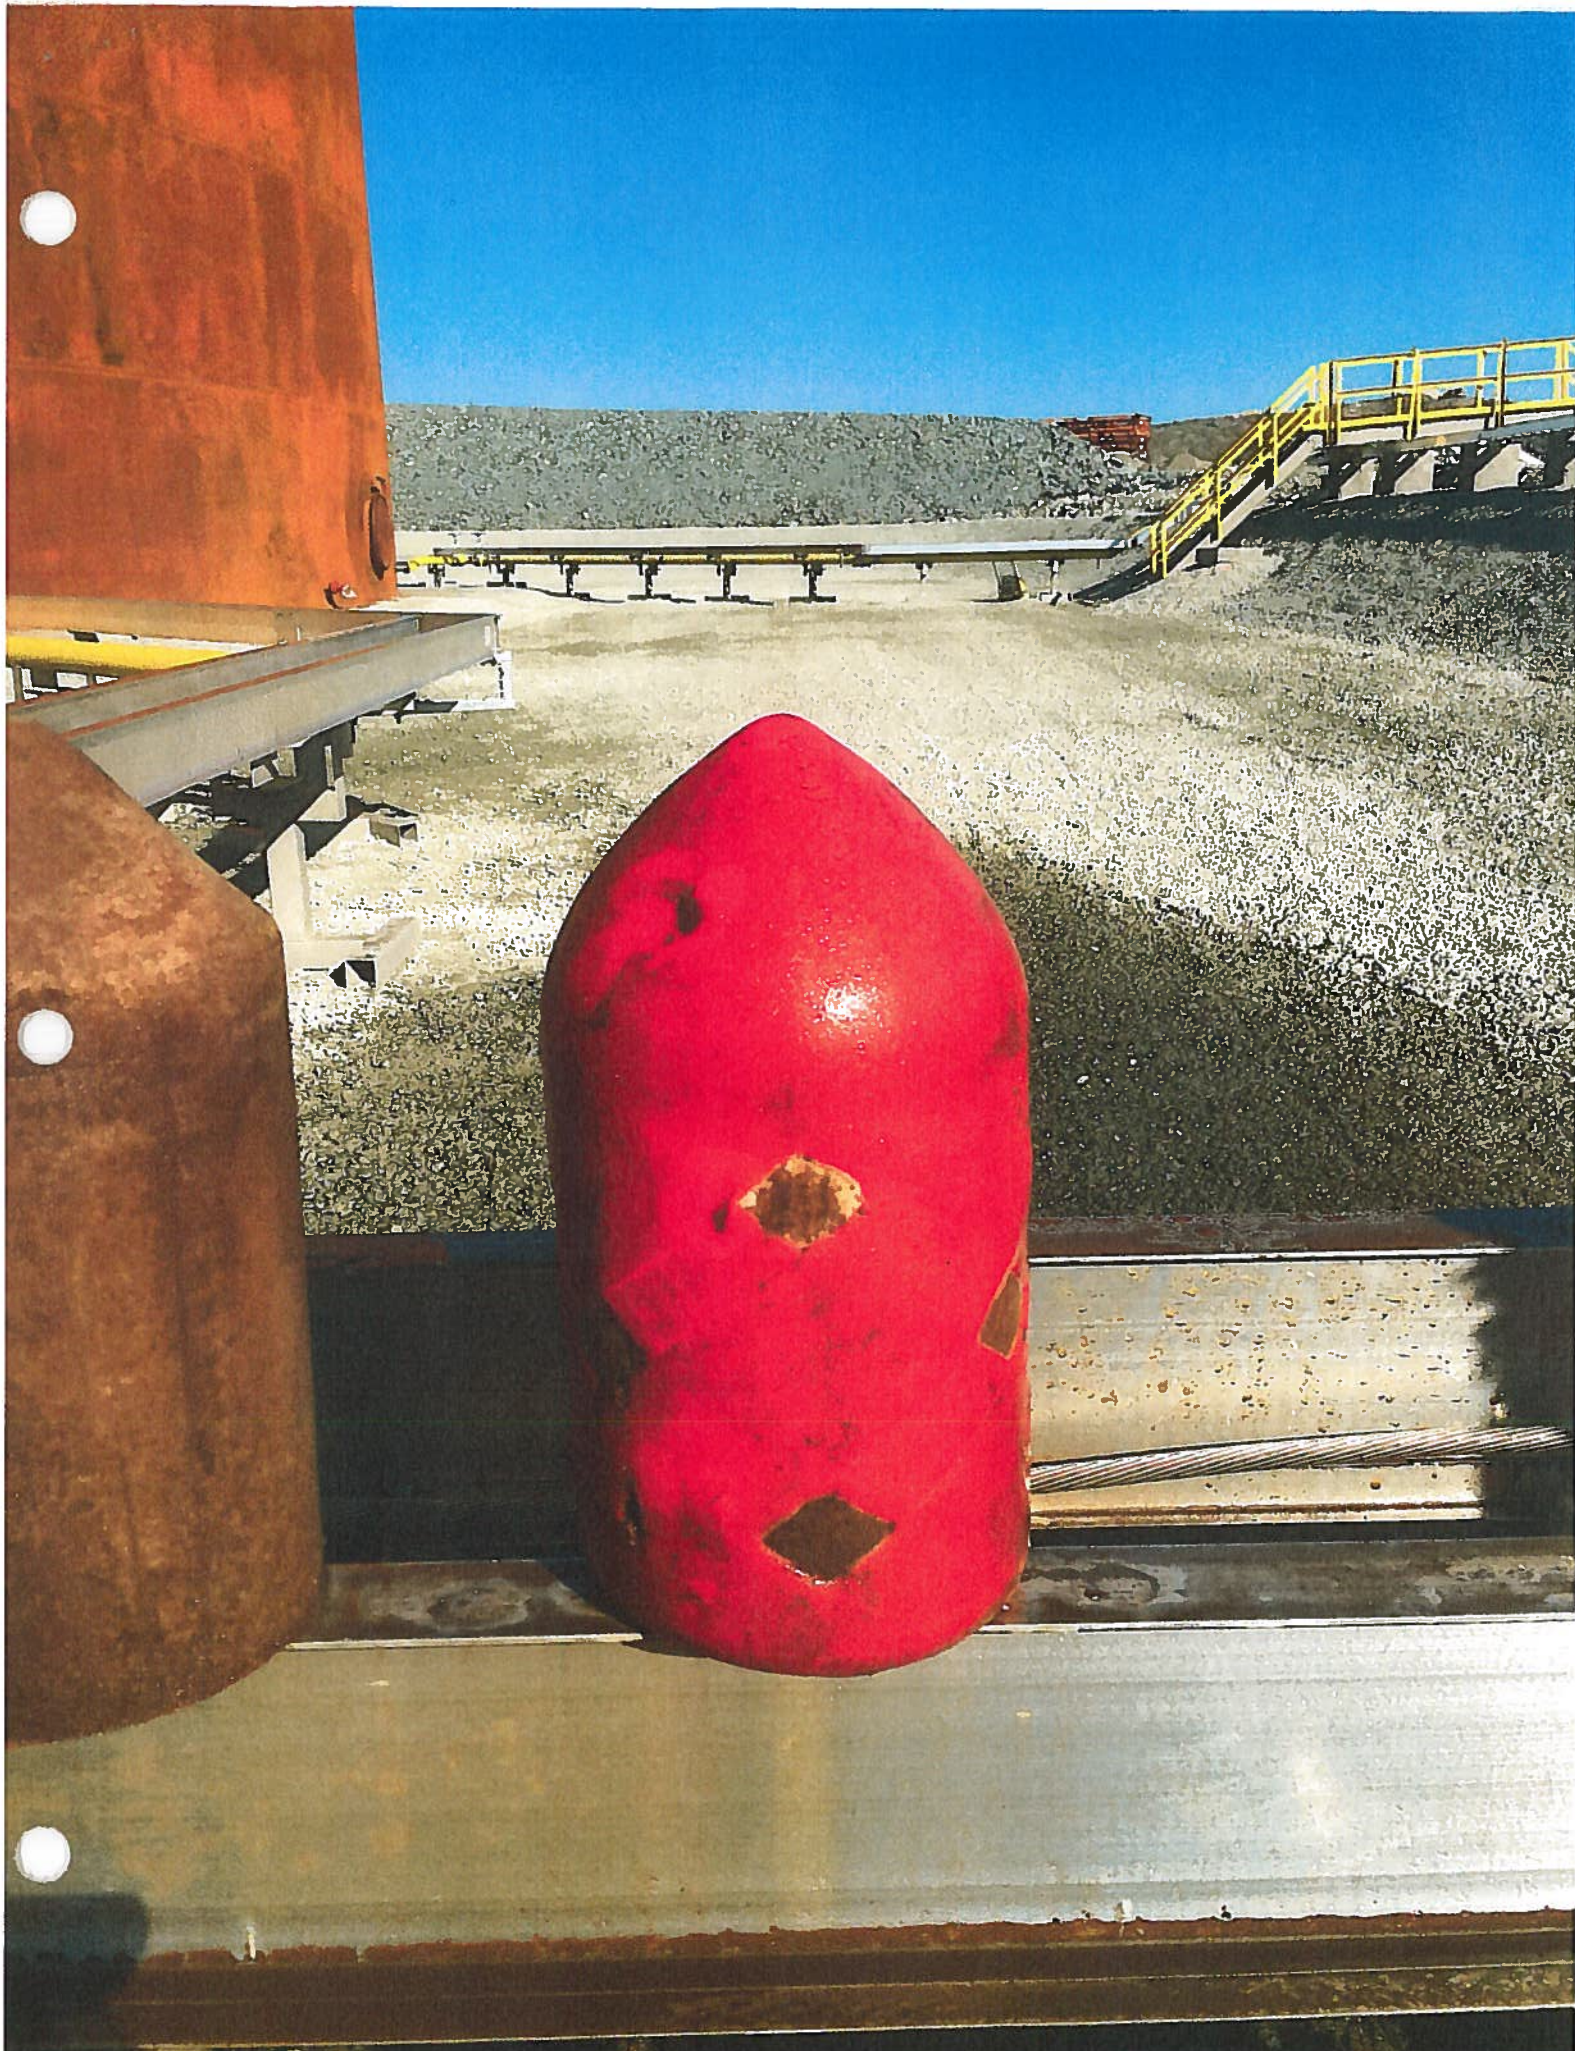



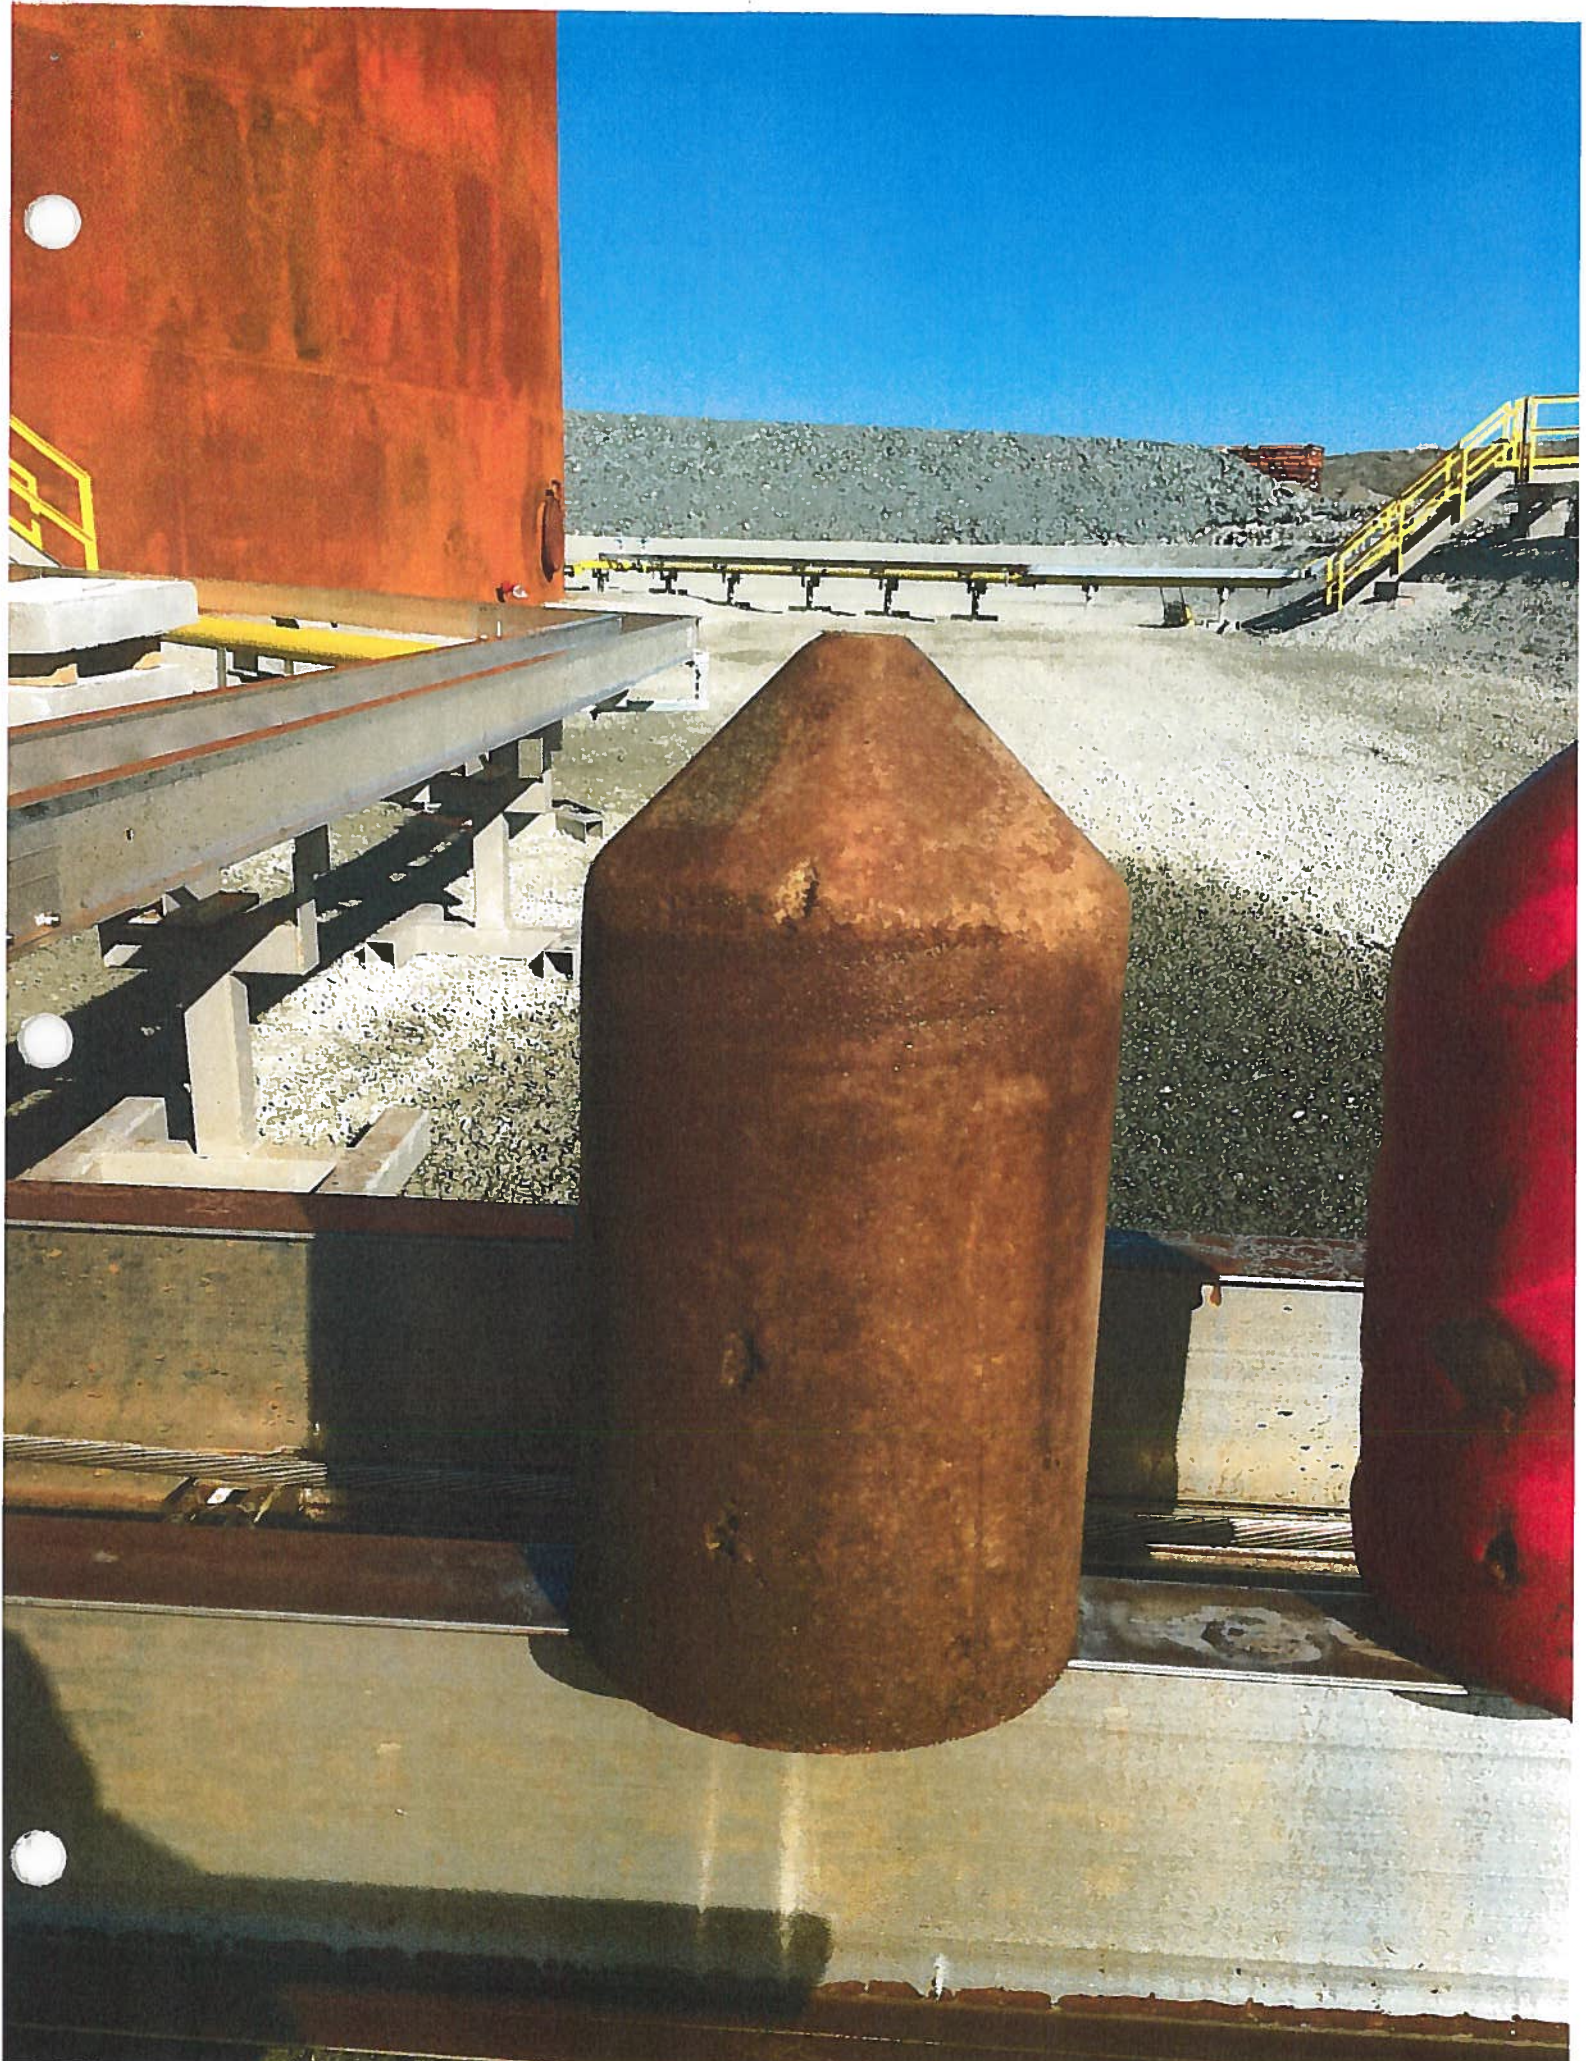



## Pigging of Pipe

1 fois le RX 3

1 fois le RX4

6 fois le RX5

2 fois le G1 swabs






U 297337 11  
2261  
30480 KGS  
67200 LBS  
2280 KGS  
4850 LBS  
28280 KGS  
62350 LBS  
332 CUM  
1.173 CWT


↑

↑




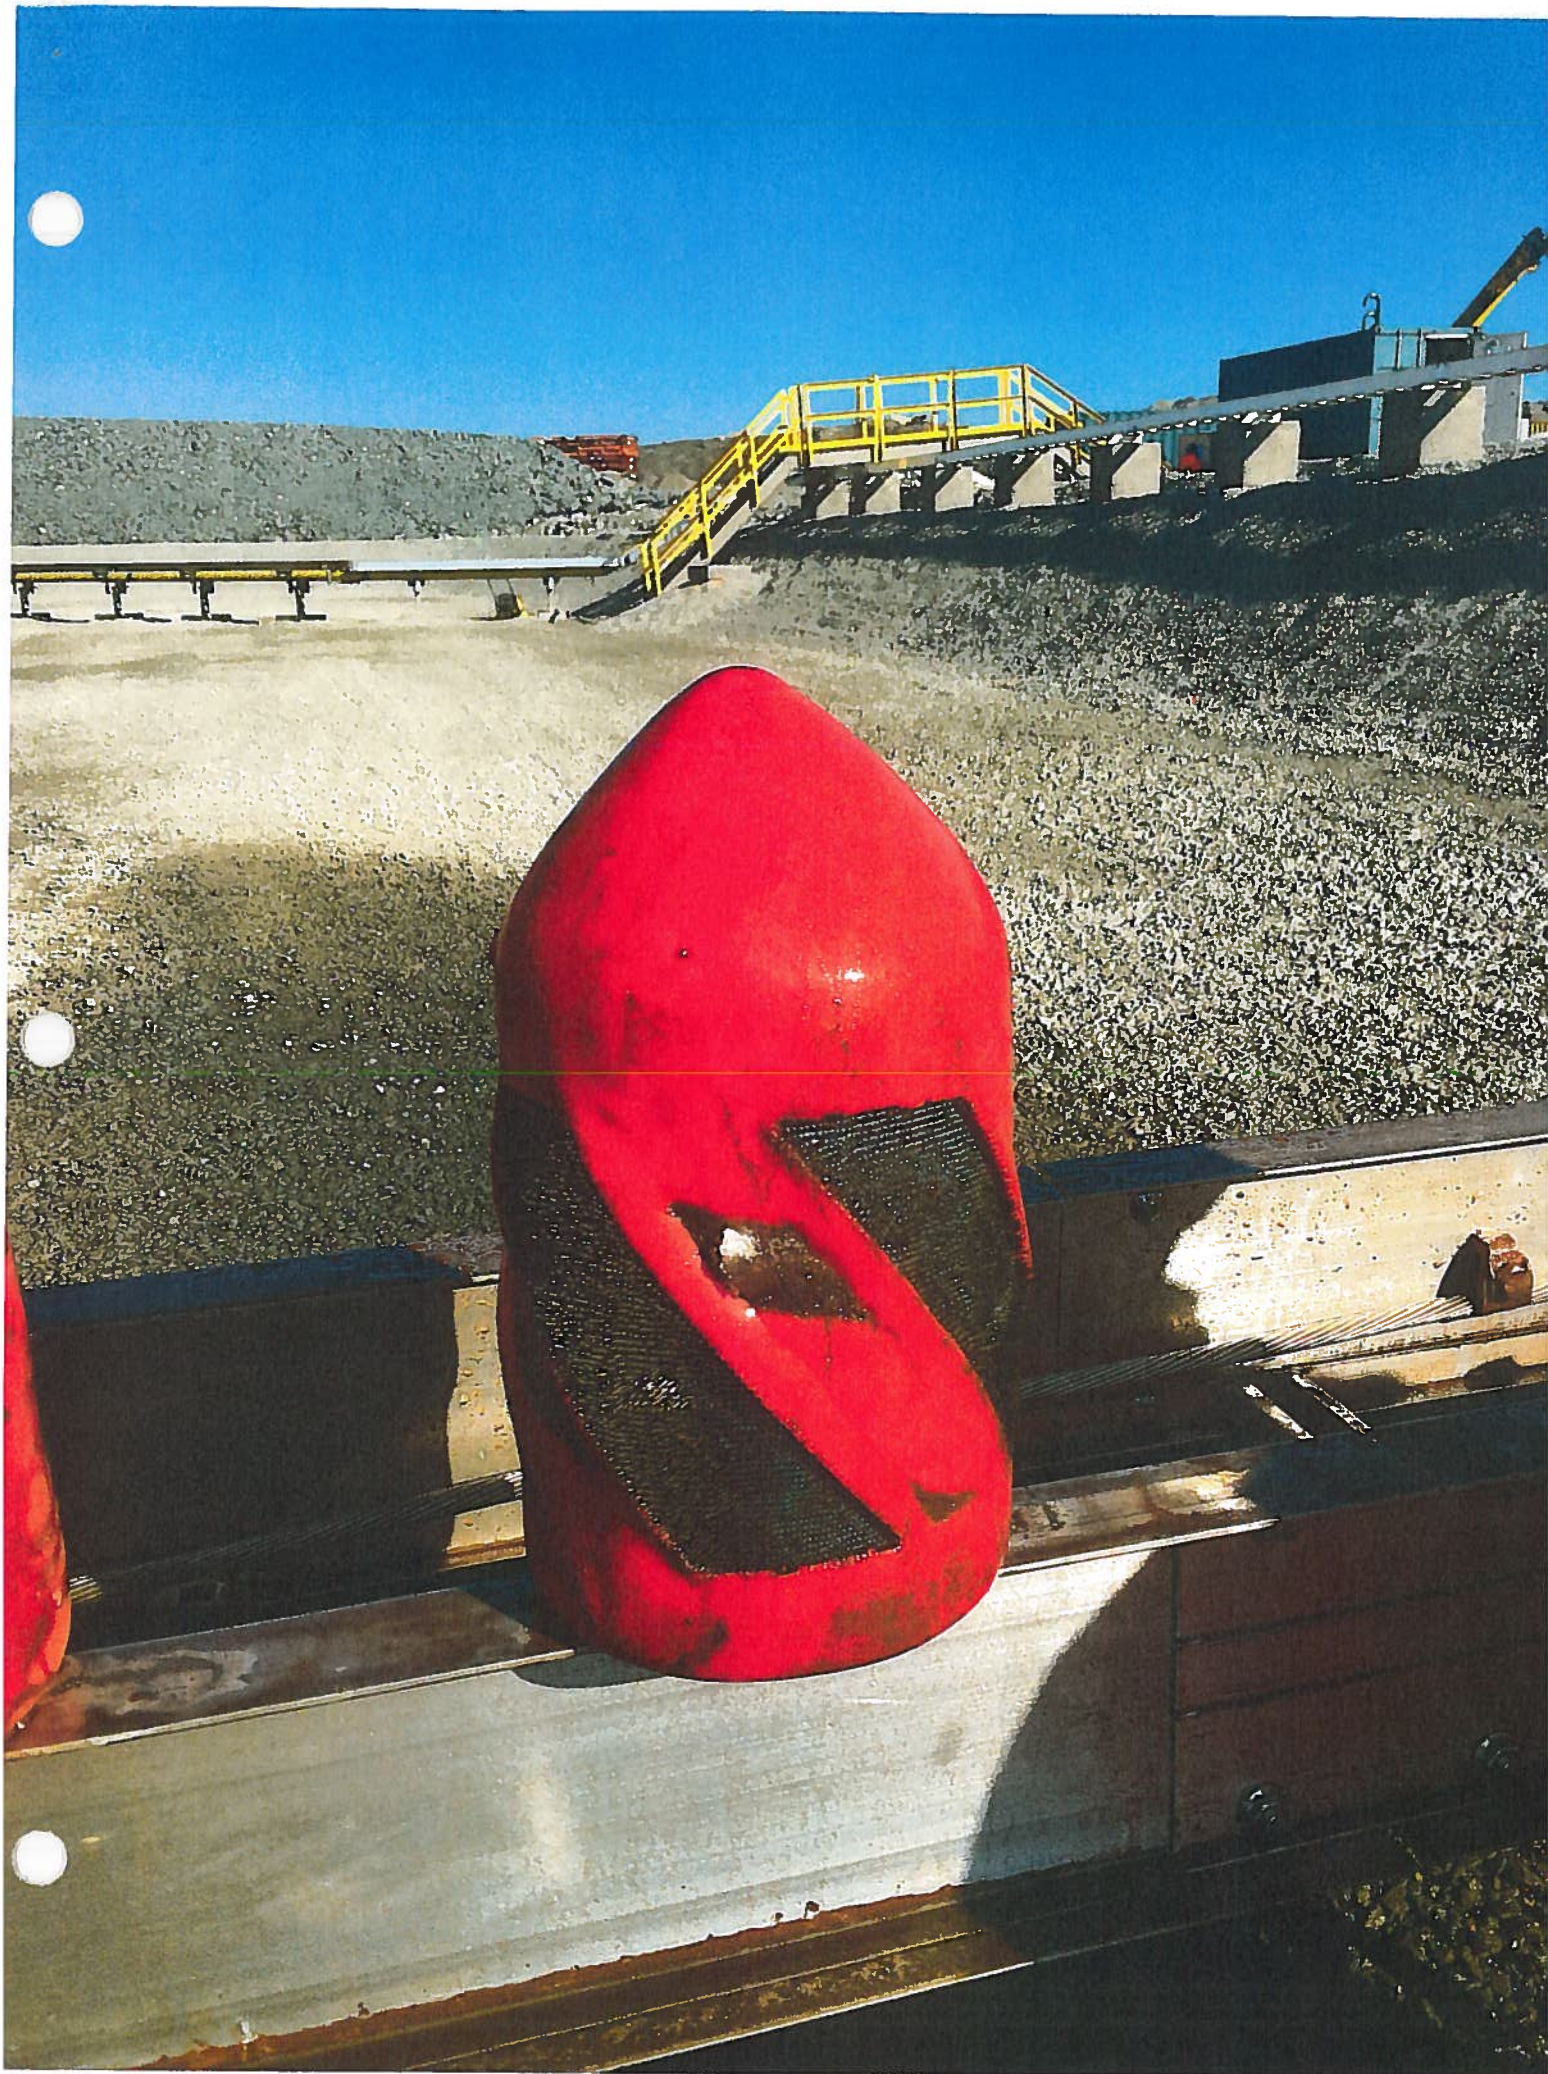



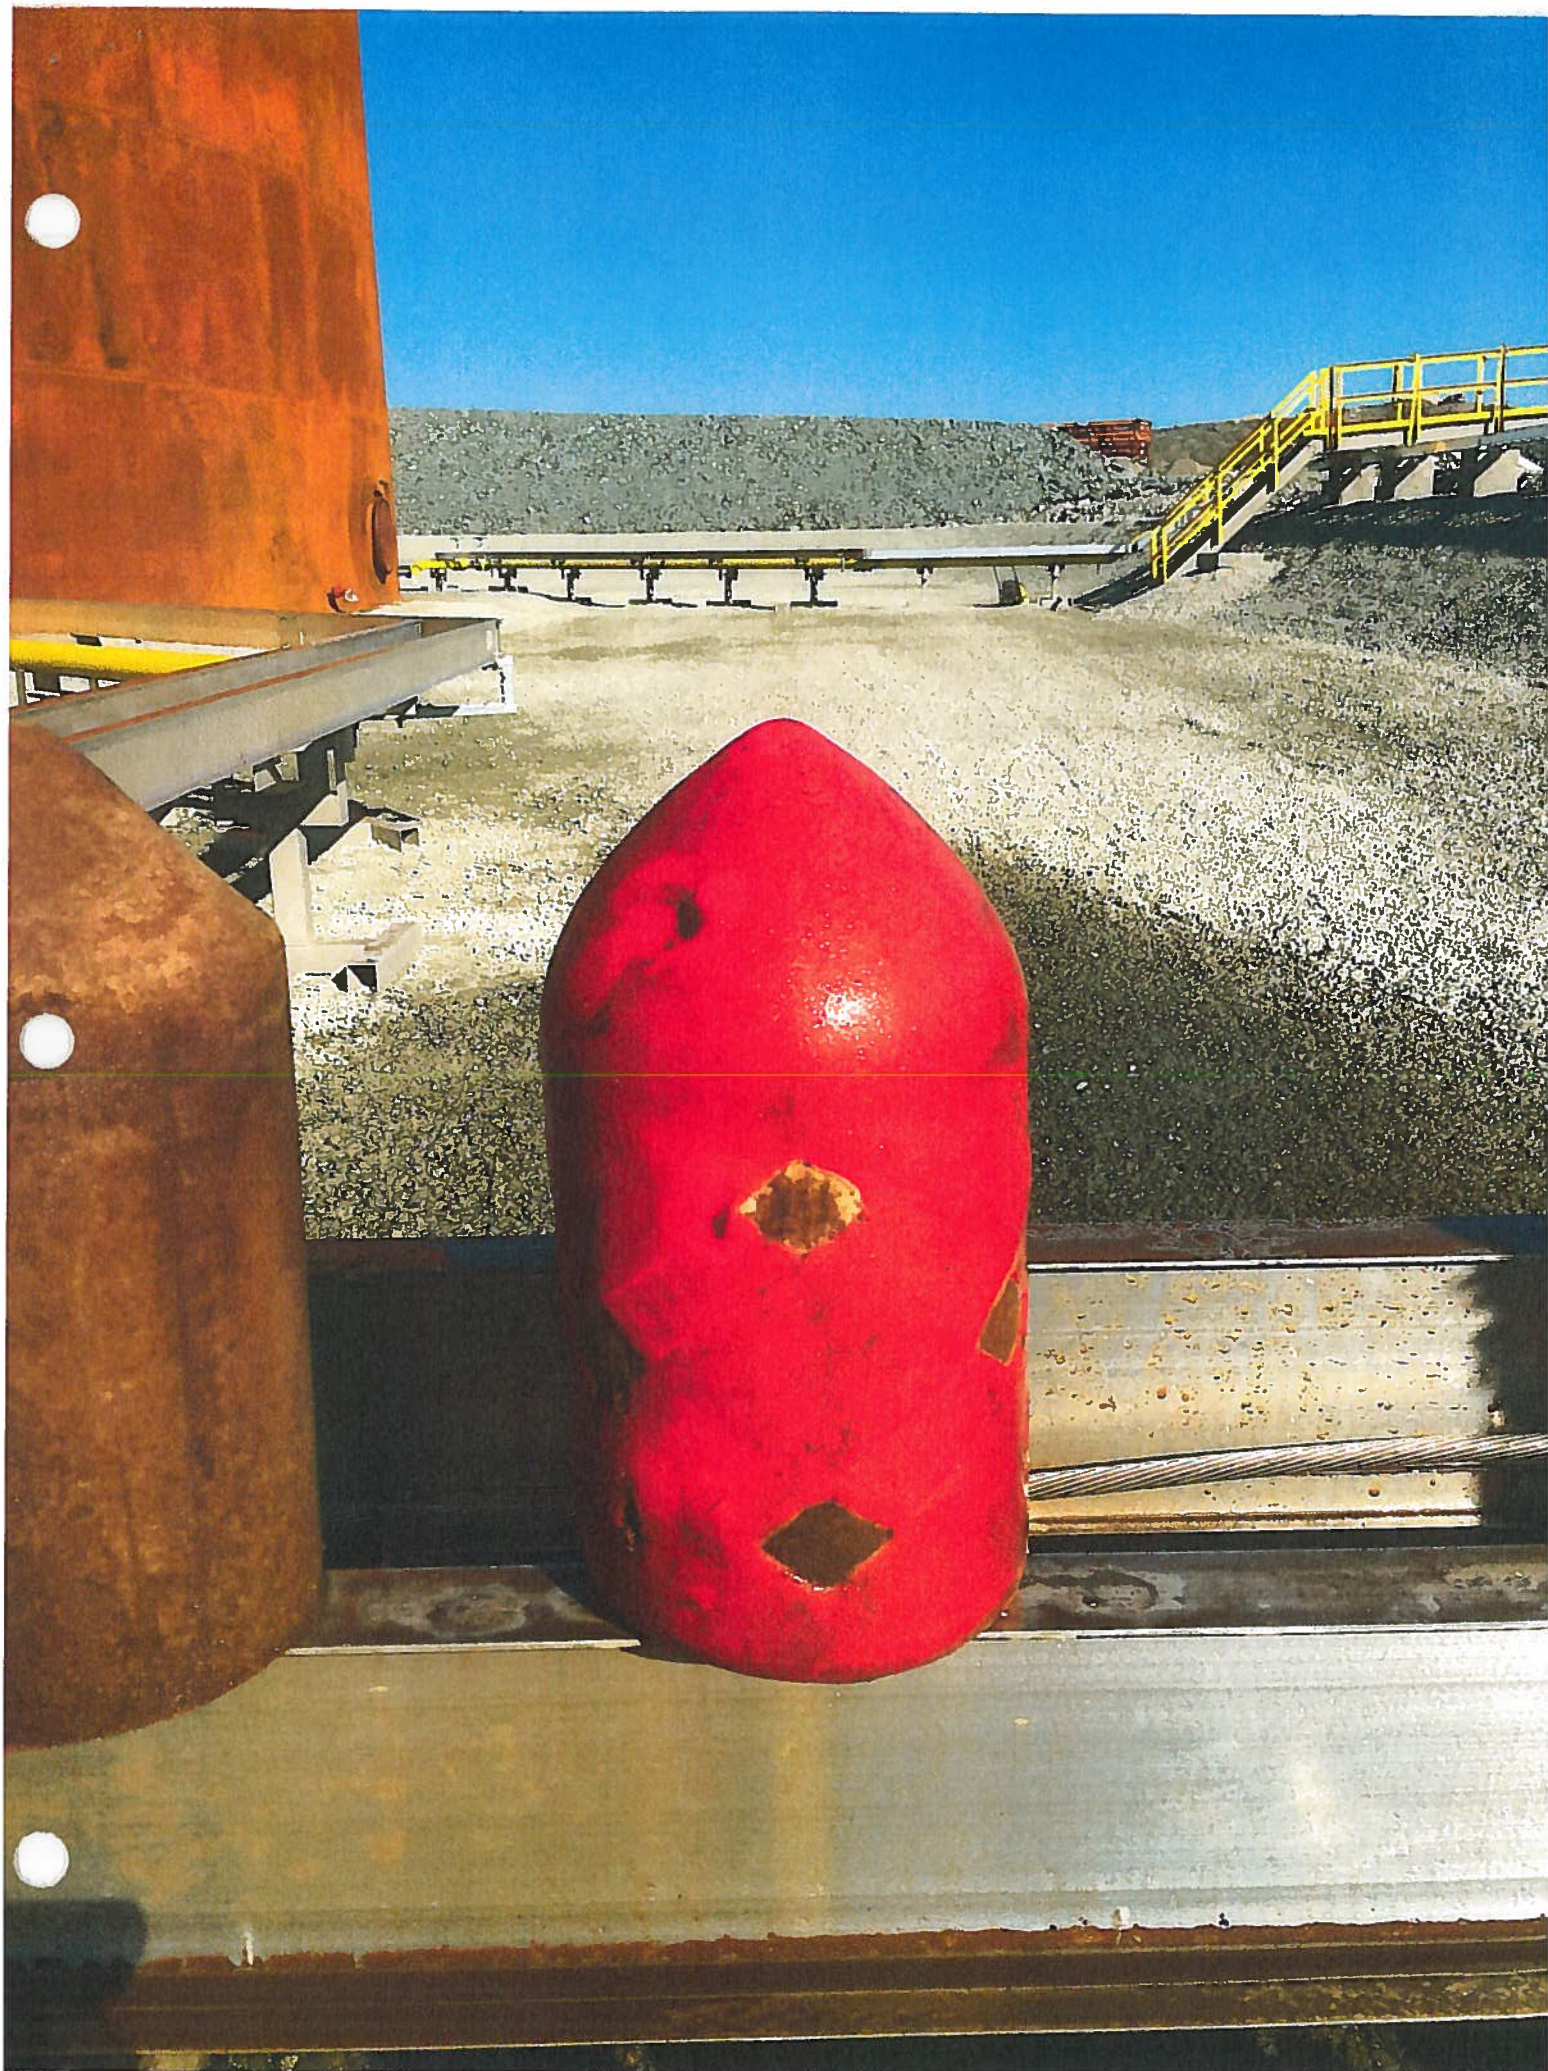



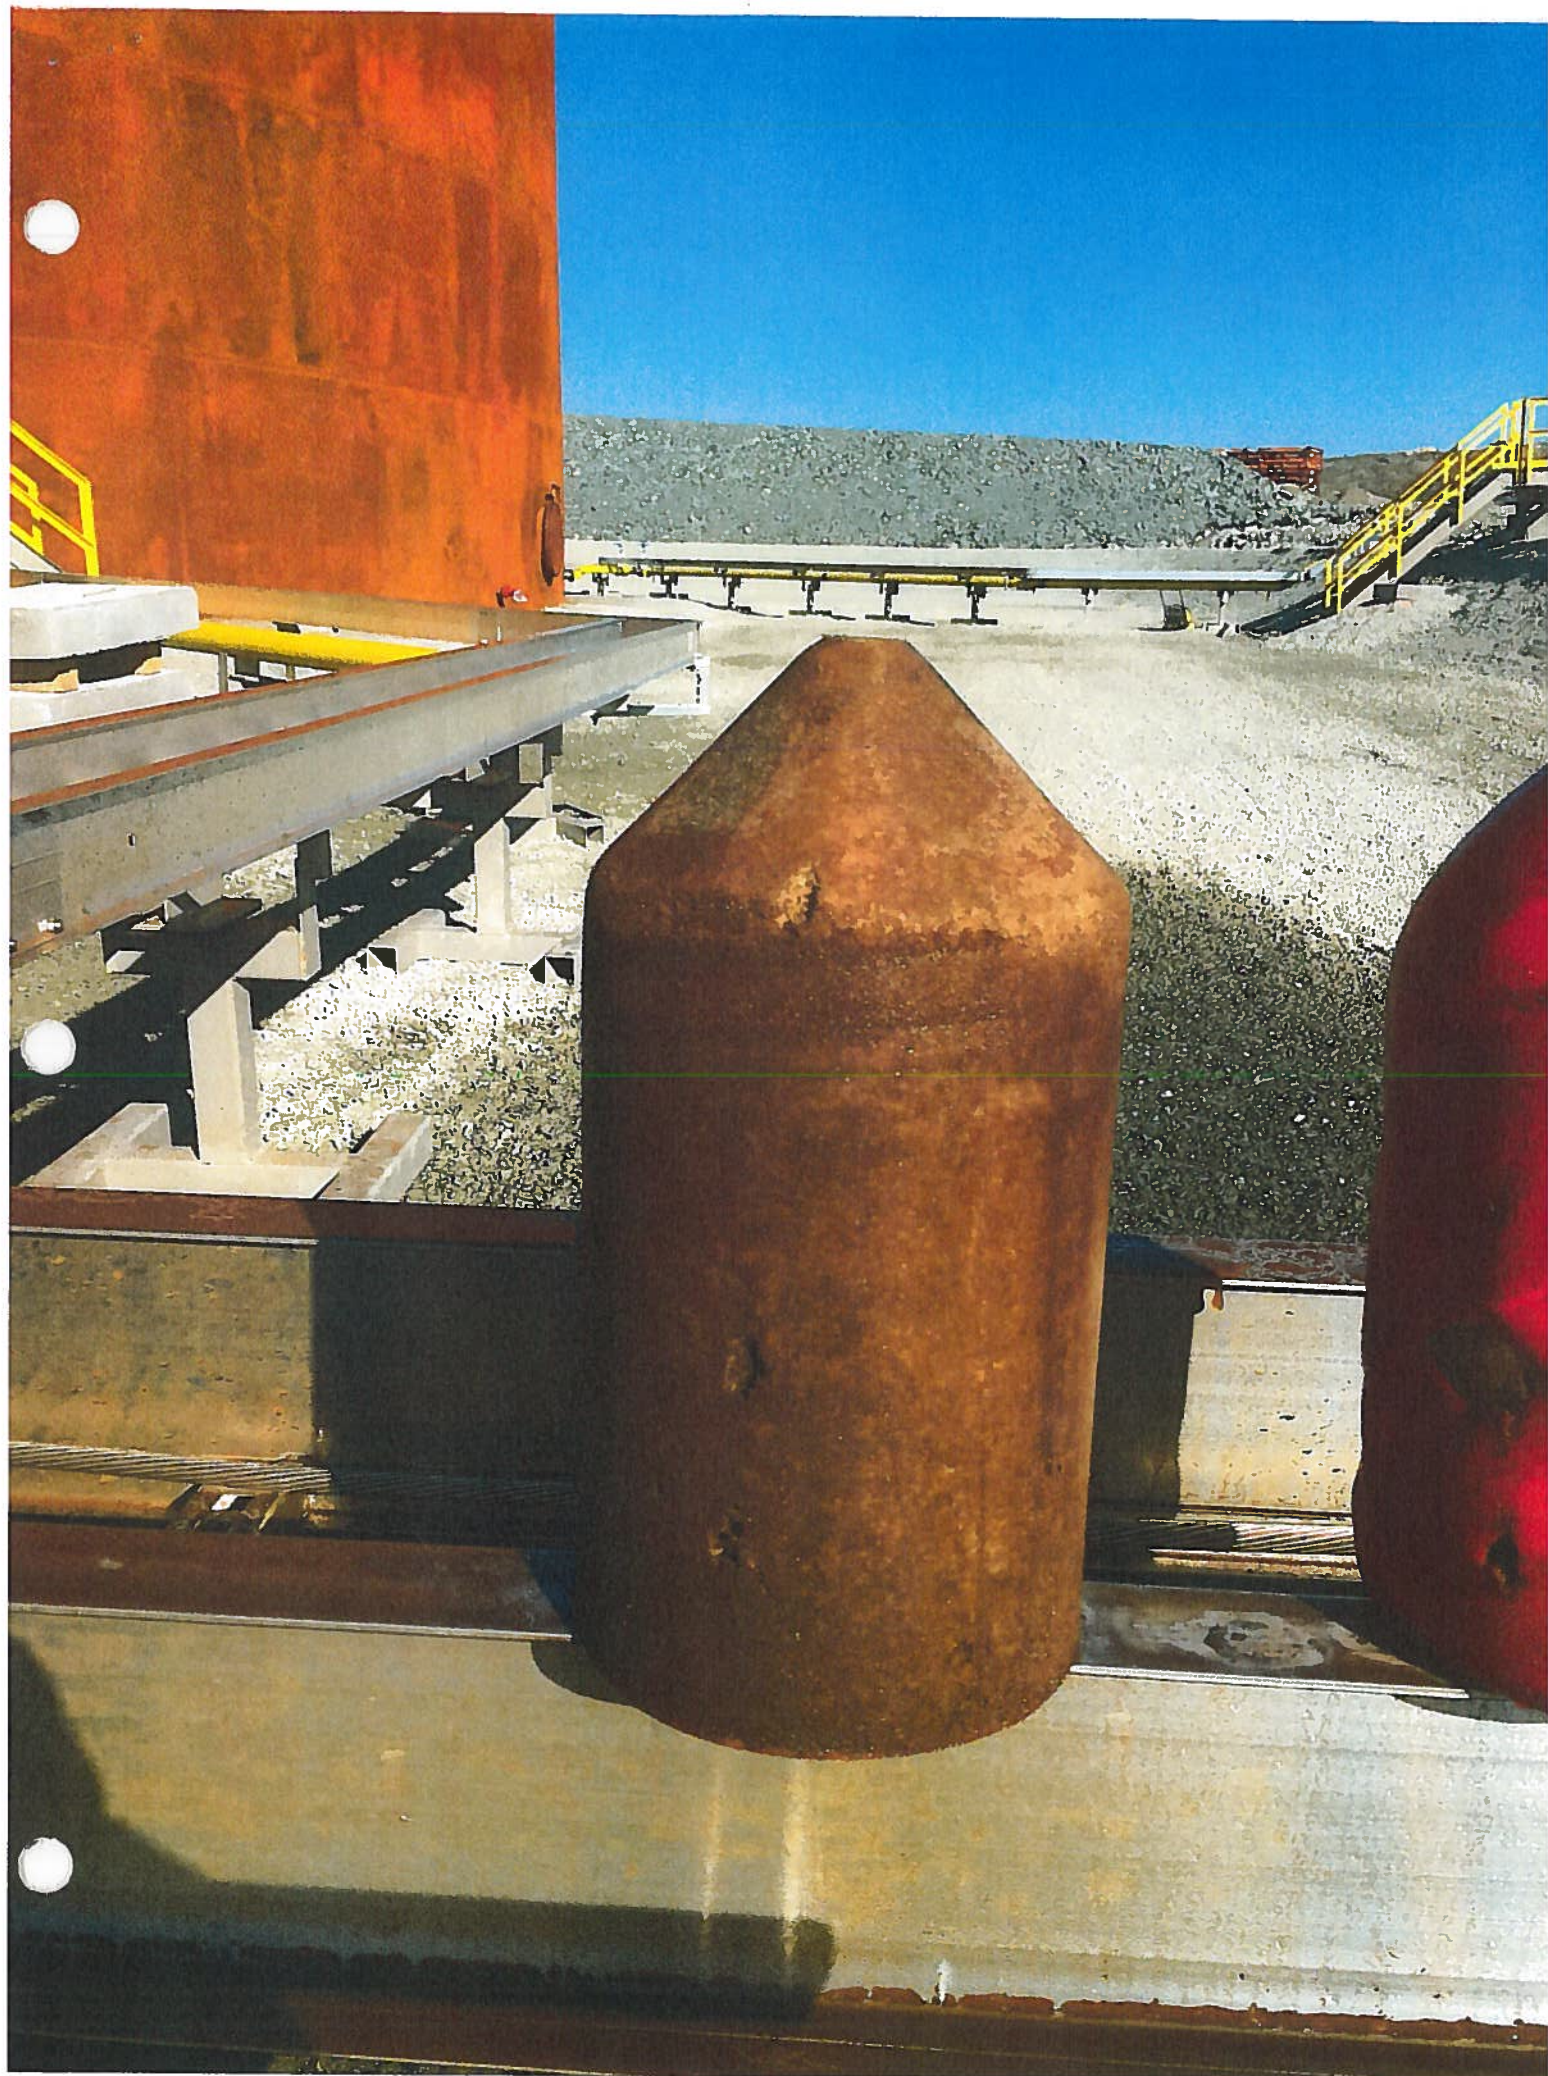



**TO BE VALIDATED  
AT A LATER DATE**



**TO BE VALIDATED  
AT A LATER DATE**





VIKING FIRE PROTECTION INC. 3005

Pitfield boulevard

Saint-Laurent, Québec, Canada

H4S 1H4

Tel.: 5 1 4. 3 3 2. 5 1 1 0

Fax: 5 1 4. 3 3 2. 6 2 6 0

info@vikingfire.ca

## AUTOMATIC DRY CHEMICAL FIRE SUPPRESSION SYSTEMS

### TECHNICAL MANUAL

FOR

**AGNICO EAGLE  
MELIADINE PROJECT  
KIVALLIQ REGION,  
NUNAVUT TERRITORY,  
CANADA**

**C-270-007 – FUEL MODULES**

SUBMITTED BY

**VIKING FIRE PROTECTION INC.  
3005, PITFIELD BOUL.  
ST-LAURENT, QUÉBEC,  
CANADA H4S 1H4  
Tel.: 514-332-5110  
Fax: 514-332-6260**

CONTRACT N° VMC04097

July 2017



## TABLE OF CONTENT

- **Chapter 1**  
General Information
- **Chapter 2**  
Components
- **Chapter 3**  
Design
- **Chapter 4**  
Installation
- **Chapter 5**  
Maintenance





3005

Pitfield boulevard

Saint-Laurent, Québec, Canada

H4S 1H4

Tel.: 5 1 4. 3 3 2. 5 1 1 0

Fax: 5 1 4. 3 3 2. 6 2 6 0

[info@vikingfire.ca](mailto:info@vikingfire.ca)

## CHAPTER 1

### GENERAL INFORMATION



## CHAPTER I

### General Information

#### INTRODUCTION

PYRO-CHEM automatic dry chemical fire suppression systems are of the pre-engineered type as defined by the NFPA Standard for Dry Chemical Extinguishing Systems, NFPA-17. The extinguishing units described in this manual are intended to be installed, inspected, and maintained in accordance with NFPA-17. Limitations detailed in this manual have been established through extensive testing by Underwriters Laboratories, Inc. Installation and maintenance of the system must conform to the limitations detailed in this manual and be performed by an Authorized PYRO-CHEM dealer.

The PYRO-CHEM Industrial Fire Suppression System utilizes either a sodium bicarbonate based dry chemical agent (specifically designed to suppress liquid, gas or electrical fires) or a monoammonium phosphate based dry chemical agent (specifically designed to suppress carbonaceous solid, liquid, gas or electrical fires). The system provides mechanical or electrical automatic actuation and can be manually actuated through a remote mechanical pull station. Upon actuation, the system discharges a pre-determined amount of agent to the hazard area.

The shutdown of fuel and power to the hazard area is required upon system actuation. Exhaust fan(s) in the ventilation system must be shut off during system discharge to allow the proper concentration of agent to build up in the hazard area.

#### TEMPERATURE LIMITATIONS

The operating temperature ranges of the PYRO-CHEM System are:

Monoammonium Phosphate (ABC) Total Flooding Systems: -20 °F (-28 °C) minimum to 120 °F (49 °C) maximum.

Local Application – Overhead Systems: 32 °F (0 °C) minimum to 120 °F (49 °C) maximum.

Local Application – Tankside Systems: -20 °F (-28 °C) minimum to 120 °F (49 °C) maximum.

#### UL LISTING

The PYRO-CHEM Industrial Fire Suppression System has been tested to the UL Standard for Pre-Engineered Dry Chemical Extinguishing System Units, UL1254 (Revised Sept. 29, 1998), and Listed by Underwriters Laboratories, Inc.





VIKING FIRE PROTECTION INC. 3005

Pitfield boulevard

Saint-Laurent, Québec, Canada

H4S 1H4

Tel.: 5 1 4. 3 3 2. 5 1 1 0

Fax: 5 1 4. 3 3 2. 6 2 6 0

info@vikingfire.ca

## CHAPTER 2

## COMPONENTS



## CHAPTER II COMPONENTS

### CYLINDERS & VALVE

PYRO-CHEM automatic dry chemical systems are supplied in 17 pound, 25 pound, 35 pound, 50 pound, and 70 pound capacity cylinders. They are the Models PCI-15ABC, PCI-17ABC, PCI-25sBC, PCI-25sABC, PCI-35ABC, PCI-50sBC, PCI-50sABC, and PCI-70ABC. Each cylinder must be separately piped to its own nozzles. All models are charged with dry nitrogen to 350 psi @ 70° F. These systems are for indoor hazard protection only. The particular models are as follows:

- PCI-15ABC. This system is charged with 12.5 pounds of monoammonium phosphate-based dry chemical, PYRO-CHEM Part No. 550170. It is Listed for use in total flooding applications. It is rated to protect Class "A," "B," and "C" hazards.

- PCI-17ABC. This system is charged with 17 pounds of monoammonium phosphate based dry chemical, PYRO-CHEM Part No. 550170. It is Listed for use in total flooding applications. It is rated to protect Class "A," "B," and "C" hazards.

- PCI-25sBC. This system is charged with 25 pounds of regular sodium bicarbonate based dry chemical, PYRO-CHEM Part No. 550162. It is Listed for use in local overhead and

local tankside applications. It is rated to protect only Class "B" and "C" hazards.

- PCI-25sABC. This system is charged with 25 pounds of monoammonium phosphate based dry chemical, PYRO-CHEM Part No. 550170. It is Listed for use in local overhead and local tankside applications. It is rated to protect Class "A," "B," and "C" hazards.

- PCI-35ABC. This system is charged with 35 pounds of monoammonium phosphate based dry chemical, PYRO-CHEM Part No. 550170. It is Listed for use in total flooding applications. It is rated to protect Class "A," "B," and "C" hazards.

- PCI-50sBC. This system is charged with 50 pounds of regular sodium bicarbonate based dry chemical, PYRO-CHEM Part No. 550162. It is Listed for use in local overhead and local tankside applications. It is rated to protect only Class "B" and "C" hazards.

- PCI-50sABC. This system is charged with 50 pounds of monoammonium phosphate based dry chemical, PYRO-CHEM Part No. 550170. It is Listed for use in local overhead and local tankside applications. It is rated to protect Class "A," "B," and "C" hazards.


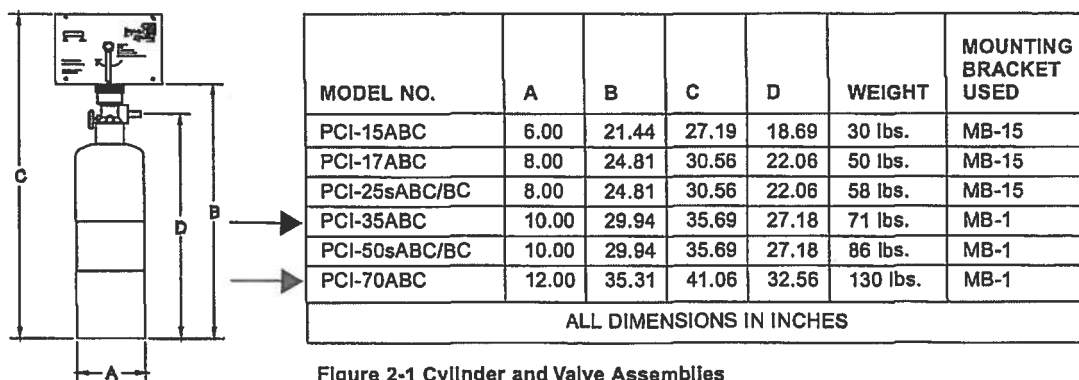


Figure 2-1 Cylinder and Valve Assemblies

002841PC

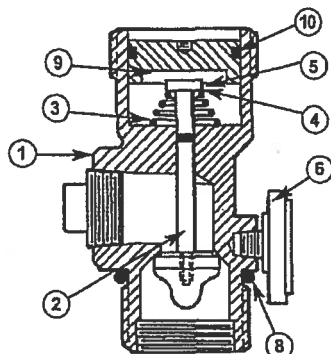

ITEM	PART NO.	DESCRIPTION
1	---	VALVE BODY
2	---	VALVE STEM & CAP ASSEMBLY
3	550022	CONICAL SPRING
4	550261	RETAINING WASHER
5	550024	E-RING
6	550025	PRESSURE GAUGE
7	550026	HIGH TEMPERATURE RELIEF PLUG
8	550029	VALVE BODY O-RING
9	550805	PISTON
10	550636	PISTON O-RING

Figure 2-2 Valve Cross Section

002843PC



► **PCI-70ABC.** This system is charged with 70 pounds of monoammonium phosphate based dry chemical, PYRO-CHEM Part No. 550170. It is Listed for use in total flooding applications. It is rated to protect Class "A," "B," and "C" hazards.

► The dimensions of the PCI-15/17/25s/35/50s/70 cylinder and valve assemblies are shown in Figure 2-1. The cylinder is manufactured, tested, and marked in accordance with DOT specification 4BW350.

The valve shown in Figure 2-2 is a pressure sealed, poppet type valve. It is used on the PCI-15/17/25s/35/50s/70, PAC-10, and PAC-200 cylinders. The valve discharge port is 3/4 in. NPT.

## NOZZLES

Nozzles have been developed for total flooding, local application overhead, and local application tankside. The Model NF-ABC nozzle is used for total flooding protection. The Model N-SCR nozzle is used for screening the opening. The Model N-OTF nozzle is used for overhead total flooding application in the work area. The Model N-PLU nozzle is used for overhead application in the plenum area. The Model N-DCT nozzle is used for exhaust duct protection. The Models N-LA-ABC and N-LA-BC nozzles are used for local overhead application. The Model N-TS nozzle is used for local tankside application. See Figure 2-3.

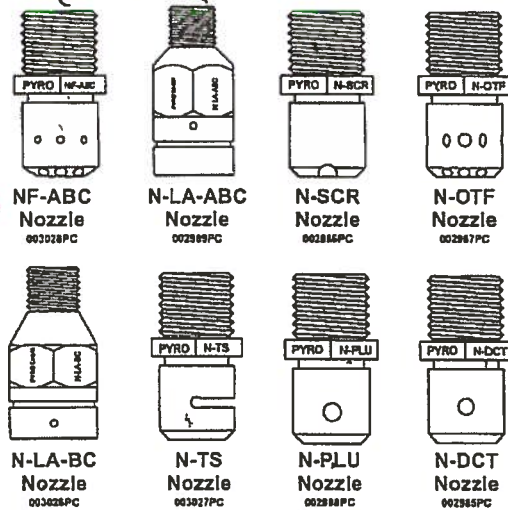


Figure 2-3. Nozzles.

## CYLINDER BRACKETING

Vertical wall mounting for the PCI-15ABC, PCI-17ABC, and PCI-25sBC/ABC, is provided by the Model MB-15 mounting bracket kit. Vertical wall mounting for the PCI-35ABC, PCI-50sBC/ABC and PCI-70ABC is provided by the Model MB-1 mounting bracket kit. See Figure 2-4.

For vertical floor mounting of the PCI-15ABC, PCI-17ABC, PCI-25sBC and PCI-25sABC, an 8 in. unistrut type mounting bracket is available, the Model MB-U8.

For vertical floor mounting of the PCI-35ABC, PCI-50sBC, and PCI-50sABC, a 10 in. unistrut type mounting bracket is available, the Model MB-U10.

► For vertical floor mounting of the PCI-70ABC, a 12 in. unistrut type mounting bracket is available, the Model MB-U12.

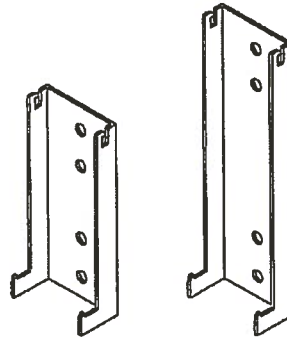


Figure 2-4 Mounting Brackets MB-15 and MB-1.

## MODEL MCH3 – MECHANICAL CONTROL HEAD

The Model MCH3 mechanical control head is a fully mechanical control head which can be connected to the PCI-15/17/25s/35/50s/70 cylinder valve. This control head will support a fusible link detection system, a remote mechanical pull station (Model RPS-M), and a mechanical or electric gas shut-off valve. A micro switch (Model MS-SPDT, MS-DPDT, MS-3PDT, or MS-4PDT) can be ordered separately and field installed. It is equipped with a local manual control handle that allows for mechanical system actuation. Operation of the local manual control requires removing the pull pin and rotating the handle clockwise. The Model MCH3 control head can actuate a maximum of five (5) cylinders. See Figure 2-5.

### MODEL MCH3 CONTROL HEAD

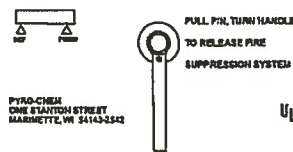


Figure 2-5. Mechanical Control Head.



## MODEL ECH3 – ELECTRIC CONTROL HEAD

- The Model ECH3 electric control head is an electrically operated control head which can be connected to the PCI-15/17/25s/35/50s/70 cylinder valve. This control head will support an electric thermal detection system, a remote mechanical pull station (Model RPS-M), and an electric gas shut-off valve. It will not support a fusible link detection system. A micro switch (Model MS-DPDT) is included. The Model ECH3 control head is available in both 120 VAC (Model ECH3-120) and 24 VDC (Model ECH3-24). It is equipped with a local manual control handle that allows for mechanical system actuation. Operation of the local manual control requires removing the pull pin and rotating the handle clockwise. The Model ECH3 control head can actuate a maximum of five (5) cylinders. See Figure 2-6.

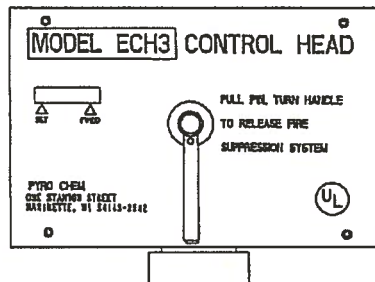


Figure 2-6. Electric Control Head.  
004789PC

## MODEL NMCH3 – MECHANICAL CONTROL HEAD

- The Model NMCH3 Mechanical Control Head is a fully mechanical control head which can be connected to the PCI-15/17/25s/35/50s/70 cylinder valve. This control head will support a fusible link detection system, a remote mechanical pull station (Model RPS-M), and a mechanical or electric shut-off valve. A micro switch (Model MS-SPDT, MS-DPDT, MS-3PDT, or MS-4PDT) can be ordered separately and field installed. There is no local manual actuation for the Model NMCH3. The Model NMCH3 control head can actuate a maximum of five (5) cylinders. See Figure 2-6a.

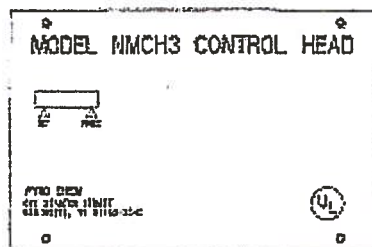


Figure 2-6a. Mechanical Control Head.  
006843PC

## MODEL MB-P2 - CONTROL HEAD MOUNTING BRACKET

The Model MB-P2 mounting bracket must be used to mount the Model MCH3, NMCH3 or ECH3 control head if the control head is not mounted directly on a cylinder valve. See Figure 2-7.

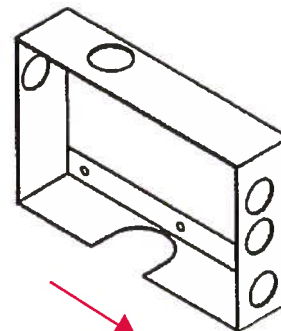


Figure 2-7. Model MB-P2 – Control Head Mounting Bracket.  
002846PC

### CAUTION

Do not screw the control head directly to a wall as this will warp the control head, not allowing the mechanism to actuate.

## MODEL PDA-D2 PNEUMATIC ACTUATING ADAPTOR

The Model PDA-D2 Pneumatic Actuating Adaptor is used to open the cylinder valve when the system is actuated. It must be installed on the valve of each cylinder unless a control head has been mounted on the cylinder valve. See Figure 2-7a.

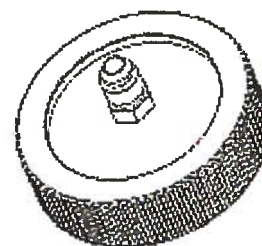


Figure 2-7a. Model PDA-D2 Pneumatic Actuating Adaptor.  
006886PC



## DETECTION EQUIPMENT

### 1. Model FLK-1.

- The Model FLK-1 fusible link kit includes a 10 in. steel bracket, two (2) 1/2 in. EMT connectors, two (2) cable crimps, and two (2) "S" hooks. Fusible links must be ordered separately. See Figure 2-10.

### 2. Model FLK-1A.

- The Model FLK-1A fusible link kit includes an 8 in. steel bracket, two (2) 1/2 in. EMT connectors, two (2) cable crimps, and two (2) "S" hooks. Fusible links must be ordered separately.

### 3. Model FLH-1.

The Model FLH-1 fusible link hanger is an accessory designed to simplify the installation of fusible links in the fusible link line. It can be used with the Model FLK-1/1A fusible link kits (kits must be ordered separately). The Fusible Link Hanger makes it possible to install fusible links without cutting and crimping loops in the fusible link line for each link. They are available in packages of 25 (FLH-25) only. See Figure 2-11.

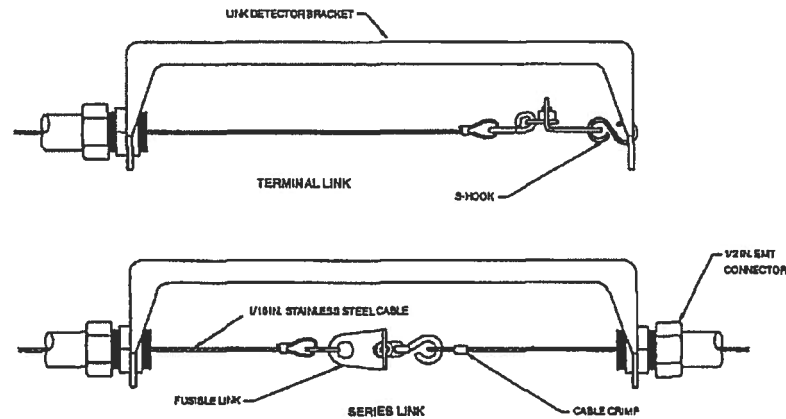


Figure 2-10. Model FLK-1 Fusible Link  
002849PC

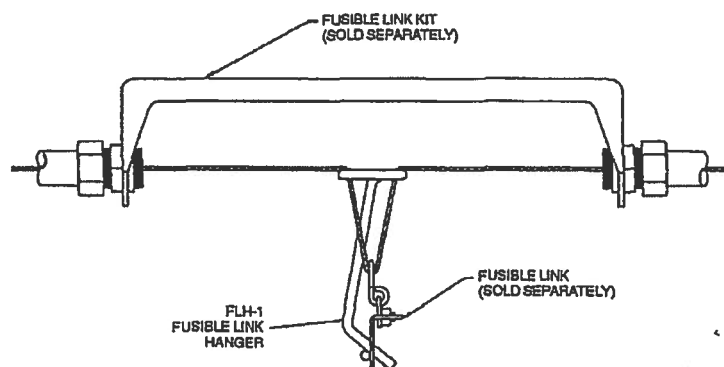


Figure 2-11. Model FLH-1 Fusible Link Hanger  
002850PC



#### 4. Fusible Links.

The fusible link is designed to separate at a specific temperature, releasing tension from the fusible link line, causing system actuation. See Figure 2-12.

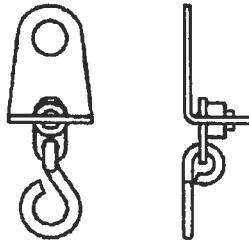


Figure 2-12. ML Style Fusible Link.

002851PG

After determining the maximum ambient temperature at the fusible link location, select the correct fusible link according to the temperature condition chart below:

Fusible Link Model No.	Maximum Ambient Temperature
FL-165	100° F. (38° C.)
FL-212	150° F. (66° C.)
FL-280	225° F. (107° C.)
FL-360	290° F. (143° C.)
FL-450	360° F. (182° C.)
FL-500	400° F. (204° C.)


After determining the maximum ambient temperature at the thermal detector location, select the correct thermal detector according to the temperature condition chart below:

Thermal Detector Model No.	Maximum Ambient Temperature
TD-140	100° F. (38° C.)
TD-190	150° F. (66° C.)
TD-225	185° F. (85° C.)
TD-325	285° F. (141° C.)
TD-450	410° F. (210° C.)
TD-600	560° F. (293° C.)

#### REMOTE MECHANICAL PULL STATION

##### Model RPS-M

Remote manual control for system releasing devices is provided by the Model RPS-M remote mechanical pull station. It is connected to the system releasing device by stainless steel cable. This cable is enclosed in 1/2 in. EMT with corner pulleys at each change in direction. The remote mechanical pull station shall be located at the point of egress from the hazard area. See Figure 2-13.

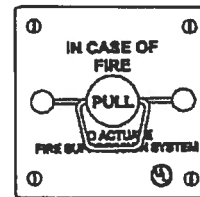

#### 5. Thermal Detectors.

Rate compensated temperature thermal detectors are normally open, mechanical contact closure switches designed to operate at a factory preset temperature. They are available in six preset temperatures which meet NFPA standards and are UL Listed and FM Approved.

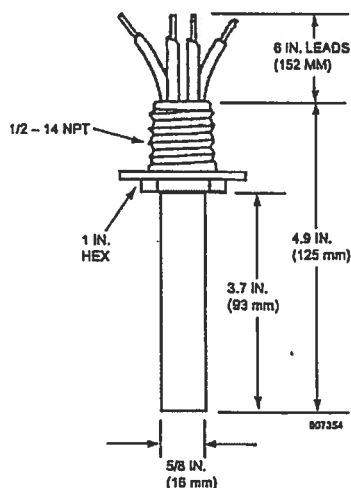


Figure 2-12a. Thermal Detector.

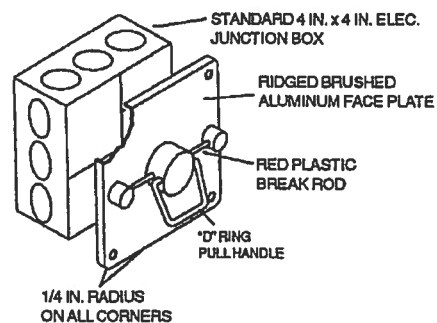


Figure 2-13. Model RPS-M Mechanical Pull Station.

002852PG

## CORNER PULLEYS

### 1. Model SBP-1.

A corner pulley is used whenever a change in stainless steel cable direction is required. The Model SBP-1 corner pulley is equipped with a set screw fitting for connection to 1/2 in. EMT. See Figure 2-15.

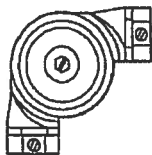


Figure 2-15. Model SBP-1 Corner Pulley.  
000180

### 2. Model CBP-1.

A corner pulley is used whenever a change in stainless cable direction is required. The Model CBP-1 is a grease-tight corner pulley designed for areas likely to experience excessive deposit build-up. It is equipped with a compression fitting for connection to 1/2 in. EMT. See Figure 2-16.

Note: The Model CBP-1 is not a liquid tight sealing device.

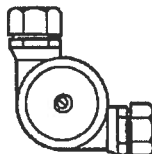


Figure 2-16. Model CBP-1 Corner Pulley.  
000181

### 3. Model WBP-1.

A corner pulley is used whenever a change in stainless cable direction is required. The Model WBP-1 is a liquid-tight corner pulley designed for areas likely to experience excessive moisture build-up. It is equipped with a female pipe thread for connection to 1/2 in. rigid conduit. See Figure 2-17.

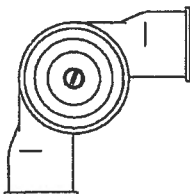


Figure 2-17. Model WBP-1 Corner Pulley.  
000194PC

## TEE PULLEY

The Model TP-1 tee pulley is used to connect two mechanical gas valves or two remote mechanical pull stations to a single control head. The tee pulley replaces two standard 90° corner pulleys. See Figure 2-18.

### CAUTION

The Tee Pulley must never be used to connect multiple fusible link lines to a single control head.

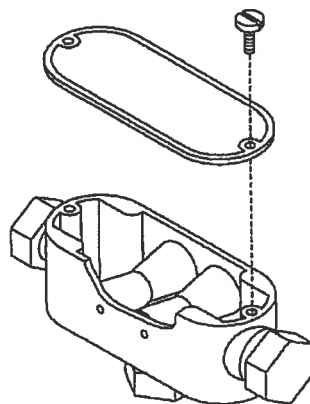


Figure 2-18. Model TP-1 Tee Pulley.  
002887PC

## SWING CHECK VALVE

The Swing Check Valve, Part No. 417788, is required when piping a main and reserve Monarch tank on the same distribution piping. It allows the dry chemical agent to discharge through the agent piping leading to the discharge nozzles, while preventing it from flowing into the piping from the other tank. The swing check valve body is constructed of brass with a 1 in. NPT female thread. See Figure 2-19.

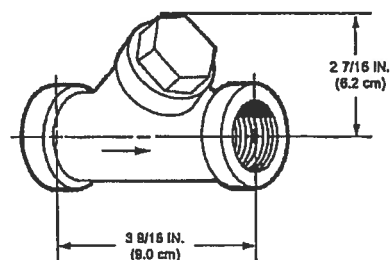


Figure 2-19. Swing Check Valve.  
000430



## ELECTRICAL SWITCHES

The electrical switches are intended for use with electric gas valves, alarms, contactors, lights, contractor supplied electric power shut-off devices and other electrical devices that are designed to shut off or turn on when the system is actuated.

Switches are available in kits: One Switch Kit, Part No. 551154; Two Switch Kit, Part No. 551155; Three Switch Kit, Part No. 551156, and Four Switch Kit, Part No. 551157. Mounting hardware and 12 in. wire assemblies are provided with each kit. Each switch has a set of single-pole, double-throw contacts rated:

UL/cUL/CSA Rating  
250 VAC, 21A Resistive  
250 VAC, 2 HP  
125 VAC, 1 HP

ENEC Rating  
IE4T105 $\mu$  Approved  
250V, 21A Resistive  
8A Motor Load

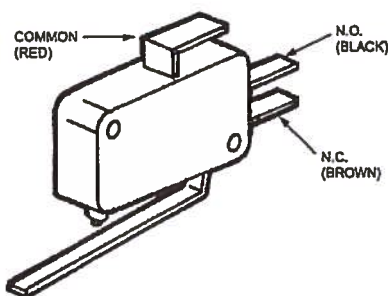


Figure 2-20a. Model MS-SPDT Micro Switch.  
001612

The Alarm Initiating Switch Kit, Part No. 550077, can be field mounted within the control head. This switch must be used to close a supervised alarm circuit to the building main fire alarm panel when the control head actuates. This action will signal the fire alarm panel that there was a system actuation in the hazard area. The switch kit contains all necessary mounting components along with a mounting instruction sheet. The switch is rated 50 mA, 28 VDC.

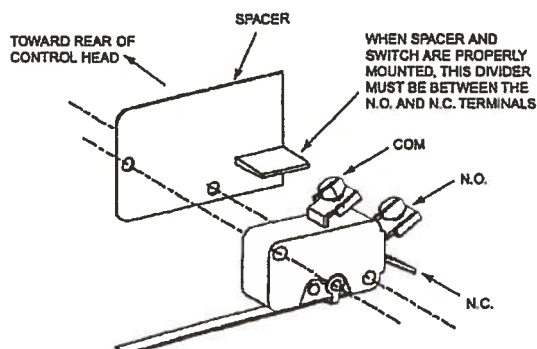


Figure 2-20b. Alarm Initiating Switch.  
001600

See NFPA 72, "National Fire Alarm Code," Initiating Devices section, for the correct method of wiring connection to the fire alarm panel.

## MODEL SM-120/24 SOLENOID MONITOR

The Model SM-120/24 solenoid monitor is used in conjunction with the Model ECH3 control head to supervise the actuation and detection circuits. In the event of a problem in the circuit, a light on the monitor goes out. The Model SM-120 is used with the Model ECH3-120 control head. The Model SM-24 is used with the Model ECH3-24 control head. Two sets of NO/NC dry contacts are provided. The unit mounts directly to a three gang wall outlet box. The Model SM-120 acts as a reset relay when used with an electric gas valve. Electric gas valve wiring instructions are provided in the installation section of this manual. See Figure 2-21.

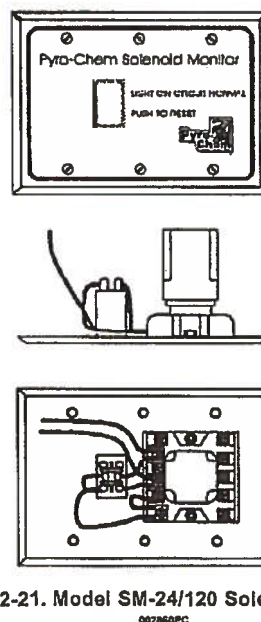


Figure 2-21. Model SM-24/120 Solenoid Monitor.  
00280PC

COMPONENT LIST  
GENERAL PURPOSE SYSTEM

MODEL NO.	DESCRIPTION	PART NO.
PCI-15ABC	15 lb. ABC Cylinder and Valve Assembly	550388
PCI-17ABC	17 lb. ABC Cylinder and Valve Assembly	551654
PCI-25sBC	25 lb. BC Cylinder and Valve Assembly	550391
PCI-25sABC	25 lb. ABC Cylinder and Valve Assembly	550390
PCI-35ABC	35 lb. ABC Cylinder and Valve Assembly	551097
PCI-50sBC	50 lb. BC Cylinder and Valve Assembly	550393
PCI-50sABC	50 lb. ABC Cylinder and Valve Assembly	550392
PCI-70ABC	70 lb. ABC Cylinder and Valve Assembly	551094
PAC-10	Pneumatic Actuating Cylinder	550104
PAC-200	Pneumatic Actuating Cylinder	550690
MB-P2	Control Head Mounting Bracket	550853
MB-15	Mounting Bracket (PCI-15,17,25s Cylinders)	550054
MB-1	Mounting Bracket (PCI-35,70 Cylinders)	550053
MB-U8	8 In. Unistrut Mounting Bracket	550324
MB-U10	10 in. Unistrut Mounting Bracket	550383
MB-U12	12 In. Unistrut Mounting Bracket	550638
MCH3	Mechanical Control Head	551200
NMCH3	Mechanical Control Head	551203
ECH3-24	24VDC Electrical Control Head	551201
ECH3-120	120VDC Electrical Control Head	551202
---	8 In. S.S. Actuation Hose	417582
---	16 In. S.S. Actuation Hose	31809
---	24 In. S.S. Actuation Hose	32336
---	42 In. S.S. Actuation Hose	430815
---	Male Elbow	31810
---	Male Tee	31811
---	Male Straight Connector	32338
PDA-D2	Pneumatic Actuating Adaptor	550829
---	Swing Check Valve	417788
NF-ABC	Nozzle Assembly	551678
N-LA-ABC	Nozzle Assembly	550646
N-LA-BC	Nozzle Assembly	550342
N-TS	Nozzle Assembly	550337
RPS-M	Remote Mechanical Pull Station	551074
RPS-E2	Remote Electric Pull Station	551166
FKL-1	10 In. Fusible Link Bracket	550131
FKL-1A	8 In. Fusible Link Bracket	550132
FLH-25	Fusible Link Hanger (25)	550876
FL-165	165° F Fusible Link	550368
FL-212	212° F Fusible Link	550365
FL-280	280° F Fusible Link	550366
FL-360	360° F Fusible Link	550009
FL-450	450° F Fusible Link	550367
FL-500	500° F Fusible Link	56816
SM-24	24VDC Solenoid Monitor	550303
SM-120	120VAC Solenoid Monitor	550302
TD-140	140° F Thermal Detector	550351
TD-190	190° F Thermal Detector	550352
TD-225	225° F Thermal Detector	550353
TD-325	325° F Thermal Detector	550354
TD-450	450° F Thermal Detector	550355
TD-600	600° F Thermal Detector	550356
GV-75	3/4 In. Mechanical Gas Valve	550593
GV-100	1 In. Mechanical Gas Valve	550594



COMPONENT LIST  
GENERAL PURPOSE SYSTEM (Continued)

MODEL NO.	DESCRIPTION	PART NO.
GV-125	1 1/4 In. Mechanical Gas Valve	550595
GV-150	1 1/2 In. Mechanical Gas Valve	550596
GV-200	2 In. Mechanical Gas Valve	551049
GV-250	2 1/2 In. Mechanical Gas Valve	550185
GV-300	3 In. Mechanical Gas Valve	550186
EGVSO-75	3/4 In. Electric Gas Valve	550358
EGVSO-100	1 In. Electric Gas Valve	550359
EGVSO-125	1 1/4 In. Electric Gas Valve	550360
EGVSO-150	1 1/2 In. Electric Gas Valve	550361
EGVSO-200	2 In. Electric Gas Valve	550362
EGVSO-250	2 1/2 In. Electric Gas Valve	550363
EGVSO-300	3 In. Electric Gas Valve	550385
MS-SPDT	Micro-Switch – Single Pole Double Throw	551154
MS-DPDT	Micro-Switch – Double Pole Double Throw	551155
MS-3PDT	Micro-Switch – 3 Pole Double Throw	551156
MS-4PDT	Micro-Switch – 4 Pole Double Throw	551157
— — —	Alarm Initiating Switch	550077
PS-SPDT-XP	Pressure Switch – Single Pole Double Throw	550052
CO2-6	6 x CO <sub>2</sub> Cartridge	551059
CBP-1	Compression Bearing Corner Pulley	423250
SBP-1	Screw Bearing Corner Pulley	415670
WBP-1	Weather Proof Corner Pulley (10 Per Package)	550983
TP-1	Tee Pulley	550186
WC-100	Oval Sleeve Crimps (100 Per Package)	550122
— — —	Stop Sleeves (Pack of 10)	24919
— — —	Valve – Piston O-Ring	550636
— — —	Valve – Stem Washer	550284
— — —	Valve – Seat Washer	550021
— — —	Valve – Stem Head	550020
— — —	Valve – Body O-Ring	550029
— — —	Valve – Pressure Gauge	550025
— — —	Valve – Stem	550806
— — —	Valve – Stem O-Ring	550028
— — —	Valve – Conical Spring	550022
— — —	Valve – Piston	550805
FR-25sBC	Flow Restrictor	550235
— — —	Pressure Bleed Down Adaptor Assembly	551736
— — —	Dry Valve Rebuilding Kit	550037
— — —	Recharge Adaptor	550130
— — —	Dry Valve Hydrotest Adaptor	552182



3005

Pitfield boulevard

Saint-Laurent, Québec, Canada

H4S 1H4

Tel.: 5 1 4. 3 3 2. 5 1 1 0

Fax: 5 1 4. 3 3 2. 6 2 6 0

[info@vikingfire.ca](mailto:info@vikingfire.ca)

## CHAPTER 3


## DESIGN



TABLE 3-1  
Total Flooding Nozzle Protection Chart

Maximum Dimensions in feet/nozzle for one (1) Model NF-ABC

Side 1 (ft.)	Nozzle Height (ft.)	Maximum Side 2 (ft.)	Side 1 (ft.)	Nozzle Height (ft.)	Maximum Side 2 (ft.)	Side 1 (ft.)	Nozzle Height (ft.)	Maximum Side 2 (ft.)	Side 1 (ft.)	Nozzle Height (ft.)	Maximum Side 2 (ft.)
3	8	16.70	7	8	15.46	11	8	12.92	15	8	7.94
	9	16.70		9	15.46		9	12.92		9	7.94
	10	16.70		10	15.46		10	11.78		10	7.94
	11	16.70		11	15.46		11	10.71		11	7.85
	12	16.70		12	15.43		12	9.82		12	7.20
	13	16.70		13	14.24		13	9.06		13	6.65
	14	16.70		14	13.22		14	8.42		14	6.17
	15	16.70		15	12.34		15	7.85		15	5.76
	16	16.70		16	11.57		16	7.36		16	5.40
	17	16.70		17	10.89		17	6.93		17	5.08
	18	16.70		18	10.29		18	6.55		18	4.80
	19	16.70		19	9.74		19	6.20		19	4.55
	20	16.70		20	9.26		20	5.89		20	4.32
4	8	16.49	8	8	14.97	12	8	12.00	16	8	5.66
	9	16.49		9	14.97		9	12.00		9	5.66
	10	16.49		10	14.97		10	10.80		10	5.66
	11	16.49		11	14.73		11	9.82		11	5.66
	12	16.49		12	13.50		12	9.00		12	5.66
	13	16.49		13	12.46		13	8.31		13	5.66
	14	16.49		14	11.57		14	7.71		14	5.66
	15	16.49		15	10.80		15	7.20		15	5.40
	16	16.49		16	10.13		16	6.75		16	5.06
	17	16.49		17	9.53		17	6.35		17	4.76
	18	16.49		18	9.00		18	6.00		18	4.50
	19	16.49		19	8.53		19	5.68		19	4.26
	20	16.20		20	8.10		20	5.40		20	4.05
5	8	16.22	9	8	14.39	13	8	10.91			
	9	16.22		9	14.39		9	10.91			
	10	16.22		10	14.39		10	9.97			
	11	16.22		11	13.09		11	9.06			
	12	16.22		12	12.00		12	8.31			
	13	16.22		13	11.08		13	7.67			
	14	16.22		14	10.29		14	7.12			
	15	16.22		15	9.60		15	6.65			
	16	16.20		16	9.00		16	6.23			
	17	15.25		17	8.47		17	5.86			
	18	14.40		18	8.00		18	5.54			
	19	13.64		19	7.58		19	5.25			
	20	12.96		20	7.20		20	4.98			
6	8	15.87	10	8	13.71	14	8	9.59			
	9	15.87		9	13.71		9	9.59			
	10	15.87		10	12.96		10	9.26			
	11	15.87		11	11.78		11	8.42			
	12	15.87		12	10.80		12	7.71			
	13	15.87		13	9.97		13	7.12			
	14	15.43		14	9.26		14	6.61			
	15	14.40		15	8.64		15	6.17			
	16	13.50		16	8.10		16	5.79			
	17	12.71		17	7.62		17	5.45			
	18	12.00		18	7.20		18	5.14			
	19	11.37		19	6.82		19	4.87			
	20	10.80		20	6.48		20	4.63			

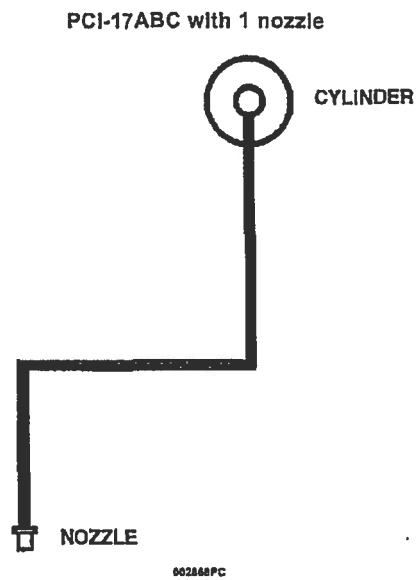


**Total Flooding Piping Limits PCI-17ABC**

Cylinder Size	Nozzle Quantity	Nozzle Type	Piping Section	Size	Length Maximum	Elbows Maximum
PCI-17ABC	1	NF-ABC	Cylinder to Nozzle	3/4 in.	30 ft.	4

**NOTE:**

1. PCI-17ABC uses one (1) NF-ABC nozzle.
2. A Main/Reserve Swing Check Valve, Part No. 417788, may be located between the cylinder and T1.



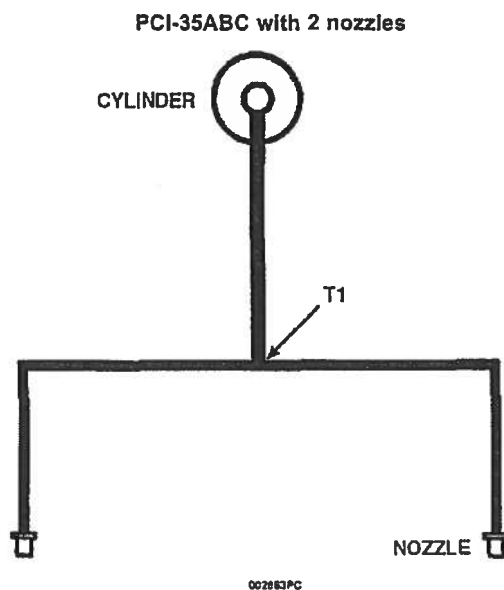


Total Flooding Piping Limits PCI-35ABC

Cylinder Size	Maximum Nozzle Quantity	Nozzle Type	Piping Section	Size	Length Maximum	Elbows Maximum
PCI-35ABC	2	NF-ABC	Cylinder to T1	3/4 in.	30 ft. (9.1 m)	4
			T1 to Nozzle	3/4 in.	9 ft. (2.7 m)	2

**NOTE:**

1. PCI-35ABC must always use two (2) NF-ABC nozzles.
2. System piping must be balanced. Balanced piping is that in which the difference between the shortest actual pipe length from T1 to nozzle and the longest actual pipe length from T1 to nozzle does not exceed 10% of the longest actual pipe length from T1 to nozzle. The number and type of fittings from all last tee to nozzle sections must be equal.
3. A Main/Reserve Swing Check Valve, Part No. 417788, may be located between the cylinder and T1.

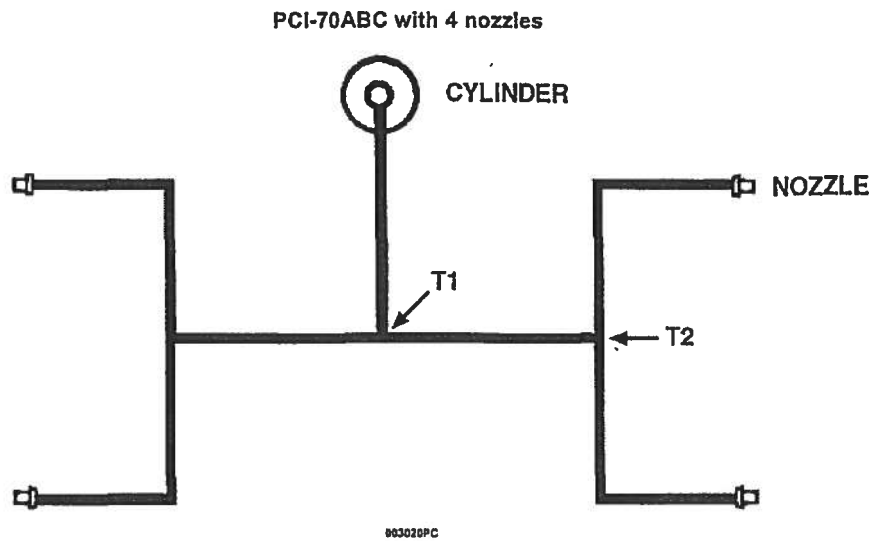

Total Flooding Piping Limits PCI-70ABC

Cylinder Size	Maximum Nozzle Quantity	Nozzle Type	Piping Section	Size	Length Maximum	Elbows Maximum
PCI-70ABC	4	NF-ABC	Cylinder to T1	1 in.	30 ft. (9.1 m)	3
			T1 to T2	1 in.	14 ft. (4.3 m)	2
			T2 to Nozzle	3/4 in.	9 ft. (2.7 m)	2

**NOTE:**

1. PCI-70ABC must always use four (4) NF-ABC nozzles.
2. System piping must be balanced. Balanced piping is that in which the difference between the shortest actual pipe length from T1 to nozzle and the longest actual pipe length from T1 to nozzle does not exceed 10% of the longest actual pipe length from T1 to nozzle. T2 to nozzle on the same branch must not exceed 10% of each other. The number and type of fittings from all last tee to nozzle sections must be equal.
3. A Main/Reserve Swing Check Valve, Part No. 417788, may be located between the cylinder and T1.



## Detector Placement.

Thermal detectors are required in all hazard areas protected by the PYRO-CHEM Industrial Fire Suppression Systems if automatic system operation is required. Either mechanical or electrical thermal detectors can be used for automatic system operation. Mechanical detectors (fusible links) are used in conjunction with the PYRO-CHEM Models MCH3 and NMCH3 control devices. Electrical detectors are used in conjunction with the PYRO-CHEM Models ECH3-24 and ECH3-120 Control Heads.

### TOTAL FLOODING (DETECTOR SPACING) – THERMAL

Ceiling Height	Spacing
Up to 14 ft. (4.2 m) Height	15 ft. (4.5 m) maximum between detectors 7 ft. 6 in. (2.3 m) max. from wall 225 sq. ft. (20.9 sq. m) max. coverage per detector
Greater than 14 ft. (4.2 m) up to 20 ft. (6.1 m) height	13 ft. (3.9 m) maximum between detectors 6 ft. 6 in. (1.9 m) max. from wall 169 sq. ft. (15.7 sq. m) max. coverage per detector
Greater than 20 ft. (6.9 m) up to 24 ft. (7.3 m)	11 ft. (3.4 m) max. between detectors 5 ft. 6 in. (1.7 m) max. from wall 121 sq. ft. (11.2 sq. m) max. coverage per detector
Greater than 24 ft. (7.3 m) up to 30 ft. (9.1 m)	9 ft. (2.7 m) max. between detectors 4 ft. 6 in. (1.4 m) max. from wall 81 sq. ft. (7.5 sq. m) max. coverage per detector

NOTE: For sloped ceiling (peaked type or shed type) installations, refer to NFPA-72, "National Fire Alarm Code" for detailed spacing requirements.

LOCAL APPLICATION – OVERHEAD (DETECTOR SPACING) – Maximum spacing per detector is 100 ft.<sup>2</sup> (9.3 m<sup>2</sup>) or 5 ft. (1.5 m) from edge of hazard and 10 ft. (3.1 m) between detectors. When detectors are mounted below the ceiling in an open area, heat traps are recommended.

LOCAL APPLICATION – TANKSIDE (DETECTOR SPACING) – Detectors can be located either near the inner tank wall and flammable liquid surface or above the tank. If located above the tank, the rules for local application overhead would apply. If located on the tank wall, the detectors can be mounted horizontally or vertically in the freeboard area, but must be protected from damage during normal working operations. The maximum spacing per detector is 5 ft. (1.5 m) from edge of hazard and 10 ft. (3.1 m) between detectors.

A temperature survey must be performed to determine the  
 ▶ maximum ambient temperature of the hazard survey. See  
 ▶ Temperature Chart in Chapter 2 – Components.

### TOTAL FLOODING (DETECTOR SPACING) – FUSIBLE LINKS

Ceiling Height	Spacing
Up to 14 ft. (4.2 m) Height	10 ft. (3.0 m) maximum detectors 5 ft. (1.5 m) max. from a wall* 100 sq. ft. (9.2 sq. m) max. coverage per detector
Greater than 14 ft. (4.2 m) up to 20 ft. (6.1 m) height	8 ft. (2.4 m) max. between detectors 4 ft. (1.2 m) max. from wall 64 sq. ft. (5.9 sq. m) max. coverage per detector

NOTE: For sloped ceiling (peaked type or shed type) installations, refer to NFPA-72, "National Fire Alarm Code" for detailed spacing requirements.

LOCAL APPLICATION – OVERHEAD (DETECTOR SPACING) – Maximum spacing per fusible link detector is 36 ft.<sup>2</sup> (3.3 m<sup>2</sup>) or 3 ft. (.9 m) from edge of hazard and 6 ft. (1.8 m) between fusible link detectors.

When a detector(s) is mounted more than 1 ft. (.3 m) below ceiling or in an open area, heat trap(s) is recommended. Detectors should be mounted overhead at nozzle height or as close to the hazard as possible without interference, not to exceed 10 ft. (3 m).

Detectors should not be located where they will be susceptible to damage during the normal work operation.

LOCAL APPLICATION – TANKSIDE (DETECTOR SPACING) – Detectors can be located either near the inner tank wall and flammable liquid surface or above the tank. If located above the tank, the rules for local application overhead would apply. If located on the tank wall, the detectors can be mounted horizontally or vertically in the freeboard area but must be protected from damage during normal working operation. Detectors should be located at a maximum spacing per detector of 3 ft. (.9 m) from edge of hazard and 6 ft. (1.8 m) between detectors on the long side of the tank.

\*For 14 ft. (4.3 m) wide booths with maximum height of 12 ft. (3.7 m), the detector location off the side wall can be a maximum of 7 ft. (2.1 m).



3005

Pitfield boulevard

Saint-Laurent, Québec, Canada

H4S 1H4

Tel.: 5 1 4. 3 3 2. 5 1 1 0

Fax: 5 1 4. 3 3 2. 6 2 6 0

[info@vikingfire.ca](mailto:info@vikingfire.ca)

## CHAPTER 4

## INSTALLATION



## CHAPTER IV SYSTEM INSTALLATION

This chapter will detail the basic information necessary for proper installation of the PYRO-CHEM Industrial Fire Suppression System. However, before attempting any installation it is necessary to attend a Factory Certification Training Class and become Certified to install the PYRO-CHEM Industrial Fire Suppression System.

Pipe and fittings for the discharge piping, conduit (EMT), pipe straps, pipe hangers, mounting bolts, and other miscellaneous equipment are not furnished as part of the PYRO-CHEM Industrial Fire Suppression System. These items must be furnished by the installer.

Before attempting any installation, unpack the entire system and check that all necessary parts are on hand. Inspect parts for damage. Verify that cylinder pressure is within the acceptable range as shown on the gauge.


### CYLINDER INSTALLATION

The cylinder and valve assembly is shipped with an anti-recoil plug in the valve discharge port.

#### CAUTION

The anti-recoil plug must remain in the valve discharge port until the discharge piping is connected to the valve.

The cylinder must be mounted vertically with the discharge port facing either left or right. The Models PCI-17 and PCI-25 cylinders must be mounted using a Model MB-15 Mounting Bracket Kit. The Model PCI-35, PCI-50, PCI-70, and PCI-cylinders must be mounted using a Model MB-1 Mounting Bracket Kit.

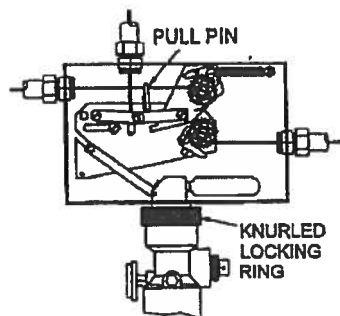

The bracket must be securely anchored to the wall using bolts or lag screws. The wall to which the bracket is attached must be sufficiently strong to support the cylinder. The bracket should never be fastened to dry wall or similar material. If this type of wall is encountered, studs must be located and the bracket fastened to them. See Figure 4-1.

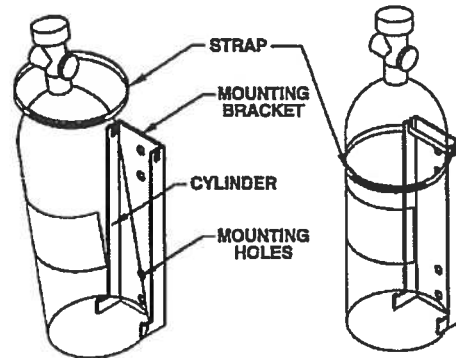


Figure 4-1. Cylinder and Mounting Bracket Installation.

002871PC

### CONTROL HEAD INSTALLATION

#### 1. Single Cylinder Installations.

For single cylinder system installations the Model MCH3/ECH3/NMCH3 Control Head can be installed directly onto the cylinder valve. When the control head is properly aligned in the desired position, tighten the knurled locking ring to secure the assembly. See Figure 4-2.

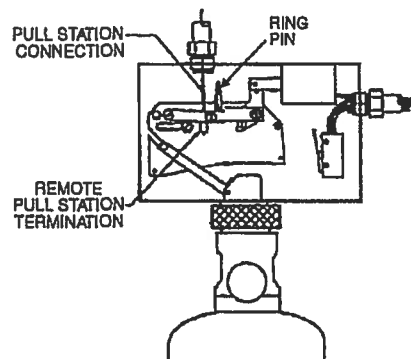


Figure 4-2. Single Cylinder Installation Using Model MCH3/ECH3/NMCH3 Control Head

002872PC/003647PC

## FUSIBLE LINK DETECTOR INSTALLATION

Fusible links are always used in conjunction with the Model MCH3 Mechanical Control Head. After mounting the cylinder and control head, the fusible link line can be installed. The first step to installing the fusible link line is to install the detector bracket(s). These brackets must be installed in the plenum area, hazard area, and in each duct. See Chapter III for detector placement guidelines.

**Note:** Only ML-style Fusible Links can be used.

- Connect the fusible link brackets together using 1/2 in. conduit and the conduit connectors supplied in the detector kit (Model FLK-1/1A). A PYRO-CHEM corner pulley must be used whenever a change in conduit direction is necessary. The conduit is connected to the control head through a knockout in the upper left-side corner.

- In general, fusible links centered in the detector brackets
- are connected in series using 1/16 in. diameter stainless steel cable. The spring plate in the control head maintains tension on this series of fusible links. If the tension is released for any reason (i.e., a fusible link separates), the control head will operate and actuate the system. Maximum limitations for the fusible link detection line are as follows:

Fusible links can be installed with or without fusible link hangers (see Chapter II for description).

### Fusible Link Line Limitations When Used With Model MCH3 and NMCH3 Control Heads and Part No. 415670 and 423250 Pulley Elbows

Maximum # of Detectors:	20
Maximum length of cable:	150 ft. (45.7 m)
Maximum # of pulleys:	40

## 1. Fusible Link Installation Without Hangers.

Begin installing links at the terminal bracket. The link is connected to the far side of the terminal bracket using an "S" hook. The "S" hook must be crimped closed after the link is installed. A tight loop is then made in the cable and secured by the crimp provided. This loop is connected to the other side of the terminal link (see Figure 4-6) and the cable fed through the conduit to the next bracket. The cable proceeding from the terminal link will be used to connect the series links (see Figure 4-7). Series links must be centered in their detector brackets.

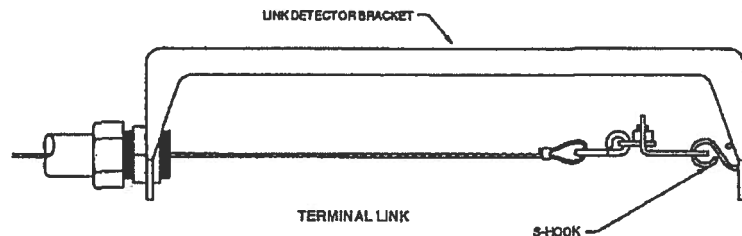


Figure 4-6. Terminal Link Installation.

002849PG

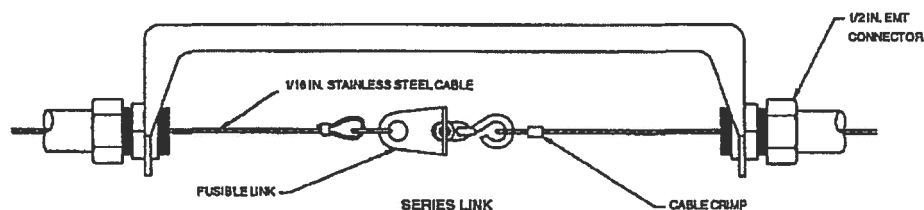


Figure 4-7. Series Link Installation.

002849PG



After the last link in the series is connected, the cable should be fed through the conduit back to the control head. Thread the cable through the hole in the fusible link ratchet wheel. The line must then be crimped, and the crimp positioned inside the center of the ratchet wheel.

#### NOTE

Crimps must always be used in conjunction with two (2) cable lengths. Loops are the accepted method of connecting the cable to mechanical components. The crimp must never be used on a single cable.  
Exception: Single cable crimp allowed in detection and gas valve ratchet wheel using stop sleeve, Part No. 26317 (packages of 10; Part No. 24919).

The fusible link line can now be put into a set position by applying tension to the fusible link line. This is accomplished by using a 1/2 in. hex wrench on the fusible link line ratchet wheel. The ratchet wheel will be ratcheted in a clockwise direction until the spring plate makes contact with the top of the control head box. The fusible link line is now in a set position. See Figure 4-8.

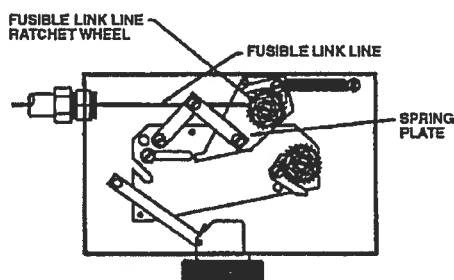


Figure 4-8. Fusible Link Line Termination.  
002878PC

## 2. Fusible Link Installation Using Model FLH-1 Fusible Link Hangers.

Beginning at the control head, feed the stainless steel cable through the conduit and brackets to the terminal bracket in one continuous length. Allow approximately 2.5 in. (6.4 cm) of slack at each bracket for the installation of the Fusible Link Hangers. At the terminal link, a tight loop is made in the cable and secured by the crimp provided. The cable is attached to the far side of the terminal bracket using an "S" hook. The "S" hook must be crimped closed after the cable is installed. See Figure 4-9.

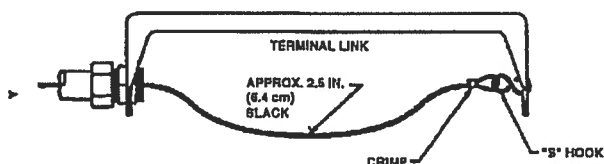


Figure 4-9. Terminal Bracket Connection.  
002877PC

Begin installing the Fusible Link Hangers at the terminal bracket and work toward the control head. Loop the cable through the oval opening in the hanger and hook the fusible link on the loop. See Figure 4-10.

Note: Only ML-style Fusible Links can be used

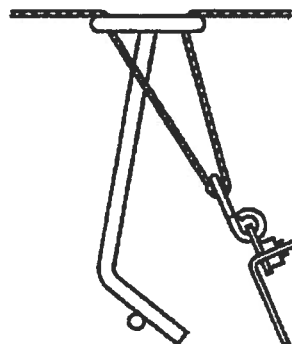


Figure 4-10. Fusible Link Connection.  
002876PC

Hook the bottom of the link onto the bottom leg of the hanger. See Figure 4-11.

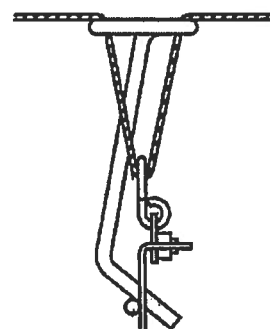


Figure 4-11. Fusible Link/Hanger Connection.  
002879PC

Center the hanger/link in the fusible link bracket by sliding it along the link line. This is easily accomplished before any tension is applied to the link line. Repeat this procedure for all fusible links.

After the last hanger/link in the series is connected, the cable should be fed through the hole in the fusible link ratchet wheel. The line must then be crimped, and the crimp positioned inside the center of the ratchet wheel.

#### NOTE

Crimps must always be used in conjunction with two (2) cable lengths. Loops are the accepted method of connecting the cable to mechanical components. The crimp must never be used on a single cable.  
Exception: Single cable crimp allowed in detection and gas valve ratchet wheel using stop sleeve, Part No. 26317 (packages of 10; Part No. 24919).

The fusible link line can now be put into a set position by applying tension to the fusible link line. This is accomplished by using a 1/2 in. hex wrench on the fusible link line ratchet wheel. The ratchet wheel will be ratcheted in a clockwise direction until the spring plate makes contact with the top of the control head box. The fusible link line is now in a set position. See Figure 4-8. Check to ensure that the fusible link hanger(s) remain centered in the bracket after the fusible link line is set. See Figure 4-12.

## THERMAL DETECTOR INSTALLATION

Thermal detectors are always used in conjunction with the Model ECH3 Electrical Control Head. After mounting the cylinder and control head, the thermal detector(s) can be installed. See Chapter III for detector placement guidelines. Follow the instructions included with the detector for proper detector mounting procedures.

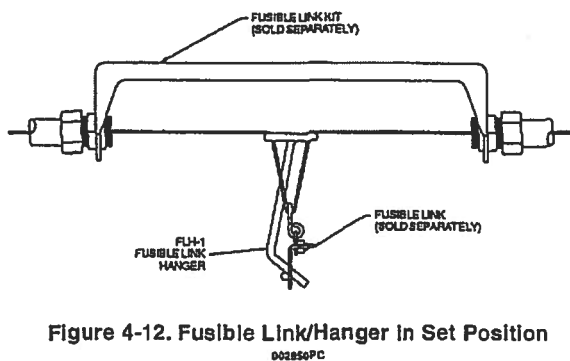


Figure 4-12. Fusible Link/Hanger In Set Position

## SETTING THE CONTROL HEAD

### 1. Model MCH3/NMCH3 Mechanical Control Head.

Once the fusible link line is set, the control head can be placed in the set position. To set the control head, the slide plate is moved from right to left, ensuring the bolt extending from the cam arm is in the slot provided in the slide plate. Continue moving the slide plate to the left until the latching arm is in the locked position. Insert the pull pin into the hole in the slide plate above the latching arm. This will lock the control head in the set position, eliminating accidental actuation during the rest of the installation procedure. See Figure 4-13.

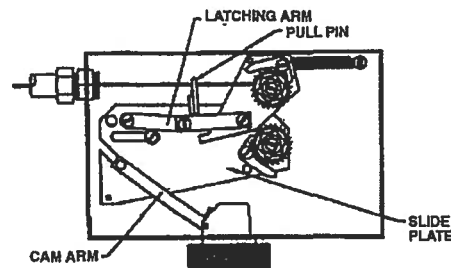


Figure 4-13. Control Head In Set Position.

### 2. Model ECH3 Electrical Control Head.

Once the thermal detectors have been installed, the control head can be placed in the set position. To set the control head, the slide plate is moved from right to left, ensuring the bolt extending from the cam arm is in the slot provided in the slide plate. Continue moving the slide plate to the left until the latching arm is in the locked position. Insert the pull pin into the hole in the slide plate above the latching arm. This will lock the control head in the set position, eliminating accidental actuation during the rest of the installation procedure.

Once the Model ECH Electrical Control Head is in the set position, it can be connected to the detection/actuation circuit.

### NOTE

No electrical connections shall be made inside the control head. All electrical wiring shall exit the control head through the knock-out on the side of the box. All electrical connections must be made in an approved electrical box.

Connect one of the black wires on the solenoid in the control head to the red wire of the Model MS-SPDT Micro Switch. The brown wire from the micro switch is then connected to one side of the first thermal detector in series. Connect the other side of the first thermal detector in series and the remaining black wire on the solenoid in the control head to the appropriate power source after installing the Model SM-24/120 Solenoid Monitor.

### CAUTION

The solenoid must never be wired "hot" (not through the micro-switch). If wired this way, the non-field replaceable solenoid will be damaged and the complete control head will require replacement.



### NOTE

A Model SM-24/120 Solenoid Monitor must always be used with an Electrical Control Head to supervise the actuation/detection circuit.

The Model ECH3-24 Electrical Control Head requires a UL Listed 24VDC power supply with a minimum 2A rating. The Model ECH3-120 Electrical Control Head requires a 1A, 120VAC power supply.

## SOLENOID MONITOR INSTALLATION

### 1. Solenoid Monitor Installation In Detection Circuit.

After installing the thermal detectors and the control head, the Model SM-120/24 Solenoid Monitor can be installed. The Solenoid Monitor is connected to the wires leading from the last thermal detector. It should be mounted in a location where it can be readily observed.

The Solenoid Monitor is an end-of-line device that supervises the actuation/detection circuit. It is comprised of a push-type switch with a built-in indicator light, a plug-type relay, a relay socket, and a cover plate. The light, when illuminated, indicates that the detection/actuation circuit is in the normal condition. The Solenoid Monitor also provides two sets of dry contacts. The Solenoid Monitor's cover plate is used to mount the Solenoid Monitor in a standard 6 in. x 4 in. x 3 in. deep electrical box (See Figure 4-14).

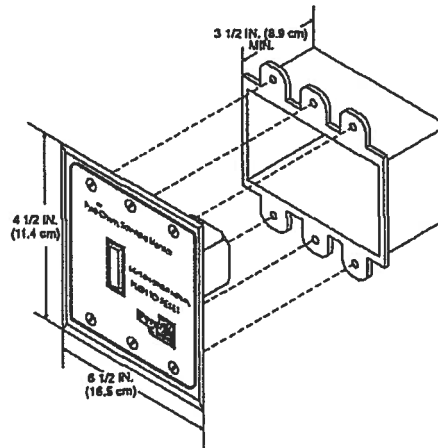


Figure 4-14. Solenoid Monitor Installation.

002881PC

All wire for circuits using the Model SM-24 shall be 18 gauge minimum, or as required by local code. All wire for circuits using the Model SM-120 shall be 14 gauge minimum, or as required by local code. The basic wiring diagram for both the Model SM-24 and Model SM-120 is shown in Figure 4-14.1.

After the Solenoid Monitor has been installed, the detection/actuation circuit can be connected to the appropriate power source and energized. To energize the detector/actuation circuit, depress the switch on the Solenoid Monitor. The light will illuminate to indicate that the circuit is properly installed. If the light fails to illuminate, the wiring must be checked.

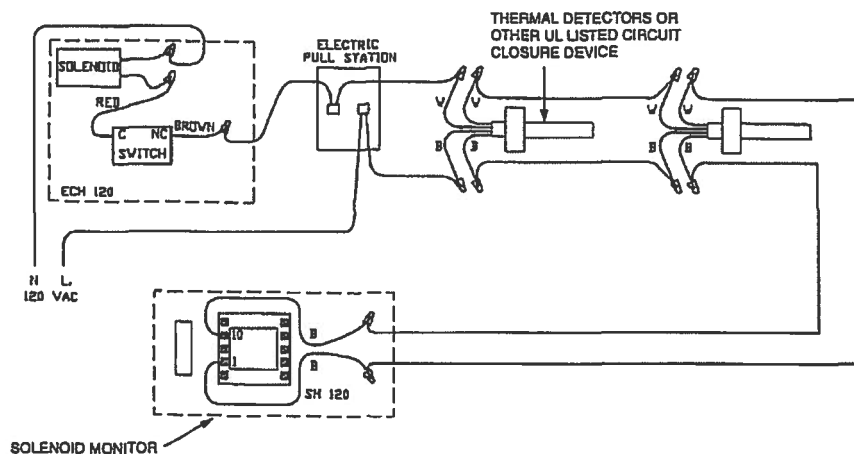


Figure 4-14.1. Wiring Diagram, Solenoid.

002882PC

## 2. Solenoid Monitor When Used As A Reset Relay

The Model SM-24/120 can be used as a reset relay when required. A reset relay is required whenever an electrical gas shut-off valve is used in conjunction with the Pyro-Chem Booth Industrial Fire Suppression System. For typical wiring connections, see Figure 4-15.

## REMOTE PULL STATION INSTALLATION

### 1. Model RPS-M.

The Model RPS-M Remote Mechanical Pull Station is used for remote mechanical actuation of the Model MCH3/ECH3/NMCH3 Control Head. It is to be located near an exit in the path of egress from the hazard area no more than 4 ft. (1.2 m) above the floor.

#### NOTE

A model RPS-M remote mechanical pull station must be used for manual actuation of a Model NMCH3 releasing device.

- The Pull Station can be surface mounted or recessed. It is connected to the control head using 1/16 in. diameter stainless steel cable. The cable enters the pull station box from the bottom, top, either side, or back. The cable enters the control head through the top-center knockout. The cable must be enclosed in 1/2 in. conduit with a PYRO-CHEM corner pulley at each change in conduit direction. Maximum limitations for the Model RPS-M Remote Mechanical Pull Station are as follows:

**Model RPS-M Cable Run Limitations When Used With Model MCH3, ECH3, and NMCH3 Control Heads and Part No. 415670 and 423250 Pulley Elbows**

Maximum length of cable: 150 ft. (45.7 m)  
Maximum # of pulleys: 40

After mounting the pull station box and conduit, feed the stainless steel cable from the control head, through the conduit, and into the pull station box. Insert the bushing into the pull station's cover plate and secure it with the locknut provided. Feed the cable through the bushing and into the pull handle ensuring that the cable fully crosses the set screw hole. Fasten the cable to the pull handle with the set screw (see Figure 4-16).

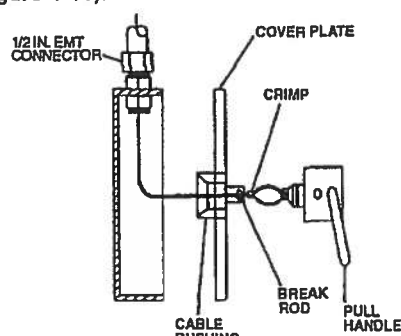


Figure 4-16. Model RPS-M Remote Pull Station Installation.

00284PC

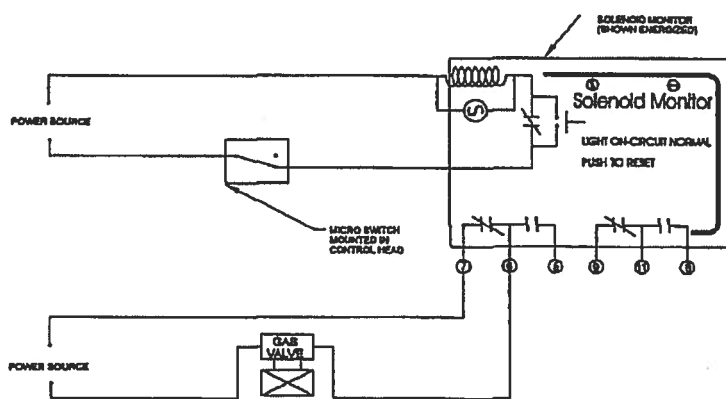


Figure 4-15. Solenoid Monitor Wiring With Electrical Gas Shut-off Valve.

00283PC



### NOTE

Crimps must always be used in conjunction with two (2) cable lengths. Loops are the accepted method of connecting the cable to mechanical components. The crimp must never be used on a single cable. Exception: Single cable crimp allowed in detection and gas valve ratchet wheel using stop sleeve, Part No. 26317 (packages of 10: Part No. 24919).

Cut and thread the cable through the hole in the latching arm of the control head and pull the cable tight. Crimp the cable 6 in. (15.2 cm) below the latching arm.

Pull the pull handle until the crimp touches the latching arm. Coil the excess cable in the pull box and attach the cover plate with the four screws provided. Insert the pull handle into the cover plate and insert the pull pin through the bushing and the pull handle. Secure the pull pin with the nylon tie provided. See Figure 4-17.

## 2. Model RPS-E2.

The Model RPS-E2 remote electrical pull station is used for remote actuation of the Model ECH3 Control Head. It is to be located near an exit in the path of egress from the hazard area no more than 4 ft. (1.2 m) above the floor. The Model RPS-E2 is installed in the detection/actuation circuit and wired in accordance with the instructions included. See Figure 4-14.1 for typical circuit wiring.

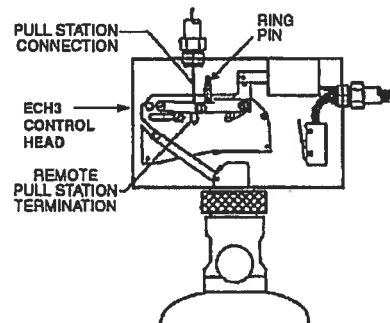
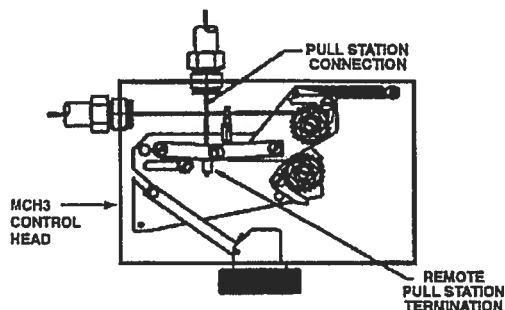


Figure 4-17. Model RPS-M Remote Pull Station Termination.

002845PC/003847PC

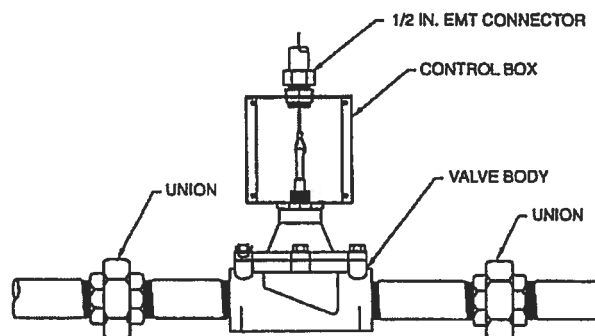


Figure 4-18. Gas Valve Installation.

002845PC

## GAS SHUT-OFF VALVE INSTALLATION

### 1. Mechanical Gas Shut-Off Valve Installation.

The Model MCH3/NMCH3 Control Head is used to operate the mechanical gas shut-off valve. This valve is located in the fuel gas supply line. The valve body has an arrow which indicates direction of gas flow through the valve. The gas shut-off valve is spring loaded and requires five pounds of force to hold it open. This force is supplied by a 1/16 in. diameter stainless steel cable that is connected to the control head. After the valve is installed in the gas line, 1/2 in. conduit must be run from the top center knockout of the gas valve box to the lower right-hand knockout in the control head. A PYRO-CHEM corner pulley is used wherever a change in conduit direction is required.

**Gas Valve Cable Run Limitations When Used With Model NMCH3 or MCH3 Control Heads and Part No. 415670 and 423250 Pulley Elbows**

Maximum length of cable:	100 ft. (30.5 m)
Maximum # of pulleys:	30

Remove the gas valve cover and thread the stainless steel cable through the conduit back to the control head. Thread the cable through the hole in the gas valve ratchet wheel. The line must then be crimped, and the crimp positioned inside the center of the ratchet wheel.

At the gas valve, loop the cable through the valve stem and secure it with the crimp provided (see Figure 4-18).

- Note: See Chapter 2 – Components for maximum dimension to extend valve stem.

The gas valve line can now be put into a set position by applying tension to the gas valve line. This is accomplished by using a 1/2 in. hex wrench on the gas valve ratchet wheel. The ratchet wheel will be ratcheted in a clockwise direction until the gas valve is fully open. Secure the gas valve cover plate to the gas valve box with the four (4) screws provided. The gas valve line is now in a set position. See Figure 4-19.

### CAUTION

Overtightening the gas valve may cause the system not to actuate.

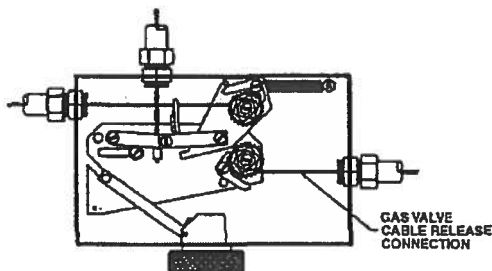


Figure 4-19. Gas Valve Line Termination.

002887PC

## 2. Electrical Gas Shut-Off Valve Installation.

The Model MCH3/ECH3/NMCH3 Control Head is used to operate the electrical gas shut-off valve. This valve is located in the fuel gas supply line. The valve body has an arrow which indicates direction of gas flow through the valve. A reset relay must always be used with an electrical gas shut-off valve. For proper wiring of the electrical gas shut-off valve, see Figure 4-15.

## TEE PULLEY INSTALLATION

The Model TP-1 Tee Pulley is used to connect two (2) mechanical gas valves or two (2) remote mechanical pull stations to a single control head. The cable proceeding from the control head must always enter the branch of the tee pulley. See Figure 4-20.

A tee pulley that is used to close two (2) gas valves can only be used to close gas valves with similar stem travel. Gas valves from 3/4 in. up to 1 1/2 in. can be used on the same tee pulley. A 2 in. gas valve can be used only with another 2 in. gas valve. Gas valves from 2 1/2 in. up to 3 in. can be used on the same tee pulley. As an example, using a 3/4 in. gas valve with a 3 in. gas valve will not allow the 3 in. valve to fully open.

### CAUTION

The tee pulley must never be used to connect multiple fusible link lines to a single control head.

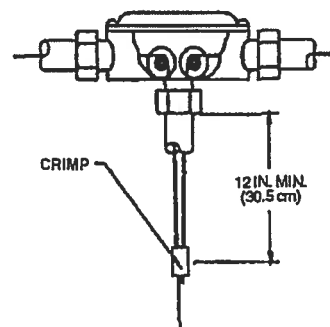


Figure 4-20. Tee Pulley Installation.

002888PC

## MICRO SWITCH INSTALLATION

See NFPA 72, "National Fire Alarm Code," Initiating Devices section, for the correct method of wiring connection to the fire alarm panel.

The Model MS-SPDT, MS-DPDT, MS-3PDT, or MS-4PDT Micro Switch is available for use where an electrical output is required. These switches can be field installed in the control head. See Figure 4-21 and Figure 4-22 and refer to Instruction Sheet, Part No. 551159, included with switch shipping assembly, for detailed mounting instructions.

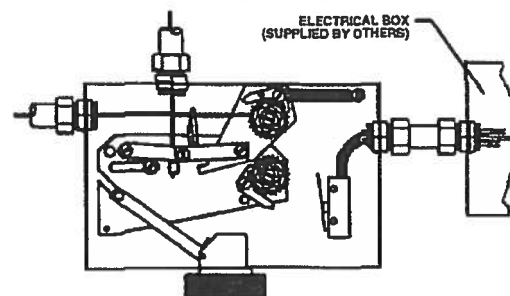


Figure 4-21. Micro Switch Installation in Model MCH3/NMCH3 Control Head.

002889PC



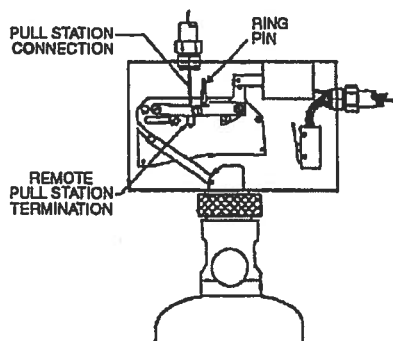


Figure 4-22. Micro Switch Installation in Model ECH3 Control Head.

003647PC

### NOTE

The Model ECH3 Control Head is supplied with a Model MS-DPDT Micro Switch. This switch can be used in the actuation/detection circuit and for electrical output.

These switches may be used to provide an electrical signal to the main breaker and/or operate electrical accessories provided the rating of the switch is not exceeded. Wiring connections are shown in Figure 4-23. The contact ratings for the switches are as follows:

**Contact Ratings For Micro Switches**  
21 amps, 1 HP, 125, 250, 277 VAC  
or 2 HP, 250, 277 VAC



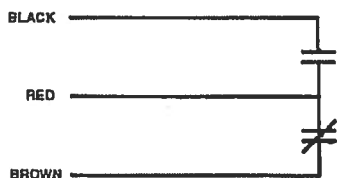


Figure 4-23. Wiring Diagram For Model MS-SPDT Micro Switch.

002803PC

The Alarm Initiating Switch, Part No. 550077, must be used to close a supervised alarm circuit to the building main fire alarm panel when the control head actuates. This will signal the fire alarm panel that there was a system actuation in the hazard area. This switch can be field installed in the control head. Refer to Instruction Sheet, Part No. 550081, included with the switch shipping assembly, for detailed mounting instructions. Wiring connections are shown in Figure 4-24. The switch is rated at 50mA, 28VDC.

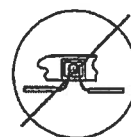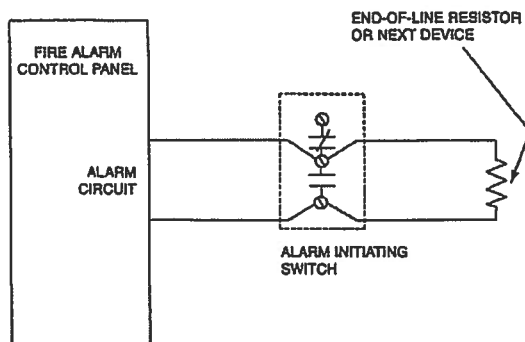

CORRECT – SEPARATE INCOMING AND OUTGOING CONDUCTORS

Figure 4-24. Wiring Diagram for Alarm Initiating Switch.

004801/004805

## PIPE AND NOZZLE INSTALLATION

### General Piping Requirements

1. Use Schedule 40 black iron (if used in a relatively non-corrosive atmosphere), galvanized, chrome-plated, or stainless steel pipe conforming to ASTM A120, A53, or A106. Fittings must be a minimum of 150 lb. Class. However, the PCI 35, 50, and 70 lb. cylinders must have a minimum of two (2) nozzles per cylinder to utilize the 150 lb. Class fittings. If the PCI 35, 50, or 70 lb. cylinder has one (1) nozzle, then a 300 lb. Class fitting must be used. The remaining Monarch cylinders have no limitations for the 150 lb. Class fittings. Distribution pipe sizes are 3/4 in. or 1 in. depending on number of nozzles.
2. Pipe unions are acceptable.
3. Use reducing tees for all pipe splits.
4. Reducing bushings are not acceptable.
5. Cast Iron pipe and fittings are not acceptable.
6. Pipe thread sealant or pipe joint compound is not allowed for distribution piping.
7. Bell Reducer or any non-restrictive fittings are allowed.
8. Before assembling the pipe and fittings, make certain all ends are carefully reamed and blown clear of chips and scale. Inside of pipe and fittings must be free of oil and dirt.

- 9. If Teflon tape is used on threaded ends, start at the second male thread and wrap the tape clockwise around the threads, away from the pipe opening.
- 10. All system piping must comply with Section A-5-9.1 of NFPA-17.

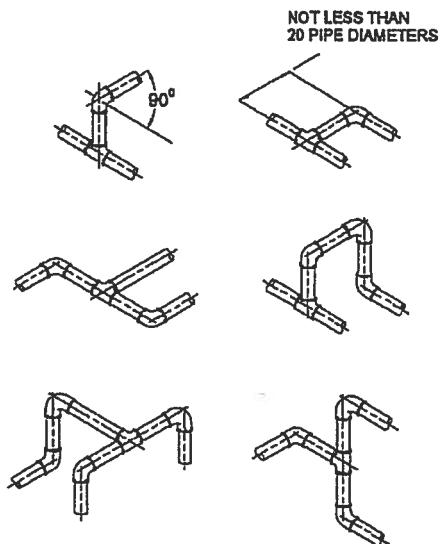


Figure 4-25. Acceptable Piping Methods.

### CAUTION

Do not apply Teflon tape to cover or overlap the pipe opening, as the pipe and nozzles could become blocked and prevent the proper flow of agent.

## TEE POSITIONING

In order to obtain equal distribution at a tee, the dry chemical must enter the side port of the tee and exit through the two end ports. See Figure 4-26.

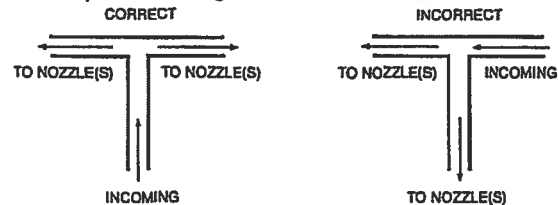


Figure 4-26. Tee Positioning

### Hanger/Support Installation

The hanger/supports must be installed in conjunction with the pipe and fittings. The spacing requirements for hangers/supports depend on the pipe size being utilized; refer to the Spacing Guidelines Chart.

#### PIPE HANGER SPACING GUIDELINES CHART

Distribution Pipe Size	Maximum Spacing Distance Hanger to Hanger	
in.	ft.	m
1/4	4	(1.2)
1/2	6	(1.8)
3/4	8	(2.4)
1	12	(3.6)

Other factors that influence hanger/support spacing are:

- Hanger/Support must be placed within 1 ft. (0.3 m) of the discharge nozzle.

Hanger/Support must be placed between elbows when distance is greater than 2 ft. (0.6 m).

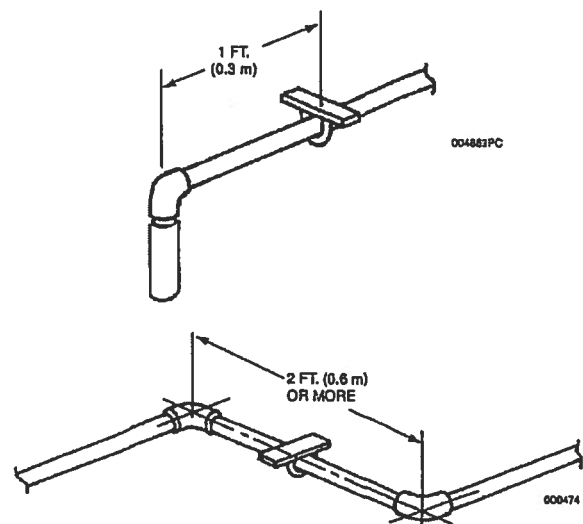


Figure 4-27. Hanger/Support.

## MAIN/RESERVE SYSTEM

When a reserve system is being utilized, two 1 in. swing check valves, Part No. 417788, must be installed in the distribution piping network. They should be positioned as close as possible to the "Y" fitting joining the piping from the main and reserve tanks to one common supply pipe. See Figure 4-28. Note: Make certain to install swing check valves in the direction of dry chemical flow as shown with an arrow stamped on the valve body.

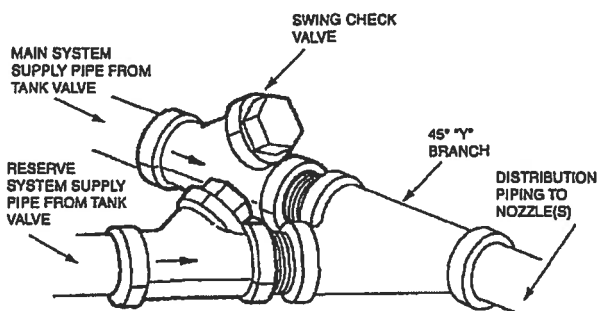


Figure 4-28. Main/Reserve System.

## PRESSURE SWITCH INSTALLATION

The Model PS-SPDT-X Pressure Switch is available for use when an electrical output is required. It must be installed in the discharge piping within 12 in. (30.5 cm) of the valve discharge port as shown in Figure 4-29. An inline tee is used for the installation. The switch is isolated from the chemical by a 12 in. to 15 in. (30.5 to 38.1 cm) column of air in the form of a vertical pipe nipple. The switch is then mounted at the top of this nipple.

### NOTE

Piping for pressure switch must be included in total cylinder to T1 piping limitations. The fitting used to connect the pressure switch to the distribution piping counts as one (1) elbow in that section.

As an alternate, the switch may be connected directly to the copper tubing of a remotely mounted control head or a PAC cylinder. The PS-SPDT-X counts as one cylinder in this section, and the limitations on copper tubing and/or pipe previously stated in this manual apply.

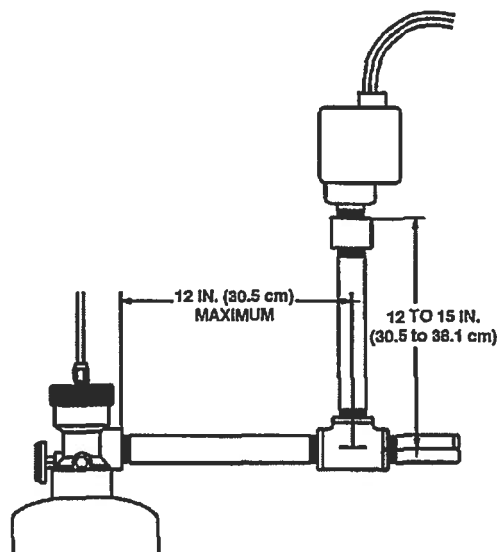


Figure 4-29. Pressure Switch Installation.

003025PC

## SYSTEM CHECKOUT AFTER INSTALLATION

### 1. Model MCH3 Mechanical Control Head.

Before putting the system into service, all components must be checked for proper operation. During this checkout, assure that the carbon dioxide pilot cartridge is not installed in the control head actuator. Remove the pull pin from the hole in the slide plate.

To check satisfactory operation of the control head, cut the terminal link or the "S" hook holding the link. This will relieve all tension on the fusible link line and operate the control head. The slide plate will move fully to the right. The gas valve cable will be released, causing the gas valve to close. Any auxiliary equipment connected to the dry contacts of the solenoid monitor and/or the Micro Switch in the control head will operate.

If any of these events fail to occur, the problem must be investigated and repaired.

Repair the terminal link and put the fusible link line back into the set position. This is accomplished by using a 1/2 in. hex wrench on the fusible link line ratchet wheel. The ratchet wheel will be ratcheted in a clockwise direction until the spring plate makes contact with the top of the control head box.





3005	Pitfield boulevard	Saint-Laurent, Québec, Canada	H4S 1H4
Tel.: 5 1 4. 3 3 2. 5 1 1 0		Fax: 5 1 4. 3 3 2. 6 2 6 0	info@vikingfire.ca

## CHAPTER 5

## MAINTENANCE

## CHAPTER V SYSTEM MAINTENANCE

### GENERAL

This chapter will detail the basic information necessary for proper maintenance of the PYRO-CHEM Industrial Fire Suppression System. However, before attempting any system maintenance, it is necessary to attend a Factory Certification Training Class and become Certified to Install and maintain the PYRO-CHEM Industrial Fire Suppression System.

### MAINTENANCE AFTER SYSTEM DISCHARGE

#### 1. System Cleanup.

The hazard area cleanup after a system discharge is very basic. The dry chemical agent should be cleaned up by either sweeping or vacuuming. Residual dry chemical should be wiped off effected surfaces with a damp cloth.

#### 2. System Cylinder Recharge.

##### CAUTION

Protective eye goggles and protective footwear must be worn when performing system maintenance.

1. Remove the cylinder from the control head or pneumatic adaptors and inspect for visual damage. If there is any damage the cylinder must be hydrostatically tested before being refilled. If there is no damage, the cylinder can be recharged.
2. Reset all pneumatic actuators (Models PDA-D2) by depressing the check valve on top and relieving the pressure. Remove the pneumatic actuator or control head from the valve and use any 1/4-20 UN screw or bolt to screw into the top of the piston. Pull up on the piston until the piston is flush with the top of the valve body and remove the screw or bolt from the piston.
3. Remove the valve and siphon tube assembly from the cylinder and unscrew the siphon tube from the valve.
4. Inspect the valve to make sure no mechanical damage has occurred. If there is evidence of any damage to the seals, rebuild the valve using the Dry Valve Rebuilding Kit (PYRO-CHEM Part Number 550037).
5. Screw the siphon tube back into the valve.

6. Refill the cylinder with agent. Use the table below for easy reference.

Cylinder	Recharge
PCI-15ABC	12.5 lb. ABC (Part No. 550170)
PCI-17ABC	17 lb. ABC (Part No.550170)
PCI-25sBC	25 lb. BC (Part No.550162)
PCI-25sABC	25 lb. ABC (Part No.550170)
PCI-35ABC	35 lb. ABC (Part No.550170)
PCI-50sBC	50 lb. BC (Part No.550162)
PCI-50sABC	50 lb. ABC (Part No.550170)
PCI-70ABC	70 lb. ABC (Part No.550170)

The Model RC-50ABC (Part No. 550170) is a 50 lb. pail of ABC dry chemical recharge agent available from PYRO-CHEM. The Model RC-50BC (Part No. 550162) is a 50 lb. pail of BC dry chemical recharge agent available from PYRO-CHEM.

7. Insert the siphon tube into the cylinder, and screw the valve onto the cylinder. Make sure that the valve is screwed completely into the cylinder.
8. Attach the Recharge Adaptor (PYRO-CHEM Part No. 550130) to the discharge port of the valve. The adaptor O-ring should be completely inside the discharge port. Attach a source of dry nitrogen to the adaptor.

Charge the cylinder with dry nitrogen to 350 psi at 70°F.

##### NOTE

1. The pressure gauge attached to the cylinder valve should not be used to determine when the charging pressure has been reached. A pressure regulator should be used.
2. Higher pressure may be needed during the initial charging stage to blow the agent out of the siphon tube. Secure the cylinder during this stage, as it may jump as the agent is blown from the siphon tube.

9. Slowly disconnect the nitrogen source from the Recharge Adaptor. The cylinder valve will close when the Recharge Adaptor is depressurized. When the valve is closed and the nitrogen source is disconnected from the Recharge Adaptor, remove the recharge adaptor from the valve discharge port. Immediately screw the recoil preventer into the discharge port.

##### CAUTION

The recoil preventer must remain in the valve discharge port until the cylinder is attached to the piping network.

10. Reinstall the cylinder to the piping network. Reattach the control head or pneumatic adaptor.

### 3. Piping and Nozzles.

Piping should be blown out with air or dry nitrogen. Nozzle blow off caps should be replaced.

### 4. System Reset.

All fusible links should be replaced. The fusible link line can now be put into a set position by applying tension to the  
➤ fusible link line. This is accomplished by using a 1/2 in. hex  
➤ wrench on the fusible link line ratchet wheel. The ratchet wheel will be ratcheted in a clockwise direction until the spring plate makes contact with the top of the control head box. The fusible link line is now in a set position.

After setting the fusible link line, the system can be put back into service by following the SYSTEM CHECKOUT AFTER INSTALLATION Section of Chapter IV.

## REGULAR SYSTEM MAINTENANCE

### 1. Six (6) Month Maintenance.

1. Check that the hazard has not changed.
2. Check that all nylon ties are in place and the system has not been tampered with.
3. Check the entire system for mechanical damage.
- 4. Check the solenoid monitor.
- 5. Disconnect the control head or pneumatic tubing from each agent cylinder. Remove the carbon dioxide pilot cartridge and exercise the control head to ensure it is functioning properly. Make sure the gas shut-off valve and the remote pull station are functioning properly.

#### NOTE

Before continuing, remove the cover from the control head and insert the pull pin in the hole in the slide plate above the latching arm. This will secure the system, preventing accidental discharge.

6. Inspect fusible link detectors for excessive grease buildup. Clean or replace links if necessary. Visually inspect thermal detectors.

#### NOTE

Methods and frequency of inspection, testing and maintenance of detectors should be in accordance with NFPA-72.

7. Reinstall the carbon dioxide pilot cartridge and replace the control head cover and nylon tie.

#### CAUTION

Before screwing the carbon dioxide pilot cartridge into the actuator, ensure that the actuator has an O-ring installed.

8. Inspect the cylinder pressure. Tap the gauge lightly to ensure the needle is moving freely. If the gauge shows a loss in pressure indicated by the needle being below the green band, the tank should be removed and recharged per the SYSTEM CYLINDER RECHARGE section of Chapter V (System Maintenance) in this manual.

### 2. Annual Maintenance.

1. Inspect as per six (6) month maintenance instructions.
2. Disconnect and remove the discharge piping from the system. Using air or nitrogen, blow out the discharge piping. Replace all nozzle caps.
- 3. Fixed temperature sensing elements of the fusible alloy type shall be replaced at least annually or more frequently, if necessary, to assure proper operation of the system.
- 4. Test thermal detectors and remote pull station per SYSTEM CHECKOUT AFTER INSTALLATION section located in Chapter IV (System Installation) of this manual. Per NFPA 72, two (2) or more detectors per circuit should be tested. Note individual detector location and date of testing. Within 5 years, all detectors in system must be tested.
5. Replace the carbon dioxide pilot cartridge, recording the date of installation on the cartridge with a felt-tipped marker.

#### CAUTION

Before screwing the carbon dioxide pilot cartridge into the actuator, ensure that the actuator has an O-ring installed.

### 3. Six (6) Year Maintenance.

1. Inspect as per annual maintenance instructions.
2. Examine the dry chemical. If there is evidence of caking, the dry chemical shall be discarded.

### 4. Hydrostatic Testing.

The dry chemical agent cylinder(s) and pneumatic cylinder(s) shall be hydrostatically tested at least every twelve (12) years as per NFPA-17.

#### NOTE

➤ Refer to NFPA-17 for additional maintenance requirements.





**AGNICO EAGLE**

**Vendor Document Status**

- 1 ☐ Proceed to next submission and status.
- 2 ☐ Proceed with exceptions as noted to next submission and status.
- 3 ☐ Do not proceed.  
☐ Revise as noted and resubmit next submission and status.
- 4 ☒ Complete, no further submission required.

**Jean-Francois Tremblay**

By:

Date: 2017-05-02

Review and authorization to fabricate are only for general conformance with the design concept of the Project as expressed in the Contract Documents. Sole responsibility for the accuracy and completeness of this document, including but not limited to dimensions and quantities, remains with the Supplier/Contractor. Agnico Eagle does not warrant the accuracy or completeness of any of the information contained herein, nor does Agnico Eagle authorize or approve any construction means, methods, techniques, sequences or any safety precautions or procedures.

Agnico Eagle  
No.

6515-C-270-007-141-TES-0015 R: Sub001

**DOCUMENT FOR INFORMATION**



Fuel Tanks Piping  
Supply and Installation



Punchlist

Document Number : AEM-GE-ITR-003  
Contract Number : C22466T / C22498E

Equipment/System description:

ITEM NO	DESCRIPTION	CAT 1	CAT 2	CAT 3	COMMENTS	COMPLETED
1						
2						
3						
CAT 1 = Effects commissioning CAT 2 = Effects operation CAT 3 = Post operation						

**TO BE VALIDATED  
AT A LATER DATE**





## Vendor Document Status

**AGNICO EAGLE**

- 1 ☐ Proceed to next submission and status.
- 2 ☐ Proceed with exceptions as noted to next submission and status.
- 3 ☐ Do not proceed.  
Revise as noted and resubmit next submission and status.
- 4 ☒ Complete, no further submission required.

By:

**Jean-Francois Tremblay**

Date:

2017-05-02

Review and authorization to fabricate are only for general conformance with the design concept of the Project as expressed in the Contract Documents. Sole responsibility for the accuracy and completeness of this document, including but not limited to dimensions and quantities, remains with the Supplier/Contractor. Agnico Eagle does not warrant the accuracy or completeness of any of the information contained herein, nor does Agnico Eagle authorize or approve any construction means, methods, techniques, sequences or any safety precautions or procedures.

Agnico Eagle  
No.

6515-C-270-007-141-TES-0016 R: Sub001

**DOCUMENT FOR INFORMATION**



**Agnico-Eagle Mines Ltd.**  
**Notice of Final Completion**

ITR Number : AEM-GE-ITR-004  
Contract no. : C22466T / C22498E



Date: \_\_\_\_\_

To: \_\_\_\_\_

Project No: \_\_\_\_\_

Contract No: \_\_\_\_\_

Contract Title: \_\_\_\_\_

Contractor: \_\_\_\_\_

We, \_\_\_\_\_ (Contractor's Name), the Contractor  
for the above described contract, hereby certify that we have reviewed the Contract  
Documents pertaining to:

Contract No.: \_\_\_\_\_

Contract Name: \_\_\_\_\_

Partial Completion Certificates: \_\_\_\_\_

and having physically inspected the Work performed, do hereby file claim for a notice of  
Final Completion.

I do declare that I am, \_\_\_\_\_ (Responsible's Name),  
HAVING AUTHORITY FROM MY COMPANY TO PETITION FOR THE ABOVE REFERRED TO  
FINAL COMPLETION NOTICE.

Signature: \_\_\_\_\_

Name: \_\_\_\_\_

Title: \_\_\_\_\_

NOTES GENERALES / GENERAL NOTES

1. CLOSING IN SEVERAL OF SHORT NOTICES AND WOULD HAVE  
SCHEDULED THEM ON AT THE EVENT AT CLOSING IN THING STORE

[illegible]

**AGNICO EAGLE**

[illegible]

## REVISIONS



AGNICO EAGLE - VELLADNE DIVISION  
116 - FUEL TANK FARM  
FUEL DISTRIBUTION  
GENERAL ARRANGEMENT  
PLAN 1/8"


[illegible]

DCI KAF	1 - 250	24	2017-04-28
------------	---------	----	------------

65-ULT-116-MP-001

NO. PROJECT	6515	REGION	3	PLANT / DIST.	1 / 1
-------------	------	--------	---	---------------	-------



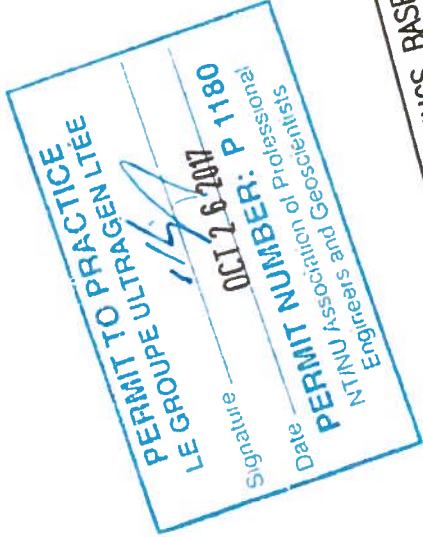



DATE: 2017/04/25	TITLE: RANKIN INLET FABRICATION ISOMETRIC MARINE LINE TO 65TNK11601 & 65TNK11602			
VER. PAR: -				
DATE: -				
APP.: -				
DATE: -				
ECHELLE: AUCUNE				
	No PROJET	No DESSIN	PAGES	REV.
	6515	116-150-PDI-CC10-0001	1/13	4

LISTE DE MATERIEL				
No	QTE	DIA	MATERIEL/CATALOGUE	DESCRIPTION
1	16045	W 150	A 333 Gr. 6	SCH STD, SMLS PIPE
2	1	150X25	A 350 Gr. LF2	CL 3000, SOCKLETT
3	2	25	A 333 Gr. 6	SCH 80, NIPPLE x 75mm LG PBE
4	1	25	A 350 Gr. LF2	CL 3000, SW 90 DEG ELBOW
5	1	25	A 333 Gr. 6	SCH 80, NIPPLE x 75mm LG PBE/EXTD
6	1	25	A 350 Gr. LF2	CL 3000, THRD CAP
7	1	150	A 350 Gr. LF2	CL 150, SCH STD, RF, WN FLANGE
8	1	25	3A-29	CL 600, SW, BALL VALVE
9	3	150	ASME B16.20	CL 150, GARLOCK 5500, RING TYPE GASKET 1/8" THK
10	24	19	A 193 B7/A 194 2H	CL 150, 8 - 19.05 X 100 STUD BOLTS c/w TWO HEAVY HEX NUTS
11	1	150	Ck-29	CL 150, RF, SWING CHECK VALVE
12	1	150	GA-10	CL 150, RF, GATE VALVE
13	1	150		PIPE GUIDE AS PER DETAIL 4, DWG: 65-116-270-200
14	1	150		PIPE SUPPORT AS PER DETAIL 3, DWG: 65-116-270-200
15	1	150	A 350 Gr. LF2	CL 150, RF, BLIND FLANGE (C/W 4" NPT HOLE)
16	1	100		GARLOCK F400-SS
17	1	100		SCH STD, BW LR 45 DEG ELBOW TRIM TO 22.5
18	1	150	A 420 Gr. NPL6	


  

No.	DATE	REVISION	APP.
4	2017/10/13	AS BUILT	A.H
3	2017/09/21	PROJECT TITLE REVISED	KHV
2	2017/09/11	LINE NUMBERS REVISED	QVN
1	2017/06/30	DRAIN REVISED AS PER CLIENT COMMENTS	QVN
0	2017/05/15	ISSUED FOR CONSTRUCTION	KHV
			PAR
			APP.


  


 <b>NUQSANA PROMEC MINING</b> <small>MEMBER OF N.C.</small>	 <b>Ultragen</b> <small>Engineering &amp; Construction</small>	CONSULTANT PROJECT NO.
		591700




# AGNICO EAGLE



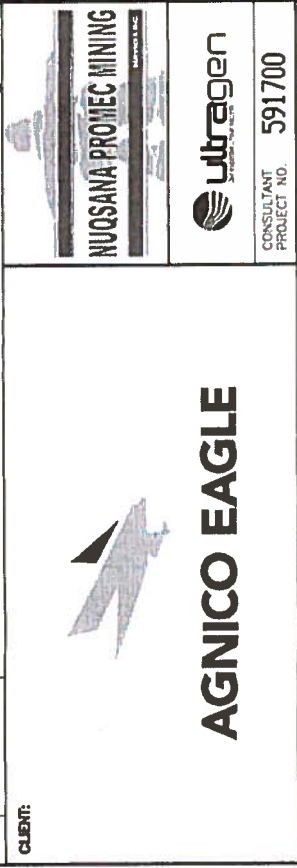

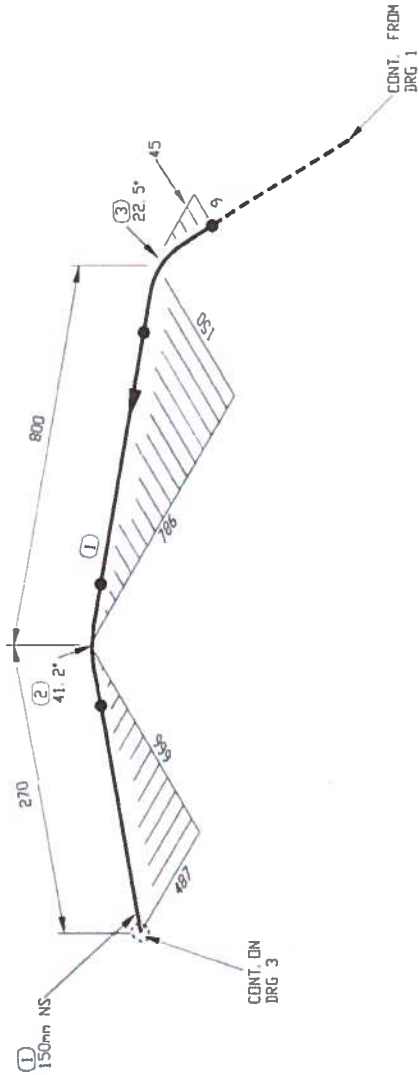PERMIT TO PRACTICE  
LE GROUPE ULTRAGEN LEE  
Signature  
Date  
OCT 26 2017  
PERMIT NUMBER: P 1180  
NT/NU Association of Professionals  
Engineers and Geoscientists

FABRICATION DRAWINGS BASED ON  
WSP CERTIFIED ENGINEERING

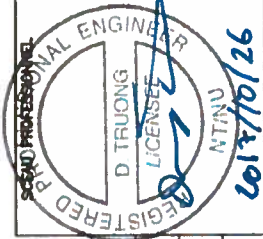

NO. DE CONDUITE		SPECIFICATION	PRODUIT	SYSTEME REVETEMENT	CODE DE COULEUR	ISOLATION ET TRACAGE	EPASS. D'ISOLATION		
116-150-PDI-CC10-0001	TEMPERATURE D'OPERATION	CC10	PDI		-			65-116-270-200	PIPE SUPPORT DETAILS
	PRESSION D'OPERATION	PRESSION DE CONCEPTION	TEMPERATURE DE CONCEPTION	PRESSION D'ESSAI	CLASSE D'INSPECTION	CODE DE SERVICE	TRAITEMENT THERMIQUE	65-116-205-200	P&ID
PSIG	°F	PSIG	°F	PSIG				No. DESSIN	DESSINS DE REFERENCE

LISTE DE MATERIEL

No	QTE	DIA	MATERIEL/CATALOGUE	DESCRIPTION
1	32178 MM	150	A 333 Gr. 6	SCH STD, SMLS PIPE
2	1	150	A 420 Gr. WPLS	SCH STD, 84 LR 45 DEG ELBDW TRIM TO 41.16
3	1	150	A 420 Gr. WPLS	SCH STD, 84 LR 45 DEG ELBDW TRIM TO 22.5

3	2017/10/13	AS BUILT	A.H.
2	2017/09/21	PROJECT TITLE REVISED	KHV
1	2017/09/11	LINE NUMBERS REVISED	KHV
0	2017/05/15	ISSUED FOR CONSTRUCTION	KHV
No.	DATE	REVISION	PAR APP.

CLIENT:



AGNICO EAGLE



CONSULTANT  
PROJECT NO. 591700

CONC.: KHV	PROJET:	AGNICO EAGLE - MELIADINE DIVISION	
DATE: 2017/04/25		116 - FUEL TANK FARM	
DESSINE PAR: KVE			
DATE: 2017/04/25			
VER. PAR: -			
DATE: -			
APP: -			
DATE: -			
ECHELLE: AUCUNE			
		No. PROJET	6515
		No. DESSIN	116-150-PDI-CC10-0001
		PAGES	2/13
		REV.	3


RANKIN INLET  
FABRICATION ISOMETRIC  
MARINE LINE TO 65TNK11601 & 65TNK11602










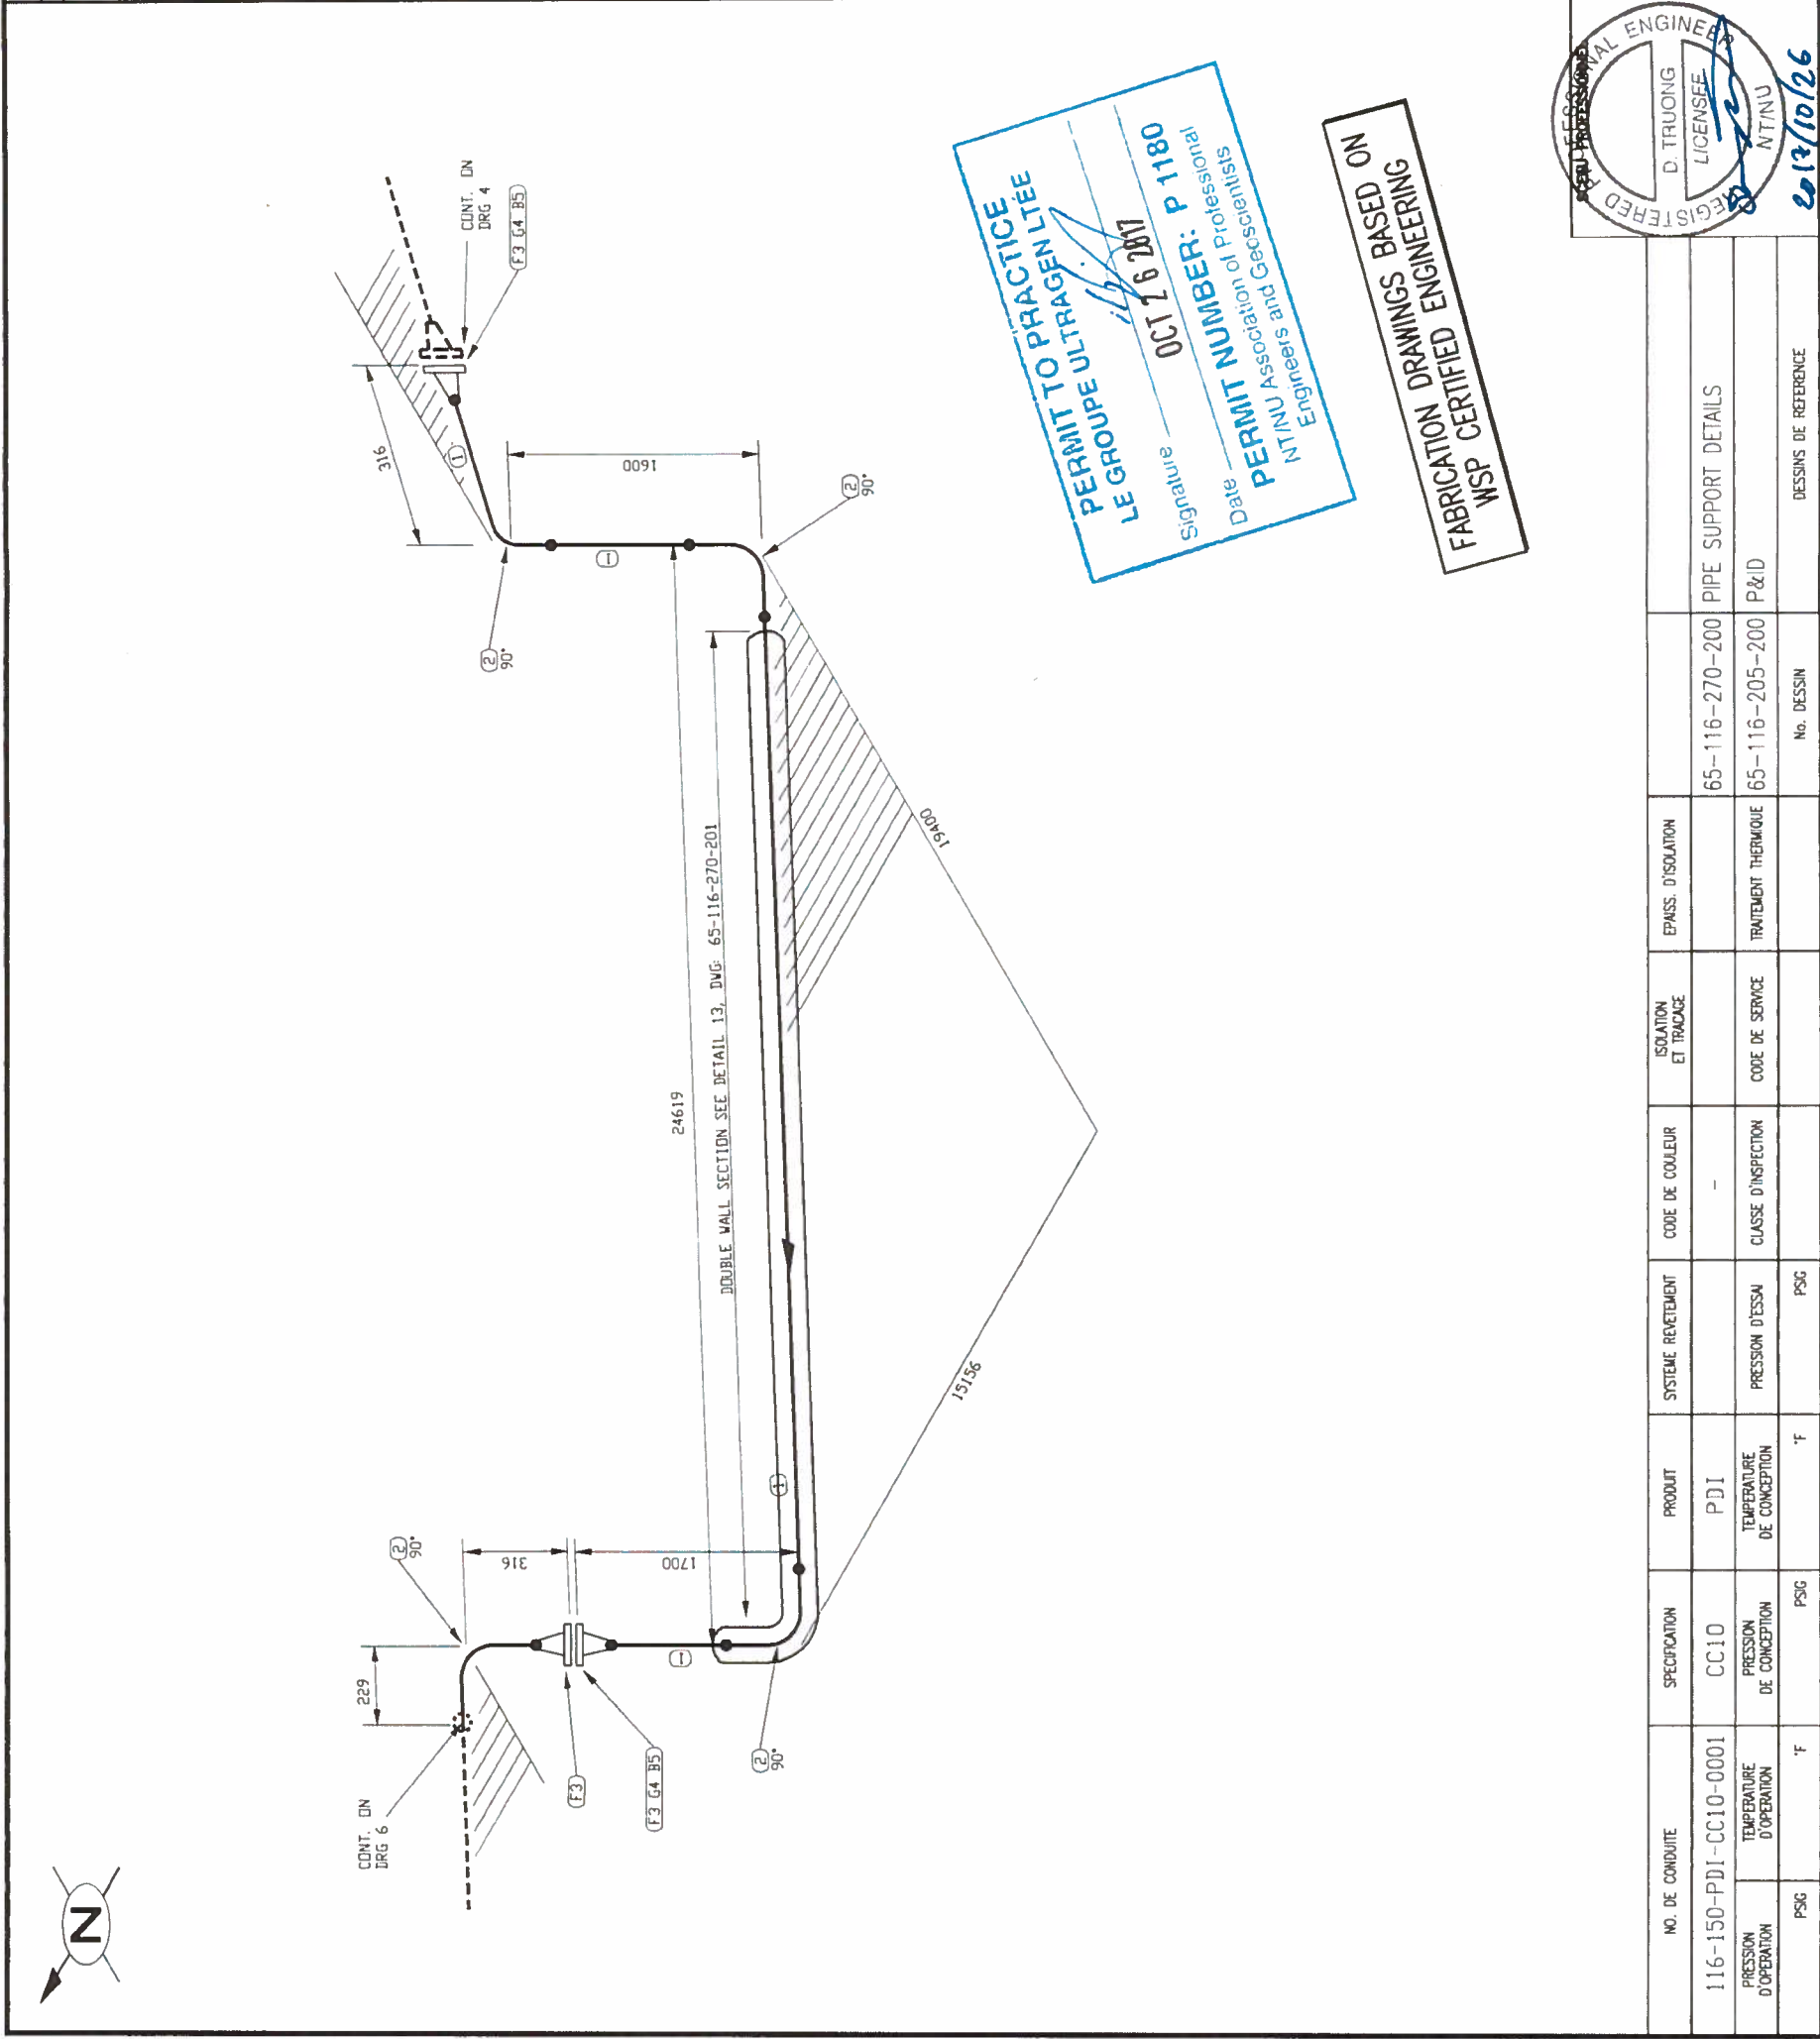

PERMIT TO PRACTICE  
LE GROUPE ULTRAGEN LEE  
Signature  
Date  
PERMIT NUMBER: P 1180  
NT/NU Association of Professionals  
Engineers and Geoscientists

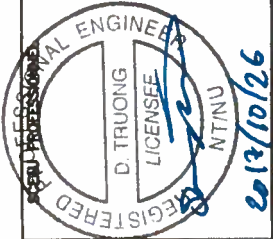


FABRICATION DRAWINGS BASED ON  
WSP CERTIFIED ENGINEERING



NO. DE CONDUITE		SPECIFICATION	PRODUIT	SYSTEME REVETEMENT	CODE DE COULEUR	ISOLATION ET TRACAGE	EPAISS. D'ISOLATION	PIPE SUPPORT DETAILS	
116-150-PDI-CC10-0001	TEMPERATURE D'OPERATION	CC10	PDI		-			65-116-270-200	
	PRESSION D'OPERATION	PRESSION D'ESSAI DE CONCEPTION	TEMPERATURE DE CONCEPTION	PRESSION D'ESSAI	CLASSE D'INSPECTION	CODE DE SERVICE	TRAITEMENT THERMIQUE	65-116-205-200	P&ID
PSIG	'F	PSIG	'F	PSIG				No. DESSIN	DESSINS DE REFERENCE


IMPRIMÉ LE: Oct 17, 2017, 3:55pm

FIGURIER: W:\Agnico Eagle\Mediaman\591700 (Fuel Distribution)\05. Dessins\02. Topographie\02. Isométrique\01. Rankin Inlet\116-150-PDI-CC10-0001-5.DWG

LISTE DE MATERIEL				
No	QTE	DIA	MATERIEL/CATALOGUE	DESCRIPTION
1	26156 MM	150	A 333 Gr. 6	SCH STD, SMLS PIPE
2	4	150	A 420 Gr. WPL6	SCH STD, BW LR 90 DEG ELBOW
3	3	150	A 350 Gr. LF2	CL 150, SCH STD, RF, WN FLANGE
4	2	150	ASPE 816.20	CL 150, GARLOCK 5500, RING TYPE GASKET 1/8" THK
6	16	19	A 193 B7/A 194 2H	CL 150, B - 19 05 X 100 STUD BOLTS c/w TWO HEAVY HEX NUTS
3	2017/10/13	AS BUILT		
2	2017/09/21	PROJECT TITLE REVISED		
1	2017/09/11	LINE NUMBERS REVISED		
0	2017/05/15	ISSUED FOR CONSTRUCTION		
No.	DATE	REVISION		
CLIENT:				
<div><div> <b>AGNICO EAGLE</b></div><div> <b>NUQSANA PROMEC MINING</b> EXPLOITATION DE MINES</div><div> <b>Ultragen</b> CONSULTANT PROJECT NO. 591700</div></div>				
CONC.: KHV		PROJET:		
DATE	2017/04/25	AGNICO EAGLE - MELIADINE DIVISION		
DESSINE PAR:	KVE	116 - FUEL TANK FARM		
DATE	2017/04/25	TITLE:		
VER. PAR:	-	RANKIN INLET		
DATE	-	FABRICATION ISOMETRIC		
APP.: -	-	MARINE LINE TO 65TNK11601 & 65TNK11602		
DATE:	-	No PROJET	No DESSIN	PAGES
Echelle: AUCUNE		6515	116-150-PDI-CC10-0001	5/13
		REV. 3		


CONC: KHV	DATE: 2017/04/25	PROJET:	AGNICO EAGLE - MELIADINE DIVISION
DESSIN: PAR KVE	DATE: 2017/04/25	116 - FUEL TANK FARM	
VER: PAR -	DATE: -	RANKIN INLET	
DATE: -	DATE: -	FABRICATION ISOMETRIC	
APP: -	DATE: -	MARINE LINE TO 65TNK11601 & 65TNK11602	
DATE: -	DATE: -	No. DESSIN	
Echelle: AUCUNE		No. PROJECT	
		6515	
		116-150-PDI-CC10-0001	
		5/13	
		3	

10-NW-911

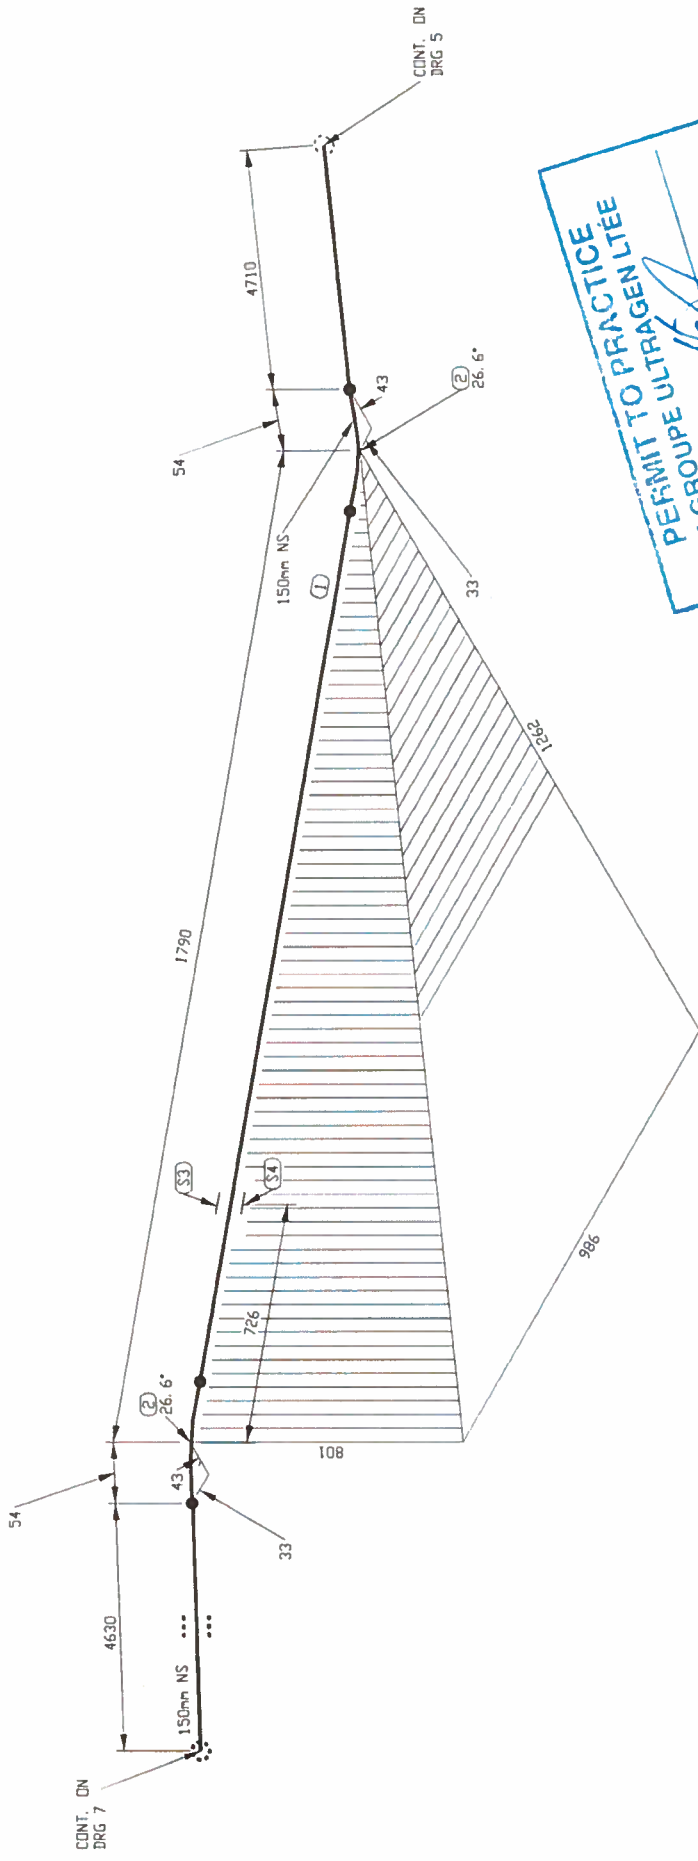

PERMIT TO PRACTICE  
LE GROUPE ULTRAGEN LEE  
Signature OCT 26 2017  
Date  
PERMIT NUMBER: P 1180  
NTINU Association of Professionals  
Engineers and Geoscientists

FABRICATION DRAWINGS BASED ON  
WSP CERTIFIED ENGINEERING

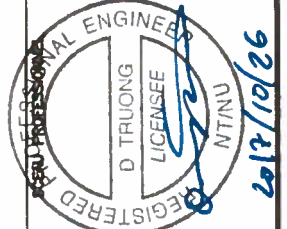

NO. DE CONDUITE		SPECIFICATION	PRODUIT	SISTEME REVETEMENT	CODE DE COULEUR	ISOLATION ET TRACAGE	EPAISS. D'ISOLATION	PIPE SUPPORT DETAILS	
116-150-PDI-CC10-0001	TEMPERATURE D'OPERATION	CC10	PDI		-			65-116-270-200	
	PRESSION D'OPERATION	PRESSION DE CONCEPTION	TEMPERATURE DE CONCEPTION	PRESSION D'ESSAI	CLASSE D'INSPECTION	CODE DE SERVICE	TRAITEMENT THERMIQUE	65-116-205-200	P&ID
PSG	'F	PSG	'F	PSG				No. DESSIN	DESSINS DE REFERENCE


IMPRIME LE: Oct 13, 2017, 11:57am

LISTE DE MATERIEL



No	QTE	DA	MATERIEL/CATALOGUE	DESCRIPTION
1	5344 MM	150	A 333 Gr. 6	SCH STD, SMLS PIPE
2	2	150	A 420 Gr. VPL6	SCH STD, BV LR 45 DEG ELBOW TRIM TO 26.57
3	3	150		PIPE SUPPORT AS DETAIL 1, DWG
4	1	150		65-116-270-200
5	2	150		PIPE SHOE AS PER DETAIL 2, DWG
				65-116-270-200
				PIPE SHOE AS PER DETAIL 2, DWG
				65-116-270-200

3	2017/10/13	AS BUILT	A.H.
2	2017/09/21	PROJECT TITLE REVISED	KHV
1	2017/09/11	LINE NUMBERS REVISED	KHV
0	2017/05/15	ISSUED FOR CONSTRUCTION	KHV
No.	DATE	REVISION	PAR APP

CLIENT:




# AGNICO EAGLE



CONSULTANT  
PROJECT NO. 591700


CONC: KHV	PROJET:	AGNICO EAGLE - MELIADINE DIVISION	
DATE: 2017/04/23		116 - FUEL TANK FARM	
DESSINE PAR: KVE	TITRE:	RANKIN INLET	
DATE: 2017/04/23		FABRICATION ISOMETRIC	
VER. PAR: -		MARINE LINE TO 65TNK11601 & 65TNK11602	
DATE: -	No PROJET	No DESSIN	REV.
APP: -	6515		PAGES
DATE: -		116-150-PDI-CC10-0001	6/13
ECHELLE: AUCUNE			3



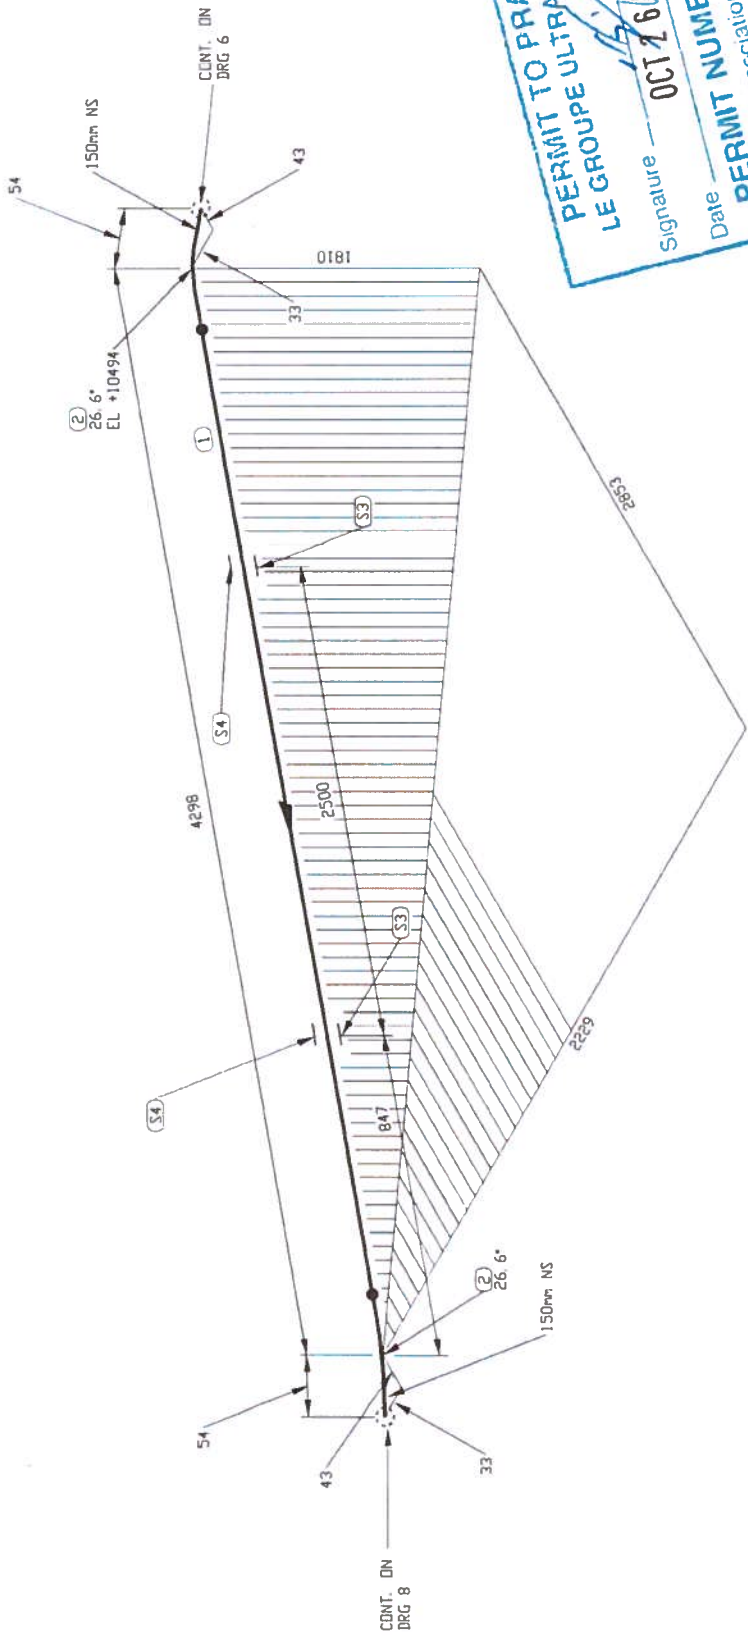

PERMIT TO PRACTICE  
LE GROUPE ULTRAGEN LEE  
Signature OCT 26/2017  
Date  
PERMIT NUMBER: P 1180  
NT/NU Association of Professionals  
Engineers and Geoscientists

FABRICATION DRAWINGS BASED ON  
WSP CERTIFIED ENGINEERING

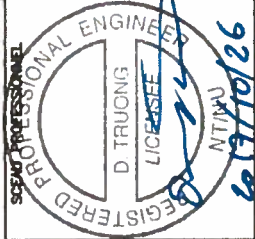

NO. DE CONDUITE		SPECIFICATION	PRODUIT	SISTEME REVETEMENT	CODE DE COULEUR	ISOLATION ET TRACAGE	EPAISS. D'ISOLATION	65-116-270-200	PIPE SUPPORT DETAILS
116-150-PDI-CC10-0001	CC10	PRESSION DE CONCEPTION	TEMPERATURE DE CONCEPTION	PRESSION D'ESSAI	CLASSE D'INSPECTION	CODE DE SERVICE	TRAITEMENT THERMIQUE	65-116-205-200	P&ID
PRESSION D'OPERATION	PSG	'F	PSG	'F				No. DESSIN	DESSINS DE REFERENCE

IMPRIME LE: Oct 13, 2017, 11:37am

FILE: #\Agico Eagle\Medline\591700 (Fuel Distribution)\05. Dessins\02. Tuyauterie\02. bornes\01. Rankin Inlet\116-150-PDI-CC10-0001-2.DWG

LISTE DE MATERIEL

No	QTE	DIA	MATERIEL/CATALOGUE	DESCRIPTION
1	3939 MM	150	A 333 Gr. 6	SCH STD. SWLS PIPE
2	2	150	A 420 Gr. WPL6	SCH STD. BW LR 45 DEG ELBOW TRIM TO 26.57
3	2	150		PIPE SUPPORT AS PER DETAIL 1, DWG
4	2	150		65-116-270-200
				PIPE SHOE AS PER DETAIL 2, DWG
				65-116-270-200

3	2017/10/13	AS BUILT	A.H.
2	2017/09/21	PROJECT TITLE REVISED	KHV
1	2017/09/11	LINE NUMBERS REVISED	KHV
0	2017/05/15	ISSUED FOR CONSTRUCTION	KHV
No.	DATE	REVISION	PAR APP.

CLIENT:



AGNICO EAGLE




CONSULTANT  
PROJECT NO. 591700

CONC.: KHV	DATE: 2017/04/25	PROJET:	AGNICO EAGLE - MELIADINE DIVISION
DESSINE PAR: KVE	DATE: 2017/04/25		116 - FUEL TANK FARM
VER. PAR: -	DATE: -	TITRE:	RANKIN INLET
DATE: -	DATE: -		FABRICATION ISOMETRIC
APP: -	DATE: -		MARINE LINE TO 65TNK11601 & 65TNK11602
DATE: -	DATE: -	No PROJET	6515
ECHELLE: AUCUNE	DATE: -	No DESSIN	116-150-PDI-CC10-0001
		PAGES	7/13
		REV.	3


10-NW-911



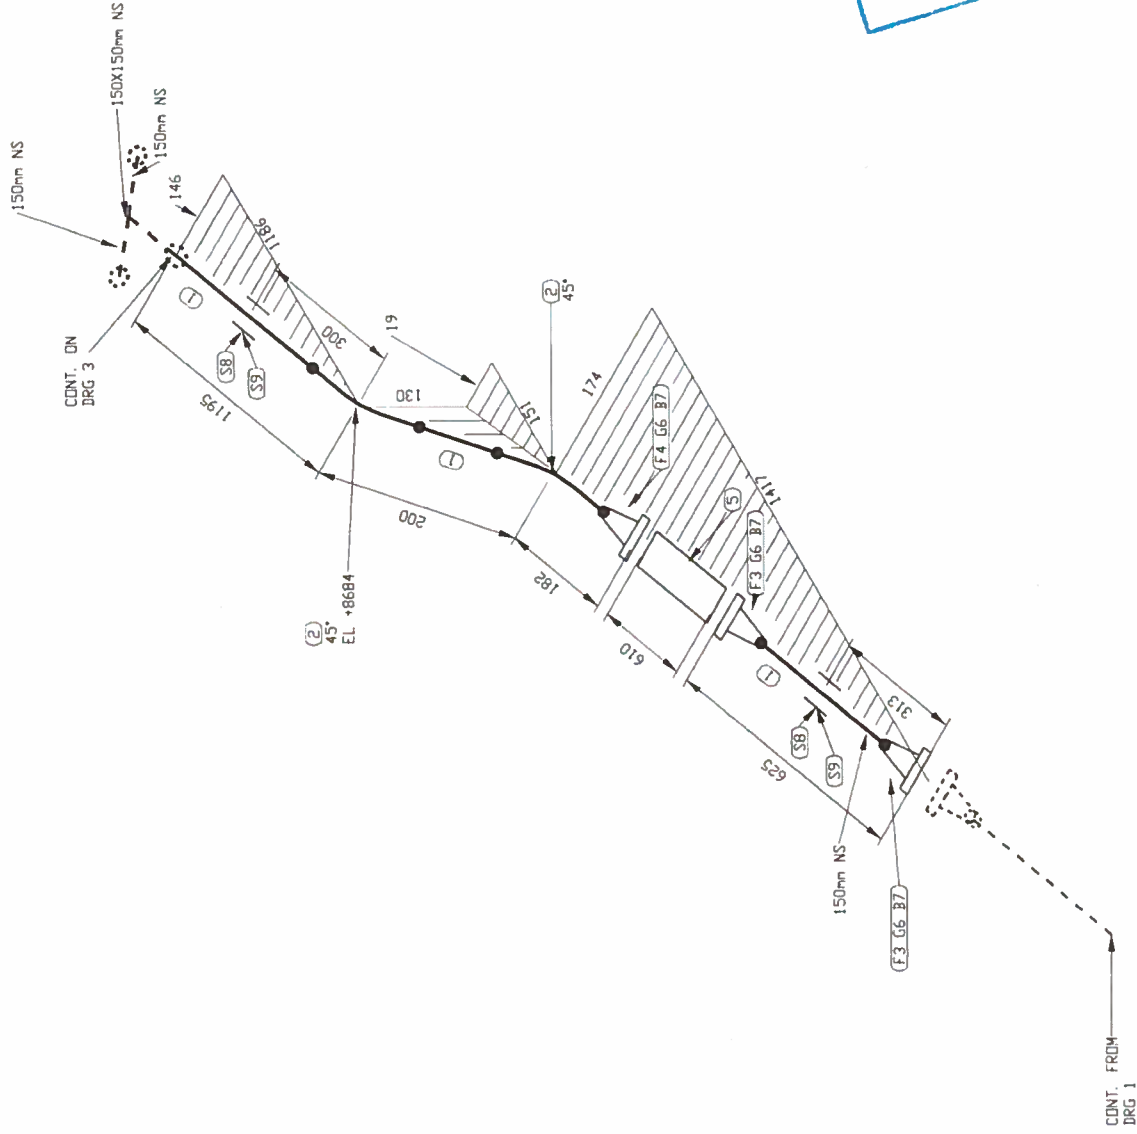

PERMIT TO PRACTICE  
LE GROUPE ULTRAGENÉE  
Signature  
OCT 26 2017  
Date  
PERMIT NUMBER: P 1180  
NTNU Association of Professionals  
Engineers and Geoscientists

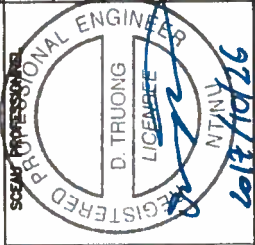


FABRICATION DRAWINGS BASED ON  
WSP CERTIFIED ENGINEERING



NO. DE CONDUITE		SPECIFICATION	PRODUIT	SISTEME RELEVEMENT	CODE DE COULEUR	ISOLATION ET TRACÉE	ÉPAISS. D'ISOLATION		
116-150-PDI-CC10-0006	PRESSION D'OPERATION	CC10	PDI		-			65-116-270-200	PIPE SUPPORT DETAILS
	TEMPERATURE D'OPERATION	PRESSION DE CONCEPTION	TEMPERATURE DE CONCEPTION	PRESSON D'ESSAI	CLASSE D'INSPECTION	CODE DE SERVICE	TRAITEMENT THERMIQUE	65-116-205-200	P&ID
	PSG	PSG	*F	PSG				No. DESSIN	DESSINS DE REFERENCE


IMPRIMÉ LE: Oct 13, 2017, 3:33pm

FILEPATH: W:\Agnico Eagle\Mediana\591700 (Fuel Distribution)\01 Rankin Inlet\116-150-PDI-CC10-0006-2.DWG

LISTE DE MATERIEL				
No	QTE	DIA	MATERIEL/CATALOGUE	DESCRIPTION
1	1825 MM	150	A 333 Gr. 6	SCH STD, SMLS PIPE
2	2	150	A 420 Gr. WPL6	SCH STD, BV LR 45 DEG ELBOW
3	2	150	A 350 Gr. LF2	CL 150, SCH STD, RF, WN FLANGE
4	1	150	A 350 Gr. LF2	CL 150, SCH STD, RF, WN FLANGE
5	1	150	ASME B16.20	CL 150, SINGLE BRAIDED HOSE ASSEMBLY
6	3	150		CL 150, GARLOCK 5500, RING TYPE GASKET 1/8" THK
7	24	19	A 193 B7/A 194 2H	CL 150, 8 - 19.05 X 100 STUD BOLTS c/w TWO HEAVY HEX NUTS
8	2	150		PIPE SUPPORT AS PER DETAIL 1, DWG: 65-116-270-200
9	2	150		PIPE SHOE AS PER DETAIL 2, DWG: 65-116-270-200
3	2017/10/13	AS BUILT		A.H.
2	2017/09/21	PROJECT TITLE REVISED		KHV
1	2017/09/11	LINE NUMBERS REVISED		KHV
0	2017/05/15	ISSUED FOR CONSTRUCTION		KHV
No.	DATE	REVISION		PAR
CLIENT:				
				
				
				
			CONSULTANT PROJECT NO. 591700	
CONC: KHV		PROJECT: AGNICO EAGLE - MELIADINE DIVISION		
DATE: 2017/04/25		116 - FUEL TANK FARM		
DESSINE PAR: KVE		TITRE: RANKIN INLET		
DATE: 2017/04/25		FABRICATION ISOMETRIC		
VER. PAR: -		DIESEL FROM 65TNK11601 & 65TNK11602 TO PUMPING STATION		
DATE: -		No. PROJET		
APP.: -		No. DESSIN		
DATE: -		6515		
ÉCHELLE: AUCUNE		116-150-PDI-CC10-0006		
		PAGES		
		2/12		
		REV.		
		3		


116-M-011



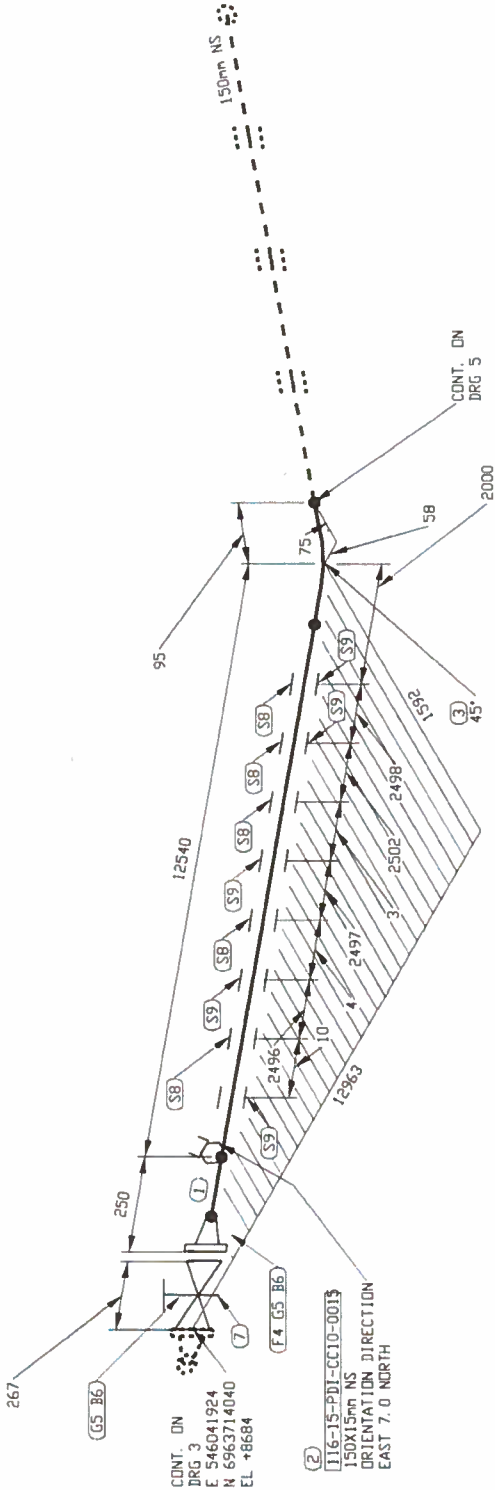

PERMIT TO PRACTICE  
LE GROUPE ULTRAGEN LTD  
Signature *[Signature]* OCT 16 2017  
Date  
PERMIT NUMBER: P 1180  
NTNU Association of Professionals  
Engineers and Geoscientists


FABRICATION DRAWINGS BASED ON  
WSP CERTIFIED ENGINEERING

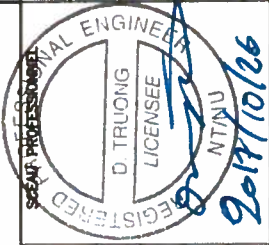


NO. DE CONQUITE	SPECIFICATION	PRODUIT	SYSTEME REVETEMENT	CODE DE COULEUR	ISOLATION ET TRACAGE	EPASS. D'ISOLATION	
116-150-PDI-CC10-0006	CC10	PDI		-			65-116-270-200 PIPE SUPPORT DETAILS
PRESSION D'OPERATION	PRESSION DE CONCEPTION	TEMPERATURE DE CONCEPTION	PRESSION D'ESSAI	CLASSE D'INSPECTION	CODE DE SERVICE	TRAITEMENT THERMIQUE	65-116-205-200 P&ID
PSG	PSG	PSG	PSG				No. DESSIN
							DESSINS DE REFERENCE

IMPRIMÉ LE: Oct 13, 2017, 3:44pm

PCHE: \\Agnico Eagle\Medians\591700 (Fuel Distribution)\05. Dessins\02. Topologie\02. bornetiques\01. Rankin Inlet\116-150-PDI-CC10-0006-4.DWG


LISTE DE MATERIEL					DESCRIPTION
No	QTE	DA	MATERIEL/CATALOGUE		
1	12983 MM	150	A 333 Gr. 6		SCH STD, SMLS PIPE
2	1	150X15	A 350 Gr. LF2		CL 3000, THREDDLET
3	1	150	A 420 Gr. WPL6		SCH STD, BV LR 45 DEG ELBOW
4	1	150	A 350 Gr. LF2		CL 150, SCH STD, RF, WN FLANGE
5	2	150	ASME B16.20		CL 150, GARLOCK 5500, RING TYPE GASKET 1/8" THK
6	16	19	A 193 B7/A 194 2H		CL 150, 8 - 19.05 X 100 STUD BOLTS c/w TWO HEAVY HEX NUTS
7	1	150	GA-10		CL 150, RF, GATE VALVE
8	5	150			PIPE SUPPORT AS PER DETAIL 1, DWG
9	5	150			65-116-270-200
					PIPE SHOE AS PER DETAIL 2, DWG
					65-116-270-200
3	2017/10/13	AS BUILT		A.H.	
2	2017/09/21	PROJECT TITLE REVISED		KHV	
1	2017/09/11	LINE NUMBERS REVISED		KHV	
0	2017/05/15	ISSUED FOR CONSTRUCTION		KHV	
No.	DATE	REVISION		PAR	APP.
CLIENT:					
					
AGNICO EAGLE					
CONSULTANT PROJECT NO. 591700					
NUQSANA-PROTEC MINING					
PROJECT: AGNICO EAGLE - MELIADINE DIVISION					
116 - FUEL TANK FARM					
TITRE: RANKIN INLET					
FABRICATION ISOMETRIC					
DIESEL FROM 65TNK11601 & 65TNK11602 TO PUMPING STATION					
No. PROJET		No. DESSIN		PAGES	REV.
6515		116-150-PDI-CC10-0006		4/12	3

10-NW-911

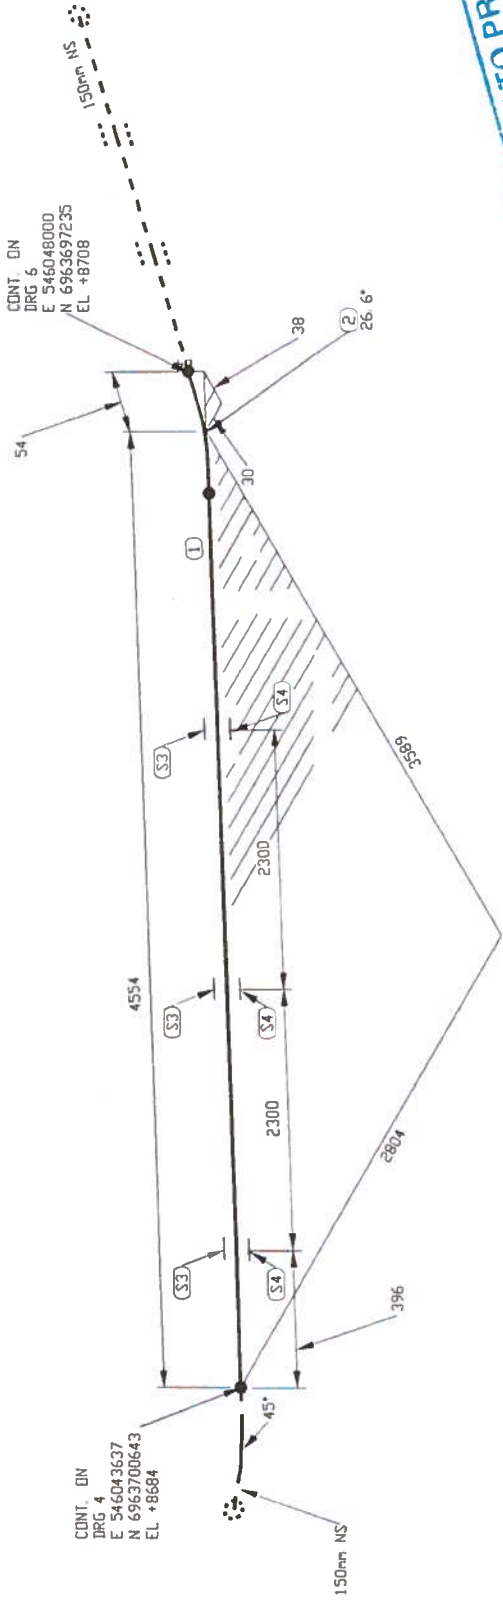

PERMIT TO PRACTICE  
LE GROUPE ULTRAGEN LTEE  
Signature OCT 13 2017  
Date  
PERMIT NUMBER: P 1180  
NTNU Association of Professionals  
Engineers and Geoscientists

FABRICATION DRAWINGS BASED ON  
WSP CERTIFIED ENGINEERING

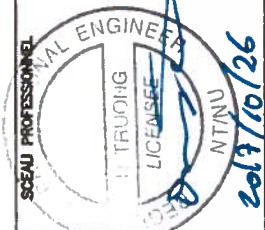

NO. DE CONDUITE		SPECIFICATION	PRODUIT	SYSTEME REVETEMENT	CODE DE COULEUR	ISOLATION ET TRAÇAGE	EPASS. D'ISOLATION	PIPE SUPPORT DETAILS	
116-150-PDI-CC10-0006	TEMPERATURE D'OPERATION	CC10	PDI		-			65-116-270-200	
	PRESSION D'OPERATION	PRESSION DE CONCEPTION	TEMPERATURE DE CONCEPTION	PRESSION D'ESSAI	CLASSE D'INSPECTION	CODE DE SERVICE	TRAITEMENT THERMIQUE	65-116-205-200	P&ID
PSG	'F	PSG	'F	PSG				No. DESSIN	DESSINS DE REFERENCE

IMPRIME LE: Oct 13, 2017, 3:54pm

FCHEIN: W:\Agnico Eagle\Medicine\931700 (Fuel Distribution)\05. Dessins\02. Topologie\02. horretrique\01. Rankin Inlet\116-150-PDI-CC10-0006-5.DWG

LISTE DE MATERIEL

No	QTE	DIA	MATERIEL/CATALOGUE	DESCRIPTION
1	5434 MM	150	A 333 Gr. 6	SCH STD. SMLS PIPE
2	1	150	A 420 Gr. VPL6	SCH STD. BV LR 90 DEG ELBOW TRIM TO 26.57
3	3	150		PIPE SUPPORT AS PER DETAIL 1, DWG
4	3	150		65-116-270-200
				PIPE SHOE AS PER DETAIL 2, DWG
				65-116-270-200


3	2017/10/13	AS BUILT	A.H.
2	2017/09/21	PROJECT TITLE REVISED	KHV
1	2017/09/11	LINE NUMBERS REVISED	KHV
0	2017/05/15	ISSUED FOR CONSTRUCTION	KHV
No.	DATE	REVISION	PAR APP.

CLIENT:

**AGNICO EAGLE**

CONSULTANT  
PROJECT NO. 591700


CONC.: KHV	PROJET:	AGNICO EAGLE - MELIADINE DIVISION	
DATE: 2017/04/25		116 - FUEL TANK FARM	
DESSINE PAR: KVE			
DATE: 2017/04/25			
VER. PAR: -	TITRE:	RANKIN INLET	
DATE: -		FABRICATION ISOMETRIC	
APP: -		DIESEL FROM 65TNK11601 & 65TNK11602 TO PUMPING STATION	
DATE: -	No. PROJET	No. DESSIN	REV.
ECHELLE: AUCUNE	6515	116-150-PDI-CC10-0006	5/12 3

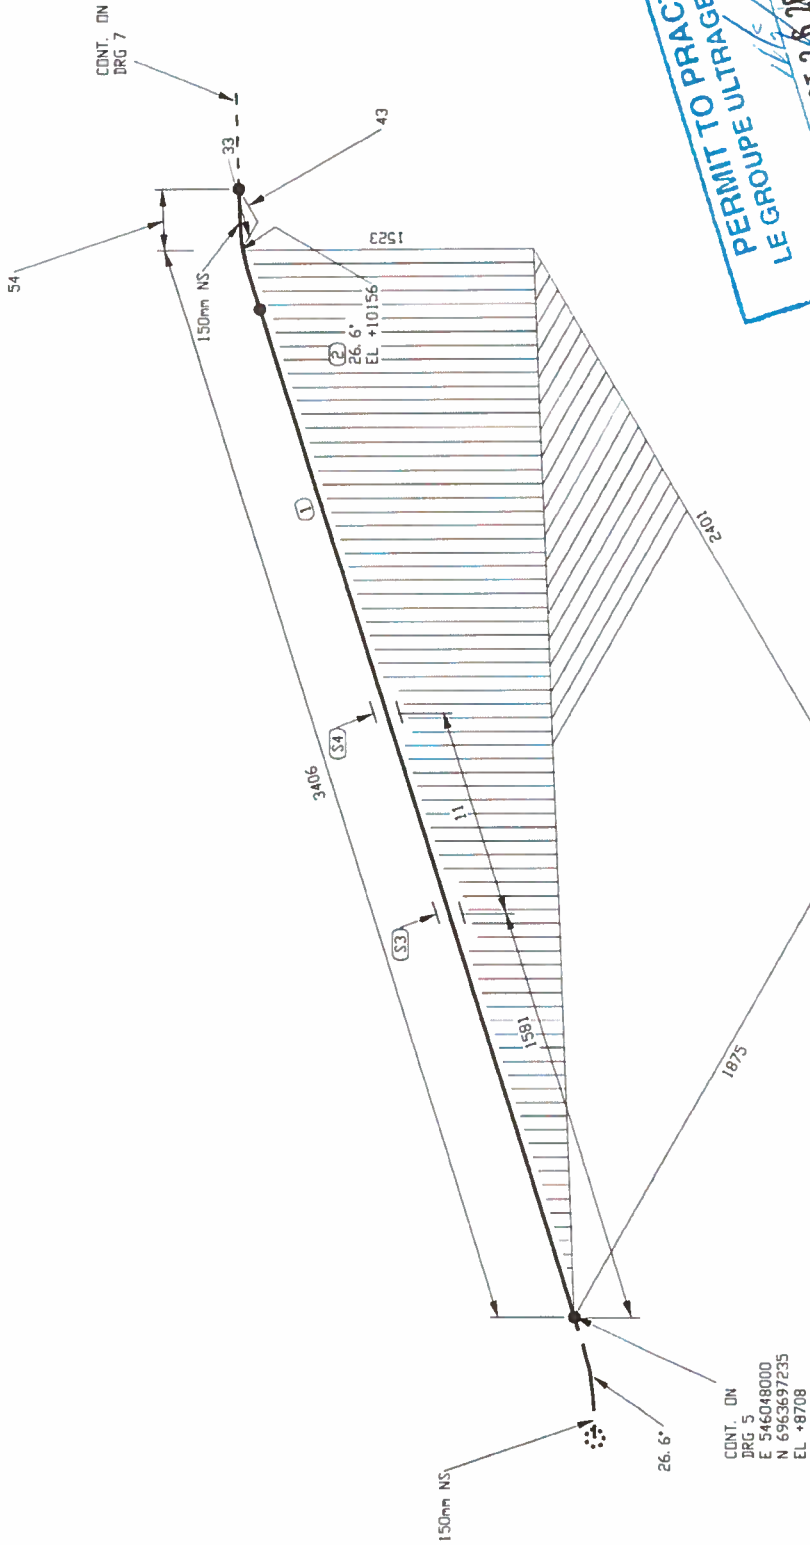

CONT. ON  
DRG 5  
E 546048000  
N 6963697235  
EL +8708

PERMIT TO PRACTICE  
LE GROUPE ULTRAGEN LEE  
Signature OCT 28 2017  
Date  
PERMIT NUMBER: P 1180  
NTNU Association of Professionals  
Engineers and Geoscientists

FABRICATION DRAWINGS BASED ON  
WSP CERTIFIED ENGINEERING

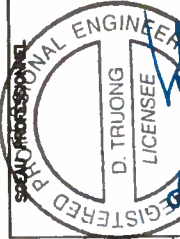

NO. DE CONDUITE		SPECIFICATION	PRODUIT	SYSTEME REVETEMENT	CODE DE COULEUR	ISOLATION ET TRACAGE	EPASS. D'ISOLATION	PIPE SUPPORT DETAILS	
116-150-PDI-CC10-0006		CC10	PDI		-			65-116-270-200	
PRESSION D'OPERATION	TEMPERATURE D'OPERATION	PRESSION DE CONCEPTION	TEMPERATURE DE CONCEPTION	PRESSION D'ESSAI	CLASSE D'INSPECTION	CODE DE SERVICE	TRAITEMENT THERMIQUE	65-116-205-200	P&ID
PSIG	°F	PSIG	°F	PSIG				No. DESSIN	DESSINS DE REFERENCE

IMPRIMÉ LE: Oct 13, 2017, 3:57pm

FIGURE: W:\Agnico Eagle\Medicine\591700 (Fuel Distribution)\05. Dessins\02 Tuyauterie\01 Rankin Inlet\116-150-PDI-CC10-0006-5.DWG

LISTE DE MATERIEL

No	QTE	DIA	MATERIEL/CATALOGUE	DESCRIPTION
1	3183 MM	150	A 333 Gr. 6	SCH STD. SHLS PIPE
2	1	150	A 420 Gr. WPL6	SCH STD. BV LR 90 DEG ELBOW TRIM TO 26.57
3	1	150		PIPE SUPPORT AS PER DETAIL 1, DWG.
4	1	150		65-116-270-200
				PIPE SHOE AS PER DETAIL 2, DWG.
				65-116-270-200

3	2017/10/13	AS BUILT	A.H.
2	2017/09/21	PROJECT TITLE REVISED	KHV
1	2017/09/11	LINE NUMBERS REVISED	KHV
0	2017/05/15	ISSUED FOR CONSTRUCTION	KHV
No.	DATE	REVISION	PAR
			APP.

CLIENT:



AGNICO EAGLE



CONSULTANT  
PROJECT NO. 591700


CONC.: KHV	DATE: 2017/04/25	PROJET: AGNICO EAGLE - MELIADINE DIVISION
DESSINE PAR: KVE	DATE: 2017/04/25	116 - FUEL TANK FARM
VER. PAR: -	DATE: -	TITRE: RANKIN INLET
APP: -	DATE: -	FABRICATION ISOMETRIC
ECHELLE: AUCUNE	No. PROJET: 6515	DIESEL FROM 65TNK11601 & 65TNK11602 TO PUMPING STATION
	No. DESSIN: 116-150-PDI-CC10-0006	
	PAGES: 6/12	REV. 3

116-MN-01





**PROMEC AS-BUILT**  
Signature: *[Signature]*  
Date: 2017-10-04

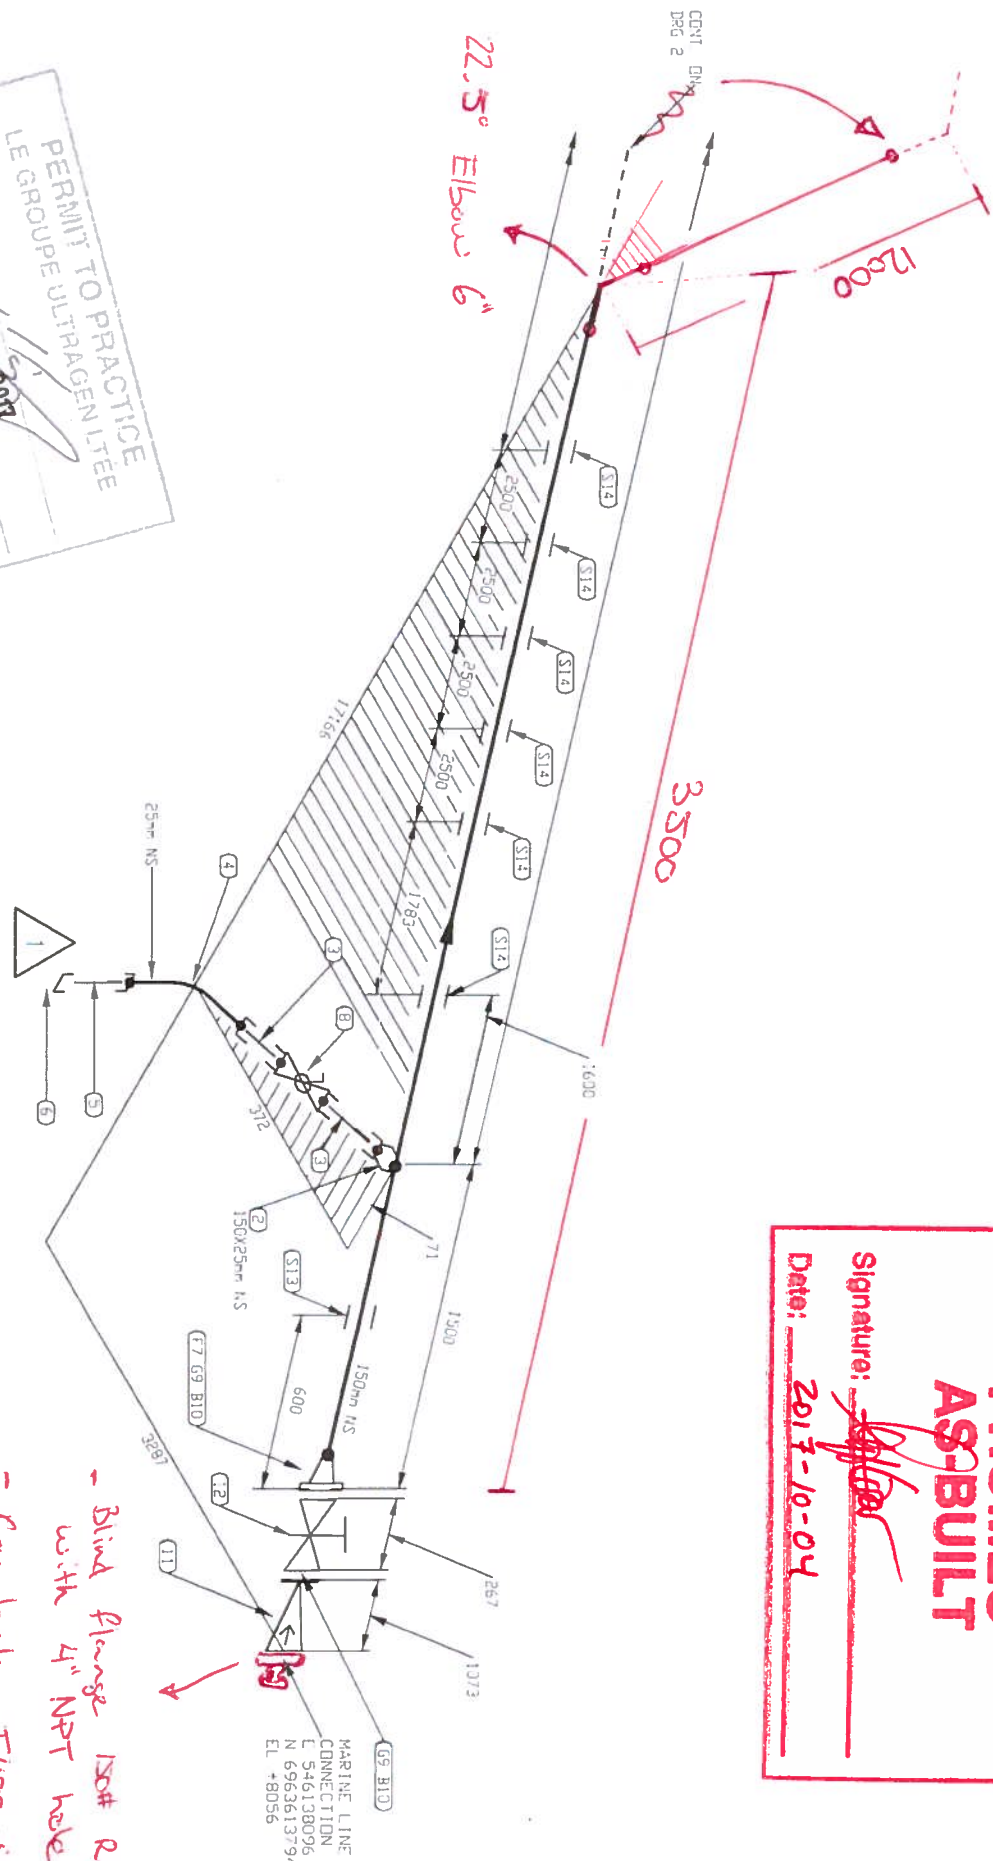


- Blind flange 150# R.F. 6"  
- Camlock F400-SS with 4" NPT hole  
- Camlock D400-SS

PERMIT TO PRACTICE  
LE GROUPE ULTRAGEN LTÉE  
Signature: *[Signature]*  
Date: SEP 21 2017  
PERMIT NUMBER: P 1180  
NTNU Association of Professional Engineers and Geoscientists

FABRICATION DRAWINGS BASED ON  
WSP CERTIFIED ENGINEERING

NO. DE CONDUITE		SPECIFICATION	PRODUIT	SISTÈME REVÊTEMENT	CODE DE COULEUR	ISOLATION ET TRACAGE	ÉPAISS. D'ISOLATION	PIPE SUPPORT DETAILS
116-150-PDI-CC10-0001		CC10	PDI				65-116-270-200	
PRESSION D'OPERATION	TEMPERATURE D'OPERATION	PRESSION DE CONCEPTION	TEMPERATURE DE CONCEPTION	PRESSION D'ESSAI	CLASSE D'INSPECTION	CODE DE SERVICE	TRAITEMENT THERMIQUE	
PSIG	F	PSIG	F	PSIG				

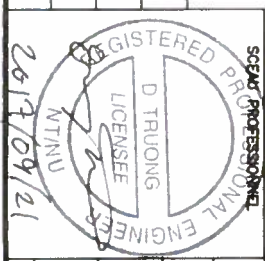


CONC.: KHV		PROJET:
DATE: 2017/04/25	DESIGNÉ PAR: WVE	AGNICO EAGLE - MELIADINE DIVISION
DATE: 2017/04/25	VER. PAR: -	116 - FUEL TANK FARM
DATE: -	APP.: -	TITRE: RANKIN INLET
DATE: -	ÉCHELLE: AUCUNE	FABRICATION ISOMETRIC
MARINE LINE TD 65TK11601 & 65TK11602		
No. PROJET	No. DESIGN	PAGES
6515	116-150-PDI-CC10-0001	1/13

AGNICO EAGLE




NUSSANA PROMEC MINING

CONSULTANT PROJECT NO. 591700

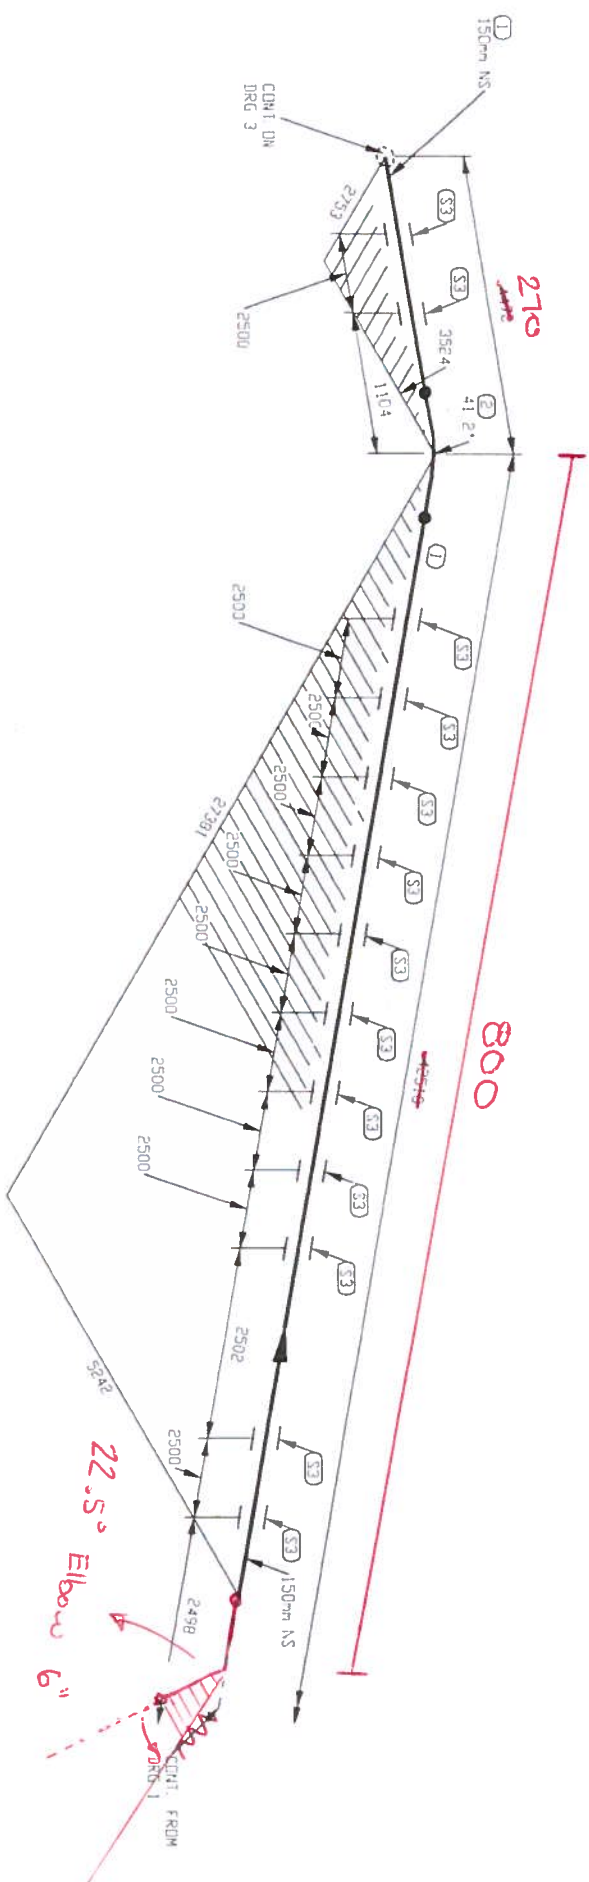

2	2017/09/21	PROJECT TITLE REVISED	KHV
1	2017/09/11	LINE NUMBERS REVISED	KHV
0	2017/05/15	ISSUED FOR CONSTRUCTION	KHV
No	DATE	REVISION	PAR APP.

		2017/09/21	
CONC. : KHY	DATE : 2017/04/25	PROJECT:	
DESIGN PAR. : KVE	DATE : 2017/04/25	AGNICO EAGLE - MELIADINE DIVISION 116 - FUEL TANK FARM	
VER. PAR. : -	DATE : -	TITLE:	
APP. : -	DATE : -	RANKIN INLET FABRICATION ISOMETRIC MARINE LINE TO 65TKK11601 & 65TKK11602	
ECHELLE : AUCUNE No PROJECT	No DESIGN 116-150-PDI-CC01-0001	PAGES	REV.
6515	116-150-PDI-CC01-0001	2/13	2

PERMIT TO PRACTICE  
LE GROUPE ULTRAGE LTÉE

Signature \_\_\_\_\_

SEP 21 2017

Date \_\_\_\_\_

PERMIT NUMBER: P 1180

INT. M. Association of Professional  
Engineers and Geoscientists

FABRICATION DRAWINGS BASED ON  
WSP CERTIFIED ENGINEERING

**PROMEC  
AS-BUILT**

Signature: 


Date: 2017-10-04

# AGNICO EAGLE



**NUQSANA PROHEC MINING**



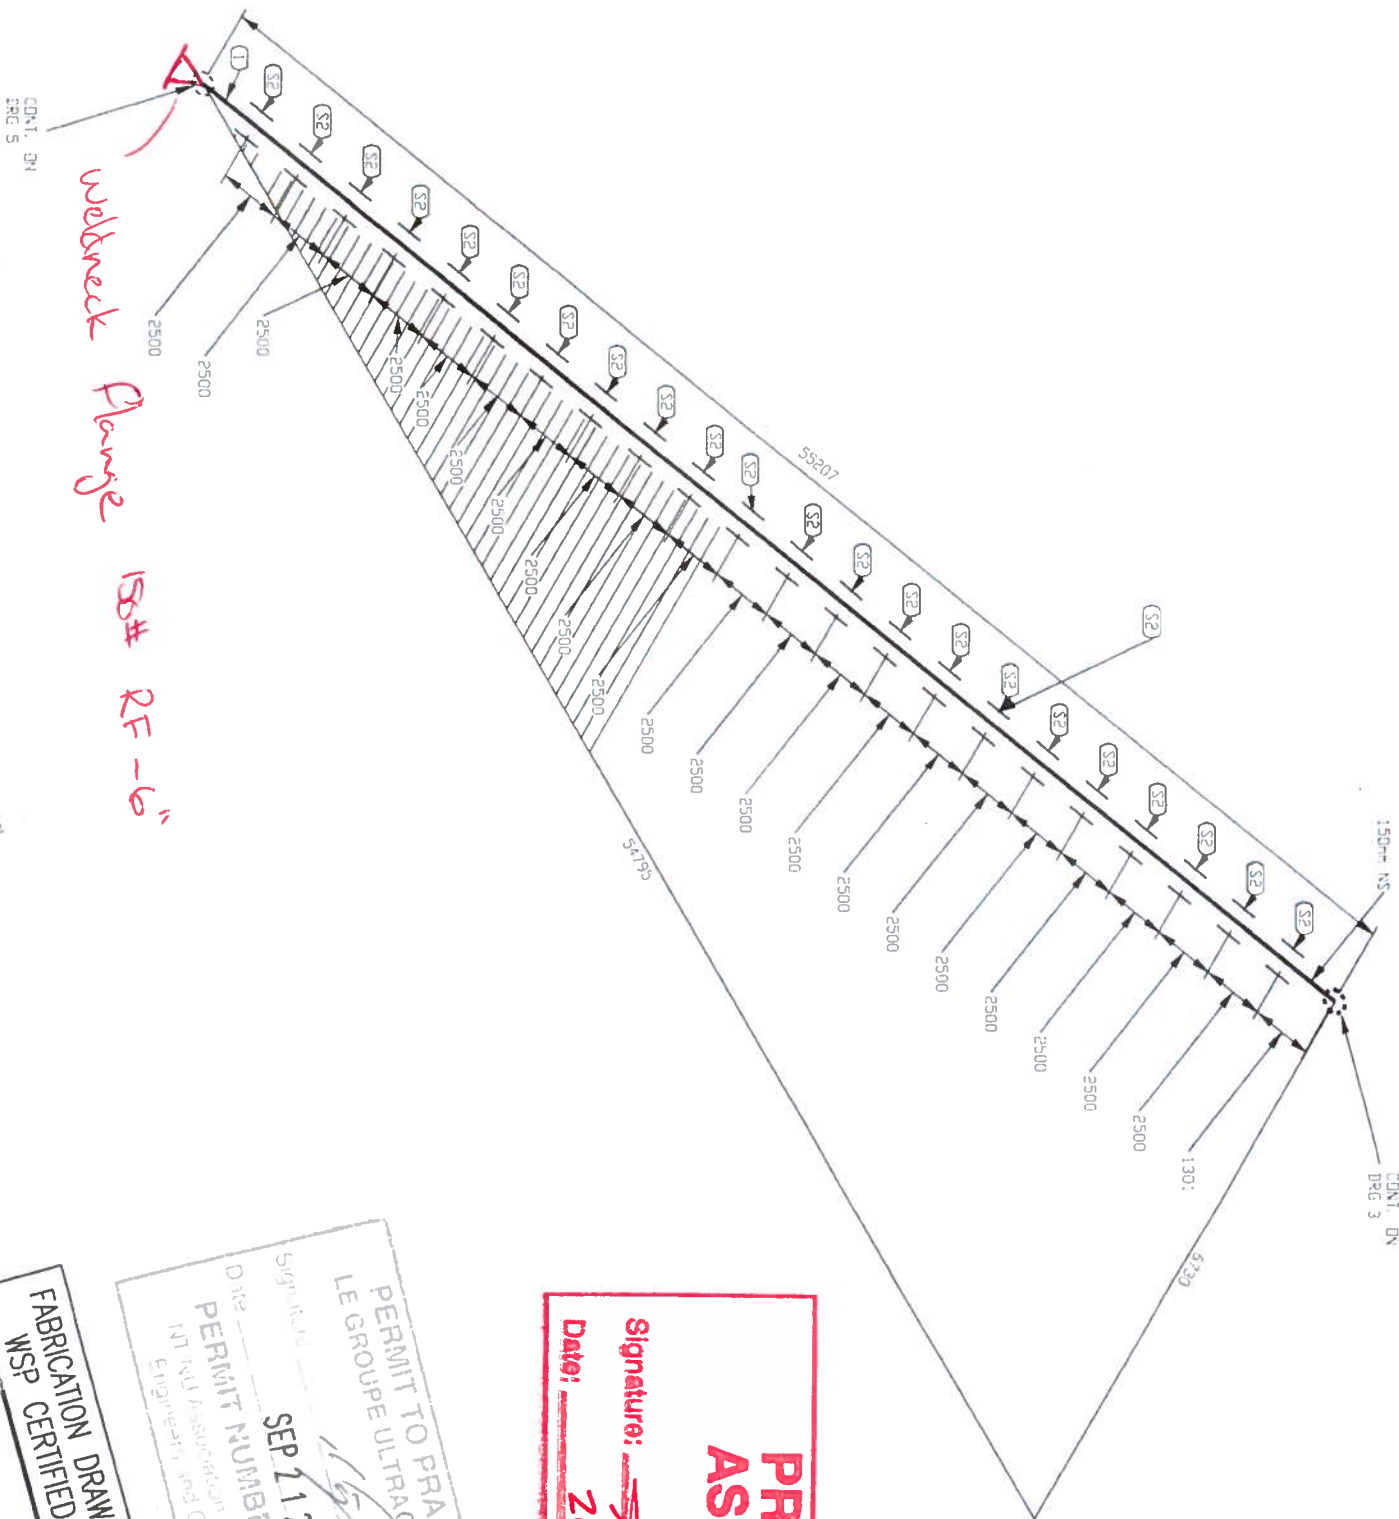


**PROMEC  
AS-BUILT**


Signature:   
Date: 2017-10-04

PERMIT TO PRACTICE  
LE GROUPE ULTRAGEN LTEE

Signature:   
Date: SEP 21 2017  
PERMIT NUMBER: P 1180  
N.T. Inc. Association of Professionals  
Engineers and Geoscientists

FABRICATION DRAWINGS BASED ON  
WSP CERTIFIED ENGINEERING

NO. DE CONDUITE	SECTION	PRODUIT	SISTEME RELEVANT	CODE DE COULEUR	ISOLATION ET TRACAGE	EPASS. DISOLATION	
116-150-PDI-CC10-0001	CC10	PDI					
PRESSION D'OPERATION	TEMPERATURE D'OPERATION	PRESSION DE CONCEPTION	TEMPERATURE DE CONCEPTION	PRESSION D'ESSAI	CLASSE D'INSPECTION	CODE DE SERVICE	TRAITEMENT THERMIQUE
PSIG	°F	PSIG	°F	PSIG			

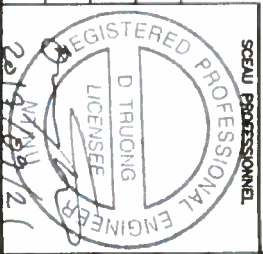

CONC.: KHV	PROJET:	AGNICO EAGLE - MELIADINE DIVISION
DATE: 2017/04/25	116 - FUEL TANK FARM	
DESIGN: PAR: KVE		
DATE: 2017/04/25		
VER. PAR: -		
DATE: -		
APP.: -		
DATE: -		
ECHELE: AUCUNE		

1	2017/09/21	PROJECT TITLE REVISED	KHV
2	2017/09/11	LINE NUMBERS REVISED	KHV
0	2017/05/15	ISSUED FOR CONSTRUCTION	KHV
No.	DATE	REVISION	PAR APP.

No.	QTE	D.E.	MATERIEL/CAT. CODE	REVISION
1	55207 M/L	150	A 333 Gr. 6	
2	23	150	SCH STD, SMLS PIPE PIPE SUPPORT AS PER DETAIL 3 DWG 65-116-270-200	

AGNICO EAGLE



NUOSANA PROMEC MINING

CONSULTANT PROJECT NO. 591700





22466+

[illegible]

CLIENT:

Agnico Eagle - Medicine division



# CONTRAT:

REF:

DESSINÉ PAR:


DATE: \_\_\_\_\_

VÉRIFIÉ PAR:

DATE: \_\_\_\_\_

# DESSIN:

REV.

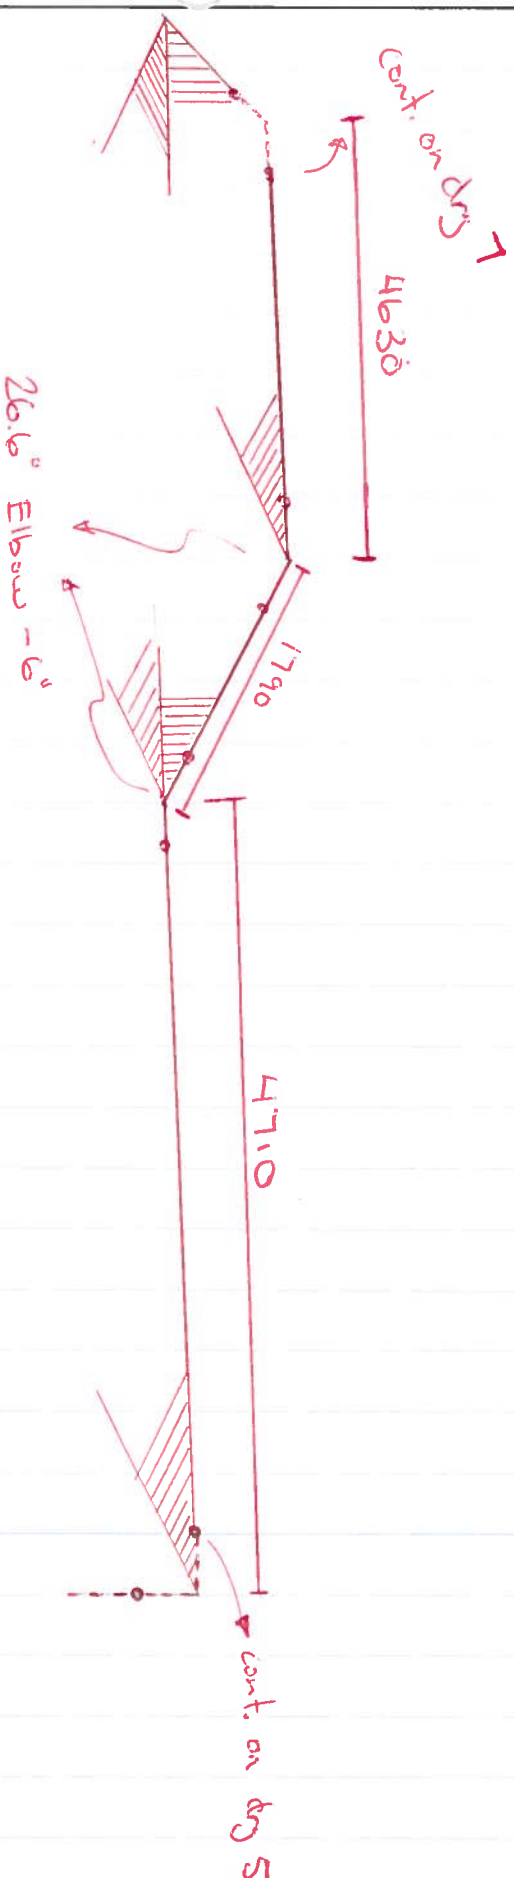

# PROMEC AS-BUILT

**Signature:**

Date: 2017-10-04

ASSEMBLÉ PAR:

DATE:

### PROCÉDÉ SOUDAGE:


ESSAI(S) / % RX



**PROMEC  
AS-BUILT**

Signature: 

Date: **2017-10-04**

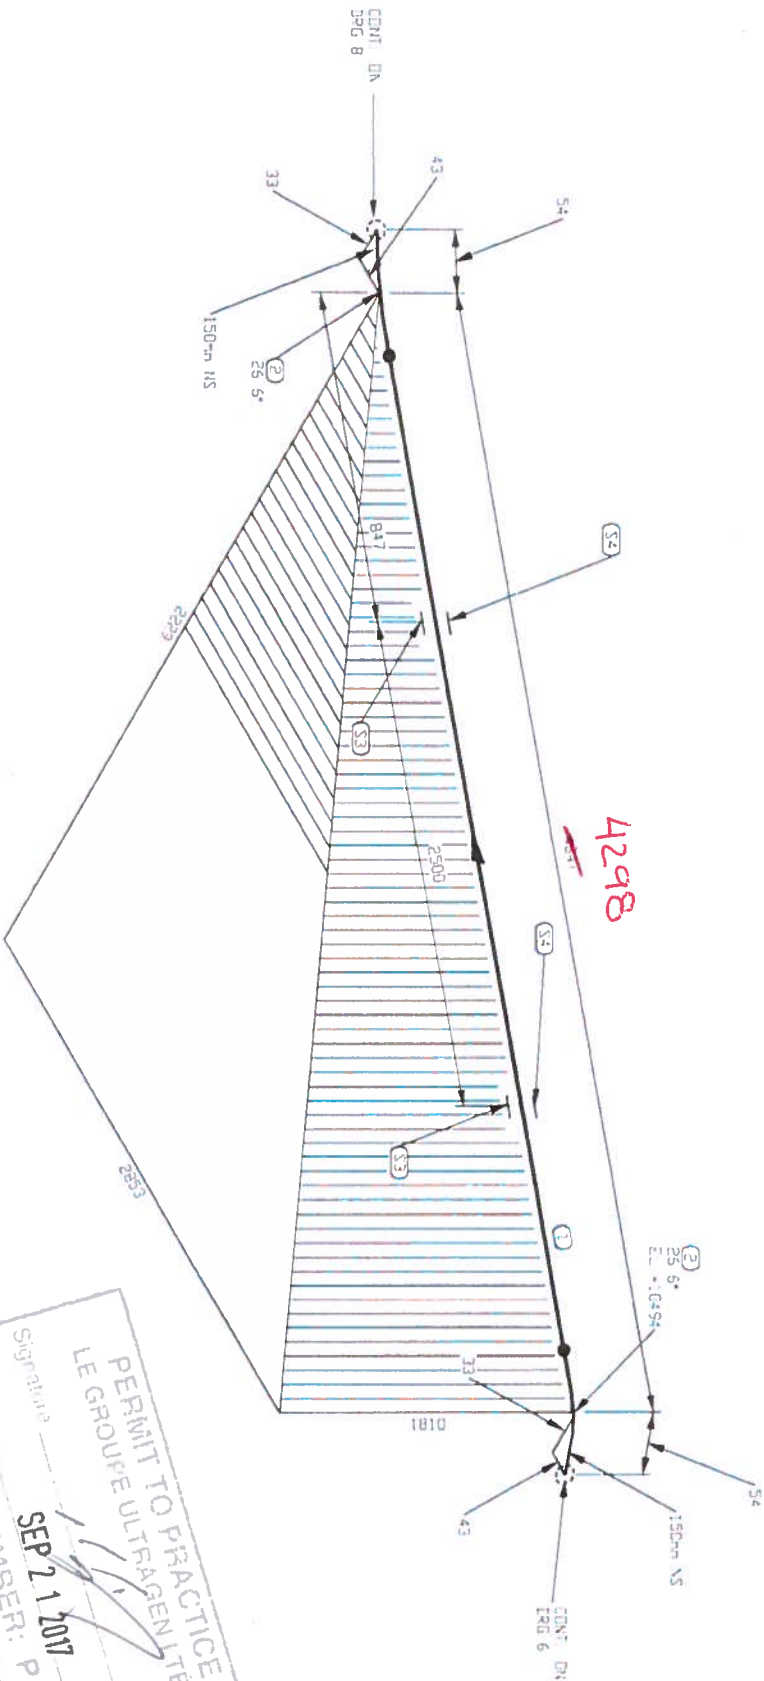

PERMIT TO PRACTICE  
LE GROUPE ULTRAGENTEE

Signature: 


Date: **SEP 21 2017**

PERMIT NUMBER: P 1180

NTNU Association of Professional  
Engineers and Geoscientists

FABRICATION DRAWINGS BASED ON  
WSP CERTIFIED ENGINEERING

NO. DE CONDUITE	SPECIFICATION	PRODUIT	SISTÈME RELEVÉ-MI	CODE DE COULEUR	ISOLATION ET TRACÉ	EPASS. DISOLATION	
116-150-PDI-CC10-0001	CC10	PDI		-			55-116-270-200
PRESSION D'OPERATION	TEMPERATURE D'OPERATION	PRESSION DE CONCEPTION	TEMPERATURE DE CONCEPTION	PRESSION DESSAI	CLASSE D'INSPECTION	CODE DE SERVICE	TRAITEMENT THERMIQUE
PSG	F	PSG	F	PSG			65-116-205-200

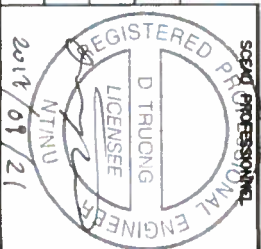


CONC.: K+V	PROJET:	DATE:	VER. PAR:	DATE:	APP.:	DATE:	ECHELLE:
2017/04/25	AGNICO EAGLE - MELIADINE DIVISION	2017/04/25	-	2017/04/25	-	-	AUCUNE
6515	RANKIN INLET FABRICATION ISOMETRIC MARINE LINE TD 65TNK11601 & 65TNK11602	6515	No PROJET	No DESSIN	PAGES	REV.	

CLIENT:	CONSULTANT	PROJET NO.
AGNICO EAGLE	ULTRAGEN	591700

NO.	DATE	REVISION	APP.
2	2017/09/21	PROJECT TITLE REVISED	KHV
1	2017/09/11	LINE NUMBERS REVISED	KHV
0	2017/05/15	ISSUED FOR CONSTRUCTION	KHV

LISTE DE MATERIE	DESCRIPTION
1 3939 MM 150 A 333 Gr. 6	SCH STD. SW.S PIPE
2 150 A 420 Gr. 6	SCH STD. 34 LR 45 DEG ELBOW 12IN TO 26 S7
3 150	PIPE SUPPORT AS PER DETAIL 1, DWG
4 150	65-116-270-200
	PIPE SUE 45 PER DETAIL 2, DWG
	65-116-270-200




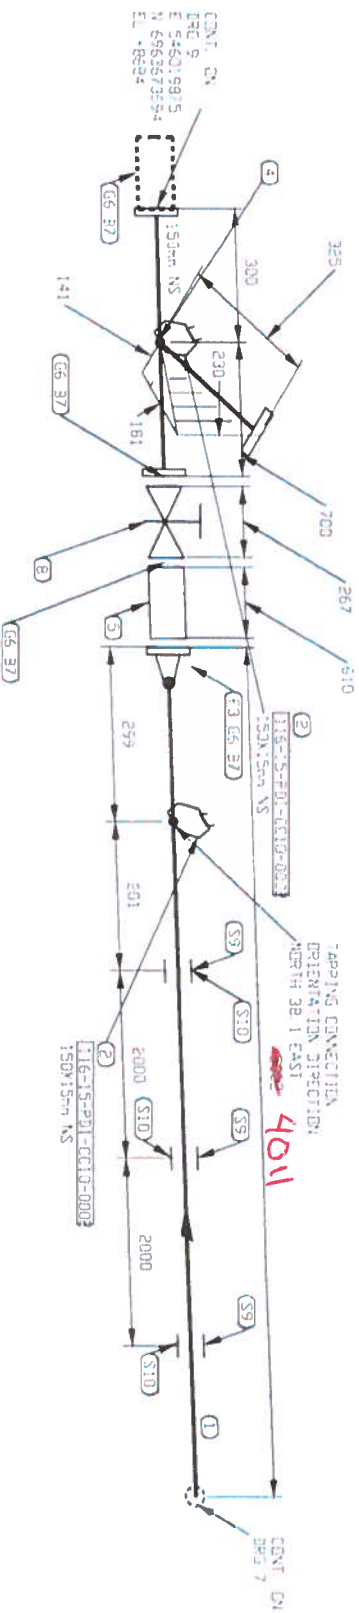

**PROMEC**  
**AS-BUILT**


Signature:   
Date: 2017-10-04

**PERMIT TO PRACTICE**  
**LE GROUPE ULTRAGEN LEE**

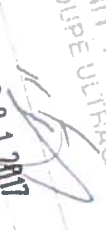Signature:   
Date: SEP 21 2017  
PERMIT NUMBER: P 1150  
Nikku Associates Ltd. General Services  
Engineers and Geoscientists

**FABRICATION DRAWINGS BASED ON**  
**WSP CERTIFIED ENGINEERING**


NO. DE CONDUITE	SPECIFICATION	PRODUIT	SISTÈME RELEVÉ-M	CODE DE COULEUR	ISOLATION ET TRACÉ	ÉPAISS. D'ISOLATION	
116-150-PDI-CC10-0001	CC10	PDI					
PRESSION D'OPERATION	TEMPERATURE D'OPERATION	PRESSION DE CONCEPTION	TEMPERATURE DE CONCEPTION	PRESSON D'ESSAI	CLASSE D'ASPECTION	CODE DE SERVICE	TRATÉMENT THERMOUE
		PSIG	°F	PSIG			

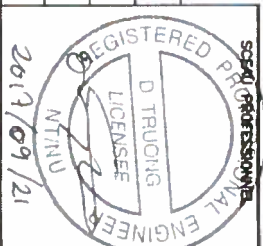



LISTE DE MATERIEL									
No	QTE	D/A	MATERIEL/CATALOGUE	Description					
1	4914 MM	ISO	A 333 Gr. 5	SCH STD. S.W.S PIPE					
2	2	ISOX15	A 350 Gr. LFE	CL 3500, TANGDLETT					
3	1	ISO	A 350 Gr. LFE	CL 150, SCH STD. 4F, UN FLANGE					
4	1	ISOX150		CL 150, PIG CATCHER AS PER DETAIL B, DWG 65-116-270-200					
5	1	ISO		CL 150, SINGLE BRAIDED HOSE ASSEMBLY					
6	4	ISO	ASPE 316 20	CL 150, CARLECK 5500, RING TYPE GASKET 1/8"					
7	22	19	A 193 87/4 194 2H	THK					
8	1	ISO	GA-10	CL 150, 8 - 19 05 X 100 STUD BOLT 5 6/8" THK					
9	3	ISO		HEAVY HEX NUTS					
10	3	ISO		CL 150, 4F, CS, FULL PORT GATE VALVE					
				PIPE SUPPORT AS PER DETAIL 1, DWG					
				65-116-270-200					
				PIPE SIZE AS PER DETAIL 2, DWG					
				65-116-270-200					



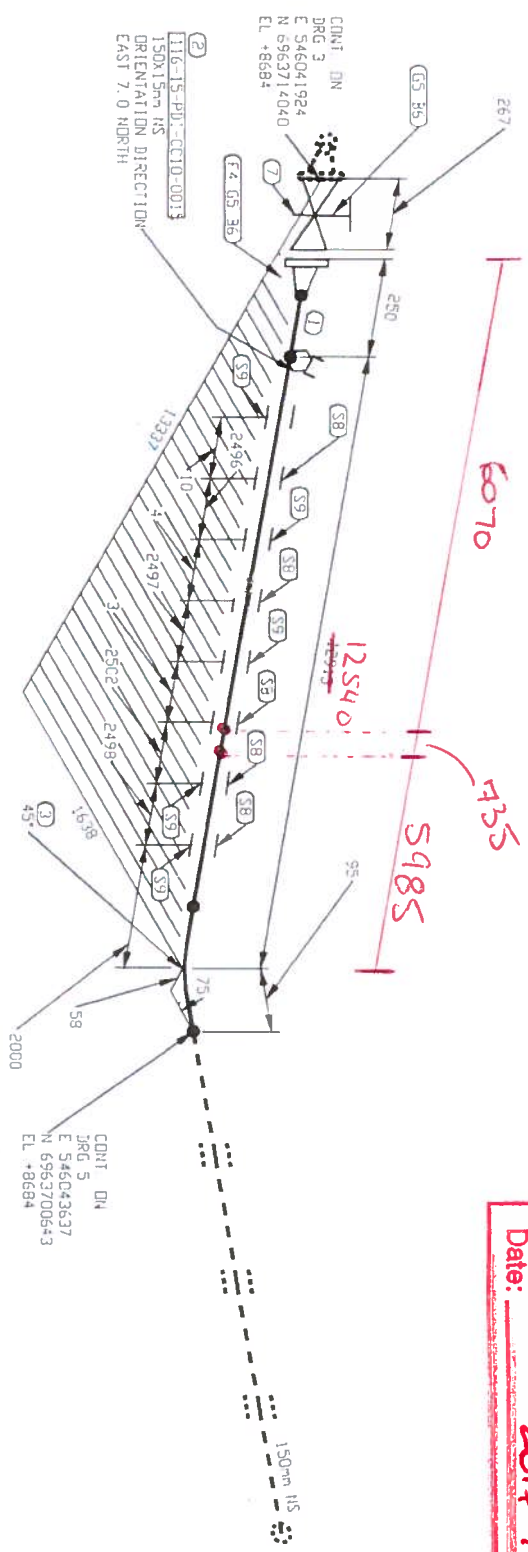




**PROMEC**  
**AS-BUILT**  
Signature:   
Date: 2017-10-04

PERMIT TO PRACTICE  
LE GROUPE ULTRAGENITEE  
Signature:   
Date: SEP 21 2017  
PERMIT NUMBER: P 1180  
NTNU Association of Professional  
Engineers and Geoscientists


FABRICATION DRAWINGS BASED ON  
WSP CERTIFIED ENGINEERING

NO. DE CONDUITE		SPECIFICATION	PRODUIT	SISTEME REVETEMENT	CODE DE COULEUR	ISOLATION ET TRAPAGE	EPASS. D'ISOLATION		
116-150-PD1-CC10-0006		CC10	PD1					65-116-270-200	
PRESSION D'OPERATION		TEMPERATURE D'OPERATION	PRESSION DE CONCEPTION	TEMPERATURE DE CONCEPTION	PRESSION D'ESSAI	CODE DE SERVICE	TRAITEMENT THERMIQUE	65-116-205-200	
PSG		T	PSG	T	PSG			No. DESSIN	
								DESSINS DE REFERENCE	

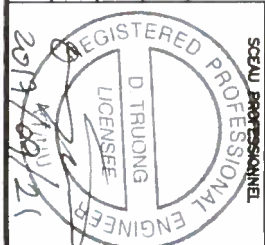


LISTE DE MATERIEL				DESCRIPTION	
No	QTE	D/A	MATERIEL/CATALOGUE		
1	12983	MM	150	A 333 Gr. 6	SCH STD. SMLS PIPE
2	1		150X15	A 350 Gr. LFR	CL 3000. T-REDUCT
3	1		150	A 420 Gr. NPL6	SCH STD. BW LR 45 DEG EL30W
4	2		150	A 350 Gr. LFR	CL 150. SCH STD. 4F. WN FLANGE
5	2		150	ASME B16.20	CL 150. GASKET 5500. RING TYPE GASKET 1/8"
6	16		19	A 193 37/4 194 2H	CL 150. 8 - 19 05 X 100 STUD BOLTS C/A TWO
7	1		150	GA-10	HEAVY HEX NUTS
8	5		150		CL 150. RF. GATE VALVE
9	5		150		PIPE SUPPORT AS PER DETAIL 1. DWG
					65-116-270-200
					PIPE SHOE AS PER DETAIL 2. DWG
					65-116-270-200

CLIENT:				REVISION	
No.	DATE			PAR	APP.
2	2017/09/21	PROJECT TITLE REVISED			KHV
1	2017/09/11	LINE NUMBERS REVISED			KHV
0	2017/05/15	ISSUED FOR CONSTRUCTION			KHV



**AGNICO EAGLE**



**NUSANA PROMEC MINING**

COMC.: KHV

DATE: 2017/04/25

DESSINE PAR: KVE

DATE: 2017/04/25

VER. PAR: -

DATE: -

APP.: -

DATE: -

ECHELLE: AUCUNE

PROJET: AGNICO EAGLE - MELIADINE DIVISION

116 - FUEL TANK FARM

TITRE: RANKIN INLET

FABRICATION ISOMETRIC

DIESEL FROM 65TKK11601 & 65TKK11602 TO PUMPING STATION


No PROJET: 6515

No DESSIN: 116-150-PD1-CC10-0006


PAGES: 4/12

REV.: 2

CONSULTANT PROJECT NO. 591700





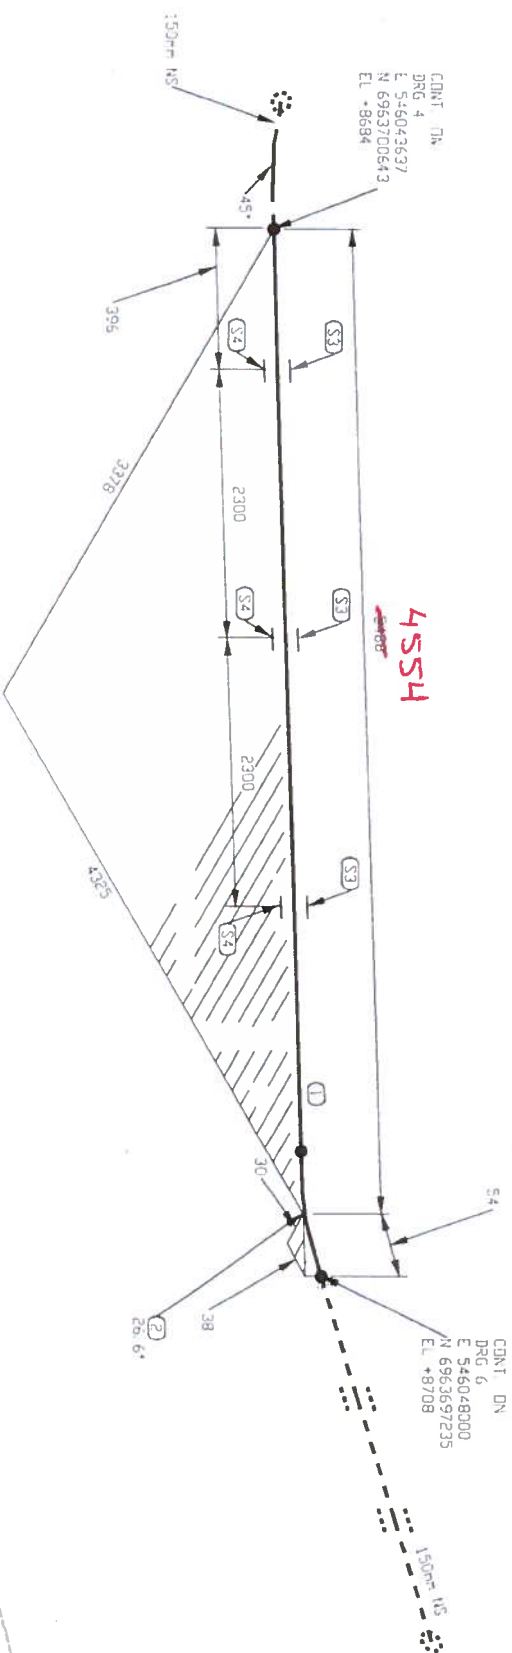

Signature: Jeffrey  
Date: 2017-10-04

FABRICATION DRAWINGS BASED ON  
WSP CERTIFIED ENGINEERING

CONC.: KHV	PROJECT:			
DATE: 2017/04/25	AGNICO EAGLE - MELIADINE DIVISION			
DRESSING PARR: KVE	116 - FUEL TANK FARM			
DATE: 2017/04/25				
VER. PAR: -	TITLE:			
DATE: -	RANKIN INLET FABRICATION ISOMETRIC			
APP: -	DIESEL FROM 65TKK11601 & 65TKK11602 TO PUMPING STATION			
DATE: -				
ECHELLE AUCUNE				
	No PROJECT	No DESIGN	PAGES	REV.
	6515	116-150-PD1-CC10-0006	5/12	2

**ultra**  
ultra


**NUOSANA PROMEC MINING**




**PROMEC  
AS-BUILT**

Signature: 

Date: 2017-10-04

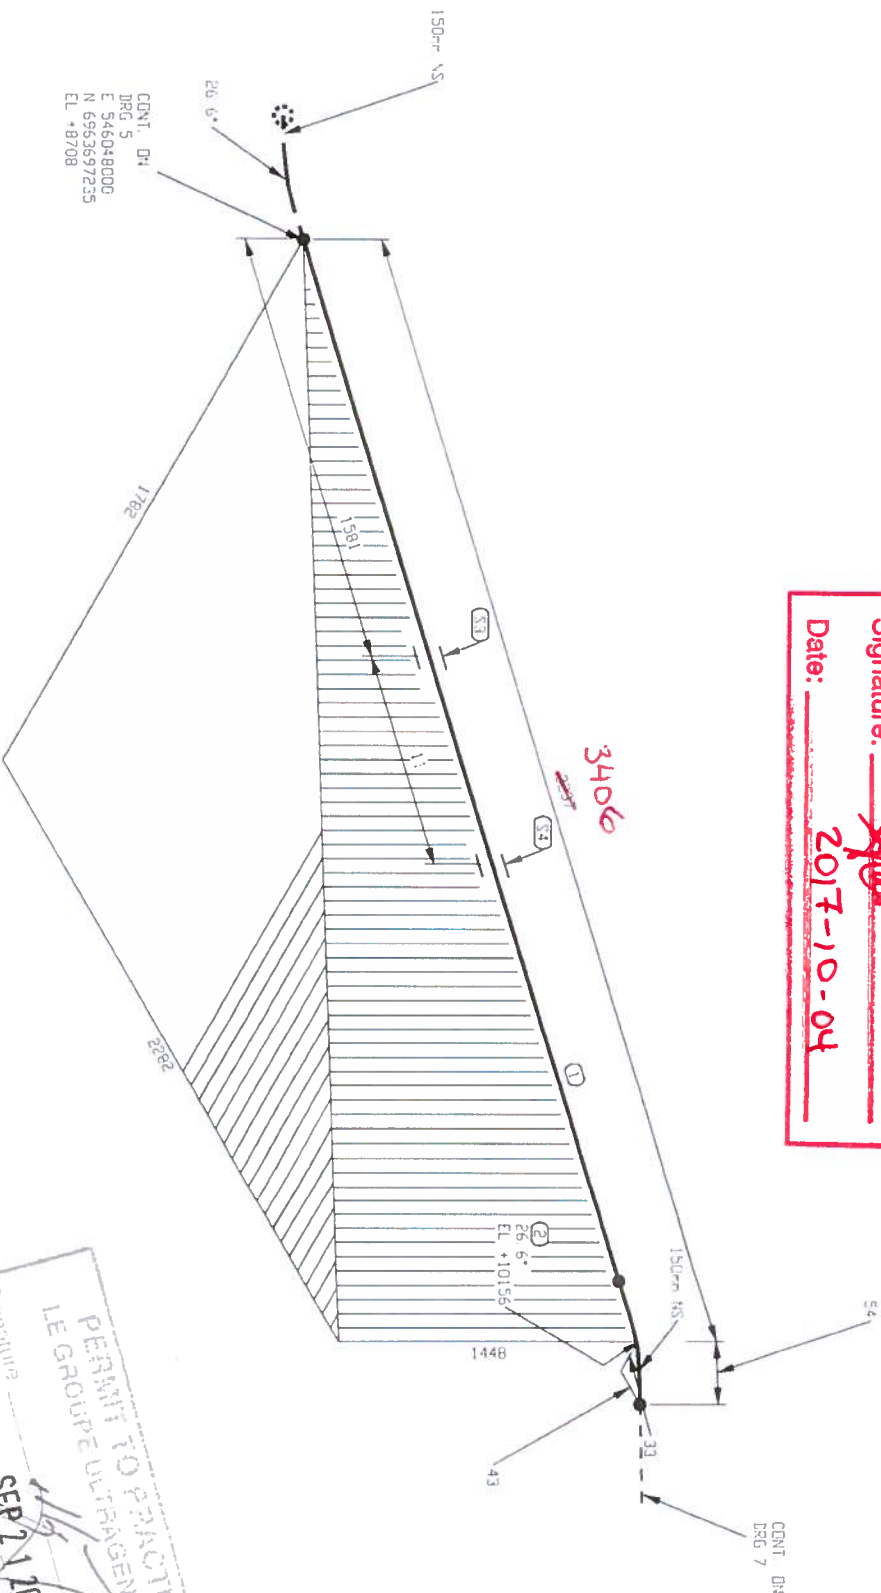

**PERMIT TO PRACTICE  
LE GROUPE ULTRAGEN L.T.E.E.**

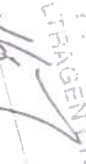Signature: 


Date: SEP 21 2017

**PERMIT NUMBER: P 1180**

NTNU Association of Professional  
Engineers and Geoscientists

**FABRICATION DRAWINGS BASED ON  
WSP CERTIFIED ENGINEERING**

NO. DE CONDUITE		SPECIFICATION	PRODUIT	SISTÈME ADÉQUANT	CODE DE COULEUR	ISOLATION ET TRAPAGE	ÉPAISS. D'ISOLATION		
116-150-PD1-CC10-0006		CC10	PD1					65-116-270-200	
PRESSION D'OPERATION	TEMPERATURE D'OPERATION	PRESSION DE CONCEPTION	TEMPERATURE DE CONCEPTION	PRESSION D'ESSAI	CLASSE D'INSPECTION	CODE DE SERVICE	TRAITEMENT THERMIQUE	65-116-205-200	
PSIG	°F	PSIG	°F	PSIG				No. DESSIN	
								DESSINS DE REFERENCE	

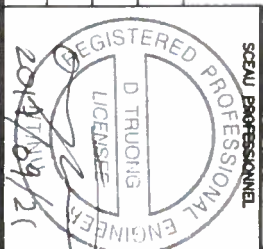

LISTE DE MATERIEL			
No	QTE	D/A	DESCRIPTION
1	3183 MM	ISO	SCH STD, SWLS PIPE
2	1	ISO	SCH STD, BW LR 90 DEG ELBOW TRIM TO 26 57
3	1	ISO	PIPE SUPPORT AS PER DETAIL 1, DWG
4	1	ISO	65-116-270-200 PIPE SHOE AS PER DETAIL 2, DWG 65-116-270-200

2	2017/09/21	PROJECT TITLE REVISED	KHV
1	2017/09/11	LINE NUMBERS REVISED	KHV
0	2017/05/15	ISSUED FOR CONSTRUCTION	KHV
No.	DATE	REVISION	PAB APP.

CLIENT:

**AGNICO EAGLE**



**ULTRAGEN**

CONSULTANT PROJECT NO. 591700

PROJECT: AGNICO EAGLE - MELIADINE DIVISION

116 - FUEL TANK FARM

TITLE: RANKIN INLET


FABRICATION ISOMETRIC

DIESEL FROM 65TK11601 & 65TK11602 TO PUMPING STATION

DATE: 2017/04/25	VER. PAR: -	DATE: -	APPR: -	ECHELLE: AUCUNE
DATE: 2017/04/25	VER. PAR: -	DATE: -	APPR: -	ECHELLE: AUCUNE

6515	116-150-PD1-CC10-0006	6/12	2
No PROJET	No DESSIN	PAGES	REV.



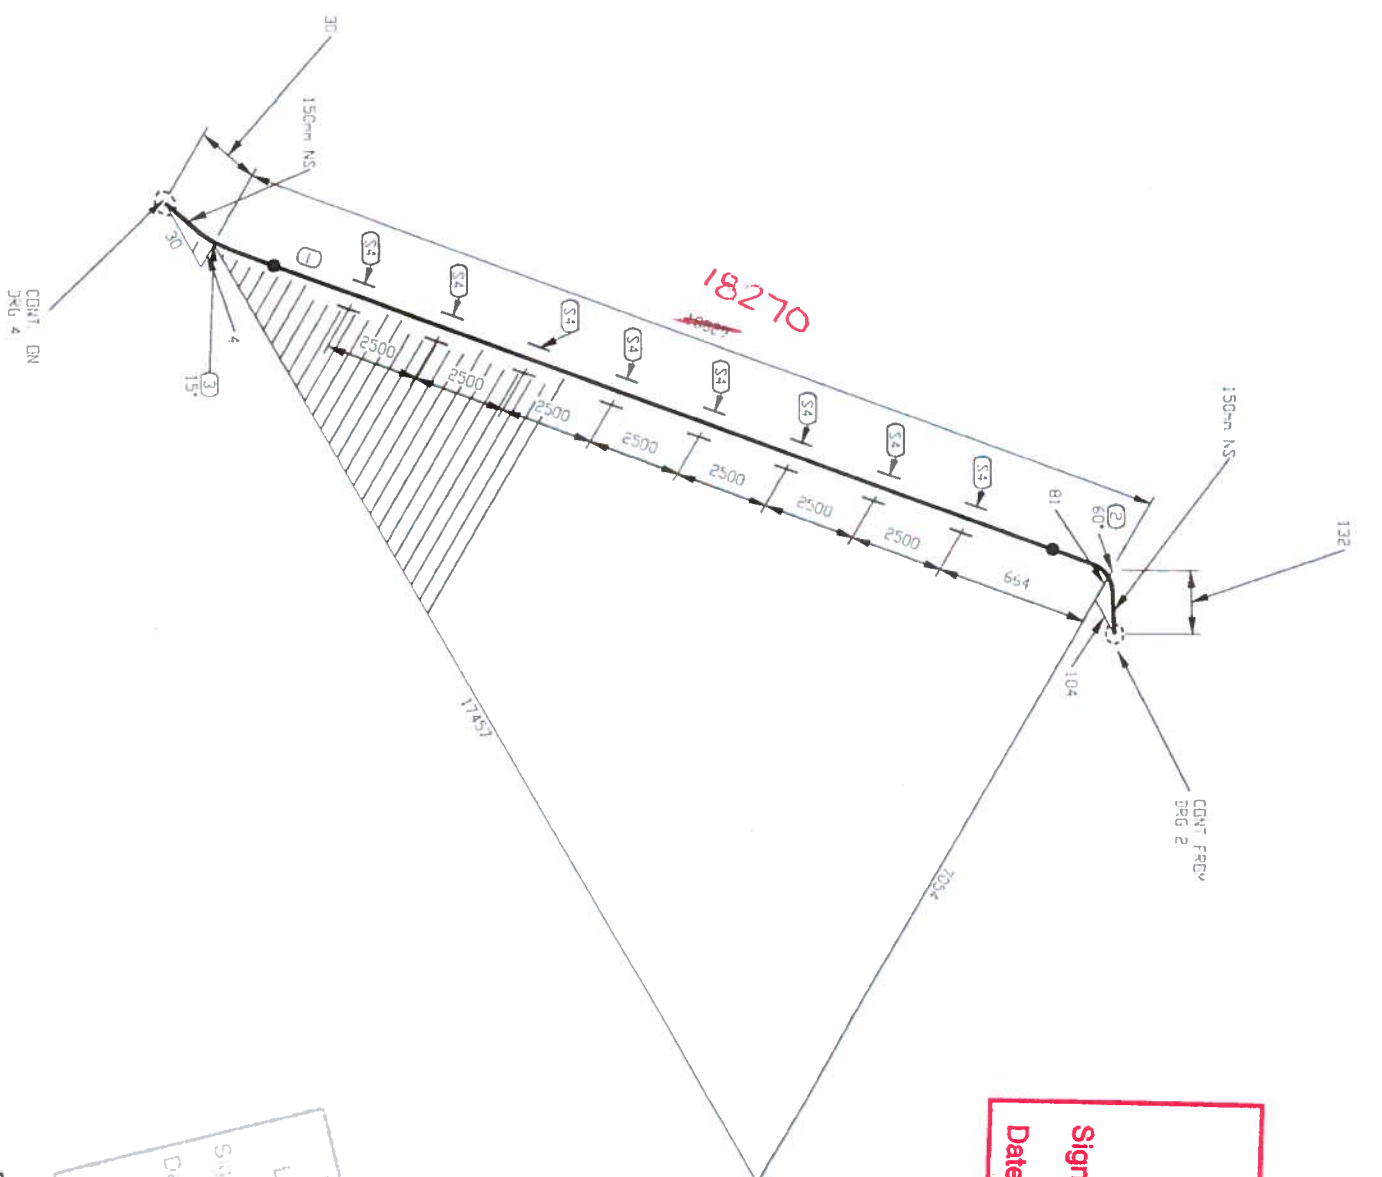

# PROMEC AS-BUILT

**Signature:**

Date: 2017-10-04

PERMIT TO PRACTICE  
LE GROUPE ULTRAGEN LTÉE

Signature \_\_\_\_\_  
Date \_\_\_\_\_  
PERMIT NUMBER: P 1480  
SEP 21 2011


168

Notary (Notaire)  
Engineer and Geoscientist

ON

FABRICATION DRAWINGS BASED ON  
WSP CERTIFIED ENGINEERING

NO. DE CONDUITE		SPECIFICATION	PRODUIT	SYSTEME REVETEMENT	CODE DE COULEUR	ISOLATION ET ENDOAGE	EPAISS. D'ISOLATION	
116-150-PDI-CC10-0001		CC10	PDI		-		65-116-270-200	PIPE SUPPORT DETAILS
PRESSION D'OPERATION	TEMPERATURE D'OPERATION	PRESSION DE CONCEPTION	TEMPERATURE DE CONCEPTION	PRESSION D'ESSAI	CLASSE D'INSPECTION	CODE DE SERVICE	TRAITEMENT THERMIQUE	
PSIG	°F	PSIG	°F	PSIG				
							No. DESSIN	DESSINS DE REFERENCE

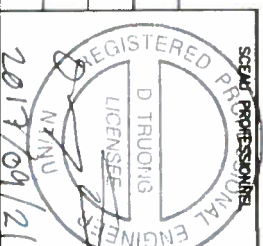

LISTE DE MATERIEL				
Id	QTE	DIA	MATERIEL/CATALOGUE	DESCRIPTION
1	18667 MM	150	A 333 gr. 6	SCH STD. SMLS PIPE
2	150	150	A 420 gr. WPL6	SCH STD. B. LR 90 DEG ELBOW TRIM TO 60.00
3	150	150	A 420 gr. WPL6	SCH STD. B. LR 90 DEG ELBOW TRIM TO 15.00
4	8	150		PIPE SUPPORT AS PER DETAIL 3. LWG 65-116-270-200

2	2017/09/21	PROJECT TITLE REVISED	KHV
1	2017/09/11	LINE NUMBERS REVISED	KHV
0	2017/05/15	ISSUED FOR CONSTRUCTION	KHV
No.	DATE	REVISION	APP. P&R

**CLIENT:**



# AGNICO EAGLE



**INUSANA PROMEC MINING**

CONC.: KHV		PROJECT:	
DATE: 2017/04/25	AGNICO EAGLE - MELIADINE DIVISION		
DESIGNÉ PAR: XVE	116 - FUEL TANK FARM		
DATE: 2017/04/25	TITRE:		
VER. PAR: -	RANKIN INLET		
DATE: -	FABRICATION ISOMETRIC		
APP: -	MARINE LINE TD 65TKK11601 & 65TNK11602		
DATE: -	NO. PROJECT	NO DESIGN	PAGES
ÉCHELLE: AUCUNE	6515	116-150-PDI-CC10-0001	3/13
			REV. 2





FABRICATION DRAWINGS BASED ON  
WSP CERTIFIED ENGINEERING

SOZIAL PROFESSIONNEL

NO. DE CONDUITE		SPECIFICATION	PRESSURE	SISTÈME RETENANT	CODE DE COLLAGE	ESLAVIN ET TROUS	EPAIS. D'ISOLATION		PIPE SUPPORT DETAILS
103-150-PPI-CC10-003	TEMPERATURE D'OPERATION	CC10	PPI		-			65-103-270-200	
	PRESSURE D'OPERATION		TEMPERATURE DE CONCEPTION	PRESSURE D'ESSAI				65-103-205-200	P&ID
				DESIGN				NO. DESIGN	DRAWING DE REFERENCE




DATE: Nov 17, 2017, 11:10 AM

10-NW-301

[illegible]



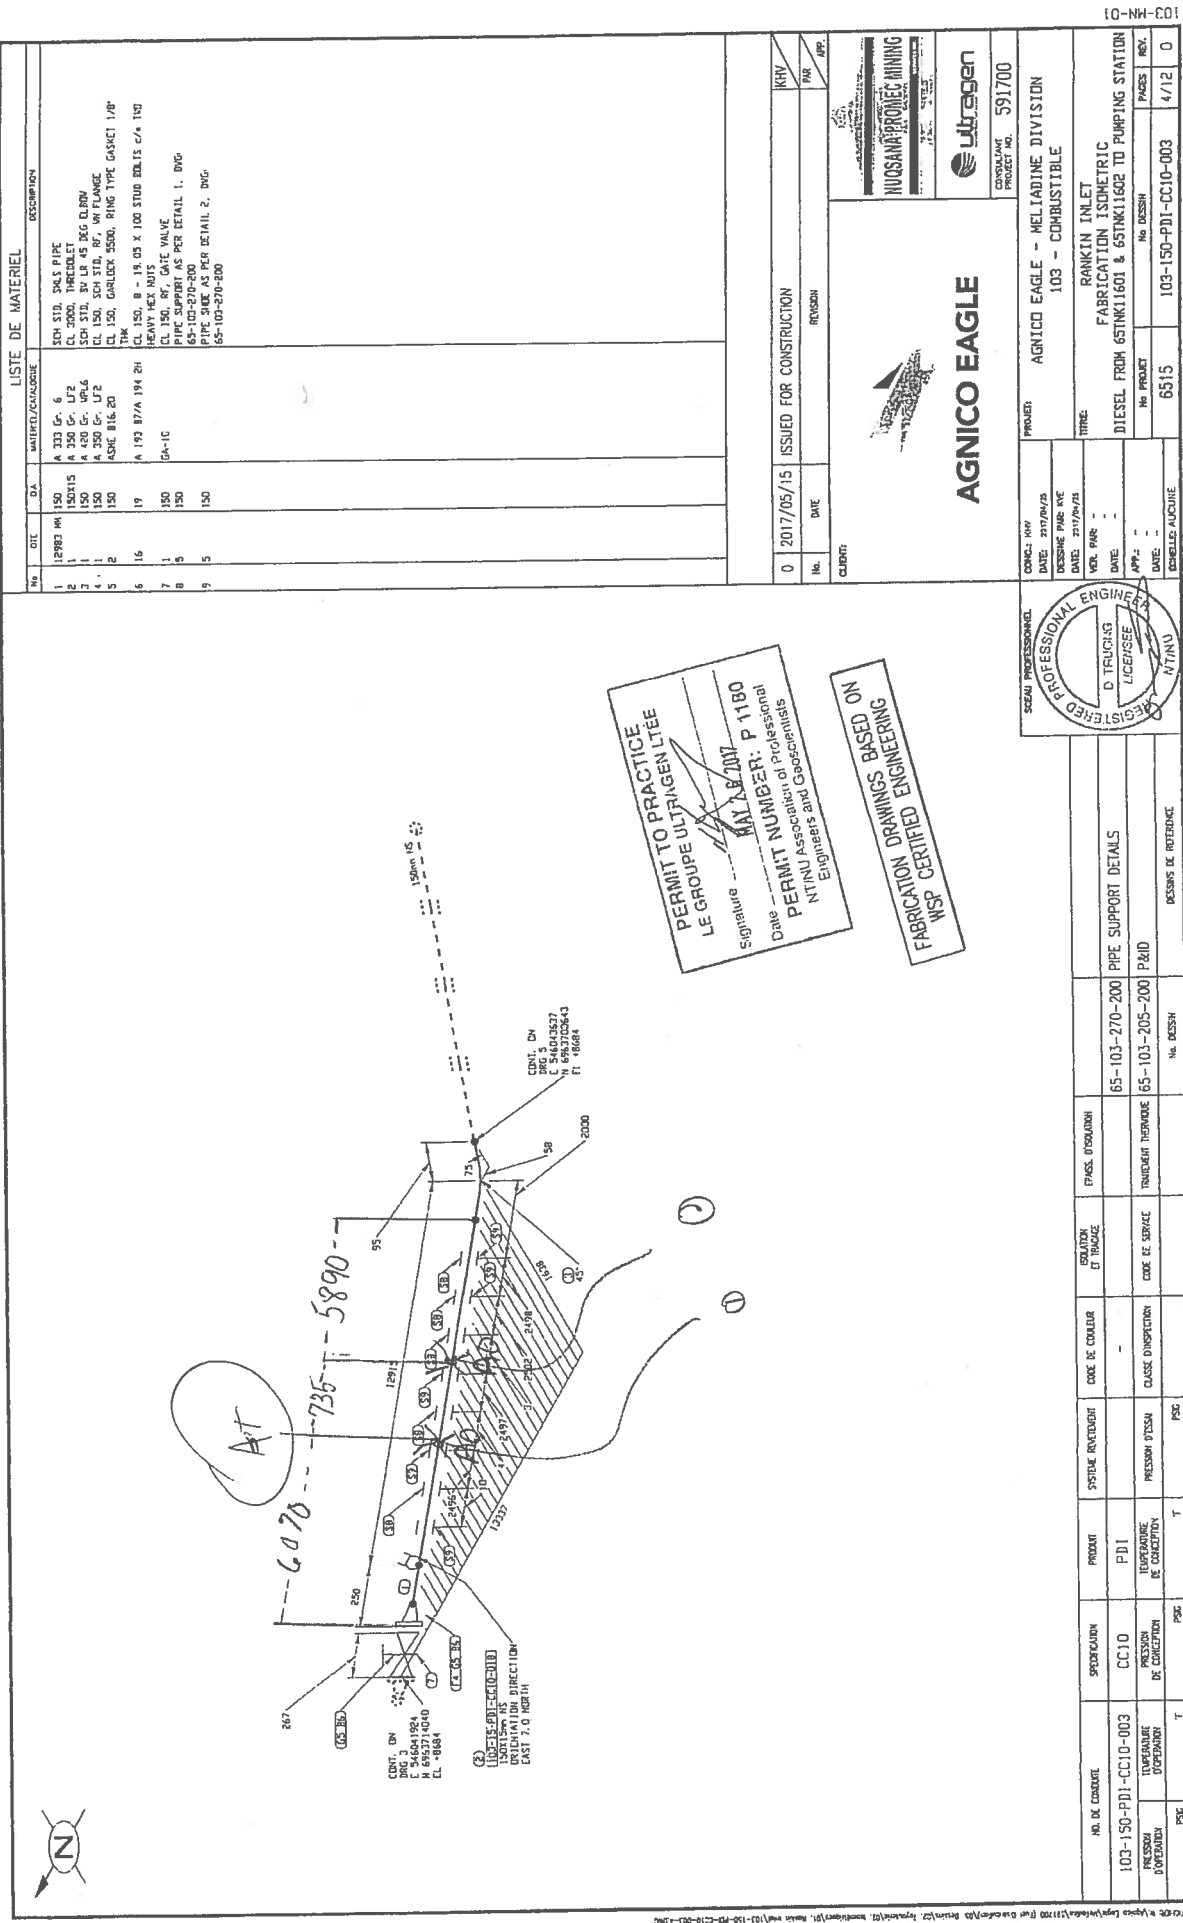

LISTE DE MATERIEL

NO	QTE	DA	MATRIEL/QUALITE	DESCRIPTION
1	1200	MM	A 312 G. 6	SECH STD. SULE PIPE
2	1	1200	A 312 G. 6	CL 2000. IMBROUET
3	1	1200	A 312 G. 6	CL 2000. IMBROUET
4	1	1200	A 312 G. 6	CL 2000. IMBROUET
5	2	1200	ASHE 816.20	CL 150. GARLOCK 5500. RING TYPE GASKET 1/8"
6	16	19	A 192 87/A 194 2H	CL 150. 8 - 19.05 X 100 STD BOLLIS C/A 150
7	1	150	GA-1C	HEAVY DUTY NUTS
8	5	150		CL 150. GARLOCK 5500. RING TYPE GASKET 1/8"
9	5	150		PIPE SUPPORT AS PER DETAIL 1. DWG.
				PIPE SIZES AS PER DETAIL 2. DWG.
				65-103-270-200

AGNICO EAGLE

AGNICO EAGLE - MELIADINE DIVISION

103 - COMBUSTIBLE

RANKIN INLET

FABRICATION ISOMETRIC

DIESEL FROM 65TNK11601 & 65TNK11602 TO PUMPING STATION

NO DESIN

6515

103-150-PDI-CC10-003

4/12

0

0


PERMIT TO PRACTICE  
LE GROUPE ULTRAGENIEE  
Signature  
Date  
PERMIT NUMBER: P 1180  
NTINU Association of Professional  
Engineers and Geoscientists

FABRICATION DRAWINGS BASED ON  
WSP CERTIFIED ENGINEERING

2019/05/26

2019/05/26

2019/05/26

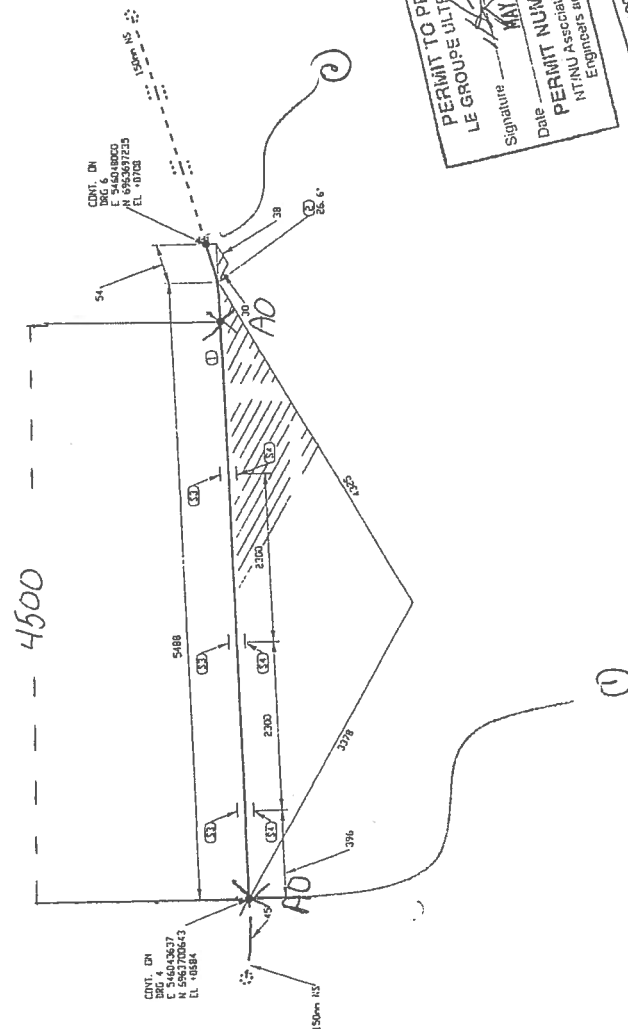

CONT. ON  
DRG 6  
E 546048000  
N 6953697235

CONF. ON  
DRG 4  
E 546043637  
N 5963700643

Signature \_\_\_\_\_ MAY 14 2007  
Date \_\_\_\_\_

**PERMIT TO PRACTICE**  
**LE GROUPE ULTRAGEN LEE**

**PERMIT NUMBER: P 1180**  
NTNU Association of Professional  
Engineers and Geoscientists




ON  
BASED  
DRAWINGS  
ENGINEERING

LISTE DE MATERIEL				DESCRIPTION	
No	QTE	DA	WIREL/MANAGER		
1	5424	150	A 333 Gr. 6	SCM STD. SMLS PIPE	
2	1	150	A 420 Gr. WPL6	PIPE SUPPORT AS PER DETAIL 1, DWG	
3	3	150		PIPE SUPPORT AS PER DETAIL 1, DWG	
4	3	150		PIPE SIZES PER DETAIL 2, DWG	
				65-103-200-200	

CLIENT		ISSUED FOR CONSTRUCTION		REV	APP.
No.	DATE	REVISION			
0	2017/05/15			KIV	

 <b>AGNICO EAGLE</b>		 <b>NORSKAMP CO. MINING</b> <small>EST. 1971</small>	 <b>Ultragon</b> <small>CONSULTANT</small>
PROJECT: AGNICO EAGLE - MELIADINE DIVISION		CONSULTANT PROJECT NO. 591700	
TITLE: 103 - COMBUSTIBLE			

CONC: KIV	DATE: 2017/05/15	ENGINEER: PAR. EXT	DATE: 2017/05/15
DESIGN: -	DATE: -	DATE: -	DATE: -
DATE: -	DATE: -	DATE: -	DATE: -
DATE: -	DATE: -	DATE: -	DATE: -


PROJECT: 103 - COMBUSTIBLE		RANKIN INLET	
TITLE: DIESEL FROM 65THK11601 & 65THK11602 TO PUMPING STATION		FABRICATION ISOMETRIC	
No. PROJECT: 6515		No. DESIGN: 103-ISO-PDI-CCIO-003	
No. REVISION: 5/12		No. REVISION: 5/12	

NO. DE GARANTIE		SPECIFICATION	PRODUIT	STATUT REVENIR	CODE DE COMMER	SOLUTION ET TRACER	PIECES INSOLATION	PIPE SUPPORT DETAILS
103-150-PJ	-CC10-003	CC10	PJ		-			65-103-270-200
PRESSON D'OPERATION	TEMPERATURE D'OPERATION	PRESSON DE COEXITION	TEMPERATURE DE COEXITION	PRESSON D'USSE	CLASSE D'INSPECTION	CODE DE SERVICE	TRATUEUR THERMOUE	65-103-205-200
								PIECES DE ENTRETIEN







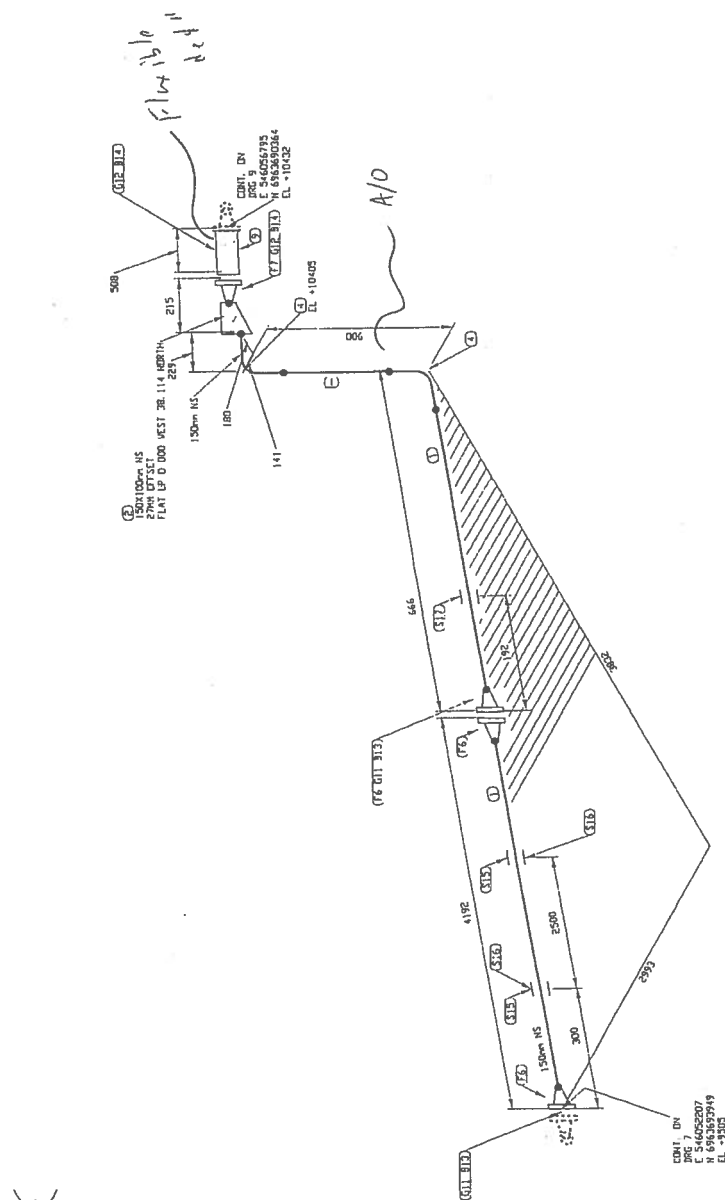


FABRICATION DRAWINGS BASED ON  
WSP CERTIFIED ENGINEERING

PERMIT TO PRACTICE  
LE GROUPE ULTRAGEN LTÉE

Signature  Date MAY 26 2017

PERMIT NUMBER: P 1180  
NTNU Association of Professional  
Engineers and Geoscientists

[illegible]

2017/05/26

NO. DE CONSOMME		SPECIFICATION	PRODUIT	STATUT RENTRÉMENT	CODE DE COMPTER	GOUVERNEMENT ET TRACAGE	EPAISSEUR D'ORIGINATION	
PSC	T	PSC	T	PSC	-			
PRESSION D'ORIGINATION	TEMPERATURE D'ORIGINATION	PRESSION DE CONCEPTION	TEMPERATURE DE CONCEPTION	PRESSION D'ESSAI DE CONCEPTION	CLASSE D'INSPECTION	CODE DE SERVICE	MATRIERE MATERIALE	
103-150-PDI-CC10-003		CC10	PDI					
								65-103-270-200
								PPE SUPPORT DETAILS
								65-103-205-200
								PAID
								No. DESIN
								DRESSING DE REFERENCE

DATE: 11/16/2017 17:23:45

PERMIT TO PRACTICE  
LE GROUPE ULTRAGEN LTÉE

Signature:

Date: MAY 28 2017

PERMIT NUMBER: P 1180

NT/NU Association of Professional  
Engineers and Geoscientists

103-150-PJ1-CC10-003

PROJON  
TEMPERATURE  
D'OPERATION

CC10

PROJON  
PRESSION  
DE CONCEPTION

CC10

PROJON  
TEMPERATURE  
D'OPERATION

PSC

PROJON  
PRESSION  
DE CONCEPTION

PSC

103-150-PJ1-CC10-003

PROJON  
TEMPERATURE  
D'OPERATION

CC10

PROJON  
PRESSION  
DE CONCEPTION

PSC

PROJON  
TEMPERATURE  
D'OPERATION

PSC

PROJON  
PRESSION  
DE CONCEPTION

PSC

103-150-PJ1-CC10-003

PROJON  
TEMPERATURE  
D'OPERATION

CC10

PROJON  
PRESSION  
DE CONCEPTION

PSC

PROJON  
TEMPERATURE  
D'OPERATION

PSC

PROJON  
PRESSION  
DE CONCEPTION

PSC

103-150-PJ1-CC10-003

PROJON  
TEMPERATURE  
D'OPERATION

CC10

PROJON  
PRESSION  
DE CONCEPTION

PSC

PROJON  
TEMPERATURE  
D'OPERATION


PSC

PROJON  
PRESSION  
DE CONCEPTION

PSC






PERMIT TO PRACTICE  
 LE GROUPE ULTRAGEN LTÉE  
 Signature   
 Date MAY 26 2017  
 PERMIT NUMBER: P 1180  
 NTNU Association of Professional  
 Engineers and Geoscientists

LISTE DE MATERIEL			
QTE	COA	MATERIEL / QUANTITE	DESCRIPTION
527 M3	100	A 200 Gp. 6	SCM ST3, SMLS PIPE
1	100X15	A 250 Gp. LF2	CL 3000, THREDDLET
1	100	A 450 Gp. UPL6	SCM ST3, BV 1/8 90 DEG CLIPON
1	100	A 200 Gp. LF2	CL 150, SCM ST3, 1/8" W/ FLANGE
1	100	A 200 Gp. LF2	CL 150, SCM ST3, 1/8" W/ FLANGE
2	100	ASPE BIG RD	CL 150, GARLOCK S500, RING TYPE GASKET 1/8"
16	A 193 B7/A 194 RH	THK	CL 150, B - 15.875 X 90 STD BOLLIS C/A TWO
1	GA-10	HEAVY HEX NUTS	CL 150, ST. GATE VALVE
1	100	CL 150, ST. GATE VALVE	CL 150, ST. GATE VALVE
1	100	CONTRACTOR CHASE-300 WELDED TO CONTAINERS C/A 1/8-BOL	CONTRACTOR CHASE-300 WELDED TO CONTAINERS C/A 1/8-BOL

**AGNICO EAGLE**



**AGNICO EAGLE - MELTADINE DIVISION**  
103 - COMBUSTIBLE

**RANKIN INLET**  
FABRICATION ISOMETRIC  
DIESEL FROM 65TNK11601 & 65TNK11602 TO PUMPING STATION

PROJECT: 103-150-P01-CC10-003

DATE: 2017/05/15

ISSUED FOR CONSTRUCTION

REVISION

CLIENT:

QTE: 0


DATE: 2017/05/15

ISSUED FOR CONSTRUCTION

REVISION

CLIENT:

**AGNICO EAGLE**




**AGNICO EAGLE - MELTADINE DIVISION**  
103 - COMBUSTIBLE

**RANKIN INLET**  
FABRICATION ISOMETRIC  
DIESEL FROM 65TNK11601 & 65TNK11602 TO PUMPING STATION

PROJECT: 103-150-P01-CC10-003

	CON-2: 649 DATE: 2/17/07/21 EXPIRATION DATE: 2/17/07/21 EXPIRATION DATE: 2/17/07/21	PROJECT:	AGNICO EAGLE - MELTADINE DIVISION 103 - COMBUSTIBLE
	TITLED:	RANKIN INLET FABRICATION ISOMETRIC DIESEL FROM 65TNK11601 & 65TNK11602 TO PUMPING STATION	
NO PROJECT	NO DESIGN	PAGES: 10/12	REV: 0
6515	103-150-P01-C510-003		


[illegible]

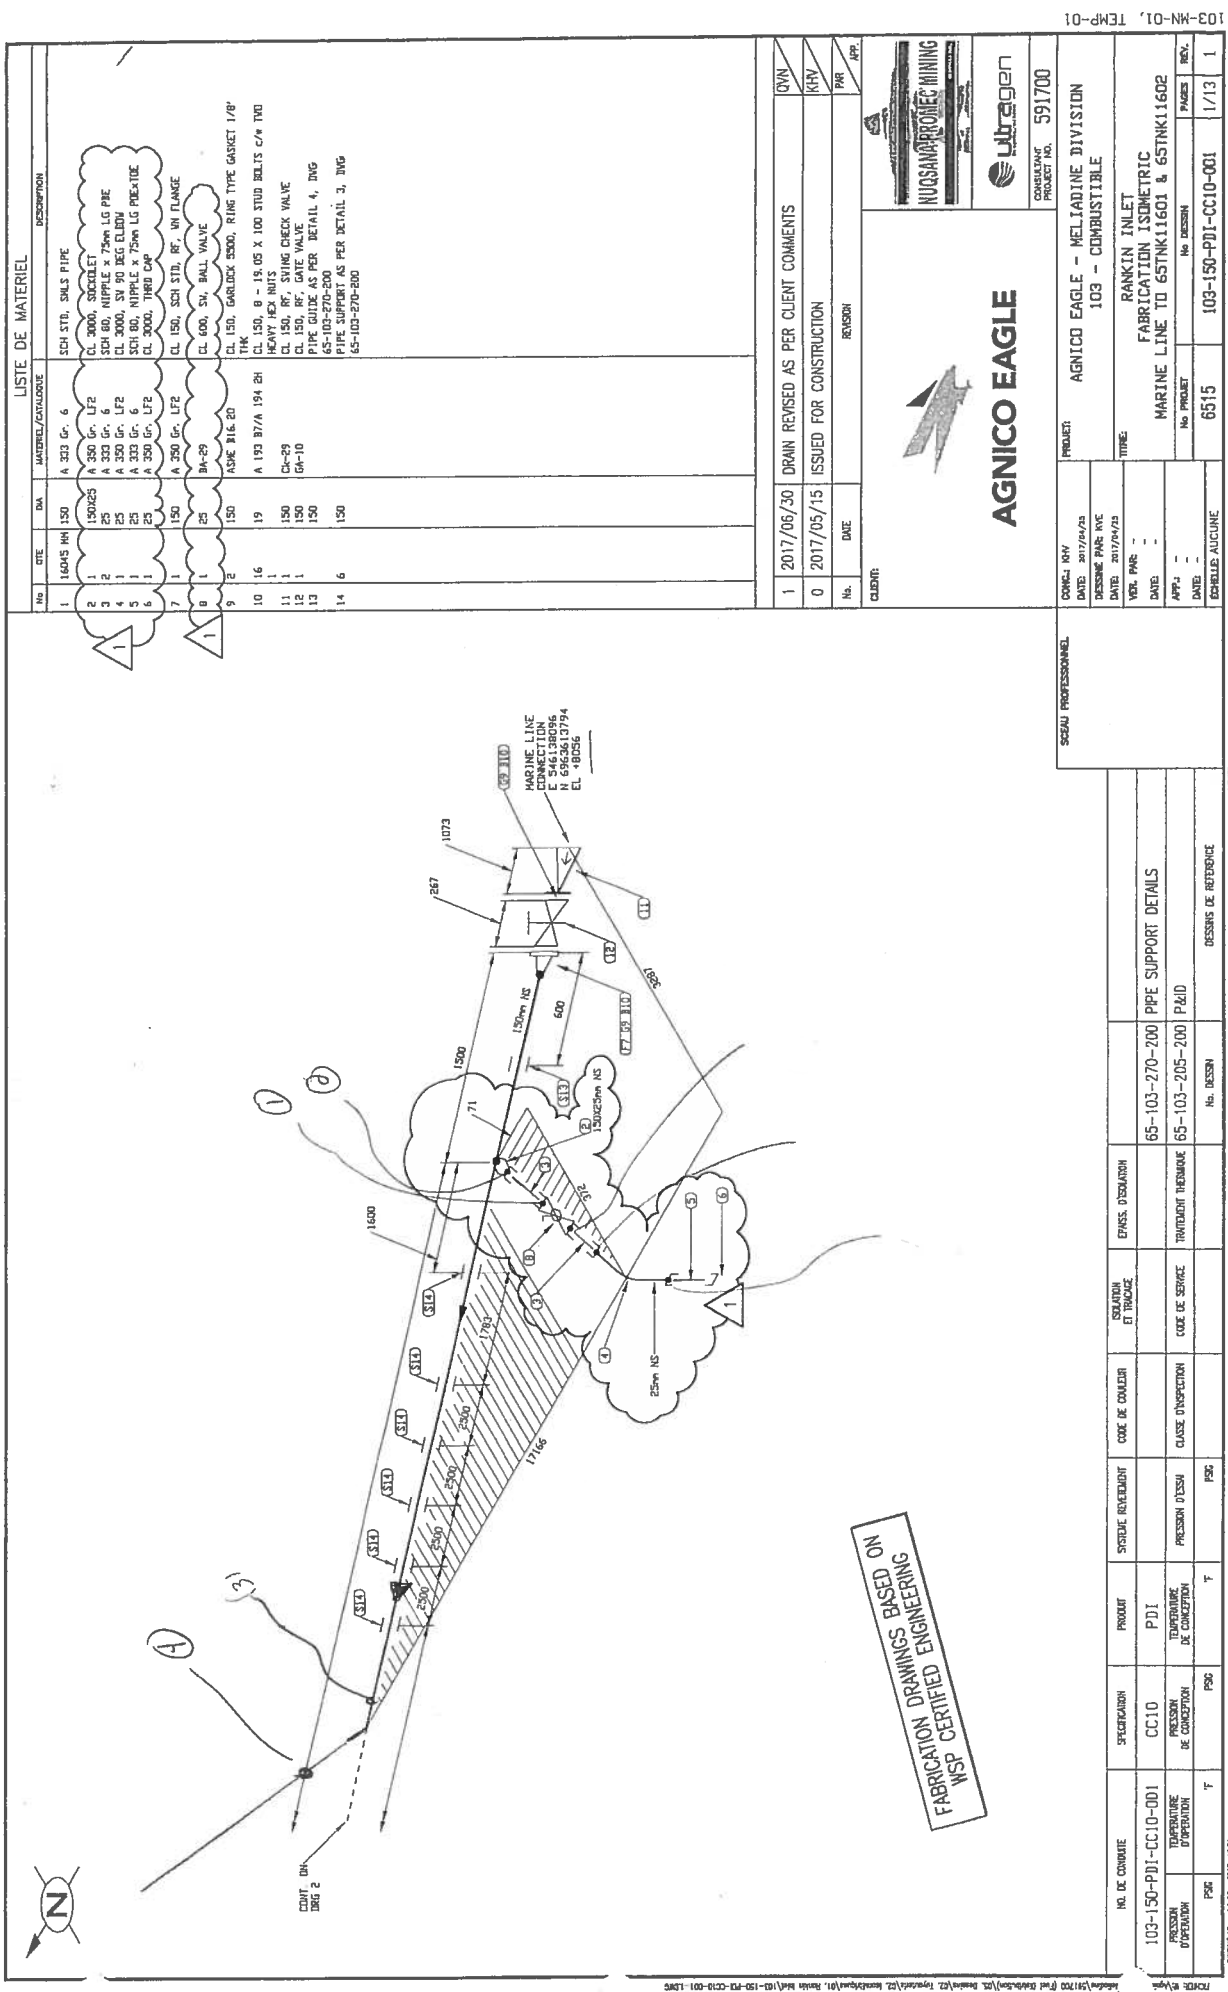

LISTE DE MATERIEL			
No	QTE	DA	MATERIEL/CATALOGUE
1	1	1600mm NS	A 333 Gr. 6
2	1	1500mm NS	A 333 Gr. 6
3	1	1500mm NS	A 333 Gr. 6
AGNICO EAGLE			
AGNICO EAGLE - MELIADINE DIVISION			
103 - COMBUSTIBLE			
RANKIN INLET			
FABRICATION ISOMETRIC			
MARINE LINE TO 65TNK11601 & 65TNK11602			
No. PROJET			
6515			
103-150-PDI-CC10-001			
1/13			



PERMIT TO PRACTICE  
 LE GROUPE ULTRA-TECHNIQUE  
 Signature:  MK 76 MIT  
 Data: PERMIT NUMBER: P 1180  
 NTM(U) Association of Professional  
 Engineers and Geoscientists

2017/05/26



**PERMIT TO PRACTICE**  
LE GROUPE ULTRAGEN LIEE

Signature: *[Signature]* Date: **MAY 16 2017**

PERMIT NUMBER: P 1180

NTNU Association of Professional Engineers and Geoscientists

**FABRICATION DRAWINGS BASED ON**  
WSP CERTIFIED ENGINEERING

**LISTE DE MATERIEL**

No	QTE	DM	MATRIEL/CATALOGUE	DESCRIPTION
1	18667	150	A 325 Gr. 5	SCM 312. 505.5 PIPE
2	1	150	A 420 Gr. WPL 6	SCM 312. BU LR 90 DEG ELBOW THIN TO 60.00
3	1	150	A 420 Gr. WPL 6	SCM 312. BU LR 90 DEG ELBOW THIN TO 15.00
4	8	150	A 420 Gr. WPL 6	PIPE SUPPORT AS PER DETAIL 3, DWG. 65-103-270-200

0	2017/05/15	ISSUED FOR CONSTRUCTION	KIV
		REVISION	PR
			APP

AGNICO EAGLE

**CLIENT:**

0 2017/05/15 ISSUED FOR CONSTRUCTION

REVISION

KIV

PR

APP

**PROJECT:**

AGNICO EAGLE - MELIADINE DIVISION

103 - COMBUSTIBLE

**TITLE:**

RANKIN INLET

FABRICATION ISOMETRIC

MARINE LINE TO 65TNK11601 & 65TNK11602

**NO. DESIN:**

6515

**103-150-PDI-CC10-001**

**PAGES:**

3/13

**REV:**

0



WSP CERTIFIED ENGINEERING  
FABRICATION DRAWINGS BASED ON  
N<sup>o</sup>. Engineer

NO. DE CORDE		PRODOT	STATUT RECEVEMENT	CODE DE COULEUR	SOLUION ET TRAÇAGE	EPAISS. ISOLATION	PIPE SUPPORT DETAILS
103-150-P01-CC10-001		PDI		-			65-103-270-200
PRESSION TEMPERATURE D'OPERATION	PRESSION TEMPERATURE DE CONCEPTION	TEMPERATURE DE CONCEPTION	PRESSION D'USAG	CLASSE D'INSPECTION	CODE DE SERVICE	TANTAUANT THERMOQUE	65-103-205-200 P&ID
PSIG	°F	°F	PSIG				N2. DESINH
							DESSINS DE REFERENCE

2017/05/26


DATE: MAY 17, 2017, 10:45 AM





# LISTE DE MATERIEL

NO	QTE	SA	MATERIEL/CHANGÉE	DESCRIPTION
1	5344	M6	A 332 G- 6	SEN STD. SMLS PIPE
2	2	150	A 420 G- 6	SEN STD. IN LR 45 DEG ELONG TERN TO 24.57
3	3	150	A 420 G- 6	PIPE SUPPORT AS DETAIL 1, DWG
4	1	150	A 420 G- 6	PIPE SUPPORT AS DETAIL 2, DWG
5	2	150	A 420 G- 6	PIPE SMOKE AS PER DETAIL 2, DWG
6	2	150	A 420 G- 6	PIPE SMOKE AS PER DETAIL 2, DWG

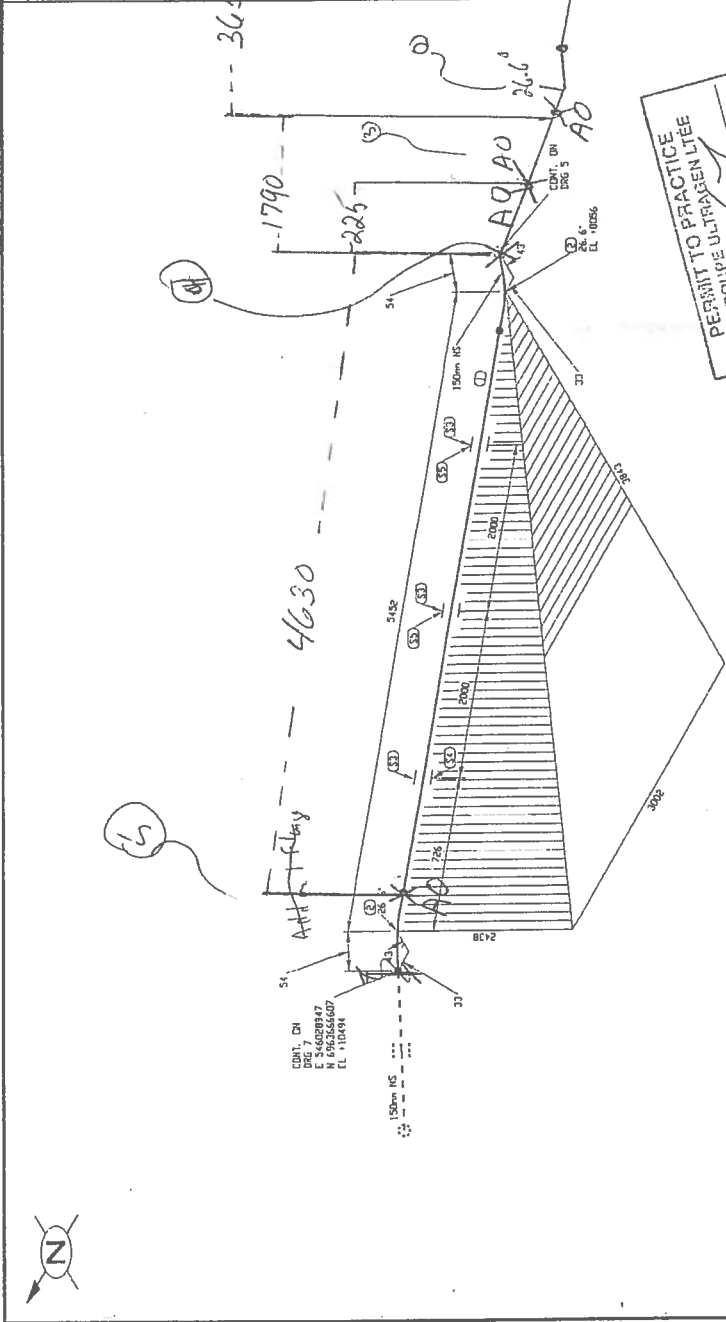

PERMIT TO PRACTICE  
 LE GROUPE ULTRAGEN LITEE  
 Signature: *[Signature]*  
 Date: MAY 25 2017  
 PERMIT NUMBER: P 1180  
 NTINU Association of Professional  
 Engineers and Geoscientists

FABRICATION DRAWINGS BASED ON  
 WSP CERTIFIED ENGINEERING

NO	DATE	REVISION	REV	APP
0	2017/05/15	ISSUED FOR CONSTRUCTION		

**AGNICO EAGLE**  
 CONSULTANT PROJECT INC.  
 591700


COMP: 607	DATE: 2017/05/15	PROJ: AGNICO EAGLE - MELIADINE DIVISION
DESIGN: 607	DATE: 2017/05/15	TITLE: 103 - COMBUSTIBLE
APP: 607	DATE: 2017/05/15	TITLE: RANKIN INLET
APP: 607	DATE: 2017/05/15	TITLE: FABRICATION ISOMETRIC
APP: 607	DATE: 2017/05/15	TITLE: MARINE LINE TO 65TNK11601 & 65TNK11602
APP: 607	DATE: 2017/05/15	TITLE: No DESIGN
APP: 607	DATE: 2017/05/15	TITLE: 103-150-P01-CC10-001
APP: 607	DATE: 2017/05/15	TITLE: 6515
APP: 607	DATE: 2017/05/15	TITLE: 103-150-P01-CC10-001
APP: 607	DATE: 2017/05/15	TITLE: 6/13
APP: 607	DATE: 2017/05/15	TITLE: 0

NO. DE CROQUE	PROJ	SYSTEME REVENCH	CODE DE COULEUR	CHANGÉ ET TRACÉ	EPASS. D'ISOLATION	65-103-270-200	PIPE SUPPORT DETAILS
103-150-P01-CC10-001	PD1	PRESSION D'ISOLATION	CC10	CODE DE SERVICE	TRADUCTION INGENIERE	65-103-205-200	PAID
PRESSION D'ISOLATION	PRESSION D'ISOLATION	PRESSION D'ISOLATION	PRESSION D'ISOLATION	PRESSION D'ISOLATION	PRESSION D'ISOLATION	PRESSION D'ISOLATION	PRESSION D'ISOLATION
PRESSION D'ISOLATION	PRESSION D'ISOLATION	PRESSION D'ISOLATION	PRESSION D'ISOLATION	PRESSION D'ISOLATION	PRESSION D'ISOLATION	PRESSION D'ISOLATION	PRESSION D'ISOLATION

2019/05/26  
 103-KN-01

# LISTE DE MATERIEL

N°	QTE	UN	MATERIEL/ALCOUSE	REMARQUE
1	3979	PH	A 373 G° 6	SEM STD. SMLS PIPE
2	2	150	A 420 G° UPL6	SEM STD. 3V LR 45 DEG CLBDY TRIM TO 26.57
3	2	150		PIPE SUPPORT AS PER DETAIL 1. DWG
4	2	150		PIPE SUPPORT AS PER DETAIL 2. DWG

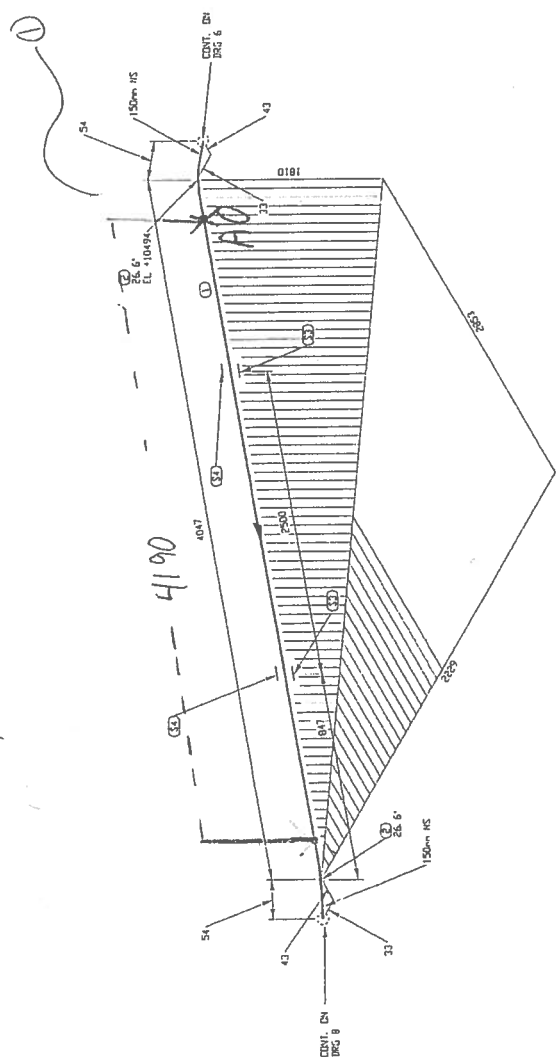

FABRICATION DRAWINGS BASED ON  
WSP CERTIFIED ENGINEERING

PERMIT TO PRACTICE  
LE GROUPE ULTRAGEN LTÉE  
Signature \_\_\_\_\_  
Date MAY 28 2017  
PERMIT NUMBER: P 1180  
NTRU Association of Professional  
Engineers and Geoscientists


SOCIÉTÉ PROFESSIONNELLE REGISTERED PROFESSIONAL ENGINEER D. TRIUONG LICENCEE 2017/05/26		COMP. KIV DATE: 2017/05/23	PROJET: AGNICO EAGLE - MELTADINE DIVISION 103 - COMBUSTIBLE
DESSIN DE RÉFÉRENCE		DESSIN PIRE KIV DATE: 2017/05/23	TITRE: RANKIN INLET FABRICATION ISOMETRIC MARINE LINE TO 65THK11601 & 65THK11602
No. DESSIN		VER. PAR	No. PROJET
65-103-270-200		DATE	6515
65-103-205-200		REV.	7/13 0

ISSUED FOR CONSTRUCTION		KIV
REVISION		PAR
DATE		APP.
CLIQUE		



AGNICO EAGLE

CONSULTING  
PROJECT NO. 591700



2017/05/26

103-NW-01



# LISTE DE MATERIEL

NO	QTE	EAU	MATERIEL/CATALOGUE	DESCRIPTION
1	525 M	150	A 332 G- 6	SDH STD. SMS PIPE
2	1	150X150	A 420 G- MPL6	SDH STD. 1/2 STRAIGHT TEE
3	1	150X150	A 420 G- MPL6	SDH STD. 1/2 ELBOW
4	1	150	A 350 G- U7	CL 150. SCH STD. RT. W/ FLANGE
5	1	150	A 350 G- U7	CL 150. IF/UD INDICATOR "VSI-FLO"
6	6	150	ASPE B16.20	CL 150. GARLOCK 2500. RING TYPE GASKET 1/8"
7	48	19	A 193 B7/A 194 2H	CL 150. 8 - 19.05 X 100 STD BOLTS C/A 190
8	1	150	2A-21	CL 150. RT. BALL VALVE
9	1	150	CK-29	CL 150. RT. SIVING CHECK VALVE
10	1	150		PIPE SUPPORT AS PER DETAIL 1. DWG
11	1	150		65-103-270-200
				PIPE SIZE AS PER DETAIL 2. DWG
				65-103-270-200


0 2017/05/15 ISSUED FOR CONSTRUCTION

REV	DATE	REVISION
0	2017/05/15	ISSUED FOR CONSTRUCTION

FABRICATION DRAWINGS BASED ON  
WSP CERTIFIED ENGINEERING

PERMIT TO PRACTICE  
LE GROUPE ULTRAGEN LTÉE  
Signature W. G. 2017  
Date 2017/05/17  
PERMIT NUMBER: P 1180  
NT/NU Association of Professional  
Engineers and Geoscientists

AGNICO EAGLE

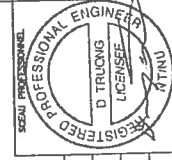

CONC. REV	DATE	REVISION
0	2017/05/15	ISSUED FOR CONSTRUCTION

NO. DE CONQTE	SPECIFICATION	PROJET	SISTÈME REVENANT	CODE DE COALUR	GRANIER ET FINAGE	DIVIS. INFORMATION	65-103-270-200	PIPE SUPPORT DETAILS
103-150-PDI-CC10-001	CC10	PDI	PRESSION D'ESCH	CLASSE D'INSPECTION	CODE DE SERVICE	TRANSDUIT MEMOIRE	65-103-205-200	P&ID
PRESSION D'OPERATION	PRESSION D'OPERATION	PRESSION D'ESCH	PRESSION D'ESCH	CLASSE D'INSPECTION	CODE DE SERVICE	TRANSDUIT MEMOIRE	65-103-205-200	P&ID
PRESSION D'OPERATION	PRESSION D'OPERATION	PRESSION D'ESCH	PRESSION D'ESCH	CLASSE D'INSPECTION	CODE DE SERVICE	TRANSDUIT MEMOIRE	65-103-205-200	P&ID

NO. DE CONQTE	SPECIFICATION	PROJET	SISTÈME REVENANT	CODE DE COALUR	GRANIER ET FINAGE	DIVIS. INFORMATION	65-103-270-200	PIPE SUPPORT DETAILS
103-150-PDI-CC10-001	CC10	PDI	PRESSION D'ESCH	CLASSE D'INSPECTION	CODE DE SERVICE	TRANSDUIT MEMOIRE	65-103-205-200	P&ID
PRESSION D'OPERATION	PRESSION D'OPERATION	PRESSION D'ESCH	PRESSION D'ESCH	CLASSE D'INSPECTION	CODE DE SERVICE	TRANSDUIT MEMOIRE	65-103-205-200	P&ID
PRESSION D'OPERATION	PRESSION D'OPERATION	PRESSION D'ESCH	PRESSION D'ESCH	CLASSE D'INSPECTION	CODE DE SERVICE	TRANSDUIT MEMOIRE	65-103-205-200	P&ID

10-NH-001

2017/05/26

Version 1.0 - May 17, 2017, 12:00

2-11/05/26

103-MN-01



FABRICATION DRAWINGS BASED ON  
WSP CERTIFIED ENGINEERING

2017/05/26

{0-NW-EO}





0017/05/28

## **APPENDIX K**

### **Inspection Report – Rankin Inlet Fuel Modules**



## Vendor Document Status

**AGNICO EAGLE**

- 1 ☐ Proceed to next submission and status.
- 2 ☐ Proceed with exceptions as noted to next submission and status.
- 3 ☐ Do not proceed.  
Revise as noted and resubmit next submission and status.
- 4 ☒ Complete, no further submission required.

By:

Date:

Review and authorization to fabricate are only for general conformance with the design concept of the Project as expressed in the Contract Documents. Sole responsibility for the accuracy and completeness of this document, including but not limited to dimensions and quantities, remains with the Supplier/Contractor. Agnico Eagle does not warrant the accuracy or completeness of any of the information contained herein, nor does Agnico Eagle authorize or approve any construction means, methods, techniques, sequences or any safety precautions or procedures.

Agnico Eagle  
No.

6515-C-270-007-141-QCR-0002 R: Sub002

**DOCUMENT FOR INFORMATION**





**22466T / 22498E**

# **FUEL MODULES**



**AGNICO EAGLE**

**MÉLIADINE**

**6515-C-270-007**

## TABLE OF CONTENT

### SECTION 1 – INSPECTION AND TEST PLAN

SECTION 1.1 – ITP-003 - FUEL FARM – RANKIN INLET	#
SECTION 1.2 – PROCEDURES SUBMITTED AND APPROVED	#
SECTION 1.3 – DRAWINGS INDEX (IFC) LATEST REVISION	#

### SECTION 2 – SPECIFIC

SECTION 2.1 – NON-CONFORMANCE REPORT & LOG – AEM-GE-ITR-002 / AEM-GE-LOG-002	#
SECTION 2.2 – INSPECT MATERIAL/EQUIPMENT FOR DAMAGES OR DEFICIENCIES	#
SECTION 2.3 – INSPECTION DEFICIENCY REPORT & LOG – AEM-GE-ITR-005 / AEM-GE-LOG-004	#

### SECTION 3 – ELECTRICAL AND INSTRUMENTATION

SECTION 3.1 – ALL CERTIFIED TEST RECORDS, FIRE ALARM CERT'S – VENDOR DOCUMENTS	#
SECTION 3.2 – ELECTRICAL EQUIPMENT INSTALLATION INSPECTION RECORD	#
SECTION 3.3 – DISTRIBUTION PANEL INSPECTION & TEST RECORD	#
SECTION 3.4 – DISTRIBUTION TRANSFORMER FIELD INSPECTION TEST RECORD	#
SECTION 3.5 – PCR INSTALLATION AND INSPECTION	#
SECTION 3.6 – HEATING DEVICE INSTALLATION RECORD	#
SECTION 3.7 – CABLE TRAY INSPECTION RECORD	#
SECTION 3.8 – POWER/CONTROL CABLES INSTALLATION TEST RECORD	#
SECTION 3.9 – LOW VOLTAGE CABLE INSTALLATION TEST RECORD	#
SECTION 3.10 – INSTRUMENT CABLE INSTALLATION TEST RECORD	#
SECTION 3.11 – GROUNDING SYSTEM INSTALLATION INSPECTION AND TEST RECORD	#
SECTION 3.12 – BRANCH CCT TEST RECORD, LIGHT, RECEPTACLES, HEATERS, ETC	#
SECTION 3.13 – FIRE ALARM PANEL AND DEVICE INSTALLATION RECORD	#
SECTION 3.14 – INSTRUMENTATION INSTALLATION TEST RECORD (POWERED INSTRUMENTS)	#
SECTION 3.15 – INSTRUMENTATION INSTALLATION TEST RECORD (NON-POWERED INSTRUMENTS)	#
SECTION 3.16 – MOTOR/INSTALL/MEGGER/ROTATION TEST AND POLARIZATION RECORDS	#
SECTION 3.17 – INSTRUMENT LOOP TEST (PRE-COMMISSIONING / COMMISSIONING ACTIVITY)	#

### SECTION 4 – FINAL TURNOVER

SECTION 4.1 – CONSTRUCTION COMPLETION (JOINT WALKDOWN PUNCHLIST)	#
SECTION 4.2 – FINAL ACCEPTANCE OF TURNOVER PACKAGE	#
SECTION 4.3 – DECLARATION OF COMPLETION	#
SECTION 4.4 – AS-BUILT DRAWINGS	#



**AGNICO EAGLE**

**Vendor Document Status**

- 1** ☐ Proceed to next submission and status.
- 2** ☐ Proceed with exceptions as noted to next submission and status.
- 3** ☐ Do not proceed.  
Revise as noted and resubmit next submission and status.
- 4** ☒ Complete, no further submission required.

**LUC SÉNÉCAL**

**2017-07-10**

By:

Date:

Review and authorization to fabricate are only for general conformance with the design concept of the Project as expressed in the Contract Documents. Sole responsibility for the accuracy and completeness of this document, including but not limited to dimensions and quantities, remains with the Supplier/Contractor. Agnico Eagle does not warrant the accuracy or completeness of any of the information contained herein, nor does Agnico Eagle authorize or approve any construction means, methods, techniques, sequences or any safety precautions or procedures.

Agnico Eagle

No.

6515-C-270-007-141-TES-0007 R: Sub002

**DOCUMENT FOR INFORMATION**



Contract title:  
Contract number:  
Promec Ref.:

Meliadine Fuel Tanks Piping Supply and Installation  
6515-C-270-007  
C22498E

Approved on :  
Approved by:

**AGNICO EAGLE**

## Inspection and Testing Plan

ITP # AEM-ITP-003  
Area rankin inlet  
System ALL  
Discipline Electrical Instrumentation

Approval Signature

Updated on:  
2017-04-26

**Legend**  
H - Hold  
W - Witness  
I - Inspect  
R - Review

Activity No. and CDRL Code	Activity Description (Per Scope of Work)	Responsibility Contractor and/or Sub	Acceptance Criteria (Specifications, Drawings, Industry Code, Regulatory Authority, Manufacturers O&M manual, Controlling Procedure, Quality/Engineering Bulletins, Other/ Site Quality Plan, Contractor Quality Manuals, etc.)	Verification Point				Verification Document(s)  1. List ONLY the Form(s) applicable to Installation. 2. ▲ Commissioning Required Document
				Contractor		Client		
				H W I R	Initials & Date	H W I R	Initials & Date	
1.0 GENERAL								
1.1	Inspection and Test Plan	Promec / CLIENT		H/R				Approved ITP
1.2	Document review (Acquire and review all applicable documentation)	Promec / CLIENT	Quality Plan	H/R				
1.3	Procedures Submitted and Approved (Cable Installation, Testing, etc.)	Promec / CLIENT	Quality Plan	H/R				All Applicable Approved Procedures
1.4	Drawing Index (IFC) to Latest Revision	Promec	Quality Plan	I/R				VDRL
2.0 ITP SPECIFIC								
2.1	Non-Conformance Report & Log (Both CLIENT & Contractor Issued)	Promec / CLIENT	Quality Plan	H/R				AEM-GE-ITR-002 (Non-Conformance Report) ▲ AEM-GE-LOG-002 (Non-Conformance Log)
2.2	Inspect Material/Equipment for Damages or Deficiencies	Promec	Quality Plan	I/R				AEM-GE-ITR-005 (Inspection Deficiency Report) ▲ AEM-GE-LOG-004 (Inspection Deficiency Log)





Contract title:  
Contract number:  
Promec Ref.:

Meliadine Fuel Tanks Piping Supply and Installation  
6515-C-270-007  
C22498E

Approved on :  
Approved by :

**AGNICO EAGLE**

Approval Signature

ITP #  
Area  
System

AEM-ITP-003  
rankin inlet  
ALL

Discipline

Electrical  
Instrumentation

Updated on:  
2017-04-26

**Legend**  
H - Hold  
W - Witness  
I - Inspect  
R - Review

## Inspection and Testing Plan

Activity No. and CDRL Code	Activity Description (Per Scope of Work)	Responsibility Contractor and/or Sub	Acceptance Criteria	Verification Point				Verification Document(s)
				Contractor		Client		
				H W I R	Initials & Date	H W I R	Initials & Date	
3.0 Electrical & Instrumentation								
3.1	All Certified Test Records • Fire Alarm Cert's - (Engineer's Stamp; Vendor Test Documents) • CSA Approval Documentation	Promec / CLIENT	AEM-IN-PRO-001 (Instrumentation Installation and Testing Procedure)	I/R				▲ Third Party Document
3.2	Electrical Equipment Installation Inspection Record	Promec / CLIENT	AEM-EL-PRO-004 (Electrical Apparatus Equipment and Support Installation Procedure)	W/R				AEM-EL-ITR-001 (General Report)
3.3	Distribution Panel Inspection & Test Record	Promec / CLIENT	AEM-EL-PRO-004 (Electrical Apparatus Equipment and Support Installation Procedure)	W/R				AEM-EL-ITR-001 (General Report)
3.4	Distribution Transformer Field Inspection Test Record	Promec / CLIENT	AEM-EL-PRO-004 (Electrical Apparatus Equipment and Support Installation Procedure)	W/R				AEM-EL-ITR-001 (General Report)
3.5	PCR Installation and Inspection	Promec / CLIENT	AEM-IN-PRO-001 (Instrumentation Installation and Testing Procedure)	W/R				AEM-IN-ITR-005A (PCR Panel Report)
3.6	Heating Device Installation Record	Promec / CLIENT	AEM-EL-PRO-004 (Electrical Apparatus Equipment and Support Installation Procedure)	I/R				AEM-EL-ITR-002 (Heating Unit Report)
3.7	Cable tray Inspection Record	Promec / CLIENT	AEM-EL-PRO-003 (Cable Tray Installation Procedure)	I/R				AEM-GE-ITR-006 (Miscellaneous Field Report)
3.8	Power/Control Cables Installation Test Record	Promec / CLIENT	AEM-EL-PRO-001 (Cable Installation and Testing Procedure)	W/R				AEM-EL-ITR-003 (Megger Cable Report) AEM-EL-ITR-004 (Continuity Test Report)
3.9	Low Voltage Cable Installation Test Record	Promec / CLIENT	AEM-EL-PRO-001 (Cable Installation and Testing Procedure)	W/R				AEM-EL-ITR-003 (Megger Cable Report)



Contract title:  
Contract number:  
Promec Ref.:

Meliadine Fuel Tanks Piping Supply and Installation  
6515-C-270-007  
C22498E

Approved on :  
Approved by:

**AGNICO EAGLE**

## Inspection and Testing Plan

ITP #  
Area  
System  
Discipline

AEM-ITP-003  
rankin inlet  
ALL  
Electrical  
Instrumentation

Approval Signature

Updated on:  
2017-04-26

**Legend**  
H - Hold  
W - Witness  
I - Inspect  
R - Review

Activity No. and CDRL Code	Activity Description (Per Scope of Work)	Responsibility Contractor and/or Sub	Acceptance Criteria	Verification Point				Verification Document(s)
				Contractor		Client		
			(Specifications, Drawings, Industry Code, Regulatory Authority, Manufacturers O&M manual, Controlling Procedure, Quality/Engineering Bulletins, Other/ Site Quality Plan, Contractor Quality Manuals, etc.)	H W I R	Initials & Date	H W I R	Initials & Date	1. List ONLY the Form(s) applicable to installation. 2. ▲ Commissioning Required Document
3.10	Instrument Cable Installation Test Record	Promec / CLIENT	AEM-EL-PRO-001 (Cable Installation and Testing Procedure)	I/R				AEM-EL-ITR-004 (Continuity Test Report)
3.11	Grounding System (Grid & Pile Grounds) Installation Inspection and Test Record	Promec / CLIENT	AEM-EL-PRO-002 (Grounding Installation and Testing Procedure)	H/R				AEM-GE-ITR-006 (Miscellaneous Field Report)
3.12	Branch cct Test Record (Lights, Receptacles, Heaters, etc.)	Promec / CLIENT	(Instrumentation Installation and Testing Procedure)	I/R				AEM-EL-ITR-001 (General Report)
3.13	Fire Alarm Panel and Device Installation Record	Promec / CLIENT	(Instrumentation Installation and Testing Procedure)	I/R				AEM-EL-ITR-001 (General Report)
3.14	Instrumentation Installation Test Record (Powered Instruments)	Promec / CLIENT	(Instrumentation Installation and Testing Procedure)	W//R				AEM-IN-ITR-003A (Level Transmitter)
								AEM-IN-ITR-004C (Pressure Switch)
								AEM-IN-ITR-006A (On/Off Valve)
								AEM-IN-ITR-001B (Flow Switch)
								AEM-IN-ITR-001C (Flow Transmitter)
AEM-IN-ITR-002A (Push Button Station)								
AEM-IN-ITR-007 (Miscellaneous Instruments)								
3.15	Instrumentation Installation Test Record (Non-powered Instruments)	Promec / CLIENT	AEM-IN-PRO-001 (Instrumentation Installation and Testing Procedure)	I/R				AEM-IN-ITR-004A (Pressure Indicator) AEM-IN-ITR-004B (Pressure Safety Valve)



**Updated on:**  
**2017-04-26**

ITP #	Area	System
-------	------	--------

**Approval Signature**

Approved on :  
Approved by:

Approved on:

Legend
H - Hold
W - Witness
I - Inspect
R - Review

PROMEC's Representatives		CLIENT's Representative	
QA/QC	Project Manager		
Name	Name	Name	
Signature	Signature	Signature	Date

**TO BE VALIDATED  
AT A LATER DATE**





## Vendor Document Status

**AGNICO EAGLE**

- 1 ☐ Proceed to next submission and status.
- 2 ☐ Proceed with exceptions as noted to next submission and status.
- 3 ☐ Do not proceed.  
Revise as noted and resubmit next submission and status.
- 4 ☒ Complete, no further submission required.

**LUC SÉNÉCAL**

**2017-07-10**

By:

Date:

Review and authorization to fabricate are only for general conformance with the design concept of the Project as expressed in the Contract Documents. Sole responsibility for the accuracy and completeness of this document, including but not limited to dimensions and quantities, remains with the Supplier/Contractor. Agnico Eagle does not warrant the accuracy or completeness of any of the information contained herein, nor does Agnico Eagle authorize or approve any construction means, methods, techniques, sequences or any safety precautions or procedures.

Agnico Eagle  
No.

6515-C-270-007-141-TES-0001 R: Sub002

**DOCUMENT FOR INFORMATION**