

Inspection and Testing Plan



Contract title: Meliadine Fuel Tanks Piping Supply and Installation
 Contract number: 6515-C-270-007
 Promec Ref.: C22466T

Approved on : _____
 Approved by: _____

Approval Signature

ITP #
 Area
 System

Discipline

AEM-ITP-001
 Rankin Inlet
 Pumping container

Mechanical
 Piping
 Structure

Updated on:
 2017-06-06

Legend

H - Hold
 W - Witness
 I - Inspect
 R - Review

Activity No. and CDRL Code	Activity Description (Per Scope of Work)	Responsibility Contractor and/or Sub	Acceptance Criteria (Specifications, Drawings, Industry Code, Regulatory Authority, Manufacturers O&M manual, Controlling Procedure, Quality/Engineering Bulletins, Other/ Site Quality Plan, Contractor Quality Manuals, etc.)	Verification Point				Verification Document(s) 1. List ONLY the Form(s) applicable to installation. 2. ▲ Commissioning Required Document
				Contractor		Client		
				H W I R	Initials & Date	H W I R	Initials & Date	
7.0	FINAL TURNOVER							
7,1	Construction Completion (Contractor Punchlist & Joint Walkdown Punchlist)	Promec / CLIENT	Quality Plan AEM-PI-PRO-002 (Pre-Commissioning Piping Procedure)	H/R		H/R		▲ AEM-GE-ITR-003 (Punchlist)
7,2	Final Acceptance of Turnover Package	Promec / CLIENT	Quality Plan	H/R		H/R		Signed ITP History Docket
7,3	Declaration of Completion	Promec	Quality Plan	H/R		H/R		AEM-GE-ITR-004 (Notice of Final Completion)
7,4	As-Built Drawings	Promec	Quality Plan	H/R		H/R		All Required As-Built Drawings
7,5	Weld Map	Promec	Quality Plan	H/R		H/R		All Required Weld Maps

PROMEC's Representatives			CLIENT's Representative	
QA/QC	Project Manager			
_____	_____			
Name	Name		Name	
_____	_____		_____	
Signature	Signature	Date	Signature	Date



Vendor Document Status

AGNICO EAGLE

- 1 ☐ Proceed to next submission and status.
- 2 ☐ Proceed with exceptions as noted to next submission and status.
- 3 ☐ Do not proceed.
Revise as noted and resubmit next submission and status.
- 4 ☒ Complete, no further submission required.

By: **JEAN-FRANCOIS TREMBLAY**

Date: **2017-06-09**

Review and authorization to fabricate are only for general conformance with the design concept of the Project as expressed in the Contract Documents. Sole responsibility for the accuracy and completeness of this document, including but not limited to dimensions and quantities, remains with the Supplier/Contractor. Agnico Eagle does not warrant the accuracy or completeness of any of the information contained herein, nor does Agnico Eagle authorize or approve any construction means, methods, techniques, sequences or any safety precautions or procedures.

Agnico Eagle
No.

6515-C-270-007-141-TES-0032 R: Sub002

DOCUMENT FOR INFORMATION

Inspection and Testing Plan



Contract title: Meliadine Fuel Tanks Piping Supply and Installation
 Contract number: 6515-C-270-007
 Promec Ref.: C22466T

Approved on : _____
 Approved by: _____

Approval Signature

ITP #
 Area
 System

Discipline

AEM-ITP-002
 Rankin Inlet
 Fuel farm

Mechanical
 Piping
 Structure

Updated on:

2017-06-06

Legend

H - Hold
 W - Witness
 I - Inspect
 R - Review

Activity No. and CDRL Code	Activity Description (Per Scope of Work)	Responsibility Contractor and/or Sub	Acceptance Criteria (Specifications, Drawings, Industry Code, Regulatory Authority, Manufacturers O&M manual, Controlling Procedure, Quality/Engineering Bulletins, Other/ Site Quality Plan, Contractor Quality Manuals, etc.)	Verification Point				Verification Document(s) 1. List ONLY the Form(s) applicable to Installation. 2. ▲ Commissioning Required Document
				Contractor		Client		
				H W I R	Initials & Date	H W I R	Initials & Date	
1.0 GENERAL								
1.1	Inspection and Test Plan	Promec / CLIENT		H/R		R		Approved ITP
1.2	Document review (Acquire and review all applicable documentation)	Promec / CLIENT	Quality Plan	H/R		R		
1.3	Procedures Submitted and Approved (Hydrostatic/Pneumatic Testing, Pre-Commissioning, etc.)	Promec / CLIENT	Quality Plan	H/R		R		All Applicable Approved Procedures
1.4	Drawing Index (IFC) to Latest Revision	Promec	Quality Plan	I/R		R		VDRL
2.0 ITP SPECIFIC								
2.1	Non-Conformance Report & Log (Both CLIENT & Contractor Issued)	Promec / CLIENT	Quality Plan	H/R		H/R		AEM-GE-ITR-002 (Non-Conformance Report) ▲ AEM-GE-LOG-002 (Non-Conformance Log)
2.2	Weld Procedures Submitted and Approved Specification/Procedure (WPS)	Promec / CLIENT	Quality Plan	H/R		R		Approved Procedure
2.3	Welders Qualification Approved	Promec / CLIENT	Quality Plan	H/R		R		Welders Qualifications Records
2.4	Inspect Material/Equipment for Damages or Deficiencies	Promec	Quality Plan	I/R		R		AEM-GE-ITR-005 (Inspection Deficiency Report) ▲ AEM-GE-LOG-004 (Inspection Deficiency Log)
3.0 Fabrication (Offsite)								
3.1	Catwalks	Promec / CLIENT / Third-Party	IFC Drawings	W/R		W/R		Third-party-report
3.2	Steel fuel tanks	Promec / CLIENT / Third-Party	6515-C-270-007-SPT-001_R3 (Technical Specifications)	W/R		W/R		Third-party-report

Inspection and Testing Plan



Contract title: Meliadine Fuel Tanks Piping Supply and Installation
 Contract number: 6515-C-270-007
 Promec Ref.: C22466T

Approved on : _____
 Approved by: _____

Approval Signature

ITP #
 Area
 System

Discipline

AEM-ITP-002
 Rankin Inlet
 Fuel farm

Mechanical
 Piping
 Structure

Updated on:

2017-06-06

Legend

H - Hold
 W - Witness
 I - Inspect
 R - Review

Activity No. and CDRL Code	Activity Description (Per Scope of Work)	Responsiblity Contractor and/or Sub	Acceptance Criteria (Specifications, Drawings, Industry Code, Regulatory Authority, Manufacturers O&M manual, Controlling Procedure, Quality/Engineering Bulletins, Other/ Site Quality Plan, Contractor Quality Manuals, etc.)	Verification Point				Verification Document(s) 1. List ONLY the Form(s) applicable to installation. 2. ▲ Commissioning Required Document
				Contractor		Client		
				H W I R	Initials & Date	H W I R	Initials & Date	
4.0	Mechanical & Piping (Offsite)							
4,1	Fabrication of piping spools	Promec / CLIENT	AEM-PI-PRO-003 (Piping Erection Procedure) AEM-WE-PRO-001 (Welding Control Procedure) CODES / STANDARDS B31,3	W/R		W/R		AEM-WE-ITR-001 (Daily Weld Report) AEM-GE-LOG-005 (Weld Log)
4,2	Painting of the piping spools (Safety Orange)	Promec / CLIENT / Third-Party	6515-GGD-022_R0 (Project Standard paint specifications) AEM-PI-PRO-003 (Piping Erection Procedure)	I/R		H/R		Third-Party Report AEM-PI-ITR-002 (Check List for Pipe Systems)
4,3	Support fabrication	Promec / CLIENT / Third-Party	IFC Drawings AEM-PI-PRO-003 (Piping Erection Procedure)	W/R		W/R		Third-Party Report AEM-PI-ITR-002 (Check List for Pipe Systems)
4,4	Perform all non-destructive examination required (NDE)	Promec / CLIENT / Third-Party	AEM-WE-PRO-002 (Non-Destructive Exam. Procedure) 5%, by ultrasound or penetrating liquid	W/R		W/R		Third-Party Report AEM-GE-LOG-005 (Weld Log)
4,5	Inspection Release prior to shipment	Promec / CLIENT	7.01_R0_Packing_Shipping_Instruct (Shipping requirements for AEM)	H/R		H/R		Partial History Docket

Inspection and Testing Plan



Contract title:
Contract number:
Promec Ref.:

Meliadine Fuel Tanks Piping Supply and Installation
6515-C-270-007
C22466T

Approved on :
Approved by:

Approval Signature

ITP #
Area
System
Discipline

AEM-ITP-002
Rankin Inlet
Fuel farm
Mechanical
Piping
Structure

Updated on:
2017-06-06

Legend

H - Hold
W - Witness
I - Inspect
R - Review

Activity No. and CDRL Code	Activity Description (Per Scope of Work)	Responsibility Contractor and/or Sub	Acceptance Criteria (Specifications, Drawings, Industry Code, Regulatory Authority, Manufacturers O&M manual, Controlling Procedure, Quality/Engineering Bulletins, Other/ Site Quality Plan, Contractor Quality Manuals, etc.)	Verification Point				Verification Document(s) 1. List ONLY the Form(s) applicable to installation. 2. ▲ Commissioning Required Document
				Contractor		Client		
				H W I R	Initials & Date	H W I R	Initials & Date	
5.0	Mechanical & Piping (Onsite)							
5.1	Installation of the tanks	Promec / CLIENT	AEM-ME-PRO-002 (Fuel Tank Installation Procedure)	W/R		W/R		AEM-ME-ITR-003 (Fuel Tank Checklist)
5.2	Installation of the catwalks	Promec / CLIENT	AEM-PI-PRO-003 (Piping Erection Procedure)	I/R		I/R		AEM-ME-ITR-004 Catwalks & Stairways Checklist
5.3	Support fabrication and installation	Promec / CLIENT	AEM-PI-PRO-003 (Piping Erection Procedure)	W/R		I		AEM-PI-ITR-002 (Check List for Pipe Systems)
5.4	Piping installation	Promec / CLIENT	AEM-PI-PRO-003 (Piping Erection Procedure) AEM-WE-PRO-001 (Welding Control Procedure) CODES / STANDARDS B31,3	I/R		I/R		AEM-PI-ITR-002 (Check List for Pipe Systems)
5.5	Perform all non-destructive examination required (NDE)	Promec / CLIENT / Third-Party	AEM-WE-PRO-002 (Non-Destructive Exam. Procedure) 5%, by ultrasound or penetrating liquid	W/R		W/R		Third-Party Report AEM-GE-LOG-005 (Weld Log)
5.6	Piping Testing & Cleaning	Promec / CLIENT	AEM-PI-PRO-001 (Hydrostatic/Pneumatic Test Procedure)	H/R		H/R		▲ AEM-PI-ITR-001 (Pressure Test Report)
5.7	Identification of piping (tagging)	Promec / CLIENT	6515-C-270-007-SPT-001_R3 (Technical Specifications)	I/R		I		AEM-PI-ITR-002 (Check List for Pipe Systems)

Inspection and Testing Plan



Contract title: Melladine Fuel Tanks Piping Supply and Installation
 Contract number: 6515-C-270-007
 Promec Ref.: C22466T

Approved on : _____
 Approved by: _____

Approval Signature

ITP #
 Area
 System
 Discipline

AEM-ITP-002
 Rankin Inlet
 Fuel farm
 Mechanical
 Piping
 Structure

Updated on:
 2017-06-06

Legend

H - Hold
 W - Witness
 I - Inspect
 R - Review

Activity No. and CDRL Code	Activity Description (Per Scope of Work)	Responsibility Contractor and/or Sub	Acceptance Criteria (Specifications, Drawings, Industry Code, Regulatory Authority, Manufacturers O&M manual, Controlling Procedure, Quality/Engineering Bulletins, Other/ Site Quality Plan, Contractor Quality Manuals, etc.)	Verification Point				Verification Document(s) 1. List ONLY the Form(s) applicable to Installation. 2. ▲ Commissioning Required Document
				Contractor		Client		
				H W I R	Initials & Date	H W I R	Initials & Date	
6.0	FINAL TURNOVER							
6.1	Construction Completion (Contractor Punchlist & Joint Walkdown Punchlist)	Promec / CLIENT	Quality Plan AEM-PI-PRO-002 (Pre-Commissioning Piping Procedure)	H/R		H/R		▲ AEM-GE-ITR-003 (Punchlist)
6.2	Final Acceptance of Turnover Package	Promec / CLIENT	Quality Plan	H/R		H/R		Signed ITP History Docket
6.3	Declaration of Completion	Promec	Quality Plan	H/R		H/R		AEM-GE-ITR-004 (Notice of Final Completion)
6.4	As-Built Drawings	Promec	Quality Plan	H/R		H/R		All Required As-Built Drawings
6.5	Weld Map	Promec	Quality Plan	H/R		H/R		All Required Weld Maps

PROMEC's Representatives			CLIENT's Representative	
QA/QC	Project Manager			
_____	_____			
Name	Name		Name	
_____	_____			
Signature	Signature	Date	Signature	Date



Vendor Document Status

AGNICO EAGLE

- 1 ☐ Proceed to next submission and status.
- 2 ☐ Proceed with exceptions as noted to next submission and status.
- 3 ☐ Do not proceed.
Revised as noted and resubmit next submission and status.
- 4 ☒ Complete, no further submission required.

By: **JEAN-FRANCOIS TREMBLAY**

Date: **2017-05-08**

Review and authorization to fabricate are only for general conformance with the design concept of the Project as expressed in the Contract Documents. Sole responsibility for the accuracy and completeness of this document, including but not limited to dimensions and quantities, remains with the Supplier/Contractor. Agnico Eagle does not warrant the accuracy or completeness of any of the information contained herein, nor does Agnico Eagle authorize or approve any construction means, methods, techniques, sequences or any safety precautions or procedures.

Agnico Eagle
No.

6515-C-270-007-141-TES-0035 R: **Sub001**

DOCUMENT FOR INFORMATION



Agnico-Eagle Mines Ltd.
Contract no. 6515-C-270-007

Hydrostatic / Pneumatic Test Procedure for Piping
AEM-PI-PRO-001

Area No.: All

System No.: All

PROMEC Approvals

Prepared by: Stéphane Doré Signature:  Date: 2017-04-26

Verified by: Jérémy Duval Signature:  Date: 2017-04-26

Approved by: Éric Poulin Signature:  Date: 2017-04-26

CLIENT Approvals

Verified by: Rene Fillion Signature: Date: 2017-05-07

Approved by: Signature: Date:

Table of Contents

	<u>Page</u>
1. PURPOSE	3
2. CODES AND STANDARDS	3
3. SAFETY AND ENVIRONMENT MEASURES	3
3.1 SAFETY MEASURES DURING THE PREPARATION OF THE TEST	3
3.2 DISPOSAL OF TEST MEDIUM	3
3.2.1 Glycols Diluted with Water	4
3.2.2 Test Water Release Authorization	4
3.2.3 Liquid Disposal Documents	4
4. GENERAL	5
4.1 INTRODUCTION	5
4.2 APPLIED REGULATIONS AND STANDARDS	6
4.3 HYDROSTATIC/PNEUMATIC TEST PACKAGE	6
5. PREPARATION FOR THE PRESSURE TEST	6
5.1 SPRING SUPPORTS	6
5.2 WIRELESS COMMUNICATION	6
6. HYDROSTATIC/PNEUMATIC TEST PROCEDURE	6
6.1 SYSTEM INSPECTION	6
6.2 SYSTEM WATER FILLING, AIR VENTING, DRAINING AND FLUSHING	7
6.3 WATER REQUIREMENTS	7
6.4 INSPECTION OF THE PRESSURIZED SYSTEM	7
6.5 ACCEPTABILITY STANDARD	7
6.6 HYDROSTATIC/PNEUMATIC TEST PROCEDURE COMPLETION	8
7. WATER RELEASE COMPLETION	8
8. RESPONSIBILITIES	8
8.1 RESPONSIBILITIES AND DUTIES OF CONTRACTORS	8
8.2 SUPERVISOR OF THE HYDROSTATIC TEST PROCEDURE (CLIENT)	8
9. PNEUMATIC TEST	9

APPENDIX C – STATUS OF INSTRUMENTS DURING PRESSURE TEST

APPENDIX D – ALL APPLICABLE ITRs & LOGs



Agnico-Eagle Mines Ltd. **Hydrostatic/Pneumatic Test Procedure for Piping**

PRO Number : AEM-PI-PRO-001
Contract no. : C22466T



1. PURPOSE

This procedure provides the requirements for hydrostatic & Pneumatic pressing testing of piping system.

2. CODES AND STANDARDS

- ASME B31.1
- ASME B31.3 (CSA B 51-03)

3. SAFETY AND ENVIRONMENT MEASURES

Promec will set the organisation and implement the safety measures with the help of CLIENT's staff.

Moving proper containments, for the disposal of spilled hydrostatic fluids and any contaminated soil that results hydrostatic fluids.

All activities must be fully documented and provided to R&E.

3.1 Safety Measures during the Preparation of the Test

- Define a specific area for each pressure test.
- Make a list of authorized personnel that will have access to the area during the test.
- Advise other sub-contractors of the terms of tests and the forbidden works to be performed in the area of the test.
- Inspect temporary installations and equipment before conducting the tests to comply with current safety measures.
- Inspect and check temporary scaffolding and lights for inspection, if required.
- List all equipment that will be handled during filling, pressurizing and drainage of the system.
- Check gauge calibration list for measurement and control equipment. (Pressure test gauges shall be calibrated once every six months).
- Ensure that all the test fluids shall be stored and/or disposed of in a safe and acceptable manner.

3.2 Disposal of Test Medium

The release of hydrostatic test water in an amount of 1,000 m³, or more, requires a registration number from AENV as proof of authorization to release hydrostatic test water. Contact R&E at least one month prior to beginning testing so applications can be completed and a registration number received the following information is required for applications:

- Name, address, fax and phone numbers of the person responsible for the testing.
- Type of pipeline, storage tank or vessel.
- Legal land descriptions for the beginning and end of the pipeline section(s), storage tank or vessel to be tested.

- Total length of pipeline to be tested.
- Inside diameter of the pipeline (mm) to be tested.
- Total volume of hydrostatic test water to be used (m³).
- Source of the hydrostatic test water: groundwater, surface water, municipal, or other.
- Origin or name of source water.
- Anticipated date of withdrawal of source water.
- Location of release of test water (legal land description).
- Start and end dates for release.
- Volume of release (m³).
- Approximate rate of release(s) (m³/hr).
- Name and location of receptor: land, surface water, injection well, other.
- Additives used (MSDS sheet(s) must be included).
- A description of the treatment and mitigative methods used prior to and during release.
- A map, diagram, or air photo of the release area showing release location, receiving land, direction of receiving water flow (if applicable) and sampling locations (soil and water).

If there are any changes to the registration information after submission, R&E must be notified immediately. The application must be signed by the person responsible for the pipeline/ storage tank indicating that the testing will be done in accordance with AENV's Code of Practice.

3.2.1 GLYCOLS DILUTED WITH WATER

Glycols diluted with water may be used for hydrostatic testing, but must be properly managed so as not to spill, contaminate soils, or contaminate ground or surface waters and must be disposed off site in an environmentally safe manner. All activities must be fully documented.

3.2.2 TEST WATER RELEASE AUTHORIZATION

Upon completion of testing and prior to release, a representative grab sample of the hydrostatic test water must be obtained from the testing pipes and analyzed as specified in Appendix A – "Monitoring Requirements and Limits for Release to Land" and Appendix B – "Monitoring Requirements and Limits for Release to Receiving Water". Hydrostatic test water must not be released before to obtain R&E approval.

3.2.3 LIQUID DISPOSAL DOCUMENTS

The testing crew supervisor must compile the following information for each hydrostatic test:

- A schematic diagram and details of the monitoring and release operations, including monitoring points, holding system, conveyance system, hydrostatic test water release flow rate and area of receiving water.



Agnico-Eagle Mines Ltd.
Hydrostatic/Pneumatic Test Procedure for Piping

PRO Number : AEM-PI-PRO-001
Contract no. : C22466T



- Where the release is to receiving water, the name of the receiving water, the estimated rate of flow of the receiving water at the time of the release and photographs taken before, during and after release at the point of release and downstream of a distance of at least 100 meters from the point of release for flowing water.
- Photographs of the sampling points, holding system and conveyance system.
- Where released to land, photographs of the land taken 7 days after the release is complete.
- All analytical results obtained for the hydrostatic testing.
- All information must be retained for a minimum of 5 years after completion of the hydrostatic testing.

4. GENERAL

4.1 Introduction

As the line designation total this procedure describes the pressure tests that have to be achieved on the following systems:

CH: Chemicals
CRW: Cold Recycle Waters
CWR: Cooling water return
CWS: Cooling water supply
DW: Drinking water
FW: Fire water
IWR: Inhibited water return
HC: High pressure condensate
HRW: Hot recycle water
HS: High pressure steam
IWS: Inhibited water supply
LC: Low pressure condensate
LS: Low pressure steam
IA: Instrument Air
LLS: Low low pressure steam
MS: Medium pressure steam
UA: Utility air
UW: Utility water
WRW: Warm recycle water
DR: Drain
EQT: Equipment trim
PA: Plant air



Agnico-Eagle Mines Ltd.
Hydrostatic/Pneumatic Test Procedure for Piping

PRO Number : AEM-PI-PRO-001
Contract no. : C22466T



4.2 Applied Regulations and Standards

The pressure tests will be conducted according to standard ASME B 31.1, Article 137, and ASME B 31.3 (CSA B 51-03) - Pressure Test.

4.3 Hydrostatic/Pneumatic Test Package

The Pressure Test Package consists of:

- Piping Pressure Test Record.
- Copy of the Line Designation Table.
- A copy of the P & ID showing the lines involved.
- Isometrics drawings.
- Copy of the drawings gauges calibration sheet.
- All NDE approved.

The Pressure Test Package will be submitted to CLIENT's for review and approval to proceed prior to testing.

5. PREPARATION FOR THE PRESSURE TEST

5.1 Spring Supports

If necessary, the spring supports must be blocked before filling.

Promec will check that all pipe supports are entirely installed according to the drawings.

5.2 Wireless Communication

To ensure at all times that communications are constant between the operator of the pressurizing pump and the workers monitoring the control gauge on the highest location of the piping system installation, two ways radio communication shall be used.

6. HYDROSTATIC/PNEUMATIC TEST PROCEDURE

6.1 System Inspection

- Promec shall check pipe loop with all approved documentation:
 - NDT/PWHT.
 - Check that all specified bolts and gaskets are installed.
 - Check that all vents and drains are installed.
 - Check that all pressure connections are installed correctly.
 - Check for direction of flow through filters and strainers, traps, check valve, etc.
 - Check that all temporary pipe supports have been removed.
 - Check that all in-one valves installed are completely open and protected (secured against unauthorized closing).
 - Check that temporary spools have been installed.
 - Check test medium for conformity to requirement
 - Check pressure gauge calibration.



Agnico-Eagle Mines Ltd.

Hydrostatic/Pneumatic Test Procedure for Piping

PRO Number : AEM-PI-PRO-001
Contract no. : C22466T



AGNICO EAGLE

6.2 System Water Filling, Air Venting, Draining and Flushing

Considering that the water filling for the pressure test is done for the first time, it is necessary to flush the piping system by filling and draining. For this purpose, water from the fire hydrant will be used. If fire hydrants are not available, water shall be trucked in and pumped into the system.

Promec shall ensure that the water that flows out in the period of drainage does not contain any hazardous contaminant for the environment so it can be directly poured into the sewer. One complete fillings and flushes should be enough.

Air venting is accomplished with valves installed for this purpose on the highest locations of the tested systems.

Air venting is completed when water is flowing from the air venting valves in a continuous flow free of air bubbles.

Speckable, blind, blinds flanges, temporary pipe plug or caps will be installed at locations indicated on isometrics and/ or P & ID's drawings.

Place of nozzles for connection on pressurised pump, gauges and air venting valve are shown on schematics, which will be attached for each hydrostatic testing system. The form to be used will be developed with CLIENT.

6.3 Water Requirements

For hydrostatic test, the test fluid shall be clean filtered water that will not corrode or damage the system being tested.

Approval must be obtained from CLIENT if the test fluid is anything other than clean water.

6.4 Inspection of the Pressurized System

The hydrostatic test must be performed during at least 10 minutes.

Visual inspection is mandatory. In the case of a leakage, the inspector will visibly mark the area with paint marker.

6.5 Acceptability Standard

The pressure test procedure is considered successfully conducted when:

- The test pressure is reached and kept constant.
- No trace of cracks, leaks and changes in the shape of parts of the system have been observed during inspection.
- The verification of the written report is noted and approved by all participants witnessing the pressure test.



Agnico-Eagle Mines Ltd.
Hydrostatic/Pneumatic Test Procedure for Piping

PRO Number : AEM-PI-PRO-001
Contract no. : C22466T



6.6 Hydrostatic/Pneumatic Test Procedure Completion

A test record shall be prepared for each piping system tested and shall include the following:

- Date of test
- Identification of piping system tested
- Test fluid
- Test pressure
- Duration of test
- Test fluid temperature
- Ambient temperature
- Pressure gauge number
- Certification of results by examiner with name and signature.
- Approval by CLIENT

N.B.: For testing an austenitic stainless steel piping, checked that the chlorine is under than 50 ppm.

7. WATER RELEASE COMPLETION

When the hydrostatic test is completed, the water stay in the pipe or in a holding vessel until Promec obtains the authorization for releasing the testing fluid. After, we use a truck to transport the water to the release area or, if possible, a water disposal ditch is used.

8. RESPONSIBILITIES

8.1 Responsibilities and Duties of Contractors

Promec's working team shall be responsible for the quality of work and for the compliance of the test procedure. Complete activities shall be registered in the hydrostatic test procedures log book. During the hydrostatic test, Promec shall provide a working team to cover the following activities:

- Water filling and air venting of system under test.
- Pressurizing of system.
- Control of pressure at highest point of system.
- Drainage of system after testing.

8.2 Supervisor of the Hydrostatic Test Procedure (CLIENT)

The hydrostatic test supervisor shall be nominated by CLIENT and coordinate the work with all other participants.



Agnico-Eagle Mines Ltd.

Hydrostatic/Pneumatic Test Procedure for Piping

PRO Number : AEM-PI-PRO-001
Contract no. : C22466T



AGNICO EAGLE

9. PNEUMATIC TEST

Wherever a hydrostatic test cannot be performed, a pneumatic test should be carried out upon CLIENT's approval.



Agnico-Eagle Mines Ltd.
Hydrostatic/Pneumatic Test Procedure for Piping

PRO Number : AEM-PI-PRO-001
Contract no. : C22466T



Appendix C

STATUS OF INSTRUMENTS DURING PRESSURE TEST

STATUS OF INSTRUMENTS DURING PRESSURE TEST

Remove:

- Control Valves
- Flow Instruments-Rotameters (Do not force reverse flow)
- Flow Meters-positive displacement type
- Flow Switches-van type
- Orifice Plates (Install after hydrotesting and line flushing)
- Pressure Regulators
- PSV's, TSV's- 3/4" & 1 " screwed

Block and Vents:

- Analyzers
- Flow Instruments-D/P cell & bellow types
- Flow Meters – turbine type
- Flow Indicating Switches-bellows type
- Level Instruments-C/P cell & bellows type
- Pressure Gauges
- Pressure Instruments-all types
- Pressure Switches

Blind Off:

- PSV's (Test gauge may be used if one is furnished; Blinds not required on PSV outlets discharging into a system being tested at 103kPa (15 PSI) or less.)

Include in Test:

- Gauge glasses
- Level Instruments-displacer type (Do not overpressure. If in doubt, block and drain instead.)
- Level Switches-float type (Do not overpressure. If in doubt, block and drain instead.)

To avoid damage due to freezing, all instruments shall be protected. As a good practice it is recommended that instruments be drained and process lead lines blown out with air or nitrogen in preparation for cold weather and during cold weather.



Agnico-Eagle Mines Ltd.
Hydrostatic/Pneumatic Test Procedure for Piping

PRO Number : AEM-PI-PRO-001
Contract no. : C22466T



Appendix D

ALL APPLICABLE ITRs & LOGs



Vendor Document Status

AGNICO EAGLE

- 1 ☐ Proceed to next submission and status.
- 2 ☐ Proceed with exceptions as noted to next submission and status.
- 3 ☐ Do not proceed.
Revise as noted and resubmit next submission and status.
- 4 ☒ Complete, no further submission required.

By:

JEAN-FRANCOIS TREMBLAY

JG

Date:

2017-05-16

Review and authorization to fabricate are only for general conformance with the design concept of the Project as expressed in the Contract Documents. Sole responsibility for the accuracy and completeness of this document, including but not limited to dimensions and quantities, remains with the Supplier/Contractor. Agnico Eagle does not warrant the accuracy or completeness of any of the information contained herein, nor does Agnico Eagle authorize or approve any construction means, methods, techniques, sequences or any safety precautions or procedures.

Agnico Eagle
No.

6515-C-270-007-141-TES-0036 R: Sub001

DOCUMENT FOR INFORMATION



Agnico-Eagle Mines Ltd.
Contract no. 6515-C-270-007

Pre-Commissioning Piping Procedure
AEM-PI-PRO-002

Area No.: All

System No.: All

PROMEC Approvals

Prepared by: Stéphane Doré Signature:  Date: 2017-04-26

Verified by: Jérémy Duval Signature:  Date: 2017-04-26

Approved by: Éric Poulin Signature:  Date: 2017-04-26

CLIENT Approvals

Verified by: _____ Signature: _____ Date: _____

Approved by: _____ Signature: _____ Date: _____

Table of Contents

	Page
1. SCOPE.....	3
2. "SYSTEMS" METHODOLOGY.....	3
2.1 SYSTEM DEFINITION.....	3
3. PRE-COMMISSIONING	3
3.1 MECHANICAL COMPLETION (MC).....	3
3.1.1 <i>Conformity Check</i>	3
3.1.2 <i>Energized tests</i>	3
3.1.3 <i>Flushing and cleaning</i>	4
4. PUNCH LIST	4
5. RESPONSIBILITY MATRIX.....	4

APPENDIX A – RESPONSIBILITY MATRIX

1. SCOPE

This procedure summarizes Promec activities to achieve a "Ready for Pre-commissioning" status.

2. "SYSTEMS" METHODOLOGY

The basic principle of the plant completion scheduling will be to define, prepare, carry out and report all pre-commissioning by system.

2.1 System Definition

The partition of the plant into systems is a key preparation activity that has a major impact on all aspects of completion operation: the system must be defined so as to be independent as possible, not too small, but of the manageable size and exactly adapted to the start-up sequence.

The partition takes place as early as possible in accordance with precise system boundaries, system sequences and system numbering defined by the client and reported on marked-up P & ID's Single Line Diagrams as support documents.

3. PRE-COMMISSIONING

3.1 Mechanical Completion (MC)

A walk-down and punch list will be completed by the client and Promec on each system as early as practical before the end of the MC.

If both parties are satisfied that the system is mechanically completed enough to go into the commissioning phase, all outstanding deficiencies are noted on the punch list, and handover documents are completed and signed.

3.1.1 CONFORMITY CHECK

Carried out on each item of equipment or component, such as pressure gauges, valves, vents and drains, safety vales, etc. to verify the condition of the equipment, the quality of the installation, the compliance with project drawings and specifications, manufacturer's instruction, safety rules, codes, standards and good practice. These activities are generally carried out in an "un-energized" state, like no pressure in the pipe.

3.1.2 ENERGIZED TESTS

These "energized" tests concern the pressure testing of piping. This pressure testing will need to be done using the approved Promec's Procedure.

3.1.3 FLUSHING AND CLEANING

Piping systems must be flushed or air blown to remove construction debris. Under special circumstances, the client's approval is required to combine the hydrostatic/pneumatic test with the flushing activities.

4. PUNCH LIST

While the construction checks and tests are being performed, all discrepancies, damaged or missing equipment, malfunctions, missing documents, etc. are recorded in the punch list, if the situation was not able to be corrected immediately.

5. RESPONSIBILITY MATRIX

The Completion Activities are now further defined in the following Appendix A - "Responsibility Matrix".

This matrix provides a useful list of the piping completion activities and it establishes to which category they belong pre-commissioning (de-energized) and pre-commissioning (under-pres).

Appendix A

RESPONSIBILITY MATRIX



Agnico-Eagle Mines Ltd.
Pre-Commissioning Piping Procedure

PRO Number : AEM-PI-PRO-002
Contract no. : C22466T



Responsibility Matrix	Contractor Responsibility	CLIENT Responsibility
LEGEND		
X = Contractor responsibility	X	
O = CLIENT responsibility		O
A = CLIENT approval hold point		A
W = CLIENT witness notification		W
R = CLIENT documentation review		R

CLIENT's APPROVAL HOLD POINT (A)

When Promec is ready to pre-commission any part of any system, which is identified as requiring CLIENT's approval, Promec shall duly notify CLIENT's representative, with 4 days written notification. Timely Review Meetings shall also be conducted between Promec's Pre-commissioning Manager and CLIENT's Commissioning Representative for the purpose of advising CLIENT on the specific Status/ Timing of all Pre-Commissioning Activities Requiring CLIENT's approval.

CLIENT WITNESS POINT (W)

When Promec is ready to pre-commission any part of any system, which is identified as requiring CLIENT witness, Promec shall duly notify CLIENT's Representative, with two days written notification. Timely review meetings shall also be conducted between Promec's QA/QC and CLIENT's Commissioning Representative for the purpose of advising CLIENT on the specific status/ timing of all pre-commissioning activities requiring CLIENT witness.

CLIENT DOCUMENTATION REVIEW (R)

When Promec has drafted the pre-commissioning procedures, descriptive and operating manuals, maintenance manuals, system schedules, and/or related final documentation etc. pertaining to pre-commissioning of any system, Promec shall formally issue via transmittal to CLIENT's Representative, for review & comment purposes. These documents must be received by CLIENT 14 days in advance of final issue.

NOTES:

CLIENT Signatures on Pre-commissioning Documentation

CLIENT's Representative in attendance will personally sign only for the relevant Pre-commissioning Documentation for which he/she approves, witnesses or reviews.

Functional Test Certificates & CLIENT Signatures

Upon completion of a functional test and proven that it has been successful when referring to the Contract requirements, CLIENT and Promec representatives will sign the test certificate.



Agnico-Eagle Mines Ltd.
Pre-Commissioning Piping Procedure

PRO Number : AEM-PI-PRO-002
 Contract no. : C22466T



Ready for Commissioning Standard				
PIPING	Pre-Com De-energized	Pre-Com Energized	Comm.	Start- Up
1) Issue Piping Flushing & Cleaning Procedures	XR			
2) Complete Vendor Package Piping Punch Lists	XA			
3) Maintain As-Built/ Red Line Mark-Ups of P&IDS	XA			
4) Remove all In-Line Instruments prior to Hydro-Testing/Flushing & Cleaning including CA/s, Check & Safety Valves	X			
5) Remove all temporary supports, protections, bracings, sea fastening stops that were installed to prevent equipment damage during shipping, storage and erection	X			
6) Install temporary spool pieces	X			
7) Check conditions of equipment, quality of installation, compliance with Project Drawings, Manufacturers instructions, safety rules, specifications, structural supports, and good practice prior to hydrotest	XA			
8) Hydrostatic test / Pneumatic test		X		
9) Set or check pipe anchors, guides, spring hangers and supports after hydrotest. Provide cold and hot setting data	XR			
10) Define, provide, install and remove all temporary blanks and flushing connections.	X			
11) Execute & Perform Piping Flushing & Cleaning/ Pickling/ Air Blows and Draining as per the Approved Procedures (Except Steam Blows)		XA		
12) Execute & Perform Critical Body & Seat Testing TSO Valves at Site of All ESD, BDV		XA		
13) Carry out piping water or air flushing operations		XA		
14) Drain all lines including low points	XA			
15) Provide and Install all Permanent Blinds, Spacers, & Spades as per P&ID's in open/closed position as specified by CLIENT	XW			
16) Disposal of Test Medium following Hydro-Testing/ Flushing & Cleaning	XW			
17) Remove as necessary and transport all safety valves to and from test facilities	XW			



Agnico-Eagle Mines Ltd.
Pre-Commissioning Piping Procedure

PRO Number : AEM-PI-PRO-002
 Contract no. : C22466T



Ready for Commissioning Standard				
PIPING	Pre-Com De-energized	Pre-Com Energized	Comm.	Start- Up
18) Test, set and tag all safety valves, then carry out safety valves final installation		XW		
19) Perform all Gross Leak Tests Tightness & Service Tests (above & under ground)		X		
20) Remove all Temporary Blinds	X			
21) Supply/ Install & Issue As-Installed Blind List	XR			
22) Compile & Issue RFC Handover Package per System	XR			
23) Alleviate any excess piping stresses that may be imposed on pipes, compressors or pump flanges	XA			
24) Check packing and packing materials and lubrication of valves; repack and lubricate if necessary	XW			
25) Install corrosion probes	XA			
26) Prepare Punch List	XR			



Vendor Document Status

AGNICO EAGLE

- 1 ☐ Proceed to next submission and status.
- 2 ☐ Proceed with exceptions as noted to next submission and status.
- 3 ☐ Do not proceed.
Revise as noted and resubmit next submission and status.
- 4 ☒ Complete, no further submission required.

By:

JEAN-FRANCOIS TREMBLAY

Date:

2017-06-09

Review and authorization to fabricate are only for general conformance with the design concept of the Project as expressed in the Contract Documents. Sole responsibility for the accuracy and completeness of this document, including but not limited to dimensions and quantities, remains with the Supplier/Contractor. Agnico Eagle does not warrant the accuracy or completeness of any of the information contained herein, nor does Agnico Eagle authorize or approve any construction means, methods, techniques, sequences or any safety precautions or procedures.

Agnico Eagle
No.

6515-C-270-007-141-TES-0037 R: Sub002

DOCUMENT FOR INFORMATION



Table of Contents

	<u>Page</u>
1. PURPOSE.....	3
2. PREREQUISITE	3
3. CODES AND STANDARDS.....	3
4. FIELD FABRICATION.....	3
4.1 PIPING	3
4.2 INTERNAL MISALIGNMENT	4
4.3 FLANGES AND FITTINGS	4
4.4 REINFORCING PADS.....	4
4.5 PIPING VERIFIED AGAINST THE ISOMETRIC DRAWINGS	5
4.6 FABRICATION TOLERANCES	5
5. ERECTION AND INSTALLATION	5
5.1 ERECTION.....	5
5.2 INSTALLATION	5
5.2.1 General.....	5
5.2.2 Flange Bolting.....	5
5.2.3 Supports.....	6
5.2.4 Branch Connections.....	6
5.2.5 Cleanliness of Piping.....	6
5.2.6 Field Pressure Testing.....	6

APPENDIX A – ALL APPLICABLE ITRs & LOGs



Agnico-Eagle Mines Ltd. Piping Erection Procedure

**PRO Number : AEM-PI-PRO-003
Contract no. : C22466T**



1. PURPOSE

The purpose of this procedure is to specify the requirements for erection, joining and installation of shop fabricated spools. It will ensure that the right piece of pipe is installed at the right location and complies with the codes, standards, and isometric drawings.

2. PREREQUISITE

The following measures shall be taken before starting works:

- All technical documents are available (latest version):
 - Isometric drawings.
 - Line lists.
 - General Arrangement drawings.
- No other work is achieved on the same place of work.
- Piping spools and piping equipment have been identified and inspected.
- Transportation equipment and lifting equipment are available.
- Tools, lifting equipment, levelling equipment, etc. are available and have been inspected.

3. CODES AND STANDARDS

n/a

4. FIELD FABRICATION

4.1 Piping

Fabricator shall shape or bevel the joints to be field welded.

Adjacent sections of longitudinal welded pipe that are joined by butt welding shall have the longitudinal weld seams positioned so that they are at least 30 degrees apart and above the horizontal centerline.

Wherever possible, Promec shall not position the longitudinal weld seam on the top or bottom of the line so that branch connections such as couplings and stub-ons are located on the seam.



Agnico-Eagle Mines Ltd. Piping Erection Procedure

**PRO Number : AEM-PI-PRO-003
Contract no. : C22466T**



4.2 Internal Misalignment

Internal misalignment criteria shall be governed by the following:

- Pipe-to-pipe or pipe-to-fitting NPS (Nominal Pipe Size) 24 and smaller: $\pm 1/16$ of an inch deviation.
- Pipe-to-pipe or pipe-to-fitting NPS 26 and larger: $\pm 1/8$ of an inch deviation.
- If the deviation factors are exceeded, one of the following procedures shall be used:
 - Rotate the pipe or fittings to reduce misalignment to the acceptable tolerances (before attempting any of the following methods).
 - Use spreaders or internal or external lineup clamps to correct moderate out-of round condition.
 - Backweld the root pass.
 - Taper the wall of the component internally, after obtaining approval from the client, to ensure wall thickness is not reduced below the minimum required by the code.

4.3 Flanges and Fittings

Flange bolt holes are to be oriented as follows, unless otherwise indicated on the piping drawings:

- Flange face vertical: bolt holes to straddle vertical centerline.
- Flange face horizontal: bolt holes to straddle north-south centerline.
- Orifice flanges shall be fabricated with the taps in the exact orientation shown on the piping drawings. The up and down stream sections of pipe to which the orifice flanges are attached may be standard mill run pipe, but each piece shall be a choice hand-selected piece, and the interior of the pipe shall be round, smooth, and free from blisters and scale; welds shall be grounded flush. Field welds shall be kept at a maximum distance from the face of the orifice.
- Where line taps and 'olets are required, first attach the connection fitting then, the hole for each line tap shall be drilled square to the axial centerline, clean, sharp, and free from burrs, wire edges, or other irregularities.
- Slip-on flanges shall be welded inside and outside. Refer to Figure 328.5.2B of ASME B31.3. The weld shall be applied so that the flange face shall be free of weld spatter and does not require refacing.

4.4 Reinforcing Pads

Reinforcing pads shall be installed only where called for on the piping drawing. Pad material shall be the same as the pipe material, unless otherwise authorized by the client. Drawing will specify size and pad thickness.



Agnico-Eagle Mines Ltd. Piping Erection Procedure

**PRO Number : AEM-PI-PRO-003
Contract no. : C22466T**



4.5 Piping verified against the isometric drawings

Check that the position of the piping satisfied the isometric drawings informations: level, horizontal and vertical measurement, etc.

4.6 Fabrication Tolerances

The fabrication tolerances for fabricated piping shall be in accordance with client's specifications and standards.

5. ERECTION AND INSTALLATION

5.1 Erection

The following equipment will be used at different steps during pipe erection works: slings, shackles, mechanical or hydraulic jacks, come-along, measuring tapes, laser tool, temporary supports, boom trucks, etc.

5.2 Installation

5.2.1 GENERAL

Except where shown otherwise on the drawings, piping shall conform to the following:

- Be run level and plumb.
- Be run on North-South and East-West axis.

Evaluation of piping installation works sequence:

- Preparation of pipe to be welded: bevels, cleanliness, etc.
- Mounting of spools at ground level.
- Evaluation of how to handle the spools.
- Lifting of spools to their final location.
- Welding or assembling of spools.
- Identification of the welds.
- Installation of temporary supports.
- Etc.

Interior cleaning of piping:

- Marine Line, cleaning will be perform by pigging.
- Diesel Line (fuel farm and pumping station), cleaning will be perform by air blowing.

5.2.2 FLANGE BOLTING

Use a logical sequence of bolt tightening to ensure even gasket compression, as indicated in ASME B16.5



Agnico-Eagle Mines Ltd. Piping Erection Procedure

**PRO Number : AEM-PI-PRO-003
Contract no. : C22466T**



Unless specified otherwise, provide a bolt stress of 30,000 psi minimum or 45,000 psi maximum using a lubricant on the bolt threads (Refer to AEM-PI-PRO-004 Flanges Bolting Procedure).

Prior to bolt-up, examine flange faces. Flange faces shall be in as-new condition, and shall be wiped clean of any debris, excess oil, grease, and dirt. Restore damaged flange faces to as-new condition. Do not perform weld repairs on flange faces or flanges.

Do not use washers or spacers to make up bolt length. Bolt lengths are specified to prevent oversizing.

5.2.3 SUPPORTS

Install supports as indicated on the drawings.

Install spring supports in compliance with Manufacturer's instructions; keep them blocked until after line closure and hydrotest. Adjust them in the installed position and check them when operating conditions are reached.

Install all required temporary supports for hydrostatic testing.

Welding of supports shall be as indicated on the drawings.

5.2.4 BRANCH CONNECTIONS

Take care in shaping the ends of branch nozzles, as well as holes burned into the pipe for branch connections, to ensure fit with suitable provision for weld metal and so that the branch connections do not project inside the pipes.

5.2.5 CLEANLINESS OF PIPING

Open-end and flange protection shall be used throughout installation. Protect open pipes at times when work on them is not actually taking place.

Inspect individual pipe sections, prefabricated spools, and pipeline items internally during installation, and remove any foreign matter before final welding or bolting.

Piping contiguous with special equipment, which requires cleaning to the equipment Manufacturer's procedure, shall be inspected by and have cleaning supervised by the Manufacturer's representative.

5.2.6 FIELD PRESSURE TESTING

Testing of installed piping systems shall be in accordance with the previously referenced standards. (Refer to AEM-PI-PRO-001 Hydrostatic-Pneumatic Test Procedure for Piping).



**Agnico-Eagle Mines Ltd.
Piping Erection Procedure**

PRO Number : AEM-PI-PRO-003
Contract no. : C22466T



AGNICO EAGLE

Appendix A

ALL APPLICABLE ITRs & LOGs



Vendor Document Status

AGNICO EAGLE

- 1 ☐ Proceed to next submission and status.
- 2 ☐ Proceed with exceptions as noted to next submission and status.
- 3 ☐ Do not proceed.
Revise as noted and resubmit next submission and status.
- 4 ☒ Complete, no further submission required.

By: **JEAN-FRANCOIS TREMBLAY**

Date: **2017-06-22**

Review and authorization to fabricate are only for general conformance with the design concept of the Project as expressed in the Contract Documents. Sole responsibility for the accuracy and completeness of this document, including but not limited to dimensions and quantities, remains with the Supplier/Contractor. Agnico Eagle does not warrant the accuracy or completeness of any of the information contained herein, nor does Agnico Eagle authorize or approve any construction means, methods, techniques, sequences or any safety precautions or procedures.

Agnico Eagle
No.

6515-C-270-007-141-TES-0033 R: Sub002

DOCUMENT FOR INFORMATION



Table of Contents

	<u>Page</u>
1. SCOPE.....	3
2. PREREQUISITE	3
3. VISUAL INSPECTION AND PREPARATION	3
4. LEVELLING AND FIXING	3
5. PUMP AUXILIARIES INSTALLATION	4
6. PIPING INSTALLATION	4
7. PRE-COMMISSIONING	4
8. FINAL ACCEPTANCE	4

APPENDIX A – ALL APPLICABLE ITRs & LOG



Agnico-Eagle Mines Ltd. Pump Installation Procedure

**PRO Number : AEM-ME-PRO-001
Contract no. : C22466T**



1. SCOPE

This procedure provides primary inspection and installation requirements pertaining to the pumps installation.

2. PREREQUISITE

- Relevant isometric drawings are up-to-date.
- Shop drawings, vendor manuals and technical specs up-to-date.
- Preservation and storage plan in place.
- Relevant team mobilized and ready.
- Pump Installation Procedure prepared and approved.
- Materials and tools available with calibration certificates and calibration log entries.

3. VISUAL INSPECTION AND PREPARATION

- Check equipment skid for any sign of damage prior to installation.
- Begin preservation program.
- Verify elevation and centerlines are correct and are clearly marked on foundation.
- Pump installation includes foundation preparation, confirmation of center lines and elevations, preliminary alignment, machinery distortion to be checked at piping bolt up, soft foot check, final alignment, flushing and recharging of lubricants (pump, gear-box, drivers and lube oil tanks) in accordance with the manufacturer's recommendations.
- Mark appropriately on the foundation the jacking screw pads and anchor bolts locations.
- Jack-up equipment skid with external jacks to allow jacking screws pads installation and secure it with temporary supports.
- Circular jackscrew leveling plate shall be made of 2-inche diameter, 12 mm thick, CSA grade 300 Structural Steel Plate, or equivalent type round stock material. The plate shall be clean and free of all scale and oil will be readjusted.

4. LEVELLING AND FIXING

- Install the jacking bolts in their respective screw location. Use the installed jacking bolts to bring the skid to the designed elevation. Ensure that pump nozzles are in proper orientation on the centerlines.
- Level the skid properly with an accurate leveling instrument using the equipment base machined faces. Align and adjust the pumps inlet and outlet flanges with the relevant pipe centerlines.
- After base plate leveling first alignment shall be performed. Soft-foot tolerance and coupling gaps shall be checked while the alignment is being confirmed. Coupling gap to be confirmed.



**Agnico-Eagle Mines Ltd.
Pump Installation Procedure**

PRO Number : AEM-ME-PRO-001
Contract no. : C22466T



5. PUMP AUXILIARIES INSTALLATION

- Lube oil console is brought to design elevation and centerlines by the use of stainless steel shims and external lifting.
- Lube oil piping is loosely installed to verify best position.
- Electrical and instrumentation will be done by those disciplines using the relevant ITP's and procedures.

6. PIPING INSTALLATION

- Piping will be cleaned and installed by the piping discipline.
- Interconnecting lube oil piping, cooling water, suction / discharge and steam piping will be subject to fit up measurements. Pipe strain measurements and adjustment shall be carried out.
- Seal flushing lines to be cleaned and connected.
- Distortion due to piping stress: If distortion exceeds allowances, piping alignment shall be re-worked and re-checked.
- All piping that is attached to the equipment for the purpose of field welding will be electrically isolated from the equipment by use of isolating kits.
- A final pipe strain check will be performed and recorded.

7. PRE-COMMISSIONING, (AEM STD TO APPLY, TO BE DETAILED BY AEM)

- If applicable, vendor presence requirements shall be requested prior to final work.
- Lube oil pipe strain to be witnessed
- Lube oil system to be flushed.
- Steam pipe blowing to be done by piping discipline.
- Running oil to be installed in lube oil console and pump bearing sumps.
- Motor bump test (uncoupled) to verify rotation will be performed on electric motor drive units.
- Final alignments with cold offsets to be witnessed.
- Pipe strain checks of steam lines and pump suction / discharge lines to be witnessed.
- All couplings and guards to be in place.
- Touch up painting will be completed.
- Mark in red on isometric drawing copy all final dimensions for as-built drawing preparation.

8. FINAL ACCEPTANCE, (AEM STD TO APPLY, TO BE DETAILED BY AEM)

- All inspection test records along with preservation records will be verified for handover to the turnover coordinator, along with relevant RFI's, NCR's and field trouble reports.
- A final punchlist will be cleared with no outstanding NCR's.
- Upon completion of work, final acceptance shall be obtained from CLIENT.



**Agnico-Eagle Mines Ltd.
Pump Installation Procedure**

PRO Number : AEM-ME-PRO-001
Contract no. : C22466T



AGNICO EAGLE

Appendix A

ALL APPLICABLE ITRs & LOGs



Vendor Document Status

AGNICO EAGLE

- 1 ☐ Proceed to next submission and status.
- 2 ☐ Proceed with exceptions as noted to next submission and status.
- 3 ☐ Do not proceed.
Revise as noted and resubmit next submission and status.
- 4 ☒ Complete, no further submission required.

By: JEAN-FRANCOIS TREMBLAY

Date: 2017-05-02

Review and authorization to fabricate are only for general conformance with the design concept of the Project as expressed in the Contract Documents. Sole responsibility for the accuracy and completeness of this document, including but not limited to dimensions and quantities, remains with the Supplier/Contractor. Agnico Eagle does not warrant the accuracy or completeness of any of the information contained herein, nor does Agnico Eagle authorize or approve any construction means, methods, techniques, sequences or any safety precautions or procedures.

Agnico Eagle
No. 6515-C-270-007-141-TES-0034 R: Sub001

DOCUMENT FOR INFORMATION



Agnico-Eagle Mines Ltd.
Contract no. 6515-C-270-007

Fuel Tank Installation Procedure
AEM-ME-PRO-002

Area No.: All

System No.: All

PROMEC Approvals

Prepared by: Stéphane Doré Signature: [Signature] Date: 2017-04-26

Verified by: Jérémy Duval Signature: [Signature] Date: 2017-04-26

Approved by: Éric Poulin Signature: [Signature] Date: 2017-04-26

CLIENT Approvals

Verified by: _____ Signature: _____ Date: _____

Approved by: _____ Signature: _____ Date: _____

Table of Contents

	<u>Page</u>
1. SCOPE	3
2. PREREQUISITE.....	3
3. VISUAL INSPECTION AND PREPARATION.....	3
4. LEVELING AND FIXING	3
5. AUXILIARIES INSTALLATIONS & INSPECTION.....	3
6. PRE-COMMISSIONING.....	3
7. TOUCH-UP PAINTING	4
8. FINAL ACCEPTANCE.....	4

APPENDIX A – ALL APPLICABLE ITRs & LOGs



Agnico-Eagle Mines Ltd.
Fuel Tank Installation Procedure

PRO Number : AEM-ME-PRO-002
Contract no. : C22466T



1. SCOPE

- This procedure provides inspection steps and requirements pertaining to a fuel tank.
- Each package is composed of a single unit.

2. PREREQUISITE

- Relevant isometric drawings are up-to-date.
- Shop drawings, vendor's manual and technical specs up-to-date.
- Relevant team mobilized and ready.
- Pertaining material and tools are prepared and ready.

3. VISUAL INSPECTION AND PREPARATION

- Check equipment for any sign of damage prior to installation.
- Mark on the foundation center lines and elevation references.
- If required, clean the foundation and skid exposed surfaces using compressed air.

4. LEVELING AND FIXING

- Jack up the equipment skid using external jacks keeping the skid level up to design elevation and center lines.
- Level the skid properly with an accurate leveling instrument. Align and adjust vessels inlet and outlet flanges with the relevant pipe axes (see relevant isometric drawing).
- Leveling shims shall to be installed on both sides of each anchor bolt. Wherever the distance between adjacent anchor bolts exceed 800 mm, additional leveling pads shall be installed midway between the anchor bolts.

5. AUXILIARIES INSTALLATIONS & INSPECTION

- External-Interconnecting pipes to be installed. Promec piping ITP to be followed for piping gaskets, studs and flange bolt-up.
- Internal inspection and cleaning to be performed if required.
- Instrumentation installation and verification to be performed by Promec instrumentation team.
- Complete equipment closing record form.

6. PRE-COMMISSIONING

- Follow vendor's operation manual procedure.



Agnico-Eagle Mines Ltd.
Fuel Tank Installation Procedure

PRO Number : AEM-ME-PRO-002
Contract no. : C22466T



7. TOUCH-UP PAINTING

- Touch up painting shall be carried out on surfaces that have scratches or scrapes or other damages that have occurred during transportation and installation (paint is supplied by equipment vendor).

8. FINAL ACCEPTANCE

- All inspection and test records to be reviewed for completeness and securely filed for hand-over to turnover coordinator.
- Upon completion of works, final acceptance shall be obtained from the client.



Agnico-Eagle Mines Ltd.
Fuel Tank Installation Procedure

PRO Number : AEM-ME-PRO-002
Contract no. : C22466T



Appendix A

ALL APPLICABLE ITRs & LOGs



Vendor Document Status

AGNICO EAGLE

- 1 ☐ Proceed to next submission and status.
- 2 ☐ Proceed with exceptions as noted to next submission and status.
- 3 ☐ Do not proceed.
Revise as noted and resubmit next submission and status.
- 4 ☒ Complete, no further submission required.

By: JEAN-FRANCOIS TREMBLAY

Date: 2017-05-02

Review and authorization to ~~fabricate~~ are only for general conformance with the design concept of the Project as expressed in the Contract Documents. Sole responsibility for the accuracy and completeness of this document, including but not limited to dimensions and quantities, remains with the Supplier/Contractor. Agnico Eagle does not warrant the accuracy or completeness of any of the information contained herein, nor does Agnico Eagle authorize or approve any construction means, methods, techniques, sequences or any safety precautions or procedures.

Agnico Eagle
No.

6515-C-270-007-141-TES-0038 R: Sub001

DOCUMENT FOR INFORMATION





Agnico-Eagle Mines Ltd.
Contract no. 6515-C-270-007

Welding Control Procedure
AEM-WE-PRO-001

Area No.: All

System No.: All

PROMEC Approvals

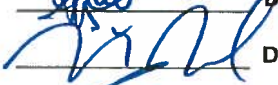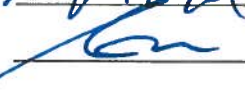Prepared by:	<u>Stéphane Doré</u>	Signature:		Date:	<u>2017-04-26</u>
Verified by:	<u>Jérémy Duval</u>	Signature:		Date:	<u>2017-04-26</u>
Approved by:	<u>Éric Poulin</u>	Signature:		Date:	<u>2017-04-26</u>

CLIENT Approvals

Verified by:	_____	Signature:	_____	Date:	_____
Approved by:	_____	Signature:	_____	Date:	_____

TABLE OF CONTENTS

	<u>Page</u>
1. SCOPE	3
2. REFERENCES	3
3. WELDING PROCEDURES	3
4. WELDER PERFORMANCE QUALIFICATION	3
5. WELDING MATERIAL CONTROL	4
6. FIT-UP AND WELDING	4
7. RADIOGRAPHIC INSPECTION	5

APPENDIX A – ALL APPLICABLE ITRs & LOGs

1. Scope

- This procedure describes the system for maintaining control of all production welding to the requirements of the applicable engineering specifications, codes and standards.

2. References

- ASME, Section IX - Welding and Brazing Qualifications
- ANSI, B-31.3 - Petroleum Refinery Piping
- ANSI, B-31.1 - Power Piping
- AWS, American Welding Society

3. Welding Procedures

- All welding performed on site will comply with applicable qualified welding procedures as specified in the Standard S40 05 13.
- Prime contractor's welders will be qualified to weld procedures in accordance with contract specifications. Prime contractor is responsible for certifying their own welders.
- Copies of the qualified welding procedures approved for that project shall be maintained on site by the Welding Foreman and Site Q/C Representative for reference and permanent retention.

4. Welder Performance Qualification

- It is the responsibility of the Site Q/C Representative to conduct or supervise the Welder Performance Qualification tests. At the discretion of the Corporate Quality Control Manager, a Welding Foreman or other qualified site supervisor may conduct these tests.
- Records attesting to the Welder Performance Qualification tests shall be generated and maintained by the Site Q/C Representative and the Welding Foreman.
- The Site Q/C Representative and the Welding Foreman shall maintain a complete listing of welders and welding operators employed. The form, Welder Qualification Log, is to be updated and reissued on a monthly basis and is to be distributed as required.

5. Welding Material Control

- The Site Q/C Representative and Welding Foreman shall make certain that the welding material used conforms to that of the welding procedure. No substitutions for the specified material will be made without written approval from the client.

6. Fit-Up and Welding

- Visual surveillance shall be performed to establish compliance to welding procedures. The inspection parameters listed below are recommended as guidelines
 - ✓ Inspect end preparation and joint configuration as established by applicable weld procedures and engineering specifications.
 - ✓ Inspect internal alignment and root opening prior to welding.
 - ✓ Check tack welds that are to be incorporated into the final weld, and be assured of proper blend grinding and absence of visual defects.
 - ✓ Check for proper welding materials and other essential variables of applicable weld procedures.
 - ✓ Check visually root pass for cracks, porosity, slag, fusion lines and quality workmanship (if required use LP).
 - ✓ Inspect completed welds for proper reinforcement. All welds should blend smoothly into the base metal and be free of cold lap or fusion at the toe.
 - ✓ Inspect weld for surface discontinuities such as undercut. Surface porosity is to be considered as an injurious defect and shall be repaired.
 - ✓ All repairs are to be made in accordance with approved procedures.
 - ✓ Each welder shall be responsible for stamping his assigned symbol immediately after completion of the weld. A smooth, flat spot shall be ground or filed on the reinforcement cap. The welder shall stamp his/hers identifying mark upon this spot.
- For ferrous material less than 1/4" (1/2" for nonferrous), the welder's symbol shall be recorded on the base metal by use of a halogen-free paint marker, or recorded on isometric drawings by the welding supervisor which shall be available to the Quality Control Inspector.



**Agnico-Eagle Mines Ltd.
Welding Control Procedure**

**PRO Number : AEM-WE-PRO-001
Contract no. : C22466T**



7. Radiographic Inspection

- The Site Q/C Representative or Welding Foreman will schedule radiographic inspections.
- Radiographic requirements shall be determined by the client standard to assure compliance to contract Codes and specifications.
- Welds requiring radiography will be flagged by a suitable means which will be consistent through contract completion.
- The Site Q/C Representative will complete the Radiographic Inspection Status Record, to indicate status of radio graphically-inspected welds. This form will be forwarded to appropriate supervision for distribution.
- In addition to the records generated under this procedure, marked-up isometric and orthographic drawings will be used as weld maps to indicate completion of radiographic inspection. This will allow a progressive record and give system status.



**Agnico-Eagle Mines Ltd.
Welding Control Procedure**

**PRO Number : AEM-WE-PRO-001
Contract no. : C22466T**



Appendix A

ALL APPLICABLE ITRs & LOGs



Vendor Document Status

AGNICO EAGLE

- 1 ☐ Proceed to next submission and status.
- 2 ☐ Proceed with exceptions as noted to next submission and status.
- 3 ☐ Do not proceed.
Revise as noted and resubmit next submission and status.
- 4 ☒ Complete, no further submission required.

By: JEAN-FRANCOIS TREMBLAY Date: 2017-05-02

Review and authorization to fabricate are only for general conformance with the design concept of the Project as expressed in the Contract Documents. Sole responsibility for the accuracy and completeness of this document, including but not limited to dimensions and quantities, remains with the Supplier/Contractor. Agnico Eagle does not warrant the accuracy or completeness of any of the information contained herein, nor does Agnico Eagle authorize or approve any construction means, methods, techniques, sequences or any safety precautions or procedures.

Agnico Eagle
No. 6515-C-270-007-141-TES-0039 R: Sub001

DOCUMENT FOR INFORMATION



TABLE OF CONTENTS

	<u>Page</u>
1. Qualified Individual.....	3
2. Qualified Firm.....	3
3. NDE Purchasing Language.....	4

The Authorized Company for carrying out NDT and its personnel engaged in non-destructive examinations should be familiar with Promec's examination methods and the methods prescribed by the applicable drawings, specifications, codes and standards. The following list outlines the most commonly used examination methods on a Promec project:

- VT - Visual Testing
- LT - Leak Testing
- PT - Liquid Penetrant Testing
- RT - Radiographic Testing (X-ray)
- MT - Magnetic Particle Testing
- UT - Ultrasonic Testing

These methods as well as other methods may or may not, in whole or in part be sub-contracted to "qualified individuals" or firms to perform. The size and scope of the project dictates these conditions as well as the contract.

1. Qualified Individual


- The term "qualified individual" refers to the assigned person responsible for performing or reviewing the nondestructive examinations. All conflicts between the "qualified individual" and any other party will be resolved through the Project Manager and/or the Site Q/C Representative.


2. Qualified Firm







- The term "qualified firm" refers to a licensed NDE organization that performs NDE testing by subcontract for Promec. The qualified firms' contract must be governed by the contract between Promec and its client.
 - ✓ The selection of the NDE firm will be confirmed by the Corporate Quality Control Manager prior to awarding a contract.
 - ✓ The NDE firm will conduct its work in support of Promec.
 - ✓ All work performed by the NDE firm will meet the codes and specifications, quality and integrity.
 - ✓ The productivity and efficiency of the NDE firm shall be monitored to ensure that GSI and its client are receiving maximum value.

3. NDE Purchasing Language

- The following NDE Language shall be added to all Field PO's or subcontracts issued to a NDE firm. The following notes are to be used as a guide and the particular methods, codes and standards shall be verified prior to insertion into the P.O.
 - ✓ All work will be performed in accordance with ASME Section 5, Article 2 Radiographic Standards or ASME requirements.
 - ✓ All radiographic personnel shall be certified in accordance with CAN/CGSB-48.9712-2005 Latest Adopted Edition.
 - ✓ Prior to commencing any radiographic services, one copy of the following must be submitted to the Promec Quality Control Manager.
 - a) Liability Insurance Certificate. Retain copy and forward the original to the Site Project Manager.
 - b) State, Provincial and Federal Radiation Licenses (If Applicable).
 - c) All anticipated personnel certifications (For methods outlined in the contract).
 - d) Each radiographic technique procedure to be used (within the scope of the project).
 - ✓ Each crew shall have one (1) certified Level II Technician on site when working.
 - ✓ All subcontractor radiography shall be interpreted by the subcontractor for film quality and defects prior to surrendering the film and record sheets to the Promec Representative.
 - ✓ All record sheets shall be filled out completely, listing all weldment defects seen on film, whether the defects are acceptable or rejectable to codes or specifications, and shall be signed by the Subcontractor's Level II Technician.

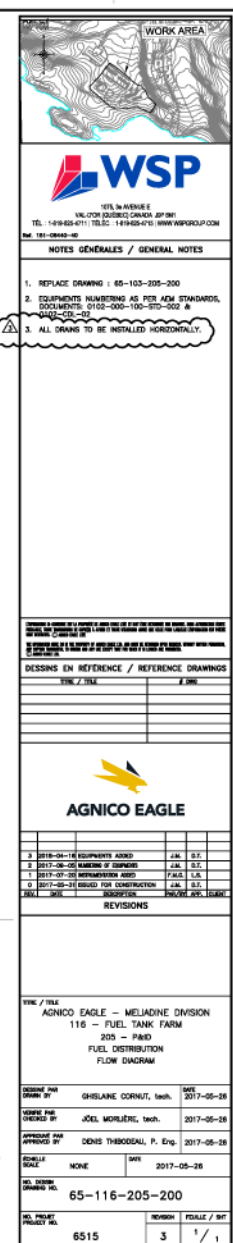

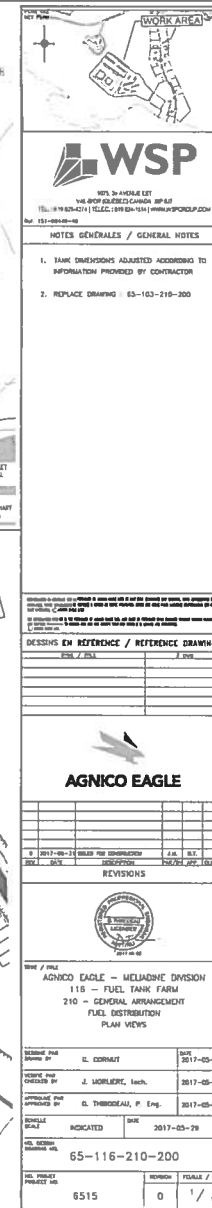

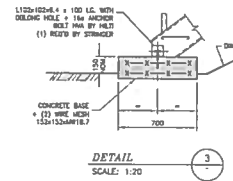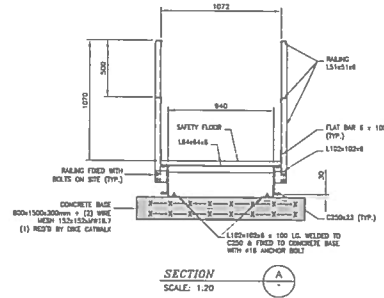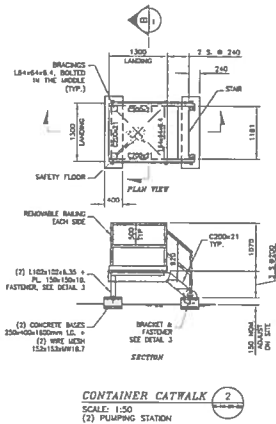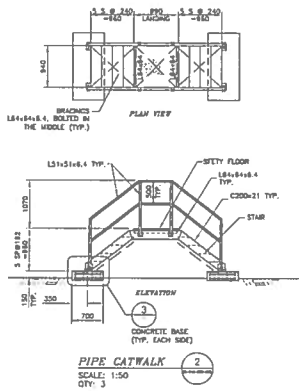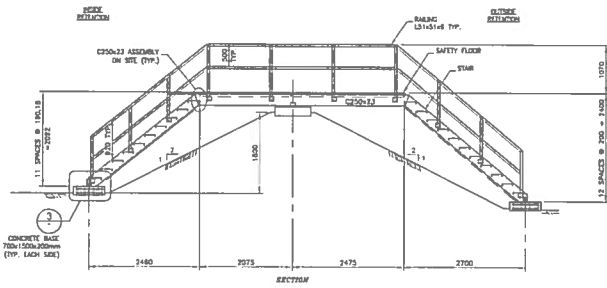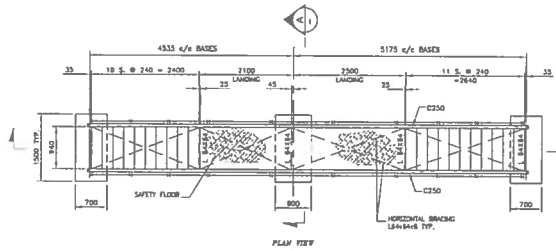

NOTES:

CATWALK, RAILINGS AND STAIRS ARE ASSEMBLED AND BOLTED ON SITE.
DEAD LOAD = 0.3 k/ft
LIVE LOAD = 4.0 k/ft
WIND LOAD = 1/200

MATERIAL

CRATING OF LANDING

GRP SPAN SAFETY GRATING, GALVANIZED STEEL, (2)-51215-G, 5 DIAMONDS, G₂ 3.7mm, 38.1mm DEEP BY FIBER LUGGAGE OR APPROVED EQUIVALENT, MAX. 300mm WIDTH EXCEPT WHEN INDICATED OTHERWISE.

STAIR

GRP SPAN SAFETY GRATING, GALVANIZED STEEL, (2)-41215-G, 4 DIAMONDS, G₂ 3.7mm, 38.1mm DEEP BY FIBER LUGGAGE OR APPROVED EQUIVALENT, MAX. 341mm WIDTH EXCEPT WHEN INDICATED OTHERWISE.

POUR CONSTRUCTION
FOR CONSTRUCTION
DATE: 2017-05-31



WSP

101, 2nd FLOOR
116-116-245-201
TEL: 1-877-874-2717 FAX: 1-877-874-1011 WWW.WSPGROUP.COM

NOTES GENERALES / GENERAL NOTES

SEE SPECIFICATIONS
1. REPLACE DRAWING: 65-103-245-201

CONSTRUCTION OF THIS PROJECT IS SUBJECT TO THE FOLLOWING CONDITIONS: THE CONTRACTOR SHALL BE RESPONSIBLE FOR OBTAINING ALL NECESSARY PERMITS AND APPROVALS FROM THE APPROPRIATE AGENCIES. THE CONTRACTOR SHALL BE RESPONSIBLE FOR OBTAINING ALL NECESSARY PERMITS AND APPROVALS FROM THE APPROPRIATE AGENCIES. THE CONTRACTOR SHALL BE RESPONSIBLE FOR OBTAINING ALL NECESSARY PERMITS AND APPROVALS FROM THE APPROPRIATE AGENCIES.

DESIGNS IN REFERENCE / REFERENCE DRAWINGS

FIG. / SHE. X. Y. Z.



NO.	DATE	DESCRIPTION	BY	CHK.
1	2017-05-31	ISSUED FOR CONSTRUCTION	J.A.	G.T.



BY / FILE
AGNICO EAGLE - MIDLAND DIVISION
116 - FUEL TANK FARM
245 - STRUCTURAL STEEL
FUEL DISTRIBUTION
DIKE, PIPE & CONTAINERS CATWALKS


DESIGNED BY	C. CORNUAT	DATE	2017-05-29
DESIGNED BY	J. MORIERE, Engr.	DATE	2017-05-29
APPROVED BY	D. THEODORE, P. Eng.	DATE	2017-05-29

PROJECT NO. 65-116-245-201

NO. PROJECT	6515	REVISION	0	DATE / BY	1 / 1
-------------	------	----------	---	-----------	-------

NOTE:

1. APPROXIMATIVE STAIRWAY LOCATION: CONTRACTOR HAVE TO ENSURE A MINIMUM CLEARANCE OF 1000MM IN ELEVATION BETWEEN STAIRS AND ANY SHELL CONNECTION

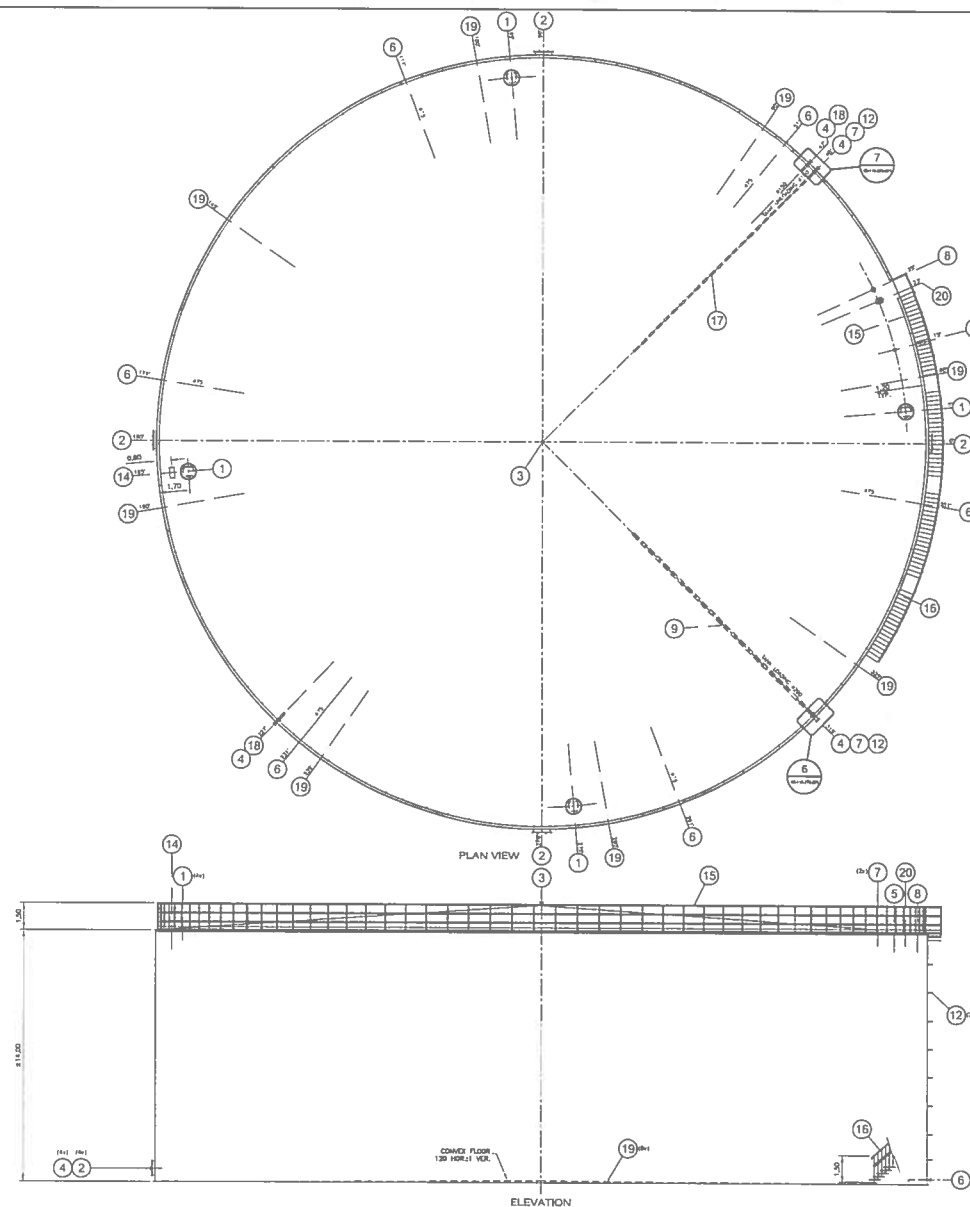

1075 DE AVENUE EST
VAL D'OR (QUEBEC) CANADA J9P 2J7
Tél.: 819 824-4774 | Téléc.: 819 824-1111 | www.mspcoulp.com

NOTES GÉNÉRALES / GENERAL NOTES

1. TANK DIMENSIONS ADJUSTED ACCORDING TO INFORMATION PROVIDED BY CONTRACTOR
2. INTERFACE DRAWING: 85-103-160-300

1. **THE STATE OF TEXAS, COUNTY OF DALLAS, ss. I, _____, a Notary Public in and for the State of Texas, do hereby certify that the foregoing is a true and correct copy of the original of the same as the same appears from the records of the County of Dallas, State of Texas.**

2. **IN WITNESS WHEREOF, I have hereunto set my hand and the seal of the County of Dallas, State of Texas, at the City of Dallas, Texas, this _____ day of _____, 20____.**

3. **My commission expires on the _____ day of _____, 20____.**

4. **Notary Public in and for the State of Texas.**

DESIGNS IN REFERENCE / REFERENCE DRAWINGS


[illegible]

8	2017-09-2	ISSUES FOR CONSTRUCTION	4.06	0.7
REV	DATE	DESCRIPTION	PAID	AMT




AGNICO EAGLE - MELJADINE DIVISION
116 - FUEL TANK FARM
260 - PLATWORK
TANK #1 - 20,000,000 liters
ø43m x 14m H.
GENERAL ARRANGEMENT

SCHEMATIC DRAWN BY	CHRISTINE CORNUAT	DATE	2017-05-29
MECHANICAL CHECKED BY	JOEL MORLOCKE, Tech.		2017-05-29
APPROVED AND APPROVED BY	DENIS THEODOREAU, Ing.		2017-05-29
BOILER SCALE	1:125	SHEET	2017-05-28
NO. SCHEMATIC 65-116-260-200			
NO. PROJECT PROJECT NO.	6515	REVISION	0 1 /

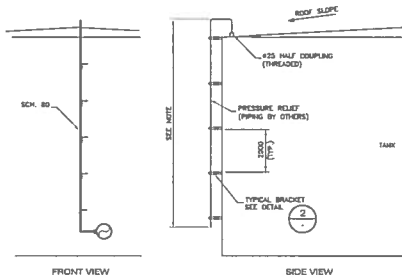


NOTE: WELDED JOINTS TO BE TESTED ON THIS SECTION (NOT THREADED JOINTS)

1 PRESSURE RELIEF LINE
Detail scale 1:10

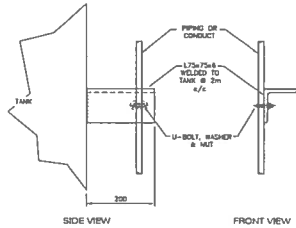


NOTE: FOR ITEMS 8 & 13


2 BRACKET FOR PIPING OR ELECTRICAL CONDUIT TO THE SHELL TANK
Detail scale 1:15

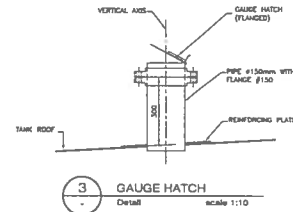


3 GAUGE HATCH
Detail scale 1:10

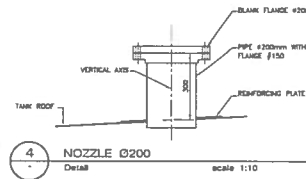


4 NOZZLE Ø200
Detail scale 1:10

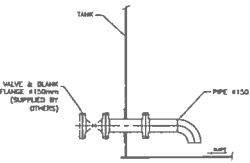


7 PUMPING LOW LEVEL
Detail scale 1:20

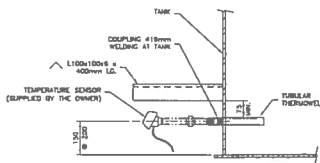


8 TEMPERATURE SENSOR ON SHELL TANK
Detail scale 1:10

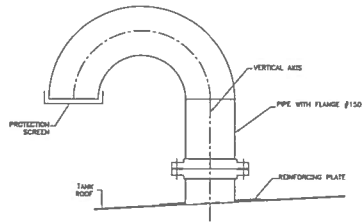


5 VENT
Typical detail scale 1:10

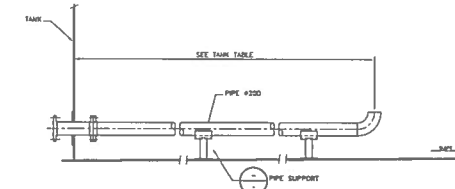


11 FIXED PIPE - TANK LOADING
Detail scale 1:20

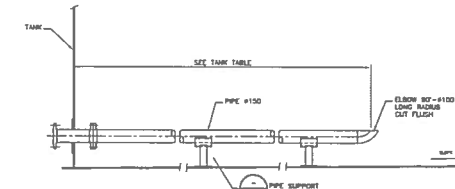

12 FIXED PIPE - TANK UNLOADING
Detail scale 1:20

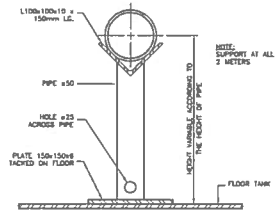

9 PIPE SUPPORT
Detail scale 1:5

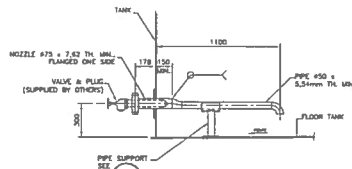

10 WATER DRAW-OFF
Detail scale 1:20

POUR CONSTRUCTION
FOR CONSTRUCTION
DATE: 2017-05-31



WSP
WSP INC. 10000 100th Ave. S.E. Unit 100
Edmonton, Alberta T6C 1B4
Tel: 780-443-1111 Fax: 780-443-1112
www.wspinc.com

NOTES GÉNÉRALES / GENERAL NOTES

1. REPLACE DRAWING: 65-103-260-202

DESIGNS EN RÉFÉRENCE / REFERENCE DRAWINGS

NO.	DESCRIPTION	DATE
1	65-103-260-202	2017-05-31

AGNICO EAGLE

REVISIONS


NO.	DESCRIPTION	DATE
1	65-103-260-202	2017-05-31

WSP / WSP
AGNICO EAGLE - MELADNE DIVISION
116 - FUEL TANK FARM
260 - PLATEWORK
TANK #1 @ #6
DETAILS

DESIGNED BY	CHELANE CORVAT	DATE	2017-05-29
DESIGNED BY	JOSÉ MORIERE, Insp.	DATE	2017-05-29
APPROVED BY	DEAN THORNDAL, Insp.	DATE	2017-05-29
REVIEWED BY	INDICATED	DATE	2017-05-29








65-116-260-202

NO. PROJECT	6515	REVISION	0	SCALE	1/1
-------------	------	----------	---	-------	-----

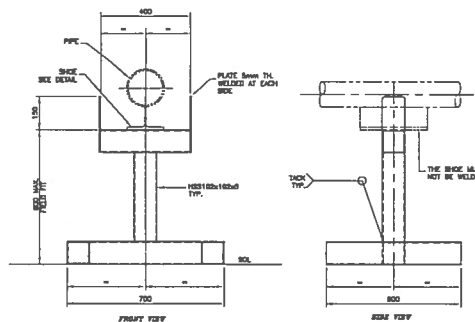


NOTE:
1. GROUND FOR THE SUPPORT TO BE FLAT AND STABLE.
AND WITH MINIMUM CHANNEL BACKSILL IF NEEDED.

PIPING SUPPORT
SCALE: 1:10

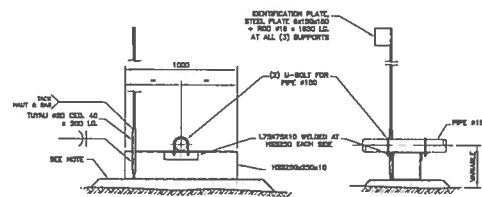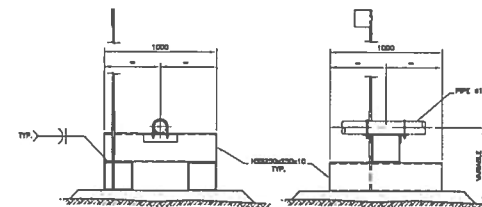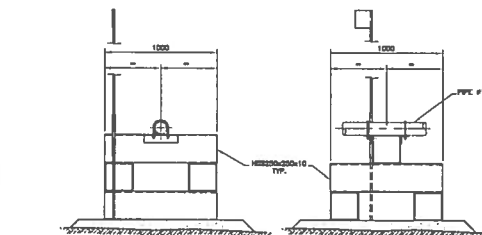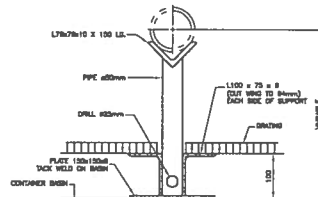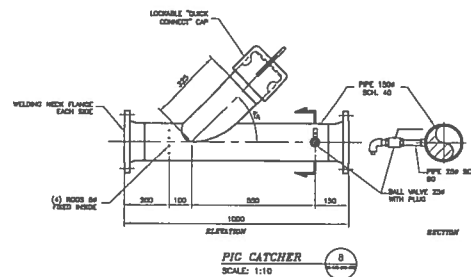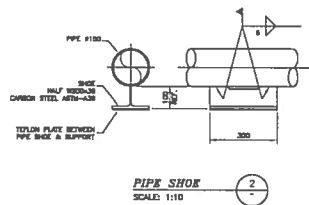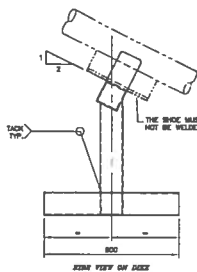


NOTE:
1. GROUND FOR THE SUPPORT TO BE FLAT AND STABLE.
AND WITH MINIMUM CHANNEL BACKSILL IF NEEDED.

MARINE LINE SUPPORT
SCALE: 1:20

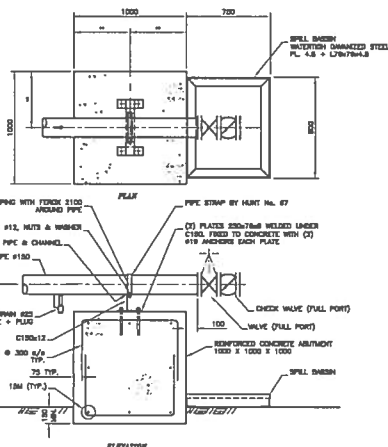

MARINE LINE MANIFOLD ABUTMENT-TYPE 1
SCALE: 1:20

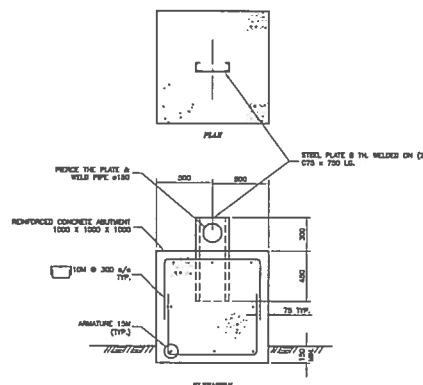

ABUTMENT-TYPE 2
SCALE: 1:20



WSP

WSP 30 ALBERTA ST.
1000 CLARKSON RD. #100
TEL: 780-441-1111 FAX: 780-441-1112 WWW.WSPGROUP.COM

NOTES GENERALES / GENERAL NOTES

1. REPLACE DRAWING: 65-103-270-200

POUR CONSTRUCTION FOR CONSTRUCTION
DATE: 2017-05-31

DESIGNS IN REFERENCE / REFERENCE DRAWINGS

1. 1000

2. 1000

3. 1000


21. 1000

22. 1000


23. 1000

24. 1000


25. 1000

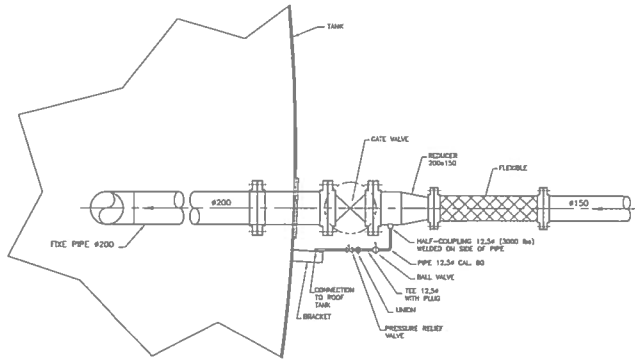


LOADING TANK PIPING
SCALE: 1:15

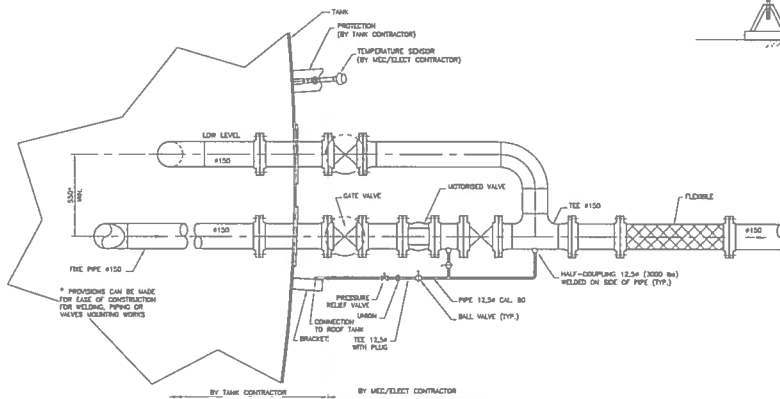


UNLOADING TANK PIPING
SCALE: 1:15

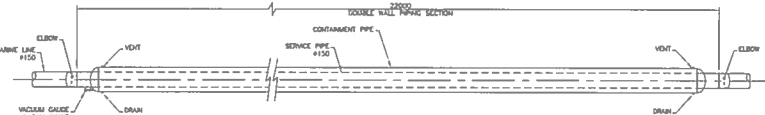



UNDERGROUND PIPING
SCALE: 1:25

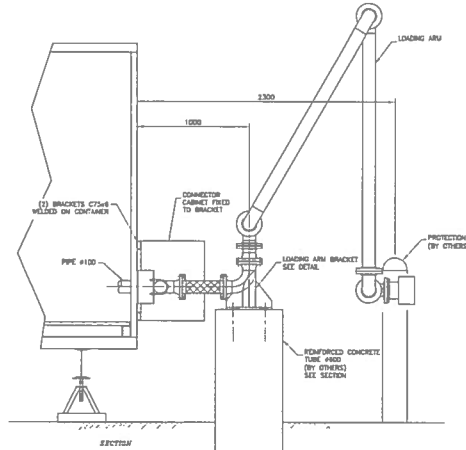

BOTTOM LOADING
SCALE: 1:20

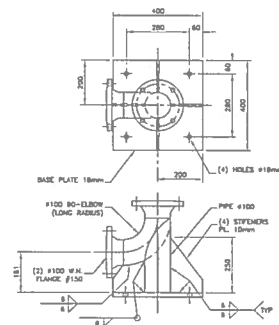

LOADING ARM BRACKET
SCALE: 1:10

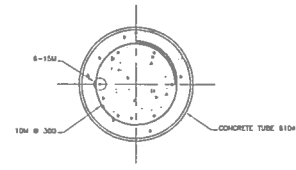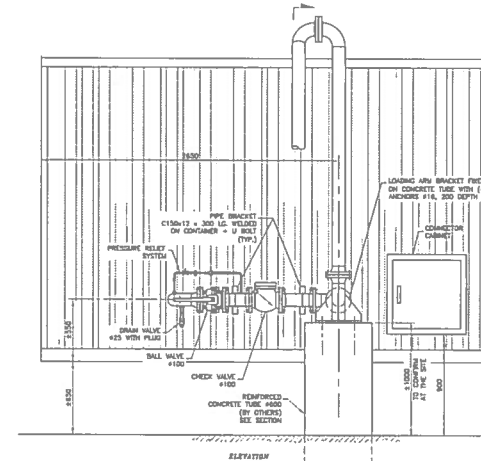

CONCRETE TUBE SECTION
SCALE: 1:10



WSP

1075, 34 AVENUE EST.
WILLOWDALE, ONTARIO, CANADA M2H 1P5
TEL: 416-490-8800 FAX: 416-490-8801 WWW.WSPGROUP.COM

NOTES GÉNÉRALES / GENERAL NOTES

1. REPLACE DRAWING: 65-103-270-201

POUR CONSTRUCTION FOR CONSTRUCTION
DATE: 2017-05-31

DESIGNS IN REFERENCE / REFERENCE DRAWINGS

FIG. 2.151 1.10

REVISIONS

2017-05-31 ISSUED FOR CONSTRUCTION J.M. S.T.

2017-05-31 ISSUED FOR CONSTRUCTION J.M. S.T.


2017-05-31 ISSUED FOR CONSTRUCTION J.M. S.T.

2017-05-31 ISSUED FOR CONSTRUCTION J.M. S.T.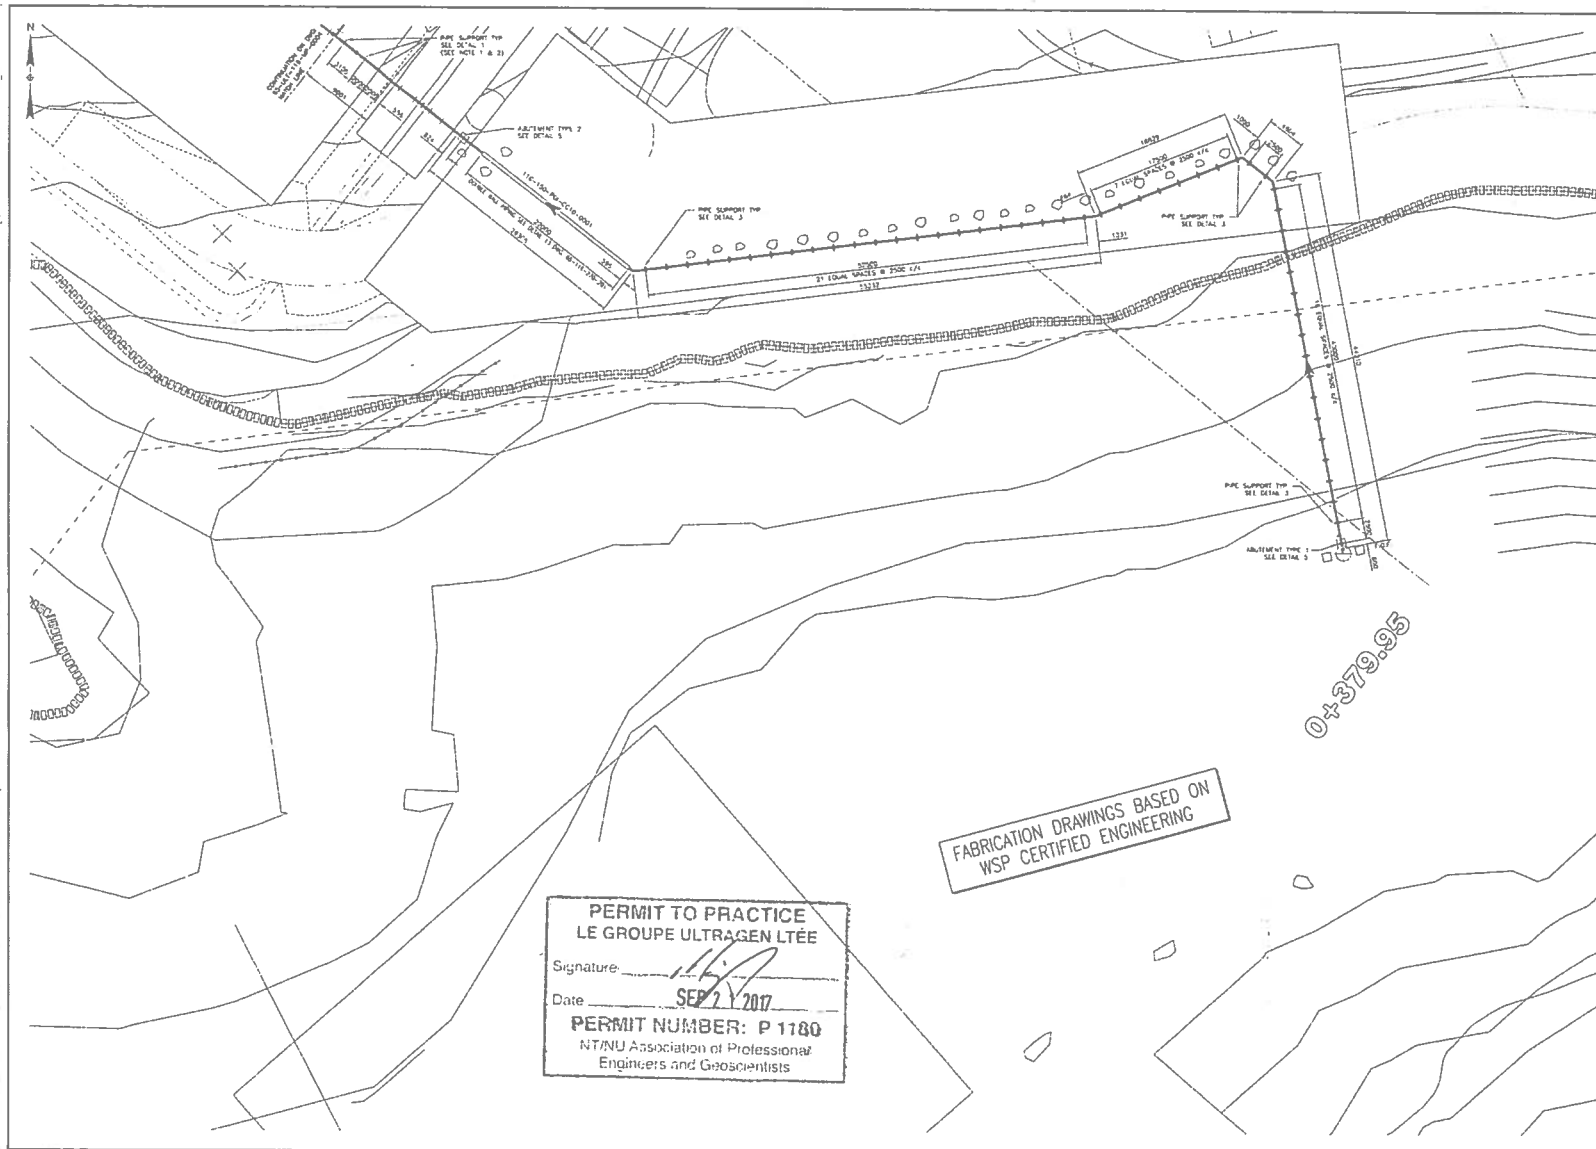

NOTES GENERALES / GENERAL NOTES

1. Consult the owner for any changes to the design or construction of the project.
2. The drawings are for informational purposes only and do not constitute a contract.



DESSINS EN REFERENCE / REFERENCE DRAWINGS

NO.	DESCRIPTION	DATE
1	GENERAL ARRANGEMENT - PLAN VIEW	2017-11-14
2	GENERAL ARRANGEMENT - PLAN VIEW	2017-11-14
3	GENERAL ARRANGEMENT - PLAN VIEW	2017-11-14
4	GENERAL ARRANGEMENT - PLAN VIEW	2017-11-14



NO.	DESCRIPTION	DATE
1	2017-08-14 PROJECT FILE REVIEW	2017-08-14
2	2017-08-14 PROJECT FILE REVIEW	2017-08-14
3	2017-08-14 PROJECT FILE REVIEW	2017-08-14




116 - FUEL TANK DIVISION
FUEL DISTRIBUTION
GENERAL ARRANGEMENT
PLAN VIEW

DESIGNER	DATE	2017-03-10
CHECKED BY	DATE	
APPROVED BY	DATE	
SCALE	1:200	2017-03-10
PROJECT NO.	65-ULT-116-MP-001	
NO. SHEET	2	1

PERMIT TO PRACTICE
LE GROUPE ULTRAGEN LTÉE
Signature: *[Signature]*
Date: **SEP 2 2017**
PERMIT NUMBER: P 1180
NT/NU Association of Professional
Engineers and Geoscientists

FABRICATION DRAWINGS BASED ON
WSP CERTIFIED ENGINEERING

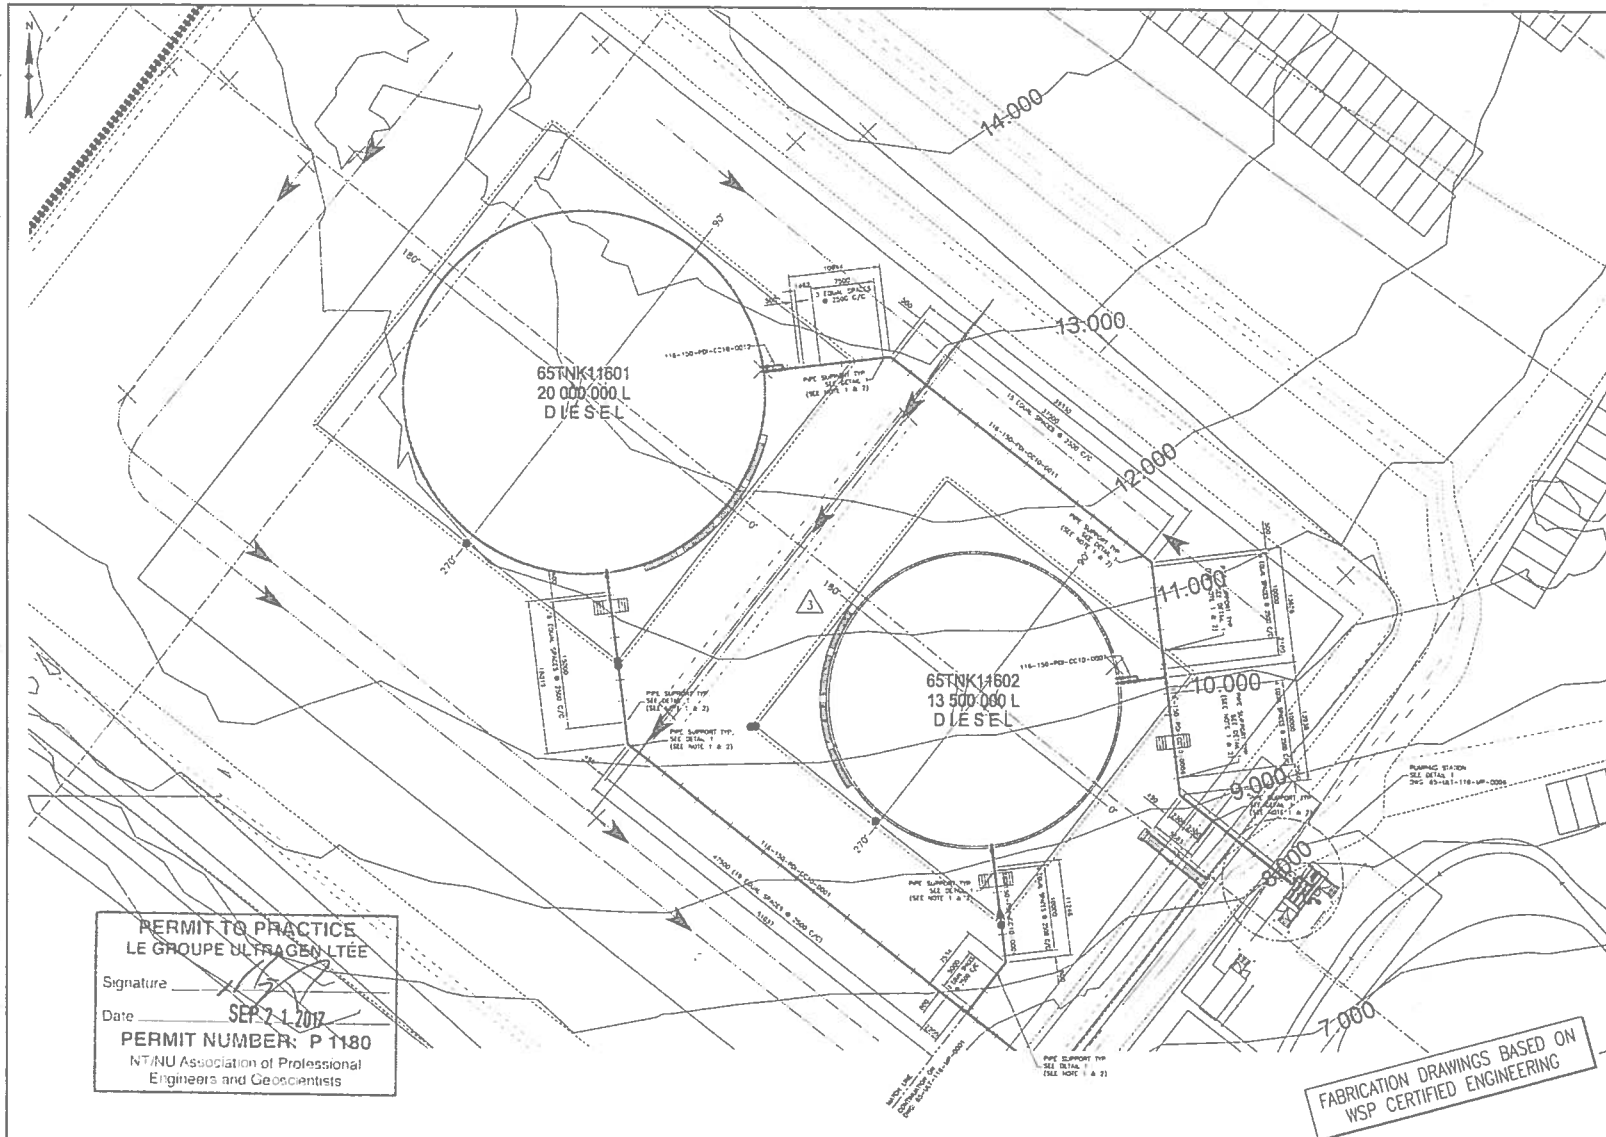

PERMIT TO PRACTICE
LE GROUPE ULTRAGEN LTÉE

Signature: *[Signature]*

Date: SEP 21 2017

PERMIT NUMBER: P 1180

NT/MU Association of Professional
Engineers and Geoscientists

FABRICATION DRAWINGS BASED ON
WSP CERTIFIED ENGINEERING



NOTES GÉNÉRALES / GENERAL NOTES

1. Check that all notes are clear and legible. If not, the Engineer shall provide a copy of the notes to the client.
2. In the event of any change to the design, the Engineer shall provide a copy of the change to the client.



2017/09/21

DESIGNS IN REFERENCE / REFERENCE DRAWINGS

DESIGN NO.	DATE	DESCRIPTION
65-ULT-116-MP-001	2017-09-21	PERMIT TO PRACTICE
65-ULT-116-MP-002	2017-09-21	PERMIT TO PRACTICE
65-ULT-116-MP-003	2017-09-21	PERMIT TO PRACTICE
65-ULT-116-MP-004	2017-09-21	PERMIT TO PRACTICE
65-ULT-116-MP-005	2017-09-21	PERMIT TO PRACTICE
65-ULT-116-MP-006	2017-09-21	PERMIT TO PRACTICE
65-ULT-116-MP-007	2017-09-21	PERMIT TO PRACTICE
65-ULT-116-MP-008	2017-09-21	PERMIT TO PRACTICE
65-ULT-116-MP-009	2017-09-21	PERMIT TO PRACTICE
65-ULT-116-MP-010	2017-09-21	PERMIT TO PRACTICE


AGNICO EAGLE

NO.	DATE	DESCRIPTION
1	2017-09-21	PERMIT TO PRACTICE
2	2017-09-21	PERMIT TO PRACTICE
3	2017-09-21	PERMIT TO PRACTICE
4	2017-09-21	PERMIT TO PRACTICE
5	2017-09-21	PERMIT TO PRACTICE
6	2017-09-21	PERMIT TO PRACTICE
7	2017-09-21	PERMIT TO PRACTICE
8	2017-09-21	PERMIT TO PRACTICE
9	2017-09-21	PERMIT TO PRACTICE
10	2017-09-21	PERMIT TO PRACTICE



THE / LES
AGNICO EAGLE - VULCAN DIVISION
116 - FUEL TANK FARM
FUEL DISTRIBUTION
CENTRAL ARRANGEMENT
PLAN VIEW

NO.	DATE	DESCRIPTION
1	2017-09-21	PERMIT TO PRACTICE
2	2017-09-21	PERMIT TO PRACTICE
3	2017-09-21	PERMIT TO PRACTICE
4	2017-09-21	PERMIT TO PRACTICE
5	2017-09-21	PERMIT TO PRACTICE
6	2017-09-21	PERMIT TO PRACTICE
7	2017-09-21	PERMIT TO PRACTICE
8	2017-09-21	PERMIT TO PRACTICE
9	2017-09-21	PERMIT TO PRACTICE
10	2017-09-21	PERMIT TO PRACTICE

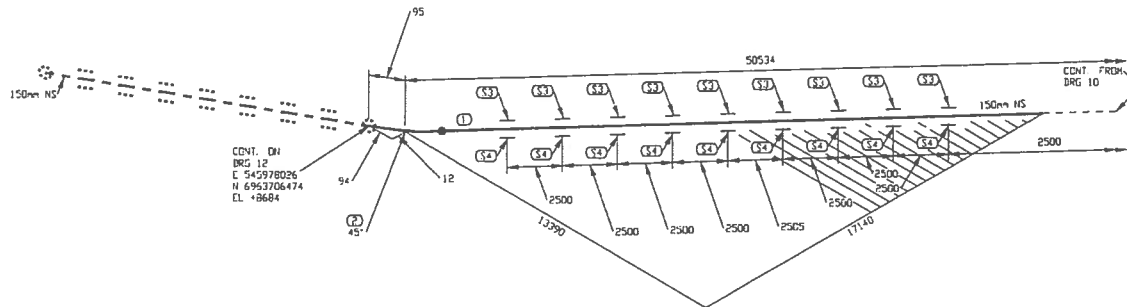

PERMIT TO PRACTICE
LE GROUPE ULTRAGEN LTÉE
Signature _____
Date **SEP 21 2017**
PERMIT NUMBER: P 1180
NTNU Association of Professional
Engineers and Geoscientists

FABRICATION DRAWINGS BASED ON
WSP CERTIFIED ENGINEERING

LISTE DE MATERIEL

no	QTE	DA	MATERIEL/CATALOGUE	DESCRIPTION
1	21655 MM	150	A 333 Gr. 6	SCH STD, SHLS PIPE
2	1	150	A 420 Gr. VPL6	SCH STD, BV LR 45 DEG ELBOW
3	9	150		PIPE SUPPORT AS PER DETAIL 1, DWG 65-116-270-200
4	9	150		PIPE SHOE AS PER DETAIL 2, DWG 65-116-270-200

2	2017/09/21	PROJECT TITLE REVISED	KHV
1	2017/09/11	LINE NUMBERS REVISED	KHV
0	2017/05/15	ISSUED FOR CONSTRUCTION	KHV
No.	DATE	REVISION	PART

CLIENT:


AGNICO EAGLE

NUOSANA PROMEC MINING


ultragen

CONSULTANT PROJECT NO. 591700

NO. DE CONDUITE	SPECIFICATION	PRODUIT	SYSTEME REYCTIVENT	CODE DE COULEUR	ISOLATION ET TRACAGE	EPAISS. D'ISOLATION	
116-150-PDI-CC10-0001	CC10	PDI		-			65-116-270-200 PIPE SUPPORT DETAILS
PRESSION D'OPERATION	TEMPERATURE D'OPERATION	PRESSION DE CONCEPTION	TEMPERATURE DE CONCEPTION	PRESSION D'ESSAI	CLASSE D'INSPECTION	CODE DE SERVICE	TRAITEMENT THERMIQUE
PSIG	T	PSIG	T	PSIG			65-116-205-200 P&ID
						No. DESSIN	DESSINS DE REFERENCE

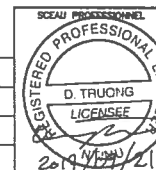

COMC.: KHV DATE: 2017/04/23 DESSINE PAR: KVE DATE: 2017/04/23 VOR. PAR: - DATE: - APP.: - DATE: - ECHELLE: AUCUNE	PROJET: AGNICO EAGLE - MELIADINE DIVISION 116 - FUEL TANK FARM TITRE: RANKIN INLET FABRICATION ISOMETRIC MARINE LINE TO 65TNK11601 & 65TNK11602 No. PROJET 6515 No. DESSIN 116-150-PDI-CC10-0001 PAGES 11/13 REV. 2
---	---

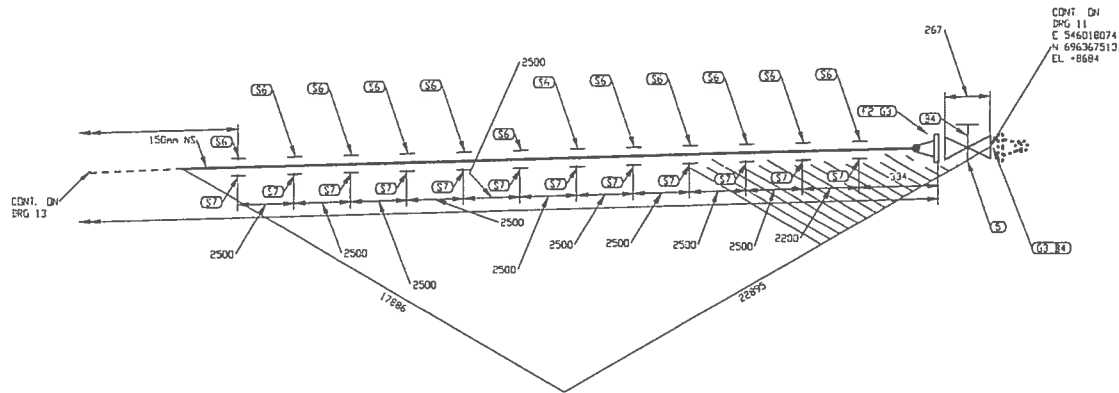

PERMIT TO PRACTICE
LE GROUPE ULTRAGEN LTÉE
Signature _____
Date _____
SEP 11 2017
PERMIT NUMBER: P 1180
NTNU Association of Professional
Engineers and Geoscientists

FABRICATION DRAWINGS BASED ON
WSP CERTIFIED ENGINEERING

LISTE DE MATERIEL				
No	QTE	DM	MATERIEL/CATALOGUE	DESCRIPTION
1	28696	MM	A 333 Gr 6	SCH STD, SHLS PIPE
2	1	150	A 350 Gr L72	CL 150, SCH STD, RF, WN FLANGE
3	2	150	ASME B16.20	CL 150, GARLOCK 5500, RING TYPE GASKET 1/8" THK
4	16	19	A 193 B7/A 194 DM	CL 150, 8 - 19 OS X 100 STUD BOL'S c/w IV0 HEAVY HEX NUTS
5	1	150	GA-10	CL 150, RF, CS, GATE VALVE
6	12	150		PIPE SUPPORT AS PER DETAIL 1, DWG 65-116-270-200
7	12	150		PIPE SHOE AS PER DETAIL 2, DWG 65-116-270-200

2	2017/09/21	PROJECT TITLE REVISED	KHV
1	2017/09/11	LINE NUMBERS REVISED	KHV
0	2017/05/15	ISSUED FOR CONSTRUCTION	KHV
No.	DATE	REVISION	PAR

CLIENT:








CONSULTANT PROJECT NO. 591700

NO. DE CONDUITE	SPECIFICATION	PRODUIT	SYSTEME REVETEMENT	CODE DE COULEUR	ISOLATION ET TRAÇAGE	EPAISS. D'ISOLATION	
116-150-PDI-CC10-0001	CC10	PDI		-		65-116-270-200	PIPE SUPPORT DETAILS
PRESSION D'OPERATION	TEMPERATURE D'OPERATION	PRESSION DE CONCEPTION	TEMPERATURE DE CONCEPTION	PRESSION D'ESSAI	CLASSE D'INSPECTION	CODE DE SERVICE	TRAITEMENT THERMIQUE
PSIG	°F	PSIG	°F	PSIG			
						No. DESSIN	DESSINS DE REFERENCE

CONC.: KHV	DATE: 2017/04/25	PROJET: AGNICO EAGLE - MELIADINE DIVISION 116 - FUEL TANK FARM
DESSINE PAR: KVE	DATE: 2017/04/25	TITRE: RANKIN INLET FABRICATION ISOMETRIC MARINE LINE TO 65TNK11601 & 65TNK11602
VER. PAR: -	DATE: -	No. PROJET: 6515
APP.: -	DATE: -	No. DESSIN: 116-150-PDI-CC10-0001
DATE: -	COCHILLE: AUCUNE	PAGES: 12/13
		REV. 2

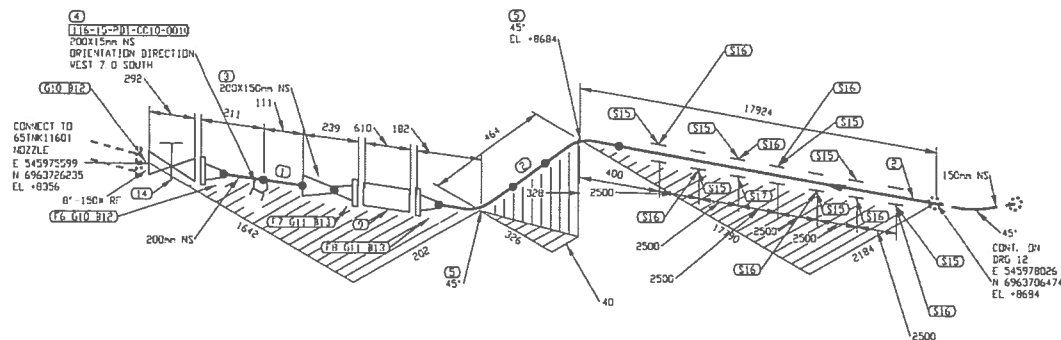

PERMIT TO PRACTICE
LE GROUPE ULTRAGEN LTÉE
Signature _____
Date **SEP 21 2017**
PERMIT NUMBER: P 1180
NTNU Association of Professional
Engineers and Geoscientists

FABRICATION DRAWINGS BASED ON
WSP CERTIFIED ENGINEERING

LISTE DE MATERIEL

No	QTE	DM	MAT/ML/CATALOGUE	DESCRIPTION
1	222 MM	200	A 333 Gr. 6	SCH STD, SMLS PIPE
2	18103 MM	150	A 333 Gr. 6	SCH STD, SMLS PIPE
3	1	200X150	A 420 Gr. VPL6	SCH STD, BV CONC RED
4	1	200X15	A 350 Gr. LF2	CL 3000, THREDDLET
5	2	150	A 420 Gr. VPL6	SCH STD, BV LR 45 DEG ELBOW
6	1	200	A 350 Gr. LF2	CL 150, SCH STD, RF, WN FLANGE
7	1	150	A 350 Gr. LF2	CL 150, SCH STD, RF, WN FLANGE
8	1	150	A 350 Gr. LF2	CL 150, SCH STD, RF, WN FLANGE
9	1	150		CL 150, SINGLE BRAIDED HOSE ASSEMBLY
10	2	200	ASME B16.20	CL 150, GARLOCK 5500, RING TYPE GASKET 1/8" THK
11	2	150	ASME B16.20	CL 150, GARLOCK 5500, RING TYPE GASKET 1/8" THK
12	16	19	A 193 B7/A 194 2H	CL 150, B - 19.05 X 110 STUD BOLTS c/w TWO HEAVY HEX NUTS
13	16	19	A 193 B7/A 194 2H	CL 150, B - 19.05 X 100 STUD BOLTS c/w TWO HEAVY HEX NUTS
14	1	200	GA-10	CL 150, RF, CS, FULL PORT GATE VALVE
15	7	150		PIPE SUPPORT AS PER DETAIL 1, DWG 65-116-270-200
16	7	150		PIPE SHOE AS PER DETAIL 2, DWG 65-116-270-200
17	1	150		PIPE SHOE AS PER DETAIL 2, DWG 65-116-270-200

2	2017/09/21	PROJECT TITLE REVISED	KHV
1	2017/09/11	LINE NUMBERS REVISED	KHV
0	2017/05/15	ISSUED FOR CONSTRUCTION	KHV
No.	DATE	REVISION	APP.

CLIENT:


AGNICO EAGLE

NUQSANA PROMEC MINING

ULTRAGEN


CONSULTANT PROJECT NO. 591700

NO. DE CONDUITE	SPECIFICATION	PRODUIT	SISTEME REVETEMENT	CODE DE COULEUR	ISOLATION ET TRAÇAGE	EPASS. D'ISOLATION	
116-150-PDI-CC10-0001	CC10	PDI		-			65-116-270-200 PIPE SUPPORT DETAILS
PRESSION D'OPERATION	TEMPERATURE D'OPERATION	PRESSION DE CONCEPTION	TEMPERATURE DE CONCEPTION	PRESSION D'ESSAI	CLASSE D'INSPECTION	CODE DE SERRAGE	TRAITEMENT THERMIQUE
PSG	T	PSG	T	PSG			65-116-205-200 P&ID
							No. DESSIN
							DESSINS DE REFERENCE

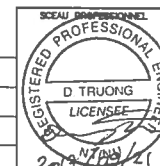

CONC: KHY	PROJECT:	AGNICO EAGLE - MELIADINE DIVISION		
DATE: 2017/04/25	116 - FUEL TANK FARM			
DESSINE PAR: KVE	TITRE:	RANKIN INLET		
DATE: 2017/04/25	FABRICATION ISOMETRIC			
VER. PAR: -	MARINE LINE TO 65TNK11601 & 65TNK11602			
DATE: -				
APP: -				
DATE: -				
ECHELLE: AUCUNE				
	No. PROJET	No. DESSIN	PAGES	REV.
	6515	116-150-PDI-CC10-0001	13/13	2

C:\E:\Projects\Engineering\116-150-PDI-CC10-0011\116-150-PDI-CC10-0011.dwg

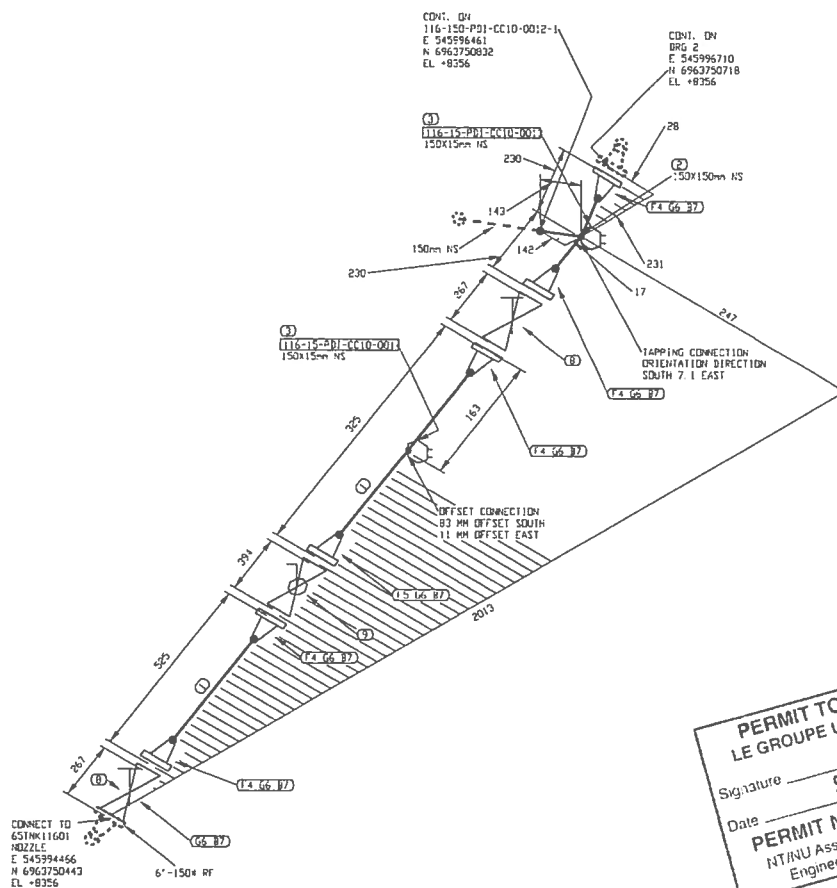

PERMIT TO PRACTICE
LE GROUPE ULTRAGEN LTÉE
 Signature: *[Signature]*
 Date: **SEP 21 2017**
PERMIT NUMBER: P 1180
 NTNU Association of Professional
 Engineers and Geoscientists

FABRICATION DRAWINGS BASED ON
WSP CERTIFIED ENGINEERING


LISTE DE MATERIEL				
NO	Q'TÉ	DA	MATÉRIEL/CATALOGUE	DESCRIPTION
1	502 MM	150	A 333 Gr. 6	SCH STD. SMLS PIPE
2	1	150X150	A 420 Gr. VPL6	SCH STD. 90° STRAIGHT TEE
3	2	150X15	A 350 Gr. LF2	CL 3000. THREEDLET
4	5	150	A 350 Gr. LF2	CL 150. SCH STD. RF. WN FLANGE
5	1	150	A 250 Gr. LF2	CL 150. SCH STD. RF. WN FLANGE
6	7	150	ASME B16.20	CL 150. GARLOCK 5500. RING TYPE GASKET 1/8" THK
7	56	19	A 193 B7/A 194 2H	CL 150. 8 - 19.05 X 100 STUD BOLTS c/w TWO HEAVY HEX NUTS
8	2	150	GA-10	CL 150. RF. GATE VALVE
9	1	150	BA-31	CL 150. RF. BALL VALVE

2	2017/09/21	PROJECT TITLE REVISED	KHV
1	2017/09/11	LINE NUMBERS REVISED	KHV
0	2017/05/15	ISSUED FOR CONSTRUCTION	KHV
NO.	DATE	REVISION	PAR APP


CLIENT:

CONSULTANT PROJECT NO. **591700**

NO. DE CONDUITE	SPECIFICATION	PRODUIT	SISTÈME REVÊTEMENT	CODE DE COULEUR	ISOLATION ET TRACAGE	ÉPAISS. D'ISOLATION	
116-150-PDI-CC10-0011	CC10	PDI		-			65-116-270-200 PIPE SUPPORT DETAILS
PRESSION D'OPERATION	TEMPERATURE D'OPERATION	PRESSION DE CONCEPTION	TEMPERATURE DE CONCEPTION	PRESSION D'ESSAI	CLASSE D'INSPECTION	CODE DE SERVICE	TRAITEMENT THERMIQUE
PSIG	°F	PSIG	°F	PSIG			55-116-205-200 P&ID
							No. DESSIN
							DESSINS DE REFERENCE

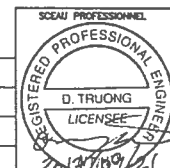


CONC.: KHV DATE: 2017/04/25 DESSINÉ PAR: KHV DATE: 2017/04/25 VÉR. PAR: - DATE: - APP.: - DATE: - ÉCHELLE: AUCUNE	PROJET: AGNICO EAGLE - MELIADINE DIVISION 116 - FUEL TANK FARM TITRE: RANKIN INLET FABRICATION ISOMETRIC DIESEL FROM 65TNK11601 TO PUMPING STATION	No. PROJET: 6515 No. DESSIN: 116-150-PDI-CC10-0011 PAGES: 1/5 REV.: 2
---	---	--

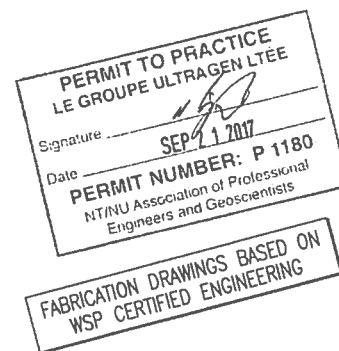

CUSTOMER:	 AGNICO EAGLE	 NUSSANA PROPEC MINING PT. KALAMATI JAWA BARAT INDONESIA
------------------	--	--

CONTRACT NO:	6197	PROJECT:	AGNICO EAGLE - MELIADINE DIVISION		
DATE:	2011/04/20		116 - FUEL TANK FARM		
DRAWING NAME:	KVE	TITLE:	RANKIN INLET		
DATE:	2011/04/20		FABRICATING ISOMETRIC		
VOL. NAME:	-		DIESEL FROM 65TNK11601 TO PUMPING STATION		
DATE:	-				
APP.:	-				
DATE:	-				
SCHEDULE:	AUCUNE				
		No PROJECT	No DRESSIN	PAGES	REV
		6515	116-150-PDI-CC10-0011	3/5	2

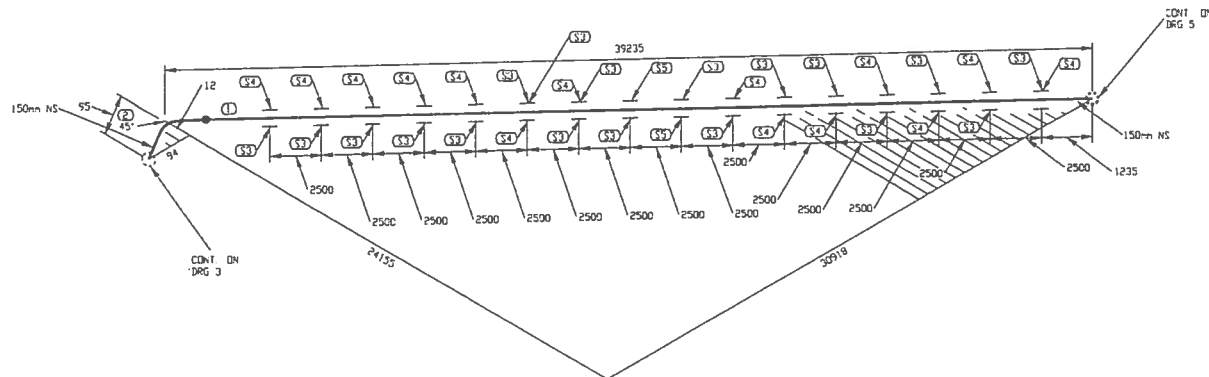

PERMIT TO PRACTICE
LE GROUPE ULTRAGEN LTÉE
Signature *[Signature]*
Date **SEP 21 2017**
PERMIT NUMBER: P 1180
NTNU Association of Professional
Engineers and Geoscientists

FABRICATION DRAWINGS BASED ON
WSP CERTIFIED ENGINEERING

LISTE DE MATERIEL				
No	QTE	DA	MATERIEL/CATALOGUE	DESCRIPTION
1	39140 MM	150	A 333 Gr. 6	SCH STD, SMLS PIPE
2	1	150	A 420 Gr. WPL6	SCH STD, BV LR 45 DEG ELBOW
3	18	150		PIPE SHOE AS PER DETAIL 2, DWG 65-116-270-200
4	14	150		PIPE SUPPORT AS PER DETAIL 1, DWG 65-116-270-200
5	2	150		PIPE SUPPORT AS PER DETAIL 3, DWG 65-116-270-200

2	2017/09/21	PROJECT TITLE REVISED	KHV
1	2017/09/11	LINE NUMBERS REVISED	KHV
0	2017/05/15	ISSUED FOR CONSTRUCTION	KHV
No.	DATE	REVISION	PAR APP.

CLIENT:



AGNICO EAGLE


NUQSANA PROMEC MINING



Ultragen


CONSULTANT PROJECT NO. **591700**

NO. DE CONDUITE	SPECIFICATION	PRODUIT	SYSTEME REVETEMENT	CODE DE COULEUR	ISOLATION ET TRACAGE	EPASS. D'ISOLATION		
116-150-PEI-CC10-0011	CC10	PDI		-			65-116-270-200	PIPE SUPPORT DETAILS
PRESSION D'OPERATION	TEMPERATURE D'OPERATION	PRESSION DE CONCEPTION	TEMPERATURE DE CONCEPTION	PRESSION D'ESSAI	CLASSE D'INSPECTION	CODE DE SERVICE	TRAITEMENT THERMIQUE	65-116-205-200 P&ID
PSIG	T	PSIG	T	PSIG				No. DESSIN
								DESSINS DE REFERENCE

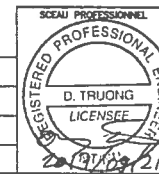

CONC.: KHV DATE: 2017/04/25 DESSINE PAR: KVE DATE: 2017/04/25 VÉR. PAR: - DATE: - APP.: - DATE: - ECHELLE: AUCUNE	PROJECT: AGNICO EAGLE - MELIADINE DIVISION 116 - FUEL TANK FARM	TITRE: RANKIN INLET FABRICATION ISOMETRIC DIESEL FROM 65TNK11601 TO PUMPING STATION	No. PROJET: 6515	No. DESSIN: 116-150-PDI-CC10-0011	PAGES: 4/5	REV: 2
---	--	--	-------------------------	--	-------------------	---------------

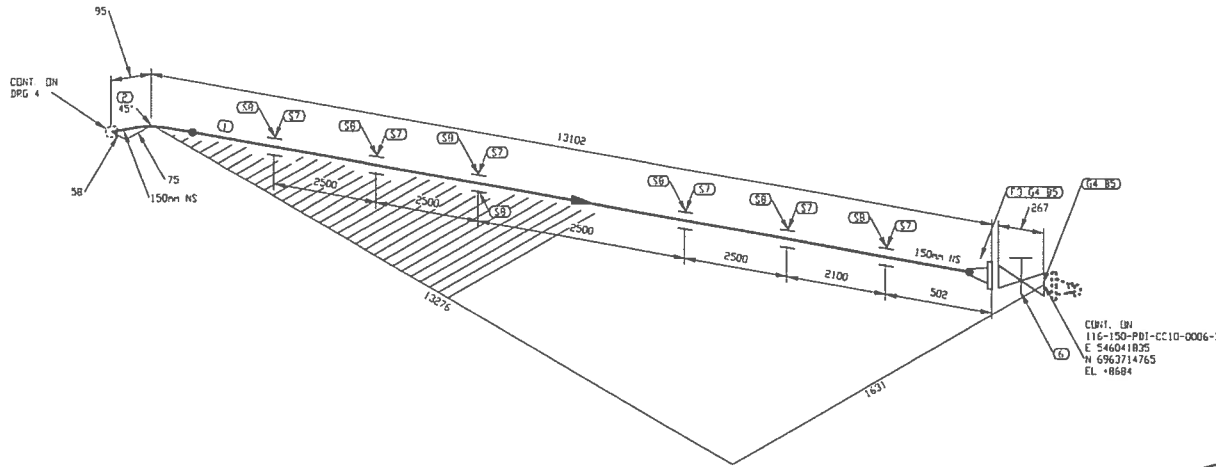

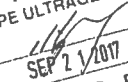PERMIT TO PRACTICE
LE GROUPE ULTRAGEN LTÉE
Signature 
Date **SEP 21 2017**
PERMIT NUMBER: P 1180
NTNU Association of Professional
Engineers and Geoscientists
**FABRICATION DRAWINGS BASED ON
WSP CERTIFIED ENGINEERING**

LISTE DE MATERIEL				
No	QTE	DA	MATERIEL/CATALOGUE	DESCRIPTION
1	12919 MM	150	A 333 Gr. 6	SCH STD, SMLS PIPE
2	1	150	A 420 Gr. WPL6	SCH STD, BV LR 45 DEG ELBOW
3	1	150	A 350 Gr. LF2	CL 150, SCH STD, RF, WN FLANGE
4	2	150	ASME B16.20	CL 150, GARLOCK 5500, RING TYPE GASKET 1/8" THK
5	16	19	A 193 B7/A 194 2H	CL 150, B - 19.05 X 100 STUD BOLTS c/v TVD
6	1	150	GA-10	HEAVY HEX NUTS
7	6	150		CL 150, RF, GATE VALVE
8	7	150		PIPE SUPPORT AS PER DETAIL 1, DNG 65-116-270-200 PIPE SHOE AS PER DETAIL 2, DNG 65-116-270-200

2	2017/09/21	PROJECT TITLE REVISED	KHV
1	2017/09/11	LINE NUMBERS REVISED	KHV
0	2017/05/15	ISSUED FOR CONSTRUCTION	KHV
No.	DATE	REVISION	PAR APP.

CLIENT:



AGNICO EAGLE




NUQSANA-PRONEC MINING




Ultragen

CONSULTANT PROJECT NO. **591700**

NO. DE CONDUITE	SPECIFICATION	PRODUIT	SYSTEME REVETEMENT	CODE DE COULEUR	ISOLATION ET TRACAGE	EPASS. D'ISOLATION	
116-150-PDI-CC10-0011	CC10	PDI		-			65-116-270-200 PIPE SUPPORT DETAILS
PRESSION D'OPERATION	TEMPERATURE D'OPERATION	PRESSION DE CONCEPTION	TEMPERATURE DE CONCEPTION	PRESSION D'ESSAI	CLASSE D'INSPECTION	CODE DE SERVICE	TRAITEMENT THERMIQUE
PSIG	T	PSIG	T	PSIG			65-116-205-200 P&ID
						No. DESSIN	DESSINS DE REFERENCE

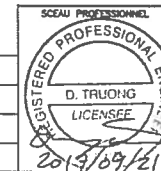

CONC.: KHV	PROJET:	AGNICO EAGLE - MELIADIVISION 116 - FUEL TANK FARM		
DATE: 2017/04/21	TITRE:	RANKIN INLET FABRICATION ISOMETRIC DIESEL FROM 65TNK11601 TO PUMPING STATION		
DESSINE PAR: KHV		No PROJET	No DESSIN	PAGES
DATE: 2017/04/21		6515	116-150-PDI-CC10-0011	5/5
VOIR PAR:				REV.
DATE:				2
APP.:				
DATE:				
ECHELLE: AUCUNE				

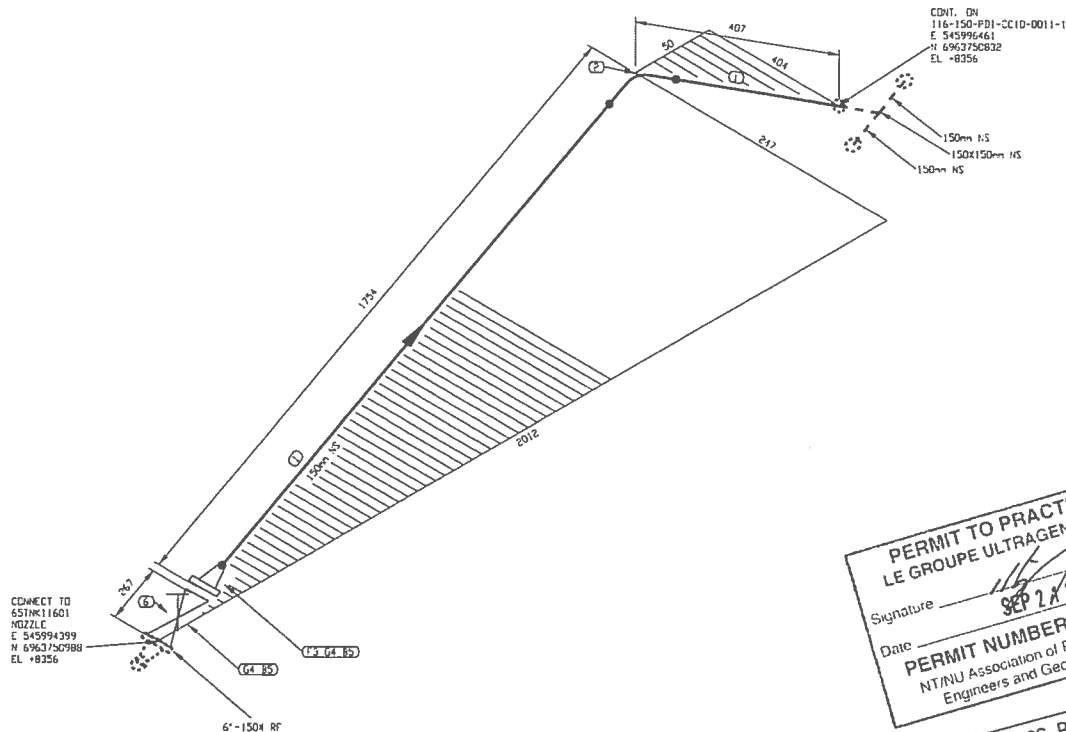

PERMIT TO PRACTICE
LE GROUPE ULTRAGEN LTÉE
Signature *[Signature]*
Date **SEP 24 2017**
PERMIT NUMBER: P 1180
NTNU Association of Professional
Engineers and Geoscientists
FABRICATION DRAWINGS BASED ON
WSP CERTIFIED ENGINEERING

LISTE DE MATERIEL

no	Q'TÉ	QTA	MATÉRIEL/CATALOGUE	DESCRIPTION
1	1616 HM	150	A 333 Gr. 6	SCH STD, SHLS PIPE
2	1	150	A 420 Gr. WPL6	SCH STD, BV LR 90 DEG ELBOW
3	1	150	A 350 Gr. LF2	CL 150, SCH STD, RF, WN FLANGE
4	2	150	ASME B16-20	CL 150, GARLOCK 5500, RING TYPE GASKET 1/8" THK
5	16	19	A 193 B7/4 194 2H	CL 150, 8 - 19.05 x 100 STUD BOLTS c/w TWO HEAVY HEX NUTS
6	1	150	GA-10	CL 150, RF, GATE VALVE

2	2017/09/21	PROJECT TITLE REVISED	KHV
1	2017/09/11	LINE NUMBERS REVISED	KHV
0	2017/05/15	ISSUED FOR CONSTRUCTION	KHV
No.	DATE	REVISION	APP

CLIENT:

AGNICO EAGLE

NUQSANA-PROMET MINING

Ultragen

CONSULTANT PROJECT NO. **591700**

NO. DE CONDUITE	SPECIFICATION	PRODUIT	SYSTEME REVETEMENT	CODE DE COULEUR	ISOLATION ET TRACAGE	EPASS. D'ISOLATION	
116-150-PDI-CC10-0012	CC10	PDI		-			65-116-270-200
PRESSON D'OPERATION	TEMPERATURE D'OPERATION	PRESSON DE CONCEPTION	TEMPERATURE DE CONCEPTION	PRESSON D'ESSAI	CLASSE D'INSPECTION	CODE DE SERVICE	TRAITEMENT THERMIQUE
PSIG	T	PSIG	T	PSIG			65-116-205-200
						No. DESSIN	DESSINS DE REFERENCE

REGISTERED PROFESSIONAL ENGINEER
D. TRUONG
LICENSEE
2017/09/21

CONC. KHV
DATE: 2017/04/23
DESSINE PAR: KHV
DATE: 2017/04/23
VÉR. PAR: -
DATE: -
APP. -
DATE: -
ECHELLE: AUCUNE

PROJET: **AGNICO EAGLE - MELIADINE DIVISION
116 - FUEL TANK FARM**

TITRE: **RANKIN INLET
FABRICATION ISOMETRIC
DIESEL FROM 65THK11601 TO PUMPING STATION**

No. PROJET	No. DESSIN	PAGES	REV.
6515	116-150-PDI-CC10-0012	1/1	2



Vendor Document Status

AGNICO EAGLE

- 1 ☐ Proceed to next submission and status.
- 2 ☐ Proceed with exceptions as noted to next submission and status.
- 3 ☐ Do not proceed.
Revise as noted and resubmit next submission and status.
- 4 ☒ Complete, no further submission required.

By:

Jean-Francois Tremblay

Date:

2017-05-02

Review and authorization to fabricate are only for general conformance with the design concept of the Project as expressed in the Contract Documents. Sole responsibility for the accuracy and completeness of this document, including but not limited to dimensions and quantities, remains with the Supplier/Contractor. Agnico Eagle does not warrant the accuracy or completeness of any of the information contained herein, nor does Agnico Eagle authorize or approve any construction means, methods, techniques, sequences or any safety precautions or procedures.

Agnico Eagle
No.

6515-C-270-007-141-TES-0014 R: Sub001

DOCUMENT FOR INFORMATION



**Agnico-Eagle Mines Ltd.
Non-Conformance Report**

ITR Number : AEM-GE-ITR-002
Contract no. : C22466T / C22498E



PART 1 – To be completed by Originator			
ITR no. :	Supplier/Vendor/Manufacturer/Contractor :	Originator :	Date:
Equipment Identification:		Equipment Tag No.:	
Disposition Requested: ☐ 48 Hours ☐ Other	NCR Classification: ☐ Supplier ☐ Fabrication ☐ Engineering ☐ Construction ☐		
Current Status: ☐ Work Already Done ☐ Partially Done ☐ Other _____	Potential Impact (Check appropriate box and give estimate): ☐ Cost ☐ Schedule ☐ Other		
Detailed Description of Non-Conformance (attach sketch, pictures, etc) :			
Describe Deviation to Drawings, Specifications, Standard, Code or other Reference:			
PART 2 - Disposition			
* CONTRACTOR Proposed Disposition / Resolution: ☐ Use As Is ☐ Repair ☐ Rework ☐ Reject/Scrap		Concession Request No. (if applicable):	Contractors NCR No. (if applicable):
Details of Contractor Corrective Actions Proposed / Concession Request:			
* Disposition: ☐ Use as Is ☐ Repair ☐ Rework ☐ Reject/Scrap		Dispositioning Party:	Signature:
Recommended Resolution / Actions:			
PART 3 - Confirmation			
Corrective Actions Completed By: Name: Date: Signature:		Corrective Actions Accepted by Dispositioning Party: Name: Date: Signature:	
Corrective Actions Accepted by Originator: Name: Date: Signature:		NCR Closed Out By (Area QA Coordinator) Name: Date: Signature:	
* Note: Dispositions are not to be construed as a change to any Contracts which may be affected. Prior to initiating any work which will impact the Contract terms, the Contractors must forward to AMEC written notice of all impacts, including but not limited to cost and schedule. Any work completed without a written instruction to proceed, if required, will be at the Contractor's risk.			



Vendor Document Status

AGNICO EAGLE

- 1 ☐ Proceed to next submission and status.
- 2 ☐ Proceed with exceptions as noted to next submission and status.
- 3 ☐ Do not proceed.
Revise as noted and resubmit next submission and status.
- 4 ☒ Complete, no further submission required.

By: JEAN-FRANCOIS TREMBLAY

Date: 2017-05-02

Review and authorization to ~~fabricate~~ are only for general conformance with the design concept of the Project as expressed in the Contract Documents. Sole responsibility for the accuracy and completeness of this document, including but not limited to dimensions and quantities, remains with the Supplier/Contractor. Agnico Eagle does not warrant the accuracy or completeness of any of the information contained herein, nor does Agnico Eagle authorize or approve any construction means, methods, techniques, sequences or any safety precautions or procedures.

Agnico Eagle
No.

6515-C-270-007-141-TES-0038 R: Sub001

DOCUMENT FOR INFORMATION



Agnico-Eagle Mines Ltd.
Contract no. 6515-C-270-007

Welding Control Procedure
AEM-WE-PRO-001

Area No.: All

System No.: All

PROMEC Approvals

Prepared by: Stéphane Doré Signature:  Date: 2017-04-26

Verified by: Jérémy Duval Signature:  Date: 2017-04-26

Approved by: Éric Poulin Signature:  Date: 2017-04-26

CLIENT Approvals

Verified by: _____ Signature: _____ Date: _____

Approved by: _____ Signature: _____ Date: _____

TABLE OF CONTENTS

	<u>Page</u>
1. SCOPE	3
2. REFERENCES	3
3. WELDING PROCEDURES	3
4. WELDER PERFORMANCE QUALIFICATION	3
5. WELDING MATERIAL CONTROL	4
6. FIT-UP AND WELDING.....	4
7. RADIOGRAPHIC INSPECTION.....	5

APPENDIX A – ALL APPLICABLE ITRs & LOGs

1. Scope

- This procedure describes the system for maintaining control of all production welding to the requirements of the applicable engineering specifications, codes and standards.

2. References

- ASME, Section IX - Welding and Brazing Qualifications
- ANSI, B-31.3 - Petroleum Refinery Piping
- ANSI, B-31.1 - Power Piping
- AWS, American Welding Society

3. Welding Procedures

- All welding performed on site will comply with applicable qualified welding procedures as specified in the Standard S40 05 13.
- Prime contractor's welders will be qualified to weld procedures in accordance with contract specifications. Prime contractor is responsible for certifying their own welders.
- Copies of the qualified welding procedures approved for that project shall be maintained on site by the Welding Foreman and Site Q/C Representative for reference and permanent retention.

4. Welder Performance Qualification

- It is the responsibility of the Site Q/C Representative to conduct or supervise the Welder Performance Qualification tests. At the discretion of the Corporate Quality Control Manager, a Welding Foreman or other qualified site supervisor may conduct these tests.
- Records attesting to the Welder Performance Qualification tests shall be generated and maintained by the Site Q/C Representative and the Welding Foreman.
- The Site Q/C Representative and the Welding Foreman shall maintain a complete listing of welders and welding operators employed. The form, Welder Qualification Log, is to be updated and reissued on a monthly basis and is to be distributed as required.



Agnico-Eagle Mines Ltd.
Welding Control Procedure

PRO Number : AEM-WE-PRO-001
Contract no. : C22466T



5. Welding Material Control

- The Site Q/C Representative and Welding Foreman shall make certain that the welding material used conforms to that of the welding procedure. No substitutions for the specified material will be made without written approval from the client.

6. Fit-Up and Welding

- Visual surveillance shall be performed to establish compliance to welding procedures. The inspection parameters listed below are recommended as guidelines
 - ✓ Inspect end preparation and joint configuration as established by applicable weld procedures and engineering specifications.
 - ✓ Inspect internal alignment and root opening prior to welding.
 - ✓ Check tack welds that are to be incorporated into the final weld, and be assured of proper blend grinding and absence of visual defects.
 - ✓ Check for proper welding materials and other essential variables of applicable weld procedures.
 - ✓ Check visually root pass for cracks, porosity, slag, fusion lines and quality workmanship (if required use LP).
 - ✓ Inspect completed welds for proper reinforcement. All welds should blend smoothly into the base metal and be free of cold lap or fusion at the toe.
 - ✓ Inspect weld for surface discontinuities such as undercut. Surface porosity is to be considered as an injurious defect and shall be repaired.
 - ✓ All repairs are to be made in accordance with approved procedures.
 - ✓ Each welder shall be responsible for stamping his assigned symbol immediately after completion of the weld. A smooth, flat spot shall be ground or filed on the reinforcement cap. The welder shall stamp his/hers identifying mark upon this spot.
- For ferrous material less than 1/4" (1/2" for nonferrous), the welder's symbol shall be recorded on the base metal by use of a halogen-free paint marker, or recorded on isometric drawings by the welding supervisor which shall be available to the Quality Control Inspector.

7. Radiographic Inspection

- The Site Q/C Representative or Welding Foreman will schedule radiographic inspections.
- Radiographic requirements shall be determined by the client standard to assure compliance to contract Codes and specifications.
- Welds requiring radiography will be flagged by a suitable means which will be consistent through contract completion.
- The Site Q/C Representative will complete the Radiographic Inspection Status Record, to indicate status of radio graphically-inspected welds. This form will be forwarded to appropriate supervision for distribution.
- In addition to the records generated under this procedure, marked-up isometric and orthographic drawings will be used as weld maps to indicate completion of radiographic inspection. This will allow a progressive record and give system status.

**PREMIÈRE PASSE E-6011 , 3/32
SMAW**

**REMPLISSAGE E-7018 , 1/8-5/32
SMAW**

ACIER AU CARBONE

Procédure : P-1 , PR-1

Les titres désignent également les hommes et les femmes.


Entreprise/Company	
Construction Promec	
Adresse/Address	
369 rue Murdoch	
Rouyn-Noranda (Québec)	
(819) 797-3456	Code postal J 9 X 1 G 4

② Enregistrement provincial Provincial Registration	MS WP 8814.6
--	-----------------

③ Désignation de la méthode/Procedure Identification	
DMS N° WPS No. P1	Révision N° Revision No. 0
RMS N° PQR No. PRI	
Section du code Code section	

④ Procédé(s) de soudage Welding Process(es)	1 SMAW	Manuel/Manual ☒	Semi-auto. ☐	Auto. ☐
	2	Manuel/Manual ☐	Semi-auto. ☐	Auto. ☐
	3	Manuel/Manual ☐	Semi-auto. ☐	Auto. ☐

⑤ Joints/Joints (QW-402)	
Genre/Design	VW Fillet Chan Frein Simple Chan Frein Double
Soutien Backing	Oui ☒ Non ☒
Matériau de soutien Backing material	P1 ou soudure
Autre Other	

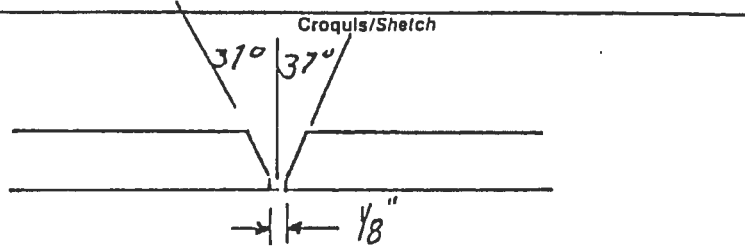

⑥ Métaux de base/Base Metals (QW-403)	
P N°/No. P1	Gr N°/No. à/to P N°/No. P1 Gr N°/No.
ou Spécifications type et grade or Specifications type and grade	
à/to	
chimique et prop. mec. Chemical Analysis and Mech. Prop.	
à/to F3 F4	
Gamme des épaisseurs qualifiées Thickness Range Qualified	
Total 3/16" à 1 1/2"	1 1/4" 2 1 1/4" 3
Autre Other	

⑦ Métaux d'apport/Filler Metals (QW-404)	
AWS N°/No. E6011	SFA 5.1 F-No. 3 A-No. 1 Dia. 3/32-1/8-5/32
AWS N°/No. E7018	SFA 5.1 F-No. 4 A-No. 1 Dia. 3/32-1/8-5/32
AWS N°/No.	SFA F-No. A-No. Dia.
Marque de commerce du flux Flux Tradename	Classification du flux-électrode Electrode-Flux Classification
Pièce insérée consommable Consumable Insert	Autre Other

⑧ Positions/Positions (QW-405)	
Position(s) du chanfrein Position(s) of Groove	Toute position
Progression du soudage Welding Progression	Montant ☒ Descendant ☒
Position(s) de l'angle Position(s) of Fillet	Toute position
Autre Other	

⑩ Traitement thermique postsoudage/ Postweld Heat Treatment (QW-407)	
Gamme de températures Temperature Range	Aucun
Gamme de durée Time Range	
Autre Other	

⑪ Préchauffage/Preheat (QW-406)	
Température de préchauffage Preheat Temperature	Min. 60°F
Température de l'interpassage Interpass Temperature	
Maintien du préchauffage Preheat Maintenance	
Autre Other	

⑪ Gaz/Gas (QW-408)	
Composition du gaz de protection Shielding Gas Composition	
Débit du gaz Gas Flow Rate	
Composition du gaz de soutien Backing Gas Composition	
Débit du gaz Gas Flow Rate	
Composition du gaz de protection traînant Trailing Shielding Gas Composition	

Caractéristiques électriques et techniques/Electrical Characteristics and Techniques (QW-409) + (QW-410)								
Méthode(s) de soudure Process(es)	Procédé Process	Métal d'apport Filler Metal		Courant Current				Gamme de vitesse Travel Speed Range
		Classification Classification	Diamètre Diameter	Type Type	Polarité Polarity	Gamme d'ampérage Amp Range	Gamme de voltage Volt Range	
à	SHAW	E6011	1/8" à 5/32"	DC	Inversé	75 - 85	26-30	--
à	SHAW	E7018	1/8" à 5/32"	DC	Inversé	105 - 110	26-30	--

Taille et type d'électrode de tungstène
 Electrode Size and Type: --

Mode de transfert du métal pour GMAW
 Metal Transfer for GMAW: --

Longueur de la goutte ou oscillant
 Bead or Weave Bead: Droit et oscillant

Mode de gougeage arrière
 Back Gouging: Arc Air

Nettoyage initial et entre les passes (brossage, meulage, etc.)
 Initial and Interpass Cleaning (Brushing, Grinding, etc.): Brossage ou meulage

Taille de la tuyère à gaz
 Gas Cup Size: --

Largeur
 Width: --

Fréquence
 Frequency: --

Distance entre tuyère & pièce
 Torch to Work Distance: --

Nombre de passes (par côté)
 Single Pass (per Side): --

Mode unique ou multiple
 Single or Multiple Electrode: --

Gamme de vitesse d'alimentation de l'électrode
 Wire feed speed range: --

Pas de martelage

Autres commentaires/Supplementary Comments

Signature du représentant de l'entreprise
Company Representative's Signature: *Donald H. Catil*

Date
Date: 15 janv. 88

Réservé au ministère/Department use only

Date: 1/20/88

QC MINISTÈRE DU TRAVAIL ET DE LA MAIN-D'OEUVRE

APPROUVÉ

SECON LA LOI SUR LES STANDARDS GÉNÉRAUX

VERIFIÉ PAR: *[Signature]*

DATE: 01/23

Illes désignent également les hommes et les femmes.

(Référence: ASME Section IX)

1 Entreprise/Company			
Nom/Name: Construction Promec			
Adresse/Address: 369 rue Murdoch			
Rouyn-Noranda (Québec)			
819-797-3456		Code postal: J9X 1G4	
4 Procédé(s) de soudage/Welding Process(es)			
SMAW		Type: Manuel	
		Type:	
		Type:	
3 Métaux de base/Base Metals (QW-403)			
No. 1	Gr No.	À/to	P No. 1 Gr No.
Spécification/Specification		Tension/Tensile	
SA - 516 - 70		70 000	
Épaisseur/Thickness: 3/4"		Diamètre/Diameter:	
Métaux d'apport/Filler Metals (QW-404)			
Classification (AWS)	SFA - No.	F - No.	A - No.
E-6011	5.1	3	1
E-7018	5.1	4	1
Positions/Positions (QW-405)			
Position(s) du joint/Position(s) of Groove: 1 - G			
Progression du soudage/Welding Progression		Montant Up ☐	Descendant Down ☐
Préchauffage/Preheat (QW-406)			
Température de préchauffage/Preheat Temperature: 60°F			
Température de l'interpassage/Interpass Temperature:			

2 Enregistrement provincial/Provincial Registration		MS WP: 8814.6
3 Désignation du résultat/Record Identification		
RMS N°	PR-1	
PQR No.		
DMS N°	P -1	
WPS No.		
5		
Croquis du joint utilisé/Groove Design used		
10 Traitement thermique postsoudage/Postweld Heat Treatment (QW-407)		
Température/Temperature: aucun		
Durée/Time:		
Autre/Other:		
11 Gaz/Gas (QW-408)		
Composition du gaz de protection/Shielding Gas Composition: --		
Débit du gaz/Gas Flow Rate:		
Composition du gaz de soutien/Backing Gas Composition:		
Débit du gaz/Gas Flow Rate:		
Autre/Other:		
12 Technique/Technique (QW-410)		
Cordon droit ou oscillant/String or Weave Bead: droit		
Oscillation/Oscillation:		
Passe unique ou multiple (par côté)/Multipass or Single Pass (Per Side): multiple		
Électrode unique ou multiple/Single or Multiple Electrode: unique		
Autre/Other:		

Caractéristiques électriques et techniques/Electrical Characteristics and Technique (QW-409) + (QW-410)								
Couche(s) de soudure/Number of Pass(es)	Procédé/Process	Métal d'apport/Filler Metal		Courant/Current				Vitesse/Travel Speed
		Classification	Diamètre/Diameter	Type	Polarité/Polarity	Ampérage/Amp	Voltage/Volt	
Préchauffage/Preheat	SMAW	E-6011	1/8	DC	Inverse	85	26-30	-
Interpassage/Interpass	SMAW	E-7018	1/8	DC	Inverse	105	26-30	-

12
 QC MINISTÈRE DU TRAVAIL ET
 DE LA MAIN-D'ŒUVRE
 APPROUVÉ
 SELON LA LOI SUR LES ALIÉNÉS
 ÉOUS PRESSION D.I.E.T.
 VÉRIFIÉ PAR: [Signature]
 DATE: [Signature]
 100005

Caractéristiques électriques et techniques/Electrical Characteristics and Technical Data (QW-409) + (QW-410)								
Méthode(s) de soudure Welding Method(s)	Procédé Process	Métal d'apport Filler Metal		Courant Current				Gamme de vitesse Travel Speed Range
		Classification	Diamètre Diameter	Type	Polarité Polarity	Gamme d'ampérage Amp Range	Gamme de voltage Volt Range	
SHAW	SHAW	E6011	1/8" à 5/32"	DC	Inversé	75 - 85	26-30	--
SHAW	SHAW	E7018	1/8" à 5/32"	DC	Inversé	105 -110	26-30	--

tailleur et type d'électrode de tungstène
Tungsten Electrode Size and Type

--

mode de transfert du métal pour GMAW
Metal Transfer Mode for GMAW

--

forme droite ou oscillante
Straight or Weave Bead

Droit et oscillant

mode de gougeage arrière
Back Gouging Method

Arc Air

nettoyage initial et entre les passes (brossage, meulage, etc.)
Initial and Interpass Cleaning (Brushing, Grinding, etc.)

Brossage ou meulage

tailleur de la tuyère à gaz
Gas Cup Size

--

largeur
Width

--

fréquence
Frequency

distance entre tuyère et pièce
Torch to Work Distance

--

simple ou multiple (par côté)
Single or Multiple Pass (per Side)

--

électrode unique ou multiple
Single or Multiple Electrode


--

gamme de vitesse d'alimentation de l'électrode
Wire Feed Speed Range

--

ne pas marteler
Pas de martelage

Autres commentaires/Supplementary Comments

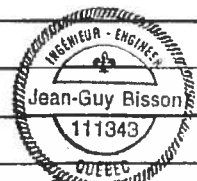

Reviewed And Accepted by Construction Prover Inc. QC Manager
Date: MARCH 29, 2007 Signed: Jean-Guy Bisson, eng

Signature du représentant de l'entreprise
Company Representative's Signature

Date
Date

15 janv. 88

Réservé au ministère/Department use only

é par

Date:

re N°





**Agnico-Eagle Mines Ltd.
Welding Control Procedure**

**PRO Number : AEM-WE-PRO-001
Contract no. : C22466T**



Appendix A

ALL APPLICABLE ITRs & LOGs

Date de qualification	Qualification
2017-05-06	Soudage sur appareils sous pression Classe A Tuyaux 50 mm, catégorie 160-P1-6G, F3-F4

Emploi

Québec  **Certificat de qualification**

Nom de famille MASSICOTTE-ROY	Número de dossier 0000000176159
Prenom ALEXANDRE	

Déllvré en vertu de la Loi sur la formation et la qualification professionnelles de la main-d'oeuvre (L.R.Q., chapitre F-5).

Déllvré le 2017-05-06
Expire le 2019-05-06

X

Signature

Ministère du Travail, de l'Emploi et de la Solidarité sociale **001386104**

Date de qualification	Qualification
2015-11-18	Soudage sur appareils sous pression Classe A Tuyaux 50 mm, catégorie 160-P1-6G, F3-F4

334 (07-2009)

Plier
ici

Détacher sur le pointillé

Plier
ici

Emploi

Québec

Certificat de qualification

Nom de famille FAUBERT	
Prénom STEVEN	Numéro de dossier 0000000125746

Délivré en vertu de la Loi sur la formation et la qualification professionnelles de la main-d'oeuvre (L.R.Q., chapitre F-5).

Délivré le
2015-11-18
Expire le
2017-11-18

x 
Signature

Ministère du Travail, de l'Emploi et de la Solidarité sociale **001139657**

Objet : Délivrance de votre certificat de qualification

Date de qualification	Qualification
2015-05-28	Soudage sur appareils sous pression Classe A Tuyaux 50 mm, catégorie 160-P1-6G, F3-F4


Emploi

Québec  Certificat de qualification

Nom de famille MARTEL	
Prénom SYLVAIN	Numéro de dossier 0000000046942

Délivré en vertu de la Loi sur la formation et la qualification professionnelles de la main-d'oeuvre (L.R.Q., chapitre F-5).

Délivré le 2015-05-28
Expire le 2017-05-28

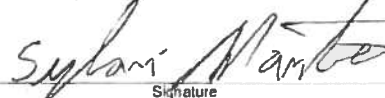X 
Signature

Ministère de l'Emploi et de la Solidarité sociale

001055843

Date de qualification

2017-05-06

Qualification

Soudage sur appareils sous pression Classe A

Tuyaux 50 mm, catégorie 160-P1-6G, F3-F4

Emploi

Québec



Certificat de qualification

Nom de famille

LEROUX

Prénom

STEPHANE

Numéro de dossier

0000000102229

Délivré en vertu de la Loi sur la formation et la qualification professionnelles de la main-d'œuvre (L.R.Q., chapitre F-5).

Délivré le

2017-05-06

Expire le

2019-05-06

X

Stephane Leroux
Signature

Ministère du Travail, de l'Emploi et de la Solidarité sociale

001386103

Alberta

Municipal Affairs
and Housing

21396

ABSA

the pressure equipment safety authority

Grade "B" Pressure Welder's

Certificate of Competency

This is to certify that **Marylene Paul**
having complied with provisions of the Safety Codes Act, is authorized to engage
in pressure welding in accordance with the prescribed Regulations.

Dated at Edmonton
October 04, 2007



W-26448

File no.

A handwritten signature in dark ink, appearing to read "L. Chan".

Chief Inspector and Administrator

Date de qualification	Qualification
2017-10-21	Soudage sur appareils sous pression Classe A Tuyaux 50 mm, catégorie 160-P1-6G, F3-F4

Emploi Québec  **Certificat de qualification**

Nom de famille
PAUL

Prénom
MARYLENE


Numéro de dossier
0000000018964

Délivré en vertu de la Loi sur la formation et la qualification professionnelles de la main-d'œuvre (RLRQ, chapitre F-5).

x 
Signature

Délivré le
2017-10-21
Expire le
2019-10-21

Ministère du Travail, de l'Emploi et de la Solidarité sociale **001457589**

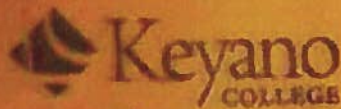

Welder Performance Qualification Card

AOQP No.
7121

MARYLENE PAUL
Name

W-26448
File No.

This card is issued pursuant to the Safety Codes Act and the Pressure Welders Regulation. The performance qualification is in accordance with Section IX of the ASME Code and subject to the limitations on the reverse side.

MARCH 17-2016
Date of Test

Marylene Paul
Welder's Signature

Louis Boutin
Welding Examiner (Print/type)

CARD No. **8816**

Performance Qualification

CARD No. **8816**

Processes SMW SMW

Materials (P. No.) P115/34/4

Filler Metal
(F. No.) F3 F4

Min. Diameter 25mm

Max. Deposited
Weld Metal 6mm MAX

Position(s)
Qualified ALL

Backing OPTIONAL

Backing Gas N/A

Progression UPHILL

28 March 12 [Signature] 15000

PQ Expiry Date

Welding Examiner Signature

File No.

Date de qualification	Qualification
2017-02-11	Soudage sur appareils sous pression Classe A Tuyaux 50 mm, catégorie 160-P1-6G, F3-F4

Emploi

Québec



Certificat de qualification

Nom de famille

GAUTHIER TOURIGNY

Prénom

KEVIN

Numéro de dossier

0000000114581

Délivré en vertu de la Loi sur la formation et la qualification professionnelles de la main-d'oeuvre (L.R.Q., chapitre F-5).

Délivré le

2017-02-11

Expire le

2019-02-11

X

Signature

Ministère du Travail, de l'Emploi et de la Solidarité sociale

001336789



Vendor Document Status

AGNICO EAGLE

- 1 ☐ Proceed to next submission and status.
- 2 ☐ Proceed with exceptions as noted to next submission and status.
- 3 ☐ Do not proceed.
Revise as noted and resubmit next submission and status.
- 4 ☒ Complete, no further submission required.

By:

Jean-Francois Tremblay

Date: 2017-05-02

Review and authorization to fabricate are only for general conformance with the design concept of the Project as expressed in the Contract Documents. Sole responsibility for the accuracy and completeness of this document, including but not limited to dimensions and quantities, remains with the Supplier/Contractor. Agnico Eagle does not warrant the accuracy or completeness of any of the information contained herein, nor does Agnico Eagle authorize or approve any construction means, methods, techniques, sequences or any safety precautions or procedures.

Agnico Eagle
No.

6515-C-270-007-141-TES-0017 R: Sub001

DOCUMENT FOR INFORMATION



Agnico-Eagle Mines Ltd.
Inspection Deficiency Report

ITR Number : AEM-GE-ITR-005
Contract no. : C22466T / C22498E



AGNICO EAGLE

Area:	CWP No:
Equipment Tag No:	Inspection Deficiency Report No:
Date:	Page _____ of _____
Reference Drawings:	
Reference Photos:	
Description of Deficiency:	
Suggested Solution:	
Engineering Contact Made: Yes ☐ No ☐ Name:	
Course of Action:	
Engineering Follow-up Required: Yes ☐ No ☐ Date Required:	

Promec's Representative
Print Name

Client's Representative
Print Name

Promec's Representative
Signature

Date

Client's Representative
Signature

Date



6515-C-270-007

Fuel Tanks Piping Supply and Installation

Inspection Deficiency Log

Document Number : AEM-GE-LOG-004

Contract Number : C22466T / C22984E



AGNICO EAGLE

Number	Description	Initiator	Dept.	Date	Contract No.	Progress Status
Deficiency-001	Vendor Document Status 1 ☐ Proceed to next submission and status. 2 ☐ Proceed with exceptions as noted to next submission and status. 3 ☐ Do not proceed. Revise as noted and resubmit next submission and status. 4 ☒ Complete, no further submission required. By: JEAN-FRANCOIS TREMBLAY Date: 2017-05-16 Review and authorization to fabricate are only for general conformance with the design concept of the Project as expressed in the Contract Documents. Sole responsibility for the accuracy and completeness of this document, including but not limited to dimensions and quantities, remains with the Supplier/Contractor. Agnico Eagle does not warrant the accuracy or completeness of any of the information contained herein, nor does Agnico Eagle authorize or approve any construction means, methods, techniques, sequences or any safety precautions or procedures. Agnico Eagle No. 6515-C-270-007-141-TES-0020 R: Sub001 DOCUMENT FOR INFORMATION					N/A
Deficiency-002						N/A
Deficiency-003						N/A
Deficiency-004						N/A
Deficiency-040						N/A



Vendor Document Status

AGNICO EAGLE

- 1 ☐ Proceed to next submission and status.
- 2 ☐ Proceed with exceptions as noted to next submission and status.
- 3 ☐ Do not proceed.
Revise as noted and resubmit next submission and status.
- 4 ☒ Complete, no further submission required.

By: **JEAN-FRANCOIS TREMBLAY**

Date: **2017-06-22**

Review and authorization to fabricate are only for general conformance with the design concept of the Project as expressed in the Contract Documents. Sole responsibility for the accuracy and completeness of this document, including but not limited to dimensions and quantities, remains with the Supplier/Contractor. Agnico Eagle does not warrant the accuracy or completeness of any of the information contained herein, nor does Agnico Eagle authorize or approve any construction means, methods, techniques, sequences or any safety precautions or procedures.

Agnico Eagle
No.

6515-C-270-007-141-TES-0045 R: Sub002

DOCUMENT FOR INFORMATION



Agnico-Eagle Mines Ltd.
Pressure Test Report

ITR Number : AEM-PI-ITR-001
Contract no. : C22466T



Design Code	Design Test Pressure	Test Medium	Medium Temp.	Test Duration

P&ID (Highlight Boundaries)	Rev	Line	Drawing/ISO	Rev	Spool

Pressure Test Specifications

	Contractor	Date (dd-mm-yy)	Client	Date (dd-mm-yy)
Pre-Hydro Inspection				
NDE/PWHT Clearance				
Release for Test				

Test Instruments

	Make/Model	Serial Number	Test Range (psi)	Calibration Date
Upper				
Lower				

Test Data

	Time	Test Pressure	Ambient Temp. (C)	Pipe Temp. (C)	Comments
Start					
Finish					

Comments/Referenced Documents (e.g. applicable field reports):

PRESSURE TEST COMPLETE

Contractor Representative			Client Representative		
Name (Print)	Signature	Date	Name (Print)	Signature	Date

LINE RESTORATION COMPLETE

Contractor Representative			Client Representative		
Name (Print)	Signature	Date	Name (Print)	Signature	Date

ADDITIONAL LINES[illegible]



FORM PRESSURE TEST REPORT

No.doc. : F172-08
Version : 02
Revision : a

Design Code	Design Test Pressure	Test Medium	Medium Temp.	Test Duration
	100 PSI	Pneumatic	15c	60 min

P&ID (Highlight Boundaries)	Rev	Line	Drawing/ISO	Rev	Spool
See attached			116-150-PDI-CC10-0011	2	Pgs 1-5
			116-150-PDI-CC10-0012	2	1/1

Pressure Test Specifications

	Contractor	Date (dd-mm-yy)	Client	Date (dd-mm-yy)
Pre-Hydro Inspection	Promec	13/07/2018		
NDE/PWHT Clearance				
Release for Test				

Test Instruments

	Make/Model	Serial Number	Test Range (psi)	Calibration Date
Upper	winters	G17-0672	0-300	May 15th 2017
Lower				

Test Data

	Time	Test Pressure	Ambient Temp. (C)	Pipe Temp. (C)	Comments
Start	2h05 P.M.	100PSI	15c	15c	
Finish	3h30 P.M.	100PSI	15c	15c	

Comments/Referenced Documents (e.g. applicable field reports):

PRESSURE TEST COMPLETE

Contractor Representative	Client Representative
JEAN-SEBASTIEN LEBLANC FOR Robbie Lamothe Signature July 13th 2018	James Cardinal Signature July 13th 2018

LINE RESTORATION COMPLETE


Contractor Representative	Client Representative
JEAN-SEBASTIEN LEBLANC FOR Robert Lamothe Signature July 13th 2018	James Cardinal Signature July 13th 2018


ADDITIONAL LINES


Prepared by : Stéphane Doré


Approved by : Éric Poulin


Date : 18-04-2018

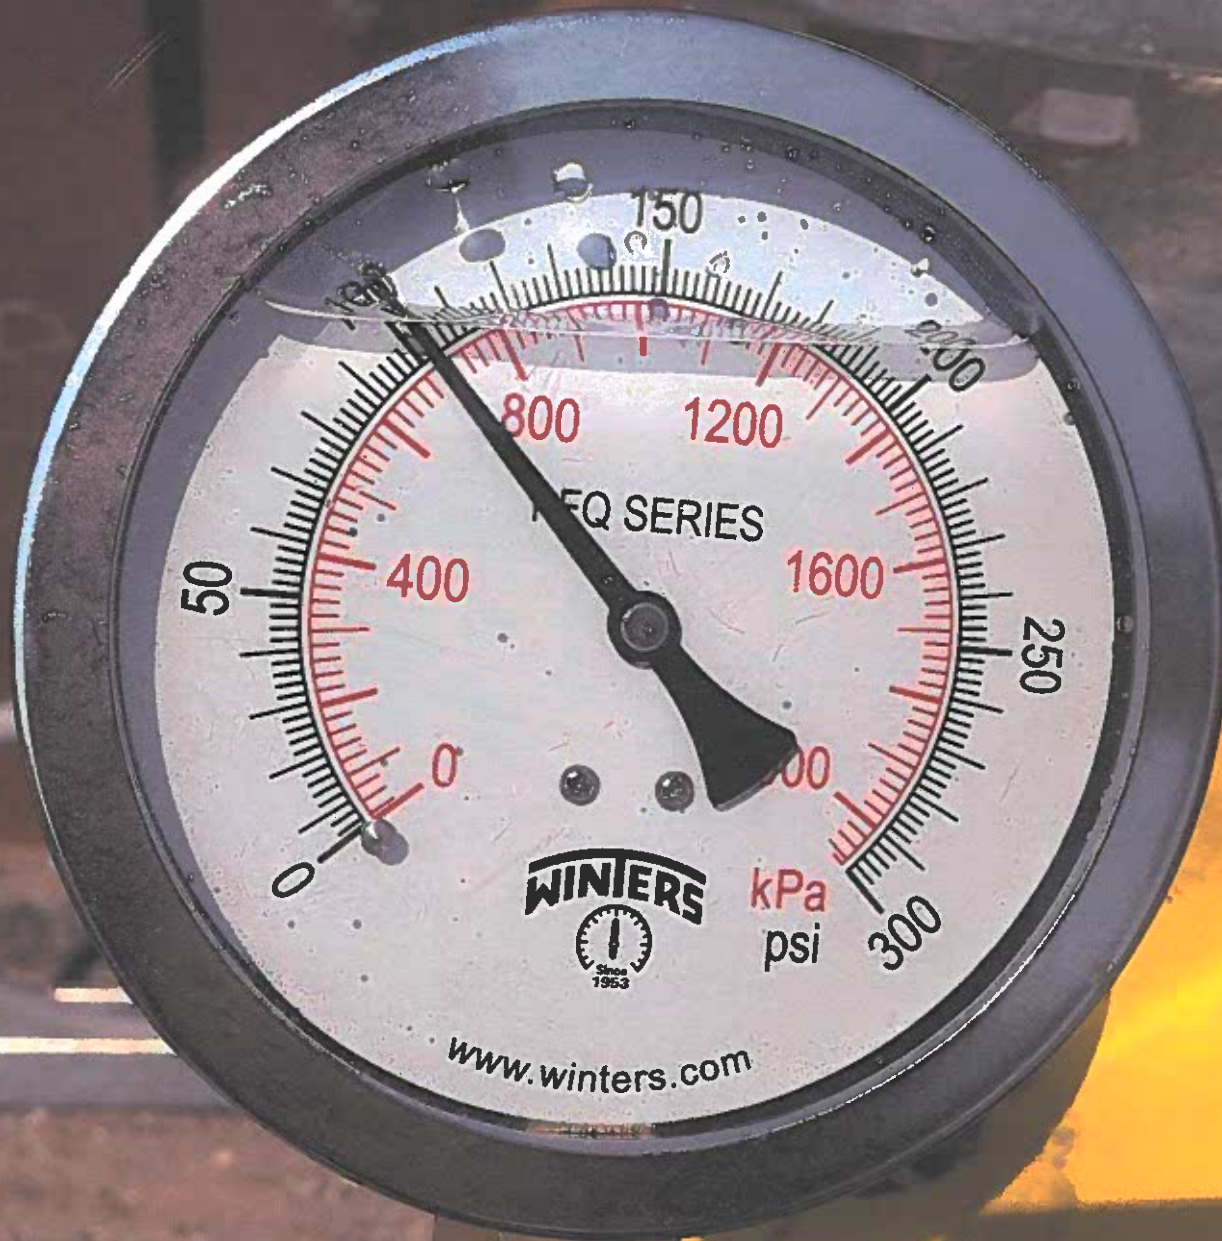

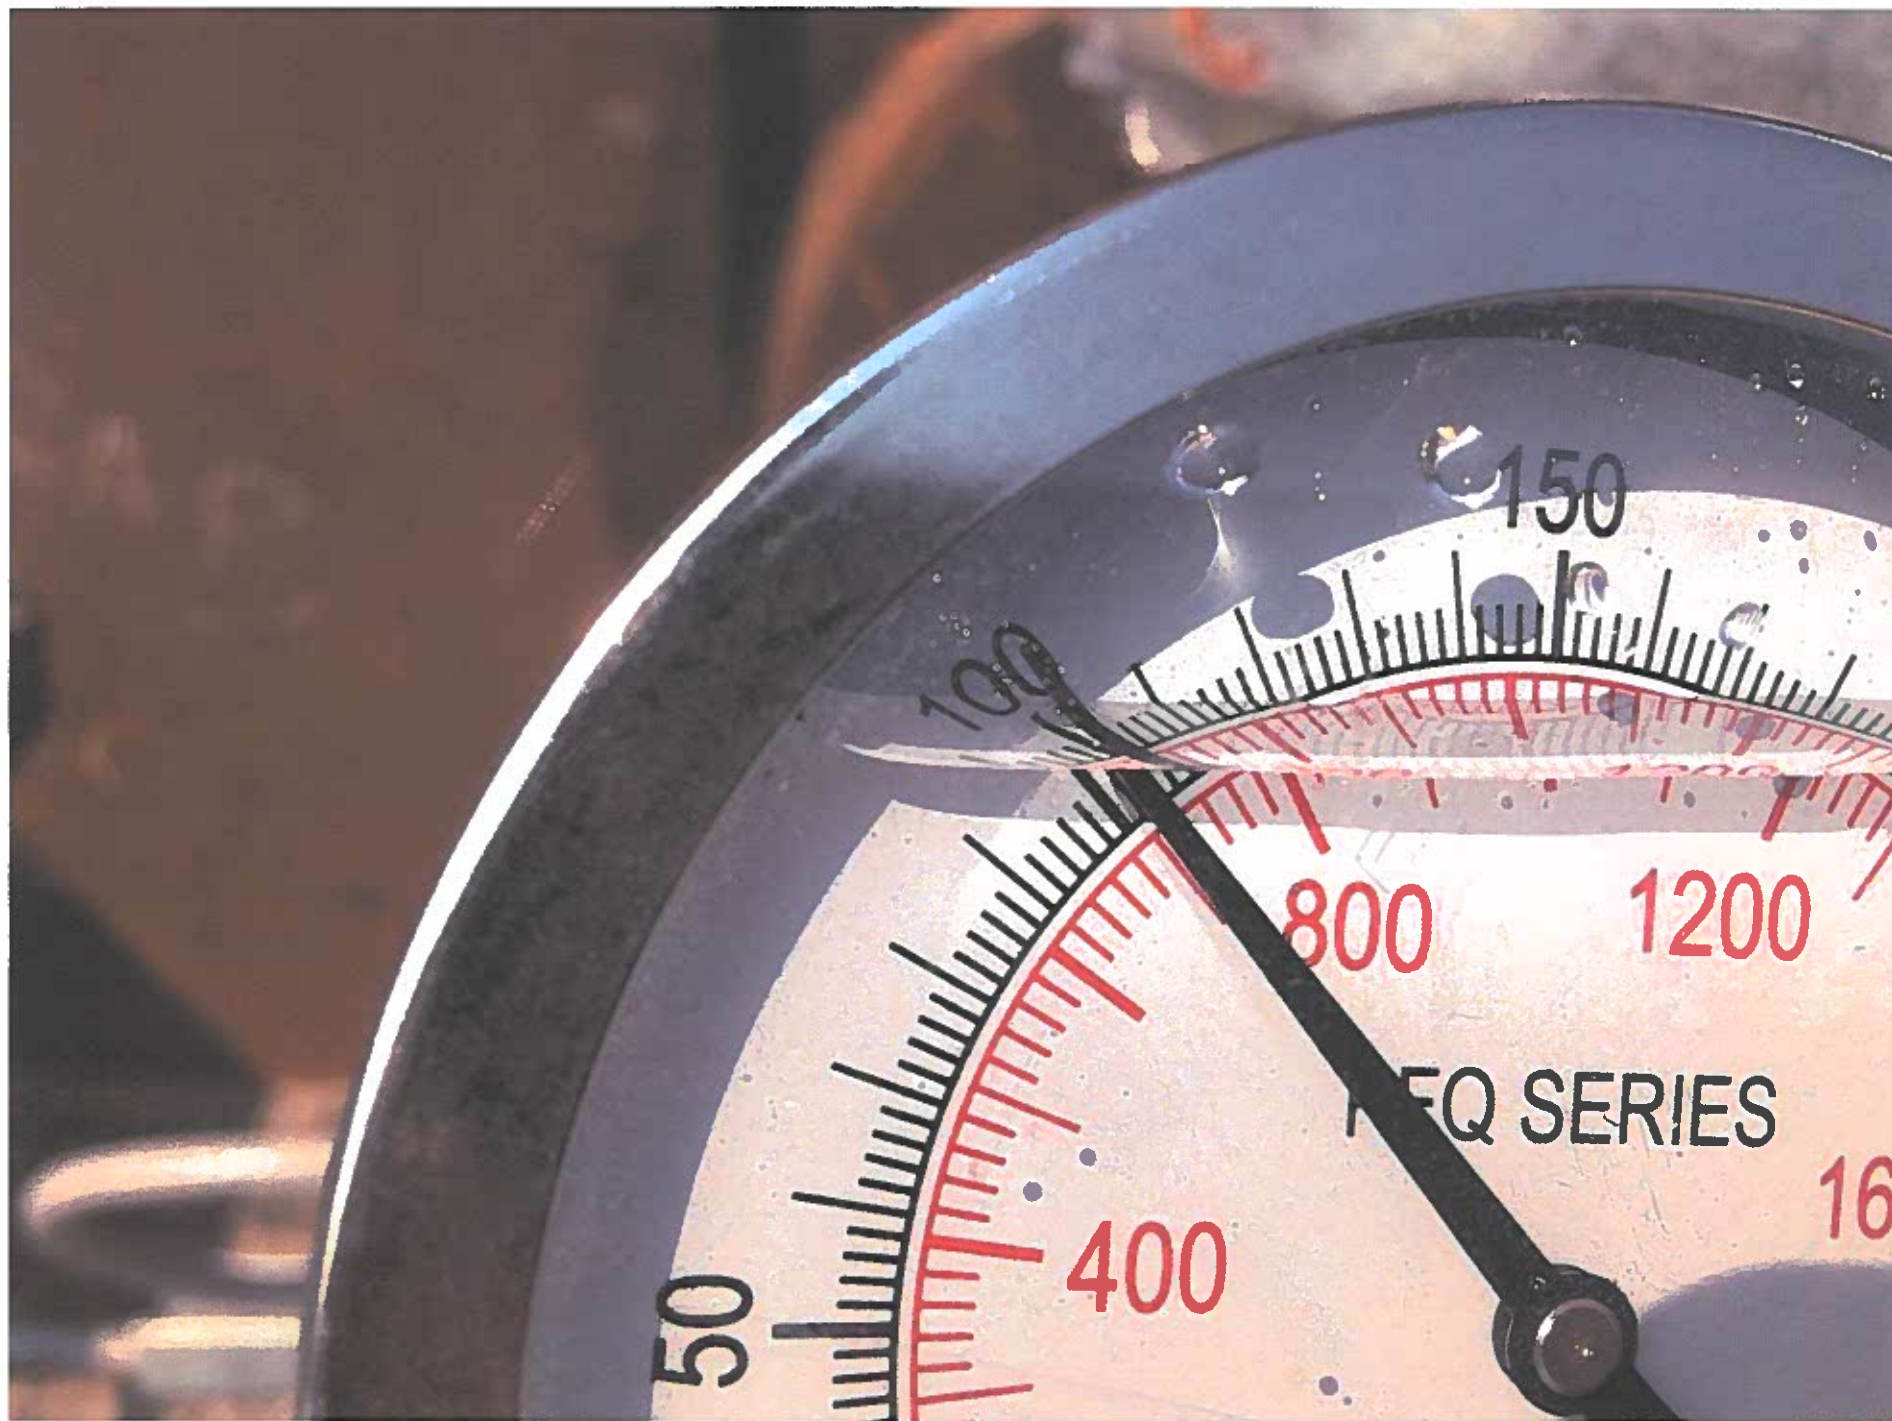

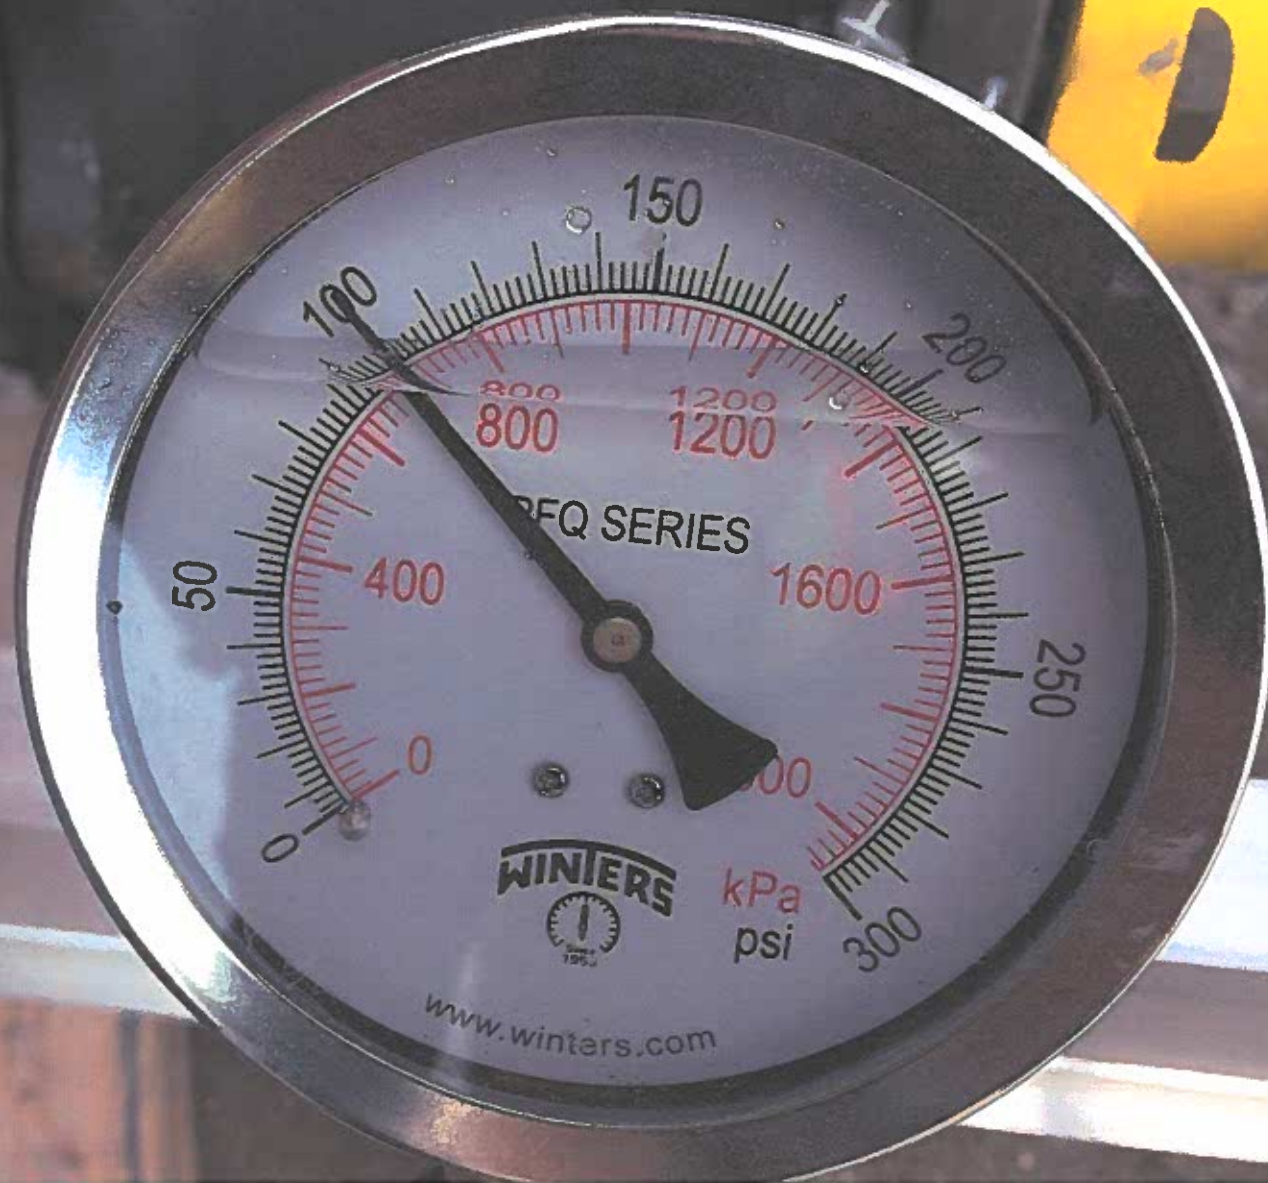

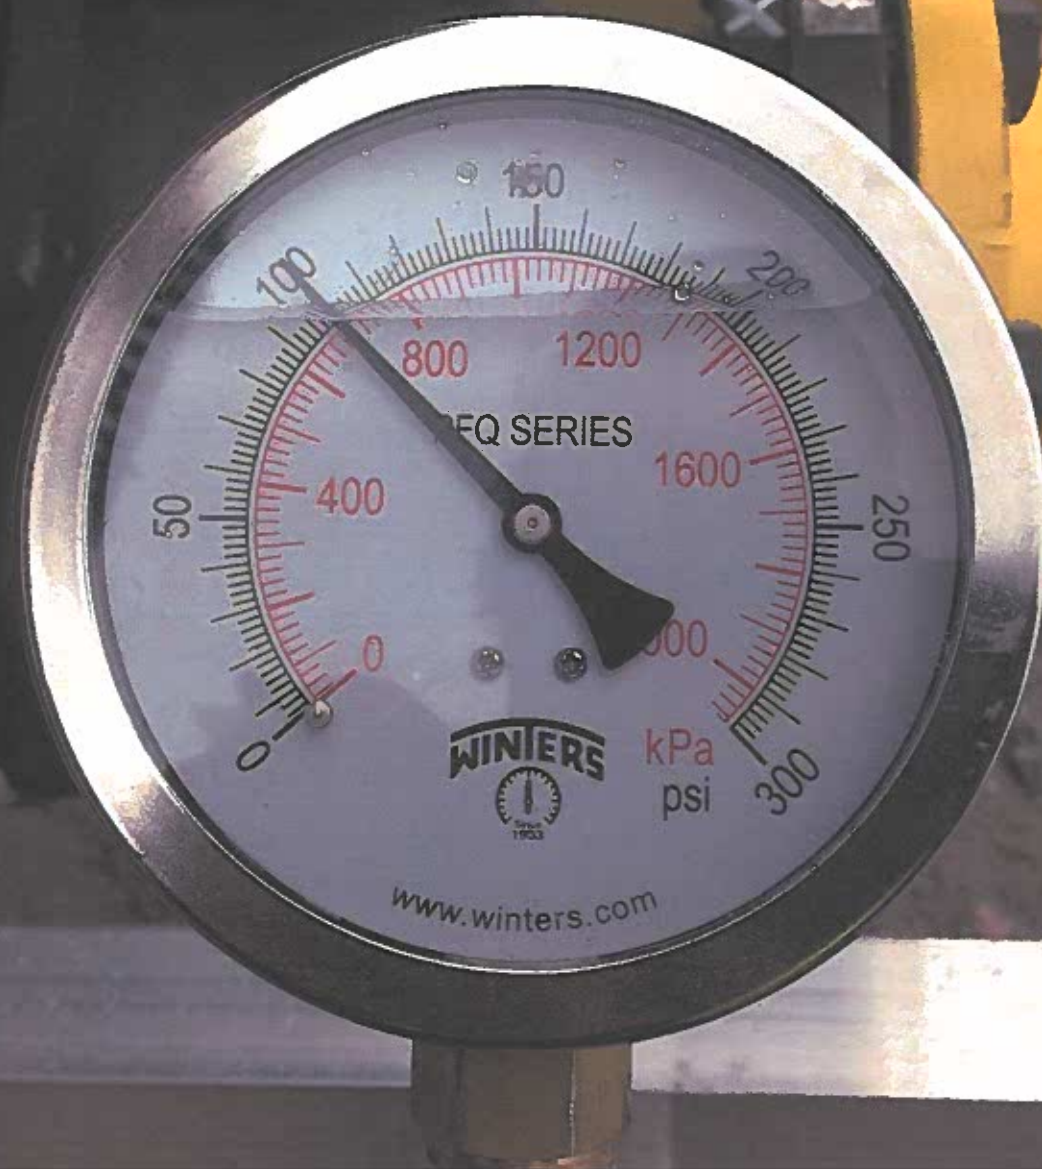

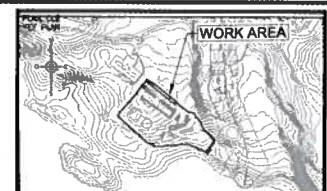

1075, 36 AVENUE E
VAL-D'OR (QUÉBEC) CANADA J9P 6M1
TÉL.: 1-819-825-4711 | TÉLÉC.: 1-819-825-4715 | WWW.WSPGROUP.COM

NOTES GÉNÉRALES / GENERAL NOTES

1. REPLACE DRAWING : 65-103-205-200
2. EQUIPMENTS NUMBERING AS PER AEM STANDARDS.
DOCUMENTS: 0102-000-100-STD-002 &
0102-CDL-02
3. ALL DRAINS TO BE INSTALLED HORIZONTALLY.

[illegible]

DESSINS EN RÉFÉRENCE / REFERENCE DRAWINGS

[illegible]

AGNICO EAGLE

[illegible]

REVISIONS



AGNICO EAGLE - MELIADINE DIVISION
116 - FUEL TANK FARM
205 - P&ID
FUEL DISTRIBUTION
FLOW DIAGRAM

DESSINE PAR DRAWN BY	GHISLAINE CORNUT, tech.	DATE 2017-05-26
-------------------------	-------------------------	--------------------

VERIFIÉ PAR CHECKED BY	JÔEL MORLIÈRE, tech.	2017-05-26
---------------------------	----------------------	------------

APPROUVE PAR APPROVED BY	DENS THIBODEAU, P. Eng.	2017-05-26
SCHEMÉ	DATE	

ECHELLE SCALE	NONE	DATE	2017-05-26
NO. DSSIN			

65-116-205-200

NO. PROJET PROJECT NO.	REVISION	FEUILLE / SHEET
	3	1 / 1

LEGEND

PIPING

RANGED	THROAT	RANGED	THROAT
	BALL VALVE		PIG CATCHER
	GATE VALVE		FLOW INDICATOR "VISI-FLOW"
	PRESSURE RELIEF VALVE		METER
	CONTROL VALVE		c/o STRAINER & BLEEDER
	MOTORIZED BALL VALVE		VALVE-NORMALLY OPEN
	CHECK VALVE		VALVE-NORMALLY CLOSED
	STRAINER		PIPE DOWN
	FLEXIBLE		PIPE UP
	REDUCER		PUMP
	UNION		5 PSI PRESSURE RELIEF VALVE KIT: PIPING #12.5 SCH. 80 PRESSURE RELIEF VALVE (ADJUSTED TO 5 PSI UNLESS OTHERWISE SPECIFIED), UNION, T WITH PLUG & BALL VALVE
	FLANGES		PRESSURE GAGE TO VACUUM OF PUMPE (VACUUM)
	BLANK FLANGE		PRESSURE GAGE TO DISCHARGE OF PUMP (POSITIVE PRESSURE)
	CAP		TEMPERATURE PROBE
	CONNECTION		

VERTICAL TANK

	OUTLET
	GAGE HATCH
	RADAR GAGE
	TEMPERATURE SENSOR (OUTLET #19)
	VENT


VENTILATION

- ✓ AIR BALANCING KEY
- ✓ AIR PRESSURE RELIEF OR BACK-DRAFT DAMPER
- ┌ MANUEL FLAP
- ⊙ AIR FLOW SWITCH

GENERAL

(E) EXTINGUISHER 20 BC

P&ID

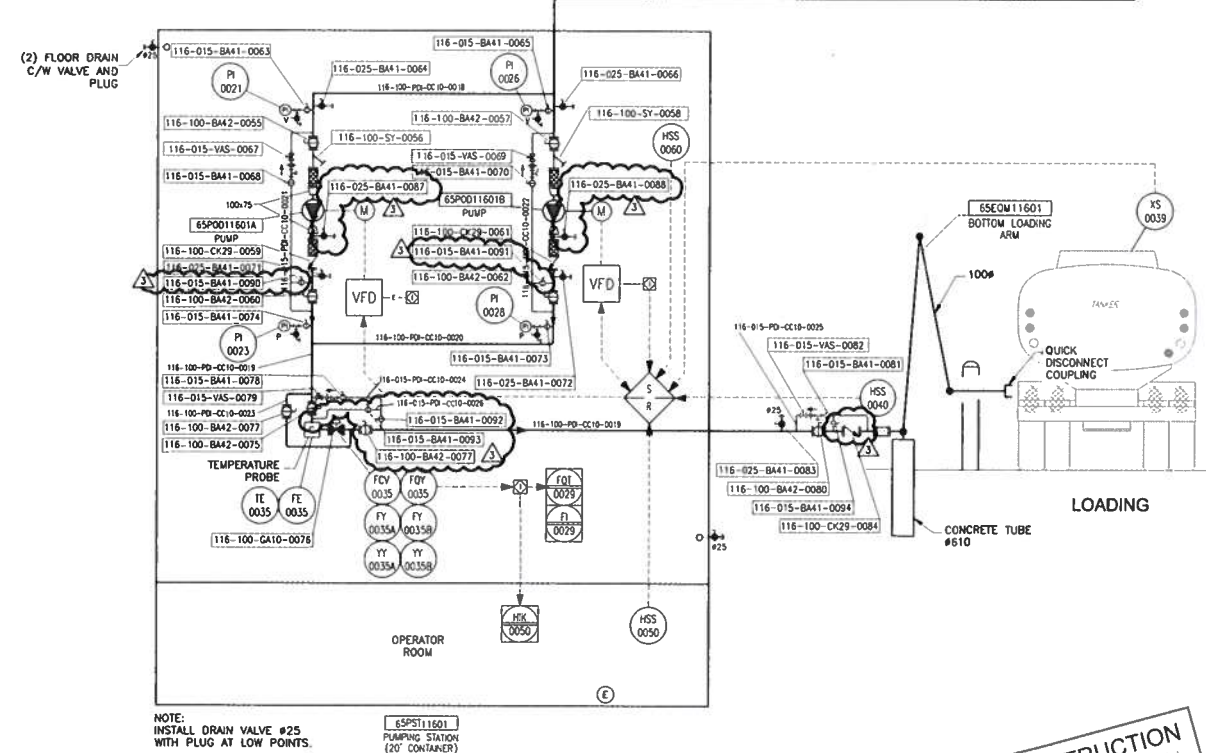SEE DWG 65-500-205-207

NOTE:
INSTALL DRAIN VALVE #25
WITH PLUG AT LOW POINTS

POUR CONSTRUCTION
FOR CONSTRUCTION
AGARCO EAGLE
DATE : 2018-04-16



Vendor Document Status

AGNICO EAGLE

- 1 ☐ Proceed to next submission and status.
- 2 ☐ Proceed with exceptions as noted to next submission and status.
- 3 ☐ Do not proceed.
Revise as noted and resubmit next submission and status.
- 4 ☒ Complete, no further submission required.

By:

Jean-Francois Tremblay

Date: 2017-05-02

Review and authorization to fabricate are only for general conformance with the design concept of the Project as expressed in the Contract Documents. Sole responsibility for the accuracy and completeness of this document, including but not limited to dimensions and quantities, remains with the Supplier/Contractor. Agnico Eagle does not warrant the accuracy or completeness of any of the information contained herein, nor does Agnico Eagle authorize or approve any construction means, methods, techniques, sequences or any safety precautions or procedures.

Agnico Eagle
No.

6515-C-270-007-141-TES-0015 R: Sub001

DOCUMENT FOR INFORMATION



Fuel Tanks Piping
Supply and Installation



Punchlist

Document Number : AEM-GE-ITR-003
Contract Number : C22466T / C22498E

Equipment/System description:

ITEM No	DESCRIPTION	CAT 1	CAT 2	CAT 3	COMMENTS	COMPLETED
1						
2						
3						
CAT 1 = Effects commissioning CAT 2 = Effects operation CAT 3 = Post operation						



Vendor Document Status

AGNICO EAGLE

- 1 ☐ Proceed to next submission and status.
- 2 ☐ Proceed with exceptions as noted to next submission and status.
- 3 ☐ Do not proceed.
Revise as noted and resubmit next submission and status.
- 4 ☒ Complete, no further submission required.

By:

Jean-Francois Tremblay

Date:

2017-05-02

Review and authorization to fabricate are only for general conformance with the design concept of the Project as expressed in the Contract Documents. Sole responsibility for the accuracy and completeness of this document, including but not limited to dimensions and quantities, remains with the Supplier/Contractor. Agnico Eagle does not warrant the accuracy or completeness of any of the information contained herein, nor does Agnico Eagle authorize or approve any construction means, methods, techniques, sequences or any safety precautions or procedures.

Agnico Eagle
No.

6515-C-270-007-141-TES-0016 R: Sub001

DOCUMENT FOR INFORMATION



**Agnico-Eagle Mines Ltd.
Notice of Final Completion**

ITR Number : AEM-GE-ITR-004
Contract no. : C22466T / C22498E



Date: _____

To: _____

Project No: _____

Contract No: _____

Contract Title: _____

Contractor: _____

We, _____ (Contractor's Name), the Contractor
for the above described contract, hereby certify that we have reviewed the Contract
Documents pertaining to:

Contract No.: _____

Contract Name: _____

Partial Completion Certificates: _____

and having physically inspected the Work performed, do hereby file claim for a notice of
Final Completion.

I do declare that I am, _____ (Responsible's Name),
HAVING AUTHORITY FROM MY COMPANY TO PETITION FOR THE ABOVE REFERRED TO
FINAL COMPLETION NOTICE.


Signature: _____

Name: _____

Title: _____


AS-BUILT DRAWINGS

F:\Agnico Eagle\Medicine\591700 (Fuel Distribution)\05. Dessins\02. Tuyauterie\02. Isométriques\01. Rankin Inlet\116-150-PDI-CC10-0001-11.DWG

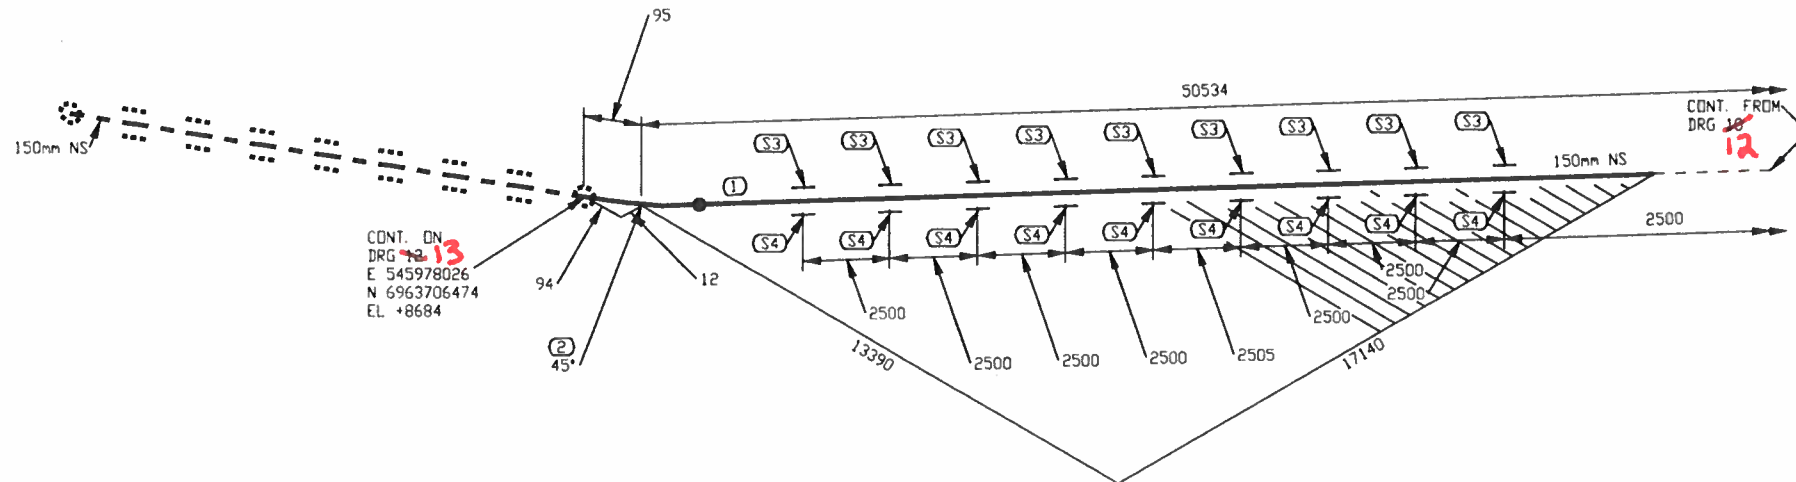

PERMIT TO PRACTICE
LE GROUPE ULTRAGEN LTÉE
Signature _____
Date _____
SEP 21 2017
PERMIT NUMBER: P 1180
NT/NU Association of Professional
Engineers and Geoscientists

FABRICATION DRAWINGS BASED ON
WSP CERTIFIED ENGINEERING

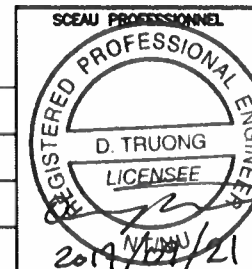

NO. DE CONDUITE		SPECIFICATION	PRODUIT	SISTEME REVETEMENT	CODE DE COULEUR	ISOLATION ET TRACAGE	EPAISS. D'ISOLATION		
116-150-PDI-CC10-0001		CC10	PDI		-			65-116-270-200	PIPE SUPPORT DETAILS
PRESSION D'OPERATION	TEMPERATURE D'OPERATION	PRESSION DE CONCEPTION	TEMPERATURE DE CONCEPTION	PRESSION D'ESSAI	CLASSE D'INSPECTION	CODE DE SERVICE	TRAITEMENT THERMIQUE	65-116-205-200	P&ID
PSIG	°F	PSIG	°F	PSIG				No. DESSIN	DESSINS DE REFERENCE

LISTE DE MATERIEL

No	QTE	D/A	MATERIEL/CATALOGUE	DESCRIPTION
1	21655 MM	150	A 333 Gr. 6	SCH STD, SMLS PIPE
2	1	150	A 420 Gr. WPL6	SCH STD, BW LR 45 DEG ELBOW
3	9	150		PIPE SUPPORT AS PER DETAIL 1, DWG: 65-116-270-200
4	9	150		PIPE SHOE AS PER DETAIL 2, DWG: 65-116-270-200

PROMEC
AS-BUILT

Signature: _____

Date: 2019/02/08

2	2017/09/21	PROJECT TITLE REVISED	KHV
1	2017/09/11	LINE NUMBERS REVISED	KHV
0	2017/05/15	ISSUED FOR CONSTRUCTION	KHV
No.	DATE	REVISION	PAR APP.

CLIENT:


AGNICO EAGLE



CONSULTANT PROJECT NO. 591700

CONC.: KHV	PROJET: AGNICO EAGLE - MELIADINE DIVISION			
DATE: 2017/04/25	116 - FUEL TANK FARM			
DESSINE PAR: KVE	TITRE: RANKIN INLET			
DATE: 2017/04/25	FABRICATION ISOMETRIC			
VER. PAR: -	MARINE LINE TO 65TNK11601 & 65TNK11602			
DATE: -	No PROJET	No DESSIN	PAGES	REV.
APP.: -	6515	116-150-PDI-CC10-0001	11/13	2
DATE: -				
ECHELLE: AUCUNE				

FIGURE: W:\Agnico Eagle\Meladine\591700 (Fuel Distribution)\05 Dessins\02 Tuyauterie\01 Rankin Inlet\116-150-PDI-CC10-0001-12.DWG

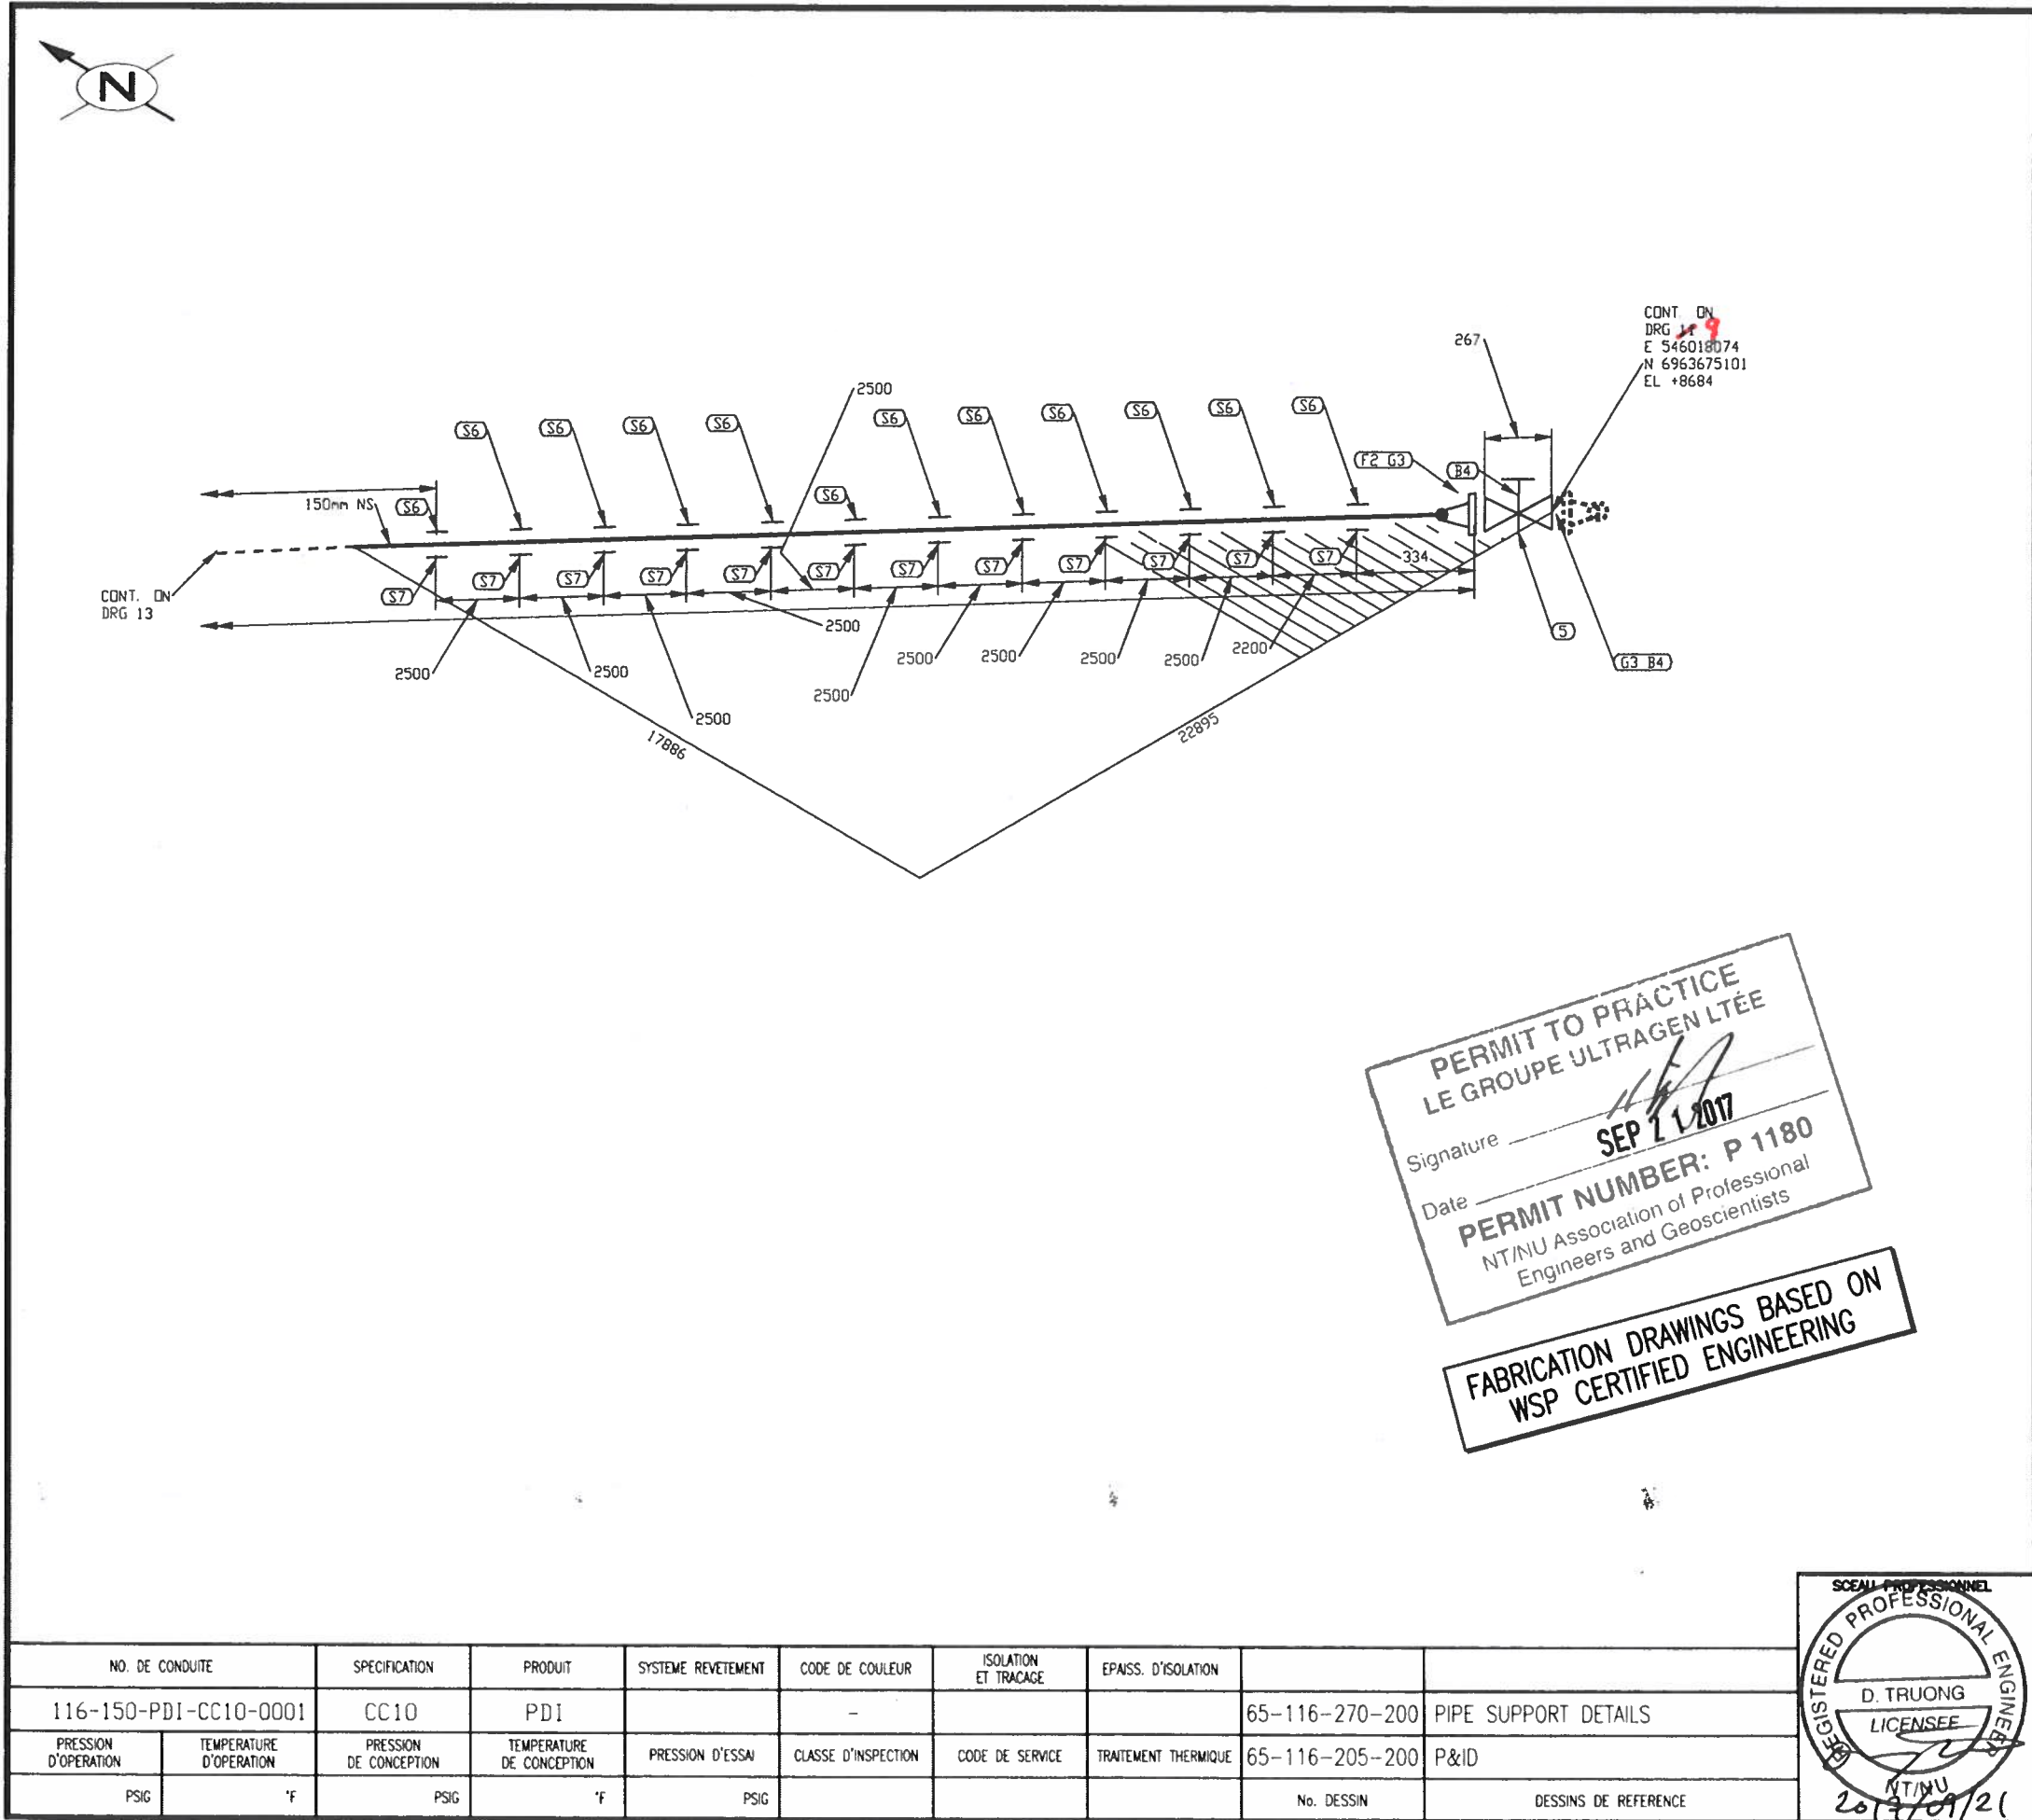

LISTE DE MATERIEL				
No	QTE	DIA	MATERIEL/CATALOGUE	DESCRIPTION
1	28696 MM	150	A 333 Gr. 6	SCH STD. SMLS PIPE
2	1	150	A 350 Gr. LF2	CL 150, SCH STD, RF, WN FLANGE
3	2	150	ASME B16.20	CL 150, GARLOCK 5500, RING TYPE GASKET 1/8" THK
4	16	19	A 193 B7/A 194 2H	CL 150, B - 19.05 X 100 STUD BOLTS c/w TWO HEAVY HEX NUTS
5	1	150	GA-10	CL 150, RF, CS, GATE VALVE
6	12	150		PIPE SUPPORT AS PER DETAIL 1, DWG: 65-116-270-200
7	12	150		PIPE SHOE AS PER DETAIL 2, DWG: 65-116-270-200

PROMEC
AS-BUILT


Signature: 

Date: 2019/02/08

2	2017/09/21	PROJECT TITLE REVISED	KHV
1	2017/09/11	LINE NUMBERS REVISED	KHV
0	2017/05/15	ISSUED FOR CONSTRUCTION	KHV
No.	DATE	REVISION	PAR APP.



AGNICO EAGLE

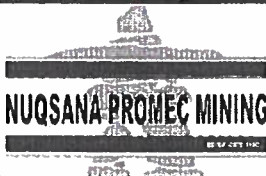


NUQSANA-PROMEC MINING



ultragen


CONSULTANT
PROJECT NO. 591700

CONC.: KHV	PROJET:	AGNICO EAGLE - MELIADINE DIVISION		
DATE: 2017/04/25		116 - FUEL TANK FARM		
DESSINÉ PAR: KVE	TITRE:	RANKIN INLET		
DATE: 2017/04/25		FABRICATION ISOMETRIC		
VER. PAR: -		MARINE LINE TO 65TNK11601 & 65TNK11602		
DATE: -	No PROJET	No DESSIN	PAGES	REV.
APP.: -	6515	116-150-PDI-CC10-0001	12/13	2
DATE: -				
ECHELLE: AUCUNE				

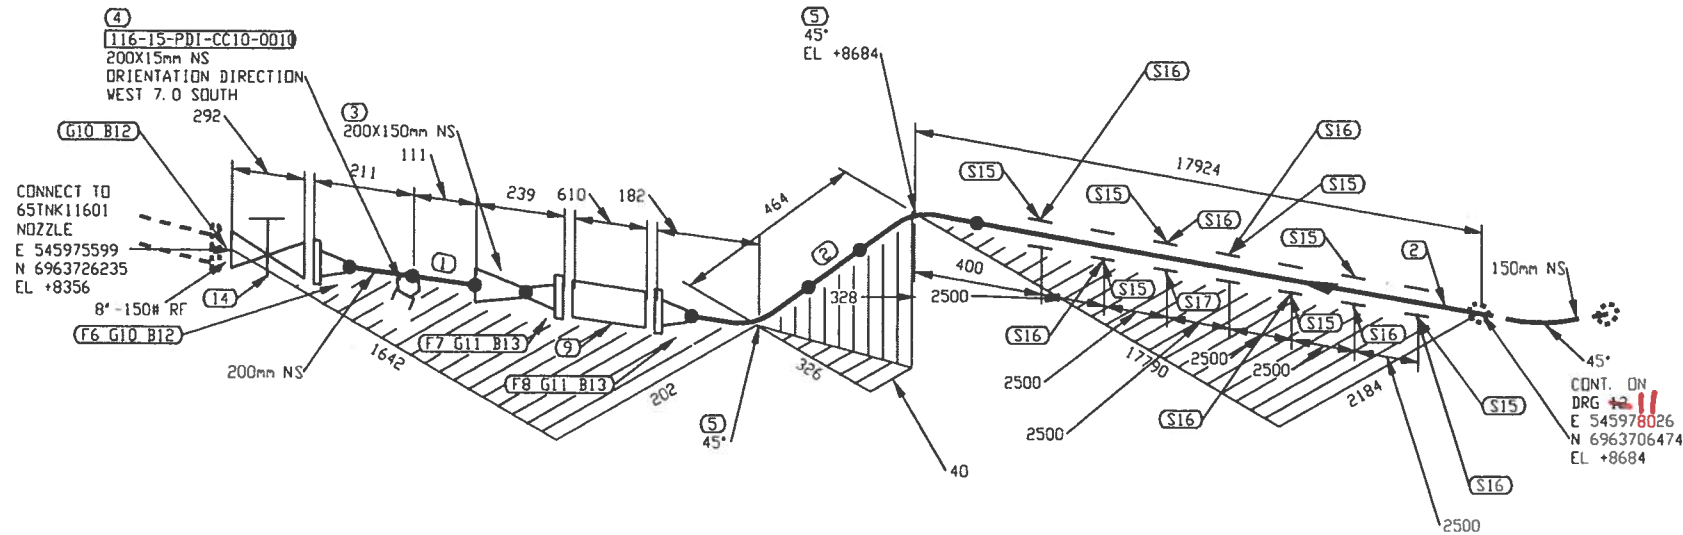

PERMIT TO PRACTICE
LE GROUPE ULTRAGEN LTÉE
Signature _____
Date **SEP 21 2017**
PERMIT NUMBER: P 1180
NT/NU Association of Professional
Engineers and Geoscientists

FABRICATION DRAWINGS BASED ON
WSP CERTIFIED ENGINEERING

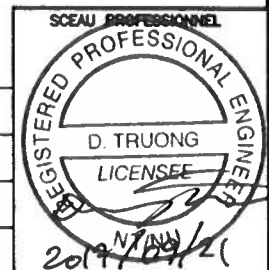

LISTE DE MATERIEL				
No	QTE	DIA	MATERIEL/CATALOGUE	DESCRIPTION
1	222 MM	200	A 333 Gr. 6	SCH STD, SMLS PIPE
2	18103 MM	150	A 333 Gr. 6	SCH STD, SMLS PIPE
3	1	200X150	A 420 Gr. WPL6	SCH STD, BW CONC RED
4	1	200X15	A 350 Gr. LF2	CL 3000, THREDOLET
5	2	150	A 420 Gr. WPL6	SCH STD, BW LR 45 DEG ELBOW
6	1	200	A 350 Gr. LF2	CL 150, SCH STD, RF, WN FLANGE
7	1	150	A 350 Gr. LF2	CL 150, SCH STD, RF, WN FLANGE
8	1	150	A 350 Gr. LF2	CL 150, SCH STD, RF, WN FLANGE
9	1	150		CL 150, SINGLE BRAIDED HOSE ASSEMBLY
10	2	200	ASME B16.20	CL 150, GARLOCK 5500, RING TYPE GASKET 1/8" THK
11	2	150	ASME B16.20	CL 150, GARLOCK 5500, RING TYPE GASKET 1/8" THK
12	16	19	A 193 B7/A 194 2H	CL 150, 8 - 19.05 X 110 STUD BOLTS c/w TWO HEAVY HEX NUTS
13	16	19	A 193 B7/A 194 2H	CL 150, 8 - 19.05 X 100 STUD BOLTS c/w TWO HEAVY HEX NUTS
14	1	200	GA-10	CL 150, RF, CS, FULL PORT GATE VALVE
15	7	150		PIPE SUPPORT AS PER DETAIL 1, DWG: 65-116-270-200
16	7	150		PIPE SHOE AS PER DETAIL 2, DWG: 65-116-270-200
17	1	150		PIPE SHOE AS PER DETAIL 2, DWG: 65-116-270-200

**PROMEC
AS-BUILT**
Signature: _____
Date: **2019/02/08**

2	2017/09/21	PROJECT TITLE REVISED	KHV
1	2017/09/11	LINE NUMBERS REVISED	KHV
0	2017/05/15	ISSUED FOR CONSTRUCTION	KHV
No.	DATE	REVISION	PAR APP.

CLIENT:




CONSULTANT PROJECT NO. **591700**

NO. DE CONDUITE		SPECIFICATION	PRODUIT	SYSTEME REVETEMENT	CODE DE COULEUR	ISOLATION ET TRACAGE	EPAISS. D'ISOLATION		
116-150-PDI-CC10-0001		CC10	PDI					65-116-270-200	PIPE SUPPORT DETAILS
PRESSION D'OPERATION	TEMPERATURE D'OPERATION	PRESSION DE CONCEPTION	TEMPERATURE DE CONCEPTION	PRESSION D'ESSAI	CLASSE D'INSPECTION	CODE DE SERVICE	TRAITEMENT THERMIQUE	65-116-205-200	P&ID
PSIG	'F	PSIG	'F	PSIG				No. DESSIN	DESSINS DE REFERENCE


CONC.: KHV DATE: 2017/04/25 DESSINE PAR: KVE DATE: 2017/04/25 VER. PAR: - DATE: - APP.: - DATE: - ECHELLE: AUCUNE	PROJET: AGNICO EAGLE - MELIADINE DIVISION 116 - FUEL TANK FARM TITRE: RANKIN INLET FABRICATION ISOMETRIC MARINE LINE TO 65TNK11601 & 65TNK11602
No PROJET 6515	No DESSIN 116-150-PDI-CC10-0001
PAGES 13/13	REV. 2

F:\CHIER\W\Yanica Eagle\Meliadine\591700 (Fuel Distribution)\05- Dessins\02- Isométriques\01- Rankin Inlet\116-150-PDI-CC10-0011-1.DWG

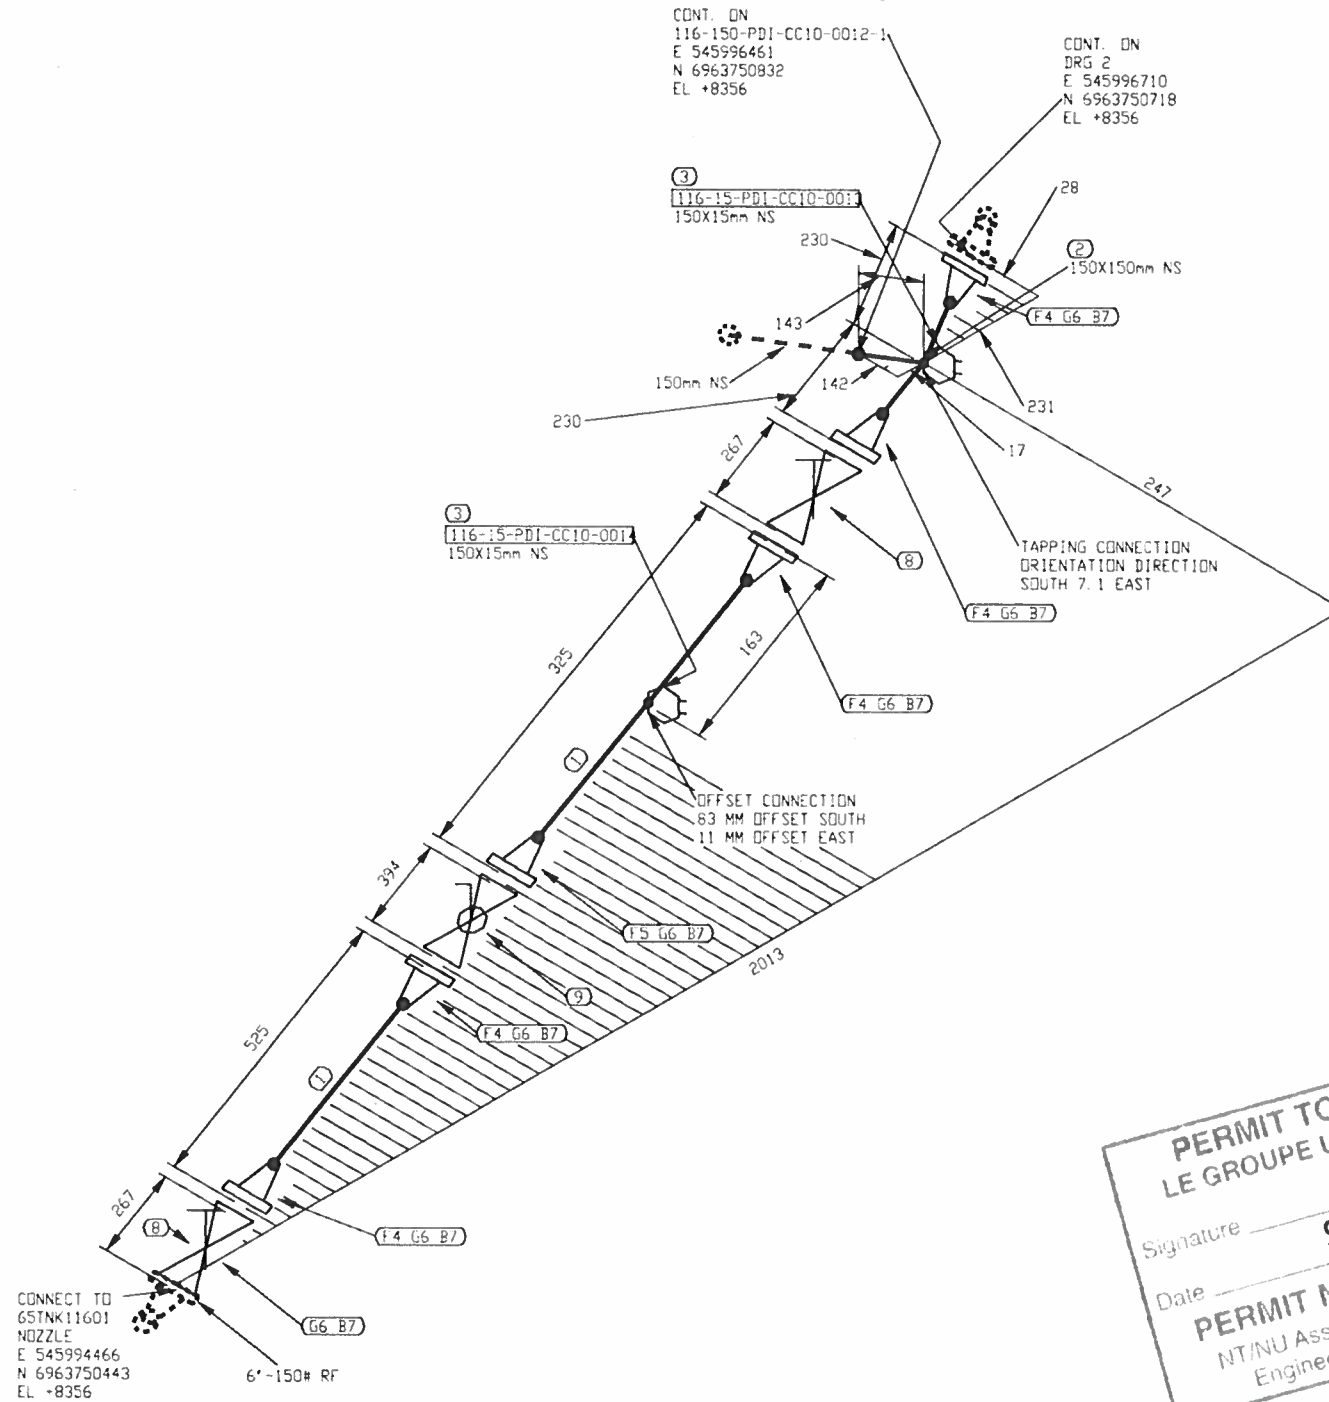

PERMIT TO PRACTICE
LE GROUPE ULTRAGEN LTÉE
Signature: *[Signature]*
Date: *SEP 21 2017*
PERMIT NUMBER: P 1180
NT/NU Association of Professional
Engineers and Geoscientists

FABRICATION DRAWINGS BASED ON
WSP CERTIFIED ENGINEERING

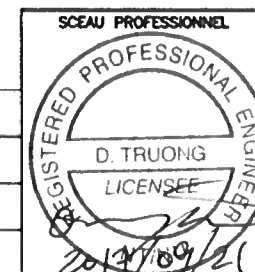

LISTE DE MATERIEL					
No	QTE	D.A	MATERIEL/CATALOGUE	DESCRIPTION	
1	502 MM	150	A 333 Gr. 6	SCH STD, SMLS PIPE	
2	1	150X150	A 420 Gr. WPL6	SCH STD, BW STRAIGHT TEE	
3	2	150X15	A 350 Gr. LF2	CL 3000, THREDDLET	
4	5	150	A 350 Gr. LF2	CL 150, SCH STD, RF, WN FLANGE	
5	1	150	A 350 Gr. LF2	CL 150, SCH STD, RF, WN FLANGE	
6	7	150	ASME B16.20	CL 150, GARLOCK 5500, RING TYPE GASKET 1/8" THK	
7	56	19	A 193 B7/A 194 2H	CL 150, 8 - 19.05 X 100 STUD BOLTS c/w TWO HEAVY HEX NUTS	
8	2	150	GA-10	CL 150, RF, GATE VALVE	
9	1	150	BA-31	CL 150, RF, BALL VALVE	

**PROMEC
AS-BUILT**
Signature: *[Signature]*
Date: *2019/02/08*



2	2017/09/21	PROJECT TITLE REVISED	KHV
1	2017/09/11	LINE NUMBERS REVISED	KHV
0	2017/05/15	ISSUED FOR CONSTRUCTION	KHV
No.	DATE	REVISION	PAR
			APP.

CLIENT:

CONSULTANT PROJECT NO. 591700

CONC.: KHV DATE: 2017/04/25 DESSINE PAR: KVE DATE: 2017/04/25 VER. PAR: - DATE: - APP.: - DATE: - ECHELLE: AUCUNE	PROJET: AGNICO EAGLE - MELIADINE DIVISION 116 - FUEL TANK FARM TITRE: RANKIN INLET FABRICATION ISOMETRIC DIESEL FROM 65TNK11601 TO PUMPING STATION
No PROJET 6515	No DESSIN 116-150-PDI-CC10-0011
PAGES 1/5	REV. 2

NO. DE CONDUITE		SPECIFICATION	PRODUIT	SYSTEME REVETEMENT	CODE DE COULEUR	ISOLATION ET TRACAGE	EPAISS. D'ISOLATION		
116-150-PDI-CC10-0011		CC10	PDI		-			65-116-270-200	PIPE SUPPORT DETAILS
PRESSON D'OPERATION	TEMPERATURE D'OPERATION	PRESSON DE CONCEPTION	TEMPERATURE DE CONCEPTION	PRESSON D'ESSAI	CLASSE D'INSPECTION	CODE DE SERVICE	TRAITEMENT THERMIQUE	65-116-205-200	P&ID
PSIG	'F	PSIG	'F	PSIG				No. DESSIN	DESSINS DE REFERENCE

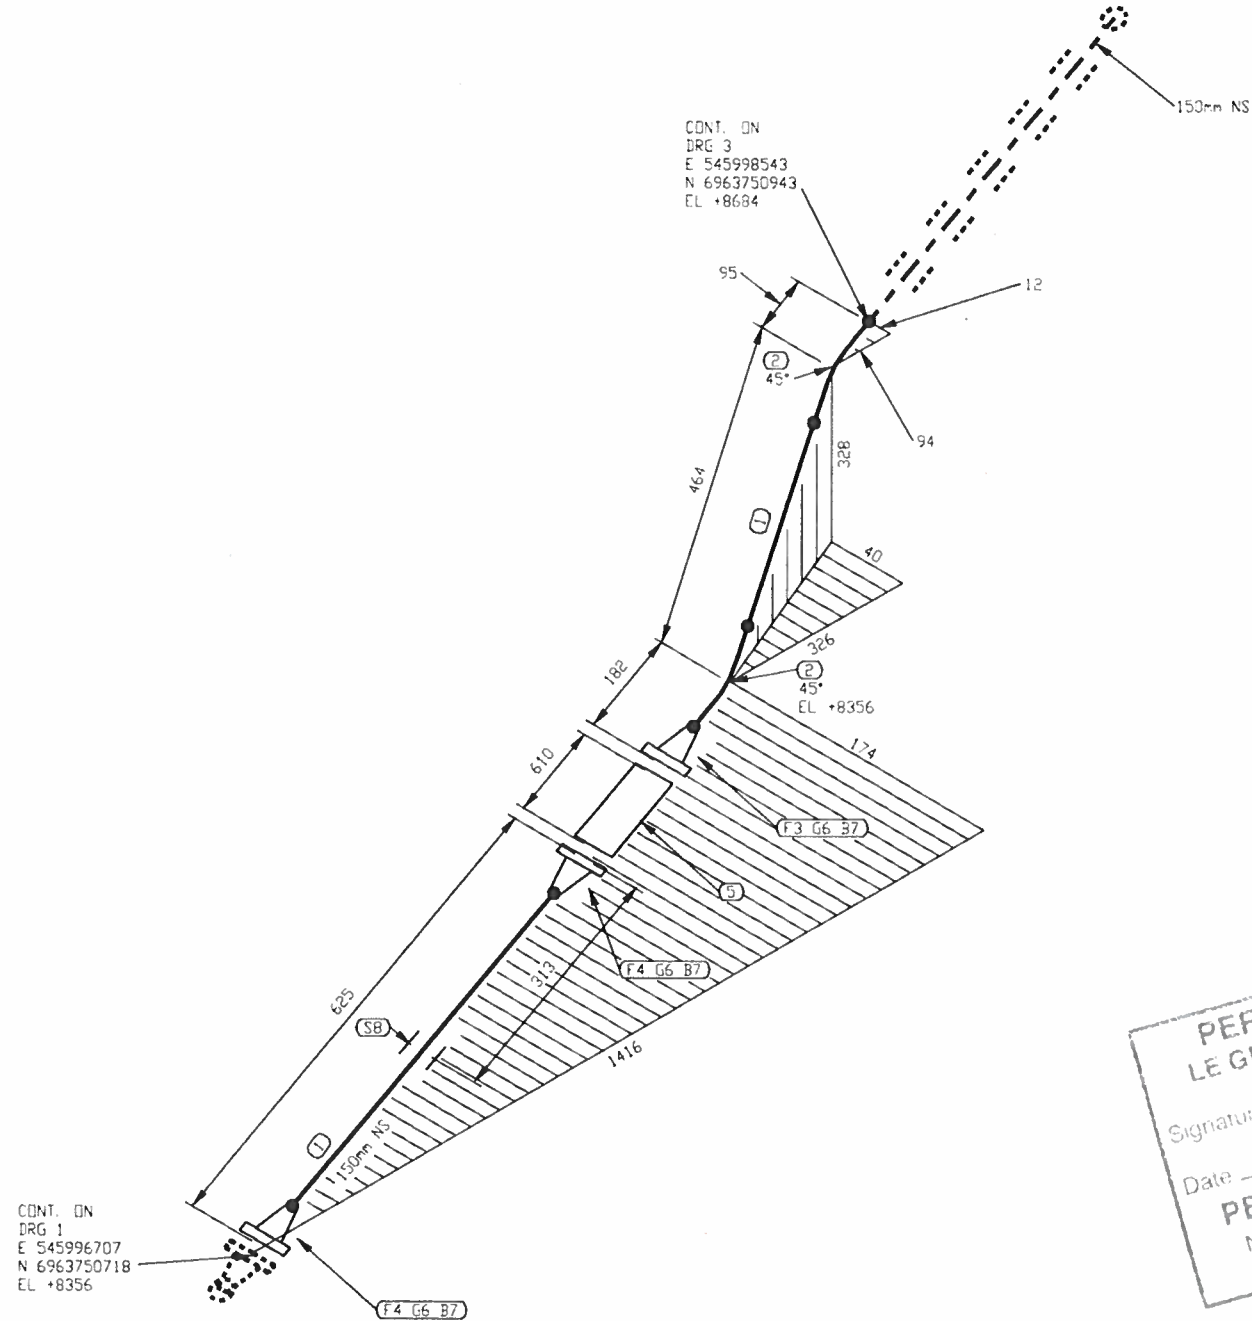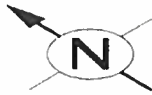

PERMIT TO PRACTICE
LE GROUPE ULTRAGEN LTÉE

Signature: *[Signature]*
Date: **SEP 21 2017**

PERMIT NUMBER: P 1180
NT/NU Association of Professional
Engineers and Geoscientists

FABRICATION DRAWINGS BASED ON
WSP CERTIFIED ENGINEERING

LISTE DE MATERIEL				
No	QTE	DIA	MATERIEL/CATALOGUE	DESCRIPTION
1	725 MM	150	A 333 Gr. 6	SCH STD, SMLS PIPE
2	2	150	A 420 Gr. WPL6	SCH STD, BW LR 45 DEG ELBOW
3	1	150	A 350 Gr. LF2	CL 150, SCH STD, RF, WN FLANGE
4	2	150	A 350 Gr. LF2	CL 150, SCH STD, RF, WN FLANGE
5	1	150		CL 150, SINGLE BRAIDED HOSE ASSEMBLY
6	3	150	ASME B16.20	CL 150, GARLOCK 5500, RING TYPE GASKET 1/8" THK
7	24	19	A 193 B7/A 194 2H	CL 150, 8 - 19.05 X 100 STUD BOLTS c/w TWO HEAVY HEX NUTS
8	1	150		PIPE SHOE AS PER DETAIL 2, DWG: 65-116-270-200

**PROMEC
AS-BUILT**

Signature: *[Signature]*
Date: **2019/02/08**

2	2017/09/21	PROJECT TITLE REVISED	KHV
1	2017/09/11	LINE NUMBERS REVISED	KHV
0	2017/05/15	ISSUED FOR CONSTRUCTION	KHV
No.	DATE	REVISION	PAR APP.

CLIENT:



AGNICO EAGLE




NUQSANA PROMEC MINING




ultragen

CONSULTANT PROJECT NO. **591700**

NO. DE CONDUITE		SPECIFICATION	PRODUIT	SYSTEME REVETEMENT	CODE DE COULEUR	ISOLATION ET TRACAGE	EPAISS. D'ISOLATION		
116-150-PDI-CC10-0011		CC10	PDI					65-116-270-200	PIPE SUPPORT DETAILS
PRESSION D'OPERATION	TEMPERATURE D'OPERATION	PRESSION DE CONCEPTION	TEMPERATURE DE CONCEPTION	PRESSION D'ESSAI	CLASSE D'INSPECTION	CODE DE SERVICE	TRAITEMENT THERMIQUE	65-116-205-200	P&ID
PSIG	°F	PSIG	°F	PSIG				No. DESSIN	DESSINS DE REFERENCE

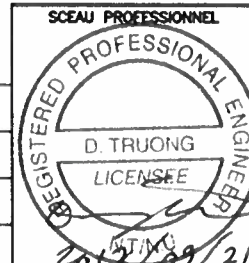

CONC.: KHV	PROJECT: AGNICO EAGLE - MELIADINE DIVISION 116 - FUEL TANK FARM		
DATE: 2017/04/25			
DESSINE PAR: KVE	TITRE: RANKIN INLET FABRICATION ISOMETRIC DIESEL FROM 65TNK11601 TO PUMPING STATION		
DATE: 2017/04/25			
VER. PAR: -	No PROJ: 6515 No DESSIN: 116-150-PDI-CC10-0011 PAGES: 2/5 REV.: 2		
DATE: -			
APP.: -			
DATE: -			
ECHELLE: AUCUNE			

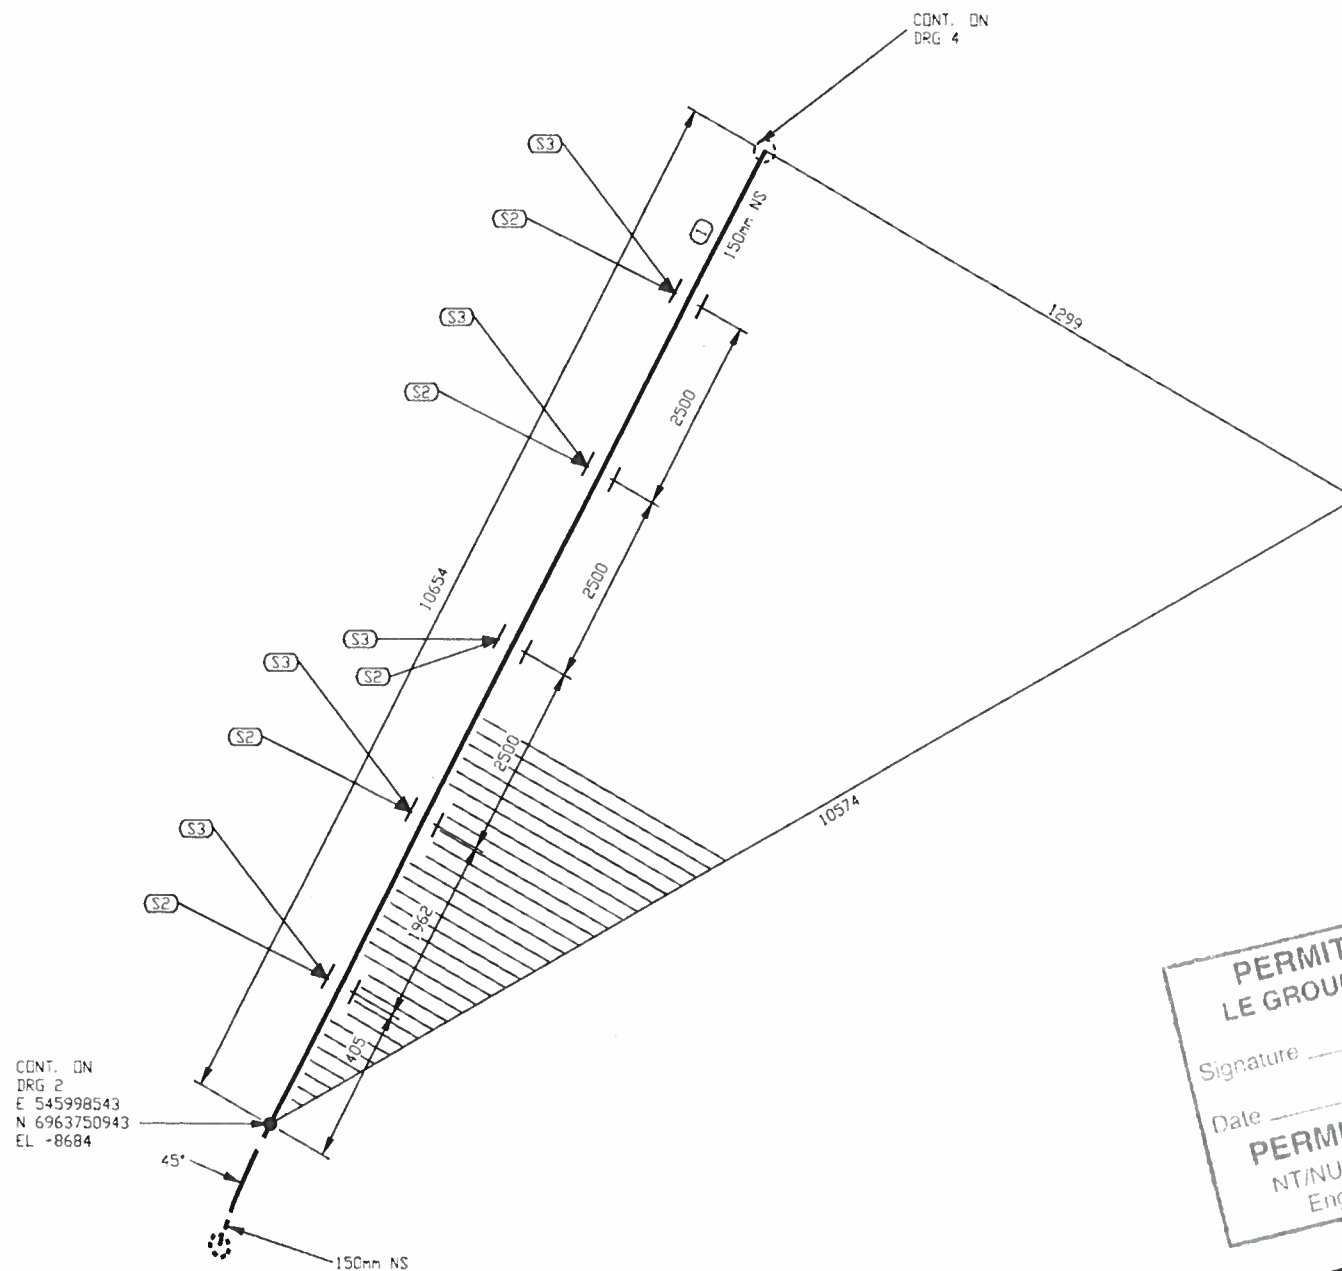

CONT. ON
DRG 2
E 545998543
N 6963750943
EL +8684

PERMIT TO PRACTICE
LE GROUPE ULTRAGEN LTÉE
Signature _____
Date **SEP 21 2017**
PERMIT NUMBER: P 1180
NT/NU Association of Professional
Engineers and Geoscientists

FABRICATION DRAWINGS BASED ON
WSP CERTIFIED ENGINEERING

LISTE DE MATERIEL				
No	QTE	DIA	MATERIEL/CATALOGUE	DESCRIPTION
1	10654 MM	150	A 333 Gr. 6	SCH STD. SMLS PIPE
2	5	150		PIPE SUPPORT AS PER DETAIL 1, DWG: 65-116-270-200
3	5	150		PIPE SHOE AS PER DETAIL 2, DWG: 65-116-270-200


**PROMEC
AS-BUILT**
Signature: _____
Date: **2019/02/03**

No.	DATE	REVISION	PAR	APP.
2	2017/09/21	PROJECT TITLE REVISED	KHV	
1	2017/09/11	LINE NUMBERS REVISED	KHV	
0	2017/05/15	ISSUED FOR CONSTRUCTION	KHV	

CLIENT:



AGNICO EAGLE

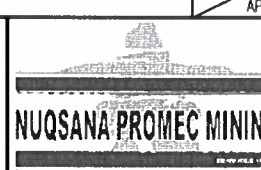


NUQSANA PROMEC MINING





ultragén

CONSULTANT
PROJECT NO. **591700**

NO. DE CONDUITE		SPECIFICATION	PRODUIT	SISTEME REVETEMENT	CODE DE COULEUR	ISOLATION ET TRACAGE	EPAISS. D'ISOLATION		
116-150-PDI-CC10-0011		CC10	PDI		-			65-116-270-200	PIPE SUPPORT DETAILS
PRESSION D'OPERATION	TEMPERATURE D'OPERATION	PRESSION DE CONCEPTION	TEMPERATURE DE CONCEPTION	PRESSION D'ESSAI	CLASSE D'INSPECTION	CODE DE SERVICE	TRAITEMENT THERMIQUE	65-116-205-200	P&ID
PSIG	°F	PSIG	°F	PSIG				No. DESSIN	DESSINS DE REFERENCE

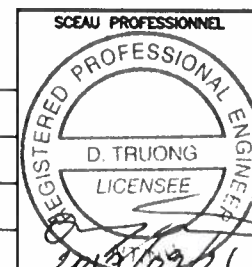

CONC.: KHV DATE: 2017/04/25 DESSINE PAR: KVE DATE: 2017/04/25 VER. PAR: - DATE: - APP.: - DATE: - ECHELLE: AUCUNE	PROJET: AGNICO EAGLE - MELIADINE DIVISION 116 - FUEL TANK FARM TITRE: RANKIN INLET FABRICATION ISOMETRIC DIESEL FROM 65TNK11601 TO PUMPING STATION	No PROJET 6515	No DESSIN 116-150-PDI-CC10-0011	PAGES 3/5	REV. 2
---	---	--------------------------	---	---------------------	------------------

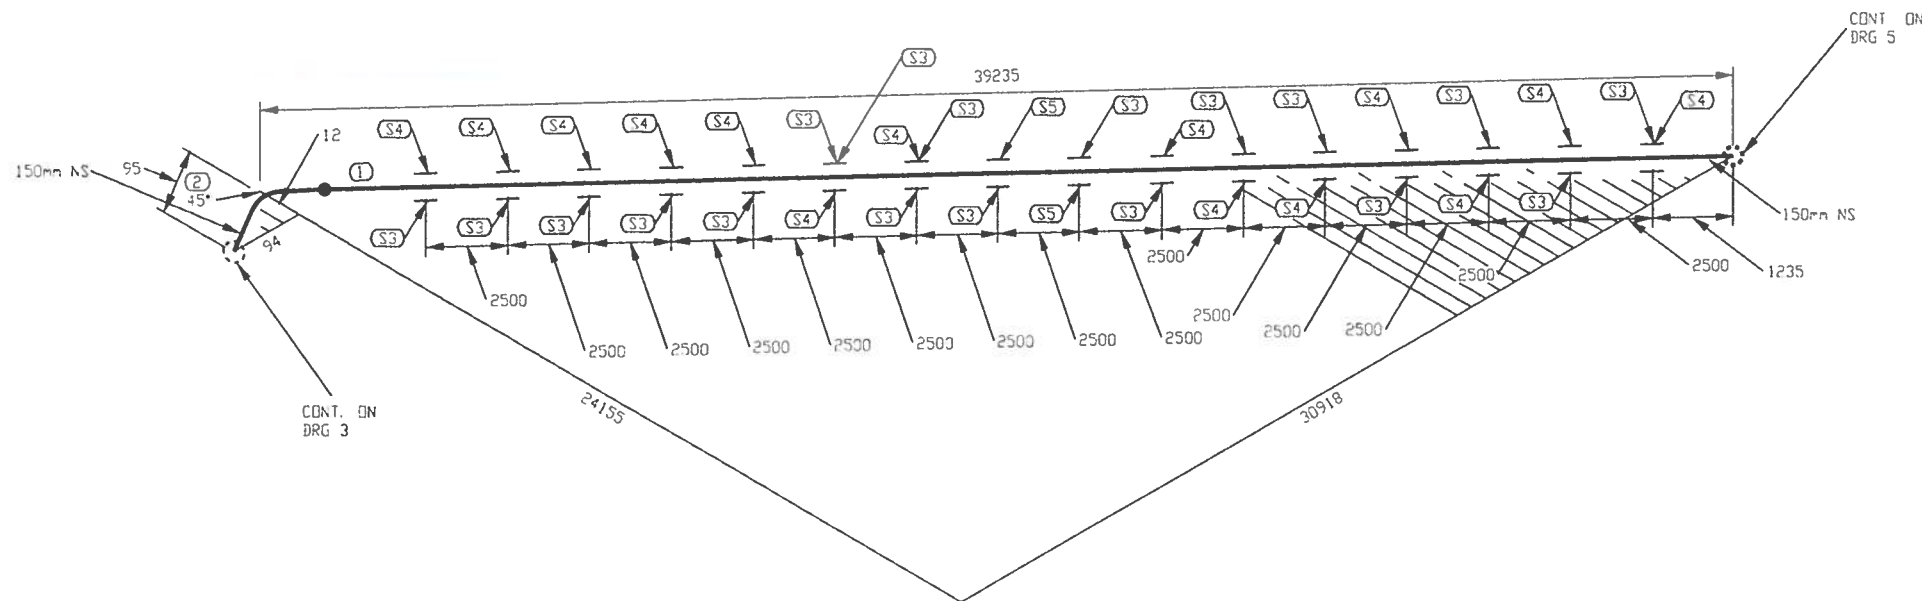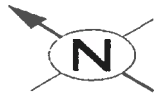

PERMIT TO PRACTICE
LE GROUPE ULTRAGEN LTÉE
Signature: *[Signature]*
Date: **SEP 21 2017**
PERMIT NUMBER: P 1180
NT/NU Association of Professional
Engineers and Geoscientists

FABRICATION DRAWINGS BASED ON
WSP CERTIFIED ENGINEERING

LISTE DE MATERIEL				
No	QTE	DA	MATERIEL/CATALOGUE	DESCRIPTION
1	39140 MM	150	A 333 Gr. 6	SCH STD, SMLS PIPE
2	1	150	A 420 Gr. WPL6	SCH STD, BW LR 45 DEG ELBOW
3	18	150		PIPE SHOE AS PER DETAIL 2, DWG: 65-116-270-200
4	14	150		PIPE SUPPORT AS PER DETAIL 1, DWG: 65-116-270-200
5	2	150		PIPE SUPPORT AS PER DETAIL 3, DWG: 65-116-270-200

**PROMEC
AS-BUILT**

Signature: *[Signature]*


Date: **2019/02/08**

2	2017/09/21	PROJECT TITLE REVISED	KHV
1	2017/09/11	LINE NUMBERS REVISED	KHV
0	2017/05/15	ISSUED FOR CONSTRUCTION	KHV
No.	DATE	REVISION	PAR
			APP.

CLIENT:




AGNICO EAGLE

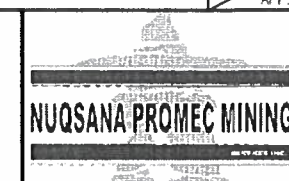


CONSULTANT
PROJECT NO. **591700**

CONC.: KHV DATE: 2017/04/25 DESSINÉ PAR: KVE DATE: 2017/04/25 VÉR. PAR: - DATE: - APP.: - DATE: - ÉCHELLE: AUCUNE	PROJET: AGNICO EAGLE - MELIADINE DIVISION 116 - FUEL TANK FARM TITRE: RANKIN INLET FABRICATION ISOMETRIC DIESEL FROM 65TNK11601 TO PUMPING STATION
No PROJET 6515	No DESSIN 116-150-PDI-CC10-0011
PAGES 4/5	REV. 2

NO. DE CONDUITE	SPECIFICATION	PRODUIT	SYSTEME REVETEMENT	CODE DE COULEUR	ISOLATION ET TRACAGE	EPAISS. D'ISOLATION		
116-150-PDI-CC10-0011	CC10	PDI		-			65-116-270-200	PIPE SUPPORT DETAILS
PRESSION D'OPERATION	TEMPERATURE D'OPERATION	PRESSION DE CONCEPTION	TEMPERATURE DE CONCEPTION	PRESSION D'ESSAI	CLASSE D'INSPECTION	CODE DE SERVICE	TRAITEMENT THERMIQUE	65-116-205-200 P&ID
PSIG	°F	PSIG	°F	PSIG				No. DESSIN
								DESSINS DE REFERENCE

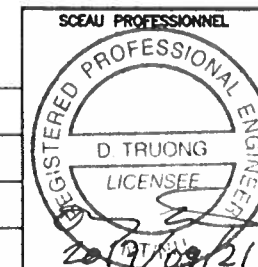

F:\Vegco Eagle\Medicine\591700 (Fuel Distribution)\05. Dessins\02. Tuyauterie\01. Rankin Inlet\116-150-PDI-CC10-0011-5.DWG

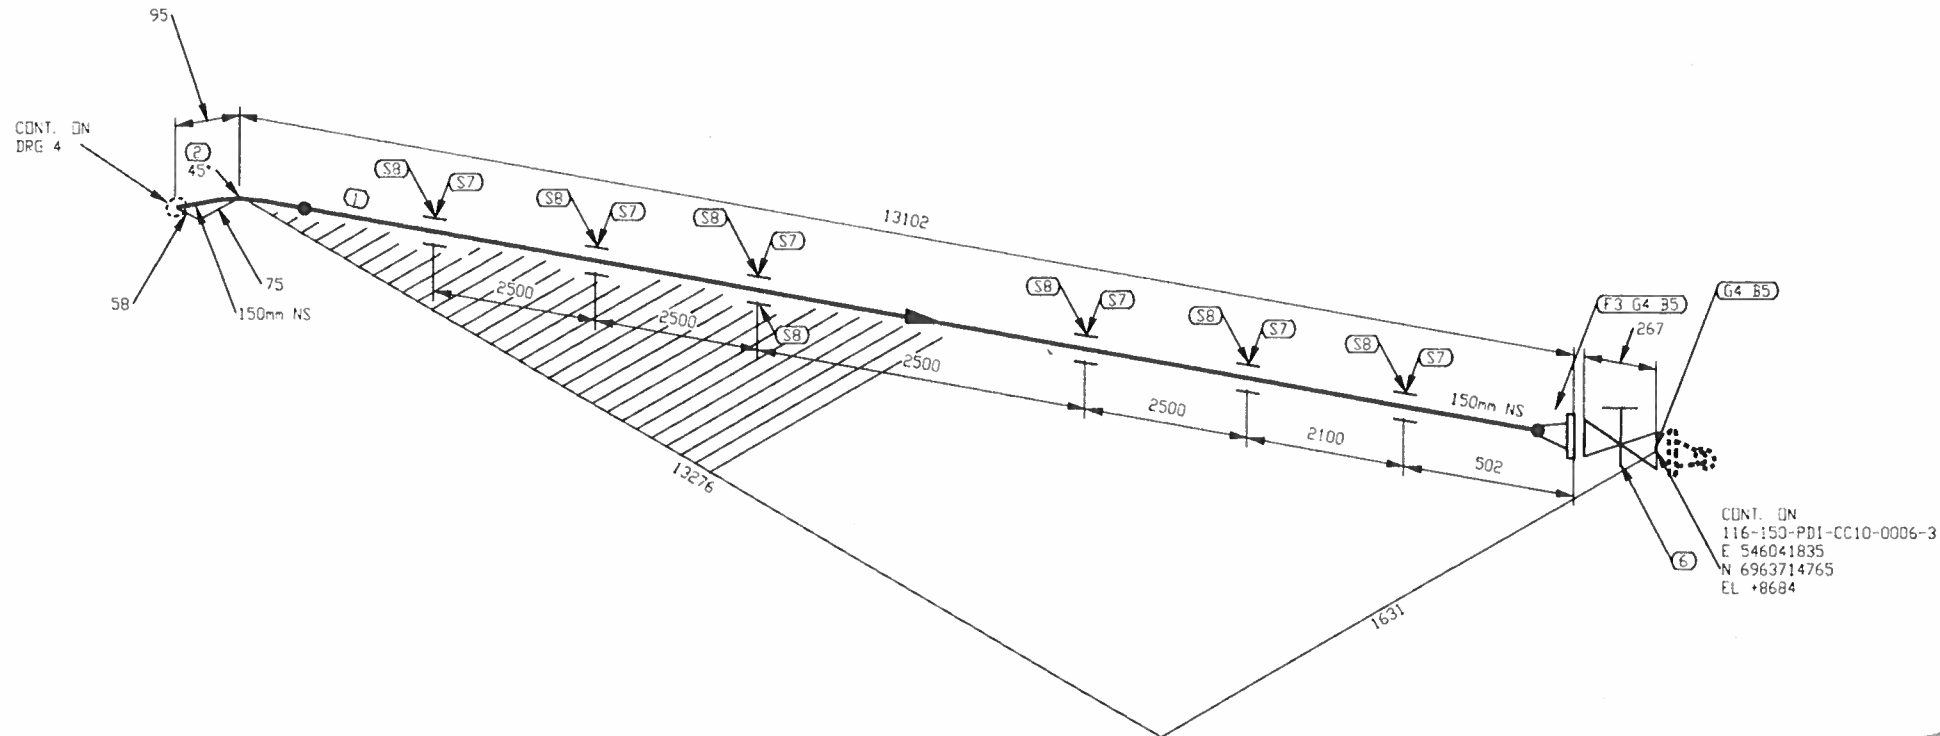

PERMIT TO PRACTICE
LE GROUPE ULTRAGEN LTÉE
Signature _____
Date **SEP 21 2017**
PERMIT NUMBER: P 1180
NT/NU Association of Professional
Engineers and Geoscientists
FABRICATION DRAWINGS BASED ON
WSP CERTIFIED ENGINEERING

LISTE DE MATERIEL				
No	QTE	DA	MATERIEL/CATALOGUE	DESCRIPTION
1	12919 MM	150	A 333 Gr. 6	SCH STD, SMLS PIPE
2	1	150	A 420 Gr. WPL6	SCH STD, BW LR 45 DEG ELBOW
3	1	150	A 350 Gr. LF2	CL 150, SCH STD, RF, WN FLANGE
4	2	150	ASME B16.20	CL 150, GARLOCK 5500, RING TYPE GASKET 1/8" THK
5	16	19	A 193 B7/A 194 2H	CL 150, B - 19.05 X 100 STUD BOLTS c/w TWO HEAVY HEX NUTS
6	1	150	GA-10	CL 150, RF, GATE VALVE
7	6	150		PIPE SUPPORT AS PER DETAIL 1, DWG: 65-116-270-200
8	7	150		PIPE SHOE AS PER DETAIL 2, DWG: 65-116-270-200

**PROMEC
AS-BUILT**
Signature: _____
Date: **2019/02/08**

2	2017/09/21	PROJECT TITLE REVISED	KHV
1	2017/09/11	LINE NUMBERS REVISED	KHV
0	2017/05/15	ISSUED FOR CONSTRUCTION	KHV
No.	DATE	REVISION	PAR APP.

CLIENT:



AGNICO EAGLE



NUQSANA PROMEC MINING



ultragen

CONSULTANT PROJECT NO. **591700**

NO. DE CONDUITE		SPECIFICATION	PRODUIT	SYSTEME REVETEMENT	CODE DE COULEUR	ISOLATION ET TRACAGE	EPAISS. D'ISOLATION		
116-150-PDI-CC10-0011		CC10	PDI					65-116-270-200	PIPE SUPPORT DETAILS
PRESSION D'OPERATION	TEMPERATURE D'OPERATION	PRESSION DE CONCEPTION	TEMPERATURE DE CONCEPTION	PRESSION D'ESSAI	CLASSE D'INSPECTION	CODE DE SERVICE	TRAITEMENT THERMIQUE	65-116-205-200	P&ID
PSIG	°F	PSIG	°F	PSIG				No. DESSIN	DESSINS DE REFERENCE

SCEAU PROFESSIONNEL
REGISTERED PROFESSIONAL ENGINEER
D. TRUONG
LICENSEE
2019/09/21


CONC.: KHV
DATE: 2017/04/25
DESSINE PAR: KVE
DATE: 2017/04/25
VER. PAR: -
DATE: -
APP.: -
DATE: -
ECHELLE: AUCUNE

PROJET: **AGNICO EAGLE - MELIADINE DIVISION
116 - FUEL TANK FARM**

TITRE: **RANKIN INLET
FABRICATION ISOMETRIC
DIESEL FROM 65TNK11601 TO PUMPING STATION**

No PROJET	No DESSIN	PAGES	REV.
6515	116-150-PDI-CC10-0011	5/5	2

F:\CHER\W\Agnico Eagle\Meladine\591700 (Fuel Distribution)\05 - Desains\02 - Isométriques\01 - Rankin Inlet\116-150-PDI-CC10-0012-1.DWG

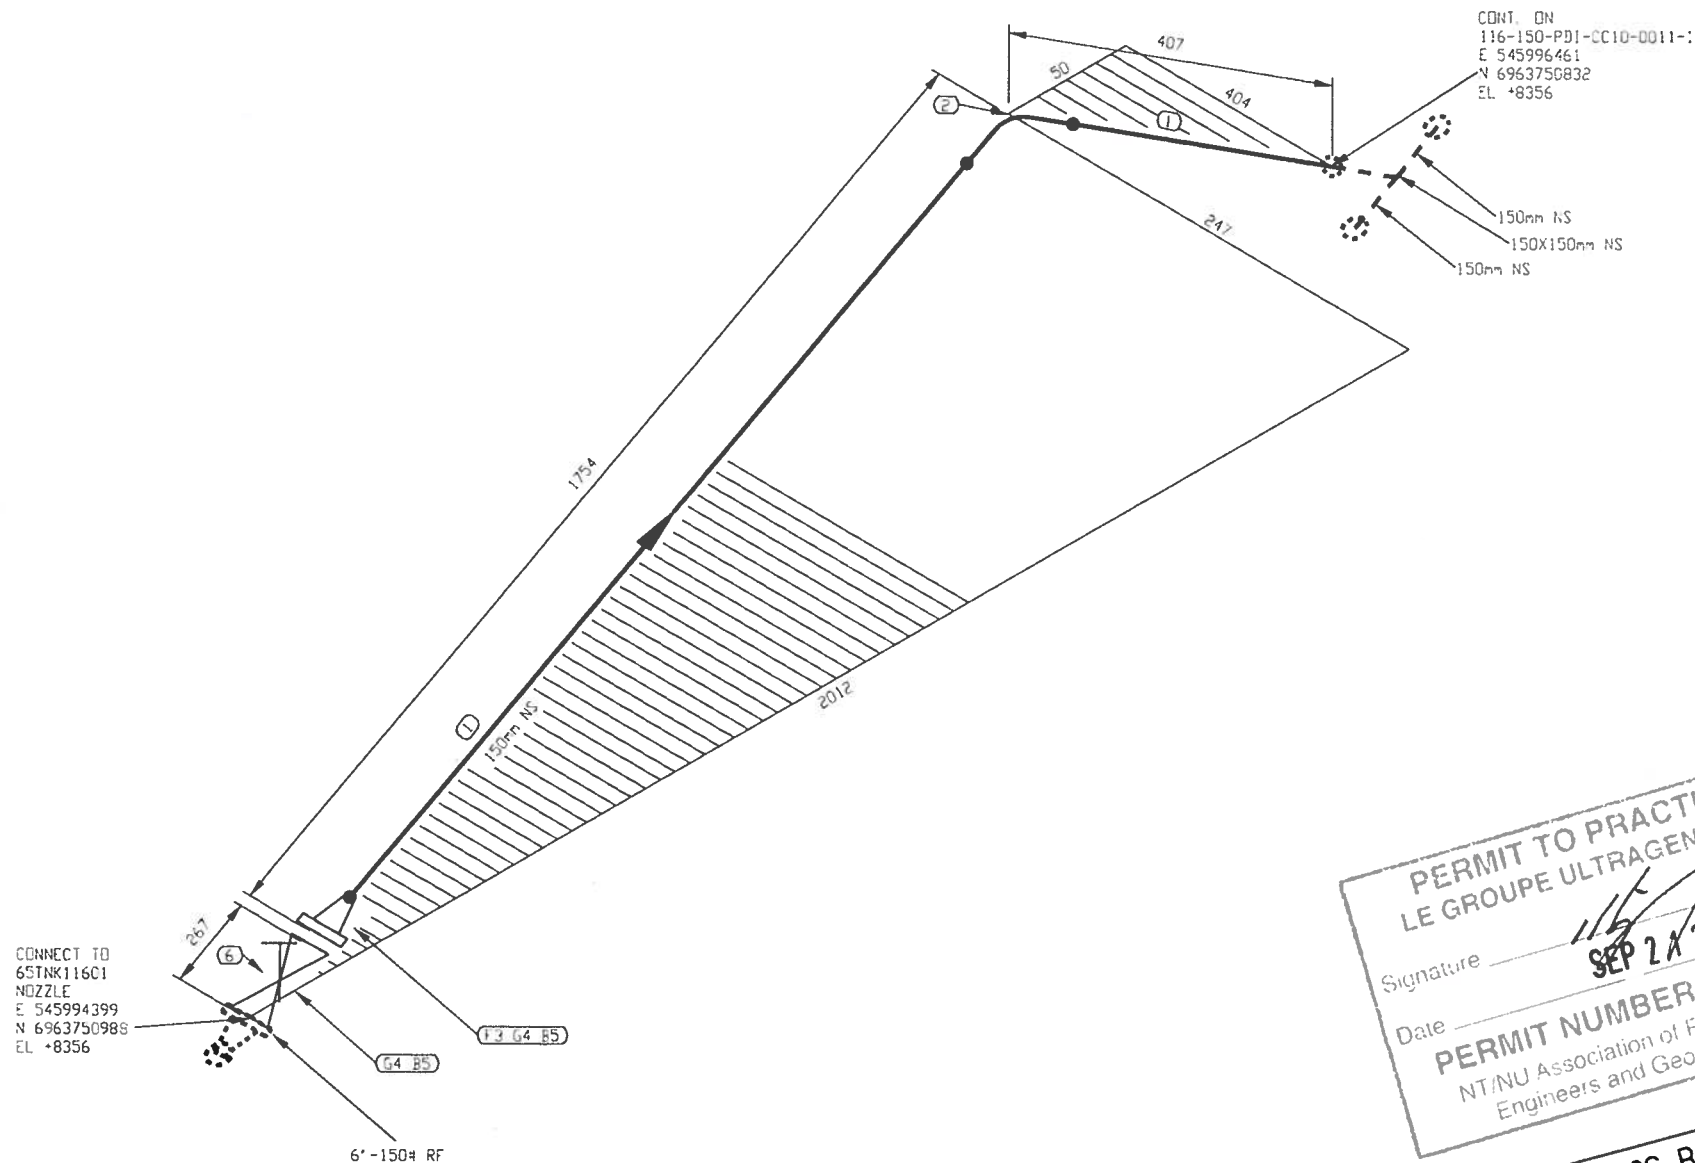

PERMIT TO PRACTICE
LE GROUPE ULTRAGEN LTÉE
Signature [Signature]
Date SEP 24 2017
PERMIT NUMBER: P 1180
NT/NU Association of Professional
Engineers and Geoscientists

FABRICATION DRAWINGS BASED ON
WSP CERTIFIED ENGINEERING

LISTE DE MATERIEL				
No	QTE	DIA	MATERIEL/CATALOGUE	DESCRIPTION
1	1616 MM	150	A 333 Gr. 6	SCH STD, SMLS PIPE
2	1	150	A 420 Gr. WPL6	SCH STD, BW LR 90 DEG ELBOW
3	1	150	A 350 Gr. LF2	CL 150, SCH STD, RF, WN FLANGE
4	2	150	ASME B16.20	CL 150, GARLOCK 5500, RING TYPE GASKET 1/8" THK
5	16	19	A 193 B7/A 194 2H	CL 150, B - 19.05 X 100 STUD BOLTS c/w TWO HEAVY HEX NUTS
6	1	150	GA-10	CL 150, RF, GATE VALVE

**PROMEC
AS-BUILT**
Signature: [Signature]
Date: 2019/02/08

2	2017/09/21	PROJECT TITLE REVISED	KHV
1	2017/09/11	LINE NUMBERS REVISED	KHV
0	2017/05/15	ISSUED FOR CONSTRUCTION	KHV
No.	DATE	REVISION	PAR APP.

CLIENT:



AGNICO EAGLE



NUQSANA PROMEC MINING



ultragén

CONSULTANT PROJECT NO. 591700

NO. DE CONDUITE		SPECIFICATION	PRODUIT	SYSTEME REVETEMENT	CODE DE COULEUR	ISOLATION ET TRACAGE	EPAISS. D'ISOLATION		
116-150-PDI-CC10-0012		CC10	PDI					65-116-270-200	PIPE SUPPORT DETAILS
PRESSION D'OPERATION	TEMPERATURE D'OPERATION	PRESSION DE CONCEPTION	TEMPERATURE DE CONCEPTION	PRESSION D'ESSAI	CLASSE D'INSPECTION	CODE DE SERVICE	TRAITEMENT THERMIQUE	65-116-205-200	P&ID
PSIG	°F	PSIG	°F	PSIG				No. DESSIN	DESSINS DE REFERENCE

SCEAU PROFESSIONNEL
REGISTERED PROFESSIONAL ENGINEER
D. TRUONG
LICENSEE
2017/09/21

CONC.: KHV
DATE: 2017/04/25
DESSINE PAR: KVE
DATE: 2017/04/25
VER. PAR: -
DATE: -
APP.: -
DATE: -
ECHELLE: AUCUNE

PROJET: AGNICO EAGLE - MELIADINE DIVISION
116 - FUEL TANK FARM
TITRE: RANKIN INLET
FABRICATION ISOMETRIC
DIESEL FROM 65TNK11601 TO PUMPING STATION

No PROJET	No DESSIN	PAGES	REV.
6515	116-150-PDI-CC10-0012	1/1	2



Vendor Document Status

AGNICO EAGLE

- 1 ☐ Proceed to next submission and status.
- 2 ☐ Proceed with exceptions as noted to next submission and status.
- 3 ☐ Do not proceed.
Revise as noted and resubmit next submission and status.
- 4 ☐ Complete, no further submission required.

By:

Date:

Review and authorization to fabricate are only for general conformance with the design concept of the Project as expressed in the Contract Documents. Sole responsibility for the accuracy and completeness of this document, including but not limited to dimensions and quantities, remains with the Supplier/Contractor. Agnico Eagle does not warrant the accuracy or completeness of any of the information contained herein, nor does Agnico Eagle authorize or approve any construction means, methods, techniques, sequences or any safety precautions or procedures.

Agnico Eagle
No.

6515-C-270-007-141-QCR-0008 R: Sub001

DOCUMENT FOR INFORMATION

AGNICO-EAGLE MINES

Contract No. 6515-C-270-007



22466T / 22498E

Rankin Inlet Tank #1

**ELECTRICITY AND
INSTRUMENTATION**

Quality Control Documents



Vendor Document Status

AGNICO EAGLE

- 1 ☐ Proceed to next submission and status.
- 2 ☐ Proceed with exceptions as noted to next submission and status.
- 3 ☐ Do not proceed.
Revise as noted and resubmit next submission and status.
- 4 ☒ Complete, no further submission required.

LUC SÉNÉCAL

2017-07-10

By:

Date:

Review and authorization to fabricate are only for general conformance with the design concept of the Project as expressed in the Contract Documents. Sole responsibility for the accuracy and completeness of this document, including but not limited to dimensions and quantities, remains with the Supplier/Contractor. Agnico Eagle does not warrant the accuracy or completeness of any of the information contained herein, nor does Agnico Eagle authorize or approve any construction means, methods, techniques, sequences or any safety precautions or procedures.

Agnico Eagle
No.

6515-C-270-007-141-TES-0007 R: Sub002

DOCUMENT FOR INFORMATION



AGNICO EAGLE

Inspection and Testing Plan

Contract title: Meliadine Fuel Tanks Piping Supply and Installation
 Contract number: 6515-C-270-007
 Promec Ref.: C22498E

Approved on : _____
 Approved by: _____

Approval Signature

ITP #
 Area
 System

Discipline

AEM-ITP-003
 rankin inlet
 ALL

Electrical
 Instrumentation

Updated on:

2017-04-26

Legend

H - Hold
 W - Witness
 I - Inspect
 R - Review

Activity No. and CDRL Code	Activity Description (Per Scope of Work)	Responsibility Contractor and/or Sub	Acceptance Criteria (Specifications, Drawings, Industry Code, Regulatory Authority, Manufacturers O&M manual, Controlling Procedure, Quality/Engineering Bulletins, Other/ Site Quality Plan, Contractor Quality Manuals, etc.)	Verification Point				Verification Document(s) 1. List ONLY the Form(s) applicable to Installation. 2. ▲ Commissioning Required Document
				Contractor		Client		
				H W I R	Initials & Date	H W I R	Initials & Date	
1.0 GENERAL								
1.1	Inspection and Test Plan	Promec / CLIENT		H/R				Approved ITP
1.2	Document review (Acquire and review all applicable documentation)	Promec / CLIENT	Quality Plan	H/R				
1.3	Procedures Submitted and Approved (Cable Installation, Testing, etc.)	Promec / CLIENT	Quality Plan	H/R				All Applicable Approved Procedures
1.4	Drawing Index (IFC) to Latest Revision	Promec	Quality Plan	I/R				VDRL
2.0 ITP SPECIFIC								
2.1	Non-Conformance Report & Log (Both CLIENT & Contractor Issued)	Promec / CLIENT	Quality Plan	H/R				AEM-GE-ITR-002 (Non-Conformance Report) ▲ AEM-GE-LOG-002 (Non-Conformance Log)
2.2	Inspect Material/Equipment for Damages or Deficiencies	Promec	Quality Plan	I/R				AEM-GE-ITR-005 (Inspection Deficiency Report) ▲ AEM-GE-LOG-004 (Inspection Deficiency Log)



Inspection and Testing Plan

Contract title: Meliadine Fuel Tanks Piping Supply and Installation
 Contract number: 6515-C-270-007
 Promec Ref.: C22498E

Approved on : _____
 Approved by: _____

Approval Signature

ITP #
 Area
 System

Discipline

AEM-ITP-003
 rankin inlet
 ALL

Electrical
 Instrumentation

Updated on:

2017-04-26

Legend

H - Hold
 W - Witness
 I - Inspect
 R - Review

Activity No. and CDRL Code	Activity Description (Per Scope of Work)	Responsibility Contractor and/or Sub	Acceptance Criteria (Specifications, Drawings, Industry Code, Regulatory Authority, Manufacturers O&M manual, Controlling Procedure, Quality/Engineering Bulletins, Other/ Site Quality Plan, Contractor Quality Manuals, etc.)	Verification Point				Verification Document(s) 1. List ONLY the Form(s) applicable to Installation. 2. ▲ Commissioning Required Document
				Contractor		Client		
				H W I R	Initials & Date	H W I R	Initials & Date	
3.0	Electrical & Instrumentation							
3.1	All Certified Test Records • Fire Alarm Cert's - (Engineer's Stamp; Vendor Test Documents) • CSA Approval Documentation	Promec / CLIENT	AEM-IN-PRO-001 (Instrumentation Installation and Testing Procedure)	I/R				▲Third Party Document
3.2	Electrical Equipment Installation Inspection Record	Promec / CLIENT	AEM-EL-PRO-004 (Electrical Apparatus Equipment and Support Installation Procedure)	W/R				AEM-EL-ITR-001 (General Report)
3.3	Distribution Panel Inspection & Test Record	Promec / CLIENT	AEM-EL-PRO-004 (Electrical Apparatus Equipment and Support Installation Procedure)	W/R				AEM-EL-ITR-001 (General Report)
3.4	Distribution Transformer Field Inspection Test Record	Promec / CLIENT	AEM-EL-PRO-004 (Electrical Apparatus Equipment and Support Installation Procedure)	W/R				AEM-EL-ITR-001 (General Report)
3.5	PCR Installation and Inspection	Promec / CLIENT	AEM-IN-PRO-001 (Instrumentation Installation and Testing Procedure)	W/R				AEM-IN-ITR-005A (PCR Panel Report)
3.6	Heating Device Installation Record	Promec / CLIENT	AEM-EL-PRO-004 (Electrical Apparatus Equipment and Support Installation Procedure)	I/R				AEM-EL-ITR-002 (Heating Unit Report)
3.7	Cable tray Inspection Record	Promec / CLIENT	AEM-EL-PRO-003 (Cable Tray Installation Procedure)	I/R				AEM-GE-ITR-006 (Miscellaneous Field Report)
3.8	Power/Control Cables Installation Test Record	Promec / CLIENT	AEM-EL-PRO-001 (Cable Installation and Testing Procedure)	W/R				AEM-EL-ITR-003 (Megger Cable Report) AEM-EL-ITR-004 (Continuity Test Report)
3.9	Low Voltage Cable Installation Test Record	Promec / CLIENT	AEM-EL-PRO-001 (Cable Installation and Testing Procedure)	W/R				AEM-EL-ITR-003 (Megger Cable Report)



AGNICO EAGLE

Inspection and Testing Plan

Contract title: Meliadine Fuel Tanks Piping Supply and Installation
 Contract number: 6515-C-270-007
 Promec Ref.: C22498E

Approved on : _____
 Approved by: _____

Approval Signature

ITP #
Area
System

AEM-ITP-003
rankin inlet
ALL

Discipline

Electrical
Instrumentation

Updated on:

2017-04-26

Legend

H - Hold
W - Witness
I - Inspect
R - Review

Activity No. and CDRL Code	Activity Description (Per Scope of Work)	Responsibility Contractor and/or Sub	Acceptance Criteria (Specifications, Drawings, Industry Code, Regulatory Authority, Manufacturers O&M manual, Controlling Procedure, Quality/Engineering Bulletins, Other/ Site Quality Plan, Contractor Quality Manuals, etc.)	Verification Point				Verification Document(s) 1. List ONLY the Form(s) applicable to installation. 2. ▲ Commissioning Required Document
				Contractor		Client		
				H W I R	Initials & Date	H W I R	Initials & Date	
3.10	Instrument Cable Installation Test Record	Promec / CLIENT	AEM-EL-PRO-001 (Cable Installation and Testing Procedure)	I/R				AEM-EL-ITR-004 (Continuity Test Report)
3.11	Grounding System (Grid & Pile Grounds) Installation Inspection and Test Record	Promec / CLIENT	AEM-EL-PRO-002 (Grounding Installation and Testing Procedure)	H/R				AEM-GE-ITR-006 (Miscellaneous Field Report)
3.12	Branch cct Test Record (Lights, Receptacles, Heaters, etc.)	Promec / CLIENT	(Instrumentation Installation and Testing Procedure)	I/R				AEM-EL-ITR-001 (General Report)
3.13	Fire Alarm Panel and Device Installation Record	Promec / CLIENT	(Instrumentation Installation and Testing Procedure)	I/R				AEM-EL-ITR-001 (General Report)
3.14	Instrumentation Installation Test Record (Powered Instruments)	Promec / CLIENT	(Instrumentation Installation and Testing Procedure)	W/I/R				AEM-IN-ITR-003A (Level Transmitter) AEM-IN-ITR-004C (Pressure Switch) AEM-IN-ITR-006A (On/Off Valve) AEM-IN-ITR-001B (Flow Switch) AEM-IN-ITR-001C (Flow Transmitter) AEM-IN-ITR-002A (Push Button Station) AEM-IN-ITR-007 (Miscellaneous Instruments)
3.15	Instrumentation Installation Test Record (Non-powered instruments)	Promec / CLIENT	AEM-IN-PRO-001 (Instrumentation Installation and Testing Procedure)	I/R				AEM-IN-ITR-004A (Pressure Indicator) AEM-IN-ITR-004B (Pressure Safety Valve)



AGNICO EAGLE

Inspection and Testing Plan

Contract title: Meliadine Fuel Tanks Piping Supply and Installation
 Contract number: 6515-C-270-007
 Promec Ref.: C22498E

Approved on : _____
 Approved by: _____

Approval Signature

ITP #
Area
System

Discipline

AEM-ITP-003
rankin inlet
ALL

Electrical
Instrumentation

Updated on:
2017-04-26

Legend

H - Hold
W - Witness
I - Inspect
R - Review

Activity No. and CDRL Code	Activity Description (Per Scope of Work)	Responsibility Contractor and/or Sub	Acceptance Criteria (Specifications, Drawings, Industry Code, Regulatory Authority, Manufacturers O&M manual, Controlling Procedure, Quality/Engineering Bulletins, Other/ Site Quality Plan, Contractor Quality Manuals, etc.)	Verification Point				Verification Document(s) 1. List ONLY the Form(s) applicable to Installation. 2. ▲ Commissioning Required Document
				Contractor		Client		
				H W I R	Initials & Date	H W I R	Initials & Date	
3.16	Motor/Install/Megger/Rotation Test and Polarization Records	Promec / CLIENT	AEM-EL-PRO-004 (Electrical Apparatus Equipment and Support Installation Procedure)	W/R				AEM-EL-ITR-005 (Motor Report)
3.17	Instrument Loop Test (Pre-Commissioning / Commissioning Activity	Promec / CLIENT	(Instrumentation Installation and Testing Procedure)	I/R				AEM-GE-ITR-006 (Miscellaneous Field Report)
4.0	FINAL TURNOVER							
4.1	Construction Completion (Contractor Punchlist & Joint Walkdown Punchlist)	Promec / CLIENT	Quality Plan	H/R				▲ AEM-GE-ITR-003 (Punchlist)
4.2	Final Acceptance of Turnover Package	Promec / CLIENT	Quality Plan	H/R				Signed ITP History Docket
4.3	Declaration of Completion	Promec	Quality Plan	H/R				AEM-GE-ITR-004 (Notice of Final Completion)
4.4	As-Built Drawings	Promec	Quality Plan	H/R				All Required As-Built Drawings
END								

PROMEC's Representatives				CLIENT's Representative	
QA/QC		Project Manager			
Name		Name		Name	
Signature		Signature		Signature	
		Date		Date	



Vendor Document Status

AGNICO EAGLE

- 1 ☐ Proceed to next submission and status.
- 2 ☐ Proceed with exceptions as noted to next submission and status.
- 3 ☐ Do not proceed.
Revise as noted and resubmit next submission and status.
- 4 ☒ Complete, no further submission required.

LUC SÉNÉCAL

2017-07-10

By:

Date:

Review and authorization to fabricate are only for general conformance with the design concept of the Project as expressed in the Contract Documents. Sole responsibility for the accuracy and completeness of this document, including but not limited to dimensions and quantities, remains with the Supplier/Contractor. Agnico Eagle does not warrant the accuracy or completeness of any of the information contained herein, nor does Agnico Eagle authorize or approve any construction means, methods, techniques, sequences or any safety precautions or procedures.

Agnico Eagle
No.

6515-C-270-007-141-TES-0001 R: Sub002

DOCUMENT FOR INFORMATION




Agnico-Eagle Mines Ltd.
Contract no. 6515-C-270-007

Cable Installation and Testing Procedure
AEM-EL-PRO-001

Area No.: All

System No.: All

PROMEC Approvals

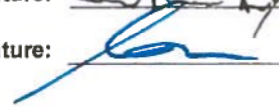Prepared by:	<u>Stéphane Doré</u>	Signature:	<u></u>	Date:	<u>2017-04-25</u>
Verified by:	<u>Jonathan Roy</u>	Signature:	<u></u>	Date:	<u>2017-04-25</u>
Approved by:	<u>Éric Poulin</u>	Signature:	<u></u>	Date:	<u>2017-04-25</u>

CLIENT Approvals

Verified by:	_____	Signature:	_____	Date:	_____
Approved by:	_____	Signature:	_____	Date:	_____

Table of Contents

	<u>Page</u>
1. SCOPE.....	3
1.1 Covered Sections.....	3
2. EXECUTION	3
2.1 Inspection and Preparation	3
2.2 Installation Requirements	3
2.3 Inspection and Test Requirements	4

APPENDIX A – ALL APPLICABLE ITRs & LOG