

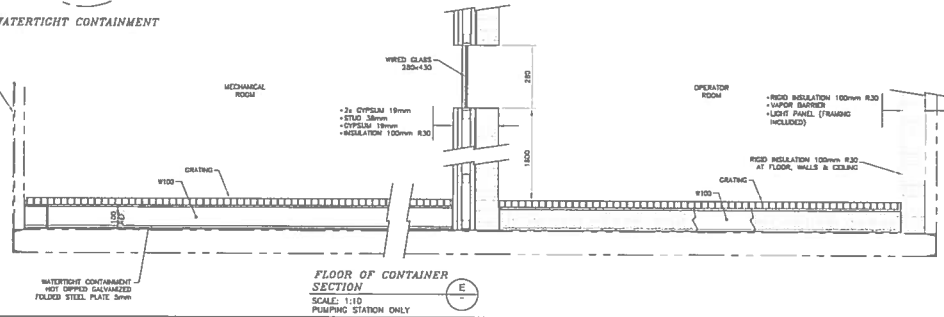
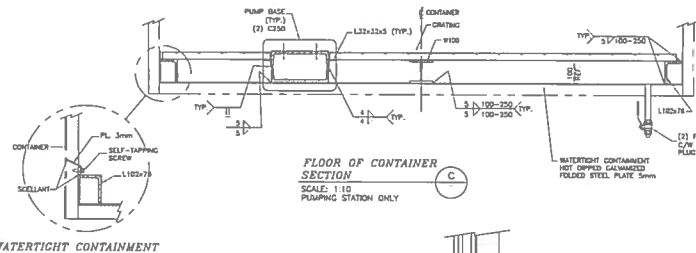
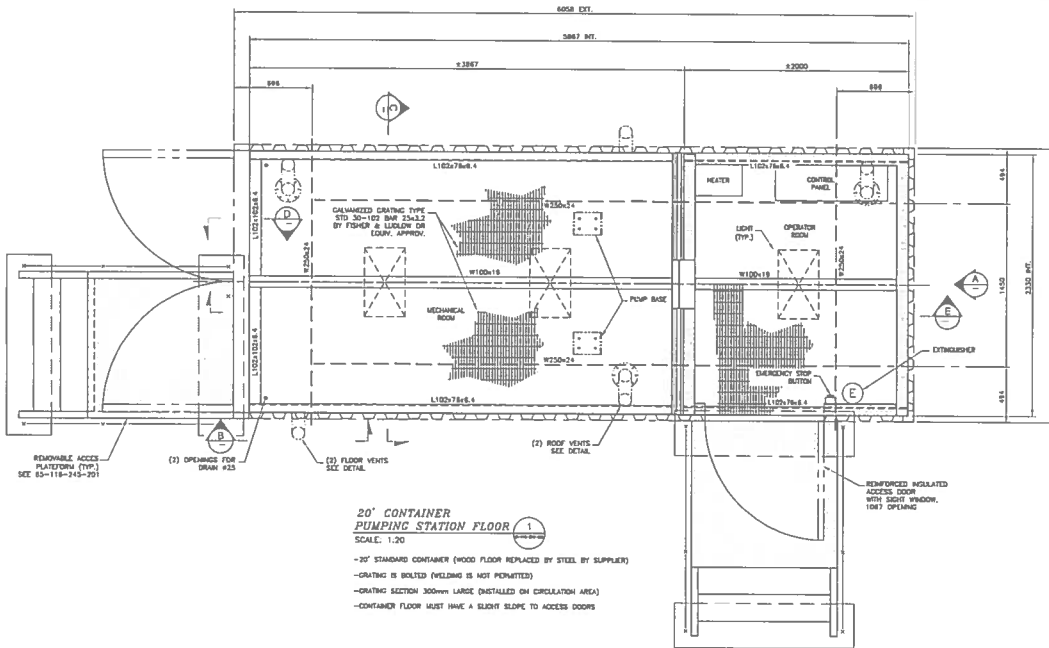



ELEVATION A
SCALE: 1:20
(1) ARRANGEMENT PUMPING STATION

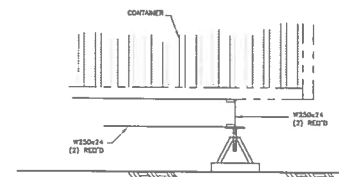

ELEVATION B
SCALE: 1:20
(1) ARRANGEMENT PUMPING STATION

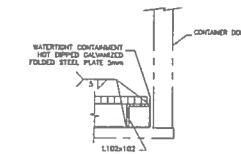

SECTION D
SCALE: 1:10
PUMPING STATION ONLY

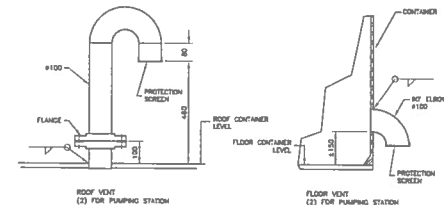

VENT FOR CONTAINER
SCALE: 1:10
PUMPING STATION ONLY



WSP 2017-05-28
1115-245-200-200
1115-245-200-200
1115-245-200-200

NOTES GÉNÉRALES / GENERAL NOTES

1. REPLACE DRAWING: 65-116-245-200

POUR CONSTRUCTION
DATE: 2017-05-31

DESIGNS EN REFERENCE / REFERENCE DRAWINGS

FILE / FICH

DESIGNS EN REFERENCE / REFERENCE DRAWINGS

FILE / FICH

DESIGNS EN REFERENCE / REFERENCE DRAWINGS


FILE / FICH

DESIGNS EN REFERENCE / REFERENCE DRAWINGS

FILE / FICH

NOTE:

1. APPROXIMATIVE STAIRWAY LOCATION; CONTRACTOR HAVE TO ENSURE A MINIMUM CLEARANCE OF 1000mm IN ELEVATION BETWEEN STAIRS AND ANY SHELL CONNECTION

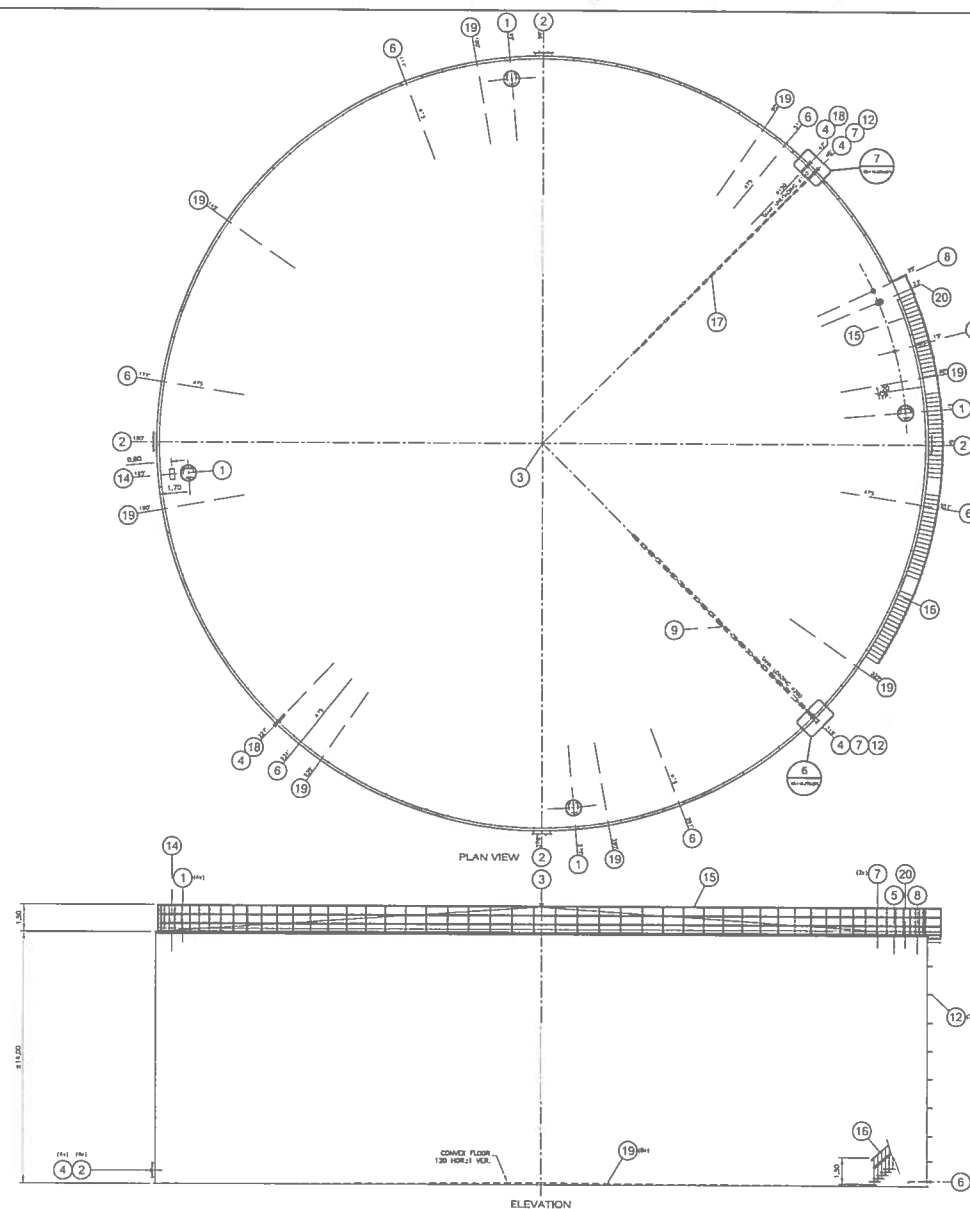

A topographic map of the study area, showing the location of the study area and the location of the study area. The map includes contour lines, a north arrow, and a scale bar. The study area is marked with a box and labeled 'STUDY AREA'.



1075 DE AVENUE EST
VAL D'OR (QUEBEC) CANADA J9P 6J7
TEL: (514) 825-4771 | TEL.: (514) 824-1111 | WWW.WSPGROUP.COM

NOTES GÉNÉRALES / GENERAL NOTES

1. TANK DIMENSIONS ADJUSTED ACCORDING TO INFORMATION PROVIDED BY CONTRACTOR
2. REPLACE DRAWING 83-103-280-300

[illegible]

DESIGNS EN RÉFÉRENCE / REFERENCE DRAWINGS

PAGE / TOTAL	DATE



AGNICO EAGLE

REVISION



TYPE / SIZE
AGNICO EAGLE - WELLDONE DIVISION
116 - FUEL TANK FARM
260 - PLATEWORK
TANK #1 - 20,000,000 Gtms
ø43m x 14m H.
GENERAL ARRANGEMENT


SCREENED BY	CHESLAINE GORHAT	DATE	2017-05-
VERIFIED BY	JILL MORLOCKE, tech.		2017-05-
APPROVED BY	DENIS THEODOREAU, Insp.		2017-05-
APPROVED BY			
RECEIVED	1:15	DATE	2017-05-28
NO. 000000	65-116-260-200		
NO. PROJECT	5515	REVISION	0 / 1
PROJECT NO.			

NEW TANK #2 - DIESEL


ITEM NO.	DESCRIPTION	REMARKS
1	4" HODD ROOF MANHOLE	TO API 650 STANDARDS
2	4" HODD SHELL MANHOLE	TO API 650 STANDARDS
3	1" HODD PAINTER SCAFFOLD CABLE SUPPORT	TO API 650 STANDARDS
4	SHELL NOZZLE - INLET/OUTLET	TO API 650 STANDARDS
5	VENT OPENING	TO API 650 STANDARDS
6	WATER DRAIN-OFF	TO API 650 STANDARDS & NRC
7	2" ROOF PRESSURE RELIEF LINE CONNECTION, HALF COUPLING #25 (THREADED)	TO API 650 STANDARDS & NRC
8	1" ROOF #150 GAGE HATCH	TO API 650 STANDARDS, SEE DETAIL
9	1" FIRE PIPE - TANK LOADING #200 x 11.7m L.C.	TO API 650 STANDARDS, SEE DETAIL
10		
11		
12	3" SHELL BRACKET FOR PIPING & CONDUIT	SEE DETAIL
13		
14	1" ROOF INSPECTION FRAME	TO API 650 STANDARDS
15	1" ROOF CLAMPING	TO API 650 STANDARDS & NRC
16	1" SPIRAL STAIRWAY, DIAGONAL & HORIZONTAL	TO API 650 STANDARDS & NRC
17	1" FIRE PIPE - TANK LOADING #150 x 11.7m L.C.	TO API 650 STANDARDS
18	2" PUMPING LOW LEVEL #150	TO API 650 STANDARDS, SEE DETAIL
19	8" GROUNDING LUG	TO API 650 STANDARDS, SEE DETAIL
20	1" ROOF NOZZLE #200 FOR OVERFILL PROTECTION	TO API 650 STANDARDS, SEE DETAIL

NOTE:

- APPROXIMATE STAIRWAY LOCATION CONTRACTOR HAVE TO ENSURE A MINIMUM CLEARANCE OF 1000mm IN ELEVATION BETWEEN STAIRS AND ANY SHELL CONNECTION

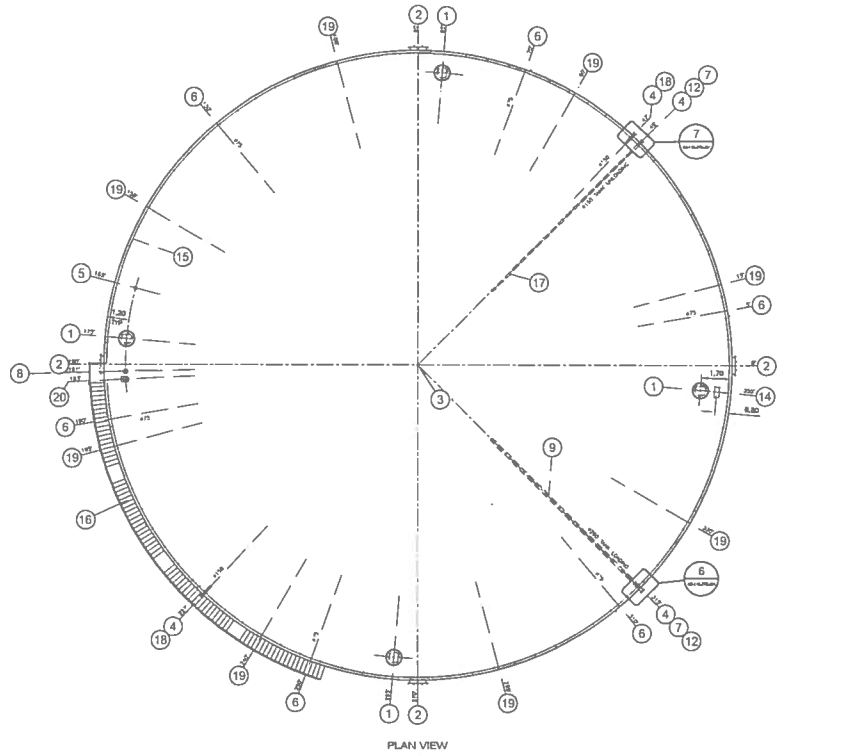

PLAN VIEW

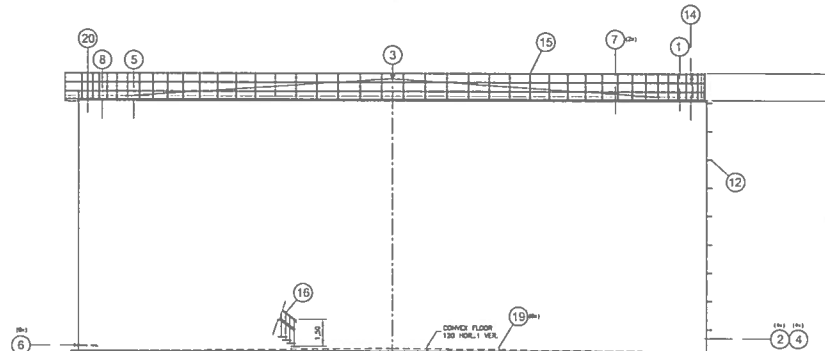

ELEVATION

POUR CONSTRUCTION
FOR CONSTRUCTION
DATE: 2017-05-31



WSP
11100 GLENVIEW AVE
VANCOUVER, BC V6V 1K7
TEL: 604-261-1111 / FAX: 604-261-1112 / WWW.WSPGROUP.COM

NOTES GENERALES / GENERAL NOTES

- TANK DIMENSIONS ADJUSTED ACCORDING TO INFORMATION PROVIDED BY CONTRACTOR
- REPLACE DRAWING: 63-163-260-201

DESIGNS EN REFERENCE / REFERENCE DRAWINGS

NO.	DESCRIPTION	DATE
1	63-163-260-201	2017-05-31

NO.	DESCRIPTION	DATE
1	63-163-260-201	2017-05-31

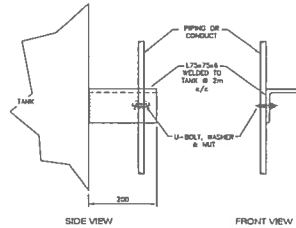

2
Detail

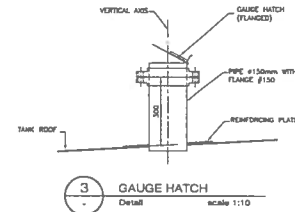


3 GAUGE HATCH
Detail scale 1:10

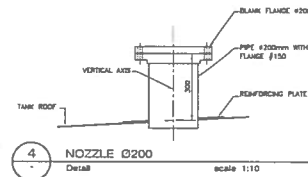


4 NOZZLE Ø200
Detail scale 1:




6 GROUNDING LUG
Detail scale 1:10

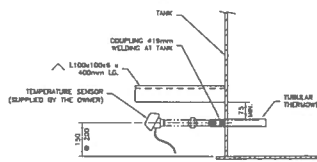


8 TEMPERATURE SENSOR ON SHELL TANK
- Detail scale 1:10

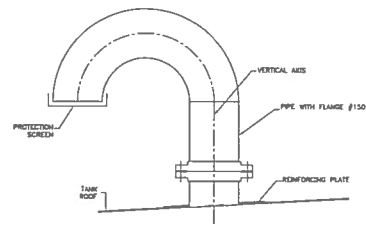


5 VENT
Typical detail scale 1:10

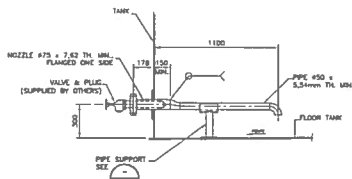

10 WATER DRAW-OFF
Detail Scale 1:20

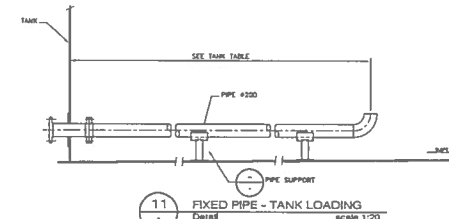

11 FIXED PIPE - TANK LOADING
Detail scale 1:20

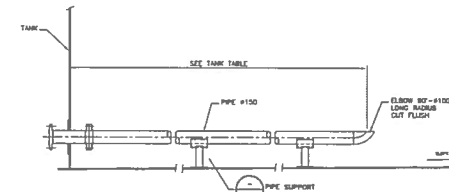

12 FIXED PIPE - TANK UNLOADING
Detail scale 1:20



TEL: 819-825-4274 | FAX: 819-825-1514 | WWW.USFORQUEBEC.COM
Fax: 1-819-825-4274

NOTES GÉNÉRALES / GENERAL NOTES

1. REPLACE DRAWING 65-103-260-202

1. **Prüfungsausschuss:** Der Prüfungsausschuss ist das höchste Gremium der Hochschule. Er besteht aus Vertretern der Fakultäten, der Verwaltung und der Studierenden. Er entscheidet über die Zulassung zur Aufnahmeprüfung, die Zulassung zum Studium, die Zulassung zur Promotion und die Zulassung zur Habilitation.

DESSINS EN RÉFÉRENCE / REFERENCE DRAWINGS

$\sigma_{\text{max}} / \sigma_{\text{ave}}$	f (%)



REVISIONS




TYPE / TALE
AGNICO EAGLE - HELIADINE DIVISION
118 - FUEL TANK FARM
280 - PLATEWORK
TANK #1 @ #8
DETAILS

SCENE Pkt checked by	CHELSEAE CORNUIT	DATE 2017-05-29
SCENE Pkt checked by	JOEL MORLIERZ, Insp.	2017-05-29
APPROVE Pkt APPROVED BY	DEMS THIBODEAU, Insp.	2017-05-29
SUBMIT SCALE	DATE	2017-05-29








65-116-260-202

NO. PROJECT	REVISION	PERMITS / DOW
PROJECT NO.		
6515	0	1 /

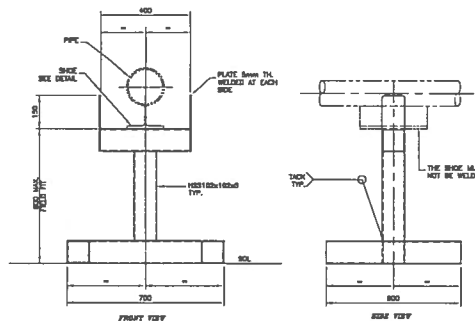



NOTE:
1. GROUND FOR THE SUPPORT TO BE FLAT AND STABLE.
AND WITH MINIMUM CONCRETE BACKFILL IF NEEDED.

PIPING SUPPORT
SCALE: 1:10

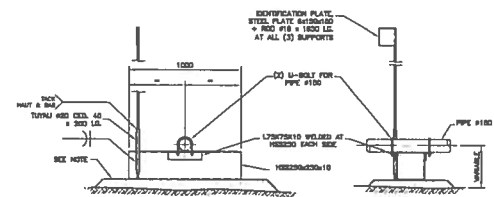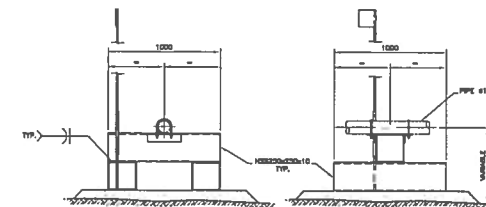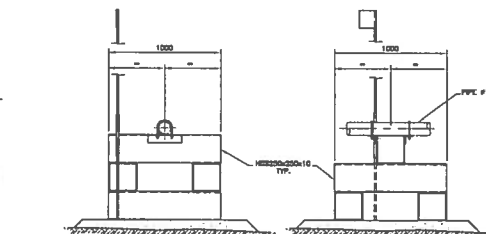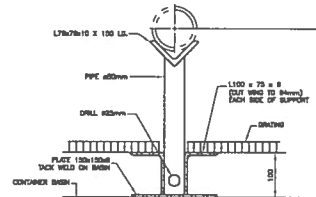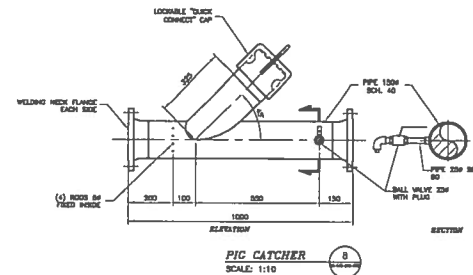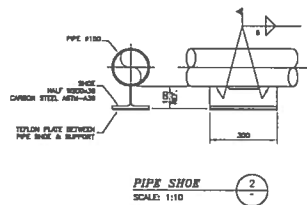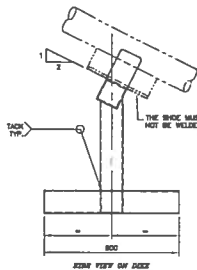

NOTE:
1. GROUND FOR THE SUPPORT TO BE FLAT AND STABLE.
AND WITH MINIMUM CONCRETE BACKFILL IF NEEDED.

MARINE LINE SUPPORT
SCALE: 1:20

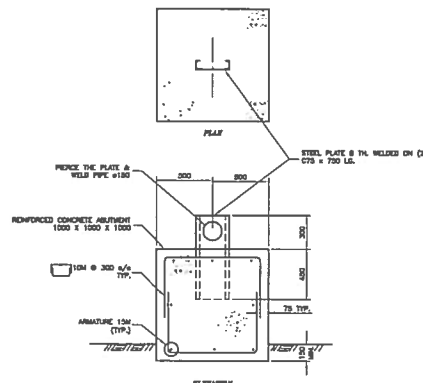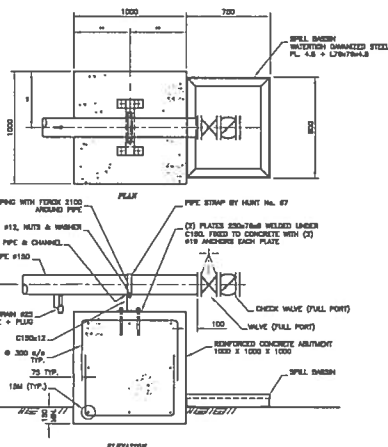

WSP
WEST SLOPE PETROLEUM
1100 11th Street, Suite 100
Tulsa, Oklahoma 74103-1100
Tel: 918-438-1100
Fax: 918-438-1101
www.wspcorp.com

NOTES / GENERAL / REMARKS

1. REPLACE DRAWING: 65-103-770-200

POUR CONSTRUCTION FOR CONSTRUCTION
DATE: 2017-05-31

DESIGNER: [Signature]
CHECKER: [Signature]
DATE: 2017-05-31

REVISIONS

REVISIONS




REVISIONS


REVISIONS

REVISIONS

REVISIONS

REVISIONS

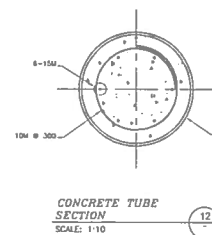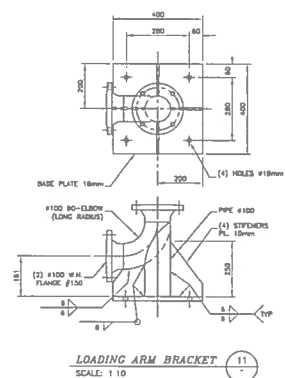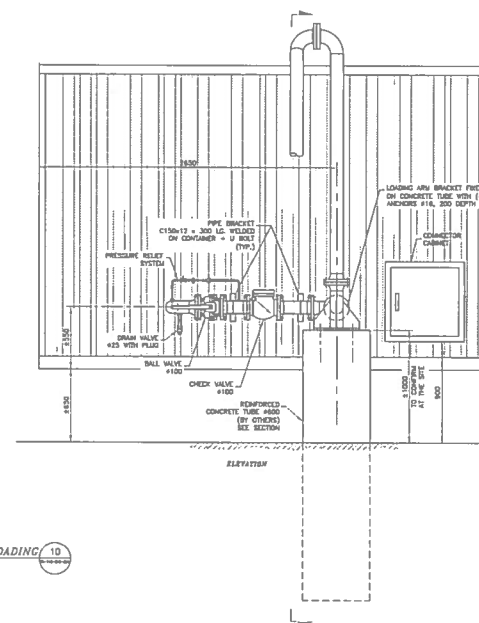

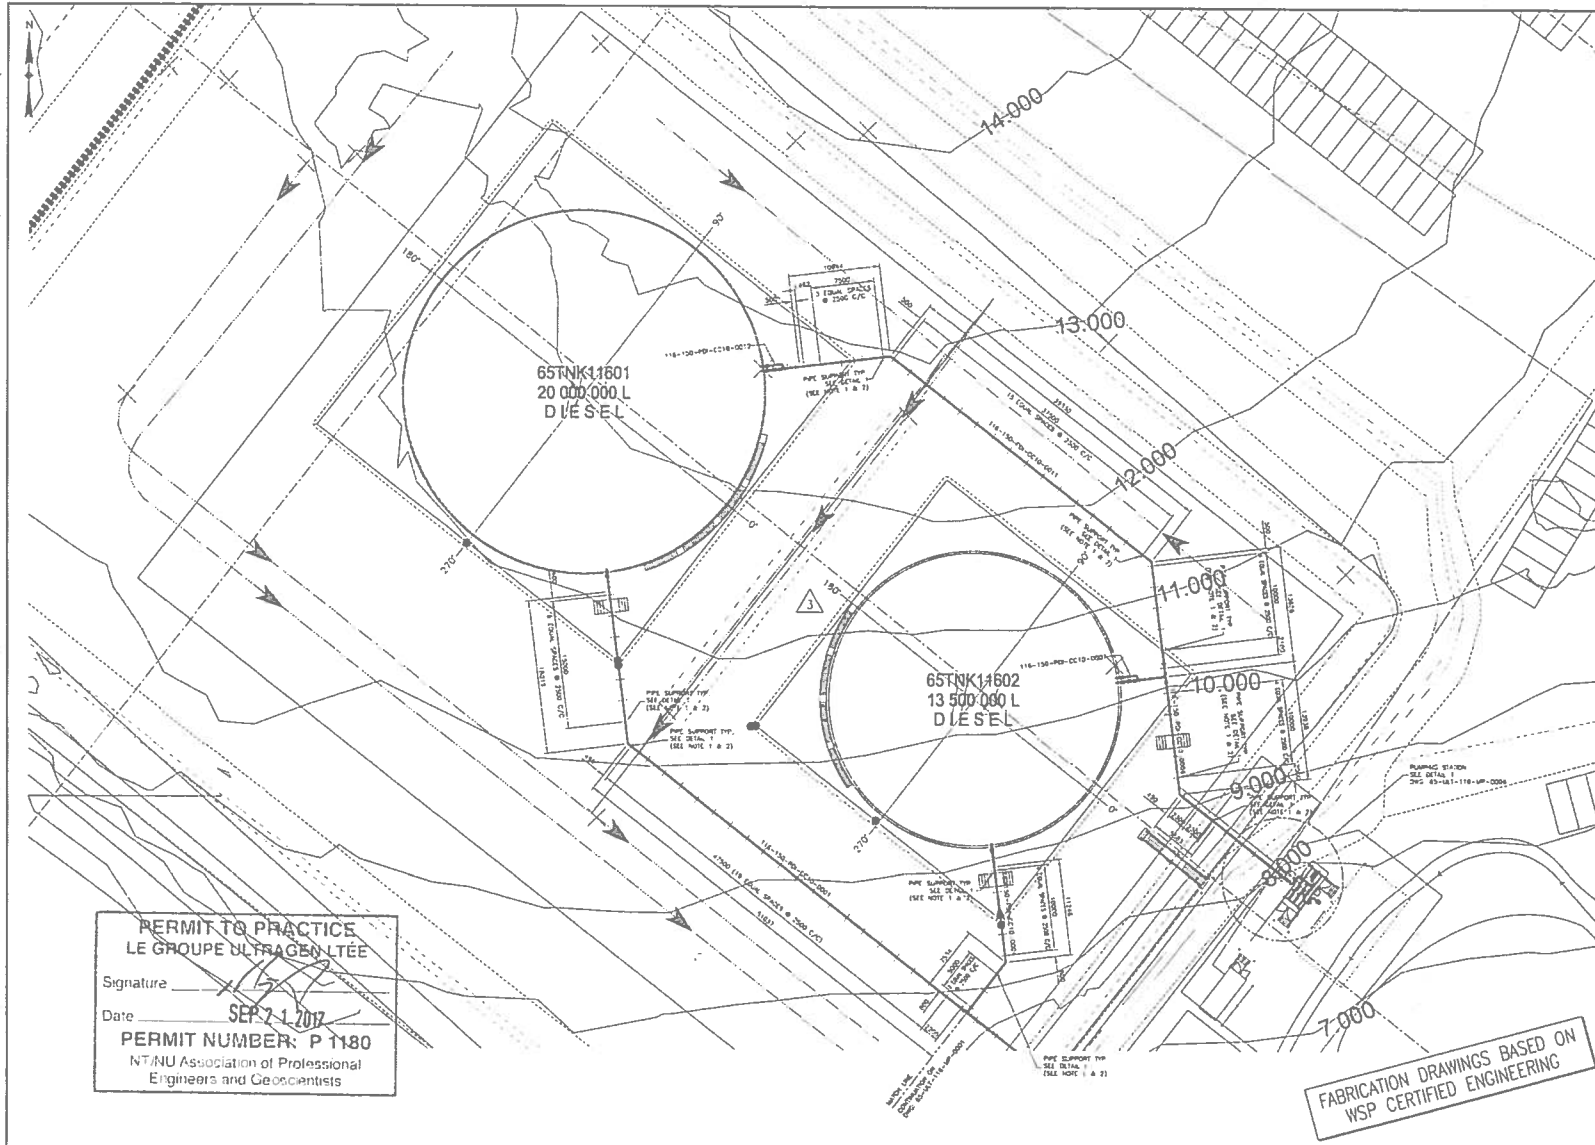

PERMIT TO PRACTICE
LE GROUPE ULTRAGEN LTÉE

Signature: *[Signature]*

Date: SEP 21 2017

PERMIT NUMBER: P 1180

NT/NU Association of Professional
Engineers and Geoscientists

FABRICATION DRAWINGS BASED ON
WSP CERTIFIED ENGINEERING

NOTES GÉNÉRALES / GENERAL NOTES

1. GÉNÉRAL: TOUS LES ÉLÉMENTS DE LA PLANIFICATION DOIVENT ÊTRE CONFORMES AUX NORMES EN VIGUEUR.
2. EN CAS DE MODIFICATION, IL FAUT S'ASSURER QUE LES CHANGEMENTS NE MODIFIENT PAS L'INTÉGRITÉ DE L'ŒUVRE.

REGISTERED PROFESSIONAL ENGINEER
D. TRUONG
LICENSEE
NT/NU
2017/09/21

DESIGNS EN RÉFÉRENCE / REFERENCE DRAWINGS

NO.	DESCRIPTION	DATE
1	PROJET DE CONSTRUCTION	2017-09-21
2	PROJET DE CONSTRUCTION	2017-09-21
3	PROJET DE CONSTRUCTION	2017-09-21
4	PROJET DE CONSTRUCTION	2017-09-21
5	PROJET DE CONSTRUCTION	2017-09-21
6	PROJET DE CONSTRUCTION	2017-09-21
7	PROJET DE CONSTRUCTION	2017-09-21
8	PROJET DE CONSTRUCTION	2017-09-21
9	PROJET DE CONSTRUCTION	2017-09-21
10	PROJET DE CONSTRUCTION	2017-09-21


AGNICO EAGLE

ULTRAGEN

116 - FUEL TANK FARM
FUEL DISTRIBUTION
CENTRAL ARRANGEMENT
PLAN VIEW

65-ULT-116-MP-002

6513 2 1 / 1

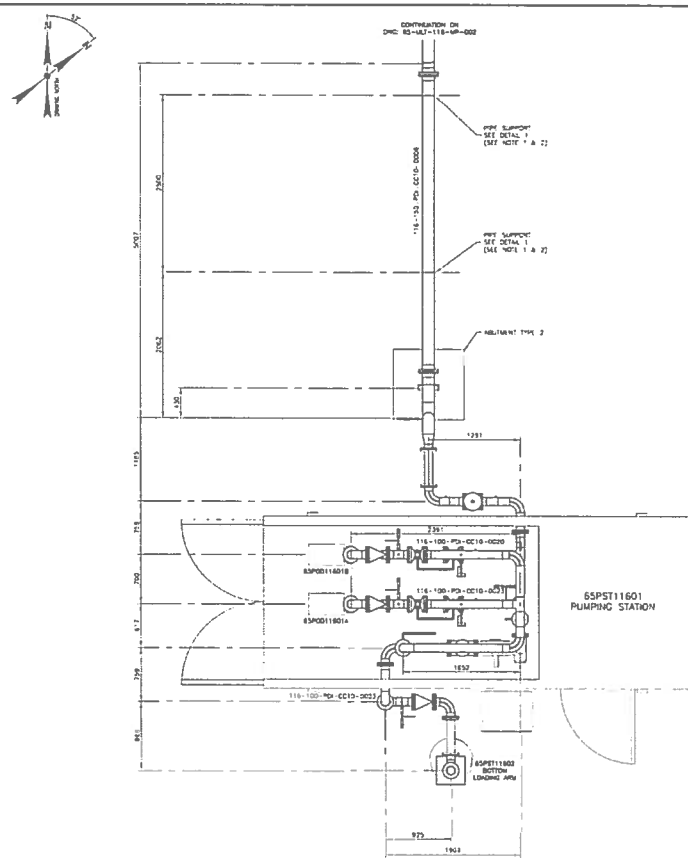

PUMPING STATION - DETAIL 1
SCALE 1:30

PERMIT TO PRACTICE
LE GROUPE ULTRAGEN LTÉE
Signature: *[Signature]*
Date: **SEP 21 2017**
PERMIT NUMBER: P 1180
NTNU Association of Professional
Engineers and Geoscientists
FABRICATION DRAWINGS BASED ON
WSP CERTIFIED ENGINEERING



NOTES GÉNÉRALES / GENERAL NOTES

1. S'IL Y A DES CHANGEMENTS À FAIRE, IL FAUT LES NOTER SUR LE DROIT DE LA DRAPEAU.
2. EN RÉVISANT, S'IL Y A DES CHANGEMENTS À FAIRE, IL FAUT LES NOTER SUR LE DROIT DE LA DRAPEAU.



2017/09/21

DESSINS EN RÉFÉRENCE / REFERENCE DRAWINGS

NO. / NO.	DESCRIPTION / DESCRIPTION	DATE / DATE
1	PROJET / PROJECT	2017-09-21
2	PROJET / PROJECT	2017-09-21
3	PROJET / PROJECT	2017-09-21
4	PROJET / PROJECT	2017-09-21
5	PROJET / PROJECT	2017-09-21



1	PROJET / PROJECT	2017-09-21
2	PROJET / PROJECT	2017-09-21
3	PROJET / PROJECT	2017-09-21
4	PROJET / PROJECT	2017-09-21
5	PROJET / PROJECT	2017-09-21



AGNICO EAGLE - MEADOW HOLLOW
116 - FUEL TANK FARM
FUEL DISTRIBUTION
GENERAL ARRANGEMENT
DETAILS


NO. / NO.	DESCRIPTION / DESCRIPTION	DATE / DATE
1	PROJET / PROJECT	2017-09-21
2	PROJET / PROJECT	2017-09-21
3	PROJET / PROJECT	2017-09-21
4	PROJET / PROJECT	2017-09-21
5	PROJET / PROJECT	2017-09-21

65-ULT-116-MP-003


5515 2 1 / 1



CONT. DRG 2

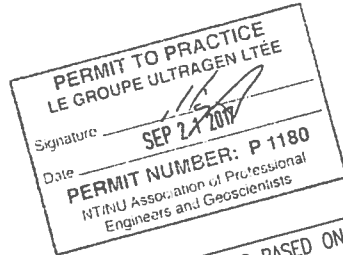

FABRICATION DRAWINGS BASED ON
WSP CERTIFIED ENGINEERING

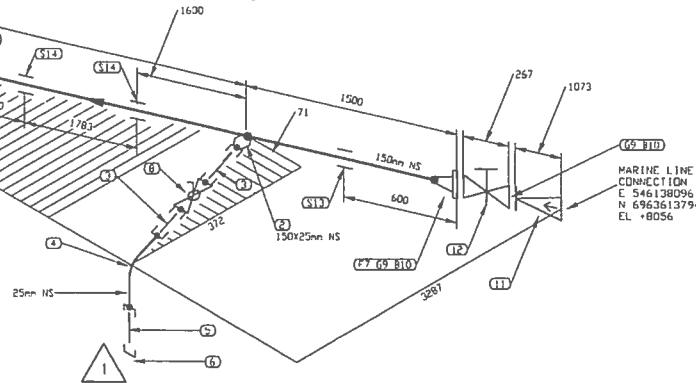

LISTE DE MATERIEL

no	QTE	DA	MATERIEL/CATALOGUE	DESCRIPTION
1	16045	MM	A 333 Gr. 6	SCH STD. SMLS PIPE
2	1	150x25	A 350 Gr. LF2	CL 3000, SOCKLE
3	2	25	A 333 Gr. 6	SCH 80, NIPPLE x 75mm LG PSE
4	1	25	A 350 Gr. LF2	CL 3000, SV 90 DEG ELBOW
5	1	25	A 333 Gr. 6	SCH 80, NIPPLE x 75mm LG PSE+10E
6	1	25	A 350 Gr. LF2	CL 3000, THRD CAP
7	1	150	A 350 Gr. LF2	CL 150, SCH STD. RF, WN FLANGE
8	1	25	BA-25	CL 600, SV, BALL VALVE
9	2	150	ASME B16.20	CL 150, GARLOCK 5500, RING TYPE GASKET 1/8" THK
10	16	19	A 193 B7/A 194 2H	CL 150, B - 19.05 X 100 STUD BOLTS c/w TWO HEAVY HEX NUTS
11	1	150	CH-29	CL 150, RF, SWING CHECK VALVE
12	1	150	GA-10	CL 150, RF, GATE VALVE
13	1	150		PIPE GUIDE AS PER DETAIL 4, DWG: 65-116-270-200
14	6	150		PIPE SUPPORT AS PER DETAIL 3, DWG: 65-116-270-200

3	2017/09/21	PROJECT TITLE REVISED	KHV
2	2017/09/11	LINE NUMBERS REVISED	OVN
1	2017/06/30	DRAWN REVISED AS PER CLIENT COMMENTS	OVN
0	2017/05/15	ISSUED FOR CONSTRUCTION	KHV
NO.	DATE	REVISION	PAR

CLIENT:


AGNICO EAGLE

NUQSANA PROMEC MINING


ultragen

CONSULTANT PROJECT NO. 591700

NO. DE CONDUITE	SPECIFICATION	PRODUIT	SYSTEME REVEITEMENT	CODE DE COULEUR	ISOLATION ET TRAÇAGE	ÉPAISS. D'ISOLATION	
116-150-PDI-CC10-0001	CC10	PDI				65-116-270-200	PIPE SUPPORT DETAILS
PRESSION D'OPERATION	TEMPERATURE D'OPERATION	PRESSION DE CONCEPTION	TEMPERATURE DE CONCEPTION	PRESSION D'ESSAI	CLASSE D'INSPECTION	CODE DE SERVICE	TRAITEMENT THERMIQUE
PSIG	°F	PSIG	°F	PSIG		No. DESSIN	DESSINS DE REFERENCE

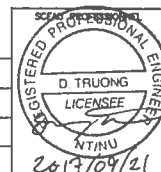

CONC.: KHV	DATE: 2017/04/25	PROJET: AGNICO EAGLE - MELIADINE DIVISION 116 - FUEL TANK FARM
DESSINE PAR: KVC	DATE: 2017/04/25	TITRE: RANKIN INLET FABRICATION ISOMETRIC MARINE LINE TO 65TNK11601 & 65TNK11602
VOR. PAR: -	DATE: -	
APP.: -	DATE: -	
ECHELLE: AUCUNE		
No. PROJET	No. DESSIN	PAGES
6515	116-150-PDI-CC10-0001	1/13
		REV. 3

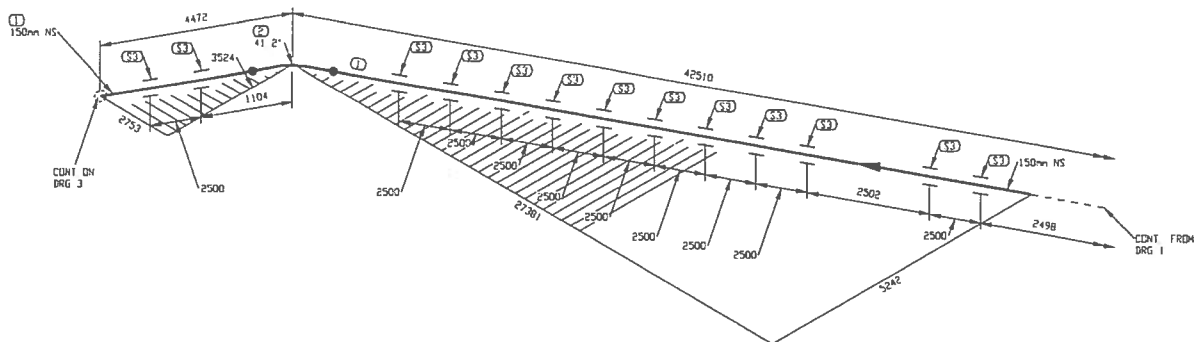

FABRICATION DRAWINGS BASED ON
WSP CERTIFIED ENGINEERING



CLIENT:



AGNICO EAGLE



NUQSANA PROMEC MINING




ultragen
ULTRASONIC TECHNOLOGY

CONSULTANT PROJECT NO

591700

COMC: KMY	PROJECT: AGNICO EAGLE - MELIADINE DIVISION		
DATE: 2017/04/25	116 - FUEL TANK FARM		
DESSINÉ PAR: KVL	TITRE: RANKIN INLET		
DATE: 2017/04/25	FABRICATION ISOMETRIC		
VID. PAR: -	MARINE LINE TO 65TNK11601 & 65TNK11602		
DATE: -			
APP: -	No PROJECT	No DESSIN	PAGES
DATE: -	6515	116-150-PDI-CCIO-0001	2/13
SCHEM: ALCUNE			2

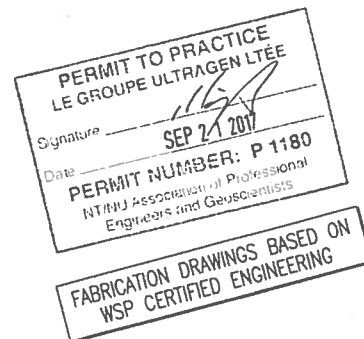

2	2017/09/21	PROJECT TITLE REVISED	KHV
1	2017/09/11	LINE NUMBERS REVISED	KHV
0	2017/05/15	ISSUED FOR CONSTRUCTION	KHV
No.	DATE	REVISION	PAR APP




AGNICO EAGLE



ENGINEER	CONC: HVC	PROJECT:	AGNICO EAGLE - MELIADINE DIVISION		
	DATE: 2017/4/25		116 - FUEL TANK FARM		
	DESSINE PAR: HVC	TITRE:	RANKIN INLET		
	DATE: 2017/4/25		FABRICATION ISOMETRIC		
			MARINE LINE TO 65TNK11601 & 65TNK11602		
VOL PAR: -		No PROJECT	No DESSIN	PAGES	REV.
DATE: -		6515	116-150-PDI-CC10-0001	3/13	2
APP: -					
DATE: -					
ÉCHELLE: AUCUNE					

SCIENTIFIC EXPRESSION
REGISTERED PROFESSIONAL
D TRUONG
LICENSEE
NT/NU
2017/09/2

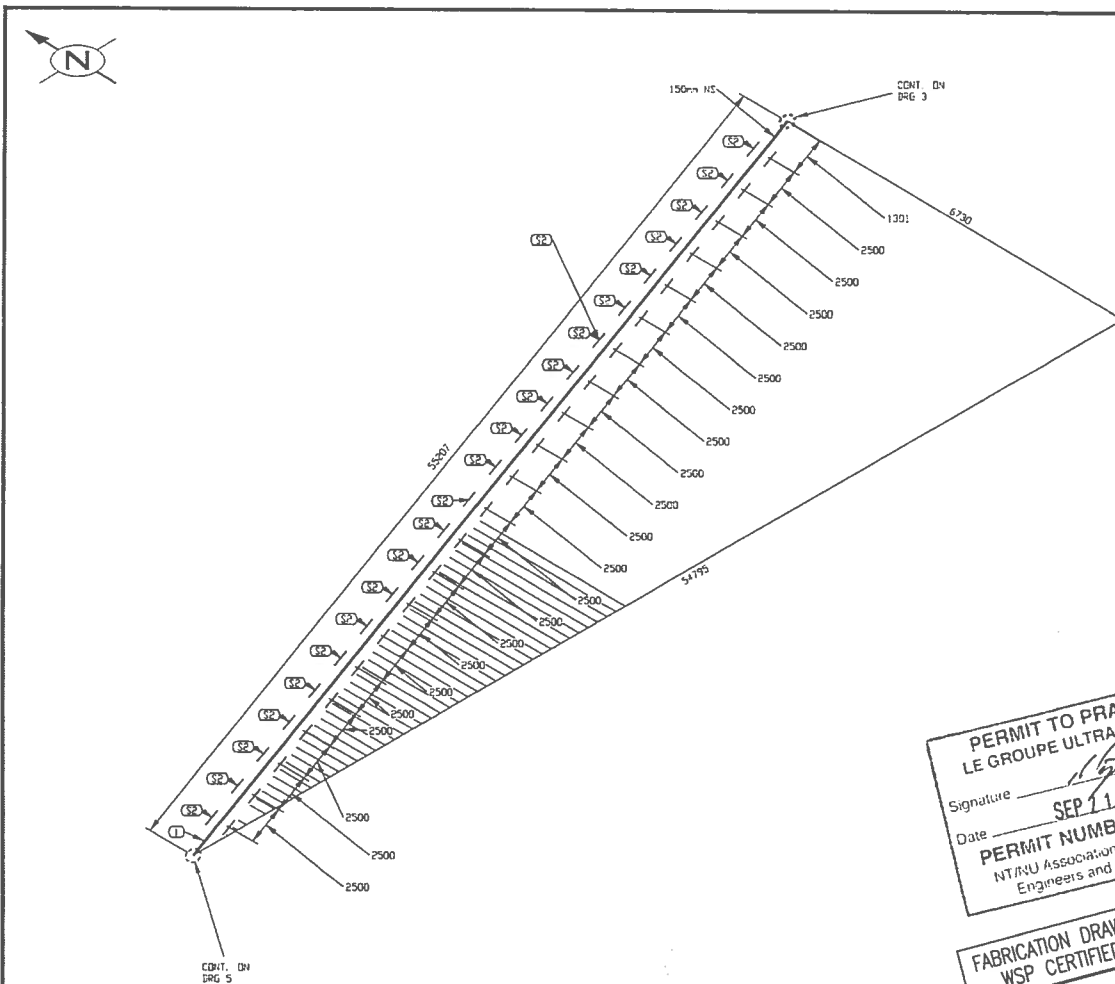

PERMIT TO PRACTICE
LE GROUPE ULTRAGEN LTÉE
Signature *[Signature]*
Date **SEP 11 2017**
PERMIT NUMBER: P 1180
NT/NU Association of Professional
Engineers and Geoscientists
FABRICATION DRAWINGS BASED ON
WSP CERTIFIED ENGINEERING

LISTE DE MATERIEL				
No	QTE	DA	MATERIEL/CATALOGUE	DESCRIPTION
1	55207 MM	150	A 333 Gr. 6	SCH STD. SHLS PIPE
2	23	150		PIPE SUPPORT AS PER DETAIL 3. Dwg 65-116-270-200

2	2017/09/21	PROJECT TITLE REVISED	KHV
1	2017/09/11	LINE NUMBERS REVISED	KHV
0	2017/05/15	ISSUED FOR CONSTRUCTION	KHV
No.	DATE	REVISION	APP.

CLIENT:


AGNICO EAGLE

NUQSANA PROMEC MINING


Ultragen

CONSULTANT PROJECT NO. **591700**

NO. DE CONDUITE		SPECIFICATION	PRODUIT	SISTÈME REVÊTEMENT	CODE DE COULEUR	ISOLATION ET TRACÉ	ÉPAISS. D'ISOLATION		
116-150-PDI-CC10-0001		CC10	PDI					65-116-270-200	PIPE SUPPORT DETAILS
PRESSION D'OPÉRATION	TEMPÉRATURE D'OPÉRATION	PRESSION DE CONCEPTION	TEMPÉRATURE DE CONCEPTION	PRESSION D'ESSAI	CLASSE D'INSPECTION	CODE DE SERVICE	TRAITEMENT THERMIQUE	65-116-205-200	P&ID
PSIG	T	PSIG	T	PSIG				No. DESSIN	DESSINS DE RÉFÉRENCE

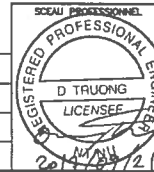

CONC.: KHV	DATE: 2017/04/23	DESSINÉ PAR: KHV	DATE: 2017/04/23	VOIR PAR: -	DATE: -	APP.: -	DATE: -	ÉCHELLE: AUCUNE
PROJECT:		AGNICO EAGLE - MELIADINE DIVISION 116 - FUEL TANK FARM						
TITLE:		RANKIN INLET FABRICATION ISOMETRIC MARINE LINE TO 65TNK11601 & 65TNK11602						
No. PROJET	No. DESSIN		PAGES	REV.				
6515	116-150-PDI-CC10-0001		4/13	2				

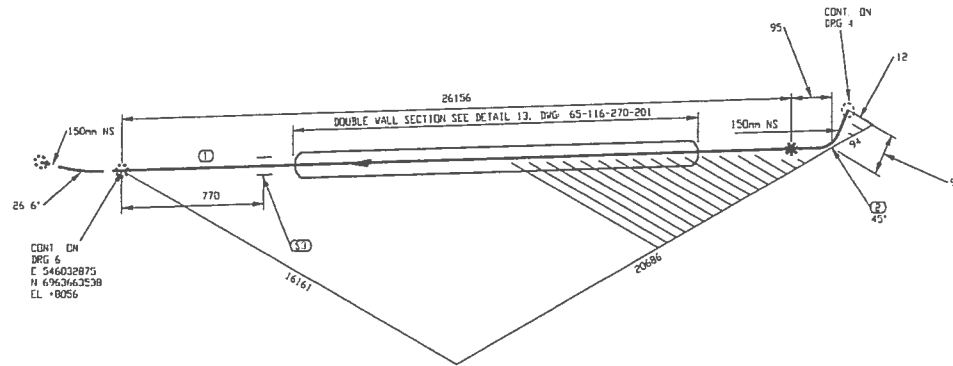

PERMIT TO PRACTICE
LE GROUPE ULTRAGEN LTÉE
Signature *[Signature]*
Date SEP 21 2017
PERMIT NUMBER: P 1180
NTINU Association of Professional
Engineers and Geoscientists

FABRICATION DRAWINGS BASED ON
WSP CERTIFIED ENGINEERING

LISTE DE MATERIEL				
No	QTE	DA	MATERIEL/CATALOGUE	DESCRIPTION
1	25156	MM	A 333 Gr. 6	SCH STD, SHLS PIPE
2	1	150	A 420 Gr. WPL6	SCH STD, BW 1/4 45 DEG ELBOW
3	1	150		ASBUTMENT TYPE 2 AS PER DETAIL 5, DWG: 65-116-270-200


2	2017/09/21	PROJECT TITLE REVISED	KHV
1	2017/09/11	LINE NUMBERS REVISED	KHV
0	2017/05/15	ISSUED FOR CONSTRUCTION	KHV
No.	DATE	REVISION	APP.

CLIENT:




CONSULTANT PROJECT NO. 591700

NO. DE CONDUITE	SPECIFICATION	PRODUIT	SISTÈME REVÊTEMENT	CODE DE COULEUR	ISOLATION ET TRACÉ	ÉPAISS. D'ISOLATION	
116-150-PDI-CC10-0001	CC10	PDI		-			65-116-270-200 PIPE SUPPORT DETAILS
PRESSION D'OPERATION	TEMPERATURE D'OPERATION	PRESSION DE CONCEPTION	TEMPERATURE DE CONCEPTION	PRESSION D'ESSAI	CLASSE D'INSPECTION	CODE DE SERVICE	TRAITEMENT THERMIQUE
PSIG	°F	PSIG	°F	PSIG			65-116-205-200 P&ID
						No. DESSIN	DESSINS DE REFERENCE

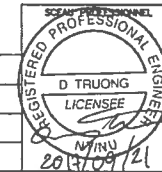

CONC.: KHV DATE: 2017/04/25 DESSINE PAR: KVE DATE: 2017/04/25 VOR. PAR: - DATE: - APP.: - DATE: - ÉCHELLE: AUCUNE	PROJET: AGNICO EAGLE - MELIADINE DIVISION 116 - FUEL TANK FARM TITRE: RANKIN INLET FABRICATION ISOMETRIC MARINE LINE TO 65TNK11601 & 65TNK11602 No PROJET: 6515 No DESSIN: 116-150-PDI-CC10-0001 PAGES: 5/13 REV.: 2
---	--

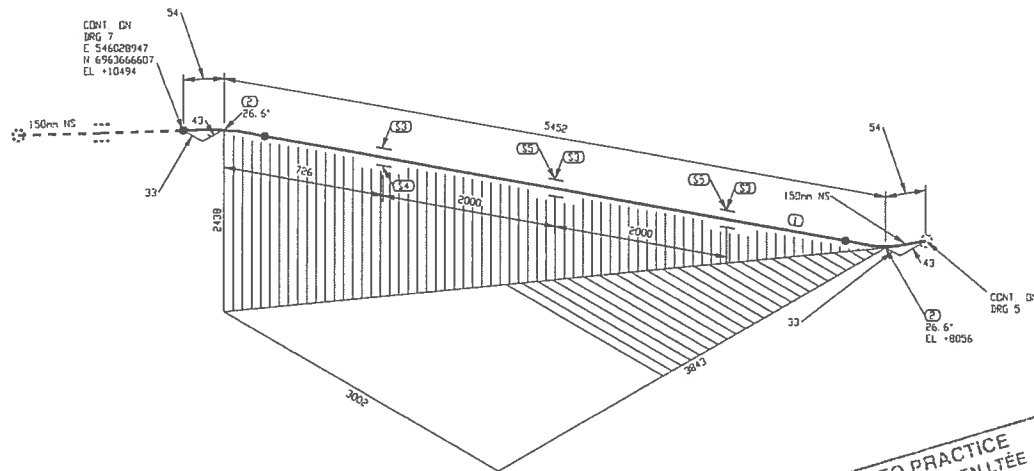

PERMIT TO PRACTICE
LE GROUPE ULTRAGEN LTÉE
Signature *[Signature]*
Date **SEP 21 2017**
PERMIT NUMBER: P 1180
NTNU Association of Professional
Engineers and Geoscientists
FABRICATION DRAWINGS BASED ON
WSP CERTIFIED ENGINEERING

LISTE DE MATERIEL				
no	UTE	DZ	MATRIEL/CATALOGUE	DESCRIPTION
1	5344 PH	150	A 323 Gr. 6	SCH STD, SMLS PIPE
2	2	150	A 420 Gr. WPL6	SCH STD, BV LR 45 DEG ELBOW TRIM TO 26.57
3	3	150		PIPE SUPPORT AS DETAIL 1, DWG 65-116-270-200
4	1	150		PIPE SHOE AS PER DETAIL 2, DWG 65-116-270-200
5	2	150		PIPE SHOE AS PER DETAIL 2, DWG 65-116-270-200

2	2017/09/21	PROJECT TITLE REVISED	KHV
1	2017/09/11	LINE NUMBERS REVISED	KHV
0	2017/05/15	ISSUED FOR CONSTRUCTION	KHV
No.	DATE	REVISION	PAR APP

CLIENT:


**AGNICO EAGLE**

**NUQSANA-PROMEC MINING**


**Ultragen**

CONSULTANT PROJECT NO. **591700**

NO. DE CONDUITE	SPECIFICATION	PRODUIT	SYSTEME REVETEMENT	CODE DE COULEUR	ISOLATION ET TRACAGE	EPASS. D'ISOLATION		
116-150-PDI-CC10-0001	CC10	PDI					65-116-270-200	PIPE SUPPORT DETAILS
PRESSION D'OPERATION	TEMPERATURE D'OPERATION	PRESSION DE CONCEPTION	TEMPERATURE DE CONCEPTION	PRESSION D'ESSAI	CLASSE D'INSPECTION	CODE DE SERVICE	TRATMENT THERMIQUE	
PSIG	T	PSIG	T	PSIG				
							No. DESSIN	DESSINS DE REFERENCE

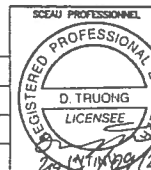

CONC.: KHV DATE: 2517/21/25 DESSINE PAR: KHV DATE: 2517/21/25 VDR. PAR: - DATE: - APP.: - DATE: - ECHELLE: AUCUNE	PROJET: AGNICO EAGLE - MELIADINE DIVISION 116 - FUEL TANK FARM	TITRE: RANKIN INLET FABRICATION ISOMETRIC MARINE LINE TO 65TNK11601 & 65TNK11602	No. PROJET 6515	No. DESSIN 116-150-PDI-CC10-0001	PAGES 6/13	REV. 2
---	--	--	---------------------------	--	----------------------	------------------

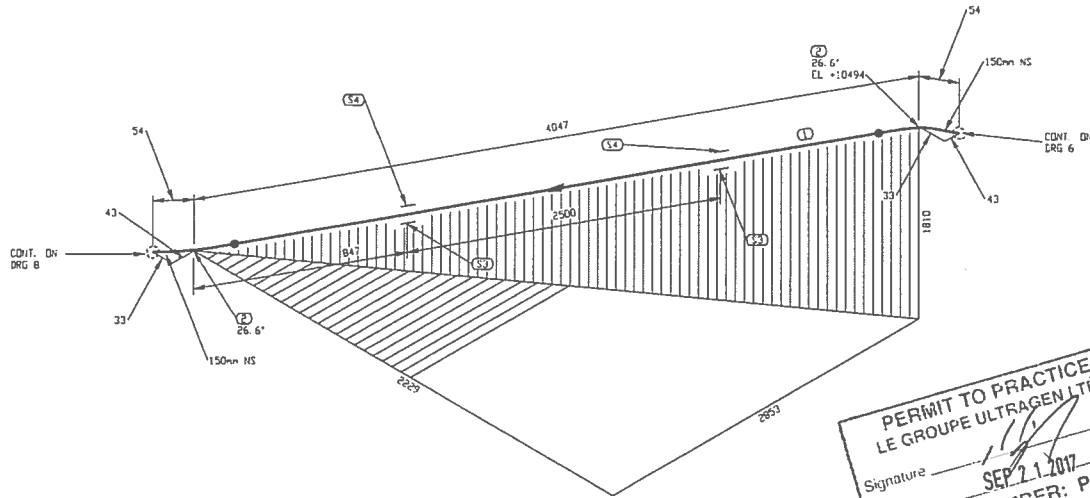

PERMIT TO PRACTICE
LE GROUPE ULTRAGEN LTÉE
Signature _____
Date **SEP 21 2017**
PERMIT NUMBER: P 1180
NTINU Association of Professional
Engineers and Geoscientists
FABRICATION DRAWINGS BASED ON
WSP CERTIFIED ENGINEERING

LISTE DE MATERIEL

No	QTE	DA	MATÉRIEL/CATÉLOGUE	DESCRIPTION
1	3939 MM	150	A 333 Gr. 6	SCM STD. SMLS PIPE
2	2	150	A 420 Gr. WPL6	SCM STD. 90° LR 45 DEG ELBOW TRIM TO 26.57
3	2	150		PIPE SUPPORT AS PER DETAIL 1, DWG
4	2	150		65-116-270-200 PIPE SHOE AS PER DETAIL 2, DWG 65-116-270-200

2	2017/09/21	PROJECT TITLE REVISED	KHV
1	2017/09/11	LINE NUMBERS REVISED	KHV
0	2017/05/15	ISSUED FOR CONSTRUCTION	KHV
No.	DATE	REVISION	PAR APP.

CLIENT:


AGNICO EAGLE

NUOSANA PROMET MINING


ultragen

CONSULTANT PROJECT NO. 591700

NO. DE CONDUITE	SPECIFICATION	PRODUIT	SISTÈME REVÊTEMENT	CODE DE COULEUR	ISOLATION ET TRACÉ	ÉPAISS. D'ISOLATION	
116-150-PDI-CC10-0001	CC10	PDI		-			65-116-270-200 PIPE SUPPORT DETAILS
PRESSION D'OPERATION	TEMPERATURE D'OPERATION	PRESSION DE CONCEPTION	TEMPERATURE DE CONCEPTION	PRESSION D'ESSAI	CLASSE D'INSPECTION	CODE DE SERVICE	TRAITEMENT THERMIQUE 65-116-205-200 P&ID
PSIG	°F	PSIG	°F	PSIG			No. DESSIN DESSINS DE REFERENCE

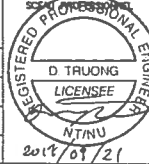

CONC.: KHV DATE: 2017/04/25 DESSINE PAR: KVC DATE: 2017/04/25 VDR: PWR DATE: - APP.: - DATE: - ECHELLE: AUCUNE	PROJET: AGNICO EAGLE - MELIADINE DIVISION 116 - FUEL TANK FARM TITRE: RANKIN INLET FABRICATION ISOMETRIC MARINE LINE TO 65TNK11601 & 65TNK11602 No. PROJET 6515 No. DESSIN 116-150-PDI-CC10-0001 PAGES 7/13 REV. 2
--	--

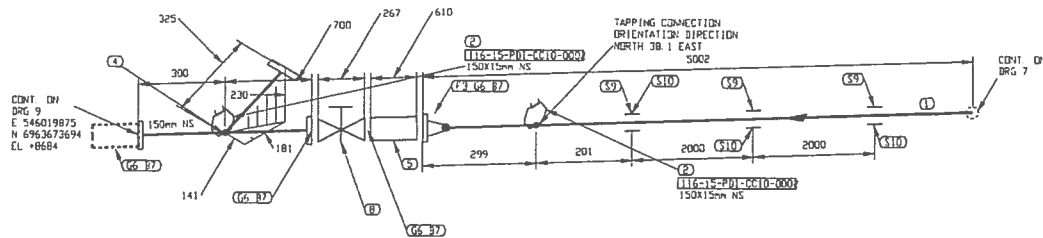

PERMIT TO PRACTICE
LE GROUPE ULTRAGEN LTÉE

Signature 
Date **SEP 21 2017**

PERMIT NUMBER: P 1160
NTNU Association of Professional
Engineers and Geoscientists

FABRICATION DRAWINGS BASED ON
WSP CERTIFIED ENGINEERING

LISTE DE MATERIEL				
Qté	OTE	DM	MATERIEL/CATALOGUE	DESCRIPTION
1	4914 MM	150	A 333 Gr. 6	SCH STD, SHLS PIPE
2	2	150X15	A 350 Gr. LFT	CL 3000, THREDOLET
3	1	150	A 350 Gr. LFT	CL 150, SCH STD, RF, WY FLANGE
4	1	150X150		CL 150, PIG CATCHER AS PER DETAIL 8, DWG 65-116-270-200
5	1	150		CL 150, SINGLE BRAIDED HOSE ASSEMBLY
6	4	150	ASME B16 20	CL 150, GARLOCK 5500, RING TYPE GASKET 1/8"
7	32	19	A 193 B7/A 194 2H	CL 150, B - 19 05 X 100 STUD BOLTS c/w 1WD HEAVY HEX NUTS
8	1	150	GA-10	CL 150, RF, CS, FULL PORT GATE VALVE
9	3	150		PIPE SUPPORT AS PER DETAIL 1, DWG 65-116-270-200
10	3	150		PIPE SHOE AS PER DETAIL 2, DWG 65-116-270-200


2	2017/09/21	PROJECT TITLE REVISED	KHV
1	2017/09/11	LINE NUMBERS REVISED	KHV
0	2017/05/15	ISSUED FOR CONSTRUCTION	KHV
No.	DATE	REVISION	PAR APP.

CLIENT:




CONSULTANT PROJECT NO. 591700

NO. DE CONDUITE	SPECIFICATION	PRODUIT	SYSTEME REVETEMENT	CODE DE COULEUR	ISOLATION ET TRACAGE	EPAISS. D'ISOLATION	
116-150-PDI-CC10-0001	CC10	PDI		-			65-116-270-200
PRESSION D'OPERATION	TEMPERATURE D'OPERATION	PRESSION DE CONCEPTION	TEMPERATURE DE CONCEPTION	PRESSION D'ESSAI	CLASSE D'INSPECTION	CODE DE SERVICE	TRAITEMENT THERMIQUE
		PSIG	T	PSIG			65-116-205-200
						No. DESSIN	DESSINS DE REFERENCE

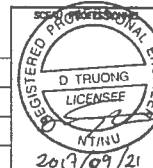

CONC.: KHV DATE: 2017/04/25 DESSINE PAR: KVE DATE: 2017/04/25 VER. PAR: - DATE: - APP.: - DATE: - ECHELLE: AUCUNE	PROJET: AGNICO EAGLE - MELIADINE DIVISION 116 - FUEL TANK FARM	TITRE: RANKIN INLET FABRICATION ISOMETRIC MARINE LINE TO 65TNK11601 & 65TNK11602	No. PROJET 6515	No. DESSIN 116-150-PDI-CC10-0001	PAGES 8/13	REV. 2
---	--	---	--------------------	-------------------------------------	---------------	-----------

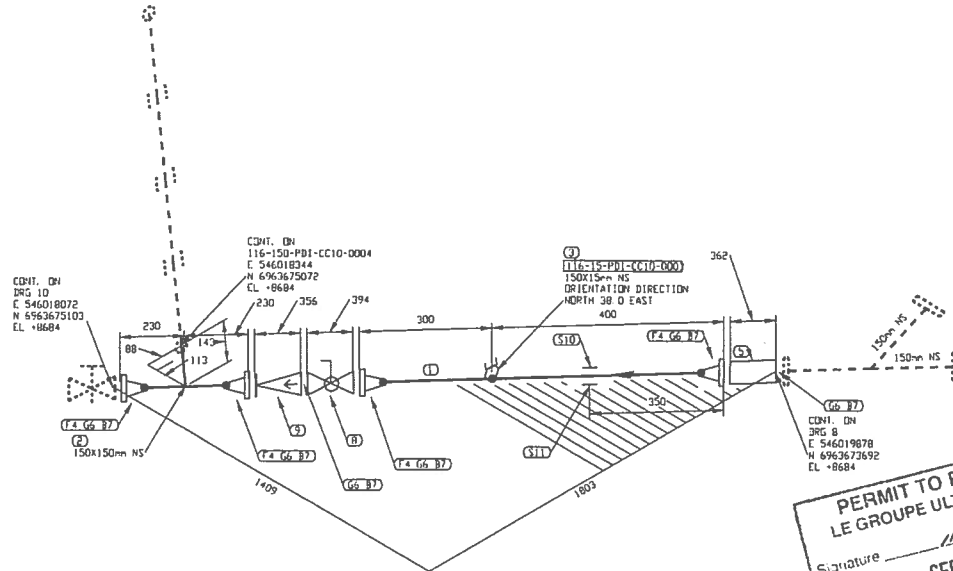

Signature _____
Date SEP 21 2017
PERMIT NUMBER: P 1180
NTNU Association of Professional
Engineers and Geoscientists

FABRICATION DRAWINGS BASED ON
WSP CERTIFIED ENGINEERING


2	2017/09/21	PROJECT TITLE REVISED	KHV
1	2017/09/11	LINE NUMBERS REVISED	KHV
0	2017/05/15	ISSUED FOR CONSTRUCTION	KHV
No.	DATE	REVISION	PAR APP



NUQSANA-PROMEC MINING

CONSULTANT PROJECT NO.	591700
---------------------------	--------

CONC: HWY	PROJECT:	AGNICO EAGLE - MELIADINE DIVISION		
DATE: 2017/04/25		116 - FUEL TANK FARM		
DESIGN: PAR: KYC	TITLE:	RANKIN INLET		
DATE: 2017/04/25		FABRICATION ISOMETRIC		
WORK PAR: -		MARINE LINE TO 65TNK11601 & 65TNK11602		
DATE: -		No PROJECT	No DESIGN	PAGES
APP: -		6515	116-150-PDI-CC10-0001	9/13
DATE: -				2
ECHELLE: AUCUNE				

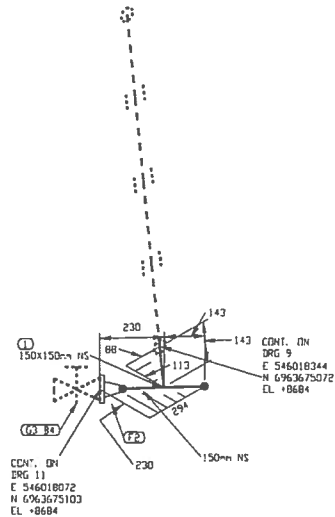


PERMIT TO PRACTICE
LE GROUPE ULTRAGEN LTÉE

Signature _____
Date SEP 7 2007

PERMIT NUMBER: P 1180
NTNU Association of Professional
Engineers and Geoscientists

FABRICATION DRAWINGS BASED ON
WSP CERTIFIED ENGINEERING

NO. DE CONDUITE		SPECIFICATION		PRODUIT		SYSTEME REVETEMENT		CODE DE COULEUR		ISOLATION ET TRACAGE		EPAISS. D'ISOLATION			
116-150-PDI-CC10-0001		CC10		PDI				-				65-116-270-200		PIPE SUPPORT DETAILS	
PRESSION D'OPERATION		TEMPERATURE D'OPERATION		PRESSION DE CONCEPTION		TEMPERATURE DE CONCEPTION		PRESSION D'ESSAI		CLASSE D'INSPECTION		CODE DE SERVICE		TRAITEMENT THERMIQUE	
65-116-205-200		P&ID													
PSIG		°F		PSIG		°F		PSIG						No. DESSIN	
														DESSINS DE REFERENCE	

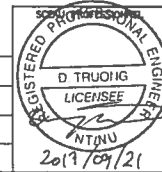

LISTE DE MATERIEL				
NO	Q'TE	DA	MATERIEL/CAT/ALIGUE	DESCRIPTION
1	1	150X150	A 420 Gr. VPL6	SCH STD, BV STRAIGHT TEE
2	1	150	A 350 Gr LF2	CL 150, SCH STD, RF, WN FLANGE
3	1	150	ASME B16.20	CL 150, GARLOCK 5500, RING TYPE GASKET 1/8" THK
4	8	19	A 193 B7/A 194 2H	CL 150, B - 19.05 X 100 STUD BOLTS c/4 TWO HEAVY HEX NUTS

2	2017/09/21	PROJECT TITLE REVISED	KHV
1	2017/09/11	LINE NUMBERS REVISED	KHV
0	2017/05/15	ISSUED FOR CONSTRUCTION	KHV
No.	DATE	REVISION	PWR APP



AGNICO EAGLE




NUOSANA PROMEC MINING



Ultragen

CONSULTANT PROJECT NO. 591700

CONC: KHV DATE: 2017/04/25 DESSIN PAR: KHV DATE: 2017/04/25 VOIR PAR: - DATE: - APP: - DATE: - ECHELLE: AUCUNE	PROJECT: AGNICO EAGLE - MELIADINE DIVISION 116 - FUEL TANK FARM TITRE: RANKIN INLET FABRICATION ISOMETRIC MARINE LINE TO 65TNK11601 & 65TNK11602 <table><tr><th>No PROJET</th><th>No DESSIN</th><th>PAGES</th><th>REV.</th></tr><tr><td>6515</td><td>116-150-PDI-CC10-0001</td><td>10/13</td><td>2</td></tr></table>	No PROJET	No DESSIN	PAGES	REV.	6515	116-150-PDI-CC10-0001	10/13	2
No PROJET	No DESSIN	PAGES	REV.						
6515	116-150-PDI-CC10-0001	10/13	2						

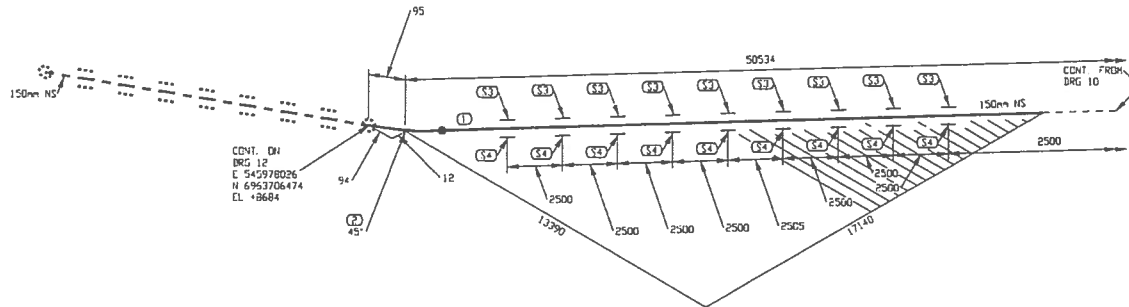

PERMIT TO PRACTICE
 LE GROUPE ULTRAGEN LTÉE
 Signature _____
 Date _____ SEP 24 2017
 PERMIT NUMBER: P 1180
 NTNU Association of Professional
 Engineers and Geoscientists


FABRICATION DRAWINGS BASED ON
WSP CERTIFIED ENGINEERING

2	2017/09/21	PROJECT TITLE REVISED	KHV
1	2017/09/11	LINE NUMBERS REVISED	KHV
0	2017/05/15	ISSUED FOR CONSTRUCTION	KHV
No.	DATE	REVISION	PAR APP.

CLIENT:  AGNICO EAGLE	 NUQSANA PROMEC MINING  ultragren CONSULTANT PROJECT NO. 591700
--	--

2019/07/12

COMM: KVC DATE: 2017/04/23 DESSINE PAR: KVC DATE: 2017/04/23 VERN. PAR: - DATE: - APP: - DATE: - ECHELLE: AUCUNE	PROJET:	AGNICO EAGLE - MELIADINE DIVISION 116 - FUEL TANK FARM		
	TITRE:	RANKIN INLET FABRICATION ISOMETRIC MARINE LINE TO 65TNK11601 & 65TNK11602		
	No PROJET	No DESSIN	PAGES	REV.
	6515	116-150-PDI-CC10-0001	11/13	2

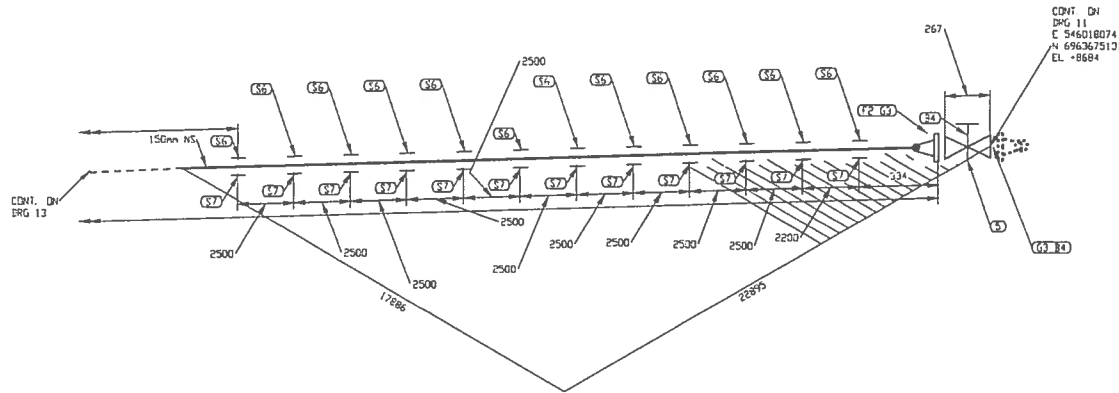

PERMIT TO PRACTICE
LE GROUPE ULTRAGEN LTÉE

Signature _____
SEP 7 2017

Date: _____
PERMIT NUMBER: P 1180

NTNU Association of Professional
Engineers and Geoscientists


FABRICATION DRAWINGS BASED ON
WSP CERTIFIED ENGINEERING

Professional Engineer Seal for D. Truong, Licensee, State of New Jersey, No. 26970921.

LISTE DE MATERIEL				
No	QTE	DA	MATERIEL/CATALOGUE	DESCRIPTION
1	28696 NH	150	A 233 Gr 6	SCH STD. SMLS PIPE
2	1	150	A 250 Gr. LF2	CL 150, SCH STD. RT. WN FLANGE
3	2	150	ASME B16.20	CL 150, GARLOCK 5500, RING TYPE GASKET 1/8" THK
4	16	19	A 193 B7/A 194 2H	CL 150, 0 - 19.05 X 100 STUD BOLT'S c/w 1VD
5	1	150	SA-10	HEAVY HEX NUTS
6	12	150		CL 150, RT. CS. GATE VALVE
7	12	150		PIPE SUPPORT AS PER DETAIL 1, DWG 65-116-270-200
				PIPE SHEE AS PER DETAIL 2, DWG 65-116-270-200

2	2017/09/21	PROJECT TITLE REVISED	KHV
1	2017/09/11	LINE NUMBERS REVISED	KHV
0	2017/05/15	ISSUED FOR CONSTRUCTION	KHV
No.	DATE	REVISION	PAR APP

CONC: KRV	PROJECT: AGNICO EAGLE - MELIADINE DIVISION			
DATE: 2017/04/25	116 - FUEL TANK FARM			
DESSINE PAIR: KVE	TITLE: RANKIN INLET			
DATE: 2017/04/25	FABRICATION ISOMETRIC			
VER. PAIR: -	MARINE LINE TO 65TNK11601 & 65TNK11602			
DATE: -	No PROJECT	No DESSIN	PAGES	REV.
APP: -	6515	116-150-PDI-CC10-0001	12/13	2
DATE: -				
ECHELLE: AUCUNE				

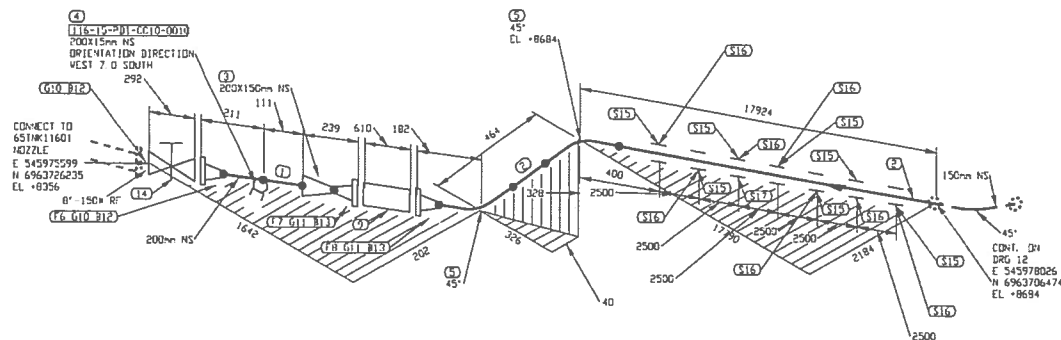

PERMIT TO PRACTICE
LE GROUPE ULTRAGEN LTÉE
Signature _____
Date **SEP 21 2017**
PERMIT NUMBER: P 1180
NTNU Association of Professional
Engineers and Geoscientists

FABRICATION DRAWINGS BASED ON
WSP CERTIFIED ENGINEERING

LISTE DE MATERIEL

No	QTE	DM	MATRIEL/CATALOGUE	DESCRIPTION
1	222 MM	200	A 333 Gr. 6	SCH STD, SMLS PIPE
2	18103 MM	150	A 333 Gr. 6	SCH STD, SMLS PIPE
3	1	200X150	A 420 Gr. VPL6	SCH STD, 3W CONC RED
4	1	200X15	A 350 Gr. LF2	CL 3000, THRODLET
5	2	150	A 420 Gr. VPL6	SCH STD, 3W LR 45 DEG ELBOW
6	1	200	A 350 Gr. LF2	CL 150, SCH STD, RF, WN FLANGE
7	1	150	A 350 Gr. LF2	CL 150, SCH STD, RF, WN FLANGE
8	1	150	A 350 Gr. LF2	CL 150, SCH STD, RF, WN FLANGE
9	1	150		CL 150, SINGLE BRAIDED HOSE ASSEMBLY
10	2	200	ASME B16.20	CL 150, GARLOCK 5500, RING TYPE GASKET 1/8" THK
11	2	150	ASME B16.20	CL 150, GARLOCK 5500, RING TYPE GASKET 1/8" THK
12	16	19	A 193 B7/A 194 2H	CL 150, B - 19.05 X 110 STUD BOLTS c/w TWO HEAVY HEX NUTS
13	16	19	A 193 B7/A 194 2H	CL 150, B - 19.05 X 100 STUD BOLTS c/w TWO HEAVY HEX NUTS
14	1	200	GA-10	CL 150, RF, CS, FULL PORT GATE VALVE
15	7	150		PIPE SUPPORT AS PER DETAIL 1, DWG 65-116-270-200
16	7	150		PIPE SHOE AS PER DETAIL 2, DWG 65-116-270-200
17	1	150		PIPE SHOE AS PER DETAIL 2, DWG 65-116-270-200

2	2017/09/21	PROJECT TITLE REVISED	KHV
1	2017/09/11	LINE NUMBERS REVISED	KHV
0	2017/05/15	ISSUED FOR CONSTRUCTION	KHV
No.	DATE	REVISION	APP.

CLIENT:


AGNICO EAGLE

NUQSANA PROMEC MINING


ULTRAGEN

CONSULTANT PROJECT NO. 591700

NO. DE CONDUITE	SPECIFICATION	PRODUIT	SISTEME REVETEMENT	CODE DE COULEUR	ISOLATION ET TRAÇAGE	EPASS. D'ISOLATION	
116-150-PDI-CC10-0001	CC10	PDI		-			65-116-270-200 PIPE SUPPORT DETAILS
PRESSION D'OPERATION	TEMPERATURE D'OPERATION	PRESSION DE CONCEPTION	TEMPERATURE DE CONCEPTION	PRESSION D'ESSAI	CLASSE D'INSPECTION	CODE DE SERRAGE	TRAITEMENT THERMOQUE
PSG	T	PSG	T	PSG			65-116-205-200 P&ID
							No. DESSIN DESSINS DE REFERENCE

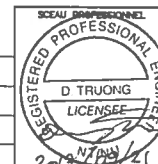


CONC. KHY DATE: 2017/04/25 DESSINE PAR: KVE DATE: 2017/04/25 VER. PAR: - DATE: - APP.: - DATE: - ECHELLE: AUCUNE	PROJET: AGNICO EAGLE - MELIADINE DIVISION 116 - FUEL TANK FARM TITRE: RANKIN INLET FABRICATION ISOMETRIC MARINE LINE TO 65TNK11601 & 65TNK11602 No. PROJET 6515 No. DESSIN 116-150-PDI-CC10-0001 PAGES 13/13 REV. 2
--	---

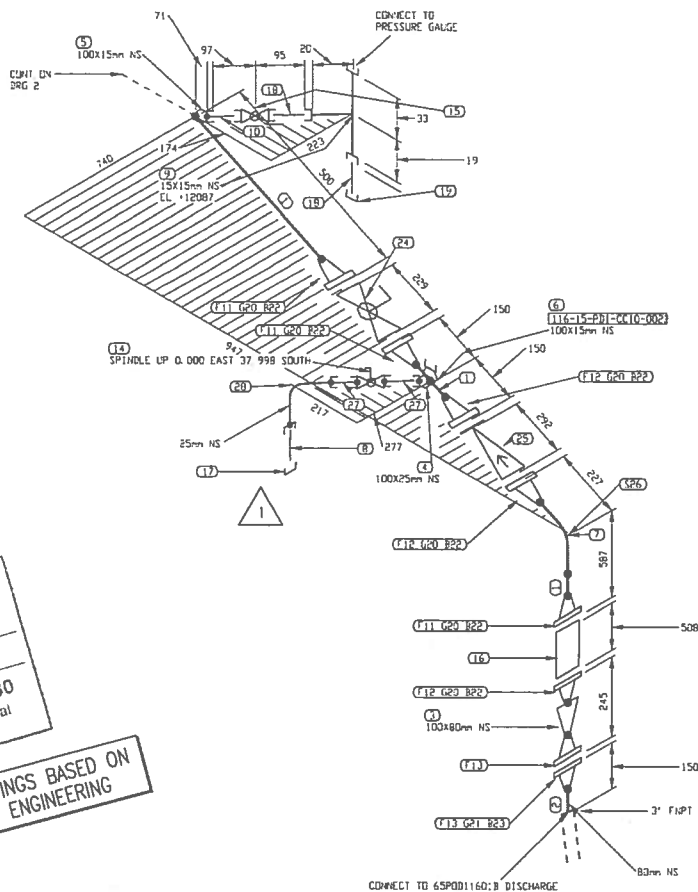

PERMIT TO PRACTICE
LE GROUPE ULTRAGEN LTÉE
Signature: *[Signature]*
Date: **SEP 24 2017**
PERMIT NUMBER: P 1180
NTNU Association of Professional
Engineers and Geoscientists

FABRICATION DRAWINGS BASED ON
WSP CERTIFIED ENGINEERING

NO. DE CONDUITE	SPECIFICATION	PRODUIT	SISTÈME REVÊTEMENT	CODE DE COULEUR	ISOLATION ET TRACÉ	ÉPAISS. D'ISOLATION	
116-100-PDI-CC10-0020	CC10	PDI					55-116-270-200 PIPE SUPPORT DETAILS
PRESSION D'OPERATION	TEMPERATURE D'OPERATION	PRESSION DE CONCEPTION	TEMPERATURE DE CONCEPTION	PRESSION D'ESSAI	CLASSE D'INSPECTION	CODE DE SERVICE	TRAITEMENT THERMIQUE
PSIG	°F	PSIG	°F	PSIG			
						No. DESSIN	DESSINS DE REFERENCE

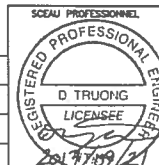

CONC.: KHV DATE: 2017/04/25 DESSINÉ PAR: KVE DATE: 2017/04/25 VÉR. PAR: - DATE: - APP.: - DATE: - ÉCHELLE: AUCUNE	PROJET: AGNICO EAGLE - MELIADINE DIVISION 116 - FUEL TANK FARM TITRE: RANKIN INLET FABRICATION ISOMETRIC DIESEL FROM 6SPD11601B TO BOTTOM LOADING ARM 6560M1601 No. PROJET: 6515 No. DESSIN: 116-100-PDI-CC10-0020 PAGES: 1/2 REV.: 3
---	---

LISTE DE MATERIEL					DESCRIPTION
No	QTE	DIA	MATERIEL/CATALOGUE		
1	577 MM	100	A 333 Gr 6		SCH STD. SMLS PIPE
2	82 MM	80	A 333 Gr 6		SCH STD. SMLS PIPE FOCKTDE
3	1	100X80	A 420 Gr VPL6		SCH STD. BV CONC REC
4	1	100X25	A 350 Gr LF2		CL 3000, SOCKOLET
5	1	100X15	A 350 Gr LF2		CL 3000, SOCKOLET
6	1	100X15	A 350 Gr LF2		CL 3000, THRODLEET
7	1	100	A 420 Gr VPL6		SCH STD. BV LR 90 DEG ELBOW
8	1	25	A 333 Gr 6		SCH 80, NIPPLE x 75mm LG PDE+TDE
9	1	15X15	A 350 Gr LF2		CL 3000, THRD STRAIGHT TEE
10	1	15	A 333 Gr 6		SCH 80, NIPPLE x 75mm LG PDE+TDE
11	3	100	A 350 Gr LF2		CL 150, SCH STD. RT. VN FLANGE
12	3	100	A 350 Gr LF2		CL 150, SCH STD. RT. VN FLANGE
13	2	80	A 350 Gr LF2		CL 150, SCH STD. RT. VN FLANGE
14	1	25	BA-25		CL 600, VS BALL VALVE
15	1	15	BA-32		CL 600, THRD. BALL VALVE
16	1	100			CL 150, SINGLE BRAIDED HOSE ASSEMBLY
17	1	25	A 350 Gr LF2		CL 3000, THRD CAP
18	2	15	A 333 Gr 6		SCH 80, NIPPLE x 75mm LG PDE
19	1	15	A 333 Gr 6		CL 150, GARLOCK 5500, RING TYPE GASKET 1/8"
20	6	100	ASME B16.20		CL 150, GARLOCK 5500, RING TYPE GASKET 1/8"
21	1	80	ASME B16.20		CL 150, GARLOCK 5500, RING TYPE GASKET 1/8"
22	48	16	A 193 B7/A 194 2H		CL 150, GARLOCK 5500, RING TYPE GASKET 1/8"
23	4	16	A 193 B7/A 194 2H		CL 150, GARLOCK 5500, RING TYPE GASKET 1/8"
24	1	100	BA 31		CL 150, RT. BALL VALVE
25	1	100	CK-29		CL 150, RT. SWING CHECK VALVE
26	1	100			PIPE SUPPORT BY CONTRACTOR
27	2	25	A 333 Gr 6		SCH 80, NIPPLE x 75mm LG PDE
28	1	25	A 350 Gr LF2		CL 3000, SV 90 DEG ELBOW

3	2017/09/21	PROJECT TITLE REVISED	INQ
2	2017/09/11	LINE NUMBERS REVISED	KHV
1	2017/06/30	DRAIN REVISED AS PER CLIENT COMMENTS	OVN
0	2017/05/15	ISSUED FOR CONSTRUCTION	KHV
No.	DATE	REVISION	APP


CLIENT:

AGNICO EAGLE

NUQSANA PROMEC MINING

Ultragen

CONSULTANT PROJECT NO. 591700

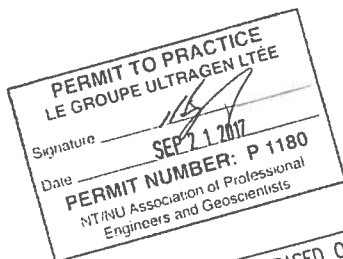

FABRICATION DRAWINGS BASED ON
WSP CERTIFIED ENGINEERING

Approved by: Sep 20, 2017, 2:43pm

CLIENT:



AGNICO EAGLE



NUOSANA PROMEC MINING

PROTECTOR




ultragren

CONSULTANT PROJECT MIN

591700

16-MN-01

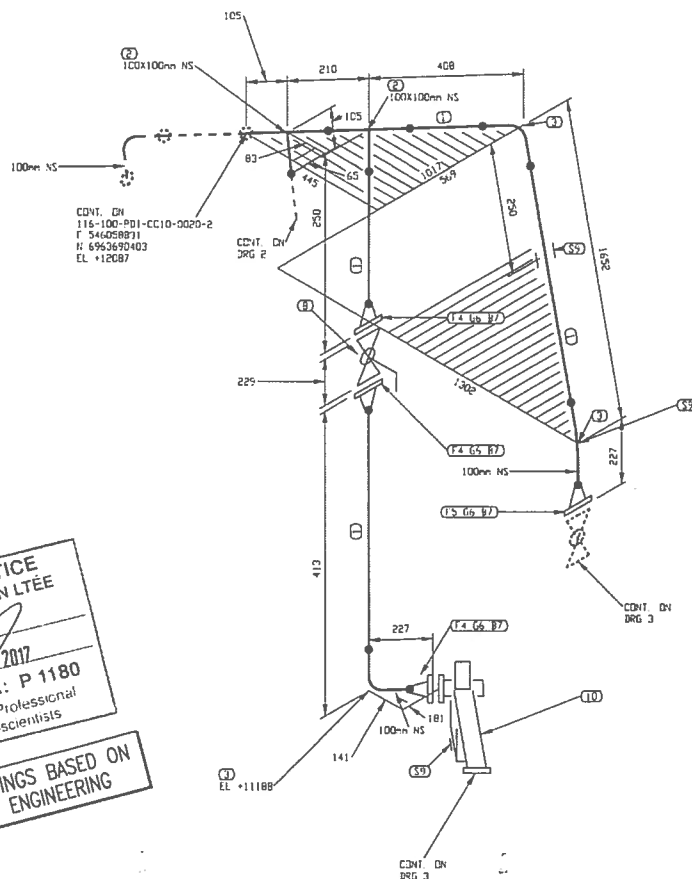


PERMIT TO PRACTICE
LE GROUPE ULTRAGEN LTÉE

Signature _____
Date _____ SEP 24 2017
PERMIT NUMBER: P 1180
NTNU Association of Professional
Engineers and Geoscientists

FABRICATION DRAWINGS BASED ON
WSP CERTIFIED ENGINEERING

NO. DE CONDUITE		SPECIFICATION		PRODUIT		SYSTEME REVETEMENT		CODE DE COULEUR		ISOLATION ET TRACAGE		EPASS. D'ISOLATION					
116-100-PDI-CC10-0023		CC10		PDI				-						65-116-270-200		PIPE SUPPORT DETAILS	
PRESSION D'OPERATION		TEMPERATURE D'OPERATION		PRESSION DE CONCEPTION		TEMPERATURE DE CONCEPTION		PRESSION D'ESSAI		CLASSE D'INSPECTION		CODE DE SERVICE		TRAITEMENT THERMIQUE		65-116-205-200 P&ID	
PSIG		°F		PSIG		°F		PSIG								No. DESSIN DESSINS DE REFERENCE	

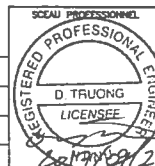

CONC.: KHV
DATE: 2017/04/25
DESSINE PAR: KVE
DATE: 2017/04/25
VER. PAR: -
DATE: -
APP.: -
DATE: -
PROJET: SUCRINE

PROJECT:		AGNICO EAGLE - MELIADINE DIVISION 116 - FUEL TANK FARM	
TITLE:		RANKIN INLET FABRICATION ISOMETRIC DIESEL FROM 65PDD11601A TO BOTTOM LOADING ARM 65EDH11601A	
No	PROJECT	No	DESIGN
6515		116-100-PD1-CC10-0023	
		PAGES	REV
		1/4	2

LISTE DE MATERIEL				
no	QTE	Dia	MATERIEL/CATALOGUE	DESCRIPTION
1	1755 MM	100	A 333 Gr. 6	SCH STD, SMLS PIPE
2	2	100X100	A 420 Gr. VPL6	SCH STD, BV STRAIGHT TEE
3	3	100	A 420 Gr. VPL6	SCH STD, BV LR 90 DEG ELBOW
4	3	100	A 350 Gr. LF2	CL 150, SCH STD, RF, WN FLANGE
5	1	100	A 350 Gr. LF2	CL 150, SCH STD, RF, WN FLANGE
6	4	100	ASME B16.20	CL 150, GARLOCK 5500, RING TYPE GASKET 1/8" THK
7	32	16	A 193 B7/A 194 2H	CL 150, R - 15 875 X 90 STUD BOLTS r/a TWD
8	1	100	BA-31	HEAVY HEX NUTS
9	3	100		CL 150, RF, BALL VALVE
10	1	100		PIPE SUPPORT BY CONTRACTOR
				TCS METER UNIT


2	2017/09/21	PROJECT TITLE REVISED	KHV
1	2017/09/11	LINE NUMBERS REVISED	KHV
0	2017/05/15	ISSUED FOR CONSTRUCTION	KHV
No.	DATE	REVISION	PAR APR

CLIENT:



AGNICO EAGLE



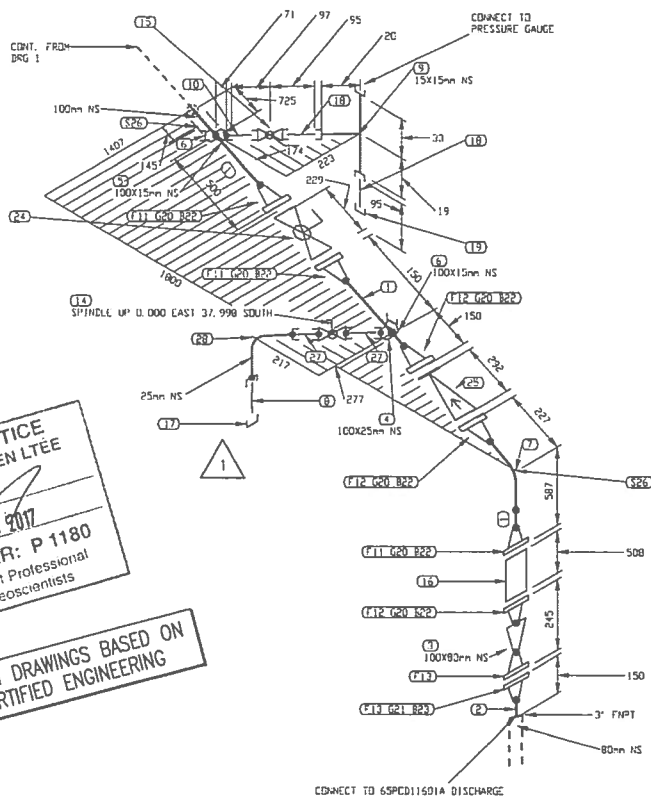

PERMIT TO PRACTICE
LE GROUPE ULTRAGEN LTÉE
Signature _____
Date SEP 2 1 2017
PERMIT NUMBER: P 1180
NTNU Association of Professional
Engineers and Geoscientists

FABRICATION DRAWINGS BASED ON
WSP CERTIFIED ENGINEERING

1

1

LISTE DE MATERIEL				
No	QTE	DA	MATERIEL/CATALOGUE	DESCRIPTION
1	1660 MM	100	A 333 Gr. 6	SCH STD, SMLS PIPE
2	82 MM	80	A 333 Gr. 6	SCH STD, SMLS PIPE PDE=10E
3	1	100X80	A 420 Gr. WPL6	SCH STD, BV CONE RED
4	1	100X25	A 350 Gr. LF2	CL 3000, SOCKET
5	1	100X15	A 350 Gr. LF2	CL 3000, SOCKET
6	2	100X15	A 350 Gr. LF2	CL 3000, THREDOLET
7	1	100	A 420 Gr. WPL6	SCH STD, BV LR 90 DEG ELBOW
8	1	25	A 333 Gr. 6	SCH 80, HIPPLE x 75mm LG PDE=10E
9	1	15X15	A 350 Gr. LF2	CL 3000, THRD STRAIGHT TEE
10	1	15	A 333 Gr. 6	SCH 80, HIPPLE x 75mm LG PDE=10E
11	2	100	A 350 Gr. LF2	CL 150, SCH STD, RF, WN FLANGE
12	3	100	A 350 Gr. LF2	CL 150, SCH STD, RF, WN FLANGE
13	2	80	A 350 Gr. LF2	CL 150, SCH STD, RF, WN FLANGE
14	1	25	BA 29	CL 600, SV BALL VALVE
15	1	15	BA-32	CL 600, THRD, BALL VALVE
16	1	100		CL 150, SINGLE BRAIDED HOSE ASSEMBLY
17	1	25	A 350 Gr. LF2	CL 3000, THRD CAP
18	2	15	A 333 Gr. 6	SCH 80, HIPPLE x 75mm LG TEE
19	1	15	A 350 Gr. LF2	CL 150, GARLOCK 5500, RING TYPE GASKET 1/8"
20	6	100	ASME B16.20	EUK150, GARLOCK 5500, RING TYPE GASKET 1/8"
21	1	80	ASME B16.20	EUK150, 8 - 15.875 x 90 STUD BOLTS c/w TWD
22	48	16	A 193 B7/A 194 2H	DEAYSCHEA NUTS 875 x 90 STUD BOLTS c/w TWD
23	4	16	A 193 B7/A 194 2H	HEAVY HEX NUTS
24	1	100	BA-31	CL 150, RF, BALL VALVE
25	1	100	CK-29	CL 150, RF, SVING CHECK VALVE
26	2	100		PIPE SUPPORT BY CONTRACTOR
27	2	25	A 333 Gr. 6	SCH 80, HIPPLE x 75mm LG PDE
28	1	25	A 350 Gr. LF2	CL 3000, SV 90 DEG ELBOW

3	2017/09/21	PROJECT TITLE REVISED	KHV
2	2017/09/11	LINE NUMBERS REVISED	KHV
1	2017/06/30	DRAIN REVISED AS PER CLIENT COMMENTS	OVN
0	2017/05/15	ISSUED FOR CONSTRUCTION	KHV


CLIENT:

CONSULTANT PROJECT NO. 591700

NO. DE CONDUITE	SPECIFICATION	PRODUIT	SYSTEME REVEITEMENT	CODE DE COULEUR	ISOLATION ET TRAÇAGE	ÉPAISS D'ISOLATION	
116-100-PDI-CC10-0023	CC10	PDI					65-116-270-200 PIPE SUPPORT DETAILS
PRESSON D'OPERATION	TEMPERATURE D'OPERATION	PRESSON DE CONCEPTION	TEMPERATURE DE CONCEPTION	PRESSON D'ESSAI	CLASSE D'INSPECTION	CODE DE SERVICE	TRAITEMENT THERMIQUE
PSIG	°F	PSIG	°F	PSIG			



CONC: KHV DATE: 2017/04/23 DESSINE PAR: KVE DATE: 2017/04/23 VÉR. PAR: - DATE: - APP. - DATE: - ÉCHELLE: AUCUNE	PROJET: AGNICO EAGLE - MELIADINE DIVISION 116 - FUEL TANK FARM TITRE: RANKIN INLET FABRICATION ISOMETRIC DIESEL FROM 65PDI1601A TO BOTTOM LOADING ARM 65EQM11601 No PROJET 6515 No DESSIN 116-100-PDI-CC10-0023 PAGES 2/4 REV. 3
---	--

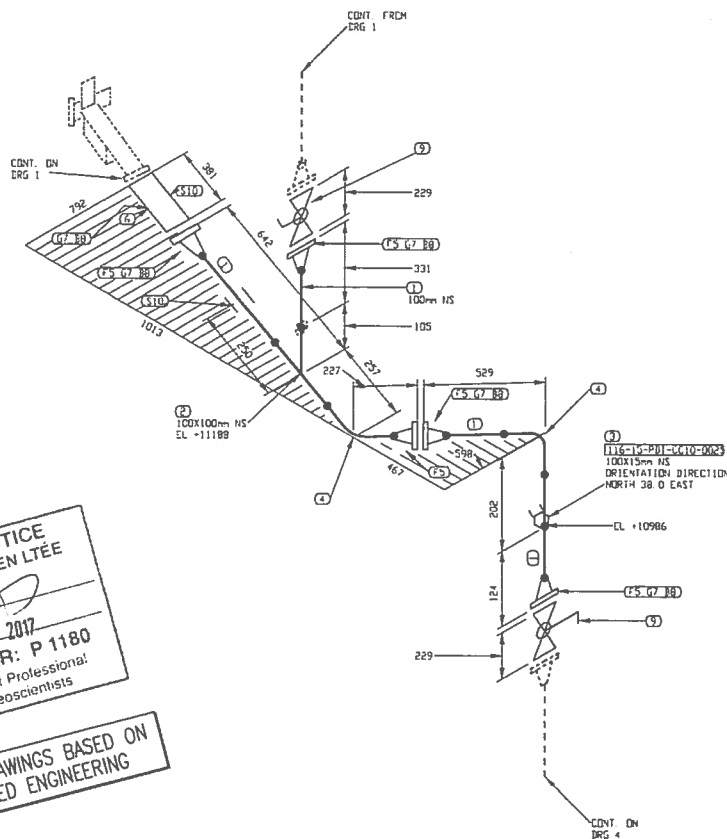

PERMIT TO PRACTICE
LE GROUPE ULTRAGEN LTÉE
Signature _____
Date **SEP 21 2017**
PERMIT NUMBER: P 1180
NT/NU Association of Professional
Engineers and Geoscientists

FABRICATION DRAWINGS BASED ON
WSP CERTIFIED ENGINEERING

LISTE DE MATERIEL

NO	QTT	DA	MATERIEL/CATALOGUE	DESCRIPTION
1	1120 MM	100	A 333 Gr 6	SCH STD, SMLS PIPE
2	1	100X100	A 420 Gr WPL6	SCH STD, BW STRAIGHT TEE
3	1	100X15	A 250 Gr LF2	CL 3000, THRODLET
4	2	100	A 420 Gr WPL6	SCH STD, BW LR 90 DEG ELBOW
5	5	100	A 350 Gr LF2	CL 150, SCH STD, RF, WN FLANGE
6	1	100	DCV #115-3	CL 150, FLOW CONTROL VALVE
7	5	100	ASME B16.20	CL 150, GARLOCK 5500, RING TYPE GASKET 1/8" THK
8	40	16	A 193 B7/A 194 2H	CL 150, B - 15 B75 X 90 STUD BOLTS c/w TWD
9	2	100	BA-31	HEAVY HEX NUTS
10	2	100		CL 150, RF, BALL VALVE
				PIPE SUPPORT AS PER DETAIL 9, BWG 65-116-270-200

2	2017/09/21	PROJECT TITLE REVISED	KHV
1	2017/09/11	LINE NUMBERS REVISED	KHV
0	2017/05/15	ISSUED FOR CONSTRUCTION	KHV
NO.	DATE	REVISION	APP.

CLIENT:

AGNICO EAGLE

NUQSANA PROMEC MINING

ultragen

CONSULTANT PROJECT NO. 591700

NO. DE CONDUITE	SPECIFICATION	PRODUIT	SYSTEME REVETEMENT	CODE DE COULEUR	ISOLATION ET TRACAGE	EPASS. D'ISOLATION	
116-100-PDI-CC10-0023	CC10	PDI				55-116-270-200	PIPE SUPPORT DETAILS
PRESSION D'OPERATION	TEMPERATURE D'OPERATION	PRESSION DE CONCEPTION	TEMPERATURE DE CONCEPTION	PRESSION D'ESSAI	CLASSE D'INSPECTION	CODE DE SERVICE	TRATMENT THERMIQUE
PSIG	T	PSIG	T	PSIG			
						No. DESSIN	DESSINS DE REFERENCE




CONC: KHV DATE: 2017/04/25 DESSINE PAR: KHV DATE: 2017/04/25 VOL. PAR: - DATE: - APP: - DATE: - ECHELLE: AUCUNE	PROJECT: AGNICO EAGLE - MELIADINE DIVISION 116 - FUEL TANK FARM TITLE: RANKIN INLET FABRICATION ISOMETRIC DIESEL FROM 6SPDI1601A TO BOTTOM LOADING ARM 6SEDM11601 No. PROJET: 6515 No. DESSIN: 116-100-PDI-CC10-0023 PAGES: 3/4 REV: 2
---	--



FABRICATION DRAWINGS BASED ON
WSP CERTIFIED ENGINEERING

CLIENT:	 AGNICO EAGLE	 NUOSANA-PROMEC MINING
CONSULTANT:	 ultragen	 ultragen
PROJECT NO.:	591700	591700

COMP: KHY	PROJECT: AGNICO EAGLE - MELADINE DIVISION			
DATE: 2017/04/25	116 - FUEL TANK FARM			
DESSINE PAR: VVC	TITLE: RANKIN INLET			
DATE: 2017/04/25	FABRICATION ISOMETRIC			
VER. PAR: -	DIESEL FROM 65P0D11601A TO BOTTOM LOADING ARM 65EQM1601			
DATE: -				
APP: -	No PROJECT	No DESIGN	PAGES	REV.
DATE: -	6515	116-100-PD1-CC10-0023	4/4	3.
CONELLE: AUCUNE				

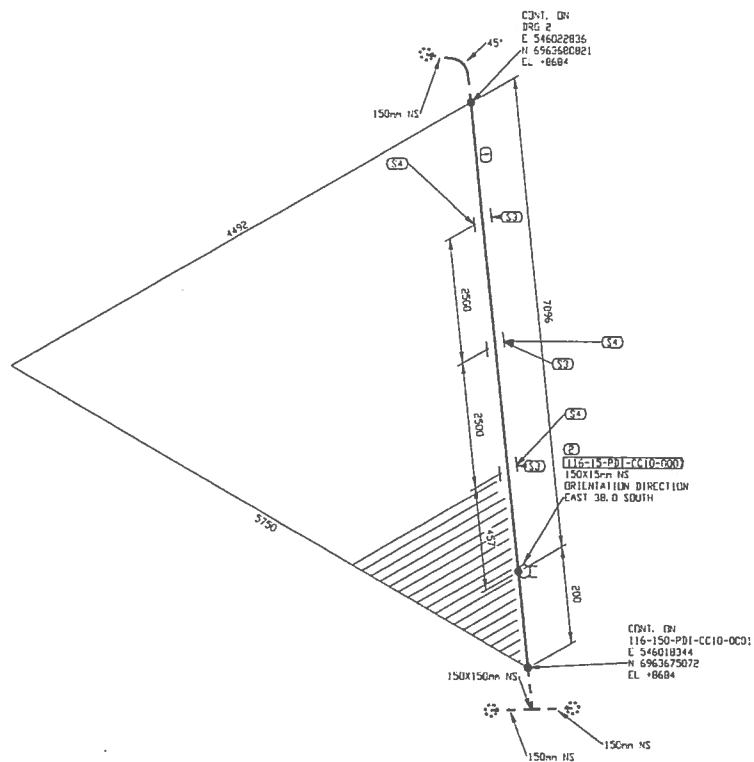

PERMIT TO PRACTICE
LE GROUPE ULTRAGEN LTÉE

Signature _____
Date _____

SEP 21 2017

PERMIT NUMBER: P 1180

NTAAJ Association of Professional
Engineers and Geoscientists

FABRICATION DRAWINGS BASED ON
WSP CERTIFIED ENGINEERING

NO. DE CONDUITE		SPECIFICATION	PRODUIT	SYSTEME REVETEMENT	CODE DE COULEUR	ISOLATION ET TRACAGE	EPAISS. D'ISOLATION		
116-150-PDI-CC10-0004		CC10	PDI		-			65-116-270-200	PIPE SUPPORT DETAILS
PRESSION D'OPERATION	TEMPERATURE D'OPERATION	PRESSION DE CONCEPTION	TEMPERATURE DE CONCEPTION	PRESSION D'ESSAI	CLASSE D'INSPECTION	CODE DE SERVICE	TRAITEMENT THERMIQUE	65-116-205-200	P&ID
		PSIG	°F	PSIG				No. DESSIN	DESSINS DE REFERENCE

LISTE DE MATERIEL				
NO	QTL	DIA	MATERIEL/CATALOGUE	DESCRIPTION
1	7296 HH	150	A 333 Gr. 6	SCH STD. SMLS PIPE
2	1	150X15	A 350 Gr. LF2	CL 3000. FAREOLET
3	3	150		PIPE SUPPORT AS PER DETAIL 1, DWG: 65-116-270-200
4	3	150		PIPE SHOE AS PER DETAIL 2, DWG: 65-116-270-200

2	2017/09/21	PROJECT TITLE REVISED	KHV
1	2017/09/11	LINE NUMBERS REVISED	KHV
0	2017/05/15	ISSUED FOR CONSTRUCTION	KHV
No.	DATE	REVISION	PHR ADD

CLIENT:




AGNICO EAGLE



CONSULTANT PROJECT NO.	591700
---------------------------	--------

COMC: KMY	PROJECT: AGNICO EAGLE - MELIADINE DIVISION			
DATE: 2017/04/25	116 - FUEL TANK FARM			
DESSINE PAR: KYE	TITLE: RANKIN INLET			
DATE: 2017/04/25	FABRICATION ISOMETRIC			
VOR PAR:	MARINE LINE TO 65TNK11602			
DATE:				
APP: -				
DATE:				
SCHELLE: AUCUNE	No PROJECT	No DESSIN	PAGES	REV.
	6515	116-150-PDI-CC10-0004	1/3	2

116-150-PDI-CC10-0004 (116-150-PDI-CC10-0004-2) DWG

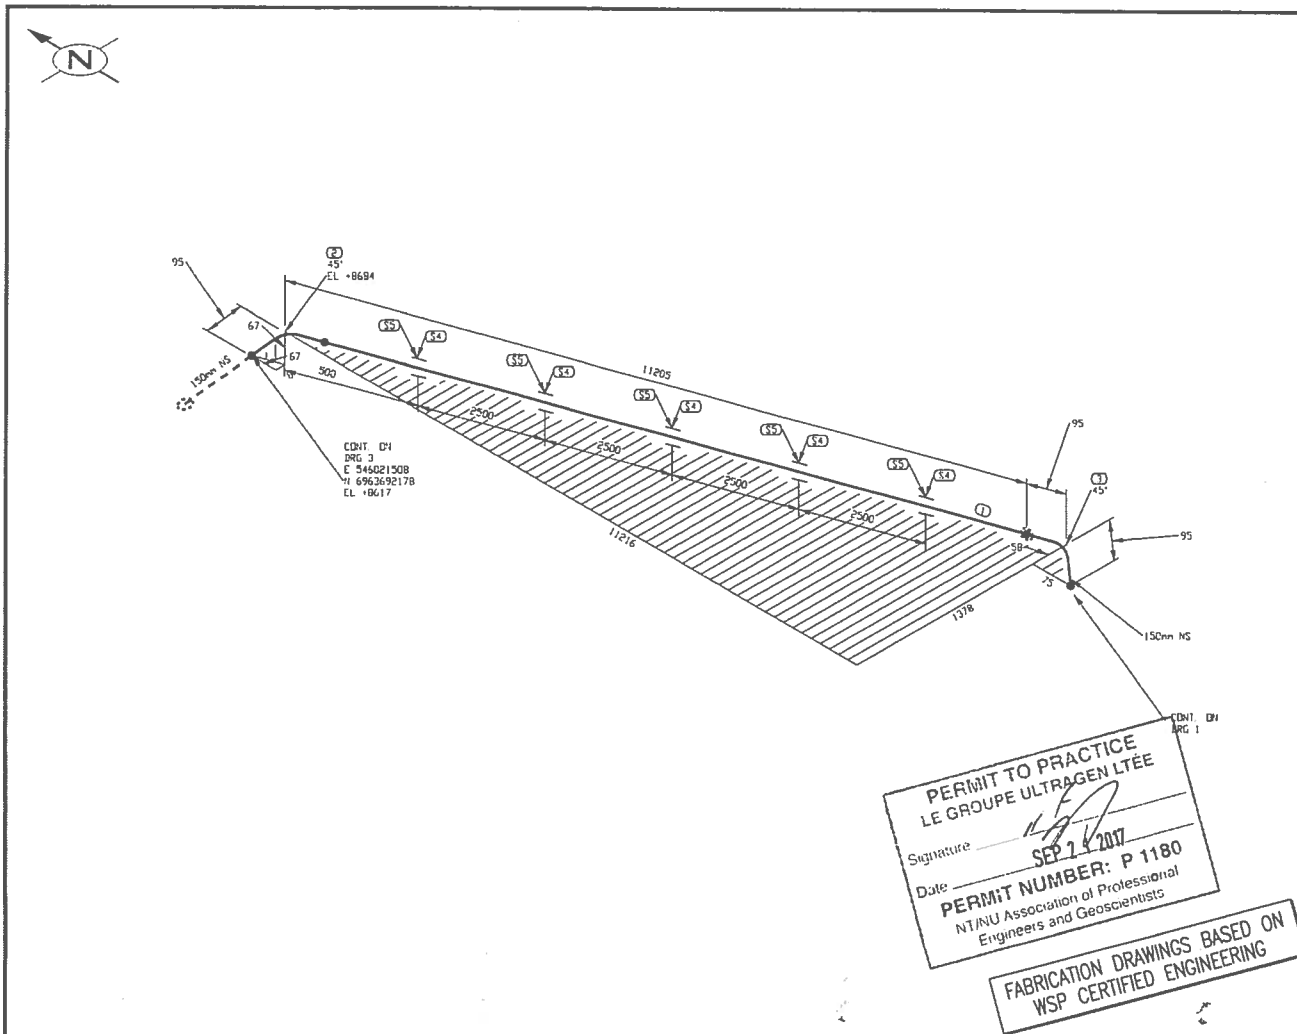

LISTE DE MATERIEL				
No	QTE	UN	MATERIEL/CATALOGUE	DESCRIPTION
1	11110	MM	150	A 333 Gr. 6 SCH STD, SMLS PIPE
2	1	150	A 420 Gr. WPL6	SCH STD, BW LR 45 DEG ELBOW
3	1	150	A 420 Gr. WPL6	SCH STD, BW LR 90 DEG ELBOW TRIM TO 45.00
4	5	150		PIPE SUPPORT AS PER DETAIL 1, DWG
5	5	150		65-116-270-200 PIPE SHOE AS PER DETAIL 2, DWG 65-116-270-200

2	2017/09/21	PROJECT TITLE REVISED	KHV
1	2017/09/11	LINE NUMBERS REVISED	KHV
0	2017/05/15	ISSUED FOR CONSTRUCTION	KHV


No.	DATE	REVISION	PAR	APP.
CLIENT:				
CONSULTANT PROJECT NO. 591700				

CONC.: KHV	PROJET: AGNICO EAGLE - MELIADINE DIVISION
DATE: 2017/04/25	116 - FUEL TANK FARM
DESSINE PAR: KVE	TITRE: RANKIN INLET
DATE: 2017/04/25	FABRICATION ISOMETRIC
VOL. PAR: -	MARINE LINE TO 65TNK11602
DATE: -	
APP.: -	
DATE: -	
ECHELLE: AUCUNE	

No PROJET	No DESSIN	PAGES	REV.
6515	116-150-PDI-CC10-0004	2/3	2

WSP VE 12: Sep 20, 2017, 2:45pm

116-PN-01

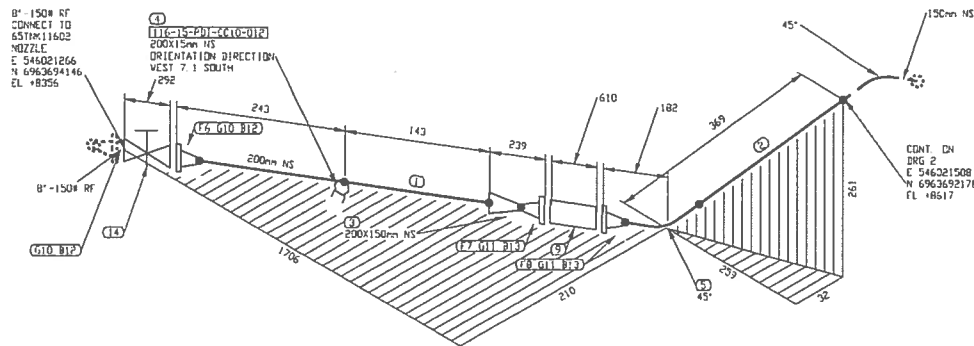

PERMIT TO PRACTICE
LE GROUPE ULTRAGEN LTEE
Signature: *[Signature]*
Date: **SEP 27 2017**
PERMIT NUMBER: P 1180
NTRU Association of Professional
Engineers and Geoscientists
FABRICATION DRAWINGS BASED ON
WSP CERTIFIED ENGINEERING

LISTE DE MATERIEL				
No	QTE	DA	MATERIEL/CATALOGUE	DESCRIPTION
1	286 MM	200	A 333 Gr. 6	SCH STD. SHLS PIPE
2	274 MM	150	A 333 Gr. 6	SCH STD. SHLS PIPE
3	1	200x150	A 420 Gr. VPL6	SCH STD. BV CONC RED
4	1	200x15	A 350 Gr. LF2	CL 3000, THREEDOLET
5	1	150	A 420 Gr. VPL6	SCH STD. BV LP 45 DEG ELBOW
6	1	200	A 350 Gr. LF2	CL 150, SCH STD. RF, WN FLANGE
7	1	150	A 350 Gr. LF2	CL 150, SCH STD. RF, WN FLANGE
8	1	150	A 350 Gr. LF2	CL 150, SCH STD. RF, WN FLANGE
9	1	150		CL 150, SINGLE BRAIDED HOSE ASSEMBLY
10	2	200	ASME B16.20	CL 150, GARLOCK 5500, RING TYPE GASKET 1/8" THK
11	2	150	ASME B16.20	CL 150, GARLOCK 5500, RING TYPE GASKET 1/8" THK
12	16	19	A 193 B7/A 194 2H	CL 150, B - 19.05 X 110 STUD BOLTS c/w TWO HEAVY HEX NUTS
13	16	19	A 193 B7/A 194 2H	CL 150, B - 19.05 X 100 STUD BOLTS c/w TWO HEAVY HEX NUTS
14	1	200	GA-10	CL 150, RF, GATE VALVE

2	2017/09/21	PROJECT TITLE REVISED	KHV
1	2017/09/11	LINE NUMBERS REVISED	KHV
0	2017/05/15	ISSUED FOR CONSTRUCTION	KHV
No.	DATE	REVISION	PAR

CLIENT:


AGNICO EAGLE

NUQSANA PROMEC MINING


Ultragen

CONSULTANT PROJECT NO. 591700

NO. DE COMUTE	SPECIFICATION	PRODUIT	SYSTEME REVEITEMENT	CODE DE COULEUR	ISOLATION ET TRACAGE	EPASS. D'ISOLATION	
116-150-PDI-CC10-0004	CC10	PDI		-			65-116-270-200
PRESSION D'OPERATION	TEMPERATURE D'OPERATION	PRESSION DE CONCEPTION	TEMPERATURE DE CONCEPTION	PRESSION D'ESSAI	CLASSE D'INSPECTION	CODE DE SERVICE	TRAITEMENT THERMIQUE
PSIG	°F	PSIG	°F	PSIG			
					No. DESSIN		DESSINS DE REFERENCE

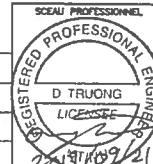

CONC.: KHV DATE: 2017/04/25 DESSINE PAR: KVC DATE: 2017/04/25 VOL. PAR: - APP.: - DATE: - ECHELLE: AUCUNE	PROJET: AGNICO EAGLE - MELIADINE DIVISION 116 - FUEL TANK FARM TITRE: RANKIN INLET FABRICATION ISOMETRIC MARINE LINE TO 657NK11602 No PROJET: 6515 No DESSIN: 116-150-PDI-CC10-0004 PAGES: 3/3 REV.: 2
--	---

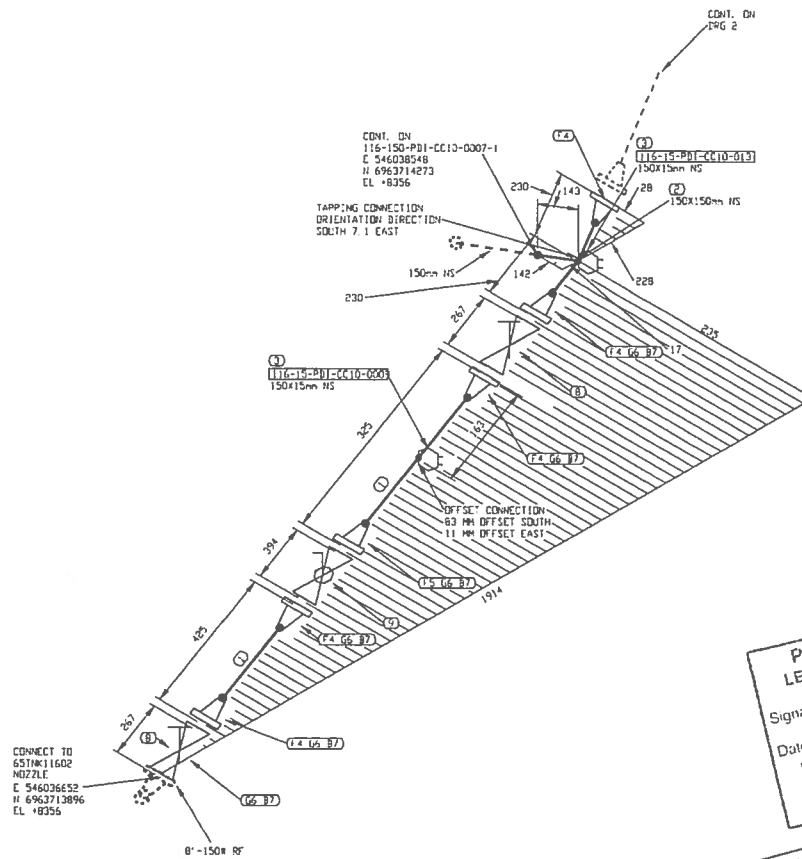

PERMIT TO PRACTICE
LE GROUPE ULTRAGEN LTÉE
Signature _____
Date **SEP 21 2017**
PERMIT NUMBER: P 1180
NT/NU Association of Professional
Engineers and Geoscientists

FABRICATION DRAWINGS BASED ON
WSP CERTIFIED ENGINEERING

LISTE DE MATERIEL				
No	QTE	DA	MATERIEL/CATALOGUE	DESCRIPTION
1	402 MM	150	A 333 Gr. 6	SCH STD. SMLS PIPE
2	1	150x150	A 420 Gr. VPL6	SCH STD. BN STRAIGHT TEE
3	2	150x15	A 350 Gr. LF2	CL 3000, THREDDLET
4	5	150	A 350 Gr. LF2	CL 150, SCH STD. RF, WN FLANGE
5	1	150	A 350 Gr. LF2	CL 150, SCH STD. RF, WN FLANGE
6	6	150	ASME B16 20	CL 150, GARLOCK 5500, RING TYPE GASKET 1/8" THK
7	48	19	A 193 B7A 194 2H	CL 150, B - 19.05 X 100 STUD BOLTS c/w TND
8	2	150	GA-10	HEAVY HEX NUTS
9	1	150	BA-31	CL 150, RF, GATE VALVE
				CL 150, RF, BALL VALVE

2	2017/09/21	PROJECT TITLE REVISED	KHV
1	2017/09/11	LINE NUMBERS REVISED	KHV
0	2017/05/15	ISSUED FOR CONSTRUCTION	KHV
No.	DATE	REVISION	PAR
			APD

CLIENT:


AGNICO EAGLE

NUQSANA PROMEC MINING

ultragen


CONSULTANT PROJECT NO. **591700**

NO. DE CONDUITE	SPECIFICATION	PRODUIT	SYSTEME REVETEMENT	CODE DE COULEUR	ISOLATION ET TRACAGE	EPASS. D'ISOLATION	
116-150-PDI-CC10-0006	CC10	PDI					65-116-270-200 P&PE SUPPORT DETAILS
PRESSION D'OPERATION	TEMPERATURE D'OPERATION	PRESSION DE CONCEPTION	TEMPERATURE DE CONCEPTION	PRESSION D'ESSAI	CLASSE D'INSPECTION	CODE DE SERVICE	TRAITEMENT THERMIQUE
PSIG	T	PSIG	F	PSIG			65-116-205-200 P&ID
							No. DESSIN
							DESSINS DE REFERENCE

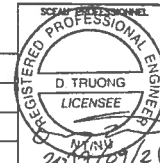

CONC: KHV DATE: 2017/04/25 DESSINE PAR: KVE DATE: 2017/04/25 VOL. PAR: - DATE: - APP: - DATE: - ECHELLE: AUCUNE	PROJET: AGNICO EAGLE - MELIADINE DIVISION 116 - FUEL TANK FARM	TITRE: RANKIN INLET FABRICATION ISOMETRIC DIESEL FROM 65TNK11601 & 65TNK11602 TO PUMPING STATION	No PROJET 6515	No DESSIN 116-150-PDI-CC10-0006	PAGES 1/12	REV. 2
---	--	--	--------------------------	---	----------------------	------------------

\\048 - 116-150-PDI-CC10-0006 (116-150-PDI-CC10-0006-10) 2017/09/21 10:00:00 (116-150-PDI-CC10-0006-10) 2017/09/21 10:00:00

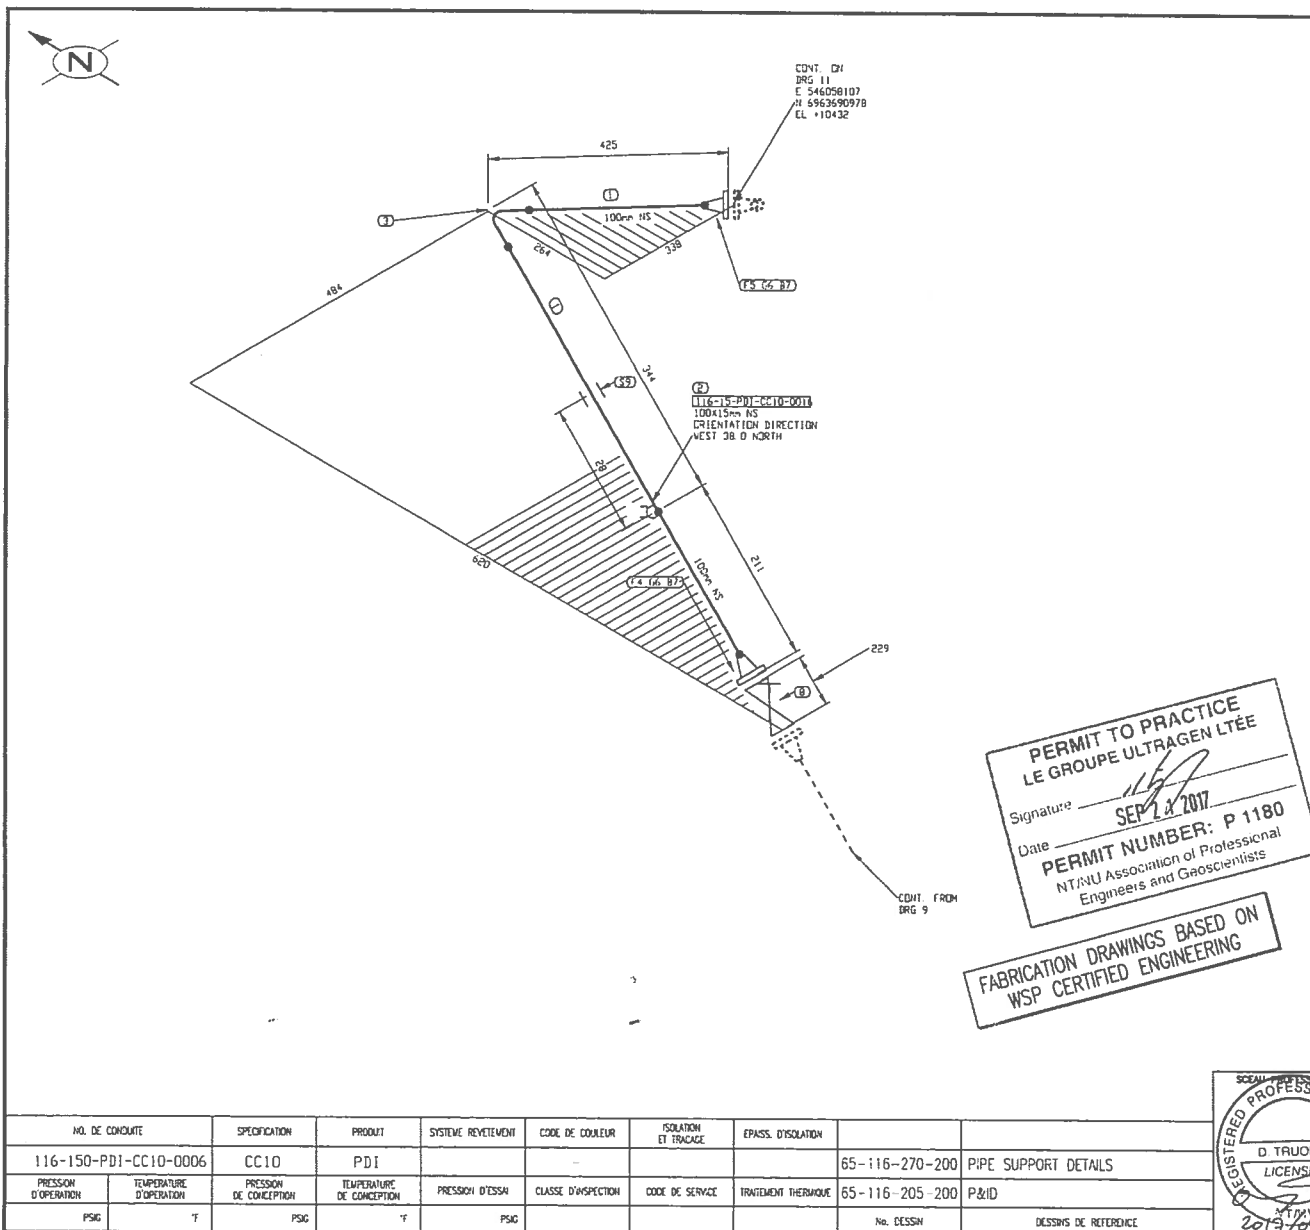


LISTE DE MATERIEL					
No	QTE	DA	MATERIEL/CATALOGUE	DESCRIPTION	
1	527 MM	100	A 333 Gr. 6	SCH STD, SMLS PIPE	
2	1	100X115	A 350 Gr. LF2	CL 3000, THREDOLET	
3	1	100	A 420 Gr. VRL6	SCH STD, BU LR 90 DEG ELBOW	
4	1	100	A 350 Gr. LF2	CL 150, SCH STD, RF, WN FLANGE	
5	1	100	A 350 Gr. LF2	CL 150, SCH STD, RF, WN FLANGE	
6	2	100	ASME B16.20	CL 150, GARLOCK 5500, RING TYPE GASKET 1/8" THK	
7	16	16	A 193 B7/A 194 2H	CL 150, B - 15.875 X 90 STUD BOLTS c/w TUD HEAVY HEX NUTS	
8	1	100	GA-10	CL 150, RF, GATE VALVE	
9	1	100		PIPE BRACKET C150x12x300 WELDED TO CONTAINER C/W U-BOLT	

2	2017/09/21	PROJECT TITLE REVISED	KHV
1	2017/09/11	LINE NUMBERS REVISED	KHV
0	2017/05/15	ISSUED FOR CONSTRUCTION	KHV

No.	DATE	REVISION	PAR	APP
CLIENT:				
				
				
				
CONSULTANT PROJECT NO. 591700				

CONC: KHV		PROJECT: AGNICO EAGLE - MELIADINE DIVISION			
DATE: 2017/04/25		116 - FUEL TANK FARM			
DESSINE PAR: KVE		TITRE: RANKIN INLET			
DATE: 2017/04/25		FABRICATION ISOMETRIC			
VOL. PAR: -		DIESEL FROM 65TNK11601 & 65TNK11602 TO PUMPING STATION			
DATE: -					
APP: -					
DATE: -					
ECHELLE: AUCUNE					

No. PROJET	No. DESSIN	PAGES	REV.
6515	116-150-PDI-CC10-0006	10/12	2

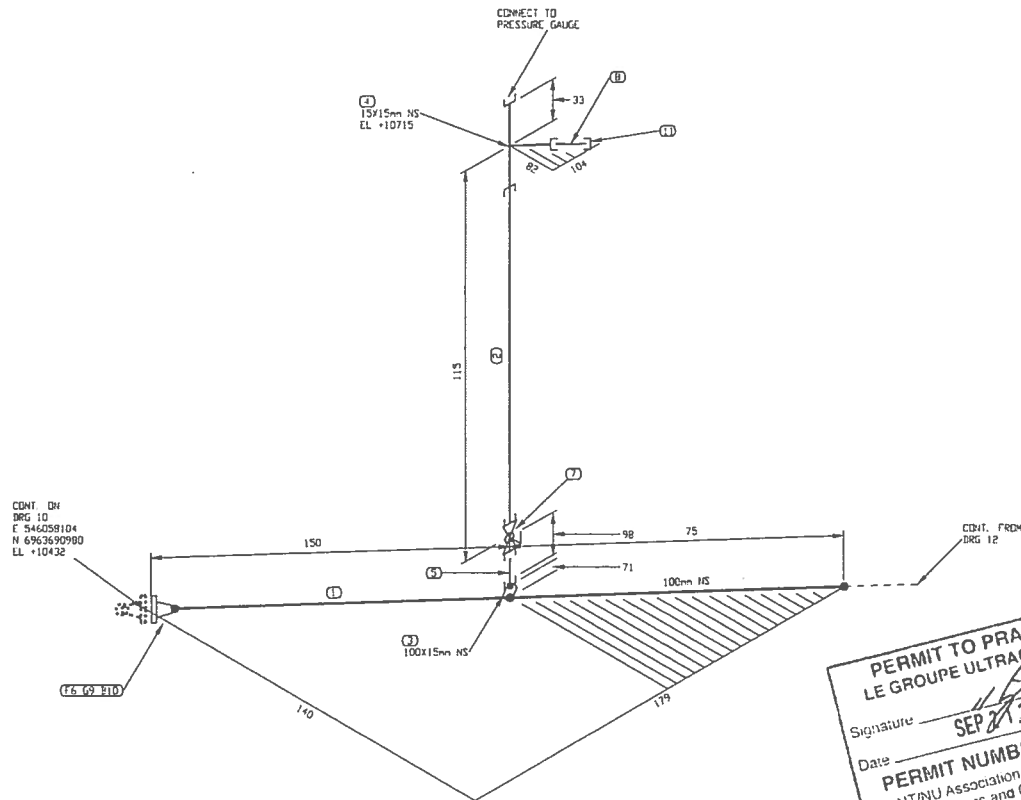

PERMIT TO PRACTICE
LE GROUPE ULTRAGEN LTÉE
 Signature [Signature]
 Date SEP 27 2017
PERMIT NUMBER: P 1180
 NTNU Association of Professional
 Engineers and Geoscientists

FABRICATION DRAWINGS BASED ON
WSP CERTIFIED ENGINEERING

LISTE DE MATERIEL				
No	QTL	DA	MATERIEL/CATALOGUE	DESCRIPTION
1	150 MM	100	A 333 Gr. 6	SCH STD, SMLS PIPE
2	74 MM	15	A 333 Gr. 6	SCH 80, SMLS PIPE
3	1	100X15	A 350 Gr. LF2	CL 3000, SOCKET
4	1	15X15	A 350 Gr. LF2	CL 3000, THRD STRAIGHT TEE
5	1	15	A 333 Gr. 6	SCH 80, NIPPLE x 75mm LG POCWTOE
6	1	100	A 350 Gr. LF2	CL 150, SCH STD, RF, WN FLANGE
7	1	15	BA-32	CL 600, THRD, BALL VALVE
8	1	15	A 333 Gr. 6	SCH 80, NIPPLE x 75mm LG TBE
9	1	100	ASME B16.20	CL 150, GARLOCK 5500, RING TYPE GASKET 1/8" THK
10	8	16	A 193 B7A 194 2H	CL 150, 8 - 15.875 X 90 STUD BOLTS c/+ TWO
11	1	15	A 350 Gr. LF2	CL 3000, THRD CAP


2	2017/09/21	PROJECT TITLE REVISED	KHV
1	2017/09/11	LINE NUMBERS REVISED	KHV
0	2017/05/15	ISSUED FOR CONSTRUCTION	KHV
No.	DATE	REVISION	PAR APP.

AGNICO EAGLE

CONSULTANT PROJECT NO. **591700**

NO. DE CONDUITE	SPECIFICATION	PRODUIT	SYSTEME REVETEMENT	CODE DE COULEUR	ISOLATION ET TRACAGE	EPASS. D'ISOLATION		
116-150-PDI-CC10-0006	CC10	PDI					65-116-270-200	PIPE SUPPORT DETAILS
PRESSION D'OPERATION	TEMPERATURE D'OPERATION	PRESSION DE CONCEPTION	TEMPERATURE DE CONCEPTION	PRESSION D'ESSAI	CLASSE D'INSPECTION	CODE DE SERVICE	TRAITEMENT THERMIQUE	
PSIG	T	PSIG	T	PSIG				
							No. DESSIN	DESSINS DE REFERENCE

SOCEAU PROFESSIONNEL REGISTERED PROFESSIONAL ENGINEER D. TRUONG LICENCEE 2017/09/21	CONC.: KHV DATE: 2017/04/25 DESSINE PAR: KVC DATE: 2017/04/23 VOL. PAR: - DATE: - APP.: - DATE: - ECHELLE: AUCUNE	PROJECT: AGNICO EAGLE - MELIADINE DIVISION 116 - FUEL TANK FARM TITRE: RANKIN INLET FABRICATION ISOMETRIC DIESEL FROM 65TNK11601 & 65TNK11602 TO PUMPING STATION	<table> <tr> <th>No. PROJET</th><th>No. DESSIN</th><th>PAGES</th><th>REV.</th></tr> <tr> <td>6515</td><td>116-150-PDI-CC10-0006</td><td>11/12</td><td>2</td></tr> </table>	No. PROJET	No. DESSIN	PAGES	REV.	6515	116-150-PDI-CC10-0006	11/12	2
No. PROJET	No. DESSIN	PAGES	REV.								
6515	116-150-PDI-CC10-0006	11/12	2								

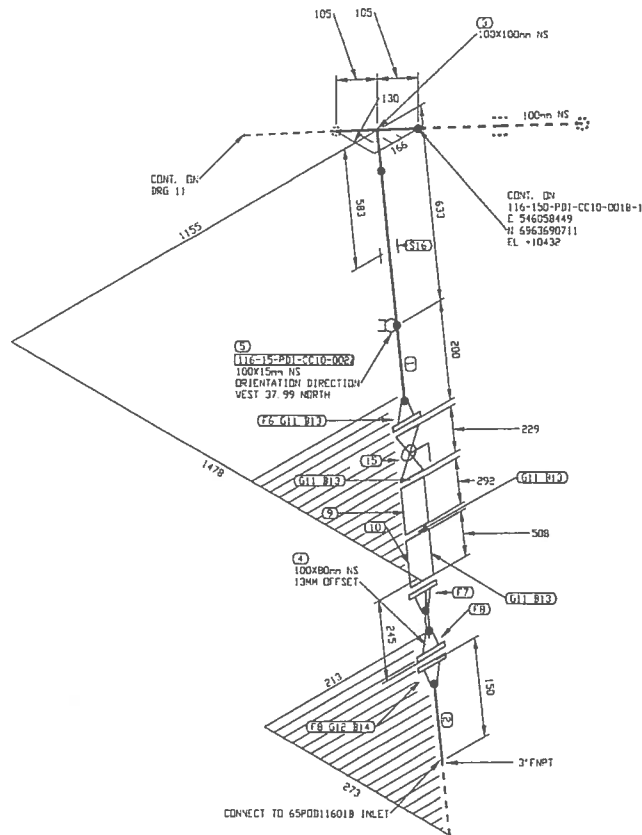

PERMIT TO PRACTICE
LE GROUPE ULTRAGEN LTÉE
Signature [Signature]
Date SEP 21 2017
PERMIT NUMBER: P 1180
P.T.N.U. Association of Professional
Engineers and Geoscientists
FABRICATION DRAWINGS BASED ON
WSP CERTIFIED ENGINEERING

LISTE DE MATERIEL				
No	QTY	DA	MATERIEL/CATALOGUE	DESCRIPTION
1	653 MM	100	A 333 Gr. 6	SCH STD, SMLS PIPE
2	81 MM	80	A 333 Gr. 6	SCH STD, SMLS PIPE PDE+TDE
3	1	100X100	A 420 Gr. VPL6	SCH STD, 90° STRAIGHT TEE
4	1	100X80	A 420 Gr. VPL6	SCH STD, 90° ELB
5	1	100X15	A 350 Gr. LF2	CL 3000, THREDOLET
6	1	100	A 350 Gr. LF2	CL 150, SCH STD, RF, WN FLANGE
7	1	100	A 350 Gr. LF2	CL 150, SCH STD, RF, WN FLANGE
8	2	80	A 350 Gr. LF2	CL 150, SCH STD, RF, WN FLANGE
9	1	100		CL 150, BASKET STRAINER
10	1	100		CL 150, SINGLE BRAIDED HOSE ASSEMBLY
11	4	100	ASME B16.20	CL 150, GARLOCK 5500, RING TYPE GASKET 1/8" THK
12	1	80	ASME B16.20	CL 150, GARLOCK 5500, RING TYPE GASKET 1/8" THK
13	32	16	A 193 B7/A 194 2H	CL 150, 8 - 15.875 X 90 STUD BOLTS c/w TWO HEAVY HEX NUTS
14	4	16	A 193 B7/A 194 2H	CL 150, 4 - 15.875 X 90 STUD BOLTS c/w TWO HEAVY HEX NUTS
15	1	100	BA-31	CL 150, M, BALL VALVE
16	1	100		PIPE SUPPORT AS PER DETAIL 9, DWG 65-116-270-200

2	2017/09/21	PROJECT TITLE REVISED	KHV
1	2017/09/11	LINE NUMBERS REVISED	KHV
0	2017/05/15	ISSUED FOR CONSTRUCTION	KHV
No.	DATE	REVISION	PAR APP.

CLIENT:


AGNICO EAGLE

NUQSANA PROMEC MINING


ultragen

CONSULTANT PROJECT NO. 591700

NO. DE CONDUITE	SPECIFICATION	PRODUIT	SYSTEME REVETEMENT	CODE DE COULEUR	ISOLATION ET TRACAGE	EPASS. D'ISOLATION	
116-150-PDI-CC10-0006	CC10	PDI		-		65-116-270-200	PIPE SUPPORT DETAILS
PRESSION D'OPERATION	TEMPERATURE D'OPERATION	PRESSION DE CONCEPTION	TEMPERATURE DE CONCEPTION	PRESSION D'ESSAI	CLASSE D'INSPECTION	CODE DE SERVICE	TRAITEMENT THERMIQUE
PSIG	°F	PSIG	°F	PSIG			
						No. DESSIN	DESSINS DE REFERENCE

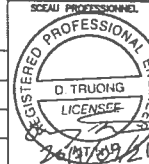

CONC: KHV DATE: 2017/04/25 DESSINE: PAR: KVE DATE: 2017/04/25 VER. PAR: - DATE: - APP: - DATE: - ECHELLE: AUCUNE	PROJECT: AGNICO EAGLE - MELIADINE DIVISION 116 - FUEL TANK FARM TITRE: RANKIN INLET FABRICATION ISOMETRIC DIESEL FROM 65TNK11601 & 65TNK11602 TO PUMPING STATION No. PROJECT: 6515 No. DESSIN: 116-150-PDI-CC10-0006 PAGES: 12/12 REV: 2
--	--

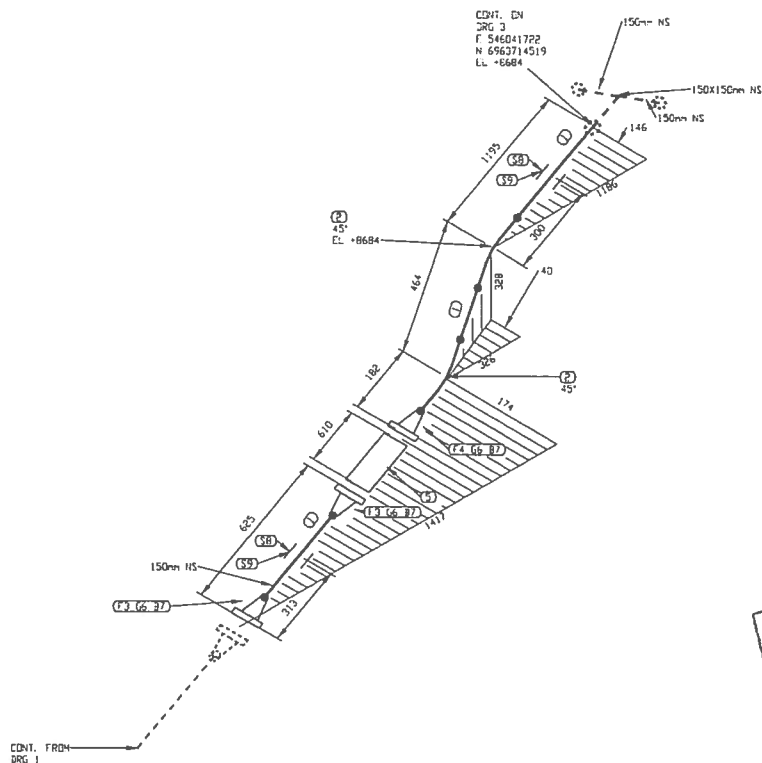

PERMIT TO PRACTICE
LE GROUPE ULTRAGEN LTÉE
Signature _____
Date SEP 21 2017
PERMIT NUMBER: P 1180
NTNU Association of Professional
Engineers and Geoscientists

FABRICATION DRAWINGS BASED ON
WSP CERTIFIED ENGINEERING

LISTE DE MATERIEL				
No	QTE	DA	MATERIEL/CATALOGUE	DESCRIPTION
1	1825 M4	150	A 333 Gr. 6	SCH STD. SMLS PIPE
2	2	150	A 420 Gr. VPL6	SCH STD. BU LR 45 DEG ELBOW
3	2	150	A 350 Gr. LF2	CL 15C, SCH STD. RF, WN FLANGE
4	1	150	A 350 Gr. LF2	CL 15C, SCH STD. RF, WN FLANGE
5	1	150		CL 15C, SINGLE BRAIDED HOSE ASSEMBLY
6	3	150	ASME B16.20	CL 15C, GARLOCK OSECO. RING TYPE GASKET 1/8"
7	24	19	A 193 B7/A 194 2H	HWK CL 15C, B - 19 05 X 100 STUD BOLTS c/w TWO HEAVY HEX NUTS
8	2	150		PIPE SUPPORT AS PER DETAIL 1, DWG 65-116-270-200
9	2	150		PIPE SHOE AS PER DETAIL 2, DWG 65-116-270-200

2	2017/09/21	PROJECT TITLE REVISED	KHV
1	2017/09/11	LINE NUMBERS REVISED	KHV
0	2017/05/15	ISSUED FOR CONSTRUCTION	KHV
No.	DATE	REVISION	PAR APP

CLIENT:


AGNICO EAGLE

NUQSANA PROMEC MINING


ultragen

CONSULTANT PROJECT NO. 591700

NO. DE COMITE	SPECIFICATION	PRODUIT	SYSTEME REVETEMENT	CODE DE COULEUR	ISOLATION ET TRACAGE	EPASS. D'ISOLATION	
116-150-PDI-CC10-0006	CC10	PDI		-		65-116-270-200	PIPE SUPPORT DETAILS
PRESSON D'OPERATION	TEMPERATURE D'OPERATION	PRESSON DE CONCEPTION	TEMPERATURE DE CONCEPTION	PRESSON D'ESSAI	CLASSE D'INSPECTION	CODE DE SERVICE	TRAITEMENT THERMIQUE
PSIG	F	PSIG	T	PSIG			
						No. DESSIN	DESSINS DE REFERENCE

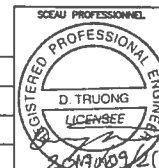

CONC: K11V	PROJET:	AGNICO EAGLE - MELIADINE DIVISION		
DATE: 2017/04/25		116 - FUEL TANK FARM		
DESSINE PAR: KVE	TITRE:	RANKIN INLET		
DATE: 2017/04/25		FABRICATION ISOMETRIC		
VOIR PAR: -		DIESEL FROM 65TNK11601 & 65TNK11602 TO PUMPING STATION		
DATE: -				
APP: -				
DATE: -				
ECHELLE: AUCUNE				
	No PROJET	No DESSIN	PAGES	REV.
	6515	116-150-PDI-CC10-0006	2/12	2

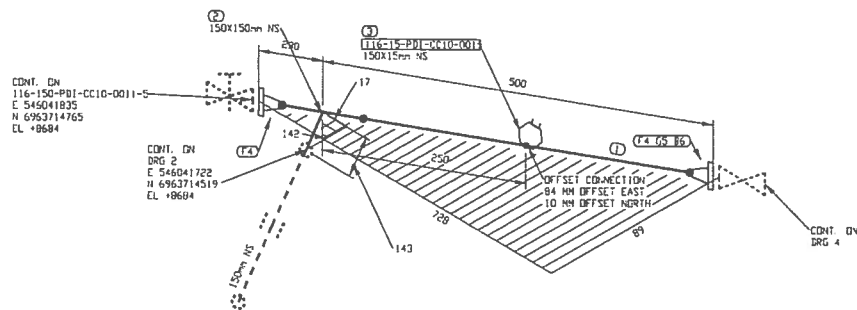

PERMIT TO PRACTICE
LE GROUPE ULTRAGEN LEE
Signature _____
Date SEP 21 2017
PERMIT NUMBER: P 1180
NTNU Association of Professional
Engineers and Geoscientists
FABRICATION DRAWINGS BASED ON
WSP CERTIFIED ENGINEERING

LISTE DE MATERIEL				
No	QTE	DA	MATERIEL/CATALOGUE	DESCRIPTION
1	270 MM	150	A 333 Gr. 6	SCH STD. SHLS PIPE
2	1	150X150	A 420 Gr. WPL6	SCH STD. BV STRAIGHT TEE
3	1	150X15	A 350 Gr. LF2	CL 3000, THREDDLET
4	2	150	A 350 Gr. LF2	CL 150, SCH STD. RF, WN FLANGE
5	1	150	ASME B16.20	CL 150, GARLOCK 5500, RING TYPE GASKET 1/8" THK
6	8	19	A 193 B7/A 194 2H	CL 150, B - 19.05 X 100 STUD BOLTS c/w TWO HEAVY HEX NUTS

2	2017/09/21	PROJECT TITLE REVISED	KHV
1	2017/09/11	LINE NUMBERS REVISED	KHV
0	2017/05/15	ISSUED FOR CONSTRUCTION	KHV

No.	DATE	REVISION	PAR	APP
-----	------	----------	-----	-----


CLIENT:

**AGNICO EAGLE**


**ULTRAGEN**

CONSULTANT PROJECT NO. 591700

NO. DE CONDUITE	SPECIFICATION	PRODUIT	SYSTEME REVETEMENT	CODE DE COULEUR	ISOLATION ET TRACAGE	EPASS. D'ISOLATION		
116-150-PDI-CC10-0006	CC10	PDI		-			65-116-270-200	PIPE SUPPORT DETAILS
PRESSION D'OPERATION	TEMPERATURE D'OPERATION	PRESSION DE CONCEPTION	TEMPERATURE DE CONCEPTION	PRESSION D'ESSAI	CLASSE D'INSPECTION	CODE DE SERVICE	TRAITEMENT THERMIQUE	65-116-205-200 P&ID
PSIG	°F	PSIG	°F	PSIG			No. DESSIN	DESSINS DE REFERENCE

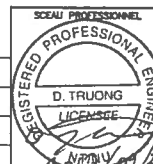

CONC: KHV DATE: 2017/04/25 DESSINE PAR: KHV DATE: 2017/04/25 VOL. PAR: - DATE: - APP: - DATE: - ECHELLE: AUCUNE	PROJET: AGNICO EAGLE - MELIADINE DIVISION 116 - FUEL TANK FARM TITRE: RANKIN INLET FABRICATION ISOMETRIC DIESEL FROM 65TNK11601 & 65TNK11602 TO PUMPING STATION No PROJET 6515 No DESSIN 116-150-PDI-CC10-0006 PAGES 3/12 REV. 2
---	--

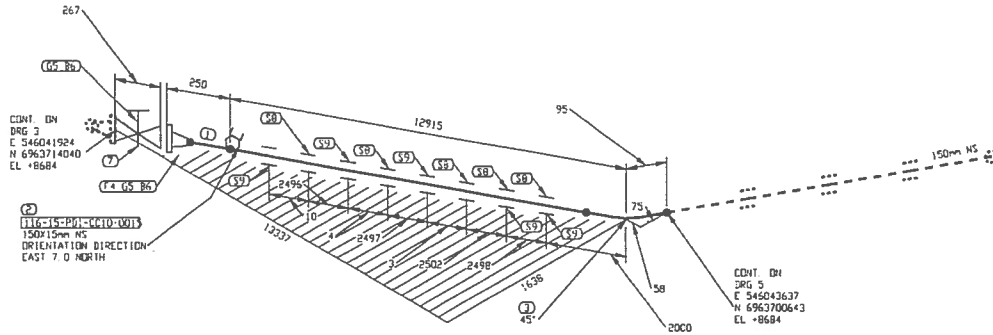

PERMIT TO PRACTICE
LE GROUPE ULTRAGEN LTÉE
Signature: *[Signature]*
Date: **SEP 21 2017**
PERMIT NUMBER: P 1180
NTNU Association of Professional
Engineers and Geoscientists

FABRICATION DRAWINGS BASED ON
WSP CERTIFIED ENGINEERING

LISTE DE MATERIEL				
QTE	QTE	DA	MATERIEL/CATALOGUE	DESCRIPTION
1	12983	MM	150	A 333 G- 6 SCH STD. SHLS PIPE
2	1	150X15	A 350 G- LF2	CL 3000. THREDOLET
3	1	150	A 420 G- VPL6	SCH STD. BV LR 45 DEG ELBOW
4	1	150	A 350 G- LF2	CL 150. SCH STD. RF. WN FLANGE
5	2	150	ASPC B16.20	CL 150. GARLOCK 5500. RING TYPE GASKET 1/8" THK
6	16	19	A 193 B7/A 194 2H	CL 150. B - 19.05 X 100 STUD BOLTS c/w TWO HEAVY HEX NUTS
7	1	150	GA-10	CL 150. RF. GATE VALVE
8	5	150		PIPE SUPPORT AS PER DETAIL 1. DWG: 65-116-270-200
9	5	150		PIPE SHOE AS PER DETAIL 2. DWG: 65-116-270-200

2	2017/09/21	PROJECT TITLE REVISED	KHV
1	2017/09/11	LINE NUMBERS REVISED	KHV
0	2017/05/15	ISSUED FOR CONSTRUCTION	KHV
No.	DATE	REVISION	PAR APP.


CLIENT:



CONSULTANT PROJECT NO. 591700

NO. DE CONDUITE	SPECIFICATION	PRODUIT	SYSTEME REVETEMENT	CODE DE COULEUR	ISOLATION ET TRACAGE	EPASS. D'ISOLATION	
116-150-PDI-CC10-0006	CC10	PDI					65-116-270-200 PIPE SUPPORT DETAILS
PRESSION D'OPERATION	TEMPERATURE D'OPERATION	PRESSION DE CONCEPTION	TEMPERATURE DE CONCEPTION	PRESSION D'ESSAI	CLASSE D'INSPECTION	CODE DE SERVICE	TRAIEMENT THERMIQUE 65-116-205-200 P&ID
PSIG	°F	PSIG	°F	PSIG			No. DESSIN DESSINS DE REFERENCE

COMC: KHV DATE: 2017/04/25 DESSINE PAR: KHV DATE: 2017/04/25 VDR PAR: - DATE: - APP: - DATE: - ECHILLE: AUCUNE	PROJET: AGNICO EAGLE - MELIADINE DIVISION 116 - FUEL TANK FARM TITRE: RANKIN INLET FABRICATION ISOMETRIC DIESEL FROM 65TNK11601 & 65TNK11602 TO PUMPING STATION No PROJET 6515 No DESSIN 116-150-PDI-CC10-0006 PAGES 4/12 REV. 2
--	--

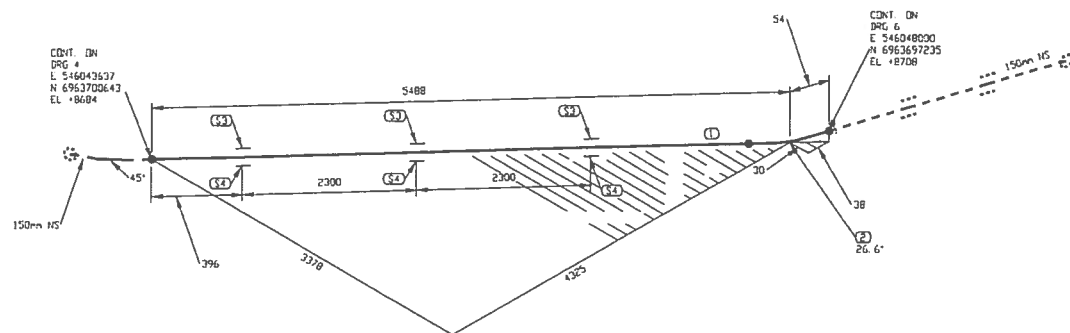

FABRICATION DRAWINGS BASED ON
WSP CERTIFIED ENGINEERING

2	2017/09/21	PROJECT TITLE REVISED	KHV
1	2017/09/11	LINE NUMBERS REVISED	KHV
0	2017/05/15	ISSUED FOR CONSTRUCTION	KHV
No.	DATE	REVISION	PAR




PT. NUOSANA PROMEC MINING

Ultragen
Life together. Love together.

CONSULTANT
PRO-FCO AND

591700

CONC: K101	PROJECT: AGNICO EAGLE - MELIADINE DIVISION	PROJECT NO: 071700
DATE: 2017/04/25	116 - FUEL TANK FARM	
DESSIN PAR: K1C	TITRE: RANKIN INLET	
DATE: 2017/04/25	FABRICATION ISOMETRIC	
VIDE PAR: -	DIESEL FROM 65TNK11601 & 65TNK11602 TO PUMPING STATION	
DATE: -		
APP: -	No PROJECT	No DESSIN
DATE: -	6515	116-150-PDI-CC10-0006
DESSIN: AUCUNE		PAGES: 1
		REV: 5/12 2

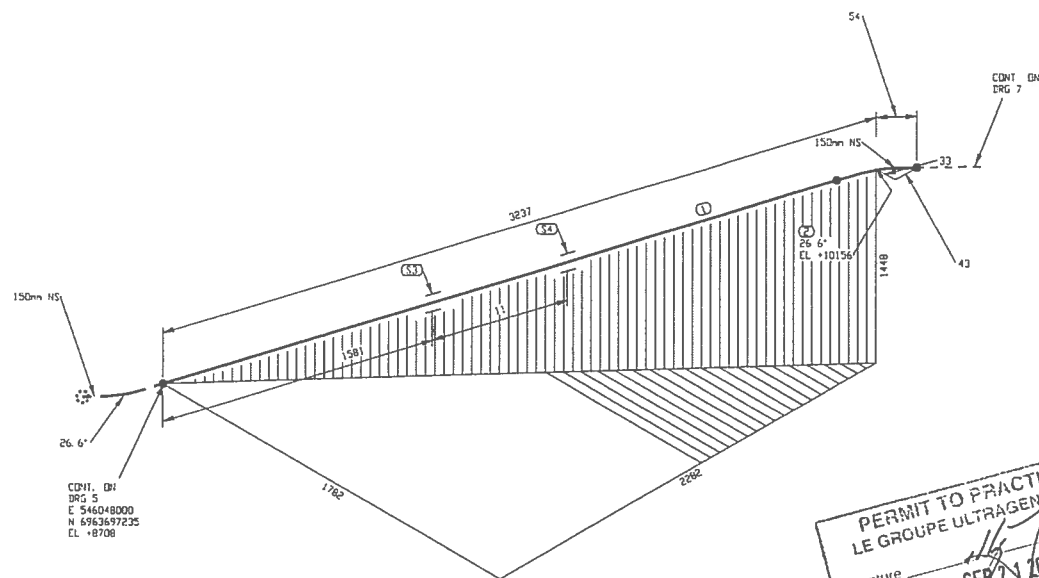

PERMIT TO PRACTICE
LE GROUPE ULTRAGEN LTEE
Signature [Signature]
Date SEP 21 2017
PERMIT NUMBER: P 1180
NTNU Association of Professional
Engineers and Geoscientists

FABRICATION DRAWINGS BASED ON
WSP CERTIFIED ENGINEERING

LISTE DE MATERIEL				
No	QTL	D.A	MATERIEL/CATALOGUE	DESCRIPTION
1	2183 MM	150	A 333 Gr. 6	SCH STD. SMLS PIPE
2	1	150	A 420 Gr. WPL6	SCH STD. BV LR 90 DEG ELBOW TRIM TO 26 S7
3	1	150		PIPE SUPPORT AS PER DETAIL 1, DWG: 65-116-270-200
4	1	150		PIPE SHOE AS PER DETAIL 2, DWG: 65-116-270-200

2	2017/09/21	PROJECT TITLE REVISED	KHV
1	2017/09/11	LINE NUMBERS REVISED	KHV
0	2017/05/15	ISSUED FOR CONSTRUCTION	KHV
No.	DATE	REVISION	PAB APP.

CLIENT:


AGNICO EAGLE

NUQSANA PROMEC MINING


ultragen

CONSULTANT PROJECT NO. 591700

NO. DE CONDUITE	SPECIFICATION	PRODUIT	SYSTEME REVETEMENT	CODE DE COULEUR	ISOLATION ET TRACAGE	EPASS. D'ISOLATION		
116-150-PDI-CC10-0006	CC10	PDI		-			65-116-270-200	PIPE SUPPORT DETAILS
PRESSION D'OPERATION	TEMPERATURE D'OPERATION	PRESSION DE CONCEPTION	TEMPERATURE DE CONCEPTION	PRESSION D'ESSAI	CLASSE D'INSPECTION	CODE DE SERVICE	TRAITEMENT THERMIQUE	65-116-205-200 P&ID
PSG	T	PSG	T	PSG			No. DESSIN	DESSINS DE REFERENCE

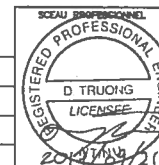

CONC: KHV DATE: 2017/04/25 DESSINE PAR: KVE DATE: 2017/04/25 VCL PAR: - DATE: - APP: - DATE: - ECHELLE: AUCUNE	PROJET: AGNICO EAGLE - MELIADINE DIVISION 116 - FUEL TANK FARM TITRE: RANKIN INLET FABRICATION ISOMETRIC DIESEL FROM 65TNK11601 & 65TNK11602 TO PUMPING STATION No PROJET: 6515 No DESSIN: 116-150-PDI-CC10-0006 PAGES: 6/12 REV: 2
--	---

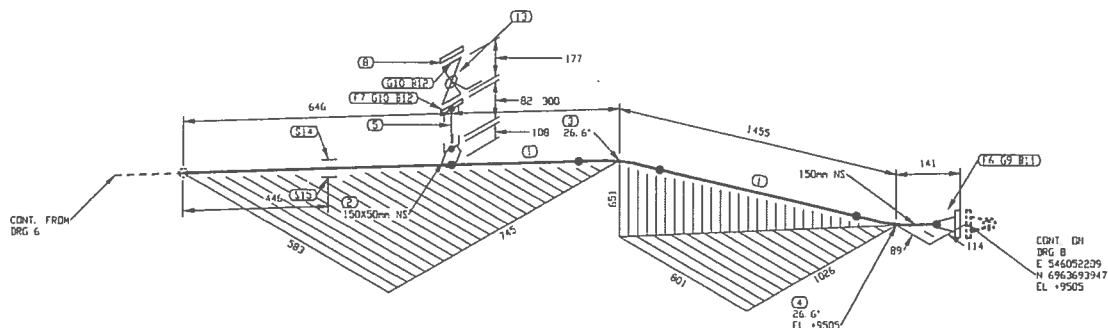

5




A circular professional engineer license stamp. The outer ring contains the text "SCEAU PROFESSIONNEL" at the top and "REGISTERED PROFESSIONAL ENGINEER" around the bottom. The center of the stamp features the name "D. TRUONG" above the word "LICENSEE". A handwritten signature is scrawled across the center, and the date "2014/09/21" is written at the bottom of the stamp.

2	2017/09/21	PROJECT TITLE REVISED	KH-V
1	2017/09/11	LINE NUMBERS REVISED	KH-V
0	2017/05/15	ISSUED FOR CONSTRUCTION	KH-V
No.	DATE	REVISION	PAR

COMC: WYV DATE: 2017/04/23 DESSINE PAR: WYV DATE: 2017/04/23 VOR PAR: - DATE: - APP: - DATE: - ECHELLE: AUCUNE	PROJET: AGNICO EAGLE - MELIADINE DIVISION 116 - FUEL TANK FARM TITRE: RANKIN INLET FABRICATION ISOMETRIC DIESEL FROM 65TNK11601 & 65TNK11602 TO PUMPING STATION	PROJET NO: 021700								
	<table><tr><th>No PROJET</th><th>No DESSIN</th><th>PAGES</th><th>REV</th></tr><tr><td>6515</td><td>116-150-PPI-CC10-0006</td><td>7/12</td><td>2</td></tr></table>	No PROJET	No DESSIN	PAGES	REV	6515	116-150-PPI-CC10-0006	7/12	2	
No PROJET	No DESSIN	PAGES	REV							
6515	116-150-PPI-CC10-0006	7/12	2							

16-MN-01

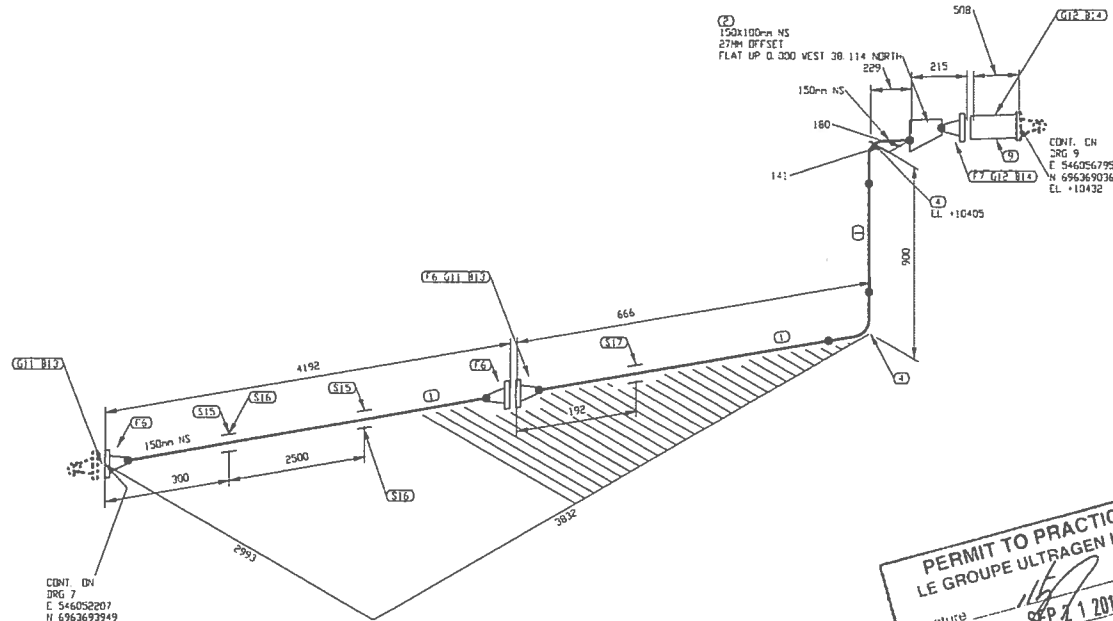

**PERMIT TO PRACTICE
LE GROUPE ULTRAGEN LTÉE**
Signature: *[Signature]*
Date: **SEP 21 2017**
PERMIT NUMBER: P 1180
NTNU Association of Professional
Engineers and Geoscientists

**FABRICATION DRAWINGS BASED ON
WSP CERTIFIED ENGINEERING**

LISTE DE MATERIEL


no	QTE	DA	MATERIEL/CATALOGUE	DESCRIPTION
1	4810 KH	150	A 333 Gr 6	SCH STD, SHLS PIPE
2	1	150K100	A 420 Gr VPL6	SCH STD, BU ECC RED
3				
4	2	150	A 420 Gr VPL6	SCH STD, BU LP 90 DEG ELBOW
5				
6	3	150	A 350 Gr LF2	CL 150, SCH STD, RF, WN FLANGE
7	1	100	A 350 Gr LF2	CL 150, SCH STD, RF, WN FLANGE
8				
9	1	100		TCS METER UNIT
10				
11	2	150	ASME B16.20	CL 150, GARLOCK 5500, RING TYPE GASKET 1/8" THK
12	2	100	ASME B16.20	CL 150, GARLOCK 5500, RING TYPE GASKET 1/8" THK
13	16	19	A 193 B7/A 194 2H	CL 150, B - 19.05 X 100 STUD BOLTS c/w TWO HEAVY HEX NUTS
14	16	16	A 193 B7/A 194 2H	CL 150, B - 15.875 X 90 STUD BOLTS c/w TWO HEAVY HEX NUTS
15	2	150		PIPE SHOE AS PER DETAIL 2, DWG: 65-116-270-200
16	2	150		PIPE SUPPORT AS PER DETAIL 1, DWG: 65-116-270-200
17	1	150		ABUTMENT TYPE 2 AS PER DETAIL 5, DWG: 65-116-270-200

2	2017/09/21	PROJECT TITLE REVISED	KHV
1	2017/09/11	LINE NUMBERS REVISED	KHV
0	2017/05/15	ISSUED FOR CONSTRUCTION	KHV
No.	DATE	REVISION	APP.

AGNICO EAGLE

CONSULTANT PROJECT NO. 591700

NO. DE CONDUITE	SPECIFICATION	PRODUIT	SYSTEME REVETEMENT	CODE DE COULEUR	ISOLATION ET TRACAGE	EPASS. D'ISOLATION	
116-150-PDI-CC10-0006	CC10	PDI					65-116-270-200 PIPE SUPPORT DETAILS
PRESSON D'OPERATION	TEMPERATURE D'OPERATION	PRESSON DE CONCEPTION	TEMPERATURE DE CONCEPTION	PRESSON D'ESSAI	CLASSE D'INSPECTION	CODE DE SERVICE	TRAIEMENT THERMIQUE
PSIG	°F	PSIG	°F	PSIG			65-116-205-200 P&ID
						No. DESSIN	DESSIN DE REFERENCE

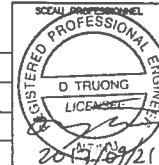

CONC: KHV DATE: 2017/09/25 DESSINE PAR: KVE DATE: 2017/09/25 VDR PAR: - DATE: - APP: - DATE: - ECHELLE: AUCUNE	PROJECT: AGNICO EAGLE - MELIADINE DIVISION 116 - FUEL TANK FARM TITLE: RANKIN INLET FABRICATION ISOMETRIC DIESEL FROM 65TNK11601 & 65TNK11602 TO PUMPING STATION
No. PROJECT: 6515 No. DESSIN: 116-150-PDI-CC10-0006 PAGES: 8/12 REV: 2	




2	2017/09/21	PROJECT TITLE REVISED	KHV
1	2017/09/11	LINE NUMBERS REVISED	KHV
0	2017/05/15	ISSUED FOR CONSTRUCTION	KHV
No.	DATE	REVISION	PAR

CLIENT:  AGNICO EAGLE	 NUQSANA PROMEC MINING General Manager: Mr. J. J. J. J. Project Manager: Mr. J. J. J. J.  ultragren Environmental Services CONSULTANT PROJECT NO. 591700
---	---

STATE OF TEXAS
REGISTERED PROFESSIONAL ENGINEER
D. TRUONG
LICENSEE
2617109/2

CONC: 41W	PROJECT:	PROJECT NO: 051100		
DATE: 2017/04/25	AGNICO EAGLE - MELIADINE DIVISION			
DESIGN: PAR V/E	116 - FUEL TANK FARM			
DATE: 2017/04/25	TITLE:	RANKIN INLET		
YOL: PAR: -	FABRICATION ISOMETRIC			
DATE: -	DIESEL FROM 65TNK11601 & 65TNK11602 TO PUMPING STATION			
APP: -	No PROJECT	No DESIGN	PAGES	REV
DATE: -	6515	116-150-PRI-C-11-0006	9/12	2
STANDARD: ALCANTARA				

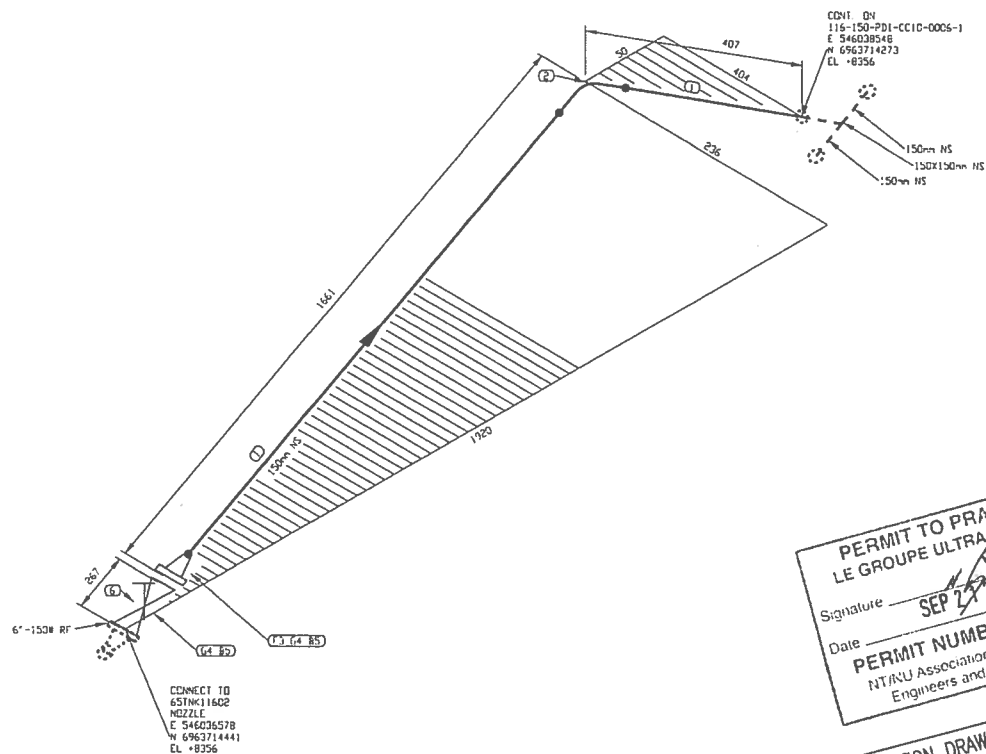

PERMIT TO PRACTICE
 LE GROUPE ULTRAGEN LTÉE
 Signature _____
 Date _____
 PERMIT NUMBER: P 1180
 NTARU Association of Professional
 Engineers and Geoscientists
 BASED ON

FABRICATION DRAWINGS BASED ON
WSP CERTIFIED ENGINEERING



LISTE DE MATERIEL				
NO	Q'T	DA	MATERIEL/CATALOGUE	DESCRIPTION
1	1523 MM	150	A 333 Gr 6	SCH STD, SMLS PIPE
2	1	150	A 420 Gr 4PL6	SCH STD, 30 LR 90 DEG ELBOW
3	1	150	A 250 Gr LF2	CL 150, SCH STD, RF, W/ FLANGE
4	2	150	ASME B16.20	CL 150, GARLOCK 5500, RING TYPE GASKET 1/8" THK
5	16	19	A 193 B7/A 194 2H	CL 150, 0 - 19 05 X 100 STUD BOLTS c/a TWO HEAVY HEX NUTS
6	1	150	GA-10	CL 150, RF, GATE VALVE

2	2017/09/21	PROJECT TITLE REVISED	KHV
1	2017/09/11	LINE NUMBERS REVISED	KHV
0	2017/05/15	ISSUED FOR CONSTRUCTION	KHV
No.	DATE	REVISION	PAR APR

CUSTOMER




AGNICO EAGLE



CONSULTANT PROJECT NO.	591700
------------------------	--------

COMC: - H/V	PROJECT:	AGNICO EAGLE - MELIADINE DIVISION		
DATE: 20/7/04/75		116 - FUEL TANK FARM		
DESSINE PAR: H/V	TITRE:	RANKIN INLET		
DATE: 20/7/04/75		FABRICATION ISOMETRIC		
VEOL PAR: -		DIESEL FROM 65TNK11602 TO PUMPING STATION		
DATE: -				
APP: -	No PROJECT	No DESSIN	PAGES	REV.
DATE: -	6515	116-150-PDI-CC10-0007	1/1	2
CHÉQUE: AUCUNE				

C:\E:\Projects\Engineering\116-150-PDI-CC10-0011\116-150-PDI-CC10-0011.dwg

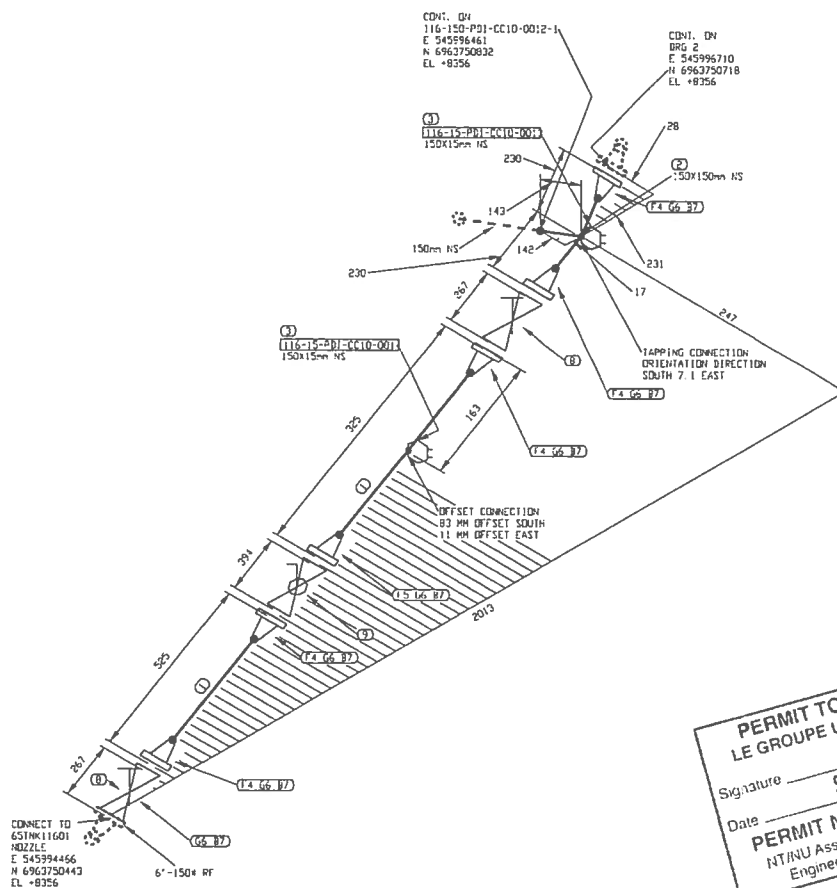

PERMIT TO PRACTICE
LE GROUPE ULTRAGEN LTÉE
Signature _____
Date **SEP 21 2017**
PERMIT NUMBER: P 1180
NTNU Association of Professional
Engineers and Geoscientists

FABRICATION DRAWINGS BASED ON
WSP CERTIFIED ENGINEERING

LISTE DE MATERIEL


NO	QTE	DA	MATRIEL/CATALOGUE	DESCRIPTION
1	502 MM	150	A 333 Gr. 6	SCH STD. SMLS PIPE
2	1	150X150	A 420 Gr. VPL6	SCH STD. 90° STRAIGHT TEE
3	2	150X150	A 350 Gr. LF2	CL 3000. THREEDOLET
4	5	150	A 350 Gr. LF2	CL 150. SCH STD. RF, WN FLANGE
5	1	150	A 250 Gr. LF2	CL 150. SCH STD. RF, WN FLANGE
6	7	150	ASME B16.20	CL 150. GARLOCK 5500. RING TYPE GASKET 1/8" THK
7	56	19	A 193 B7/A 194 2H	CL 150. 8 - 19.05 X 100 STUD BOLTS c/w TWO HEAVY HEX NUTS
8	2	150	GA-10	CL 150. RF, GATE VALVE
9	1	150	BA-31	CL 150. RF, BALL VALVE

2	2017/09/21	PROJECT TITLE REVISED	KHV
1	2017/09/11	LINE NUMBERS REVISED	KHV
0	2017/05/15	ISSUED FOR CONSTRUCTION	KHV
NO.	DATE	REVISION	PAS
			APP


CLIENT:

CONSULTANT PROJECT NO. **591700**

NO. DE CONQUETE	SPECIFICATION	PRODUIT	SYSTEME REVETEMENT	CODE DE COULEUR	ISOLATION ET TRACAGE	EPASS. D'ISOLATION	
116-150-PDI-CC10-0011	CC10	PDI					65-116-270-200 PIPE SUPPORT DETAILS
PRESSON D'OPERATION	TEMPERATURE D'OPERATION	PRESSON DE CONCEPTION	TEMPERATURE DE CONCEPTION	PRESSON D'ESSAI	CLASSE D'INSPECTION	CODE DE SERVICE	TRAITEMENT THERMIQUE
PSIG	°F	PSIG	°F	PSIG			
						No. DESSIN	DESSINS DE REFERENCE

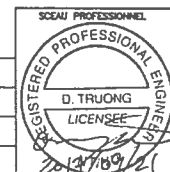

CONC.: KHV DATE: 2017/04/25 DESSINE PAR: KHV DATE: 2017/04/25 VOR. PAR: - DATE: - APP.: - DATE: - ECHELLE: AUCUNE	PROJET: AGNICO EAGLE - MELIADINE DIVISION 116 - FUEL TANK FARM TITRE: RANKIN INLET FABRICATION ISOMETRIC DIESEL FROM 65TNK11601 TO PUMPING STATION No. PROJET: 6515 No. DESSIN: 116-150-PDI-CC10-0011 PAGES: 1/5 REV.: 2
---	--

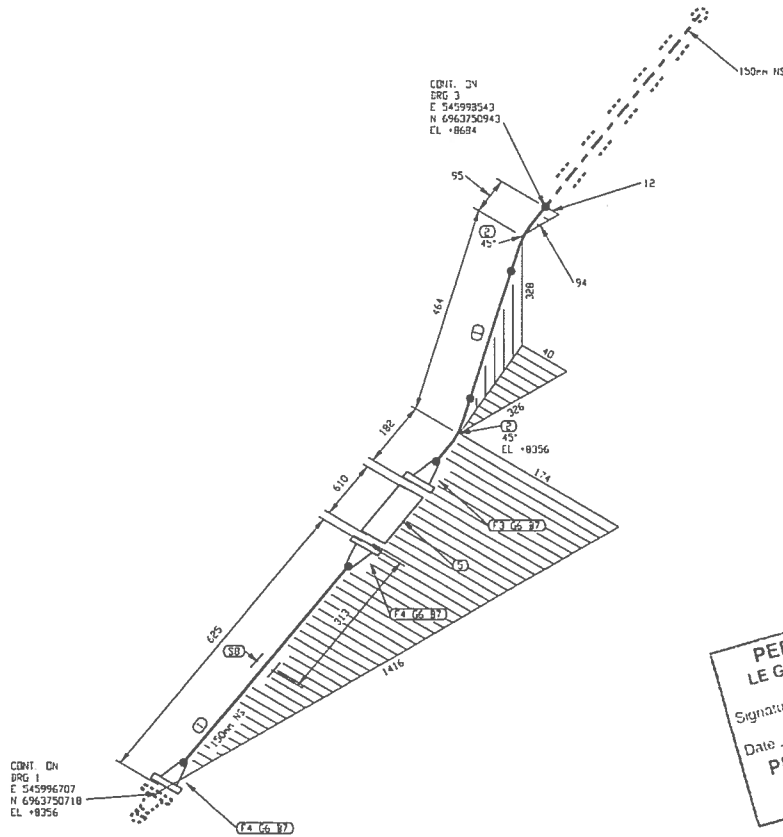

PERMIT TO PRACTICE
LE GROUPE ULTRAGEN LTÉE
Signature: *[Signature]*
Date: **SEP 1 2017**
PERMIT NUMBER: P 1180
NTNU Association of Professional
Engineers and Geoscientists

FABRICATION DRAWINGS BASED ON
WSP CERTIFIED ENGINEERING

LISTE DE MATERIEL				
No	QTE	DA	MATERIEL/CATALOGUE	DESCRIPTION
1	725 MM	150	A 333 Gr. 6	SCH STD, SMLS PIPE
2	2	150	A 420 Gr. WPL6	SCH STD, 90 LR 45 DEG ELBOW
3	1	150	A 350 Gr. LF2	CL 150, SCH STD, RF, WN FLANGE
4	2	150	A 350 Gr. LF2	CL 150, SCH STD, RF, WN FLANGE
5	1	150		CL 150, SINGLE BRAIDED HOSE ASSEMBLY
6	3	150	ASME B16.20	CL 150, GARLOCK 5500, RING TYPE GASKET 1/8" THK
7	24	19	A 193 B7/A 194 2H	CL 150, 8 - 19 05 X 100 STUD BOLTS c/n 1VD
8	1	150		HEAVY HEX NUTS PIPE SHOE AS PER DETAIL 2. DWG 65-116-270-200

2	2017/09/21	PROJECT TITLE REVISED	KHV
1	2017/09/11	LINE NUMBERS REVISED	KHV
0	2017/05/15	ISSUED FOR CONSTRUCTION	KHV
No.	DATE	REVISION	APP

CLIENT:


**AGNICO EAGLE**

**NUQSANA PROMEC MINING**


**Ultragen**

CONSULTANT PROJECT NO 591700

NO. DE CONDUITE	SPECIFICATION	PRODOT	SISTEME REVETEMENT	CODE DE COULEUR	ISOLATION ET TRACAGE	EPASS. D'ISOLATION	
116-150-PDI-CC10-0011	CC10	PDI		-			65-116-270-200 PIPE SUPPORT DETAILS
PRESSON D'OPERATION	TEMPERATURE D'OPERATION	PRESSON DE CONCEPTION	TEMPERATURE DE CONCEPTION	PRESSON D'ESSAI	CLASSE D'INSPECTION	CODE DE SERVICE	TRAITEMENT THERMIQUE 65-116-205-200 P&ID
PSIG	T	PSIG	T	PSIG			No. DESSIN DESSINS DE REFERENCE

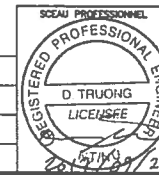

CONC.: KHV DATE: 2017/04/25 DESSINE PAR: KVE DATE: 2017/04/25 VDR PAR: - DATE: - APP.: - DATE: - ECHELLE: AUCUNE	PROJET: AGNICO EAGLE - MELIADINE DIVISION 116 - FUEL TANK FARM TITRE: RANKIN INLET FABRICATION ISOMETRIC DIESEL FROM 65TNK11601 TO PUMPING STATION No PROJET 6515 No DESSIN 116-150-PDI-CC10-0011 PAGES 2/5 REV. 2
--	--

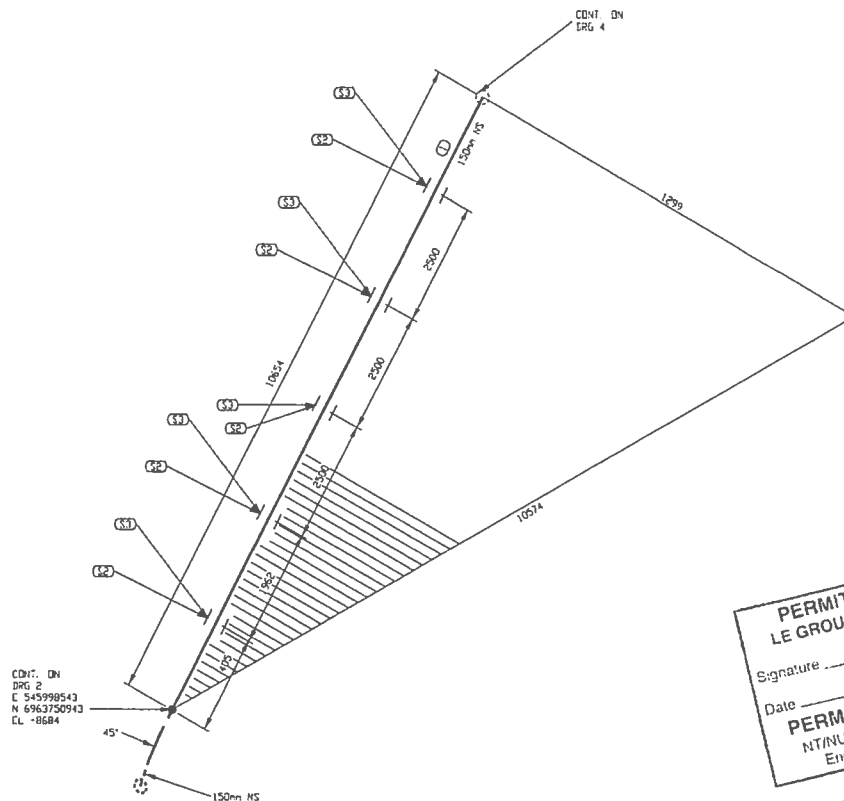

CONT. ON
DRG 2
E 545998543
N 6963750943
EL -8684

PERMIT TO PRACTICE
LE GROUPE ULTRAGEN LTEE
Signature _____
Date _____
SEP 11 2017
PERMIT NUMBER: P 1180
NT/NU Association of Professional
Engineers and Geoscientists

FABRICATION DRAWINGS BASED ON
WSP CERTIFIED ENGINEERING

LISTE DE MATERIEL

No	QTE	DA	MATERIEL/CATALOGUE	DESCRIPTION
1	10634 MM	150	A 333 Gr. 6	SCH STD. SHLS PIPE
2	5	150		PIPE SUPPORT AS PER DETAIL 1, DWG 65-116-270-200
3	5	150		PIPE SHOE AS PER DETAIL 2, DWG 65-116-270-200

2	2017/09/21	PROJECT TITLE REVISED	KHV
1	2017/09/11	LINE NUMBERS REVISED	KHV
0	2017/05/15	ISSUED FOR CONSTRUCTION	KHV
No.	DATE	REVISION	APP.

CLIENT:


AGNICO EAGLE

NUQSANA PROMEC MINING


Ultragen

CONSULTANT PROJECT NO. 591700

NO. DE CONDUITE	SPECIFICATION	PRODUIT	SYSTEME REVETEMENT	CODE DE COULEUR	ISOLATION ET TRACAGE	EPASS. D'ISOLATION		
116-150-PDI-CC10-0011	CC10	PDI					65-116-270-200	PIPE SUPPORT DETAILS
PRESSION D'OPERATION	TEMPERATURE D'OPERATION	PRESSION DE CONCEPTION	TEMPERATURE DE CONCEPTION	PRESSION D'ESSAI	CLASSE D'INSPECTION	CODE DE SERVICE	TRAITEMENT THERMIQUE	65-116-205-200 P&ID
PSIG	°F	PSIG	°F	PSIG			No. DESSIN	DESSINS DE REFERENCE

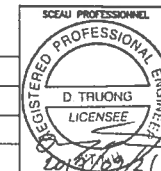

CONC: KHV DATE: 2017/04/25 DESSINE PAR: KVE DATE: 2017/04/25 VIRE PAR: - DATE: - APP: - DATE: - ECHELLE: AUCUNE	PROJET: AGNICO EAGLE - MELIADINE DIVISION 116 - FUEL TANK FARM TITRE: RANKIN INLET FABRICATION ISOMETRIC DIESEL FROM 65TNK11601 TO PUMPING STATION No PROJET 6515 No DESSIN 116-150-PDI-CC10-0011 PAGES 3/5 REV. 2
---	--

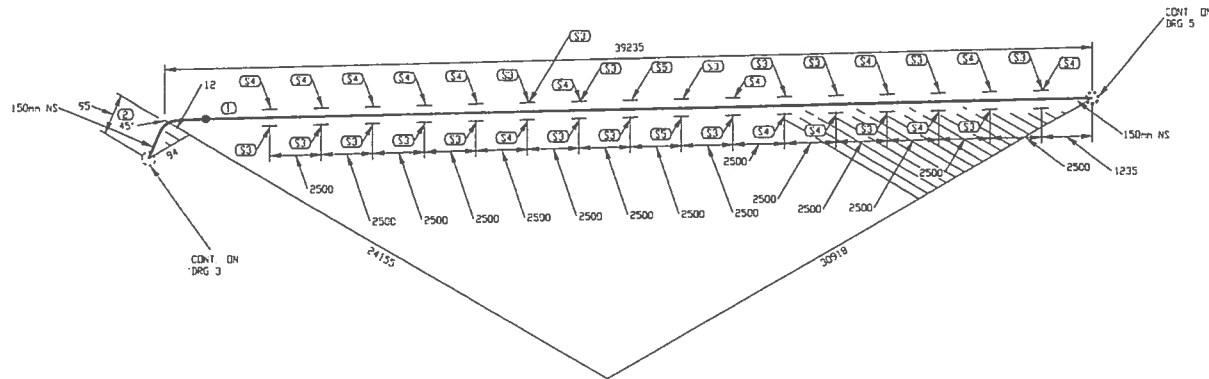

PERMIT TO PRACTICE
LE GROUPE ULTRAGEN LTÉE
Signature *[Signature]*
Date **SEP 21 2017**
PERMIT NUMBER: P 1180
NTNU Association of Professional
Engineers and Geoscientists

FABRICATION DRAWINGS BASED ON
WSP CERTIFIED ENGINEERING

LISTE DE MATERIEL				
NO	QTE	DA	MATERIEL/CATALOGUE	DESCRIPTION
1	39140 MM	150	A 333 Gr. 6	SCH STD, SMLS PIPE
2	1	150	A 420 Gr. WPL6	SCH STD, BV LR 45 DEG ELBOW
3	18	150		PIPE SHOE AS PER DETAIL 2, DWG 65-116-270-200
4	14	150		PIPE SUPPORT AS PER DETAIL 1, DWG 65-116-270-200
5	2	150		PIPE SUPPORT AS PER DETAIL 3, DWG 65-116-270-200


2	2017/09/21	PROJECT TITLE REVISED	KHV
1	2017/09/11	LINE NUMBERS REVISED	KHV
0	2017/05/15	ISSUED FOR CONSTRUCTION	KHV
NO.	DATE	REVISION	PAR APP.

CLIENT:




CONSULTANT PROJECT NO. **591700**

NO. DE CONDUITE	SPECIFICATION	PRODUIT	SYSTEME REVETEMENT	CODE DE COULEUR	ISOLATION ET TRACAGE	EPAISS. D'ISOLATION		
116-150-PDI-CC10-0011	CC10	PDI		-			65-116-270-200	PIPE SUPPORT DETAILS
PRESSION D'OPERATION	TEMPERATURE D'OPERATION	PRESSION DE CONCEPTION	TEMPERATURE DE CONCEPTION	PRESSION D'ESSAI	CLASSE D'INSPECTION	CODE DE SERVICE	TRAITEMENT THERMIQUE	65-116-205-200 P&ID
PSIG	T	PSIG	T	PSIG				No. DESSIN
								DESSINS DE REFERENCE

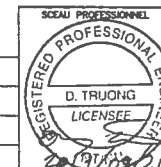

CONC.: KHV DATE: 2017/04/25 DESSINE PAR: KVE DATE: 2017/04/25 VÉR. PAR: - DATE: - APP.: - DATE: - ECHAELLE: AUCUNE	PROJECT: AGNICO EAGLE - MELIADINE DIVISION 116 - FUEL TANK FARM TITRE: RANKIN INLET FABRICATION ISOMETRIC DIESEL FROM 65TNK11601 TO PUMPING STATION No. PROJECT: 6515 No. DESSIN: 116-150-PDI-CC10-0011 PAGES: 4/5 REV: 2
--	---

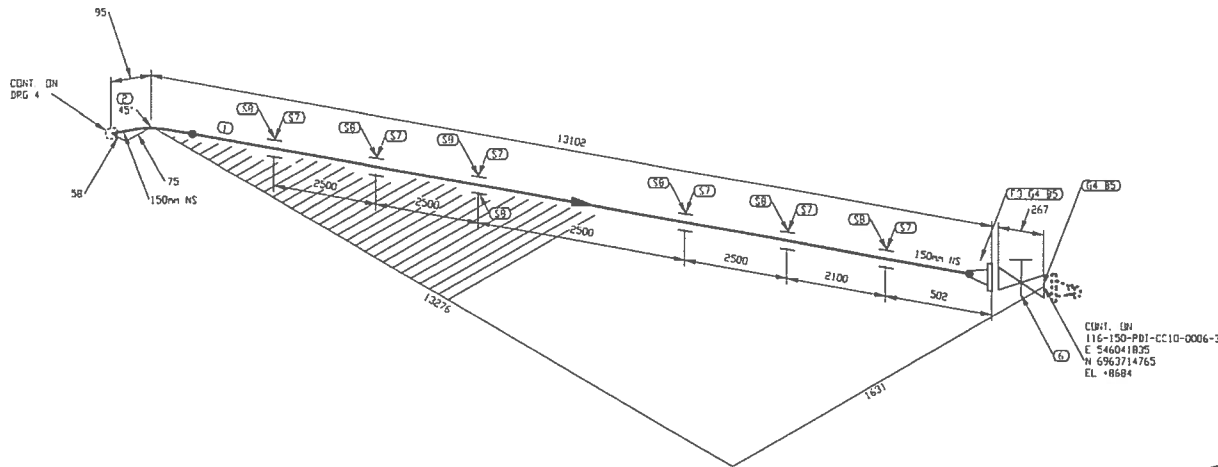

PERMIT TO PRACTICE
LE GROUPE ULTRAGEN LTÉE
Signature _____
Date **SEP 21 2017**
PERMIT NUMBER: P 1180
NTNU Association of Professional
Engineers and Geoscientists

FABRICATION DRAWINGS BASED ON
WSP CERTIFIED ENGINEERING

LISTE DE MATERIEL				
no	QTE	DA	MATERIEL/CATALOGUE	DESCRIPTION
1	12919 MM	150	A 333 Gr. 6	SCH STD, SMLS PIPE
2	1	150	A 420 Gr. WPL6	SCH STD, BV LR 45 DEG ELBOW
3	1	150	A 350 Gr. LF2	CL 150, SCH STD, RF, WN FLANGE
4	2	150	ASME B16.20	CL 150, GARLOCK 5500, RING TYPE GASKET 1/8" THK
5	16	19	A 193 B7/A 194 2H	CL 150, B - 19 05 X 100 STUD BOLTS c/w TWO HEAVY HEX NUTS
6	1	150	GA-10	CL 150, RF, GATE VALVE
7	6	150		PIPE SUPPORT AS PER DETAIL 1, DWG 65-116-270-200
8	7	150		PIPE SHOE AS PER DETAIL 2, DWG 65-116-270-200

2	2017/09/21	PROJECT TITLE REVISED	KHV
1	2017/09/11	LINE NUMBERS REVISED	KHV
0	2017/05/15	ISSUED FOR CONSTRUCTION	KHV
No.	DATE	REVISION	APP.

CLIENT:



AGNICO EAGLE




NUQSANA-PROTEC MINING




Ultragen

CONSULTANT PROJECT NO. **591700**

NO. DE CONDUITE	SPECIFICATION	PRODUIT	SYSTEME REVETEMENT	CODE DE COULEUR	ISOLATION ET TRACAGE	EPASS. D'ISOLATION	
116-150-PDI-CC10-0011	CC10	PDI		-			65-116-270-200 PIPE SUPPORT DETAILS
PRESSION D'OPERATION	TEMPERATURE D'OPERATION	PRESSION DE CONCEPTION	TEMPERATURE DE CONCEPTION	PRESSION D'ESSAI	CLASSE D'INSPECTION	CODE DE SERVICE	TRAITEMENT THERMIQUE
PSIG	T	PSIG	T	PSIG			65-116-205-200 P&ID
							No. DESSIN
							DESSINS DE REFERENCE

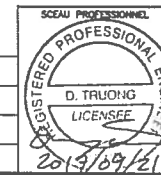

COMC.: KHV	DATE: 2017/04/23	PROJET: AGNICO EAGLE - MELIADINE DIVISION 116 - FUEL TANK FARM
DESSINE PAR: KHV	DATE: 2017/04/23	TITRE: RANKIN INLET FABRICATION ISOMETRIC DIESEL FROM 65TNK11601 TO PUMPING STATION
VOIR PAR: -	DATE: -	
APP.: -	DATE: -	
EDHELLE: AUCUNE		
No PROJET	No DESSIN	PAGES
6515	116-150-PDI-CC10-0011	5/5
		REV. 2

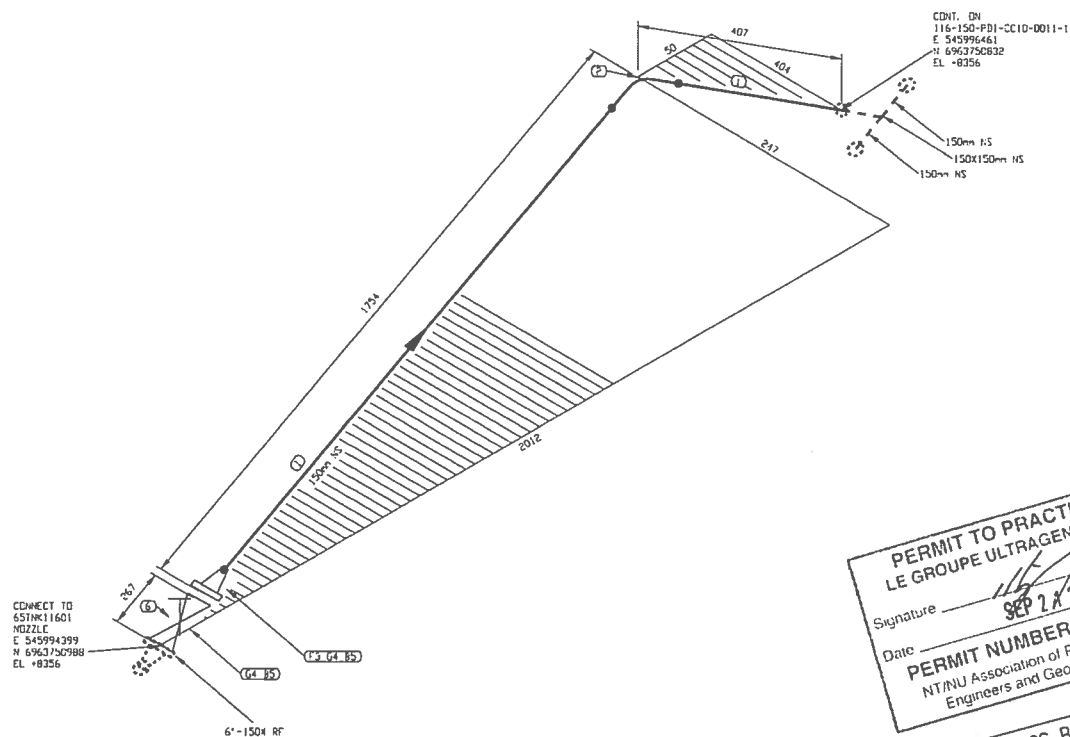


PERMIT TO PRACTICE
 LE GROUPE ULTRAGEN LTÉE
 Signature _____
 Date _____
 SEP 24 2017
 PERMIT NUMBER: P 1180
 NTNU Association of Professional
 Engineers and Geoscientists


FABRICATION DRAWINGS BASED ON
WSP CERTIFIED ENGINEERING

2	2017/09/21	PROJECT TITLE REVISED	KHV
1	2017/09/11	LINE NUMBERS REVISED	KHV
0	2017/05/15	ISSUED FOR CONSTRUCTION	KHV
No.	DATE	REVISION	PKT

CLIENT:

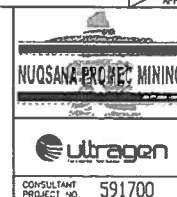

	COMC: 11/1/	PROJECT:	PROJECT NO: 07100		
	DATE: 2017/04/25	AGNICO EAGLE - MELIADINE DIVISION			
	DESIGN: PAR: 11/1/	116 - FUEL TANK FARM			
	DATE: 2017/04/25	TITLE:	RANKIN INLET		
	VDL: PAR: -	FABRICATION ISOMETRIC			
	DATE: -	DIESEL FROM 65TNK11601 TO PUMPING STATION			
APP: -		No PROJECT	No DESIGN	PAGES	REV
DATE: -		6515	116-150-PPI-CC10-0012	1/1	2
ÉCHELLE: AUCUNE					

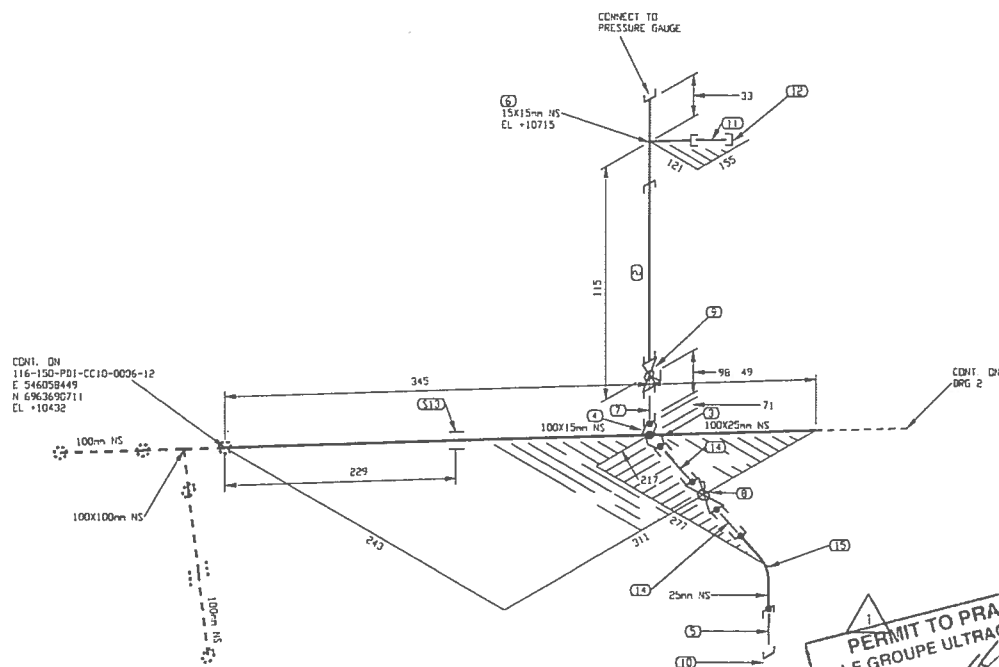

1

PERMIT TO PRACTICE
LE GROUPE ULTRAGEN LTÉE

Signature _____

Date **SEP 27 2017**

PERMIT NUMBER: P 1180
NTNU Association of Professional
Engineers and Geoscientists

FABRICATION DRAWINGS BASED ON
WSP CERTIFIED ENGINEERING

LISTE DE MATERIEL				
NO	QTE	DA	MATERIEL/CATALOGUE	DESCRIPTION
1	394 MM	100	A 333 Gr. 6	SCH STD, SMLS PIPE
2	73 MM	15	A 333 Gr. 6	SCH 80, SMLS PIPE
3	1	100X25	A 350 Gr. LF2	CL 3000, SCKOLET
4	1	100X15	A 350 Gr. LF2	CL 3000, SCKOLET
5	1	25	A 333 Gr. 6	SCH 80, NIPPLE x 75mm LG PDEWICE
6	1	15X15	A 350 Gr. LF2	CL 3000, THRD STRAIGHT TEE
7	1	15	A 333 Gr. 6	SCH 80, NIPPLE x 75mm LG PDEWICE
8	1	25	3A-29	CL 600, SW, BALL VALVE
9	1	15	3A-32	CL 600, THRD, BALL VALVE
10	1	25	A 350 Gr. LF2	CL 3000, THRD CAP
11	1	15	A 333 Gr. 6	SCH 80, NIPPLE x 75mm LG TBE
12	1	15	A 350 Gr. LF2	CL 3000, THRD CAP
13	1	100		PIPE SUPPOR* AS PER DETAIL 9, DWG 65-116-270-200
14	2	25	A 333 Gr. 6	SCH 80, NIPPLE x 75mm LG PBE
15	1	25	A 350 Gr. LF2	CL 3000, SW 90 DEG ELBOW

3	2017/09/21	PROJECT TITLE REVISED	KHV
2	2017/09/11	LINE NUMBERS REVISED	KHV
1	2017/06/30	DRAIN REVISED AS PER CLIENT COMMENTS	QVN
0	2017/05/15	ISSUED FOR CONSTRUCTION	KHV
NO	DATE	REVISION	PAR

CLIENT:




AGNICO EAGLE



CONSULTANT PROJECT NO.	591700
------------------------	--------

NO. DE CONDUITE		SPECIFICATION		PRODUIT		SYSTEME REVETEMENT		CODE DE COULEUR		ISOLATION ET TRACAGE		EPAISS. D'ISOLATION					
116-150-PDI-CC10-0018		CC10		PDI										65-116-270-200		PIPE SUPPORT DETAILS	
PRESSION D'OPERATION		TEMPERATURE D'OPERATION		PRESSION DE CONCEPTION		TEMPERATURE DE CONCEPTION		PRESSION D'ESSAI		CLASSE D'INSPECTION		CODE DE SERVICE		TRAITEMENT THERMIQUE		65-116-205-200 P&ID	
PSIG		°F		PSIG		°F		PSIG								No. DESSIN DESSINS DE REFERENCE	

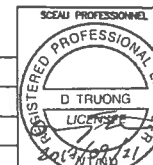

CONC: 4049	PROJECT:	PROJECT NO: 071700	
DATE: 2017/04/25	AGNICO EAGLE - MELIADINE DIVISION		
DESIGNE PAR: 4049	116 - FUEL TANK FARM		
DATE: 2017/04/25	TITRE:	RANKIN INLET	
VER. PAR: -	FABRICATION ISOMETRIC		
DATE: -	DIESEL FROM 65TNK11601 & 65TNK11602 TO 65P0011601A		
APP: -	No PROJECT	No DESIGN	PAGES
DATE: -	6515	116-150-P01-CC10-0018	1/2
RECHER: AUCUNE			REV



Vendor Document Status

AGNICO EAGLE

- 1 ☐ Proceed to next submission and status.
- 2 ☐ Proceed with exceptions as noted to next submission and status.
- 3 ☐ Do not proceed.
Revise as noted and resubmit next submission and status.
- 4 ☒ Complete, no further submission required.

By:

Jean-Francois Tremblay

Date:

2017-05-02

Review and authorization to fabricate are only for general conformance with the design concept of the Project as expressed in the Contract Documents. Sole responsibility for the accuracy and completeness of this document, including but not limited to dimensions and quantities, remains with the Supplier/Contractor. Agnico Eagle does not warrant the accuracy or completeness of any of the information contained herein, nor does Agnico Eagle authorize or approve any construction means, methods, techniques, sequences or any safety precautions or procedures.

Agnico Eagle
No.

6515-C-270-007-141-TES-0014 R: Sub001

DOCUMENT FOR INFORMATION



**Agnico-Eagle Mines Ltd.
Non-Conformance Report**

ITR Number : AEM-GE-ITR-002
Contract no. : C22466T / C22498E



PART 1 – To be completed by Originator			
ITR no. :	Supplier/Vendor/Manufacturer/Contractor :	Originator :	Date:
Equipment Identification:		Equipment Tag No.:	
Disposition Requested: ☐ 48 Hours ☐ Other	NCR Classification: ☐ Supplier ☐ Fabrication ☐ Engineering ☐ Construction ☐		
Current Status: ☐ Work Already Done ☐ Partially Done ☐ Other _____	Potential Impact (Check appropriate box and give estimate): ☐ Cost ☐ Schedule ☐ Other		
Detailed Description of Non-Conformance (attach sketch, pictures, etc) :			
Describe Deviation to Drawings, Specifications, Standard, Code or other Reference:			
PART 2 - Disposition			
* CONTRACTOR Proposed Disposition / Resolution: ☐ Use As Is ☐ Repair ☐ Rework ☐ Reject/Scrap		Concession Request No. (if applicable):	Contractors NCR No. (if applicable):
Details of Contractor Corrective Actions Proposed / Concession Request:			
* Disposition: ☐ Use as Is ☐ Repair ☐ Rework ☐ Reject/Scrap		Dispositioning Party:	Signature:
Recommended Resolution / Actions:			
PART 3 - Confirmation			
Corrective Actions Completed By: Name: Date: Signature:		Corrective Actions Accepted by Dispositioning Party: Name: Date: Signature:	
Corrective Actions Accepted by Originator: Name: Date: Signature:		NCR Closed Out By (Area QA Coordinator) Name: Date: Signature:	
* Note: Dispositions are not to be construed as a change to any Contracts which may be affected. Prior to initiating any work which will impact the Contract terms, the Contractors must forward to AMEC written notice of all impacts, including but not limited to cost and schedule. Any work completed without a written instruction to proceed, if required, will be at the Contractor's risk.			



Vendor Document Status

AGNICO EAGLE

- 1 ☐ Proceed to next submission and status.
- 2 ☐ Proceed with exceptions as noted to next submission and status.
- 3 ☐ Do not proceed.
Revise as noted and resubmit next submission and status.
- 4 ☒ Complete, no further submission required.

By: JEAN-FRANCOIS TREMBLAY Date: 2017-05-02

Review and authorization to ~~fabricate~~ are only for general conformance with the design concept of the Project as expressed in the Contract Documents. Sole responsibility for the accuracy and completeness of this document, including but not limited to dimensions and quantities, remains with the Supplier/Contractor. Agnico Eagle does not warrant the accuracy or completeness of any of the information contained herein, nor does Agnico Eagle authorize or approve any construction means, methods, techniques, sequences or any safety precautions or procedures.

Agnico Eagle
No. 6515-C-270-007-141-TES-0038 R: Sub001

DOCUMENT FOR INFORMATION



Agnico-Eagle Mines Ltd.
Contract no. 6515-C-270-007

Welding Control Procedure
AEM-WE-PRO-001

Area No.: All

System No.: All

PROMEC Approvals

Prepared by: Stéphane Doré Signature:  Date: 2017-04-26

Verified by: Jérémy Duval Signature:  Date: 2017-04-26

Approved by: Éric Poulin Signature:  Date: 2017-04-26

CLIENT Approvals

Verified by: _____ Signature: _____ Date: _____

Approved by: _____ Signature: _____ Date: _____

TABLE OF CONTENTS

	<u>Page</u>
1. SCOPE	3
2. REFERENCES	3
3. WELDING PROCEDURES	3
4. WELDER PERFORMANCE QUALIFICATION	3
5. WELDING MATERIAL CONTROL	4
6. FIT-UP AND WELDING	4
7. RADIOGRAPHIC INSPECTION	5

APPENDIX A – ALL APPLICABLE ITRs & LOGs

1. Scope

- This procedure describes the system for maintaining control of all production welding to the requirements of the applicable engineering specifications, codes and standards.

2. References

- ASME, Section IX - Welding and Brazing Qualifications
- ANSI, B-31.3 - Petroleum Refinery Piping
- ANSI, B-31.1 - Power Piping
- AWS, American Welding Society

3. Welding Procedures

- All welding performed on site will comply with applicable qualified welding procedures as specified in the Standard S40 05 13.
- Prime contractor's welders will be qualified to weld procedures in accordance with contract specifications. Prime contractor is responsible for certifying their own welders.
- Copies of the qualified welding procedures approved for that project shall be maintained on site by the Welding Foreman and Site Q/C Representative for reference and permanent retention.

4. Welder Performance Qualification

- It is the responsibility of the Site Q/C Representative to conduct or supervise the Welder Performance Qualification tests. At the discretion of the Corporate Quality Control Manager, a Welding Foreman or other qualified site supervisor may conduct these tests.
- Records attesting to the Welder Performance Qualification tests shall be generated and maintained by the Site Q/C Representative and the Welding Foreman.
- The Site Q/C Representative and the Welding Foreman shall maintain a complete listing of welders and welding operators employed. The form, Welder Qualification Log, is to be updated and reissued on a monthly basis and is to be distributed as required.



**Agnico-Eagle Mines Ltd.
Welding Control Procedure**

PRO Number : AEM-WE-PRO-001
Contract no. : C22466T



5. Welding Material Control

- The Site Q/C Representative and Welding Foreman shall make certain that the welding material used conforms to that of the welding procedure. No substitutions for the specified material will be made without written approval from the client.

6. Fit-Up and Welding

- Visual surveillance shall be performed to establish compliance to welding procedures. The inspection parameters listed below are recommended as guidelines
 - ✓ Inspect end preparation and joint configuration as established by applicable weld procedures and engineering specifications.
 - ✓ Inspect internal alignment and root opening prior to welding.
 - ✓ Check tack welds that are to be incorporated into the final weld, and be assured of proper blend grinding and absence of visual defects.
 - ✓ Check for proper welding materials and other essential variables of applicable weld procedures.
 - ✓ Check visually root pass for cracks, porosity, slag, fusion lines and quality workmanship (if required use LP).
 - ✓ Inspect completed welds for proper reinforcement. All welds should blend smoothly into the base metal and be free of cold lap or fusion at the toe.
 - ✓ Inspect weld for surface discontinuities such as undercut. Surface porosity is to be considered as an injurious defect and shall be repaired.
 - ✓ All repairs are to be made in accordance with approved procedures.
 - ✓ Each welder shall be responsible for stamping his assigned symbol immediately after completion of the weld. A smooth, flat spot shall be ground or filed on the reinforcement cap. The welder shall stamp his/hers identifying mark upon this spot.
- For ferrous material less than 1/4" (1/2" for nonferrous), the welder's symbol shall be recorded on the base metal by use of a halogen-free paint marker, or recorded on isometric drawings by the welding supervisor which shall be available to the Quality Control Inspector.

7. Radiographic Inspection

- The Site Q/C Representative or Welding Foreman will schedule radiographic inspections.
- Radiographic requirements shall be determined by the client standard to assure compliance to contract Codes and specifications.
- Welds requiring radiography will be flagged by a suitable means which will be consistent through contract completion.
- The Site Q/C Representative will complete the Radiographic Inspection Status Record, to indicate status of radio graphically-inspected welds. This form will be forwarded to appropriate supervision for distribution.
- In addition to the records generated under this procedure, marked-up isometric and orthographic drawings will be used as weld maps to indicate completion of radiographic inspection. This will allow a progressive record and give system status.

**PREMIÈRE PASSE E-6011 , 3/32
SMAW**

**REEMPLISSAGE E-7018 , 1/8-5/32
SMAW**

ACIER AU CARBONE

Procédure : P-1 , PR-1

Les titres désignent également les hommes et les femmes.


Entreprise/Company	
Construction Promec	
Adresse/Address	
369 rue Murdoch	
Rouyn-Noranda (Québec)	
(819) 797-3456	Code postal J 9 X 1 G 4

② Enregistrement provincial Provincial Registration	MS WP 8814.6
--	-----------------

③ Désignation de la méthode/Procedure Identification	
DMS N° WPS No. P1	Révision N° Revision No. 0
RMS N° PQR No. PRI	
Section du code Code section	

④ Procédé(s) de soudage Welding Process(es)	1 SMAW	Manuel/Manual ☒	Semi-auto. ☐	Auto. ☐
	2	Manuel/Manual ☐	Semi-auto. ☐	Auto. ☐
	3	Manuel/Manual ☐	Semi-auto. ☐	Auto. ☐

⑤ Joints/Joints (QW-402)	
Genre/Design	VW Fillet Chan Frein Simple Chan Frein Double
Soutien Backing	Oui ☒ Non ☒ Yes No
Matériau de soutien Backing material	P1 ou soudure
Autre Other	

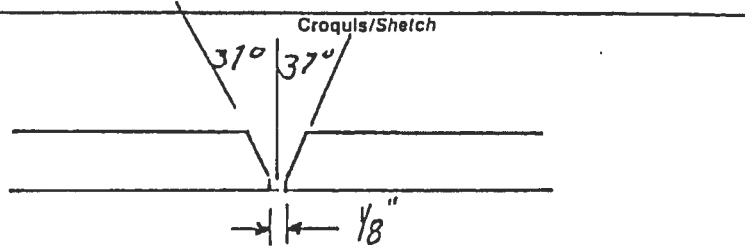

⑥ Métaux de base/Base Metals (QW-403)	
P N°/No. P1	Gr N°/No. à/to P N°/No. P1 Gr N°/No.
ou Spécifications type et grade or Specifications type and grade	
à/to	
Analyse chimique et prop. mec. Chemical Analysis and Mech. Prop.	
à/to F3 F4	
Gamme des épaisseurs qualifiées Thickness Range Qualified	
Total 3/16" à 1 1/2"	1 1/4" 2 1 1/4" 3
Autre Other	

⑦ Métaux d'apport/Filler Metals (QW-404)	
AWS N°/No. E6011	SFA 5.1 F-No. 3 A-No. 1 Dia. 3/32-1/8-5/32
AWS N°/No. E7018	SFA 5.1 F-No. 4 A-No. 1 Dia. 3/32-1/8-5/32
AWS N°/No.	SFA F-No. A-No. Dia.
Marque de commerce du flux Flux Tradename	Classification du flux-électrode Electrode-Flux Classification
Pièce insérée consommable Consumable Insert	Autre Other

⑧ Positions/Positions (QW-405)	
Position(s) du chanfrein Position(s) of Groove	Toute position
Progression du soudage Welding Progression	Montant ☒ Descendant ☒ Up Down
Position(s) de l'angle Position(s) of Fillet	Toute position
Autre Other	

⑩ Traitement thermique postsoudage/ Postweld Heat Treatment (QW-407)	
Gamme de températures Temperature Range	Aucun
Gamme de durée Time Range	
Autre Other	

⑨ Préchauffage/Preheat (QW-406)	
Température de préchauffage Preheat Temperature	Min. 60°F
Température de l'interpassage Interpass Temperature	
Maintien du préchauffage Preheat Maintenance	
Autre Other	

⑪ Gaz/Gas (QW-408)	
Composition du gaz de protection Shielding Gas Composition	
Débit du gaz Gas Flow Rate	
Composition du gaz de soutien Backing Gas Composition	
Débit du gaz Gas Flow Rate	
Composition du gaz de protection traînant Trailing Shielding Gas Composition	

Caractéristiques électriques et techniques/Electrical Characteristics and Techniques (QW-409) + (QW-410)								
Méthode(s) de soudure Process(es)	Procédé Process	Métal d'apport Filler Metal		Courant Current				Gamme de vitesse Travel Speed Range
		Classification Classification	Diamètre Diameter	Type Type	Polarité Polarity	Gamme d'ampérage Amp Range	Gamme de voltage Volt Range	
à	SHAW	E6011	1/8" à 5/32"	DC	Inversé	75 - 85	26-30	--
à	SHAW	E7018	1/8" à 5/32"	DC	Inversé	105 - 110	26-30	--

Taille et type d'électrode de tungstène
 Electrode Size and Type: --

Mode de transfert du métal pour GMAW
 Metal Transfer for GMAW: --

Longueur de la goutte ou oscillant
 Bead or Weave Bead: Droit et oscillant

Mode de gougeage arrière
 Back Gouging: Arc Air

Nettoyage initial et entre les passes (brossage, meulage, etc.)
 Initial and Interpass Cleaning (Brushing, Grinding, etc.): Brossage ou meulage

Taille de la tuyère à gaz
 Gas Cup Size: --

Largeur
 Width: --

Fréquence
 Frequency: --

Distance entre tuyère & pièce
 Torch to Work Distance: --

Nombre de passes (par côté)
 Single Pass (per Side): --

Mode unique ou multiple
 Single or Multiple Electrode: --

Gamme de vitesse d'alimentation de l'électrode
 Wire feed speed range: --

Pas de martelage

Autres commentaires/Supplementary Comments

Signature du représentant de l'entreprise
Company Representative's Signature: Donald H. Catil

Date
Date: 15 janv. 88

Réservé au ministère/Department use only

Date: 1/20/88

QC MINISTÈRE DU TRAVAIL ET DE LA MAIN-D'OEUVRE

APPROUVÉ

SECON LA LOI SUR LES STANDARDS DE TRAVAIL

SOUS PRESS. J.M.T.

VÉRIFIÉ PAR: [Signature]

DATE: 01/23

Illes désignent également les hommes et les femmes.

(Référence: ASME Section IX)

1 Entreprise/Company			
Nom/Name: Construction Promec			
Adresse/Address: 369 rue Murdoch			
Rouyn-Noranda (Québec)			
819-797-3456		Code postal J 9 1 X 1 G 4	
4 Procédé(s) de soudage/Welding Process(es)			
SMAW		Type: Manuel	
		Type:	
		Type:	
3 Métaux de base/Base Metals (QW-403)			
No. 1	Gr No.	à/to	P No. 1 Gr No.
Spécification/Specification		Tension/Tensile	
SA - 516 - 70		70 000	
épaisseur thickness: 3/4"		Diamètre/Diameter	
1 Métaux d'apport/Filler Metals (QW-404)			
Classification (AWS)	SFA - No.	F - No.	A - No.
E-6011	5.1	3	1
E-7018	5.1	4	1
3 Positions/Positions (QW-405)			
Position(s) du joint Position(s) of Groove: 1 - G			
Progression du soudage Welding Progression		Montant Up ☐	Descendant Down ☐
3 Préchauffage/Preheat (QW-406)			
Température de préchauffage Preheat Temperature: 60°F			
Température de l'interpasse Interpass Temperature			

2 Enregistrement provincial Provincial Registration		MS WP 8814.6
3 Désignation du résultat/Record Identification		
RMS N° PQR No.: PR-1		
DMS N° WPS No.: P -1		
5		
Croquis du joint utilisé/Groove Design used		
10 Traitement thermique postsoudage/ Postweld Heat Treatment (QW-407)		
Température Temperature: aucun		
Durée Time		
Autre Other		
11 Gaz/Gas (QW-408)		
Composition du gaz de protection Shielding Gas Composition: --		
Débit du gaz Gas Flow Rate		
Composition du gaz de soutien Backing Gas Composition		
Débit du gaz Gas Flow Rate		
Autre Other		
12 Technique/Technique (QW-410)		
Cordon droit ou oscillant String or Weave Bead: droit		
Oscillation Oscillation		
Passe unique ou multiple (par côté) Multipass or Single Pass (Per Side): multiple		
Électrode unique ou multiple Single or Multiple Electrode: unique		
Autre Other		

3 Caractéristiques électriques et techniques/Electrical Characteristics and Technique (QW-409) + (QW-410)								
Couche(s) de soudeur Welder(s)	Procédé Process	Métal d'apport Filler Metal		Courant Current			Voltage Volt	Vitesse Travel Speed
		Classification	Diamètre Diameter	Type Type	Polarité Polarity	Ampérage Amp		
Préchauffage	SMAW	E-6011	1/8	DC	Inverse	85	26-30	-
Interpasse	SMAW	E-7018	1/8	DC	Inverse	105	26-30	-



Caractéristiques électriques et techniques/Electrical Characteristics and Technical Data (QW-409) + (QW-410)								
Méthode(s) de soudure Welding Method(s)	Procédé Process	Métal d'apport Filler Metal		Courant Current				Gamme de vitesse Travel Speed Range
		Classification	Diamètre Diameter	Type Type	Polarité Polarity	Gamme d'ampérage Amp Range	Gamme de voltage Volt Range	
SHAW	SHAW	E6011	1/8" à 5/32"	DC	Inverse	75 - 85	26-30	--
SHAW	SHAW	E7018	1/8" à 5/32"	DC	Inverse	105 - 110	26-30	--

tailleur et type d'électrode de tungstène Tungsten Electrode Size and Type	--
mode de transfert du métal pour GMAW Metal Transfer for GMAW	--
son droit ou oscillant Weave or Oscillating	Droit et oscillant
mode de gougeage arrière Back Gouging	Arc Air
nettoyage initial et entre les passes (brossage, meulage, etc.) Initial and Interpass Cleaning (Brushing, Grinding, etc.)	Brossage ou meulage
tailleur de la tuyère à gaz Gas Cup Size	--
largeur Width	--
fréquence Frequency	--
distance entre tuyère & pièce Work Distance	--
single ou multiple (par côté) Single Pass (per Side)	--
électrode unique ou multiple Single or Multiple Electrode	--
gamme de vitesse d'alimentation de l'électrode Wire Feed Speed Range	--
martelage Peening	Pas de martelage

Autres commentaires/Supplementary Comments

Reviewed and accepted by Construction Prover Inc. QC Manager
Date: MARCH 29, 2007 Signed: Jean-Guy Bisson, eng

Signature du représentant de l'entreprise
Company Representative's Signature: Donald Latil
Date: 15 janv. 88

Réservé au ministère/Department use only
Date: 8/25/88

