

Agnico Eagle Mines Ltd/Meliadine Division

Paste Line C

Meliadine Site, Rankin Inlet, NU

Technical Report

Construction Summary Report for Paste Line C - Piping

BBA Document No.-Rev.: 5287324-010001-40-ERA-0002-R0

AEM Document No.-Rev.: 6537-584-132-REP-005_R0

June 6, 2025

FINAL

100, du Lac Avenue, Suite 200

Rouyn-Noranda, QC, J9X 4N4

T + 1 873 770-2111

BBAconsultants.com All rights reserved. © BBA

Client Project No.: 6537



Prepared by:
Dominik Lapierre, P.Eng.
OIQ No. 6020193

Approved by:
Louis-Francois Gagnon, P.Eng.
NAPEG No. L3183

Approved by:
Valérie Houle, P.Eng.
NAPEG No. L3241

Approved by:
Joel Bournival, P.Eng.
Client – Engineering Superintendent
Agnico Eagle Mines Limited



REVISION HISTORY

Revision	Document Status – Revision Description	Date
R0	Final	2025-06-06

This document has been prepared by BBA for its Client and may be used solely by the Client and shall not be used nor relied upon by any other party or for any other purpose without the express prior written consent of BBA. BBA accepts no responsibility for losses, claims, expenses, or damages, if any, suffered by a third party as a result of any decisions made or actions based on this document.

While it is believed that the information contained herein is reliable under the conditions and subject to the limitations set forth in the document, this document is based on information not within the control of BBA, nor has said information been checked by BBA, and BBA, therefore, cannot and does not guarantee its sufficiency and accuracy. The comments in the document reflect BBA's best judgment in light of the information available to it at the time of preparation.

Use of this document acknowledges acceptance of the foregoing conditions.



TABLE OF CONTENTS

1. Introduction	1
1.1 Project overview	1
1.2 Purpose of the report	1
1.3 Construction schedule	1
2. Construction summary.....	1
2.1 Paste Line C – Construction activities.....	2
2.2 Works Limit.....	4
2.3 Construction monitoring.....	4
3. Compliance with code	5

LIST OF TABLES

Table 1: Codes and standards list	5
---	---

LIST OF FIGURES

Figure 1: Paste Line C installed – Aerial view.....	2
Figure 2 : Expansion loop and borehole connection	3
Figure 3: Installation of the pipe supports.	4

APPENDICES

Appendix A:	General Arrangement – Paste Line C – 65-584-210-003-2-R2
Appendix B:	Pipe Supports Details – Paste Line C - 65-584-245-008-1-R2
Appendix C:	P&ID – 584-Paste Plant - 65-584-205-201-2-R8



1. Introduction

1.1 Project overview

Agnico Eagle (AEM) is operating the Meliadine Gold Mine located near the western shore of Hudson Bay in the Nunavut Territory, 32 km north of Rankin Inlet. They have a Paste Plant building on their site to make the mix of cement and tailings called “paste”. The paste is distributed from the surface to the underground network using pipelines and boreholes. The paste is used for backfilling in the underground mine. There are already two pipelines (A and B) to feed the underground, but a third one will be necessary to ensure sufficient distribution.

The main objective of the project was to install the “Paste Line C” that connects the Paste Plant to a new borehole. The new granular pad has already been submitted and presented in the construction summary report for “Paste Line C” Pad - 6537-584-123-REP-004.

1.2 Purpose of the report

This report aims to present the construction summary for the piping of the Paste Line C. The work includes the pipe supports, piping, insulation, heat tracing, and temperature sensor. This document includes drawings issued for as-built (Appendix) as specified under Nunavut Water Board (NWB) Water License 2AM-MEL 1631.

1.3 Construction schedule

The construction started in September 2024 and was completed by the end of the same year.

2. Construction summary

Figure 1 presents an aerial view of the new Paste Line C. The Paste Line C has an approximate length of 220 m. The piping line number is 200-SPB-CH1-0014 (See appendix C).

The following activities have been completed for the piping installation:

- Placing and burying the pipe supports in the ground;
- Placing and welding the pipe together;
- Putting the pipe through the casing under the road;

- Welding the pipe shoes in position;
- Performing pressure tests;
- Performing weld examination;
- Installing the heat tracing and the temperature sensors;
- Installing the fibreglass insulation;
- Connection at the Tie-In point.



Figure 1: Paste Line C installed – Aerial view

2.1 Paste Line C – Construction activities

2.1.1 Piping

The installation for the pipe from tie-in point TP01 to TP02 has been completed. The design criteria used are from AEM's pipe specifications (document numbers 60-000-270-GGD-001-R3 and 60-000-270-GGD-002-R0). The as-built route is shown in the drawing 65-584-210-003 - General Arrangement in Appendix A.

The pipes are sitting on supports using pipe shoes. The connection point inside the Paste Plant is bolted flanges. The same mechanical joint will be used for the connection point at the Borehole entry. The connection between each pipe section is butt welded or bolted in accordance with the drawings issued for construction.

The expansion loop was built in accordance with the Isometric drawings. The picture in Figure 2 shows the expansion loop and the connection at the borehole.



Figure 2 : Expansion loop and borehole connection

Being an outdoor pipeline, insulation is used for freeze protection. The insulation selection is made using the AEM's General Guideline for Design – Insulation of Piping, Tanks and Equipment (60-000-270-GGD-003-R0). The selected solution is of heat tracing and fibreglass insulation. It is designed to maintain a minimum fluid temperature of 4°C in all conditions.

2.1.2 Structure – Pipe support

The pipe supports are made of structural steel. The design criteria used are from the AEM's Structural Design Criteria (60-000-245-GGD-002-R0) and Site Information and Design Coefficients (60-000-100-GGD-001-R1). The as built is shown in the drawing 65-584-245-008-1 in Appendix B. The pipe supports were made in factory before being shipped to the Meliadine site.

The pipe supports are partially buried in the new pad. Any displacement after installation can be corrected using shims and spacers to adjust the height between the pipe shoe and the pipe support. Upon verification with the geotechnical report, the vertical and lateral support of the structure are assumed by the structural pad. The pictures in Figure 3 show the pipe support Type 1 installation.

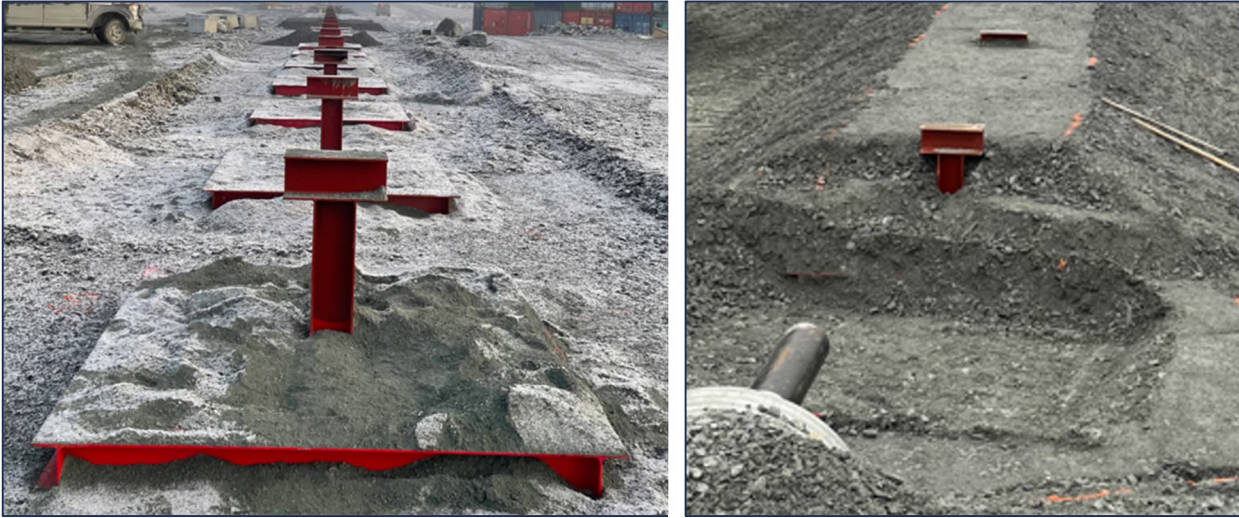


Figure 3: Installation of the pipe supports.

The casing under the road has been changed for a longer one. It created the need to replace one pipe support (red) by a support inside the casing as in drawing 65-584-210-003 – Section B. It does not impact the design as it respects the maximal span between two supports.

2.1.3 Electric and ATI

The piping system outside the building is heat traced. Also, an additional temperature sensor has been installed for monitoring temperature directly through an existing PLC.

2.2 Works Limit

The Paste Line C limits are from the borehole (TP01) to the Paste Plant (TP02).

2.3 Construction monitoring

A quality control program was followed during the construction by the project supervisor. The following quality control (monitoring) activities have been completed:

- Survey to validate the position of all pipes supports in accordance with the construction drawings;
- Inspection of pipe welding using an approved methodology;



- Leak and pressure tests (hydrostatic) were done after the installation of the pipeline;
- Pre-operational verification on the heat tracing and the electric line.

Qualified Agnico Eagle personal was responsible for the quality insurance on site.

3. Compliance with code



Table 1 below presents a summary of the codes and standards that were respected for the activities related to the project.

Table 1: Codes and standards list


	Code number	Title
Piping	ASME – B31.3	Process piping
	CSA – B51	Boiler, pressure vessel, and pressure piping code
	NBC 2015	National Building Code of Canada
Structural steel	CSA - S16	Design and construction of steel structures
Concrete	CSA - A23.3	Design of concrete structures
Electric and ATI	CSA - C22.1	Canadian Electrical Code, Part I, Safety Standard for Electrical Installations
	CSA - C22.2 No.03	Test Methods for Electrical Wires and Cables
	CSA - M421	Use of Electricity in Mines
	CSA - Z462	Workplace Electrical Safety




Appendix A: General Arrangement – Paste Line C – 65-584- 210-003-2-R2

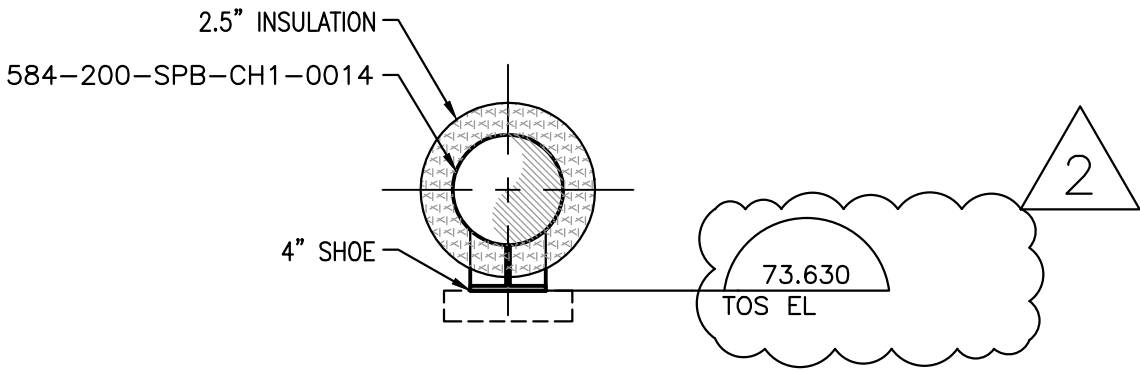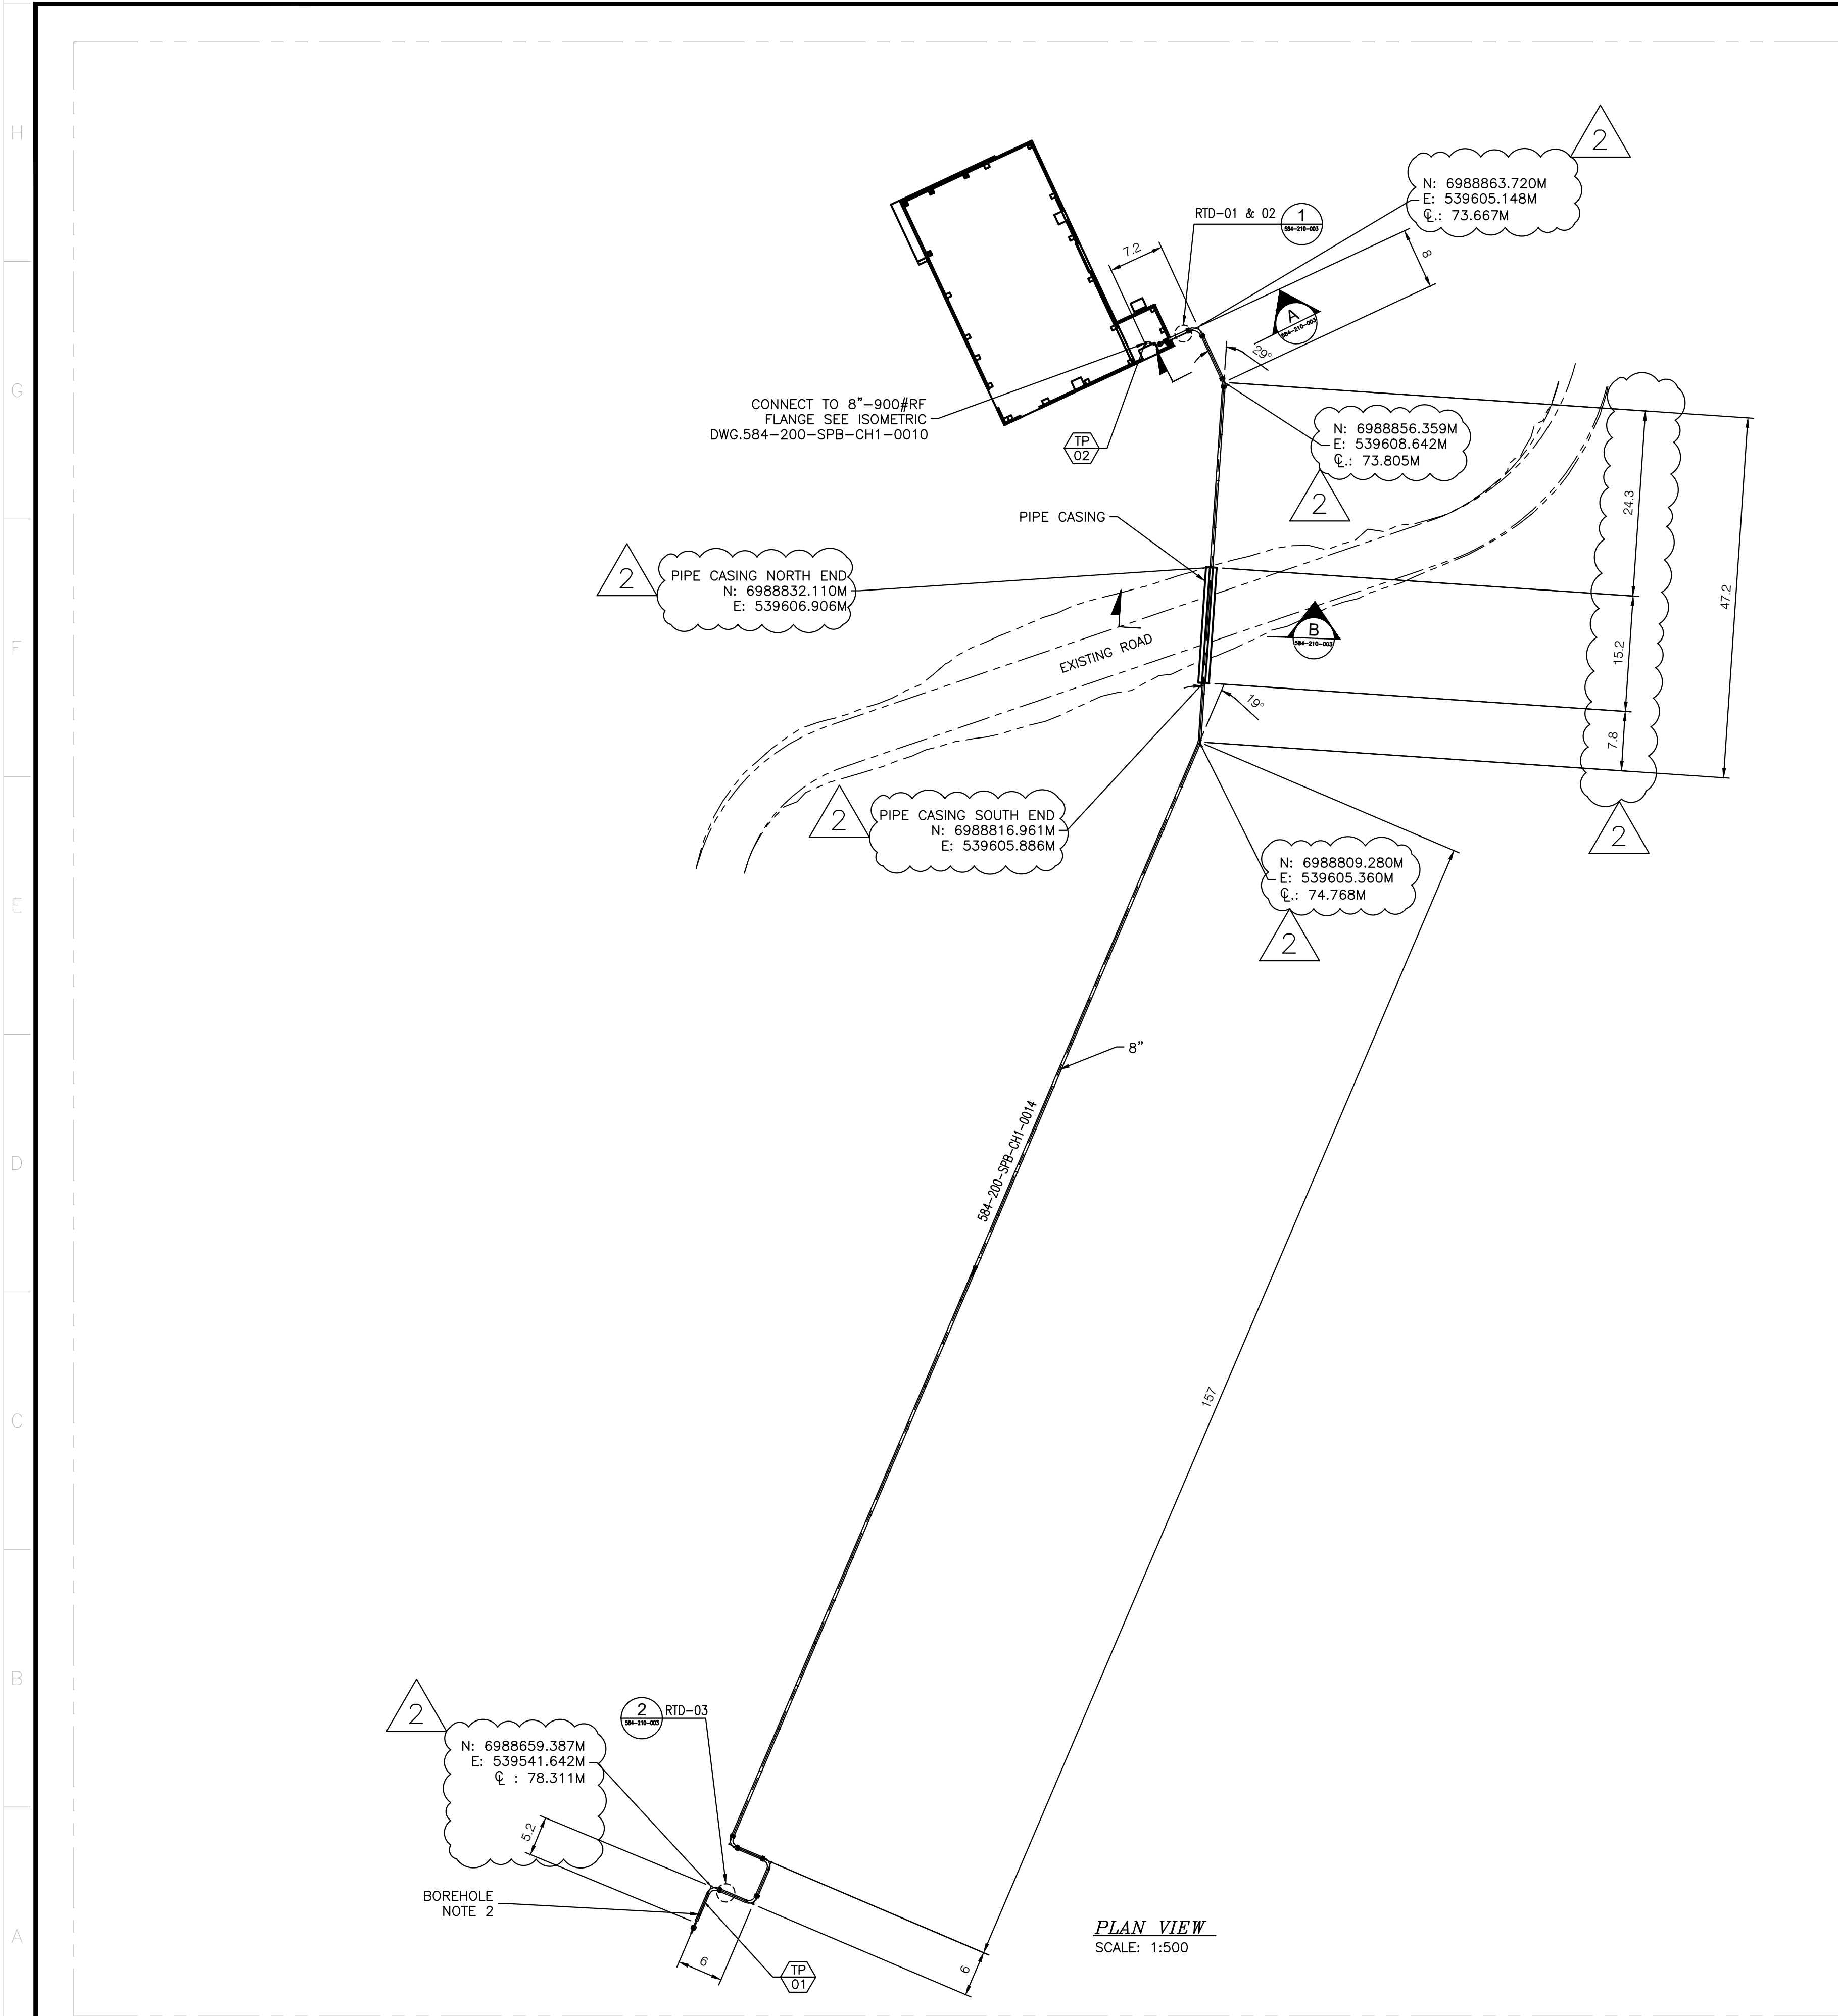

SECTION A
ECH: 1:15

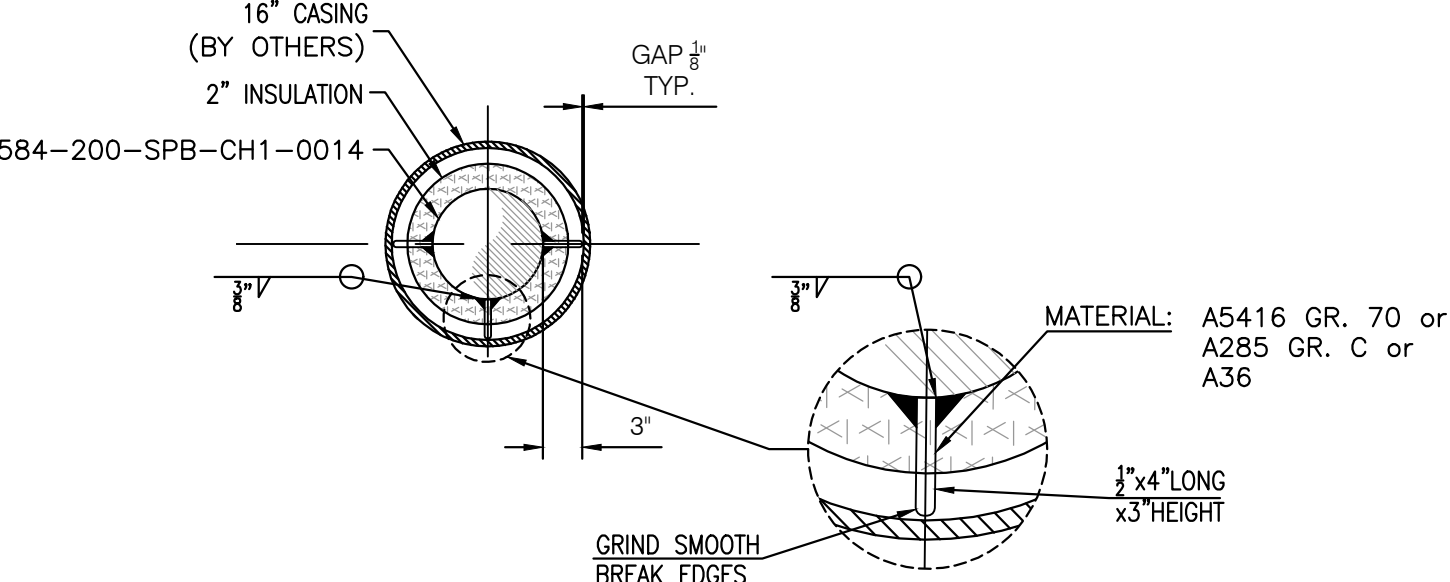


SECTION B
ECH: 1:15

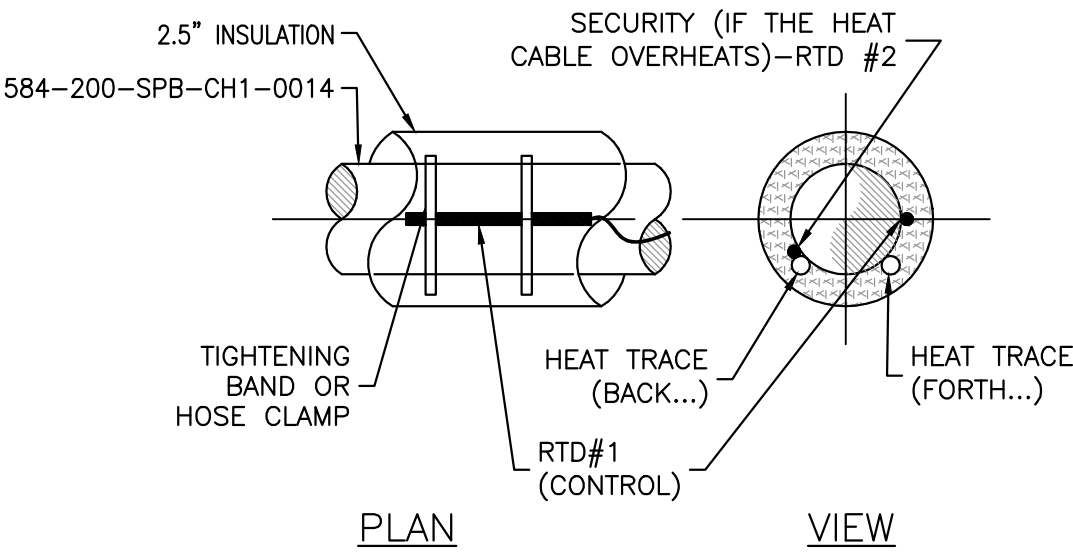

PLAN VIEW



DETAIL 1
ECH: 1:15
QTE: 2
RESISTANCE TEMPERATURE DETECTOR (RTD 01 & RTD 02)

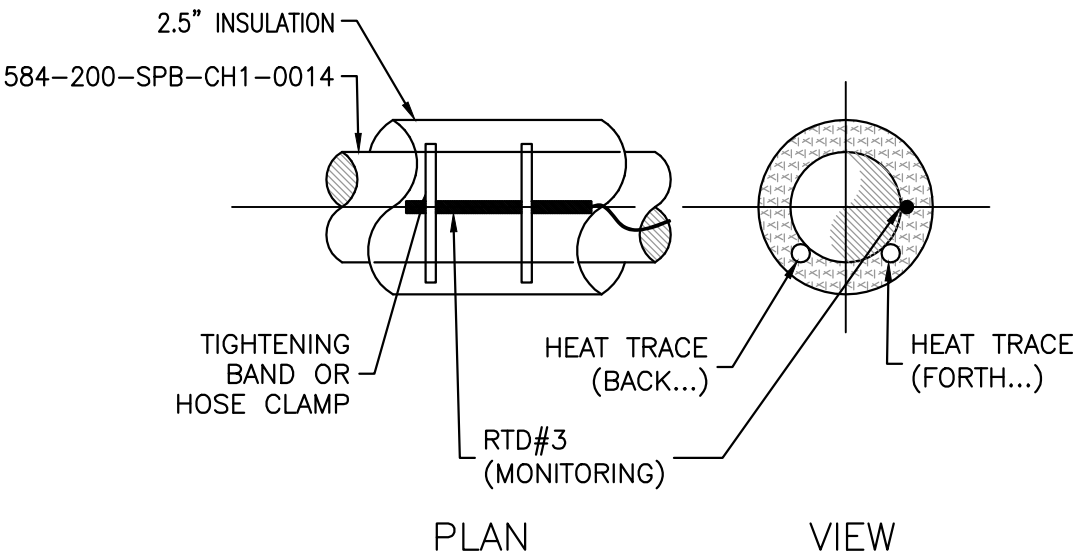

PLAN VIEW

DETAIL 2
ECH: 1:15
QTE: 1
RESISTANCE TEMPERATURE DETECTOR (RTD 03)

TEL QUE CONSTRUIT
AS BUILT
DATE : 2025-04-14

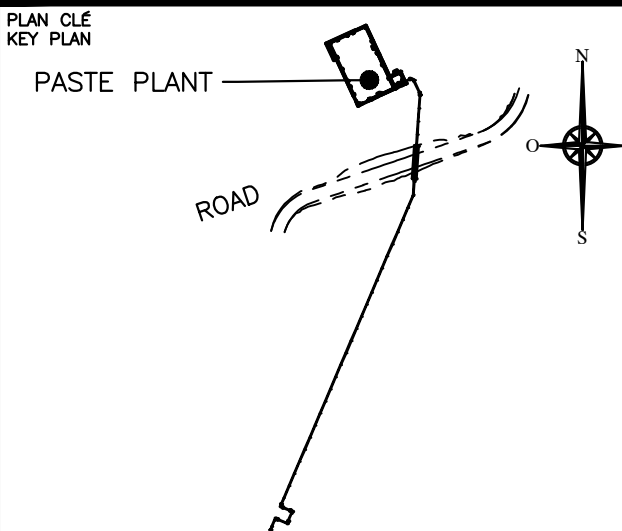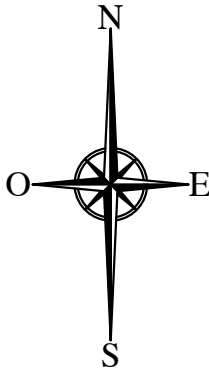

#5287324

NOTES GÉNÉRALES / GENERAL NOTES

- ALL DIMENSIONS ARE IN METERS, UNLESS NOTED OTHERWISE.
- FOR DETAIL INFORMATION OF BOREHOLE SEE WSP CANADA DWG 23595000-4000-S-1002.
- ALL MATERIAL MUST BE AS PER PIPING SPECIFICATION CH1 IN 60-000-270-G00-001 REFER TO 6537-S-270-032-MIT-000 FOR B.O.M. REQUIREMENT.
- SUPPORT DETAIL CAN BE FOUND UNDER PIPE SUPPORT SPECIFICATION 6537-S-245-008-SPT-001.
- INSULATION IN ACCORDANCE TO THE LINE LIST 6537-584-270-PPL-001 AND SPECIFICATION 60-000-270-G00-003.
- LOCATE THE RTD AT LEAST 1.5 METERS FROM THE END/START OF THE HEAT TRACE INSTALLATION.
- COORDINATE SYSTEM IS UTM15-W083. COORDINATES ARE SHOWN AS REFERENCE ONLY. VALIDATION ON SITE MUST BE DONE.
- STRUCTURAL STEEL PIPE SUPPORT DETAILS TO BE FOUND ON 65-284-245-008-1.

L'INFORMATION D'ORDRE EST LA PROPRIÉTÉ DE AGNICO EAGLE LTD ET DOIT ÊTRE RETENUE PAR VOUS. SANS AUTORISATION ÉCRITE, VOUS NE DEVEZ PAS REPRODUIRE, COPIER, RÉPLIQUER, NI TRANSMETTRE À AUTRIER. TOUTE VIOLATION DE CES CONDITIONS D'UTILISATION EST PUNIE PAR LA LOI. L'AGNICO EAGLE LTD.

DESSINS EN RÉFÉRENCE / REFERENCE DRAWINGS

TITRE / TITLE	# DWG
PASTE PLANT - TOP VIEW, SECTION & ISOMETRIC VIEWS	584-200-SPB-CH1-0010
PASTE PLANT - STRUCTURAL STEEL - PIPE SUPPORT DETAILS	65-584-245-0008
GENERAL DRAIN WORKS - PLAN VIEW, SECTIONS AND DETAILS	65-584-230-0003
ISOMETRICS	65-584-200-SPB-CH1-0014



REV.	DATE	DESCRIPTION	PAR/REV	APP.	CLIENT
2	2025-04-14	ISSUED FOR AS-BUILT	D.L.	L.G.	
1	2024-09-12	ISSUED FOR CONSTRUCTION	G.F.	L.G.	
0	2024-08-22	ISSUED FOR CONSTRUCTION	G.F.	L.G.	

REVISIONS

TITRE / TITLE
AGNICO EAGLE - MELIADINE DIVISION
584 - PASTE PLANT
210 - GENERAL ARRANGEMENT
PLAN VIEW AND DETAILS
PIPING PASTE LINE C


DESSINÉ PAR DRAWN BY	GABRIEL FERNANDEZ	DATE 2024-08-22
REVU PAR REVIEWED BY	DOMINIK LAPIERRE, P.ENG.	2024-08-22
VÉRIFIÉ PAR VERIFIED BY	LOUIS-FRANÇOIS GAGNON, P.ENG.	2024-08-22
ÉCHELLE SCALE	1:500	DATE 2024-08-22

NO. DESSIN
PROJECT NO. 65-584-210-003

NO. PROJET PROJECT NO.	REVISION	FEUILLE / SHEET
6537	2	2 / 2




Appendix B: Pipe Supports Details – Paste Line C - 65-584- 245-008-1-R2

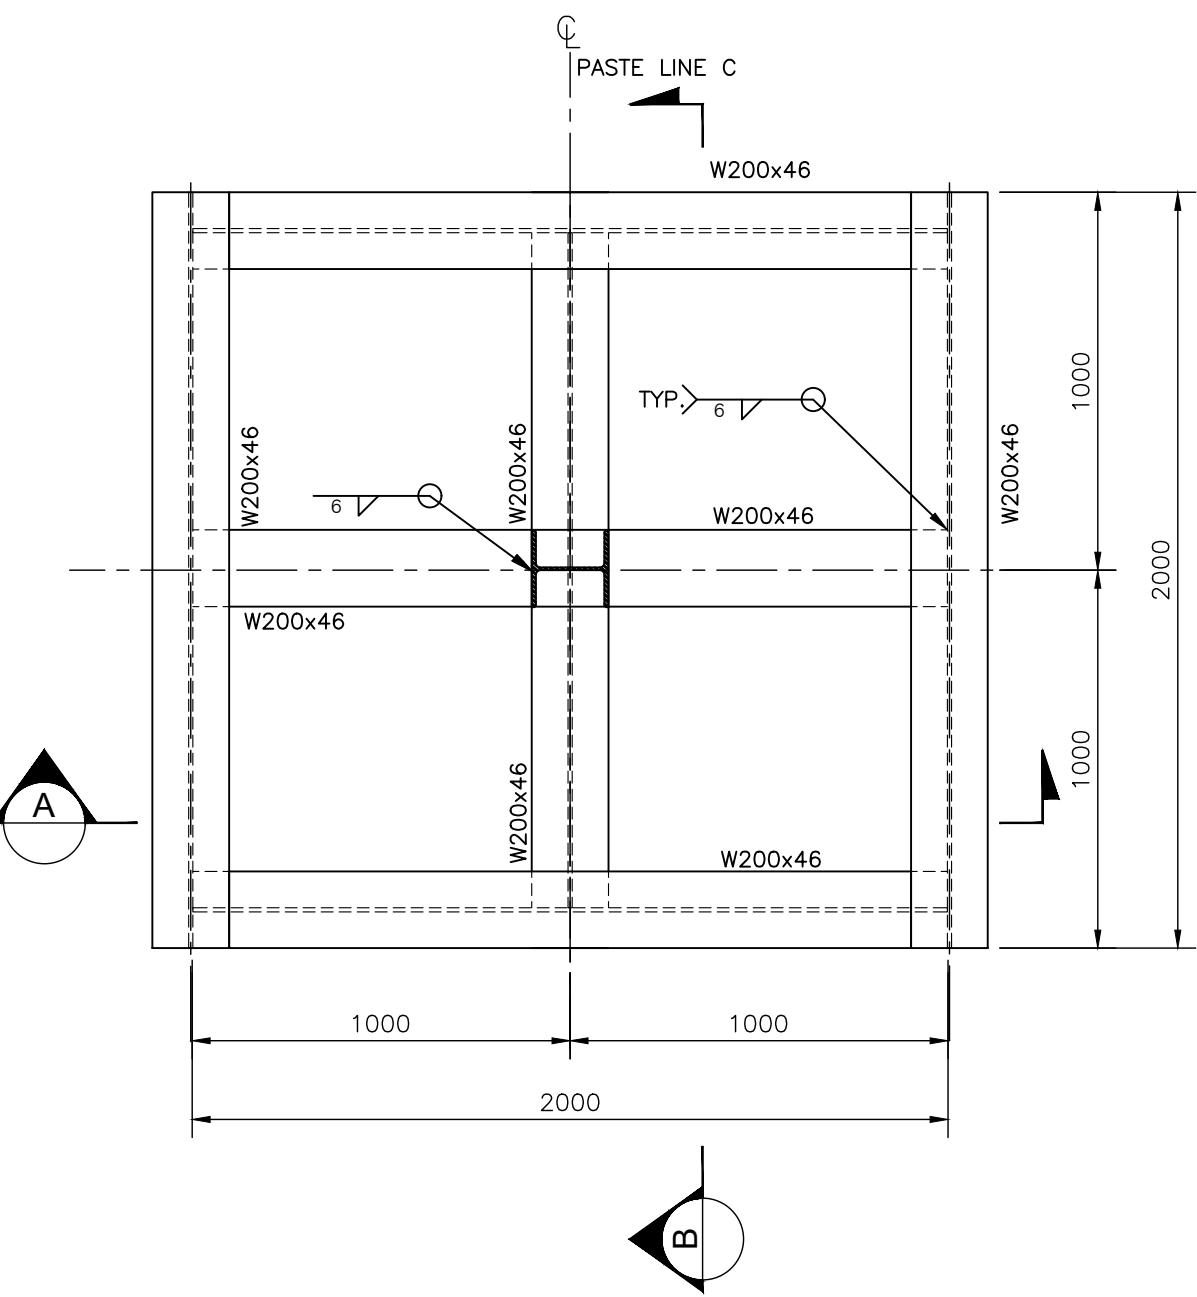


SUPPORT TYPE 1 - PLAN VIEW
SCL:1/20

(52 REQ)

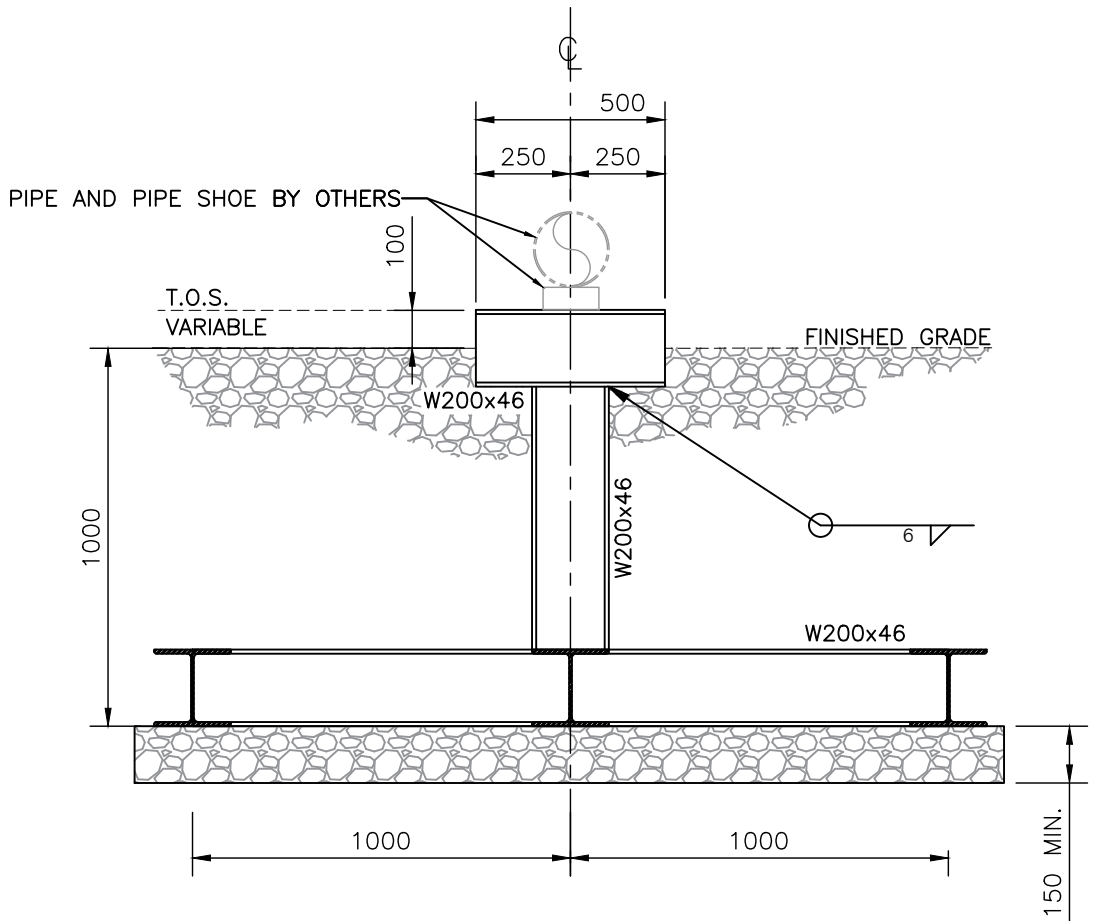


SECTION A
SCL:1/20


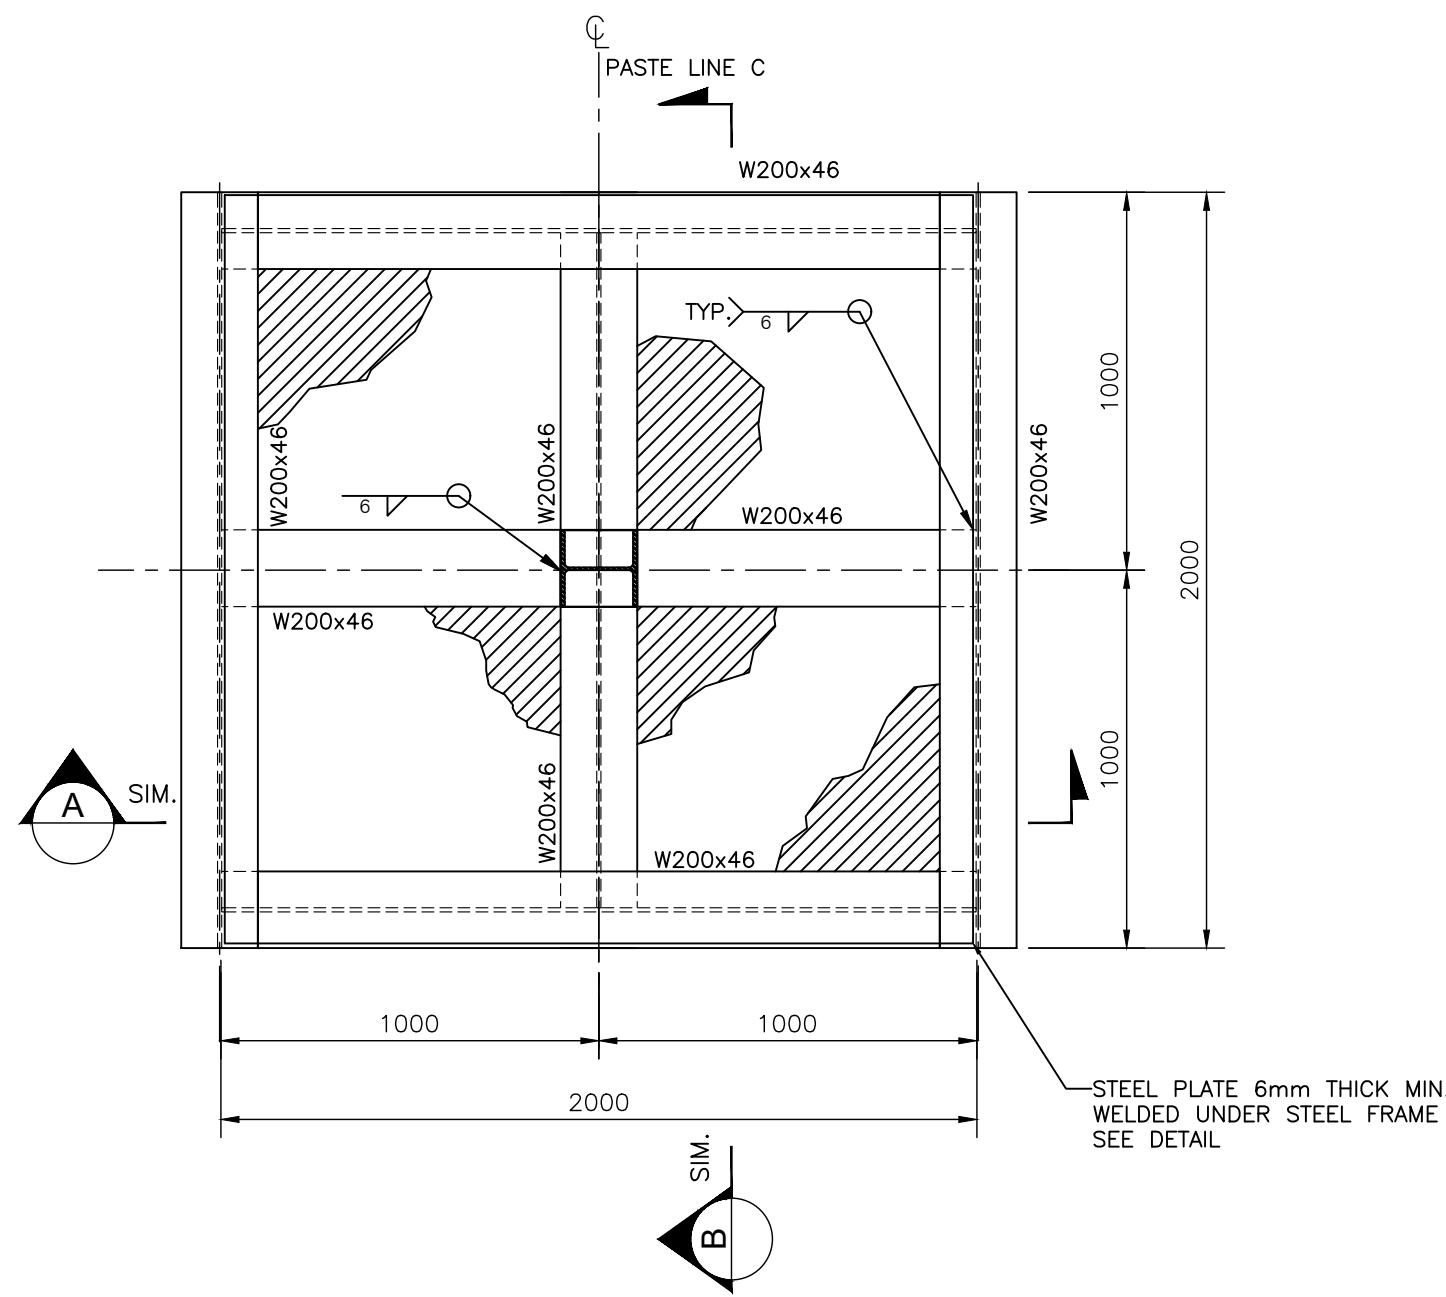


SUPPORT TYPE 2 - PLAN VIEW
SCL:1/20


(4 REQ)
- SUPPORT TYPE 2 REQUIRED AT SUPPORT #11, #41, #42 AND #43 (SEE DRAWING 65-584-210-003-1 & 65-584-210-003-2 FOR SUPPORT LOCALISATION)

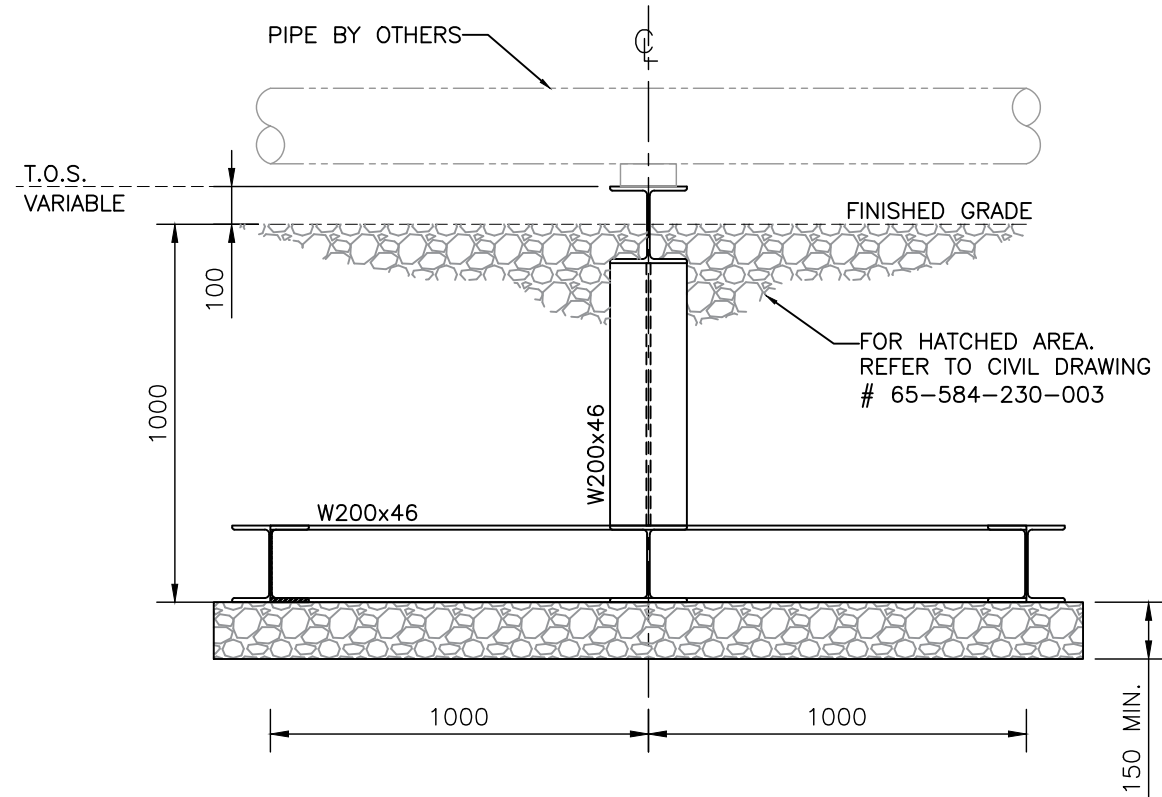


SECTION B
SCL:1/20

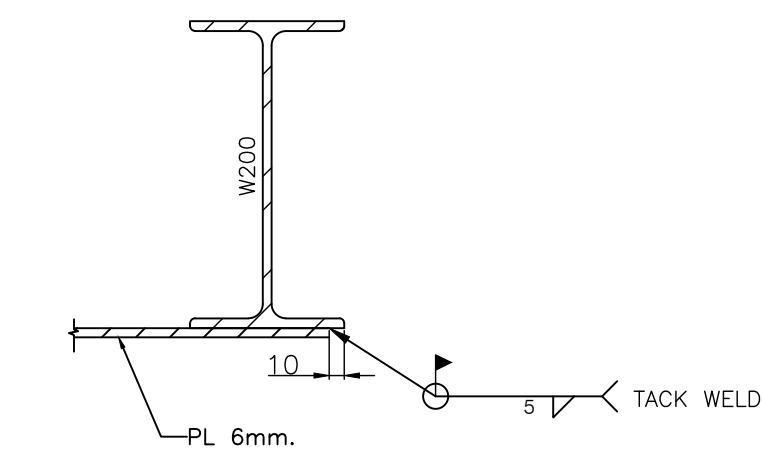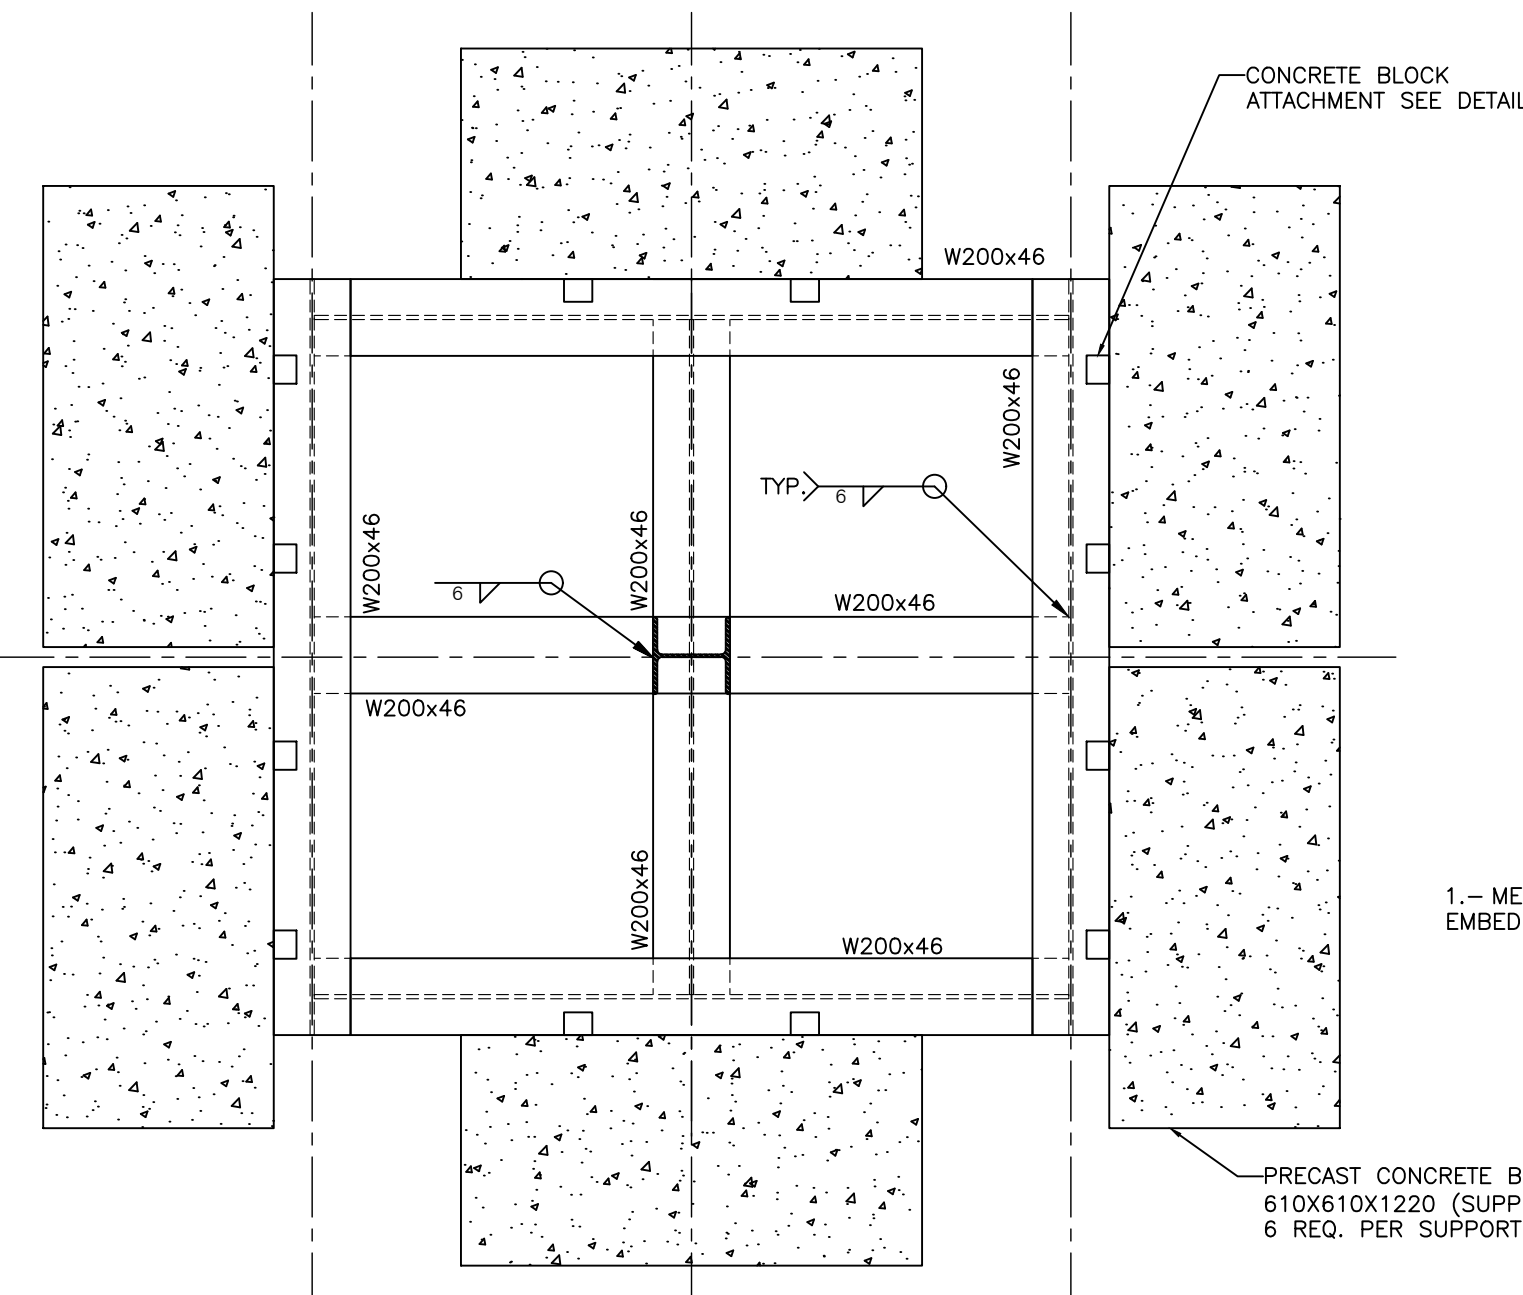

DETAIL - STEEL PLATE ASSEMBLY
SCL:1/20

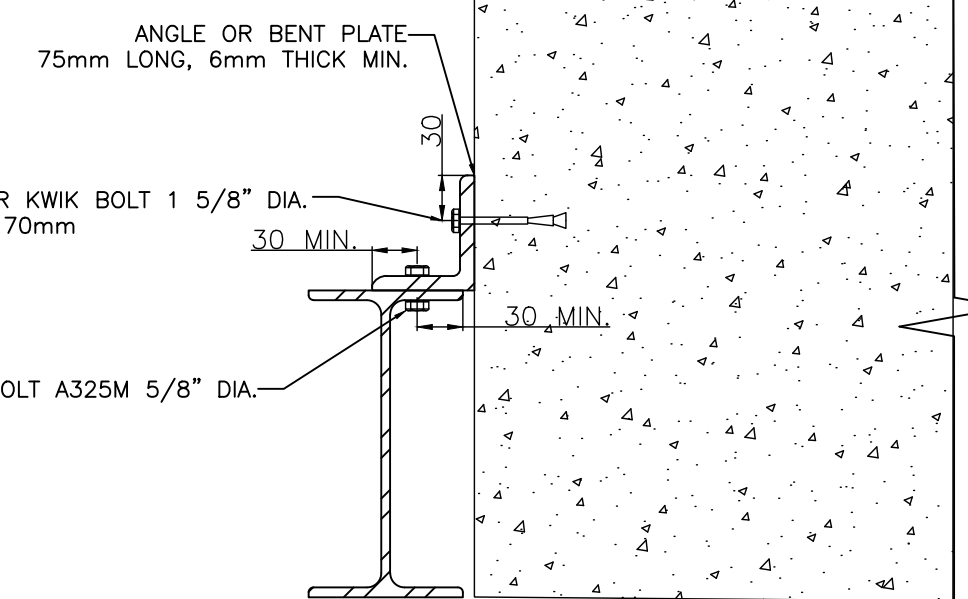

DETAIL - CONCRETE BLOCK ATTACHMENT
SCL:1/20
- 2 REQUIRED PER BLOCK

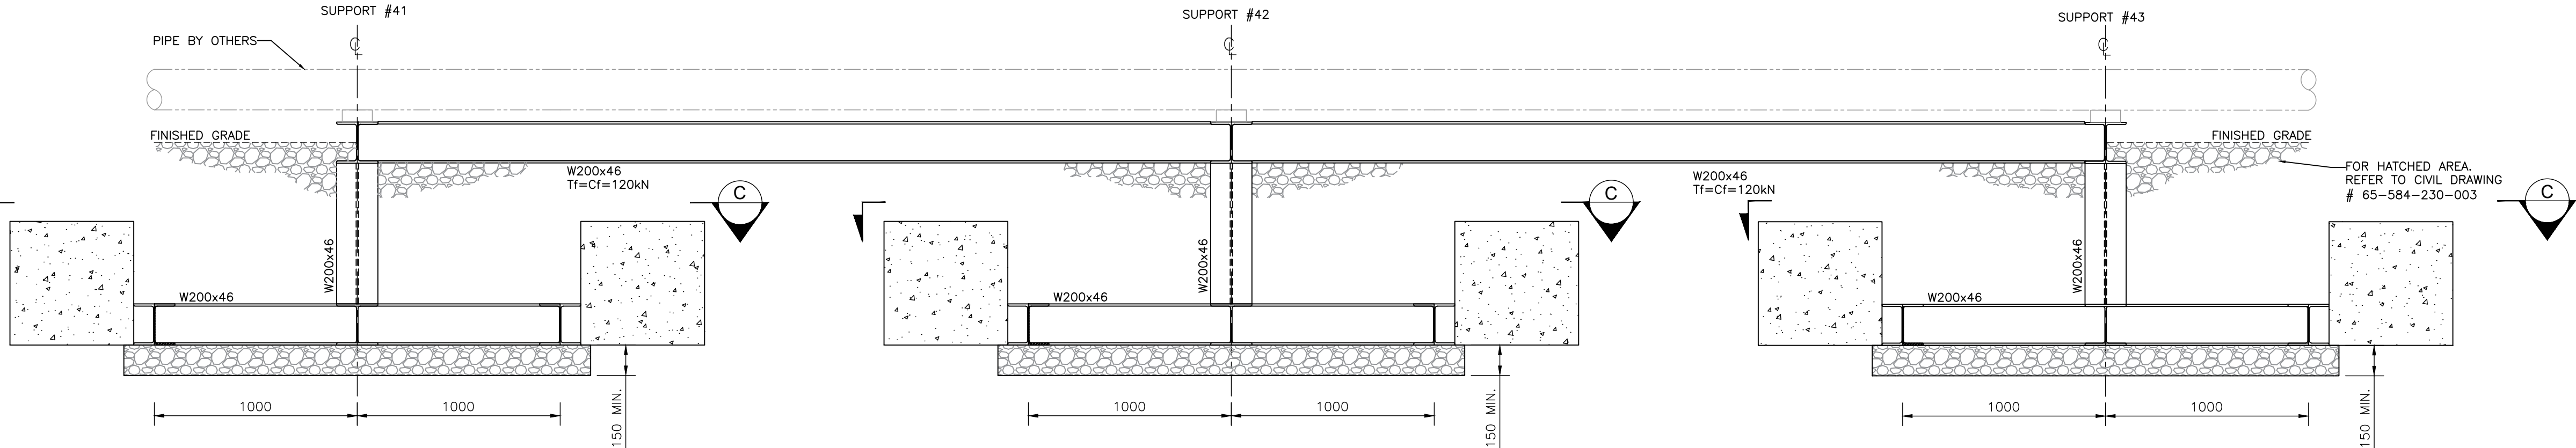

SUPPORT ASSEMBLY - SUPPORT #41, #42, #43
SCL:1/20
- THE BEAM CONNECTED BETWEEN THE SUPPORTS MUST BE SITTING DIRECTLY ON COMPACTED BACKFILL.

NOTES:

- 1.- FOR GENERAL NOTES REFER TO DRAWING # 23595000-4000-S-1001-0
- 2.- FOR STRUCTURAL DESIGN CRITERIA REFER TO DOCUMENTS 60-000-100-GCD-001 AND 60-000-245-GCD-002.
- 3.- FOR STRUCTURAL STEEL SPECIFICATION REFER TO DOCUMENT 60-000-245-GGD-003.
- 4.- FOR PAINT SPECIFICATION REFER TO DOCUMENT 60-000-245-GGD-001.
- 5.- THE DRAWING SHOULD BE READ IN CONJUNCTION WITH CIVIL DRAWING 65-584-230-003 AND MECHANICAL DRAWING 65-584-210-003.
- 6.- SINCE OF THE GEOTECHNICAL PARAMETERS OF THE BACKFILL ARE UNKNOWN, THE SETTLEMENTS OF THE PIPE SUPPORT UNDER PIPE LOAD OF FREEZE-THAW CYCLES HAVE NOT BEEN EVALUATED. IT IS SUGGESTED THAT THE PIPELINE BE MONITORED DURING ITS UTILIZATION TO EVALUATE THE SETTLEMENTS IN REAL TIME.
- 7.- FOR PIPING DRAWING SEE DRAWING 65-584-210-003-1 & 65-584-210-003-2

PLAN CLE
KEY PLAN

PASTE PLANT

5287324

NOTES GÉNÉRALES / GENERAL NOTES

INFORMATION D'ORDRE EST LA PROPRIÉTÉ DE AGNICO EAGLE LTD. ET DOIT ÊTRE RETOURNÉE SUR DEMANDE. SANS AUTORISATION ÉCRITE, RÉPLIQUE, TRADUCTION OU COPIE À MÔTEUR ET TOUTE UTILISATION NON DESIÉE POUR VOUS. L'INFORMATION EST PRÉSENTÉE SANS GARANTIE. © AGNICO EAGLE LTD.

INFORMATION HEREIN IS THE PROPERTY OF AGNICO EAGLE LTD. AND MUST BE RETURNED UPON REQUEST. WITHOUT WRITTEN PERMISSION, REPRODUCTION, TRANSLATION OR COPYING BY MOTOR OR ANY USE EXCEPT THAT FOR WHICH IT IS LOANED ARE PROHIBITED. © AGNICO EAGLE LTD.

DESSINS EN RÉFÉRENCE / REFERENCE DRAWINGS	
TITRE / TITLE	# DWG
230-GENERAL EARTH WORKS - PLAN VIEW	-
SECTIONS AND DETAILS - PASTE LINE C PAD	65-584-230-003
584 - PASTE PLANT - PLAN VIEW AND	-
DETAILS - PIPING PASTE LINE C	65-584-210-003

AGNICO EAGLE

REV.	DATE	DESCRIPTION	PAR/EN	APP.	CLIENT
2	2025-05-09	AS-BUILT		R.G.F.	V.L.
1	2024-09-13	ADDITION OF TYPICAL SUPPORT		F.L.	V.H.
0	2024-07-04	ISSUED FOR CONSTRUCTION		F.L.	V.H.
AA	2024-06-13	ISSUED FOR PERMITTING		F.L.	V.H.

REVISIONS

TITRE / TITLE
AGNICO EAGLE - MELIADINE DIVISION
584 - PASTE PLANT
245 - STRUCTURAL STEEL
PIPE SUPPORTS DETAILS - PASTE LINE C

DESSINÉ PAR DRAWN BY	DATE 2024-06-13
FABIOLA LIZAMA <td></td>	
REVU PAR REVIEWED BY	DATE 2024-06-13
BEATRICE LACOMBE, P. Eng.	
VÉRIFIÉ PAR VERIFIED BY	DATE 2024-06-13
VALÉRIE HOULE, P. Eng.	
ÉCHELLE SCALE	DATE 2024-06-12
AS SHOWN	
NO. DESSIN DRAWING NO.	65-584-245-008
NO. PROJET PROJECT NO.	6537
REVISION	FEUILLE / SHEET
2	1 / 1

TEL QUE CONSTRUIT
AS BUILT

AGNICO EAGLE

DATE : 2025-04-14



Appendix C: P&ID – 584-Paste Plant - 65-584-205-201-2-R8

