

Design Report Sewage Treatment Plant (STP) Upgrade

6526-460-132-REP-002

In Accordance with Licence 2AM-MEL1631 Part D, item 1 & 2

Prepared by:

Agnico Eagle Mines Limited – Meliadine Division

July 2020

DOCUMENT CONTROL

Version	Date (YMD)	Section	Page	Revision
R0	17/07/2019			Design report

Prepared By:  2020-07-17
Thomas Genty
Water Treatment Eng.
OIQ 5021068


Approved by:  2020-07-17
Jessica Huza
Environment Superintendent

TABLE OF CONTENTS

1	INTRODUCTION	5
1.1	Site Location and Access	5
1.2	Site Facilities.....	5
1.3	Purpose of Document.....	5
1.4	Scope of work.....	5
2	DESIGN METHODOLOGY	8
2.1	Design rationale, requirements, criteria and parameters	8
2.2	Design standards analysis and methods.....	8
2.3	Design assumptions and limitations	8
2.4	Waste water Characteristics	8
2.5	Water Management Strategy.....	9
3	DESCRIPTION	9
3.1	Concept	9
3.2	Flow equalisation and screening	9
3.3	Aerobic reactor	9
3.4	Membrane Filtration.....	10
3.5	UV disinfection.....	10
3.6	Sludge storage and dewatering.....	11
4	CONSTRUCTION METHODS.....	11
4.1	Construction method and equipment	11
4.2	Quality control/assurance	11
4.3	Testing and inspection.....	11
4.4	Timeline	11

LIST OF FIGURES

Figure 1 : General location plan	7
--	---

LIST OF TABLES

Table 1: Expected operational parameters	8
Table 2: Raw Water	8

LIST OF APPENDICES

Appendix A: STP Upgrade Drawings
Appendix B: Current STP Drawings

1 INTRODUCTION

1.1 SITE LOCATION AND ACCESS

Agnico Eagle Mines Limited (Agnico Eagle) is developing the Meliadine gold mine located approximately 25 km north of Rankin Inlet, and 80 km southwest of Chesterfield Inlet in the Kivalliq Region of Nunavut. The project site is located on the peninsula between the East, South, and West basins of Meliadine Lake (63°01'23.8"N, 92°13'6.42"W). The area is accessible from the all-weather gravel road linking the Meliadine mine site with Rankin Inlet.

A general location plan for the project is shown in Figure 1.

1.2 SITE FACILITIES

The current mine plan focuses on the development of the Tiriganiaq gold deposit which will be mined using both conventional open-pit and underground mining operations. Current mining facilities to support the Mine include a plant site and accommodations, tailings storage facility, waste rock storage facilities, ore storage pads, process plant, power plant, maintenance facilities, water management treatment plants and supporting infrastructures.

Such infrastructures include water retention dikes, berms, culverts, channels, collection ponds, pumping stations, fresh water intake and water treatment plants are required to manage water during pre-production, operation, and interim mine closure.

To support the camp accommodation, upgrading the current sewage treatment (STP) plant unit would be required.

1.3 PURPOSE OF DOCUMENT

This report includes the final design and construction drawings for the STP upgrade.

1.4 SCOPE OF WORK

H2O innovation was selected to supply the STP upgrade. Construction drawings of the listed infrastructure are presented in appendices of this report. Note that the STP concept stays the same but an additional aerobic tank and membrane filtration unit are added.

7

2 DESIGN METHODOLOGY

2.1 DESIGN RATIONALE, REQUIREMENTS, CRITERIA AND PARAMETERS

The design rationales are the following:

- Provide additional sewage treatment capacity for the camp;
- Limit extent of required modifications of the current infrastructure;
- Ensure the system is containerized for simplicity.

Table 1 presents the target effluent concentration at the exit of the STP. Note that these parameters are operational targets and no effluent are discharged to the environment.

Table 1: Expected operational parameters

Parameter	Unit	Effluent target
BOD ₅	mg/L	<25
TSS	mg/L	<25
pH	units	6-9
Ammonia Nitrogen (N-NH ₃)	mg/L	0.89
Fats, Oils and Grease	mg/L	15

2.2 DESIGN STANDARDS ANALYSIS AND METHODS

STP upgrade equipment were selected to manage an equivalent of 200 additional people in the camp (the current STP is designed for 520 persons). The selection of each of these components was based on a typical process used in the industrial water treatment sector and synergy with the current STP set up was prioritized. The robustness and redundancy of equipment were also taken into account during equipment/supplier selection.

2.3 DESIGN ASSUMPTIONS AND LIMITATIONS

The current treatment plant is able to treat a maximum daily flow of 216 000 L per day (maximum design flow). The upgrade STP equipment will be able to handle an additional 83 076 L per day.

2.4 WASTE WATER CHARACTERISTICS

Table 2 presents the raw sewage water characteristic used for the design.

Table 2: Raw Water

Parameter	Unit	Raw water
BOD ₅	mg/L	200-360
TSS	mg/L	50-350
pH	unit	6.5-8.5
Ammonia Nitrogen (N-NH ₃)	mg/L	40-50
Fats, Oils and Grease	mg/L	20-50
TKN	mg/L	45-60
P _{total}	mg/L	5-12
Alkalinity	mg/L	250-500

2.5 WATER MANAGEMENT STRATEGY

Sewage will be collected from the facilities and pumped to the STP. The objective of the STP is to treat sewage to an acceptable level for discharge to CP1 via a sewage water discharge pipeline. The STP is housed in a prefabricated (modular) structure, located on the east side of the industrial pad (Figure 1).

The treated sewage from the STP will be pumped through a heat traced insulated pipeline to CP1 pond which is designed to receive all the surface contact waters on site. This water is pumped to the final effluent treatment plant for TSS control prior to discharge into Meliadine Lake.

The composition of the sewage and grey water entering the plant and the Effluent water quality exiting the units will be monitored on a regular basis to determine plant efficiency. Sewage sludge removed from the STP will be added to the landfarm as nutrient amendment, on an as needed basis. Excess sludge will be disposed of in the waste rock storage facility (WRSF) primarily, however alternate disposal options are possible such as the Tailings Storage Facility or shipment south for disposal.

3 DESCRIPTION

3.1 CONCEPT

The STP relies on bacterial activity. The process is composed of five (5) steps described below:

- flow equalization and screening,
- aerobic biological treatment,
- membrane filtration,
- ultraviolet disinfection,
- and sludge handling/dewatering.

PIDs are available in appendices.

3.2 FLOW EQUALIZATION AND SCREENING

The influent wastewater is pumped to the two (2) aerated equalization tanks. The equalization system is able to manage a variation in flows. It provides raw wastewater storage to store feed during high flow periods and to ensure feed supplementation during low flow periods. It provides a stable and consistent raw feed for the downstream processes. Equalized water is pumped via two (2) equalization pumps into a standpipe inside the second tank and flows from that pipe by gravity to the fine screens. The fine screens are rotary drum screens with 2 mm perforated plate openings that operate continuously. The screens will ensure the removal of large debris to protect downstream equipment. Pressurized wash water is used intermittently to clean the screens and screenings.

3.3 AEROBIC REACTOR

Screened raw water flows by gravity from the screens into the sump tank, where it is pumped to the aerobic tank, which is located outdoors. Aerobic biological treatment removes the organic load (measured as BOD) of the wastewater. Bacteria grown in the bioreactor remove unwanted organic pollutants to produce a treated water of high quality. Oxygen is supplied by regenerative blowers and is injected by fine bubble diffusers in the tank. The diffusers are designed for a wide range of air flows, according to the system's demand in oxygen. It keeps a dissolved oxygen concentration of at least 2 mg/L at any time to satisfy the needs of the biomass. The mixed liquor suspended solids (MLSS)

overflows into a standpipe inside the tank and flows by gravity to the membrane filtration trains. The target MLSS in the aerobic reactor is 10 g/L.

The dry bacteria product, BEC105, could be used in the treatment process to stimulate biological activity when needed. To start up of the new bioreactor, sludge from the current plant can be used too.

The equipment added in the STP upgrade is an aerobic tank with fine bubble diffuser.

3.4 MEMBRANE FILTRATION

Membrane filtration is used to separate the bacteria from the water to ensure keeping them in the process at the desired concentration. Activated sludge is returned at a constant flow rate to the aerobic tank to prevent a build-up of sludge in the membrane tank. The return activated sludge (RAS) is pumped at a higher flow rate than the design flow rate of the plant, to make sure that there is good circulation in the whole system and that there is no accumulation of solids.

The membranes are totally submerged and have a pore size of 0.4 microns, which remove all suspended solids in the effluent.

The permeation pumps are provided to suction the effluent through the membrane modules and transport it to the permeate tank. The permeation pumps are supplied with variable speed drives to overcome any changes in transmembrane pressure and achieve the design at all times.

The operating cycle for the selected modules is to suction effluent water for seven (7) minutes and to relax the membrane for one (1) minute. The cycle optimizes the long-term operation of the membrane modules. The housings are constructed with an integrated diffuser at the bottom to aerate the membrane continuously and prevent clogging and accumulation of sludge. The relaxation of the membranes allows extending the interval between cleanings (CIP or Clean-In-Place). CIP cleans are done about twice a year. Washes are performed with permeate stored in the permeate storage tank while a cleaning chemical (either sodium hypochlorite or citric acid) is added. Chemical solutions are backflushed through the membranes, which are soaked for a few hours after. After washing, the permeation is restarted. While a train is washing, the other train can continue to treat water and ensure a continuous production of effluent.

Once a week, a chemically enhanced back pulse (CEB) should be performed on the membrane modules with sodium hypochlorite to mitigate membrane fouling. Permeate flow is reversed to flow back into the membranes while the cleaning chemical is added inline.

An additional sea can with a membrane train and utilities (instrumentation, blower, pumps, UV, CIP tank, sodium hypochlorite system) are added to the current STP system. This allows the filtration area to increase from 900 m² (current system) to 1350 m² (upgraded system).

3.5 UV DISINFECTION

From the permeate pumps, each membrane bioreactor train sends permeate through an inline ultraviolet disinfection system. It is a physical process that inactivates instantaneously microorganisms. The UV system process adds no chemicals to the water, and therefore, has no impact on the chemical composition of the effluent. From here, effluent is sent to a common permeate storage tank. The permeate tank acts as a reservoir for treated water that is pumped to the discharge location. This tank can also be used for CEB and CIP process, as previously mentioned.

3.6 SLUDGE STORAGE AND DEWATERING

Since bacteria continue to reproduce as they consume organics and nutrients, the concentration of biomass, measured as Mixed Liquor Suspended Solids (MLSS), increases with time. Periodic sludge wasting is required to control the MLSS concentration in the bioreactor tanks. Sludge is sent to the sludge storage tank by redirecting the flow of the RAS pump (approximately at 1% solid content). A blower and coarse bubble diffuser system maintains an aerobic environment within the sludge tank to minimize the proliferation of odors. Periodic settling is used to facilitate the thickening of the waste activated sludge. The supernatant (upper portion of the tank) is sent back to the sump tank by opening a valve, where it will re-enter the treatment process. This operation (called decanting) reduces the volume of sludge that needs to be handled and extends the period of time that the sludge tank can be used before thickened sludge is disposed (approximately at 2-3 % solid content).

A Sludge Dewatering System (Volute) system is also available to remove the solid fraction out of the sludge storage tank. Basically, the flocculated sludge pass through a screw press that utilizes a screw inside a moving casing. Water collected during the dewatering is sent back to the STP equalization tank. The cake is then collected in a solid-waste bin for disposal in the Waste Rock Storage Facility. Alternative disposal locations can include: Tailings Storage Facility, use at the landfarm as nutrient amendment or shipment south during the barge season for disposal. The system is designed to treat 3 to 5 m³ per 12 h and will produce approximately 0.28 m³ per day of sludge cake at approximately 18% solid. The cationic polymer consumption is estimated at 0.5 kg per day.

4 CONSTRUCTION METHODS

4.1 CONSTRUCTION METHOD AND EQUIPMENT

No building construction is expected for the upgrade. An additional container and tank will be placed close to the current infrastructure. Installation of equipment will be done on the existing industrial pad.

4.2 QUALITY CONTROL/ASSURANCE

A record of as-built drawings will be produced.

4.3 TESTING AND INSPECTION

Prior to start up, the indoor pipe will be tested for leaks. If leaks are found, the pipe will be repaired.

After start up, a periodic inspection, performed by Agnico Eagle personnel, will be done to ensure piping and plant integrity.

4.4 TIMELINE

The expected date of construction is September 1st 2020, commissioning completion is planned for mid-September 2020.

Appendix A : STP upgrade



EXPANSION - SITE VIEW
SCL: 1:125

PLAN CLÉ
KEY PLAN

wsp

1075, 3th AVENUE EAST
VAL-D'OR (QUEBEC) CANADA J9P 0J7
PHONE : 1-819-826-4274 | FAX : 1-819-824-1514 | WWW.WSP.COM
Rev. : 201-00413-01

NOTES GÉNÉRALES / GENERAL NOTES

**POUR CONSTRUCTION
FOR CONSTRUCTION**

AGNICO EAGLE DATE : 2020-05-22

INFORMATION D'ORDRE DE LA PROPRIÉTÉ DE AGNICO EAGLE LEE ET DONT EST RETENUE, SANS AUTORISATION ÉCRITE, REPRODUCTION, TOUTE TRANSMISSION DE COPIES À MOINS D'ÊTRE LIBÉRÉE PAR AGNICO EAGLE LEE. INFORMATION EST RETENUE, SANS AUTORISATION ÉCRITE, REPRODUCTION, TOUTE TRANSMISSION DE COPIES À MOINS D'ÊTRE LIBÉRÉE PAR AGNICO EAGLE LEE.

THE INFORMATION HEREIN IS THE PROPERTY OF AGNICO EAGLE LEE. ANY REUSE OR REPRODUCTION WITHOUT WRITTEN PERMISSION, OR COPIES TRANSMISSION TO OTHERS AND ANY USE EXCEPT THAT FOR WHICH IT IS ISSUED ARE PROHIBITED.

DESSINS EN RÉFÉRENCE / REFERENCE DRAWINGS	
TITRE / TITLE	# DWG
WASTE WATER CONTAINER	20C1131-B01-0001
---	---
---	---
---	---
---	---

AGNICO EAGLE

REVISIONS	
REV.	DATE
0	2020-05-22


TITRE / TITLE	
AGNICO EAGLE - MELIADINE DIVISION	
460 - SEWAGE TREATMENT PLANT	
210 - GENERAL ARRANGEMENT	
EXPANSION	
SITE VIEW	

DESSINÉ PAR DRAWN BY		DATE 2020-05-20
CARINE BEAULIEU		
VÉRIFIÉ PAR CHECKED BY		2020-05-22
PAUL RIVEST, P.Eng.		
APPROUVÉ PAR APPROVED BY		2020-05-22
PAUL RIVEST, P.Eng.		
ÉCHELLE SCALE		DATE 2020-05-20
INDICATED		

NO. DESSIN DRAWING NO.	
65-460-210-200	

NO. PROJET PROJECT NO.	
6526	

REVISION	FEUILLE / SHEET
0	1 / 1

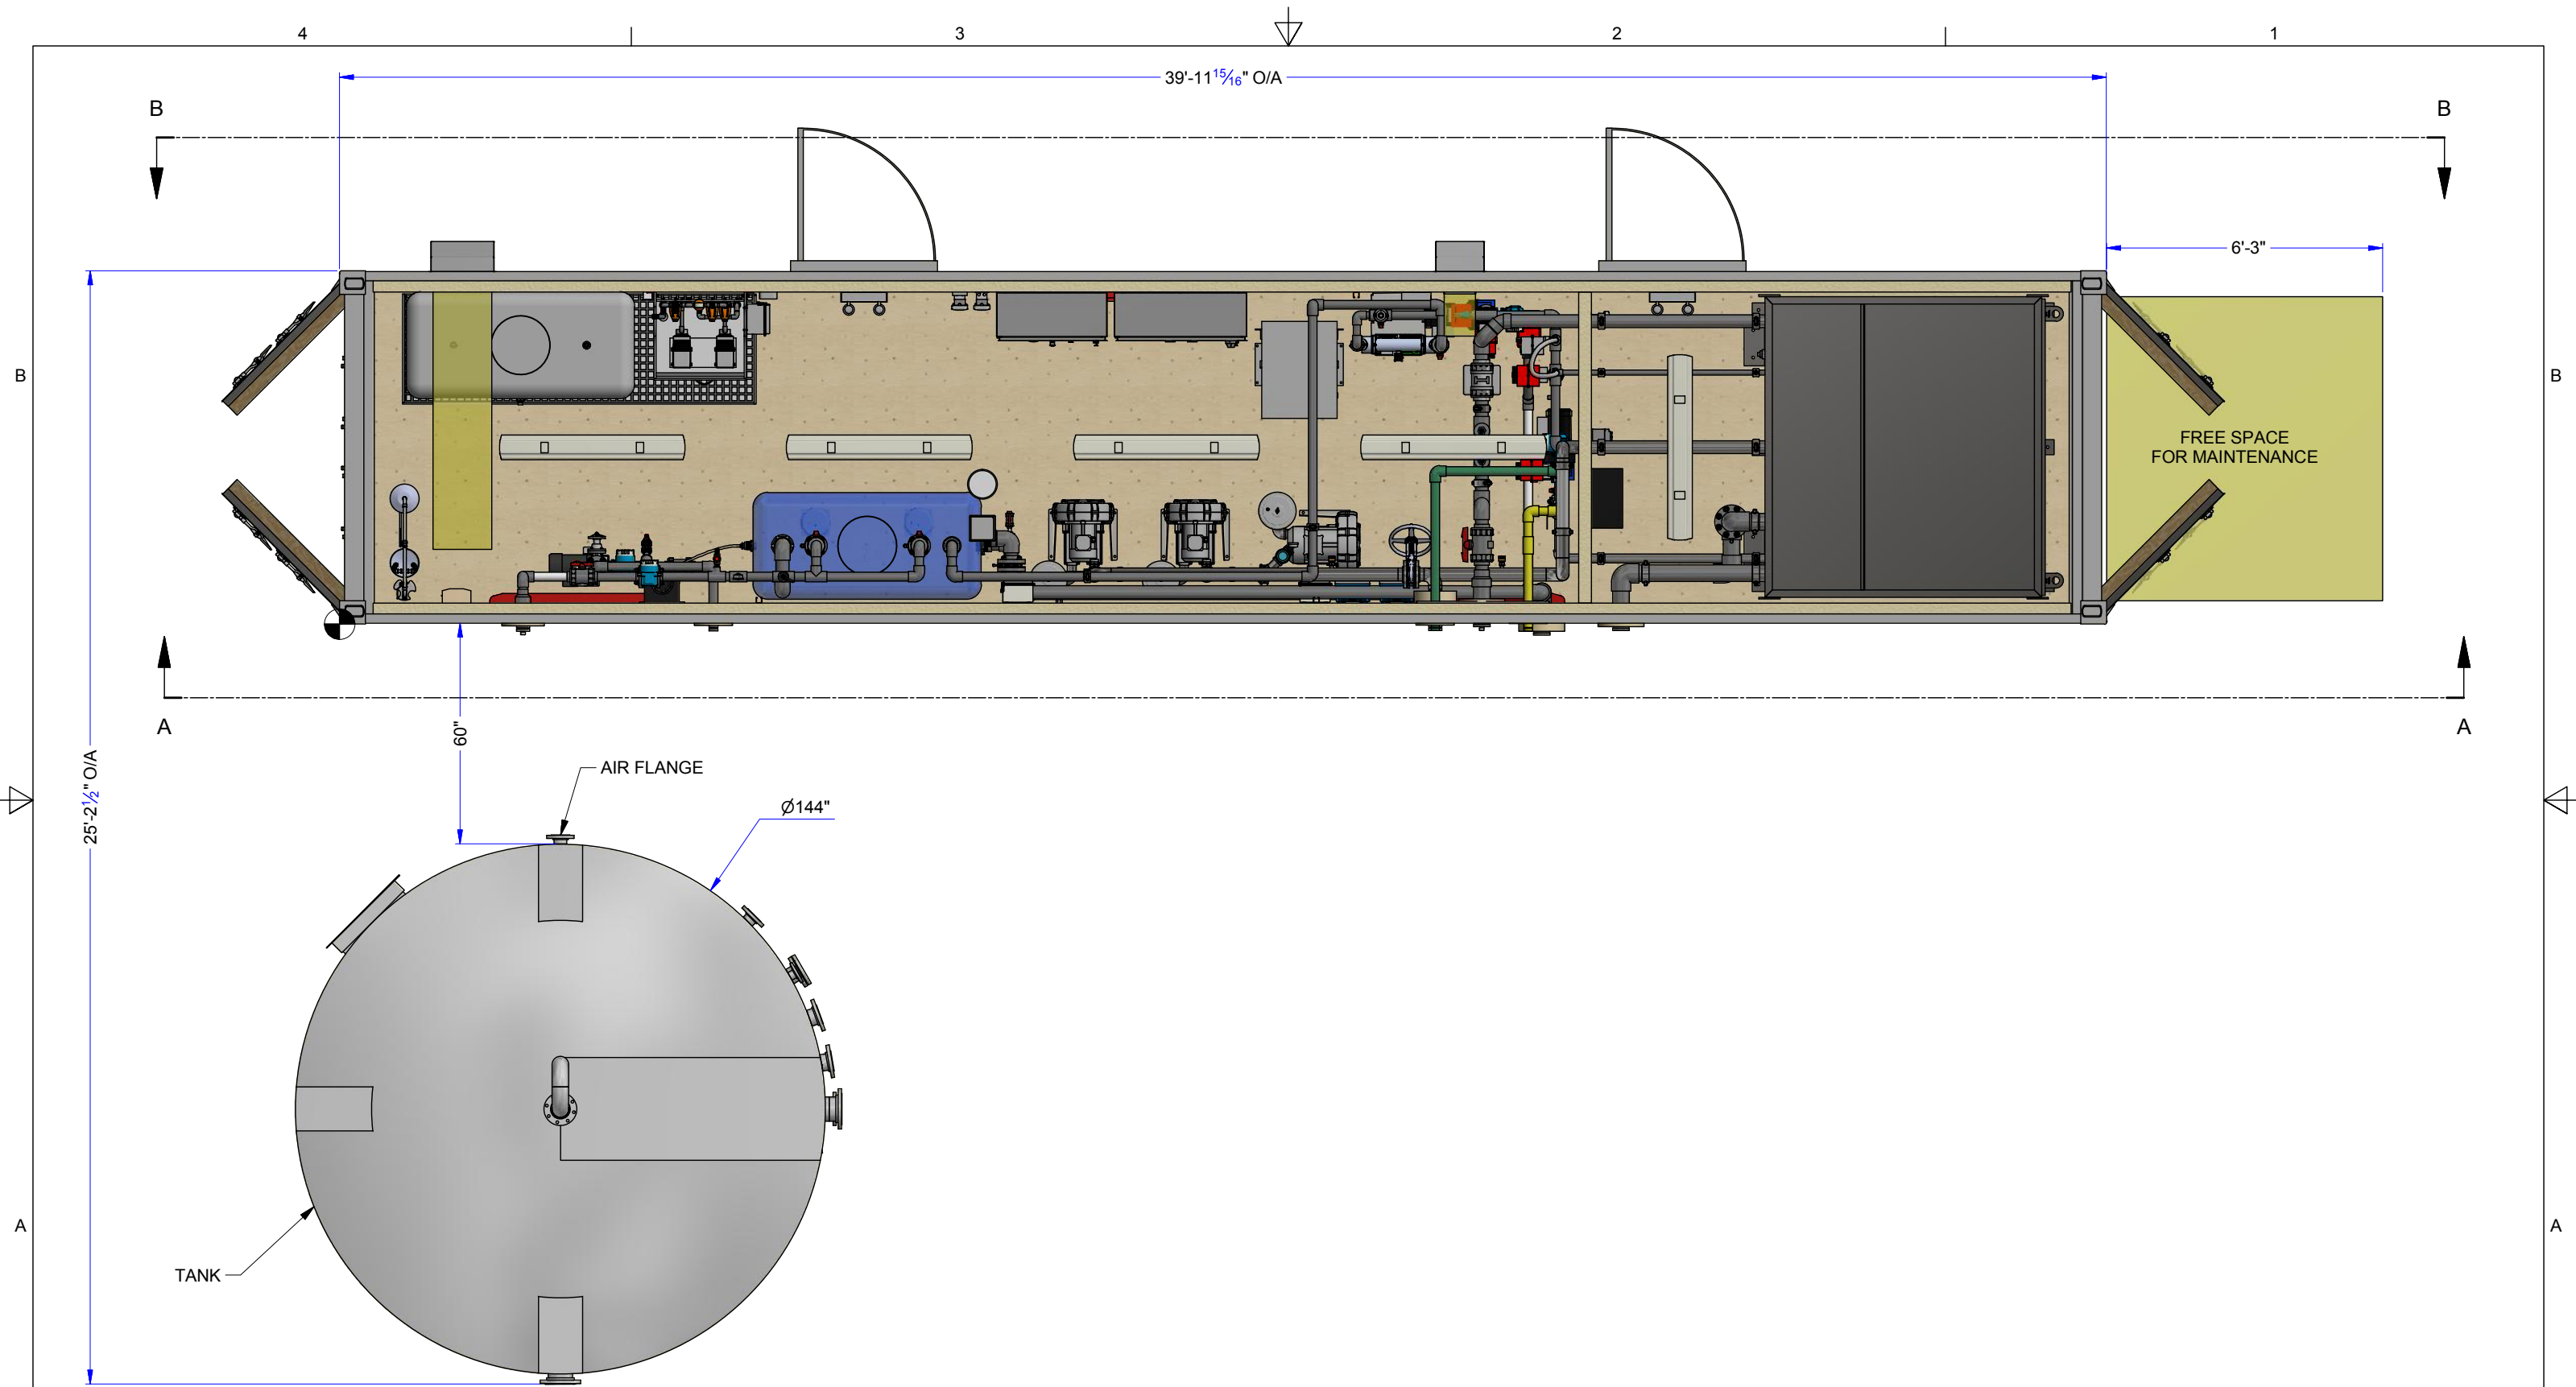

TOP VIEW

NOTE:
THE INFORMATION, SPECIFICATIONS AND DATA SHOWN ON THIS PRINT ARE FURNISHED BY AND ARE TO REMAIN THE PROPERTY OF H₂O INNOVATION.

THE PURPOSE OF THIS DOCUMENT IS TO FACILITATE THE INSTALLATION, MAINTENANCE AND OPERATION OF THE EQUIPMENT REPRESENTED BY SAID PRINT. NO OTHER USE OF THIS DOCUMENT SHALL BE MADE WITHOUT EXPRESS WRITTEN CONSENT FROM H₂O INNOVATION.

DRAWING REVISION						
REV	DATE	REVISION DESCRIPTION	DRAWN	PEER	ENG	APPVD
01	2020-06-02	REVISED AS PER ENGINEER COMMENTS	M.C	R.D.	R.D.	A.M.
00	2020-05-21	INITIAL RELEASE	M.C.	R.D.	R.D.	A.M.



UNLESS NOTED OTHERWISE
INTERPRETATION: ANSI Y14.5


TOLERANCES:
FRACTIONS: $\pm \frac{1}{16}$ "
DECIMALS: 0.5 ± 0.030
0.001 ± 0.015
ANGLES: $\pm 0.5^\circ$
HOLE SIZES: $\pm \frac{1}{32}$ "
HOLE CENTERS: $\pm \frac{1}{16}$ "
DO NOT SCALE PRINTS

MELIADINE WW EXPANSION

MELIADINE , NU

TITLE:		
WASTE WATER CONTAINER GENERAL ARRANGEMENT		
SCALE: N.T.S	DRAWING NUMBER: 20C1131-B01-0001 SHEET: 2 OF 5	REVISION 01

NOZZLE#	DESCRIPTION	MATERIAL	DIAMETER	CONNECTION
A	EQUALIZED WATER FROM MAIN PLANT SUMP PUMPS DISCHARGE LINE	PVC, SCH.80	2"	CUT GROOVE
B	EQUALIZED WATER TO EXPANSION AEROBIC TANK	PVC, SCH.80	2"	CUT GROOVE
C	MEMBRANE TANK VENT TO OUTSIDE	PVC, SCH.80	4"	CUT GROOVE
D	MEMBRANE TANK OVERFLOW	PVC, SCH.80	4"	CUT GROOVE
E	PERMEATE TANK OVERFLOW	PVC, SCH.80	4"	CUT GROOVE
F	PERMEATE EFFLUENT TO DISCHARGE	PVC, SCH.80	3"	CUT GROOVE
G	BIOREACTOR AIR TO EXPANSION AEROBIC TANK	SS 304, SCH.10	3"	CUT GROOVE
H	WAS TO MAIN PLANT SLUDGE TANK	PVC, SCH.80	2"	CUT GROOVE
I	RAS TO EXPANSION AEROBIC TANK	PVC, SCH.80	2"	CUT GROOVE
J	PRETREATED WATER FROM EXPANSION AEROBIC TANK	PVC, SCH.80	4"	CUT GROOVE
K	POTABLE WATER	PVC, SCH.80	1/2"	FNPT
L	CITRIC ACID	PVC, SCH.80	1/2"	FNPT
M	HYPOCHLORITE	PVC, SCH.80	1/2"	FNPT

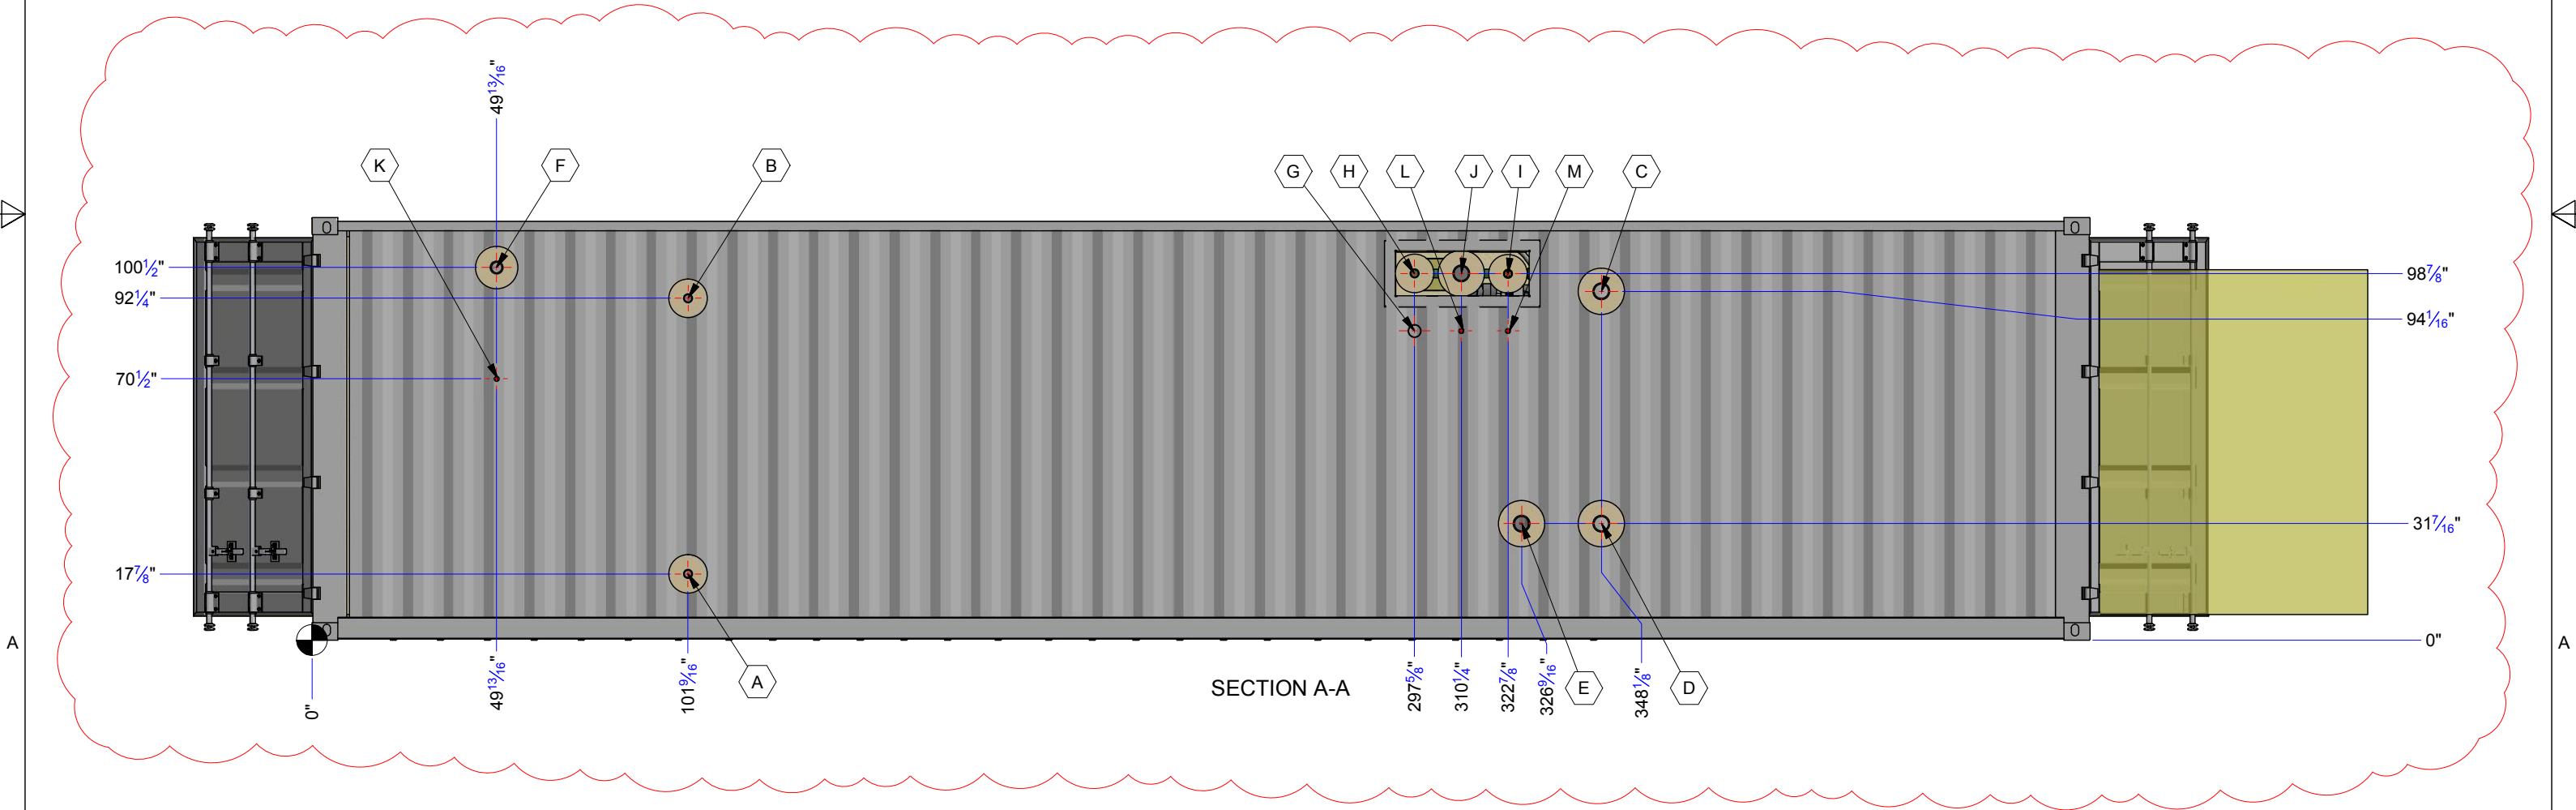

NOTE:
THE INFORMATION, SPECIFICATIONS AND DATA SHOWN ON THIS PRINT ARE FURNISHED BY AND ARE TO REMAIN THE PROPERTY OF H₂O INNOVATION.

THE PURPOSE OF THIS DOCUMENT IS TO FACILITATE THE INSTALLATION, MAINTENANCE AND OPERATION OF THE EQUIPMENT REPRESENTED BY SAID PRINT. NO OTHER USE OF THIS DOCUMENT SHALL BE MADE WITHOUT EXPRESS WRITTEN CONSENT FROM H₂O INNOVATION.

DRAWING REVISION						
REV	DATE	REVISION DESCRIPTION	DRAWN	PEER	ENG	APPVD
01	2020-06-02	REVISED AS PER ENGINEER COMMENTS	M.C	R.D.	R.D.	A.M.
00	2020-05-21	INITIAL RELEASE	M.C.	R.D.	R.D.	A.M.




UNLESS NOTED OTHERWISE
INTERPRETATION: ANSI Y14.5

TOLERANCES:
FRACTIONS: $\pm \frac{1}{64}$
DECIMALS: 0.5 ± 0.030
0.001 ± 0.015
ANGLES: $\pm 0.5^\circ$
HOLE SIZES: $\pm \frac{1}{64}$
HOLE CENTERS: $\pm \frac{1}{64}$

DO NOT SCALE PRINTS

MELIADINE WW EXPANSION
MELIADINE , NU

TITLE:		
WASTE WATER CONTAINER GENERAL ARRANGEMENT		
SCALE: N/A	DRAWING NUMBER: 20C1131-B01-0001 SHEET: 3 OF 5	REVISION 01

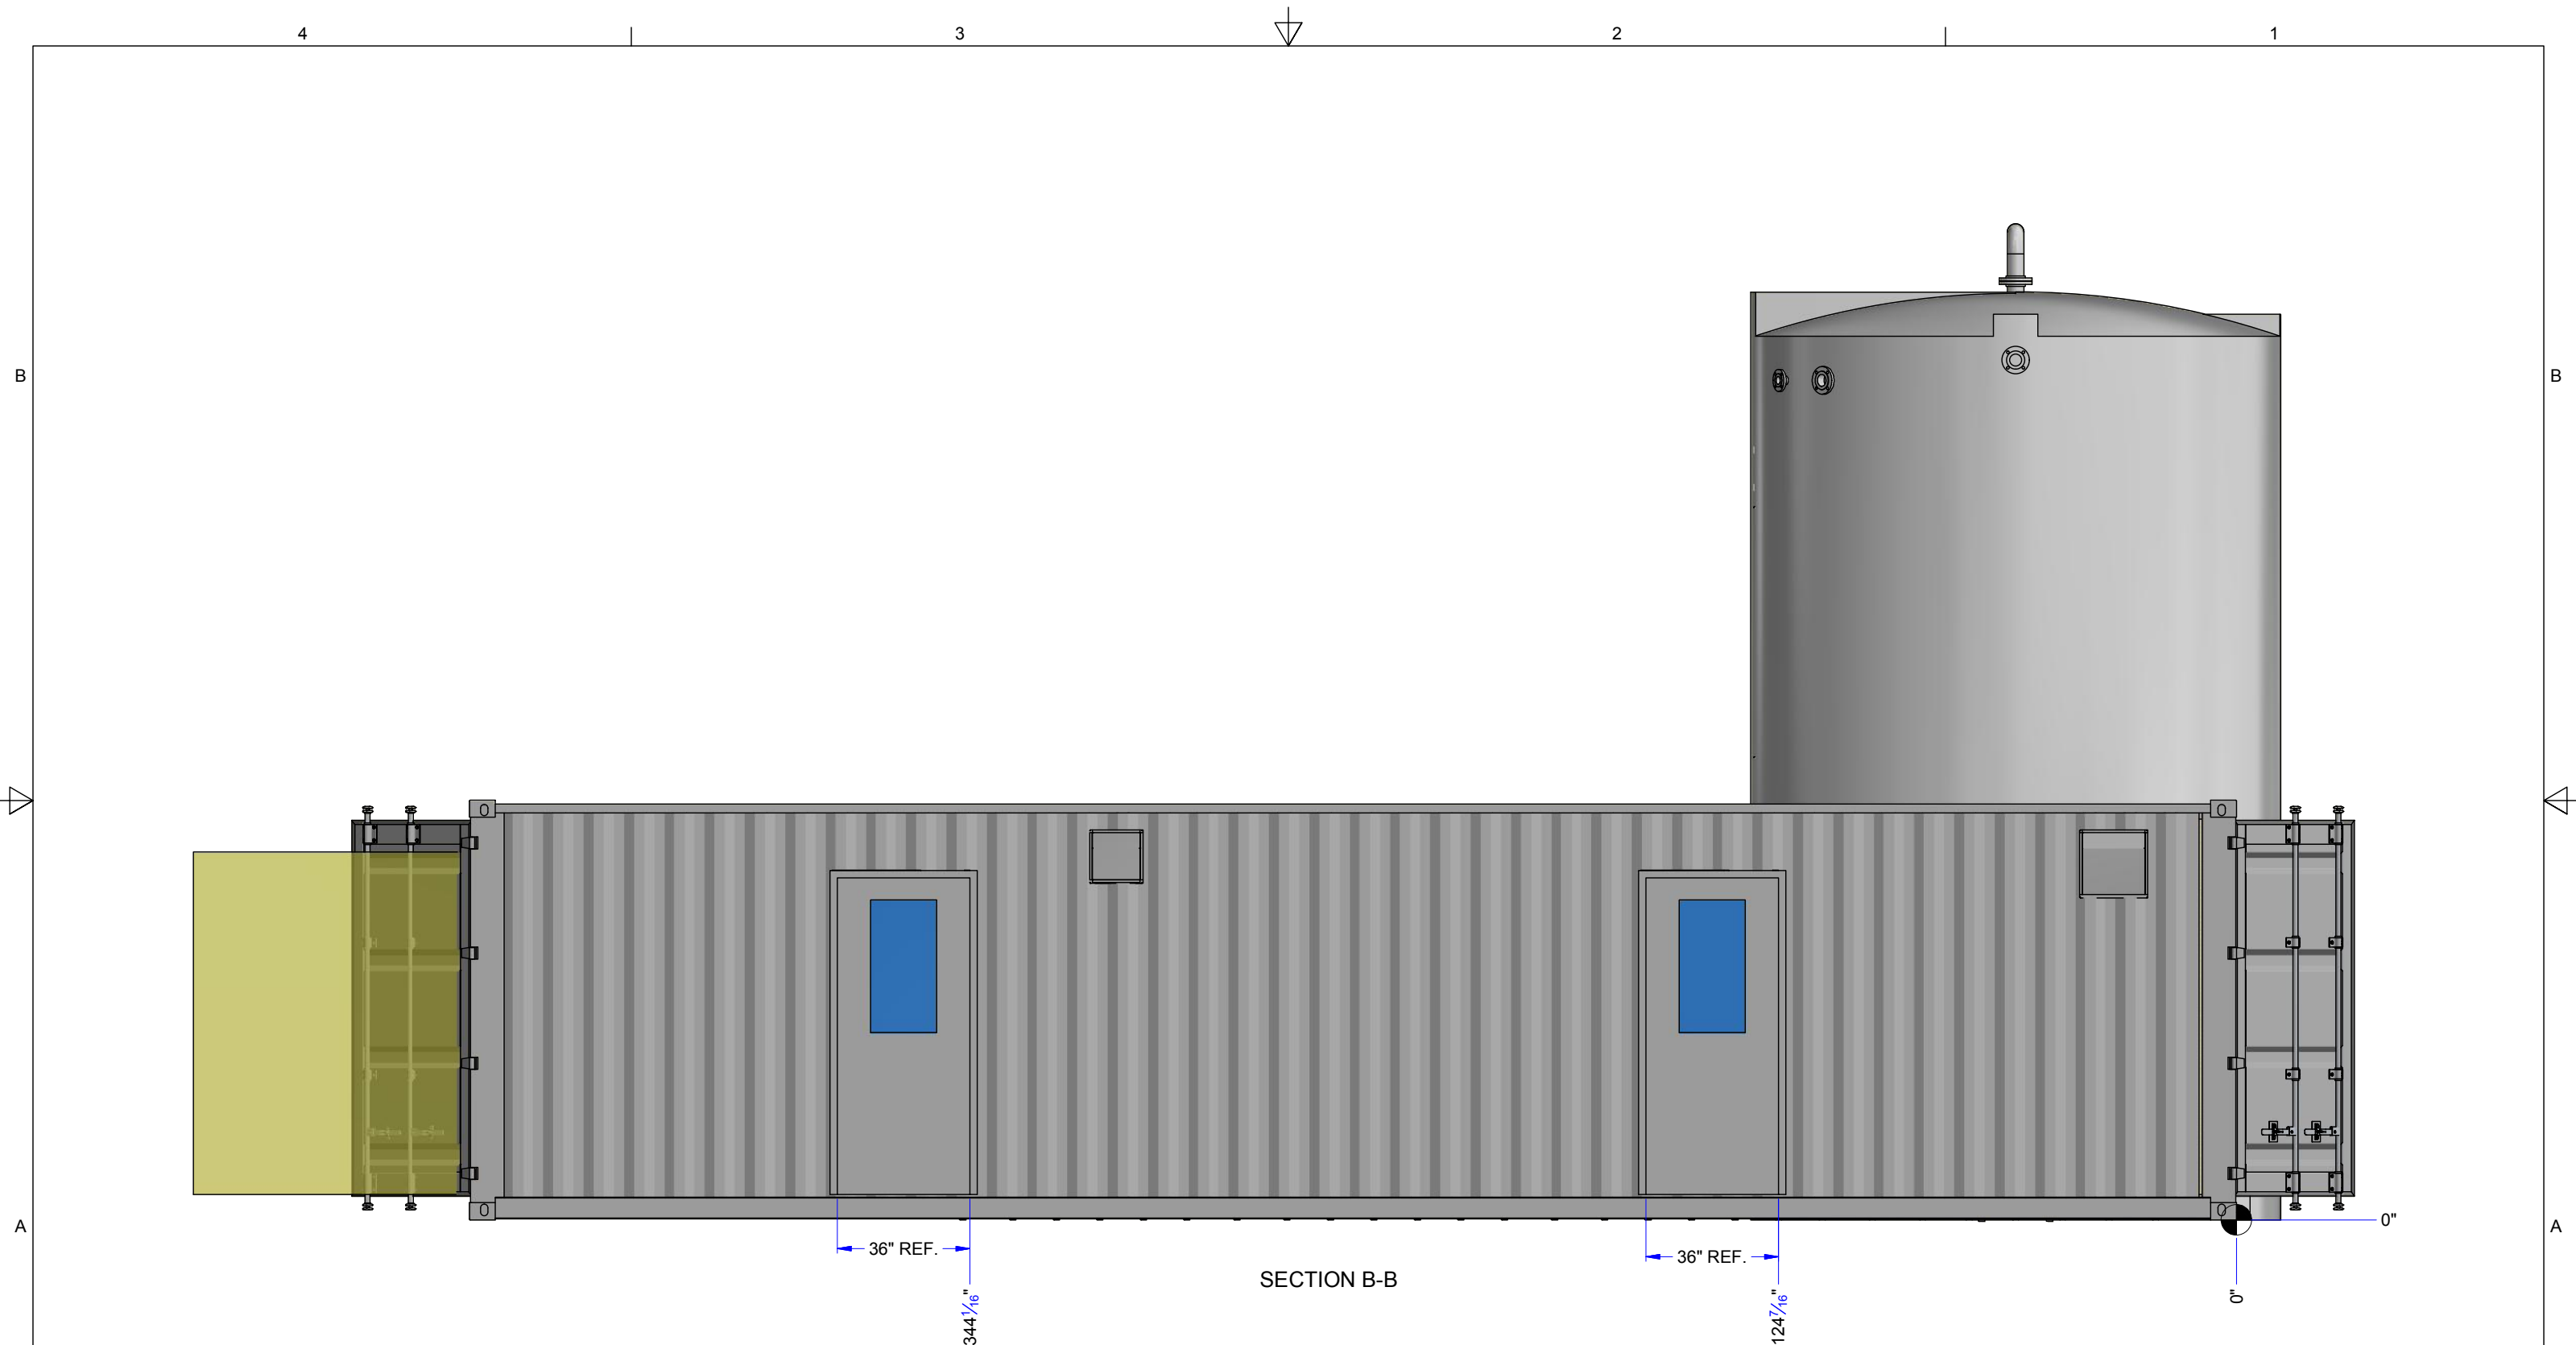

NOTE:
THE INFORMATION, SPECIFICATIONS AND DATA SHOWN ON THIS PRINT ARE FURNISHED BY AND ARE TO REMAIN THE PROPERTY OF H₂O INNOVATION.

THE PURPOSE OF THIS DOCUMENT IS TO FACILITATE THE INSTALLATION, MAINTENANCE AND OPERATION OF THE EQUIPMENT REPRESENTED BY SAID PRINT. NO OTHER USE OF THIS DOCUMENT SHALL BE MADE WITHOUT EXPRESS WRITTEN CONSENT FROM H₂O INNOVATION.

DRAWING REVISION						
REV	DATE	REVISION DESCRIPTION	DRAWN	PEER	ENG	APPVD
01	2020-06-02	REVISED AS PER ENGINEER COMMENTS	M.C	R.D.	R.D.	A.M.
00	2020-05-21	INITIAL RELEASE	M.C.	R.D.	R.D.	A.M.



UNLESS NOTED OTHERWISE

INTERPRETATION:
ANSI Y14.5

TOLERANCES
FRACTIONS: $\pm \frac{1}{16}$ "
DECIMALS: 0.005
0.001


ANGLES:
HOLE SIZES: $\pm \frac{1}{16}$ "
HOLE CENTERS: $\pm \frac{1}{16}$ "

DO NOT SCALE PRINTS

MELIADINE WW EXPANSION

MELIADINE , NU

TITLE:		
WASTE WATER CONTAINER GENERAL ARRANGEMENT		
SCALE: N/A	DRAWING NUMBER: 20C1131-B01-0001 SHEET: 4 OF 5	REVISION 01

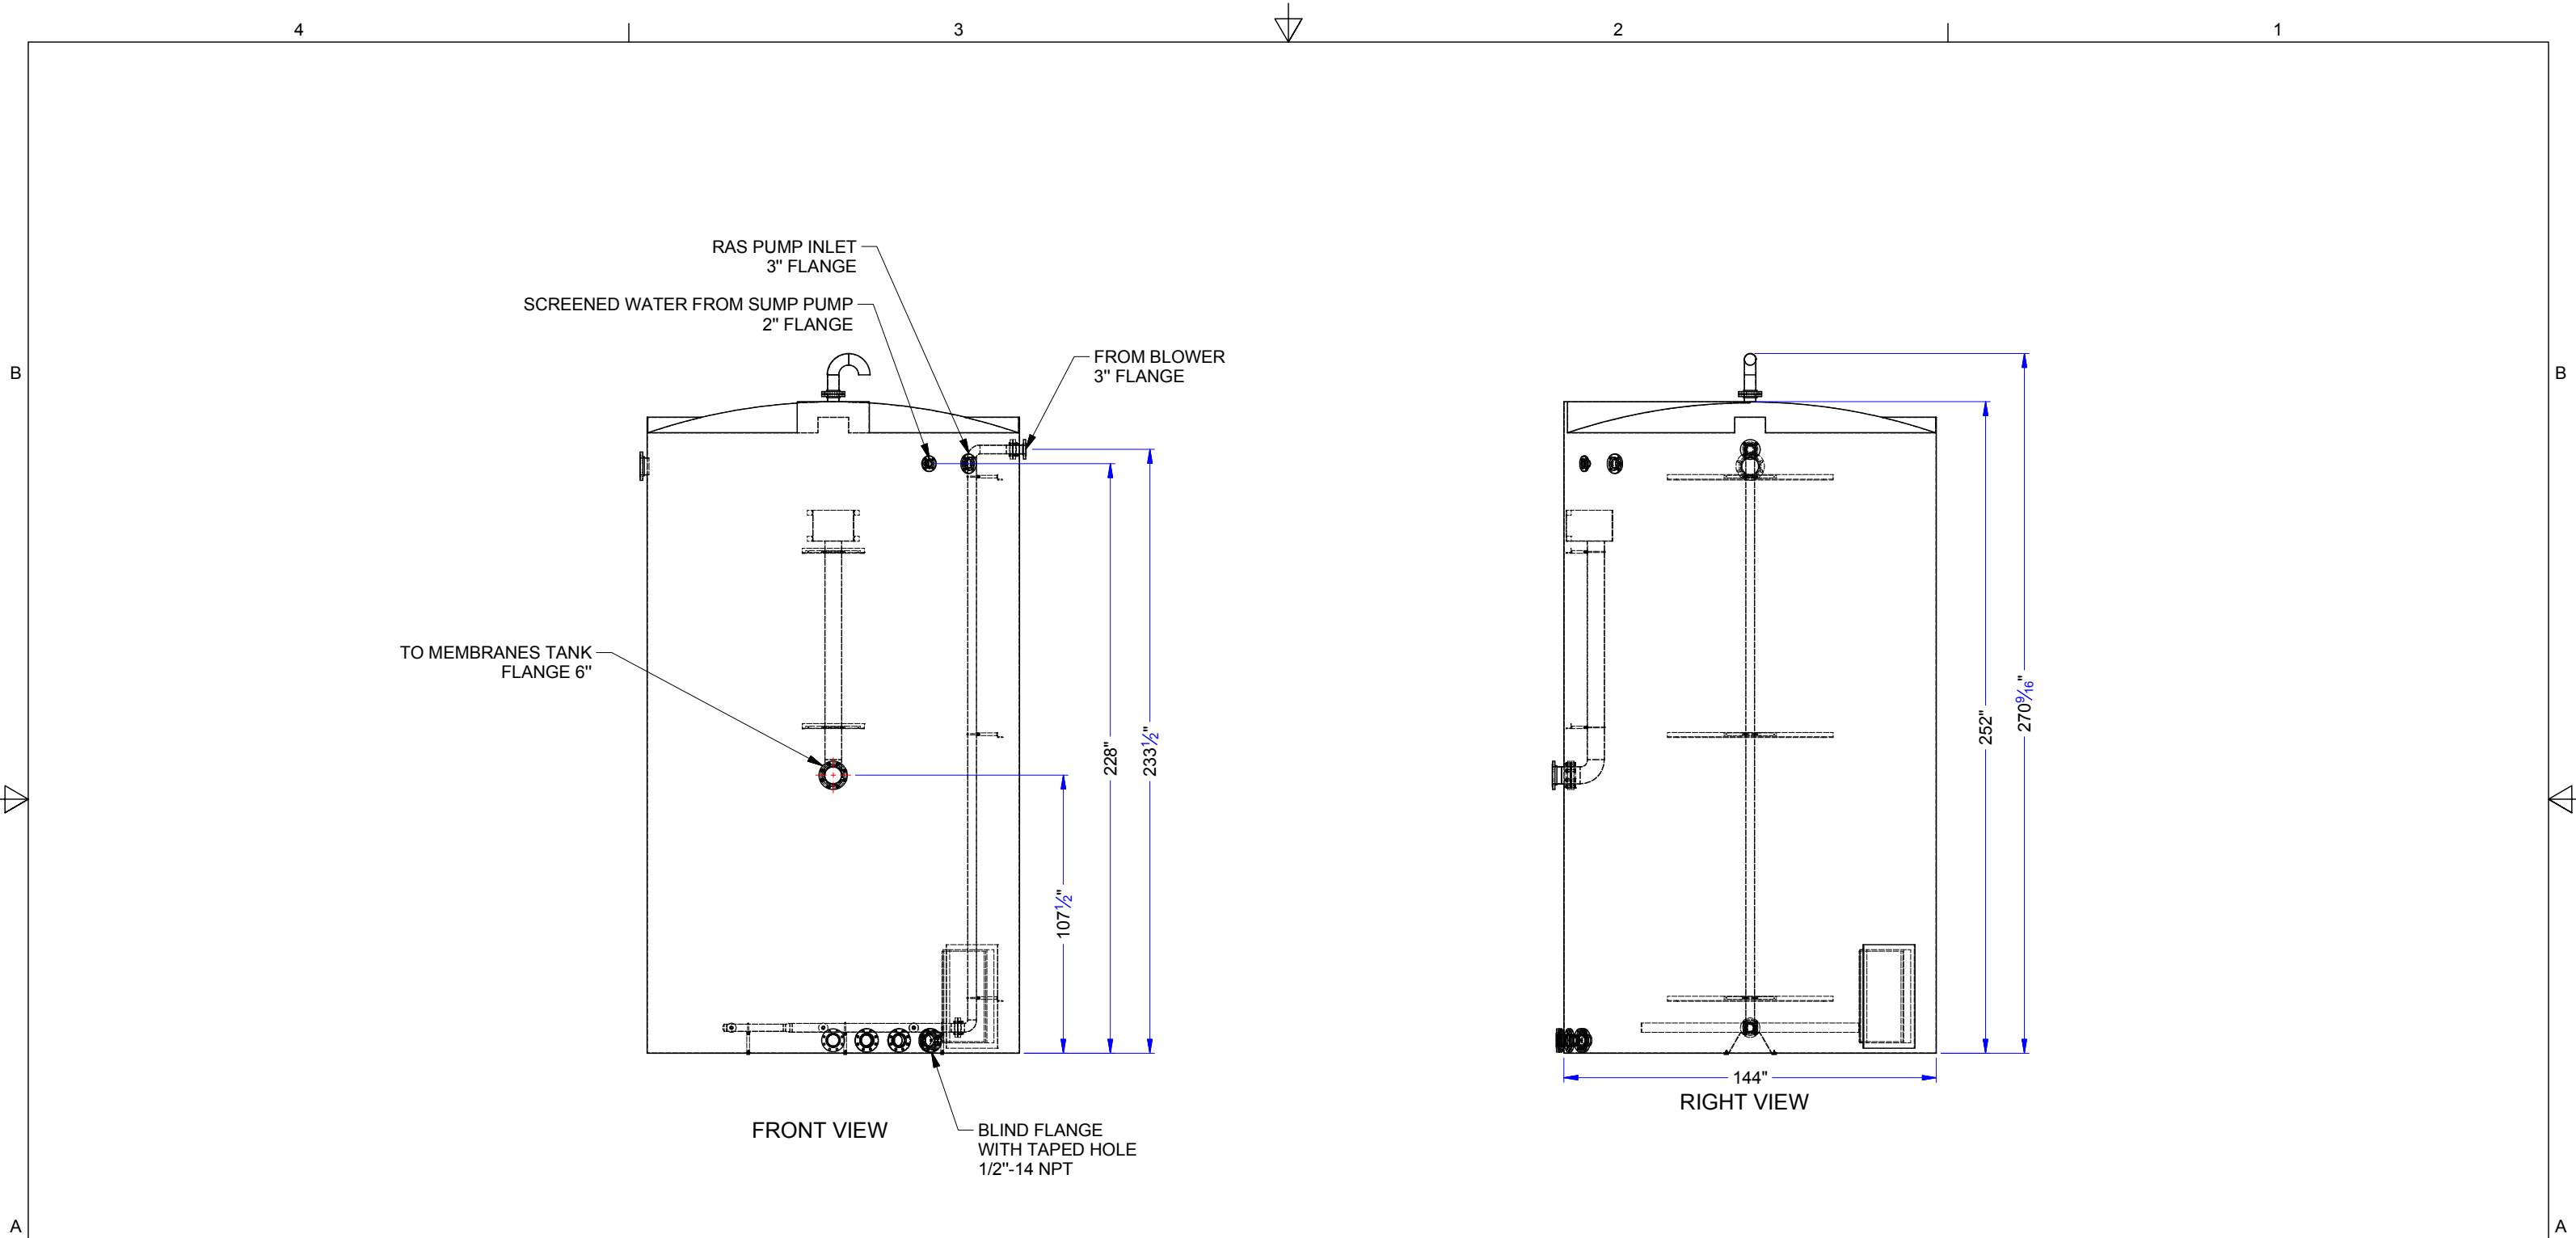

NOTE:
THE INFORMATION, SPECIFICATIONS AND DATA SHOWN ON THIS PRINT ARE FURNISHED BY AND ARE TO REMAIN THE PROPERTY OF H₂O INNOVATION.

THE PURPOSE OF THIS DOCUMENT IS TO FACILITATE THE INSTALLATION, MAINTENANCE AND OPERATION OF THE EQUIPMENT REPRESENTED BY SAID PRINT. NO OTHER USE OF THIS DOCUMENT SHALL BE MADE WITHOUT EXPRESS WRITTEN CONSENT FROM H₂O INNOVATION.

DRAWING REVISION						
REV	DATE	REVISION DESCRIPTION	DRAWN	PEER	ENG	APPVD
01	2020-06-02	REVISED AS PER ENGINEER COMMENTS	M.C	R.D.	R.D.	A.M.
00	2020-05-21	INITIAL RELEASE	M.C.	R.D.	R.D.	A.M.



UNLESS NOTED OTHERWISE

INTERPRETATION: ANSI Y14.5

TOLERANCES:
FRACTIONS: ±1/16"
DECIMALS: 0.5 ±0.030
0.001 ±0.015

ANGLES: ±0.5°
HOLE SIZES: ±1/64"
HOLE CENTERS: ±1/32"


DO NOT SCALE PRINTS

MELIADINE WW EXPANSION


MELIADINE , NU

TITLE:		
WASTE WATER CONTAINER GENERAL ARRANGEMENT		
SCALE: N/A	DRAWING NUMBER: 20C1131-B01-0001 SHEET: 5 OF 5	REVISION 01

VALVE SYMBOLS

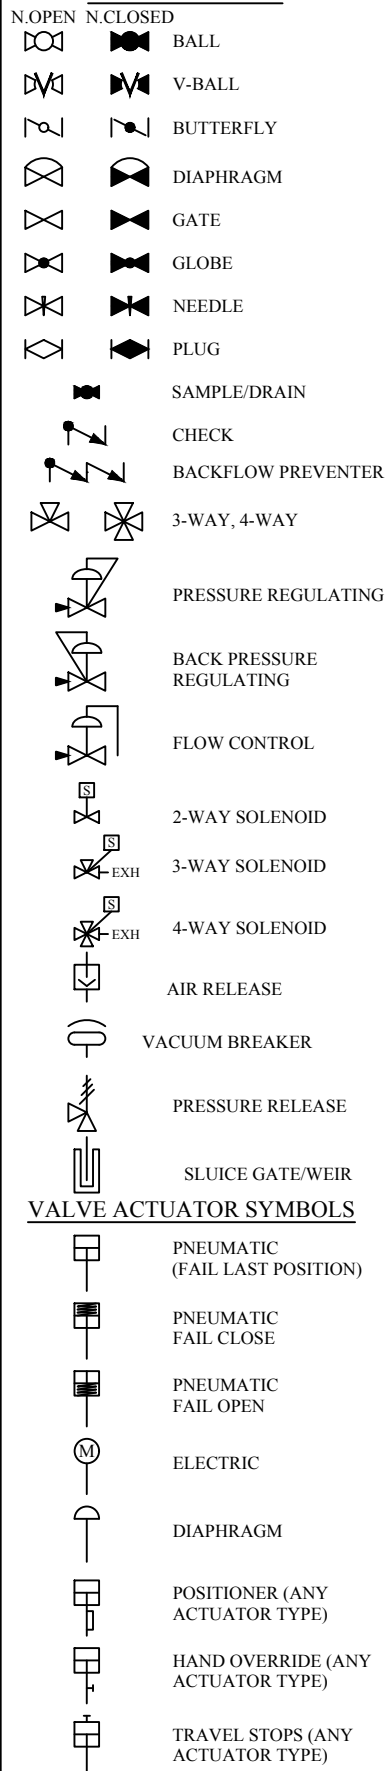


FLOWMETER SYMBOLS

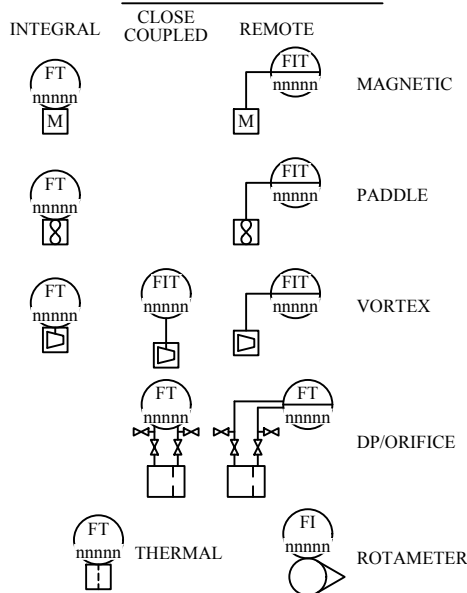


PIPING ABBREVIATIONS

316 SS	316 STAINLESS STEEL
304 SS	304 STAINLESS STEEL
316L SS	LOW CARBON 316 STAINLESS STEEL
304L SS	LOW CARBON 304 STAINLESS STEEL
CPVC	CHLORINATED POLYVINYL CHLORIDE
CS	CARBON STEEL
DI	DUCTILE IRON
HDPE	HIGH-DENSITY POLYETHYLENE
PE	POLYETHYLENE
PVC	POLYVINYL CHLORIDE
RLCS	RUBBER LINED CARBON STEEL
SCH.	SCHEDULE
SDR	STANDARD DIMENSION RATIO
CML	CEMENT MORTAR LINED


LINE SYMBOLLOGY

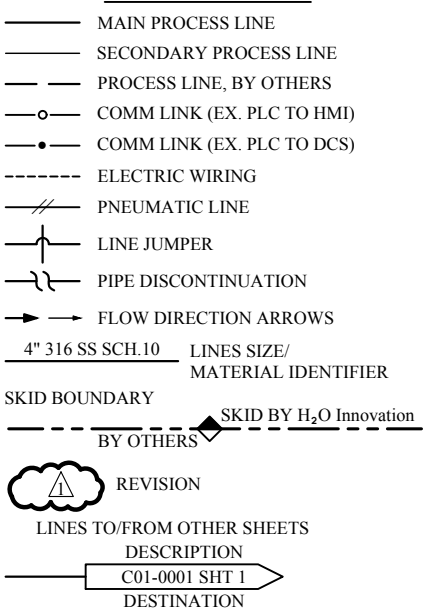

PUMP SYMBOLS

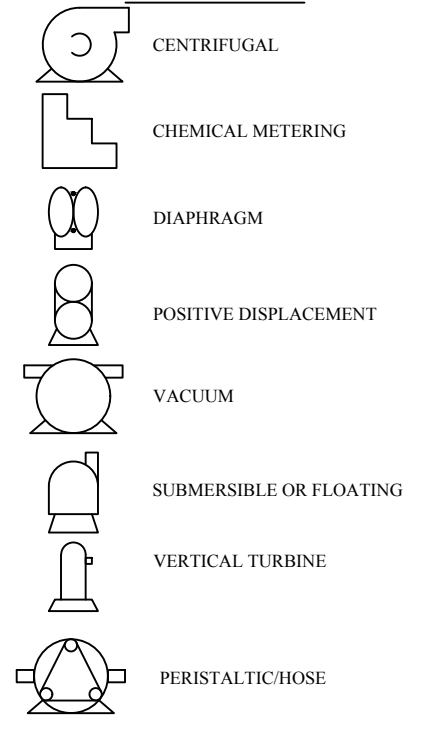

MISCELLANEOUS EQUIPMENT SYMBOLS

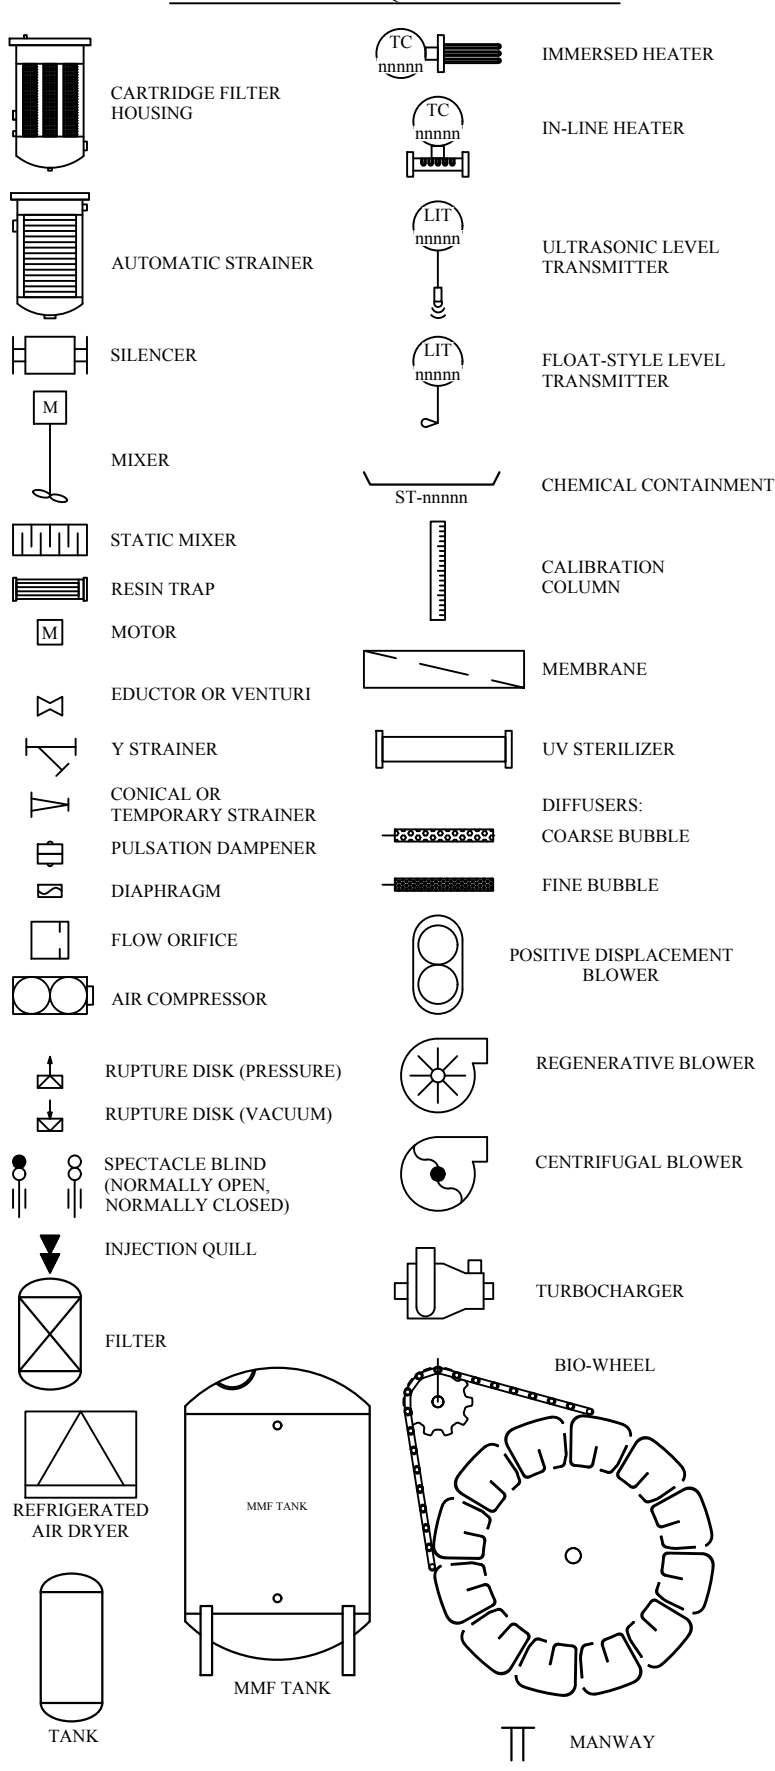

FLOW INSTRUMENTS

FAH	FLOW ALARM HIGH
FAL	FLOW ALARM LOW
FCV	FLOW CONTROL VALVE
FE	FLOW ELEMENT
FI	FLOW INDICATOR
FIC	FLOW INDICATING CONTROLLER
FIT	FLOW INDICATING TRANSMITTER
FR	FLOW RECORDING
FSH	FLOW SWITCH HIGH
FSL	FLOW SWITCH LOW
FV	FLOW CONTROL OR ON/OFF VALVE
FQ	FLOW TOTALIZER
FX	ELEMENT CONTROLLED BY FLOW
FY	FLOW SIGNAL CONVERT. I/P. OR SOLN

FLOW SIGNAL CONVERTER, I/P, & PRESSURE INSTRUMENTS

PAH	PRESSURE ALARM HIGH
PAL	PRESSURE ALARM LOW
PC	PRESSURE CONTROLLER
PCV	SELF REG PRESS CONTROL VALVE
PDH	DIFFERENTIAL PRESSURE HIGH
PDI	DIFFERENTIAL PRESSURE INDICATOR
PDI ^T	DIFF PRESS INDICATING TRANSMITTER
PDSH	DIFFERENTIAL PRESS SWITCH HIGH
PG	PRESSURE GAUGE
PI	PRESSURE INDICATOR
PIC	PRESSURE INDICATING CONTROLLER
PIT	PRESSURE INDICATING TRANSMITTER
PSH	PRESSURE SWITCH HIGH
PSL	PRESSURE SWITCH LOW
PSV	SELF REG PRESS SAFETY VALVE
PT	PRESSURE TRANSMITTER
PX	ELEMENT CONTROLLED BY PRESSURE
PY	PRESS SIGNAL CONVERT, I/P, OR SOLN
PSLH	PRESSURE SWITCH LOW HIGH

PRESSURE SWITCHES ON LEVEL INSTRUMENTS

LAH	LEVEL ALARM HIGH
LAL	LEVEL ALARM LOW
LCV	SELF REG LEVEL CONTROL VALVE
LE	LEVEL ELEMENT
LG	LEVEL GAUGE
LI	LEVEL INDICATOR
LIC	LEVEL INDICATING CONTROLLER
LIT	LEVEL INDICATING TRANSMITTER
LSH	LEVEL SWITCH HIGH
LSL	LEVEL SWITCH LOW
LT	LEVEL TRANSMITTER
LV	LEVEL CONTROL OR ON/OFF VALVE
LX	ELEMENT CONTROLLED BY LEVEL
LY	LEVEL SIGNAL CONVERT. I/P. OR SOLN

TEMPERATURE INSTRUMENTS

TAH	TEMPERATURE ALARM HIGH
TAL	TEMPERATURE ALARM LOW
TC	TEMPERATURE CONTROLLER
TE	TEMPERATURE ELEMENT
TG	TEMPERATURE GAUGE
TI	TEMPERATURE INDICATOR
TIC	TEMP INDICATING CONTROLLER
TIT	TEMP INDICATING TRANSMITTER
TSH	TEMPERATURE SWITCH HIGH
TSL	TEMPERATURE SWITCH LOW
TT	TEMPERATURE TRANSMITTER
TV	TEMP CONTROL OR ON/OFF VALVE
TX	ELEMENT CONTROLLED BY TEMP
TY	TEMP SIGNAL CONVERT, I/P, OR SOLN

ELECTRICAL ABBREVIATIONS

JB	JUNCTION BOX
MCP	MAIN CONTROL PANEL
RIO	REMOTE I/O PANEL
PP	POWER PANEL
VFD	VARIABLE FREQUENCY DRIVE
HOA	HAND-OFF-AUTO

ANALYTICAL INSTRUMENTS

AAH	ANALYTICAL ALARM HIGH
AAL	ANALYTICAL ALARM LOW
AE	ANALYTICAL ELEMENT
AI	ANALYTICAL INDICATOR
ANAL	ANAL INDICATING CONTROLLER
AIT	ANAL INDICATING TRANSMITTER
ASH	ANALYTICAL SWITCH HIGH
ASL	ANALYTICAL SWITCH LOW
AT	ANALYTICAL TRANSMITTER
AX	ELEMENT CONTROLLED BY ANALYTICAL
AY	ANALYTICAL SIGNAL CONVERT, I/P, OR SOL

MISCELLANEOUS INSTRUMENTS

HS	HAND SWITCH
HI	HAND SWITCH POSITION INDICATOR
II	CURRENT INDICATOR
QOI	TOTALIZER INDICATOR
SC	SPEED CONTROLLER
SI	SPEED INDICATOR
YA	MOTOR ALARM
YC	MOTOR CONTROL
YI	MOTOR ON/OFF INDICATOR
ZIC	SWITCH CLOSE INDICATOR
ZIO	SWITCH OPEN INDICATOR
ZSC	POSITION SWITCH CLOSED
ZSO	POSITION SWITCH OPEN
ZT	POSITION TRANSMITTER
ZI	POSITION INDICATOR

POSITION INDICATOR VALVES & EQUIPMENT

AC	AIR COMPRESSOR
ARV	AIR RELEASE VALVE
AS	AIR SUPPLY
B	BLOWER
BT	BULK TOTE
CBD	COARSE BUBBLE DIFFUSER
CV	CHECK VALVE
ED	EDUCTOR
F	FILTER
FBD	FINE BUBBLE DIFFUSER
FL	FAIL LAST (DEFAULT IF NOT SHOWN)
FC	FAIL CLOSED
FO	FAIL OPEN
FGG	CALIBRATION COLUMN
H	HEATER
HCV	HAND CONTROL VALVE
HTR	HEATER
HV	HAND VALVE
M	MOTOR
MX	MIXER
P	PUMP
RT	RESIN TRAP
ST	SPILL TANK
STR	STRAINER
T	TANK
UV	ULTRAVIOLET
HV	HAND VALVE
MV	MULTI FUNCTION VALVE

OTHER ABBREVIATIONS

CAP	CAPACITANCE
CIP	CLEAN-IN-PLACE
COND	CONDUCTIVITY
DO2	DISSOLVED OXYGEN
ESP	EMERGENCY STOP
IA	INSTRUMENT AIR
I/P	CURRENT TO PNEUMATIC CONVERTER
ORP	OXIDATION REDUCTION POTENTIAL
pH	HYDROGEN ION
RES	RESISTIVITY
RTD	RESISTANCE TEMP DETECTOR
SOL	SOLENOID
SP	SET POINT
uS	MICROSIEMENS
MIT	MEMBRANE INTEGRITY TEST

NOTE:
THE INFORMATION, SPECIFICATIONS AND DATA SHOWN
ON THIS PRINT ARE FURNISHED BY AND ARE TO REMAIN
THE PROPERTY OF H₂O INNOVATION.



THE PURPOSE OF THIS DOCUMENT IS TO FACILITATE THE
INSTALLATION, MAINTENANCE AND OPERATION OF THE
EQUIPMENT REPRESENTED BY SAID PRINT. NO OTHER USE OF
THIS DOCUMENT SHALL BE MADE WITHOUT EXPRESS WRITTEN
CONSENT FROM H₂O INNOVATION.

DRAWING REVISION

REV	DATE (DDMMYY)	REVISION DESCRIPTION	DRAWN	CHKD	ENG	APPVD
01	13/05/2020	MODIFIED PER COMMENTS, MODIFIED INTERCONNECTION WITH MAIN PLANT	G.B.	R.D.	R.D.	A.M.
00	04/23/2020	INITIAL RELEASE	Y.D.	R.D.	H.C.	A.M.



UNLESS NOTED OTHERWISE

INTERPRETATION:  

TOLERANCES

FRACTIONS: $\pm \frac{1}{16}$ "

DECIMALS 0.X: ± 0.030

0.XX: ± 0.015

ANGLES: $\pm 0.5^\circ$

HOLE SIZES: $\pm \frac{1}{32}$ "

HOLE CENTERS: $\pm \frac{1}{32}$ "

DO NOT SCALE PRINTS

MELIADINE STP EXPANSION

83 M3/DAY

TITLE: PIPING AND INSTRUMENTATION
DIAGRAMS LEGEND

SCALE: N/A	DRAWING NUMBER: 20C1131-C01-0001 SHEET: 1 of 1	REVISION: 01
---------------	--	-----------------

4

3

2

1

D

D

C

C

B



B

A

A

CONNECT "A"
Light brown line

CONNECT "B"
dark brown line

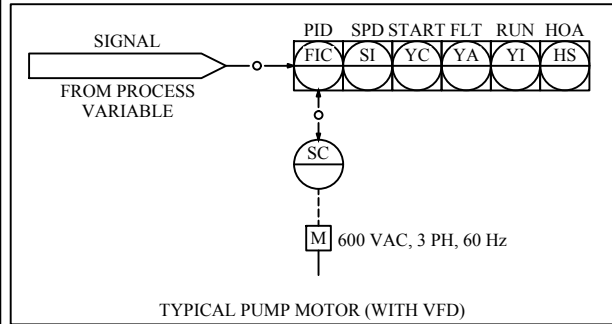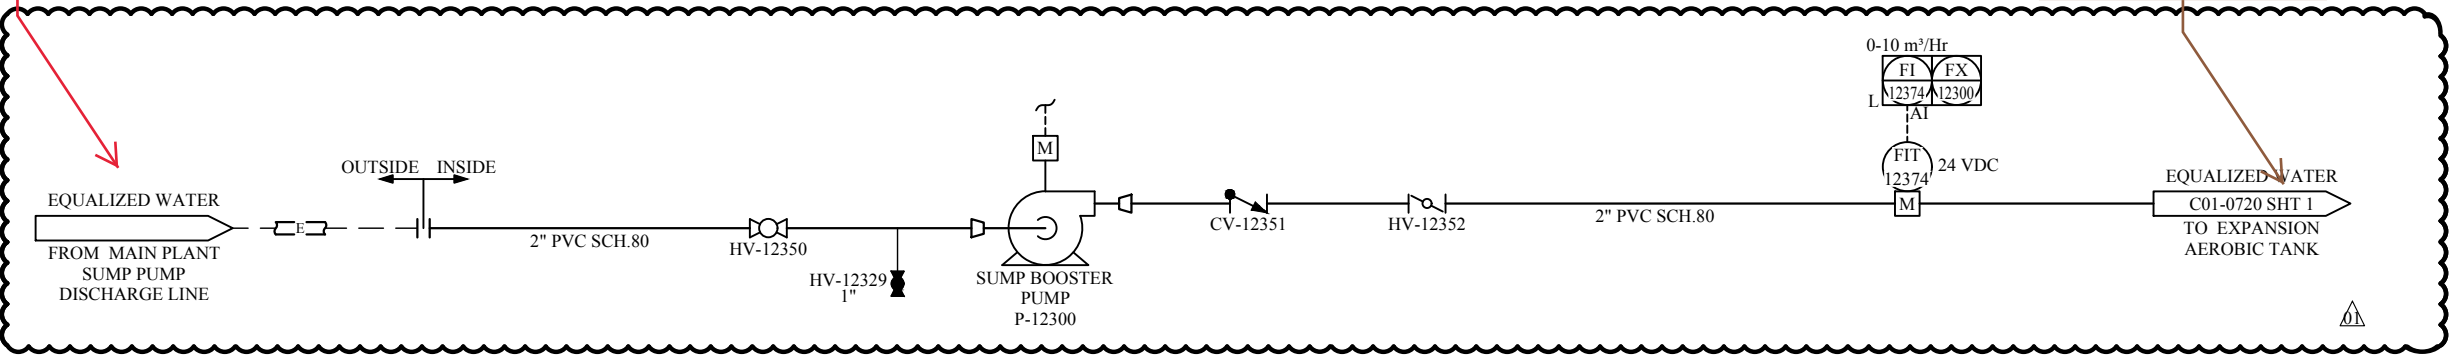

NOTE:
THE INFORMATION, SPECIFICATIONS AND DATA SHOWN ON THIS PRINT ARE FURNISHED BY AND ARE TO REMAIN THE PROPERTY OF H₂O INNOVATION.

THE PURPOSE OF THIS DOCUMENT IS TO FACILITATE THE INSTALLATION, MAINTENANCE AND OPERATION OF THE EQUIPMENT REPRESENTED BY SAID PRINT. NO OTHER USE OF THIS DOCUMENT SHALL BE MADE WITHOUT EXPRESS WRITTEN CONSENT FROM H₂O INNOVATION.

DRAWING REVISION						
REV	DATE (DDMMYY)	REVISION DESCRIPTION	DRAWN	CHKD	ENG	APPVD
01	13/05/2020	MODIFIED PER COMMENTS, MODIFIED INTERCONNECTION WITH MAIN PLANT	G.B.	R.D.	R.D.	A.M.
00	04/23/2020	INITIAL RELEASE	Y.D.	R.D.	H.C.	A.M.



UNLESS NOTED OTHERWISE
INTERPRETATION: ANSI Y14.5

TOLERANCES:
FRACTIONS: $\pm 1/16"$
DECIMALS: ± 0.030
ANGLES: ± 0.015
HOLE SIZES: ± 0.015
HOLE CENTERS: ± 0.015

DO NOT SCALE PRINTS

MELIADINE STP EXPANSION

83 M3/DAY


TITLE:		
SUMP BOOSTER PUMP PIPING & INSTRUMENTATION DIAGRAM		
SCALE: N/A	DRAWING NUMBER: 20C1131-C01-0110	REVISION 01
SHEET: 1 of 1		

4

3

2

1

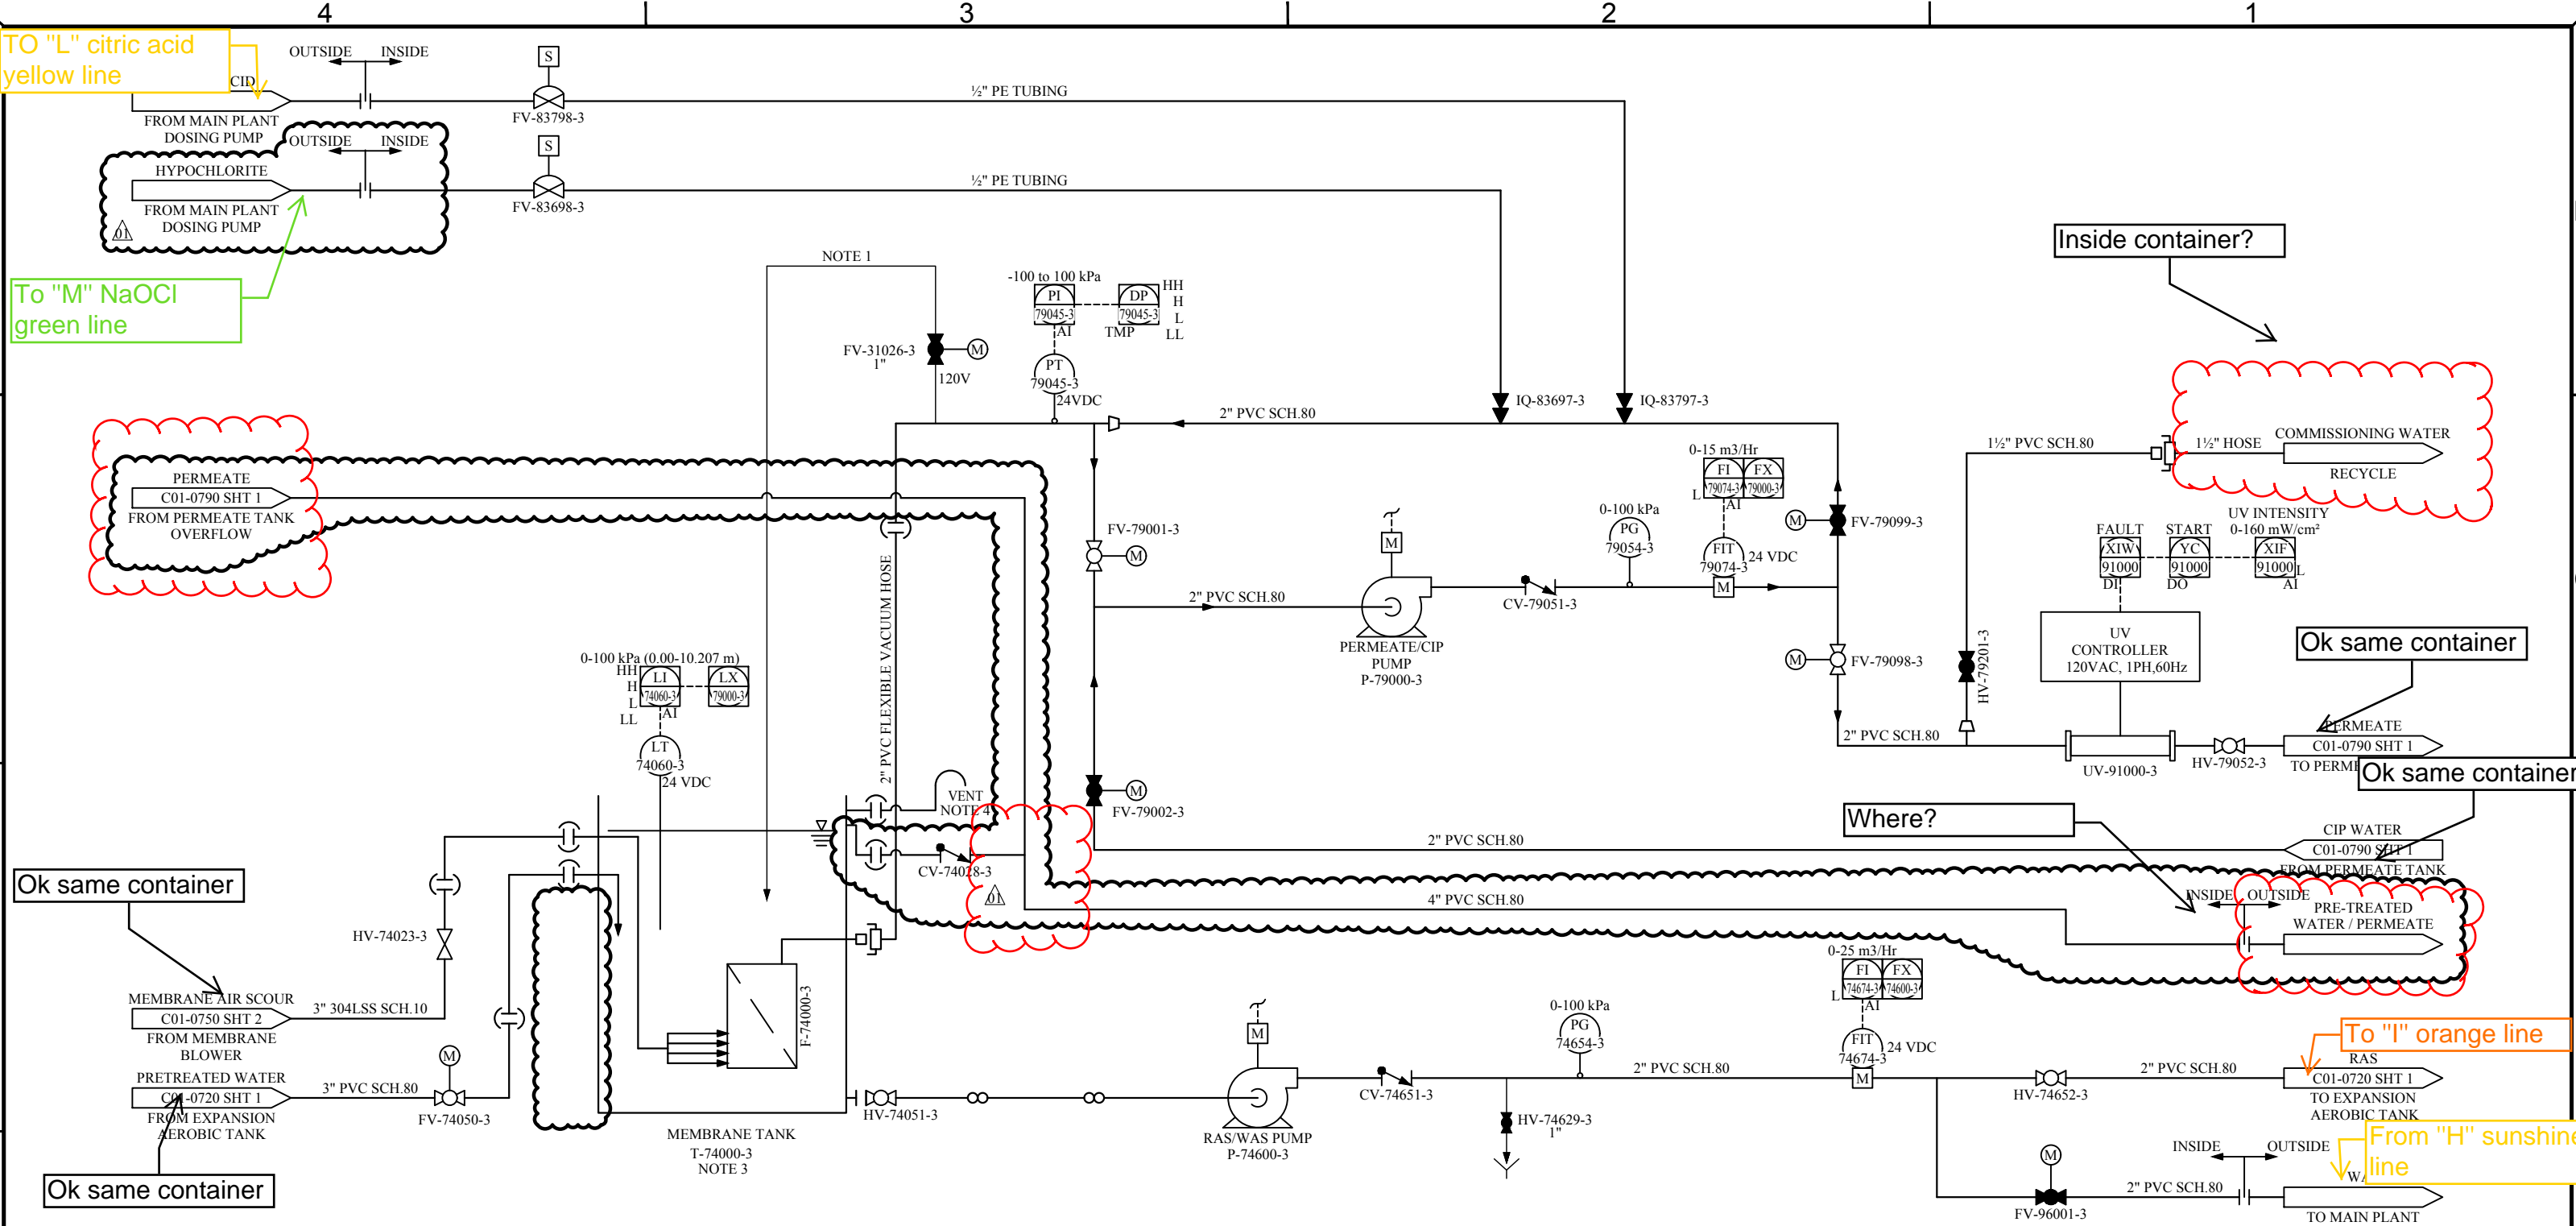

NOTE:
THE INFORMATION, SPECIFICATIONS AND DATA SHOWN ON THIS PRINT ARE FURNISHED BY AND ARE TO REMAIN THE PROPERTY OF H₂O INNOVATION.

THE PURPOSE OF THIS DOCUMENT IS TO FACILITATE THE INSTALLATION, MAINTENANCE AND OPERATION OF THE EQUIPMENT REPRESENTED BY SAID PRINT. NO OTHER USE OF THIS DOCUMENT SHALL BE MADE WITHOUT EXPRESS WRITTEN CONSENT FROM H₂O INNOVATION.

TYPICAL PUMP MOTOR (WITH VFD)

SIGNAL FROM PROCESS VARIABLE

PID, SPD, START, FLT, RUN, HOA

FIC, SI, YC, YA, YI, HS

IAC, AI, DO, DI, DI

SC

600 VAC, 3 PH, 60 Hz

TYPICAL RAS / WAS PUMP MOTOR

START, FLT, RUN, HOA

YC, YA, YI, HS

DO, DI, DI

600 VAC, 3PH, 60HZ

TYPICAL ELECTRIC VALVE

HOA, HSC, HSO

DO, DO

120 VAC, 1 PH, 60 Hz

TYPICAL SOLENOID VALVE

HOA, HS

DO

FY

24 VDC

S

NOTE 6

AAH 74153-1

DI

AE 74153-1

24 VAC

NOTE 7

AAH 74153-2

DI

AE 74153-2

24 VAC

NOTE 8

AAH 74153-3

DI

AE 74153-3

120 V

NOTE 5

LEH 74168

DI

LE 74168

120 V

NOTES:

- HEIGHT OF 4.6 FT REQUIRED ABOVE MEMBRANE TANK LIQUID.
- ALL COMPONENTS GOING INTO RIO-103.
- MBR TANK WITH COVER.
- ALL VENT TO OUTSIDE
- WATER LEAK DETECTOR.
- CH4 DETECTOR.
- H2S DETECTOR.
- SMOKE/CARBON DETECTOR.

<p>NOTE: THE INFORMATION, SPECIFICATIONS AND DATA SHOWN ON THIS PRINT ARE FURNISHED BY AND ARE TO REMAIN THE PROPERTY OF H₂O INNOVATION.</p> <p>THE PURPOSE OF THIS DOCUMENT IS TO FACILITATE THE INSTALLATION, MAINTENANCE AND OPERATION OF THE EQUIPMENT REPRESENTED BY SAID PRINT. NO OTHER USE OF THIS DOCUMENT SHALL BE MADE WITHOUT EXPRESS WRITTEN CONSENT FROM H₂O INNOVATION.</p>	DRAWING REVISION							<p>UNLESS NOTED OTHERWISE</p> <p>INTERPRETATION: ANSI Y14.5</p> <p>TOLERANCES</p> <p>FRACTIONS: ±1/16"</p> <p>DECIMALS: 0.X: ±0.020</p> <p>0.XX: ±0.015</p> <p>ANGLES: ±0.5°</p> <p>SOLE SIZES: ±1/16"</p> <p>SOLE CENTERS: ±1/32"</p> <p>DO NOT SCALE PRINTS</p>	<p>MELIADINE STP EXPANSION</p> <p>83 M3/DAY</p>		<p>TITLE:</p> <p>PIPING AND INSTRUMENTATION PROCESS & INSTRUMENTATION DIAGRAM</p>			
	REV	DATE (DDMMYYYY)	REVISION DESCRIPTION	DRAWN	CHKD	ENG								APPVD
												N/A	20C1131-C01-0740	01
	01	13/05/2020	MODIFIED PER COMMENTS, MODIFIED INTERCONNECTION WITH MAIN PLANT	G.B.	R.D.	R.D.					A.M.			
	00	04/23/2020	INITIAL RELEASE	Y.D.	R.D.	H.C.					A.M.			


4



3

2

1

SHEET: 1 of 1

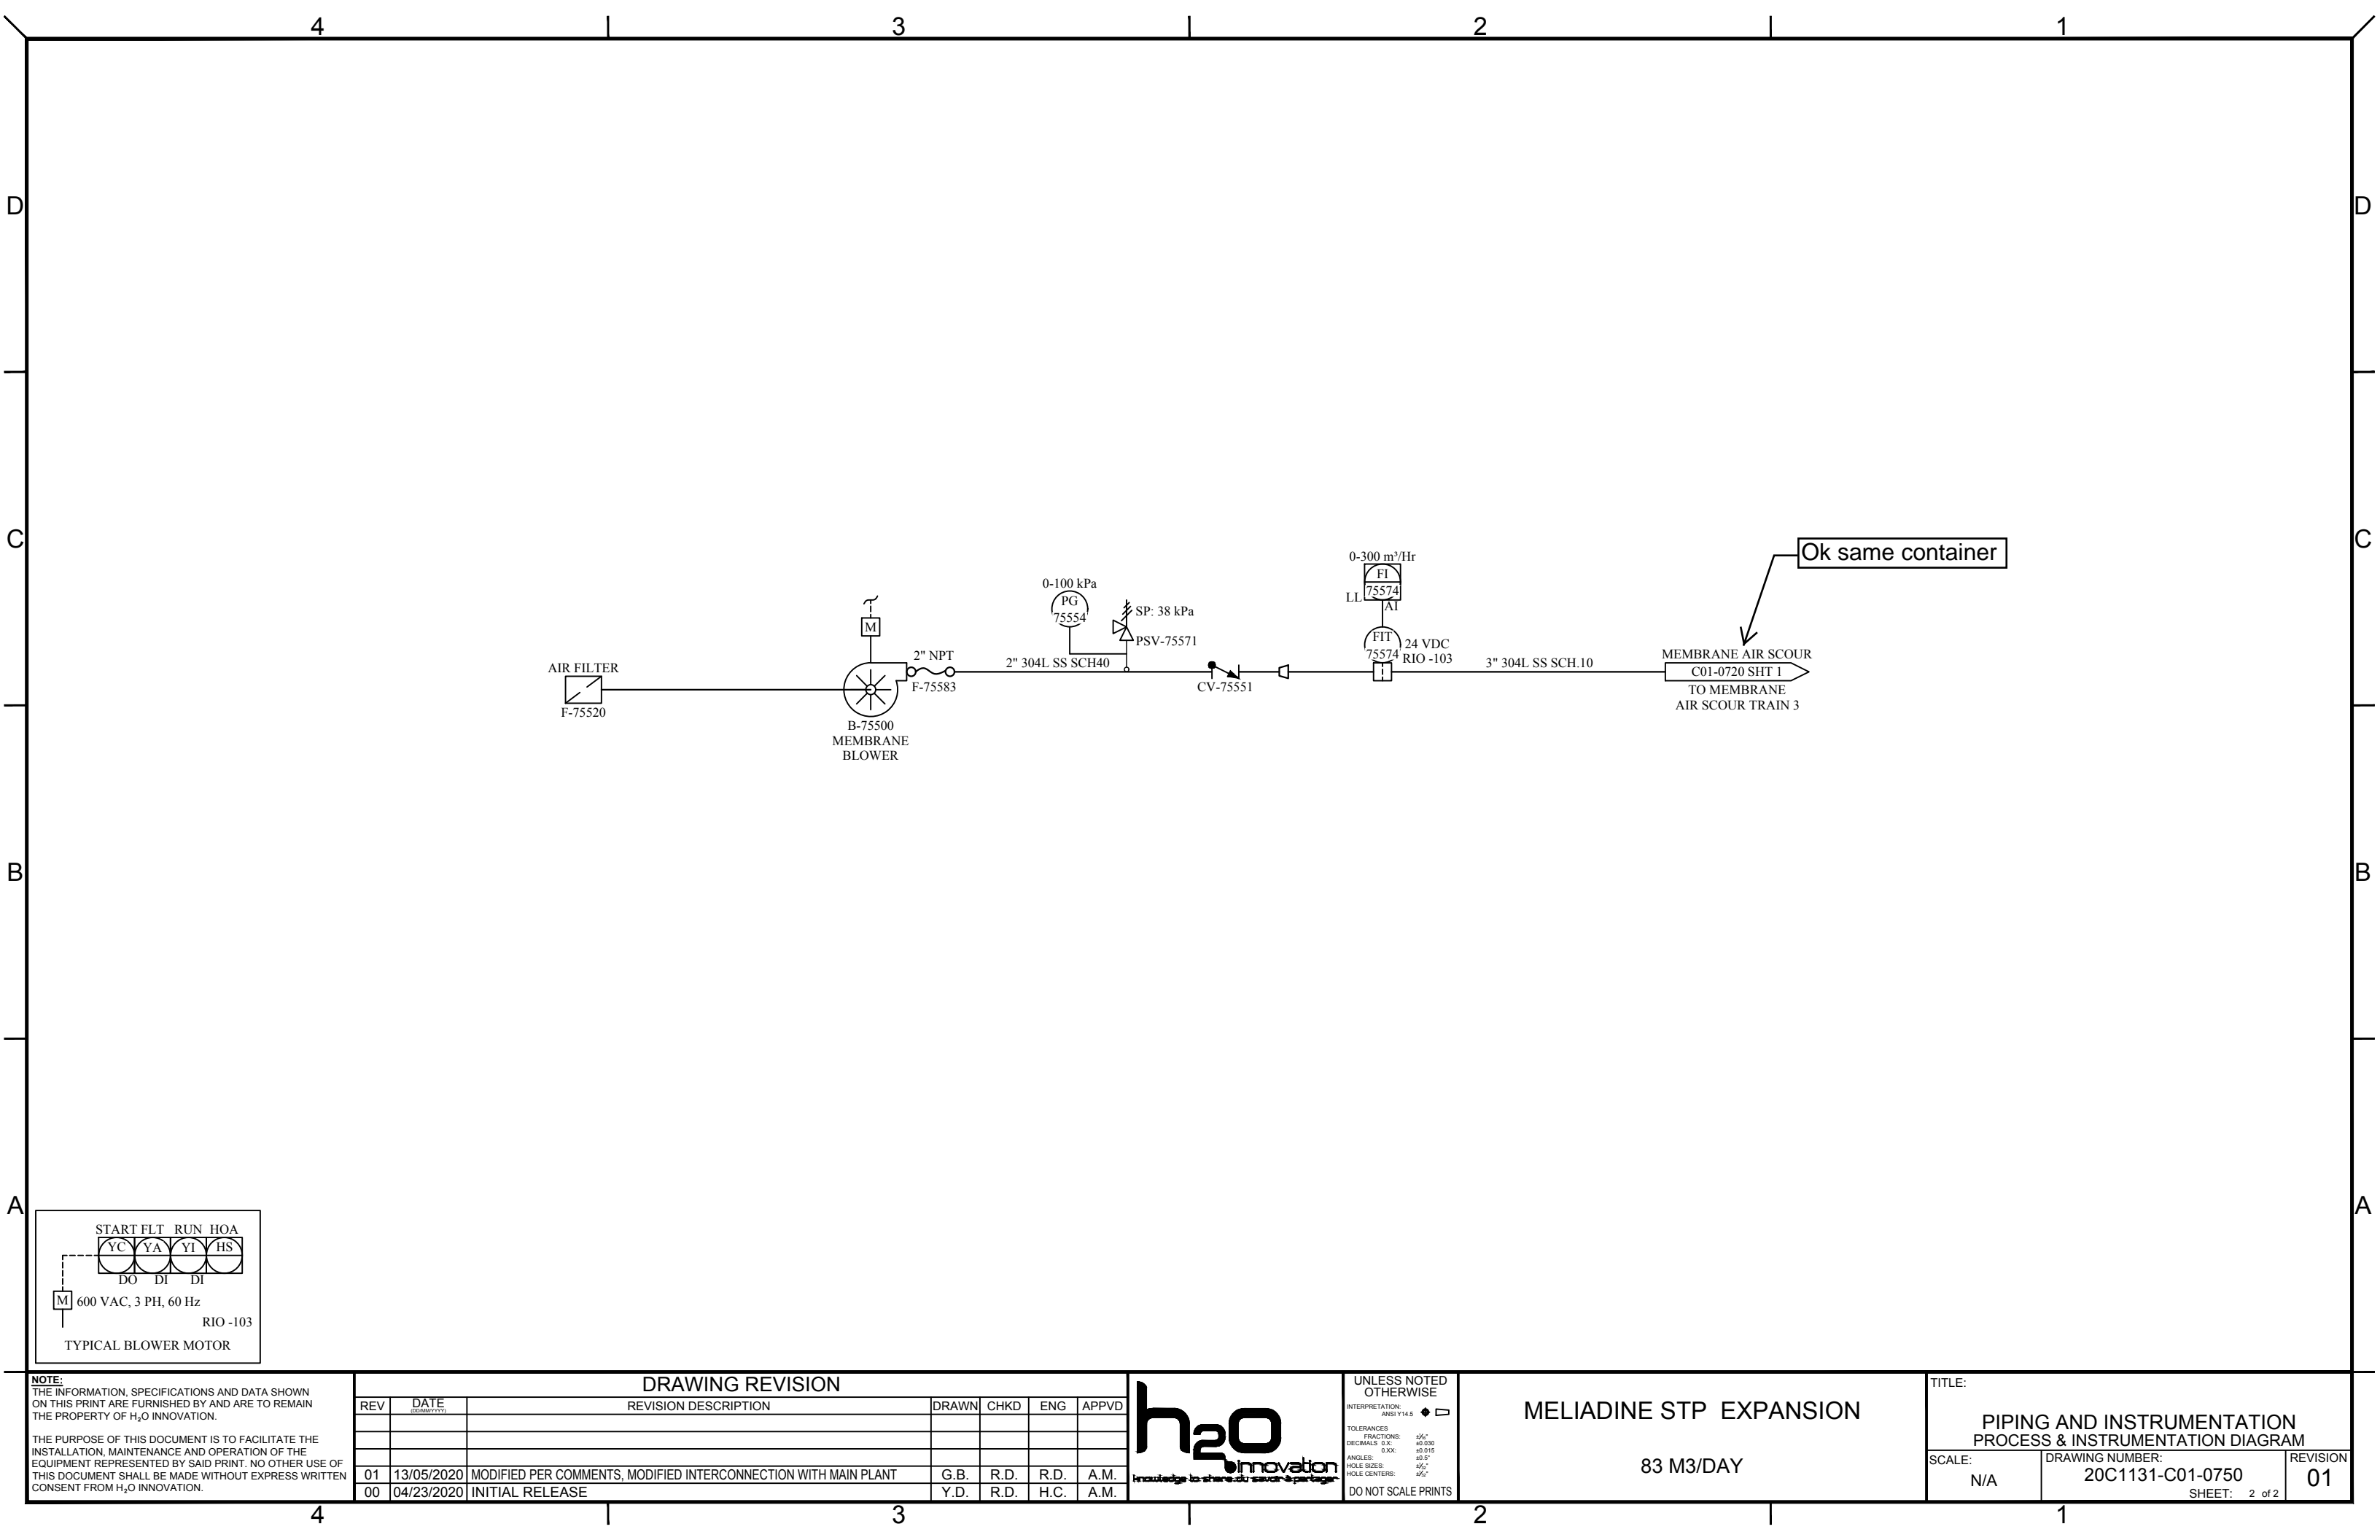

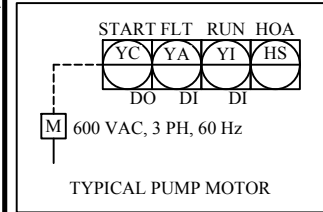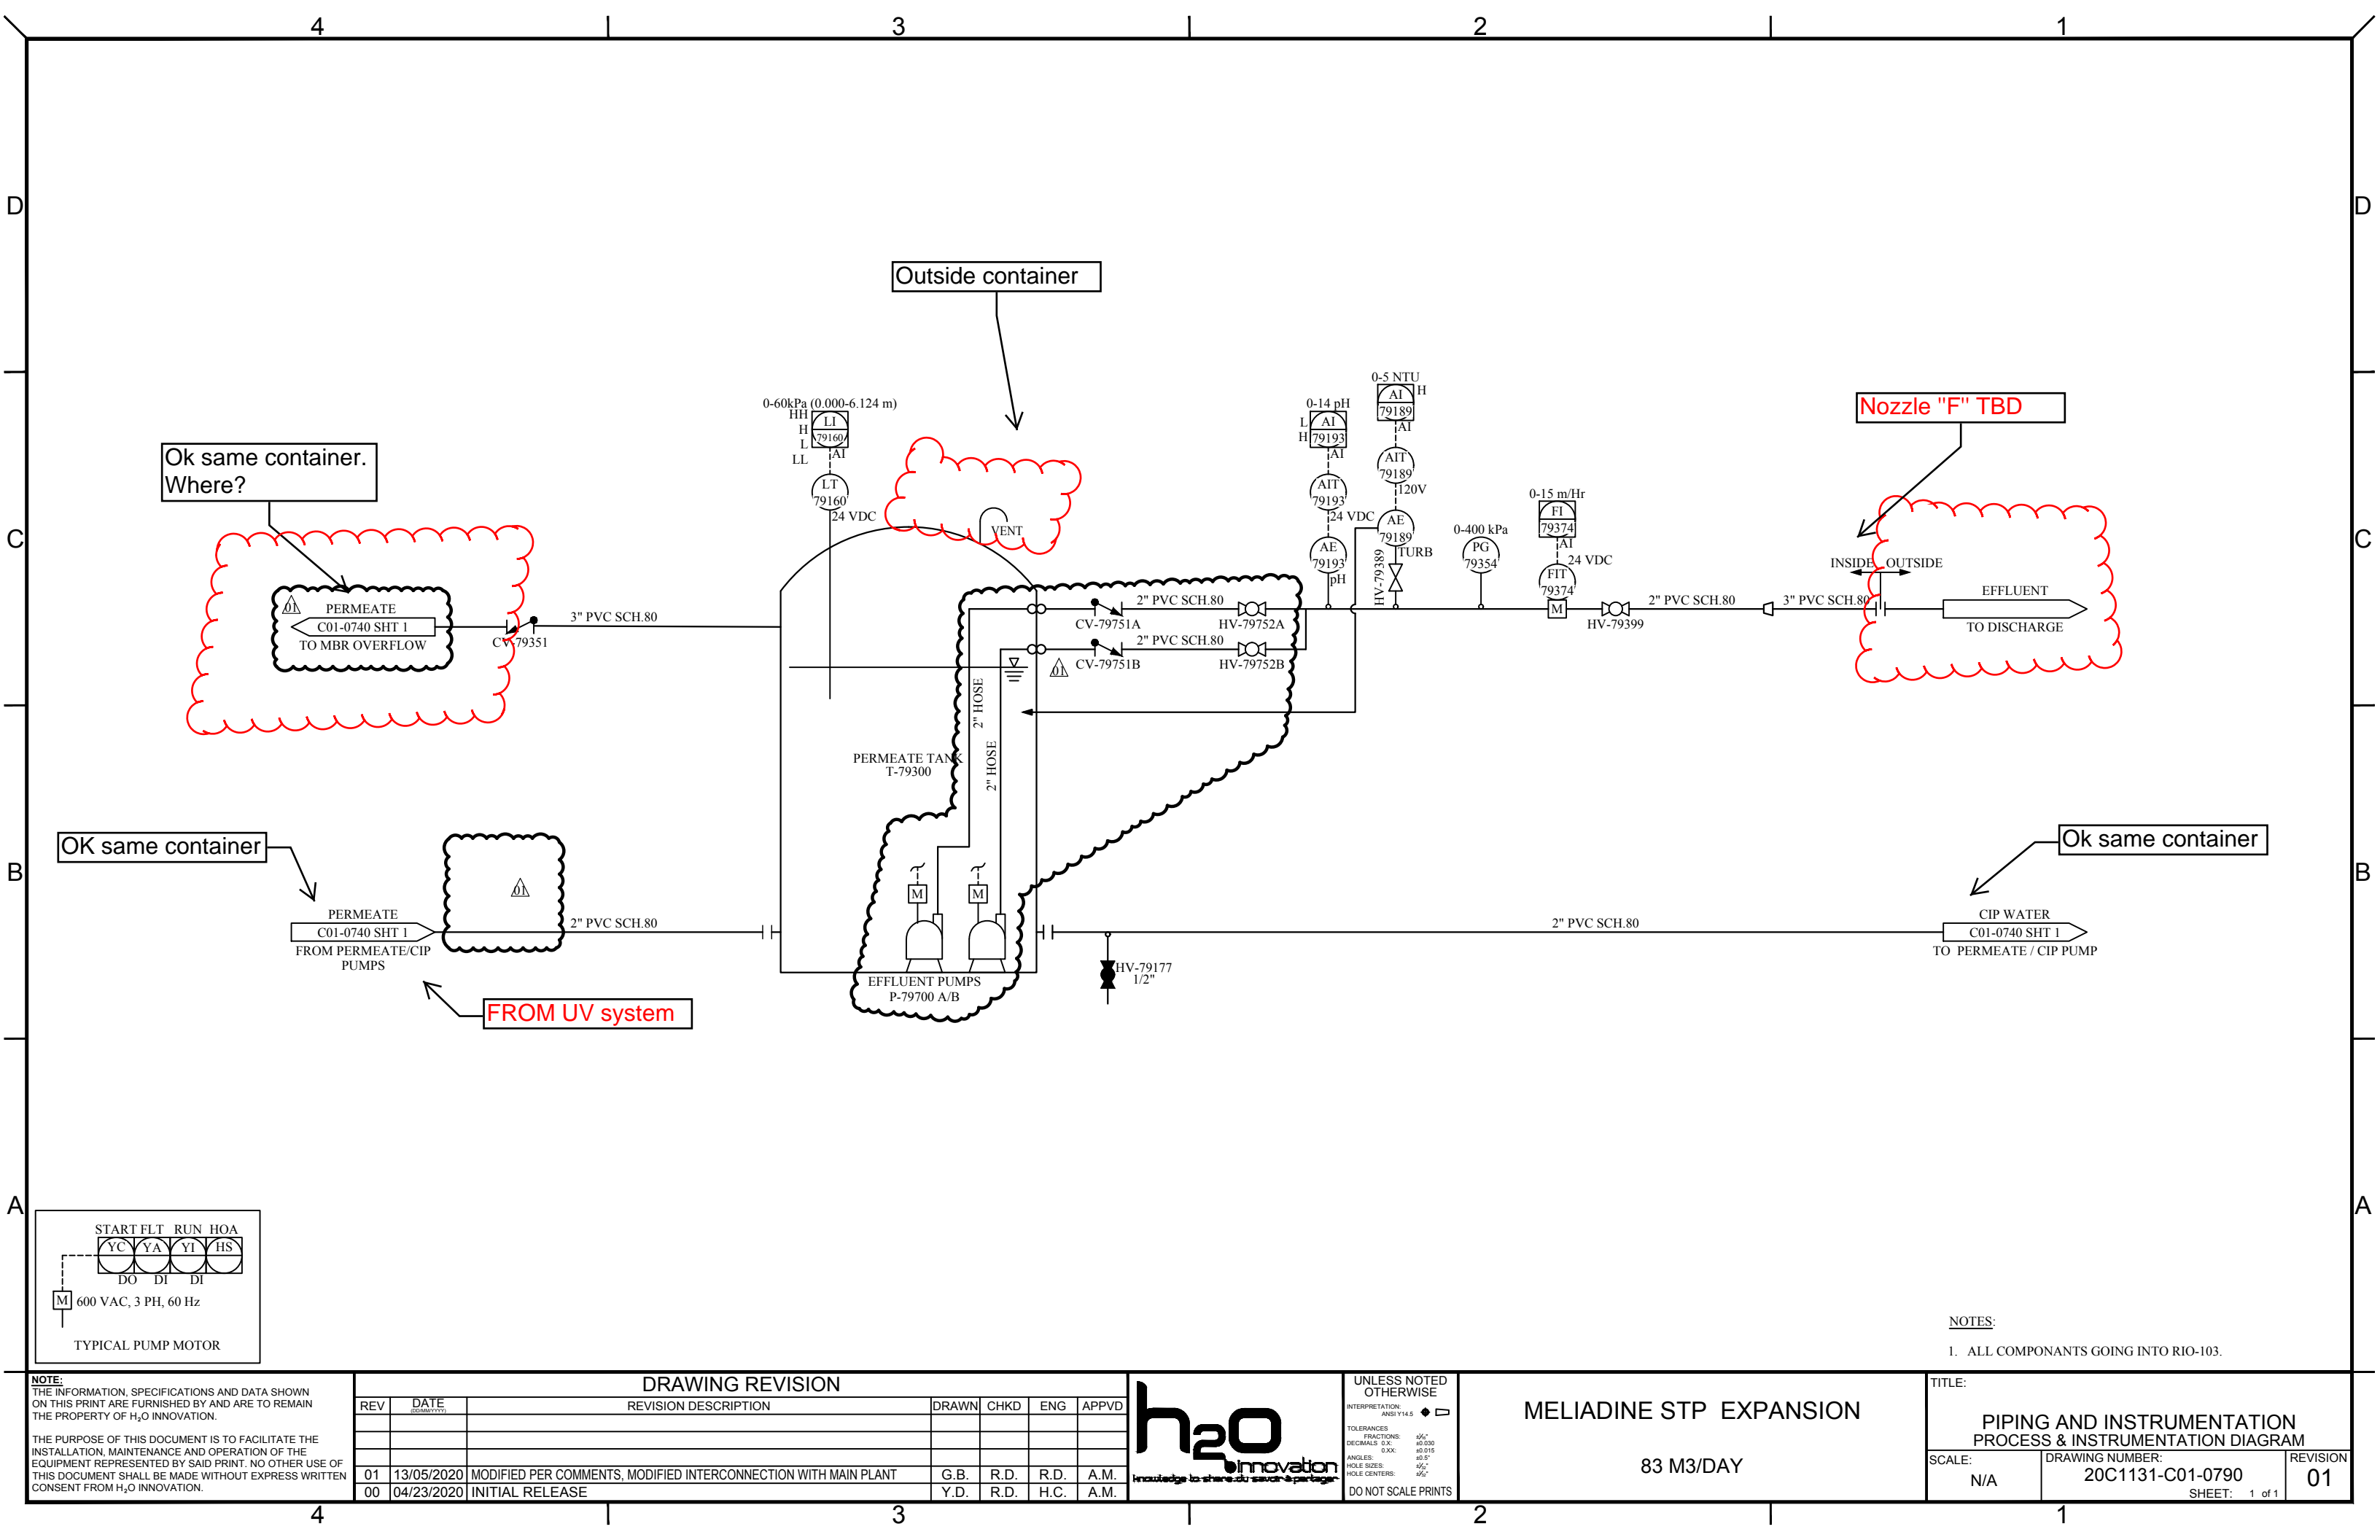

NOTE:
THE INFORMATION, SPECIFICATIONS AND DATA SHOWN ON THIS PRINT ARE FURNISHED BY AND ARE TO REMAIN THE PROPERTY OF H₂O INNOVATION.

THE PURPOSE OF THIS DOCUMENT IS TO FACILITATE THE INSTALLATION, MAINTENANCE AND OPERATION OF THE EQUIPMENT REPRESENTED BY SAID PRINT. NO OTHER USE OF THIS DOCUMENT SHALL BE MADE WITHOUT EXPRESS WRITTEN CONSENT FROM H₂O INNOVATION.

DRAWING REVISION						
REV	DATE (DDMMYY)	REVISION DESCRIPTION	DRAWN	CHKD	ENG	APPVD
01	13/05/2020	MODIFIED PER COMMENTS, MODIFIED INTERCONNECTION WITH MAIN PLANT	G.B.	R.D.	R.D.	A.M.
00	04/23/2020	INITIAL RELEASE	Y.D.	R.D.	H.C.	A.M.



UNLESS NOTED OTHERWISE
INTERPRETATION: ANSI Y14.5

TOLERANCES:
FRACTIONS: $\pm 1/32"$
DECIMALS: ± 0.000
ANGLES: ± 0.015
HOLE SIZES: ± 0.005
HOLE CENTERS: ± 0.005

DO NOT SCALE PRINTS

MELIADINE STP EXPANSION

83 M3/DAY

TITLE:		
PIPING AND INSTRUMENTATION PROCESS & INSTRUMENTATION DIAGRAM		
SCALE: N/A	DRAWING NUMBER: 20C1131-C01-0790	REVISION 01
SHEET: 1 of 1		

Appendix B : Current STP

Vendor Document Status

1 ☐ Received for review and status.


2 ☐ Received with exceptions as noted for review and status.

3 ☐ Not provided.

4 ☐ Complete, no further submission required.


DOCUMENT FOR INFORMATION

6515-C-250-010-275-03M-010-01-0001

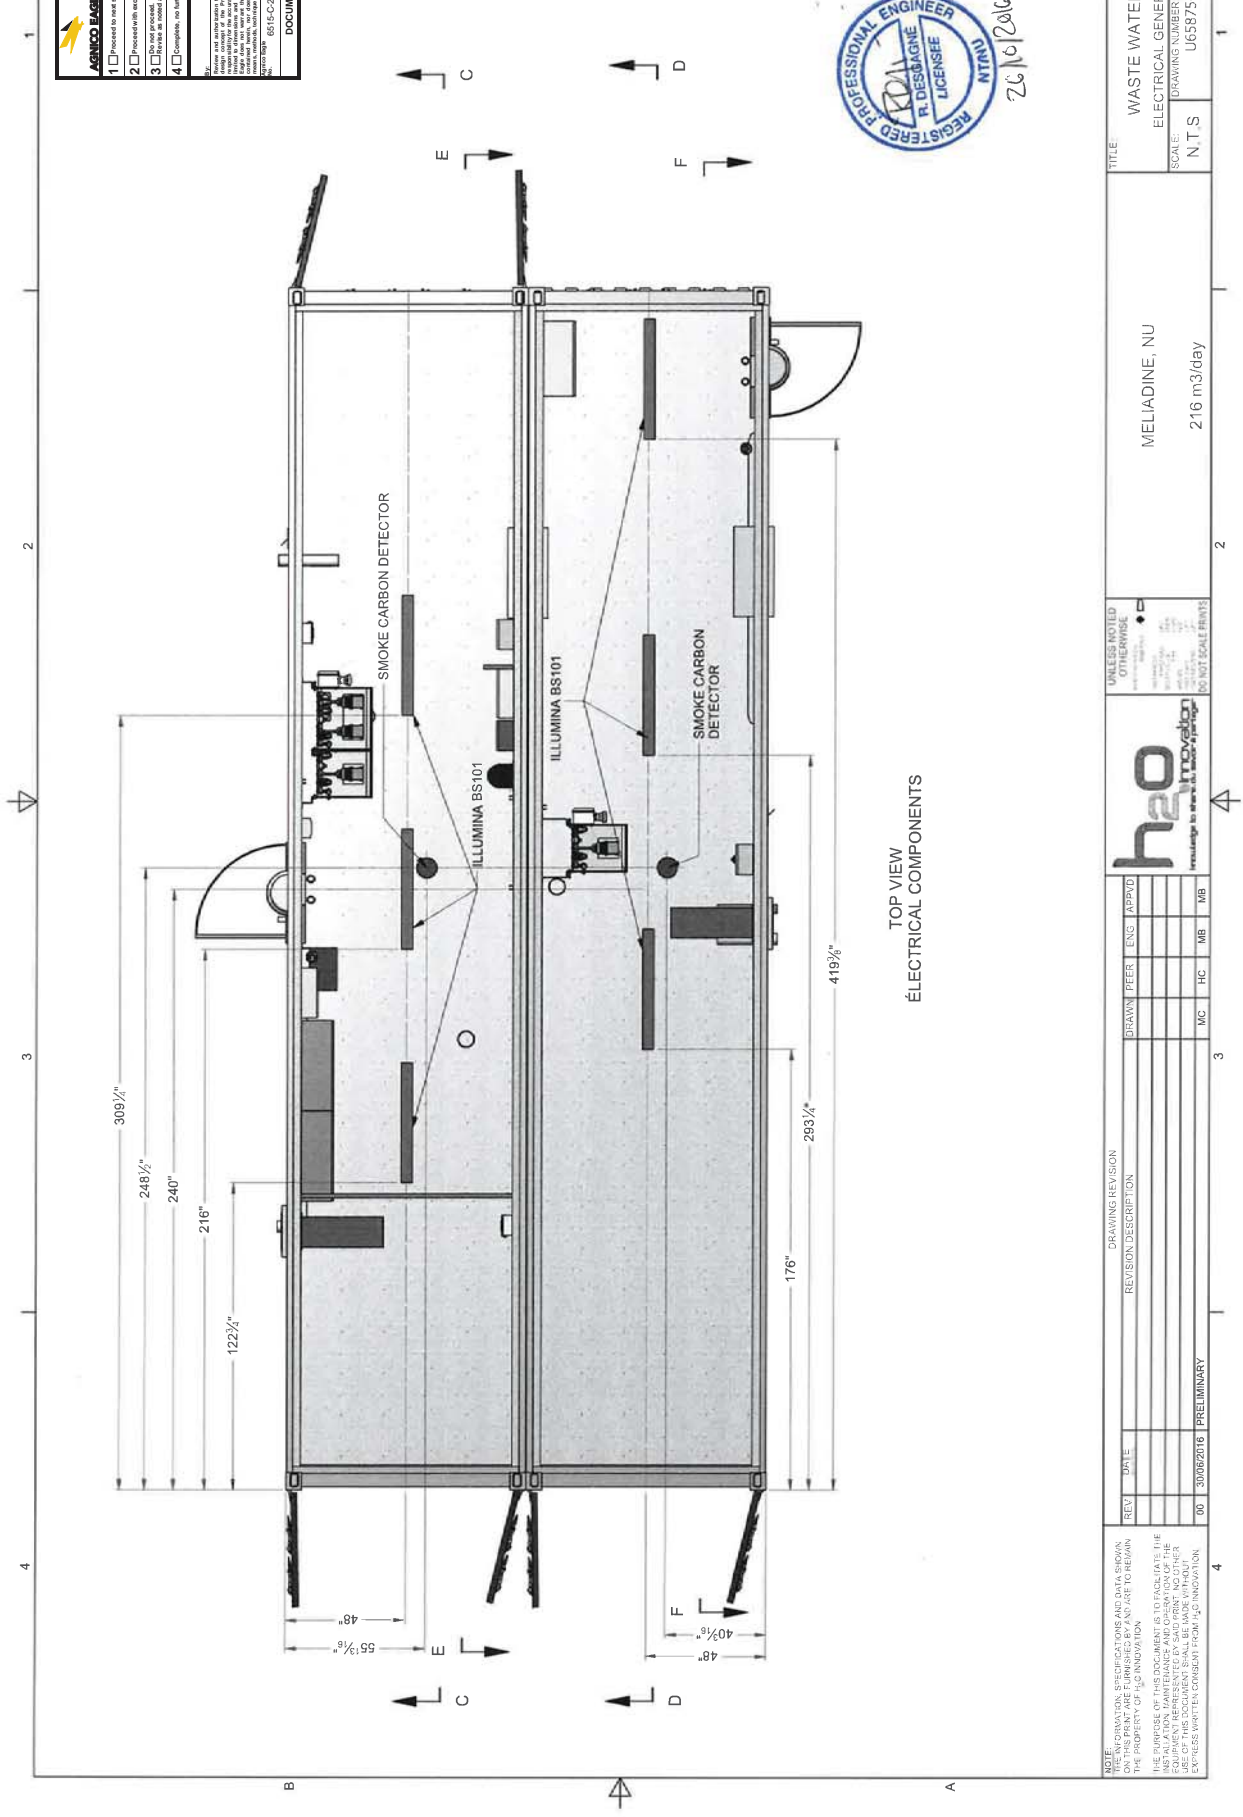



TOP VIEW
ELECTRICAL COMPONENTS

NOTE: INFORMATION, SPECIFICATIONS AND DATA SHOWN ON THIS PRINT ARE FURNISHED BY AND ARE TO REMAIN THE PROPERTY OF H2O INNOVATION. THE PURPOSE OF THIS DOCUMENT IS TO FACILITATE THE EQUIPMENT REPRESENTED BY SAID PRINT. NO OTHER EQUIPMENT OR MATERIALS SHALL BE USED WITHOUT THE EXPRESS WRITTEN CONSENT FROM H2O INNOVATION.				h2o innovation knowledge to make it work				UNLESS NOTED OTHERWISE ALL DIMENSIONS ARE IN INCHES DIMENSIONS IN PARENTHESES ARE IN MILLIMETERS DO NOT SCALE PRINTS	TITLE WASTE WATER CONTAINER ELECTRICAL GENERAL ARRANGEMENT	SCALE N.T.S.	DRAWING NUMBER U65875-B01-0002	REVISION 00
REV	DATE	DRAWING REVISION	REVISION DESCRIPTION	DRAWN	PREP	ENG	APPD					
00	30/06/2016	PRELIMINARY		MC	HC	MB	MB					

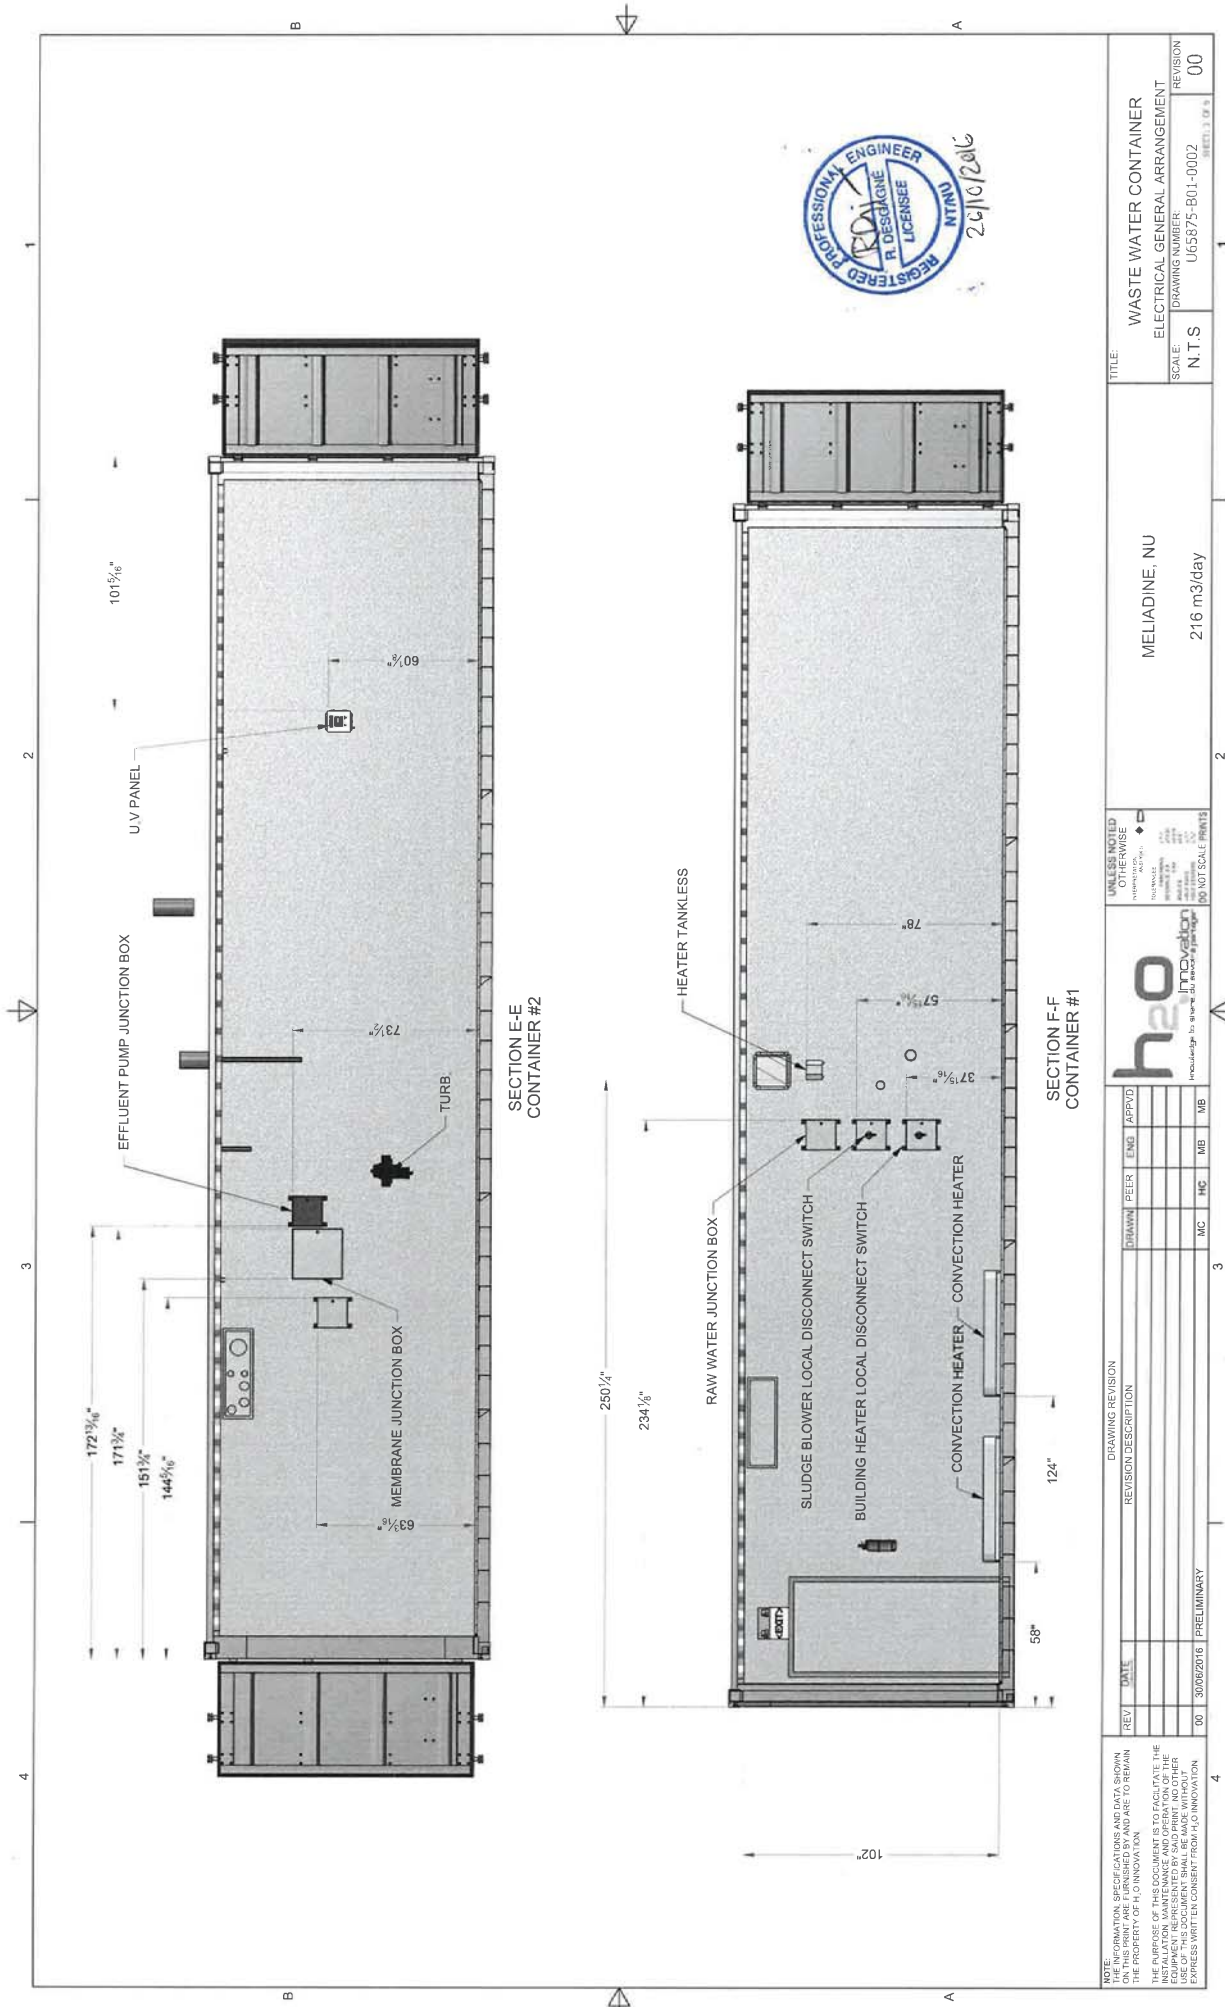

<p>NOTE: INFORMATION, SPECIFICATIONS AND DATA SHOWN ON THIS PRINT ARE FURNISHED BY AND ARE TO REMAIN THE PROPERTY OF H.O. INNOVATION.</p> <p>THE PURPOSE OF THIS DOCUMENT IS TO FACILITATE THE INSTALLATION, OPERATION AND MAINTENANCE OF THE EQUIPMENT REPRESENTED BY SAID PRINT. NO OTHER USES OR MODIFICATIONS ARE TO BE MADE WITHOUT THE EXPRESS WRITTEN CONSENT FROM H.O. INNOVATION.</p>				<p>UNLESS NOTED OTHERWISE (SEE NOTE 1)</p> <p>DO NOT SCALE PRINTS</p>				<p>h.o. innovation</p> <p>INNOVATION</p>				<p>SCALE: N.T.S.</p> <p>DRAWING NUMBER: U65875-B01-0002</p> <p>REVISION: 00</p>			
<p>SECTION E-E</p> <p>CONTAINER #2</p>				<p>SECTION F-F</p> <p>CONTAINER #1</p>				<p>WASTE WATER CONTAINER</p> <p>ELECTRICAL GENERAL ARRANGEMENT</p>				<p>TITLE:</p>			
<p>REV. DATE</p>				<p>DRAWING REVISION</p>				<p>MELIADINE, NU</p>				<p>216 m3/day</p>			
<p>00 30/06/2016 PRELIMINARY</p>				<p>3</p>				<p>2</p>				<p>1</p>			

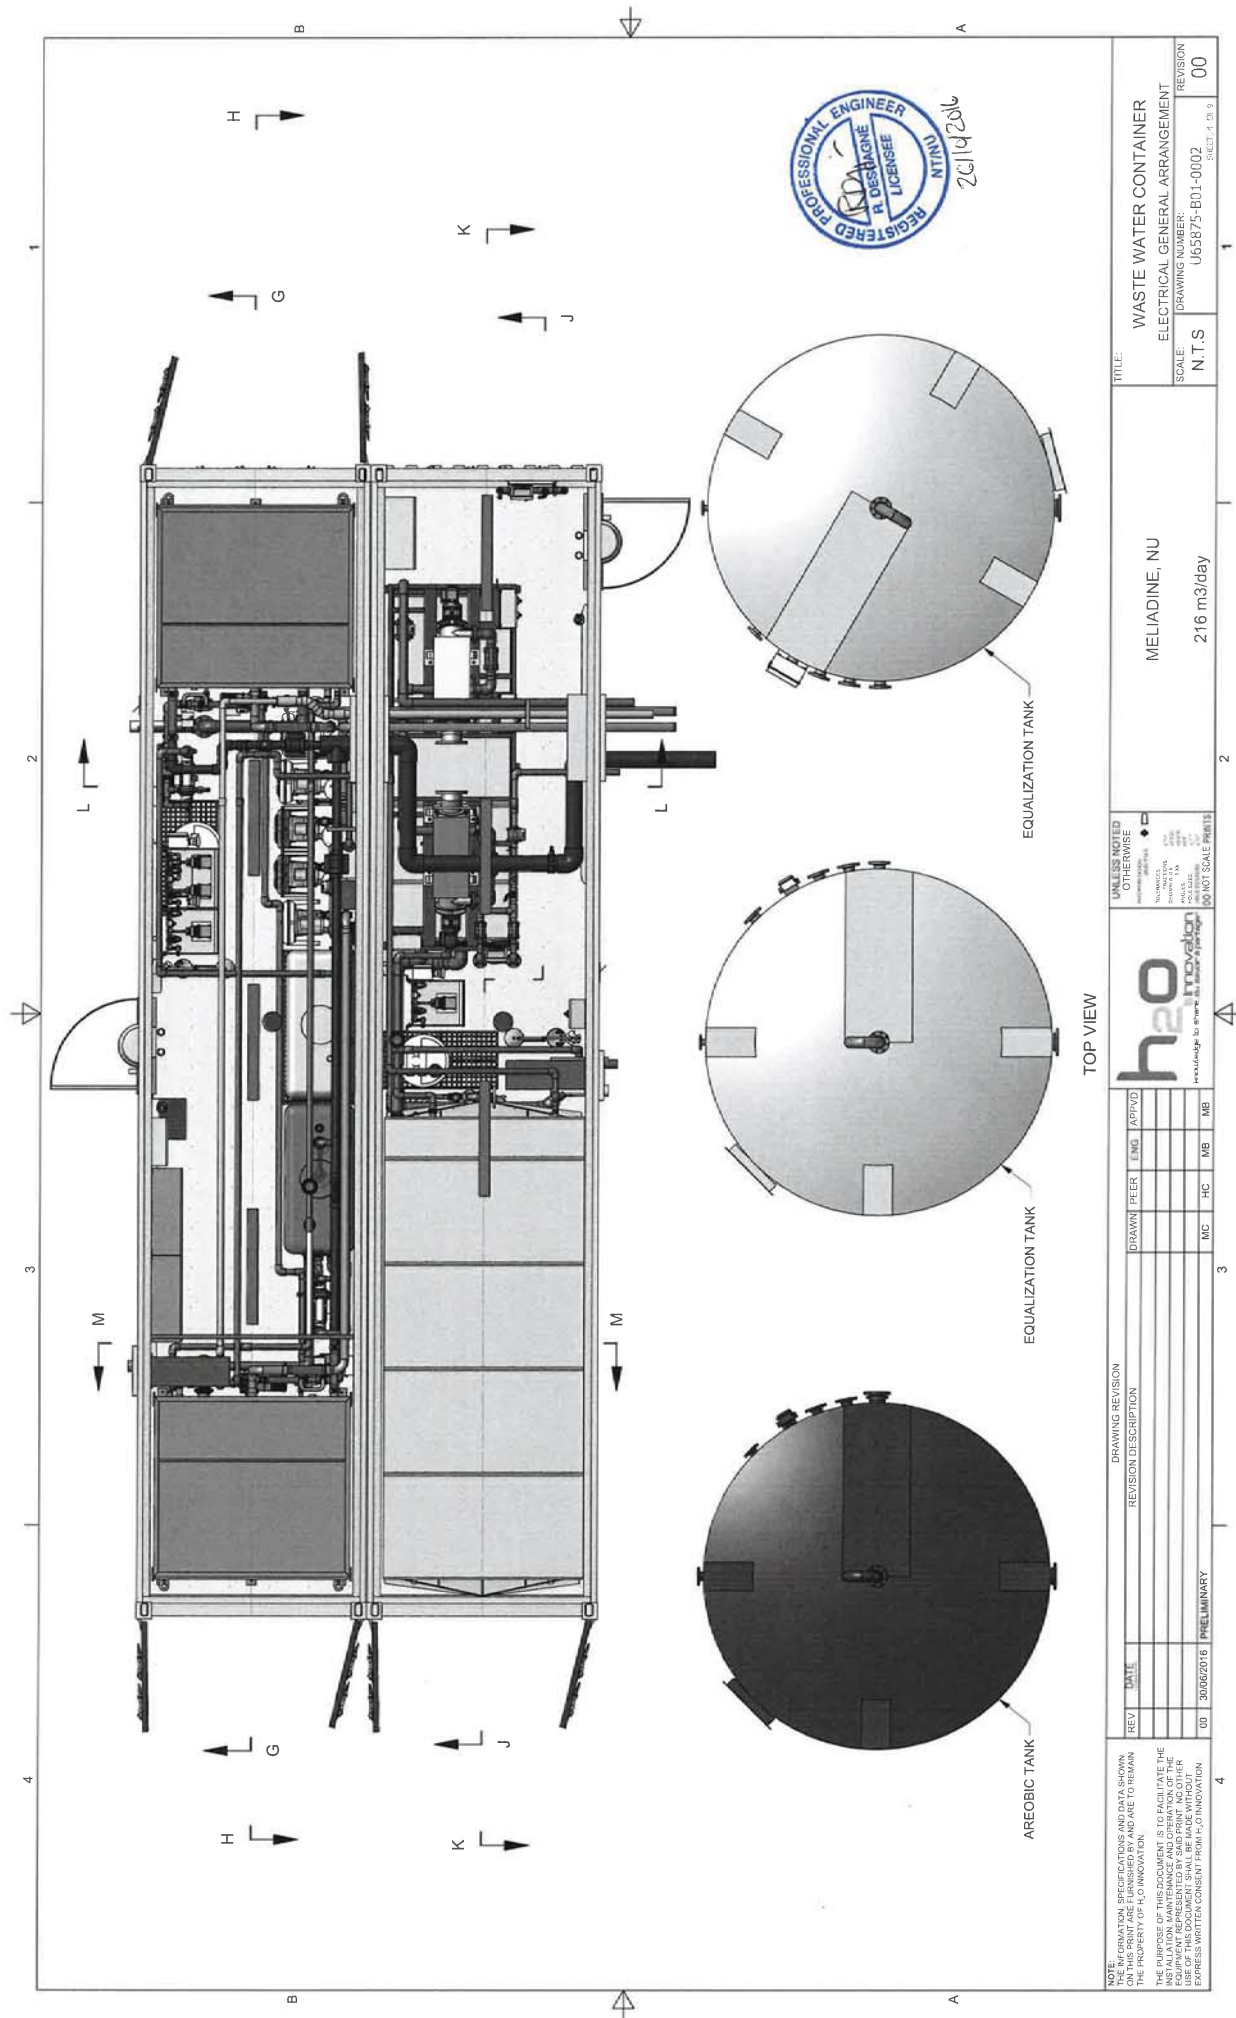

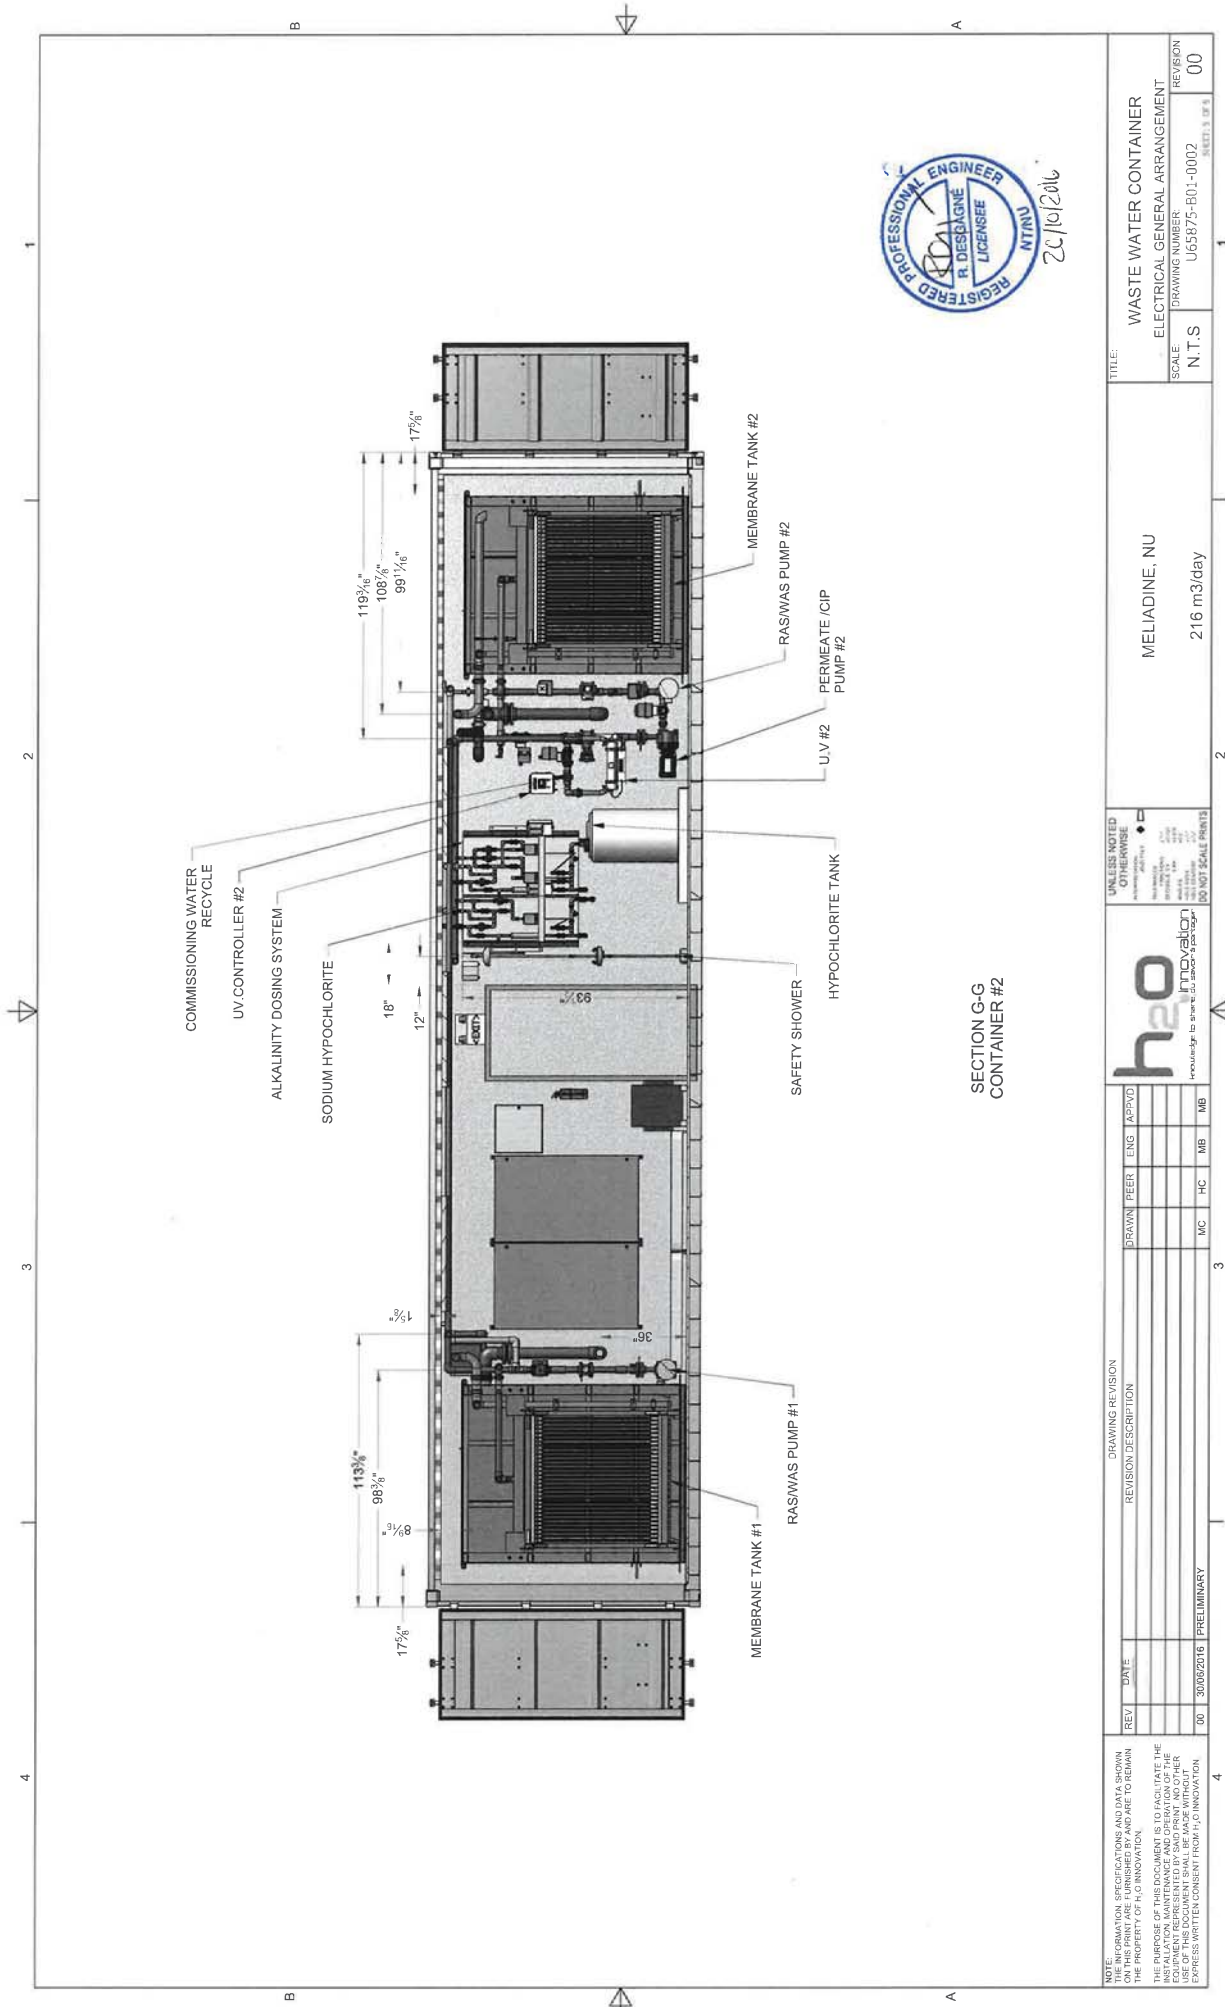















SECTION G-G
CONTAINER #2

<p>NOTE: INFORMATION, SPECIFICATIONS AND DATA SHOWN ON THIS PRINT ARE FURNISHED BY AND ARE TO REMAIN THE PROPERTY OF H2O INNOVATION.</p> <p>THE PURPOSE OF THIS DOCUMENT IS TO FACILITATE THE USE OF THIS DOCUMENT BY THE USER. THE USER SHALL BE RESPONSIBLE FOR THE PROPER USE OF THIS DOCUMENT. THE USER SHALL BE RESPONSIBLE FOR THE PROPER USE OF THIS DOCUMENT.</p>				<p>UNLESS NOTED OTHERWISE, ALL DIMENSIONS SHALL BE IN INCHES. DIMENSIONS SHALL BE TO FACE UNLESS NOTED OTHERWISE. DO NOT SCALE PRINTS.</p>				<p>h2o innovation Engineering & Construction</p>				<p>WASTE WATER CONTAINER ELECTRICAL GENERAL ARRANGEMENT</p>				<p>REVISION 00</p>			
REV	DATE	DRAWING REVISION				DRAWN	CHKD	ENG	ASPD	TITLE				SCALE	DRAWING NUMBER	SHEET 3 OF 8			
		REVISION DESCRIPTION								MELIADINE, NU				N.T.S.	U65875-B01-0002	216 m3/day			
00	30/06/2016	PRELIMINARY				MC	HC	MB	MB	2						1			



[illegible]

NOTE: INFORMATION, SPECIFICATIONS, AND DATA SHOWN ON THIS PRINT ARE FURNISHED BY AND ARE TO REMAIN THE PROPERTY OF H2O INNOVATION	REV#		DATE	REVISION DESCRIPTION	DRAWING CHK'D		ENG	APP'D	 10000 Kingsway Dr. Suite 200 Dallas, TX 75243 Tel: 972.382.2200 Fax: 972.382.2201 www.h2oinnovation.com © 2017 H2O INNOVATION, INC.	UNLESS NOTED OTHERWISE: DIMENSIONS: 1/8" = 1'-0" ♦	TITLE:	PROCESS AND INSTRUMENT DIAGRAMS LEGEND	SCALE:	DRAWING NUMBER: P65873-C01-0001	REVISION: 03
	DRAFTING REVISION		M.P. S.B. R.D. A.M.		M.P. S.B. R.D. A.M.		M.P. S.B. R.D. A.M.								
THE PURPOSE OF THIS DOCUMENT IS TO FACILITATE THE INSTALLATION, MAINTENANCE AND OPERATION OF THE CONTAINERIZED UNIT SHOWN ON THIS DRAWING. THIS DOCUMENT SHALL BE MADE WITHOUT EXPRESS WRITTEN CONSENT FROM H2O INNOVATION.	03		09/08/2016	AS BUILT	M.P. S.B. R.D. A.M.		M.P.	S.B.	R.D.	A.M.	WTP CONTAINERIZED UNIT	MELIADINE	N/A	P65873-C01-0001	c. 011
	02		25/07/2016	REVISED AS PER COMMENTS	M.P. S.B. R.D. A.M.		M.P.	S.B.	R.D.	A.M.					
	01		23/05/2016	AS PER COMMENTS	M.P. S.B. R.D. A.M.		M.P.	S.B.	R.D.	A.M.					
			01	13/05/2016	INITIAL RELEASE	M.P. S.B. R.D. A.M.		M.P.	S.B.	R.D.	A.M.	DO NOT SCALE PRINTS			

VALVE SYMBOLS	
NOBEN CLOSED	        
	    

BACK PRESSURE
REGULATING








FLOW CONTROL






2-WAY SOLENOID











3-WAY SOLENOID











4-WAY SOLENOID

















AIR RELEASE

	VACUUM BREAKER
	PRESSURE RELEASE
	SLICE GATEWEIR
	VALVE ACTUATOR SYMBOLS
	PNEUMATIC (FAIL LAST POSITION)
	PNEUMATIC FAIL CLOSE
	PNEUMATIC FAIL OPEN

	ELECTRIC
	DIAPHRAGM
	POSITIONER (ANY ACTUATOR TYPE)
	HAND OVERRIDE (ANY ACTUATOR TYPE)
	TRAVEL STOPS (ANY ACTUATOR TYPE)

	MAIN PROCESS LINE
	SECONDARY PROCESS LINE
	PROCESS LINE, BY OTHERS
	COMM LINK (EX. PLC TO HM)
	COMM LINK (EX. PLC TO DCS)
	ELECTRIC WIRING
	PNEUMATIC LINE
	LINE JUMPER
	PIPE DISCONTINUATION
	FLOW DIRECTION ARROWS


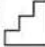





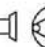
					DISCRETE INSTRUMENT
					PRIMARY PLC OR DCS SHARED CONTROL
					SECONDARY PLC OR DCS SHARED CONTROL
					COMPUTER FUNCTION


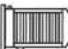

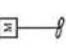








SIGNAL PROCESSING FUNCTION		INSTRUMENT CONNECTIONS		PIPING SYMBOLS	
	AUTOMANUAL		SOCKET WELDED		FLANGED CONNECTION
	ADDITIONS/IMMATION		WELDED		BLIND FLANGE
	DIFFERENTIAL				QUICK DISCONNECT
	INTER LOGIC FUNCTION				VETRICATIC
	AVERAGING				QUICK DISCONNECT
					CAULX
					CAPPED PIPE END
					EXPANSION
					UNIONS
					ISOLATION JOINT
					HEAT TRACER
					INSULATION THICKNESS
					CONTAINMENT
					DOUBLE
					THREAD CONNECTION
					HEAT TRACER
					INSULATION THICKNESS
					CONTAINMENT
					DOUBLE
					THREAD CONNECTION
					HEAT TRACER
					INSULATION THICKNESS







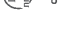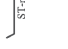

PIPPING ABBREVIATIONS	
316	STAINLESS STEEL
316L	LOW CARBON 316 STAINLESS STEEL
304	LOW CARBON 304 STAINLESS STEEL
304L	LOW CARBON 304 STAINLESS STEEL
CPVC	CHLORINATED POLYVINYL CHLORIDE
HDPE	HIGH-DENSITY POLYETHYLENE
PE	POLYETHYLENE
PP	POLYPROPYLENE
PVC	POLYVINYL CHLORIDE
RUBBER	RUBBER LINED CARBON STEEL
SCHEDULE	SCHEDULE
SDR	STANDARD DIMENSION RATIO
CML	CEMENT MORTAR LINED

LINE SYMBOLOLOGY	
MAIN PROCESS LINE	
PROCESSING PROCESS LINE	
SECONDARY LINE, BY OTHERS	
COMAN LINK (P.L.C TO IMI)	—○—
COMAN LINK (EX. P.L.C TO DCS)	—◇—
ELECTRIC WIRING	—●—
PNEUMATIC LINE	—■—

LINE JUMPER
PIPE DISCONTINUATION
FLOW DIRECTION ARROWS
LINE SIZE/
MATERIAL IDENTIFIER
SKID BOUNDARY
BY OTHERS
REVISION
LINES TO/FROM OTHER SHEETS
DISCUSSION
C01-0001 SHT 1
DESTINATION

	CENTRIFUGAL
	CHEMICAL METERING
	DIAPHRAGM
	POSITIVE DISPLACEMENT
	VACUUM
	SUBMERSIBLE OR FLOATING
	VERTICAL TURBINE
	PERISTALTIC

MISCELLANEOUS EQUIPMENT SYMBOLS	
	CARTRIDGE FILTER HOUSING
	AUTOMATIC STRAINER
	SILENCER
	MIXER
	STATIC MIXER
	RESIN TRAP
	IMMERSED HEATER
	IN-LINE HEATER
	ULTRASONIC LEVEL TRANSMITTER
	FLOAT-STYLE LEVEL TRANSMITTER
	CHEMICAL CONTAINMENT
	CALIBRATION COLUMN

							
MOTOR	EDUCTOR OR VENTURI	V STRAINER	CONICAL OR TEMPORARY STRAINER	PULSATION DAMPENER	DIAPHRAGM	FLOW ORIFICE	AIR COMPRESSOR

[illegible]

FLOW INSTRUMENTS	
PAH	FLOW ALARM HIGH
PAI	FLOW ALARM LOW
PAV	FLOW ALARM VALVE
FE	FLOW ELEMENT
FI	FLOW INDICATOR
FIC	FLOW INDICATING CONTROLLER
FIT	FLOW INDICATING TRANSMITTER
FR	FLOW RECORDING
FT	FLOW TRANSDUCER
FV	FLOW SWITCH LOW
FV	FLOW SWITCH HIGH
FV	FLOW TOTALIZER
FX	ELEMENT CONTROLLED BY FLOW
FX	ELEMENT CONTROLLED BY FLOW OR SOLN
FX	ELEMENT CONTROLLED BY FLOW OR SOLN
PRESSURE INSTRUMENTS	
PAH	PRESSURE ALARM HIGH
PAI	PRESSURE ALARM LOW
PCV	PRESSURE CONTROLLER
PCV	SELF REG PRESS CONTROLLER
PDH	DIFFERENTIAL PRESSURE HIGH
PDH	DIFFERENTIAL PRESSURE INDICATOR
PDH	DIFFERENTIAL PRESS SWITCH HIGH
PDH	PRESSURE GAUGE

PI	PRESSURE INDICATOR
PICT	PRESSURE INDICATING CONTROLLER
PT	PRESSURE INDICATING TRANSMITTER
PSH	PRESSURE SWITCH HIGH
PSL	PRESSURE SWITCH LOW
PSV	SELF PROTECT SAFETY VALVE
PSV	PRESSURE TRANSDUCER
PT	ELEMENT CONTROLLED BY PRESSURE
PV	PRESS SIGNAL CONVERT. UP OR SOLN
PSLH	PRESSURE SWITCH LOW/HIGH LEVEL INSTRUMENTS
LEVEL ALARM HIGH	
LAH	LEVEL ALARM LOW
LAL	LEVEL ALARM
LCV	SELF REG LEVEL CONTROL VALVE
LE	LEVEL ELEMENT
LG	LEVEL GAUGE
LH	LEVEL HEAD
LH	LEVEL HEAD


LIC	LEVEL INDICATING CONTROLLER
LIT	LEVEL INDICATING TRANSMITTER
LSS	LEVEL SWITCH HIGH
LSL	LEVEL SWITCH LOW
LST	LEVEL TRANSMITTER
LTV	LEVEL CONTROL ON/OFF VALVE
LX	LEVEL ELEMENT CONTROLLER
LY	LEVEL SIGNAL CONVERT. UP OR DN
TEMPERATURE INSTRUMENTS	
TAH	TEMPERATURE ALARM HIGH
TAL	TEMPERATURE ALARM LOW
TC	TEMPERATURE CONTROLLER
TE	TEMPERATURE ELEMENT
TEG	TEMPERATURE GAUGE
TI	TEMPERATURE INDICATOR
TIC	TEMP INDICATING CONTROLLER
TT	TEMP INDICATING TRANSMITTER
TS	TEMPERATURE SWITCH
TSI	TEMPERATURE SWITCH LOW
TSR	TEMPERATURE SWITCH HIGH
TTX	TEMPERATURE TRANSMITTER
TV	TEMP CONTROL ON/OFF VALVE
TX	ELEMENT CONTROLLED BY TEMP
Y	TEMPERATURE SIGNAL CONVERT. UP OR DN
ELECTRICAL ALARMATIONS	
JB	JUNCTION BOX
MC	MAIN CONTROL PANEL
NC	NON CONTROL PANEL
PP	POWER PANEL
VFD	VARIABLE FREQUENCY DRIVE
HOA	HAND-OFF-AUTO

NOTE: THE INFORMATION, SPECIFICATIONS AND DATA SHOWN ON THIS PRINT ARE FURNISHED BY AND ARE TO REMAIN THE PROPERTY OF H₂O INNOVATION

THE PURPOSE OF THIS DOCUMENT IS TO FACILITATE THE INSTALLATION, MAINTENANCE AND OPERATION OF THE EQUIPMENT REPRESENTED BY SAID PRINT. NO OTHER USE OF THIS DOCUMENT SHALL BE MADE WITHOUT EXPRESS WRITTEN CONSENT FROM H₂O INNOVATION

REVISION	DESCRIPTION	DRAWN	CHKD	ENG
		M.P.	H.S.	H.C.
		M.P.	H.S.	H.C.
		M.P.	H.S.	H.C.
		M.P.	H.S.	H.C.
	TRIC VALVE TURBIDITY METER TO 120V	M.P.	H.S.	H.C.

TITLE:	PR
SCALE:	N/A

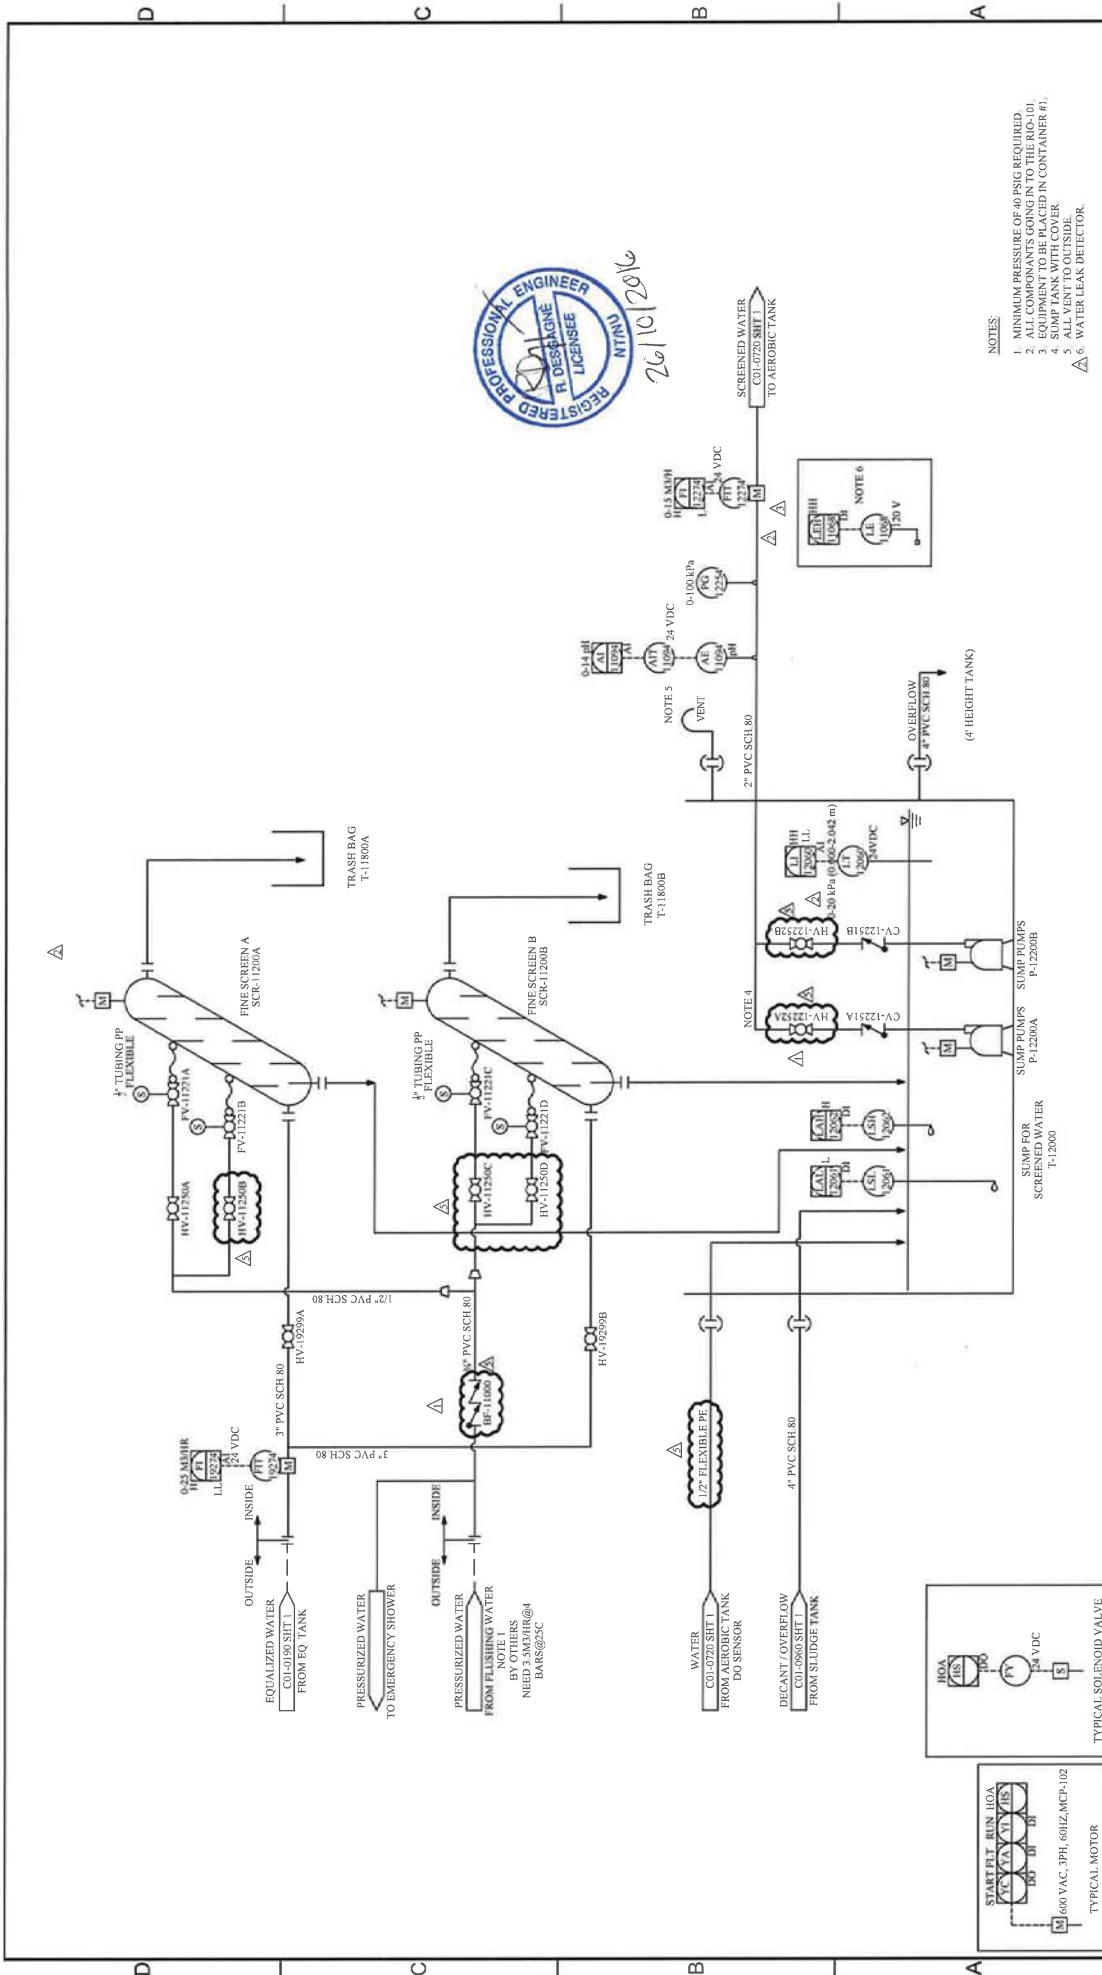


DRAWING REVISION				TITLE			
REV	DATE	REVISION DESCRIPTION	BY	CHKD	ENG	APPROV	
01	21/09/2016	REVISED AS BUILT	M.P.	H.S.	H.C.	H.C.	
02	08/02/2016	REVISED AS PER COMMENT	M.P.	H.S.	H.C.	H.C.	
03	25/07/2016	REVISED AS PER COMMENT	M.P.	H.S.	H.C.	H.C.	
04	13/07/2016	REVISED AS PER COMMENT	M.P.	H.S.	H.C.	H.C.	
05	11/07/2016	CHANGE SUMP TANK BALL TO GATE VALVE SOLENOID TO ELECTRIC TURBIDITY METER TO 120V	M.P.	H.S.	H.C.	H.C.	


RAW WATER SCREENING		MELIADINE STP	
PROCESS & INSTRUMENTATION DIAGRAM		216 M3/DAY	
SCALE	N/A	DRAWING NUMBER	U65875-C01-0110
REVISION	05	SHEET	1 of 1



TITLE:		AEROBIC TANK PROCESS & INSTRUMENTATION DIAGRAM	
SCALE:	N/A	DRAWING NUMBER:	U65875-C01-0720
		REVISION:	05

TITLE:		AEROBIC TANK PROCESS & INSTRUMENTATION DIAGRAM	
SCALE:	N/A	DRAWING NUMBER:	U65875-C01-0720
		REVISION:	05

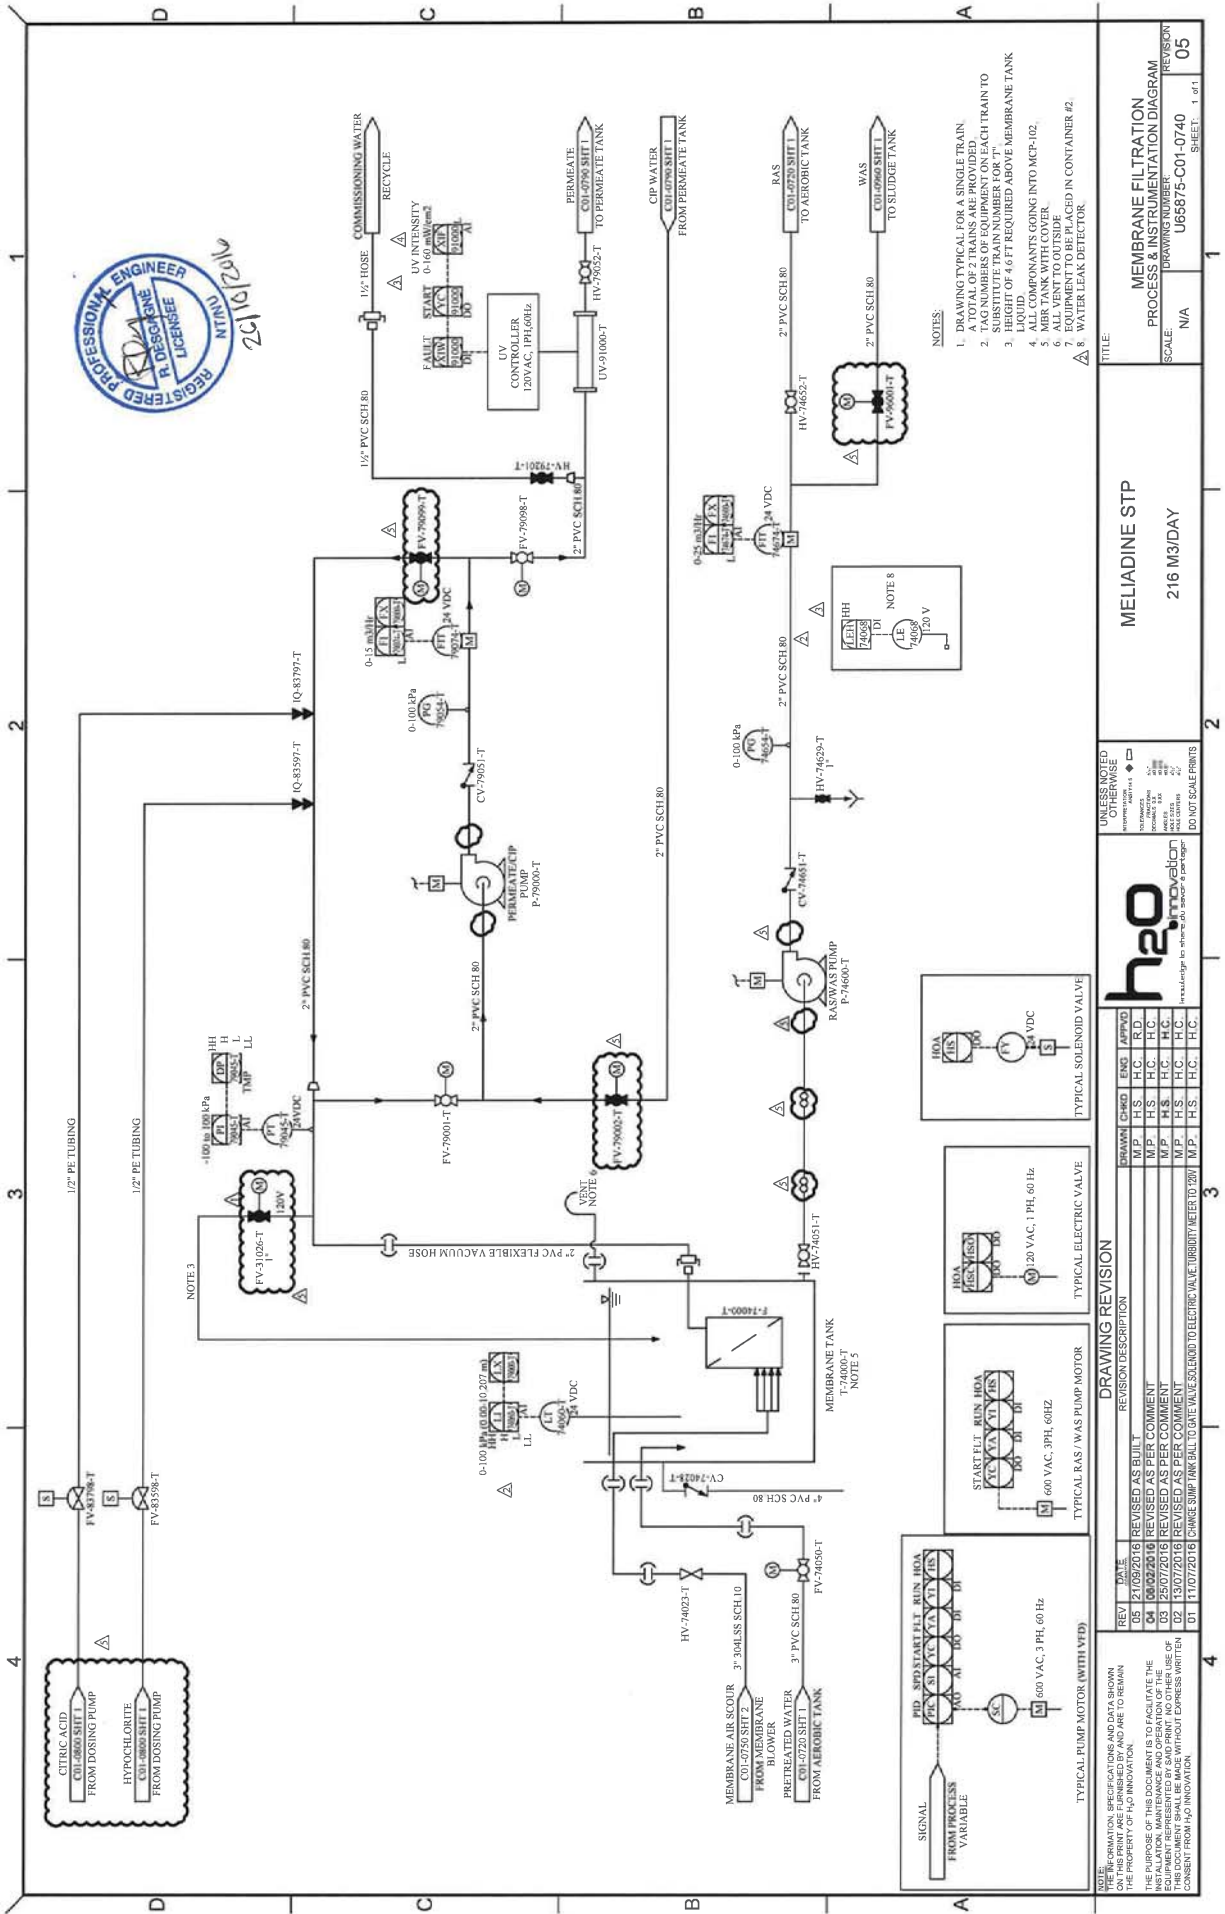

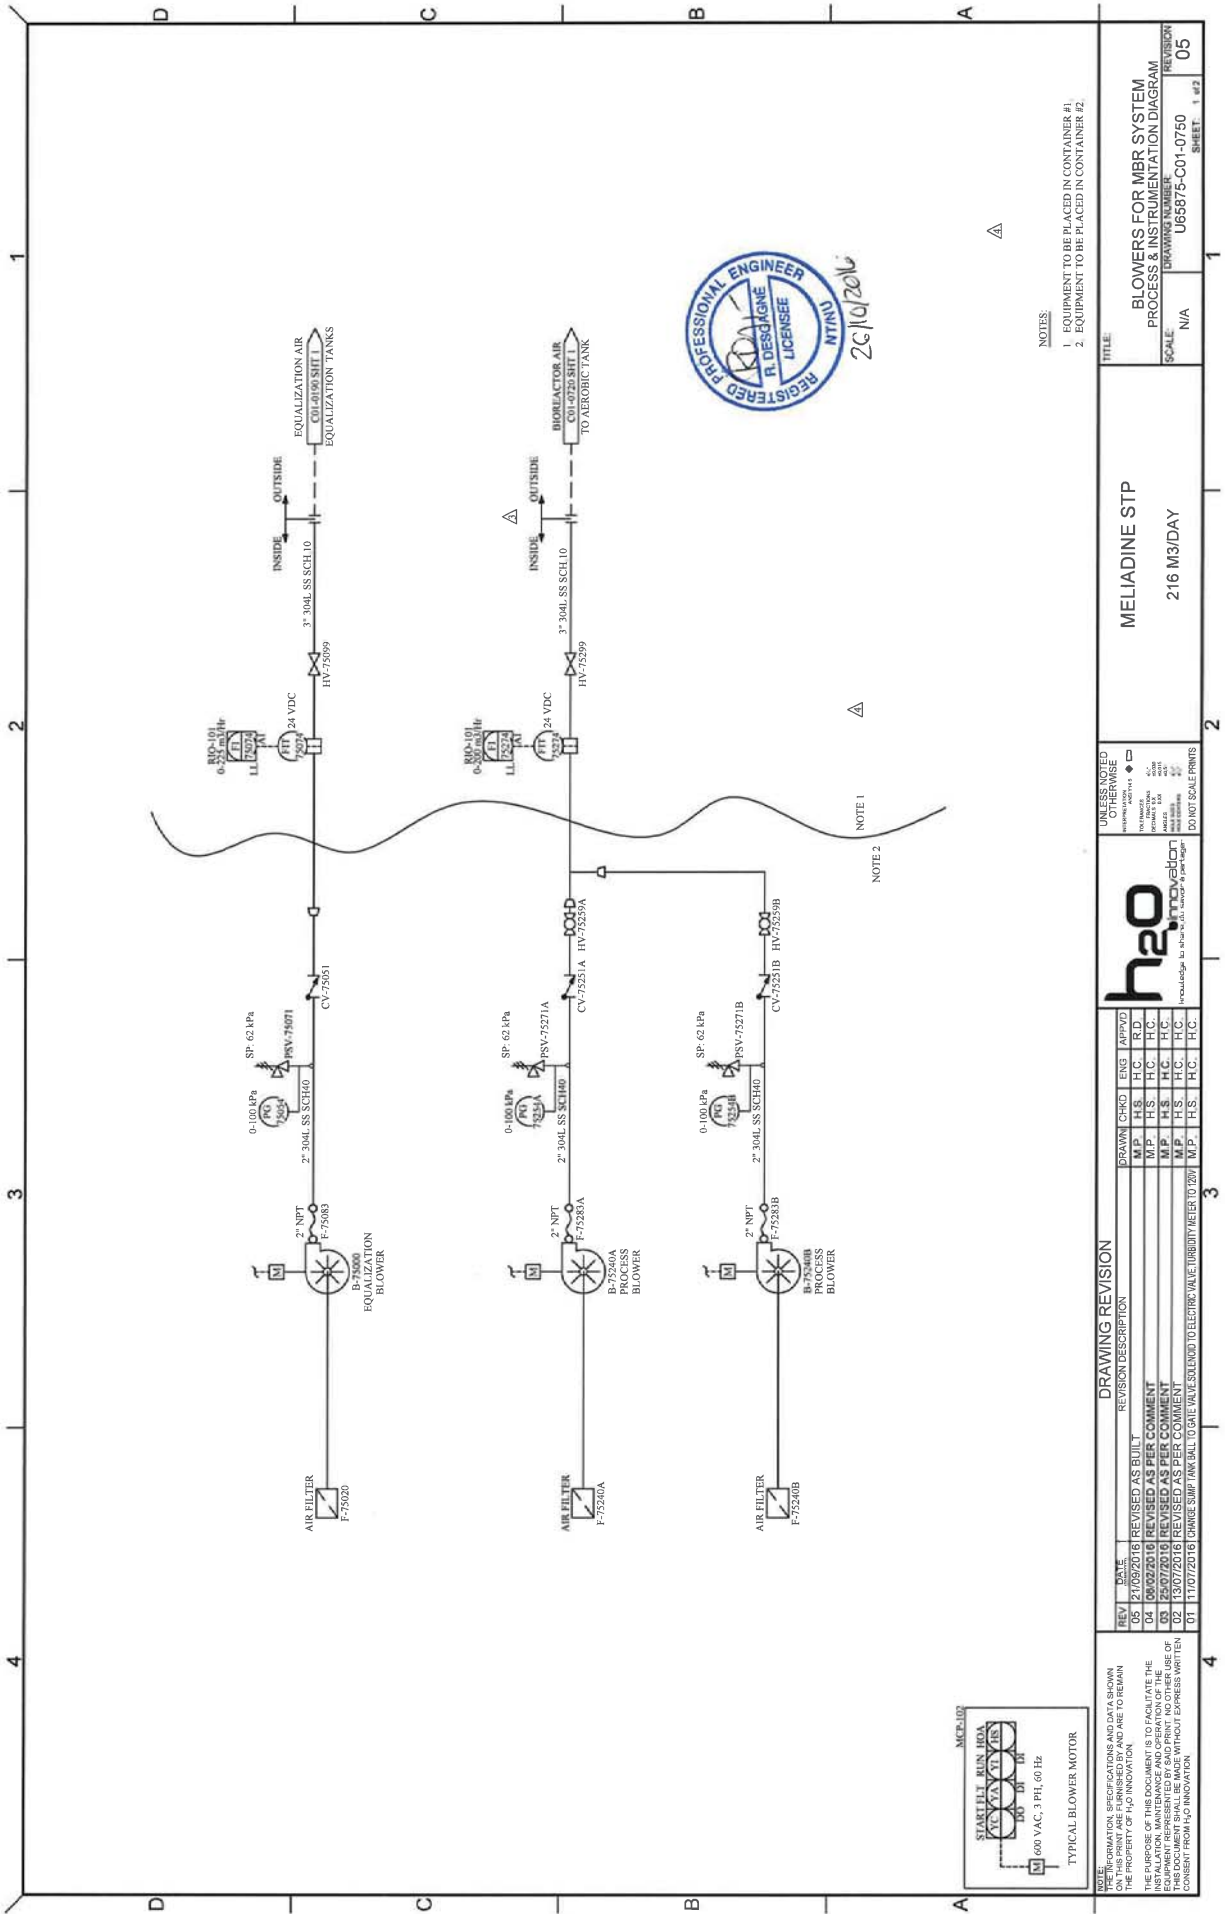


NOTES



1. EQUIPMENT TO BE PLACED IN CONTAINER #1.
2. EQUIPMENT TO BE PLACED IN CONTAINER #2.

DRAWING REVISION		TITLE	
REV	DATE	DESCRIPTION	REVISION
05	21/05/2016	REVISED AS BUILT	05
04	06/02/2016	REVISED AS PER COMMENT	04
03	25/07/2016	REVISED AS PER COMMENT	03
02	13/07/2016	REVISED AS PER COMMENT	02
01	11/07/2016	CHANGE SHUT OFF VALVE TO GATE VALVE TO ELECTRIC VALVE (URDITY METER TO 20V)	01

h2o	MELIADINE STP
216 M3/DAY	

UNLESS NOTED OTHERWISE	DO NOT SCALE PRINTS
PROJECT NO. U65875-C01-0750	
SCALE: N/A	
DRAWING NUMBER: U65875-C01-0750	
SHEET: 1 OF 2	

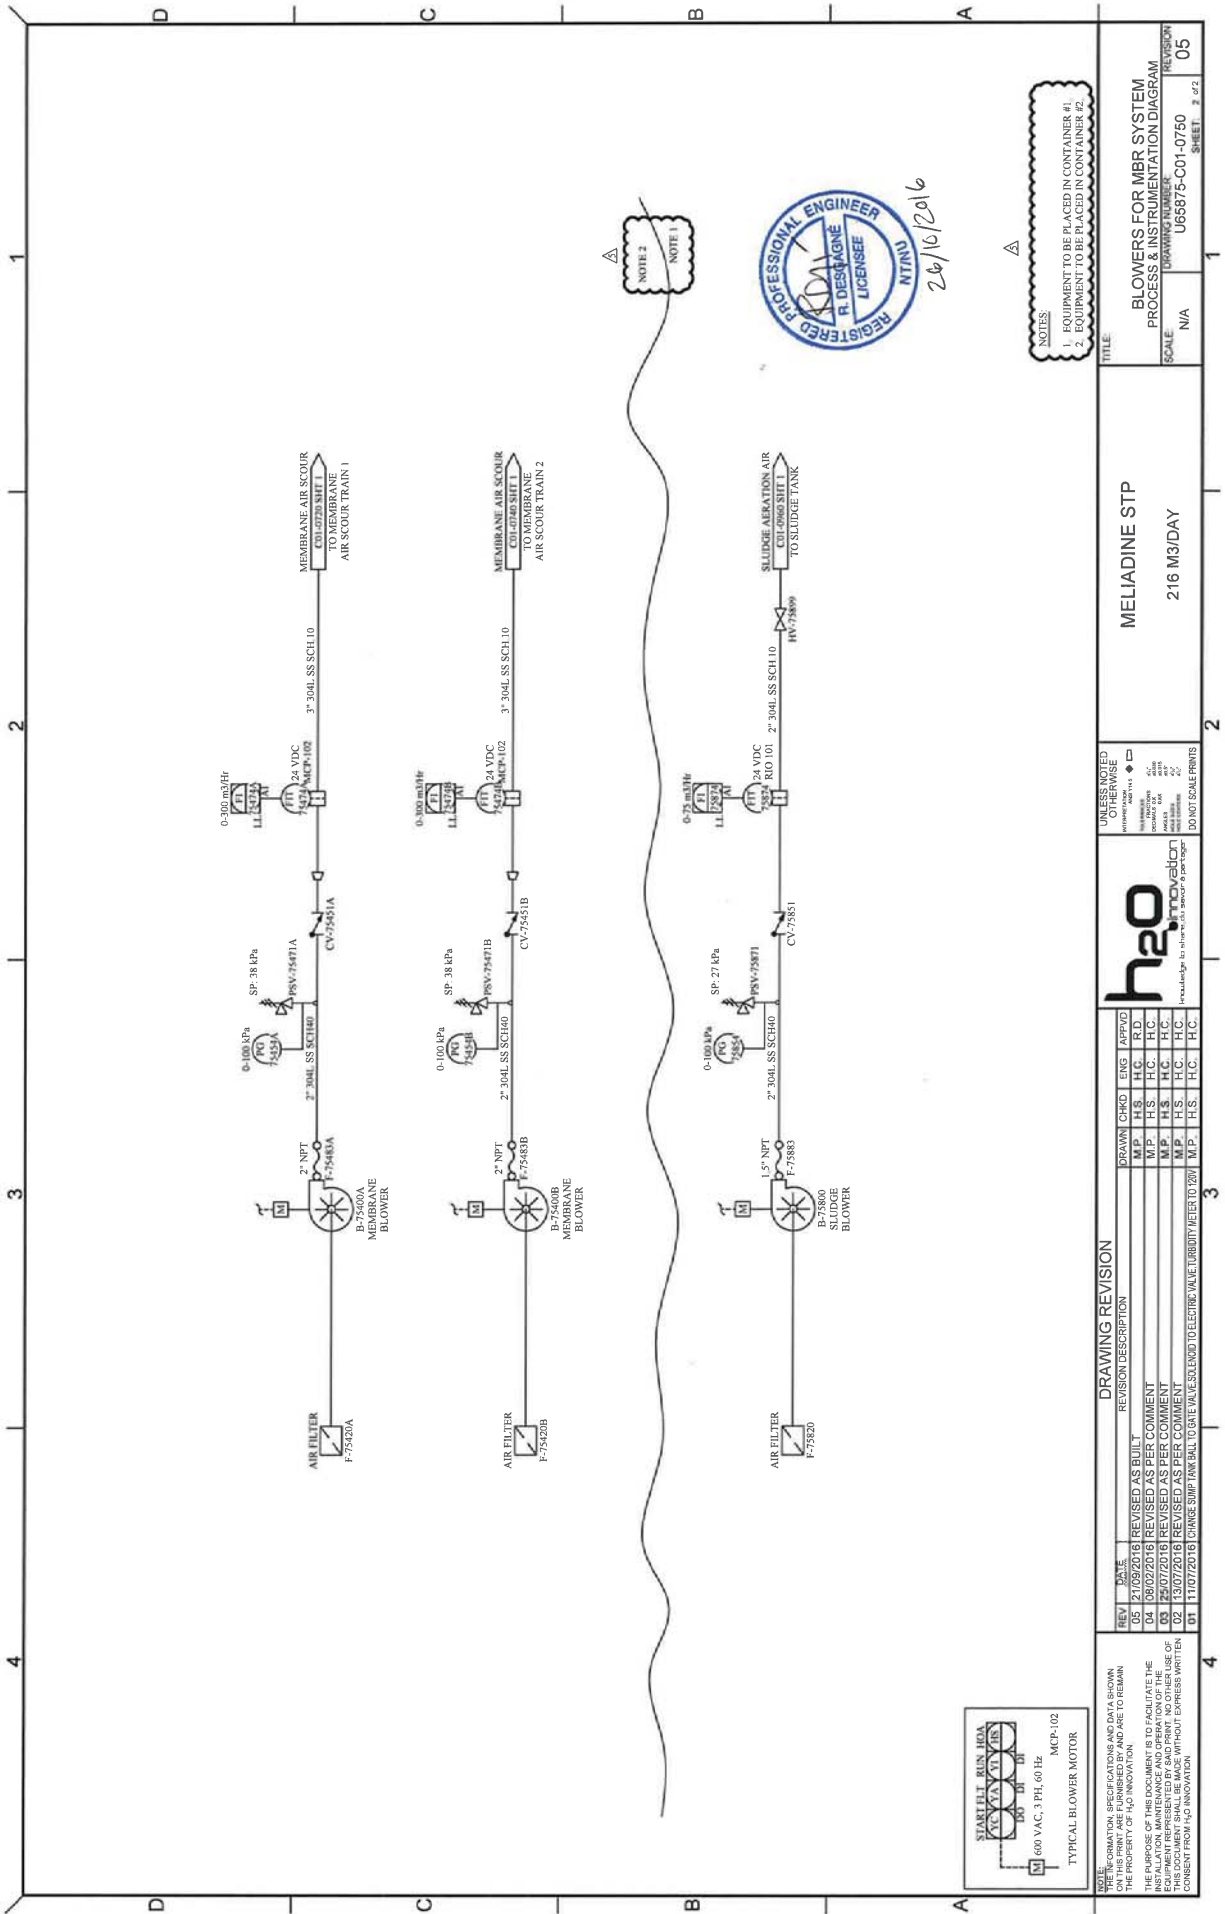

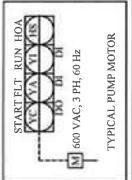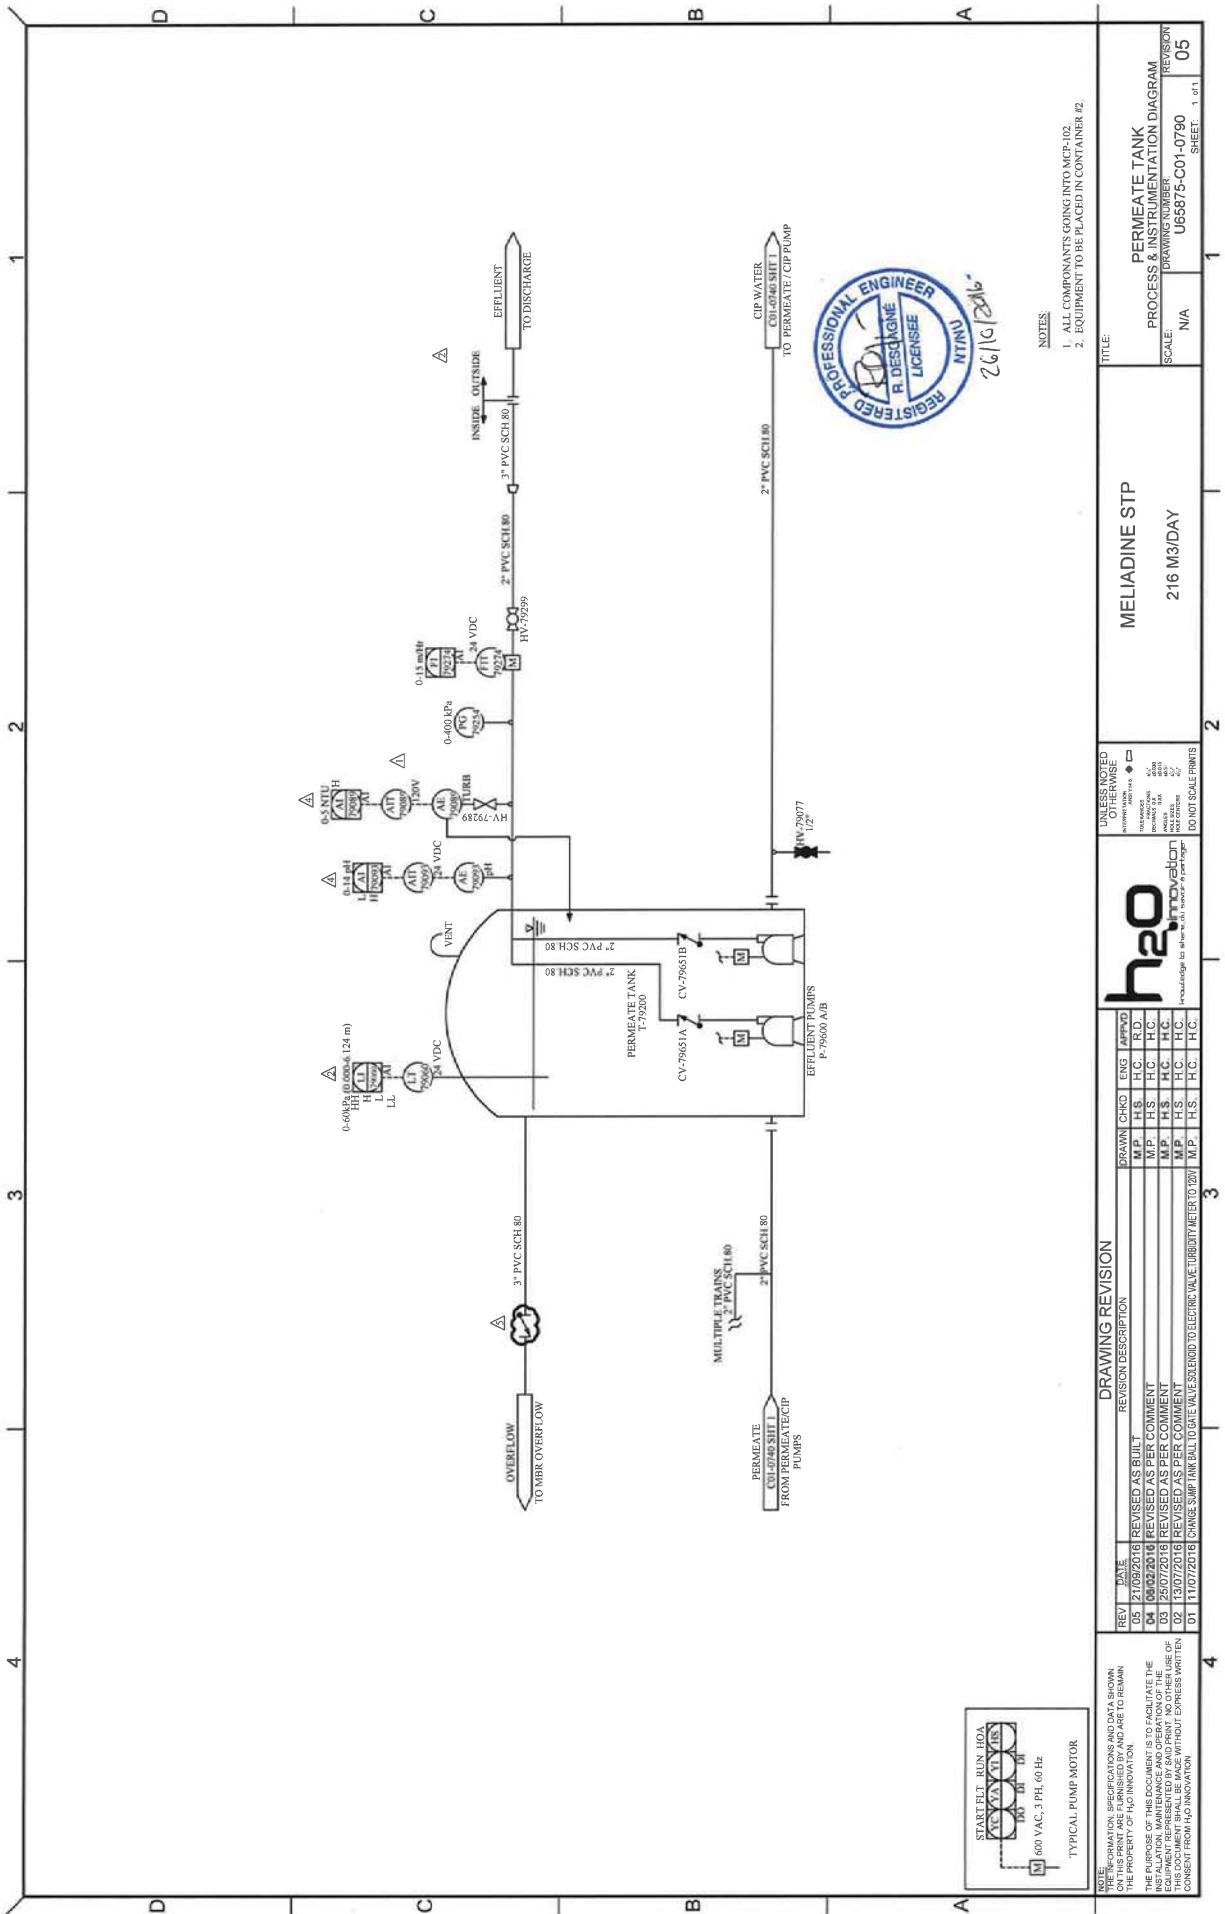

NOTE: DRAWING IS FOR INFORMATION ONLY AND IS NOT TO BE USED FOR CONSTRUCTION. THE PROPERTY OF H2O INNOVATION. THE PURPOSE OF THIS DOCUMENT IS TO FACILITATE THE EQUIPMENT REPRESENTED BY THIS PRINT. NO OTHER USE OF THIS DOCUMENT SHALL BE MADE WITHOUT EXPRESS WRITTEN CONSENT FROM H2O INNOVATION.

REV	DATE	REVISION DESCRIPTION
05	21/09/2016	REVISED AS BUILT
04	09/02/2016	REVISED AS PER COMMENT
03	25/07/2016	REVISED AS PER COMMENT
02	13/07/2016	REVISED AS PER COMMENT
01	11/07/2016	CHANGE SUPPLY AIR BALL TO BE VALVE TO ELECTRIC VALVE TO BE TO 20V

UNLESS NOTED OTHERWISE	DO NOT SCALE PRINTS
h2o	

MELIADINE STP	216 M3/DAY
---------------	------------

TITLE	PERMEATE TANK
SCALE	PROCESS & INSTRUMENTATION DIAGRAM
DRAWING NUMBER	U65875-C01-0790
SHEET	1 of 1


- NOTES
1. ALL COMPONENTS GOING INTO MCP-102.
 2. EQUIPMENT TO BE PLACED IN CONTAINER #2.





1. ALL SIGNALS GOING INTO MCP-101.
2. EQUIPMENT TO BE PLACED IN CONTAINER #1.


TYPICAL PUMP MOTOR

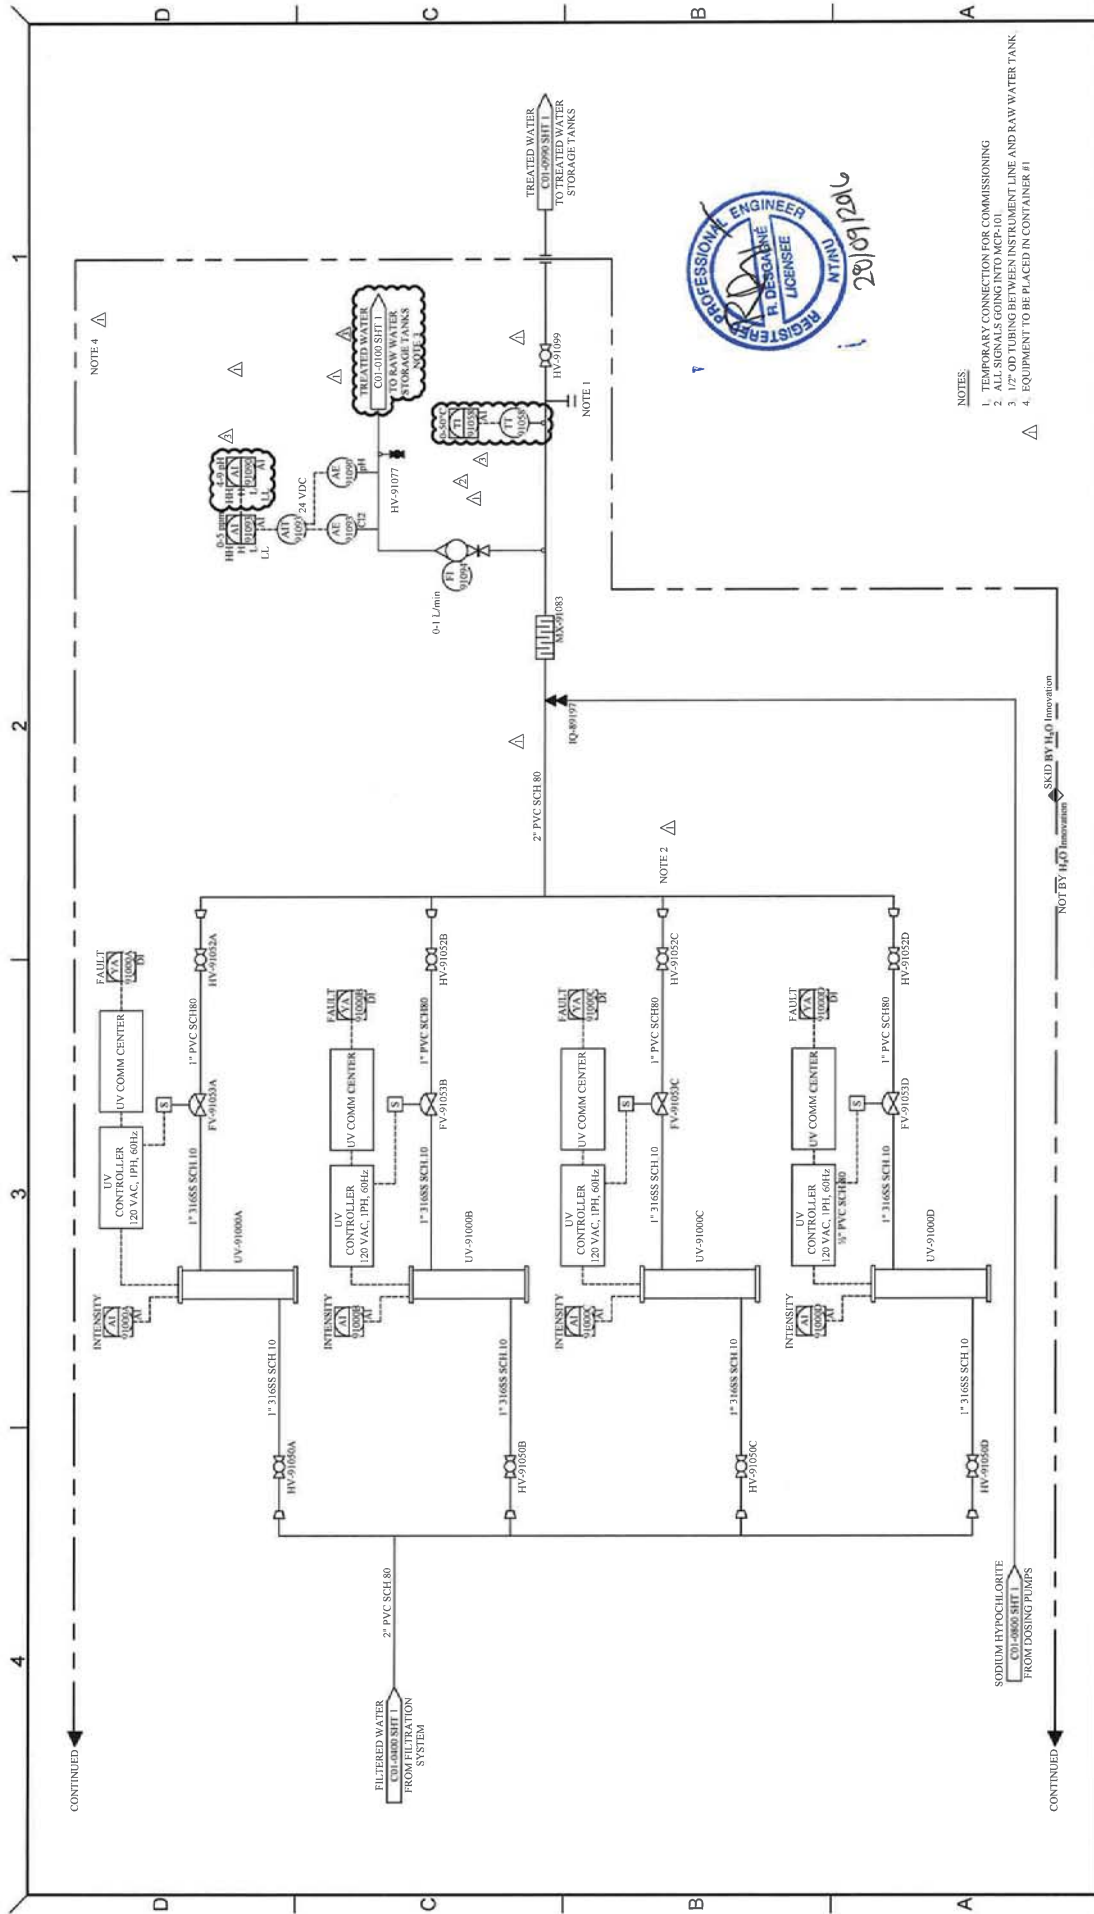

h2o WATER TREATMENT INNOVATION				h2o WATER TREATMENT INNOVATION			
DRAWING REVISION REVISION DESCRIPTION				DRAWING REVISION REVISION DESCRIPTION			
REV	DATE	BY	CHKD	ENG	APPROV		
03	10/05/2016	AS BUILT	M.P.	S.B.	R.D.	A.M.	
02	25/07/2016	REVISED AS PER COMMENTS	M.P.	S.B.	R.D.	A.M.	
01	24/06/2016	AS PER COMMENTS	M.P.	S.B.	R.D.	A.M.	
00	13/06/2016	INITIAL RELEASE	M.P.	S.B.	R.D.	A.M.	

TITLE MELIADINE WTP CONTAINERIZED UNIT				TITLE MELIADINE WTP CONTAINERIZED UNIT			
SCALE N/A				SCALE N/A			
DRAWING NUMBER P65873-C01-0910				DRAWING NUMBER P65873-C01-0910			
SHEET 1 of 1				SHEET 1 of 1			



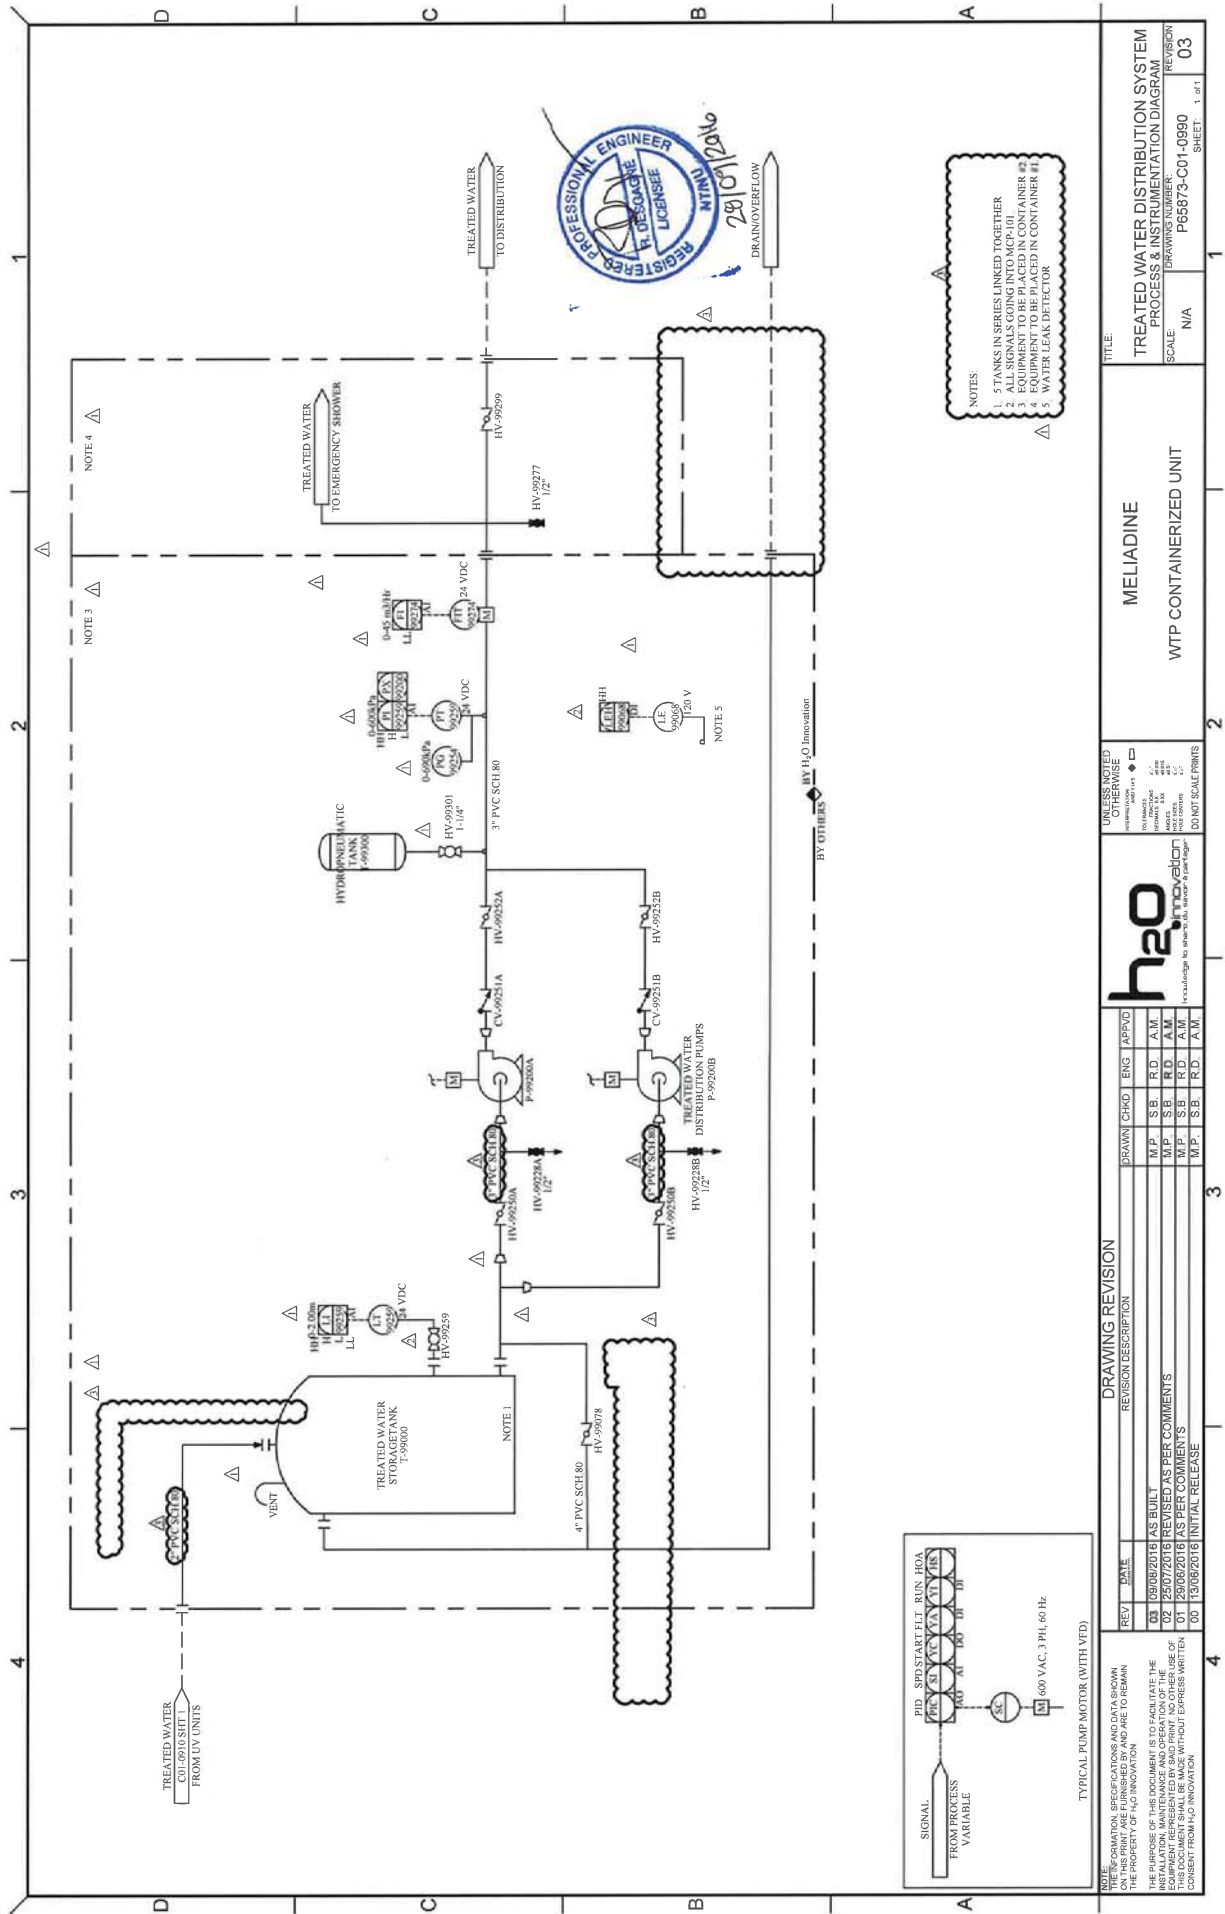

DRAWING REVISION			
REV.	DATE	REVISION DESCRIPTION	APPROVED
03	09/08/2016	AS BUILT	M.P. S.B. R.D. A.M.
02	25/07/2016	REVISED AS PER COMMENTS	M.P. S.B. R.D. A.M.
01	29/06/2016	AS PER COMMENTS	M.P. S.B. R.D. A.M.
00	13/06/2016	INITIAL RELEASE	M.P. S.B. R.D. A.M.

TITLE	
TREATED WATER DISTRIBUTION SYSTEM PROCESS & INSTRUMENTATION DIAGRAM	
SCALE	N/A
DRAWING NUMBER	P65873-C01-0990
REVISION	03
SHEET: 1 of 1	

MELIADINE	
WTP CONTAINERIZED UNIT	

UNLESS NOTED OTHERWISE	
DO NOT SCALE PRINTS h2o logo	

DRAWING REVISION	
REV.	DATE
03	09/08/2016
02	25/07/2016
01	29/06/2016
00	13/06/2016

DRAWING REVISION	
REV.	DATE
03	09/08/2016
02	25/07/2016
01	29/06/2016
00	13/06/2016

DRAWING REVISION	
REV.	DATE
03	09/08/2016
02	25/07/2016
01	29/06/2016
00	13/06/2016

DRAWING REVISION	
REV.	DATE
03	09/08/2016
02	25/07/2016
01	29/06/2016
00	13/06/2016

****Civil Construction Notes****

- install sump at location indicated.
- install grating between building fans and outside louvers.
- thermal insulation on walls and ceiling.
- door colour to be the same as building.

****Mech/Elec. Construction Notes****


- locate cooling thermostat in the warmest location at ceiling level.
- locate heating thermostat at floor level.
- plug and seal (with washers) any holes in the floor to contain water spills.
- maximum width for shipping is 102". this includes all connections that protrude through the sides of the enclosure.

****Commissioning Notes****

- fan and lower hoods need to be installed on site. cannot ship with hoods attached.
- some flow meters such as rmc meters will be shipped with the unions in the process piping loosened to ensure meters are not damaged during shipment.
- buildings need to be shimmed on site to allow doors to open freely. please have shimming material ready during building installation.
- for buildings in cold weather climates, where the building is elevated, a skirt must be built around the base to prevent the floor from freezing.
- newterra recommends pad be at least 12" larger than enclosure in all directions. local codes may require alternate dimensions.

newterra standard system labels

- flow direction labels
- air line labels
- water line labels
- air/water line labels
- hot surface label (lines >= 140 degf)
- hearing protection labels
- warning label: this machine is automatically controlled
- arc flash warning label

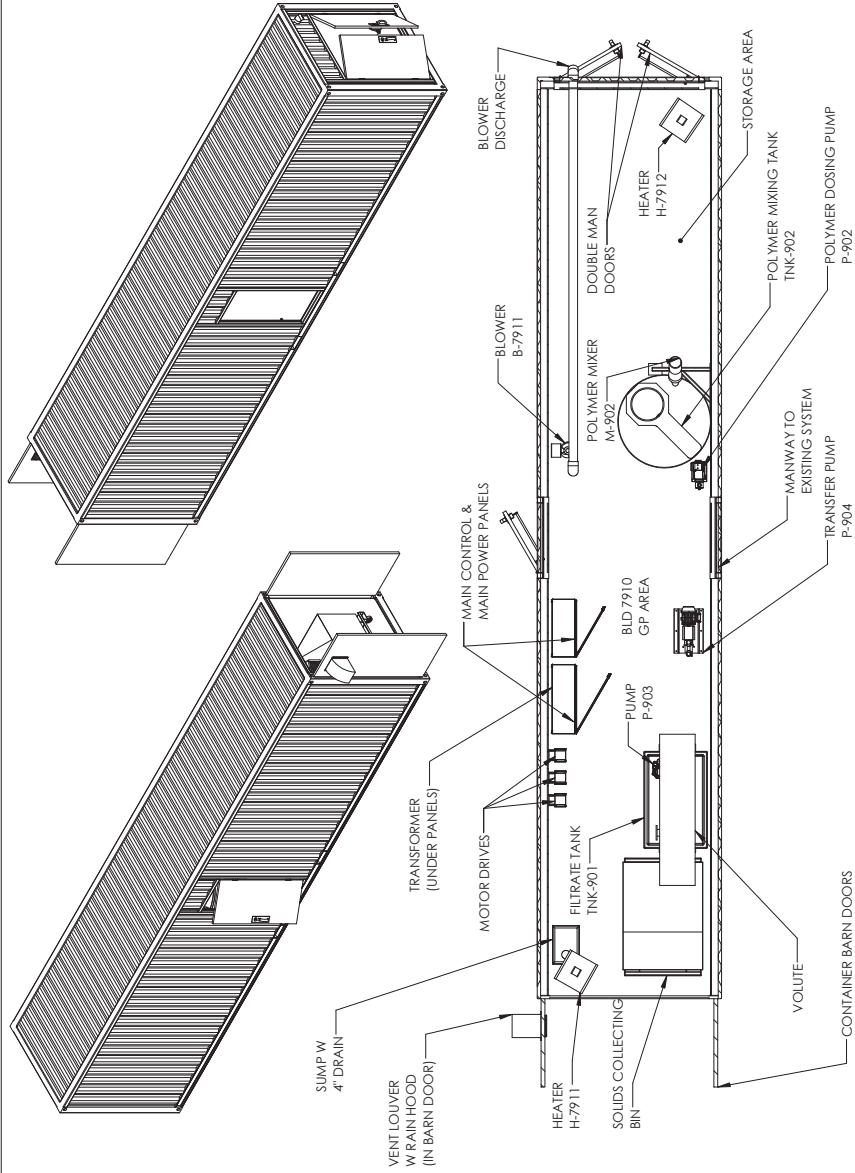

GENERAL TOLERANCES				GENERAL TOLERANCES			
.XX ± 1/8"				.XX ± 1/8"			
.XXX ± 1/16"				.XXX ± 1/16"			
UNLESS OTHERWISE SPECIFIED, ALL DIMENSIONS ARE IN INCHES				UNLESS OTHERWISE SPECIFIED, ALL DIMENSIONS ARE IN INCHES			
newterra				newterra			
As Built				As Built			
DATE	REVISION	BY	DATE	DATE	REVISION	BY	DATE
C-01	NM	NM	28/07/2019	28/07/2019	NM	NM	28/07/2019
REVISIONS AND CHANGES ARE TO BE MADE ON REPRODUCTION WITHOUT WRITING CONSENT.				REVISIONS AND CHANGES ARE TO BE MADE ON REPRODUCTION WITHOUT WRITING CONSENT.			
APPROVED BY				APPROVED BY			
PROJECT/CLIENT				PROJECT/CLIENT			
SYSTEM LAYOUT				SYSTEM LAYOUT			
PROJECT NUMBER				PROJECT NUMBER			
905884				905884			
DATE				DATE			
JUL 30, 2019				JUL 30, 2019			
SHEET 1 OF 1				SHEET 1 OF 1			

INSTRUMENTATION IDENTIFIERS			
FIRST LETTERS		SUCCEEDING LETTERS	
MEASURED/INITIATING VARIABLE	VARIABLE MODIFIER	READOUT/PASSIVE FUNCTION	OUTPUT/ACTIVE FUNCTION
A ANALYSIS		ALARM	
B BURN, COMBUSTION			
C CYCLE	CONTROL		CONTROL
D	DIFFERENCE, DIFFERENTIAL		CLOSE DEVIATION
E VOLTAGE		SENSOR, PRIMARY ELEMENT	
F FLOW, FLOW RATE	RATIO		
G GAS (LEL)		GLASS, GAUGE	
H HAND		VIEWING DEVICE	HAND
I CURRENT		INDICATE	
J POWER		SCAN	
K LEVEL	TIME RATE OF CHANGE	LIGHT	CONTROL, STATION
L			MOTORIZED
M MONITOR			MODULE, INTERMED
N			
P PRESSURE	INTEGRATE, TOTALIZE	ORIFICE, RESTRICTION	PNEUMATIC
Q QUANTITY		POINT/TEST/CONNECT	
R RATE		INTEGRATE, TOTALIZE	OPEN
S SPEED, FREQUENCY	SAFETY	RECORD	
T TEMPERATURE			STOP
U MULTIVARIABLE			SWITCH, SOLENOID
V ANALYSIS, VACUUM		MULTIFUNCTION	TRANSMIT
W WEIGHT, FORCE			MULTIFUNCTION
X UNCLASSIFIED	X-AXIS	WELL, PROBE	LOUVER
Y EVENT, STATE, PRESENCE	Y-AXIS	UNCLASSIFIED	UNCLASSIFIED
Z POSITION, DIMENSION	Z-AXIS, SAFETY, INSTRUMENTED SYSTEM		AUXILIARY DEVICES, DRIVER, ACTUATOR, UNCLASSIFIED FINAL CONTROL ELEMENT

EQUIPMENT	EQUIPMENT	EQUIPMENT	VALVES AND PIPING
<p>CENTRIFUGAL PUMP -</p> <p>PROGRESSIVE-CAVITY PUMP -</p> <p>CHEMICAL-INJECTION PUMP -</p> <p>CENTRIFUGAL, REGENERATIVE BLOWER -</p> <p>POSITIVE-DISPLACEMENT BLOWER -</p> <p>ROTARY-CLAW BLOWER -</p> <p>LINEAR BLOWER -</p> <p>LIQUID-RING PUMP -</p> <p>ROTARY-VANE COMPRESSOR -</p> <p>RECIPROCATING COMPRESSOR -</p> <p>PASSIVE COOLING FINS -</p> <p>HEAT EXCHANGER -</p> <p>EDUCTOR -</p> <p>MAGNETIC FLOWMETER -</p> <p>AVERAGING PITO TUBE -</p> <p>VENTURI -</p> <p>ROTOMETER -</p> <p>WATER FLOW METER -</p>	<p>CLOSED TOP TANK</p> <p>OPEN TOP TANK</p> <p>OPEN TOP TANK WITH LID</p> <p>AIR DIFFUSER ASSEMBLY</p> <p>STRAINER/FILTER</p> <p>MEMBRANE CASSETTE</p> <p>NO CLOG SPRAYER ASSEMBLY</p> <p>ULTRA VIOLET LIGHT</p> <p>IMPERMEABLE LINER</p> <p>ROTARY SCREEN</p> <p>FILTER PRESS</p>	<p>AIR STRIPPER</p> <p>OIL WATER SEPARATOR</p> <p>VAPOR/LIQUID, SEAL FLUID SEPARATOR</p> <p>BAG FILTER</p> <p>CARBON VESSEL</p> <p>OXIDIZER</p> <p>PRODUCT STORAGE DRUM, TANK</p> <p>STANDARD, CONICAL BOTTOM TANK</p>	<p>NC</p> <p>BALL VALVE -</p> <p>GATE VALVE -</p> <p>GLOBE VALVE -</p> <p>NEEDLE VALVE -</p> <p>SLIDE VALVE -</p> <p>SOLENOID VALVE -</p> <p>BUTTERFLY VALVE -</p> <p>SWING CHECK VALVE -</p> <p>WATER CHECK VALVE -</p> <p>SPRING CHECK VALVE -</p> <p>WYE STRAINER -</p> <p>SAMPLE PORT -</p> <p>PRESSURE RELIEF VALVE -</p> <p>VACUUM RELIEF VALVE -</p> <p>CAMLOCK CONNECTION -</p> <p>FLEXIBLE CONNECTION -</p> <p>FLANGED CONNECTION -</p> <p>REDUCER -</p> <p>UNION -</p> <p>ADSORBENT FILTER -</p> <p>COALESCING FILTER -</p> <p>PARTICULATE FILTER -</p> <p>FILTER, SILENCER -</p> <p>PRESSURE REGULATOR -</p> <p>REGULATOR W/ FILTER -</p>


<p>- INDICATING INSTRUMENT</p> <p>- DIGITAL INPUT TO CONTROL PANEL</p> <p>- DIGITAL INPUT CAUSING ALARM</p> <p>- DIGITAL INPUT CAUSING SYSTEM SHUTDOWN ALARM</p> <p>- ANALOG INPUT TO CONTROL PANEL</p> <p>- ANALOG OUTPUT FROM CONTROL PANEL</p>	<p>VFD - VARIABLE FREQUENCY DRIVE</p> <p>SMD - SIDE WATER DEPTH</p> <p>HRT - HYDRAULIC RETENTION TIME</p> <p>BD - BUILDING</p> <p>BD - BUILDING TRAILER, OR SKID</p> <p>FLT - FILTER VESSEL</p> <p>LPC - LIQUID-PHASE CARBON VESSEL</p> <p>MFD - MANFOLD</p> <p>MVS - OIL/WATER SEPARATOR</p> <p>OST - OIL/WATER SEPARATOR</p> <p>PST - PRODUCT STORAGE TANK</p> <p>SOS - SEAL OIL SEPARATOR</p> <p>SMS - SEAL WATER SEPARATOR</p> <p>TNK - TANK</p> <p>TNK - TANK FOR LIQUID SEPARATOR</p> <p>VPC - VAPOR-PHASE CARBON VESSEL</p>
---	--



1201 CALIFORNIA AVE.
BROCKVILLE ONTARIO
CANADA L6Y 3T6
PHONE: 1-800-400-4056
WWW.NEWTERRA.COM

CD1	AS BUILT	01/06/2018	BAKED
BD1	FOR PRODUCTION	02/06/2018	BAKED
AD1	FOR CUSTOMER REVIEW	03/07/2018	BAKED
LEVEL	REVISION	DATE	BY
		(see notes)	

PROJECT NO:	1905584	CUSTOMER:	Agnico Eagle Mines Agnico Eagle Value
TITLE/NOTATION:	LEGEND	SCALE:	1:1
		SHEET:	3
		OF:	3

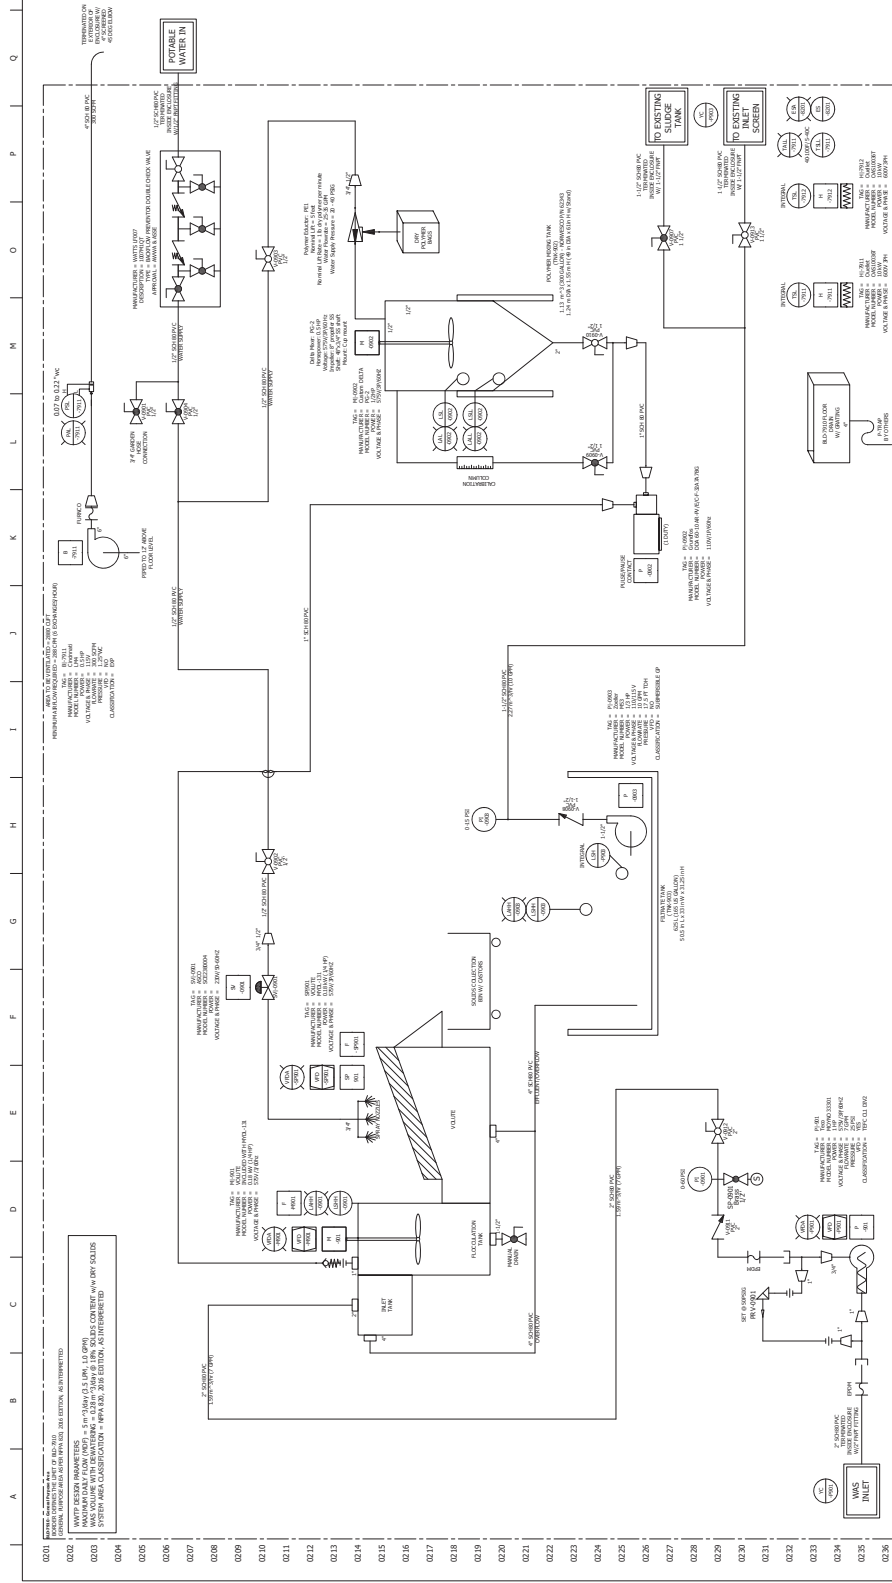

<p>NOTES:</p> <ul style="list-style-type: none"> Flow flow meters: install as per manufacturer's recommendations. Flow as measured, unless otherwise noted in direct flow of the meter. Precip Air flow meters: Provide 4' Dia. of straight pipe before and 4' Dia. of straight pipe after meters. Avoid trees and downspouts after rain events. Materials of valves and piping to be as specified on the diagrams. Flow direction: Indicate flow direction with arrows. All flow meters shall be installed in the direction of flow. Flexible hose: to be as specified on the diagrams. If flexible connection is preferred please consult Engineering to ensure selected hose is rated for the operating conditions. Do not use PVC pipe on air lines over 5' high. Do not use PVC pipe on air lines over 5' high. No flammable materials to be used in direct contact with water flow. Follow NFPA 309 D010. All PVC must be schedule 40. 		<p>1291 CALIFORNIA AVE. BIRMINGHAM, AL 35202 CANADA 661 550</p> <p>PHONE: 1-800-434-4956 www.newterra.com</p>	<p>COI AS BUILT</p> <p>R01 FOR PRODUCTION</p> <p>R02 FOR CUSTOMER REVIEW</p> <p>UC01</p>	<p>23/09/2015</p> <p>23/09/2015</p> <p>30/07/2015</p> <p>30/07/2015</p>	<p>johnson</p> <p>johnson</p> <p>johnson</p> <p>johnson</p>	<p>19055884</p>	<p>TITLE SHEET PROCESS AND INSTRUMENTATION DIAGRAM</p>	<p>CUSTOMER:</p> <p>AgriPro Eagle Mines AgriPro Eagle Volute</p> <p>SHEET 2 SHEETS 3</p> <p>THIS INFORMATION IS THE PROPERTY OF NEWTERRA LTD. AND CANNOT BE REPRODUCED OR REPRODUCED WITHOUT THE WRITTEN CONSENT OF NEWTERRA LTD.</p>
--	---	---	--	---	---	-----------------	--	---