



January 19th 2017

Karen Kharatyan
Manager of Licensing
Nunavut Water Board
P.O. Box 119
Gjoa Haven, NU
X0B 1J0

Re: Water License 2AM-MEL1631 Part D, Items 1&2 - Submission of Final Design and Construction Drawings for the Sewage Treatment Plant

Mr. Kharatyan,

Agnico Eagle Mines Limited is developing the Meliadine Project, a gold mine located approximately 25 km north from Rankin Inlet, and 80 km southwest from Chesterfield Inlet in the Kivalliq Region of Nunavut. Situated on the western shore of Hudson Bay, the Project site is located on a peninsula between the east, south, and west basins of Meliadine Lake (63°1'23.8" N, 92°13'6.42"W) on Inuit Owned Land.

Facilities that are planned to be constructed for the operation of the future Meliadine Mine include a mill, power plant, maintenance facilities, tank farm for fuel storage, water treatment plant, sewage treatment plant, and accommodation and kitchen facilities for 520 people.

In accordance with Water License 2AM-MEL1631, Part D, Items 1 and 2, please find enclosed with this letter, a copy of the final design and construction drawings for the Sewage Treatment Plant.

Should you have any questions regarding this submission, please contact me.

Regards,

Agnico Eagle Mines Limited – Meliadine Division

A handwritten signature in blue ink, appearing to read "Manon Turmel", with a stylized flourish at the end.

Manon Turmel
manon.turmel@agnicoeagle.com
819-759-3555 x8025
Environmental Compliance Counselor

cc: *Ian Parsons, Indigenous and Northern Affairs Canada*
Luis Manzo, Kivalliq Inuit Association



Meliadine Sewage Treatment Plant

30-Day Notice to Nunavut Water Board
In Accordance with Water License 2AM-MEL1631 (Part D, item 1)

Prepared by:
Agnico Eagle Mines Limited – Meliadine Division

January 2017

TABLE OF CONTENTS

1	INTRODUCTION	4
1.1	Site Location and Access	4
1.2	existing and future site facilities	4
2	DESIGN	6
2.1	Water management strategy	6
2.2	Description of sewage treatment system	6
2.2.1	Screening and Flow Equalization	6
2.2.2	Aerobic Biological Treatment	7
2.2.3	Membrane Filtration System	7
2.2.4	UV Disinfection System	8
2.2.5	Sludge Handling System	8
3	DRAWINGS AND SKETCHES	9

LIST OF FIGURES

Figure 1 – Location of Meliadine STP and effluent pipeline to CP1 (former dewatered Pond H17)..... 5

LIST OF APPENDICES

Appendix A: Design drawings

1 INTRODUCTION

1.1 SITE LOCATION AND ACCESS

Agnico Eagle Mines Limited (Agnico Eagle) is developing the Meliadine Project (the Project), a gold mine located approximately 25 km north from Rankin Inlet, and 80 km southwest from Chesterfield Inlet in the Kivalliq Region of Nunavut. Situated on the western shore of Hudson Bay, the Project site is located on a peninsula between the east, south, and west basins of Meliadine Lake (63°1'23.8" N, 92°13'6.42"W) on Inuit Owned Land.

The area is accessible from the all-weather gravel road linking the existing exploration camp with Rankin Inlet.

1.2 EXISTING AND FUTURE SITE FACILITIES

Current facilities at the Meliadine Project site include the exploration camp located on the shore of Meliadine Lake, approximately 3.5 km south-east of the future accommodations. The self-contained exploration camp consists of four wings of new trailers that can accommodate up to 200 people and includes kitchen facilities, complete with diesel generators. Power for the exploration camp is currently provided by diesel generators. Potable water for the exploration camp is pumped from Meliadine Lake.

Facilities that are planned to be constructed for the operation of the future Meliadine Mine include a mill, power plant, maintenance facilities, tank farm for fuel storage, water treatment plant, sewage treatment plant, and accommodation and kitchen facilities for 520 people.

The Nunavut Water Board (NWB) has issued Type A Water License 2AM-MEL1631 to Agnico Eagle Mines Limited (Agnico Eagle) for the Meliadine Gold Project site authorizing the use of water and the disposal of waste required by mining and milling and associated uses.

This report includes the final design and construction drawings for the sewage treatment plant (STP), as specified under Water License 2AM-MEL1631 Part D, Item 1.

Figure 1 shows the location of the future STP and pipeline to CP1 for final discharge.



Figure 1 –Location of Meliadine STP and effluent pipeline to CP1 (former dewatered Pond H17)

2 DESIGN

2.1 WATER MANAGEMENT STRATEGY

Sewage will be collected from the new facilities and pumped to the new STP. In addition to the sewage generated from the buildings connected to this STP, a sewage vacuum truck will collect sewage from storage tanks at different temporary or remote buildings such as the emulsion plant, the paste plant, the crusher building, the portal #1 and construction offices. This material will be directly deposited into the STP equalization tanks.

The objective of the STP is to treat sewage to an acceptable level for discharge to CP1 via a sewage water discharge pipeline. The STP is housed in a prefabricated (modular) structure, located on the east side of the industrial pad (Figure 1). The sewage treatment system is designed for a maximum daily flow rate of 216 m³ and a peak hour flow of 106 m³, and an average Biological Oxygen Demand (BOD) in the influent of 200-360 mg/L.

The treated sewage from the STP will be pumped through a heat traced insulated pipeline to CP1 pond which is designed to receive all the surface contact waters on site. This water is pumped to the final effluent treatment plant for TSS control prior to discharge into Meliadine Lake.

The composition of the sewage and grey water entering the plant and the composition water exiting the units will be monitored on a regular basis to determine plant efficiencies.

Sewage sludge removed from the STP will be added to the landfarm as nutrient amendment on an as needed basis. Excess sludge will be disposed of in the Tailings Storage Facility (TSF) or shipped south for disposal.

2.2 DESCRIPTION OF SEWAGE TREATMENT SYSTEM

The STP relies on bacterial activity. The process is composed of five (5) steps described below: screening and flow equalization, aerobic biological treatment, membrane filtration, ultraviolet disinfection, and sludge handling. The flow diagram is available in Appendix B.

2.2.1 Screening and Flow Equalization

Influent wastewater is pumped to the two (2) aerated equalization tanks. The equalization system is able to manage a variation in flows. It provides raw wastewater storage of up to 50% of the design flow to store feed during high flow periods and to ensure feed supplementation during low flow periods. It provides a stable and consistent raw feed for the downstream processes. Equalized water is pumped via two (2) equalization pumps into a standpipe inside the second tank and flows from that pipe by gravity to the fine screens. The fine screens are rotary drum screens with 2 mm perforated plate openings that operate continuously. The screens will ensure the removal of large debris to protect downstream equipment. Pressurized wash water is used intermittently to clean the screens and screenings.

2.2.2 Aerobic Biological Treatment

Screened raw water falls by gravity from the screens into the sump tank, where it is pumped to the aerobic tank, which is located outdoors. Aerobic biological treatment remove the organic load (measured as BOD) of the wastewater. Bacteria grown in the bioreactor remove unwanted organic pollutants to produce a treated water of high quality. Oxygen is supplied by regenerative blowers and is injected by fine bubble diffusers in the tank. The diffusers are designed for a wide range of air flows, according to the system's demand in oxygen. It keeps a dissolved oxygen concentration of at least 2 mg/L at any time to satisfy the needs of the biomass. The mixed liquor suspended solids (MLSS) overflows into a standpipe inside the tank and flows by gravity to the membrane filtration trains.

The dry bacteria product, BEC105, could be used in the treatment process to stimulate biological activity when needed.

2.2.3 Membrane Filtration System

Membrane filtration is used to separate the bacteria from the water to ensure keeping them in the process at the desired concentration. Activated sludge is returned at a constant flow rate to the aerobic tank to prevent a build-up of sludge in the membrane tank. The return activated sludge (RAS) is pumped at a higher flow rate than the design flow rate of the plant, to make sure that there is good circulation in the whole system and that there is no accumulation of solids.

The membranes are totally submerged and have a pore size of 0.4 microns, which remove all suspended solids in the effluent.

Permeation pumps are provided to suction the effluent through the membrane modules and transport it to the permeate tank. Permeation pumps are supplied with variable speed drives to overcome any changes in transmembrane pressure and achieve the design at all times.

The operating cycle for the selected modules is to suction effluent water for seven (7) minutes and to relax the membrane for one (1) minute. The cycle optimizes the long-term operation of the membrane modules. The housings are constructed with an integrated diffuser at the bottom to aerate continuously the membrane and prevent clogging and accumulation of sludge. The relaxation of the membranes allows extending the interval between cleanings (CIP or Clean-In-Place). CIP cleans are done about twice a year. Washes are performed with permeate stored in the permeate storage tank while a cleaning chemical (either sodium hypochlorite or citric acid) is added. Chemical solutions are reverse flowing through the membranes, which are soaked for a few hours after. After washing, the permeation is restarted. While a train is washing, the other train can continue to treat water and ensure a continuous production of effluent.

Once a week, a chemically enhanced backpulse (CEB) should be performed on the membrane modules with sodium hypochlorite to mitigate membrane fouling. Permeate flow is reversed to flow back into the membranes while the cleaning chemical is added inline.

2.2.4 UV Disinfection System

From the permeate pumps, each membrane bioreactor train sends permeate through an inline ultraviolet disinfection system. It is a physical process that inactivates instantaneously microorganisms. The UV system process adds no chemicals to the water, and therefore, has no impact on the chemical composition of the effluent. From here, effluent is sent to a common permeate storage tank. The permeate tank acts as a reservoir for treated water that is pumped to a discharge location. This tank can also be used for CEB and CIP process, as previously mentioned.

2.2.5 Sludge Handling System

Since bacteria continue to reproduce as they consume organics and nutrients, the concentration of biomass, measured as Mixed Liquor Suspended Solids (MLSS), increases with time. Periodic sludge wasting is required to control the MLSS concentration in the bioreactor tanks.


Sludge is sent to the sludge storage tank by redirecting the flow of the RAS pump. A blower and coarse bubble diffuser system maintains an aerobic environment within the sludge tank to minimize the proliferation of odours. Periodic settling is used to facilitate the thickening of the waste activated sludge. The supernatant (upper portion of the tank) is sent back to the sump tank by opening a valve, where it will re-enter the treatment process. This operation (called decanting) reduces the volume of sludge that needs to be handled and extends the period of time that the sludge tank can be used before thickened sludge is disposed.

3 DRAWINGS AND SKETCHES

Drawings of the new STP are available in Appendix A.



Appendix A: Sewage Treatment Plant Design Drawings

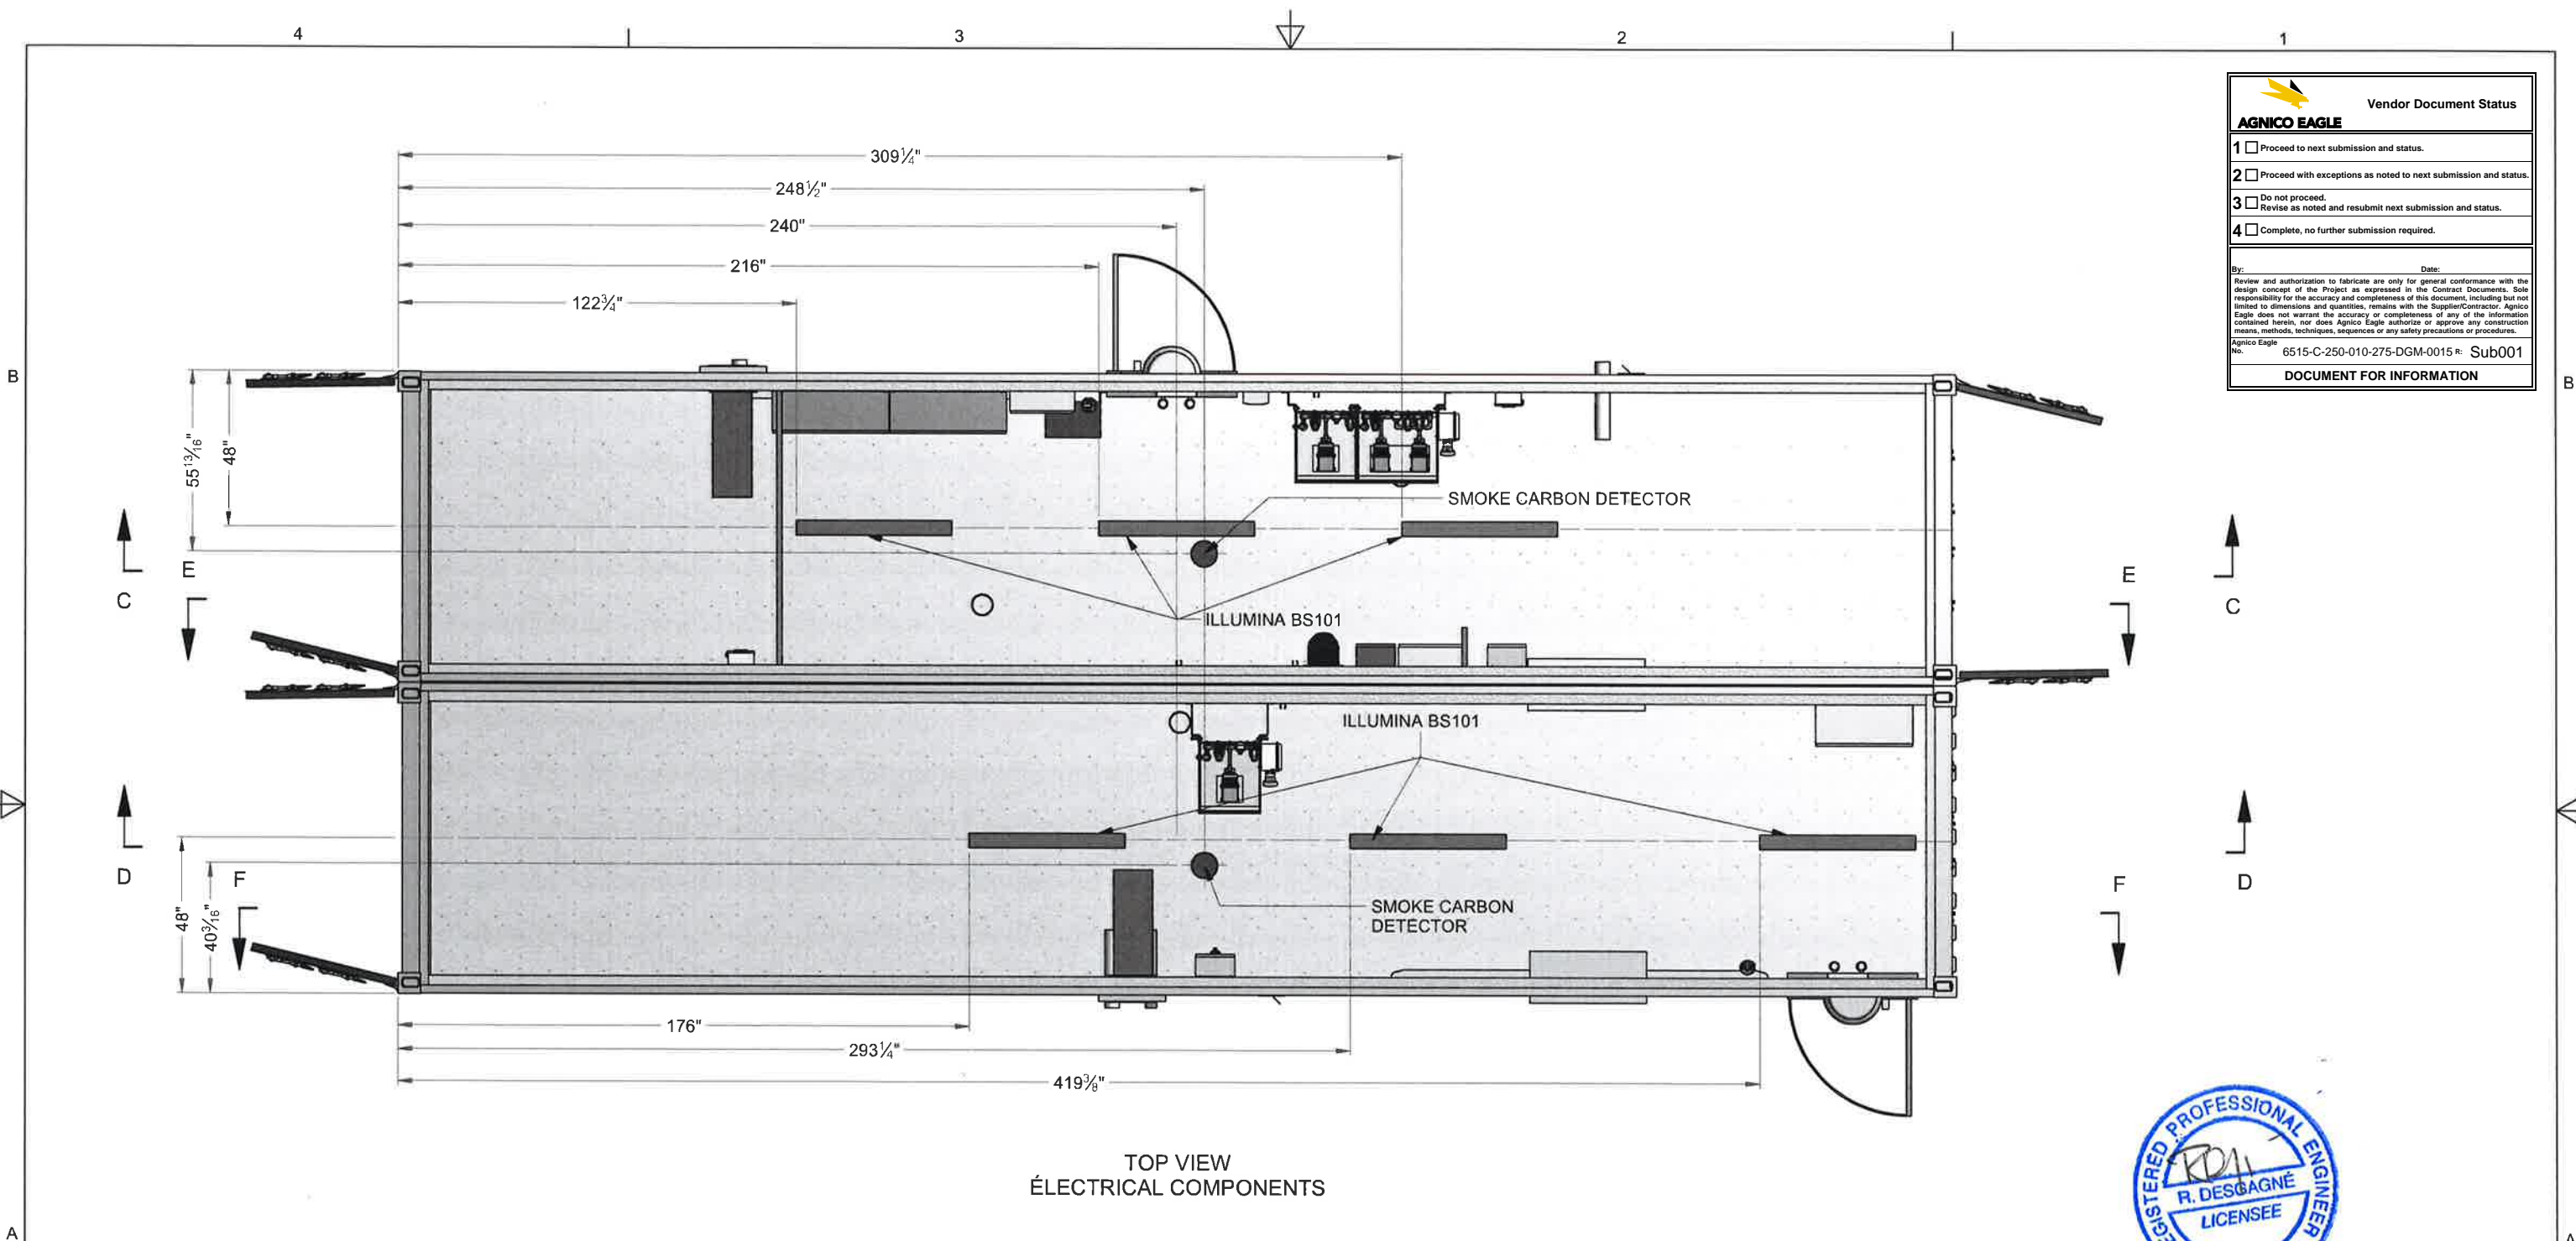

Vendor Document Status

☐ 1

Proceed to next submission and status.

☐ 2

Proceed with exceptions as noted to next submission and status.

☐ 3

Do not proceed.
Revise as noted and resubmit next submission and status.

☐ 4

Complete, no further submission required.

By:

Date:

Review and authorization to fabricate are only for general conformance with the design concept of the Project as expressed in the Contract Documents. Sole responsibility for the accuracy and completeness of this document, including but not limited to dimensions and quantities, remains with the Supplier/Contractor. Agnico Eagle does not warrant the accuracy or completeness of any of the information contained herein, nor does Agnico Eagle authorize or approve any construction means, methods, techniques, sequences or any safety precautions or procedures.

Agnico Eagle No. 6515-C-250-010-275-DGM-0015



Sub001

DOCUMENT FOR INFORMATION



26/10/2016

<div>NOTE:</div> <div>THE INFORMATION, SPECIFICATIONS AND DATA SHOWN ON THIS PRINT ARE FURNISHED BY AND ARE TO REMAIN THE PROPERTY OF H₂O INNOVATION.</div> <div>THE PURPOSE OF THIS DOCUMENT IS TO FACILITATE THE INSTALLATION, MAINTENANCE AND OPERATION OF THE EQUIPMENT REPRESENTED BY SAID PRINT. NO OTHER USE OF THIS DOCUMENT SHALL BE MADE WITHOUT EXPRESS WRITTEN CONSENT FROM H₂O INNOVATION.</div>	DRAWING REVISION				<div>h₂o</div> <div>INNOVATION</div> <div>knowledge to share, du savoir à partager</div>	<div>UNLESS NOTED OTHERWISE</div> <div>INTERVIEWED</div> <div>REVIEWED</div> <div>DO NOT SCALE PRINTS</div>	<div>MELIADINE, NU</div> <div>216 m3/day</div>	TITLE		
	REV	DATE	REVISION DESCRIPTION	DRAWN	PEER	ENG	APPVD			
	00	30/06/2016	PRELIMINARY	MC	HC	MB	MB	SCALE: N.T.S		DRAWING NUMBER
									U65875-B01-0002	
									REVISION	
									00	
									SHEET: 1 OF 9	

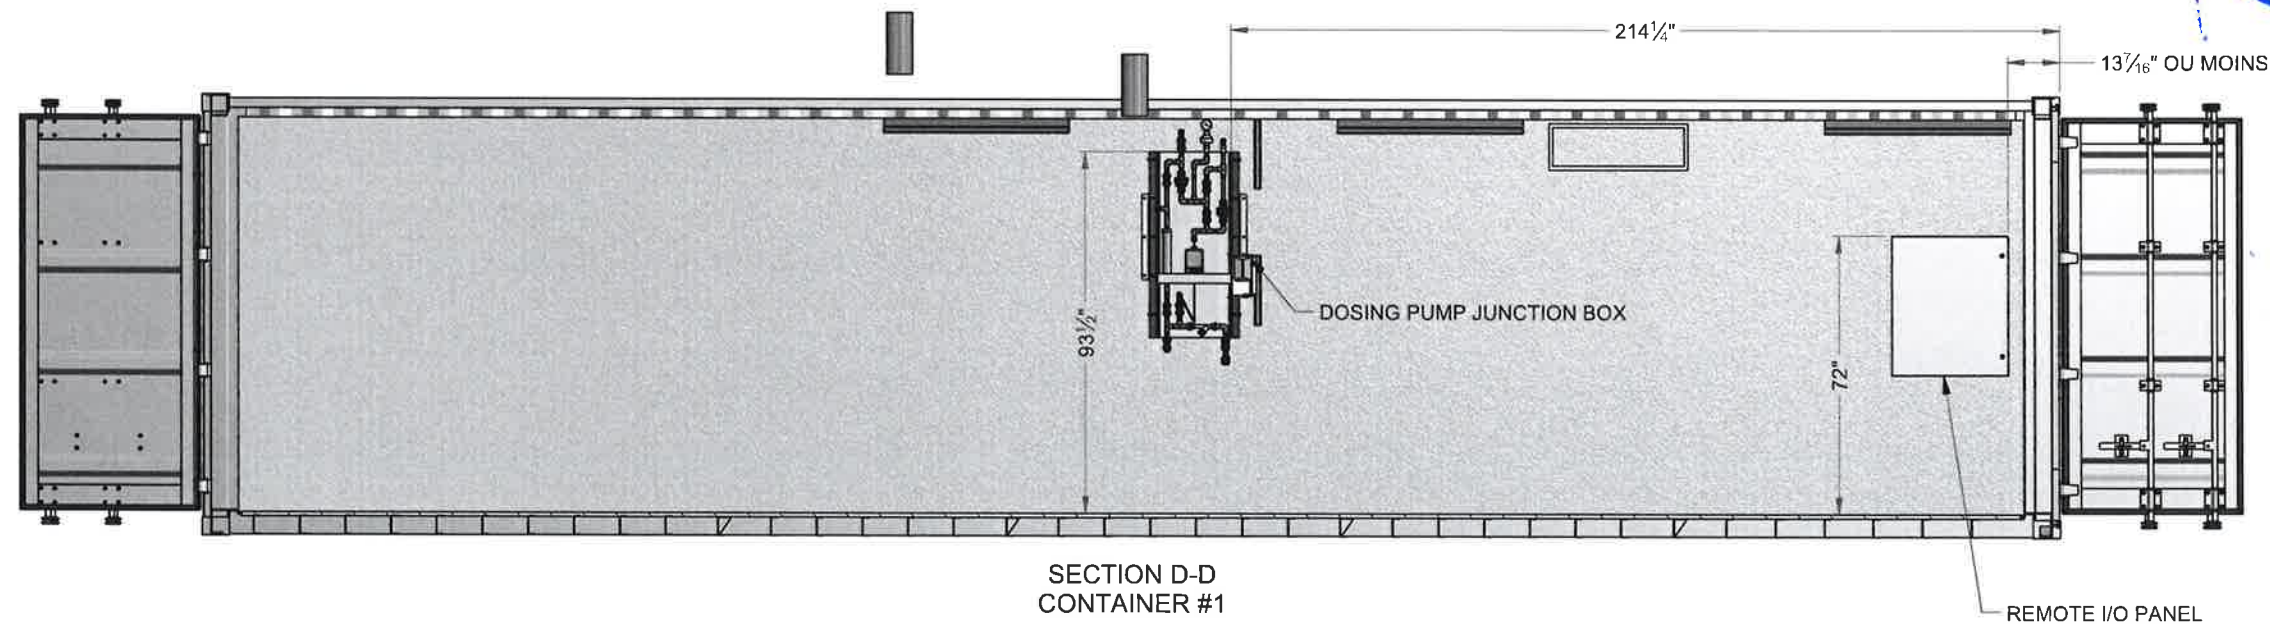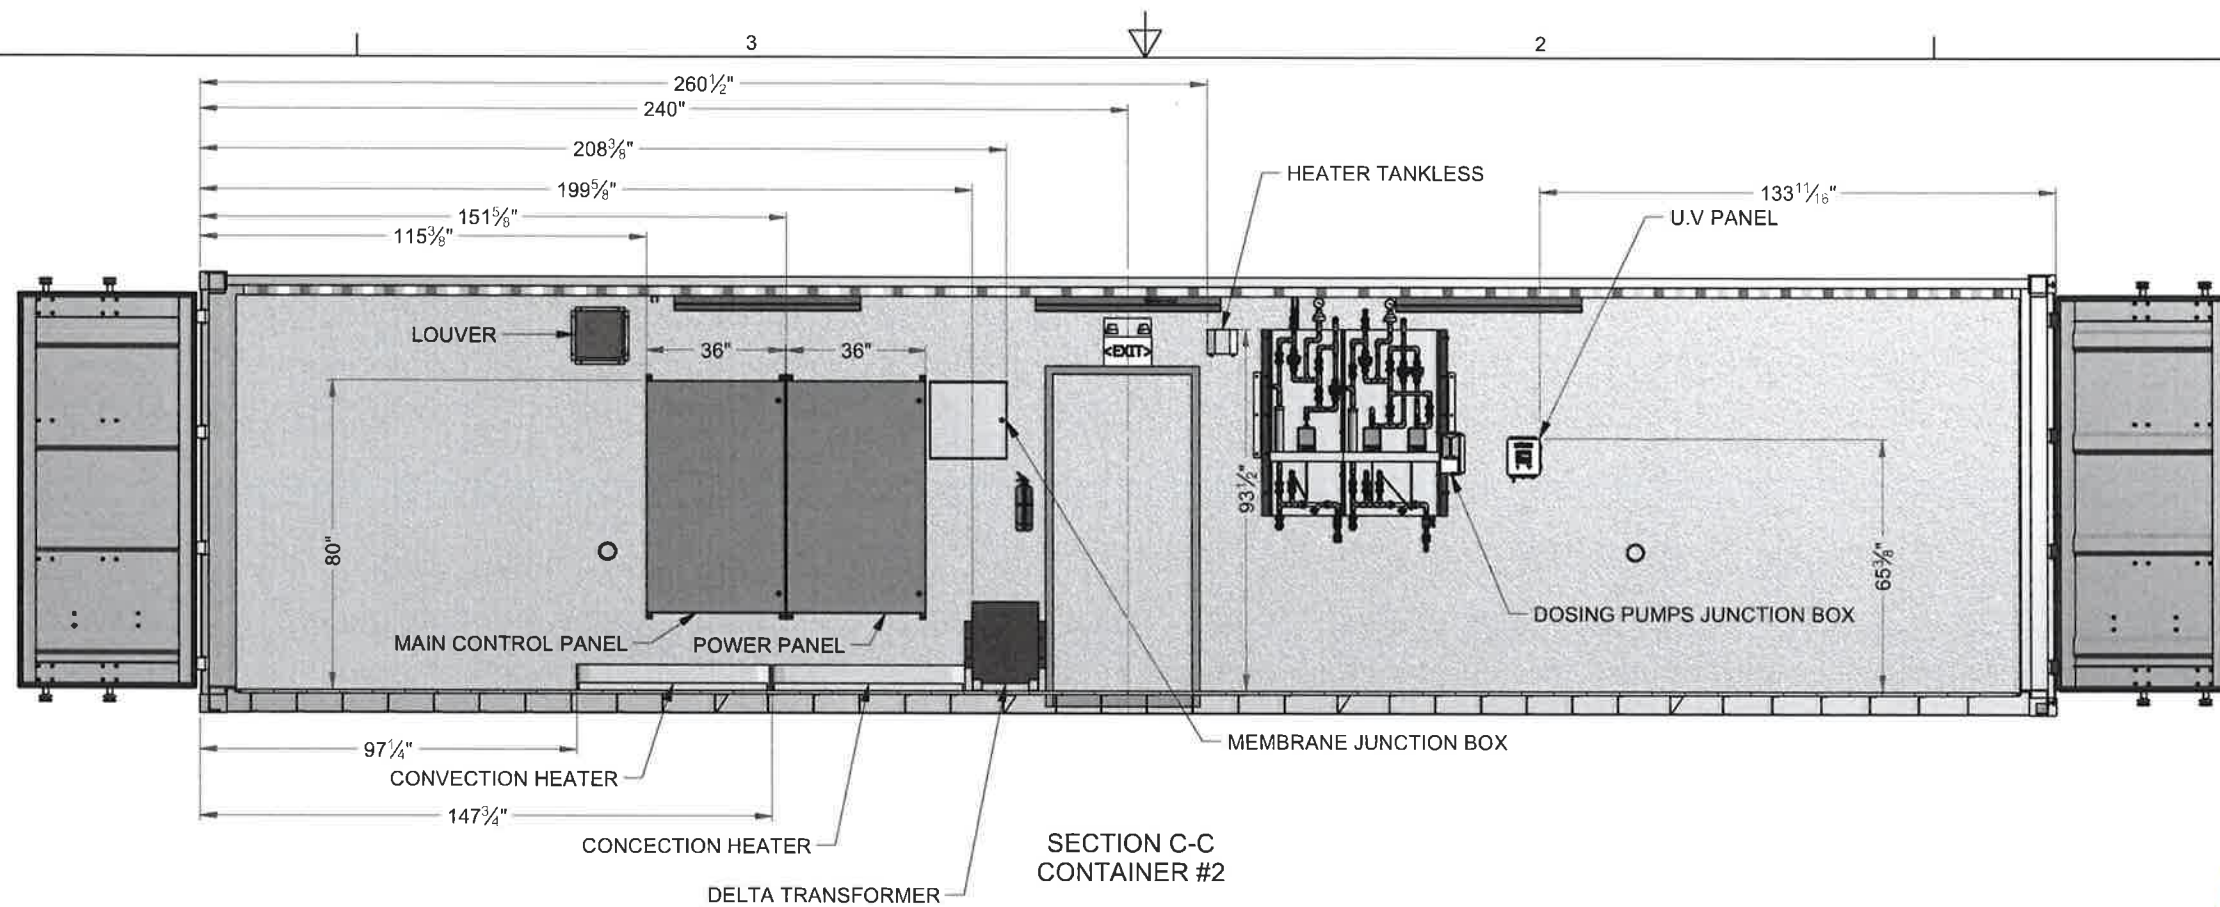

NOTE:
THE INFORMATION, SPECIFICATIONS AND DATA SHOWN ON THIS PRINT ARE FURNISHED BY AND ARE TO REMAIN THE PROPERTY OF H₂O INNOVATION.

THE PURPOSE OF THIS DOCUMENT IS TO FACILITATE THE INSTALLATION, MAINTENANCE AND OPERATION OF THE EQUIPMENT REPRESENTED BY SAID PRINT. NO OTHER USE OF THIS DOCUMENT SHALL BE MADE WITHOUT EXPRESS WRITTEN CONSENT FROM H₂O INNOVATION.

DRAWING REVISION				DRAWN			
REV	DATE	REVISION DESCRIPTION		MC	HC	MB	APP'D
00	30/06/2016	PRELIMINARY					MB




UNLESS NOTED OTHERWISE
DO NOT SCALE PRINTS


MELIADINE, NU
216 m3/day

TITLE: WASTE WATER CONTAINER ELECTRICAL GENERAL ARRANGEMENT		
SCALE: N.T.S	DRAWING NUMBER: U65875-B01-0002	REVISION 00

SHEET: 2 OF 9

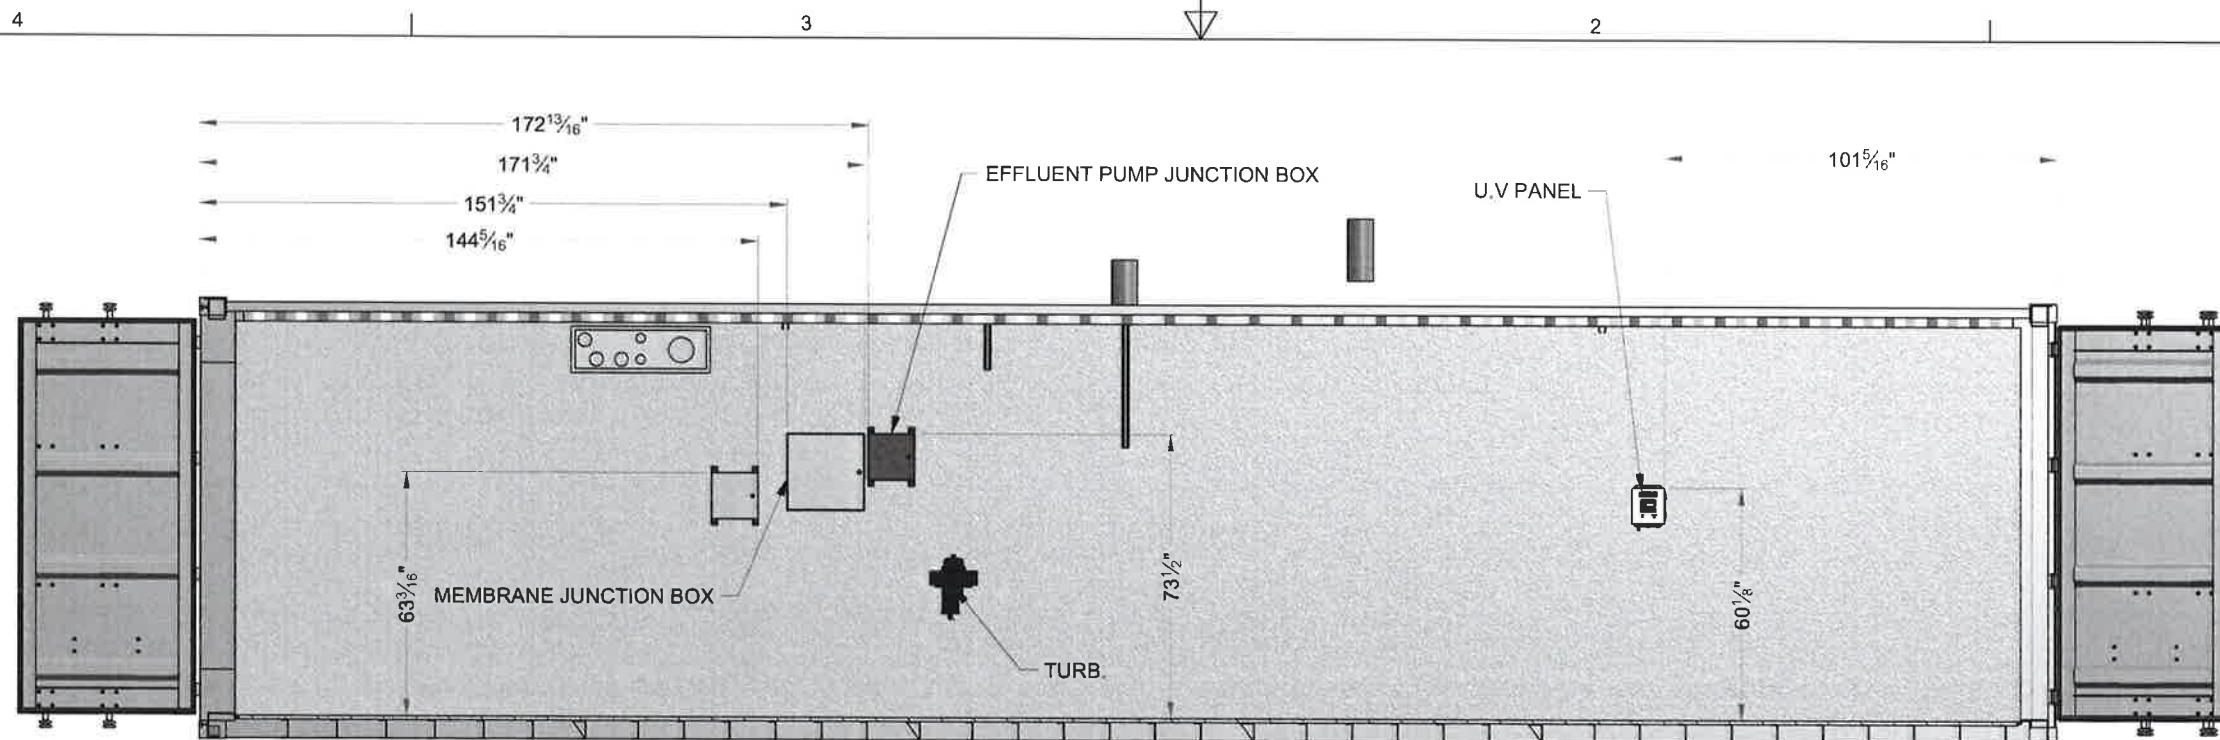


SECTION E-E
CONTAINER #2

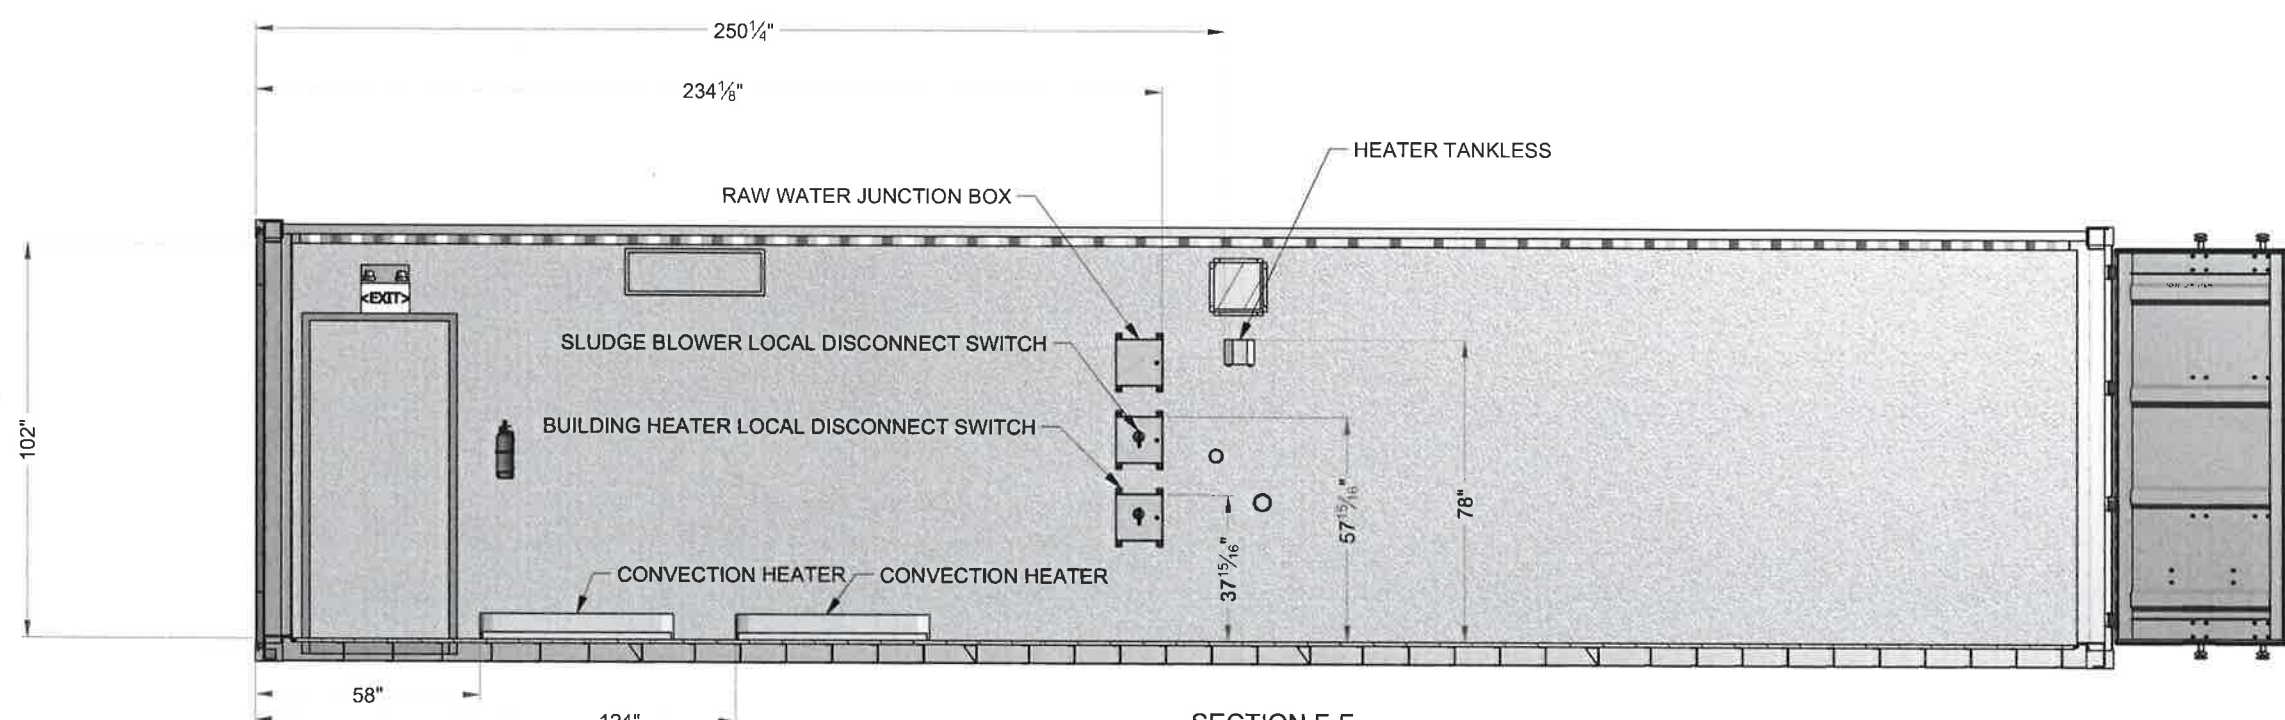

SECTION F-F
CONTAINER #1



NOTE: THE INFORMATION, SPECIFICATIONS AND DATA SHOWN ON THIS PRINT ARE FURNISHED BY AND ARE TO REMAIN THE PROPERTY OF H ₂ O INNOVATION. THE PURPOSE OF THIS DOCUMENT IS TO FACILITATE THE INSTALLATION, MAINTENANCE AND OPERATION OF THE EQUIPMENT REPRESENTED BY SAID PRINT. NO OTHER USE OF THIS DOCUMENT SHALL BE MADE WITHOUT EXPRESS WRITTEN CONSENT FROM H ₂ O INNOVATION.	DRAWING REVISION						 <small>Knowledge to share, du savoir à partager</small>	UNLESS NOTED OTHERWISE INTERPRETATION: 	MELIADINE, NU 216 m3/day	TITLE: WASTE WATER CONTAINER ELECTRICAL GENERAL ARRANGEMENT		
	REV	DATE	REVISION DESCRIPTION	DRAWN	PEER	ENG	APPVD			SCALE: N.T.S	DRAWING NUMBER: U65875-B01-0002	REVISION
	00	30/06/2016	PRELIMINARY	MC	HC	MB	MB					00

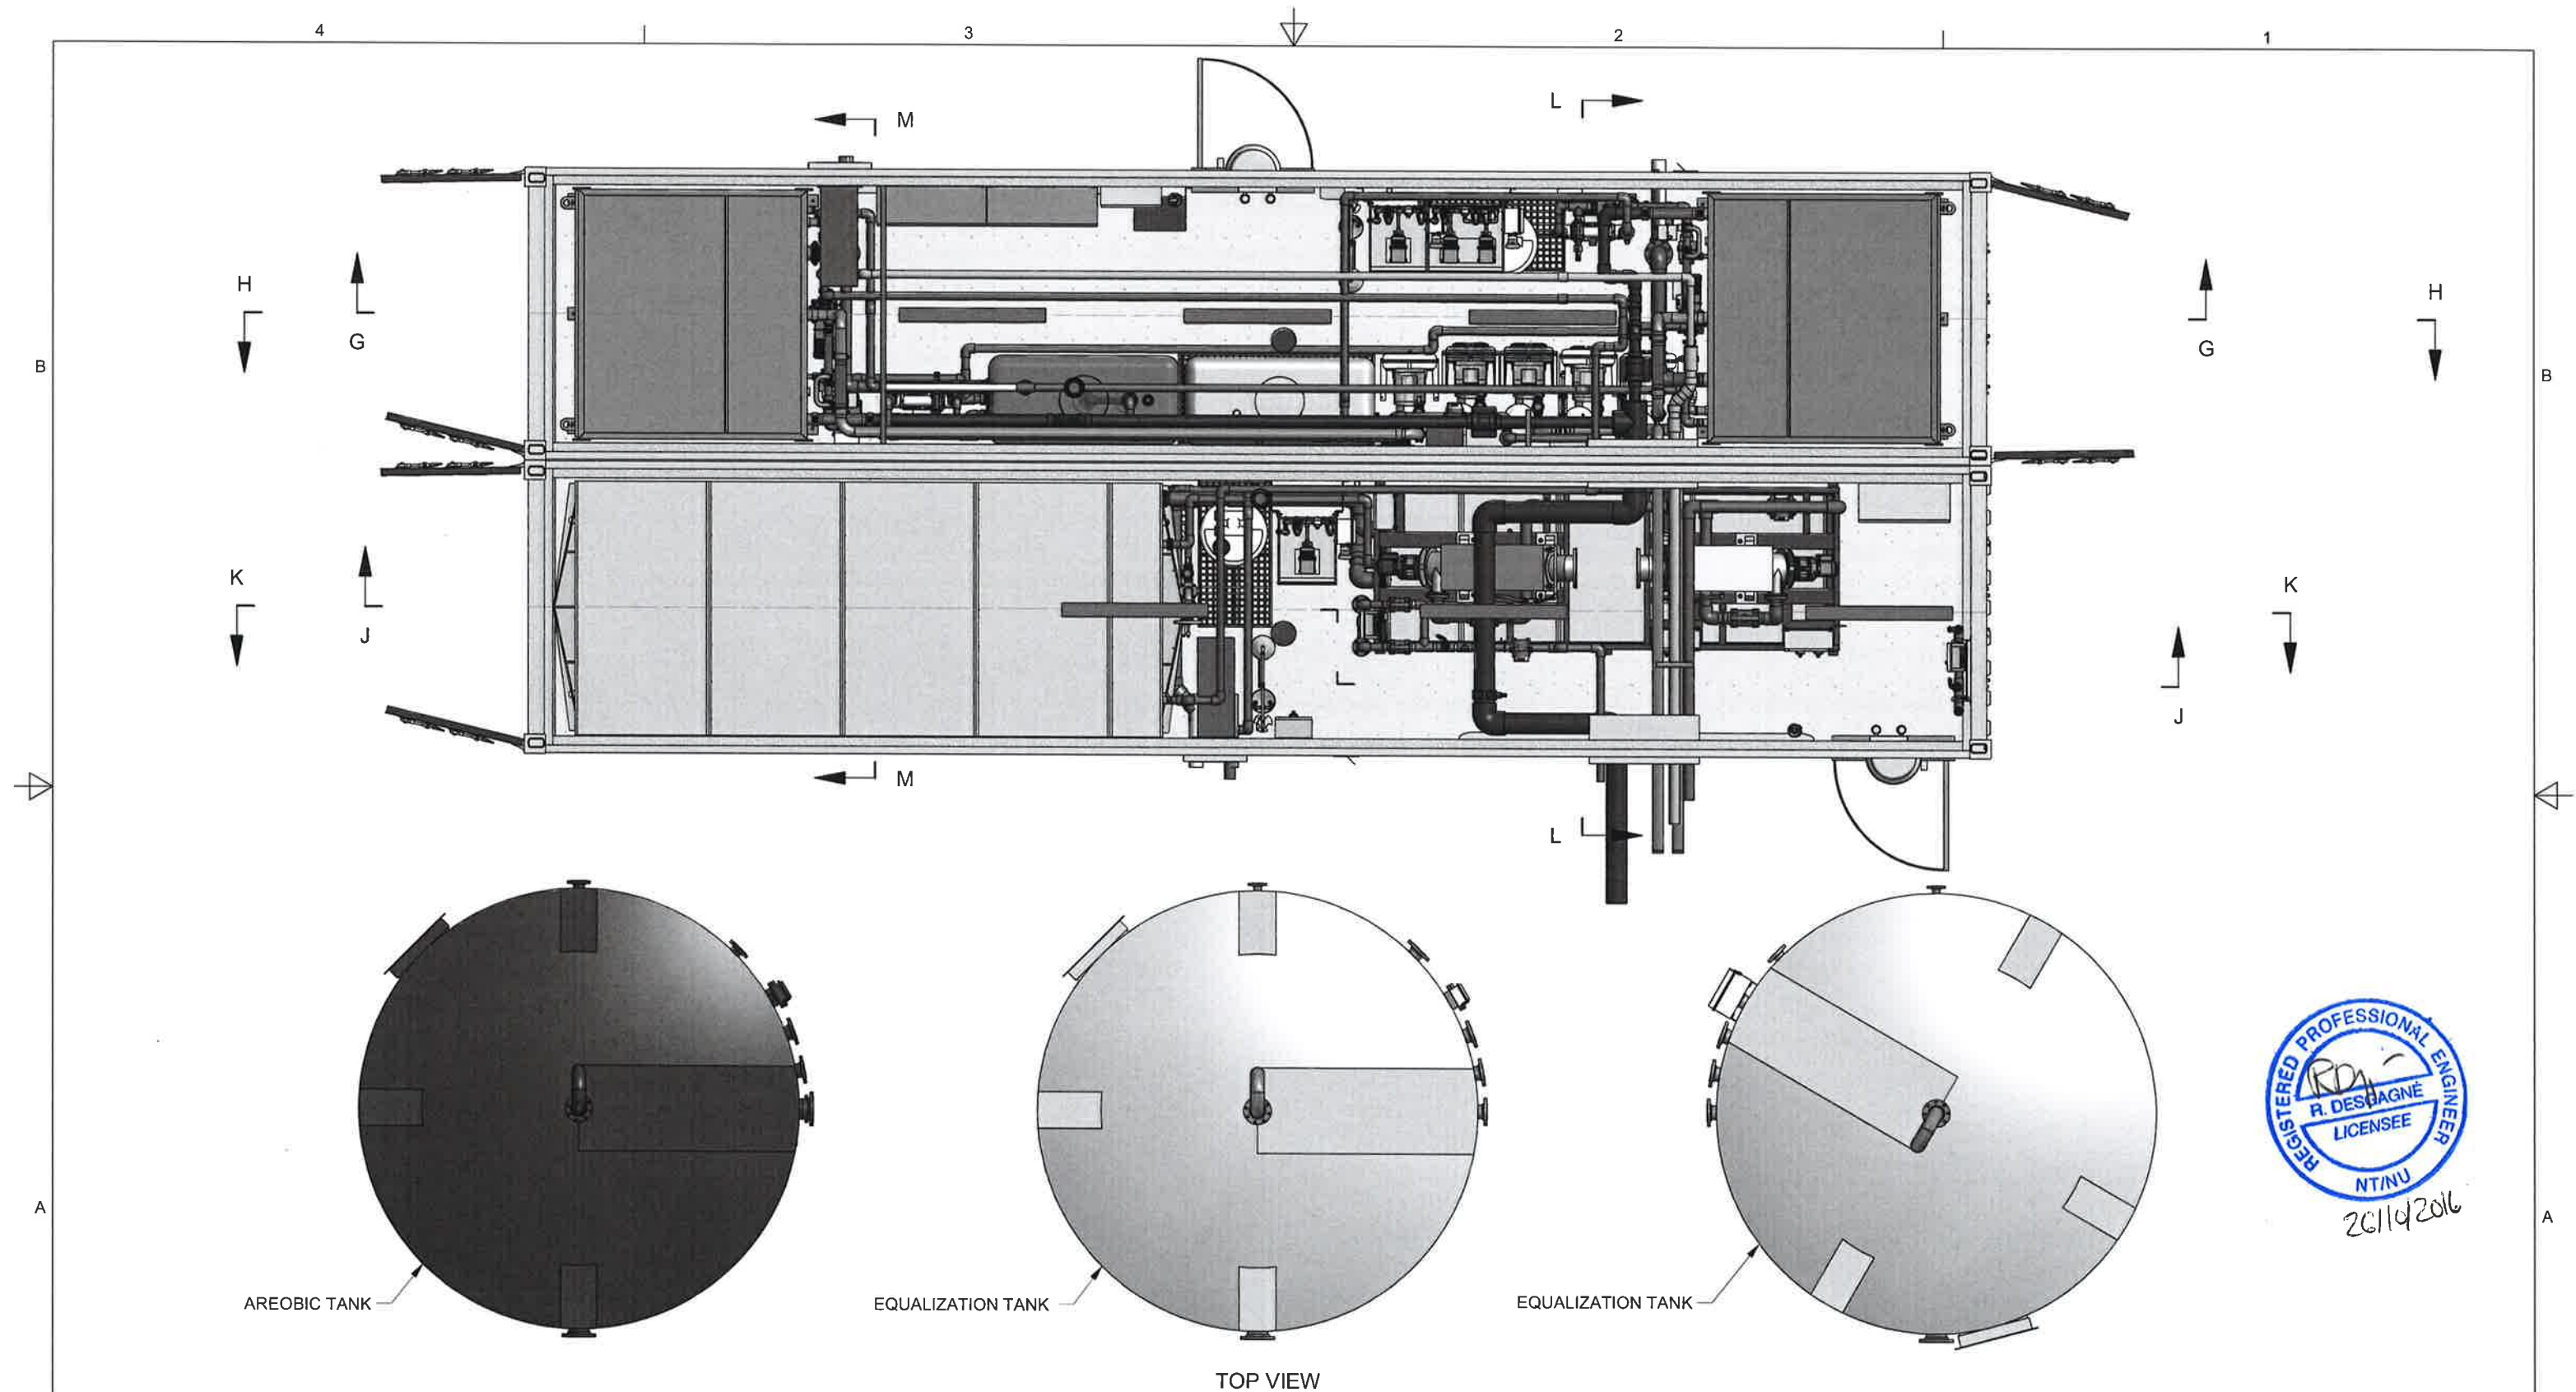

NOTE:
THE INFORMATION, SPECIFICATIONS AND DATA SHOWN ON THIS PRINT ARE FURNISHED BY AND ARE TO REMAIN THE PROPERTY OF H₂O INNOVATION.

THE PURPOSE OF THIS DOCUMENT IS TO FACILITATE THE INSTALLATION, MAINTENANCE AND OPERATION OF THE EQUIPMENT REPRESENTED BY SAID PRINT. NO OTHER USE OF THIS DOCUMENT SHALL BE MADE WITHOUT EXPRESS WRITTEN CONSENT FROM H₂O INNOVATION.

REV		DATE	DRAWING REVISION				DRAWN	PEER	ENG	APPVD
			REVISION DESCRIPTION							
00		30/06/2016	PRELIMINARY				MC	HC	MB	MB

h₂o
Innovation
knowledge to share, du savoir à partager

UNLESS NOTED OTHERWISE
INTERPRETATION: ANALYSIS

TOLERANCES: FRACTIONS 1/16" 1/32" 1/64" 3/32" 1/8" 1/4" 3/8" 1/2" 5/8" 3/4" 1" 1 1/4" 1 1/2" 2" 2 1/2" 3" 3 1/2" 4" 4 1/2" 5" 5 1/2" 6" 6 1/2" 7" 7 1/2" 8" 8 1/2" 9" 9 1/2" 10" 11" 12" 14" 16" 100"


DO NOT SCALE PRINTS

MELIADINE, NU

216 m3/day

TITLE: WASTE WATER CONTAINER ELECTRICAL GENERAL ARRANGEMENT		
SCALE: N.T.S	DRAWING NUMBER: U65875-B01-0002	REVISION 00



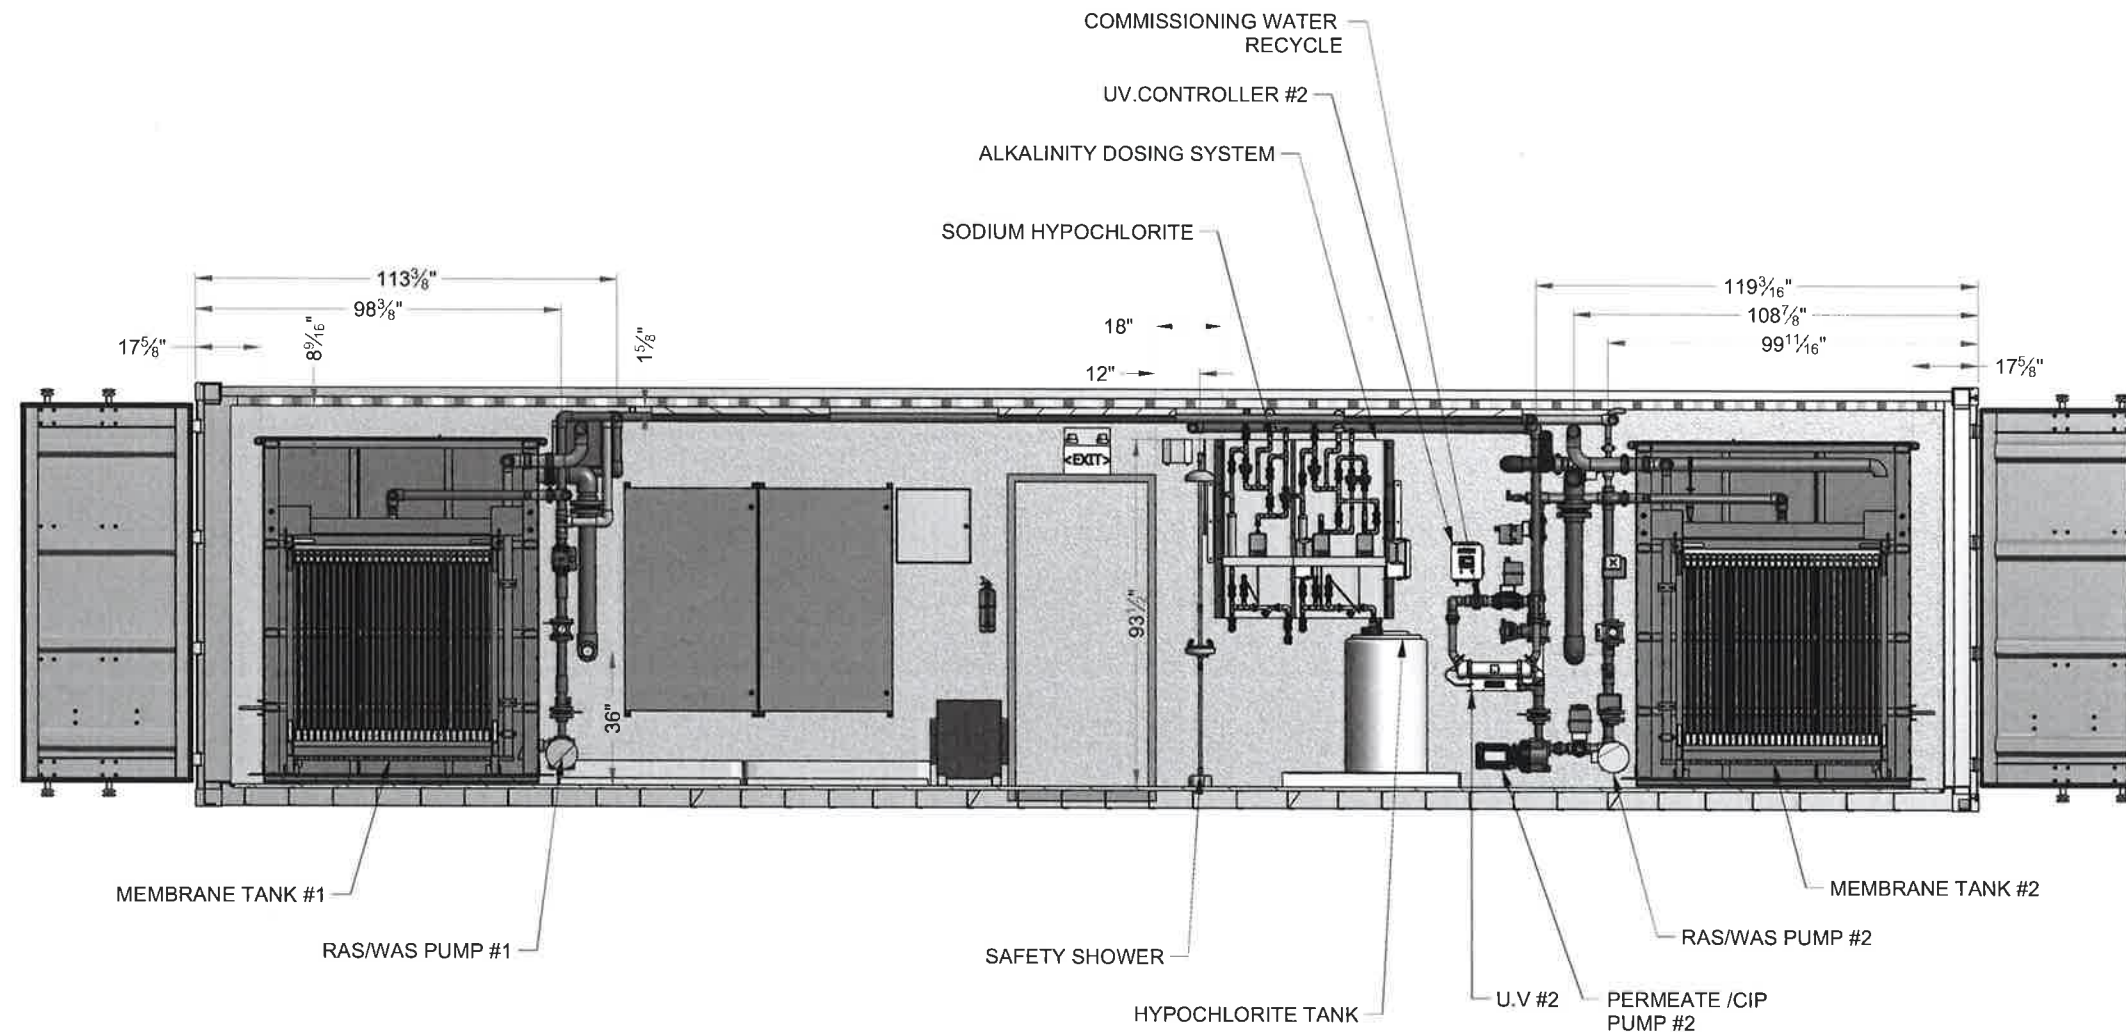

SECTION G-G
CONTAINER #2



NOTE:
THE INFORMATION, SPECIFICATIONS AND DATA SHOWN ON THIS PRINT ARE FURNISHED BY AND ARE TO REMAIN THE PROPERTY OF H₂O INNOVATION.

THE PURPOSE OF THIS DOCUMENT IS TO FACILITATE THE INSTALLATION, MAINTENANCE AND OPERATION OF THE EQUIPMENT REPRESENTED BY SAID PRINT. NO OTHER USE OF THIS DOCUMENT SHALL BE MADE WITHOUT EXPRESS WRITTEN CONSENT FROM H₂O INNOVATION.


DRAWING REVISION						
REV	DATE	REVISION DESCRIPTION	DRAWN	PEER	ENG	APPVD
00	30/06/2016	PRELIMINARY	MC	HC	MB	MB



UNLESS NOTED OTHERWISE
INTERPRETATION AND USE
TOLERANCES: FRACTIONS 32ND, DECIMALS 2ND, ANGLES: HOLE SIZES 16TH, HOLE CENTERS 32ND
DO NOT SCALE PRINTS

MELIADINE, NU
216 m3/day


TITLE: WASTE WATER CONTAINER ELECTRICAL GENERAL ARRANGEMENT		
SCALE: N.T.S	DRAWING NUMBER: U65875-B01-0002 SHEET: 5 OF 9	REVISION 00

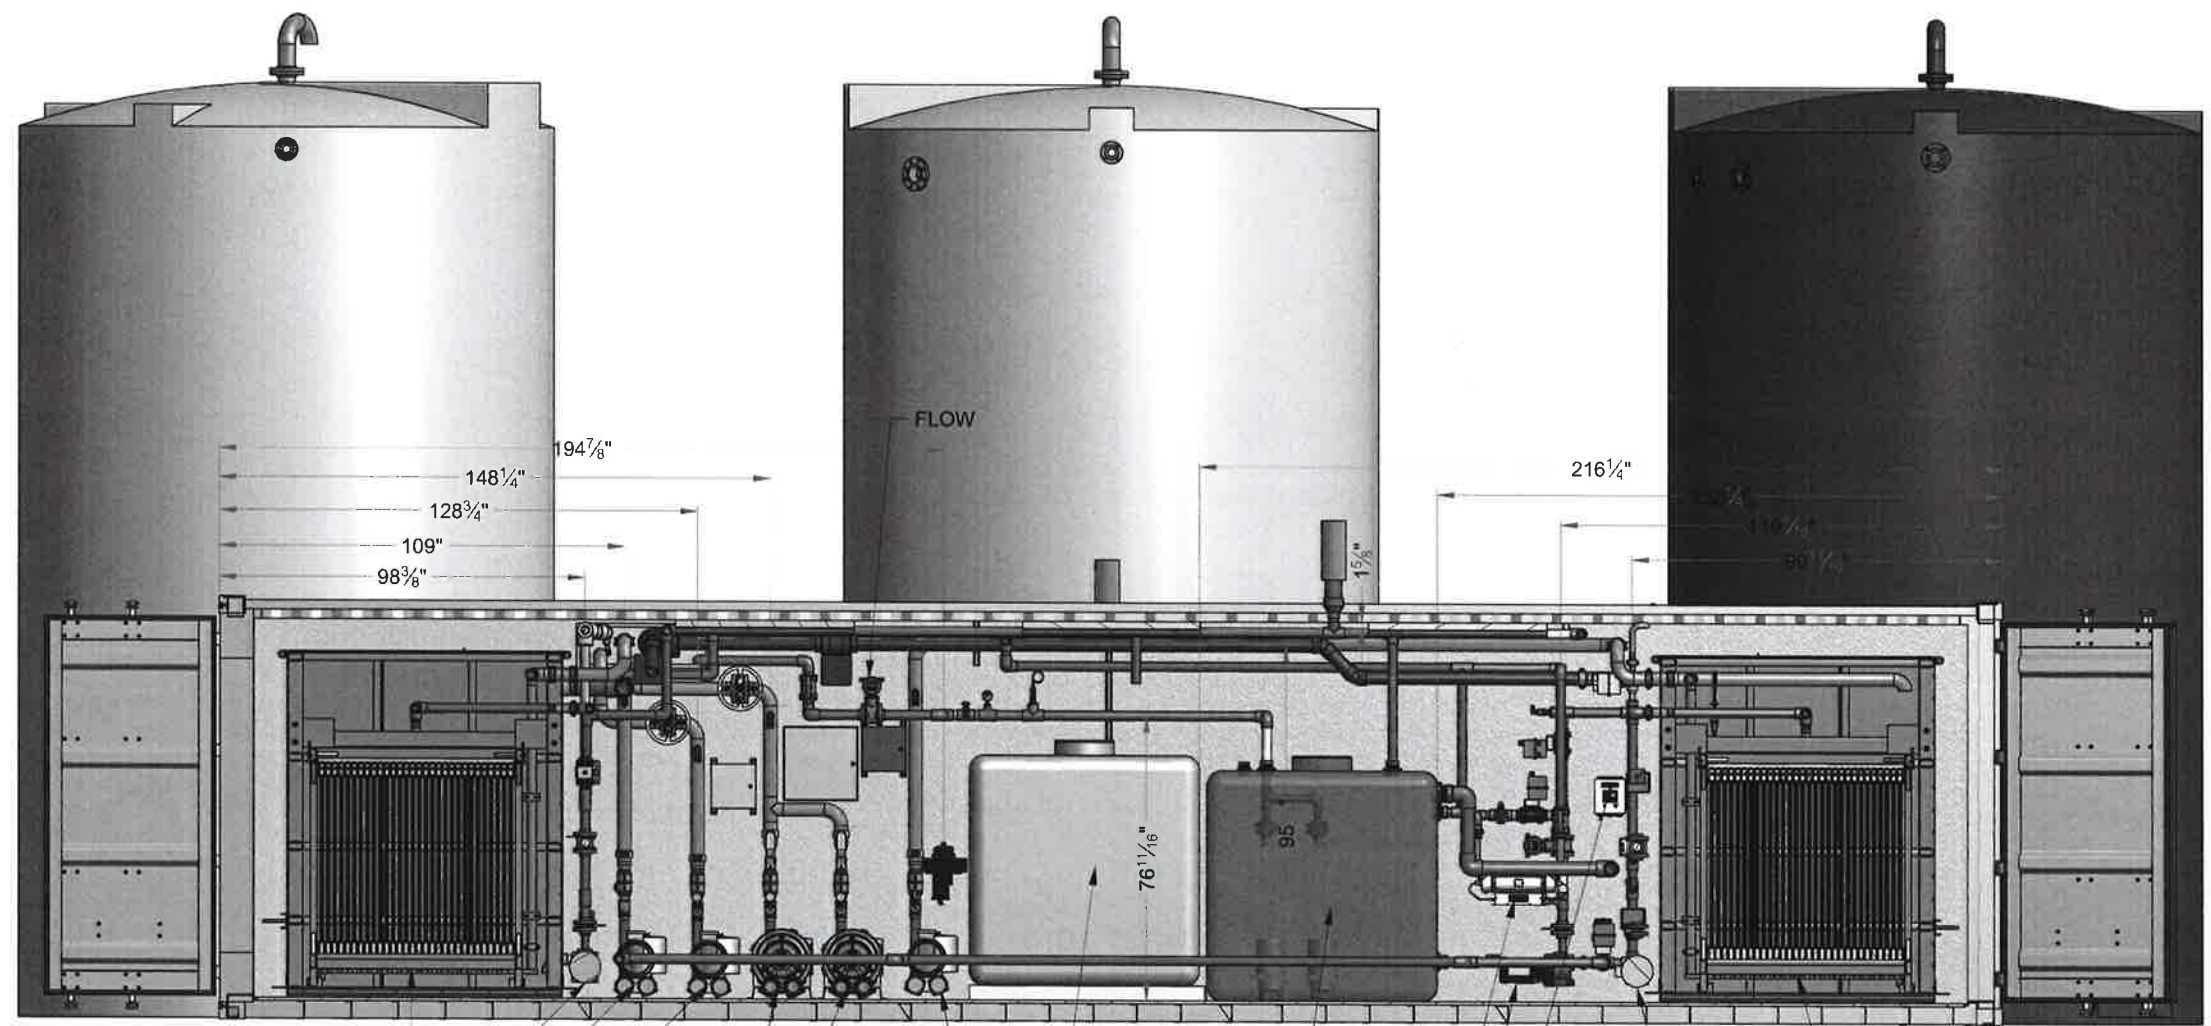


- MEMBRANE TANK #2
- RAS/WAS PUMP #2
- MEMBRANE BLOWER #2
SEE DRAWING U65875-D09-0750-10
- EQUALIZATION BLOWER
SEE DRAWING U65875-D09-0750-30
- PROCES BLOWER
SEE DRAWING U65875-D09-0750-40
- PERMEATE TANK
- U.V. #1
- PERMEATE /CIP PUMP #1
- U.V. CONTROLLER #1
- ALKALINITY TANK
- MEMBRANE BLOWER #1
SEE DRAWING U65875-D09-0750-10-B
- RAS/WAS PUMP #1
- MEMBRANE TANK #1



SECTION H-H
CONTAINER #2

NOTE: THE INFORMATION, SPECIFICATIONS AND DATA SHOWN ON THIS PRINT ARE FURNISHED BY AND ARE TO REMAIN THE PROPERTY OF H ₂ O INNOVATION. THE PURPOSE OF THIS DOCUMENT IS TO FACILITATE THE INSTALLATION, MAINTENANCE AND OPERATION OF THE EQUIPMENT REPRESENTED BY SAID PRINT. NO OTHER USE OF THIS DOCUMENT SHALL BE MADE WITHOUT EXPRESS WRITTEN CONSENT FROM H ₂ O INNOVATION.		DRAWING REVISION					UNLESS NOTED OTHERWISE INTERPRETATION: ANGLES TOLERANCES: FRACTIONS: 1/16" MIN. DECIMALS: 0.005" MIN. DIMENSIONS: 1/4" MIN. HOLE CLOSURE: 1/16" MIN. DO NOT SCALE PRINTS	MELIADINE, NU 216 m3/day	TITLE: WASTE WATER CONTAINER ELECTRICAL GENERAL ARRANGEMENT		
		REV	DATE	REVISION DESCRIPTION	DRAWN	PEER	ENG	APPVD	SCALE:	DRAWING NUMBER:	REVISION
		00	30/06/2016	PRELIMINARY	MC	HC	MB	MB		U65875-B01-0002	00

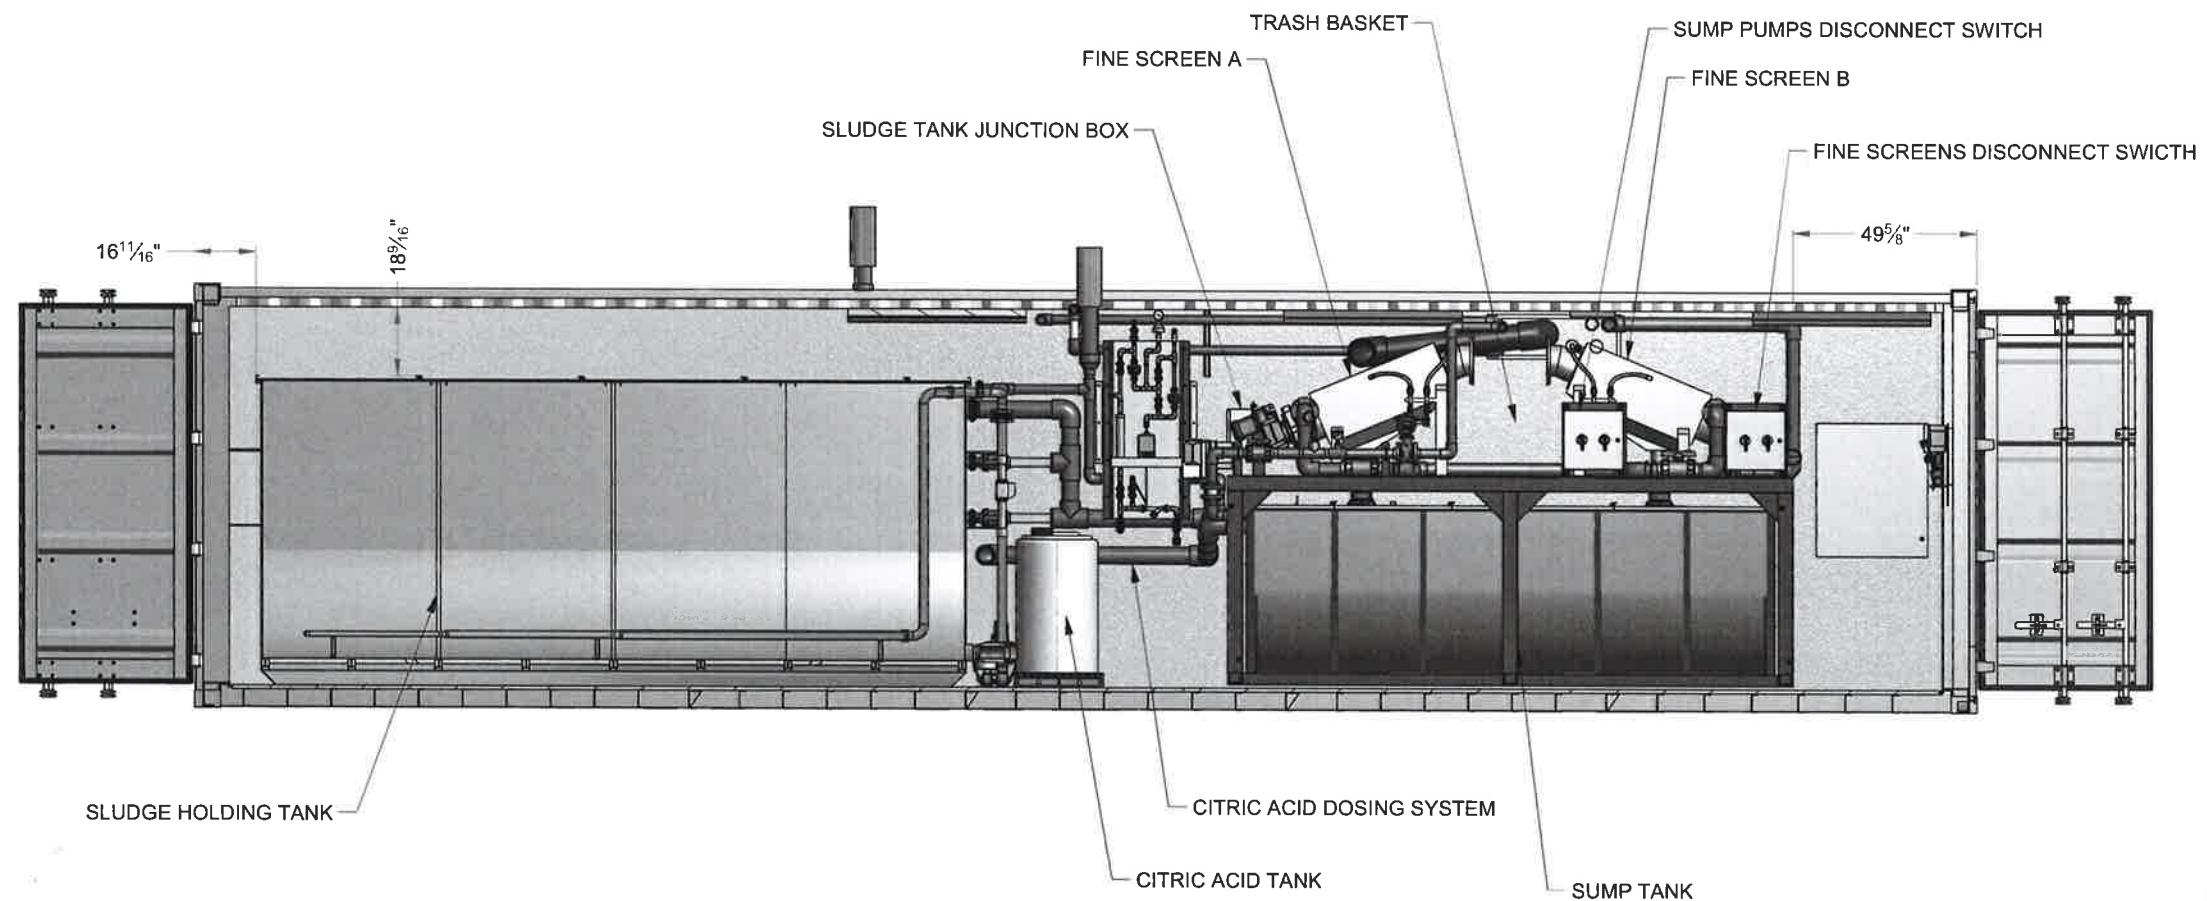

SECTION J-J
CONTAINER #1



NOTE:
THE INFORMATION, SPECIFICATIONS AND DATA SHOWN ON THIS PRINT ARE FURNISHED BY AND ARE TO REMAIN THE PROPERTY OF H₂O INNOVATION.

THE PURPOSE OF THIS DOCUMENT IS TO FACILITATE THE INSTALLATION, MAINTENANCE AND OPERATION OF THE EQUIPMENT REPRESENTED BY SAID PRINT. NO OTHER USE OF THIS DOCUMENT SHALL BE MADE WITHOUT EXPRESS WRITTEN CONSENT FROM H₂O INNOVATION.


DRAWING REVISION						
REV	DATE	REVISION DESCRIPTION	DRAWN	PEER	ENG	APPVD
00	30/06/2016	PRELIMINARY	MC	HC	MB	MB



UNLESS NOTED OTHERWISE
INTERPRETATION: AND T.Y.S.
TOLERANCES: FRACTIONS 2/32" 1/16" 1/32" 1/64"
DECIMALS 0.0063" 0.0031" 0.0015" 0.0008"
ANGLES: 1/2° 1/4° 1/8° 1/16°
HOLE SIZES: 1/16" 1/8" 3/16" 1/4" 3/8" 1/2" 5/8" 3/4" 7/8" 1"
HOLE CENTER: 1/16" 1/8" 3/16" 1/4" 3/8" 1/2" 5/8" 3/4" 7/8" 1"
DO NOT SCALE PRINTS

MELIADINE, NU
216 m3/day

TITLE: WASTE WATER CONTAINER ELECTRICAL GENERAL ARRANGEMENT		
SCALE: N.T.S	DRAWING NUMBER: U65875-B01-0002	REVISION 00

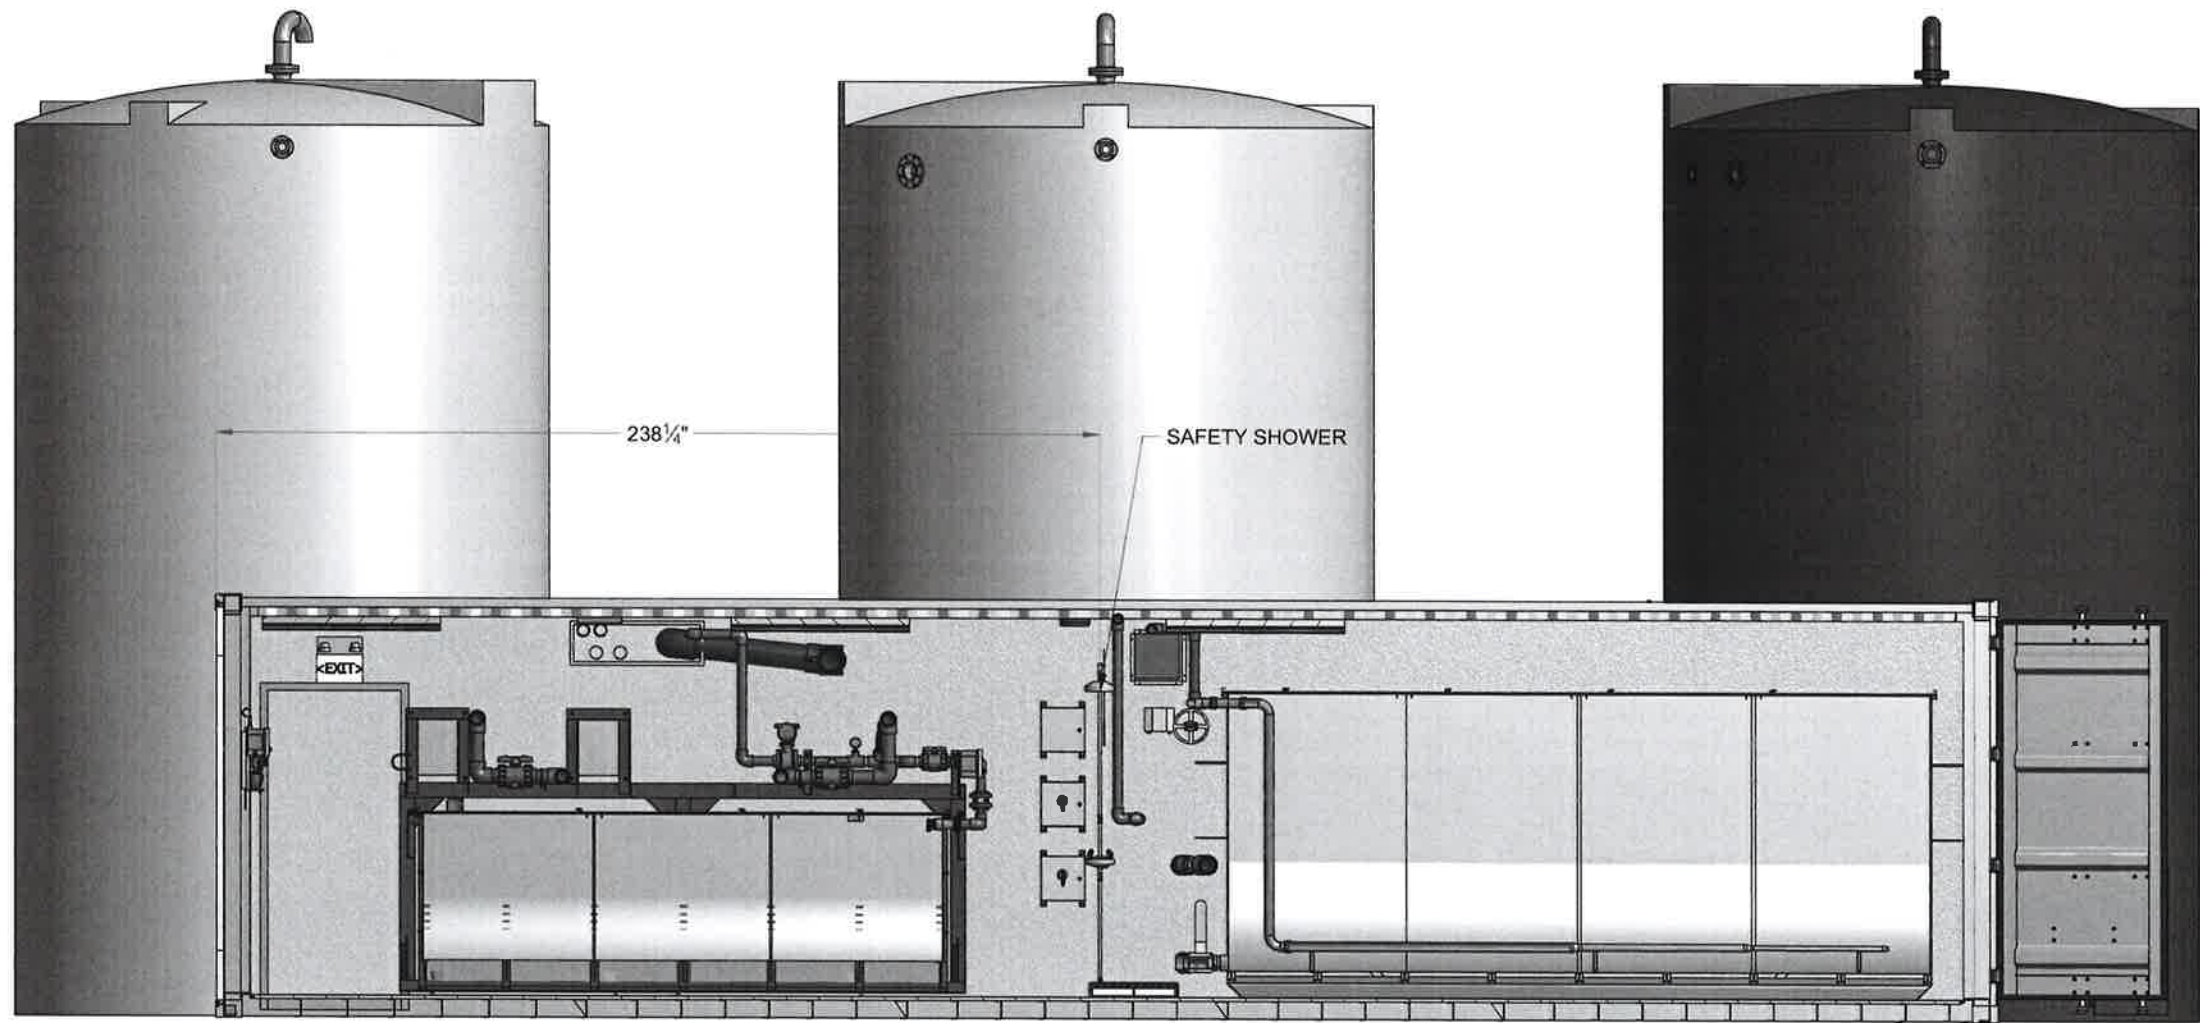

26/10/2016

SECTION K-K
CONTAINER #1

NOTE:
THE INFORMATION, SPECIFICATIONS AND DATA SHOWN
ON THIS PRINT ARE FURNISHED BY AND ARE TO REMAIN
THE PROPERTY OF H₂O INNOVATION.

THE PURPOSE OF THIS DOCUMENT IS TO FACILITATE THE
INSTALLATION, MAINTENANCE AND OPERATION OF THE
EQUIPMENT REPRESENTED BY SAID PRINT. NO OTHER
USE OF THIS DOCUMENT SHALL BE MADE WITHOUT
EXPRESS WRITTEN CONSENT FROM H₂O INNOVATION.

DRAWING REVISION						
REV	DATE	REVISION DESCRIPTION	DRAWN	PEER	ENG	APPVD
00	30/06/2016	PRELIMINARY	MC	HC	MB	MB




UNLESS NOTED
OTHERWISE
INTERPRETATION
AND YES
TOLERANCES
FRACTIONS
DECIMALS
ANGLES
HOLE SIZES
HOLE CENTERS
DO NOT SCALE PRINTS


MELIADINE, NU

216 m3/day

TITLE: WASTE WATER CONTAINER ELECTRICAL GENERAL ARRANGEMENT		
SCALE: N.T.S	DRAWING NUMBER: U65875-B01-0002 SHEET: 8 OF 9	REVISION 00

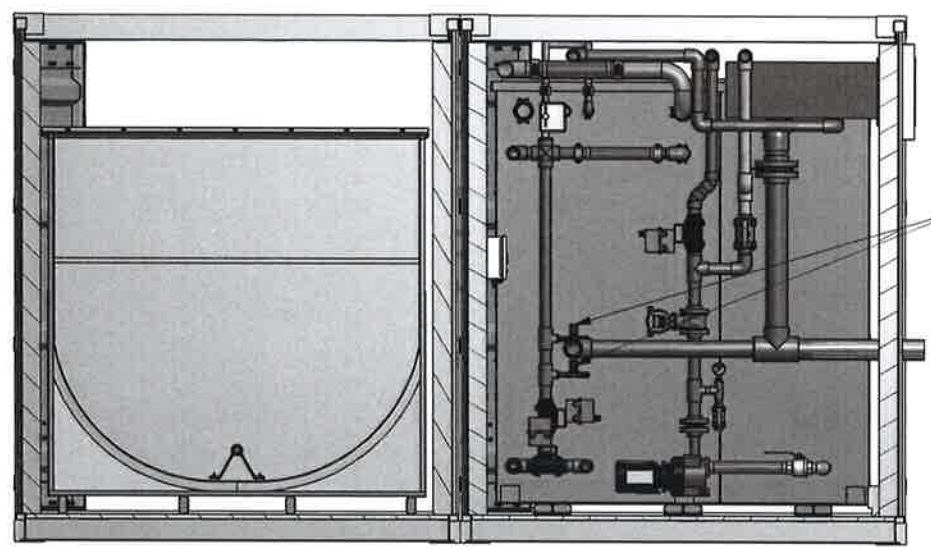

SECTION M-M

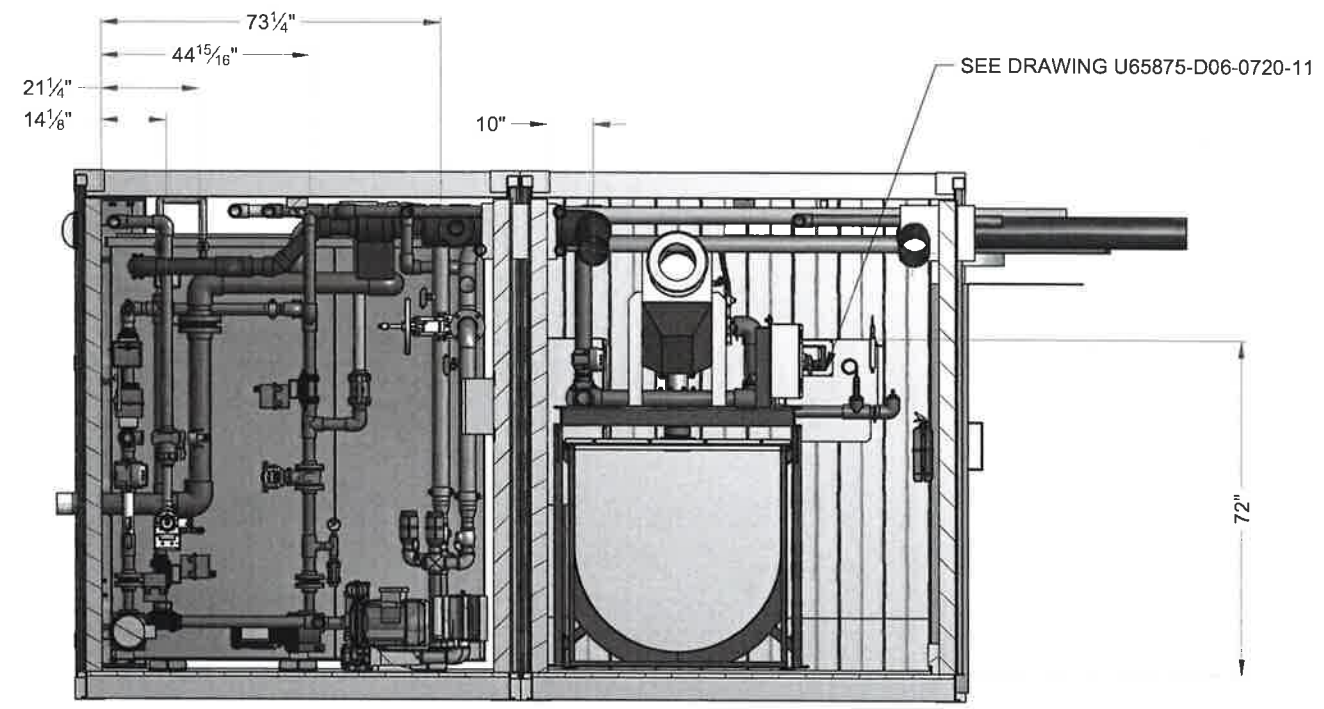

SECTION L-L



26/10/2016

NOTE:
THE INFORMATION, SPECIFICATIONS AND DATA SHOWN ON THIS PRINT ARE FURNISHED BY AND ARE TO REMAIN THE PROPERTY OF H₂O INNOVATION.

THE PURPOSE OF THIS DOCUMENT IS TO FACILITATE THE INSTALLATION, MAINTENANCE AND OPERATION OF THE EQUIPMENT REPRESENTED BY SAID PRINT. NO OTHER USE OF THIS DOCUMENT SHALL BE MADE WITHOUT EXPRESS WRITTEN CONSENT FROM H₂O INNOVATION.

DRAWING REVISION						
REV	DATE	REVISION DESCRIPTION	DRAWN	PEER	ENG	APPVD
00	30/06/2016	PRELIMINARY	MC	HC	MB	MB



UNLESS NOTED OTHERWISE
INTERPRETATION: ANALYSIS
TOLERANCES: FRACTIONS 2/16, DECIMALS 0.1, ANGLES 10°, HOLE DIMS 1/16, HOLE CENTERS 2/16
DO NOT SCALE PRINTS

MELIADINE, NU
216 m3/day

TITLE:		
WASTE WATER CONTAINER ELECTRICAL GENERAL ARRANGEMENT		
SCALE: N.T.S	DRAWING NUMBER: U65875-B01-0002	REVISION 00

4

3

2

1

VALVE SYMBOLS

N OPEN N CLOSED

BALL

V-BALL

BUTTERFLY

DIAPHRAGM

GATE

GLOBE

NEEDLE

PLUG

SAMPLE/DRAIN CHECK

BACKFLOW PREVENTER

INJECTION QUILL

3-WAY, 4-WAY

PRESSURE REGULATING

BACK PRESSURE REGULATING

FLOW CONTROL

2-WAY SOLENOID

3-WAY SOLENOID

4-WAY SOLENOID

AIR RELEASE

VACUUM BREAKER

PRESSURE RELEASE

SLUICE GATE/WEIR

VALVE ACTUATOR SYMBOLS

PNEUMATIC (FAIL LAST POSITION)

PNEUMATIC FAIL CLOSE

PNEUMATIC FAIL OPEN

ELECTRIC

DIAPHRAGM

POSITIONER (ANY ACTUATOR TYPE)

HAND OVERRIDE (ANY ACTUATOR TYPE)

TRAVEL STOPS (ANY ACTUATOR TYPE)

FLOWMETER SYMBOLS

FI

ROTAMETER

FI

ROTAMETER W/ INTEGRAL NEEDLE VALVE

FT

THERMAL

FT

INTEGRAL

FT

REMOTE

FT

MAGNETIC

FT

PADDLE

FT

VORTEX

FT

DP/ORIFICE

PIPING ABBREVIATIONS

316 SS

316 STAINLESS STEEL

304 SS

304 STAINLESS STEEL

316L SS

LOW CARBON 316 STAINLESS STEEL

304L SS

LOW CARBON 304 STAINLESS STEEL

CPVC

CHLORINATED POLYVINYL CHLORIDE

CS

CARBON STEEL

DI

DUCTILE IRON

HDPE

HIGH-DENSITY POLYETHYLENE

PE

POLYETHYLENE

PVC

POLYVINYL CHLORIDE

RLCS

RUBBER LINED CARBON STEEL

SCH

SCHEDULE

SDR

STANDARD DIMENSION RATIO

LINE SYMBOLOGY

—

MAIN PROCESS LINE

—

SECONDARY PROCESS LINE

—

PROCESS LINE, BY OTHERS

—

COMM LINK (EX. PLC TO HMI)

—

COMM LINK (EX. PLC TO DCS)

—

ELECTRIC WIRING

—

PNEUMATIC LINE

—

LINE JUMPER

—

PIPE DISCONTINUATION

—

FLOW DIRECTION ARROWS

4" 316 SS SCH.10

LINES SIZE/ MATERIAL IDENTIFIER

SKID BOUNDARY

NOT BY H₂O Innovation

SKID BY H₂O Innovation

REVISION

LINES TO/FROM OTHER SHEETS DESCRIPTION

C01-0001 SHT 1

DESTINATION

MISCELLANEOUS EQUIPMENT SYMBOLS

CARTRIDGE FILTER HOUSING

AUTOMATIC STRAINER

SILENCER

MOTORIZED MIXER

STATIC MIXER

RESIN TRAP

MOTOR

EDUCTOR OR VENTURI

Y STRAINER

CONICAL OR TEMPORARY STRAINER

PULSATION DAMPENER

DIAPHRAGM

FLOW ORIFICE

RUPTURE DISK (PRESSURE)

RUPTURE DISK (VACUUM)

SPECTACLE BLIND (NORMALLY OPEN, NORMALLY CLOSED)

COARSE BUBBLE DIFFUSER

FINE BUBBLE DIFFUSER

FILTER

TURBOCHARGER

MANWAY

TANK

IMMERSED HEATER

IN-LINE HEATER

ULTRASONIC LEVEL TRANSMITTER

FLOAT-STYLE LEVEL SWITCH

CHEMICAL CONTAINMENT

CALIBRATION COLUMN

MEMBRANE

UV STERILIZER

AIR COMPRESSOR

POSITIVE DISPLACEMENT BLOWER

REGENERATIVE BLOWER

CENTRIFUGAL BLOWER

REFRIGERATED AIR DRYER

FLOW CHAMBER

BIO-WHEEL

FLOW INSTRUMENTS

FAH

FLOW ALARM HIGH

FAL

FLOW ALARM LOW

FCV

FLOW CONTROL VALVE

FE

FLOW ELEMENT

FI

FLOW INDICATOR

FIC

FLOW INDICATING CONTROLLER

FIT

FLOW INDICATING TRANSMITTER

FR

FLOW RECORDING

FSH

FLOW SWITCH HIGH

FSL

FLOW SWITCH LOW

FV

FLOW CONTROL OR ON/OFF VALVE

FQ

FLOW TOTALIZER

FY

FLOW SIGNAL CONVERT, I/P, OR SOLN

PRESSURE INSTRUMENTS

PAH

PRESSURE ALARM HIGH

PAL

PRESSURE ALARM LOW

PC

PRESSURE CONTROLLER

PCV

SELF REG PRESS CONTROL VALVE

PDH

DIFFERENTIAL PRESSURE HIGH

PDI

DIFFERENTIAL PRESSURE INDICATOR

PDIT

DIFF PRESS INDICATING TRANSMITTER

PDH

DIFFERENTIAL PRESS SWITCH HIGH

PG

PRESSURE GAUGE

PI

PRESSURE INDICATOR

PIC

PRESSURE INDICATING CONTROLLER

PIT

PRESSURE INDICATING TRANSMITTER

PSH

PRESSURE SWITCH HIGH

PSL

PRESSURE SWITCH LOW

PSV

SELF REG PRESS SAFETY VALVE

PT

PRESSURE TRANSMITTER

PY

PRESS SIGNAL CONVERT, I/P, OR SOLN

PSLH

PRESSURE SWITCH LOW HIGH

LEVEL INSTRUMENTS

LAH

LEVEL ALARM HIGH

LAL

LEVEL ALARM LOW

LCV

SELF REG LEVEL CONTROL VALVE

LE

LEVEL ELEMENT

LG

LEVEL GAUGE

LI

LEVEL INDICATOR

LIC

LEVEL INDICATING CONTROLLER

LIT

LEVEL INDICATING TRANSMITTER

LSH

LEVEL SWITCH HIGH

LSL

LEVEL SWITCH LOW

LT

LEVEL TRANSMITTER

LV

LEVEL CONTROL OR ON/OFF VALVE

LY

LEVEL SIGNAL CONVERT, I/P, OR SOLN

TEMPERATURE INSTRUMENTS

TAH

TEMPERATURE ALARM HIGH

TAL

TEMPERATURE ALARM LOW

TC

TEMPERATURE CONTROLLER

TE

TEMPERATURE ELEMENT

TG

TEMPERATURE GAUGE

TI

TEMPERATURE INDICATOR

TIC

TEMP INDICATING CONTROLLER

TIT

TEMP INDICATING TRANSMITTER

TSH

TEMPERATURE SWITCH HIGH

TSL

TEMPERATURE SWITCH LOW

TT

TEMPERATURE TRANSMITTER

TV

TEMP CONTROL OR ON/OFF VALVE

TY

TEMP SIGNAL CONVERT, I/P, OR SOLN

ELECTRICAL ABBREVIATIONS

JB

JUNCTION BOX

MCP

MAIN CONTROL PANEL

RIO

REMOTE I/O PANEL

PP

POWER PANEL

VFD

VARIABLE FREQUENCY DRIVE

HOA

HAND-OFF-AUTO

ANALYTICAL INSTRUMENTS

AAH

ANALYTICAL ALARM HIGH

AAL

ANALYTICAL ALARM LOW

AE

ANALYTICAL ELEMENT

AI

ANALYTICAL INDICATOR

AIC

ANAL INDICATING CONTROLLER

AIT

ANAL INDICATING TRANSMITTER

ASH

ANALYTICAL SWITCH HIGH

ASL

ANALYTICAL SWITCH LOW

AT

ANALYTICAL TRANSMITTER

AY

ANALYTICAL SIGNAL CONVERT, I/P, OR SOL

MISCELLANEOUS INSTRUMENTS

HS

HAND SWITCH

HI

HAND SWITCH POSITION INDICATOR

II

CURRENT INDICATOR

QOI

TOTALIZER INDICATOR

SC

SPEED CONTROLLER

SI

SPEED INDICATOR

YA

MOTOR ALARM

YC

MOTOR CONTROL

YI

MOTOR ON/OFF INDICATOR

ZI

POSITION INDICATOR

ZIC

SWITCH CLOSE INDICATOR

ZIO

SWITCH OPEN INDICATOR

ZSC

POSITION SWITCH CLOSED

ZSO

POSITION SWITCH OPEN

ZT

POSITION TRANSMITTER

ZY

POSITIONER

VALVES & EQUIPMENT

AC

AIR COMPRESSOR

ARV

AIR RELEASE VALVE

AS

AIR SUPPLY

B

BLOWER

BT

BULK TOTE

CBD

COARSE BUBBLE DIFFUSER

CV

CHECK VALVE

ED

EDUCTOR

F

FILTER

FBD

FINE BUBBLE DIFFUSER

FL

FAIL LAST (DEFAULT IF NOT SHOWN)

FC

FAIL CLOSED

FO

FAIL OPEN

FQG

CALIBRATION COLUMN

H

HEATER

HCV

HAND CONTROL VALVE

HTR

HEATER

M

MOTOR

MX

MIXER

P

PUMP

RT

RESIN TRAP

ST

SPILL TRANK

STR

STRAINER

UV

ULTRAVIOLET

UV

MULTI-FUNCTION VALVE

VAL

VALVE

VAL

CAPACITANCE

CIP

CLEAN-IN-PLACE

COND

CONDUCTIVITY

DO₂

DISSOLVED OXYGEN

ESP

EMERGENCY STOP

IA

INSTRUMENT AIR

I/P

CURRENT TO PNEUMATIC CONVERTER

ORP

OXIDATION REDUCTION POTENTIAL

pH

HYDROGEN ION

RES

RESISTIVITY

RTD

RESISTANCE TEMP DETECTOR

SOL

SOLENOID

SP

SET POINT

uS

MICROSIEMENS

INSTRUMENTATION SYMBOLS

LOCALLY MOUNTED	IN CONTROL PANEL	DESCRIPTION
		DISCRETE INSTRUMENT
		PRIMARY PLC OR DCS SHARED CONTROL
		SECONDARY PLC OR DCS SHARED CONTROL
		COMPUTER FUNCTION

INSTRUMENT FUNCTIONS

K

SIGNAL PROCESSING FUNCTION

A/M

AUTO/MANUAL

Σ

ADDITION/SUMMATION

Δ

DIFFERENTIAL

△

INTERLOCK LOGIC FUNCTION

Σ

AVERAGING

INSTRUMENT CONNECTIONS

—

THREADED

—

SOCKETWELD

—

WELDED

PIPING CONNECTIONS & SYMBOLS

—

FLANGE

—

THREADED CONNECTION

—

UNION

—

BLIND FLANGE

—

CAPPED END

—

REDUCER

—

ECCENTRIC REDUCER

—

DRAIN OUTLET

—

QUICK DISCONNECT HOSE/TUBE

—

EXPANSION/FLEXIBLE/ ISOLATION JOINT

—

GROOVED COUPLING

—

DOUBLE CONTAINMENT

—

INSULATION THICKNESS

—

INSULATION

—

INSULATION THICKNESS

—

HEAT TRACING

—

ELECTRIC

—

GLYCOL

—

S-STEAM

PUMP SYMBOLS

CENTRIFUGAL

CHEMICAL METERING

DIAPHRAGM

POSITIVE DISPLACEMENT

VACUUM

SUBMERSIBLE OR FLOATING

VERTICAL TURBINE

PERISTALTIC/HOSE

NOTE:

THE INFORMATION, SPECIFICATIONS AND DATA SHOWN ON THIS PRINT ARE FURNISHED BY AND ARE TO REMAIN THE PROPERTY OF H₂O INNOVATION.

THE PURPOSE OF THIS DOCUMENT IS TO FACILITATE THE INSTALLATION, MAINTENANCE AND OPERATION OF THE EQUIPMENT REPRESENTED BY SAID PRINT. NO OTHER USE OF THIS DOCUMENT SHALL BE MADE WITHOUT EXPRESS WRITTEN CONSENT FROM H₂O INNOVATION.

DRAWING REVISION

REV	DATE	REVISION DESCRIPTION	DRAWN	CHKD	ENG	APPVD
03	09/08/2016	AS BUILT	M.P.	S.B.	R.D.	A.M.
02	25/07/2016	REVISED AS PER COMMENTS	M.P.	S.B.	R.D.	A.M.
01	29/06/2016	AS PER COMMENTS	M.P.	S.B.	R.D.	A.M.
00	13/06/2016	INITIAL RELEASE	M.P.	S.B.	R.D.	A.M.

h₂O

INNOVATION

knowledge to share, du savoir & partager

UNLESS NOTED OTHERWISE

INTERPRETATION

ANSI Y14.5

TOLERANCES

FRACTIONS

DECIMALS

ANGLES

HOLE SIZES

HOLE CENTERS

DO NOT SCALE PRINTS

MELIADINE

WTP CONTAINERIZED UNIT

TITLE:

PROCESS AND INSTRUMENTATION DIAGRAMS LEGEND

SCALE:

N/A

DRAWING NUMBER:

P65873-C01-0001

REVISION

03

SHEET:


1 of 1

4

3

2

1

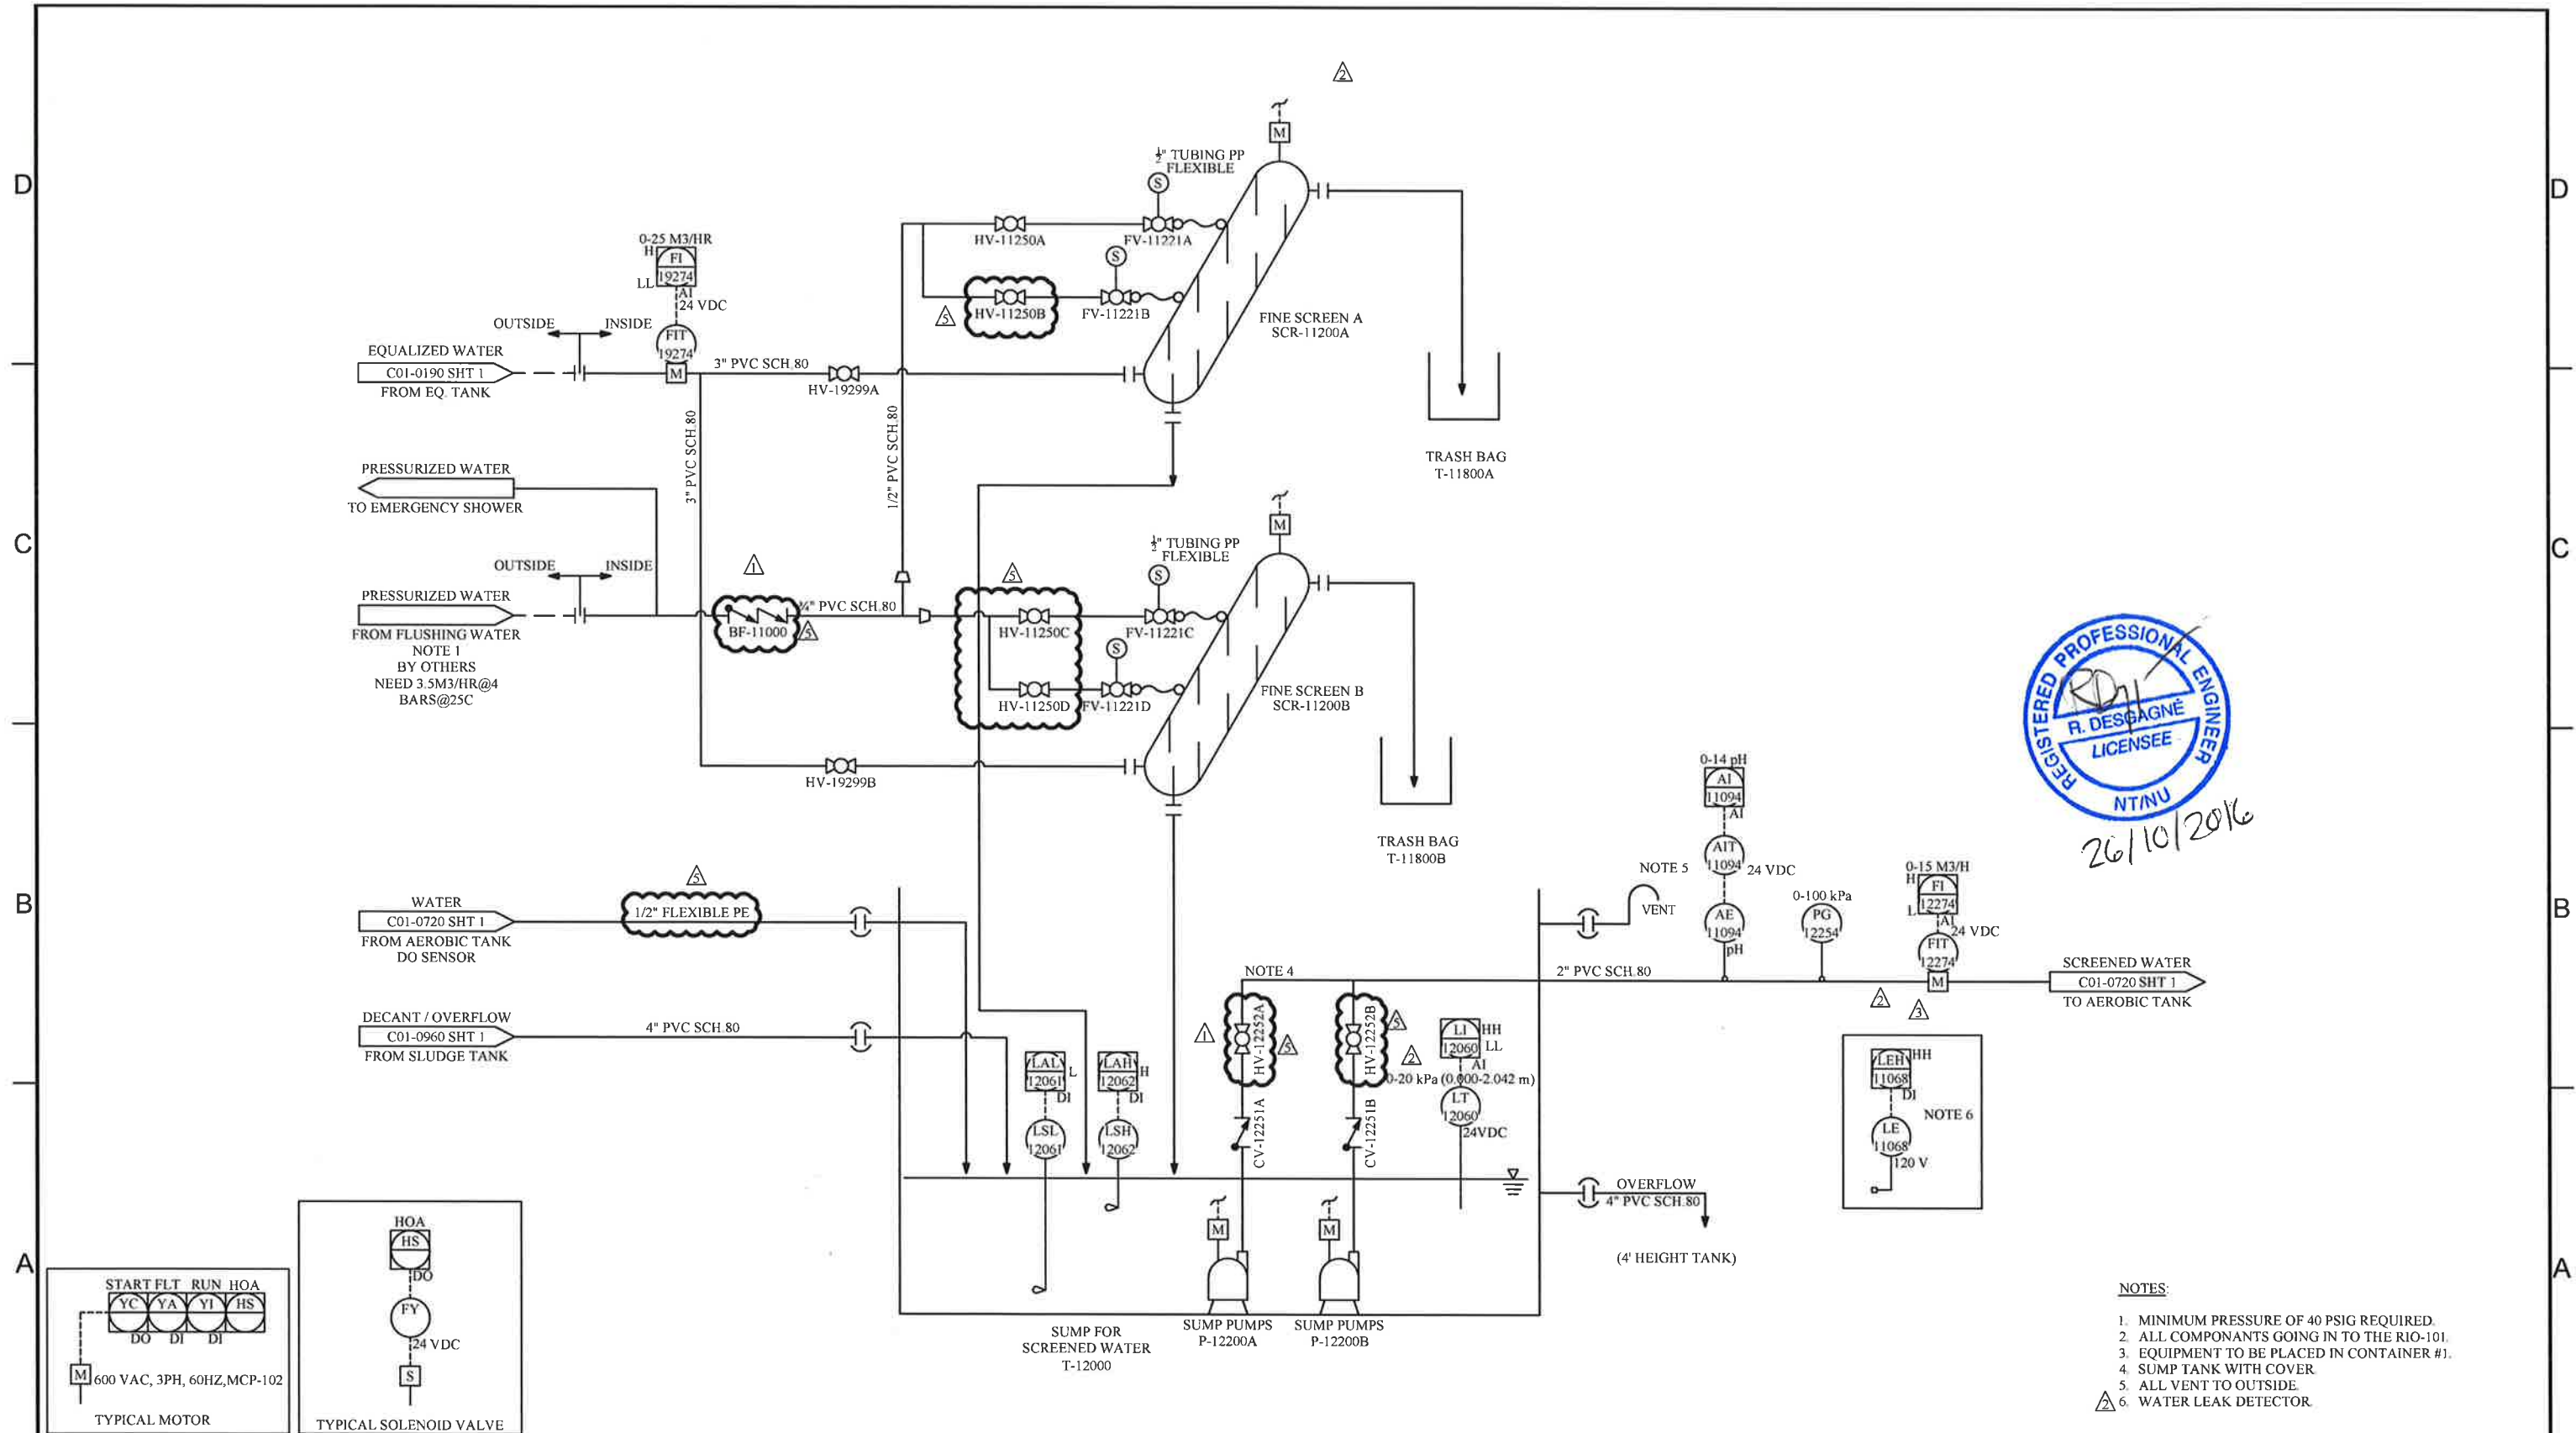

NOTE:
THE INFORMATION, SPECIFICATIONS AND DATA SHOWN ON THIS PRINT ARE FURNISHED BY AND ARE TO REMAIN THE PROPERTY OF H₂O INNOVATION.

THE PURPOSE OF THIS DOCUMENT IS TO FACILITATE THE INSTALLATION, MAINTENANCE AND OPERATION OF THE EQUIPMENT REPRESENTED BY SAID PRINT. NO OTHER USE OF THIS DOCUMENT SHALL BE MADE WITHOUT EXPRESS WRITTEN CONSENT FROM H₂O INNOVATION.

DRAWING REVISION			
REV	DATE	REVISION DESCRIPTION	
05	21/09/2016	REVISED AS BUILT	
04	08/02/2016	REVISED AS PER COMMENT	
03	25/07/2016	REVISED AS PER COMMENT	
02	13/07/2016	REVISED AS PER COMMENT	
01	11/07/2016	CHANGE SUMP TANK BALL TO GATE VALVE, SOLENOID TO ELECTRIC VALVE, TURBIDITY METER TO 120V	



UNLESS NOTED OTHERWISE
INTERPRETATION AND 1/4" 5


TOLERANCES
FRACTIONS
DECIMALS
ANGLES
HOLE SIZES
HOLE CENTERS


DO NOT SCALE PRINTS

MELIADINE STP

216 M3/DAY

TITLE: RAW WATER SCREENING PROCESS & INSTRUMENTATION DIAGRAM		
SCALE: N/A	DRAWING NUMBER: U65875-C01-0110	REVISION 05
SHEET: 1 of 1		

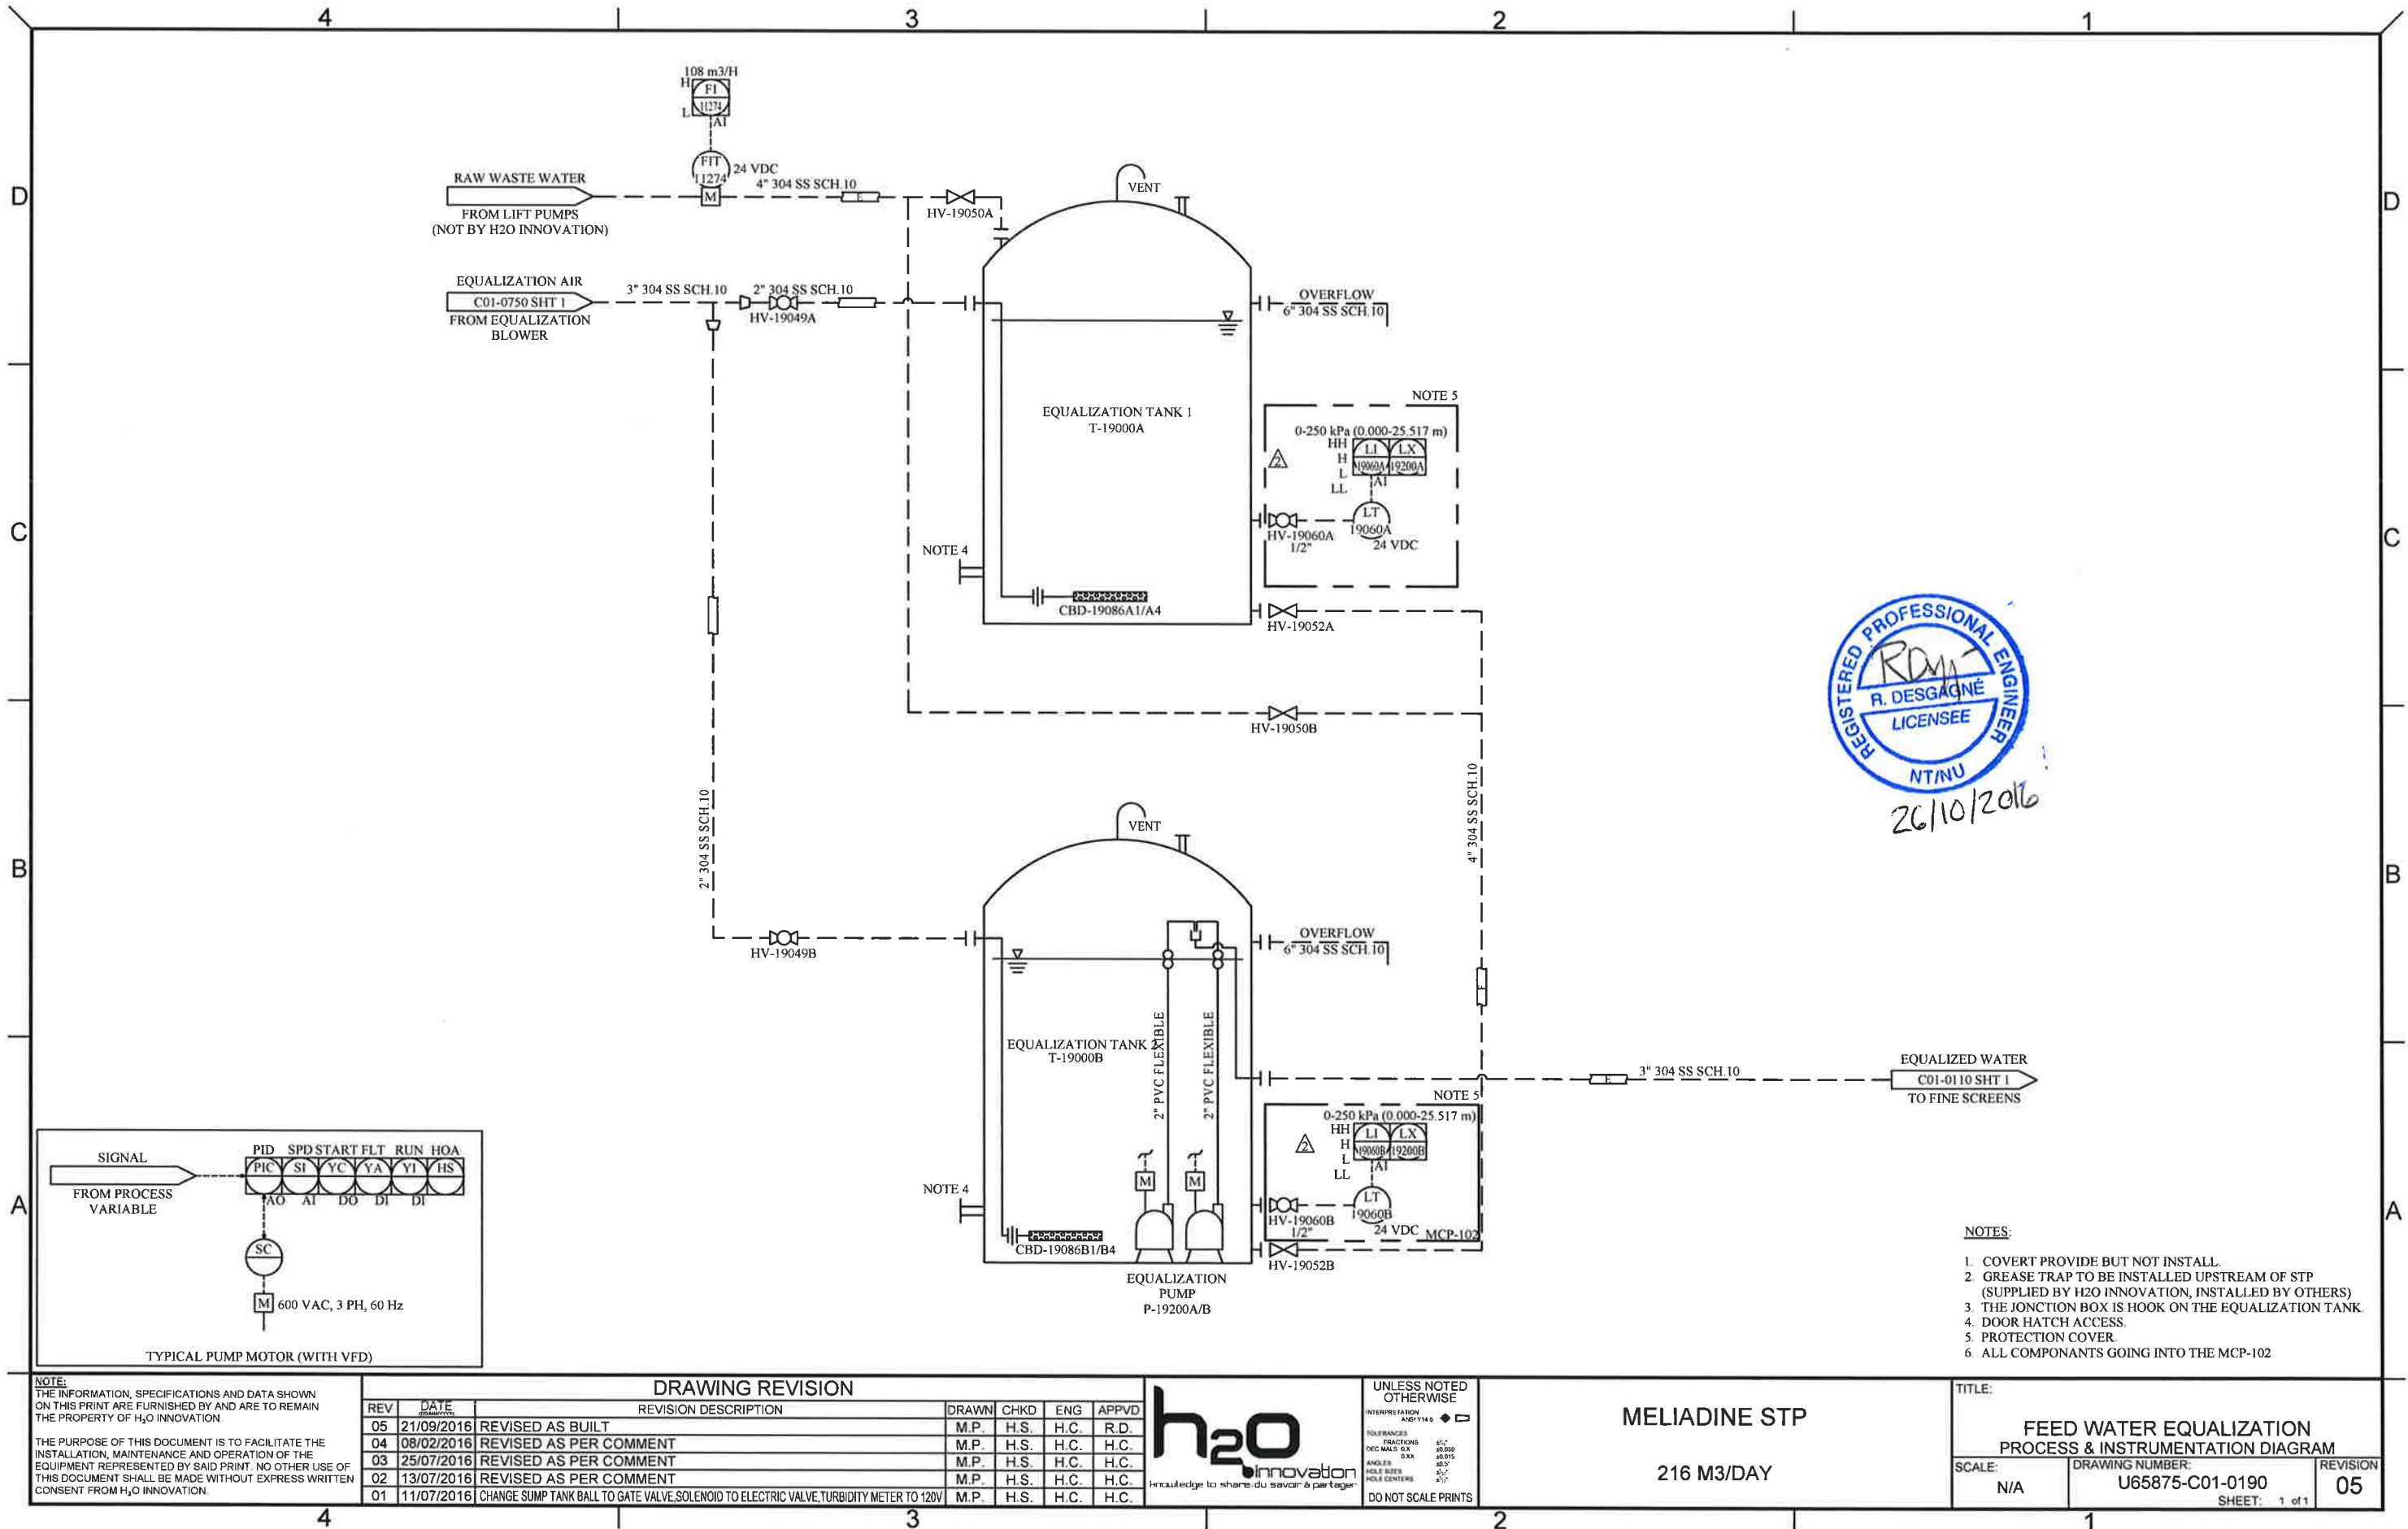

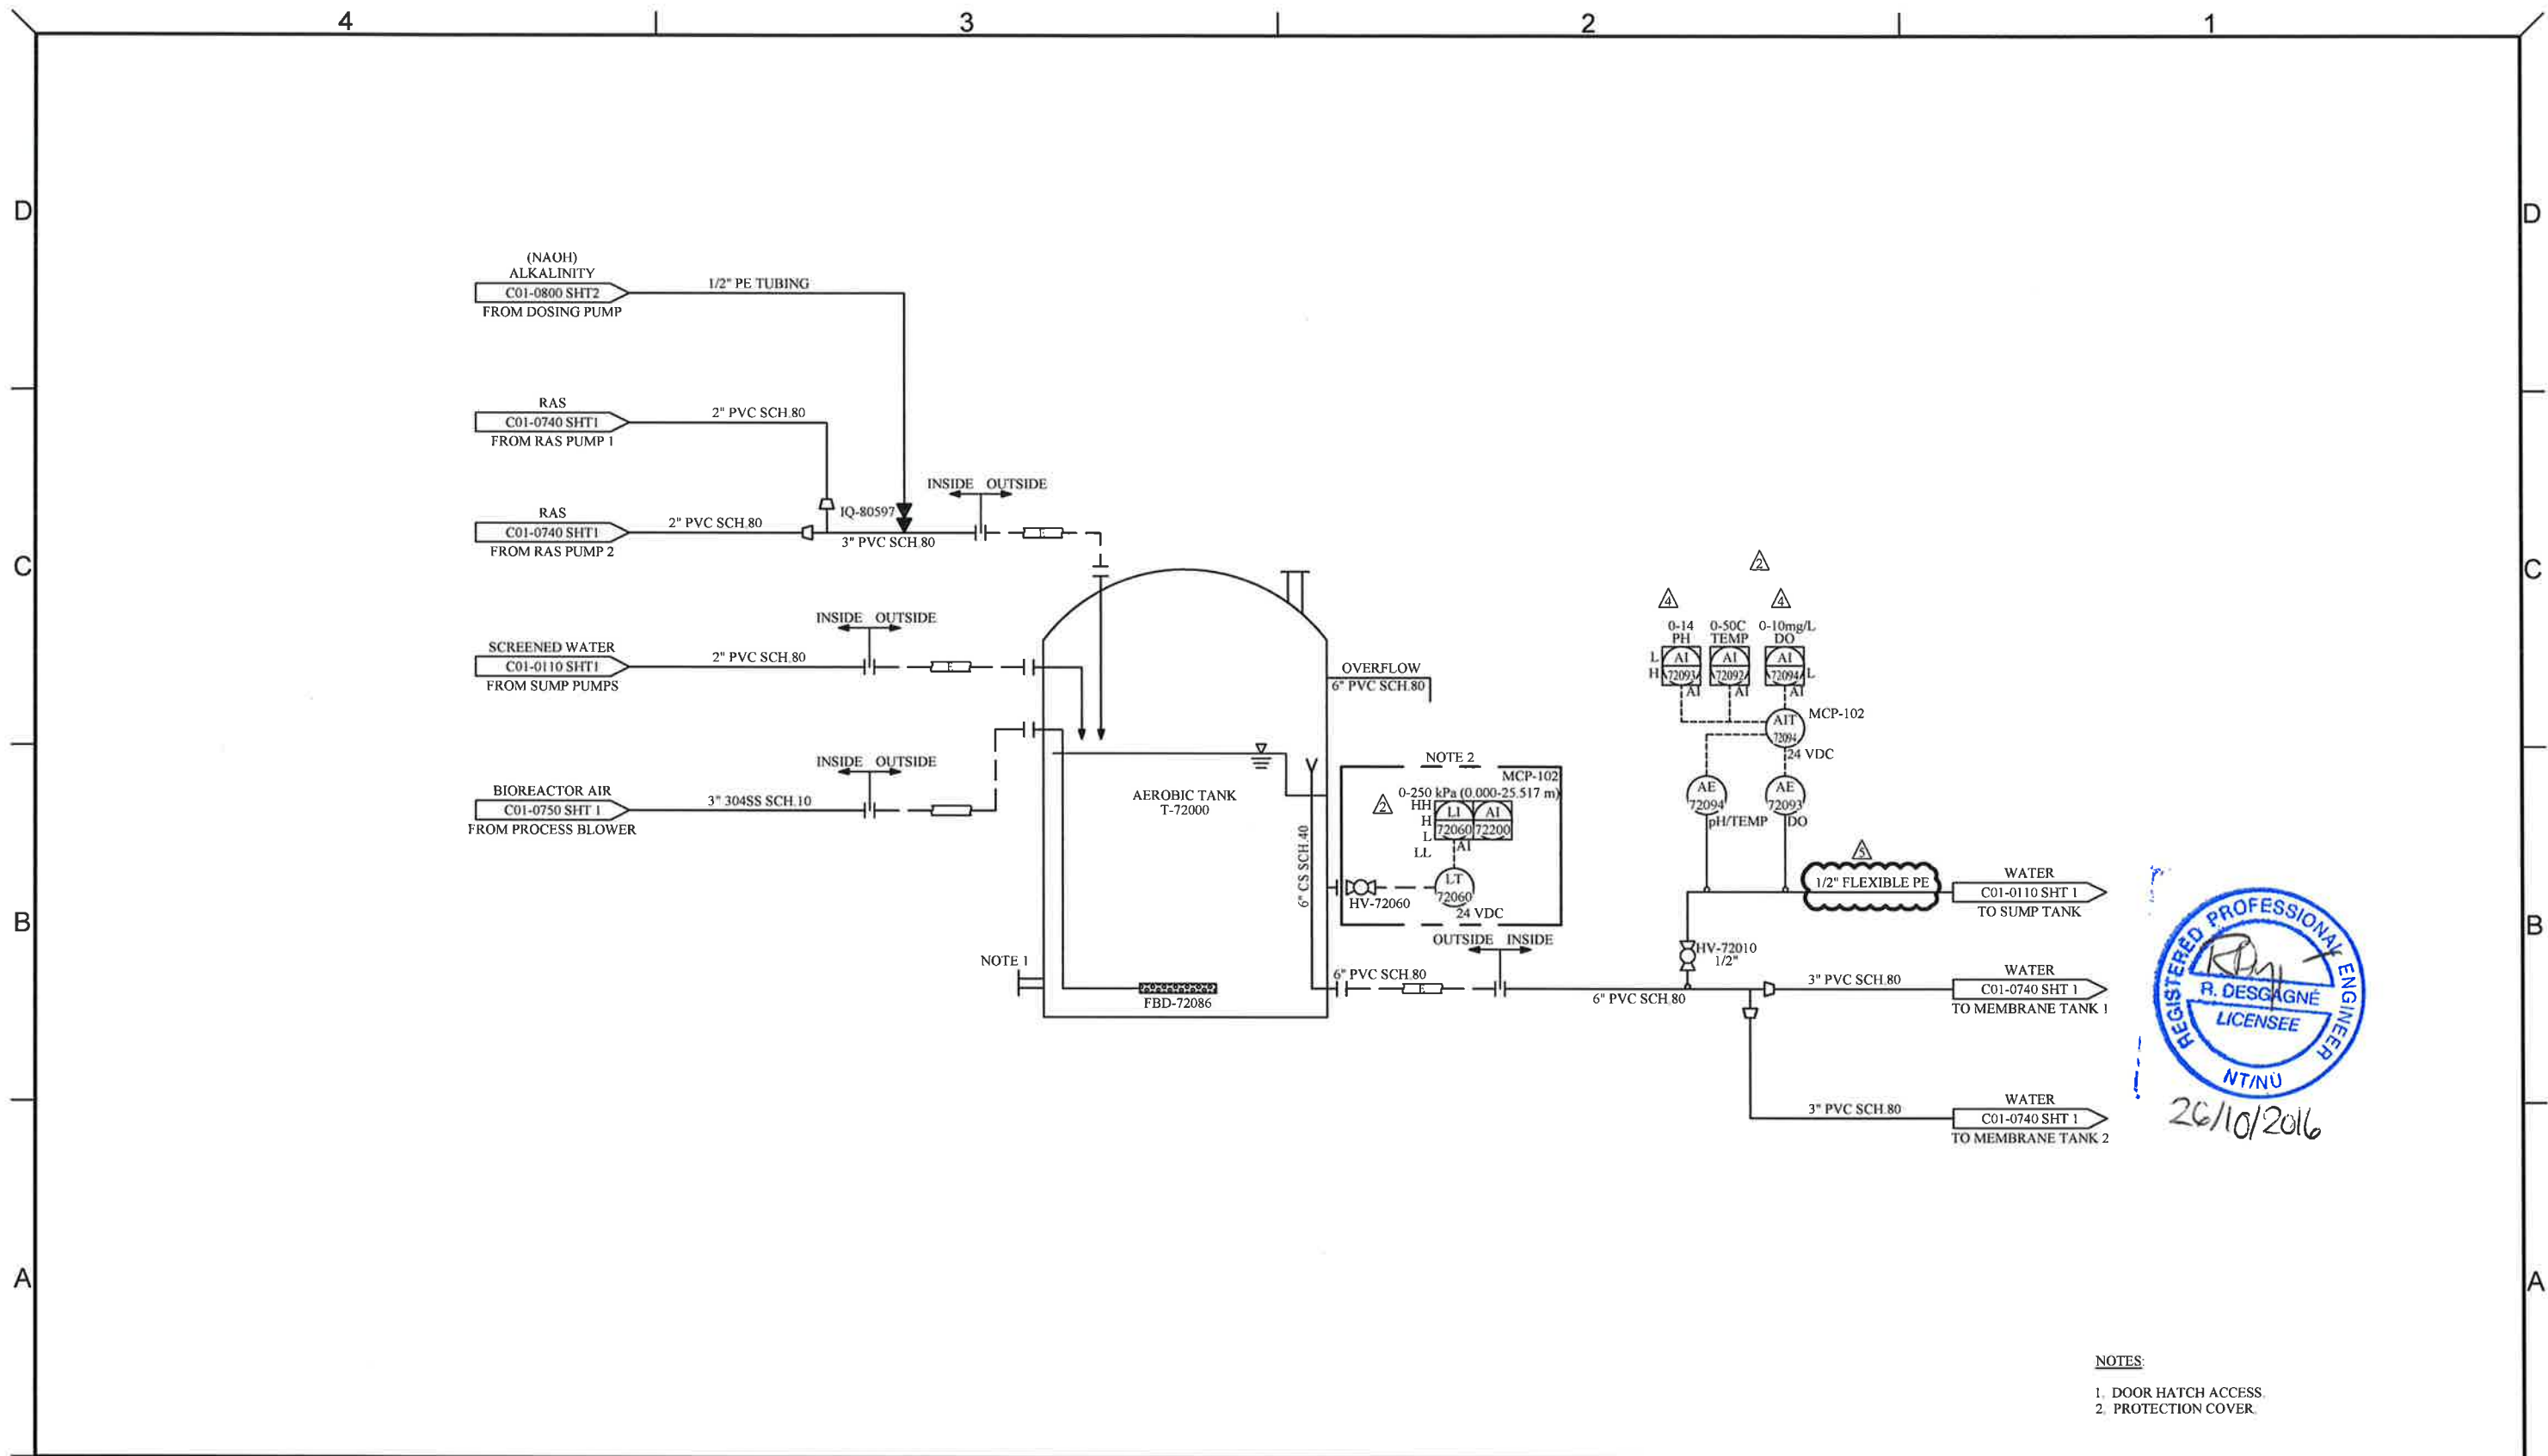

- NOTES:
1. DOOR HATCH ACCESS.
 2. PROTECTION COVER.

NOTE:
THE INFORMATION, SPECIFICATIONS AND DATA SHOWN ON THIS PRINT ARE FURNISHED BY AND ARE TO REMAIN THE PROPERTY OF H₂O INNOVATION.

THE PURPOSE OF THIS DOCUMENT IS TO FACILITATE THE INSTALLATION, MAINTENANCE AND OPERATION OF THE EQUIPMENT REPRESENTED BY SAID PRINT. NO OTHER USE OF THIS DOCUMENT SHALL BE MADE WITHOUT EXPRESS WRITTEN CONSENT FROM H₂O INNOVATION.

DRAWING REVISION					
REV	DATE	REVISION DESCRIPTION	DRAWN	CHKD	ENG
05	21/09/2016	REVISED AS BUILT	M.P.	H.S.	H.C.
04	08/02/2016	REVISED AS PER COMMENT	M.P.	H.S.	H.C.
03	25/07/2016	REVISED AS PER COMMENT	M.P.	H.S.	H.C.
02	13/07/2016	REVISED AS PER COMMENT	M.P.	H.S.	H.C.
01	11/07/2016	CHANGE SUMP TANK BALL TO GATE VALVE, SOLENOID TO ELECTRIC VALVE, TURBIDITY METER TO 120V	M.P.	H.S.	H.C.




UNLESS NOTED OTHERWISE
INTERPRETATION
ANSI Y14.5

TOLERANCES
FRACTIONS
DECIMALS
ANGLES
HOLE SIZES
HOLE CENTERS

DO NOT SCALE PRINTS

MELIADINE STP
216 M3/DAY

TITLE: AEROBIC TANK PROCESS & INSTRUMENTATION DIAGRAM		
SCALE: N/A	DRAWING NUMBER: U65875-C01-0720	REVISION 05
SHEET: 1 of 1		

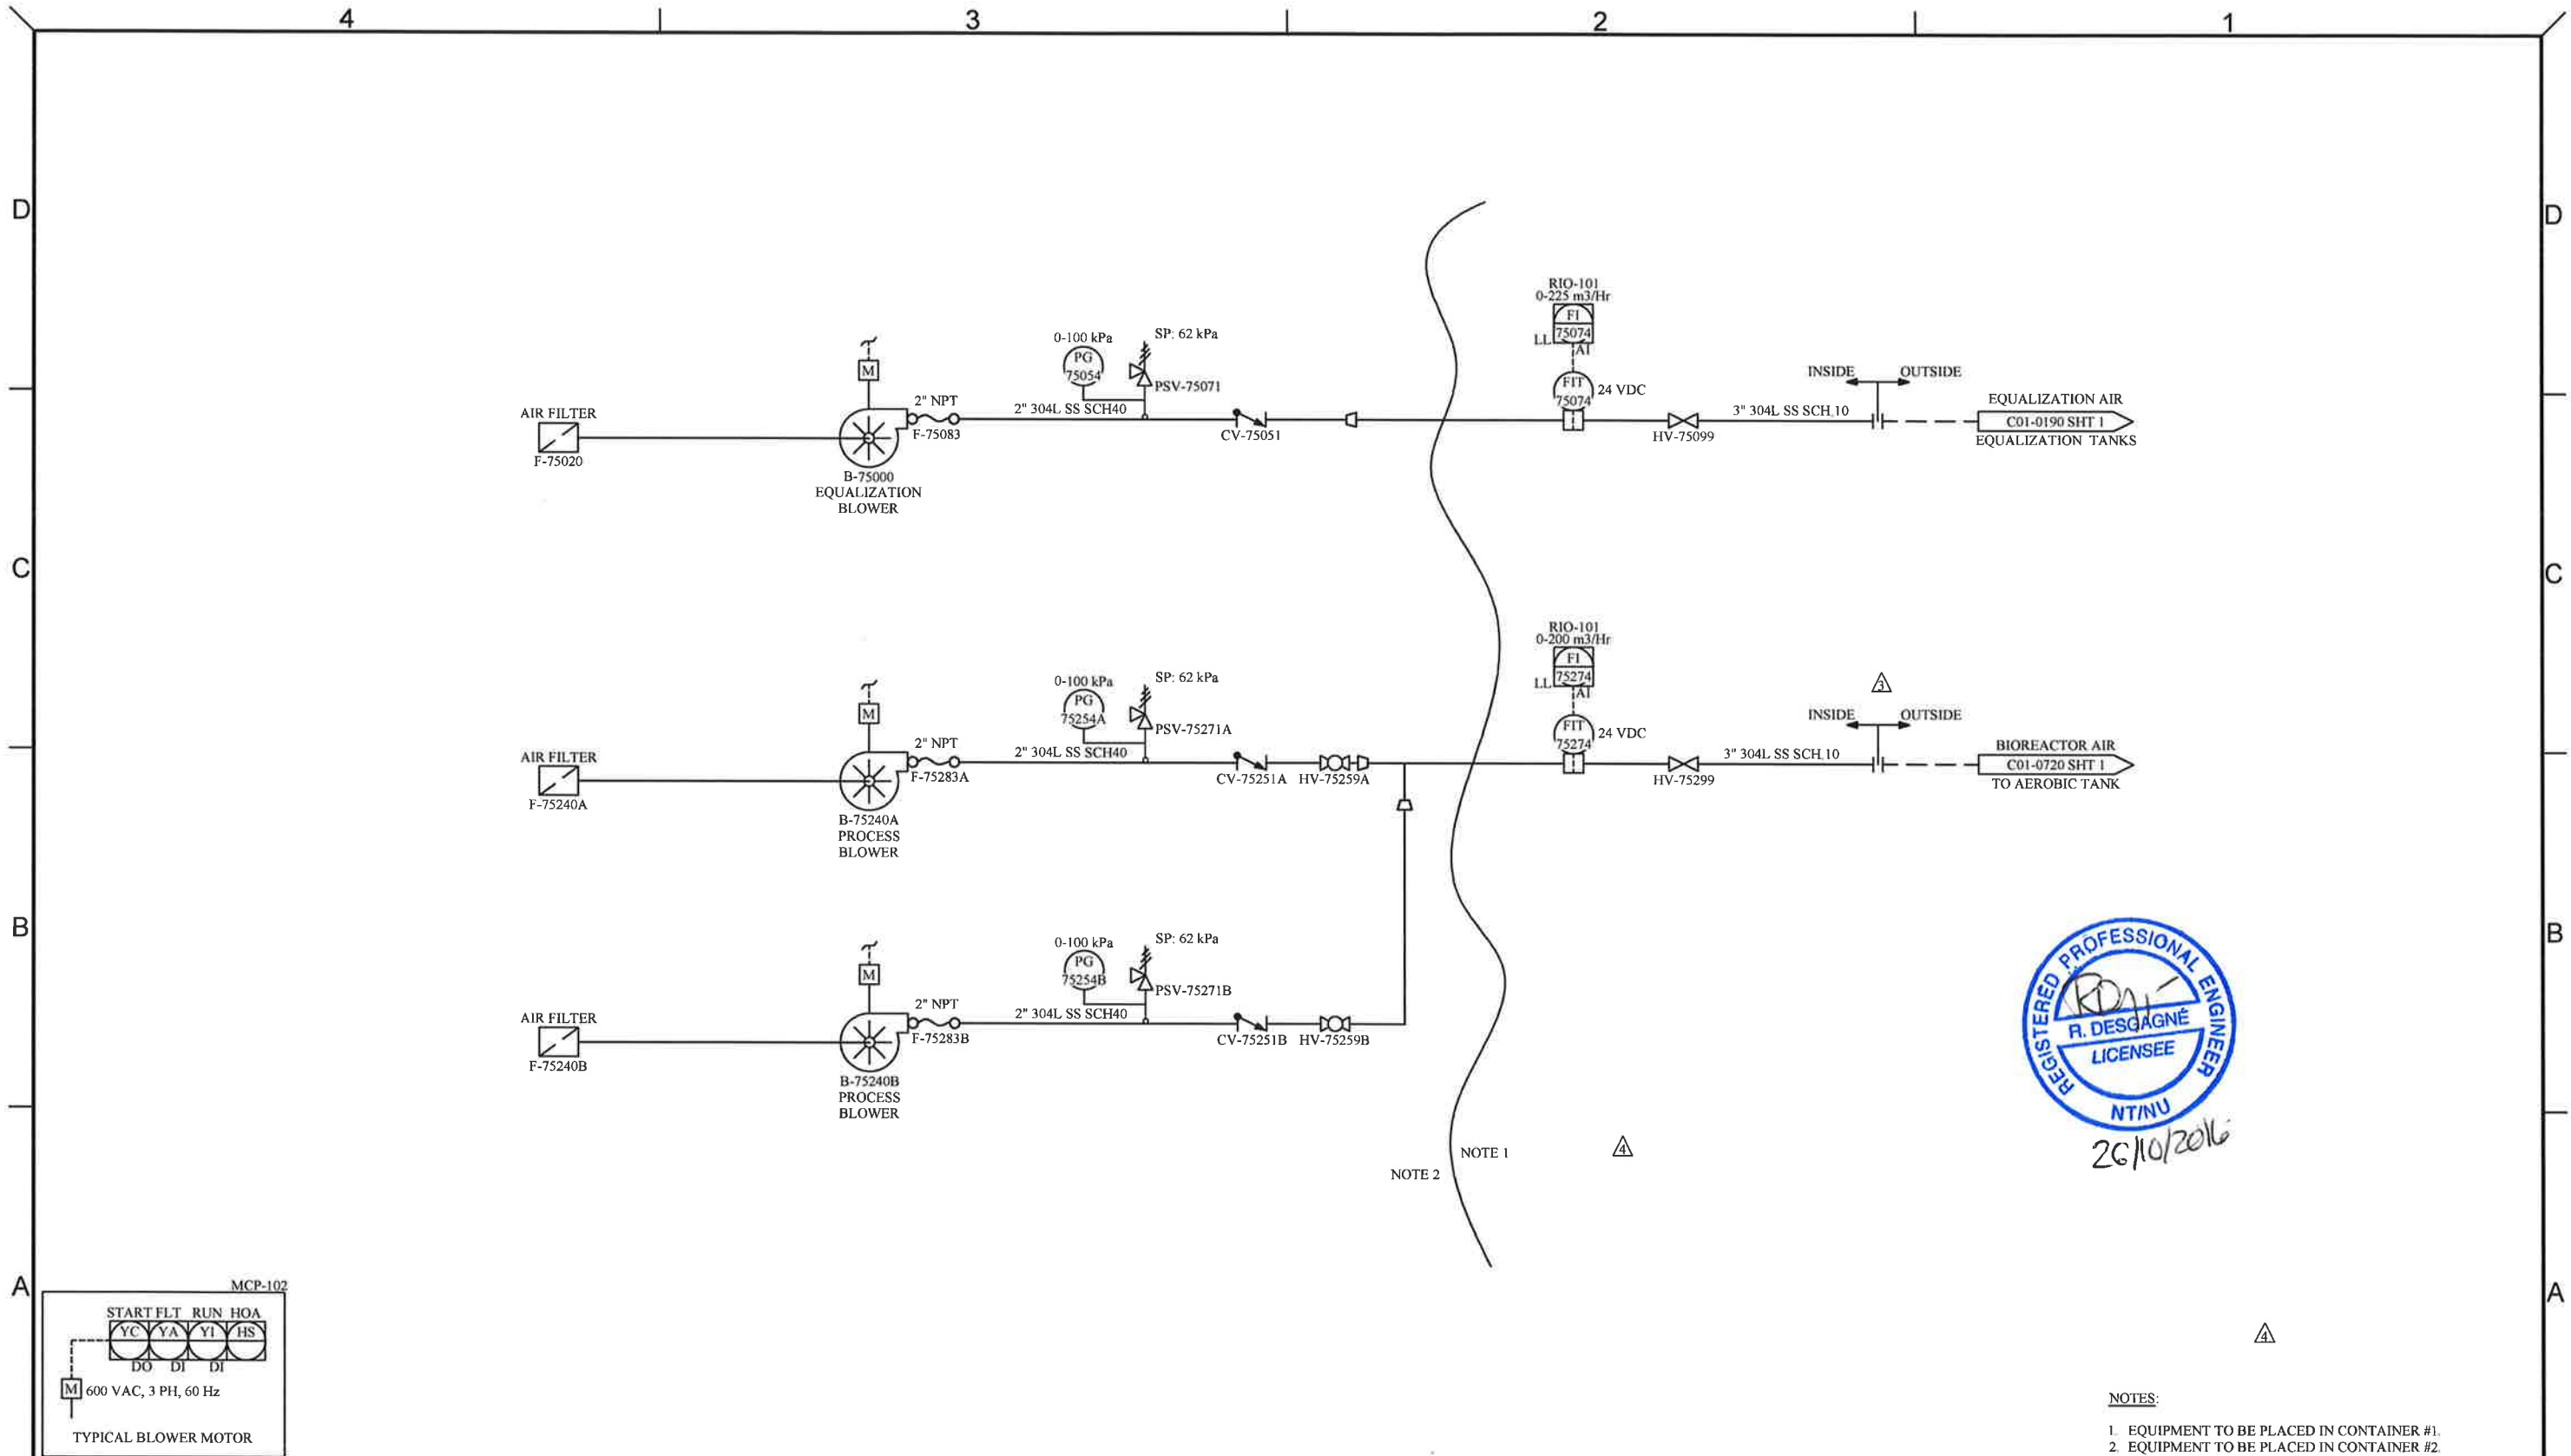

NOTE:
THE INFORMATION, SPECIFICATIONS AND DATA SHOWN ON THIS PRINT ARE FURNISHED BY AND ARE TO REMAIN THE PROPERTY OF H₂O INNOVATION.

THE PURPOSE OF THIS DOCUMENT IS TO FACILITATE THE INSTALLATION, MAINTENANCE AND OPERATION OF THE EQUIPMENT REPRESENTED BY SAID PRINT. NO OTHER USE OF THIS DOCUMENT SHALL BE MADE WITHOUT EXPRESS WRITTEN CONSENT FROM H₂O INNOVATION.


DRAWING REVISION				
REV	DATE	REVISION DESCRIPTION	DRAWN	CHKD
05	21/09/2016	REVISED AS BUILT	M.P.	H.S.
04	08/02/2016	REVISED AS PER COMMENT	M.P.	H.S.
03	25/07/2016	REVISED AS PER COMMENT	M.P.	H.S.
02	13/07/2016	REVISED AS PER COMMENT	M.P.	H.S.
01	11/07/2016	CHANGE SUMP TANK BALL TO GATE VALVE, SOLENOID TO ELECTRIC VALVE, TURBIDITY METER TO 120V	M.P.	H.S.


h₂O
innovation
knowledge to share, du savoir à partager

UNLESS NOTED OTHERWISE
INTERPRETATION
ANALYST 4 S
TOLERANCES
FRACTIONS
DECIMALS
ANGLES
HOLE SIZES
HOLE CENTERS
DO NOT SCALE PRINTS

MELIADINE STP
216 M3/DAY


TITLE:		
BLOWERS FOR MBR SYSTEM PROCESS & INSTRUMENTATION DIAGRAM		
SCALE:	DRAWING NUMBER:	REVISION
N/A	U65875-C01-0750	05
SHEET: 1 of 2		

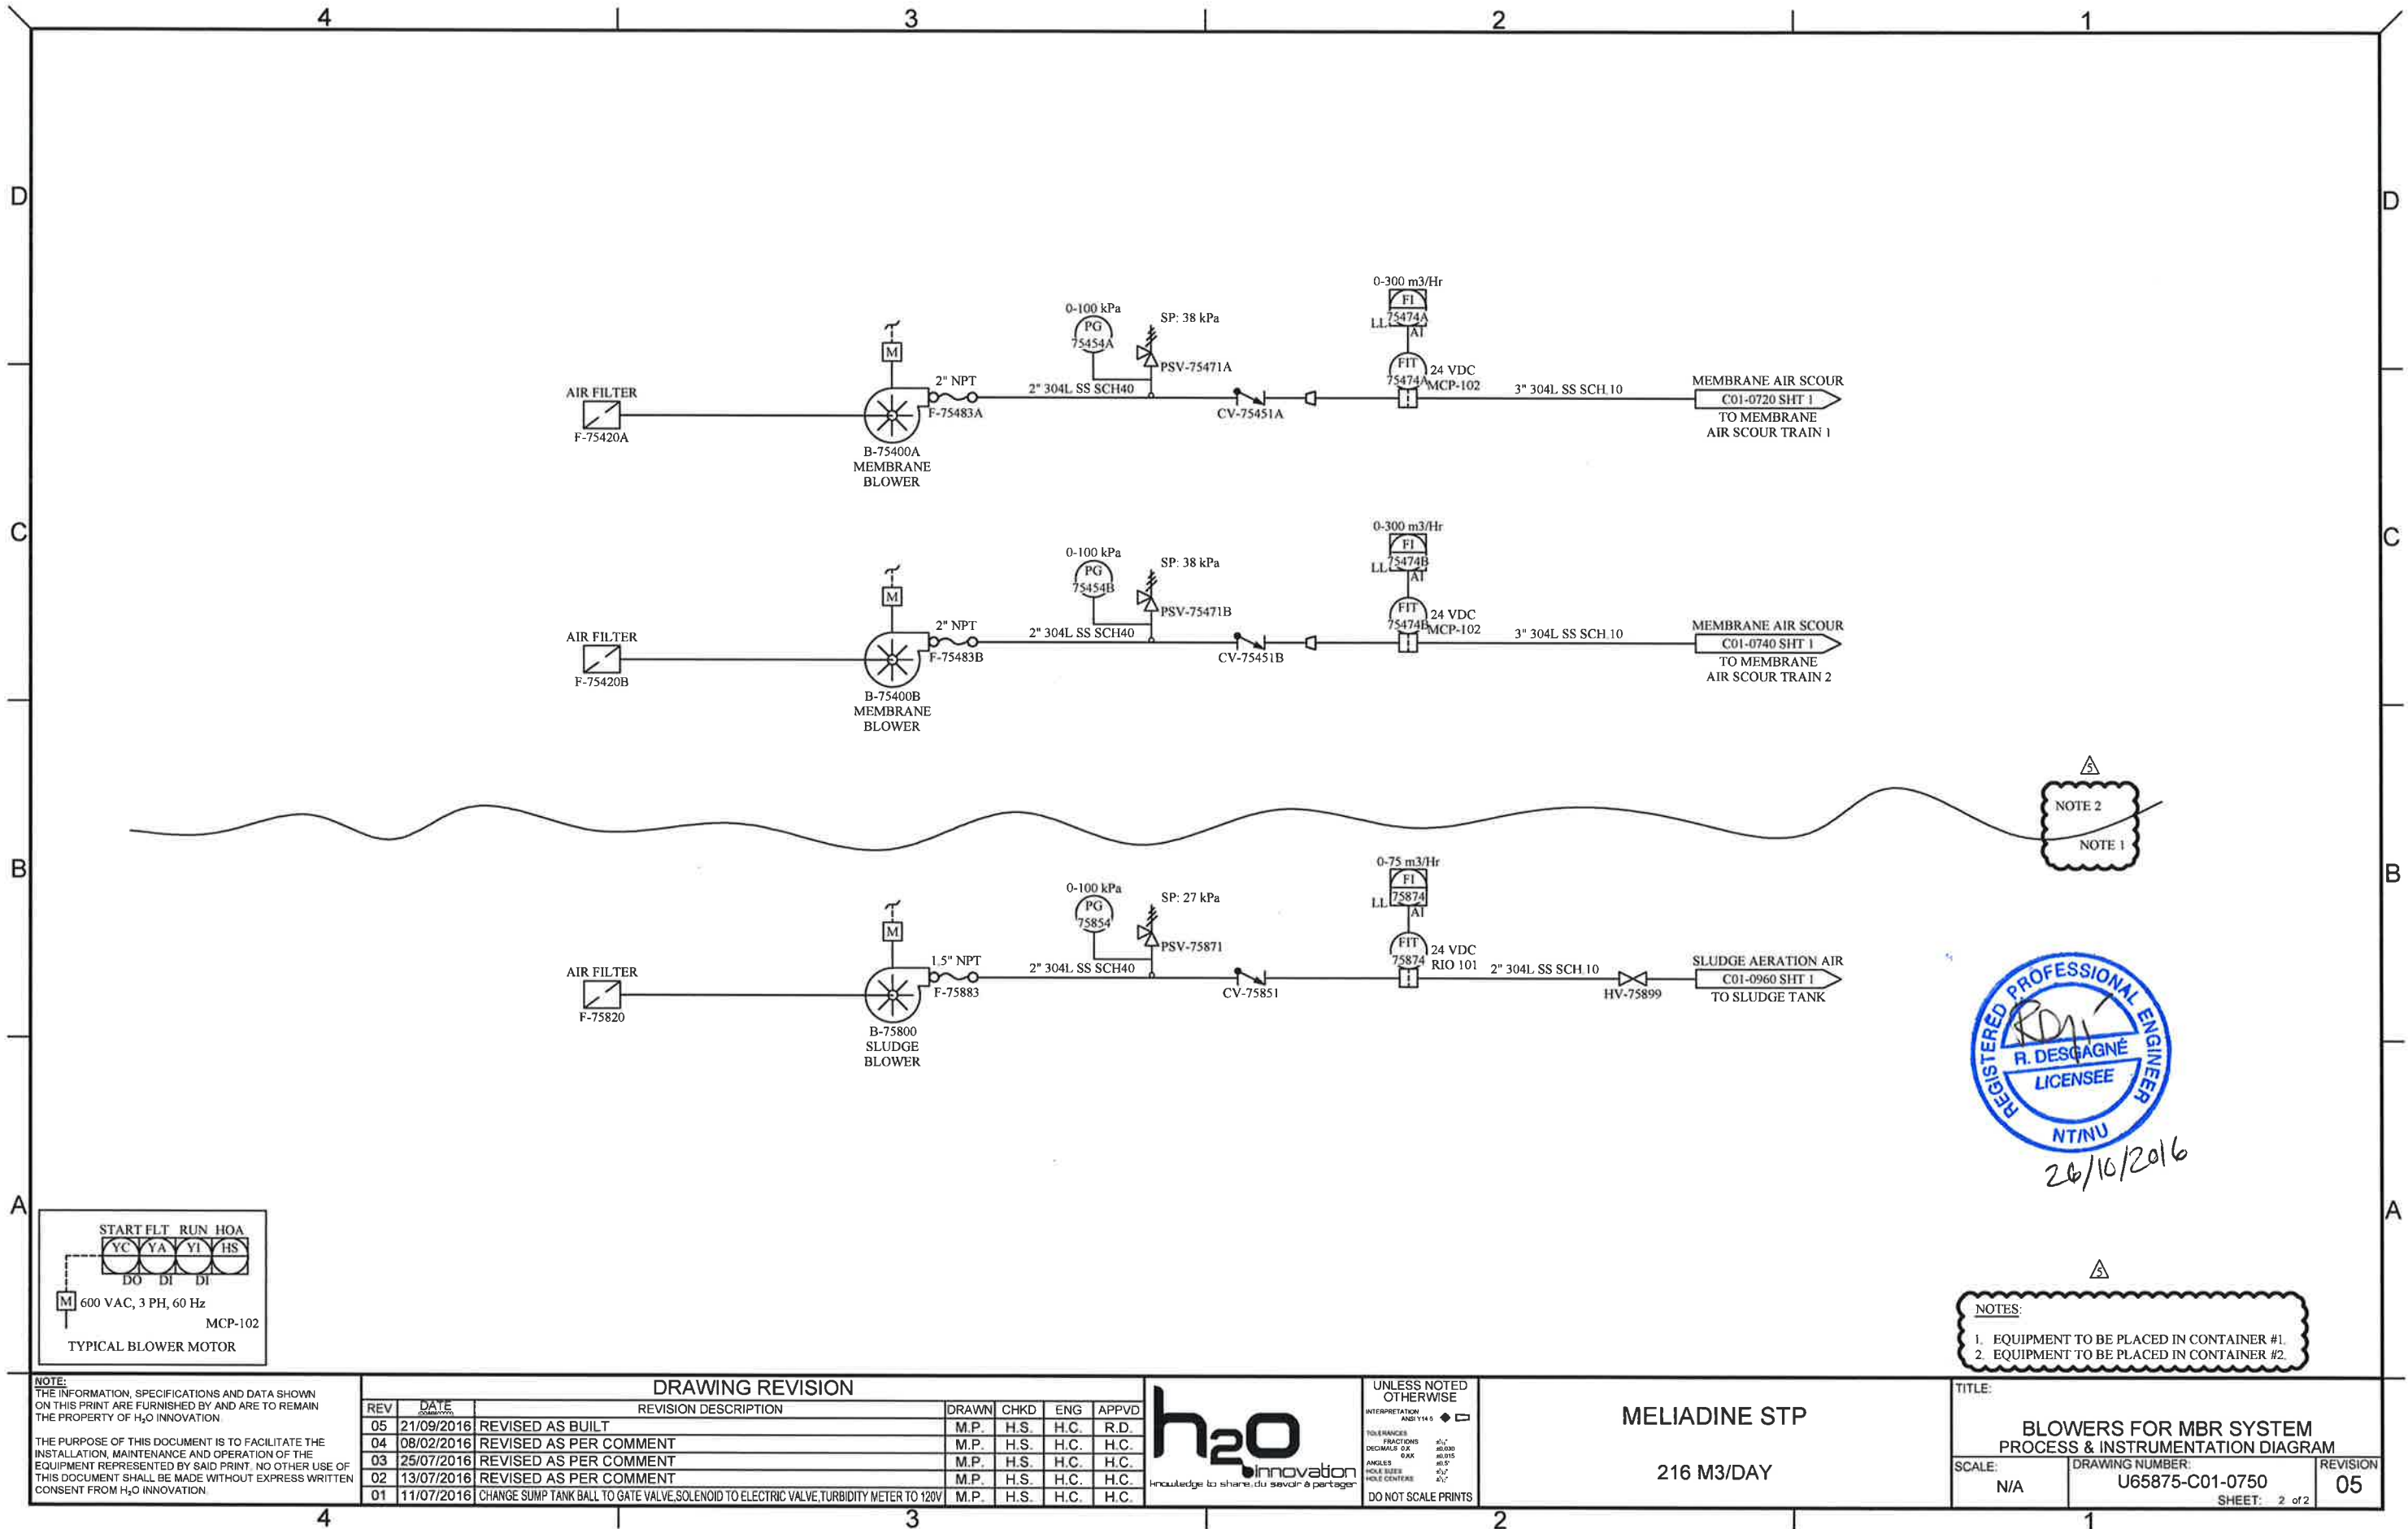

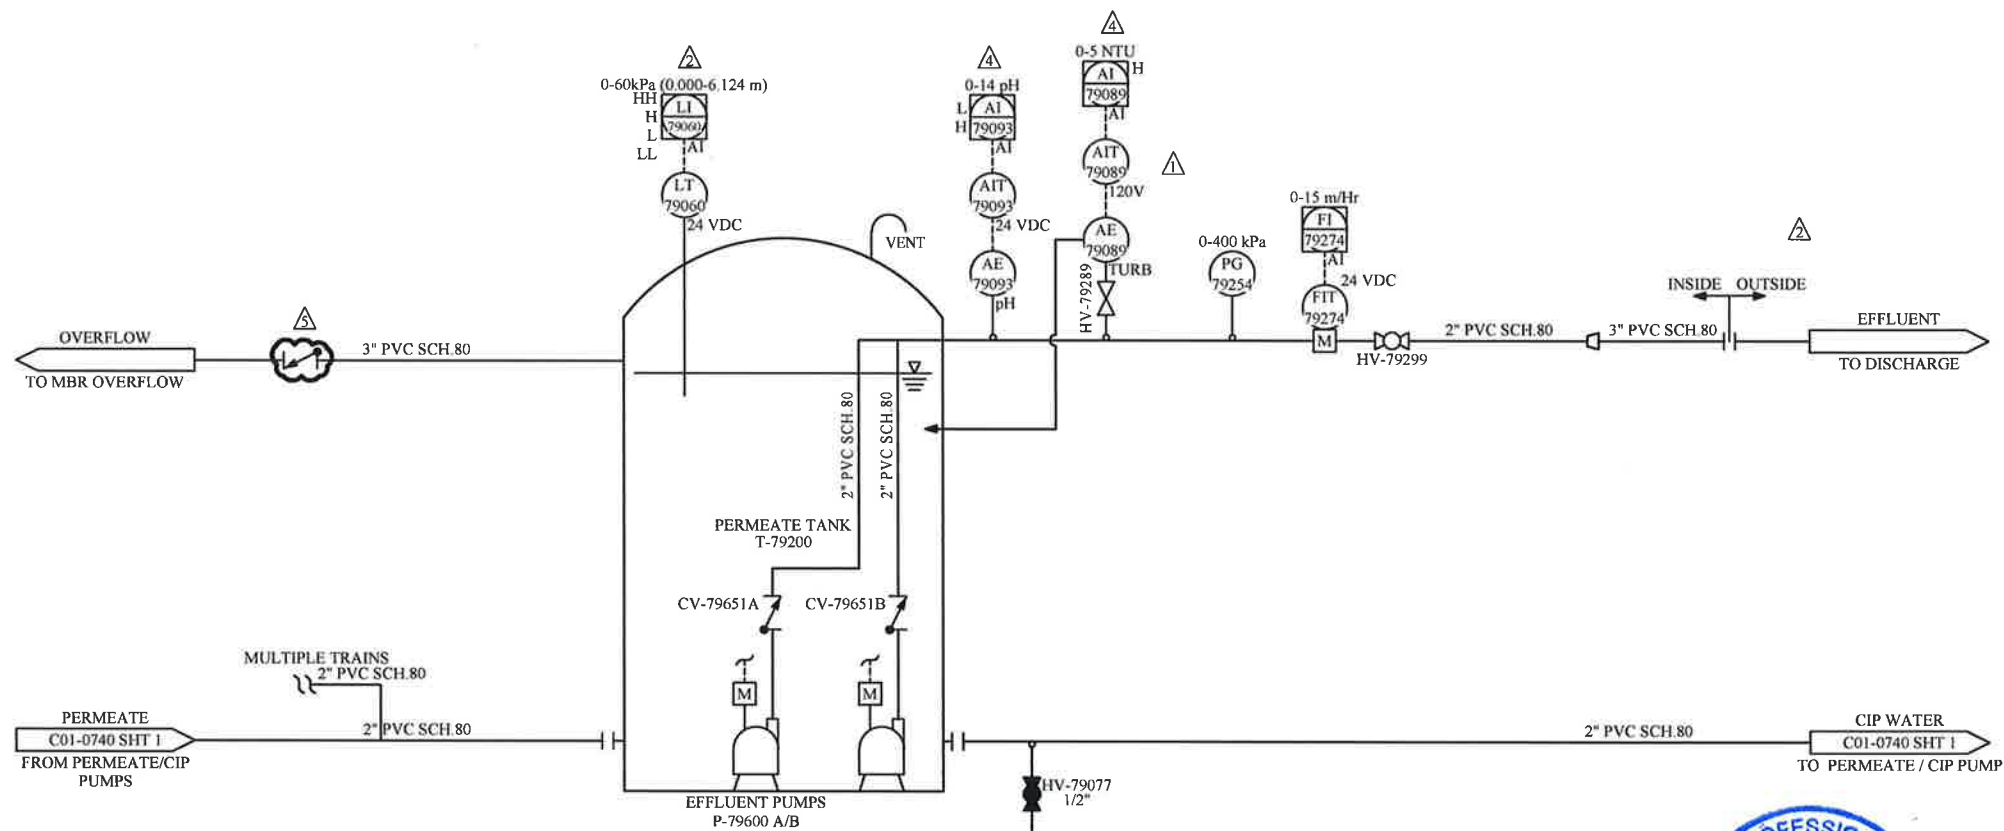

NOTES:

1. ALL COMPONENTS GOING INTO MCP-102.
2. EQUIPMENT TO BE PLACED IN CONTAINER #2.

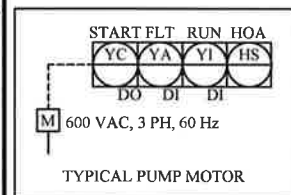

NOTE:
THE INFORMATION, SPECIFICATIONS AND DATA SHOWN ON THIS PRINT ARE FURNISHED BY AND ARE TO REMAIN THE PROPERTY OF H₂O INNOVATION.

THE PURPOSE OF THIS DOCUMENT IS TO FACILITATE THE INSTALLATION, MAINTENANCE AND OPERATION OF THE EQUIPMENT REPRESENTED BY SAID PRINT. NO OTHER USE OF THIS DOCUMENT SHALL BE MADE WITHOUT EXPRESS WRITTEN CONSENT FROM H₂O INNOVATION.




DRAWING REVISION							
REV	DATE	REVISION DESCRIPTION	DRAWN	CHKD	ENG	APPVD	
05	21/09/2016	REVISED AS BUILT	M.P.	H.S.	H.C.	R.D.	
04	08/02/2016	REVISED AS PER COMMENT	M.P.	H.S.	H.C.	H.C.	
03	25/07/2016	REVISED AS PER COMMENT	M.P.	H.S.	H.C.	H.C.	
02	13/07/2016	REVISED AS PER COMMENT	M.P.	H.S.	H.C.	H.C.	
01	11/07/2016	CHANGE SUMP TANK BALL TO GATE VALVE, SOLENOID TO ELECTRIC VALVE, TURBIDITY METER TO 120V	M.P.	H.S.	H.C.	H.C.	



UNLESS NOTED OTHERWISE
INTERPRETATION AND TOLERANCES
FRACTIONS: 1/16, 1/8, 3/16, 1/2, 3/4, 1, 1 1/2, 2, 3, 4, 6, 8, 12, 16, 20, 24, 30, 36, 48, 60, 72, 96, 120, 144, 180, 216, 240, 288, 360, 432, 480, 576, 720, 864, 1080, 1296, 1440, 1728, 2160, 2592, 2880, 3456, 4320, 5184, 5760, 6912, 8640, 10368, 12288, 14745, 17712, 21216, 25824, 30960, 36864, 43776, 52704, 63840, 77184, 93024, 111456, 133776, 161280, 193920, 232704, 281280, 341280, 413760, 499200, 599040, 723840, 876480, 1059840, 1276800, 1542400, 1856640, 2229120, 2726400, 3271680, 3984000, 4790400, 5798400, 6998400, 8496000, 10396800, 12796800, 15596800, 18896800, 22796800, 27796800, 33796800, 40796800, 48796800, 58796800, 70796800, 84796800, 100796800, 119796800, 141796800, 167796800, 197796800, 232796800, 272796800, 317796800, 367796800, 422796800, 482796800, 547796800, 612796800, 682796800, 752796800, 9922796800, 1000000000.

MELIADINE STP
216 M3/DAY

TITLE: PERMEATE TANK PROCESS & INSTRUMENTATION DIAGRAM		
SCALE: N/A	DRAWING NUMBER: U65875-C01-0790	REVISION 05
SHEET: 1 of 1		

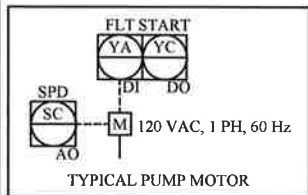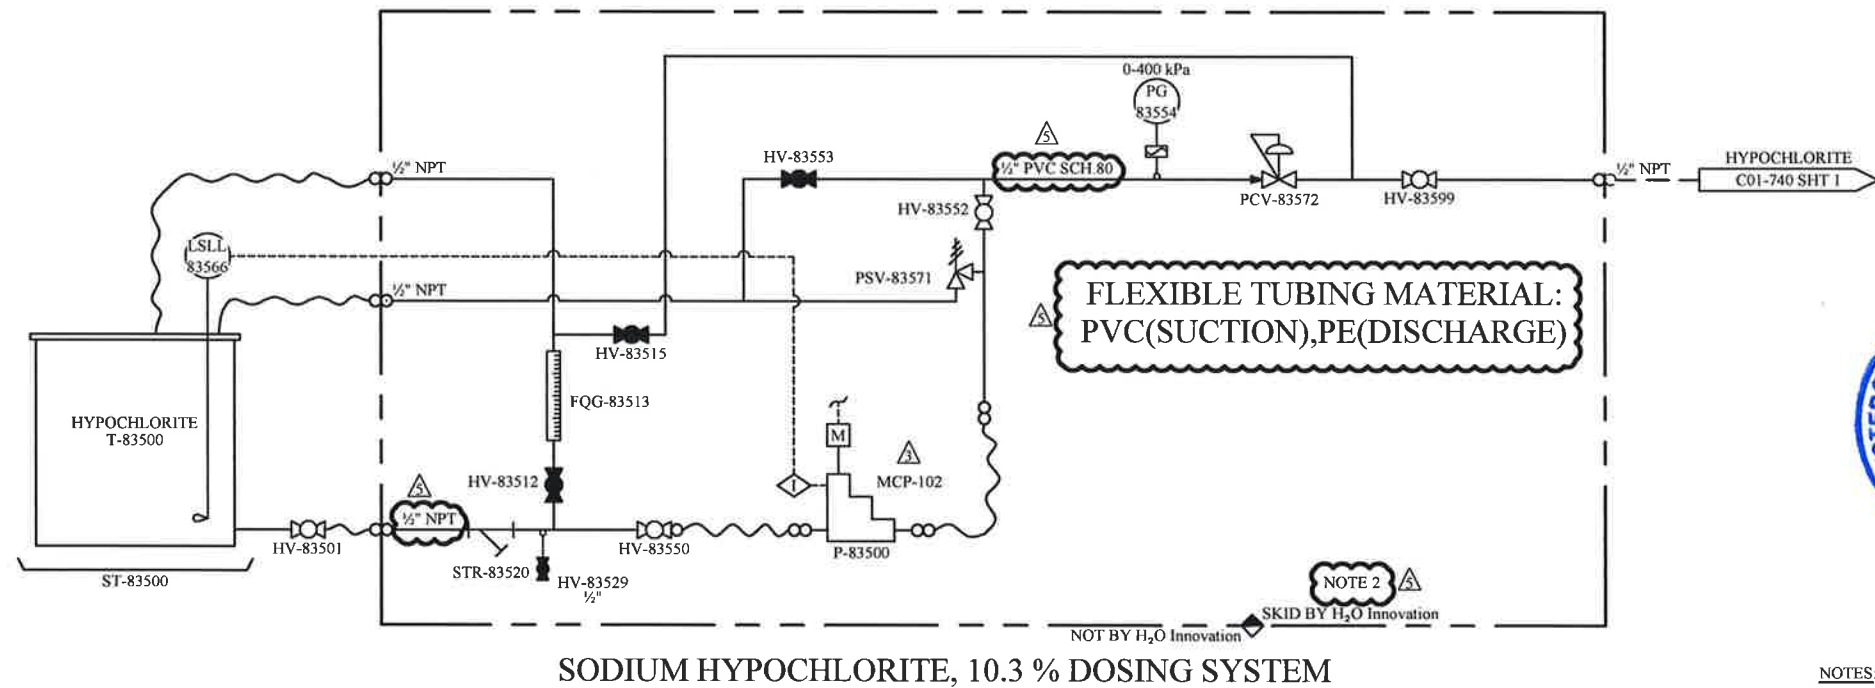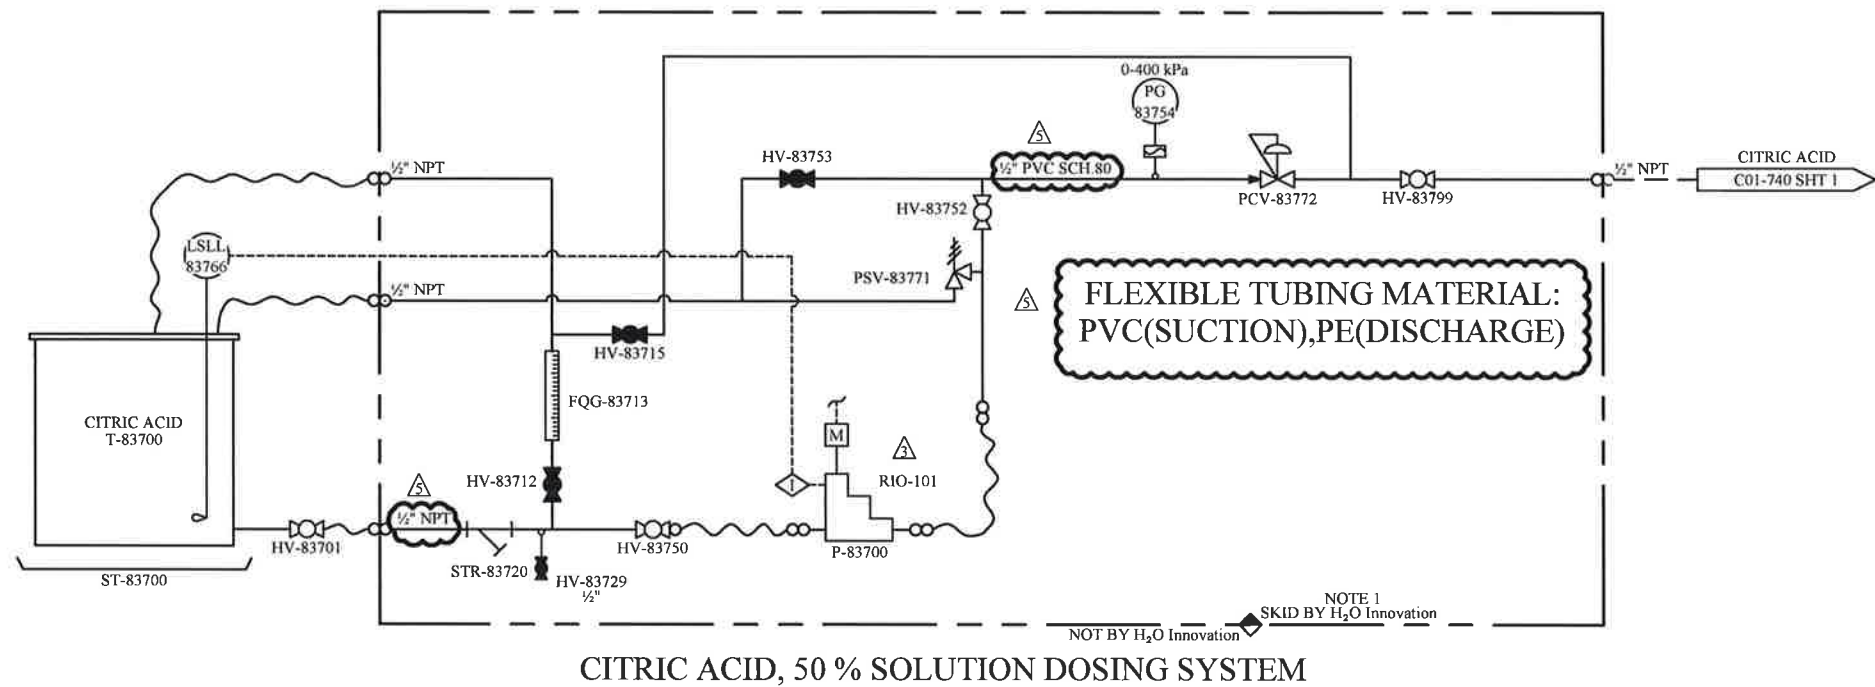

- NOTES:
- EQUIPMENT TO BE PLACED IN CONTAINER #1
 - EQUIPMENT TO BE PLACED IN CONTAINER #2

NOTE:
THE INFORMATION, SPECIFICATIONS AND DATA SHOWN ON THIS PRINT ARE FURNISHED BY AND ARE TO REMAIN THE PROPERTY OF H₂O INNOVATION.

THE PURPOSE OF THIS DOCUMENT IS TO FACILITATE THE INSTALLATION, MAINTENANCE AND OPERATION OF THE EQUIPMENT REPRESENTED BY SAID PRINT. NO OTHER USE OF THIS DOCUMENT SHALL BE MADE WITHOUT EXPRESS WRITTEN CONSENT FROM H₂O INNOVATION.



DRAWING REVISION							
REV	DATE	REVISION DESCRIPTION	DRAWN	CHKD	ENG	APPVD	
05	21/09/2016	REVISED AS BUILT	M.P.	H.S.	H.C.	R.D.	
04	08/02/2016	REVISED AS PER COMMENT	M.P.	H.S.	H.C.	H.C.	
03	25/07/2016	REVISED AS PER COMMENT	M.P.	H.S.	H.C.	H.C.	
02	13/07/2016	REVISED AS PER COMMENT	M.P.	H.S.	H.C.	H.C.	
01	11/07/2016	CHANGE SUMP TANK BALL TO GATE VALVE, SOLENOID TO ELECTRIC VALVE, TURBIDITY METER TO 120V	M.P.	H.S.	H.C.	H.C.	



UNLESS NOTED OTHERWISE
INTERPRETATION AND Y14.5
TOLERANCES
FRACTIONS
DECIMALS
HOLE SIZES
HOLE CENTERS
DO NOT SCALE PRINTS

MELIADINE STP
216 M3/DAY

TITLE:		
DOSING SKIDS - CLEANING CHEMICALS PROCESS & INSTRUMENTATION DIAGRAM		
SCALE: N/A	DRAWING NUMBER: U65875-C01-0800 SHEET: 1 of 2	REVISION 05

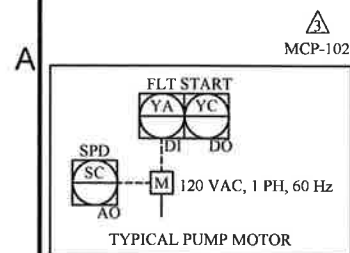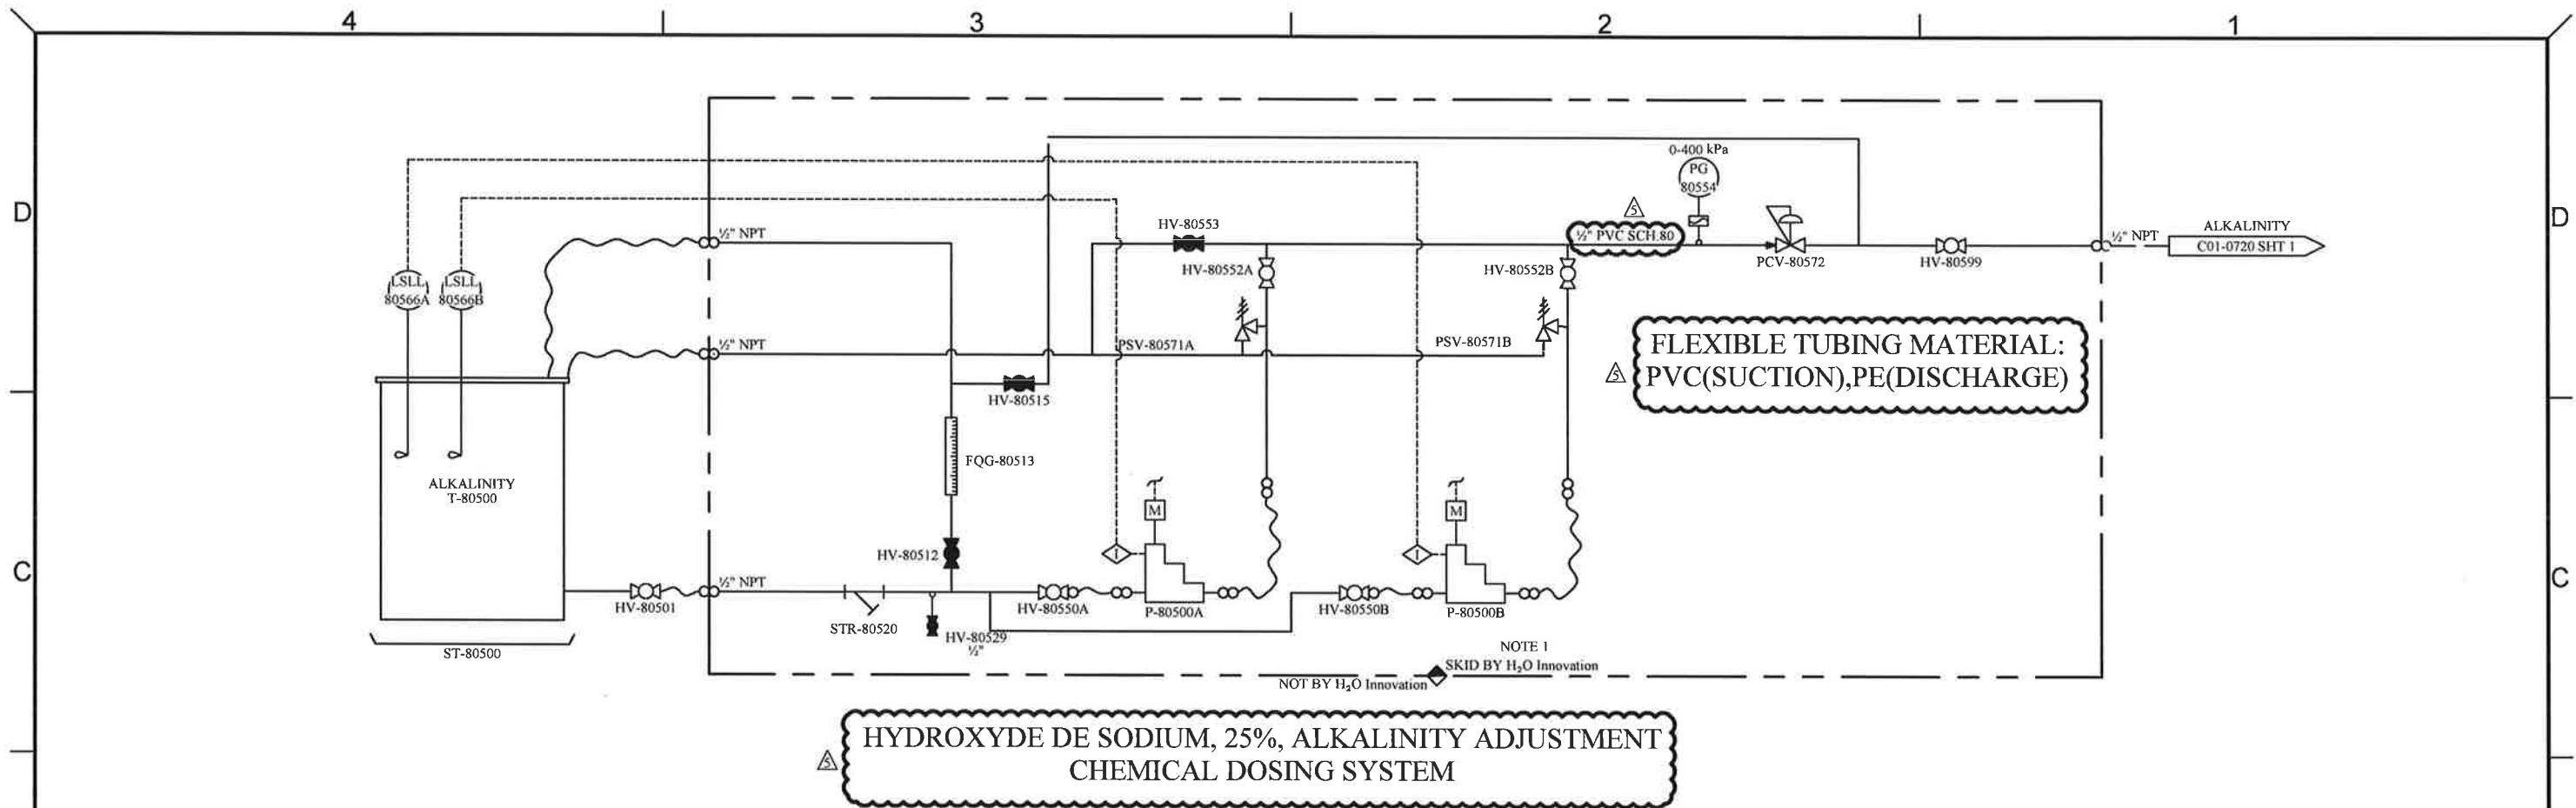

- NOTES:
- EQUIPMENT TO BE PLACED IN CONTAINER #2.

NOTE:
THE INFORMATION, SPECIFICATIONS AND DATA SHOWN ON THIS PRINT ARE FURNISHED BY AND ARE TO REMAIN THE PROPERTY OF H₂O INNOVATION.

THE PURPOSE OF THIS DOCUMENT IS TO FACILITATE THE INSTALLATION, MAINTENANCE AND OPERATION OF THE EQUIPMENT REPRESENTED BY SAID PRINT. NO OTHER USE OF THIS DOCUMENT SHALL BE MADE WITHOUT EXPRESS WRITTEN CONSENT FROM H₂O INNOVATION.

DRAWING REVISION						
REV	DATE	REVISION DESCRIPTION	DRAWN	CHKD	ENG	APPVD
05	21/09/2016	REVISED AS BUILT	M.P.	H.S.	H.C.	R.D.
04	08/02/2016	REVISED AS PER COMMENT	M.P.	H.S.	H.C.	H.C.
03	25/07/2016	REVISED AS PER COMMENT	M.P.	H.S.	H.C.	H.C.
02	13/07/2016	REVISED AS PER COMMENT	M.P.	H.S.	H.C.	H.C.
01	11/07/2016	CHANGE SUMP TANK BALL TO GATE VALVE, SOLENOID TO ELECTRIC VALVE, TURBIDITY METER TO 120V	M.P.	H.S.	H.C.	H.C.



UNLESS NOTED OTHERWISE
INTERPRETATION AND T44.5

TOLERANCES
FRACTIONS
DECIMALS
ANGLES
HOLE SIZES
HOLE CENTERS


1/16" 0.0625
1/8" 0.125
3/16" 0.1875
1/4" 0.25
3/8" 0.375
1/2" 0.5
3/4" 0.75
1" 1.0
1 1/2" 1.5
2" 2.0
2 1/2" 2.5
3" 3.0
3 1/2" 3.5
4" 4.0
4 1/2" 4.5
5" 5.0
5 1/2" 5.5
6" 6.0
6 1/2" 6.5
7" 7.0
7 1/2" 7.5
8" 8.0
8 1/2" 8.5
9" 9.0
9 1/2" 9.5
10" 10.0

DO NOT SCALE PRINTS

MELIADINE STP

216 M3/DAY

TITLE:		
DOSING SKIDS - ALKALINITY PROCESS & INSTRUMENTATION DIAGRAM		
SCALE:	DRAWING NUMBER:	REVISION
N/A	U65875-C01-0800	05
SHEET: 2 of 2		

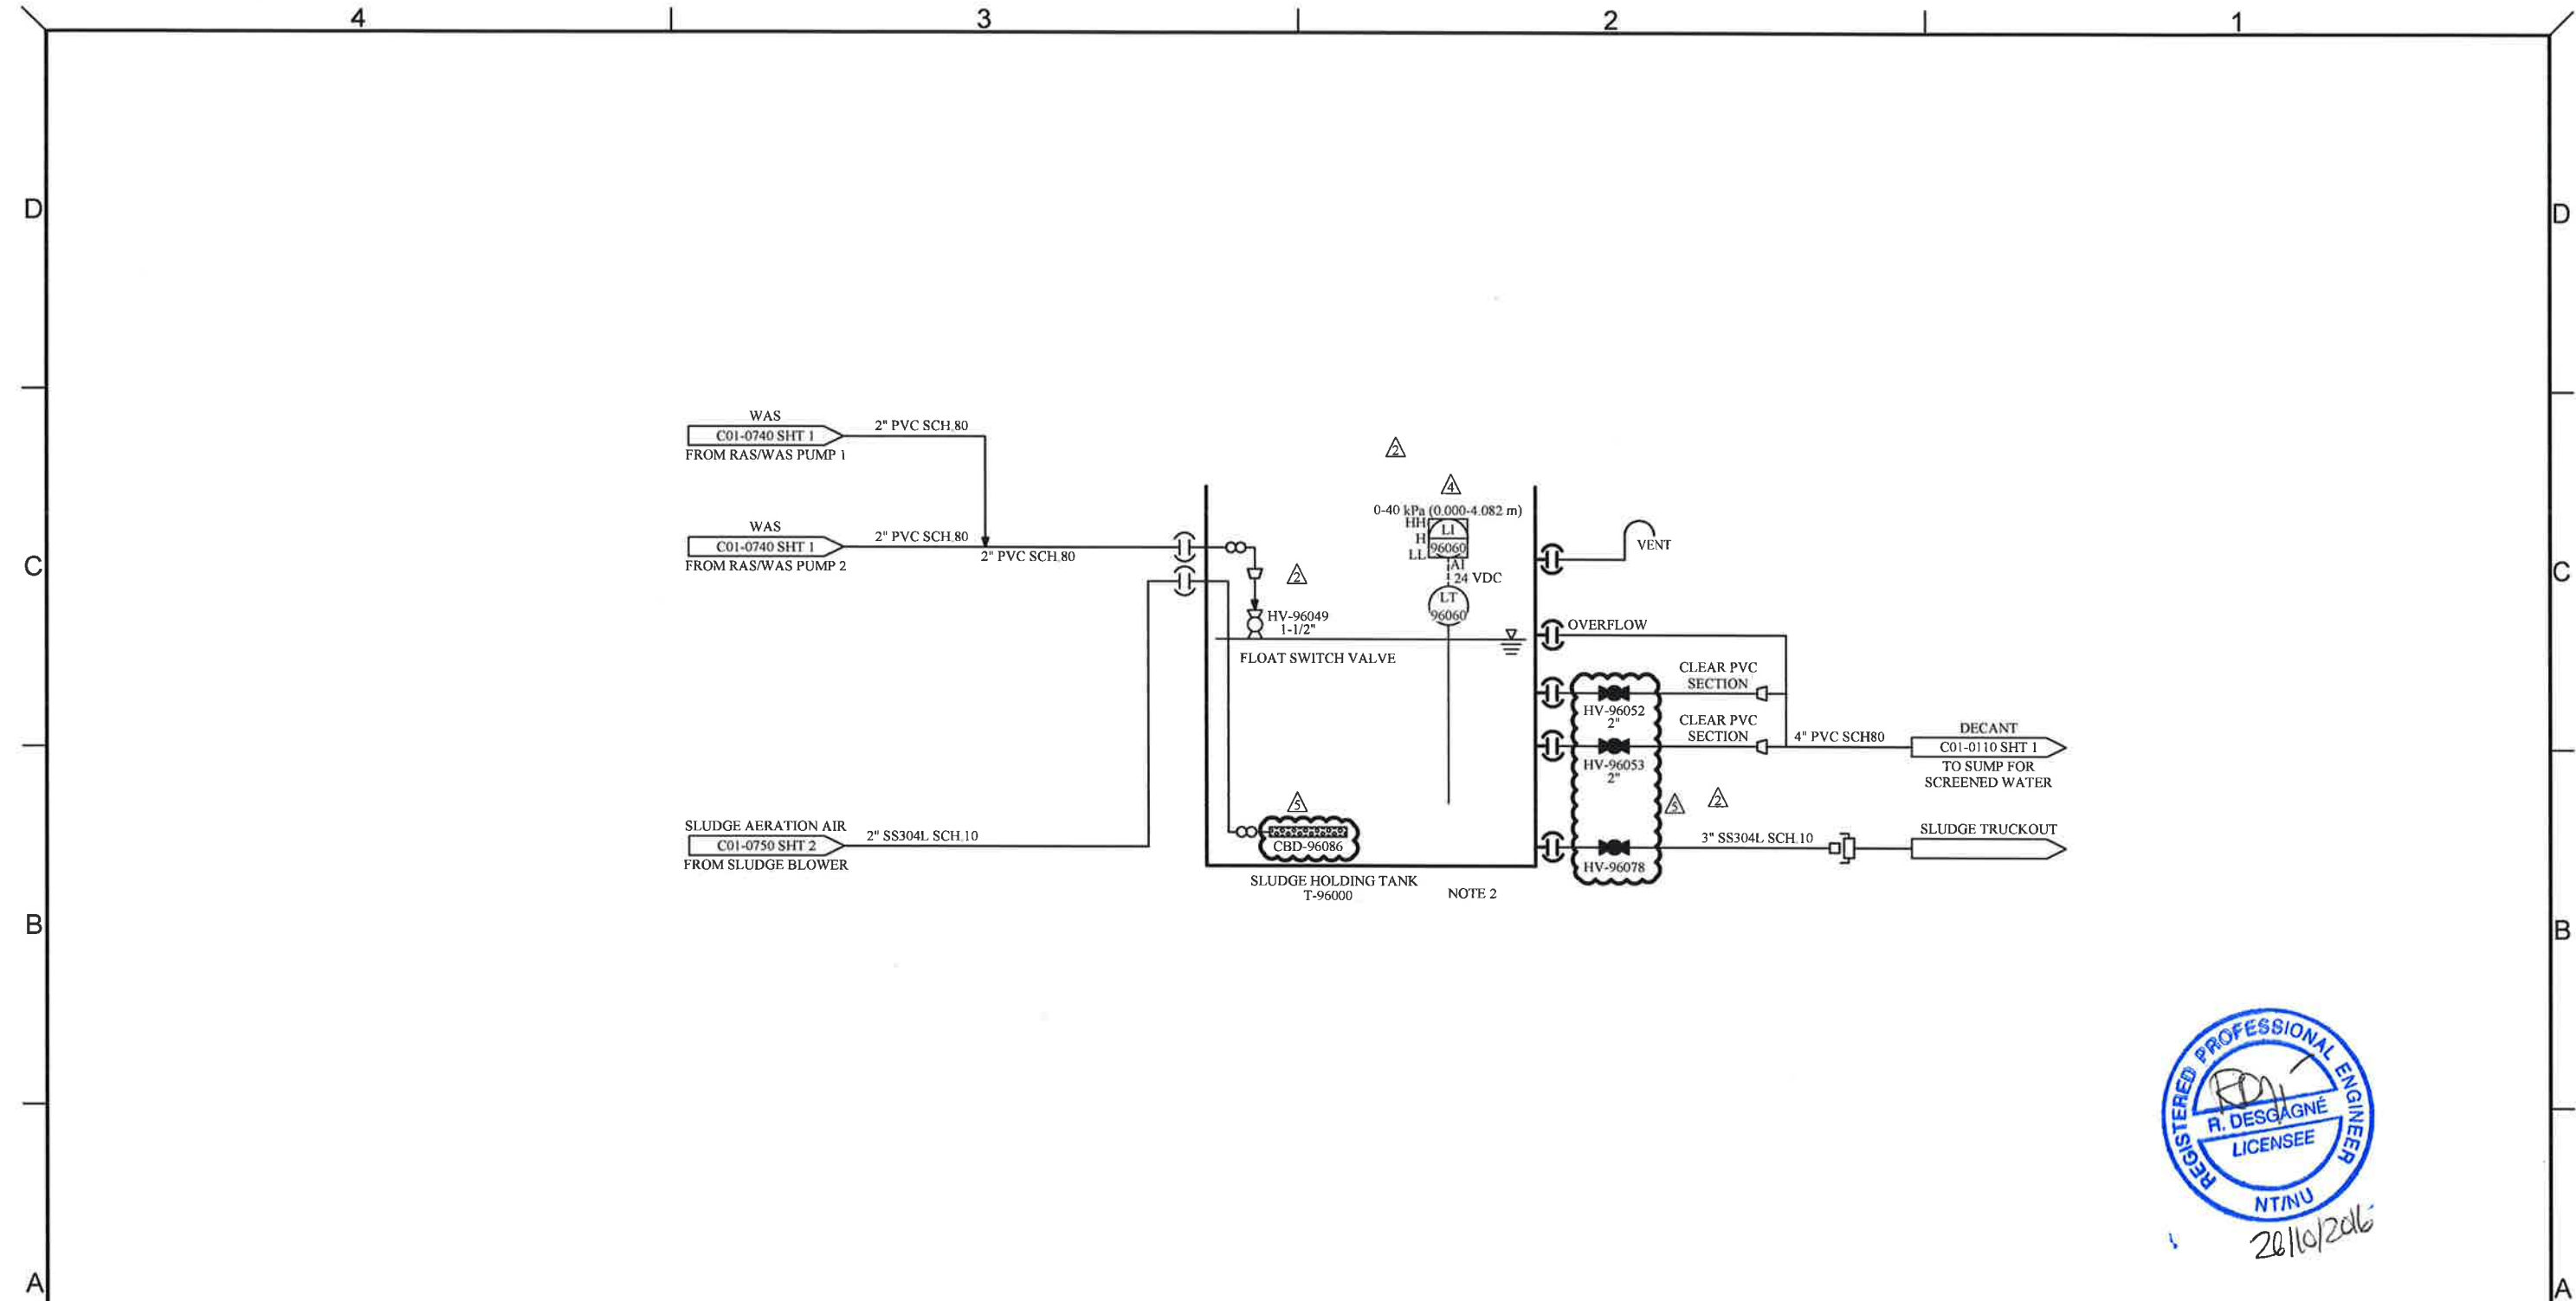

- NOTES:
1. ALL COMPONENTS GOING INTO RIO 101.
 2. SLUDGE HOLDING TANK WITH COVER.
 3. ALL VENT TO OUTSIDE.

NOTE:
THE INFORMATION, SPECIFICATIONS AND DATA SHOWN ON THIS PRINT ARE FURNISHED BY AND ARE TO REMAIN THE PROPERTY OF H₂O INNOVATION.

THE PURPOSE OF THIS DOCUMENT IS TO FACILITATE THE INSTALLATION, MAINTENANCE AND OPERATION OF THE EQUIPMENT REPRESENTED BY SAID PRINT. NO OTHER USE OF THIS DOCUMENT SHALL BE MADE WITHOUT EXPRESS WRITTEN CONSENT FROM H₂O INNOVATION.

DRAWING REVISION					
REV	DATE	REVISION DESCRIPTION	DRAWN	CHKD	ENG
05	21/09/2016	REVISED AS BUILT	M.P.	H.S.	H.C.
04	08/02/2016	REVISED AS PER COMMENT	M.P.	H.S.	H.C.
03	25/07/2016	REVISED AS PER COMMENT	M.P.	H.S.	H.C.
02	13/07/2016	REVISED AS PER COMMENT	M.P.	H.S.	H.C.
01	11/07/2016	CHANGE SUMP TANK BALL TO GATE VALVE, SOLENOID TO ELECTRIC VALVE, TURBIDITY METER TO 120V	M.P.	H.S.	H.C.



UNLESS NOTED OTHERWISE

INTERPRETATION: ANGLES 1:14.5

TOLERANCES: FRACTIONS 1/16, 1/8, 1/4, 1/2, 3/4, 1, 1 1/2, 2, 3, 4, 6, 8, 12, 16, 24, 36, 48, 72, 96, 144, 192, 288, 384, 576, 768, 1152, 1536, 2304, 3072, 4608, 6144, 8192, 10240, 13312, 17408, 22912, 30208, 39552, 51904, 68480, 89984, 117760, 154304, 201728, 265600, 347264, 452000, 589696, 766400, 1000000

DECIMALS: 0.001, 0.002, 0.005, 0.01, 0.02, 0.05, 0.1, 0.2, 0.5, 1, 2, 5, 10, 20, 50, 100, 200, 500, 1000

ANGLES: 1/16, 1/8, 1/4, 1/2, 3/4, 1, 1 1/2, 2, 3, 4, 6, 8, 12, 16, 24, 36, 48, 72, 96, 144, 192, 288, 384, 576, 768, 1152, 1536, 2304, 3072, 4608, 6144, 8192, 10240, 13312, 17408, 22912, 30208, 39552, 51904, 68480, 89984, 117760, 154304, 201728, 265600, 347264, 452000, 589696, 766400, 1000000

HOLE SIZES: 1/16, 1/8, 1/4, 1/2, 3/4, 1, 1 1/2, 2, 3, 4, 6, 8, 12, 16, 24, 36, 48, 72, 96, 144, 192, 288, 384, 576, 768, 1152, 1536, 2304, 3072, 4608, 6144, 8192, 10240, 13312, 17408, 22912, 30208, 39552, 51904, 68480, 89984, 117760, 154304, 201728, 265600, 347264, 452000, 589696, 766400, 1000000


HOLE CENTERS: 1/16, 1/8, 1/4, 1/2, 3/4, 1, 1 1/2, 2, 3, 4, 6, 8, 12, 16, 24, 36, 48, 72, 96, 144, 192, 288, 384, 576, 768, 1152, 1536, 2304, 3072, 4608, 6144, 8192, 10240, 13312, 17408, 22912, 30208, 39552, 51904, 68480, 89984, 117760, 154304, 201728, 265600, 347264, 452000, 589696, 766400, 1000000

DO NOT SCALE PRINTS

MELIADINE STP



216 M3/DAY

TITLE:		
SLUDGE HANDLING SYSTEM PROCESS & INSTRUMENTATION DIAGRAM		
SCALE:	DRAWING NUMBER:	REVISION
N/A	U65875-C01-0960	05
SHEET: 1 of 1		

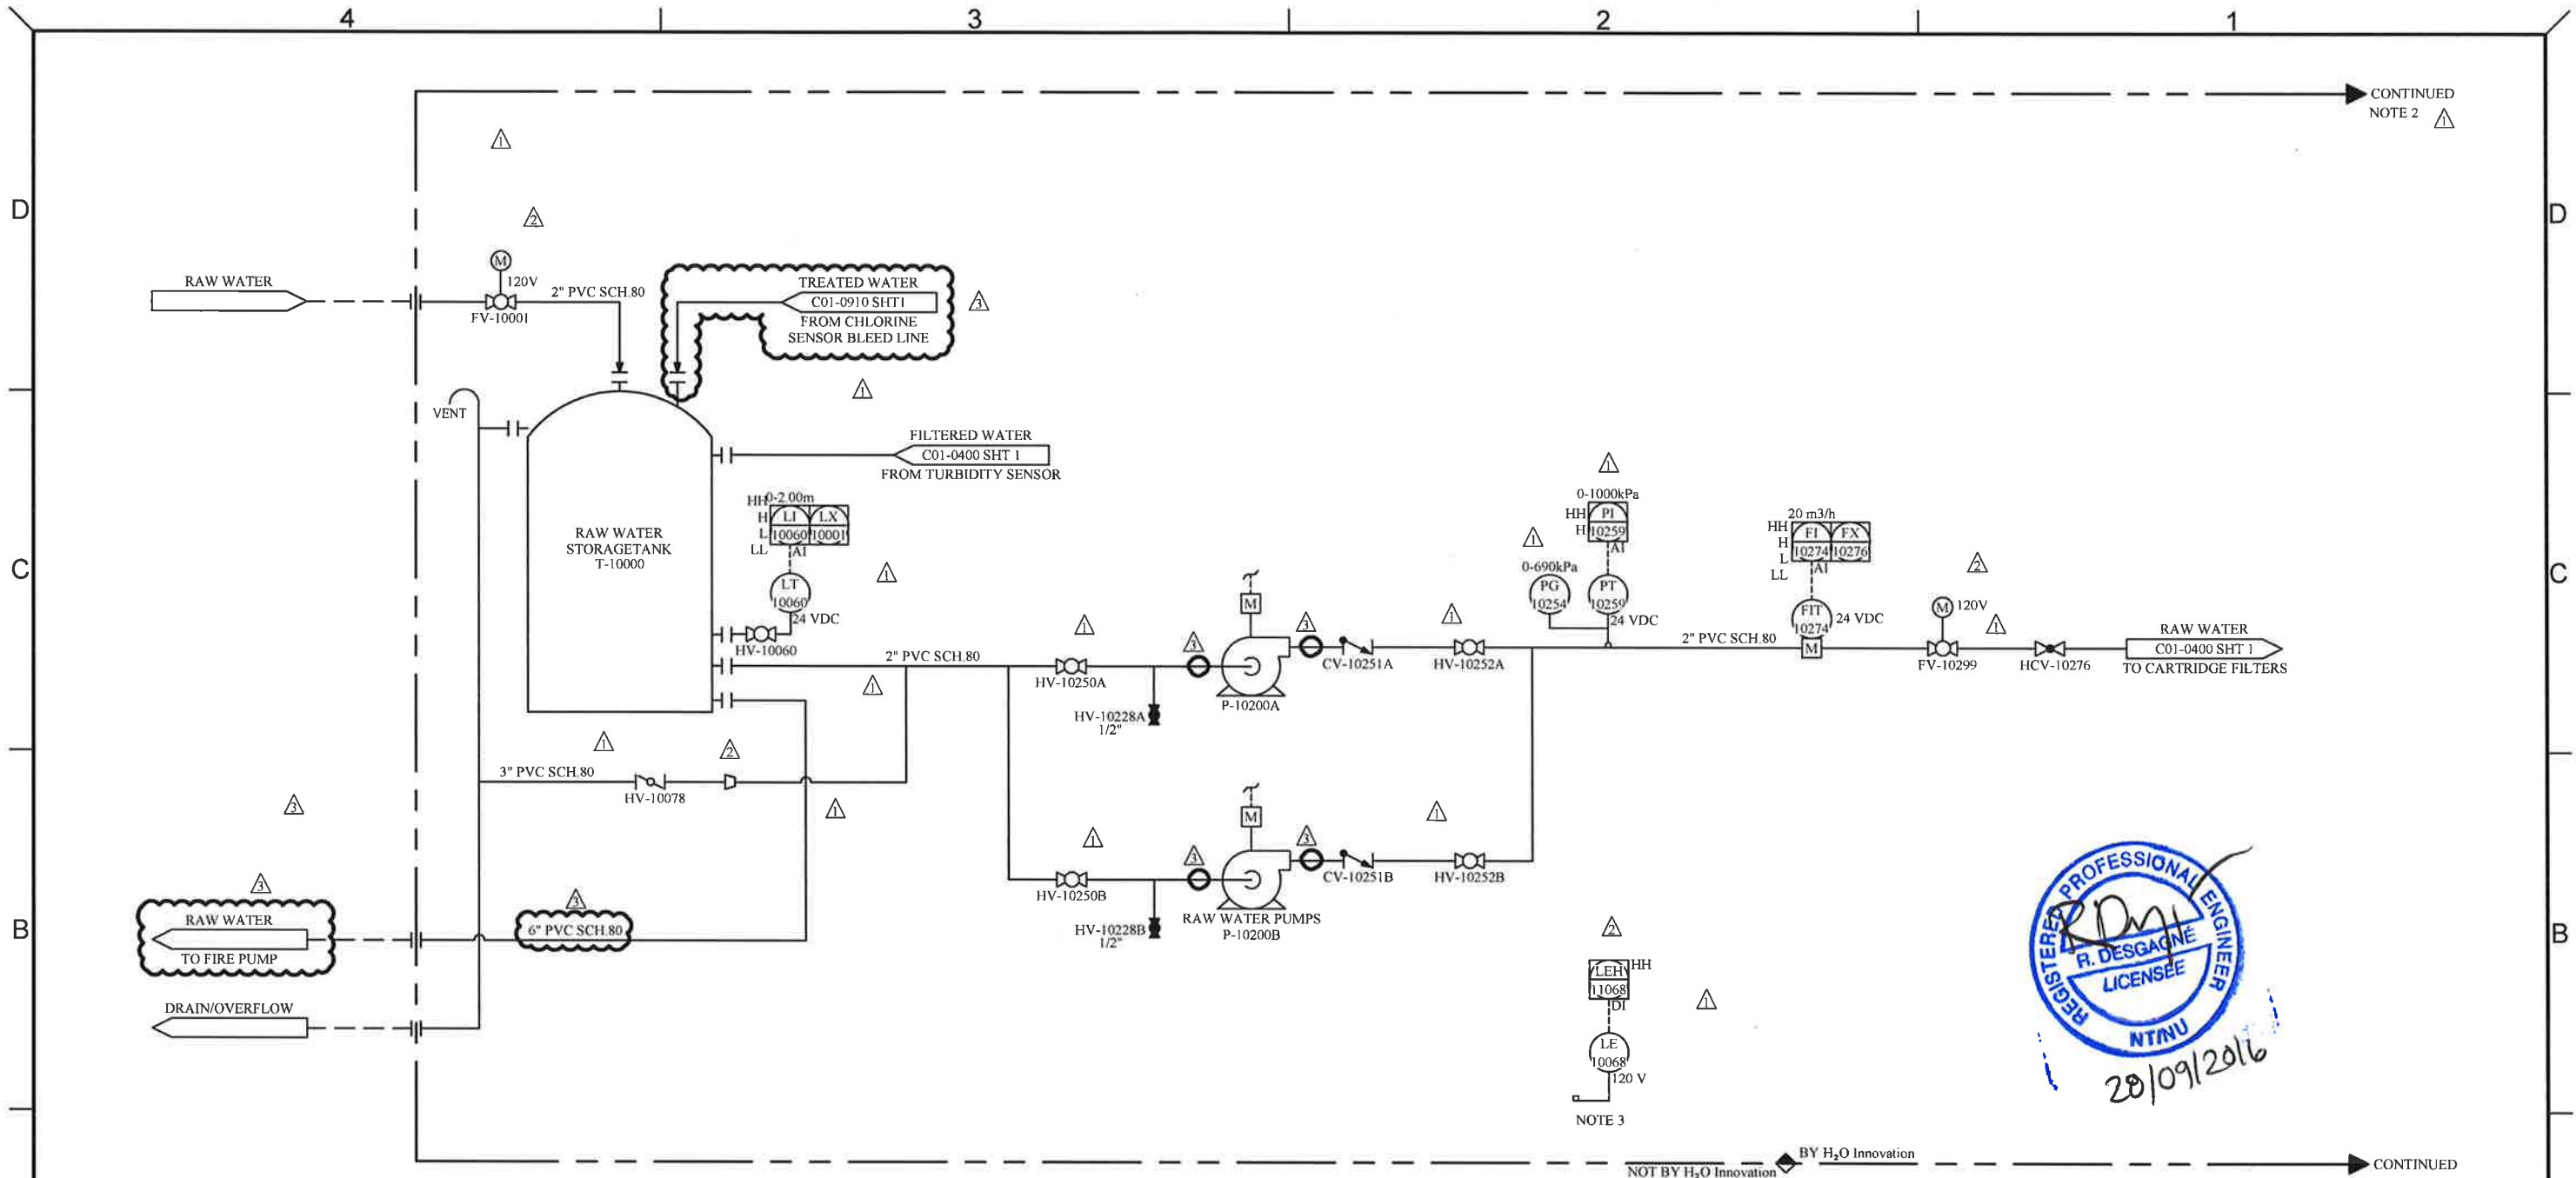

NOTES:

- ALL SIGNALS GOING INTO MCP-101.
- EQUIPMENT TO BE PLACED IN CONTAINER #1.
- WATER LEAK DETECTOR

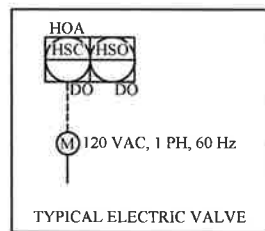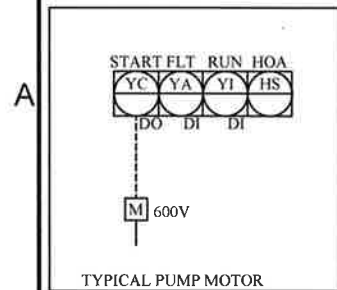

NOTE:
THE INFORMATION, SPECIFICATIONS AND DATA SHOWN ON THIS PRINT ARE FURNISHED BY AND ARE TO REMAIN THE PROPERTY OF H₂O INNOVATION.

THE PURPOSE OF THIS DOCUMENT IS TO FACILITATE THE INSTALLATION, MAINTENANCE AND OPERATION OF THE EQUIPMENT REPRESENTED BY SAID PRINT. NO OTHER USE OF THIS DOCUMENT SHALL BE MADE WITHOUT EXPRESS WRITTEN CONSENT FROM H₂O INNOVATION.

DRAWING REVISION					
REV	DATE	REVISION DESCRIPTION	DRAWN	CHKD	ENG
03	09/08/2016	AS BUILT	M.P.	S.B.	R.D.
02	25/07/2016	REVISED AS PER COMMENTS	M.P.	S.B.	R.D.
01	29/06/2016	AS PER COMMENTS	M.P.	S.B.	R.D.
00	13/06/2016	INITIAL RELEASE	M.P.	S.B.	R.D.




UNLESS NOTED OTHERWISE
INTERPRETATION
ANSI Y14.5

TOLERANCES
FRACTIONS
DECIMALS
ANGLES
HOLE SIZES
HOLE CENTERS

DO NOT SCALE PRINTS

MELIADINE
WTP CONTAINERIZED UNIT

TITLE:		
RAW WATER FEED SYSTEM PROCESS & INSTRUMENTATION DIAGRAM		
SCALE: N/A	DRAWING NUMBER: P65873-C01-0100	REVISION 03
SHEET: 1 of 1		

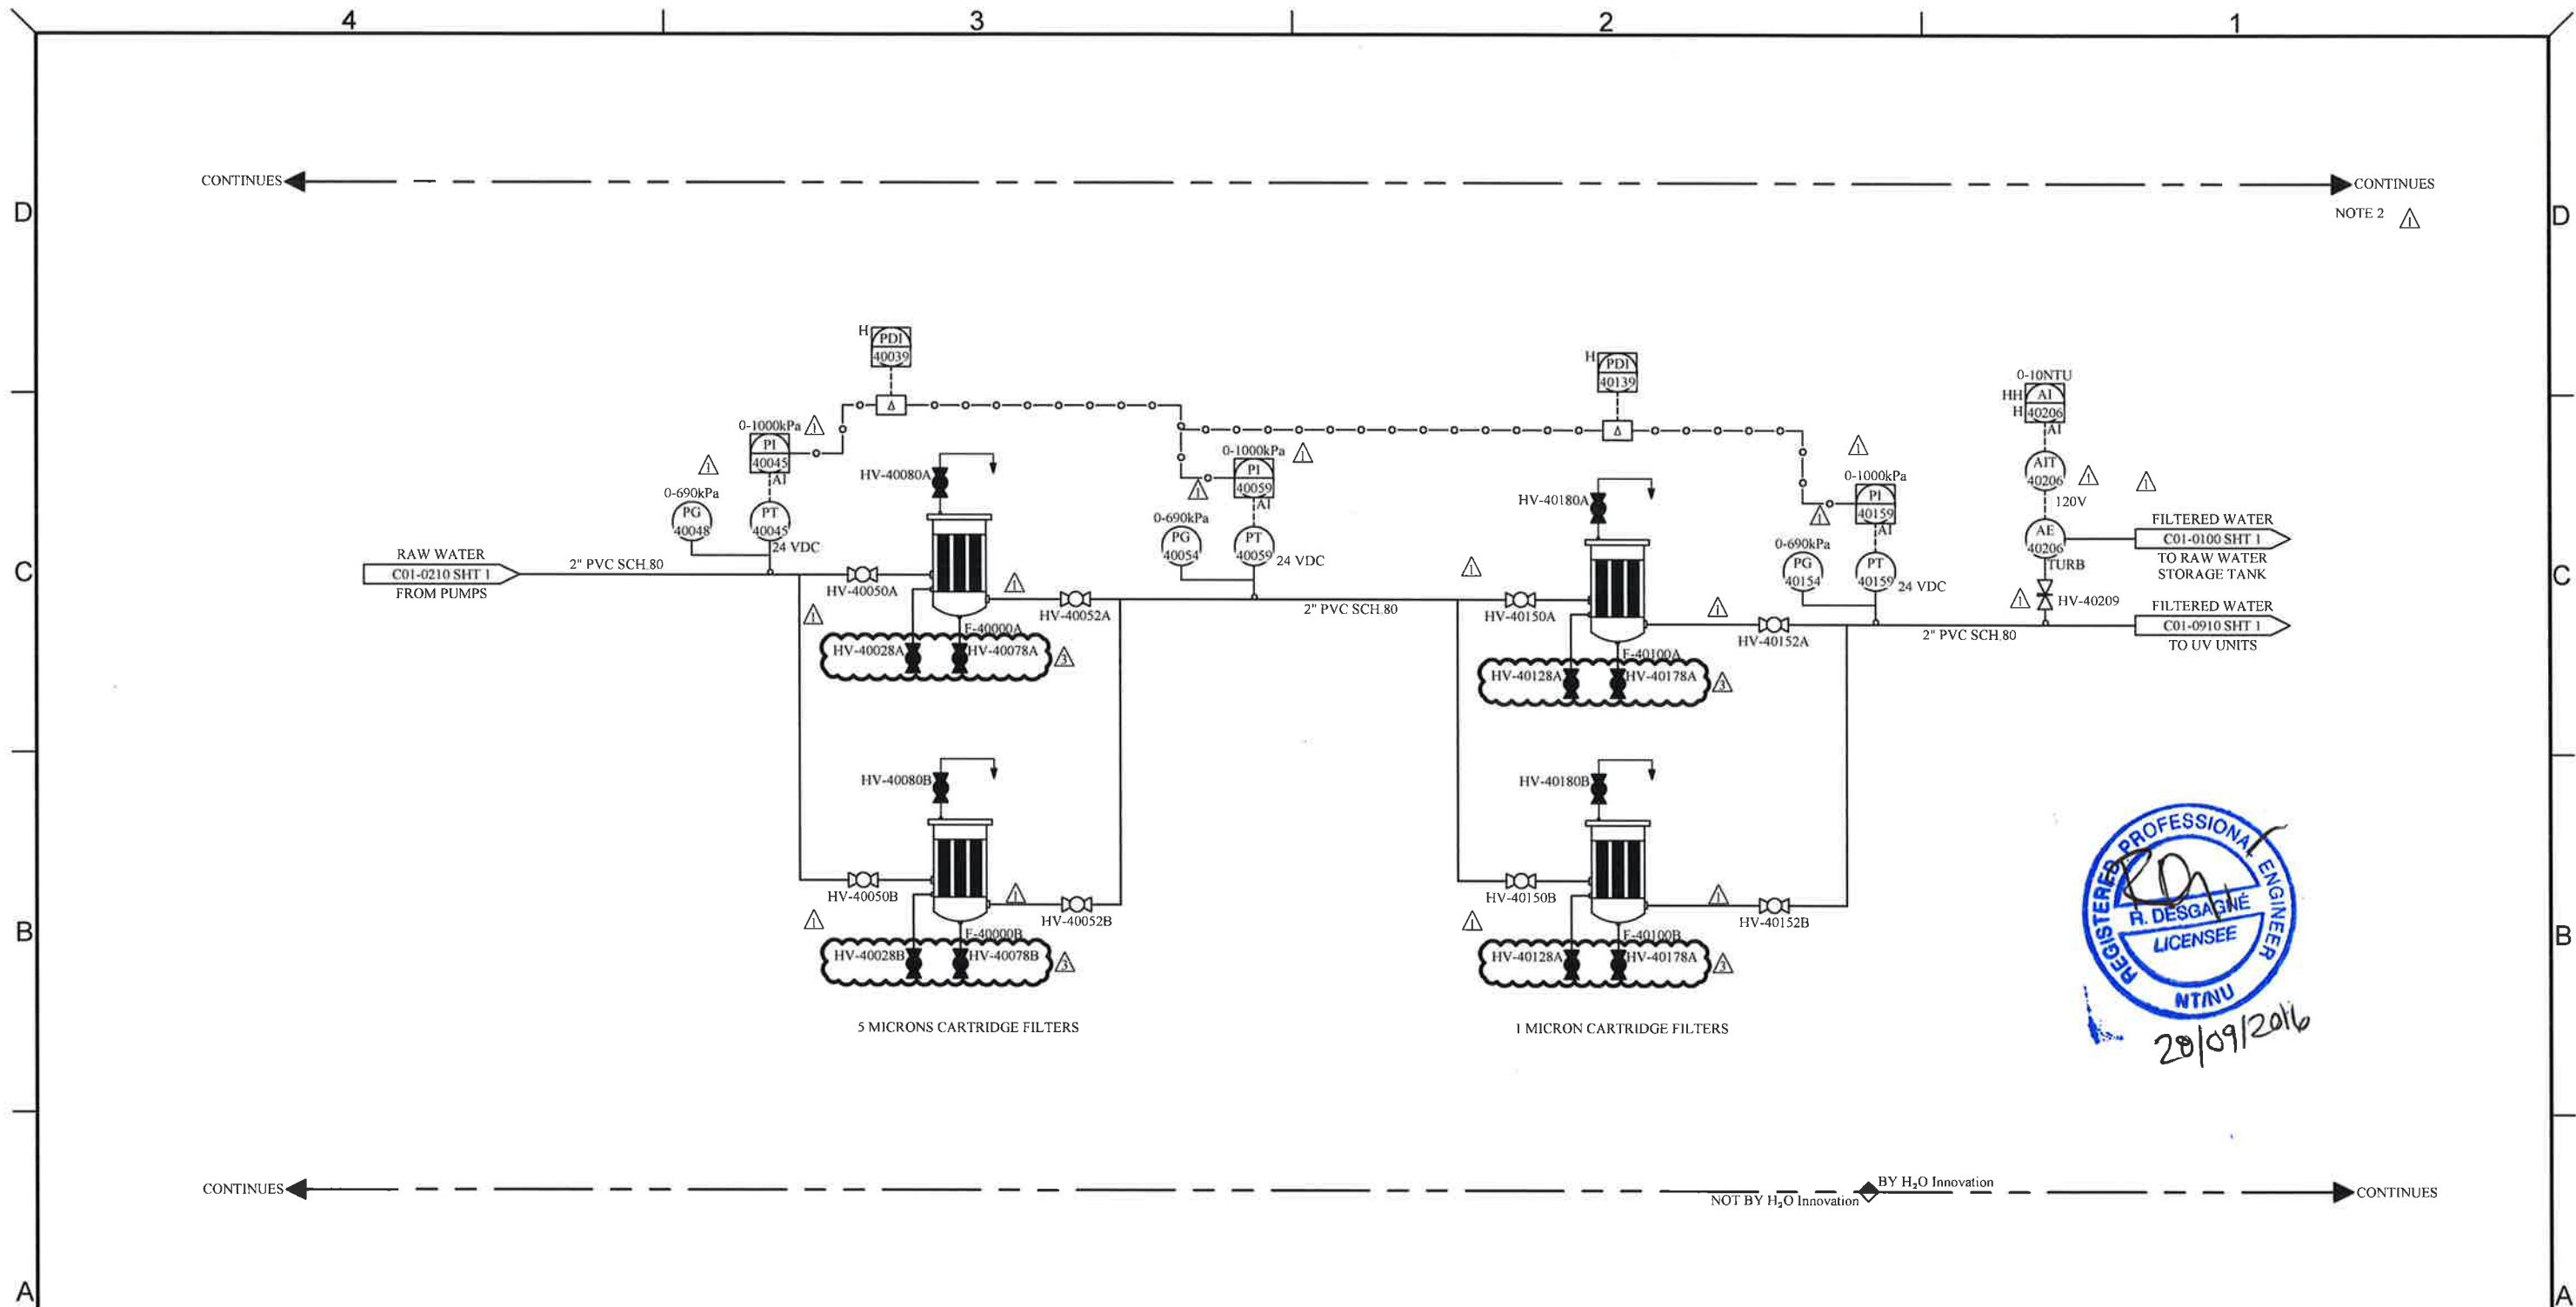

- NOTES:
1. ALL SIGNALS GOING INTO MCP-101.
 2. EQUIPMENT TO BE PLACED IN CONTAINER #1.

NOTE:
THE INFORMATION, SPECIFICATIONS AND DATA SHOWN ON THIS PRINT ARE FURNISHED BY AND ARE TO REMAIN THE PROPERTY OF H₂O INNOVATION.

THE PURPOSE OF THIS DOCUMENT IS TO FACILITATE THE INSTALLATION, MAINTENANCE AND OPERATION OF THE EQUIPMENT REPRESENTED BY SAID PRINT. NO OTHER USE OF THIS DOCUMENT SHALL BE MADE WITHOUT EXPRESS WRITTEN CONSENT FROM H₂O INNOVATION.

DRAWING REVISION						
REV	DATE	REVISION DESCRIPTION	DRAWN	CHKD	ENG	APPVD
03	09/08/2016	AS BUILT	M.P.	S.B.	R.D.	A.M.
02	25/07/2016	REVISED AS PER COMMENTS	M.P.	S.B.	R.D.	A.M.
01	29/06/2016	AS PER COMMENTS	M.P.	S.B.	R.D.	A.M.
00	13/06/2016	INITIAL RELEASE	M.P.	S.B.	R.D.	A.M.




UNLESS NOTED OTHERWISE
INTERPRETATION: ANSI Y14.5

TOLERANCES:
FRACTIONS: 1/16" ± 1/32"
DECIMALS: 0.125 ± 0.005
HOLE SIZES: 1/8" ± 0.005
HOLE CENTERS: 1/8" ± 0.005

DO NOT SCALE PRINTS

MELIADINE
WTP CONTAINERIZED UNIT

TITLE: CARTRIDGE FILTERS PROCESS & INSTRUMENTATION DIAGRAM		
SCALE: N/A	DRAWING NUMBER: P65873-C01-0400	REVISION 03
SHEET: 1 of 1		

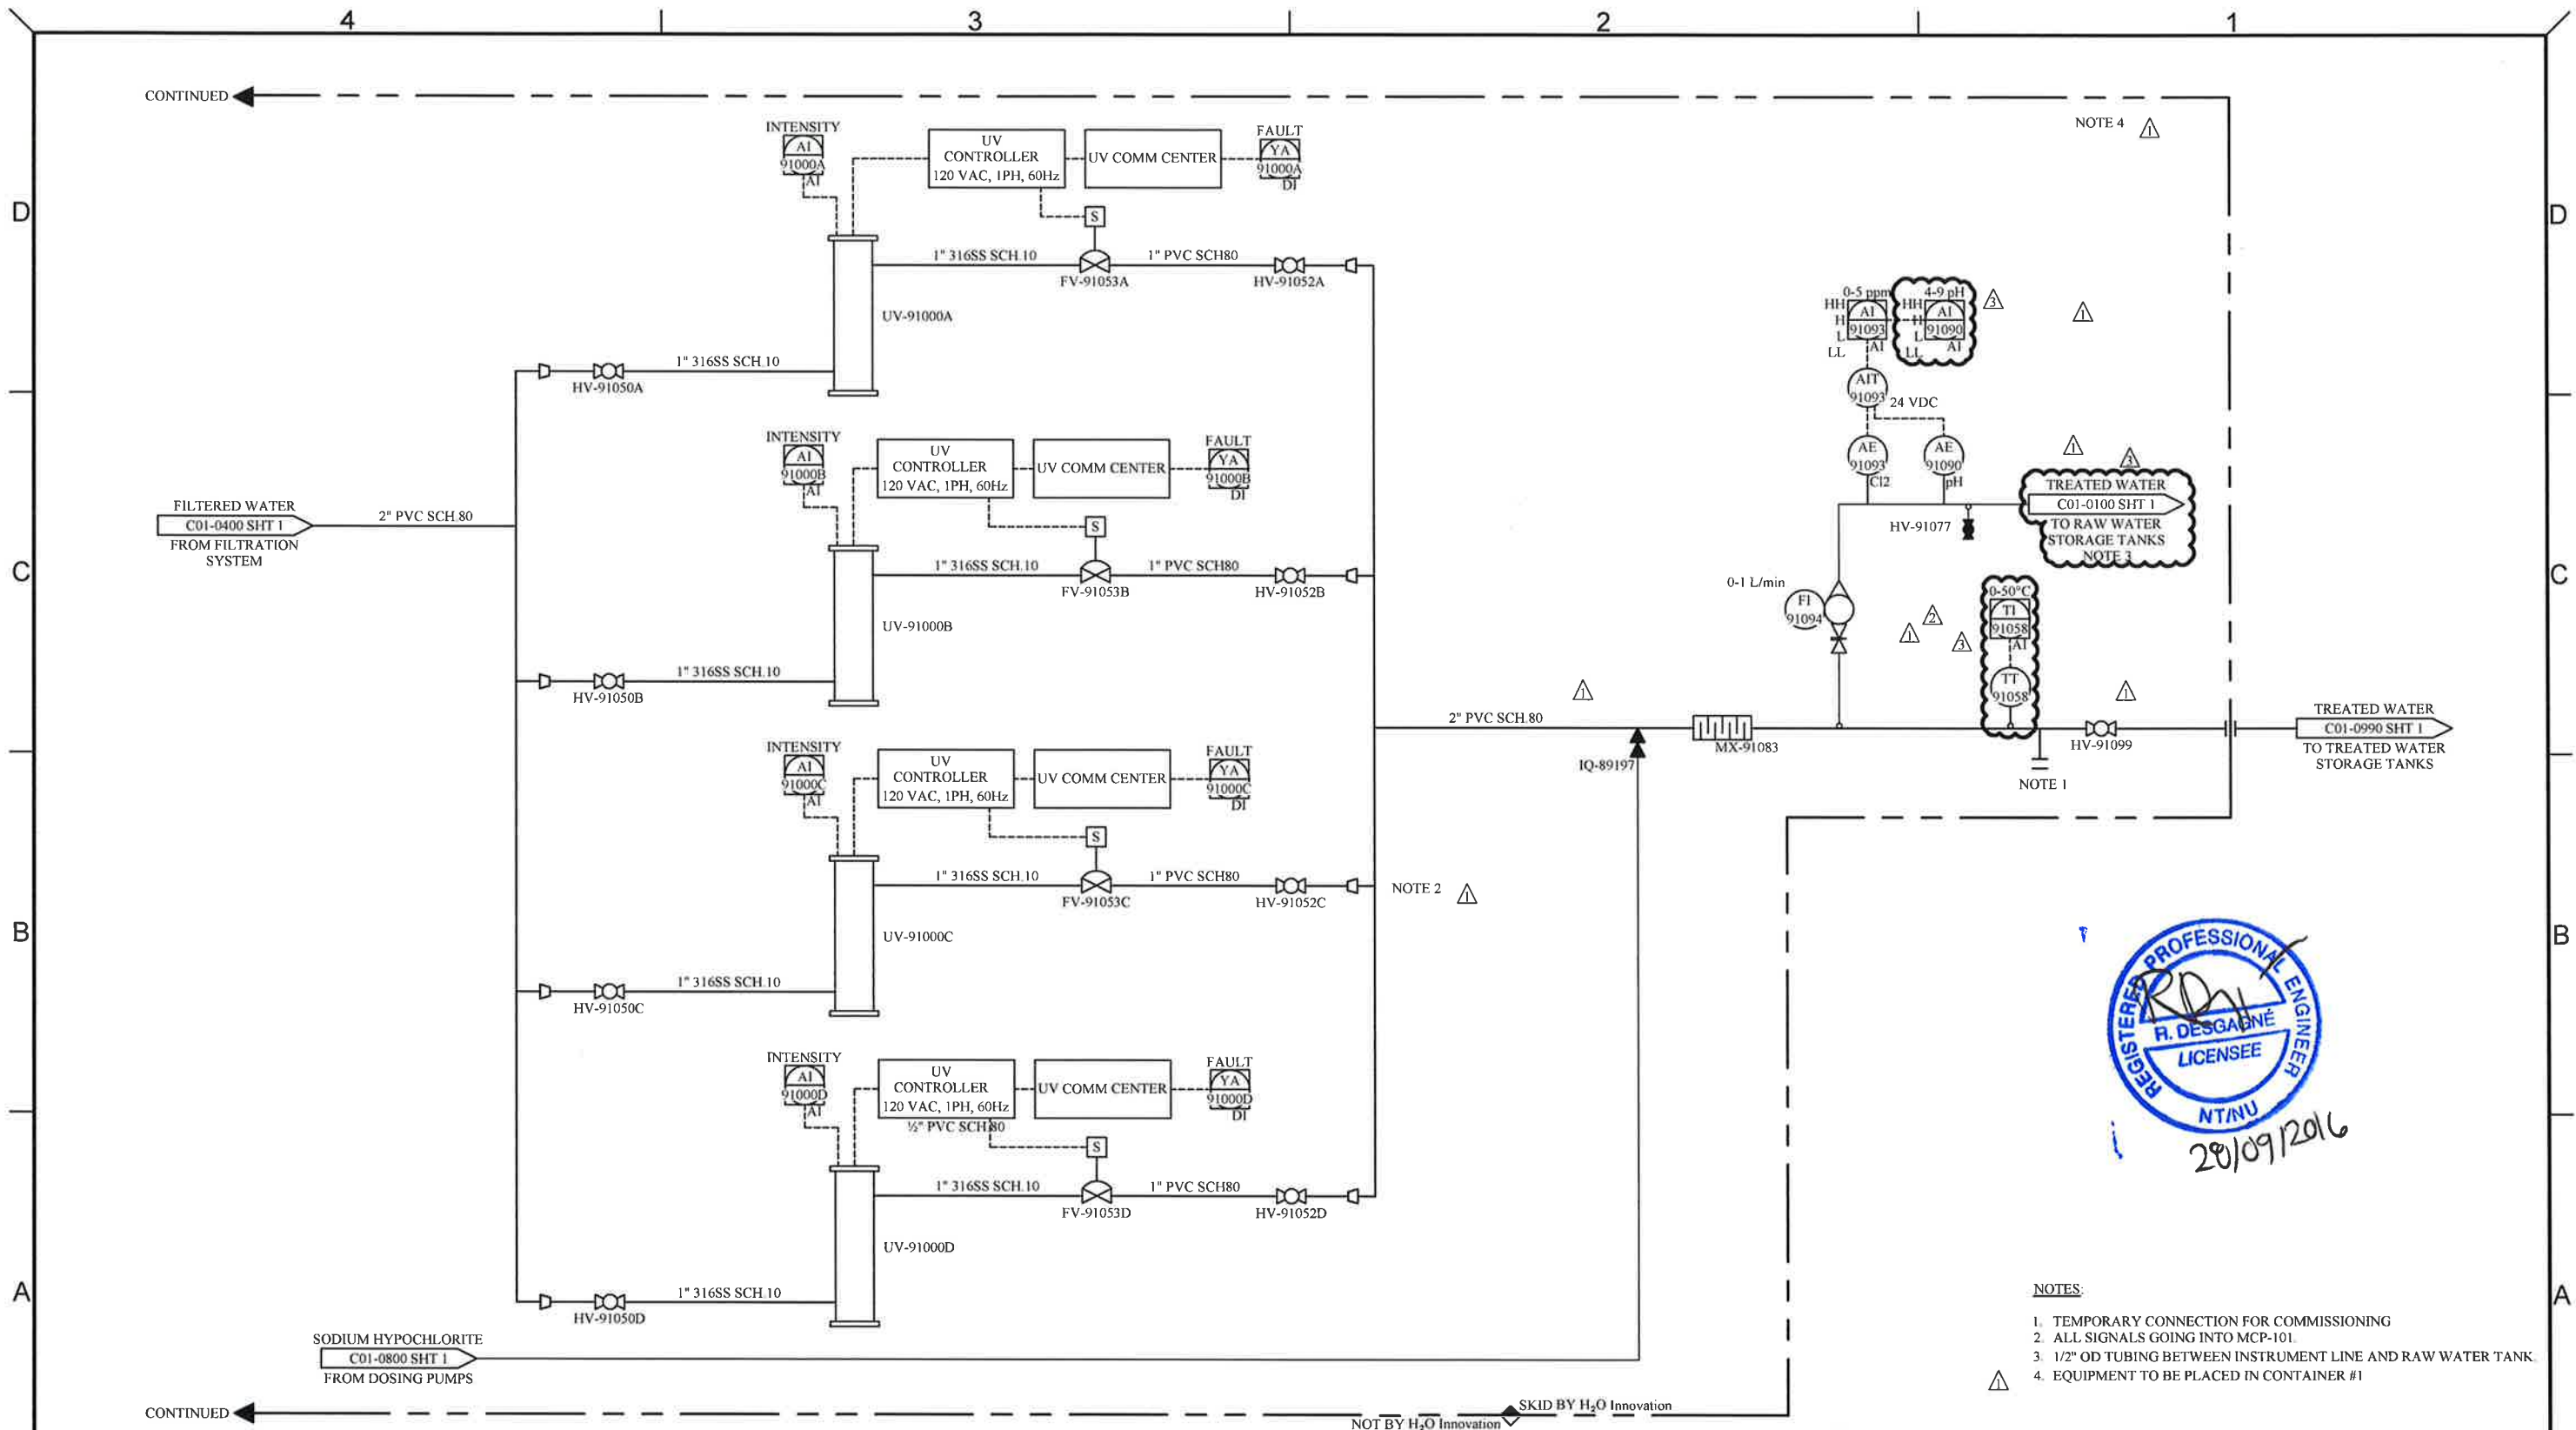

NOTES:

1. TEMPORARY CONNECTION FOR COMMISSIONING
2. ALL SIGNALS GOING INTO MCP-101.
3. 1/2" OD TUBING BETWEEN INSTRUMENT LINE AND RAW WATER TANK.
4. EQUIPMENT TO BE PLACED IN CONTAINER #1

NOTE:
THE INFORMATION, SPECIFICATIONS AND DATA SHOWN ON THIS PRINT ARE FURNISHED BY AND ARE TO REMAIN THE PROPERTY OF H₂O INNOVATION.

THE PURPOSE OF THIS DOCUMENT IS TO FACILITATE THE INSTALLATION, MAINTENANCE AND OPERATION OF THE EQUIPMENT REPRESENTED BY SAID PRINT. NO OTHER USE OF THIS DOCUMENT SHALL BE MADE WITHOUT EXPRESS WRITTEN CONSENT FROM H₂O INNOVATION.

DRAWING REVISION					
REV	DATE	REVISION DESCRIPTION	DRAWN	CHKD	ENG
03	09/08/2016	AS BUILT	M.P.	S.B.	R.D.
02	25/07/2016	REVISED AS PER COMMENTS	M.P.	S.B.	R.D.
01	29/06/2016	AS PER COMMENTS	M.P.	S.B.	R.D.
00	13/06/2016	INITIAL RELEASE	M.P.	S.B.	R.D.



UNLESS NOTED OTHERWISE
INTERPRETATION AND Y14 S

TOLERANCES
FRACTIONS
DECIMALS
ANGLES
HOLE SIZES
HOLE CENTERS

MELIADINE
WTP CONTAINERIZED UNIT

TITLE: UV TREATMENT UNITS PROCESS & INSTRUMENTATION DIAGRAM		
SCALE: N/A	DRAWING NUMBER: P65873-C01-0910	REVISION 03
SHEET: 1 of 1		

