


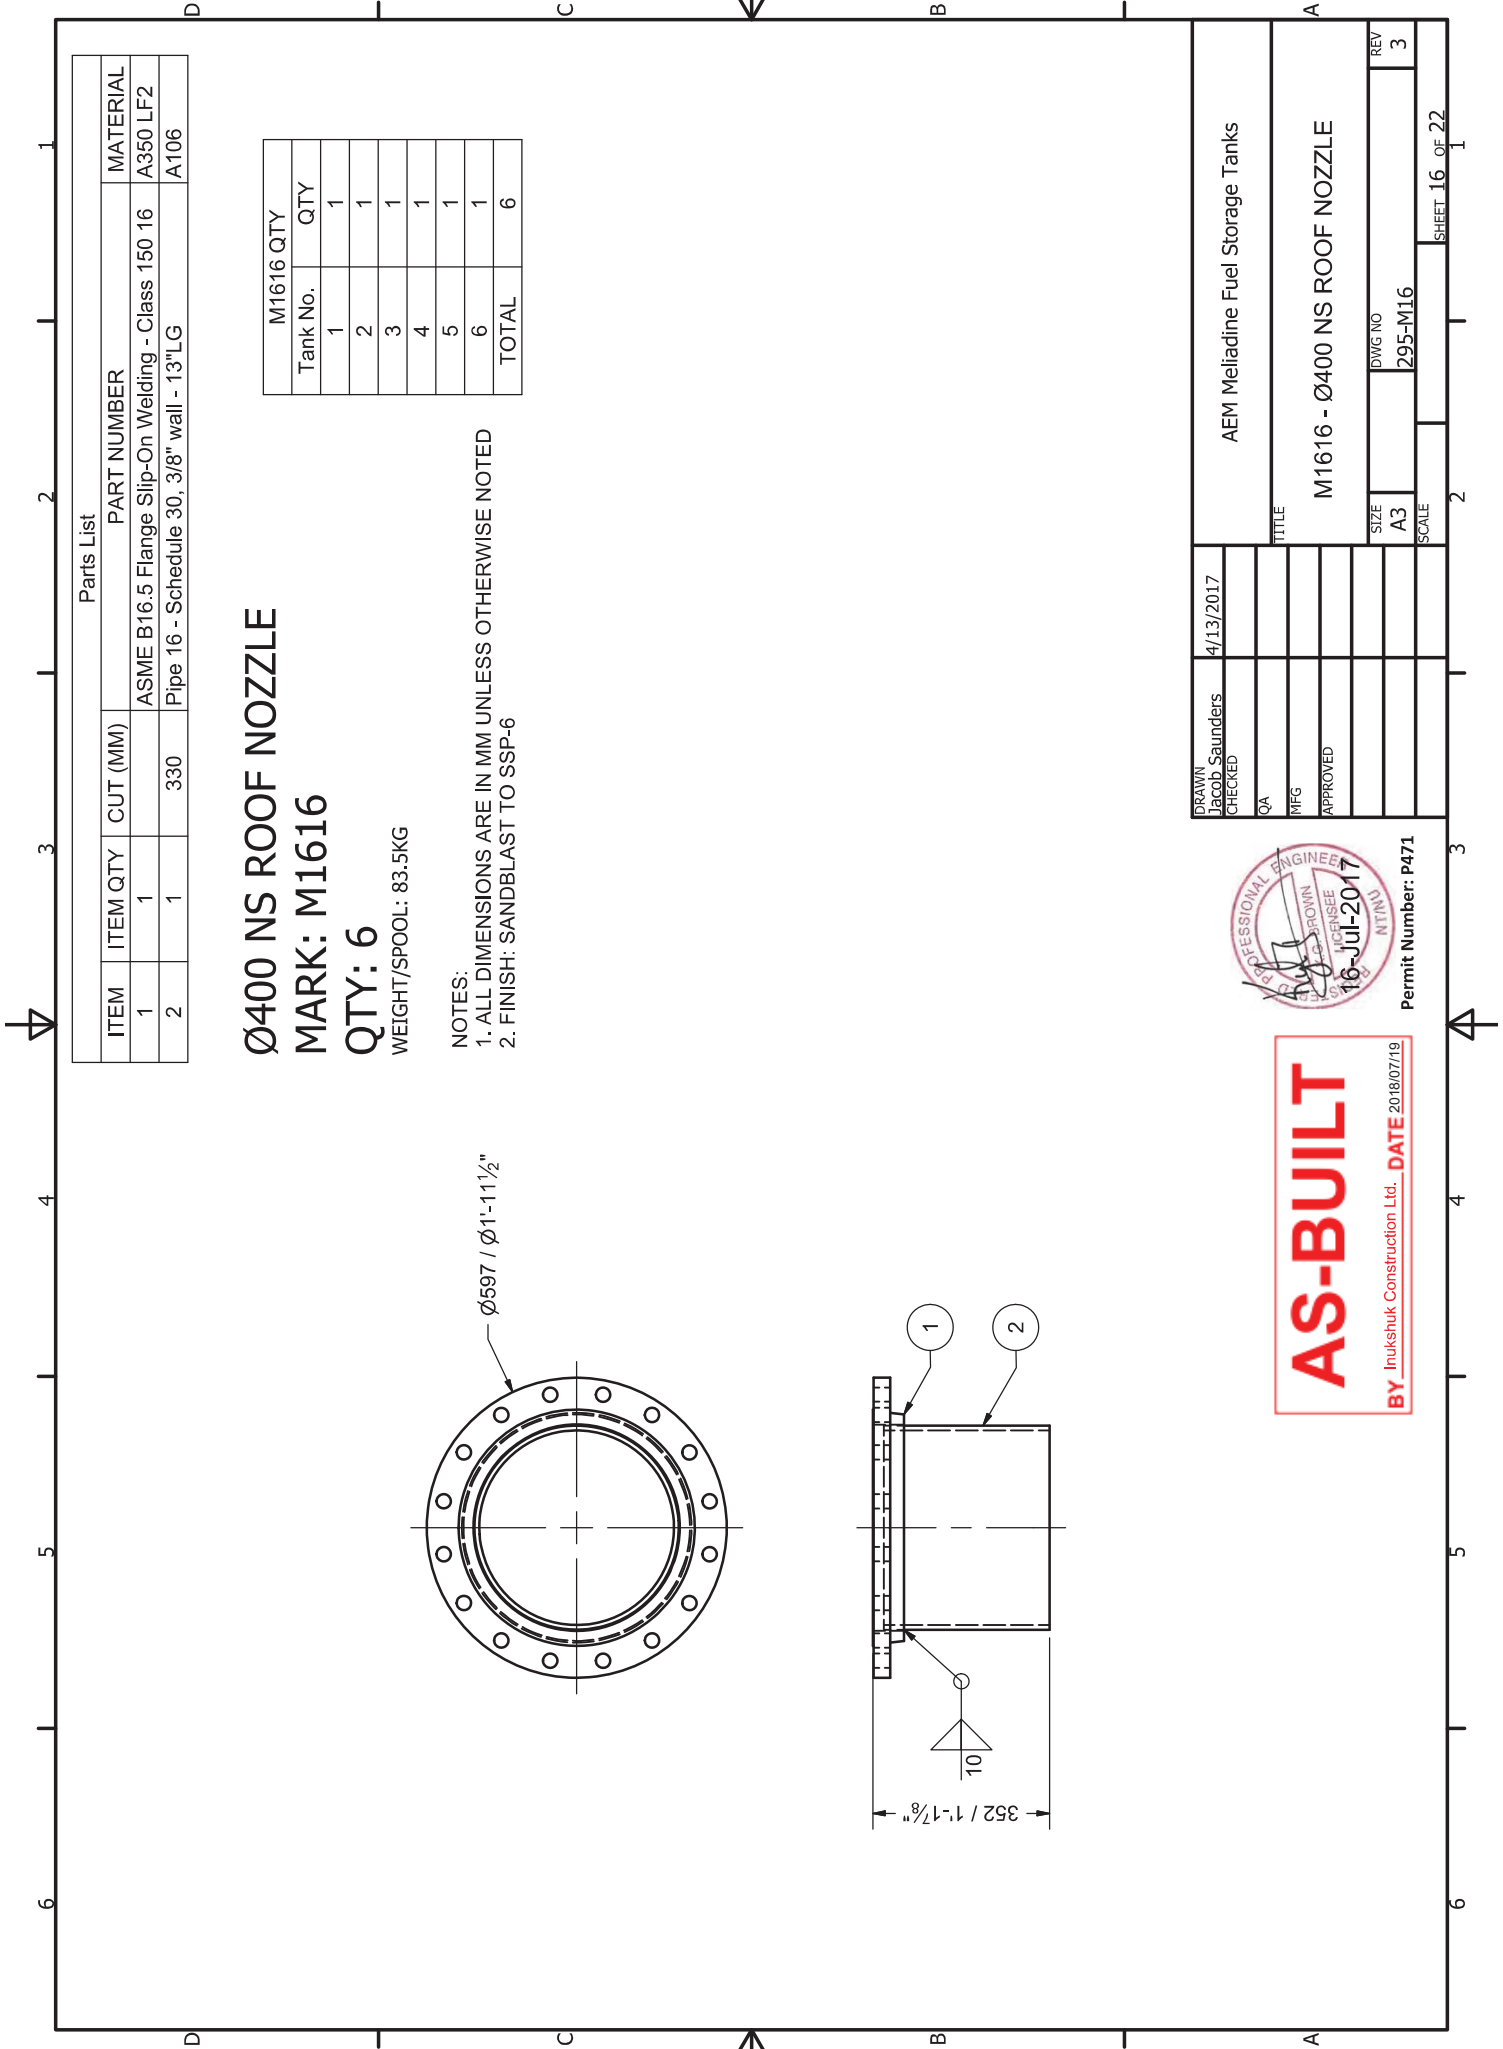

Parts List			
ITEM	ITEM QTY	CUT (MM)	PART NUMBER
1	1		ASME B16.5 Flange Slip-On Welding - Class 150 16
2	1	330	Pipe 16 - Schedule 30, 3/8" wall - 13"LG
			MATERIAL
			A350 LF2
			A106

Ø400 NS ROOF NOZZLE

MARK: M1616

QTY: 6

WEIGHT/SPOOL: 83.5KG

M1616 QTY	
Tank No.	QTY
1	1
2	1
3	1
4	1
5	1
6	1
TOTAL	6

- NOTES:
- 1. ALL DIMENSIONS ARE IN MM UNLESS OTHERWISE NOTED
 - 2. FINISH: SANDBLAST TO SSP-6



DRAWN Jacob Saunders	4/13/2017	AEM Meliadine Fuel Storage Tanks	
CHECKED		TITLE	
QA		M1616 - Ø400 NS ROOF NOZZLE	
MFG		SIZE A3	
APPROVED		SCALE	
		DWG NO 295-M16	
		REV 3	
		SHEET 16 OF 22	



Permit Number: P471

AS-BUILT

BY Inukshuk Construction Ltd. DATE 2018/07/19

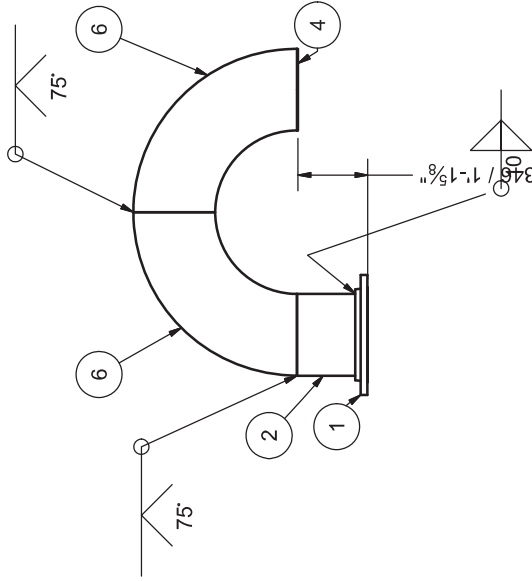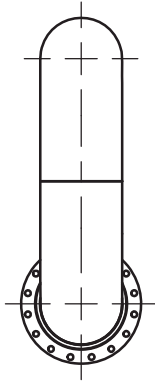

Ø400 NS VENT (RETURN BEND)

MARK: M1617

QTY: 2 3

WEIGHT/SPOOL: 320.5KG

NOTES:

- 1. ALL DIMENSIONS ARE IN MM UNLESS OTHERWISE NOTED
- 2. FINISH: SANDBLAST TO SSP-6

3

M1617 QTY	
Tank No.	QTY
1	1
2	1
3	0
4	0
5	0
6	0
TOTAL	
2	

Parts List			
ITEM	ITEM QTY	CUT (MM)	PART NUMBER
1	1		ASME B16.5 Flange Slip-On Welding - Class 150 16
2	1	330	Pipe 16 - Schedule 30 - std .375" WALL
4	1		Bird Screen 1/2" in Hole Opening
6	2	1	ASME B16.9 Long Radius 90 Deg Elbow (Metric) 16 x 9.5 [.375"] WALL
			S30 STD


MATERIAL	
A350 LF2	
A106	
MILD STEEL	
A234	

REVISION HISTORY		
REV	DESCRIPTION	DATE
3	QTY CHANGE FROM 6 TO 2	7/9/2017

DRAWN Jacob Saunders	4/13/2017	AEM Meliadine Fuel Storage Tanks	
CHECKED			
QA			
MFG			
APPROVED			
		TITLE	
		M1617 - 400NS VENT (RETURN BEND)	
		SIZE	REV
		A3	3
		SCALE	
		SHEET 17 OF 22	



Permit Number: P471

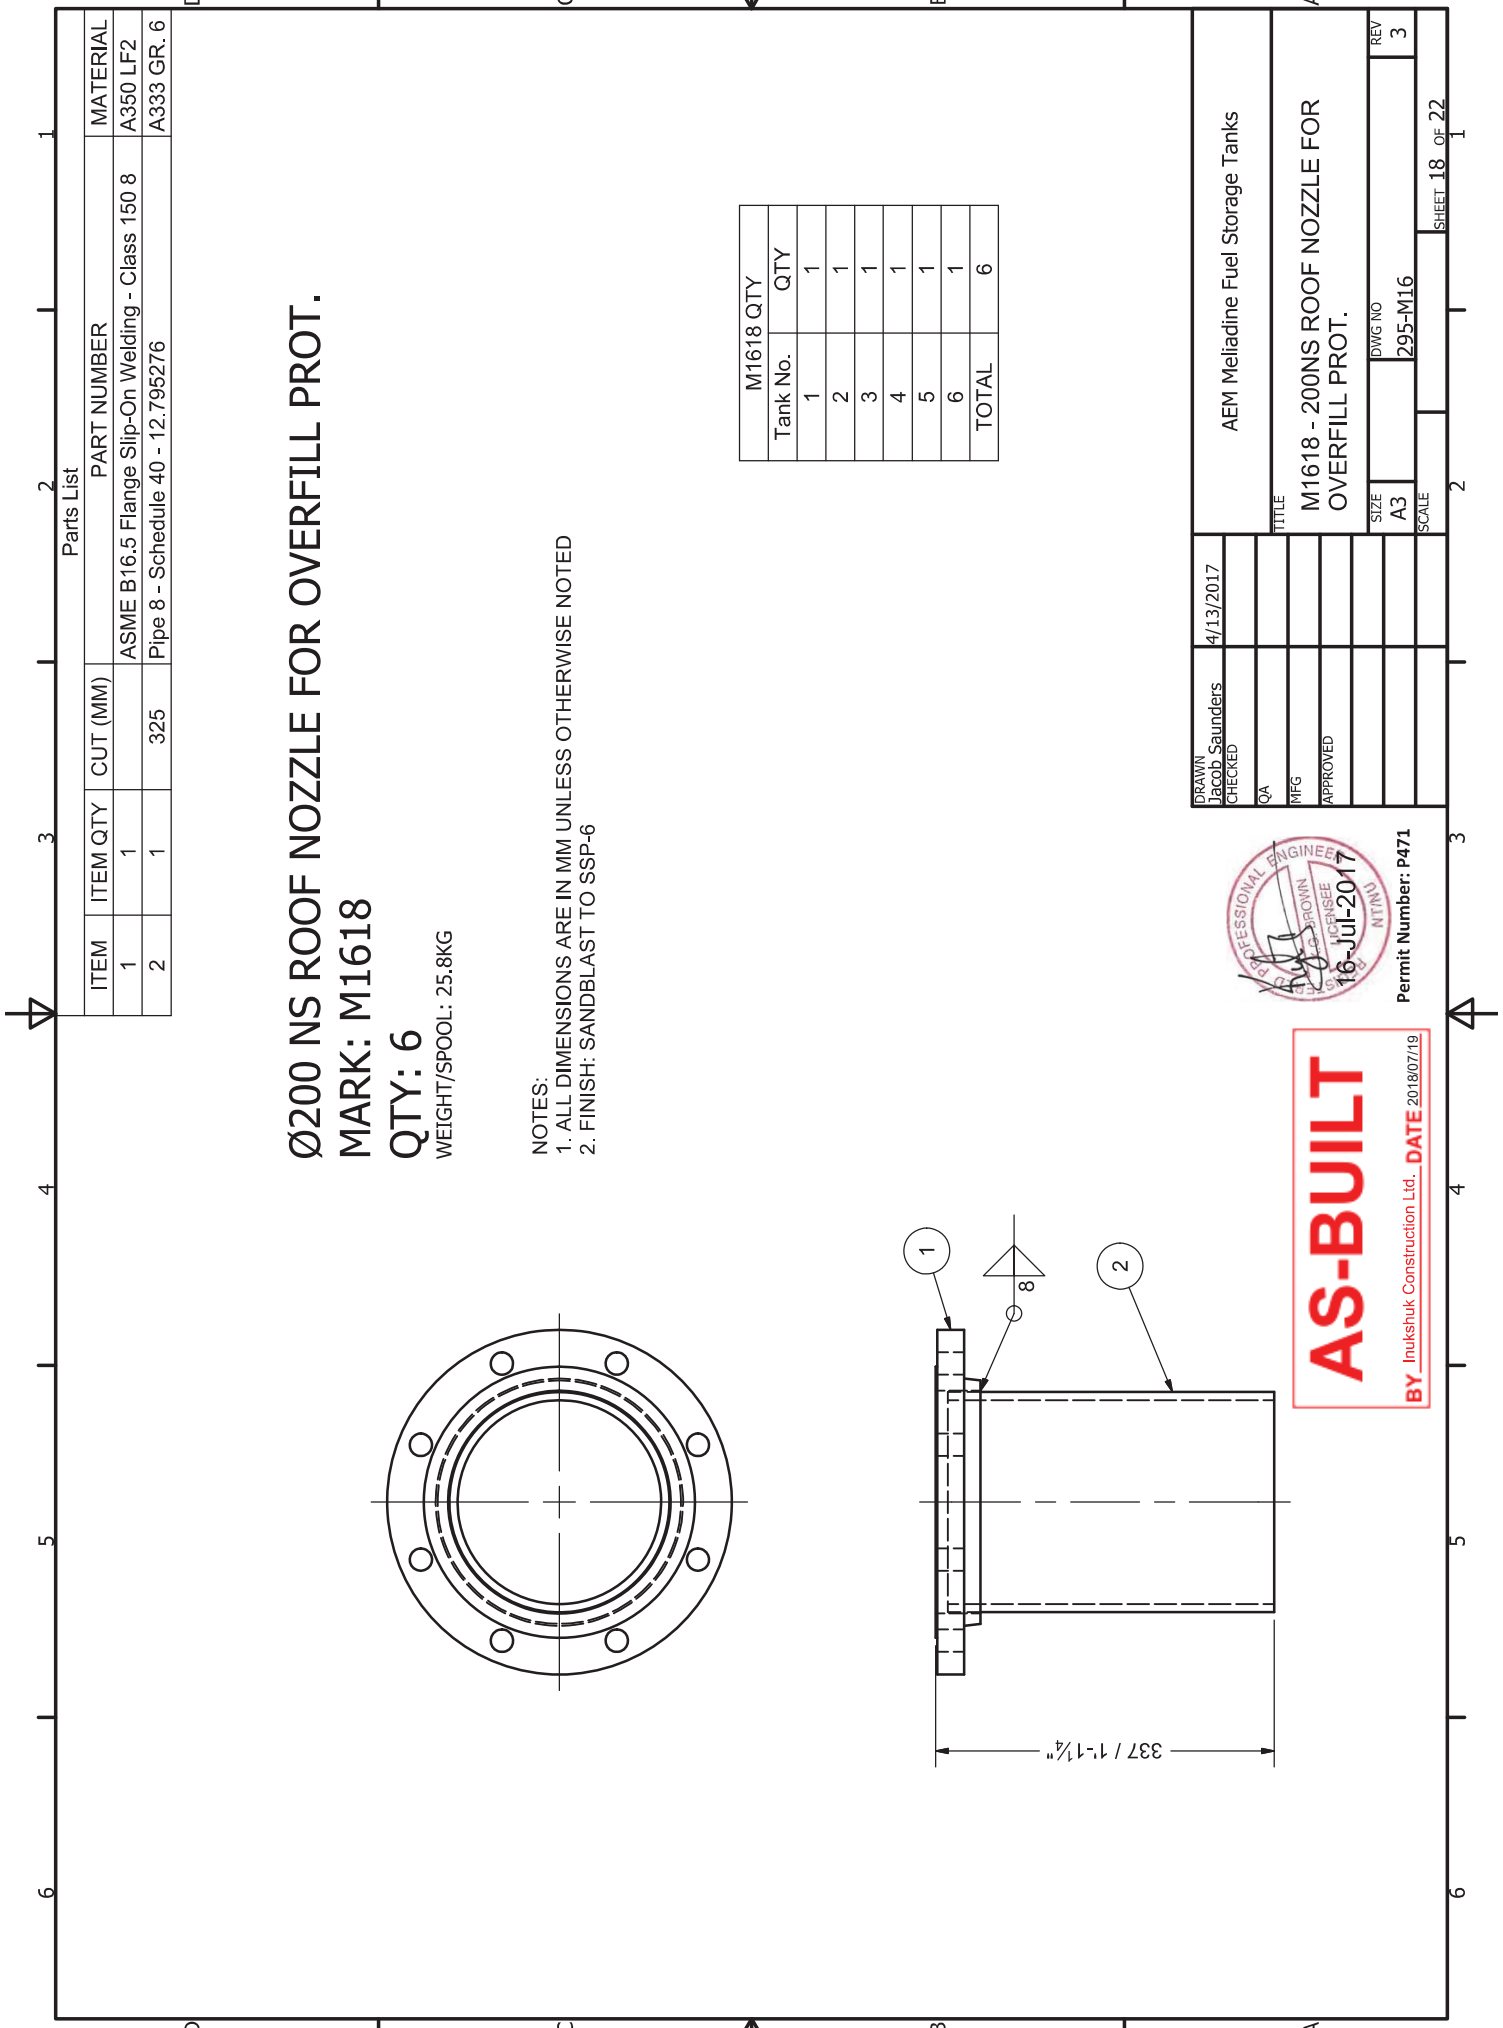

Ø200 NS ROOF NOZZLE FOR OVERFILL PROT.

MARK: M1618

QTY: 6

WEIGHT/SPOOL: 25.8KG

NOTES:

- 1. ALL DIMENSIONS ARE IN MM UNLESS OTHERWISE NOTED
- 2. FINISH: SANDBLAST TO SSP-6

M1618 QTY	
Tank No.	QTY
1	1
2	1
3	1
4	1
5	1
6	1
TOTAL	6




AS-BUILT

BY Inukshuk Construction Ltd. DATE 20190719

Permit Number: P471

DRAWN Jacob Saunders	4/13/2017	AEM Meliadine Fuel Storage Tanks	
CHECKED			
QA		TITLE	
MFG		M1618 - 200NS ROOF NOZZLE FOR OVERFILL PROT.	
APPROVED			
		SIZE A3	DWG NO 295-M16
		SCALE	REV 3
			SHEET 18 OF 22

ITEM	ITEM QTY	CUT (MM)	PART NUMBER	MATERIAL
1	1		ASME B16.5 Flange Slip-On Welding - Class 150 8	A350 LF2
2	1	325	Pipe 8 - Schedule 40 - 12.795276	A333 GR. 6

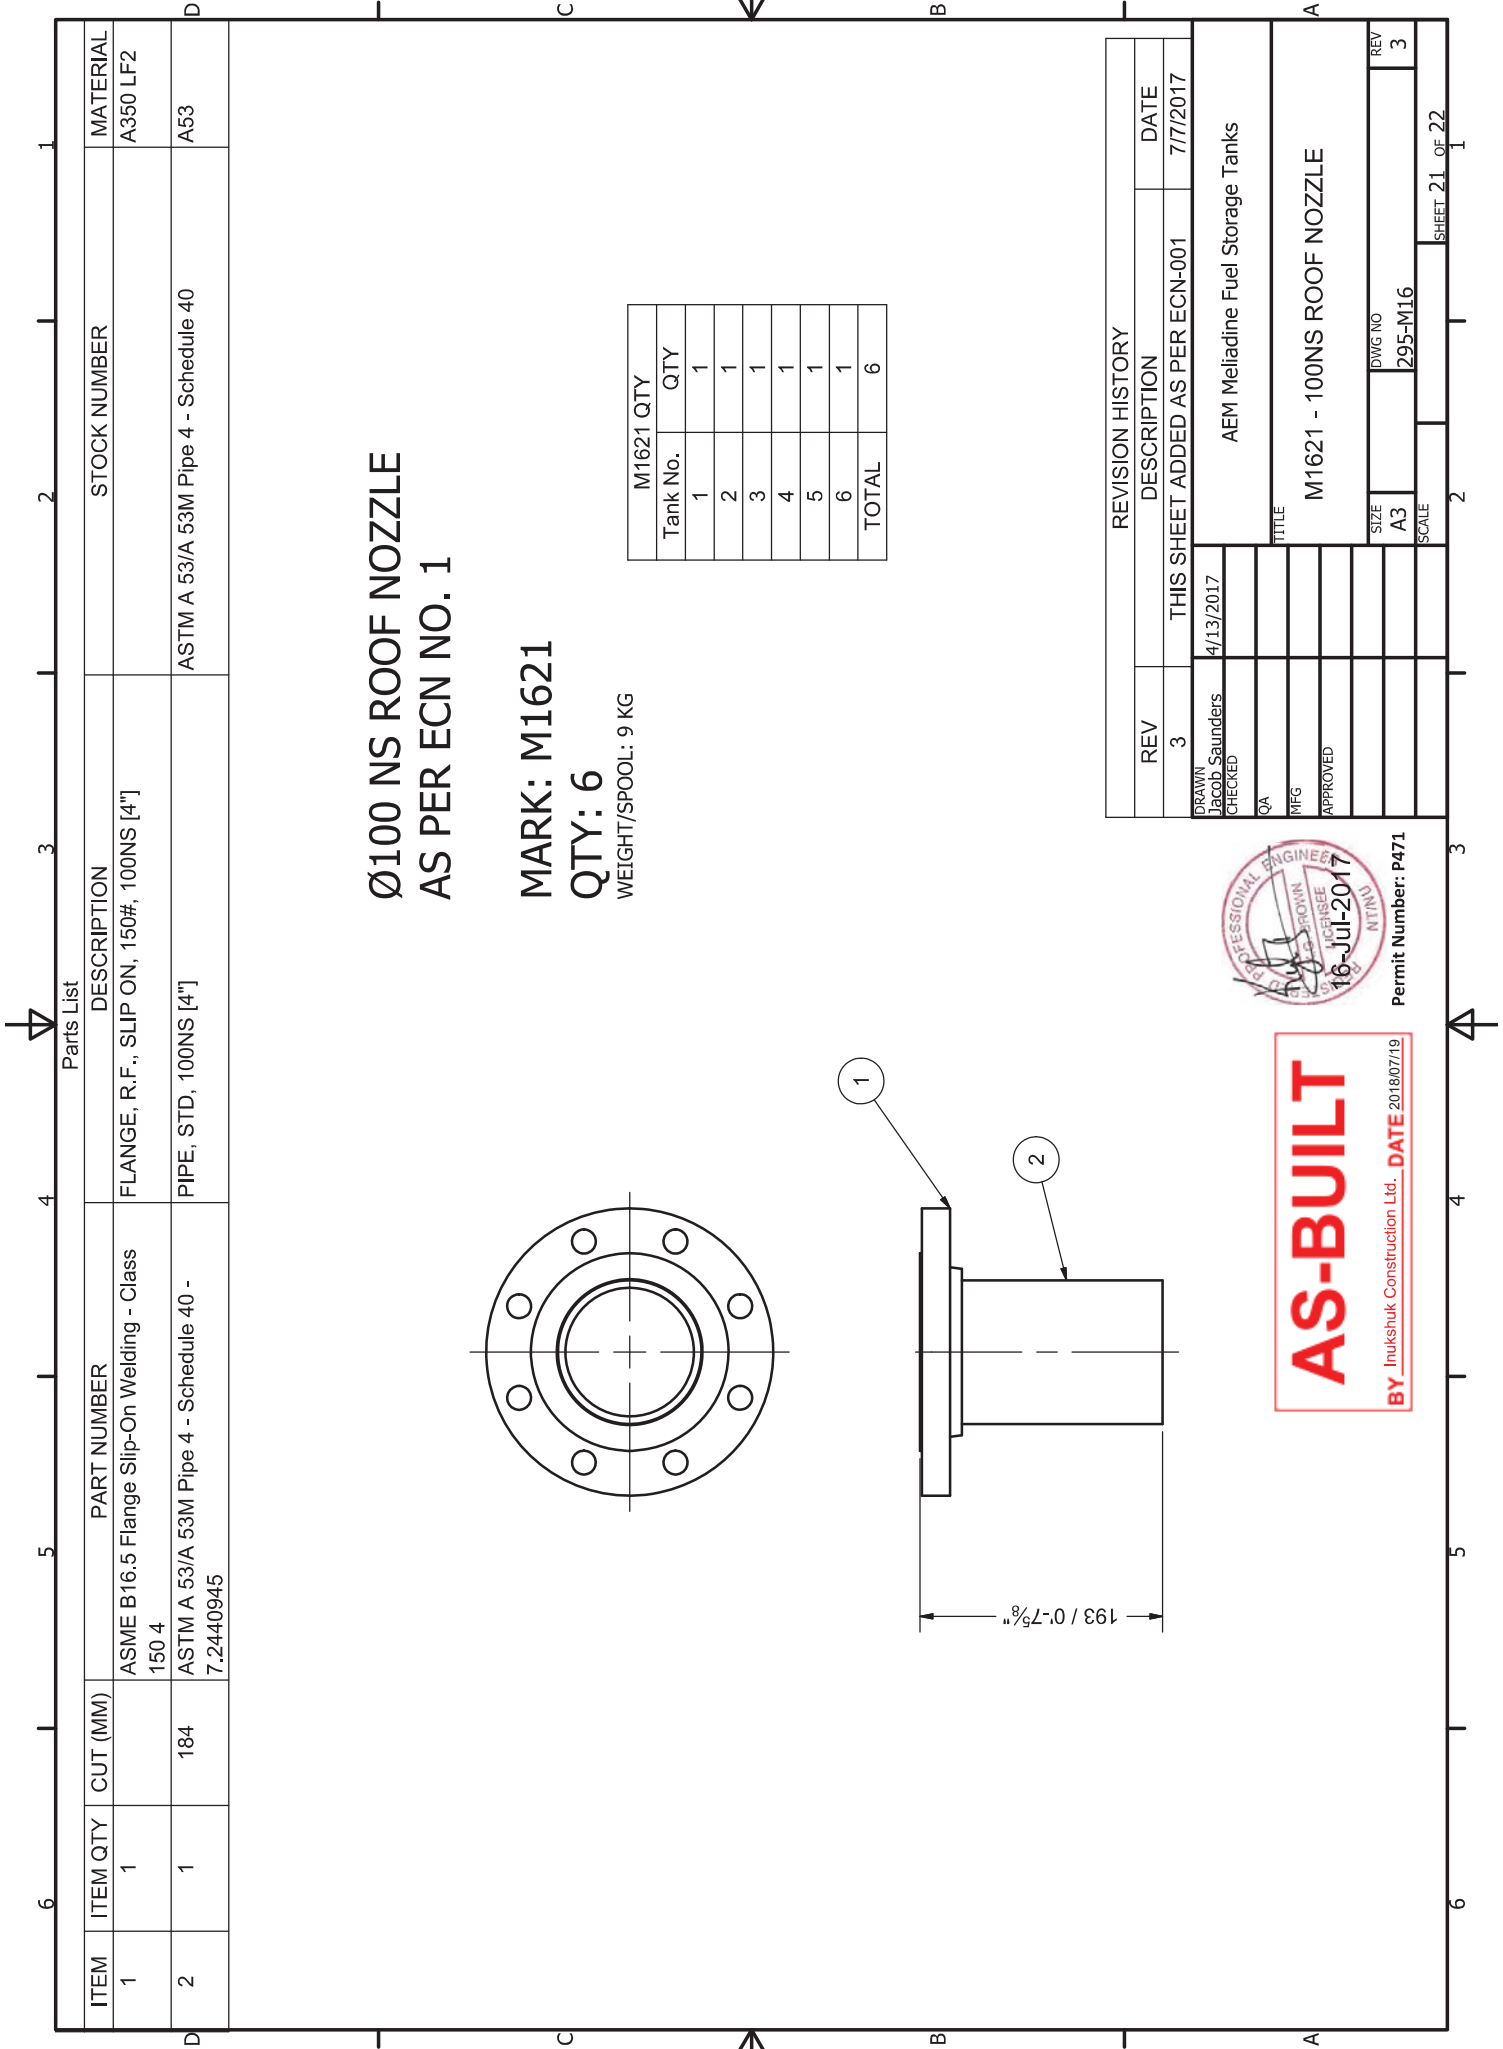

Ø100 NS ROOF NOZZLE
AS PER ECN NO. 1

MARK: M1621
QTY: 6
WEIGHT/SPOOL: 9 KG

M1621 QTY	
Tank No.	QTY
1	1
2	1
3	1
4	1
5	1
6	1
TOTAL	6

REVISION HISTORY		
REV	DESCRIPTION	DATE
3	THIS SHEET ADDED AS PER ECN-001	7/7/2017
DRAWN Jacob Saunders	4/13/2017	
CHECKED		
QA		
MFG		
APPROVED		
AEM Meliadine Fuel Storage Tanks		
TITLE		
M1621 - 100NS ROOF NOZZLE		
SIZE A3	DWG NO 295-M16	REV 3
SCALE		SHEET 21 OF 22



AS-BUILT

BY Inukshuk Construction Ltd. DATE 20180719

Permit Number: P471



SHOP DRAWING
DATA SHEET

Affixing this stamp confirms that an administrative approval and/or a verification of compliance with shop drawings or specifications was made, but does not entail the liability of the author of the work or its owner. The responsibility remains with the contractor, for which the contractor is the sole responsible.

☒ Reviewed

☐ Rejected

☐ Reviewed as noted

☐ Filed for records

The contractor, supplier and/or sub-contractor is responsible for ensuring that all shop drawings, quantities and dimensions are correct and that all processes and techniques of construction, coordinating his or her work with that of all other trades and performing all work in a safe and satisfactory manner.

By: J. morliere



Date: 2017/07/14

Project #: 151-0640-40

PIPE SUPPORT TYPE 1

MARK: M17101

QTY: 72

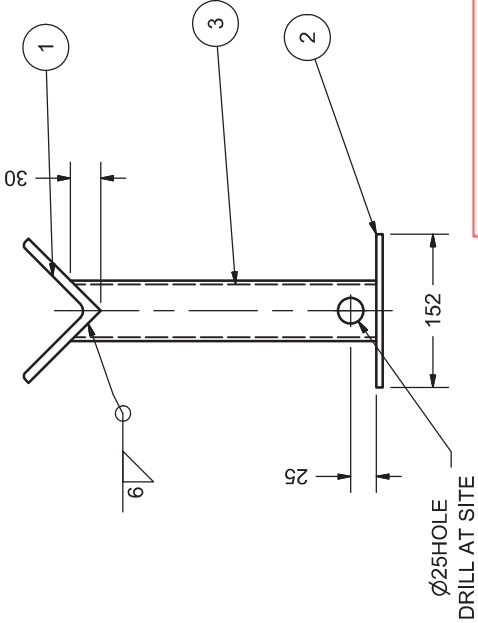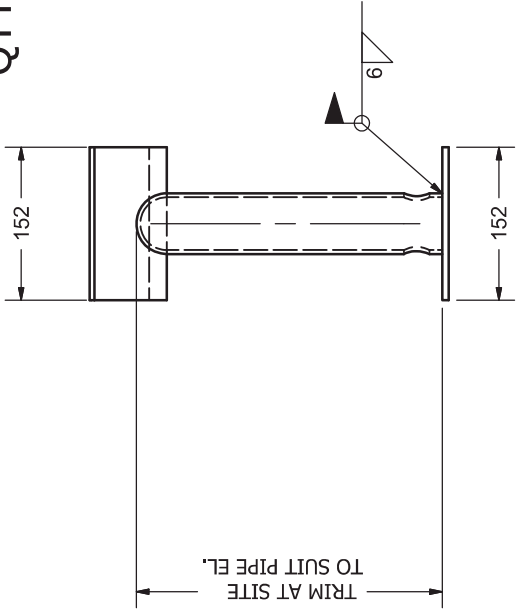

QTY PER TANK	
Tank No.	QTY
1	20
2	16
3	12
4	12
5	6
6	6
TOTAL	72

PIPE SUPPORT
SCALE 1/5

AS-BUILT


BY Inukshuk Construction Ltd. DATE 2018/07/19



Permit Number: P471

DRAWN Jacob Saunders CHECKED QA MFG APPROVED	4/13/2017	PIPE SUPPORT	
		TITLE	
		MISC. SUPPORTS AND BRACKETS	
		SIZE A3	DWG NO 295-M17
		SCALE	REV 2
			SHEET 1 OF 5

NOTE:
ALL DIMENSIONS ARE IN MM UNLESS OTHERWISE NOTED

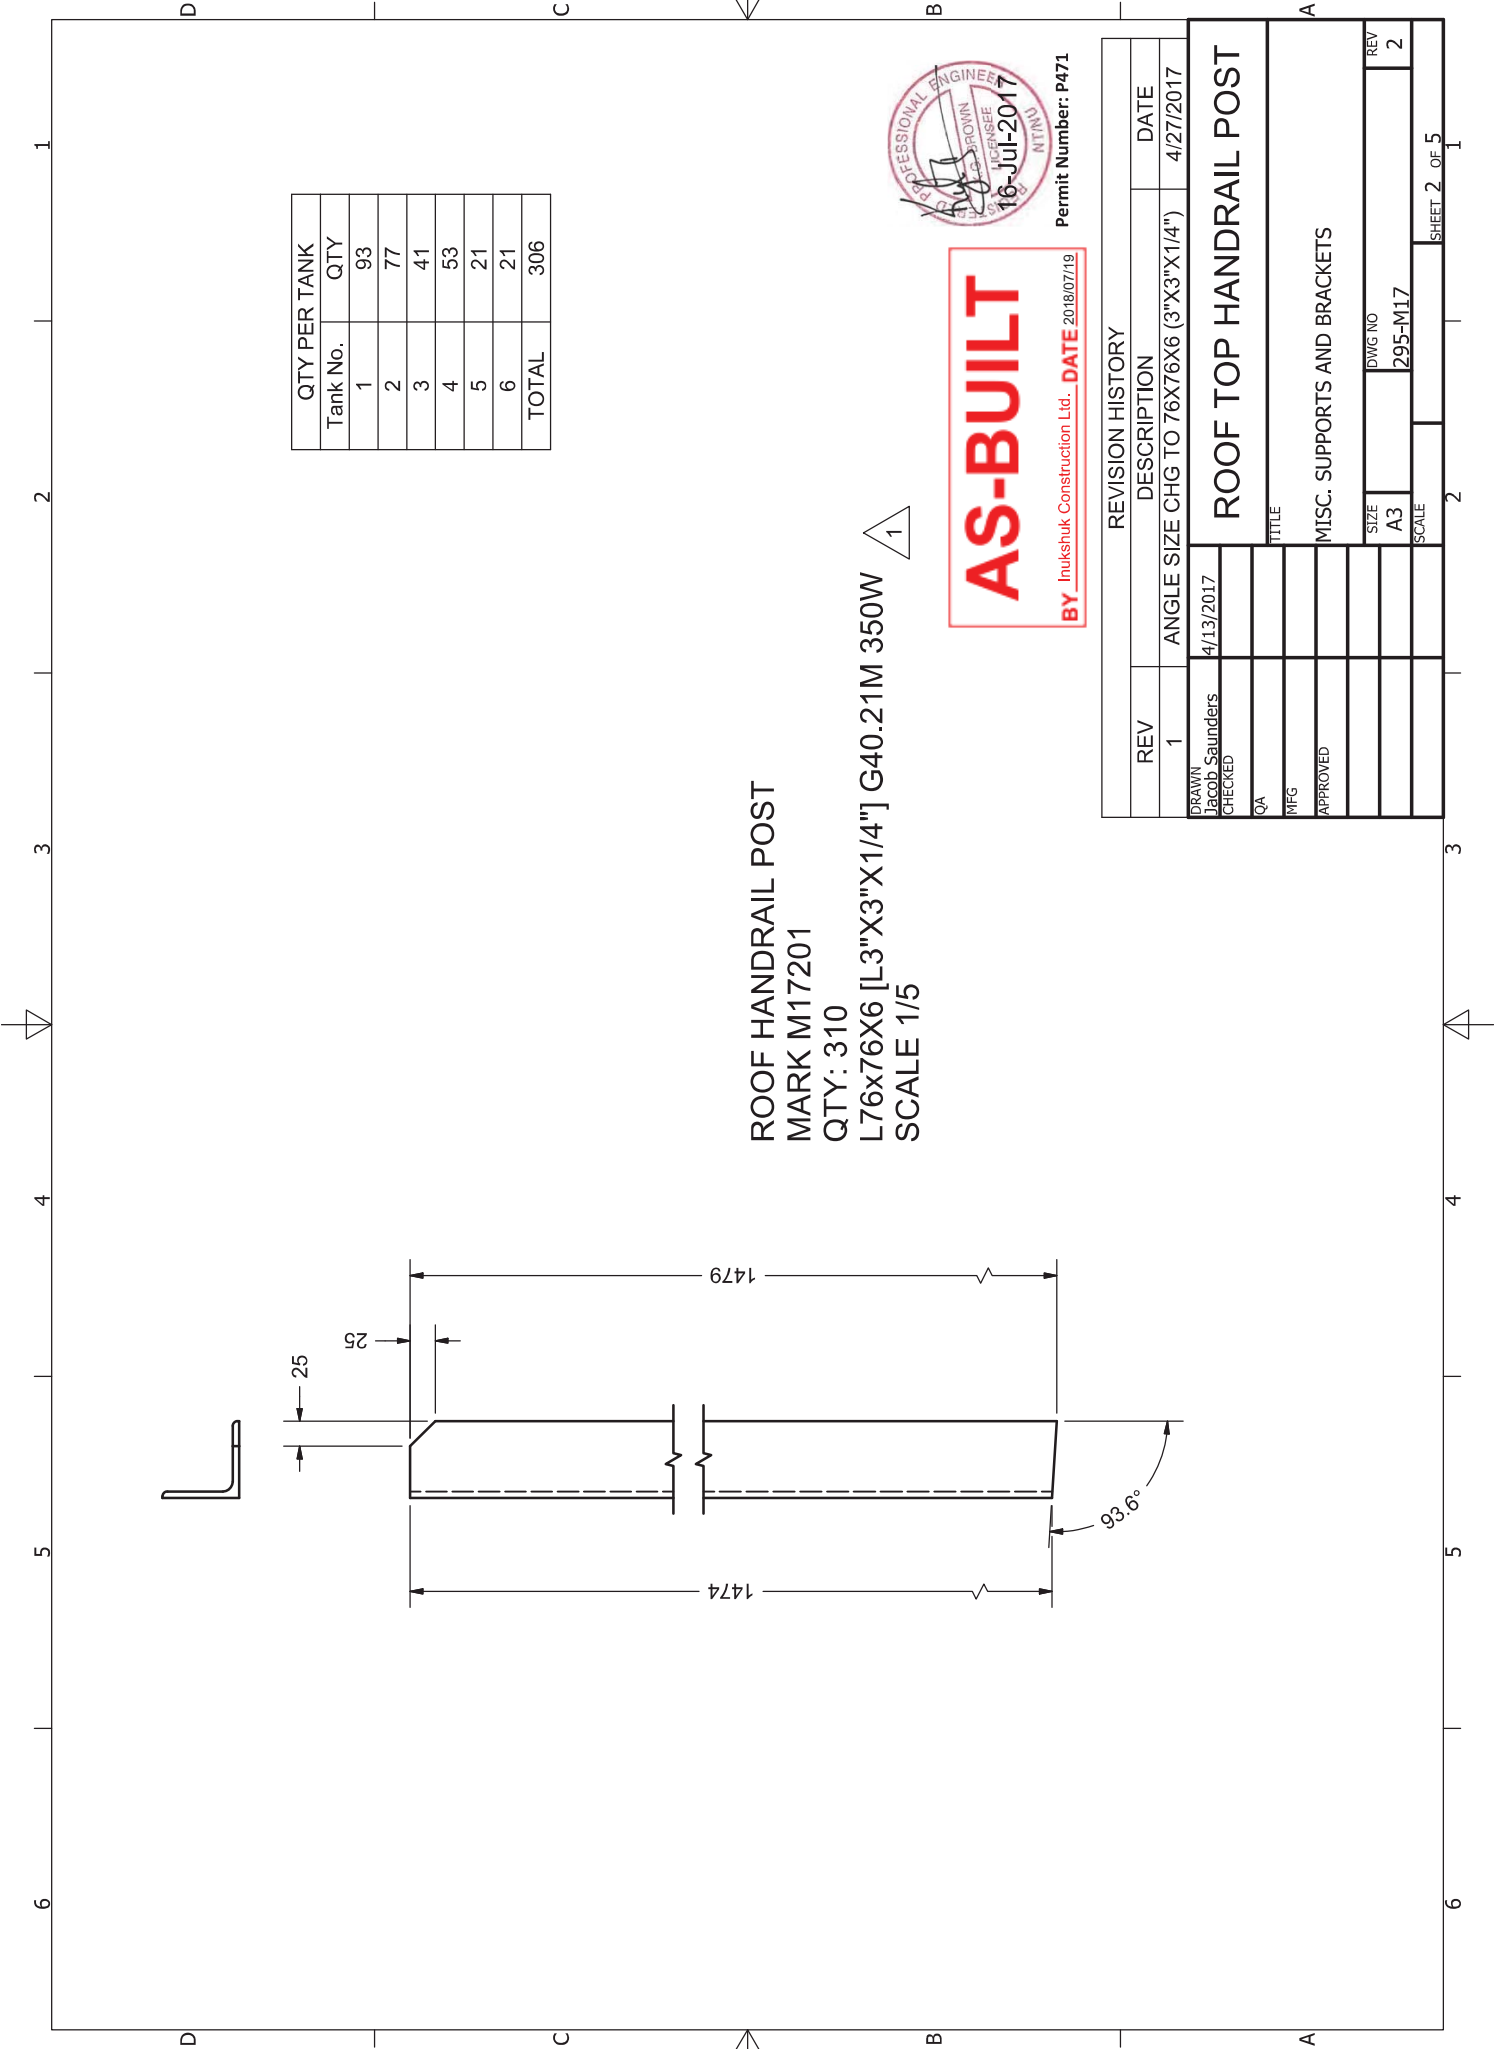

ROOF HANDRAIL POST
MARK M17201
QTY: 310
L76x76X6 [L3"X3"X1/4"] G40.21M 350W
SCALE 1/5




AS-BUILT
BY Inukshuk Construction Ltd. DATE 2018/07/19
Permit Number: P471



QTY PER TANK	
Tank No.	QTY
1	93
2	77
3	41
4	53
5	21
6	21
TOTAL	306

REVISION HISTORY			
REV	DESCRIPTION	DATE	
1	ANGLE SIZE CHG TO 76X76X6 (3"X3"X1/4")	4/27/2017	
DRAWN	4/13/2017		
Jacob Saunders			
CHECKED			
QA			
MFG			
APPROVED			
TITLE			
ROOF TOP HANDRAIL POST			
MISC. SUPPORTS AND BRACKETS			
SIZE			
A3			
DWG NO			
295-M17			
SCALE			
2			
SHEET 2 OF 5			

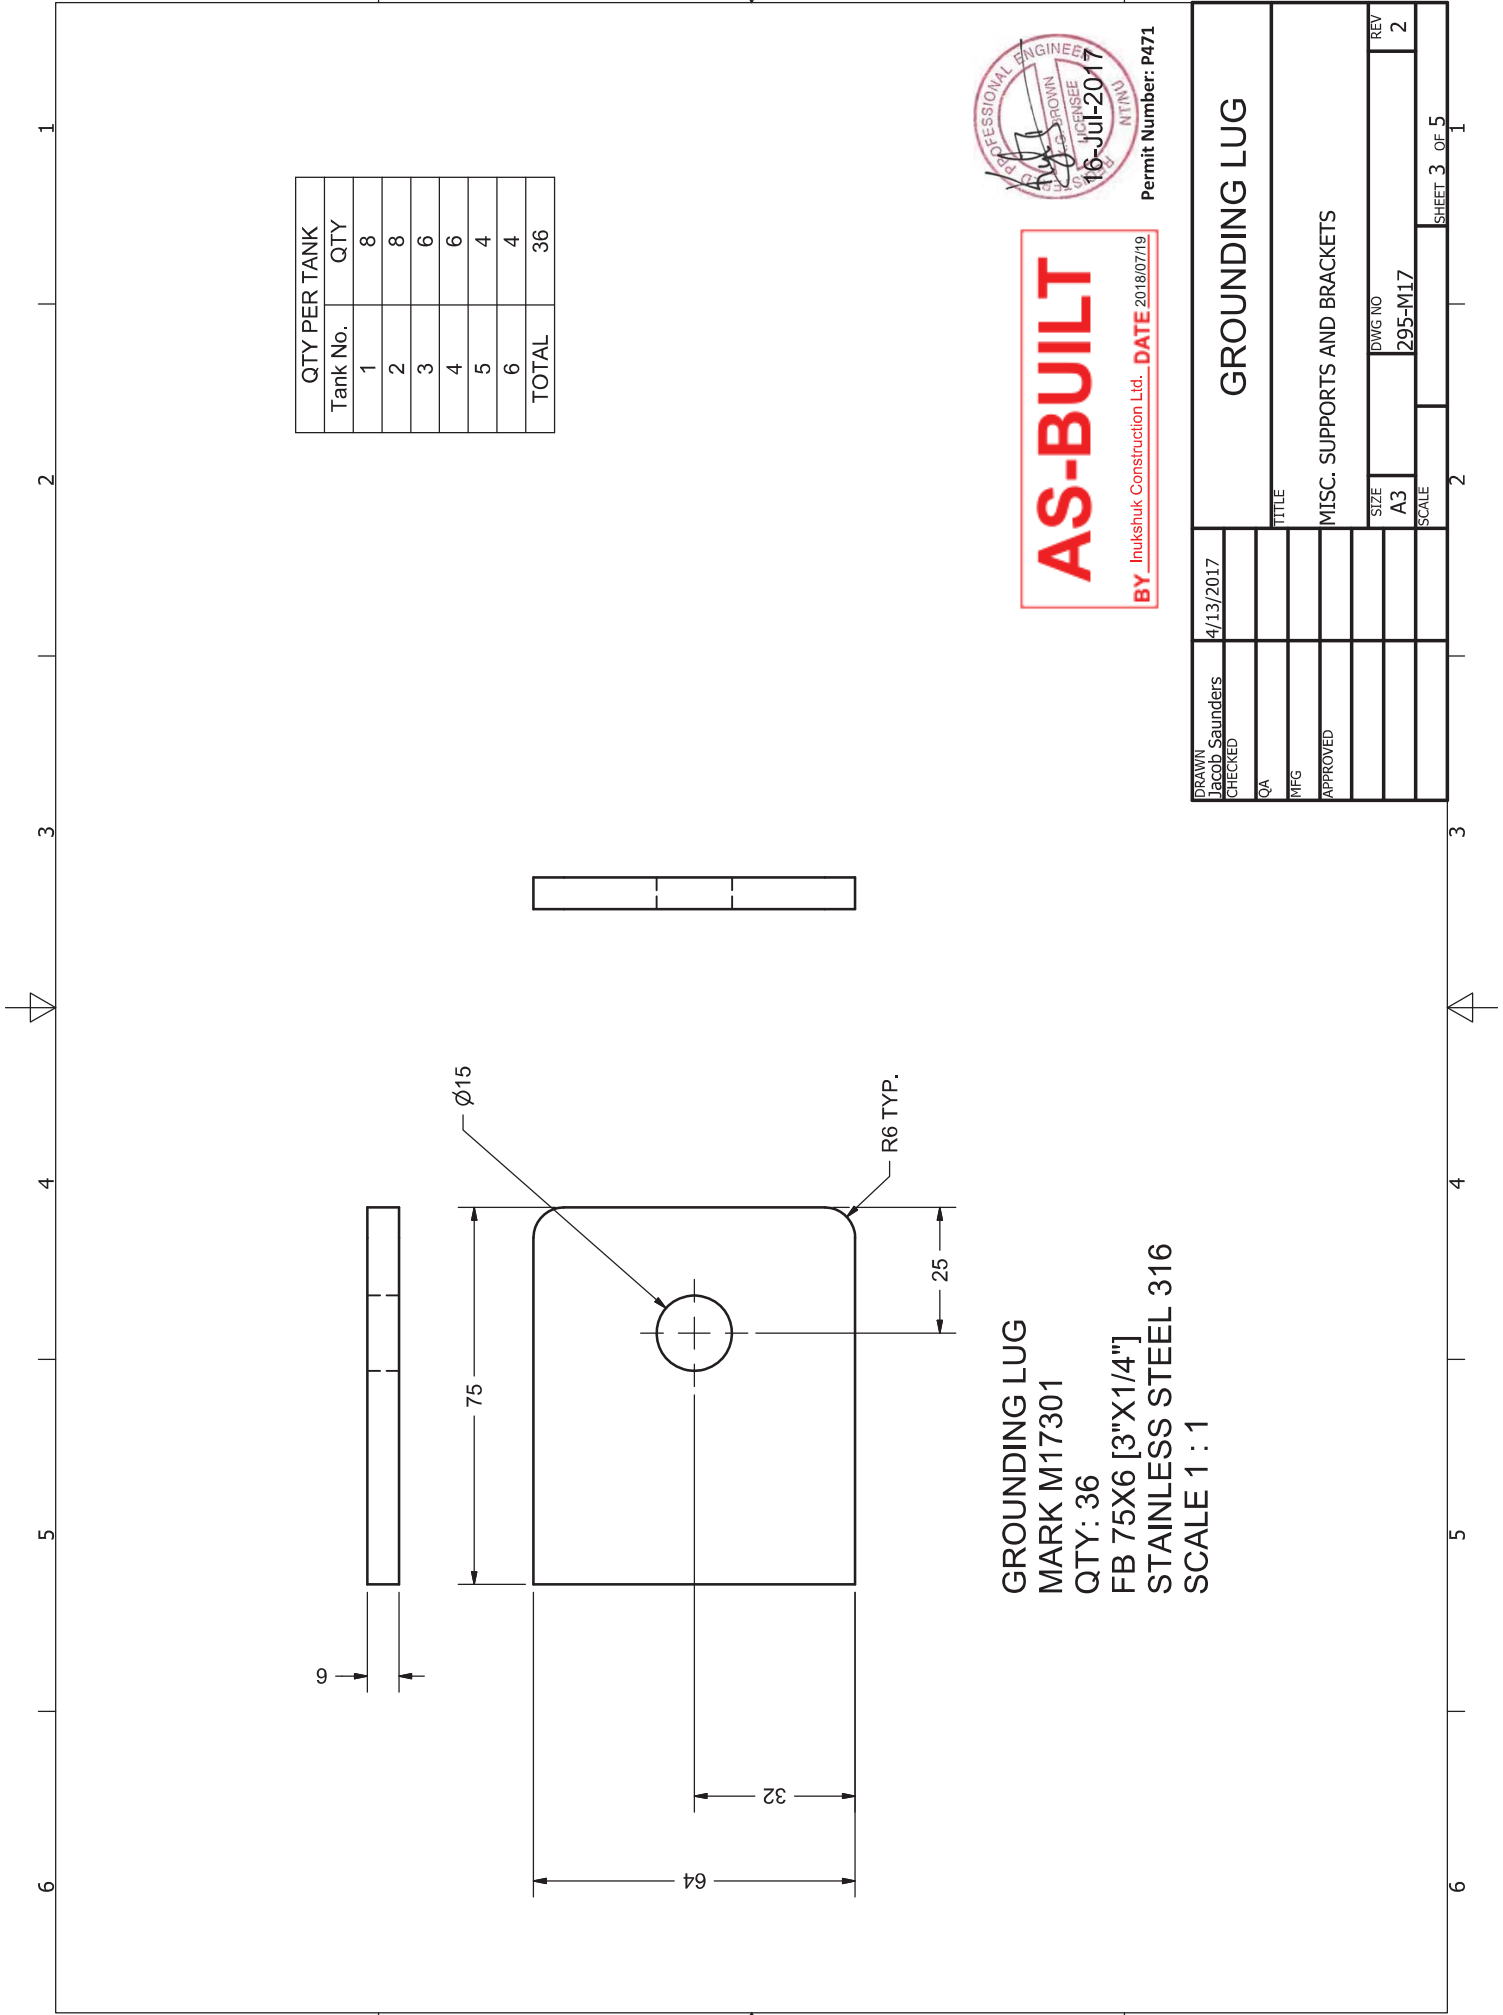

GROUNDING LUG
MARK M17301
QTY: 36
FB 75X6 [3"X1/4"]
STAINLESS STEEL 316
SCALE 1 : 1

QTY PER TANK	
Tank No.	QTY
1	8
2	8
3	6
4	6
5	4
6	4
TOTAL	36

AS-BUILT

BY Inukshuk Construction Ltd. DATE 2018/07/19



Permit Number: P471

DRAWN Jacob Saunders	4/13/2017	GROUNDING LUG	
CHECKED		TITLE	
QA		MISC. SUPPORTS AND BRACKETS	
MFG		SIZE	
APPROVED		A3	
		DWG NO	
		295-M17	
		REV	
		2	
		SCALE	
		SHEET 3 OF 5	

6										5										4										3										2										1																																																											
CUT LIST										DESCRIPTION										MATERIAL										UNIT QTY PER TANK																																																																															
MARK										QTY										CUT MM										L100X100X6 [L4"X4"X1/4"] TEMPERATOR SENSOR										G40.21M 350W										TK #1										TK #2										TK #3										TK #4										TK #5										TK #6									
M17401										6										400																				1										1										1										1										1										1										1									
M17402										45										400										L75X75X6 [L3"X3"X1/4"] PIPING & ELECTRICAL BRACKET										G40.21M 350W										14										14										6										7										2										2									

<

AS-BUILT


BY Inukshuk Construction Ltd. DATE 2018/07/19

Permit Number: P471



DRAWN Jacob Saunders	4/13/2017	MISC BRACKETS	
CHECKED			
QA		TITLE	
MFG			
APPROVED		MISC. SUPPORTS AND BRACKETS	
		SIZE	DWG NO
		A3	295-M17
		SCALE	REV
			2
		SHEET 4 OF 5	

Parts List						1	
ITEM	ITEM QTY	CUT (MM)	PART NUMBER	DESCRIPTION	STOCK NUMBER	MATERIAL	
2	1	1230	AISC - L 3 x 3 x 3/8 - 48.426	Angle Steel	L 3 x 3 x 3/8	G40.21 350w	
3	1	914	AISC - C 6 x 8.2 - 36	U-Shape	C 6 x 8.2	G40.21 350w	
4	1	203	AISC - 6x1/4 - 8	Flat Bar Steel	6x1/4	G40.21 350w	
5	1	229	AISC - 6x1/4 - 9	Flat Bar Steel	6x1/4	G40.21 350w	

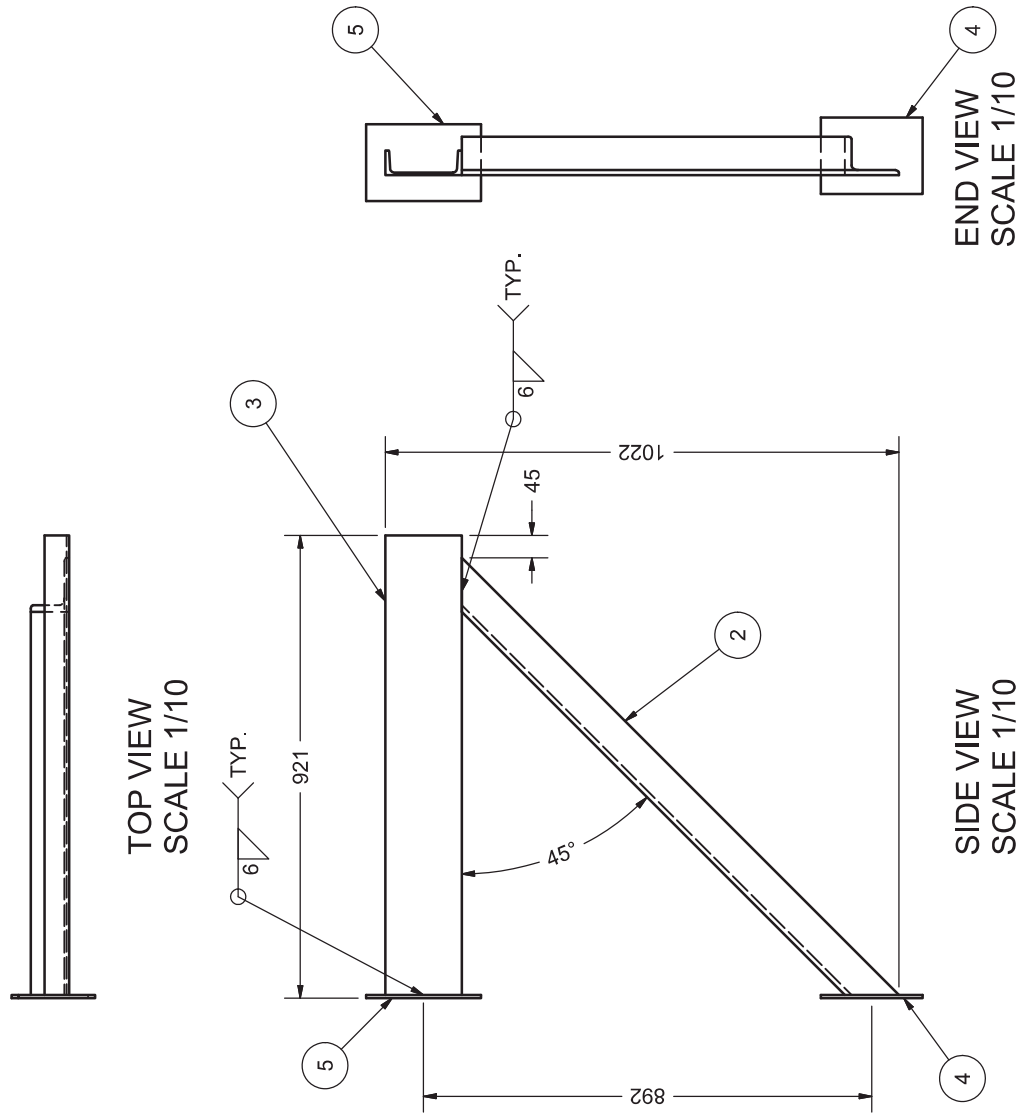

TOP VIEW
SCALE 1/10

SIDE VIEW
SCALE 1/10

END VIEW
SCALE 1/10

PIPE SUPPORT FOR 400NS
VENT SUPPORT FOR TANK NO. 1 & 2
MARK: M17501
QTY: 4
2 AS SHOWN
2 MIRROR

FINISH: SHOP SANDBLAST

AS-BUILT

BY Inukshuk Construction Ltd. DATE 2018/07/19

16-Jul-2017

Permit Number: P471

REVISION HISTORY		
REV	DESCRIPTION	DATE
2	THIS SHEET ADDED	7/7/2017
DRAWN	4/13/2017	
Jacob Saunders		
CHECKED		
QA		
MFG		
APPROVED		
TITLE		
MISC. SUPPORTS AND BRACKETS		
	SIZE	DWG NO
	A3	295-M17
	SCALE	
	2	
	SHEET 5 OF 5	

6

5

4

3

PARTS LIST FOR ONE (1) ASSY, TWO (2) PER TANK, FOUR (4) REQUIRED

ITEM	ITEM QTY	CUT (MM)	DESCRIPTION	MATERIAL
M18201	1	295	3/8"THK X 62 WIDE PLATE, SEE DETAIL	G40.21M 300W
M18202	1	373	2 1/2" STD PIPE	A53
M18203	1		DAVIT ARM, SEE DETAIL	
M18204	1	198	10 [3/8"] DIA LG SEE DETAIL	Steel
M18205	1		EYE-BOLT 3/8"DIA X 8" LG Crosby G-291	FORGED STEEL
M18206	2		3/8"-16UNC Hex Nuts (Inch Series) Heavy Hex Nut	A194 GR4

FINISH: SANDBLAST TO SSPC-6

MANHOLE 760MM [32"] REF.

M18203

3

3

3

3

45°

(10)

3

TO MANHOLE FLANGE

645 [25 3/8]

76 [3]

M18205

M18206

M18204

Ø984 REF. [Ø38 3/4]

10

TYP. TO COVER

M18201

M18202

373 [14 11/16]

AS-BUILT

BY Inukshuk Construction Ltd. DATE 2018/07/19

PROFESSIONAL ENGINEER
L. J. BROWN
10-Jan-2018
NTNT

DAVIT ASSEMBLY

QTY: 4

MARK M18200

SCALE 1/20

62 [2 1/16]

10 [3/8]

R492 [R19 3/8]

295 [1 15/8]

52 [2 1/16]

24 [1 5/16]

Ø10 [Ø3 3/8]

38 [1 1/2]

57 [2 1/4]

10

10

Pc M18201 DETAIL

QTY: 4

SCALE 1/10

Pc M18104 DETAIL

SCALE 1/4

6

5

4

3

PARTS LIST FOR ONE (1) DAVIT ARM, 2 PER TANK, FOUR (4) REQ'D

ITEM	ITEM QTY	CUT (MM)	DESCRIPTION	MATERIAL
M18208	1	569	2"NS XH PIPE	A53
M18209	1	25	2 1/2"NS STD PIPE	A53
M18210	1		2"NS XH ELBOW BW 90DEG L.R.	A234
M18211	1	787	2"NS XH PIPE	A53
M18212	1	520	FB10X50 [3/8"X2"]	G40.21M 300W

76 [3]

Ø19 [Ø3/4]

645 [25 3/8]

569 [22 3/8]

247 [9 3/4]

10

10

TYP.

Pc M18203 DETAIL

DAVIT ARM

QTY: 4

SCALE 1/10

760MM [32"] NS FOR TK 5&6

TITLE

MANHOLE COVER DAVIT

SIZE A3

DWG NO 295-M18

SCALE

2

1

4/13/2017

MARC LOSIER


QA

MFG

APPROVED

REV

MARK	QTY.	DESCRIPTION	MATERIAL	MTR	WT #3
1	1	CG0.15" x 3'-4" LG (CR)	G40.21-300W	C	—
2	1	CG0.15" x 3'-4" LG (CR)	G40.21-300W	C	—
3	1	CG0.15" x 2'-8" LG (CR)	G40.21-300W	C	—
4	1	CG0.15" x 2'-8" LG (CR)	G40.21-300W	C	—
5	2	3/8" x 3" x 5" ANGLE x 2'-11 1/8" LG (CR)	G40.21-300W	C	—
6	4	3/8" THK x 3" x 5"	G40.21-260W	C	—
7	16	1/4" THK x 6" x 10" C/W R ² RADIUS CORNERS	G40.21-260W	C	—
8	2	5/8" x 1 3/4" LG HEX HD BOLT 5/8" (1) NUT & LOCK WASHER AND (2) FLAT WASHERS	A325 GALV	C	—
9	2	3/8" x 3" x 5" ANGLE x 3'-1 1/8" LG (CR)	G40.21-300W	C	—
10	2	1/4" THK x 5' 3/4" SEE DETAIL	G40.21-260W	C	—
11	4	1/4" THK x 6" x 6"	G40.21-260W	C	—


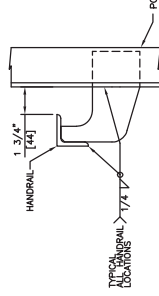


TYPICAL HANDRAIL DETAIL

****HANDRAIL LOCATED ON OUTSIDE ONLY -- BOLTED TO PLATFORM**

****ALL GRATING TO BE SECURED TO PLATFORM FRAME USING SADDLE CLIPS (BOLTED).**

PLATFORM IS CAPABLE OF SUPPORTING A MOVING CONCENTRATED LOAD OF 1000LBS, AND HANDRAIL LOAD OF 200LBS IN ANY DIRECTION.

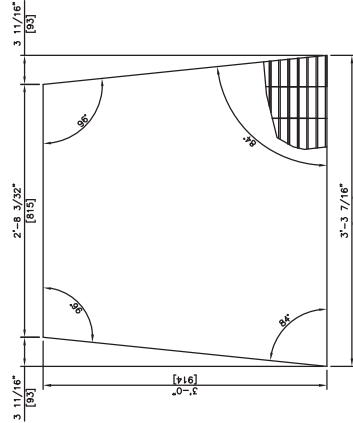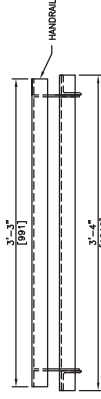

MARK 2 - RIGHT HAND SHOWN
LEFT HAND OPPOSITE

BY Inukshuk Construction Ltd. DATE 2018/07/19

ANCO EAGLE MINES LIMITED - MELBORNE PROJECT									
DATE	TIME	BY	FOR	REASON	ISSUED FOR	ISSUED BY	ISSUED FOR	ISSUED BY	ISSUED FOR
0	5-MAY-17	ME	VB	ISSUED FOR CONSTRUCTION					
1	17-APR-17	ME	VB	ISSUED FOR APPROVAL					
2		ME	VB	ISSUED FOR APPROVAL					
3		ME	VB	ISSUED FOR APPROVAL					
56		ME	VB	ISSUED FOR					


NOTE: MARK 3 IS PLACED SAME SIDE AS STAIR.

[illegible]

BILLING FOR ONE TANK SHOWN. TWO REQUIRED



②

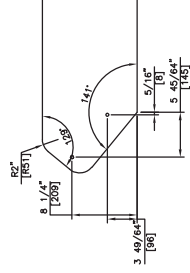

TOP

[illegible]

BY Inukshuk Construction Ltd. DATE 2018/07/19

10-Jan-2018

NOTE: MARK 3 IS PLACED SAME SIDE AS STAIR.

[illegible][illegible]

10-Jan-2018

SECTION B



[illegible]

Permit Number: P471


BILL OF MATERIALS

MARK	QTY.	DESCRIPTION	MATERIAL	MTR	WT #
1	1	62610.54 x 3'-4" LG (CSE)	62610.54	1	1
2	2	62610.54 x 3'-1 1/2" LG (CSE)	62610.54	2	2
3	1	62610.54 x 2'-8 5/8" LG (CSE)	62610.54	1	1
4	1	3/8" x 3" x 3" ANGLE x 2'-11 11/16" LG (CSE)	62610.54	1	1
5	2	3/8" THK x 3" x 5"	62610.54	2	2
6	4	1/4" THK x 6" x 10" 2" RADIUS CORNERS	62610.54	4	4
7	20	5/8" x 1 3/4" LG HEX HD BOLT c/w (1) NUT & WASHER	62610.54	20	20
8	2	LOCK WASHER	62610.54	2	2
9	4	1/4" THK x 5" x 5 3/4" SEE DETAIL	62610.54	4	4


BILLING FOR ONE TANK SHOWN, TWO (2) REQUIRED

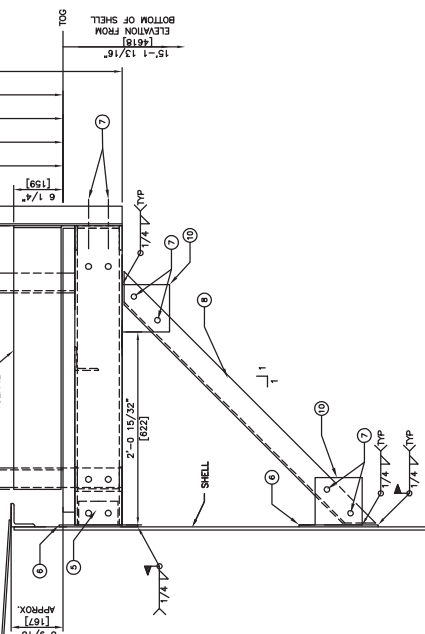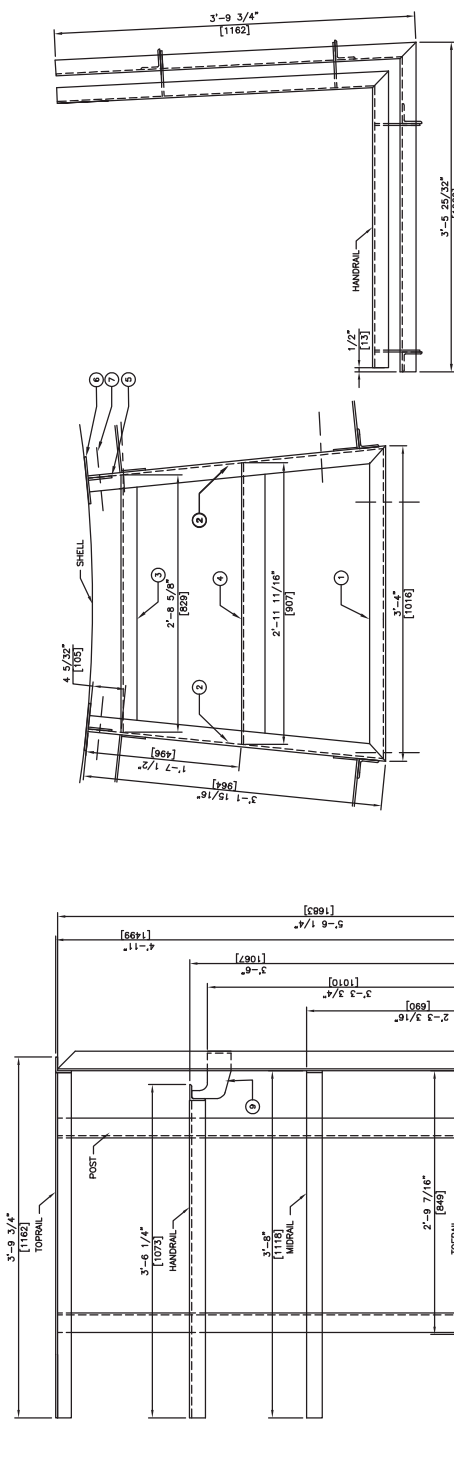

PLATFORM ELEVATION DETAIL

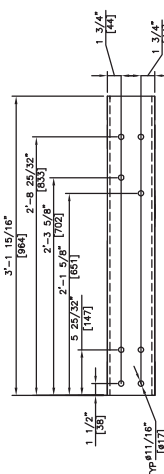

MARK 2 - RIGHT HAND SHOWN
LEFT HAND OPPOSITE

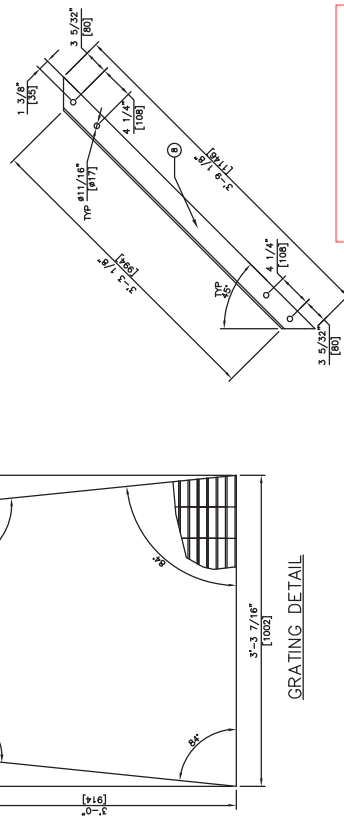

TYPICAL HANDRAIL/POST DETAIL

TYPICAL HANDRAIL DETAIL

TOPRAIL - 1/4" x 2" x 2" ANGLE
HANDRAIL - 1/4" x 2" x 2" ANGLE
MERRAIL - 1/4" x 2" FLATBAR
TOSRAIL - 1/4" x 2" FLATBAR
POST - 1/4" x 2" x 2" ANGLE
GRATING - 19-W-4 1 1/2" DEEP x 3/16"
GALVANIZED SERRATED BAR GRATING

**HANDRAIL LOCATED ON OUTSIDE ONLY - BOLTED TO PLATFORM
**ALL GRATING TO BE SECURED TO PLATFORM FRAME USING SADDLE CLIPS (BOLTED)
FIELD TO TRIM HANDRAIL OVER TANK ROOF TO MATE WITH PERIMETER HANDRAIL
FIELD TO TRIM HANDRAIL OVER TANK ROOF TO MATE WITH PERIMETER HANDRAIL
PLATFORM IS CAPABLE OF SUPPORTING A MOVING CONCENTRATED LOAD OF 1000LBS.
AND HANDRAIL END OF JOINTS IN ANY DIRECTION.

AS-BUILT
BY: Inshukh Construction Ltd. DATE: 20180719






Permit Number: P471

SUB-ARC SYSTEMS INC.	
PROJECT NO.	6515
TANK TAG: TK #5 & #6	17-03-5-005
DATE: 17-03-5-005	17-03
REVISIONS	
DATE	DESCRIPTION
0	5-MAY-17 ME IG ISSUED FOR CONSTRUCTION
1	17-APR-17 ME IG ISSUED FOR APPROVAL
2	3/4" = 1'-0"
3	17-APR-17

[illegible]

BILLING FOR ONE TANK SHOWN. FOUR (4) REQUIRED

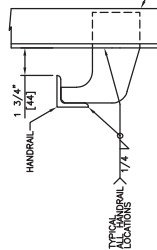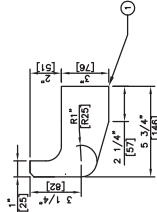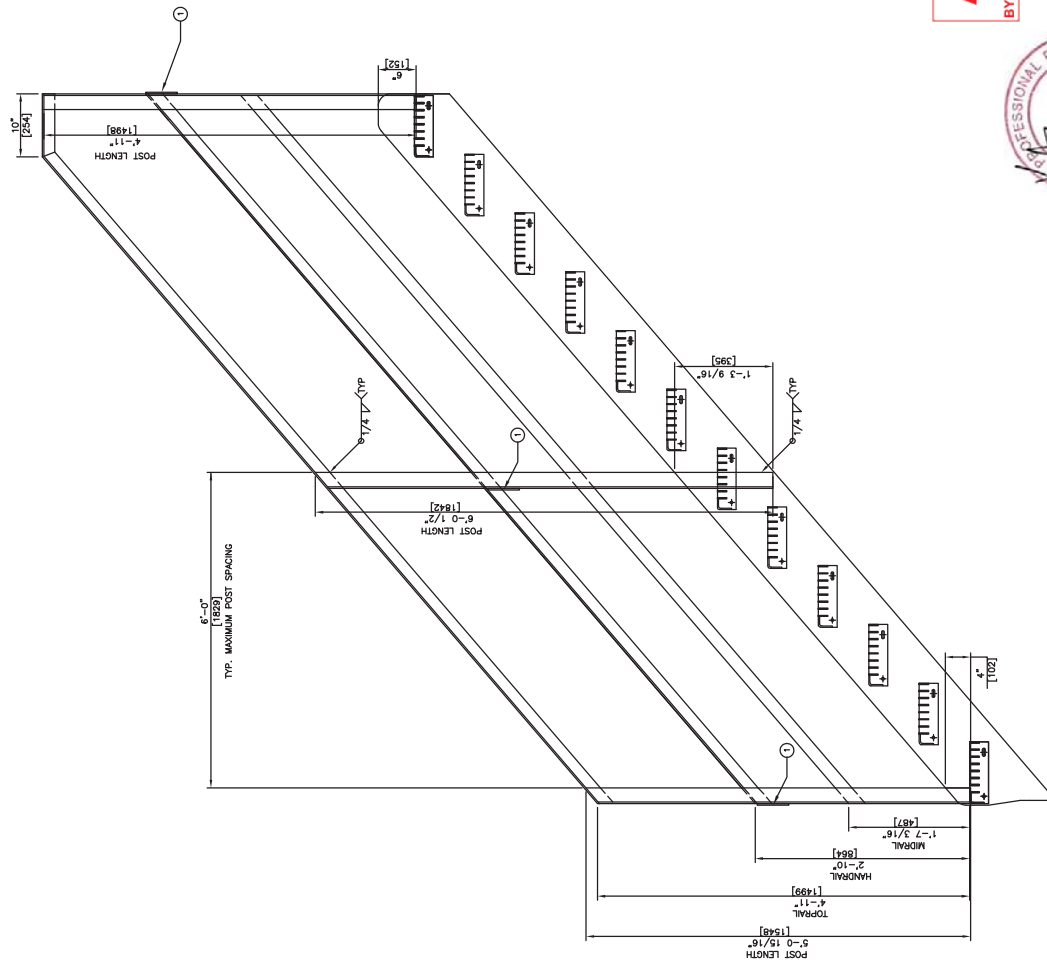

TYPICAL HANDRAIL/POST DETAIL

TYPICAL HANDRAIL DETAIL

TOPRAIL - 1/4" x 2" x 2" ANGLE
HANDRAIL - 1/4" x 2" x 2" ANGLE
MIDRAIL - 1/4" x 2" FLATBAR

POST - 1/4" x 2 1/2" x 2 1/2" ANGLE
POST SHALL BE SQUARE TO THE STAIR HOLES
1 POST AT EACH END, 2 POSTS EQUAL SPACE ON STRINGER

QUANTITY OF STAIRS IS FOR DEMONSTRATION ONLY.

STAIRS ARE CAPABLE OF SUPPORTING A MOVING CONCENTRATED LOAD OF 1000LBS. AND HANDRAIL LOAD OF 200LBS IN ANY DIRECTION.

AS-BUILT

BY Inukshuk Construction Ltd. **DATE** 2018/07/19



Permit Number: P471

[illegible]

APPENDIX H

Construction Summary of Industrial Site Fuel Storage and Containment Facilities

Civil Earthworks Construction Summary – Industrial Site Tank Farm

- Construction management and quality assurance performed by Agnico Eagle Construction
- Primary civil construction contractor was MTKSL (2017) and AEM Construction (2018)
- Subcontractors: Texel Geosol for liner installation and liner QC
- All survey conducted by Hamel Arpentage

Design Changes:

Material Substitutions

- As per RFI 6515-C-230-009_015, the following material substitutions were approved by the design engineer and implemented in the field:
 - o 600 mm minus ROM outside of the tank pedestal footprints (including the perimeter berms) was replaced with 600 mm minus esker material
 - o 200 mm minus transition material was eliminated from the above area
- No changes to the original design were made to the tank pedestal footprints

1. Site Preparation (June 2017)

- OG surveyed of tank farm footprint

2. Under Liner Material Placement (June 9 to September 15, 2017)

- Both the 600 mm minus waste rock (tank pedestal areas) and 600 mm minus esker (outside tank pedestals) were placed in controlled lifts and compacted with a 10-ton vibratory drum compactor
- The first lift of under liner material was placed directly on original ground.

3. Liner System Installation (September 16 to September 17, 2017 and July 14 to July 19, 2018)

- Textured 60 mil HDPE installed throughout, bedded above and below with 540 g/m² geotextile.
- Liner was first placed under the tank pedestal footprints (September, 2017) and the bases of the two tanks were placed prior to winter 2017.
- After erection of the two tanks was completed in 2018, liner installation proceeded throughout the remainder of the containment area (July, 2018)
- Liner installation QA was carried out by AEM and quality control testing by Texel.

4. Tank Erection

- Civil earthworks within the Tank Farm area were suspended during erection of the tanks

5. Over Liner Material Placement (September 2017 and July 21 to July 29, 2018)

- Over liner material placement on the tank pedestals (September, 2017) and in the tank containment area (July, 2018) generally followed the design specification of placement of 30 mm minus placed on geotextile placed on HDPE.

Equipment Used for Construction:

- | | |
|----------------------|--|
| - CAT D8 Bulldozer | - CAT skid steers |
| - CAT D6 Bulldozer | - CAT 773 haul trucks |
| - CAT 330L Excavator | - CAT 740 articulated haul trucks |
| - CAT 345B Excavator | - CAT CS56 10-ton vibratory drum compactor |
| - CAT 320 Excavator | - HAMM 5-ton vibratory drum compactor |
| - CAT 980 Loader | |

- Various small hand-pushed compactors

QA/QC Summary

1. 600 mm minus, 200 mm minus and 30 mm minus (under liner) was placed according to the Technical Specifications for Civil Earthworks Revision 3 (6515-GNS-014, June 6, 2017).
Compaction efforts (under liner only) consisted of a minimum number of passes with either a 10-tonne vibratory compactor (4 passes) or a 5-tonne vibratory compactor (6 passes). Suitability for placement and compaction efforts were assessed visually and approved by AEM.
2. Particle size analysis was conducted on the 30 mm minus produced from ROM (results attached) and show that the material generally meets specification.
3. Texel Geosol was responsible for all quality control of the liner installation process.

APPENDIX I

Particle Size Summary – 30 mm minus Run of Mine

30 mm Minus- ROM Meliadine

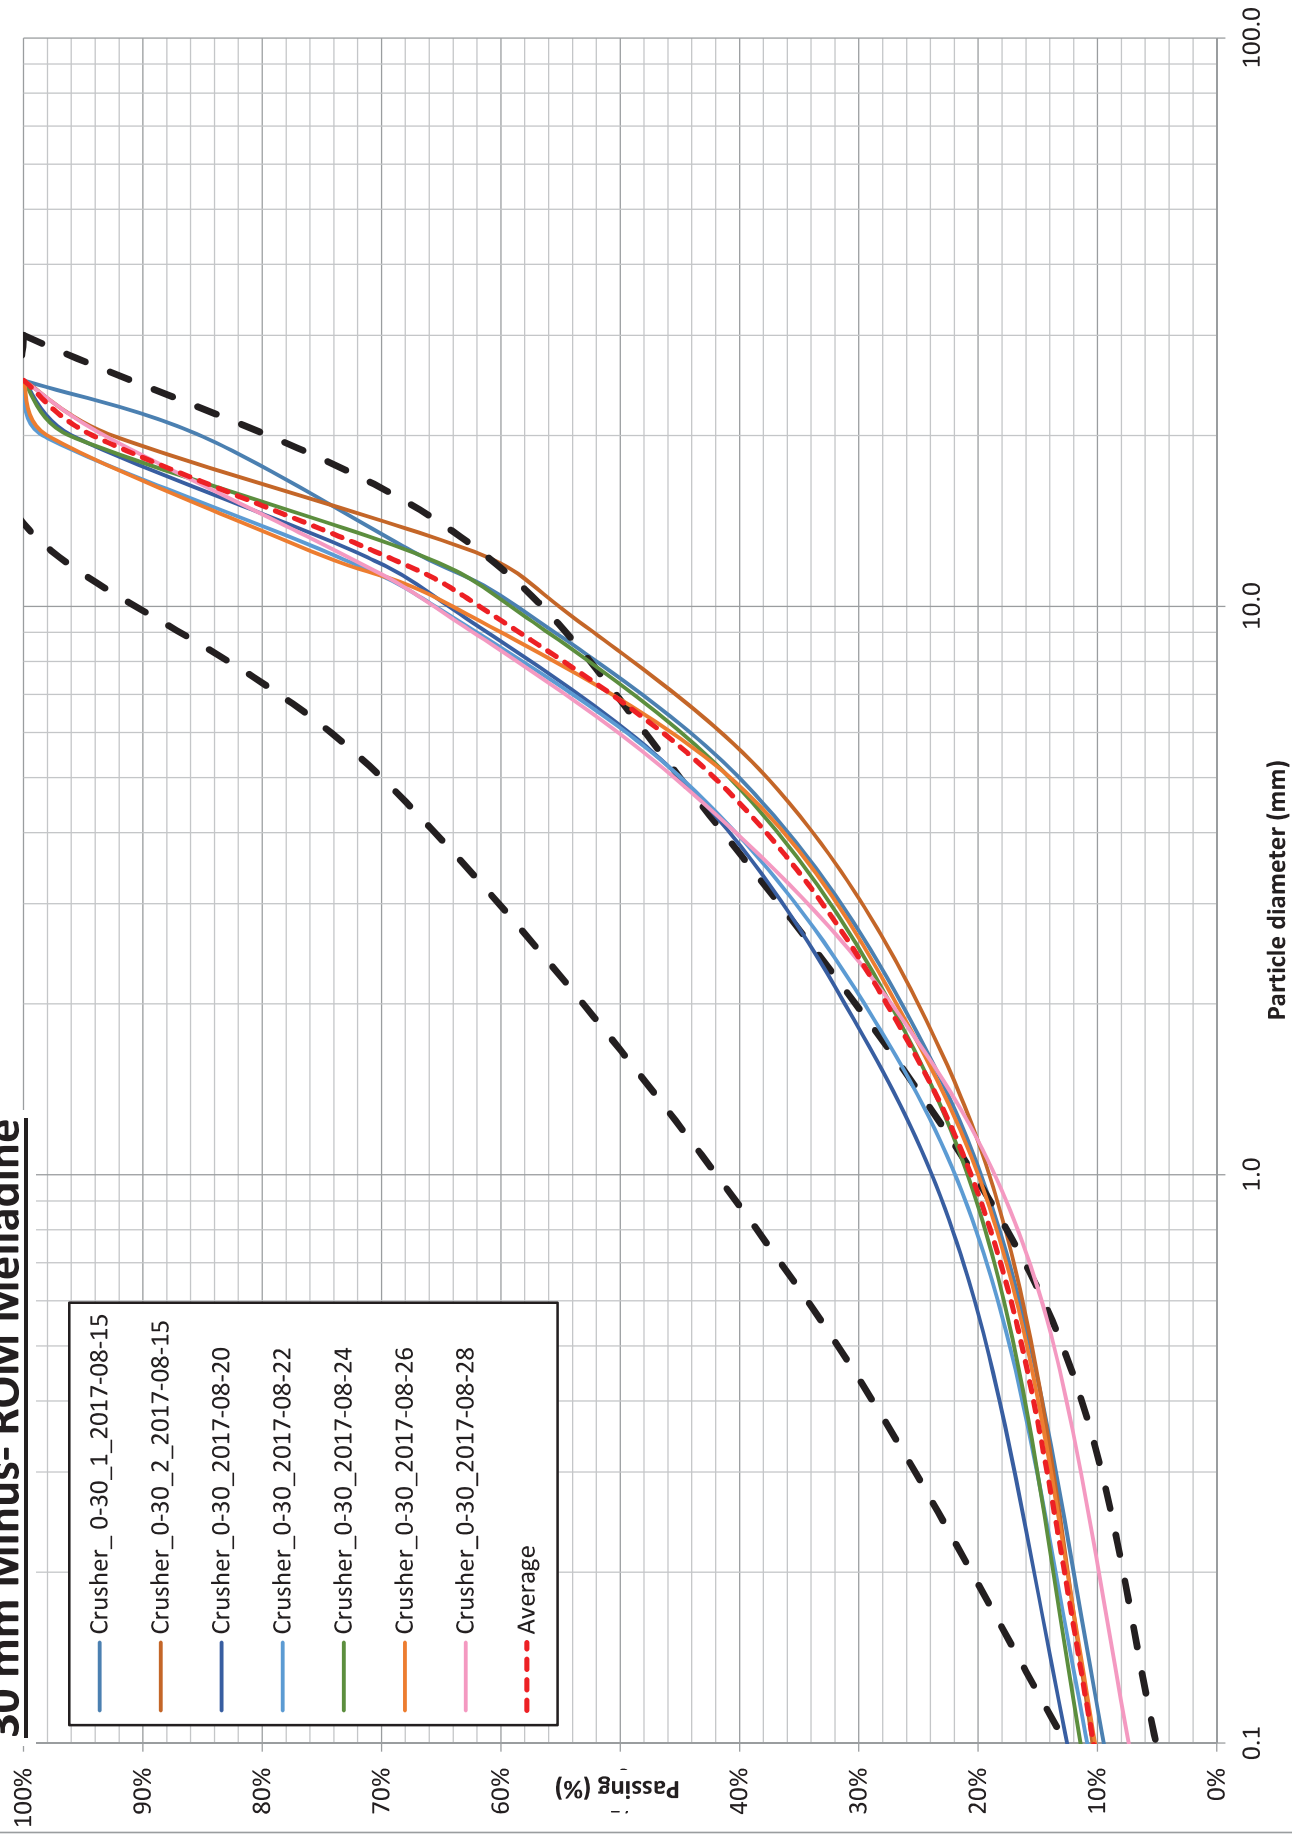


Table 1: Summary of Particle Size Analysis Results - 30 mm minus ROM Meliadine

No.	Sample ID	Sieve Size (mm)								Moisture Content
		25.00	20.00	12.50	10.00	5.00	2.00	0.63	0.08	
1	Crusher_0-30_1_2017-08-15	100.0%	85.2%	67.4%	58.6%	40.0%	26.4%	16.8%	8.6%	4.2%
2	Crusher_0-30_2_2017-08-15	100.0%	92.6%	62.3%	55.1%	37.7%	25.0%	16.5%	9.7%	2.9%
3	Crusher_0-30_2017-08-20	100.0%	95.9%	72.3%	64.4%	45.0%	31.2%	20.6%	11.6%	3.2%
4	Crusher_0-30_2017-08-24	100.0%	96.2%	67.6%	59.2%	40.9%	27.4%	18.1%	10.7%	2.2%
5	Crusher_0-30_2017-08-22	100.0%	98.4%	74.7%	65.5%	44.9%	29.5%	18.6%	10.0%	3.7%
6	Crusher_0-30_2017-08-26	100.0%	98.0%	75.9%	64.0%	40.8%	26.8%	17.0%	9.4%	2.2%
7	Crusher_0-30_2017-08-28	100.0%	93.2%	73.8%	65.6%	45.5%	27.3%	15.0%	6.5%	4.4%
Average		100.0%	94.2%	70.6%	61.8%	42.1%	27.7%	17.5%	9.5%	3.2%

APPENDIX J

Inspection Report – Inspection Test Plan

INSPECTION TEST PLAN

9	Placement of Material <30mm - Under liner	MTKSL /AEM	Monitoring placement of materials	As required	IFC's, Site Standards, Technical Specs	Conforms to IFC's and Technical Specs	Back Fill Report	V	VR	JC	10-20-17	VR	JP 10/20/17	RE	Int to be released by QA
10	Placement of Liner	MTKSL/Tenax	Monitoring placement of materials & verification	Ongoing	Manufacturers Specs, Technical Specs	Conforms to Manufacturers Specs, Install SOP, Technical Specs	Liner Installation Report	V	VR	JC	10-20-17	VR	JP 10/20/17	RE	Other ITP/QC Documents to be submitted separately.
11	Placement of Material <30mm - Over Liner	MTKSL /AEM	Monitoring placement of materials	As required	IFC's, Site Standards, Technical Specs	Conforms to IFC's and Technical Specs	Back Fill Report	V	VR	JC	10-20-17	VR	JP 10/20/17	RE	Track gas liner color, -Welds Bearing Specs for Equipment on liner cover
12	Placement of Sand - Under Tank	MTKSL	Monitoring placement of materials	As required	IFC's, Site Standards, Technical Specs	Conforms to IFC's and Technical Specs	Back Fill Report	V	VR	JP	10/20/17	VR	JP 10/20/17	RE	
13	As built summary	AEM/MTKSL-HAMEL	Verify construction against IFC's	Once	Issued IFC's & Approved Field Changes	Conforms to IFC's & Approved Field Changes	Survey report & cleared ECN log	H	H	JP	09/20/18	RV	JP 09/20/18	RE	Survey to be completed as each material change for area
14	Walkdowns & Deficiency Correction	AEM/MTKSL-HAMEL	Verification	As Required	Asbuilt summary, IFC's, Field Changes	Conforms to IFC's & Approved Field Changes	Cleared Punch Log	N/A	H	JP	09/20/18	RV	JP 09/20/18	RE	
15	Final acceptance and turnover	AEM/MTKSL-HAMEL	Acceptance of final turnover	Once	Issued IFC's, Technical Specs	Conforms to IFC's, Technical Specs, Field Changes	Final Acceptance	H	H	JP	09/20/18	W	JP 09/20/18	RE	

Comments: All Survey to be performed by Hamel. Material Testing to be performed by AEM.

Applicable Site Standard XXXXX-XXXX

Applicable Technical Specification - 6515-GNS-014_R3.

ITP ISSUE APPROVALS

Contractor Construction Manager / Superintendent (Print)	Title	Signature	Date (mm/dd/yy)
Contractor Site Quality Manager / Supervisor (Print)	Owner Title	Signature	Date (mm/dd/yy)
Jennifer Pyllyuk AEM Quality Manager / Supervisor (Print)	Resident Engineer	Jennifer Pyllyuk	09/20/18

ITP CLOSEOUT AND WORK ACCEPTANCE APPROVALS

Contractor Site Quality Manager / Supervisor (Print)	Title	Signature	Date (mm/dd/yy)
AEM Quality Manager / Supervisor / Designate (Print)	Title	Signature	Date (mm/dd/yy)

APPENDIX K

Inspection Report – Quality Control Final Report for Geomembrane Installation

**MELIADINE INDUSTRIAL PAD FUEL FARM
AGNICO EAGLE MINES LIMITED
Meliadine, Nunavut
Texel Geosol Project No. C-17060 / C-18068**

**QUALITY CONTROL FINAL REPORT
BY TEXEL GEOSOL INC.**

Prepared for:

NUNA KIVALLIQ EARTHWORKS INC

By:



August, 2018

**MELIADINE INDUSTRIAL PAD FUEL FARM
AGNICO EAGLE MINES LIMITED
Meliadine, Nunavut
Texel Geosol Project No. C-17060 / C-18068**

**QUALITY CONTROL FINAL REPORT
BY TEXEL GEOSOL INC.**

Prepared for:

**NUNA KIVALLIQ EARTHWORKS INC
NUNA SERVICES LTD
9839-31 Avenue
Edmonton, Alberta
T6N 1C5**

By:

**TEXEL GEOSOL INC.
1300, 2^e Rue, Parc industriel
Sainte-Marie, Québec, Canada
G6E 1G8**

August, 2018

TABLE OF CONTENTS

1. INTRODUCTION	4
2. HUMAN RESOURCES	4
3. GEOMEMBRANE INSTALLATION	4
3.1. DESCRIPTION OF THE WORK	4
3.2. INSTALLATION PROCEDURES	5
3.3. GEOMEMBRANE QUALITY CONTROLS	5
3.3.1. <i>On-site geomembrane installation</i>	5
3.3.1.1 Welding trial tests	5,6
3.3.1.2 On-site non-destructive testing	6,7
3.3.1.3 On-site destructive tests	7
3.4. REPAIR PROCEDURES	8
3.5. RECORD DRAWING	8
4. GEOTEXTILE QUALITY CONTROL	8
5. CERTIFICATION	9

LIST OF APPENDICES

- APPENDIX I - Quality control test results obtained on site by Texel Geosol Inc
- APPENDIX II - Field Memos and Communications
- APPENDIX III - US-EPA Classification for Types of Break
- APPENDIX IV - Record drawing

LIST OF FIGURES

FIGURE 1 - DOUBLE -TRACK GEOMEMBRANE WELD	5
FIGURE 2 - FILLET-EXTRUDED GEOMEMBRANE WELD	5
FIGURE 3 - PEEL ADHESION TEST	6
FIGURE 4 - SHEAR STRENGTH TEST.....	6
FIGURE 5 - AIR-PRESSURE TEST.....	6
FIGURE 6 - VACUUM-BOX TEST.....	7

1. INTRODUCTION

The following report was prepared by Texel Geosol, for Nuna Kivalliq Earthworks Inc.

This report contains a description as well as a certification of all work conducted by Texel Geosol, installer of the geosynthetics. It also contains the record drawing of the geomembrane installation for the Meliadine Industrial Pad Fuel Farm. All installation work conducted on the geosynthetics took place between September 16 and 17, 2017 and between July 14 to 19, 2018.

2. HUMAN RESOURCES

The following list identifies the key personnel involved with the physical realization of this project

TEXEL GEOSOL INC. (Geosynthetic Installer)

- Mr. François Thivierge, Construction and project Manager
- Mr. Jacques St-Gelais, Operation Manager
- Mr. Simon-Carl Marcoux, Eric Black, Site Foreman
- Mr. Michael Gilbert, Louis-Philippe Beauchamps, Field QC Inspector and technician
- Mr. Kléber Nault and Philippe Alie, Technician

NUNA KIVALLIQ EARTHWORKS INC (General Contractor - Client)

- Mr. Matt Gallant, Project Manager

AGNICO EAGLE CONSTRUCTION. (Quality Assurance)

3. GEOMEMBRANE INSTALLATION

This section includes a description of the work and the installation procedures used during the deployment of the geomembrane. Also, the construction quality control procedures are detailed in this section

3.1. Description of the work

The scope of the installation was to completely cover the Industrial pad fuel farm with a geosynthetic lining system. Texel Geosol installed approximately 5259,7 sm of 60 mil HDPE textured geomembrane. All the installation, seaming and repair procedures were conducted according to the project plans and specifications, and manufacturer's recommendations.

3.2. Installation Procedures

The geomembrane rolls were later deployed and installed by Texel Geosol as prescribed in the specifications. Panels were placed to minimize seams across the side slope and the tie-in seams. The panels were overlapped about 125 to 150 mm, allowing adequate double fusion welding and leaving enough material to perform peel and shear tests on seam samples (see section 3.3.2.1 for a description of these tests).

All seams between panels were made using an automated polymer fusion process, the fusion being obtained through a double hot wedge. These parallel welds create an air channel which allow air-pressure testing of the continuity of the seam (see Fig. 1).

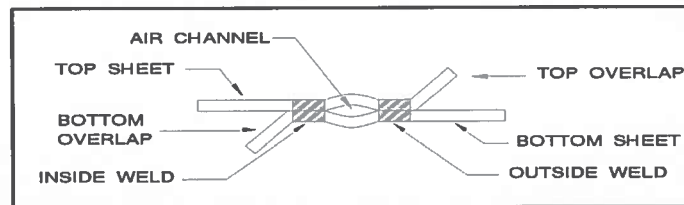


Figure 1 - Double -Track Geomembrane Weld

In restrictive areas where this process could not be adequately applied, such as corners, repair work and pipe penetrations, a manual extrusion fillet welding was employed (see Fig. 2).

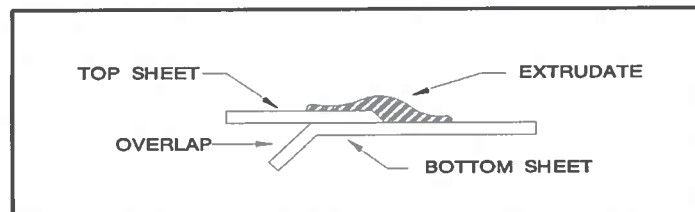


Figure 2 - Fillet-Extruded Geomembrane Weld

3.3. Geomembrane quality control

3.3.1. On-site geomembrane installation

3.3.1.1 Welding trial tests

Trial tests were performed prior to any on-site seaming in order to quantify the calibration of the welding equipment. On each sample, four peel tests and one shear tests were performed. A peel adhesion test is conducted by submitting a one inch-wide seam specimen to a tensile effort on a calibrated, portable tensiometer and trying to "peel", or open the seam (see Fig. 3). A shear strength test is similar, but the tension is applied in the plane of the seam (see Fig. 4). The peel test gives an indication of the quality of the seam while the shear test demonstrates the actual behavior of the seam in service.

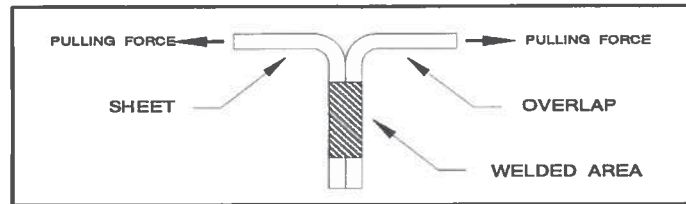


Figure 3 - Peel Adhesion Test

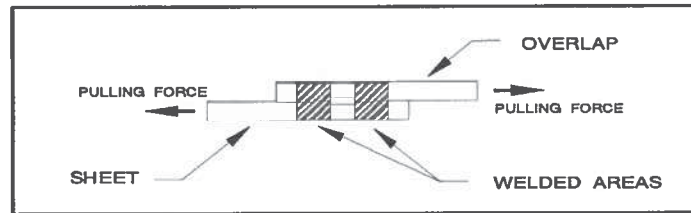


Figure 4 - Shear Strength Test

For each trial test, the QC Inspector recorded the date, time, ambient and operating temperatures, equipment number, speed setting, operator's initials, peel and shear values and corresponding type of break. The only type of break acceptable is designated as "FTB", as per the US-EPA classification for types of breaks, available in appendix III. The seams were made only after a satisfactory trial test had been obtained. All the results of these tests are also included in appendix I.

3.3.1.2 On-site non-destructive testing

The continuity of all seams (100%) was verified by non-destructive methods. These methods include the air-pressure test and the vacuum-box test. Any seam that failed one of these tests was rebuilt or repaired until a satisfactory result was obtained. All the results of these tests are included in Appendix I of this report.

a) Air-Pressure Testing

Air-pressure testing was employed as the primary test method. This non-destructive test method consists of injecting air at a predetermined pressure in the center air channel of fusion-welded seams (see Fig. 5). If the seam is continuous there will be very little or no drop of pressure. If a leak is present within the area under pressure, it is located and repaired. This type of non-destructive test is faster than the vacuum-box test, less observer-dependent and represents a supplementary mechanical resistance test since the geomembrane sheets are pulled away from each other by the air pressure in the channel.

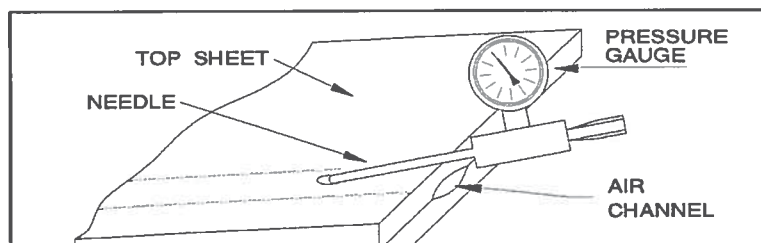


Figure 5 - Air-Pressure Test

b) Vacuum-box test

Wherever the air-pressure test could not be used, the vacuum-box test was employed. In this test, a film of soapy water is sprinkled over the area to be tested. A box fitted with a transparent upper cover and a neoprene lower rim is placed over that same area and connected to a vacuum pump; a negative pressure of 5 psi is then applied (see Fig. 6). If there is a puncture or discontinuous seam within this area, bubbles will appear and be detected by the observer.

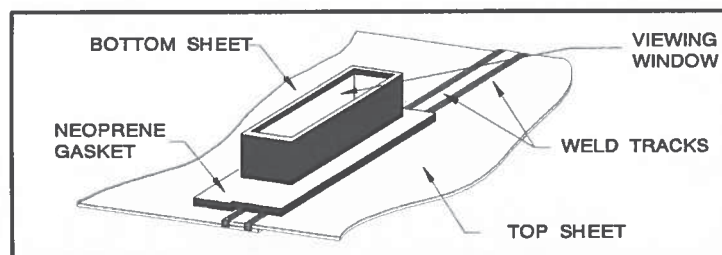


Figure 6 - Vacuum-Box Test

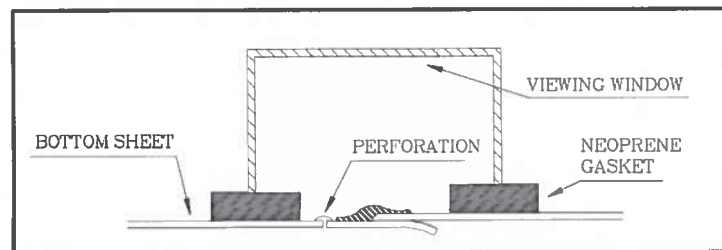


Figure 7 - Vacuum-Box Test

3.3.1.3 On-site destructive tests

Finally, a destructive testing program was applied, where seam samples taken from the installed geomembrane were tested for peel adhesion and shear strength on a calibrated, portable tensiometer. On each sample, four peel tests and one shear tests were performed. All the results from these tests are included in Appendix I of this report.

3.4. Repair Procedures

All materials were visually inspected for blemishes, punctures and other defects or damages that may have occurred during transport or panel placement. Any defect or damage was repaired as per the procedures described in this section.

Demobilization was not authorized until Texel Geosol, Nuna Kivalliq Earthworks Inc and Agnico Eagle Construction completed a last visual inspection of the installation work. Any defect revealed by any step of the Quality Control Program was repaired and verified according to the prescribed procedures:

- All pockmarks, pinholes, T-seams, etc., smaller than the tip of the extruder were covered with an extrusion bead;
- All punctures, holes, tears, etc., wider than the tip of the extruder were repaired with extrusion-welded patches;
- Any seam revealed as defective by the CQC or CQA Programs was entirely rebuilt through a fusion and/or extrusion seaming process.

Prior to any fillet extrusion welding, the geomembrane was buffed to insure better adhesion of the extruded material. All repairs were visually inspected and verified by a non-destructive testing method, as described in section 3.3.2.2.

3.5. Record Drawing

The record drawing of the geomembrane installation, showing all panels, panel identification, pipe penetrations, repairs and destructive test locations, is included in Appendix IV of this report.

4. GEOTEXTILE QUALITY CONTROL

Approximately 10 519,4 sm of non-woven geotextile was installed by Texel Geosol according to the project plans and specifications. The geotextile panels were overlapped approximately 100 to 150 mm and thermally bonding (hot air or wedge) or sewing in order to ensure the continuity of the cushion layer.

Any holes or tears in the geotextile were repaired according to the project specifications. All geotextile materials were installed by Texel Geosol.

5. CERTIFICATION

Texel Geosol certifies having installed all geosynthetic materials according to the project plans and specifications provided by the consultant Tetra Tech, for Nuna Kivalliq Earthworks Inc. All installation work conducted by Texel Geosol meets or exceeds the standards of the geosynthetic industry.



François Thivierge, P. Eng., MBA
Construction Director
TEXEL GEOSOL INC.



Date

(mm-dd-yy)

APPENDIX I

**QUALITY CONTROL PROCEDURES CONDUCTED ON SITE BY
TEXEL GEOSOL INC.**

Fusion Trial Tests
Calibration par Fusion
Project Name / Nom de Projet: Meliadine Industrial Pad Fuel Farm

Project No. / No. de Projet: C-17060 / C-18068

QC Inspector / Inspecteur CQ: Louis-Philippe Beauchamps

Trial Test No. No. de Calibration	Date (mm/dd/yy)	Time Heure	Ambient Temp. Temp. Ambiante	Equipment No. No. Équipement	Equipment Temp. Temp. Équipement	Equipment Speed Vitesse Équipement	Peel Resistance Résistance Pelage "A" (ppi)	Peel Type of Break Type de Brisure	Peel Resistance Résistance Pelage "B" (ppi)	Peel Type of Break Type de Brisure	Shear Resistance Résist. Cisaillement (ppi)	Shear Type of Break Type de Brisure	Tech.-Welder Soudeur	Tensimeter No. No. Tensiomètre
September 2017														
F-1	09-16-17	13:50	5 °C	MD-007	860 °F	450	144	SE1	150	SE1	191	BRK	K.N	T-9709
"	"	"	"	"	"	"	121	SE1	150	SE1	N/A	N/A	"	"
"	"	"	"	"	"	"	132	SE1	149	SE1	N/A	N/A	"	"
"	"	"	"	"	"	"	134	SE1	155	SE1	N/A	N/A	"	"
F-2	09-17-17	07:00	2 °C	MD-007	860 °F	450	151	SE1	160	SE1	220	BRK	K.N	T-9709
"	"	"	"	"	"	"	147	SE1	153	SE1	N/A	N/A	"	"
"	"	"	"	"	"	"	148	SE1	165	SE1	N/A	N/A	"	"
"	"	"	"	"	"	"	147	SE1	159	SE1	N/A	N/A	"	"
July 2018														
F-1	07-14-18	12:20	18 °C	M-9856	750 °F	675	138	SE1	141	SE1	168	BRK	P.A	T-9601
"	"	"	"	"	"	"	173	SE1	168	SE1	173	BRK	"	"
"	"	"	"	"	"	"	154	SE1	129	SE1	N/A	N/A	"	"
"	"	"	"	"	"	"	144	SE1	137	SE1	N/A	N/A	"	"
F-2	07-16-18	07:20	12 °C	M-9856	750 °F	700	141	SE1	94	SE1	181	BRK	P.A	T-9601
"	"	"	"	"	"	"	127	SE1	113	SE1	180	BRK	"	"
"	"	"	"	"	"	"	126	SE1	111	SE1	N/A	N/A	"	"
"	"	"	"	"	"	"	129	SE1	119	SE1	N/A	N/A	"	"
F-3	07-17-18	09:45	14 °C	M-9856	750 °F	750	136	SE1	103	SE1	177	BRK	P.A	T-9601
"	"	"	"	"	"	"	126	SE1	109	SE1	176	BRK	"	"
"	"	"	"	"	"	"	131	SE1	127	SE1	N/A	N/A	"	"
"	"	"	"	"	"	"	138	SE1	131	SE1	N/A	N/A	"	"

Fusion Trial Tests Calibration par Fusion

Project Name / Nom de Projet: Meliadine Industrial Pad Fuel Farm

Project No. / No. de Projet: C-17060 / C-18068

QC Inspector / Inspecteur CQ: Louis-Philippe Beauchamps

Trial Test No. No. de Calibration	Date (mm/dd/yy)	Time Heure	Ambient Temp. Temp. Ambiante	Equipment No. No. Équipement	Equipment Temp. Temp. Équipement	Equipment Speed Vitesse Équipement	Peel Resistance Résistance Pelage "A" (ppi)	Peel Type of Break Type de Brisure	Peel Resistance Résistance Pelage "B" (ppi)	Peel Type of Break Type de Brisure	Shear Resistance Résist. Cisaillement (ppi)	Shear Type of Break Type de Brisure	Tech.-Welder Soudeur	Tensionmeter No. No. Tensiomètre
F-4	07-19-18	07:50	13 °C	M-9856	750 °F	700	130	SE1	107	SE1	178	BRK	P.A	T-9601
"	"	"	"	"	"	"	134	SE1	109	SE1	180	BRK	"	"
"	"	"	"	"	"	"	122	SE1	114	SE1	N/A	N/A	"	"
"	"	"	"	"	"	"	128	SE1	131	SE1	N/A	N/A	"	"

Extrusion Trial Tests Calibration par Extrusion

Project Name / Nom de Projet: Meliadine Industrial Pad Fuel Farm

Project No. / No. de Projet: C-17060 / C-18068

QC Inspector / Inspecteur CQ: Louis-Philippe Beauchamps

Trial Test No. No. de Calibration	Date (mm/dd/yy)	Time Heure	Ambient Temp. Temp. Ambiante	Equipment No. No. Équipement	Equipment Temp. Temp. Équipement	Pre-Heat Temp. Temp. Pré-Chauf.	Peel Resistance Résistance Pelage (ppi)	Peel Type of Break Type de Brisure	Shear Resistance Résist. Cisaillement (ppi)	Shear Type of Break Type de Brisure	Tech.-Welder Soudeur	Tensiometer No. No. Tensiomètre
September 2017												
E-1	09-17-17	07:00	2 °C	EX-E	260 °C	260 °C	121	SE3	N/A	N/A	S.M	T-9709
"	"	"	"	"	"	"	127	SE3	N/A	N/A	"	"
"	"	"	"	"	"	"	128	SE3	N/A	N/A	"	"
"	"	"	"	"	"	"	78	Ad	N/A	N/A	"	"
E-2	09-17-17	08:00	2 °C	EX-E	260 °C	260 °C	146	SE3	193	BRK	S.M	T-9709
"	"	"	"	"	"	"	133	SE3	N/A	N/A	"	"
"	"	"	"	"	"	"	138	SE3	N/A	N/A	"	"
"	"	"	"	"	"	"	171	SE3	N/A	N/A	"	"
July 2018												
E-1	07-17-18	12:50	15 °C	EX-38	250 °C	250 °C	124	SE3	180	BRK	E.B	T-9601
"	"	"	"	"	"	"	131	SE3	176	BRK	"	"
"	"	"	"	"	"	"	121	SE3	N/A	N/A	"	"
"	"	"	"	"	"	"	134	SE3	N/A	N/A	"	"
E-2	07-18-18	07:45	13 °C	EX-38	250 °C	245 °C	119	SE3	182	BRK	E.B	T-9601
"	"	"	"	"	"	"	142	SE3	182	BRK	"	"
"	"	"	"	"	"	"	130	SE3	N/A	N/A	"	"
"	"	"	"	"	"	"	129	SE3	N/A	N/A	"	"

Extrusion Trial Tests Calibration par Extrusion

Project Name / Nom de Projet: Meliadine Industrial Pad Fuel Farm

Project No. / No. de Projet: C-17060 / C-18068

QC Inspector / Inspecteur CQ: Louis-Philippe Beauchamps

Trial Test No. No. de Calibration	Date (mm/dd/yy)	Time Heure	Ambient Temp. Temp. Ambiante	Equipment No. No. Équipement	Equipment Temp. Temp. Équipement	Pre-Heat Temp. Temp. Pré-Chauf.	Peel Resistance Résistance Pelage (ppi)	Peel Type of Break Type de Brisure	Shear Resistance Résist. Cisaillement (ppi)	Shear Type of Break Type de Brisure	Tech.-Welder Soudeur	Tensiometer No. No. Tensiomètre
E-3	07-19-18	07:45	8 °C	EX-38	250 °C	245 °C	128	SE3	189	BRK	E.B	T-9601
"	"	"	"	"	"	"	124	SE3	186	BRK	"	"
"	"	"	"	"	"	"	141	SE3	N/A	N/A	"	"
"	"	"	"	"	"	"	141	SE3	N/A	N/A	"	"

**Seaming Procedures
Procédures de Soudures**

Project Name / Nom de Projet: Meliadine Industrial Pad Fuel Farm

QC Inspector / Inspecteur CQ: Louis-Philippe Beauchamps

Project No. / No. de Projet: C-17060 / C-18068

Seaming Procedures / Procédures de Soudures						Non-Destructive Testing / Essai Non-Destructif							Approved (Yes/No) Approuvé (Oui/Non)
Seam No. No. de Soudure	Date of Seaming (mm/dd/yy)	Time of Seaming Heure de Soudure	Seam Length (m)	Trial Test No. No. Calibration	Technician-Welder Soudeur	Test Date (mm/dd/yy)	Time Heure	Air-Pressure Pressurisation	Vacuum Box Boîte à Vide	Starting Pressure (psi) Pression Départ	Ending Pressure (psi) Pression Fin	Testing Details/Location Détails de l'essai/Localisation	Approved (Yes/No) Approuvé (Oui/Non)
September 2017													
1-2 (E4-E8)	09-16-17	13:37	33,1	F-1	K.N	09-16-17	13:55	X	-	32	32	Full seam	Y
2-3 (E3-E4)	09-16-17	13:54	33,2	F-1	K.N	09-16-17	14:20	X	-	31	31	Full seam	Y
3-4 (E2-E3)	09-16-17	14:17	33	F-1	K.N	09-16-17	14:27	X	-	30	29	Start at South (SEOS) 0m to 6m	Y
"	"	"	"	"	"	09-16-17	14:40	X	-	31	31	6m to 33m	Y
4-5 (E1-E2)	09-16-17	15:35	32	F-1	K.N	09-16-17	15:56	X	-	31	31	Full seam	Y
6-7 (E6-E7)	09-17-17	10:00	18,4	F-2	K.N	09-17-17	10:11	X	-	31	30	Full seam	Y
7-8 (E5-E6)	09-17-17	10:06	17,8	F-2	K.N	09-17-17	10:27	X	-	32	32	Full seam	Y
July 2018													
1-2	07-14-18	17:02	8,5	F-1	P.A	07-14-18	17:15	X	-	29	28	Full seam	Y
1-3	07-14-18	17:20	5,9	F-1	P.A	07-14-18	17:28	X	-	31	31	Full seam	Y
2-3	07-14-18	17:20	6,65	F-1	P.A	07-14-18	17:28	X	-	31	31	Full seam	Y
3-4	07-14-18	17:33	18	F-1	P.A	07-16-18	07:20	X	-	29	28	Full seam	Y

Seaming Procedures
Procédures de Soudures

Project Name / Nom de Projet: Meliadine Industrial Pad Fuel Farm

QC Inspector / Inspecteur CQ: Louis-Philippe Beauchamps

Project No. / No. de Projet: C-17060 / C-18068

Seaming Procedures / Procédures de Soudures						Non-Destructive Testing / Essai Non-Destructif							Approved (Yes/No) Approuvé (Oui/Non)
Seam No. No. de Soudure	Date of Seaming (mm/dd/yy)	Time of Seaming	Seam Length (m)	Trial Test No. No. Calibration	Technician-Welder Soudeur	Test Date (mm/dd/yy)	Time Heure	Air-Pressure Pressurisation	Vacuum Box Boîte à Vide	Starting Pressure (psi) Pression Départ	Ending Pressure (psi) Pression Fin	Testing Details/Location Détails de l'essai/Localisation	
4-5	07-16-18	07:47	18,5	F-2	P.A	07-16-18	07:55	X	-	31	31	Full seam	Y
5-6	07-16-18	07:56	18,6	F-2	P.A	07-16-18	08:10	X	-	31	31	Full seam	Y
6-7	07-16-18	08:11	18,5	F-2	P.A	07-16-18	08:23	X	-	31	31	Full seam	Y
7-8	07-16-18	08:35	19,6	F-2	P.A	07-16-18	08:45	X	-	30	30	Full seam	Y
8-9	07-16-18	08:55	20,3	F-2	P.A	07-16-18	09:02	X	-	31,5	31	Full seam	Y
9-10	07-16-18	09:05	20,4	F-2	P.A	07-16-18	09:15	X	-	30	30	Start at North (NEOS) 0m to 6,9m 6,9m to 20,4m	Y
"	"	"	"	"	"	07-16-18	09:45	X	-	31	30		Y
8-11	07-16-18	09:53	0,6	F-2	P.A	07-16-18	10:06	X	-	29	29	Full seam	Y
9-11	07-16-18	09:53	6,65	F-2	P.A	07-16-18	10:04	X	-	31	30	Full seam	Y
10-11	07-16-18	09:53	6,1	F-2	P.A	07-16-18	10:04	X	-	31	30	Full seam	Y
11-12	07-16-18	10:05	14,3	F-2	P.A	07-16-18	10:17	X	-	28,5	28,5	Full seam	Y
12-13	07-16-18	10:12	14,5	F-2	P.A	07-16-18	10:22	X	-	31	30	Full seam	Y
13-14	07-16-18	10:30	14,7	F-2	P.A	07-16-18	10:44	X	-	31	31	Full seam	Y

Seaming Procedures
Procédures de Soudures

Project Name / Nom de Projet: Meliadine Industrial Pad Fuel Farm

QC Inspector / Inspecteur CQ: Louis-Philippe Beauchamps

Project No. / No. de Projet: C-17060 / C-18068

Seaming Procedures / Procédures de Soudures						Non-Destructive Testing / Essai Non-Destructif						Testing Details/Location Détails de l'essai/Localisation	Approved (Yes/No) Approuvé (Oui/Non)
Seam No. No. de Soudure	Date of Seaming (mm/dd/yy)	Time of Seaming Heure de Soudure	Seam Length (m)	Trial Test No. No. Calibration	Technician-Welder Soudeur	Test Date (mm/dd/yy)	Time Heure	Air-Pressure Pressurisation	Vacuum Box Boîte à Vide	Starting Pressure (psi)	Ending Pressure (psi)		
14-15	07-16-18	10:38	14,8	F-2	P.A	07-17-18	09:37	X	-	32	31	Full seam	Y
16-17	07-16-18	10:53	6,65	F-2	P.A	07-17-18	09:44	X	-	31	31	Full seam	Y
15-16	07-16-18	10:53	15,5	F-2	P.A	07-17-18	09:44	X	-	31	31	Full seam	Y
15-17	07-16-18	11:00	2,3	F-2	P.A	07-17-18	09:50	X	-	29	29	Full seam	Y
E1-17	07-17-18	10:05	6,65	F-3	P.A	07-17-18	10:07	X	-	31	30	Full seam	Y
E1-15	07-17-18	10:10	4,35	F-3	P.A	07-17-18	10:25	X	-	31	29	Full seam	Y
E1-14	07-17-18	10:10	6,65	F-3	P.A	07-17-18	10:25	X	-	31	29	Full seam	Y
E1-13	07-17-18	10:10	6,65	F-3	P.A	07-17-18	10:25	X	-	31	29	Full seam	Y
E1-12	07-17-18	10:10	6,65	F-3	P.A	07-17-18	10:25	X	-	31	29	Full seam	Y
E1-11	07-17-18	10:10	6,65	F-3	P.A	07-17-18	10:25	X	-	31	29	Full seam	Y
16-18	07-17-18	10:26	21,7	F-3	P.A	07-17-18	10:40	X	-	32	32	Full seam	Y
19-20	07-17-18	10:53	17,9	F-3	P.A	07-17-18	11:02	X	-	30	29	Full seam	Y
20-21	07-17-18	11:00	18,1	F-3	P.A	07-17-18	11:09	X	-	29,5	29	Full seam	Y

Seaming Procedures
Procédures de Soudures

Project Name / Nom de Projet: Meliadine Industrial Pad Fuel Farm

QC Inspector / Inspecteur CQ: Louis-Philippe Beauchamps

Project No. / No. de Projet: C-17060 / C-18068

Seaming Procedures / Procédures de Soudures						Non-Destructive Testing / Essai Non-Destructif							Approved (Yes/No) Approuvé (Oui/Non)
Seam No. No. de Soudure	Date of Seaming (mm/dd/yy)	Time of Seaming	Seam Length (m)	Trial Test No. No. Calibration	Technician-Welder Soudeur	Test Date (mm/dd/yy)	Time Heure	Air-Pressure Pressurisation	Vacuum Box Boîte à Vide	Starting Pressure (psi)	Ending Pressure (psi)	Testing Details/Location Détails de l'essai/Localisation	
21-22	07-17-18	11:13	17,6	F-3	P.A	07-17-18	11:20	X	-	31	29	Full seam	Y
22-23	07-17-18	11:27	17,7	F-3	P.A	07-17-18	13:07	X	-	31	31	Full seam	Y
18-19	07-17-18	11:50	6,65	F-3	P.A	07-17-18	11:56	X	-	30	30	Full seam	Y
E7-23	07-17-18	12:57	17,2	F-3	P.A	07-17-18	13:12	X	-	31	29	Full seam	Y
23-24	07-17-18	13:27	35,4	F-3	P.A	07-17-18	14:10	X	-	31	31	Full seam	Y
E8-24	07-17-18	14:07	33,4	F-3	P.A	07-17-18	14:24	X	-	30	28,5	Full seam	Y
24-25	07-17-18	14:29	46,9	F-3	P.A	07-17-18	15:50	X	-	32	32	Full seam	Y
24-26	07-17-18	14:56	27,1	F-3	P.A	07-17-18	16:10	X	-	30	28	Full seam	Y
E5-19	07-17-18	16:05	2,6	F-3	P.A	07-17-18	16:20	X	-	31	29	Full seam	Y
E5-18	07-17-18	16:05	6,65	F-3	P.A	07-17-18	16:20	X	-	31	29	Full seam	Y
E5-16	07-17-18	16:05	6,65	F-3	P.A	07-17-18	16:20	X	-	31	29	Full seam	Y
E5-17	07-17-18	16:05	2,3	F-3	P.A	07-17-18	16:20	X	-	31	29	Full seam	Y
E5-20	07-17-18	16:13	6,65	F-3	P.A	07-17-18	16:26	X	-	31	30	Full seam	Y

**Seaming Procedures
Procédures de Soudures**

Project Name / Nom de Projet: Meliadine Industrial Pad Fuel Farm

QC Inspector / Inspecteur CQ: Louis-Philippe Beauchamps

Project No. / No. de Projet: C-17060 / C-18068

Seaming Procedures / Procédures de Soudures						Non-Destructive Testing / Essai Non-Destructif							
Seam No.	Date of Seaming (mm/dd/yy)	Time of Seaming	Seam Length (m)	Trial Test No.	Technician-Welder	Test Date (mm/dd/yy)	Time Heure	Air-Pressure Pressurisation	Vacuum Box Boîte à Vide	Starting Pressure (psi) Pression Départ	Ending Pressure (psi) Pression Fin	Testing Details/Location Détails de l'essai/Localisation	Approved (Yes/No) Approuvé (Oui/Non)
E6-21	07-17-18	16:13	6,65	F-3	P.A	07-17-18	16:26	X	-	31	30	Full seam	Y
E7-22	07-17-18	16:13	6,65	F-3	P.A	07-17-18	16:26	X	-	31	30	Full seam	Y
E8-23	07-17-18	16:27	6,65	F-3	P.A	07-17-18	16:40	X	-	30	29	Full seam	Y
E4-E7	07-17-18	16:27	6,65	F-3	P.A	07-17-18	16:40	X	-	30	29	Full seam	Y
E3-E6	07-17-18	16:27	6,65	F-3	P.A	07-17-18	16:40	X	-	30	29	Full seam	Y
E2-E5	07-17-18	16:27	6,65	F-3	P.A	07-17-18	16:40	X	-	30	29	Full seam	Y
25-26	07-17-18	16:45	6,65	F-3	P.A	07-17-18	16:50	X	-	31	30	Start at int. 24-25-26 0m at 1m	Y
"	"	"	"	"	"	07-18-18	AM	-	X	-	-	1m at 3,3m	Y
"	"	"	"	"	"	07-17-18	16:55	X	-	30	30	3,3m at 6,65m	Y
3-24	07-17-18	17:00	8,8	F-3	P.A	07-17-18	17:13	X	-	31	30	Full seam	Y
1-24	07-17-18	17:00	0,8	F-3	P.A	07-17-18	17:13	X	-	31	30	Full seam	Y
1-26	07-17-18	17:00	6,65	F-3	P.A	07-17-18	17:13	X	-	31	30	Full seam	Y
E1-8	07-17-18	17:20	6,5	F-3	P.A	07-18-18	08:05	X	-	29	29	Full seam	Y

Seaming Procedures
Procédures de Soudures

Project Name / Nom de Projet: Meliadine Industrial Pad Fuel Farm

QC Inspector / Inspecteur CQ: Louis-Philippe Beauchamps

Project No. / No. de Projet: C-17060 / C-18068

Seaming Procedures / Procédures de Soudures						Non-Destructive Testing / Essai Non-Destructif							
Seam No.	Date of Seaming (mm/dd/yy)	Time of Seaming	Seam Length (m)	Trial Test No.	Technician-Welder	Test Date (mm/dd/yy)	Time Heure	Air-Pressure Pressurisation	Vacuum Box Boîte à Vide	Starting Pressure (psi) Pression Départ	Ending Pressure (psi) Pression Fin	Testing Details/Location Détails de l'essai/Localisation	Approved (Yes/No) Approuvé (Oui/Non)
E1-7	07-17-18	17:20	0,6	F-3	P.A	07-18-18	08:05	X	-	29	29	Full seam	Y
E2-7	07-17-18	17:25	6,3	F-3	P.A	07-18-18	08:10	X	-	30	29	Full seam	Y
E2-6	07-17-18	17:25	0,6	F-3	P.A	07-18-18	08:10	X	-	30	29	Full seam	Y
E3-6	07-17-18	17:25	6,2	F-3	P.A	07-18-18	08:10	X	-	30	29	Full seam	Y
E3-5	07-17-18	17:30	0,7	F-3	P.A	07-18-18	08:14	X	-	30	29	Full seam	Y
E4-5	07-17-18	17:30	6	F-3	P.A	07-18-18	08:14	X	-	30	29	Start at int. E3-5-6 0m at 1,9m	Y
"	"	"	"	"	"	07-18-18	08:14	X	-	30	29	1,9m at 6m	Y
E4-4	07-17-18	17:30	0,6	F-3	P.A	07-18-18	08:14	X	-	30	29	Full seam	Y
E8-4	07-17-18	17:30	6	F-3	P.A	07-18-18	08:14	X	-	30	29	Full seam	Y
E8-3	07-17-18	17:30	0,6	F-3	P.A	07-18-18	08:14	X	-	30	29	Full seam	Y
18-27	07-19-18	07:40	15,2	F-4	P.A	07-19-18	07:50	X	-	31	30	Full seam	Y
27-28	07-19-18	07:50	15,7	F-4	P.A	07-19-18	08:01	X	-	32	31	Full seam	Y
28-29	07-19-18	07:55	15,8	F-4	P.A	07-19-18	08:05	X	-	30	30	Full seam	Y

Seaming Procedures
Procédures de Soudures

Project Name / Nom de Projet: Meliadine Industrial Pad Fuel Farm

QC Inspector / Inspecteur CQ: Louis-Philippe Beauchamps

Project No. / No. de Projet: C-17060 / C-18068

Seaming Procedures / Procédures de Soudures						Non-Destructive Testing / Essai Non-Destructif							
Seam No. No. de Soudure	Date of Seaming (mm/dd/yy)	Time of Seaming Heure de Soudure	Seam Length (m)	Trial Test No. No. Calibration	Technician-Welder Soudeur	Test Date (mm/dd/yy)	Time Heure	Air-Pressure Pressurisation	Vacuum Box Boîte à Vide	Starting Pressure (psi)	Ending Pressure (psi)	Testing Details/Location Détails de l'essai/Localisation	Approved (Yes/No) Approuvé (Oui/Non)
19-27	07-19-18	08:13	6,65	F-4	P.A	07-19-18	08:20	X	-	30	29	Full seam	Y
19-28	07-19-18	08:13	6,65	F-4	P.A	07-19-18	08:20	X	-	30	29	Full seam	Y
19-29	07-19-18	08:13	6,65	F-4	P.A	07-19-18	08:20	X	-	30	29	Full seam	Y

**Destructive Testing
Essai Destructif**
Project Name / Nom de Projet: Meliadine Industrial Pad Fuel Farm

Project No. / No. de Projet: C-17060 / C-18068

QC Inspector / Inspecteur CQ: Louis-Philippe Beauchamps

Destructive Test No. No. Essai Destructif	Seam No. No. de Soudure	Date (mm/dd/yy)	Sample Location Localisation de l'échantillon	Peel Resistance Résistance Pelage (ppi)	Peel Type of Break Type de Brisure	Peel Resistance Résistance Pelage (ppi)	Peel Type of Break Type de Brisure	Shear Resistance Résist. Cisaillement (ppi)	Shear Type of Break Type de Brisure	Date Repaired Date Réparée (mm/dd/yy)	Date Repair Verified Date Réparée Vérifiée (mm/dd/yy)	Lab. Testing (P/F) Lab. Indép. (A/R)	Tensimeter No. No. Tensiomètre
September 2017													
DT-1	4-5	09-17-17	At 5,5m from SEOS	155	SE1	140	SE1	210	BRK	09-17-17	09-17-17	N/A	T-9709
"	"	"	"	164	SE1	129	SE1	N/A	N/A	"	"	"	"
"	"	"	"	140	SE1	140	SE1	N/A	N/A	"	"	"	"
"	"	"	"	168	SE1	138	SE1	N/A	N/A	"	"	"	"
July 2018													
DT-1	12-13	07-16-18	WEOS (tie-end waste)	139	SE1	124	SE1	178	BRK	N/A	N/A	N/A	T-9601
"	"	"	"	123	SE1	126	SE1	N/A	N/A	"	"	"	"
"	"	"	"	118	SE1	137	SE1	N/A	N/A	"	"	"	"
"	"	"	"	130	SE1	134	SE1	N/A	N/A	"	"	"	"
DT-2	21-22	07-17-18	NEOS (tie-end waste)	121	SE1	131	SE1	183	BRK	N/A	N/A	N/A	T-9601
"	"	"	"	121	SE1	127	SE1	N/A	N/A	"	"	"	"
"	"	"	"	130	SE1	127	SE1	N/A	N/A	"	"	"	"
"	"	"	"	119	SE1	137	SE1	N/A	N/A	"	"	"	"
DT-3	24-25	07-17-18	At 0,1m of int. 24-25-26	126	SE1	126	SE1	178	BRK	07-18-18	07-18-18	N/A	T-9601
"	"	"	"	131	SE1	125	SE1	N/A	N/A	"	"	"	"
"	"	"	"	130	SE1	118	SE1	N/A	N/A	"	"	"	"
"	"	"	"	127	SE1	117	SE1	N/A	N/A	"	"	"	"

Repair Report Rapport de Réparation

Project Name / Nom de Projet: Meliadine Industrial Pad Fuel Farm

Project No. / No. de Projet: C-17060 / C-18068

QC Inspector / Inspecteur CQ: Louis-Philippe Beauchamps

Repair No. No. Réparation	Type & Dimensions Type et Dimensions			Location of Repair Localisation de la Réparation				Date Repaired Date Réparée (mm/dd/yy)	Date Repair Verified Date Réparée Vérifiée (mm/dd/yy)	Approved (Yes/No) Approuvé (Oui/Non)
	Patch Empiècement	Extrusion Weld or Bead Soudure Extrusion	Pipe Boot Manchon d'étanchéité	On Panel No. Sur Panneau No.	On Seam No. Sur Soudure No.	Intersection of Panels Intersection des Panneaux	Sample Location Localisation de l'échantillon			
September 2017										
R-1	P1				3-4		At 6m from SEOS	09-17-17	09-17-17	Y
July 2018										
R-2	P2					E1-E2-E5-17		07-17-18	07-17-18	Y
R-3		E				E2-E5-E6		07-17-18	07-17-18	Y
R-4		E				E2-E3-E6		07-17-18	07-17-18	Y
R-5		E DB			E3-E6		Full seam	07-17-18	07-17-18	Y
R-6		E DB			E4-E7		Full seam	07-17-18	07-17-18	Y
R-7		E				E4-E7-23		07-17-18	07-17-18	Y
R-8		E				E4-E8-23		07-17-18	07-17-18	Y
R-9	P2					E8-23-24		07-17-18	07-17-18	Y
R-10	P3					E7-22-23		07-17-18	07-17-18	Y
R-11		E				E6-E7-21-22		07-17-18	07-17-18	Y
R-12		E				E5-E6-20-21		07-17-18	07-17-18	Y
R-13	P2					E5-19-20		07-17-18	07-17-18	Y
R-14		E				E5-18-19		07-17-18	07-17-18	Y
R-15		E				E5-16-18		07-17-18	07-17-18	Y
R-16		E				E5-16-17		07-17-18	07-17-18	Y
R-17	P3					E1-15-16-17		07-17-18	07-17-18	Y
R-18	P1				24-25		At 3,3m from SEOS	07-17-18	07-17-18	Y
R-19		E DB			24-25		From SEOS to 3,3m	07-17-18	07-17-18	Y
R-20		E				9-10-11		07-17-18	07-17-18	Y

Repair Report Rapport de Réparation

Project Name / Nom de Projet: Meliadine Industrial Pad Fuel Farm

Project No. / No. de Projet: C-17060 / C-18068

QC Inspector / Inspecteur CQ: Louis-Philippe Beauchamps

Repair No. No. Réparation	Type & Dimensions Type et Dimensions			Location of Repair Localisation de la Réparation				Date Repaired Date Réparée (mm/dd/yy)	Date Repair Verified Date Réparée Vérifiée (mm/dd/yy)	Approved (Yes/No) Approuvé (Oui/Non)
	Patch Empiècement	Extrusion Weld or Bead Soudure Extrusion	Pipe Boot Manchon d'étanchéité	On Panel No. Sur Panneau No.	On Seam No. Sur Soudure No.	Intersection of Panels Intersection des Panneaux	Sample Location Localisation de l'échantillon			
R-21		E				E1-14-15		07-18-18	07-18-18	Y
R-22		E				E1-13-14		07-18-18	07-18-18	Y
R-23		E				E1-12-13		07-18-18	07-18-18	Y
R-24		E				E1-11-12		07-18-18	07-18-18	Y
R-25	P2					E1-8-11		07-18-18	07-18-18	Y
R-26	P1					8-9-11		07-18-18	07-18-18	Y
R-27		E				E1-7-8		07-18-18	07-18-18	Y
R-28	P2					E1-E2-7		07-18-18	07-18-18	Y
R-29		E				E2-6-7		07-18-18	07-18-18	Y
R-30		E				6-E2-E3		07-18-18	07-18-18	Y
R-31	P2					5-6-E3-E4		07-18-18	07-18-18	Y
R-32		E DB			E4-5		Between R-31 and R-33	07-18-18	07-18-18	Y
R-33	P2				E4-5		At 1,9m of int. E3-E4-5	07-18-18	07-18-18	Y
R-34		E				E4-4-5		07-18-18	07-18-18	Y
R-35		E				E4-E8-4		07-18-18	07-18-18	Y
R-36		E				E8-3-4		07-18-18	07-18-18	Y
R-37	P2					E8-3-24		07-18-18	07-18-18	Y
R-38	P2				9-10		At 6,9m from NEOS	07-18-18	07-18-18	Y
R-39		E				1-2-3		07-18-18	07-18-18	Y
R-40		E				1-3-24		07-18-18	07-18-18	Y
R-41		E				1-24-26		07-18-18	07-18-18	Y
R-42	P3					24-25-26		07-18-18	07-18-18	Y

Repair Report Rapport de Réparation

Project Name / Nom de Projet: Meliadine Industrial Pad Fuel Farm

Project No. / No. de Projet: C-17060 / C-18068

QC Inspector / Inspecteur CQ: Louis-Philippe Beauchamps

Repair No. No. Réparation	Type & Dimensions Type et Dimensions			Location of Repair Localisation de la Réparation				Date Repaired Date Réparée (mm/dd/yy)	Date Repair Verified Date Réparée Vérifiée (mm/dd/yy)	Approved (Yes/No) Approuvé (Oui/Non)
	Patch Empiècement	Extrusion Weld or Bead Soudure Extrusion	Pipe Boot Manchon d'étanchéité	On Panel No. Sur Panneau No.	On Seam No. Sur Soudure No.	Intersection of Panels Intersection des Panneaux	Sample Location Localisation de l'échantillon			
R-43	P1				25-26		At 1m of int. 24-25-26	07-18-18	07-18-18	Y
R-44	P1				25-26		At 1,6m of int. 24-25-26	07-18-18	07-18-18	Y
R-45	P1				25-26		At 3,1m of int. 24-25-26	07-18-18	07-18-18	Y
R-46		E DB			25-26		Between R-43 and R-45	07-18-18	07-18-18	Y
R-47	P2					18-19-27		07-19-18	07-19-18	Y
R-48		E				19-27-28		07-19-18	07-19-18	Y
R-49		E				19-28-29		07-19-18	07-19-18	Y
R-50			B	24			At 1m of 24-25 and 3,3m of SEOP	07-19-18	07-19-18	Y

CHARTER/CHART : Empiècement/Patch (**P1** 0.3m à/to 0.6m; **P2** 0.6m à/to 1m; **P3** over 1m et plus), Extrusion (**E**), Embout/Pipe Boot (**B**), Cap strip (**CS**), Doublure/Reinforcement (**DB**) et/and Reconstruction

APPENDIX II

-FIELD MEMOS AND COMMUNICATIONS



**CERTIFICAT D'ACCEPTATION DES ASSISES
SUBGRADE ACCEPTATION CERTIFICATE**

Nom du projet / Project name :

TAUK FARM ISFF


N° du projet / Project n° :

Emplacement / Location :

Mekhadine

CROQUIS / SKETCH

☒ ACCEPTATION PARTIELLE / PARTIAL ACCEPTATION
☐ ACCEPTATION COMPLETE / COMPLETE ACCEPTATION

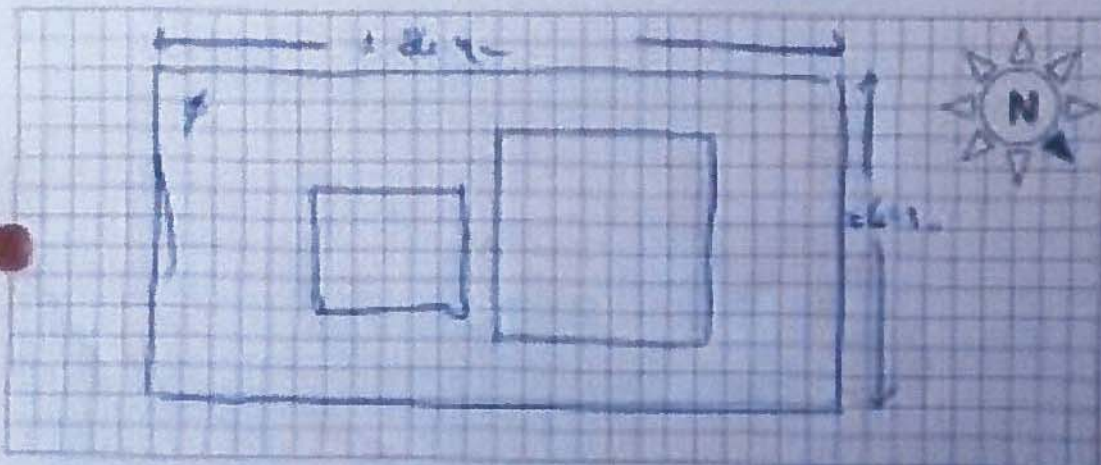

REMARQUES / COMMENTS

Attestation d'acceptation des assises de l'Etat. Le présent document est soumis à la validation de l'Etat. Toute modification ou suppression de l'Etat est interdite. (The State's approval of the subgrade is confirmed. This document is submitted for validation by the State. Any modification or deletion of the State is prohibited.)

Date / Date :

19 July 2008

Signature / Signature :

[Signature]

[Signature]

Date / Date :

19 July 2008

Signature / Signature :

[Signature]

Signature / Signature :

[Signature]




CERTIFICAT D'ACCEPTATION
PROVISOIRE

PROVISIONAL ACCEPTATION
CERTIFICATE

Nom du projet / Project Name: **TANK ROY LSK**
N° du projet / Project #: **1076**
Emplacement / Location: **Melindine**
N° des plans inclus / % of completion: **100%**

MATÉRIEL / MATERIAL	QUANTITÉ / QUANTITY	DESCRIPTION / DESCRIPTION
Geotextile Texel No6	3808.7 m ²	SUR P1 à P24
Geomembrane HDPE 400	2808.7 m ²	P1 à P24
Geotextile Texel No6	3808.7 m ²	SUR P1 à P24

CRUQUIS / SKETCH

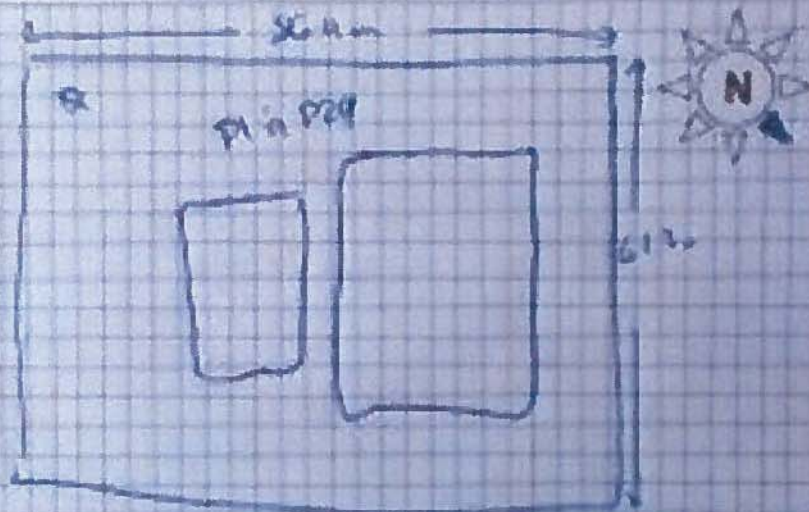

Je, soussigné, représentant légal de la société, certifie par la présente que les données fournies ci-dessus sont exactes et conformes aux plans et spécifications fournis en référence au contrat de cet ouvrage. Je certifie également que les travaux ont été réalisés conformément aux plans et spécifications fournis en référence au contrat de cet ouvrage. Je certifie également que les travaux ont été réalisés conformément aux plans et spécifications fournis en référence au contrat de cet ouvrage. Je certifie également que les travaux ont été réalisés conformément aux plans et spécifications fournis en référence au contrat de cet ouvrage.

[Signature] 19/04/2018
Certificat de réception provisoire de l'ouvrage / Certificate of provisional acceptance of the work

Reçu à l'attention de / Received by:

[Signature]
Reçu à l'attention de / Received by:


Reçu à l'attention de / Received by:

[Signature]
Reçu à l'attention de / Received by:

APPENDIX III

-US-EPA CLASSIFICATION FOR TYPES OF BREAK

FILLET-EXTRUDED GEOMEMBRANE WELD

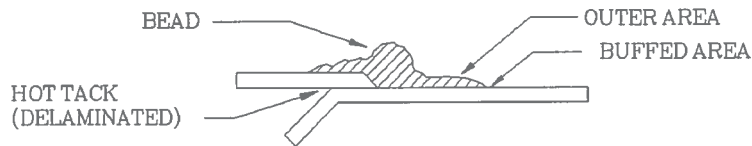


TYPES OF BREAKS	CODE	BREAK DESCRIPTION	CLASSIFICATION ^a
	AD1	FAILURE IN ADHESION. SPECIMENS MAY ALSO DELAMINATE UNDER THE BEAD AND BREAK THROUGH THE THIN EXTRUDED MATERIAL IN THE OUTER AREA.	NON-FTB
	AD2	FAILURE IN ADHESION.	NON-FTB
	AD-WLD	BREAK THROUGH THE FILLET. BREAKS THROUGH THE FILLET RANGE FROM BREAKS STARTING AT THE EDGE OF THE TOP SHEET TO BREAKS THROUGH THE FILLET AFTER SOME ADHESION FAILURE BETWEEN THE FILLET AND THE BOTTOM SHEET.	NON-FTB ^b
	SE	BREAK AT SEAM EDGE. INDICATE LOCATION BY 1, 2 OR 3	FTB
	BRK	BREAK IN THE SHEET. USE 1 TO INDICATE BOTTOM SHEET AND 2 TO INDICATE TOP SHEET. IF BREAK IS IN BUFFED AREA, INDICATE WITH "(B)".	FTB
	AD-BRK	BREAK IN THE BOTTOM SHEETING AFTER SOME ADHESION FAILURE BETWEEN THE FILLET AND THE BOTTOM SHEET. (APPLICABLE TO PEEL ONLY).	FTB
	HT	BREAK AT THE EDGE OF THE HOT TACK FOR SPECIMENS WHICH COULD NOT BE DELAMINATED IN THE HOT TACK.	NO TEST

^a FTB="FILM-TEAR BOND."

^b ACCEPTANCE OF AD-WLD BREAKS MAY DEPEND ON WHETHER TEST VALUES MEET A MINIMUM SPECIFICATION VALUE AND NOT ON CLASSIFICATION AS A FTB OR NON-FTB BREAK.

DOUBLE-TRACK GEOMEMBRANE WELD

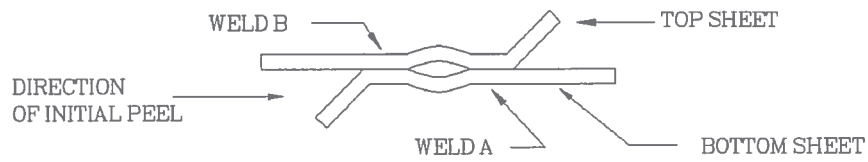

<u>TYPES OF BREAK</u>	<u>CODE</u>	<u>BREAK DESCRIPTION</u>	<u>CLASSIFICATION ^a</u>
	AD	ADHESION FAILURE	NON-FTB
	BRK	BREAK IN SHEETING. BREAK CAN BE IN EITHER TOP OR BOTTOM SHEET.	FTB
	SE1	BREAK AT OUTER EDGE OF SEAM. BREAK CAN BE IN EITHER TOP OR BOTTOM SHEET.	FTB
	SE2	BREAK AT INNER EDGE OF SEAM THROUGH BOTH SHEETS	FTB
	AD-BRK	BREAK IN FIRST SEAM AFTER SOME ADHESION FAILURE. BREAK CAN BE IN EITHER THE TOP OR BOTTOM SHEET.	FTB

^a FTB="FILM-TEAR BOND."

APPENDIX IV

-RECORD DRAWING



INGÉNIEUR / ENGINEER :

AGNICO EAGLE
CONSTRUCTION

LÉGENDE / LEGEND :

- EMPÎÈCEMENT / PATCH
- ⊕ MANCHON TUYAU / PIPE BOOT
- DESTRUCTIF / DESTRUCTIVE
- ▨ SOUDURE EXTRUSION / EXTRUSION WELD
- I PANNEAU NO. / PANEL NO.
- I-30474 ROULEAU NO. / ROLL NO.
- ||||| ANCRAGE MÉCANIQUE / MECHANICAL ANCHORAGE
- SOUDURE EXISTANTE / EXISTING SEAM

CLIENT / CUSTOMER :

NUNA KIVALLIQ
EARTHWORKS INC

TYPE DE PRODUIT INSTALLÉ / PRODUCT TYPE
INSTALLED

GEOTEXTILE 1 GOE - HDPE GOMIL -
GEOTEXTILE 1 GOE

TYPE DE PROJET / PROJECT TYPE

INDUSTRIAL PAD FUEL FARM LINING
AS-BUILT

NOM DU PROJET / PROJECT NAME

AGNICO EAGLE MELIADINE AEMO09 -
MELIADINE INDUSTRIAL PAD FUEL FARM

Texel
GEOSOL

1300, 2^e Rue, Parc industriel
Sainte-Marie, QC, Canada
G1V 4T2

NO. PROJET / PROJ. NO. : C-17060/C-18068

FICHIER AUTOCAD : C-18068.plt2.dwg
AUTOCAD FILE :

DATE (jj-mm-aa) : 01/09/18

DATE (dd-mm-yy) :


DESSINÉ PAR / DRAWN BY : E.B.

VÉRIFIÉ PAR / VERIFIED BY : E.B.

APPROUVÉ PAR / APPROVED BY : F.T.

ÉCHELLE / SCALE : 1/500

DESSIN NO. / DRAWING NO. : 1/1

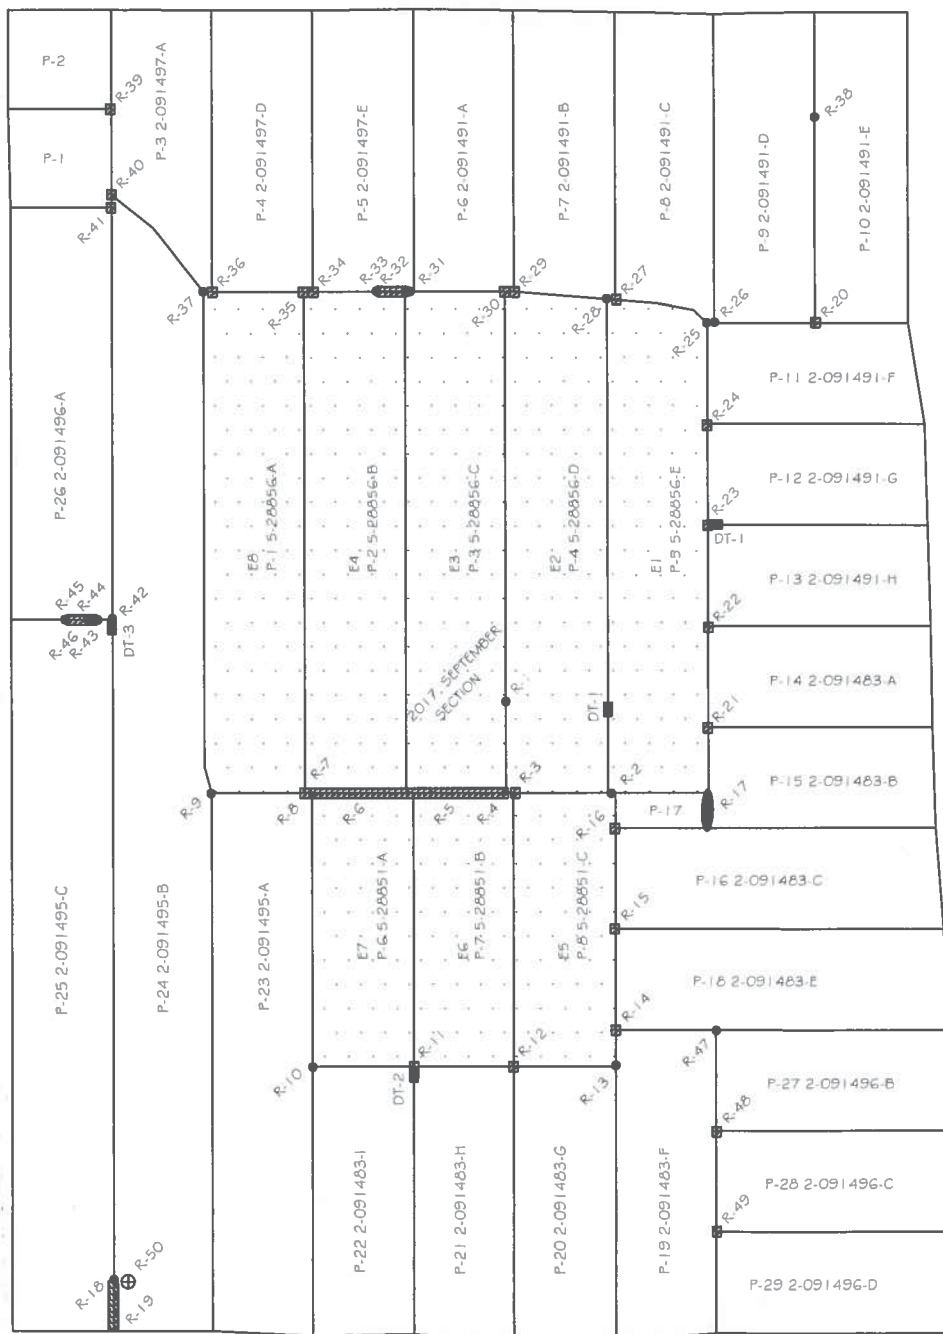

NO PANNEAU / PANEL NO	ROULEAU NO. / ROLL NO	
P-1	2-091497	A
P-2	2-091497	B
P-17	2-091483	D



ÉCHELLE : 1:500

APPENDIX L

Request for Information

Request For Information

Project No: 6515 Contract No: C-005 RFI No: 6515-C-230-005_001 Rev: 0
 Meliadine Project
 Site RFI Initiator: Matt Gallant Date: Mar 19, 2017

1. REFERENCE DOCUMENTS :

<u>Title(s):</u>	<u>Number:</u>	<u>Revision:</u>
Rankin Fuel Farm and Laydown Area	65-131-230-201	H

2. DESCRIPTION , JUSTIFICATION OF THE RFI AND PROPOSED SOLUTION :

- The typical HDPE liner specifies an above liner thickness of 200 mm for the Fuel Farm Floor, and 150mm for the dike slopes.
 - Please clarify the minimum lift thickness for equipment operating over liner, our proposed methode of placement over the liner is with a Cat D5 dozer.
- The Dike and Tank Pad Fill Detail specifies that 30mm minus granular fill material placed in lifts with a maximum thickness of 150mm nad compacted to 98%
 - Please confirm. the overliner lift and compaction requirements. Can the overliner be placed in one lift?
- We recommend that the 30mm Minus Above the liner be increased to > 300mm thick to facilitate constructability.

Prepared by: Matt Gallant Signature: *Matt Gallant* Date: Mar 19, 2017

3. TECHNICAL RESPONSE FROM ENGINEERING AND/OR VALIDATION OF PROPOSED SOLUTION :

The use of CAT D5 Dozer equipment for granular fill placement over the liner requires a minimum fill thickness of 300 mm to protect it. We recommend to increase the thickness of this layer and place 300 mm of 0-30 mm granular fill material over the liner in one lift and compact it by track packing only, with the CAT D5 Dozer in the entire fuel tank farm area. In addition, the remaining 0-30 mm granular fill layer for the tanks foundation will be placed in 200 mm thick lifts and compacted to 98% Standard Proctor Maximum Dry Density.

To avoid increasing the total required material quantities, the thickness of 0-30 mm granular fill material layer underneath the liner will be reduced accordingly and will be compacted to 98% Standard Proctor Maximum Dry Density. Under the liner system, the particle size of the top 300 mm of the 0-600 mm granular fill layer should not exceed Ø 200 mm.

For any equipment yielding heavier loads than a CAT D5 Dozer, the fill thickness above the liner shall be increased to allow for circulation. For a 10 ton packer, 500 mm is the minimum required fill thickness. For any other equipment, a specific request shall be submitted for the Engineer's approval.

Engineering : Rene Panazan Signature: *R. Panazan* Date: Mar 22, 2017

4. IF NOT TECHNICAL RFI VALIDATION OF PROPOSED SOLUTION BY SITE SUPERVISION

Deviation Request: ☐ No ☐ Yes		
Name	Signature	Date
Superintendent:		
c.c. Contract Administrator:		

Request For Information

Project No: 6515 Meliadine Project	Contract No: C-009	RFI No: 6515-C-230-009_015	Rev: 0
Site RFI Initiator: Jennifer Pyliuk		Date: July 25, 2017	


1. REFERENCE DOCUMENTS :

<u>Title(s):</u>	<u>Number:</u>	<u>Revision:</u>
Industrial Site Fuel Tank Farm – Cross Section and Details	65-000-230-215	1
Industrial Site Fuel Tank Farm – Ground Leveling – Finished Grade Elevation Plan View	65-000-230-223	1

2. DESCRIPTION , JUSTIFICATION OF THE RFI AND PROPOSED SOLUTION :

Due to current shortages of available underground run-of-mine (ROM) on site, the following material substitutions are proposed for construction of the Industrial Site Fuel Tank Farm (see details):

1. ROM Rockfill (600 mm minus) for construction of the containment area outside the tank pedestal footprints and perimeter berms to be replaced with Class A Esker material (600 mm minus).
2. Elimination of the Transition Rockfill (200 mm minus) from the under liner in the above noted area.
3. ROM Rockfill (600 mm minus) for construction of the Service Pad to be replaced with Class A esker material (600 mm minus).

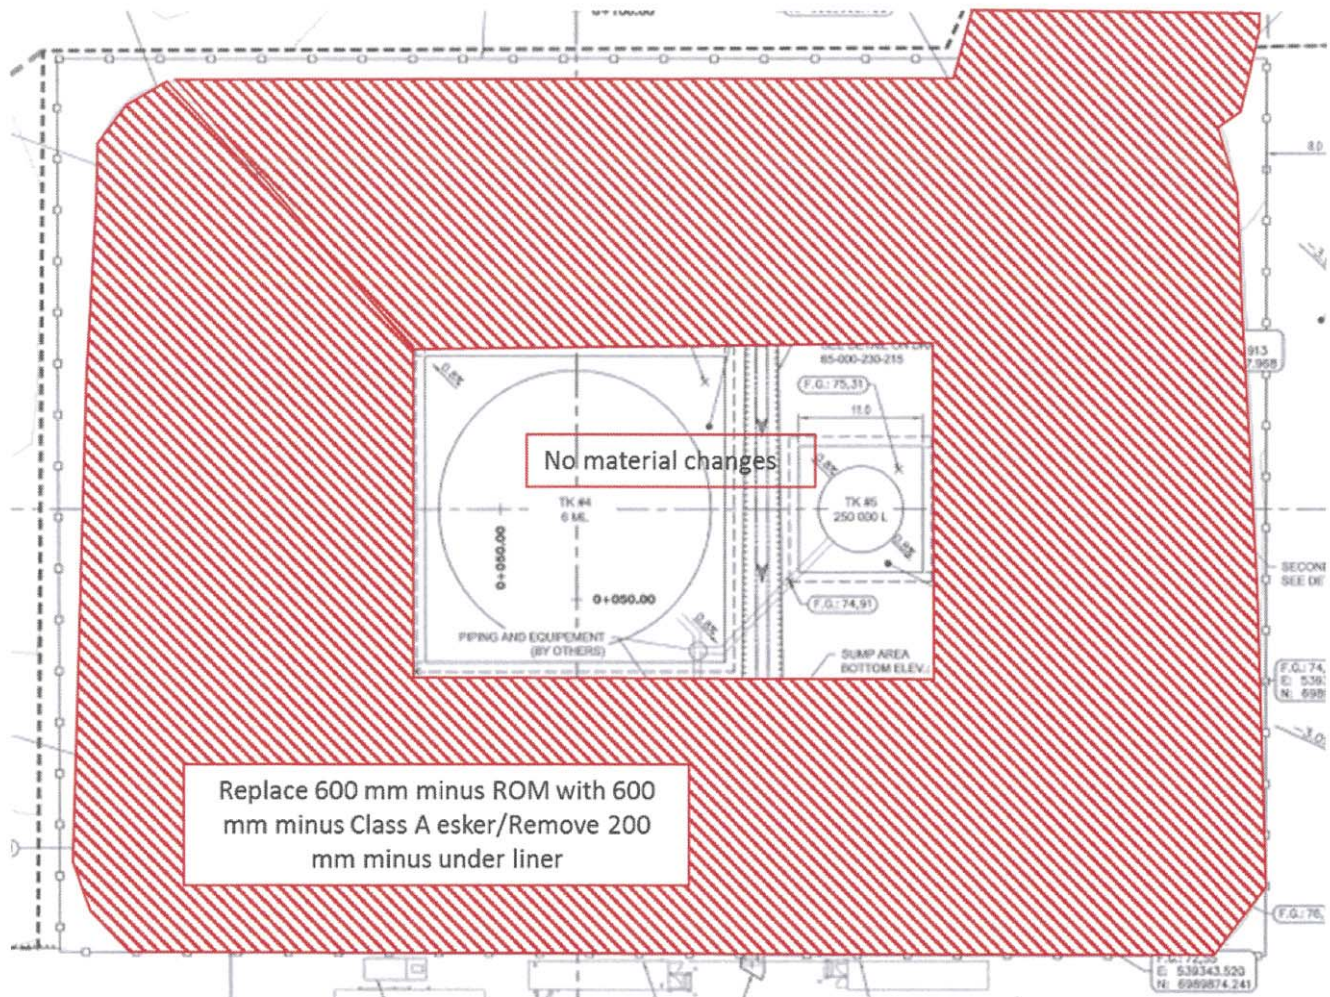



July 25, 2017

c.c. Contract Administrators:

Request For Information

3. TECHNICAL RESPONSE FROM ENGINEERING AND/OR VALIDATION OF PROPOSED SOLUTION :

1. **ROM Rockfill (600mm minus) substitution with Class A Esker material (600mm minus) for the fuel farm floor outside the tank pedestal and its projection slope 1V:2H :** Accepted provided that the material is sufficiently graded and with adequate moisture to achieve the minimum compaction specified on drawings (90% standard proctor maximum dry density). The maximum lift thickness should also be reduced to adapt with the material quality, the optimum thickness shall be determined on site with the field engineer. A special attention to the quality of material, lifts, compaction and slope to have a very good general stability achieved with the material on the perimeter berm (dike) is required.
2. **Elimination of transition rockfill (200mm minus) in the same area:** Accepted provided that the material is sufficiently graded and with adequate moisture to achieve the minimum compaction specified on drawings (95% standard proctor maximum dry density). The maximum particle size shall be limited to 200mm and the granular material shall be placed in lifts not exceeding 300mm in the associated layer underneath the liner system.
3. **ROM Rockfill (600mm minus) substitution with Class A Esker material (600mm minus) for the Service Pad :** Accepted provided that the material is sufficiently graded and with adequate moisture to achieve the minimum compaction specified on drawings (90% standard proctor maximum dry density). The maximum lift thickness should also be reduced to adapt with the material quality, the optimum thickness shall be determined on site with the field engineer.

Engineering : JOSEÉ ALARIE

Signature: Josee Alarie

Date: 2017-07-25

4. IF NOT TECHNICAL RFI VALIDATION OF PROPOSED SOLUTION BY SITE SUPERVISION

		Deviation Request: ☐ No ☐ Yes	
	Name	Signature	Date
Superintendent:			
c.c. Contract Administrator:			